

# NELSON LAGOON POWER SYSTEM UPGRADE PROJECT

## ON SITE CONSTRUCTION

CIVIL DRAWINGS	
G1	VICINITY MAP
G.2	SURVEY CONTROL SHEET
C1	SITE PLAN
C2	TYPICAL SECTIONS
ARCHITECTURAL DRAWINGS	
A1	FLOOR PLAN, REFLECTED CEILING PLAN, CODE ANALYSIS, & GENERAL NOTES
A2.1	INTERIOR ELEVATIONS
A2.2	DOOR & WINDOW DETAILS & SCHEDULE
A3	EXTERIOR ELEVATIONS & ROOFING NOTES & TRIM DETAILS
A4	BUILDING SECTIONS & DETAILS
STRUCTURAL DRAWINGS	
S1.1	FOUNDATION PLAN, CODE ANALYSIS & STRUCTURAL NOTES
S1.2	FOUNDATION DETAILS
S2	MODULE FRAMING PLANS & DETAILS
S3	MODULE SECTIONS & DETAILS
S4	ROOF FRAMING PLAN & DETAILS
S5.1	STAIRS, LANDINGS, LOADING DOCK, & RADIATOR SUPPORT PLAN
S5.2	STAIRS/LANDINGS FABRICATION DETAILS
S5.3	LOADING DOCK FABRICATION DETAILS
S5.4	RADIATOR SUPPORT FABRICATION DETAILS


MECHANICAL DRAWINGS	
M1.1	MECHANICAL LEGENDS & SCHEDULES
M1.2	WARNING SIGN & FIRE EXTINGUISHER PLAN, SIGN & VALVE TAG SCHEDULES
M1.3	SYSTEM START UP & SEQUENCE OF OPERATIONS
M1.4	OVERALL PROJECT AREA PLAN & POWER PLANT AREA MECHANICAL SITE PLAN
M1.5	POWER PLANT ENLARGED MECHANICAL SITE PLAN & DETAILS
M1.6	INTERMEDIATE TANK INSTALLATION ELEVATIONS & DETAILS
M1.7	INTERMEDIATE TANK DETAILS
M1.8	4,000 GALLON DOUBLE WALL INTERMEDIATE TANK FABRICATION DETAILS
M2.1	MECHANICAL PENETRATIONS PLAN, ELEVATIONS & DETAILS
M2.2	MECHANICAL PENETRATION DETAILS
M2.3	MECHANICAL SUPPORT PLANS & DETAILS
M2.4	MECHANICAL SUPPORT HORIZONTAL WALL STRUT INSTALLATION
M2.5	MECHANICAL SUPPORT VERTICAL WALL STRUT INSTALLATION
M3.1	EQUIPMENT LAYOUT PLAN, SECTION, & DETAILS
M3.2	WALL ELEVATIONS & PIPING DETAILS
M3.3	MECHANICAL DETAILS
M3.4	GENERATOR FABRICATION DETAILS
M4.1	COOLANT & HEAT RECOVERY PIPING PLAN & DETAILS
M4.2	COOLANT & HEAT RECOVERY ISOMETRICS & DETAILS
M4.3	COOLANT & HEAT RECOVERY PIPING DETAILS
M4.4	GLYCOL STORAGE & EXPANSION TANKS FABRICATION
M5.1	DIESEL FUEL & USED OIL PIPING PLAN, DIAGRAM, & DETAILS
M5.2	DIESEL FUEL & USED OIL PIPING ELEVATIONS & DETAILS
M5.3	USED OIL HOPPER & BLENDER INSTALLATION DETAILS
M5.4	200 GALLON DAY TANK FABRICATION
M5.5	USED OIL BLENDER FILTER BANK LAYOUT & CONFIGURATION
M5.6	USED OIL BLENDER TYPICAL FILTER HOUSING DETAILS
M5.7	USED OIL BLENDER 25 GALLON HOPPER FABRICATION
M6	EXHAUST & CRANK VENT PLAN & DETAILS
M7.1	VENTILATION PLAN & DETAILS
M7.2	SHEET METAL FABRICATION DETAILS
M8.1	HEAT RECOVERY SYSTEM OVERALL PLAN, SCHEMATIC, & EQUIPMENT SCHEDULE
M8.2	HEAT RECOVERY SYSTEM ARCTIC PIPE DETAILS
M8.3	HEAT RECOVERY SYSTEM TOURISM BUILDING PLAN & DETAILS
M8.4	HEAT RECOVERY SYSTEM STORAGE COMPOUND PLANS & PIPING ELEVATION
M8.5	HEAT RECOVERY SYSTEM STORAGE COMPOUND PIPING ISOMETRIC & DETAILS
M8.8	HEAT RECOVERY SYSTEM STORAGE COMPOUND PIPING DETAILS
M8.7	HEAT RECOVERY SYSTEM ICEHOUSE PLAN, PIPING ISOMETRIC, & DETAILS
M8.8	HEAT RECOVERY SYSTEM ICEHOUSE PIPING DETAILS
FS1	FIRE SUPPRESSION SYSTEM PLAN, SECTION, LEGEND, & NOTES

ELECTRICAL – POWER PLANT	
E1.1	ELECTRICAL LEGENDS & SCHEDULES
E1.2	POWER PLANT AREA ELECTRICAL SITE PLAN
E1.3	POWER PLANT ENLARGED ELECTRICAL SITE PLAN
E1.4	POWER PLANT AREA STAKING SHEET & DISTRIBUTION DETAILS
E1.5	POWER PLANT SITE ELECTRICAL DETAILS
E1.6	POWER PLANT AREA ELECTRICAL SERVICE DETAILS
E1.7	POWER PLANT COMMUNICATION PLAN & DETAILS
E2	MODULE GROUNDING PLAN & DETAILS
E3.1	WIREWAY PLAN, BUILDING SECTION, & DETAILS
E3.2	ELEVATIONS & DETAILS
E3.3	ELEVATIONS & DETAILS
E4.1	RECEPTACLE & LIGHTING PLANS & PANELBOARD
E4.2	STATION SERVICE PLAN, DETAILS, & PANELBOARD
E5	INSTRUMENTATION & DATA PLAN & DETAILS
E6.1	SWITCHGEAR ENCLOSURE LAYOUT, SETTING TABLE, & DETAILS
E6.2	SWITCHGEAR ONE-LINE & DETAILS
E6.3	24VDC ENGINE WIRING JUNCTION BOX
E7.1	DAY TANK CONTROL PANEL LOGIC DIAGRAM & BILL OF MATERIALS
E7.2	DAY TANK CONTROL PANEL LAYOUT & TERMINAL STRIPS
E7.3	DAY TANK CONTROL PANEL NOTES, SEQUENCE OF OPERATIONS & INTERCONNECT DETAILS
E7.4	DAY TANK FILTER WATER INDICATION PANEL
E8	HEAT RECOVERY SYSTEM END USER BUILDINGS ELECTRICAL PLANS
2004 BFU E-07	LADDER DIAGRAM TANK FARM CONTROL
2004 BFU E-08	INTERCONNECT DIAGRAM & NOTES
2004 BFU E-09	POWER PLANT TANK – TRANSFER CONTROL PANEL

ELECTRICAL – DISTRIBUTION	
E10.1	DISTRIBUTION LEGEND, ABBREVIATIONS, SPECIFICATIONS & NOTES
E10.2	DISTRIBUTION DETAILS
E10.3	TRENCH DETAILS
E10.4	DISTRIBUTION ONE-LINE DIAGRAM
E11.0	OVERALL DISTRIBUTION SITE PLAN
E11.1	DISTRIBUTION DEMOLITION PLAN (1 OF 7)
E11.2	DISTRIBUTION DEMOLITION PLAN (2 OF 7)
E11.3	DISTRIBUTION DEMOLITION PLAN (3 OF 7)
E11.4	DISTRIBUTION DEMOLITION PLAN (4 OF 7)
E11.5	DISTRIBUTION DEMOLITION PLAN (5 OF 7)
E11.6	DISTRIBUTION DEMOLITION PLAN (6 OF 7)
E11.7	DISTRIBUTION DEMOLITION PLAN (7 OF 7)
E12.1	DISTRIBUTION PLAN (1 OF 7)
E12.2	DISTRIBUTION PLAN (2 OF 7)
E12.3	DISTRIBUTION PLAN (3 OF 7)
E12.4	DISTRIBUTION PLAN (4 OF 7)
E12.5	DISTRIBUTION PLAN (5 OF 7)
E12.6	DISTRIBUTION PLAN (6 OF 7)
E12.7	DISTRIBUTION PLAN (7 OF 7)


THIS DRAWING SET INCLUDES DRAWINGS THAT SHOW WORK THAT IS INCLUDED IN THIS CONTRACT AND REFERENCE DRAWINGS THAT SHOW WORK PERFORMED UNDER THE PRIOR MODULE ASSEMBLY CONTRACT. SEE RED NOTES ON EACH SHEET FOR DELINEATION OF SCOPE.

THIS DRAWING SET SHOWS WORK THAT IS UNDER THE BASE BID AND ADDITIVE ALTERNATES. ALL WORK SHOWN IS INCLUDED IN THE BASE BID UNLESS SPECIFICALLY INDICATED AS ADDITIVE ALTERNATE.



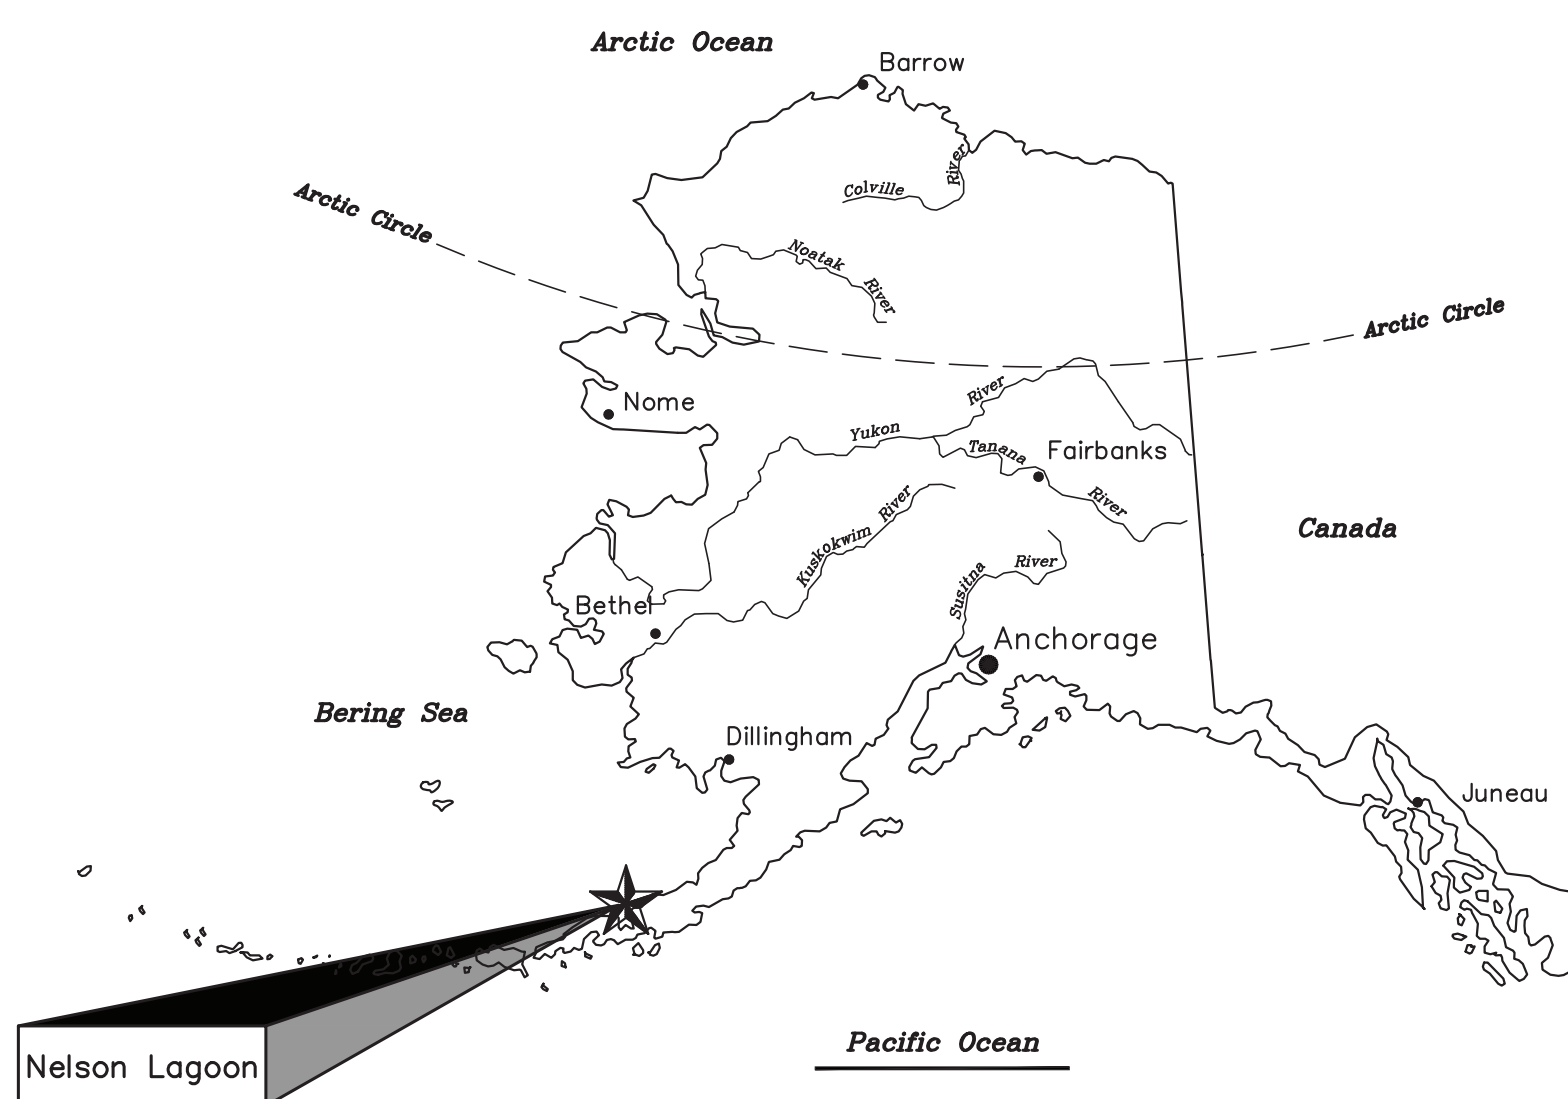


ISSUED FOR CONSTRUCTION  
MAY 2023



 ALASKA ENERGY AUTHORITY	
PROJECT: NELSON LAGOON POWER SYSTEM UPGRADE	
TITLE: ON-SITE CONSTRUCTION SCHEDULE OF DRAWINGS	
DRAWN BY: BCG	SCALE: NO SCALE
DESIGNED BY: BCG	DATE: 5/30/23
FILE NAME: NELS PP G1	SHEET: <b>GO</b>
PROJECT NUMBER:	
P.O. 111405, Anchorage, AK 99511 (907)349-0100	

File: J:\JobsData\72308.02 Nelson Lagoon Rpsu - Civil Design\00 Cadd 2019\01 Working Set\01 Civil\72308.02 Vicinity Map.dwg PLOT DATE: 5/18/2023 10:22 AM

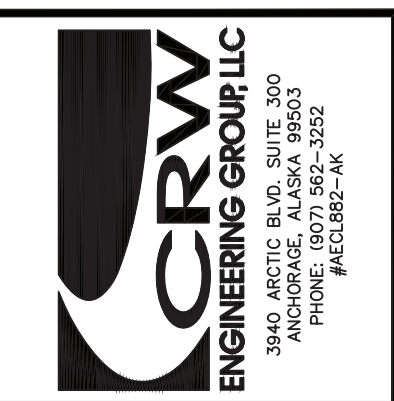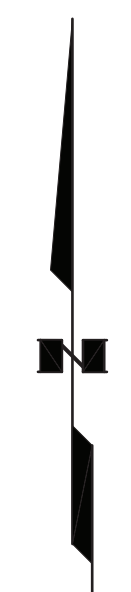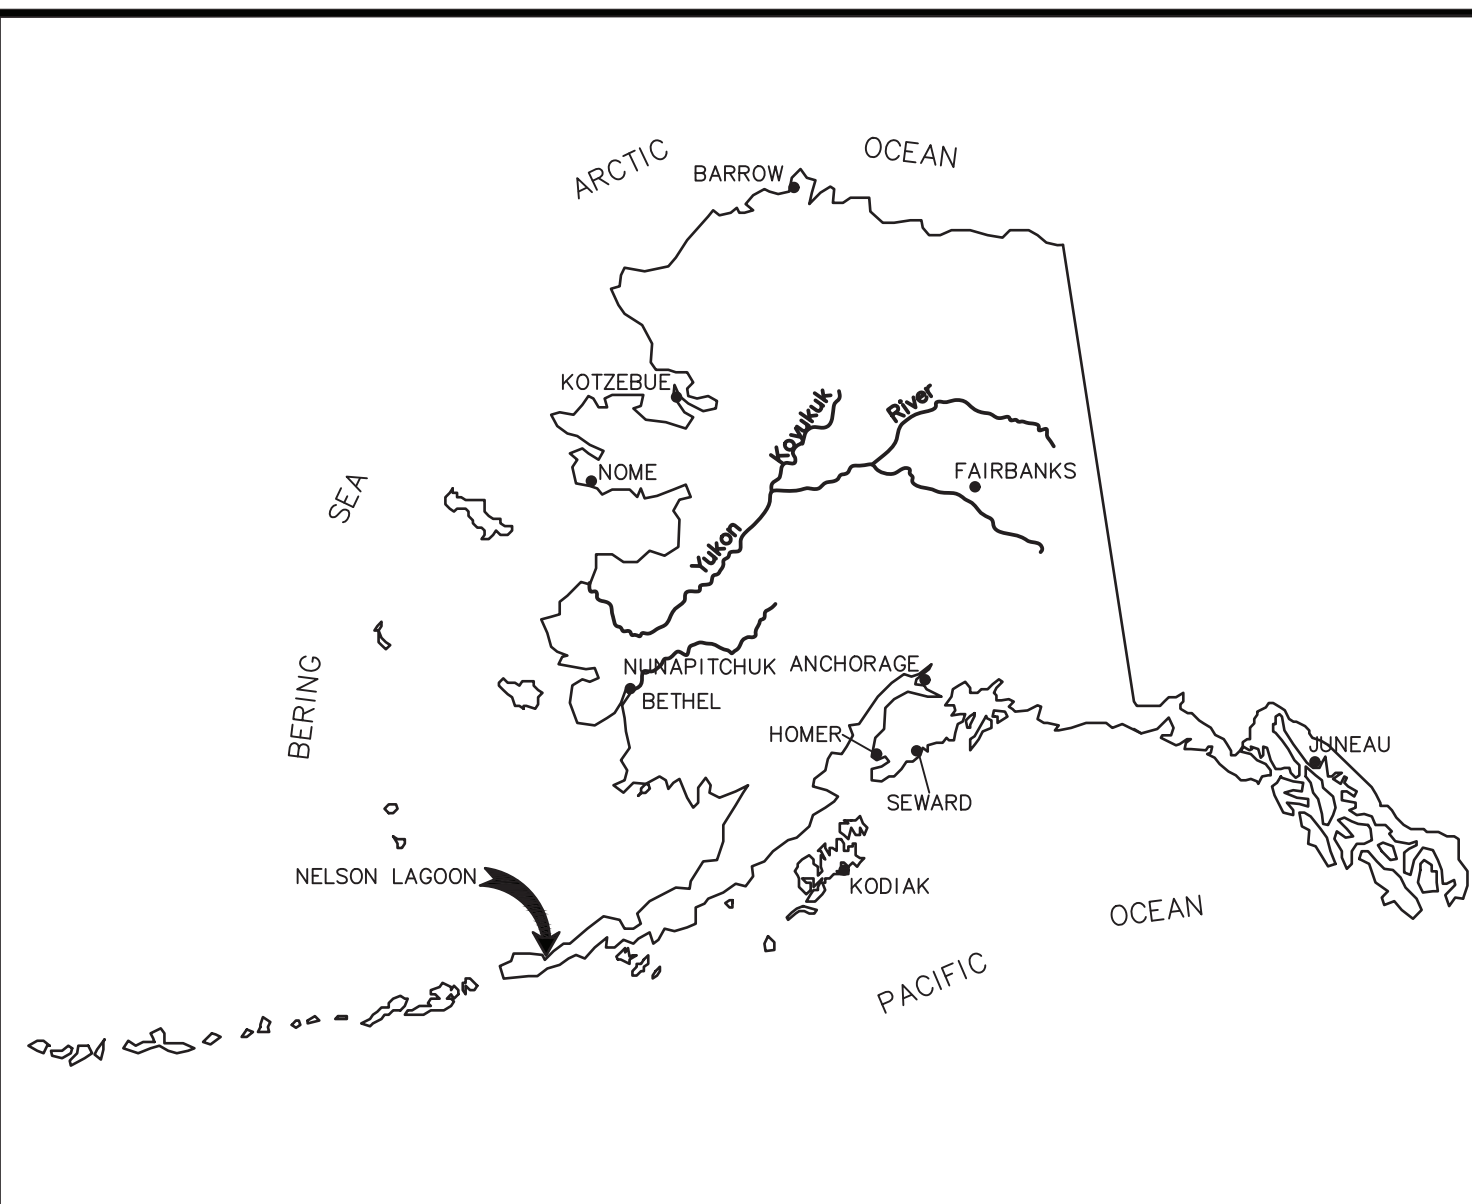

PROJECT NO.	CITY GRID	WATER GRID	SEWER GRID

NELSON LAGOON RPSU  
VICINITY MAP  
VICINITY MAP

STATUS: FINAL SUBMITTAL

DATE: 5/30/23

REV	DATE	DESCRIPTION	BY

SCALE	HOR. NTS	VER. NTS
DESIGNED BY		
DRAWN BY		
CHECKED BY		
APPROVED BY		

SHEET NO. **G1**

1

**VICINITY MAP**

ALL WORK ON THIS SHEET IS INCLUDED IN THE ON SITE CONTRACT.



**SURVEYOR'S CERTIFICATE**

I, CHRISTOPHER J. BLITZ, HEREBY CERTIFY THAT I AM PROPERLY REGISTERED AND LICENSED TO PRACTICE LAND SURVEYING IN THE STATE OF ALASKA, AND THAT THIS DRAWING REPRESENTS A SURVEY MADE BY ME OR UNDER MY DIRECT SUPERVISION, AND THAT THE MONUMENTS SHOWN HEREON ACTUALLY EXIST AS DESCRIBED, AND THAT ALL DIMENSIONS AND OTHER DETAILS ARE CORRECT TO THE EXTENT SHOWN HEREON.

**NOTES**

1. THIS FIELD SURVEY WAS CONDUCTED SEPTEMBER 27-30, 2022 BY CRW ENGINEERING GROUP. SURVEY NOTES ARE CONTAINED IN FIELD BOOK 227, PAGES 27-49.
2. ALL COORDINATES SHOWN ARE EXPRESSED IN U.S. SURVEY FEET AND ALL DISTANCES HAVE BEEN REDUCED TO HORIZONTAL GROUND DISTANCES.
3. HORIZONTAL CONTROL POINTS SHOWN WERE ESTABLISHED VIA REDUNDANT RTK GNSS TECHNIQUES.
4. WHETHER LISTED OR NOT, ALL MONUMENTS OR PROPERTY MARKERS, CORNERS, OR ACCESSORIES, WHICH WILL BE DISTURBED OR BURIED, SHALL BE REFERENCED OR RE-ESTABLISHED IN THEIR ORIGINAL POSITION (A.S. 19.10.260) AND RECORDED (A.S. 34.65.040).
5. ALL DOCUMENTS SHOWN RECORDED IN THE ALEUTIAN ISLANDS RECORDING DISTRICT.
6. IT IS THE RESPONSIBILITY OF THE CONTRACTOR TO VERIFY THE HORIZONTAL AND VERTICAL POSITIONS OF CONTROL POINTS SHOWN HEREON.
7. BACKGROUND TOPOGRAPHIC INFORMATION SHOWN IS FOR ORIENTATION PURPOSES ONLY.

**COORDINATE SYSTEM:**

THIS PROJECT IS LOCATED ENTIRELY WITHIN THE NELSON LAGOON LDP, A LOW DISTORTION PROJECTION CREATED BY CRW ENGINEERING GROUP, SEE NELSON LAGOON LDP PARAMETERS FOR MORE INFORMATION.

**BASIS OF COORDINATES:**

A MULTI-DAY AVERAGED NAD83 (2011) (EPOCH: 2010.0000) OPUS SOLUTION FOR CONTROL POINT 601 WAS HELD FIXED AT 56°00'22.67401" N, 161° 10' 37.07293" W. SAID POINT HAS NELSON LAGOON LDP COORDINATES N 62,301.5384', E 94,714.5790'. NGS CORS STATIONS USED INCLUDE AC42 SANAKISLNDK2007 (PID DM7493), BET1 BETHEL WAAS (PID DK4091), AV09 HAYSTACK\_AK2004 (PID DG7471), AC45 SITKINAKISAK2006 (PID DM7499), & AC26 CAPE\_GULL\_AK2008 (PID DL7659).

**VERTICAL CONTROL**

PROJECT VERTICAL DATUM IS NAVD 88 USING GEOID 12BAK SEPARATIONS. THE OPUS-AVERAGED ELLIPSOID HEIGHT OF POINT 601 WAS HELD FIXED AT 62.23', WHICH PROPAGATES TO AN ORTHOMETRIC ELEVATION OF 16.36' WITH GEOID 12BAK SEPARATIONS. ELEVATIONS FOR TEMPORARY BENCH MARKS 351-353 WERE ESTABLISHED VIA DIFFERENTIAL LEVELING HOLDING THE ABOVE LISTED ELEVATION OF CONTROL POINT 601 FIXED. A LEICA DNA 10 DIGITAL LEVEL WAS USED FOR ALL DIFFERENTIAL LEVELING.

**NELSON LAGOON LDP PARAMETERS:**

LINEAR UNIT: US SURVEY FEET  
 DATUM: NAD83  
 ELLIPSOID: GRS80  
 PROJECTION: TRANSVERSE MERCATOR  
 LATITUDE OF ORIGIN: 56°00'00" N  
 CENTRAL MERIDIAN: 161°12'00" W  
 SCALE FACTOR AT ORIGIN: 1.00000297  
 ZONE WIDTH: 0°30'00"  
 FALSE NORTHING: 60,000.0000'  
 FALSE EASTING: 90,000.0000'

HORIZONTAL CONTROL					
POINT NO	NORTHING	EASTING	LATITUDE	LONGITUDE	DESCRIPTION
1	61692.7020	94687.0274	N56° 00' 16.6740"	W161° 10' 37.5611"	SET 2" ALUMINUM CAP 0.1' BELOW GRADE
601	62301.5384	94714.5790	N56° 00' 22.6740"	W161° 10' 37.0729"	FOUND 3-1/4" ALUMINUM CAP 0.4' ABOVE GRADE
602	62293.6586	95192.9533	N56° 00' 22.5947"	W161° 10' 28.6586"	FOUND 3-1/4" BRASS CAP 0.25' ABOVE GRADE
603	62272.1400	94818.9693	N56° 00' 22.3839"	W161° 10' 35.2369"	FOUND 2-1/2" ALUMINUM CAP FLUSH WITH GRADE
604	62270.0251	94841.5662	N56° 00' 22.3630"	W161° 10' 34.8395"	FOUND 3-1/4" ALUMINUM CAP FLUSH WITH GRADE
605	62282.0959	94713.1530	N56° 00' 22.4824"	W161° 10' 37.0981"	FOUND BENT S.S. ROD 0.6' BELOW GRADE, CAP MISSING
606	62316.2553	94715.6701	N56° 00' 22.8190"	W161° 10' 37.0537"	FOUND 3-1/4" ALUMINUM CAP 0.6' BELOW GRADE
607	62188.4239	94662.0694	N56° 00' 21.5594"	W161° 10' 37.9972"	FOUND 5/8" REBAR 1.7' BELOW GRADE & PLUMB
608	62159.9315	94608.2159	N56° 00' 21.2788"	W161° 10' 38.9446"	FOUND 1-1/2" PLASTIC CAP 1.5' BELOW GRADE
609	61937.5218	94531.8864	N56° 00' 19.0872"	W161° 10' 40.2885"	FOUND BENT 5/8" REBAR BELOW GRAVEL PAD LINER
610	61796.4578	94606.4047	N56° 00' 17.6968"	W161° 10' 38.9786"	FOUND 1/2" REBAR 0.7' BELOW GRADE & PLUMB
611	61972.8345	95126.5023	N56° 00' 19.4332"	W161° 10' 29.8295"	FOUND 3-1/4" ALUMINUM CAP 0.9' BELOW GRADE
612	62051.8298	95065.3788	N56° 00' 20.2119"	W161° 10' 30.9041"	FOUND 3-1/4" ALUMINUM CAP 0.1' ABOVE GRADE
613	62207.9834	95509.6523	N56° 00' 21.7492"	W161° 10' 23.0886"	FOUND 3-1/4" ALUMINUM CAP 0.5' BELOW GRADE
614	62308.1221	95509.4437	N56° 00' 22.7361"	W161° 10' 23.0916"	FOUND 3-1/4" BRASS CAP FLUSH WITH GRADE
615	62370.3404	95509.4593	N56° 00' 23.3492"	W161° 10' 23.0909"	FOUND 3-1/4" ALUMINUM CAP 0.9' BELOW GRADE
616	62064.9228	95262.8400	N56° 00' 20.3403"	W161° 10' 27.4308"	FOUND 2" ALUMINUM CAP 0.6' BELOW GRADE
617	61966.6465	95118.5677	N56° 00' 19.3723"	W161° 10' 29.9691"	FOUND 2" ALUMINUM CAP 1.0' BELOW GRADE
618	62043.9656	95071.5024	N56° 00' 20.1344"	W161° 10' 30.7965"	FOUND 2" ALUMINUM CAP 0.4' BELOW GRADE
619	62045.3902	95057.7395	N56° 00' 20.1485"	W161° 10' 31.0385"	FOUND 5/8" REBAR 0.6' BELOW GRADE & PLUMB
* 620	61998.9485	94305.2486	N56° 00' 19.6933"	W161° 10' 44.2745"	FOUND 2-1/2" ALUMINUM CAP 0.2' BELOW GRADE
3501	62226.7046	94733.6120	N56° 00' 21.9365"	W161° 10' 36.7386"	SET 2" ALUMINUM CAP 0.3' BELOW GRADE
3502	62158.3752	94786.5560	N56° 00' 21.2629"	W161° 10' 35.8077"	SET 2" ALUMINUM CAP 0.3' BELOW GRADE
3503	62109.3760	94723.3178	N56° 00' 20.7802"	W161° 10' 36.9203"	SET 2" ALUMINUM CAP 0.3' BELOW GRADE
3504	61797.3783	94965.0644	N56° 00' 17.7047"	W161° 10' 32.6701"	SET 2" ALUMINUM CAP 0.3' BELOW GRADE
3505	62196.1094	95509.6665	N56° 00' 21.6322"	W161° 10' 23.0885"	SET 2" ALUMINUM CAP 0.3' BELOW GRADE
3506	61813.1879	94952.8146	N56° 00' 17.8605"	W161° 10' 32.8855"	SET 2" ALUMINUM CAP 0.3' BELOW GRADE


VERTICAL CONTROL				
POINT NO	NORTHING	EASTING	ELEVATION	DESCRIPTION
351	62296	94599	16.92	SET PAINTED MARK ON S.W. CORNER OF DIKE
352	62060	94548	9.62	SET PAINTED MARK IN CONCRETE FINISHED FLOOR ALONG SOUTH WALL NEAR EAST END OF GARAGE DOOR
353	62025	94520	10.05	SET PAINTED MARK IN S.E. CORNER OF CONCRETE SLAB EMERGING FROM GARAGE DOOR

**SURVEY CONTROL**

SCALE: GRAPHIC

1

ALL WORK ON THIS SHEET IS INCLUDED IN THE ON SITE CONTRACT.

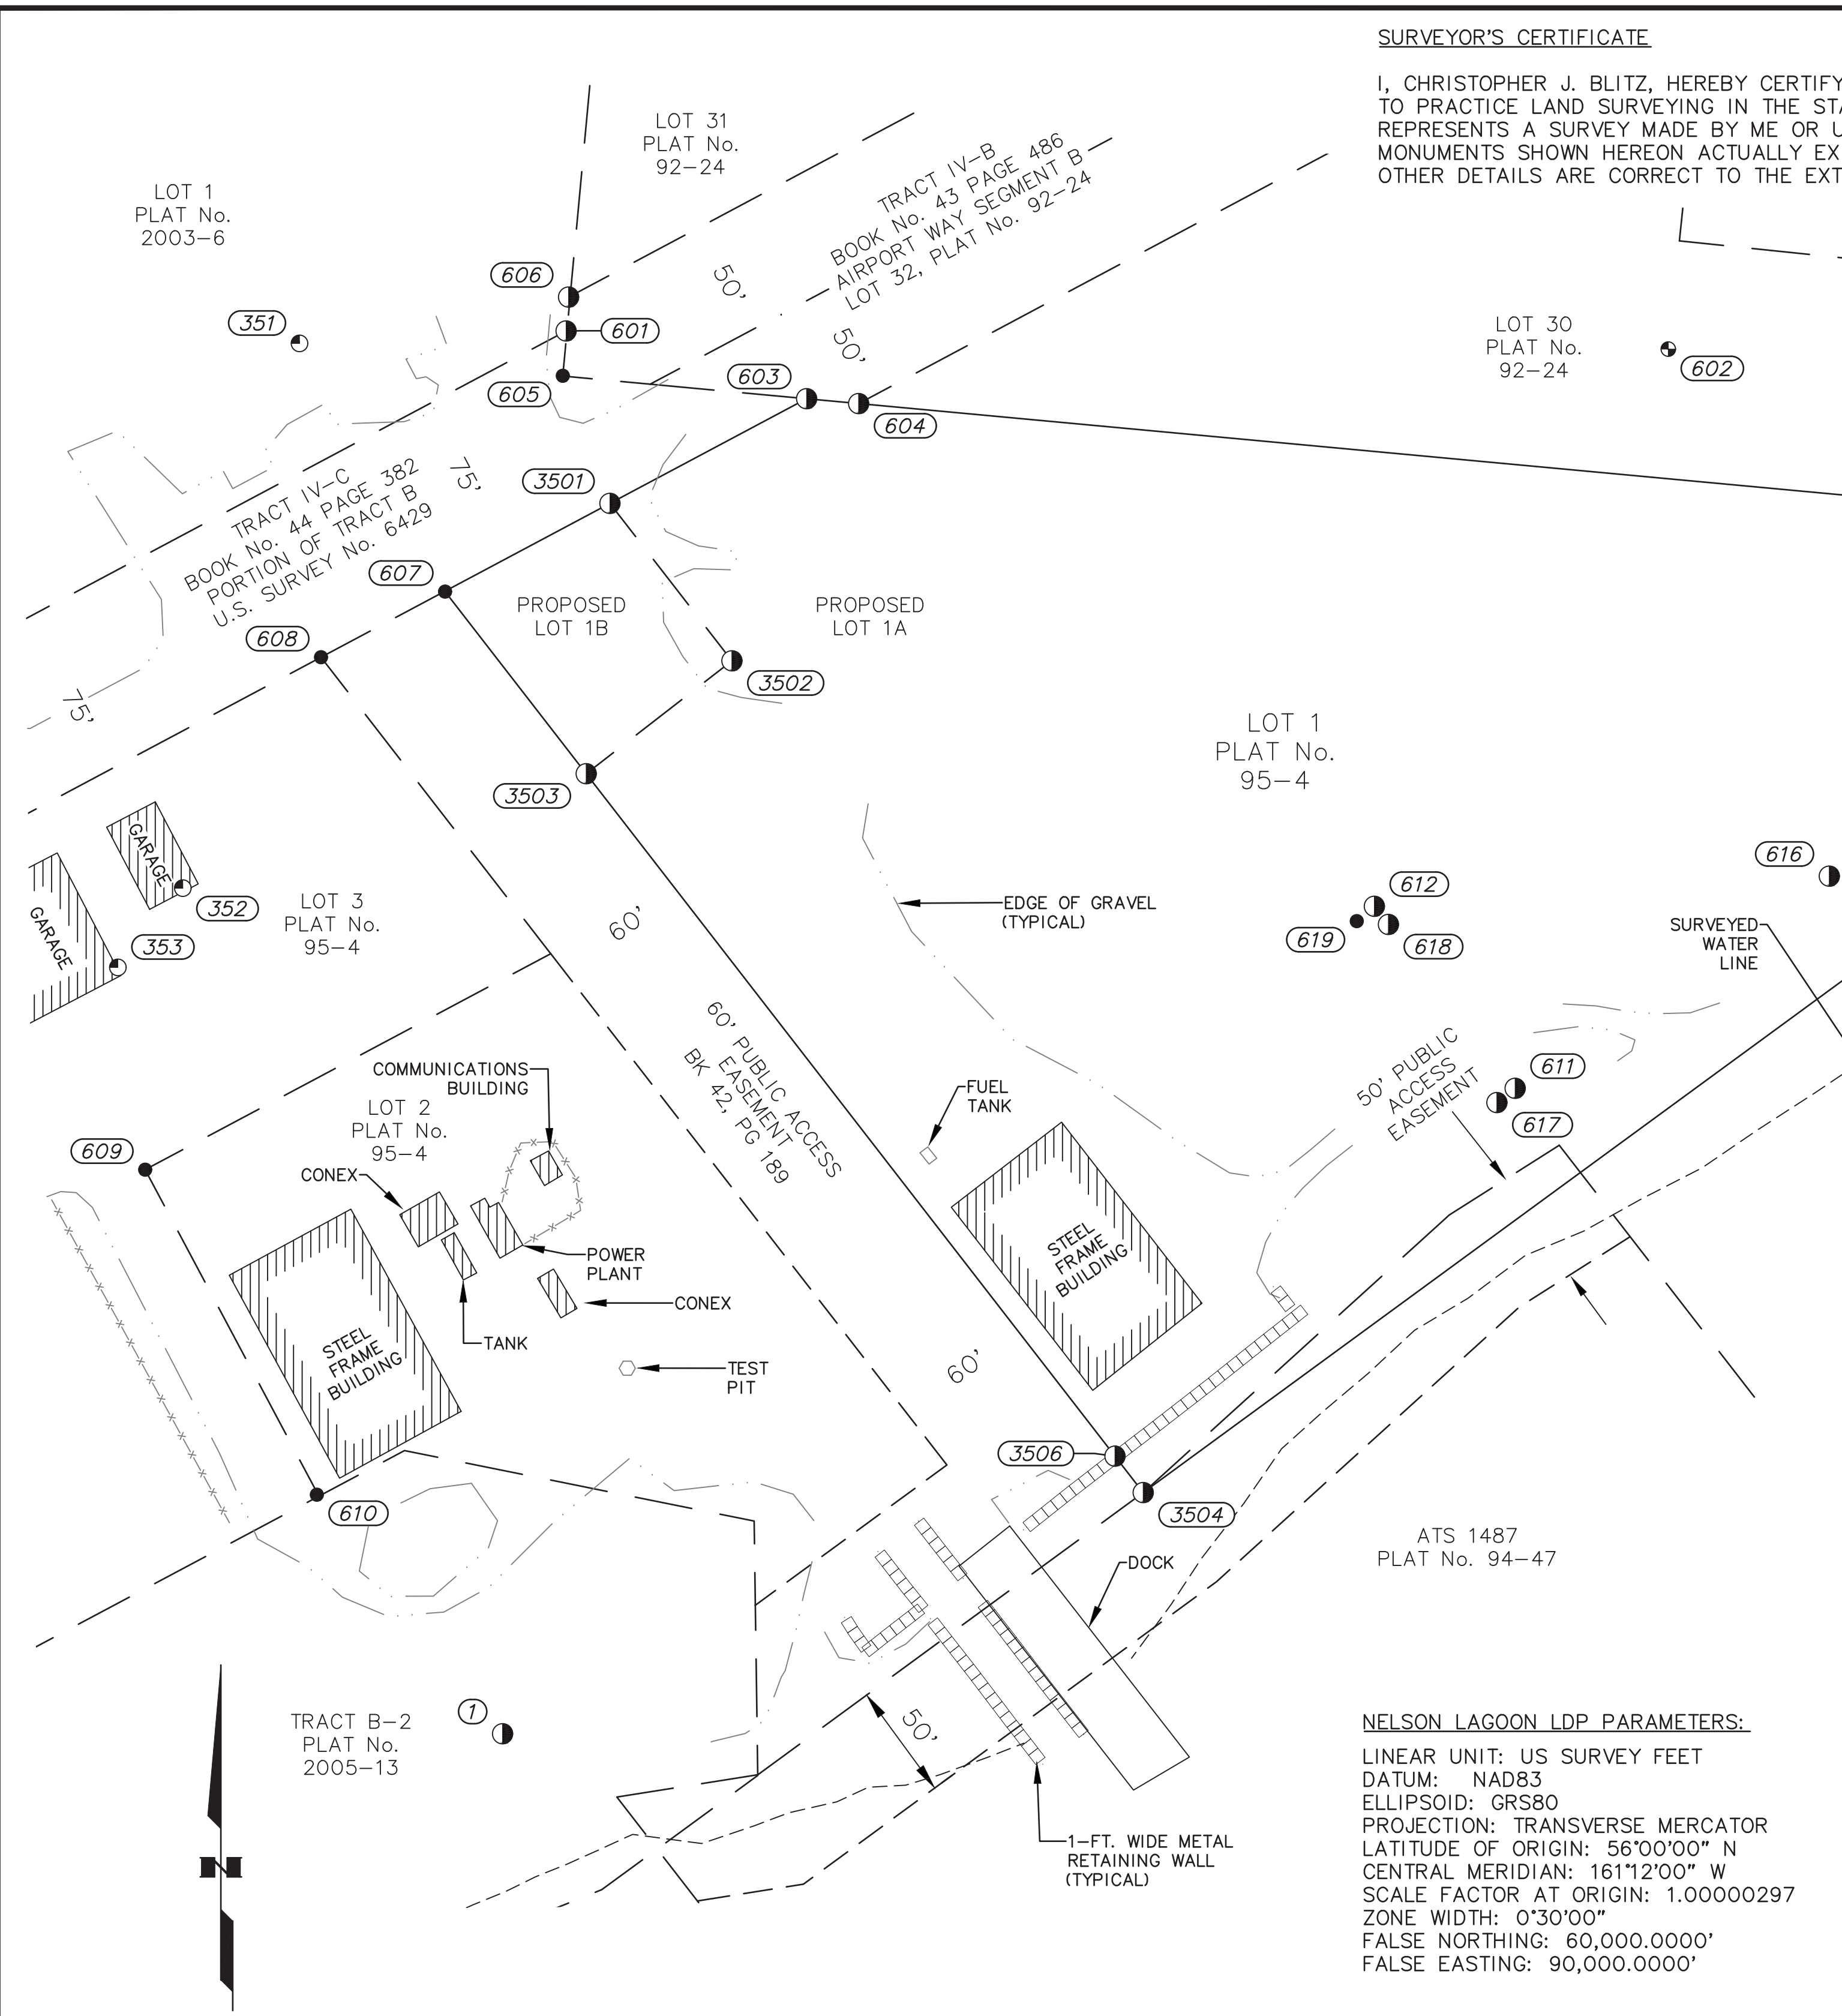

- LEGEND**
- ALUMINUM CAP
  - TEMPORARY BENCHMARK
  - REBAR OR PLASTIC CAP
  - (500) POINT NUMBER IDENTIFIER
  - \* NOT SHOWN
- BUILDING

File: J:\JobsData\23308.02 Nelson Lagoon Rpsu - Civil Design\00 Cadd 2019\01 Working Set\02 Survey\03 Survey Control\23308.02 Nelson Lagoon - SCS.dwg PLOT DATE: 5/18/2023 10:22 AM




PROJECT NO.	CITY GRID	WATER GRID	SEWER GRID

NELSON LAGOON RPSU  
**SURVEY CONTROL SHEET**  
 SURVEY CONTROL SHEET  
 STATUS: FINAL SUBMITTAL  
 DATE: 5/30/23

SCALE	HOR. NTS	VER. NTS	DESIGNED BY	DRAWN BY	CHECKED BY	APPROVED BY	REVISION	
							REV	DESCRIPTION

SHEET NO. **G2**

File: J:\JobsData\72308.02 Nelson Lagoon Rpsu - Civil Design\00 Cadd 2019\01 Working Set\01 Civil\72308.02 Site Plan.dwg PLOT DATE: 5/18/2023 10:23 AM

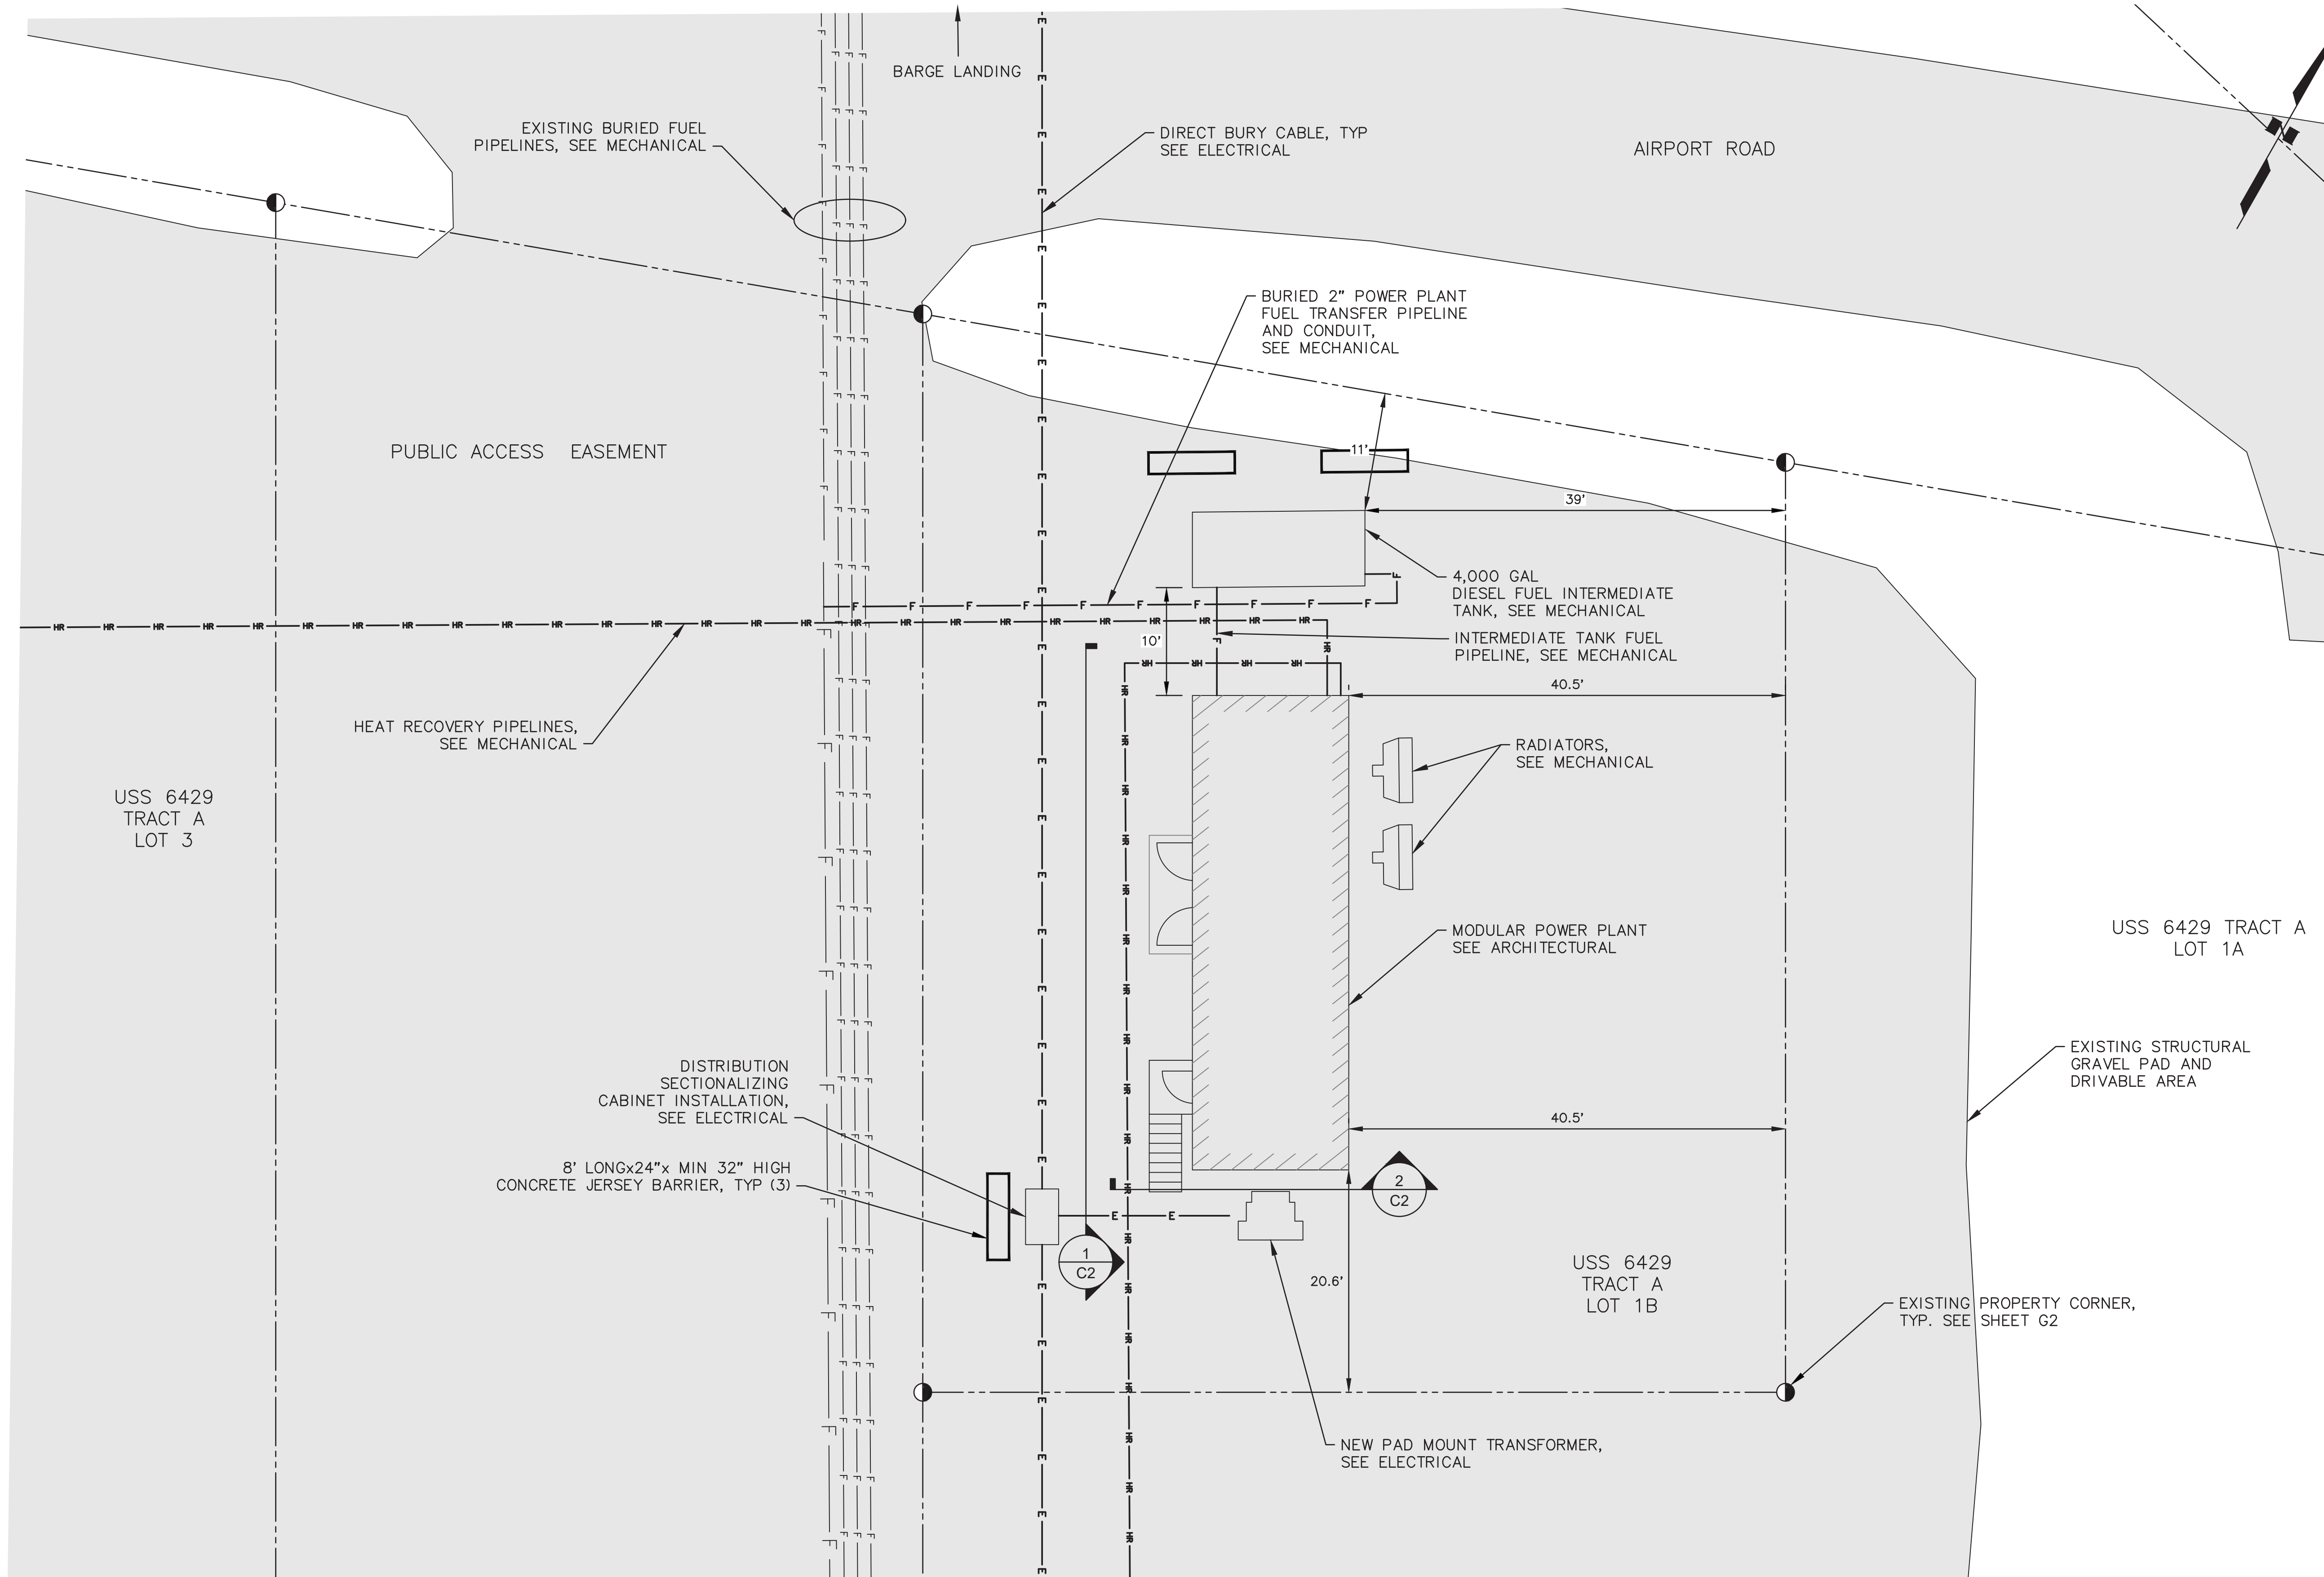

**NOTES:**

1. LOCATION OF UTILITIES AND EQUIPMENT MAY VARY.
2. SEE SHEETS M1.5 AND A1 FOR CODE ANALYSIS.

1

**SITE PLAN**

ALL WORK ON THIS SHEET IS INCLUDED IN THE ON SITE CONTRACT.



PROJECT NO.	CITY GRID	WATER GRID	SEWER GRID

NELSON LAGOON RPSU  
**SITE PLAN**  
 SITE PLAN

DATE: 5/30/23

STATUS: FINAL SUBMITTAL



REV	DATE	DESCRIPTION	BY

SCALE	HOR. NTS	VER. NTS	DESIGNED BY	DRAWN BY	CHECKED BY	APPROVED BY

SHEET NO.

**C1**

NOTE:  
 THE EXISTING SITE IS ESSENTIALLY FLAT.  
 AFTER EXCAVATION AND BACKFILL FOR  
 FOOTINGS AND UTILITIES, COMPACT AND  
 RE-GRADE SITE TO BLEND INTO  
 SURROUNDING SURFACE ALL AROUND.

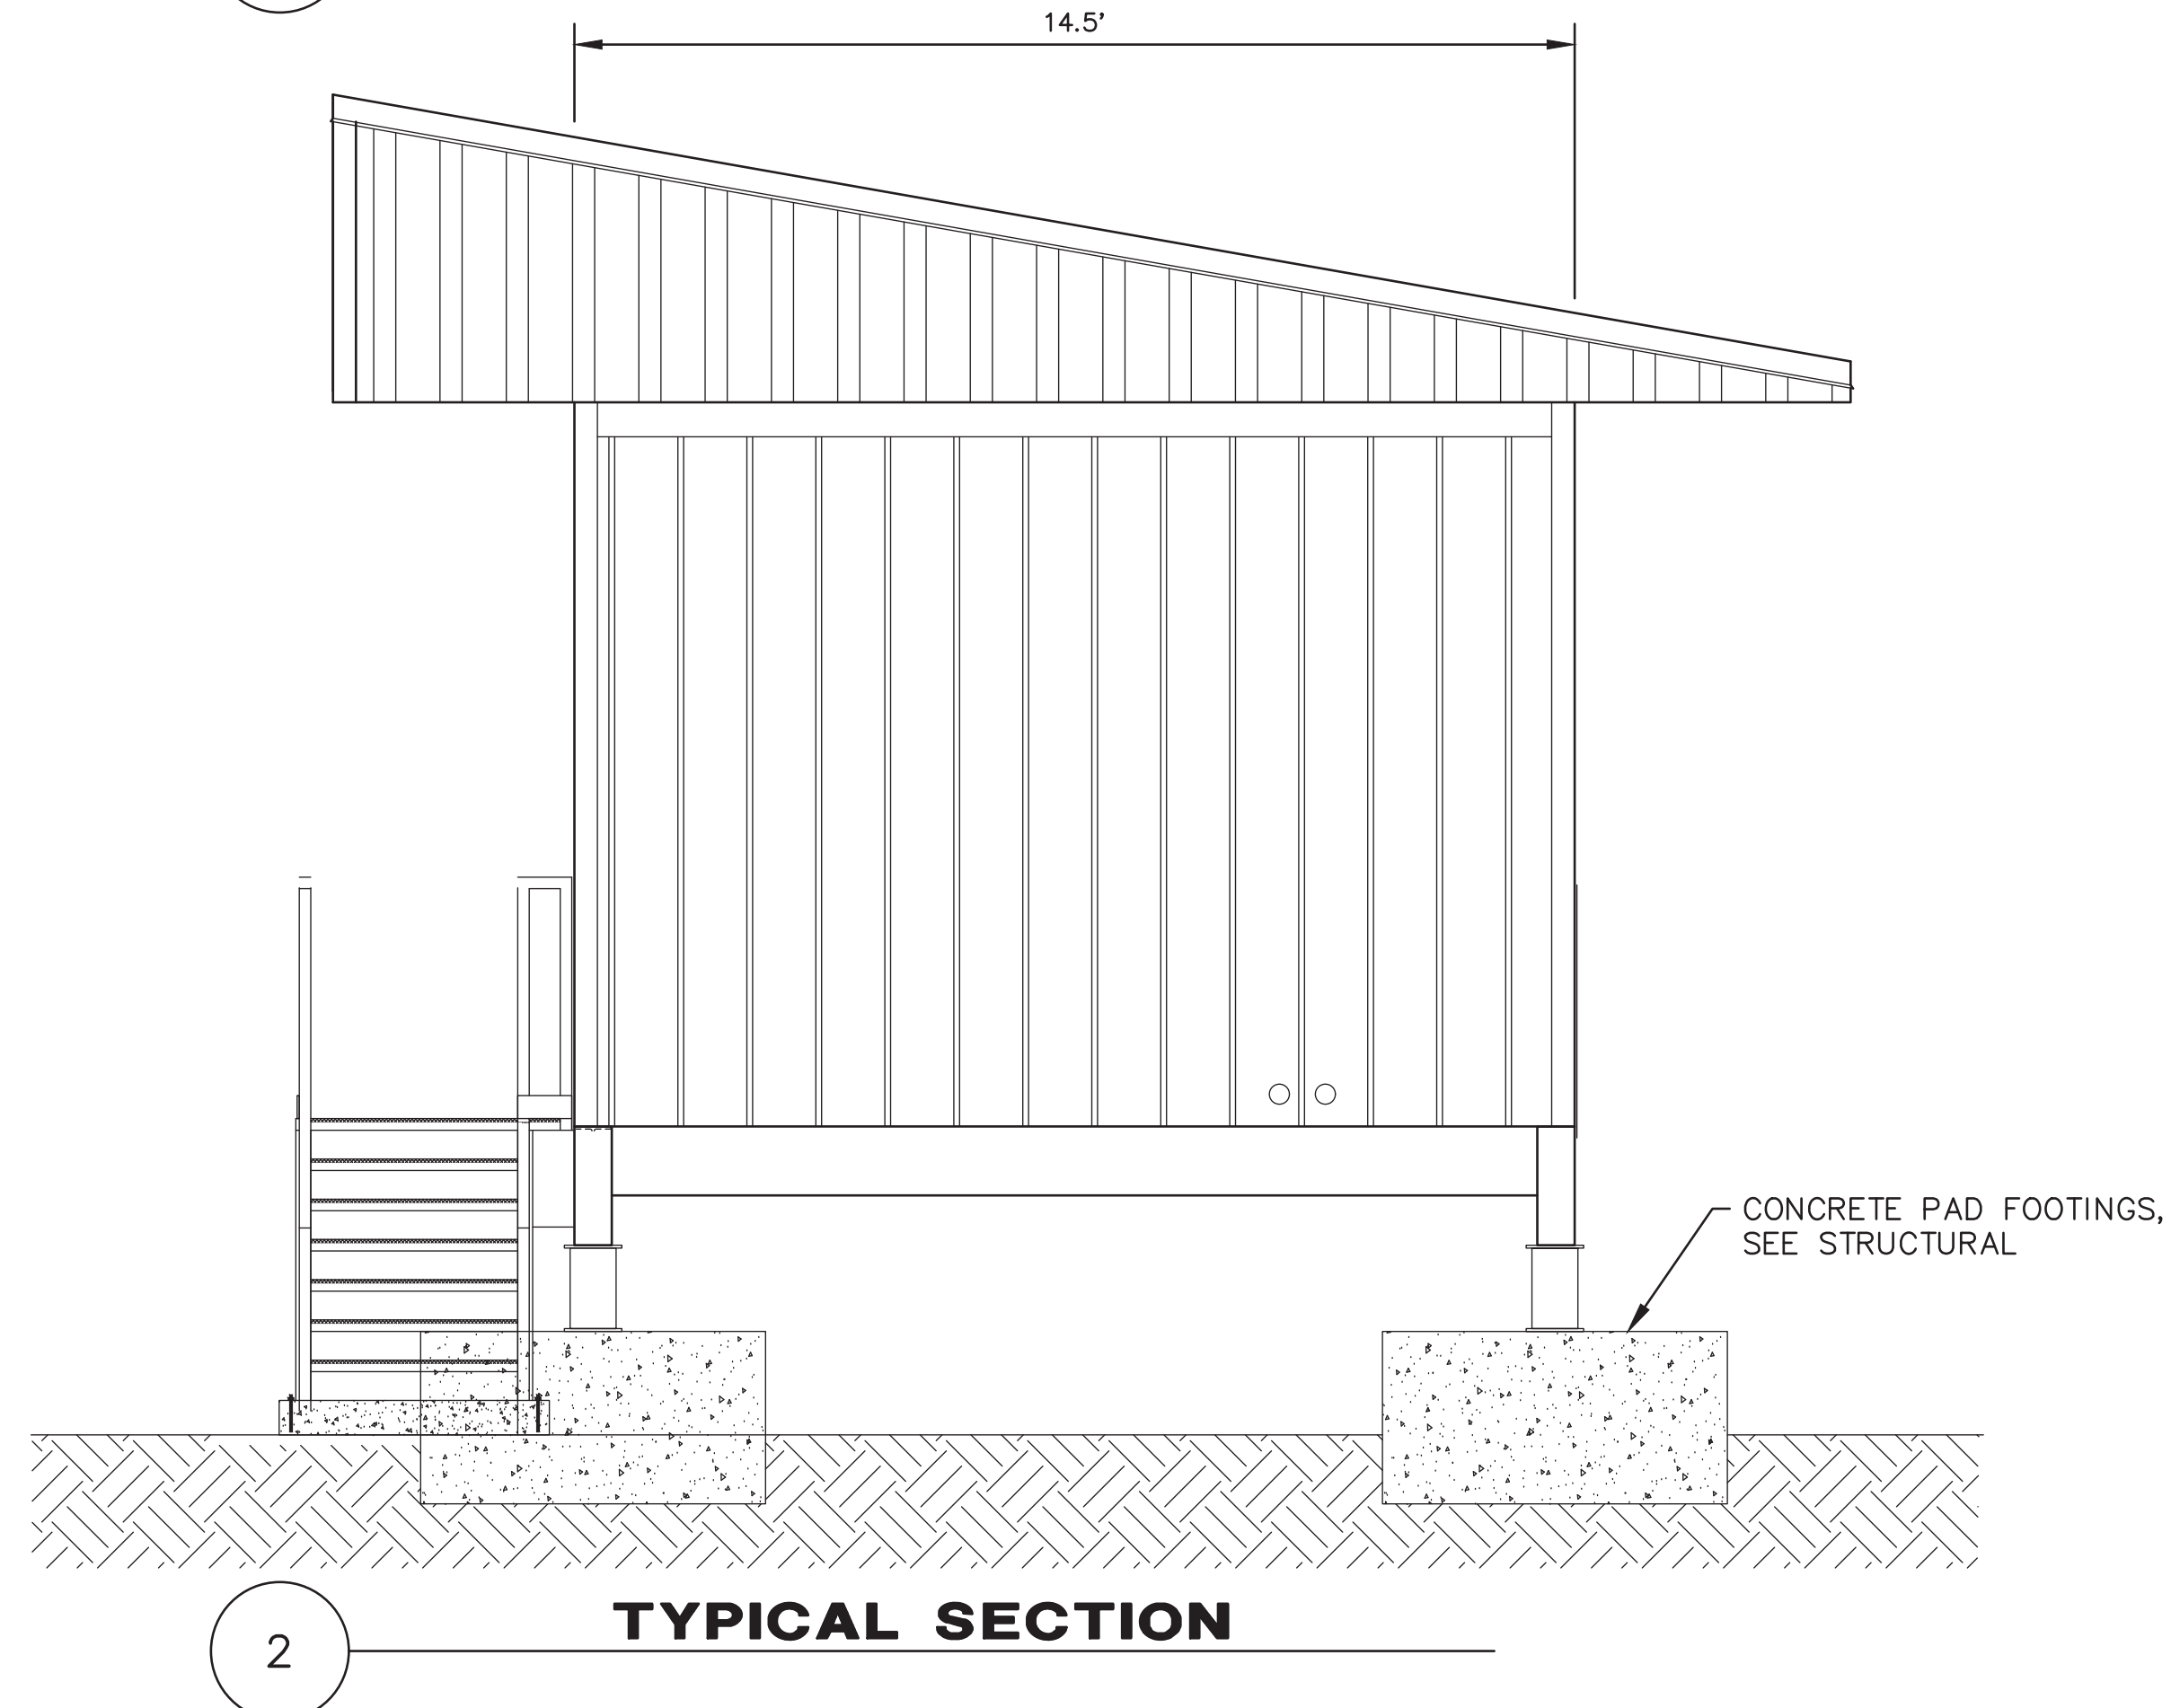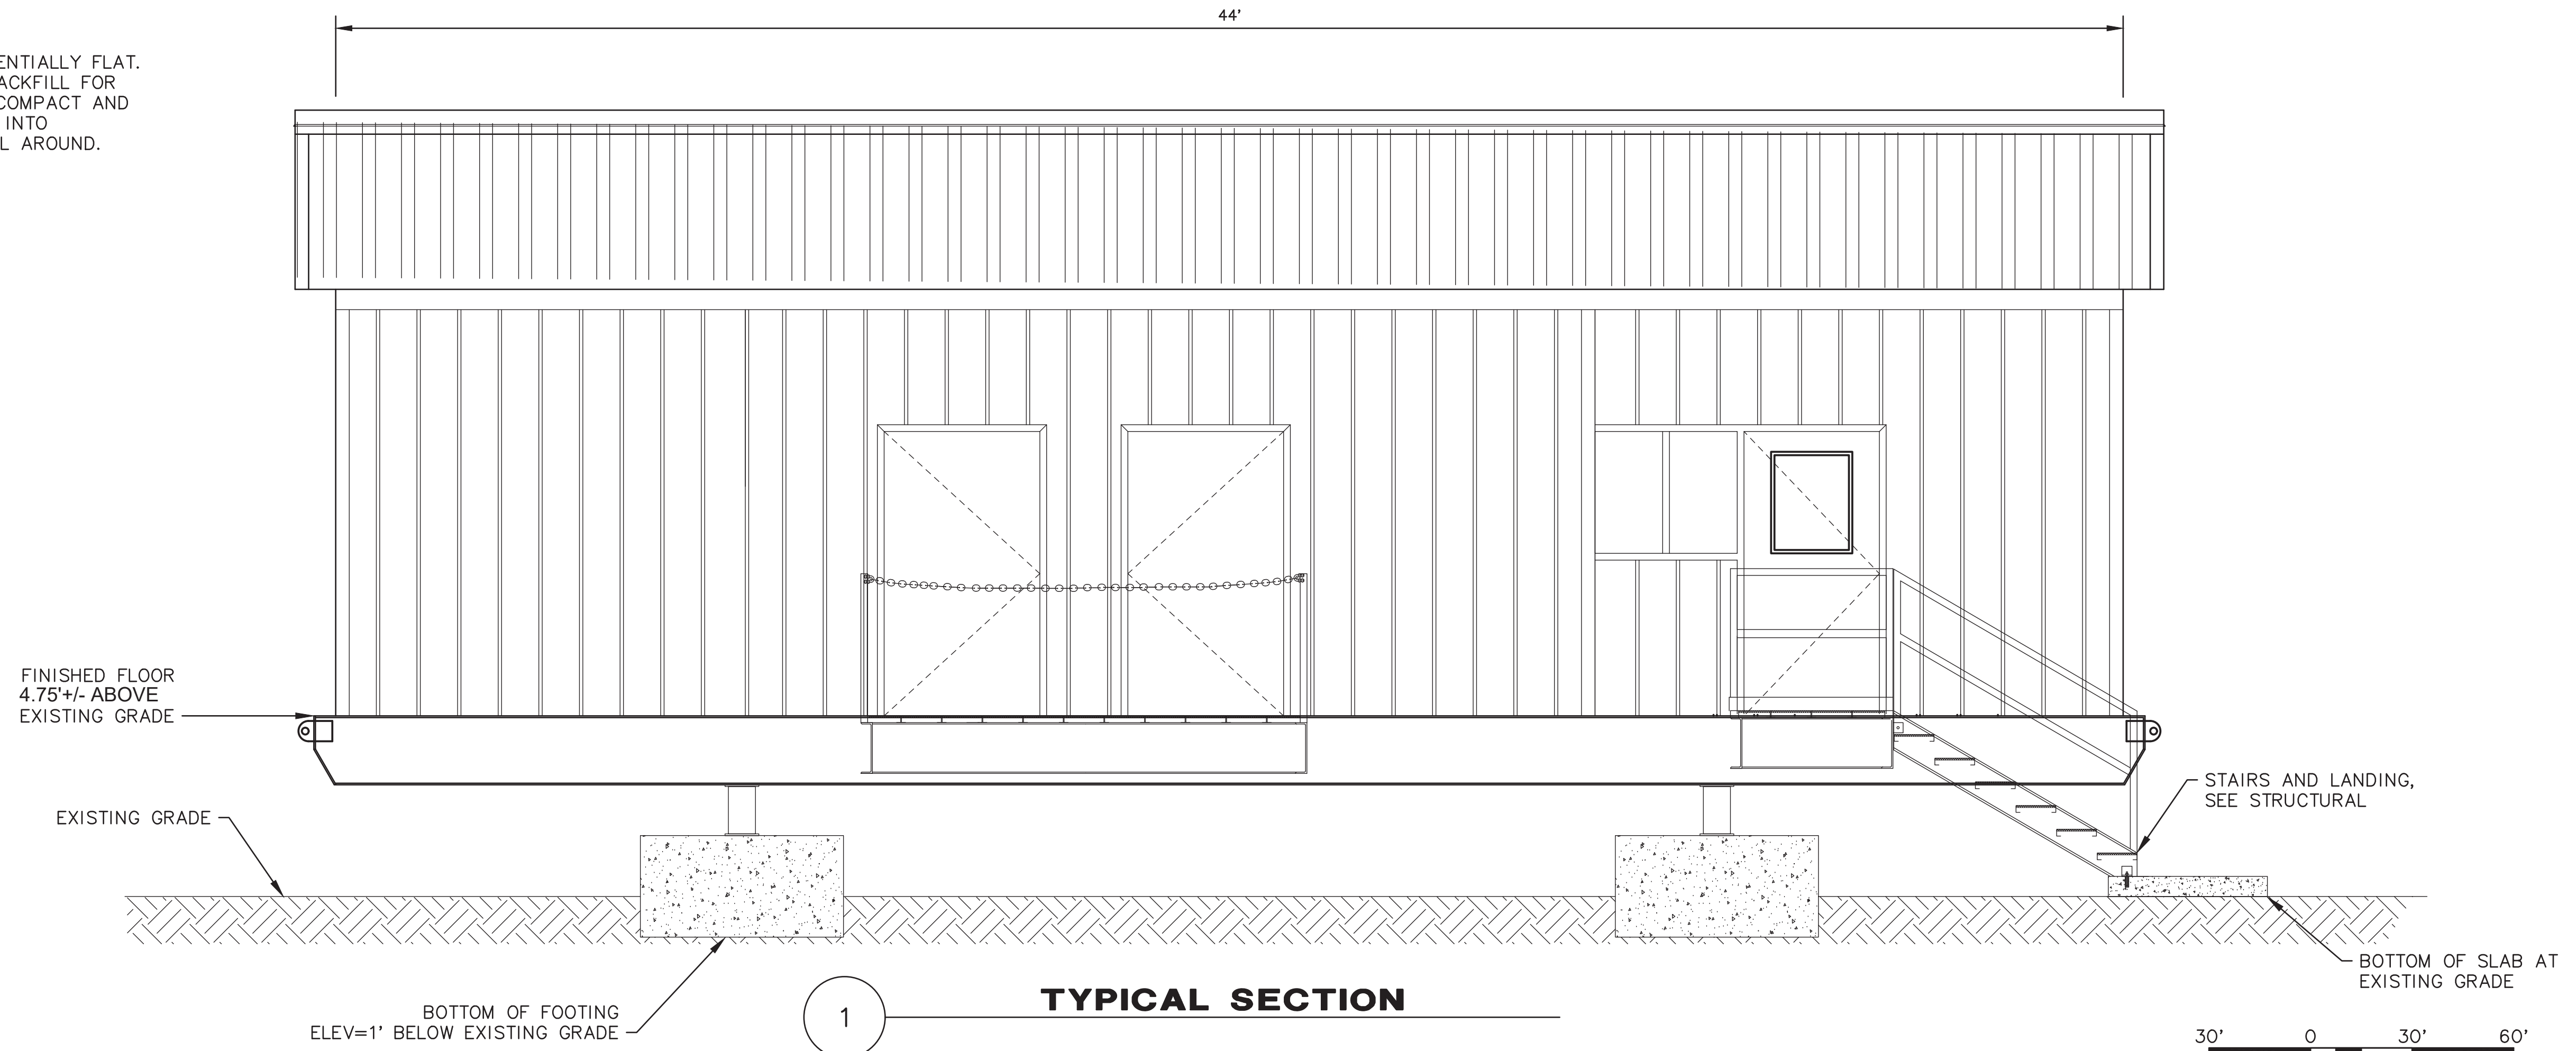

PROJECT NO.	CITY GRID	WATER GRID	SEWER GRID

NELSON LAGOON RPSU  
**TYPICAL SECTIONS**  
 TYPICAL SECTIONS

STATUS: FINAL SUBMITTAL

DATE: 5/30/23

REV	DATE	DESCRIPTION	BY


SCALE	HOR. NTS	VER. NTS	DESIGNED BY	DRAWN BY	CHECKED BY	APPROVED BY

SHEET NO.


**G2**

ALL WORK ON THIS SHEET IS INCLUDED IN THE ON SITE CONTRACT.

File: J:\JobsData\72308.02 Nelson Lagoon Rpsu - Civil Design\00 Cadd 2019\01 Working Set\01 Civil\72308.02 Sections.dwg PLOT DATE: 5/18/2023 10:23 AM

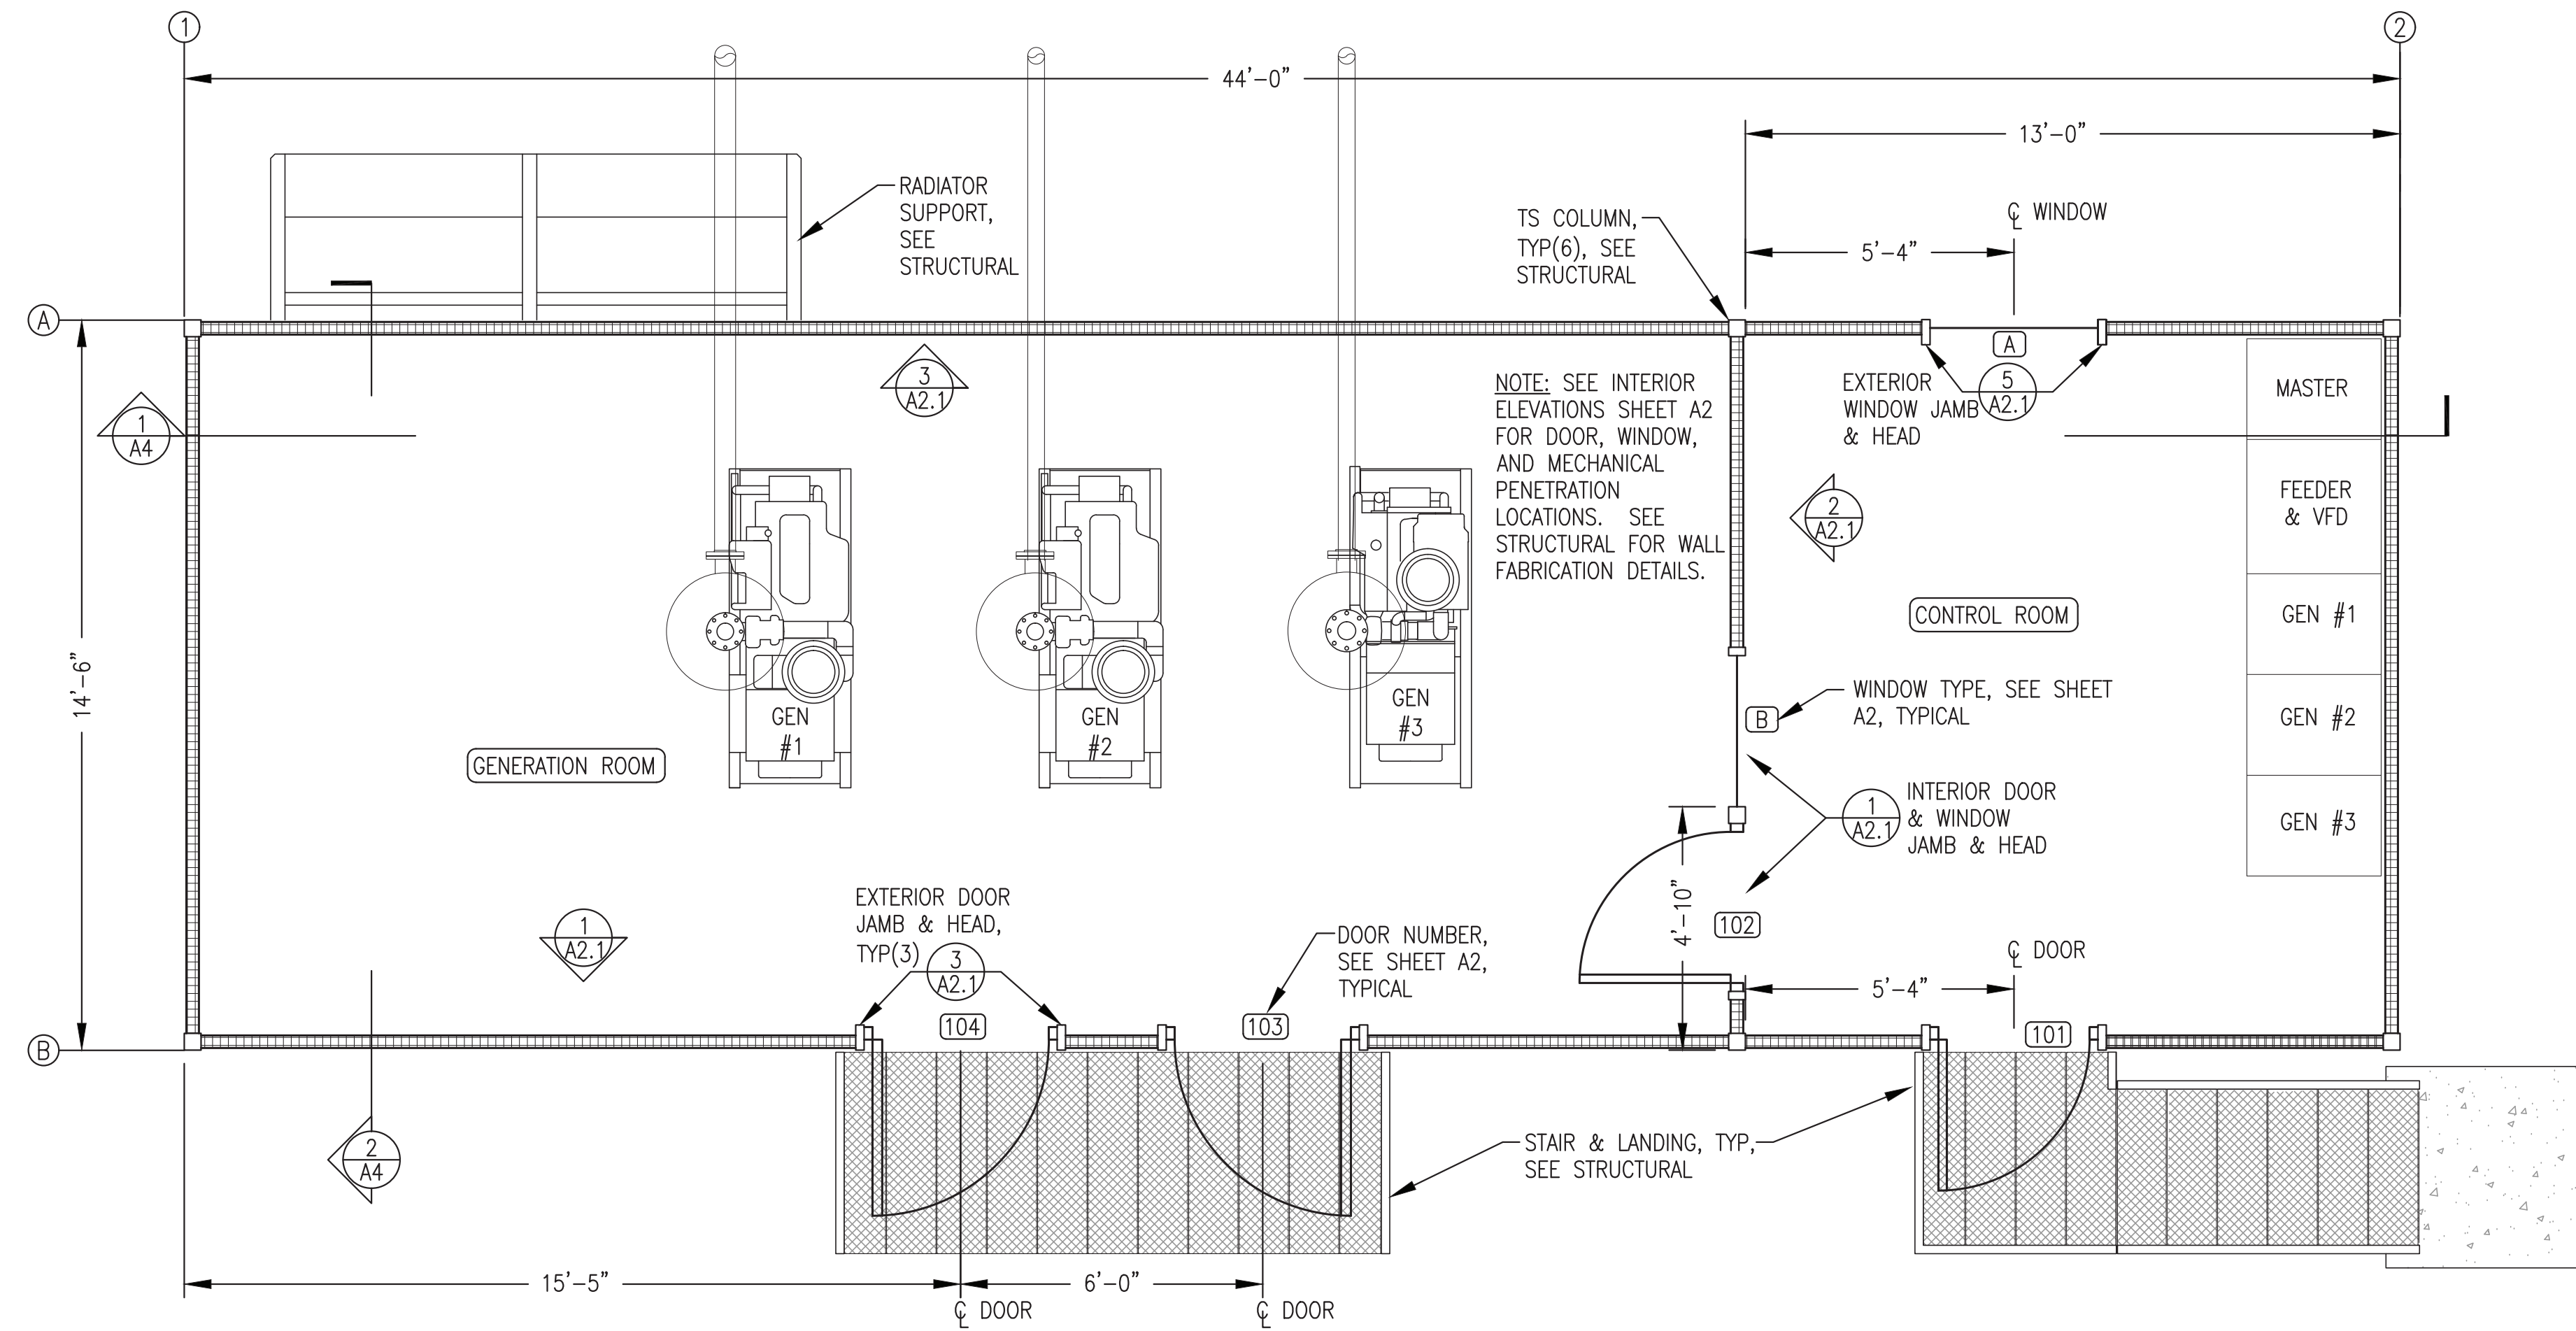

1 FLOOR PLAN  
A1 3/8"=1'-0"

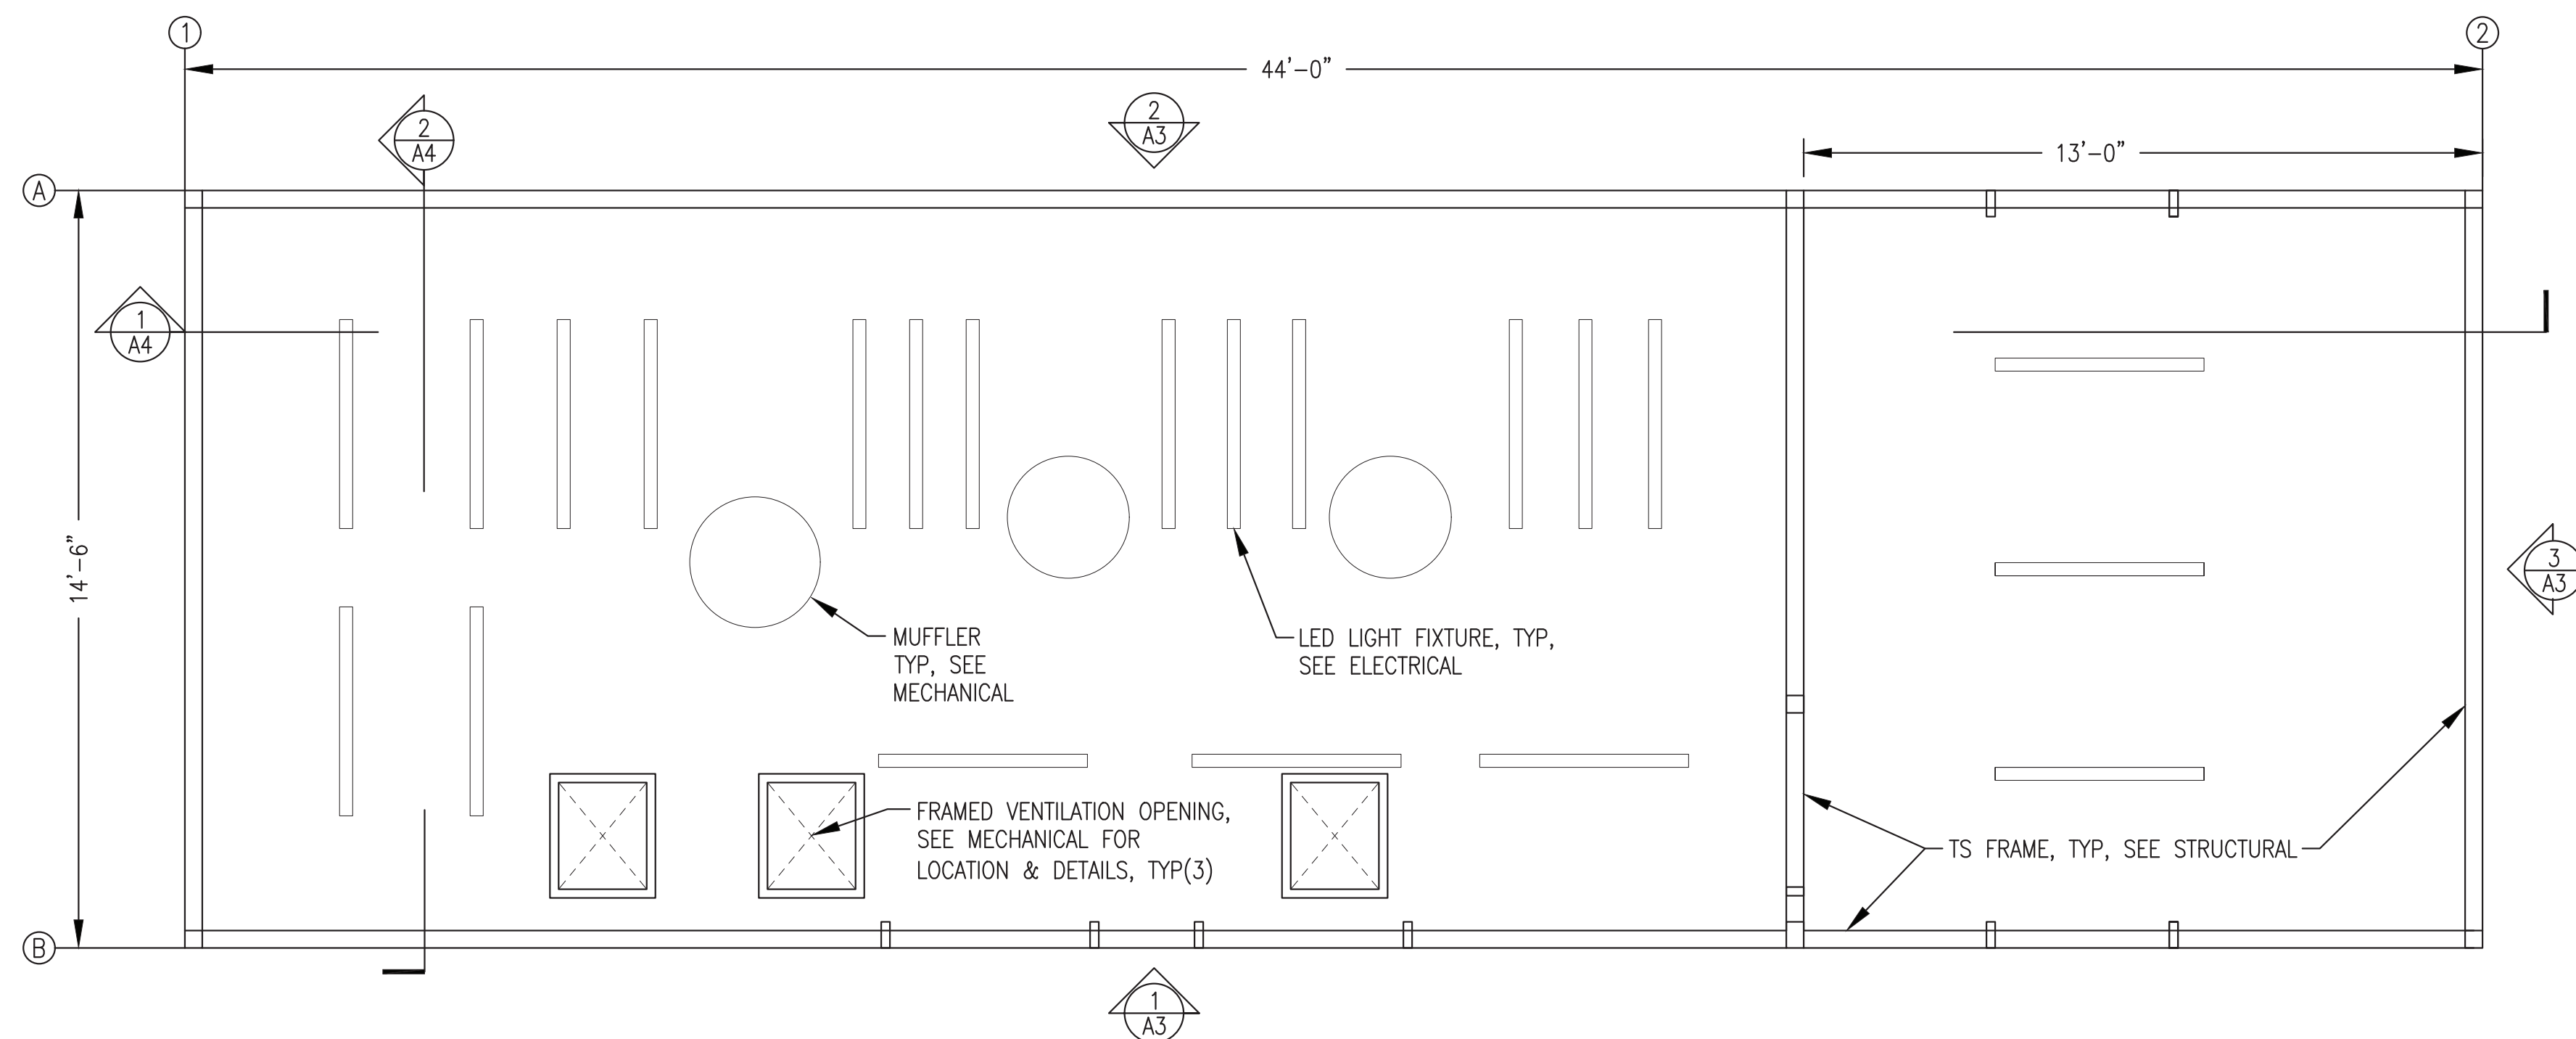

2 REFLECTED CEILING PLAN  
A1 3/8"=1'-0"


CODE ANALYSIS – 2021 EDITION INTERNATIONAL BUILDING CODE	
OCCUPANCY CLASSIFICATION	REF: IBC-2021, SEC. 306.2
GROUP F-1: FACTORY INDUSTRIAL MODERATE HAZARD – ELECTRIC GENERATION PLANT	
TYPE OF CONSTRUCTION	REF: IBC-2021, TABLE 601
TYPE V-B (NON-RATED)	REF: IBC-2021, SEC. 602.5
BUILDING HEIGHTS AND AREAS	REF: IBC-2021, TABLES 504.3, 504.4, & 506.2
MAX ALLOWED = 40'-0" 1 STORY 8,500 S.F.	ACTUAL = 16'-0" 1 STORY 640 S.F.
FIRE RESISTANCE RATING REQUIREMENTS FOR BUILDING ELEMENTS	REF: IBC-2021, TABLE 601
STRUCTURAL FRAME: 0 HR BEARING WALLS: 0 HR INTERIOR PARTITIONS: 0 HR FLOOR: 0 HR ROOF: 0 HR	
FIRE RESISTANCE RATING REQUIREMENTS FOR EXTERIOR WALLS	REF: IBC-2021, SEC. 705.5
EXTERIOR WALLS 10' < X < 30' 0 HR	
FIRE PROTECTION SYSTEM	REF: IBC-2021, SEC. 903.2.4
FIRE PROTECTION NOT REQUIRED. WATER MIST FIRE SUPPRESSION SYSTEM PROVIDED (SEE MECHANICAL).	
OCCUPANT LOAD	REF: IBC-2021, TABLE 1004.5
MECHANICAL/STORAGE = 300 S.F./PERSON 610 S.F./300 S.F. PER OCCUPANT = 2 OCCUPANTS	
MEANS OF EGRESS – TRAVEL DISTANCE	REF: IBC-2021, TABLE 1017.2
MAX ALLOWED = 200'	ACTUAL = 40'
COMBUSTIBLE LIQUIDS STORAGE	REF: IBC-2021, TABLE 307.1(1)(i)
MAX ALLOWED = 660 GAL CLASS II LIQUIDS ACTUAL = 200 GAL CLASS II (DIESEL FUEL DAY TANK)	
MAX ALLOWED = 13200 GAL CLASS III LIQUIDS ACTUAL = 110 GAL CLASS III (GLYCOL & LUBE OIL)	
STATIONARY STORAGE BATTERY SYSTEMS	REF: IBC-2021, TABLE 1207.1.1
MAX EXEMPT = 50 GAL (FLOODED LEAD ACID) ACTUAL = 6 GAL (6 BATTERIES AT 1 GAL MAX EACH)	
<b>ARCHITECTURAL GENERAL NOTES:</b>	
1) SEE CIVIL SITE PLAN FOR LOCATION AND LAYOUT. PROVIDE SEPARATION TO PROPERTY BOUNDARIES IN ACCORDANCE WITH CODE ANALYSIS.	
2) PROVIDE A COMPLETE AND OPERATIONAL FACILITY. ALL WORK TO BE IN ACCORDANCE WITH CURRENT APPROVED EDITIONS OF THE IBC, IMC, IFC, AND NEC INCLUDING STATE OF ALASKA AMENDMENTS.	
3) SEE SHEET A2 FOR DOOR AND WINDOW DETAILS AND SCHEDULE. SEE SHEETS A3 AND A4 FOR DESCRIPTION OF FIELD INSTALLED ROOF SYSTEM.	
4) INSULATE ALL WALLS, FLOORS, AND CEILINGS WITH HIGH TEMPERATURE MINERAL FIBER ACOUSTICAL FIRE BATT INSULATION, MIN R VALUE 4 PER INCH, MIN 2000F MELTING TEMP. ROXUL AFB OR EQUAL. FILL ALL PANEL VOIDS OR PROVIDE THICKNESS AS INDICATED ON DRAWINGS. MECHANICALLY FASTEN FLOOR INSULATION TIGHT TO FLOOR.	
5) UPON COMPLETION OF FABRICATION ROUND ALL CORNERS AND GRIND EDGES SMOOTH AND PAINT ALL INTERIOR AND EXTERIOR EXPOSED STEEL. PERFORM ALL PAINTING IN A WARM DRY ENVIRONMENT IN ACCORDANCE WITH MANUFACTURER'S INSTRUCTIONS INCLUDING DRYING TIME TO RE-COAT.	
6) SANDBLAST EXTERIOR SURFACE TO SSPC-SP-10. PRIME WITH ONE COAT OF REINFORCED INORGANIC ZINC PRIMER, DEVCO CATHA-COAT 302 OR APPROVED EQUAL, COLOR GREEN, TO 3 MILS DRY FILM THICKNESS. COVER WITH TWO COATS OF EPOXY, DEVCO BAR-RUST 236 OR APPROVED EQUAL, TO 10 MILS DRY FILM THICKNESS. FIRST COAT COLOR WHITE, SECOND COAT COLOR GRAY.	
7) FINISH EXTERIOR WALLS AND SKIDS (ALL EXPOSED VERTICAL EXTERIOR SURFACES) WITH ONE COAT OF ALIPHATIC URETHANE ENAMEL, DEVCO DEVTHANE 389 OR APPROVED EQUAL, COLOR WHITE, TO 3 MILS DRY FILM THICKNESS. NOTE: TOTAL EXTERIOR COATING BUILD 16 MILS MINIMUM DRY FILM THICKNESS.	
8) SANDBLAST INTERIOR SURFACE TO SSPC-SP-6. PRIME AND FINISH WITH TWO COATS OF EPOXY, PPG AMERLOC 2 VOC OR APPROVED EQUAL, TO 8 MILS TOTAL DRY FILM THICKNESS. CEILING COLOR WHITE. WALL AND FLOOR COLOR ANSI 61 GRAY. NOTE THAT FIRST COAT ON WALLS AND FLOOR MAY BE WHITE.	
9) SANDBLAST ALL EXTERIOR PLATFORMS AND FABRICATIONS AND APPLY 3 COATS OF COLD GALVANIZING COMPOUND, ZRC OR EQUAL, TO 9 MILS MINIMUM DRY FILM THICKNESS. SEE STRUCTURAL.	

ALL WORK ON THIS SHEET WAS PERFORMED AS PART OF THE PRIOR MODULE ASSEMBLY CONTRACT EXCEPT FOR FIELD INSTALLATION OF PREVIOUSLY FABRICATED STAIRS AND SUPPORTS AS INDICATED ON STRUCTURAL.


ISSUED FOR CONSTRUCTION  
MARCH 2023




 ALASKA ENERGY AUTHORITY	
PROJECT: NELSON LAGOON POWER SYSTEM UPGRADE	
TITLE: FLOOR PLAN, REFLECTED CEILING PLAN, CODE ANALYSIS, & GENERAL NOTES	
DRAWN BY: JTD	SCALE: AS NOTED
DESIGNED BY: DGT/BCG	DATE: 3/2/23
FILE NAME: NELS PP A1-A4	SHEET: A1
PROJECT NUMBER:	
P.O. 111405, Anchorage, AK 99511 (907)349-0100	

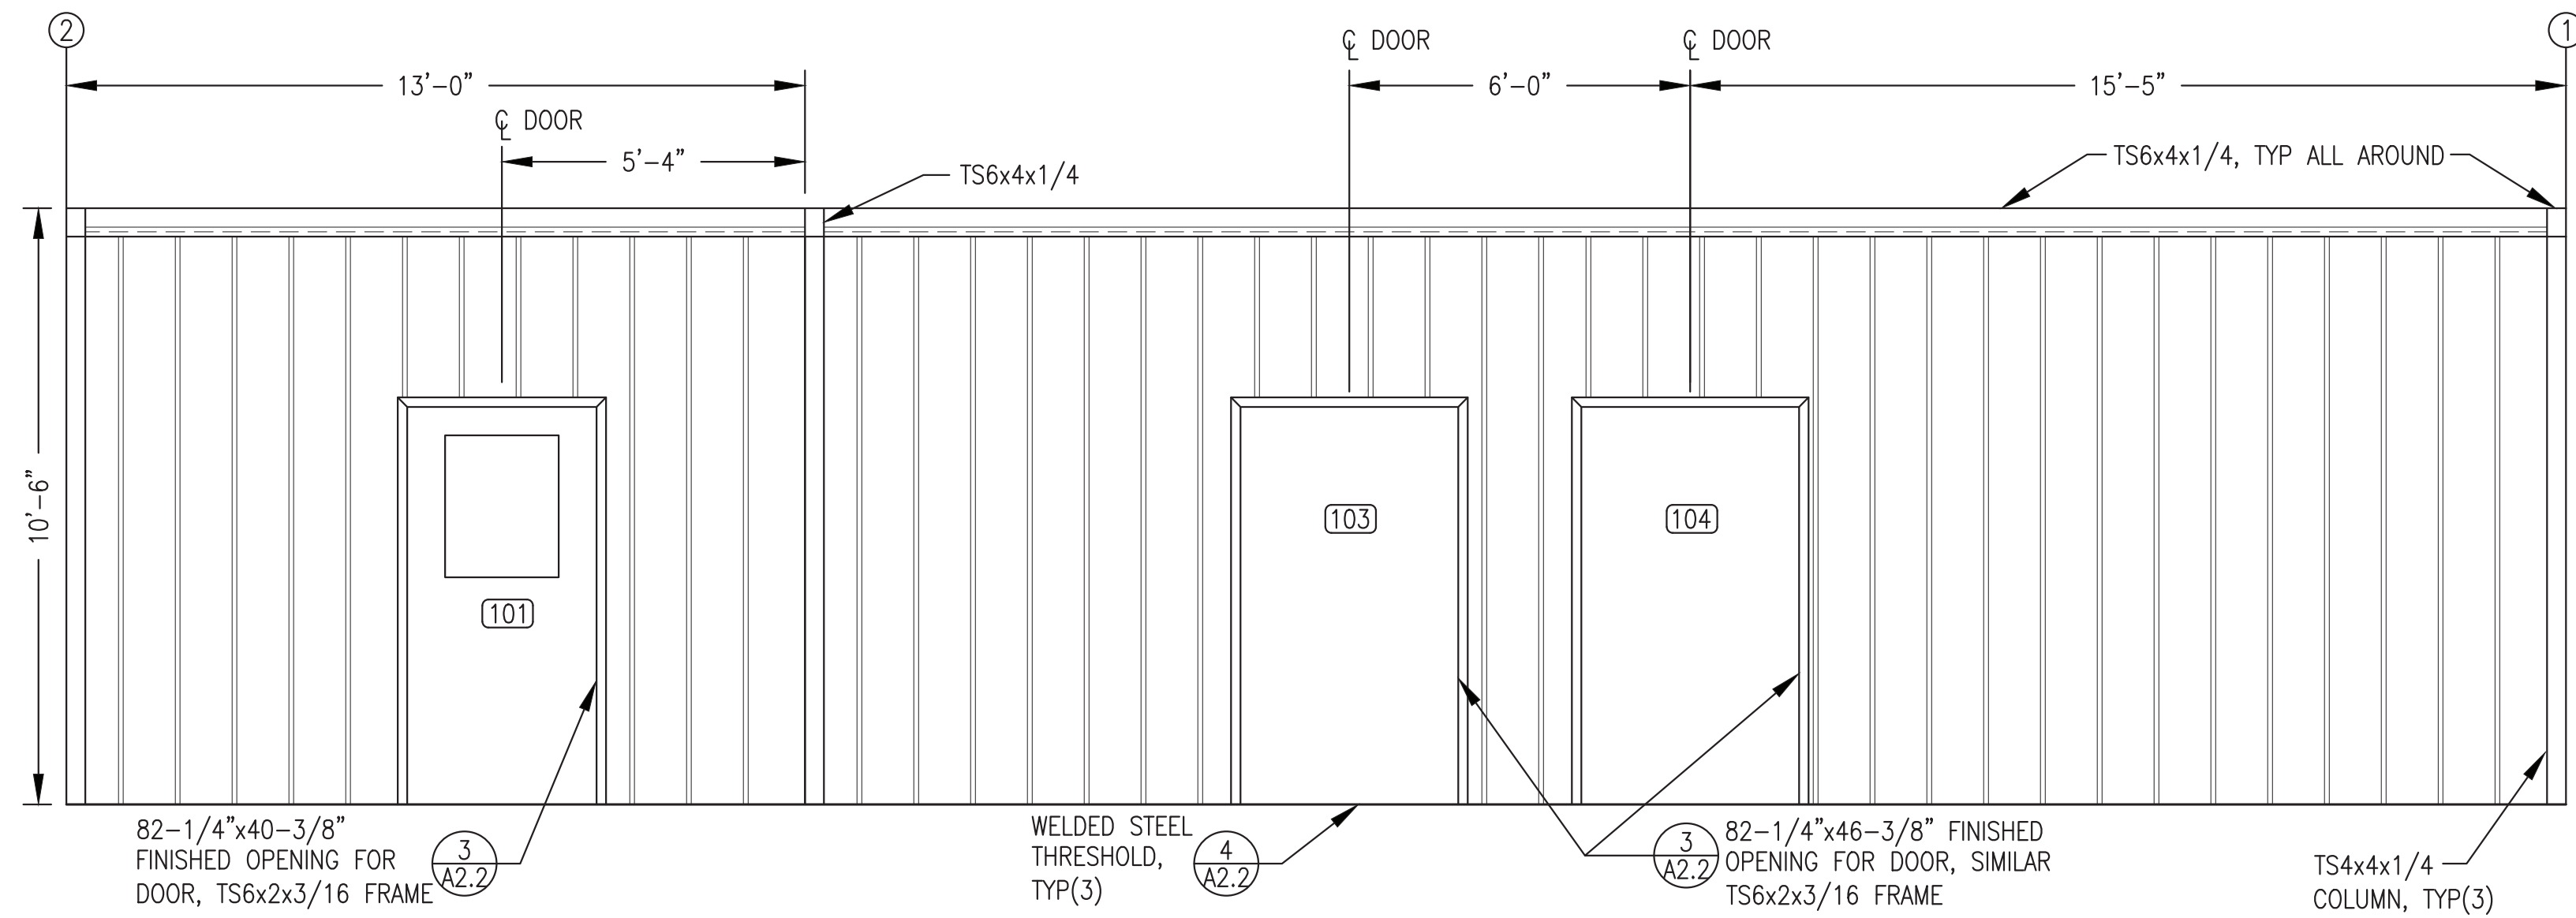

**1**  
A2.1 FRONT WALL INTERIOR ELEVATION  
3/8"=1'-0"

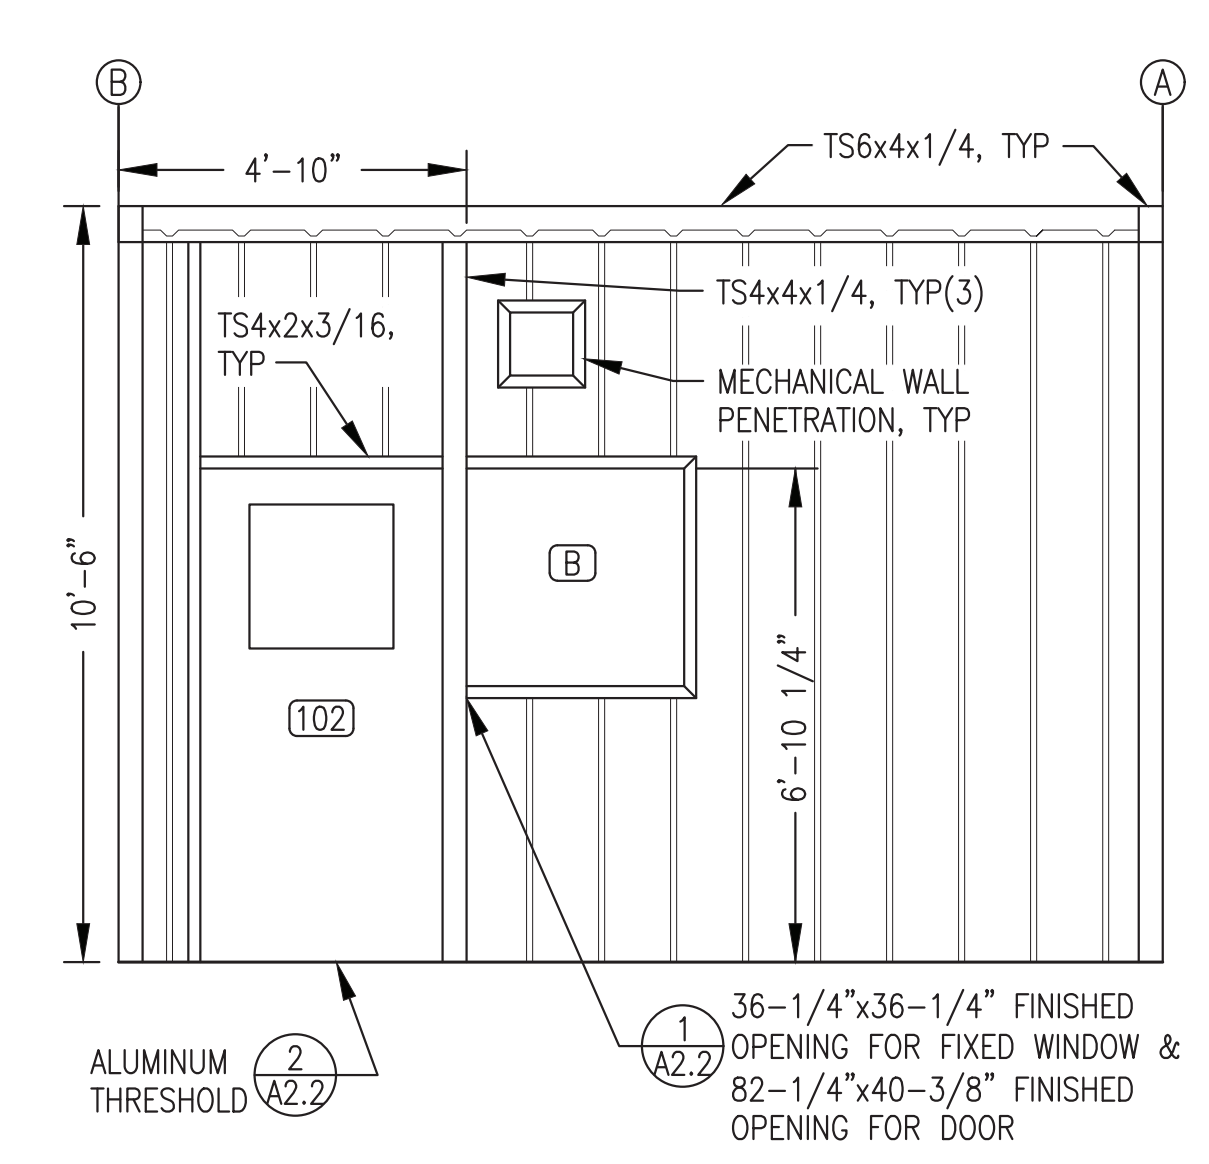

**2**  
A2.1 CONTROL ROOM WALL INTERIOR ELEVATION  
3/8"=1'-0"

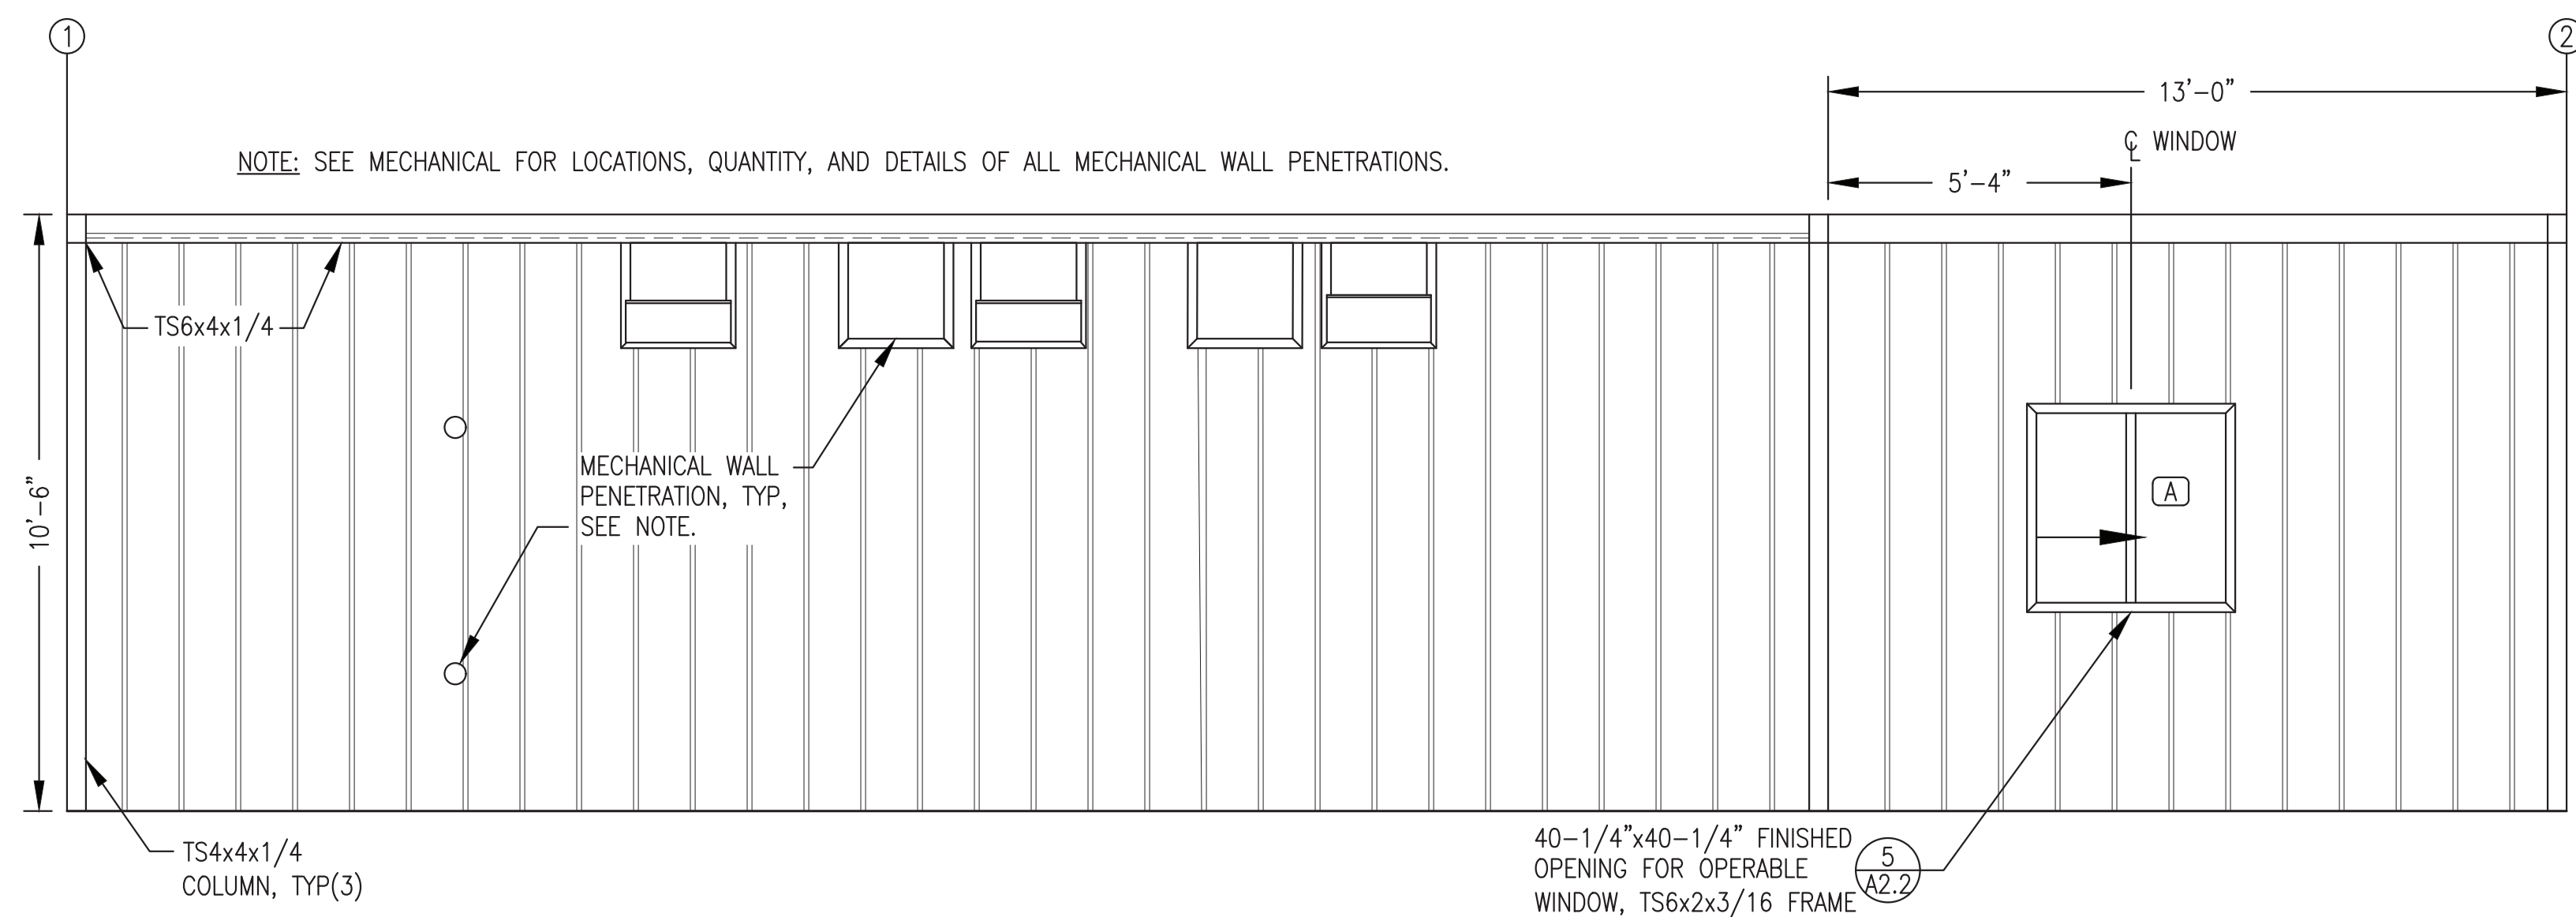

**3**  
A2.1 PARTIAL BACK WALL INTERIOR ELEVATION  
3/8"=1'-0"




- FRAMED OPENING NOTES:**
- 1) SEE MECHANICAL FOR SIZE, LOCATIONS, QUANTITY, AND DETAILS OF ALL MECHANICAL WALL PENETRATIONS.
  - 2) FABRICATE DOOR AND WINDOW FRAMED OPENINGS TO FINISHED INSIDE (CLEAR) DIMENSIONS INDICATED AND LOCATE TO INSIDE EDGE OR CENTERLINE AS INDICATED.
  - 3) FABRICATE ALL FRAMED OPENINGS WITH MITERED CORNERS AND FULL PENETRATION GROOVE WELDS. GRIND OUT INSIDE OF MITERED CORNERS TO PROVIDE FULL CLEAR OPENING.


ALL WORK ON THIS SHEET WAS PERFORMED AS PART OF THE PRIOR MODULE ASSEMBLY CONTRACT AND IS SHOWN HERE FOR REFERENCE ONLY.

ISSUED FOR CONSTRUCTION  
MARCH 2023




ALASKA ENERGY AUTHORITY		
PROJECT: NELSON LAGOON POWER SYSTEM UPGRADE		
TITLE: INTERIOR ELEVATIONS		
DRAWN BY: JTD	SCALE: AS NOTED	
DESIGNED BY: DGT/BCG	DATE: 3/2/23	
FILE NAME: NELS_PP_A1-A4	SHEET:	A2.1
PROJECT NUMBER:		
P.O. 111405, Anchorage, AK 99511 (907)349-0100		

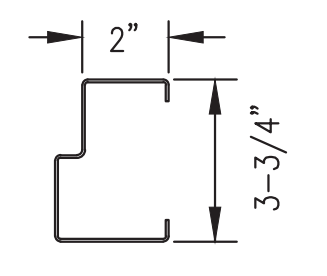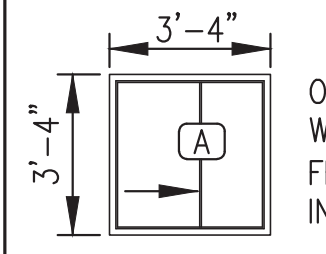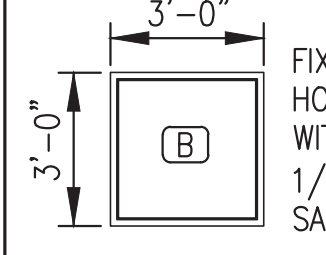DOOR CONSTRUCTION														
DOOR NO.	WIDTH	HEIGHT	THICK NESS	FIRE RATING	HARDWARE GROUP	WALL THICK.	FRAME PROFILE	FRAME PREP.	REMARKS					
101	3'-0"	6'-8"	1-3/4"	NONE	HW-1	N/A	3-3/4" SINGLE RABBETED	DIMPLE & PUNCH	24"x24" RE-LIGHT {4}					
102	3'-0"	6'-8"	1-3/4"	NONE	HW-2	N/A	3-3/4" SINGLE RABBETED	DIMPLE & PUNCH	24"x24" RE-LIGHT {4}					
103	3'-6"	6'-8"	1-3/4"	NONE	HW-3	N/A	3-3/4" SINGLE RABBETED	DIMPLE & PUNCH						
104	3'-6"	6'-8"	1-3/4"	NONE	HW-3	N/A	3-3/4" SINGLE RABBETED	DIMPLE & PUNCH						
DOOR HARDWARE:					DOOR FRAME PROFILE:									
<b>HW-1</b>					<b>NOTES:</b> {1} DOORS TO BE 16 GA. STEEL WITH SOLID POLYURETHANE INSULATION CORE AND WITH TOPS INVERTED AND CAULKED WATER TIGHT. {2} HOLLOW METAL FRAMES TO BE 16 GA. STEEL WELDED CONSTRUCTION, DIMPLED AND PUNCHED. {3} DOORS AND HOLLOW METAL FRAMES GALVANIZED AND FACTORY PRIMED. FIELD FINISH WITH TWO COATS OF PAINT IDENTICAL TO INTERIOR WALLS AND FLOORS AS SPECIFIED ON SHEET A1. {4} INSTALL INSULATED RE-LIGHT WITH TWO PANES OF 1/4" LAMINATED SAFETY GLASS WITH 1/2" AIR GAP, SIZE AS INDICATED. {5} MOUNT DOOR CLOSERS AND OVERHEAD STOPS TO VERTICAL INTERIOR FACES OF DOORS AND FRAMES SO THERE IS NO INTERFERENCE WITH WEATHER STRIP. {6} SET FRAMES PLUMB AND ADJUST POSITION AND HARDWARE SO DOORS OPERATE SMOOTH WITHOUT INTERFERENCE. {7} SET WEATHER STRIPS TIGHT TO DOORS TO MAKE WATER TIGHT SEAL TOP AND SIDE. SEAL CORNERS WITH POLYURETHANE CAULK. UPON COMPLETION, DOORS SHALL BE TESTED FOR WATER TIGHTNESS WITH 10 GPM HOSE STREAM AGAINST EXTERIOR EDGES.									
3 EA	HINGES	HAGER	BB1191	4.5 x 4.5NRP x 630										
1 EA	EXIT DEVICE	PRECISION	2108	x 4908AX3 x 630										
1 EA	CORE	BEST	BROWN CONSTRUCTION CORE							<b>WINDOW TYPES:</b> OPERABLE SLIDER WITH WHITE VINYL FRAME & 1" INSULATED GLAZING FIXED SINGLE RABBET HOLLOW METAL FRAME WITH 2 PANES OF 1/4" LAMINATED SAFETY GLASS NOTE: DIMENSIONS ARE OVERALL FRAME SIZE.				
1 EA	DOOR CLOSER	LCN	4040	x SCUSH x 689										
1 EA	W/SPRING STOP													
1 EA	KICK PLATE	ROCKWOOD	K1050	10 x 34 x 630										
1 EA	WEATHER STRIP	PEMKO	2891AS	x 36 (HEAD)										
2 EA	WEATHER STRIP	PEMKO	290AS	x 80 (SIDE JAMBS)										
1 EA	BOTTOM SWEEP	HAGER	750S	x 36	<b>HW-2</b> 3 EA HINGES HAGER BB1191 4.5 x 4.5 x 630 1 EA EXIT DEVICE PRECISION 2108 x 4908AX3 x 630 1 EA DOOR CLOSER LCN 4040 x CUSH x 689 1 EA KICK PLATE ROCKWOOD K1050 10 x 34 x 630 1 EA MOP PLATE ROCKWOOD K1050 10 x 35 x 630 1 EA WEATHER STRIP PEMKO 2891AS x 36 (HEAD) 2 EA WEATHER STRIP PEMKO 290AS x 80 (SIDE JAMBS) 1 EA THRESHOLD HAGER 580S x 36									
1 EA	HINGES	HAGER	BB1191	4.5 x 4.5NRP x 630										
1 EA	EXIT LOCK	SCHLAGE	ND25D	x RHODES x 626	<b>HW-3</b> 3 EA HINGES HAGER BB1191 4.5 x 4.5NRP x 630 1 EA EXIT LOCK SCHLAGE ND25D x RHODES x 626 1 EA OVERHEAD STOP ROCKWOOD OH903H x US32D 1 EA WEATHER STRIP PEMKO 2891AS x 42 (HEAD) 2 EA WEATHER STRIP PEMKO 290AS x 80 (SIDE JAMBS) 1 EA BOTTOM SWEEP HAGER 750S x 42									
1 EA	OVERHEAD STOP	ROCKWOOD	OH903H	x US32D										
1 EA	WEATHER STRIP	PEMKO	2891AS	x 42 (HEAD)	<b>HW-4</b> 1 EA WEATHER STRIP PEMKO 2891AS x 42 (HEAD) 2 EA WEATHER STRIP PEMKO 290AS x 80 (SIDE JAMBS) 1 EA BOTTOM SWEEP HAGER 750S x 42									
2 EA	WEATHER STRIP	PEMKO	290AS	x 80 (SIDE JAMBS)										
1 EA	BOTTOM SWEEP	HAGER	750S	x 42										

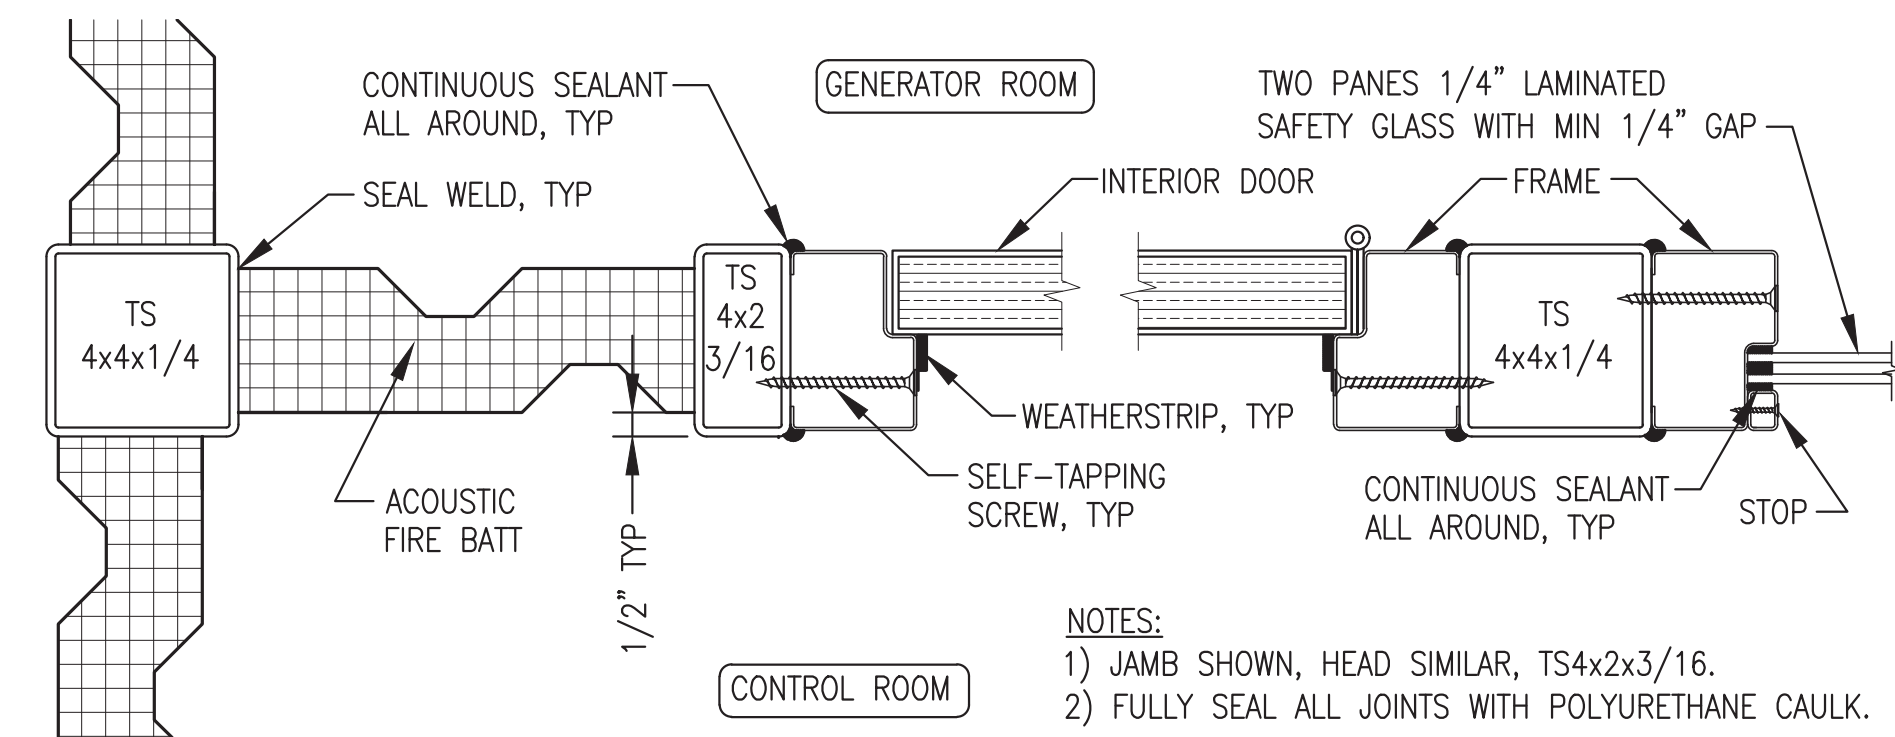


**1** INTERIOR DOOR AND WINDOW JAMB/HEAD  
A2.2 NO SCALE

**NOTES:**  
 1) SET THRESHOLD IN CONTINUOUS BED OF POLYURETHANE CAULK & CAULK ENDS TO JAMB TO FORM LIQUID TIGHT CONTAINMENT.  
 2) TRIM DOOR BOTTOM TO WITHIN 1/8" MAX OF THRESHOLD TO ACHIEVE FULL CONTACT WITH GASKET.

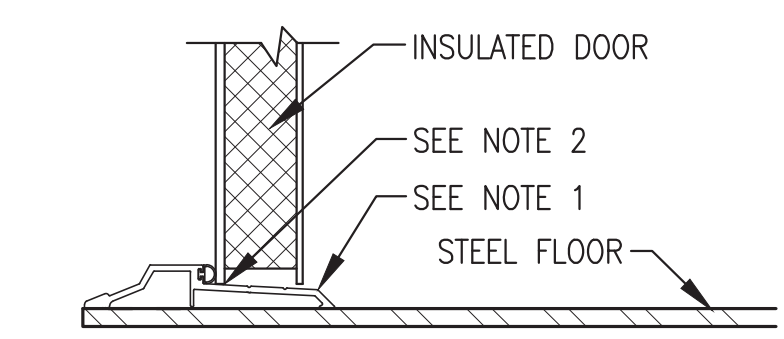


**2** INTERIOR DOOR THRESHOLD  
A2.2 NO SCALE

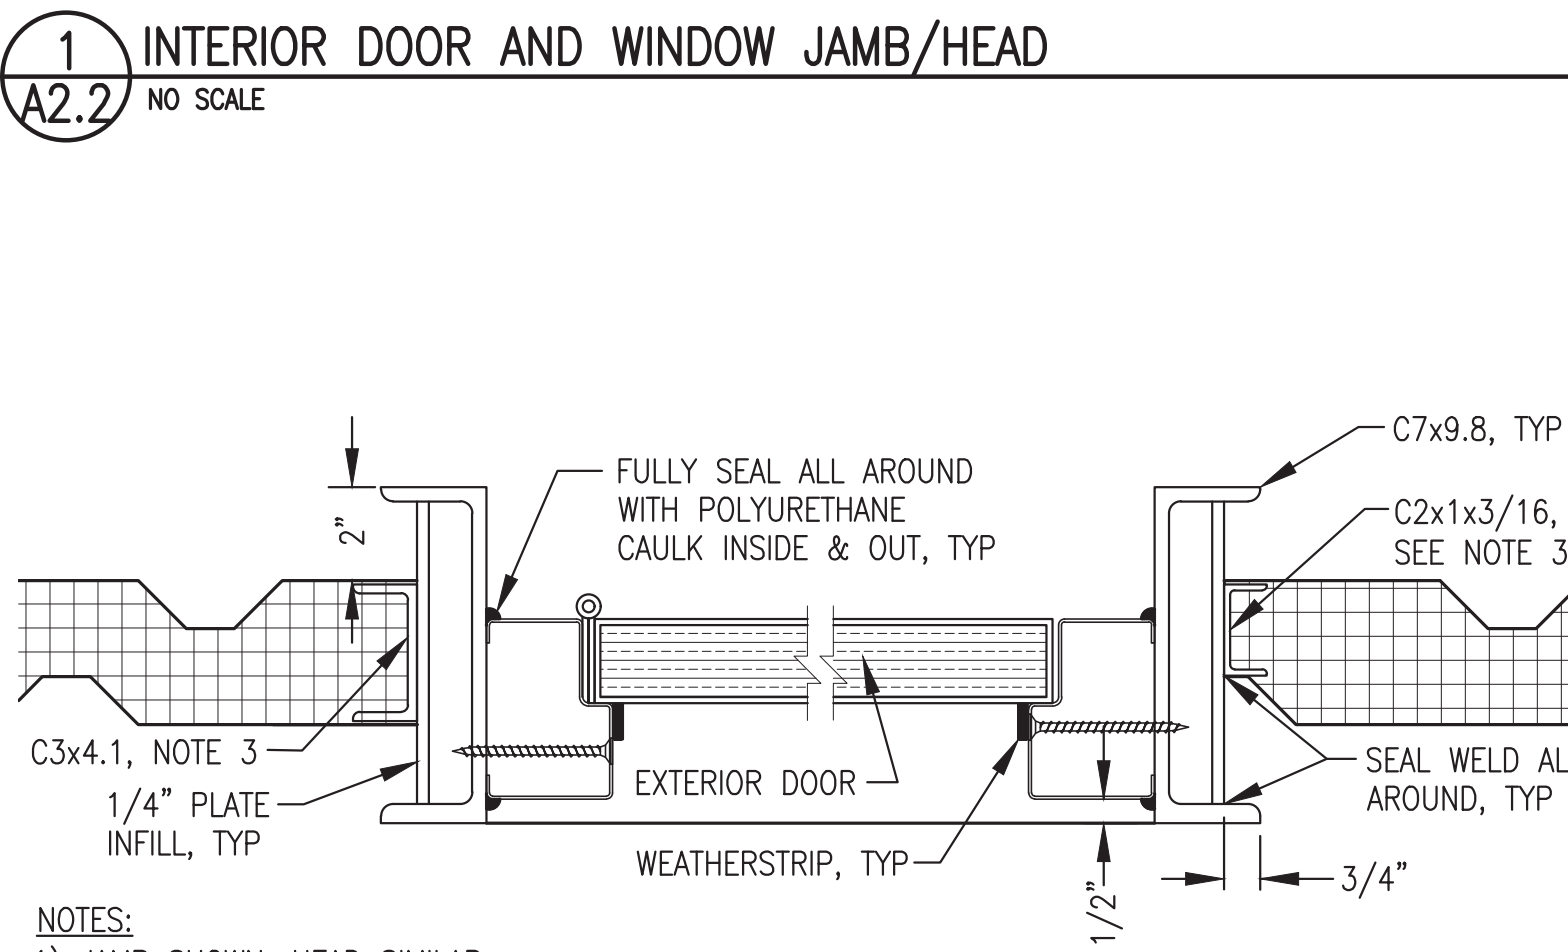


**NOTES:**  
 1) JAMB SHOWN, HEAD SIMILAR.  
 2) MITER TOP CORNERS & SEAL WELD TO FORM WATERTIGHT DAM.  
 3) PROVIDE 2" CHANNEL AT CORRUGATIONS & ACROSS HEAD. PROVIDE 3" CHANNEL AT FULL PANEL AS SHOWN. ON JAMBS RUN CONTINUOUS FLOOR TO ROOF FRAME.

**3** TYPICAL EXTERIOR DOOR JAMB/HEAD  
A2.2 NO SCALE

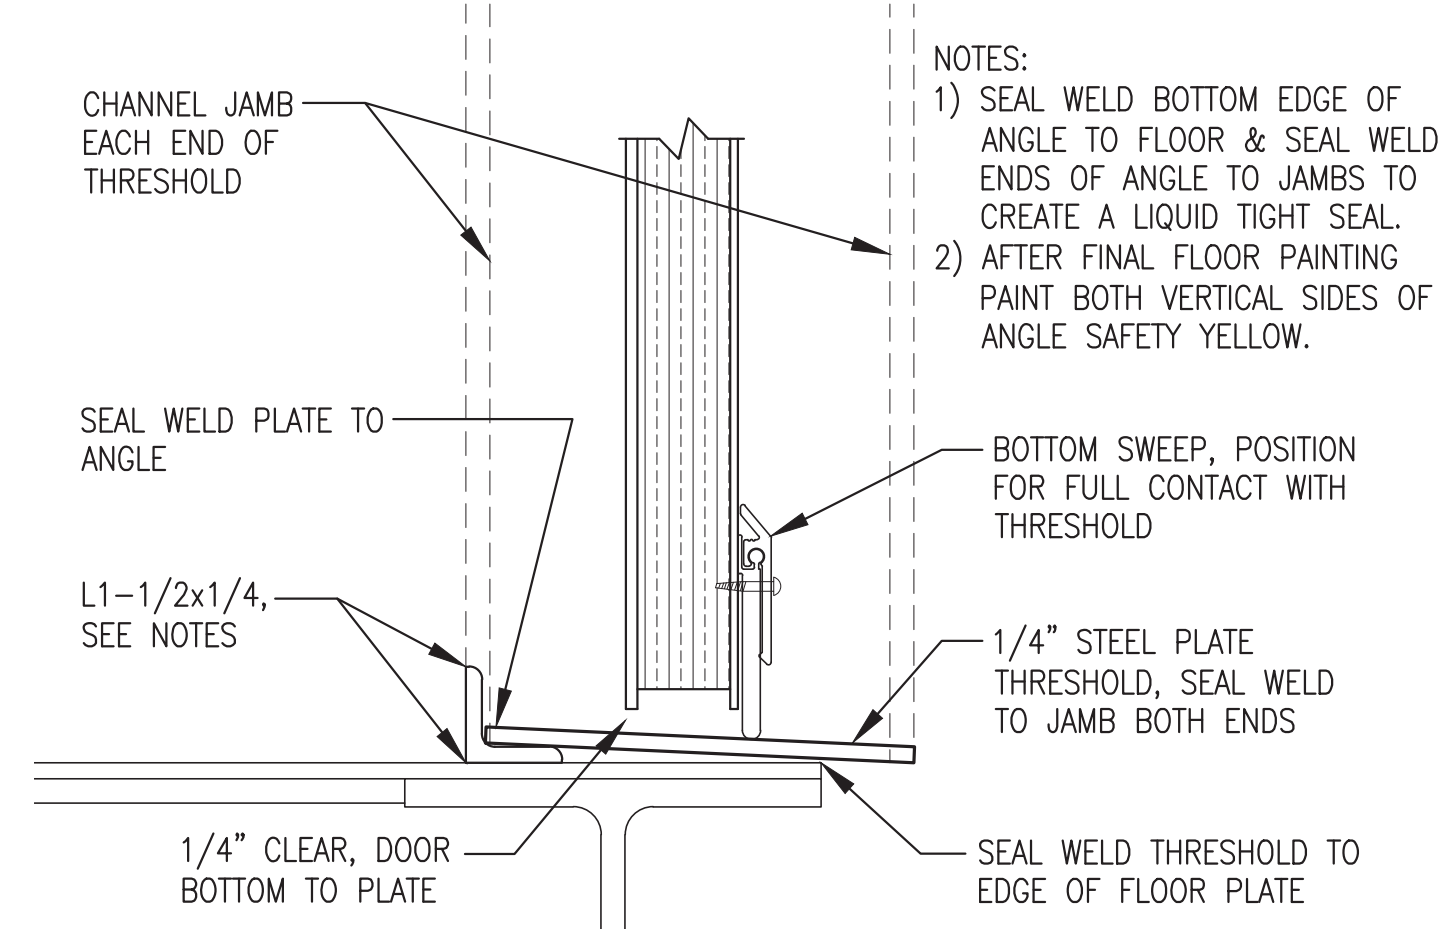

**4** EXTERIOR DOOR THRESHOLD  
A2.2 NO SCALE

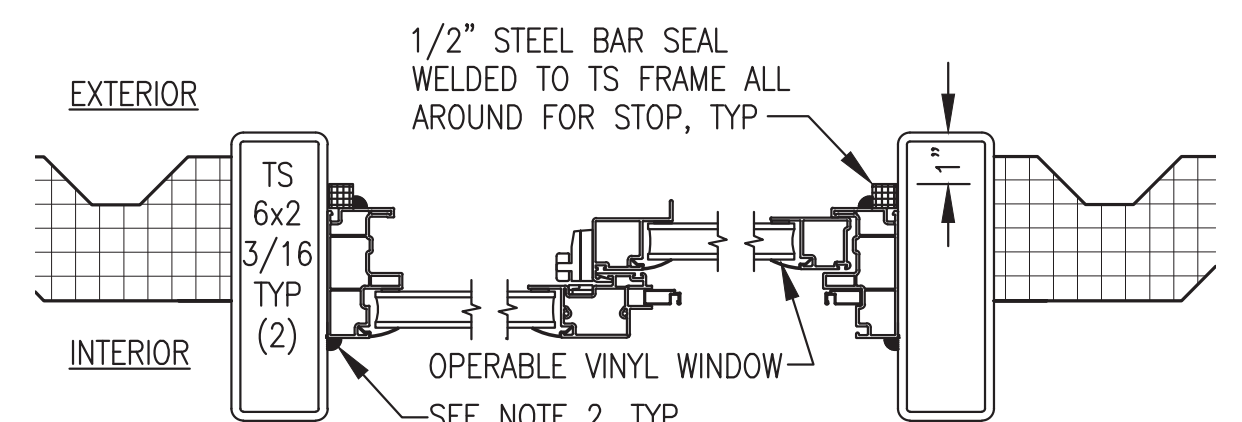


**NOTES:**  
 1) JAMB SHOWN, HEAD & SILL SIMILAR.  
 2) FULLY SEAL ALL JOINTS WITH POLYURETHANE CAULK.

**5** EXTERIOR WINDOW JAMB/HEAD  
A2.2 NO SCALE

ALL WORK ON THIS SHEET WAS PERFORMED AS PART OF THE PRIOR MODULE ASSEMBLY CONTRACT EXCEPT.


ISSUED FOR CONSTRUCTION  
MARCH 2023




 ALASKA ENERGY AUTHORITY		
PROJECT: NELSON LAGOON POWER SYSTEM UPGRADE		
TITLE: DOOR & WINDOW DETAILS & SCHEDULE		
DESIGNED BY: DGT/BCG	SCALE: AS NOTED	DATE: 3/2/23
FILE NAME: NELS PP A1-A4	SHEET: A2.2	
PROJECT NUMBER:		
P.O. 111405, Anchorage, AK 99511 (907)349-0100		






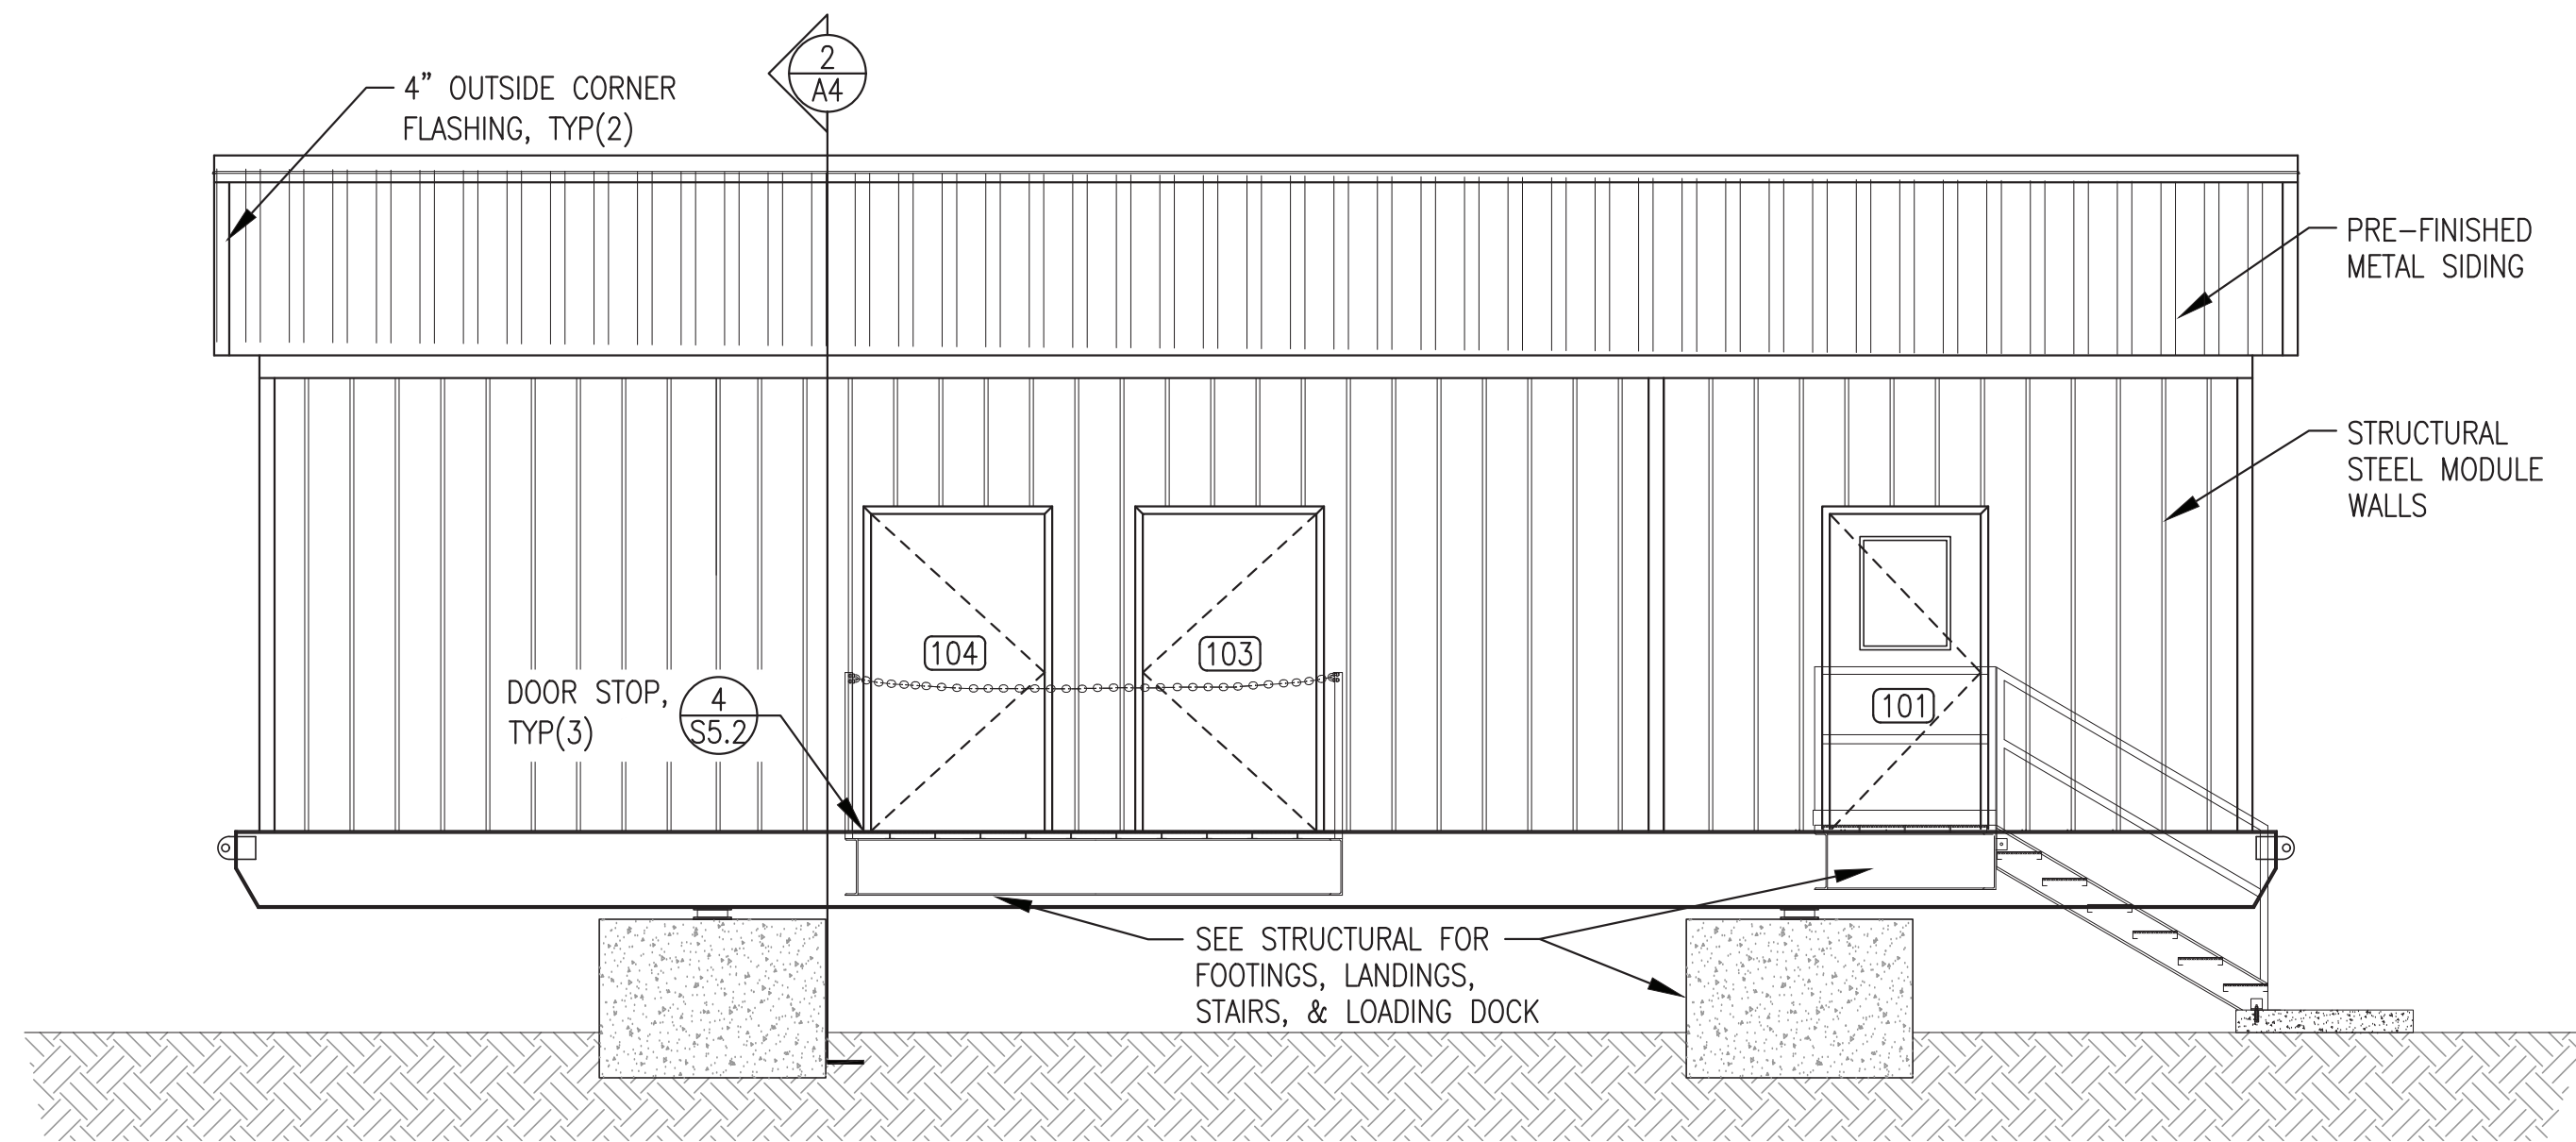

**1 FRONT EXTERIOR ELEVATION**  
1/4"=1'-0"

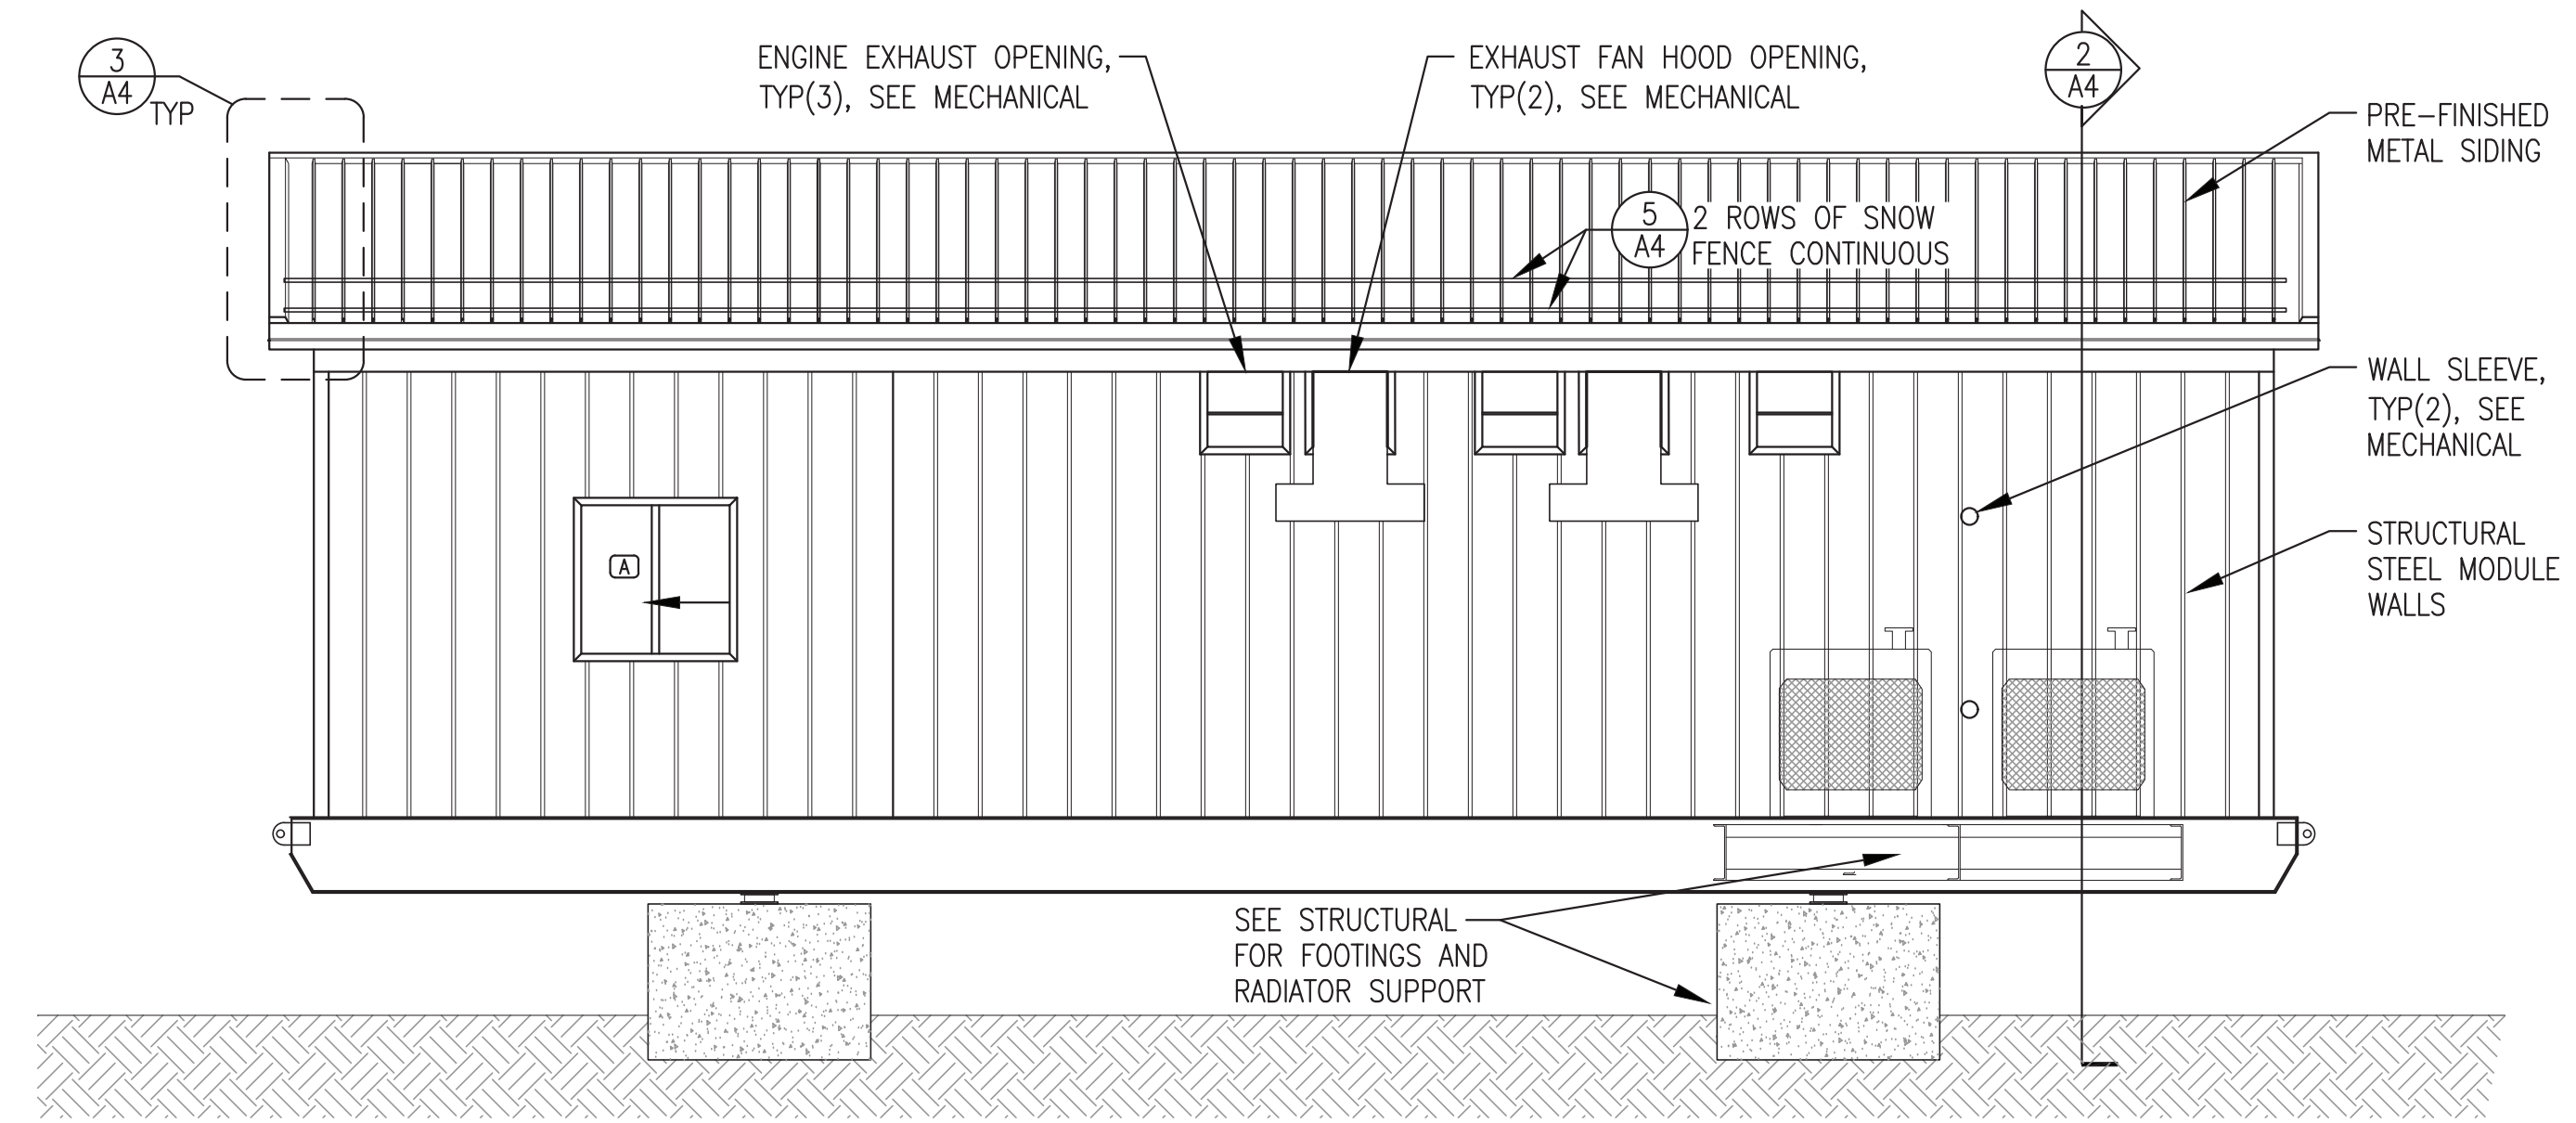

**2 BACK EXTERIOR ELEVATION**  
1/4"=1'-0"

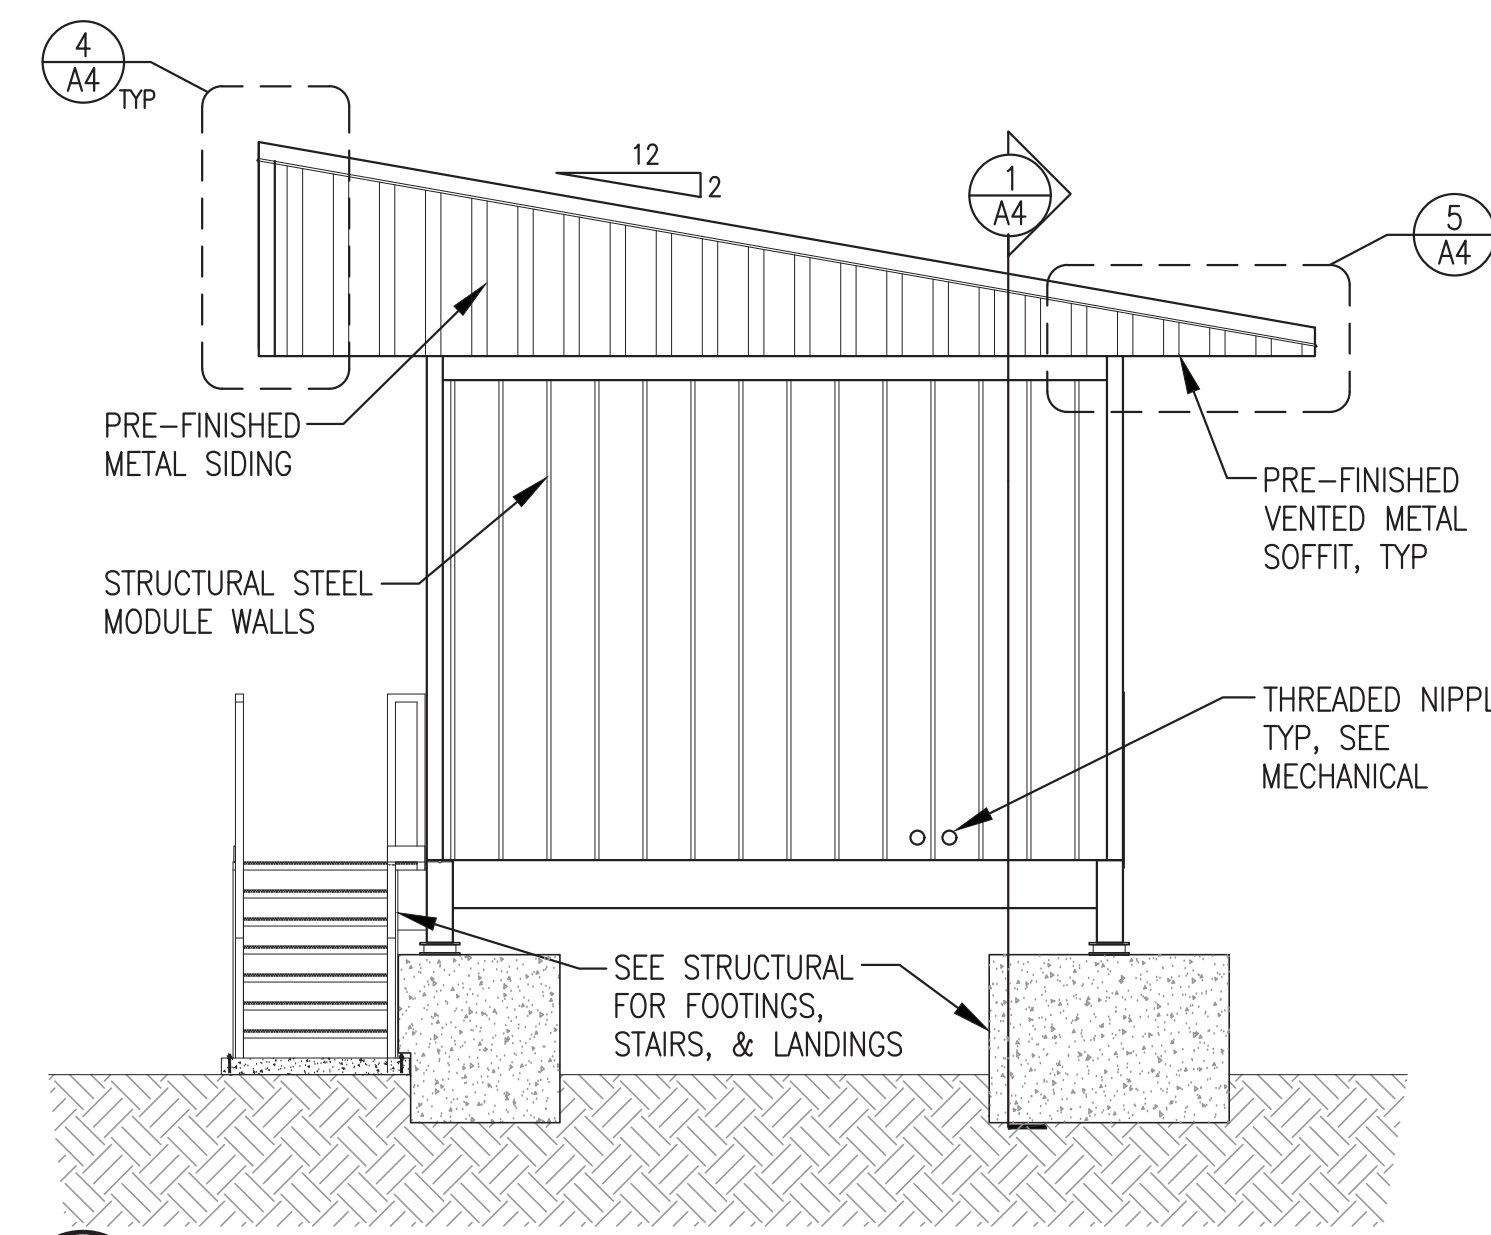


**3 END EXTERIOR ELEVATION**  
1/4"=1'-0"

**ROOFING SYSTEM NOTES:**


- 1) FIELD INSTALL TRUSSES TO MODULE STRUCTURE, SEE STRUCTURAL. FIELD INSTALL PLYWOOD SHEATHING, ICE AND WATER SHIELD, AND METAL ROOFING/SIDING AS INDICATED. SEAL AND FLASH ALL SEAMS TO FORM A CONTINUOUS WEATHERPROOF SEAL.
- 2) ALL ROOFING, SIDING, SOFFIT, TRIM, AND FLASHING SHALL BE MIN 24 GAUGE GALVANIZED STEEL WITH KYNAR FINISH, COLOR COOL TAHOE BLUE. ALL FASTENERS SHALL BE CORROSION RESISTANT COATED SCREWS AND RIVETS.
- 3) ROOFING SHALL BE MECHANICAL STANDING SEAM TYPE, 24 GAUGE, 16" NET COVERAGE, 2" HIGH RIBS AT 16" O.C. WITH TWO PENCIL RIBS BETWEEN. AEP SPAN SPAN LOK HP OR EQUAL. FURNISH CLIPS AND FASTENERS AS REQUIRED TO MEET LOAD CONDITIONS INDICATED ON SHEET S1.
- 4) SIDING SHALL BE LOW PROFILE, 24 GAUGE, 36" NET COVERAGE, 1-1/4" HIGH MAJOR RIBS AND 1/4" HIGH MINOR RIBS AT 12" O.C. AEP SPAN SUPER-SPAN OR EQUAL. FURNISH FASTENERS AS REQUIRED TO MEET LOAD CONDITIONS INDICATED ON SHEET S1.1.
- 5) VENTED SOFFIT PANELS SHALL BE 24 GAUGE GALVANIZED STEEL, 12" NET COVERAGE, KYNAR FINISH, 1" STANDOFF FROM SUBSTRATE, CONCEALED FASTENERS, WITH TWO PENCIL RIBS PROVIDING MINIMUM 7.8% NET FREE AREA. AEP SPAN FLUSH PANEL OR EQUAL.
- 6) SEE SHEET A4 FOR ROOF MOUNTED SNOW FENCE.


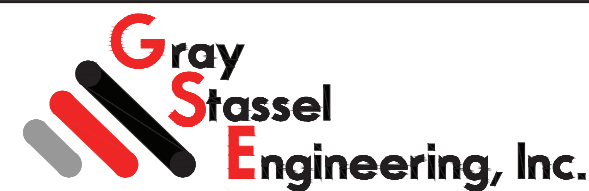
**ROOFING SYSTEM TRIM & FLASHING:**

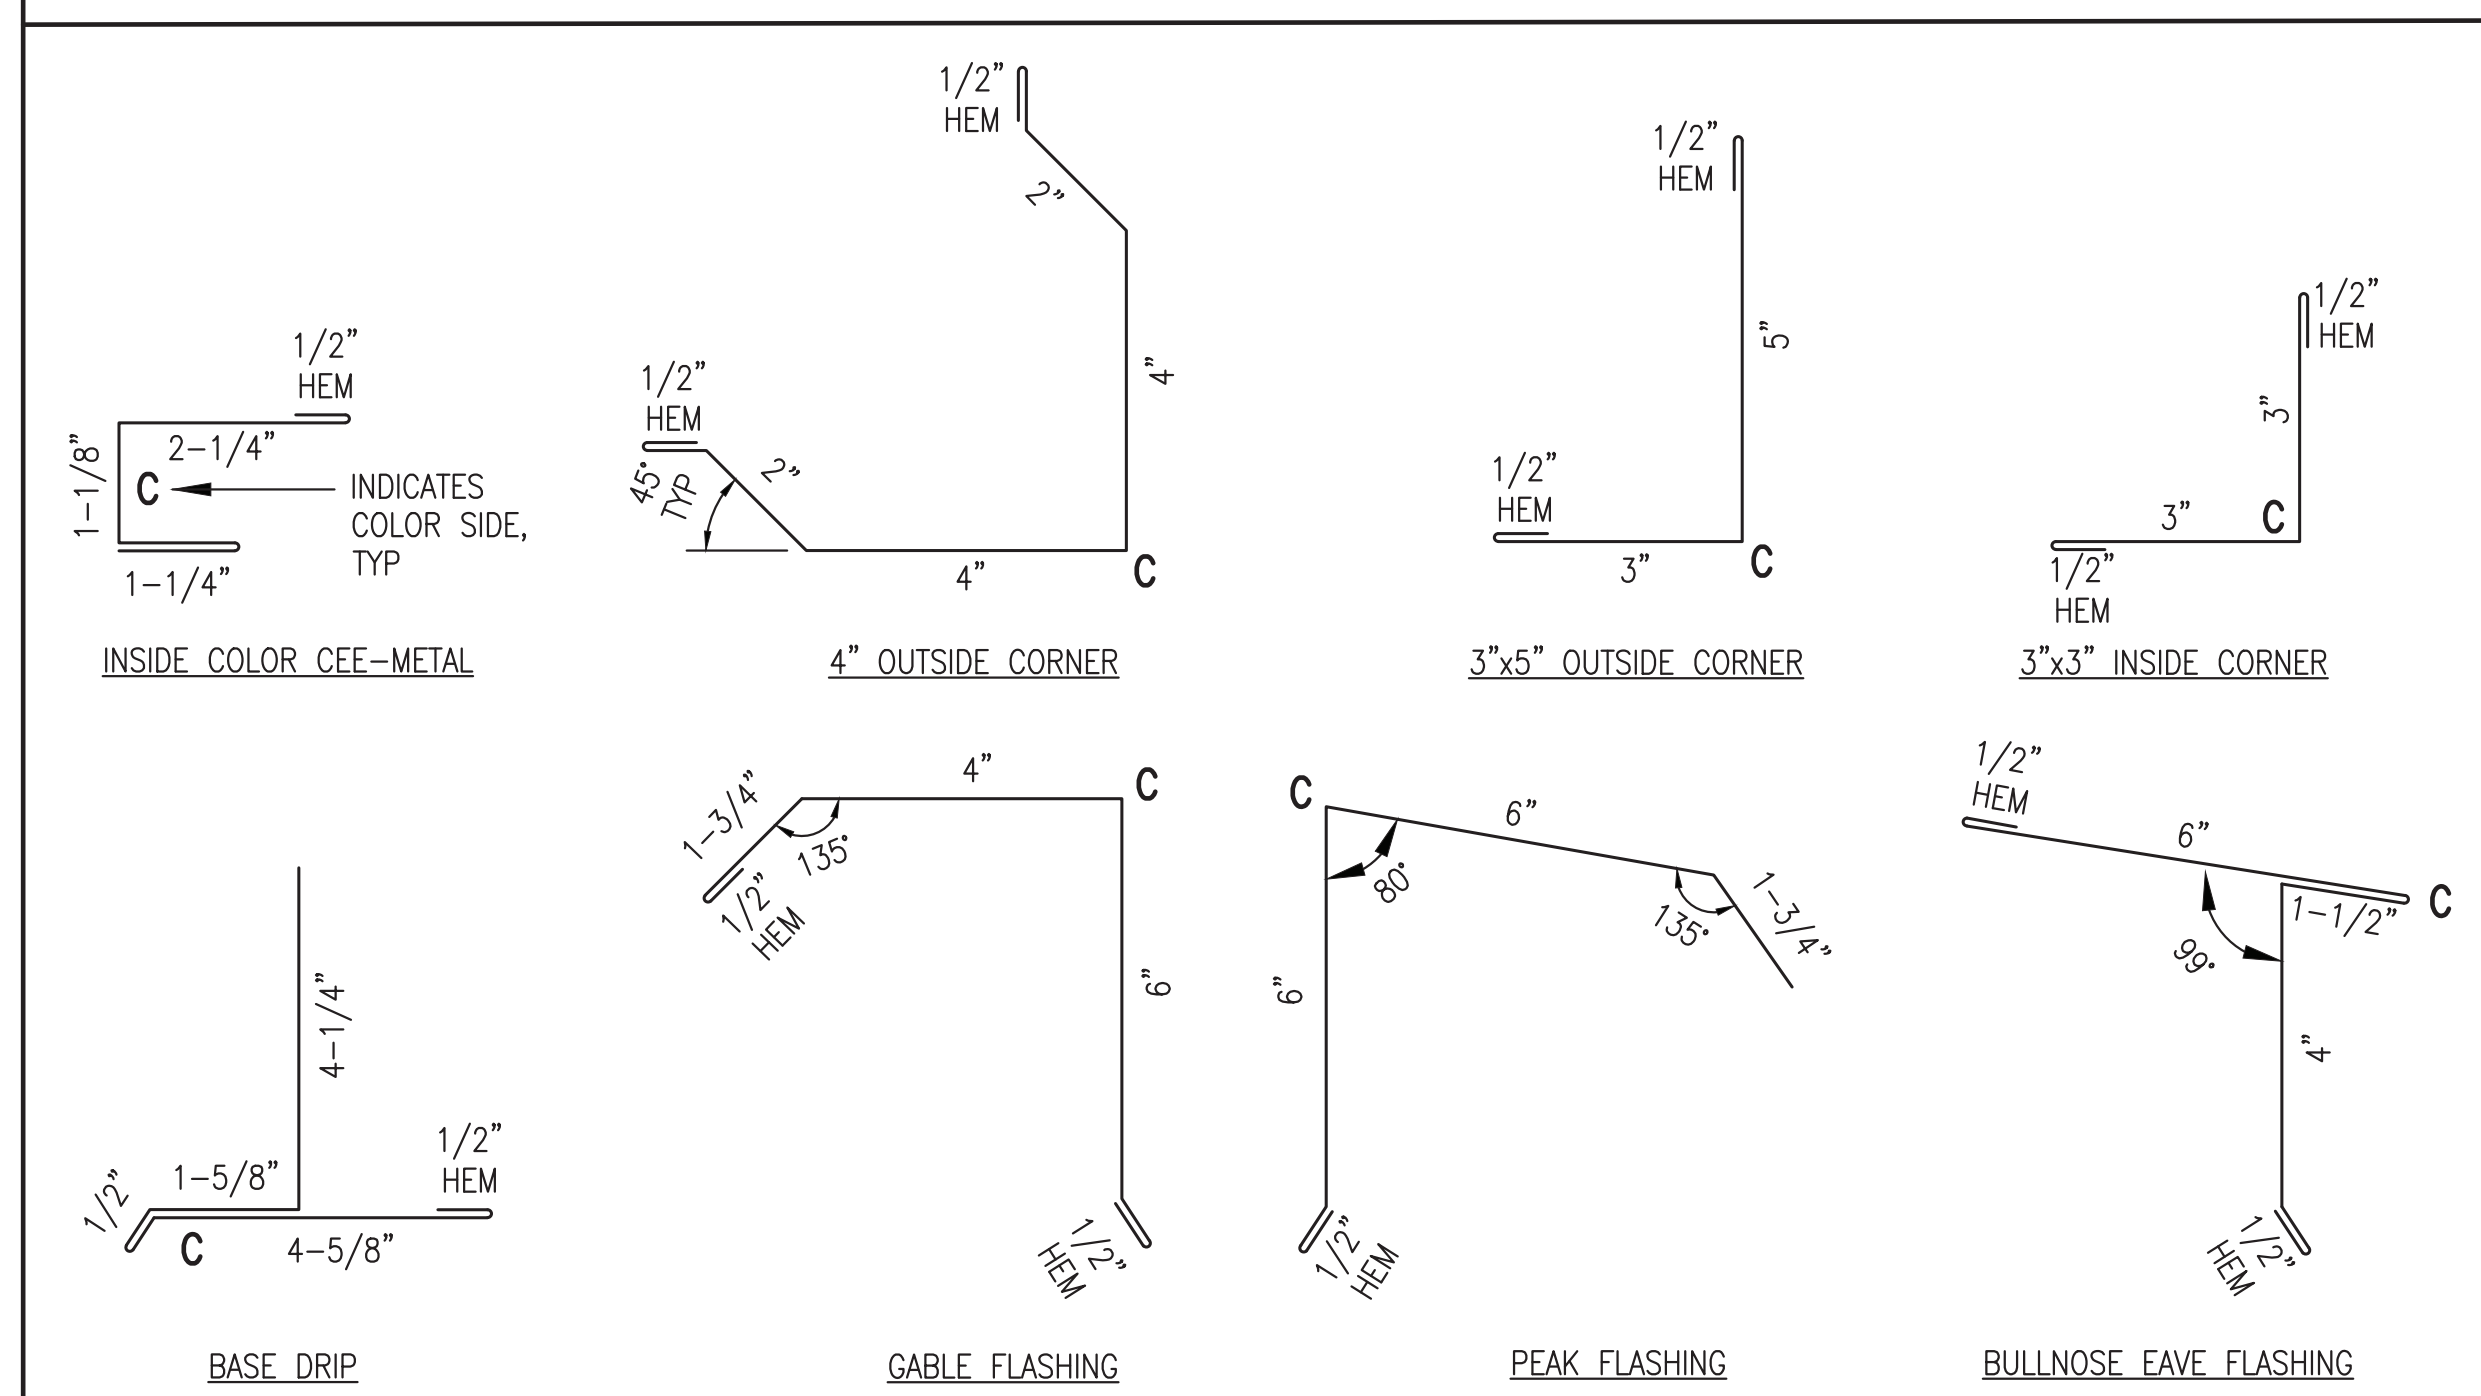


FIELD INSTALLED ROOF SYSTEM SHOWN THIS SHEET IS INCLUDED IN THE ON SITE CONTRACT


ISSUED FOR CONSTRUCTION  
MARCH 2023

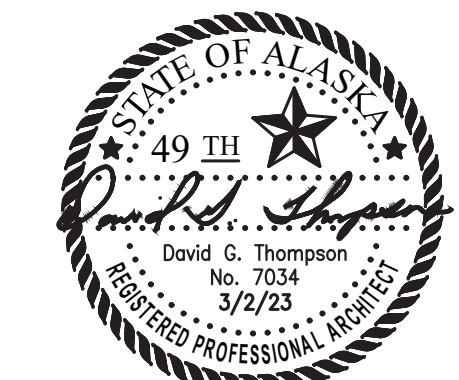


 <b>ALASKA ENERGY AUTHORITY</b>		
PROJECT: NELSON LAGOON POWER SYSTEM UPGRADE		
TITLE: EXTERIOR ELEVATIONS & ROOFING NOTES & TRIM DETAILS		
 <b>Gray Stassel Engineering, Inc.</b> P.O. 111405, Anchorage, AK 99511 (907)349-0100	DRAWN BY: JTD DESIGNED BY: DGT/BCG FILE NAME: NELS PP A1-A4 PROJECT NUMBER:	SCALE: AS NOTED DATE: 3/2/23 SHEET: <b>A3</b>

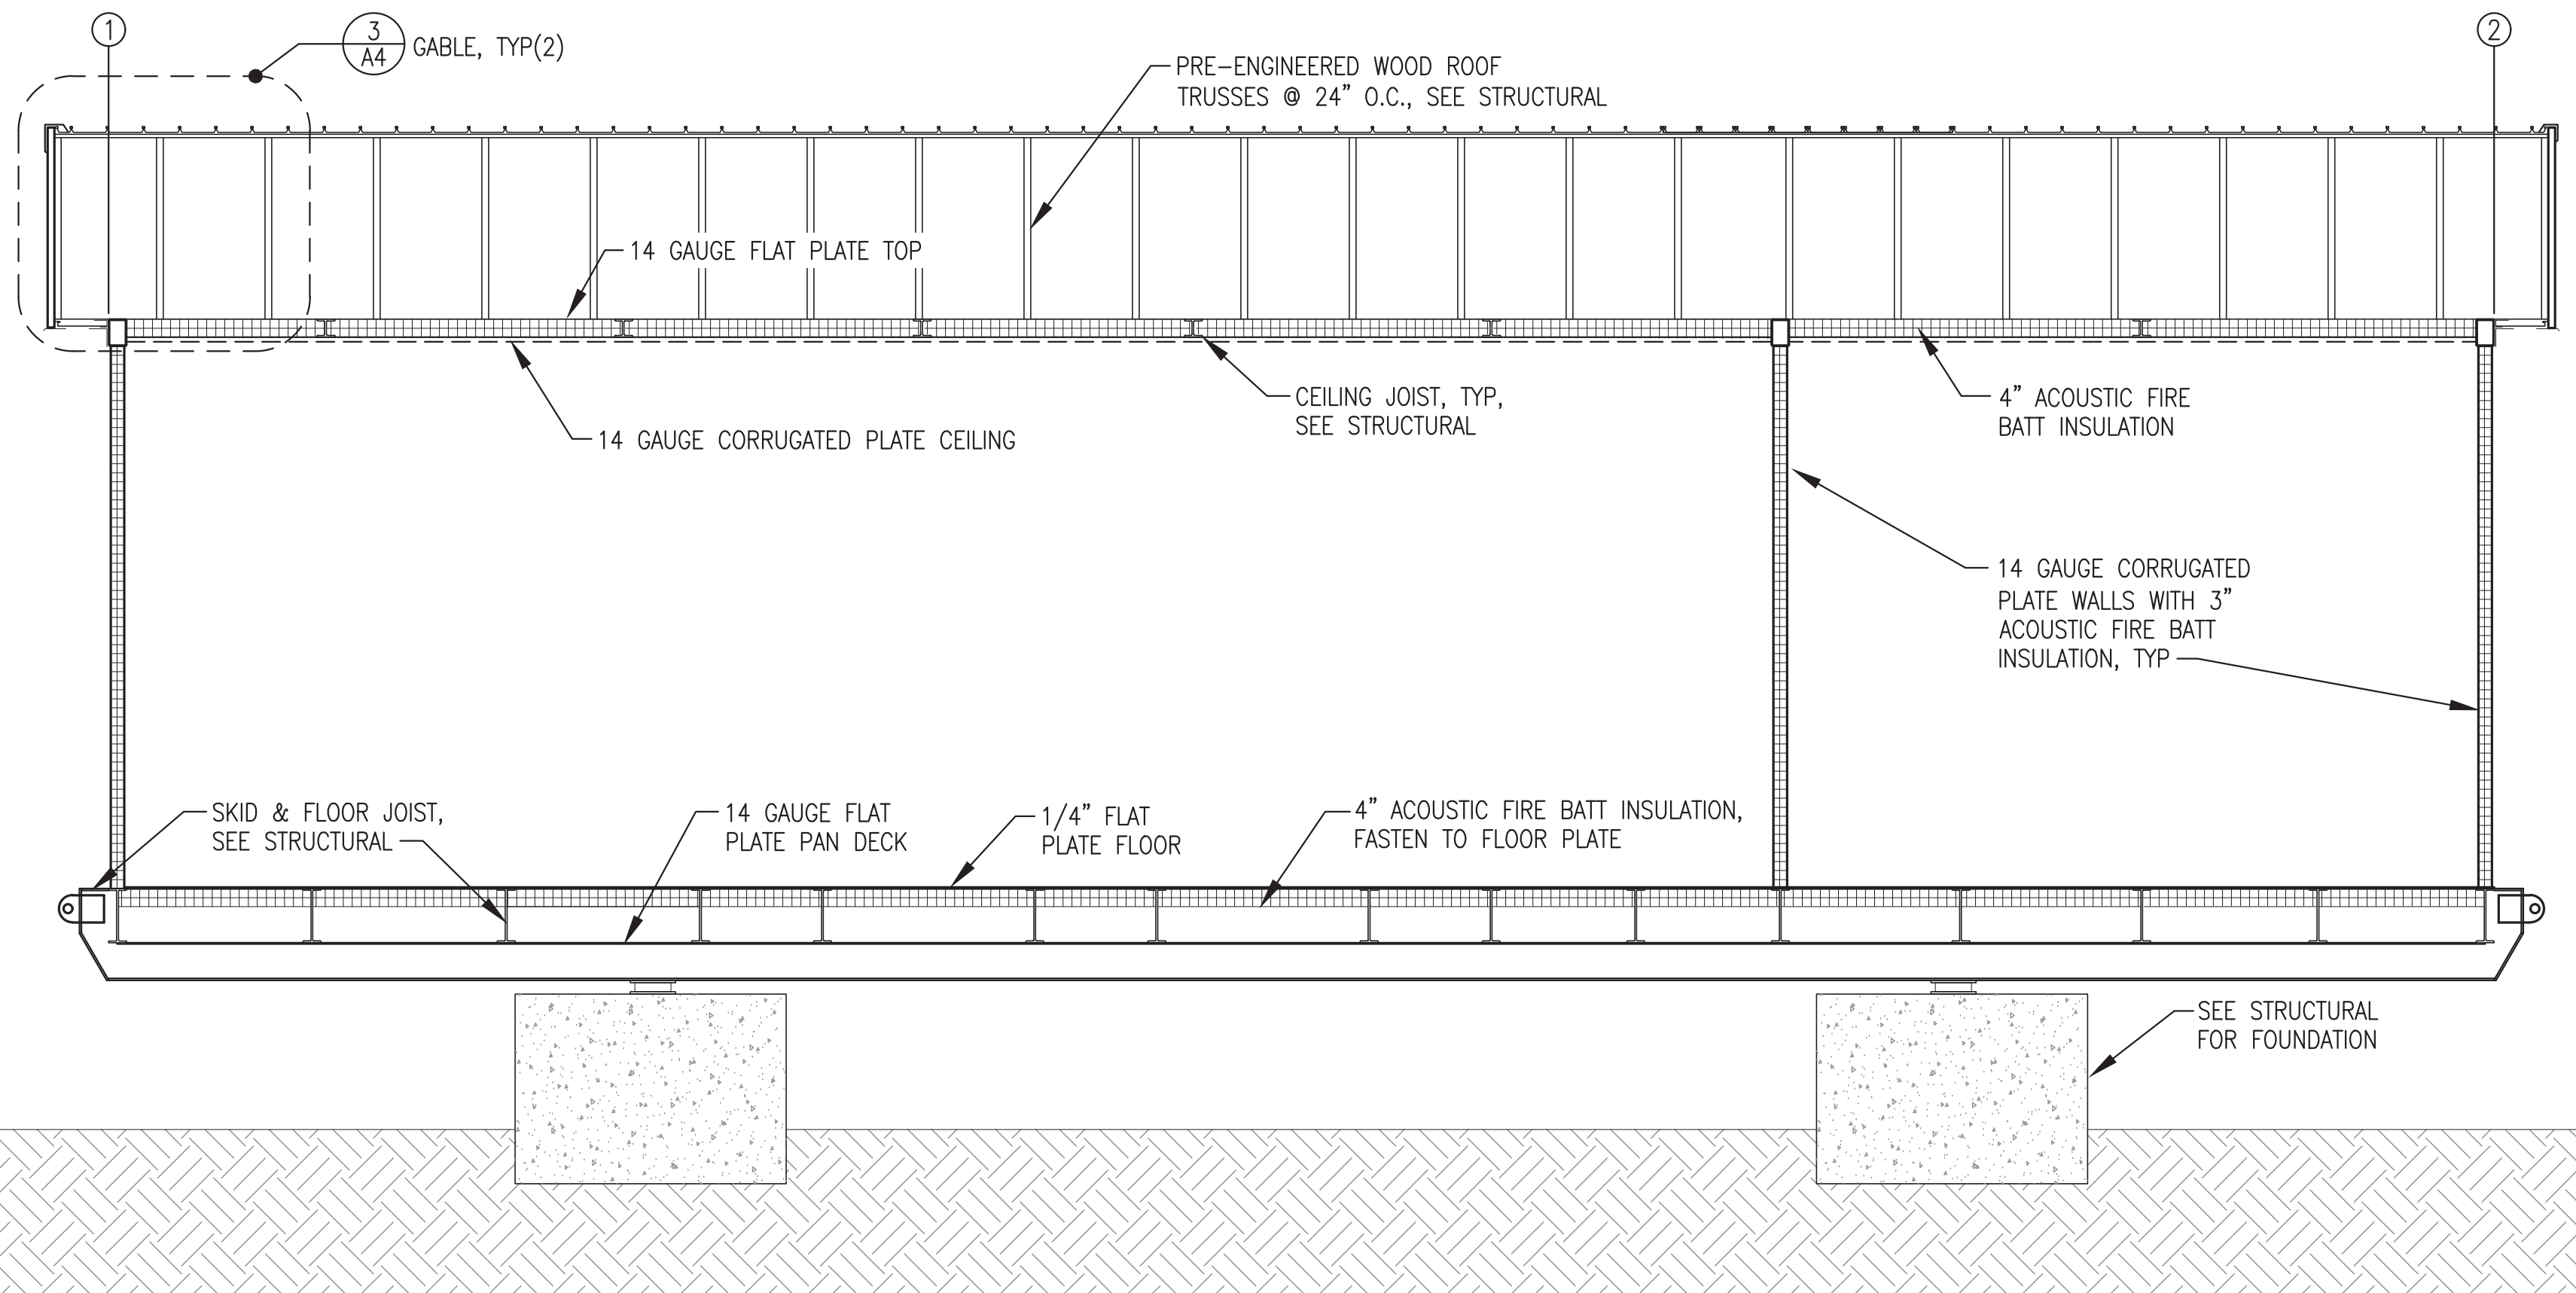


**1 BUILDING SECTION**  
A4 3/8"=1'-0"

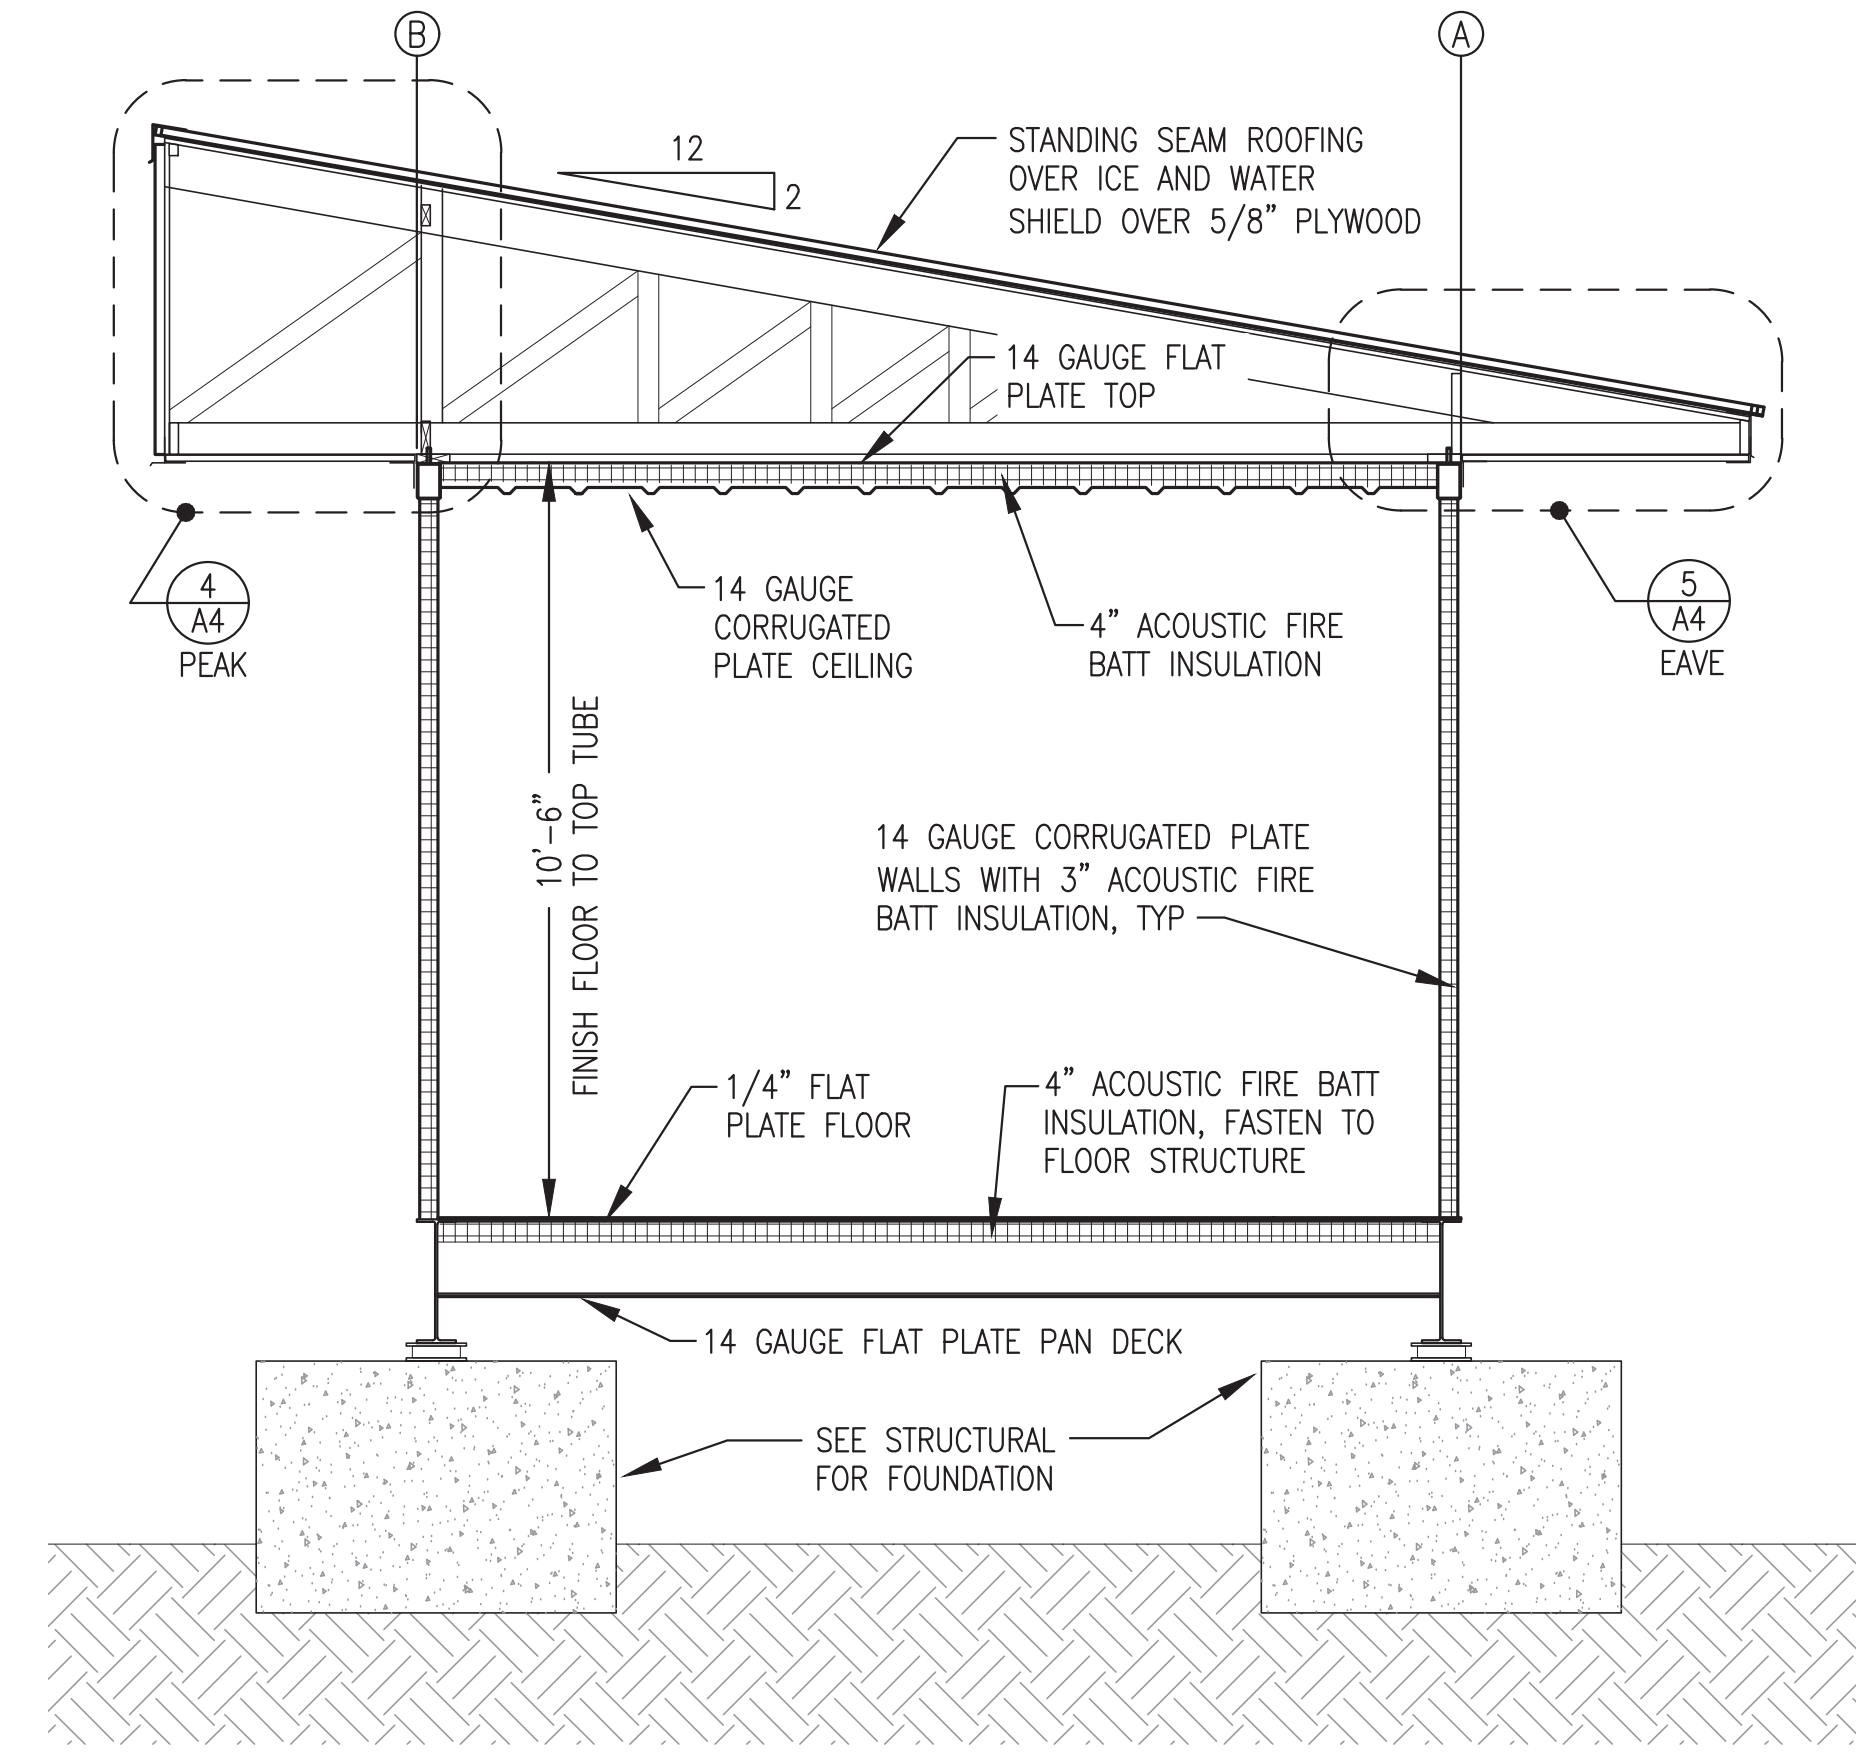


**2 BUILDING SECTION**  
A4 3/8"=1'-0"

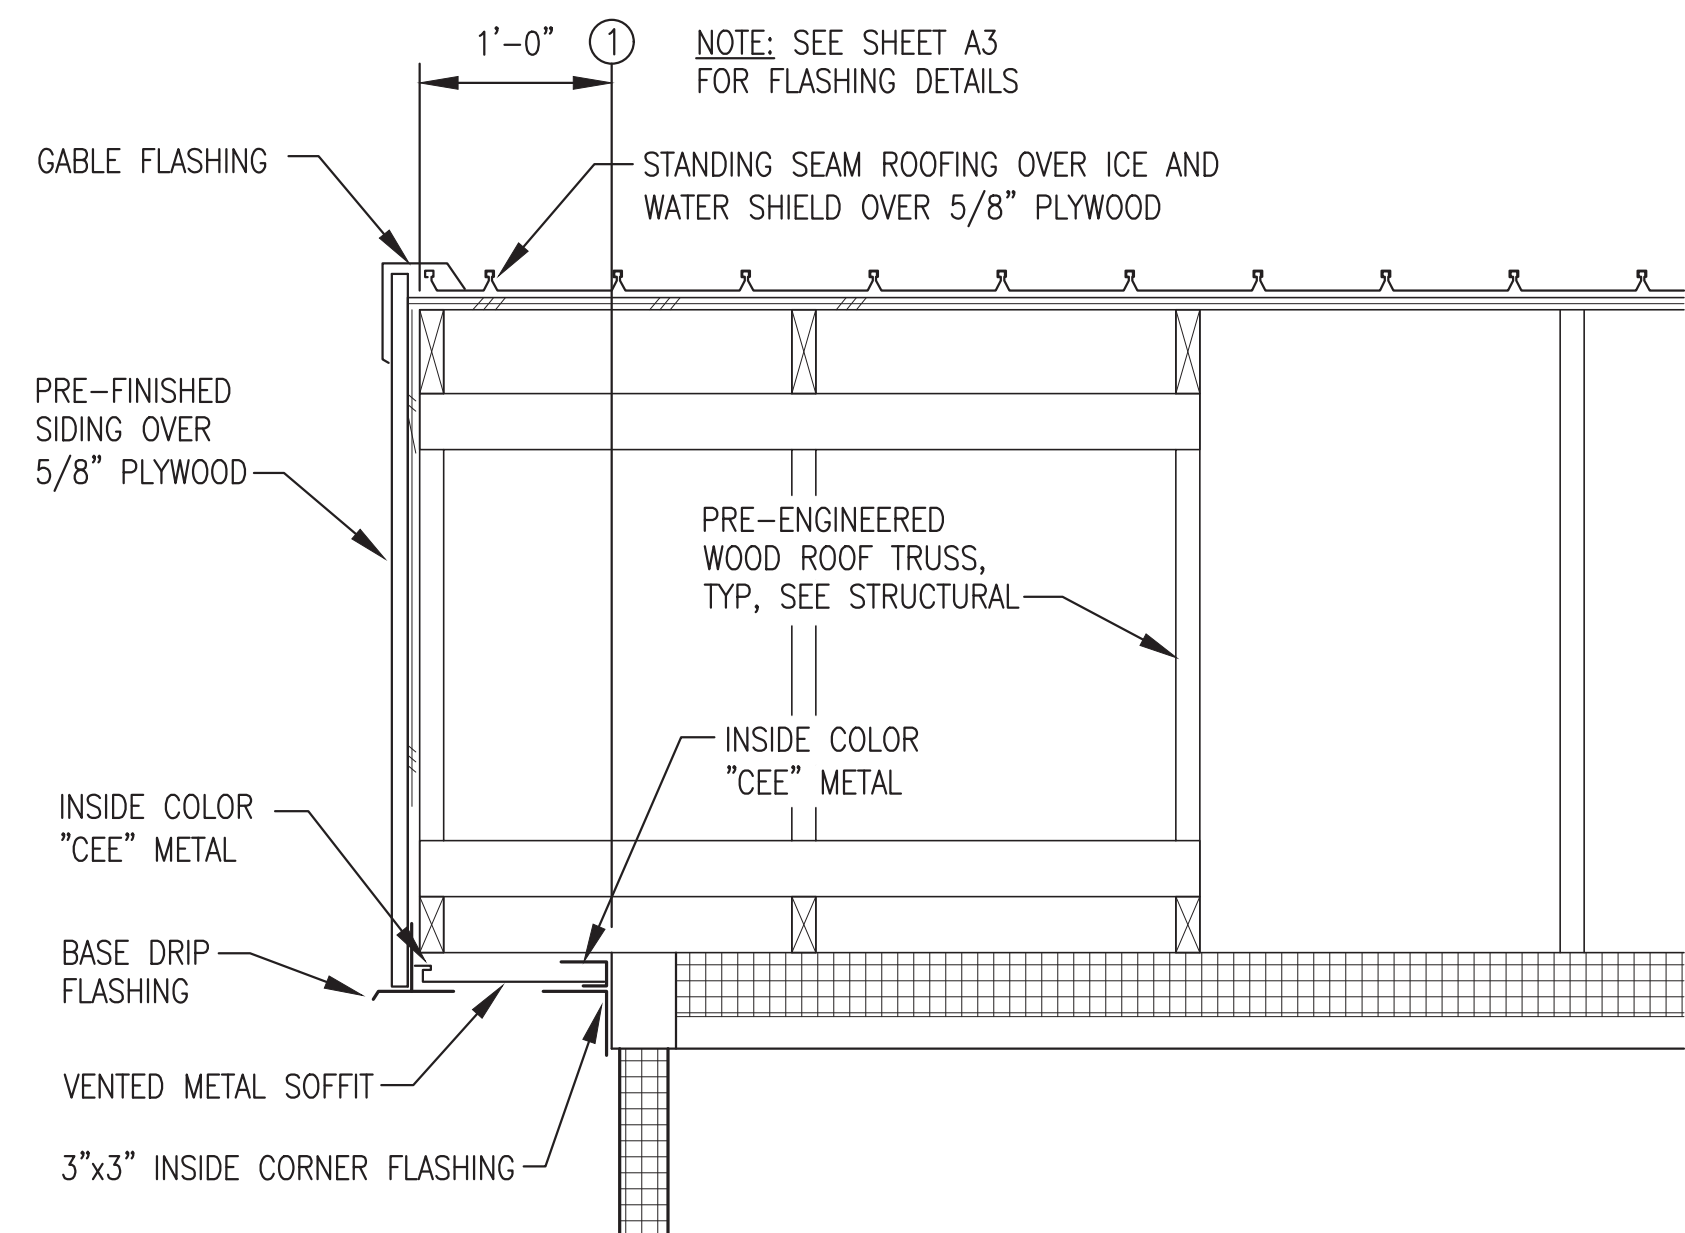

**3 GABLE DETAIL**  
A4 1"=1'-0"

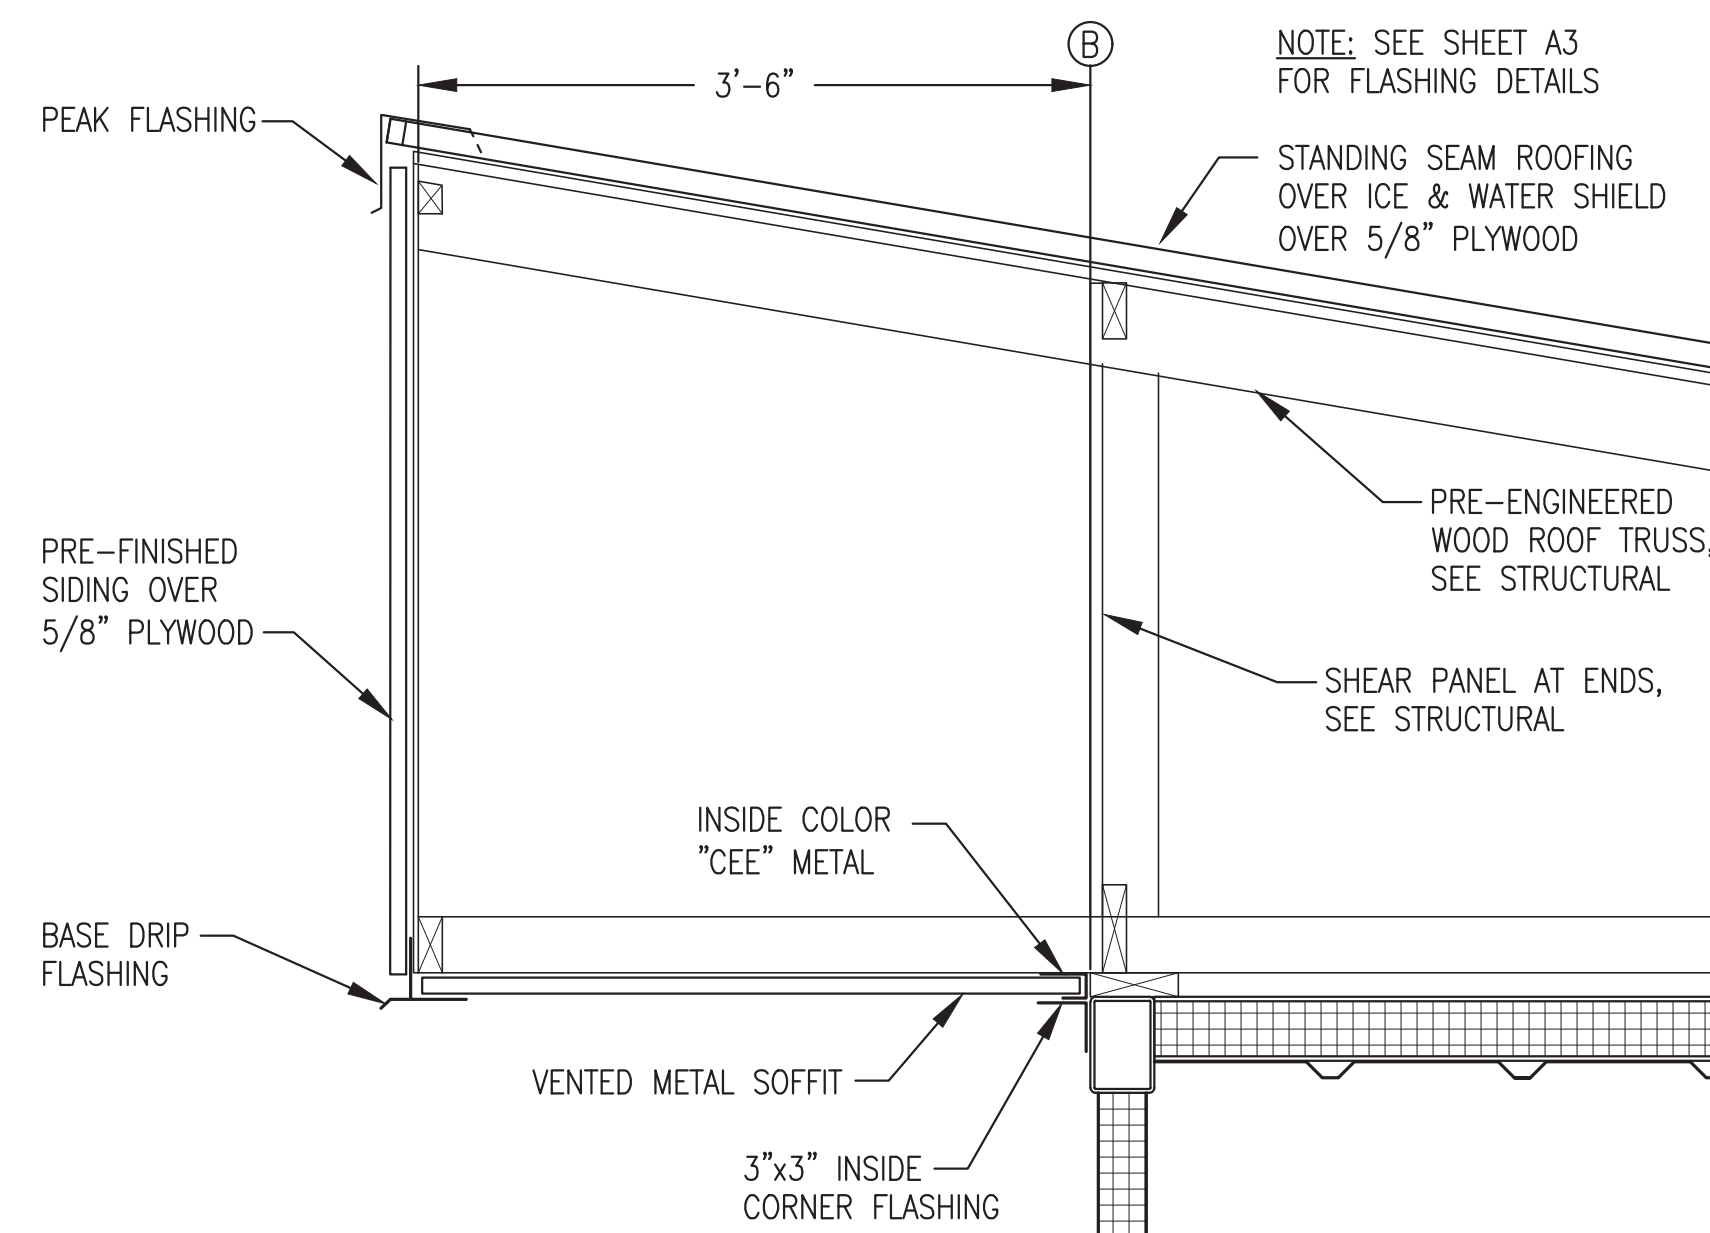

**4 PEAK DETAIL**  
A4 1"=1'-0"

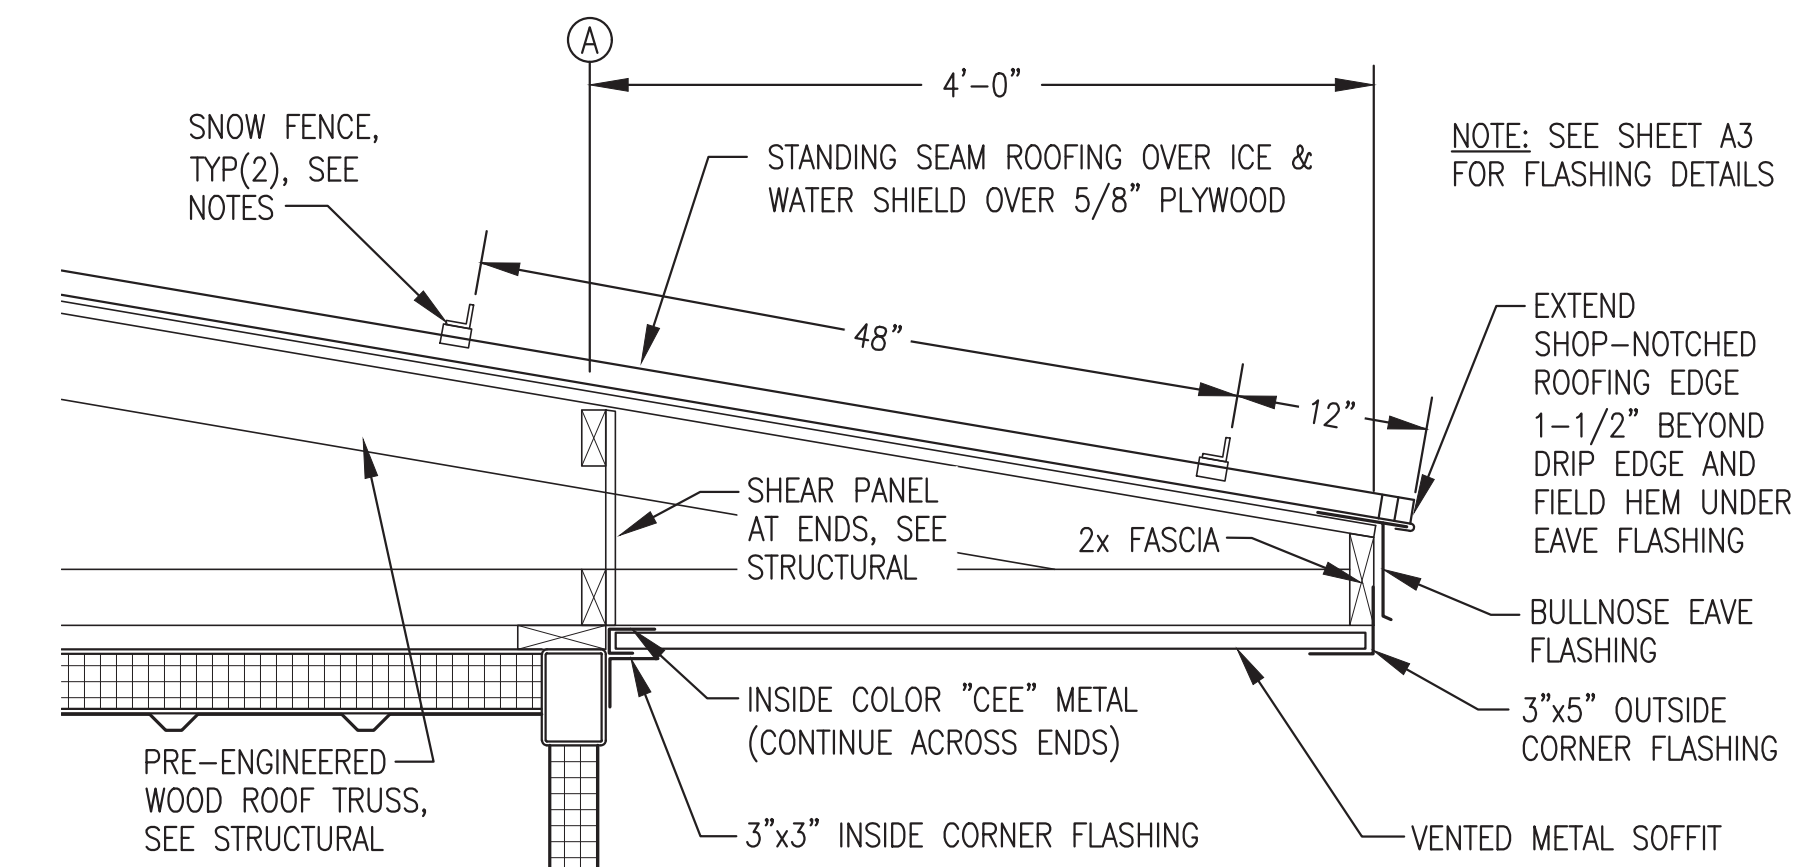

**5 EAVE DETAIL**  
A4 1"=1'-0"

**SNOW FENCE NOTES:**


- 1) PROVIDE 2 ROWS OF CONTINUOUS SNOW RETENTION FENCE AS INDICATED.
- 2) SNOW FENCE SHALL BE L.M. CURBS COLOR GUARD OR APPROVED EQUAL. FURNISH COMPLETE SYSTEM INCLUDING UNPUNCHED COLOR GUARD, SPLICES, VERSA CLIPS, SNO CLIPS III, S5-U CLAMPS, AND ALL REQUIRED FASTENERS.

**FIELD INSTALLED ROOF SYSTEM SHOWN THIS SHEET IS INCLUDED IN THE ON SITE CONTRACT**

ISSUED FOR CONSTRUCTION  
MARCH 2023



ALASKA ENERGY AUTHORITY	
PROJECT: NELSON LAGOON POWER SYSTEM UPGRADE	
TITLE: BUILDING SECTIONS & DETAILS	
DRAWN BY: JTD	SCALE: AS NOTED
DESIGNED BY: DGT/BCC	DATE: 3/2/23
FILE NAME: NELS PP A1-A4	SHEET: A4
PROJECT NUMBER:	
P.O. 111405, Anchorage, AK 99511 (907)349-0100	

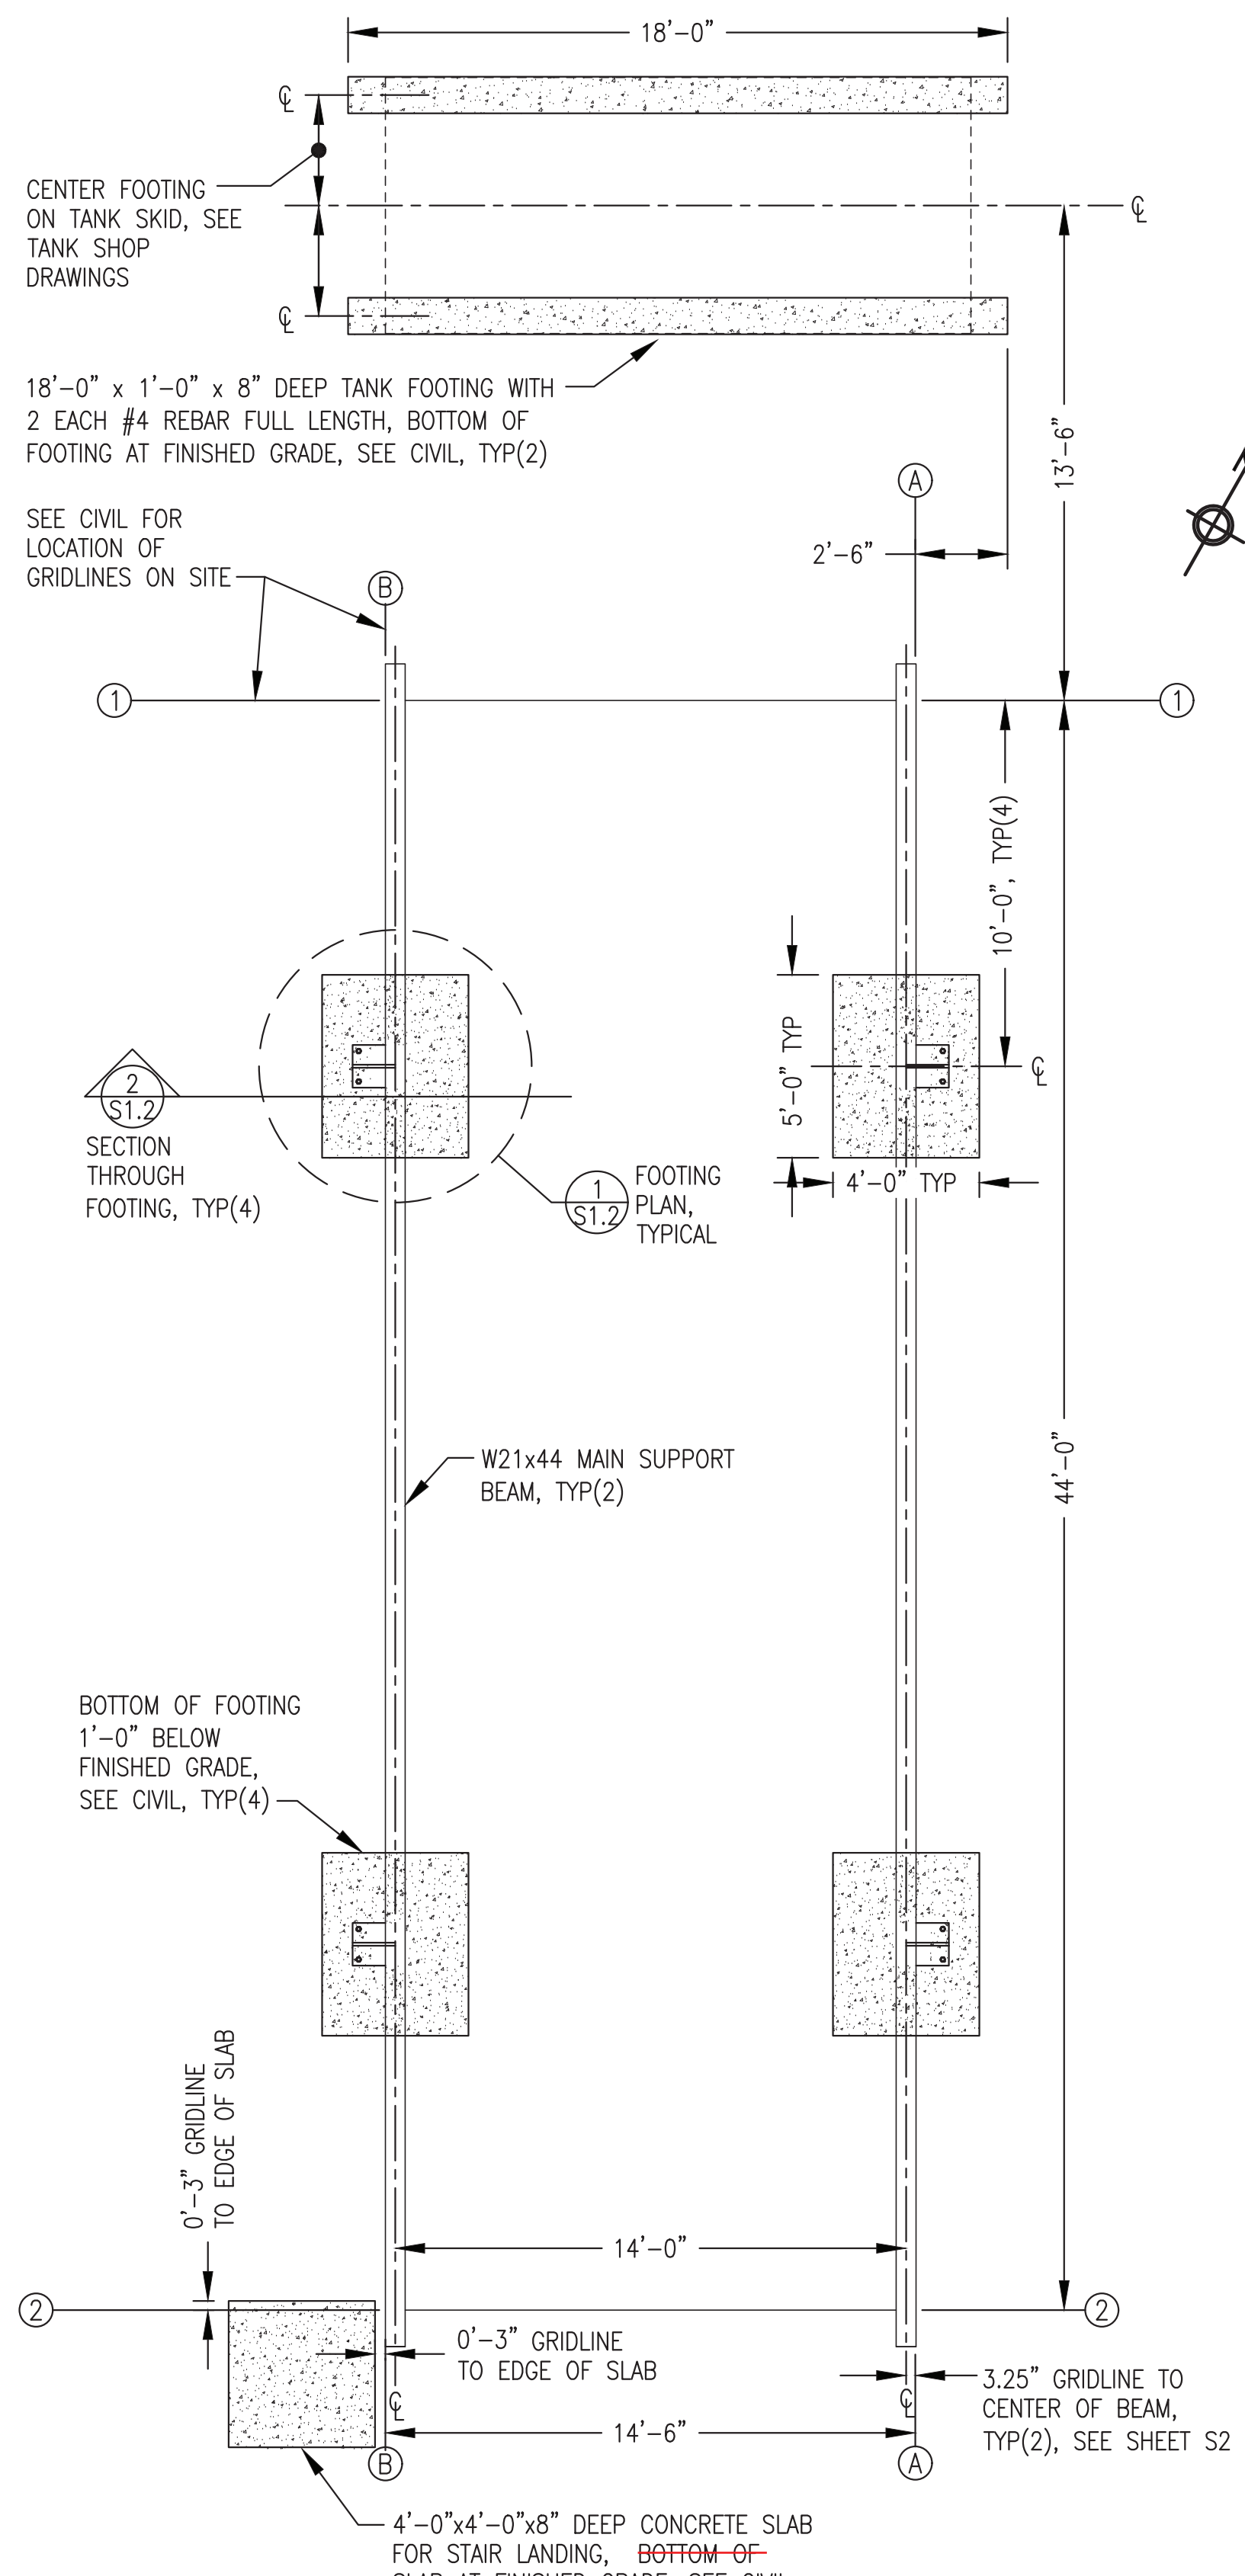

CENTER FOOTING ON TANK SKID, SEE TANK SHOP DRAWINGS

18'-0" x 1'-0" x 8" DEEP TANK FOOTING WITH 2 EACH #4 REBAR FULL LENGTH, BOTTOM OF FOOTING AT FINISHED GRADE, SEE CIVIL, TYP(2)

SEE CIVIL FOR LOCATION OF GRIDLINES ON SITE

SECTION THROUGH FOOTING, TYP(4)

FOOTING PLAN, TYPICAL

W21x44 MAIN SUPPORT BEAM, TYP(2)

BOTTOM OF FOOTING 1'-0" BELOW FINISHED GRADE, SEE CIVIL, TYP(4)

0'-3" GRIDLINE TO EDGE OF SLAB

0'-3" GRIDLINE TO EDGE OF SLAB

3.25" GRIDLINE TO CENTER OF BEAM, TYP(2), SEE SHEET S2

4'-0" x 4'-0" x 8" DEEP CONCRETE SLAB FOR STAIR LANDING, BOTTOM OF SLAB AT FINISHED GRADE, SEE CIVIL

TOP OF SLAB 50" BELOW MODULE FINISHED FLOOR

1 FOUNDATION PLAN  
S1.1 1/4"=1'-0"


**STRUCTURAL GENERAL NOTES:**


1.0 DESIGN LOADS:


BUILDING CODE:	2021 INTERNATIONAL BUILDING CODE, ASCE 7-16
A. FLOOR LIVE LOADS: (IBC TABLE 1607.1)	
LIGHT STORAGE/MANUFACTURING	125 PSF OR 2000 POUND POINT LOAD
MAXIMUM GENERATOR UNIT WEIGHT	6,000 POUNDS
B. SNOW LOADS: (ASCE 7-22)	
GROUND SNOW LOAD, $P_g =$	70 PSF
COEFFICIENT OF EXPOSURE, $C_e =$	1.0 PARTIALLY EXPOSED
SNOW IMPORTANCE FACTOR, $I_s =$	1.2 CATEGORY IV
THERMAL COEFFICIENT, $C_t =$	1.2 COLD, VENTILATED ROOF
ROOF/FLAT SNOW LOAD, $P_f =$	70 PSF
C. WIND LOADS:	
BASIC WIND SPEED =	175 MPH, 3 SECOND GUST
RISK CATEGORY =	CATEGORY IV
EXPOSURE CLASSIFICATION =	EXPOSURE D
D. SEISMIC LOADING:	
SEISMIC =	$S_s = 0.931$ $S_1 = 0.401$
SEISMIC IMPORTANCE FACTOR =	1.50, CATEGORY IV
SITE CLASS	"D" (DEFAULT)
BASIC SEISMIC FORCE RESISTANCE SYSTEM	
BUILDING = BEARING WALL WITH STEEL SHEAR PANELS	
FOUNDATION = SPREAD CONCRETE FOOTINGS	
SEISMIC RESPONSE COEFFICIENT	$R = 7.0$

MODULE FOUNDATION SYSTEM SHOWN THIS SHEET IS INCLUDED IN THE ON SITE CONTRACT.


ISSUED FOR CONSTRUCTION  
MARCH 2023

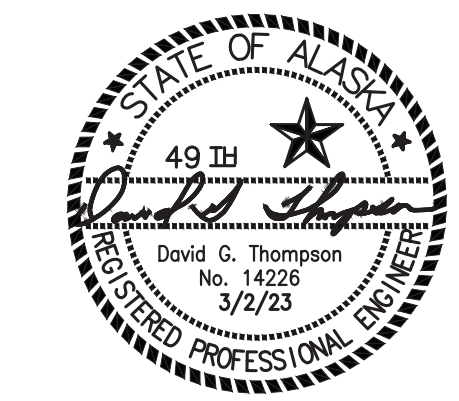


 ALASKA ENERGY AUTHORITY		
PROJECT:	NELSON LAGOON POWER SYSTEM UPGRADE	
TITLE:	FOUNDATION PLAN, CODE ANALYSIS, & STRUCTURAL NOTES	
DRAWN BY: JTD	DESIGNED BY: DGT/BCG	SCALE: AS NOTED
FILE NAME: NELS PP S1-S5	PROJECT NUMBER:	DATE: 3/2/23
P.O. 111405, Anchorage, AK 99511 (907)349-0100		SHEET: S1.1

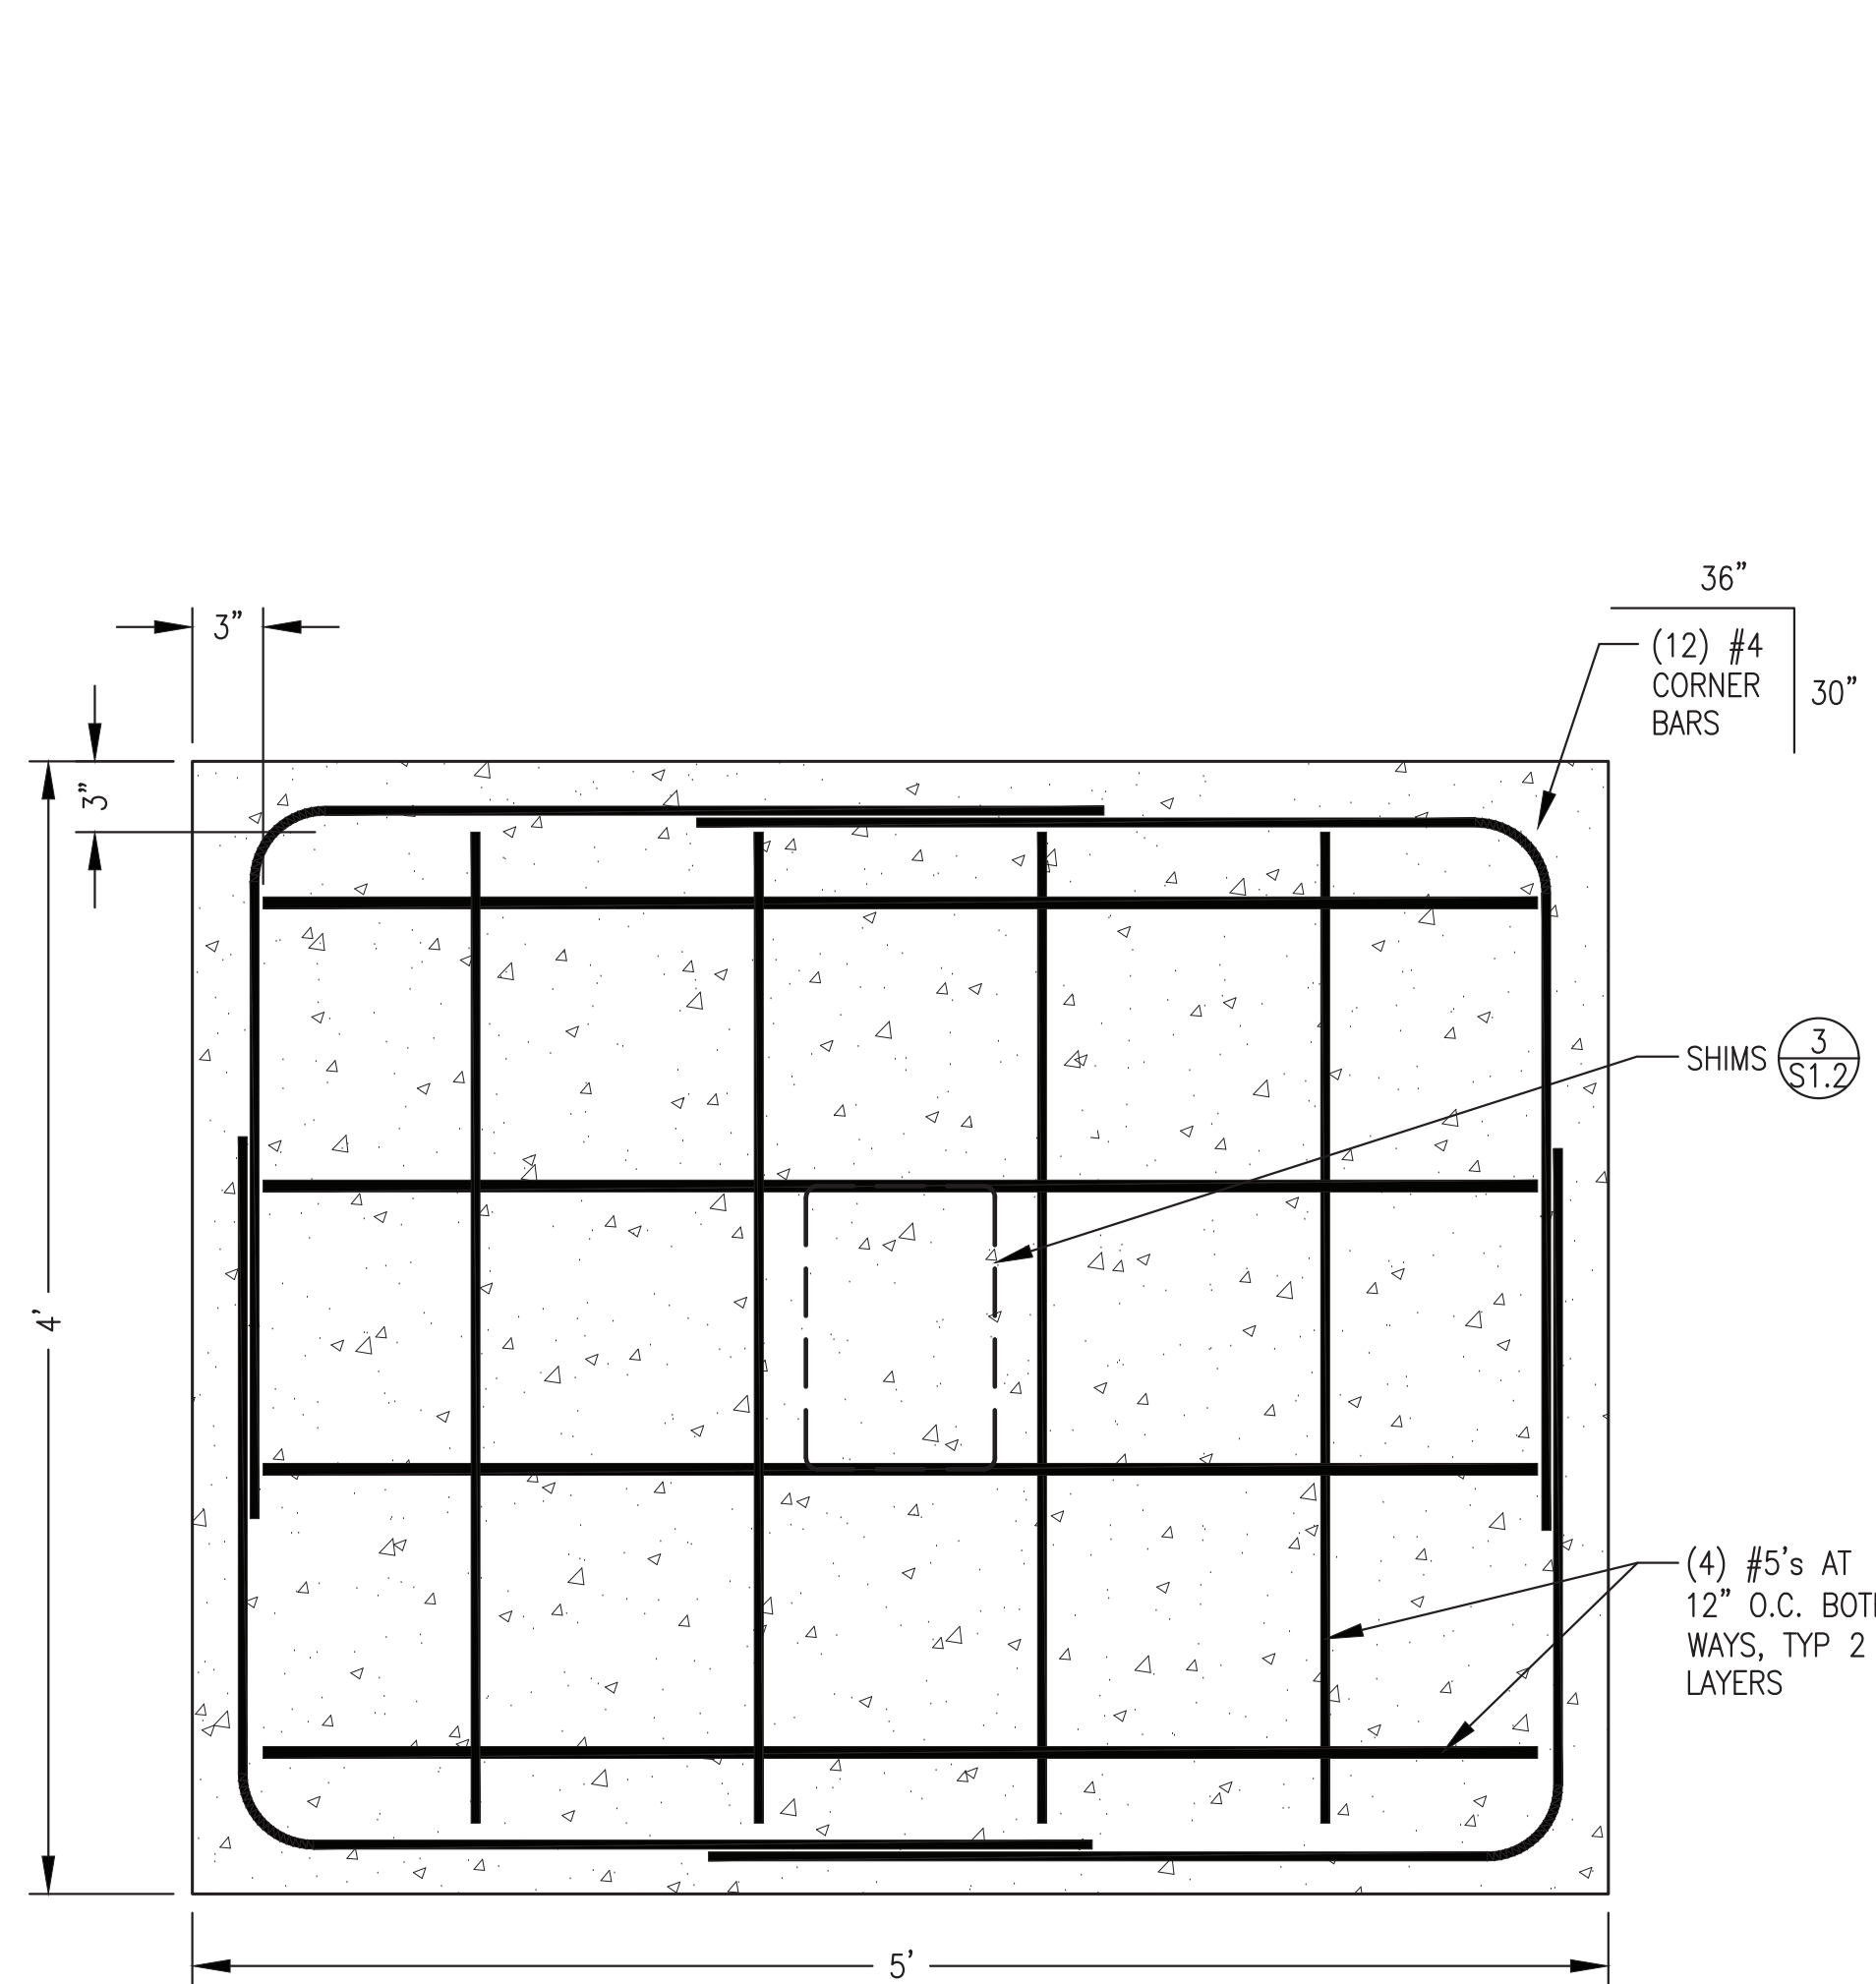


1 FOOTING PLAN  
S1.2 1 1/2"=1'-0"

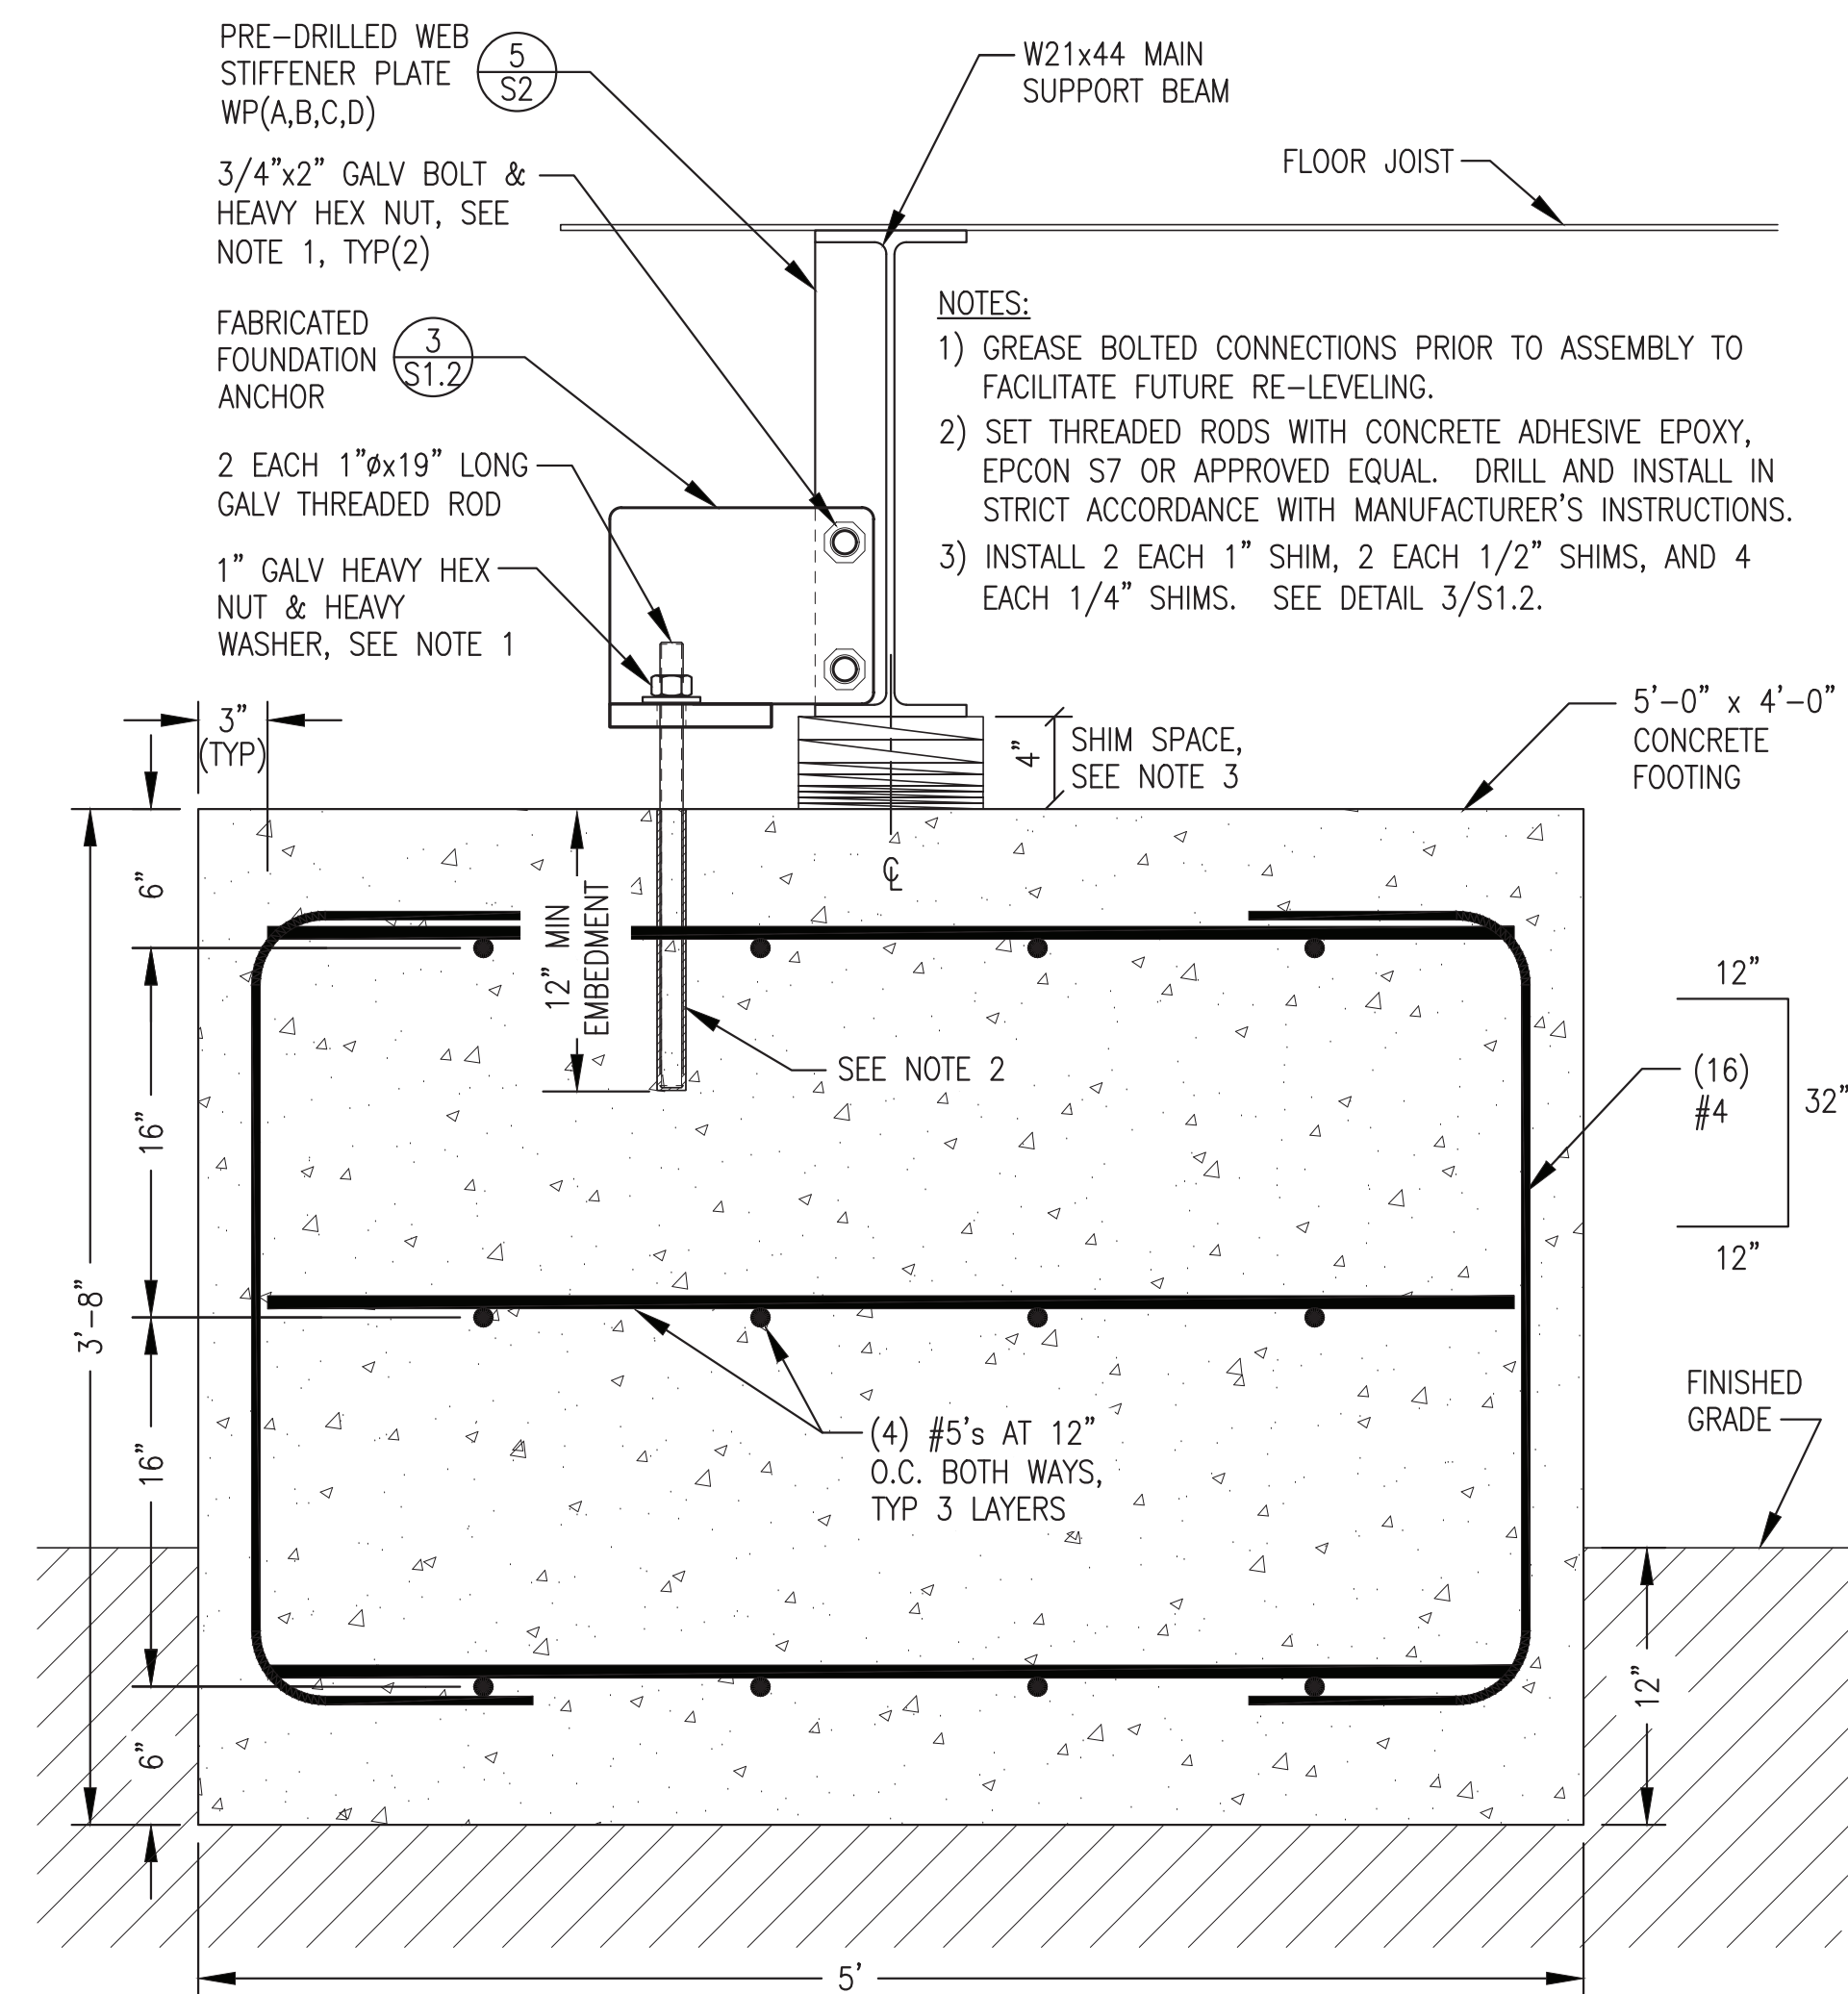


2 SECTION THROUGH FOOTING  
S1.2 1 1/2"=1'-0"

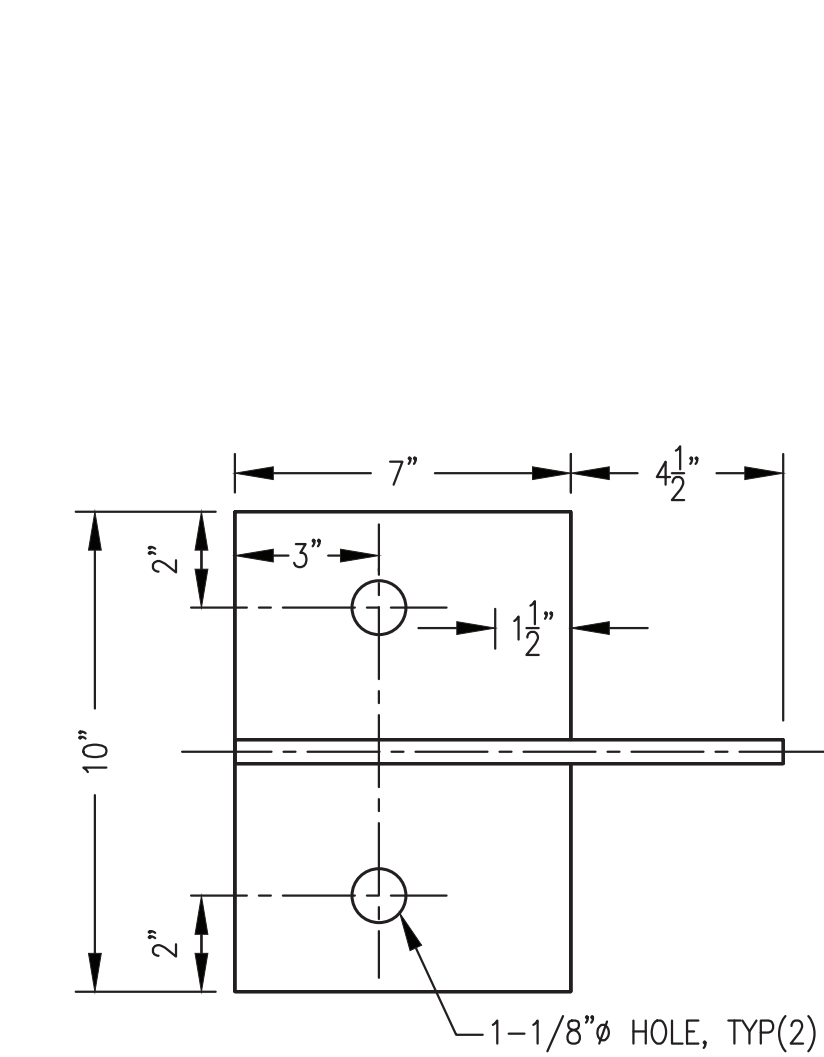

SECTION A-A

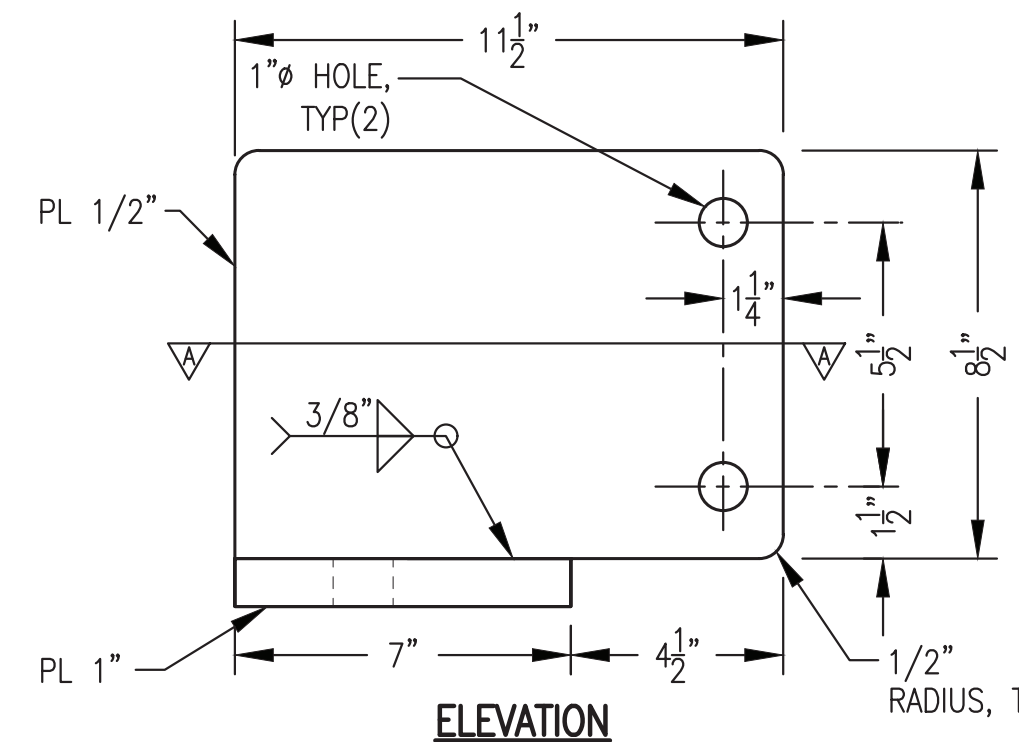

3 TYPICAL FOUNDATION ANCHOR & SHIM FABRICATION  
S1.2 3\"/>

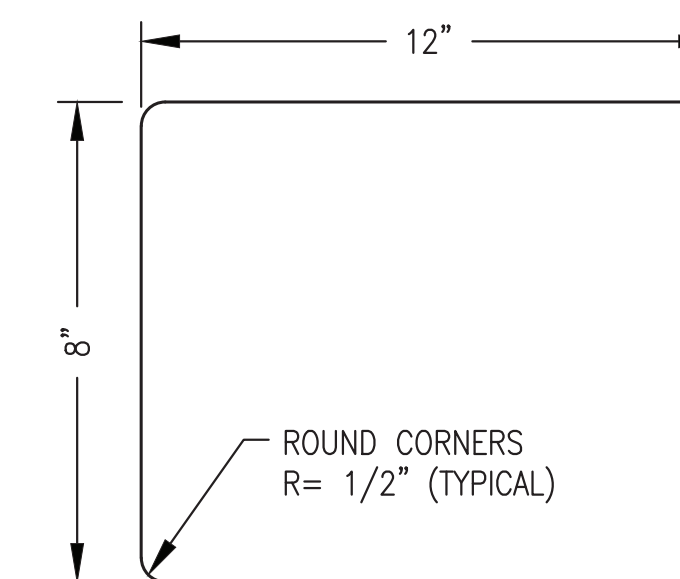

TYPICAL SHIM


SHIM FABRICATION TABLE		
THICKNESS	QUANTITY	MATERIAL
1/4"	16	GALV STEEL
1/2"	8	GALV STEEL
1"	8	GALV STEEL

ANCHOR & SHIM FABRICATION NOTES:


- FABRICATE FOUR IDENTICAL ANCHOR ASSEMBLIES. DO NOT SHEAR ANCHOR PLATES. CUT WITH WATER JET, TORCH, OR SAW.
- FABRICATE FROM ASTM A-36 STEEL PLATE.
- MAKE ALL JOINTS AND CONNECTIONS WITH CONTINUOUS GROOVE OR FILLET WELDS.
- FABRICATE SHIMS OF QUANTITY AND THICKNESS AS DESCRIBED IN SHIM FABRICATION TABLE.
- UPON COMPLETION OF FABRICATION ROUND ALL OUTSIDE CORNERS AND GRIND ALL EDGES SMOOTH.
- SAND BLAST ALL PIECES TO SSPC-SP-6. COAT WITH 3 COATS OF COLD GALVANIZING COMPOUND, ZRC OR APPROVED EQUAL TO 9 MILS MINIMUM DRY FILM THICKNESS.

MODULE FOUNDATION SYSTEM SHOWN THIS SHEET IS INCLUDED IN THE ON SITE CONTRACT. NOTE THAT FABRICATED FOUNDATION ANCHOR AND SHIMS WERE PREVIOUSLY FABRICATED AND ARE INCLUDED WITH THE OWNER FURNISHED MODULE.

ISSUED FOR CONSTRUCTION  
MARCH 2023

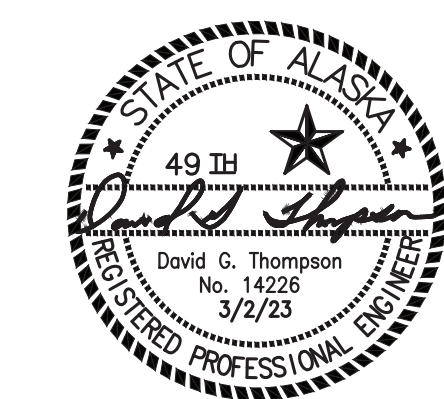


PROJECT: NELSON LAGOON POWER SYSTEM UPGRADE		
TITLE: FOUNDATION DETAILS		
DRAWN BY: JTD	SCALE: AS NOTED	DESIGNED BY: DGT/BCG
FILE NAME: NELS PP S1-S5	PROJECT NUMBER:	DATE: 3/2/23
P.O. 111405, Anchorage, AK 99511 (907)349-0100		SHEET: <b>S1.2</b>

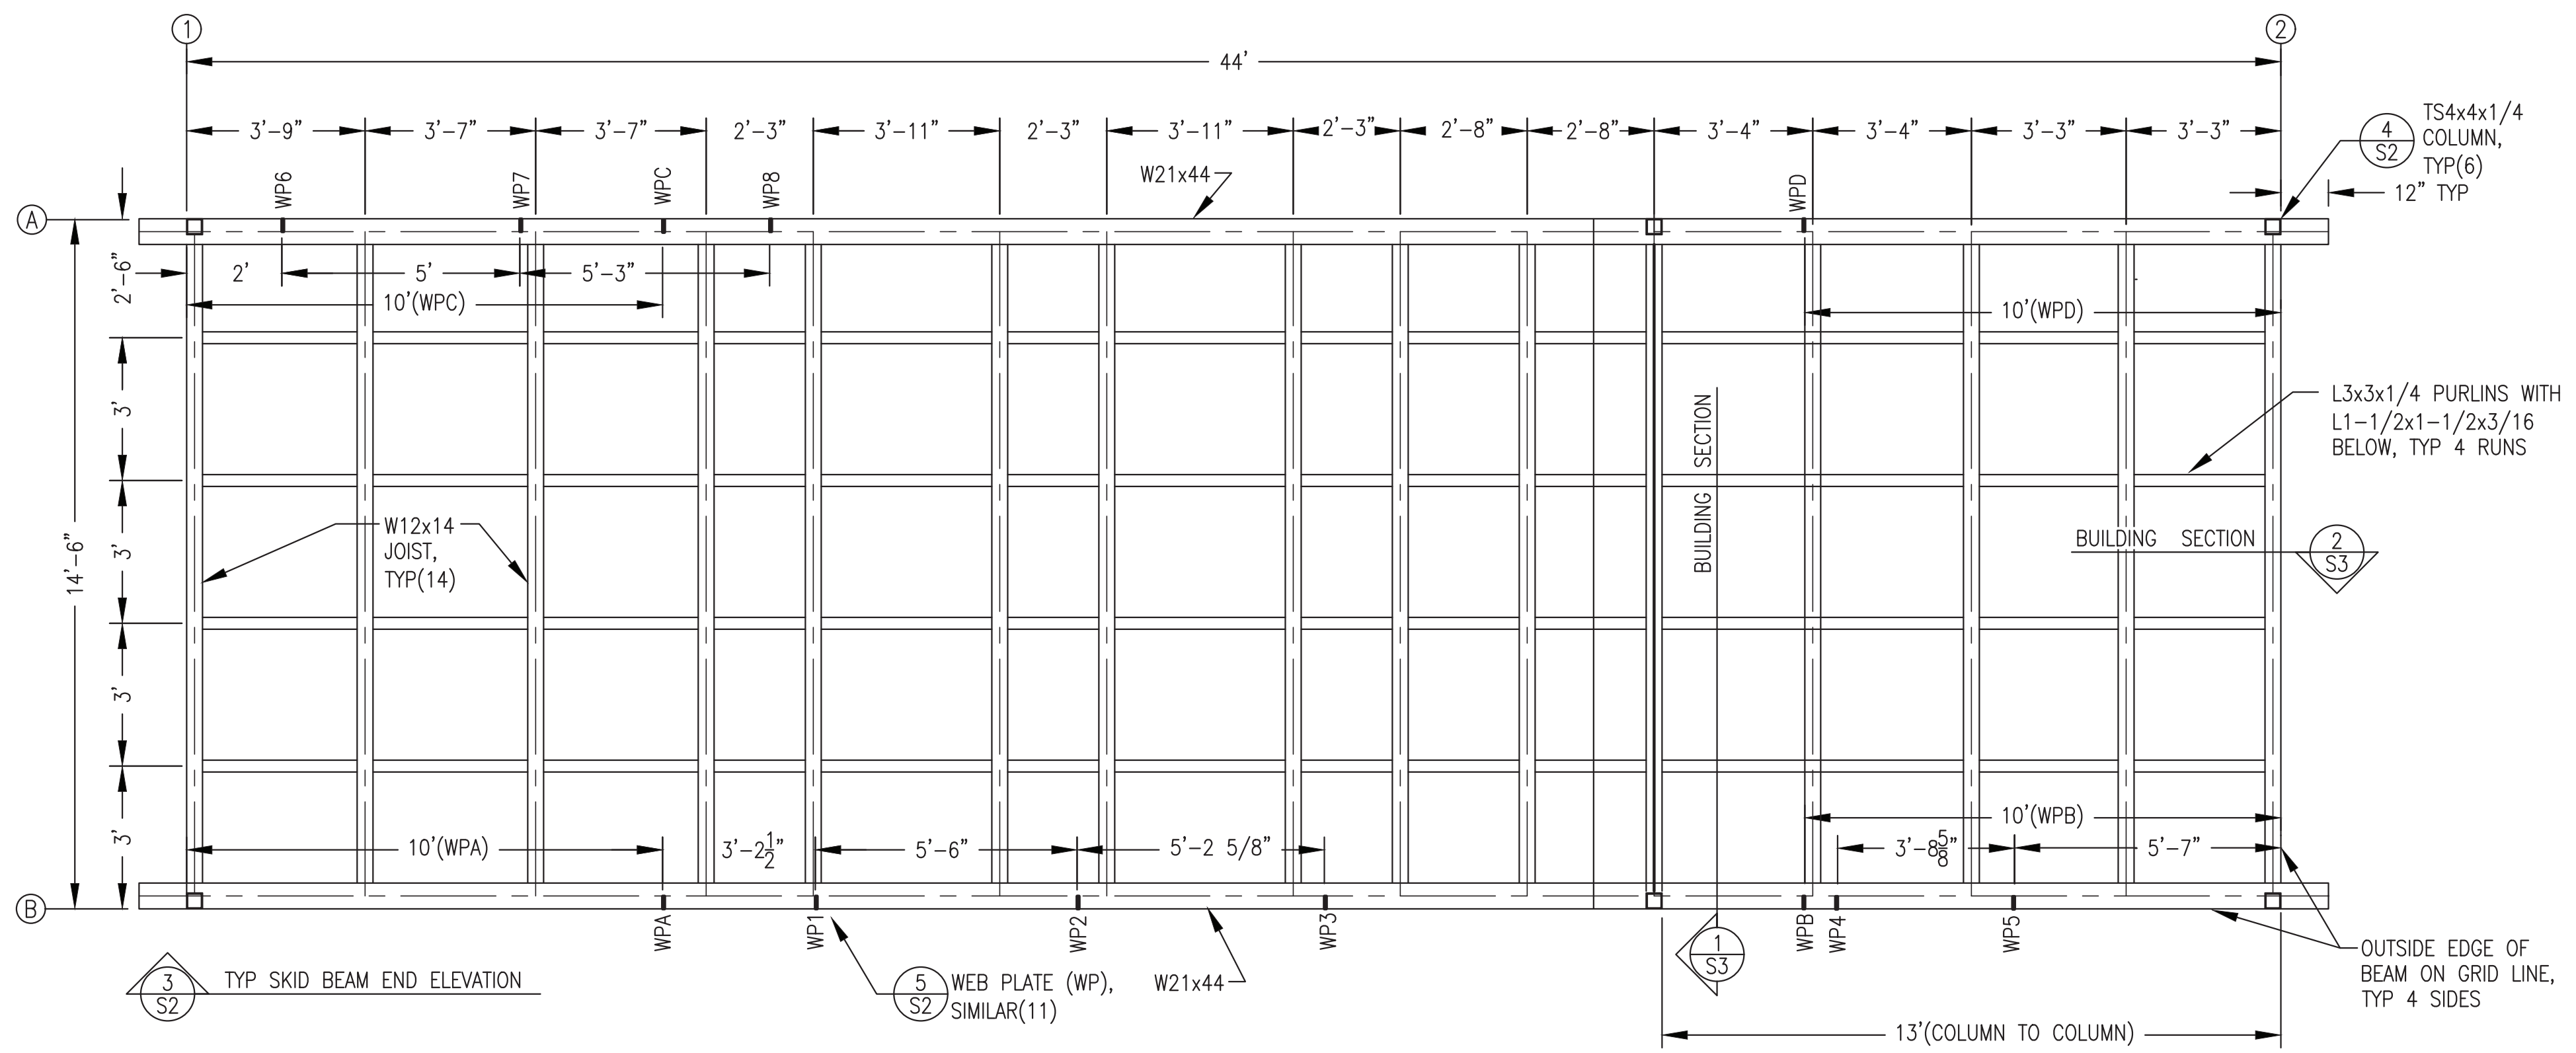


NOTES: 1) FABRICATE FLOOR AND PAN DECKS USING SHEETS CUT SO THAT ALL JOINTS ARE CENTERED ON PURLINS AND/OR JOISTS.  
 2) SEE MECHANICAL SUPPORT PLAN M2.2 FOR GENERATOR SUPPORT PEDESTAL LOCATIONS AND FABRICATION.

**1 FLOOR FRAMING PLAN**  
 S2 3/8"=1'-0"

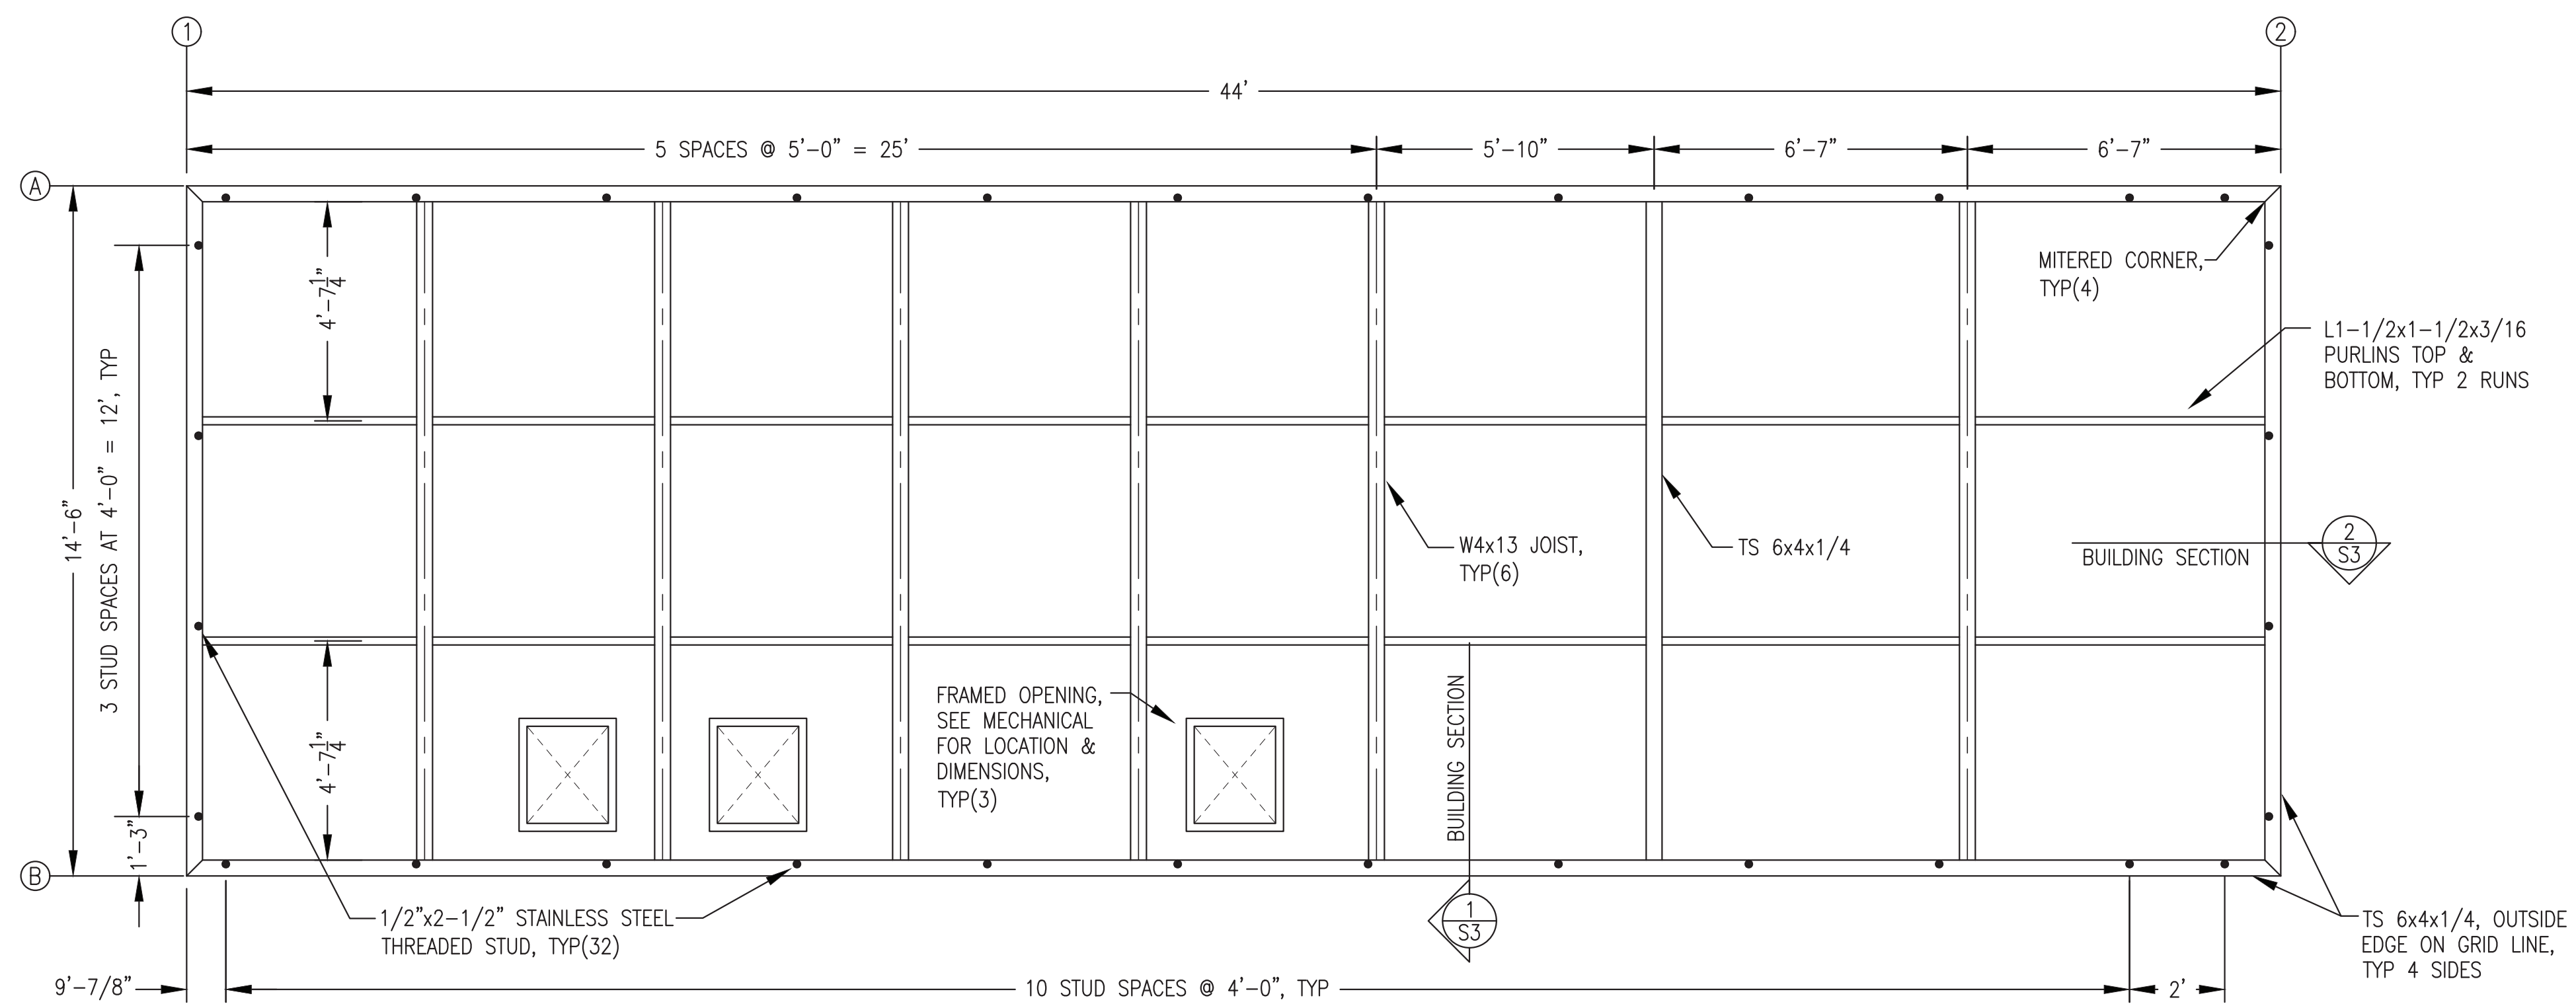


NOTES: 1) FABRICATE CEILING FLAT AND CORRUGATED DECKS USING SHEETS CUT SO THAT ALL JOINTS ARE CENTERED ON PURLINS AND/OR JOISTS.  
 2) SEE MECHANICAL SUPPORT PLAN M2.3 FOR CEILING CORRUGATION LAYOUT AND STRUT SUPPORT LOCATION AND INSTALLATION.  
 3) PROVIDE ADDITIONAL L1-1/2" BOTTOM PURLINS AGAINST PERIMETER TS AS REQUIRED FOR CEILING PLATE SUPPORT.


**2 CEILING FRAMING PLAN**  
 S2 3/8"=1'-0"

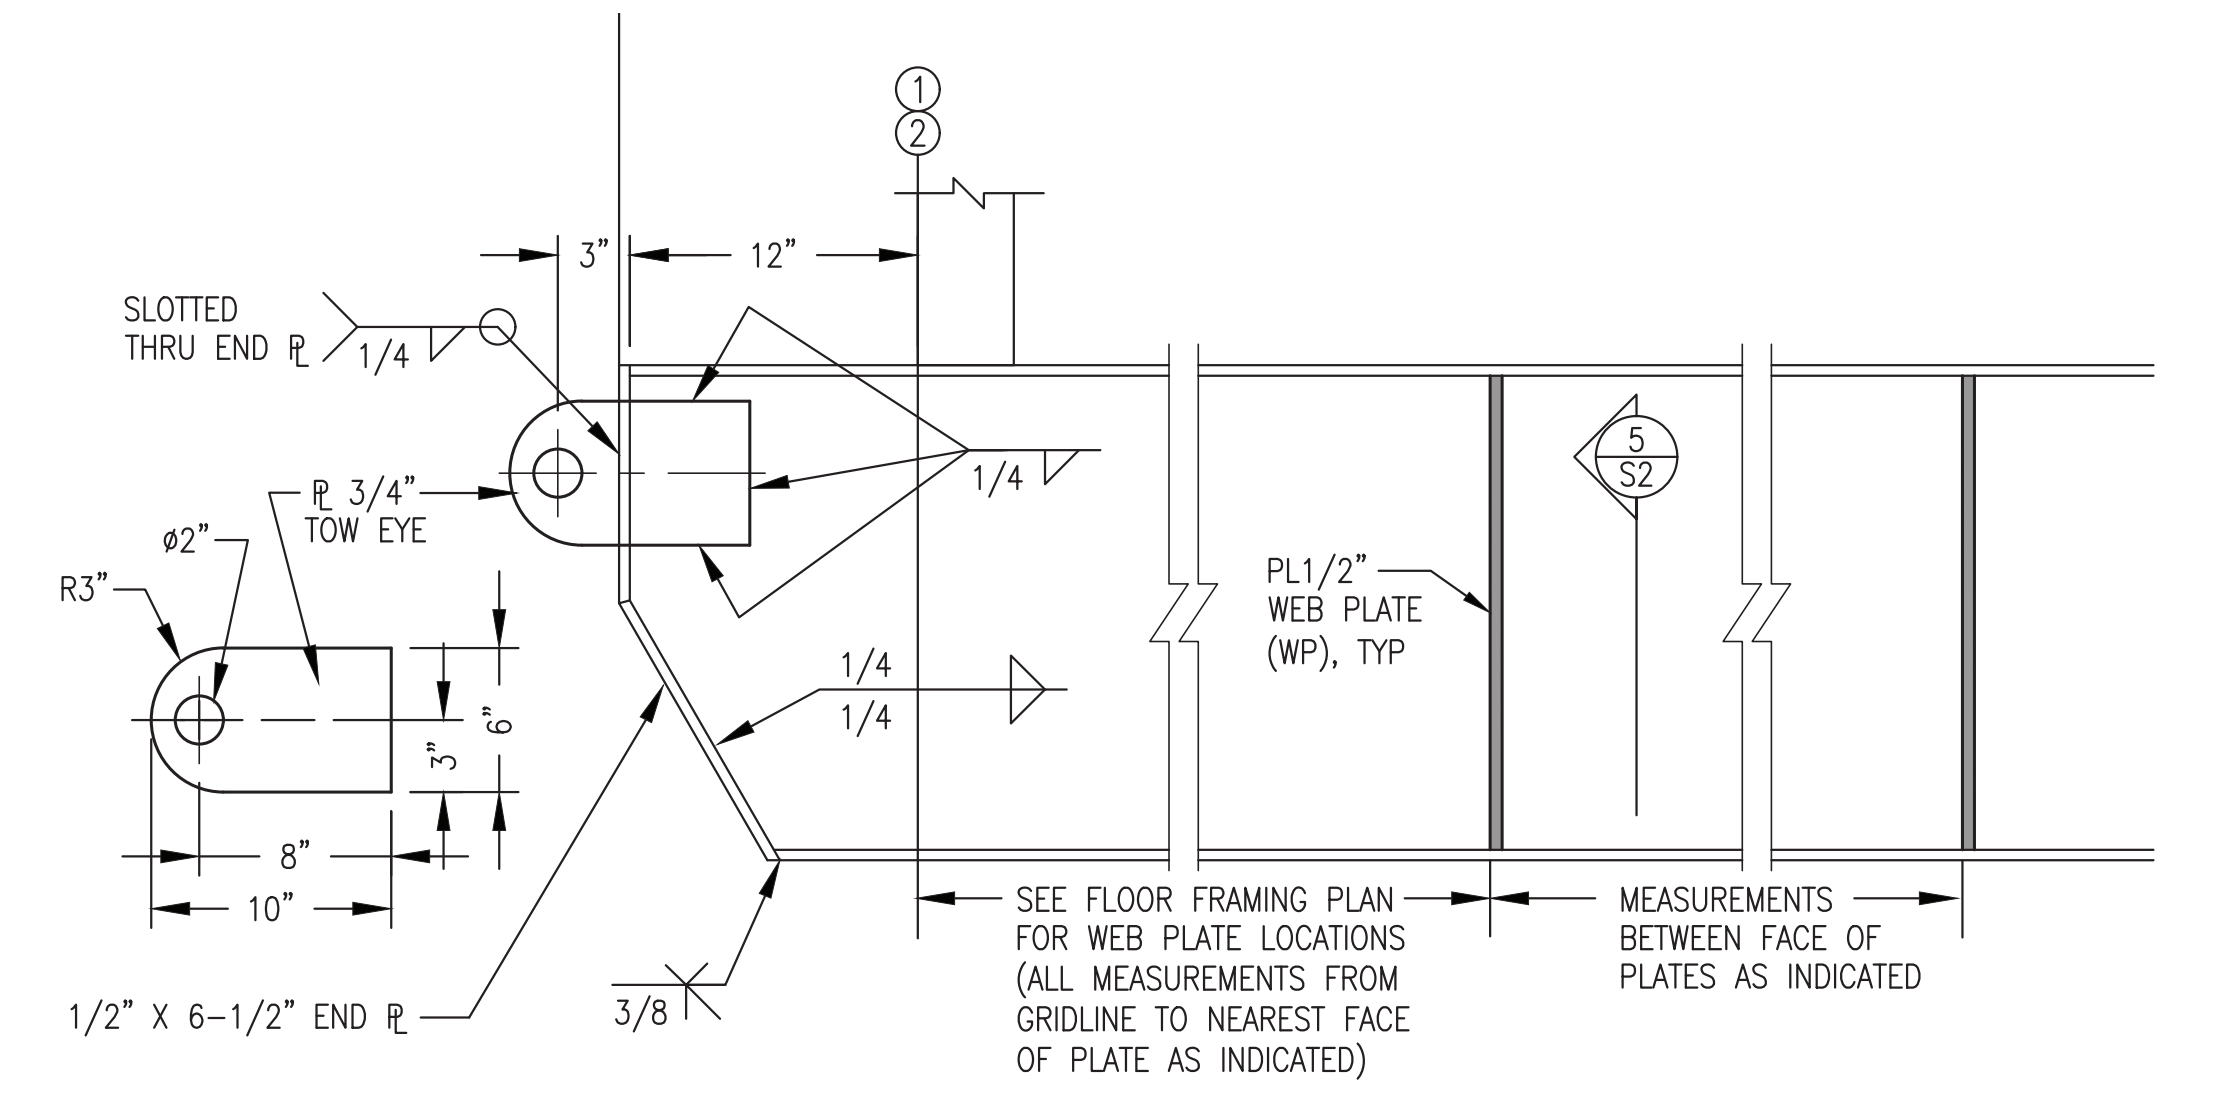

**3 TYPICAL SKID BEAM END ELEVATION**  
 S2 1-1/2"=1'-0"

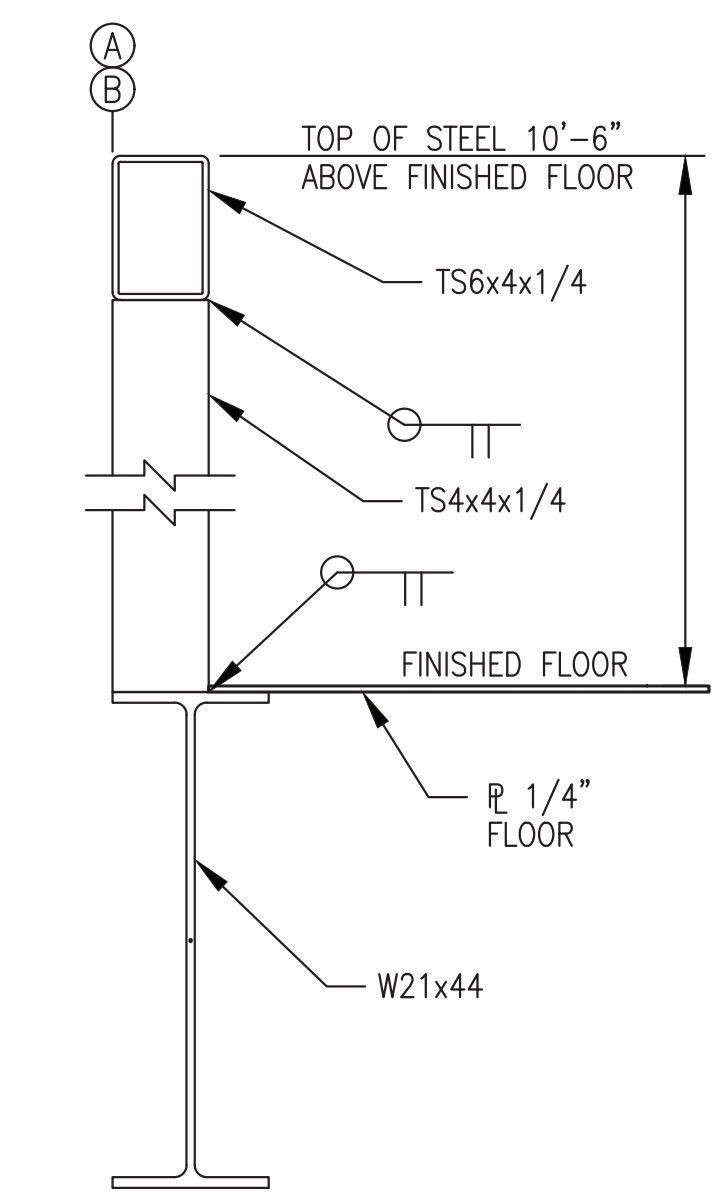

**4 TYP CORNER COLUMN**  
 S2 1-1/2"=1'-0"

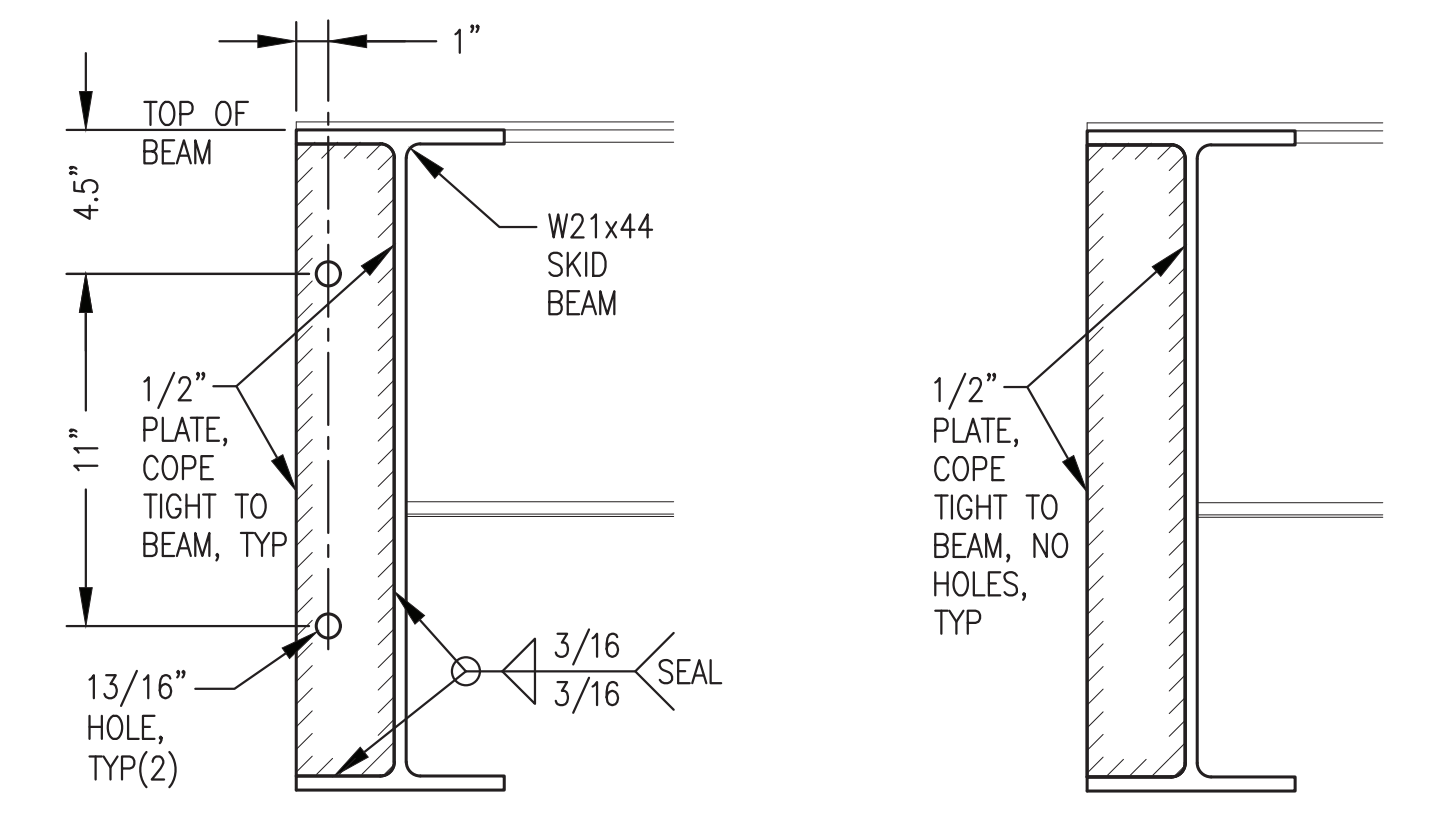

**5 TYPICAL WEB PLATE (WP)**  
 S2 2"=1'-0"


NOTE: DO NOT SHEAR WEB PLATES. CUT WITH WATER JET, TORCH, OR SAW.

ALL WORK ON THIS SHEET WAS PERFORMED AS PART OF THE PRIOR MODULE FABRICATION CONTRACT AND IS SHOWN HERE FOR REFERENCE ONLY.

ISSUED FOR CONSTRUCTION  
 MARCH 2023




 ALASKA ENERGY AUTHORITY	
PROJECT: NELSON LAGOON POWER SYSTEM UPGRADE	
TITLE: MODULE FRAMING PLANS & DETAILS	
DRAWN BY: JTD DESIGNED BY: DGT/BCC FILE NAME: NELS PP S1-S5 PROJECT NUMBER:	SCALE: AS NOTED DATE: 3/2/23 SHEET: S2
P.O. 111405, Anchorage, AK 99511 (907)349-0100  Gray Stassel Engineering, Inc.	

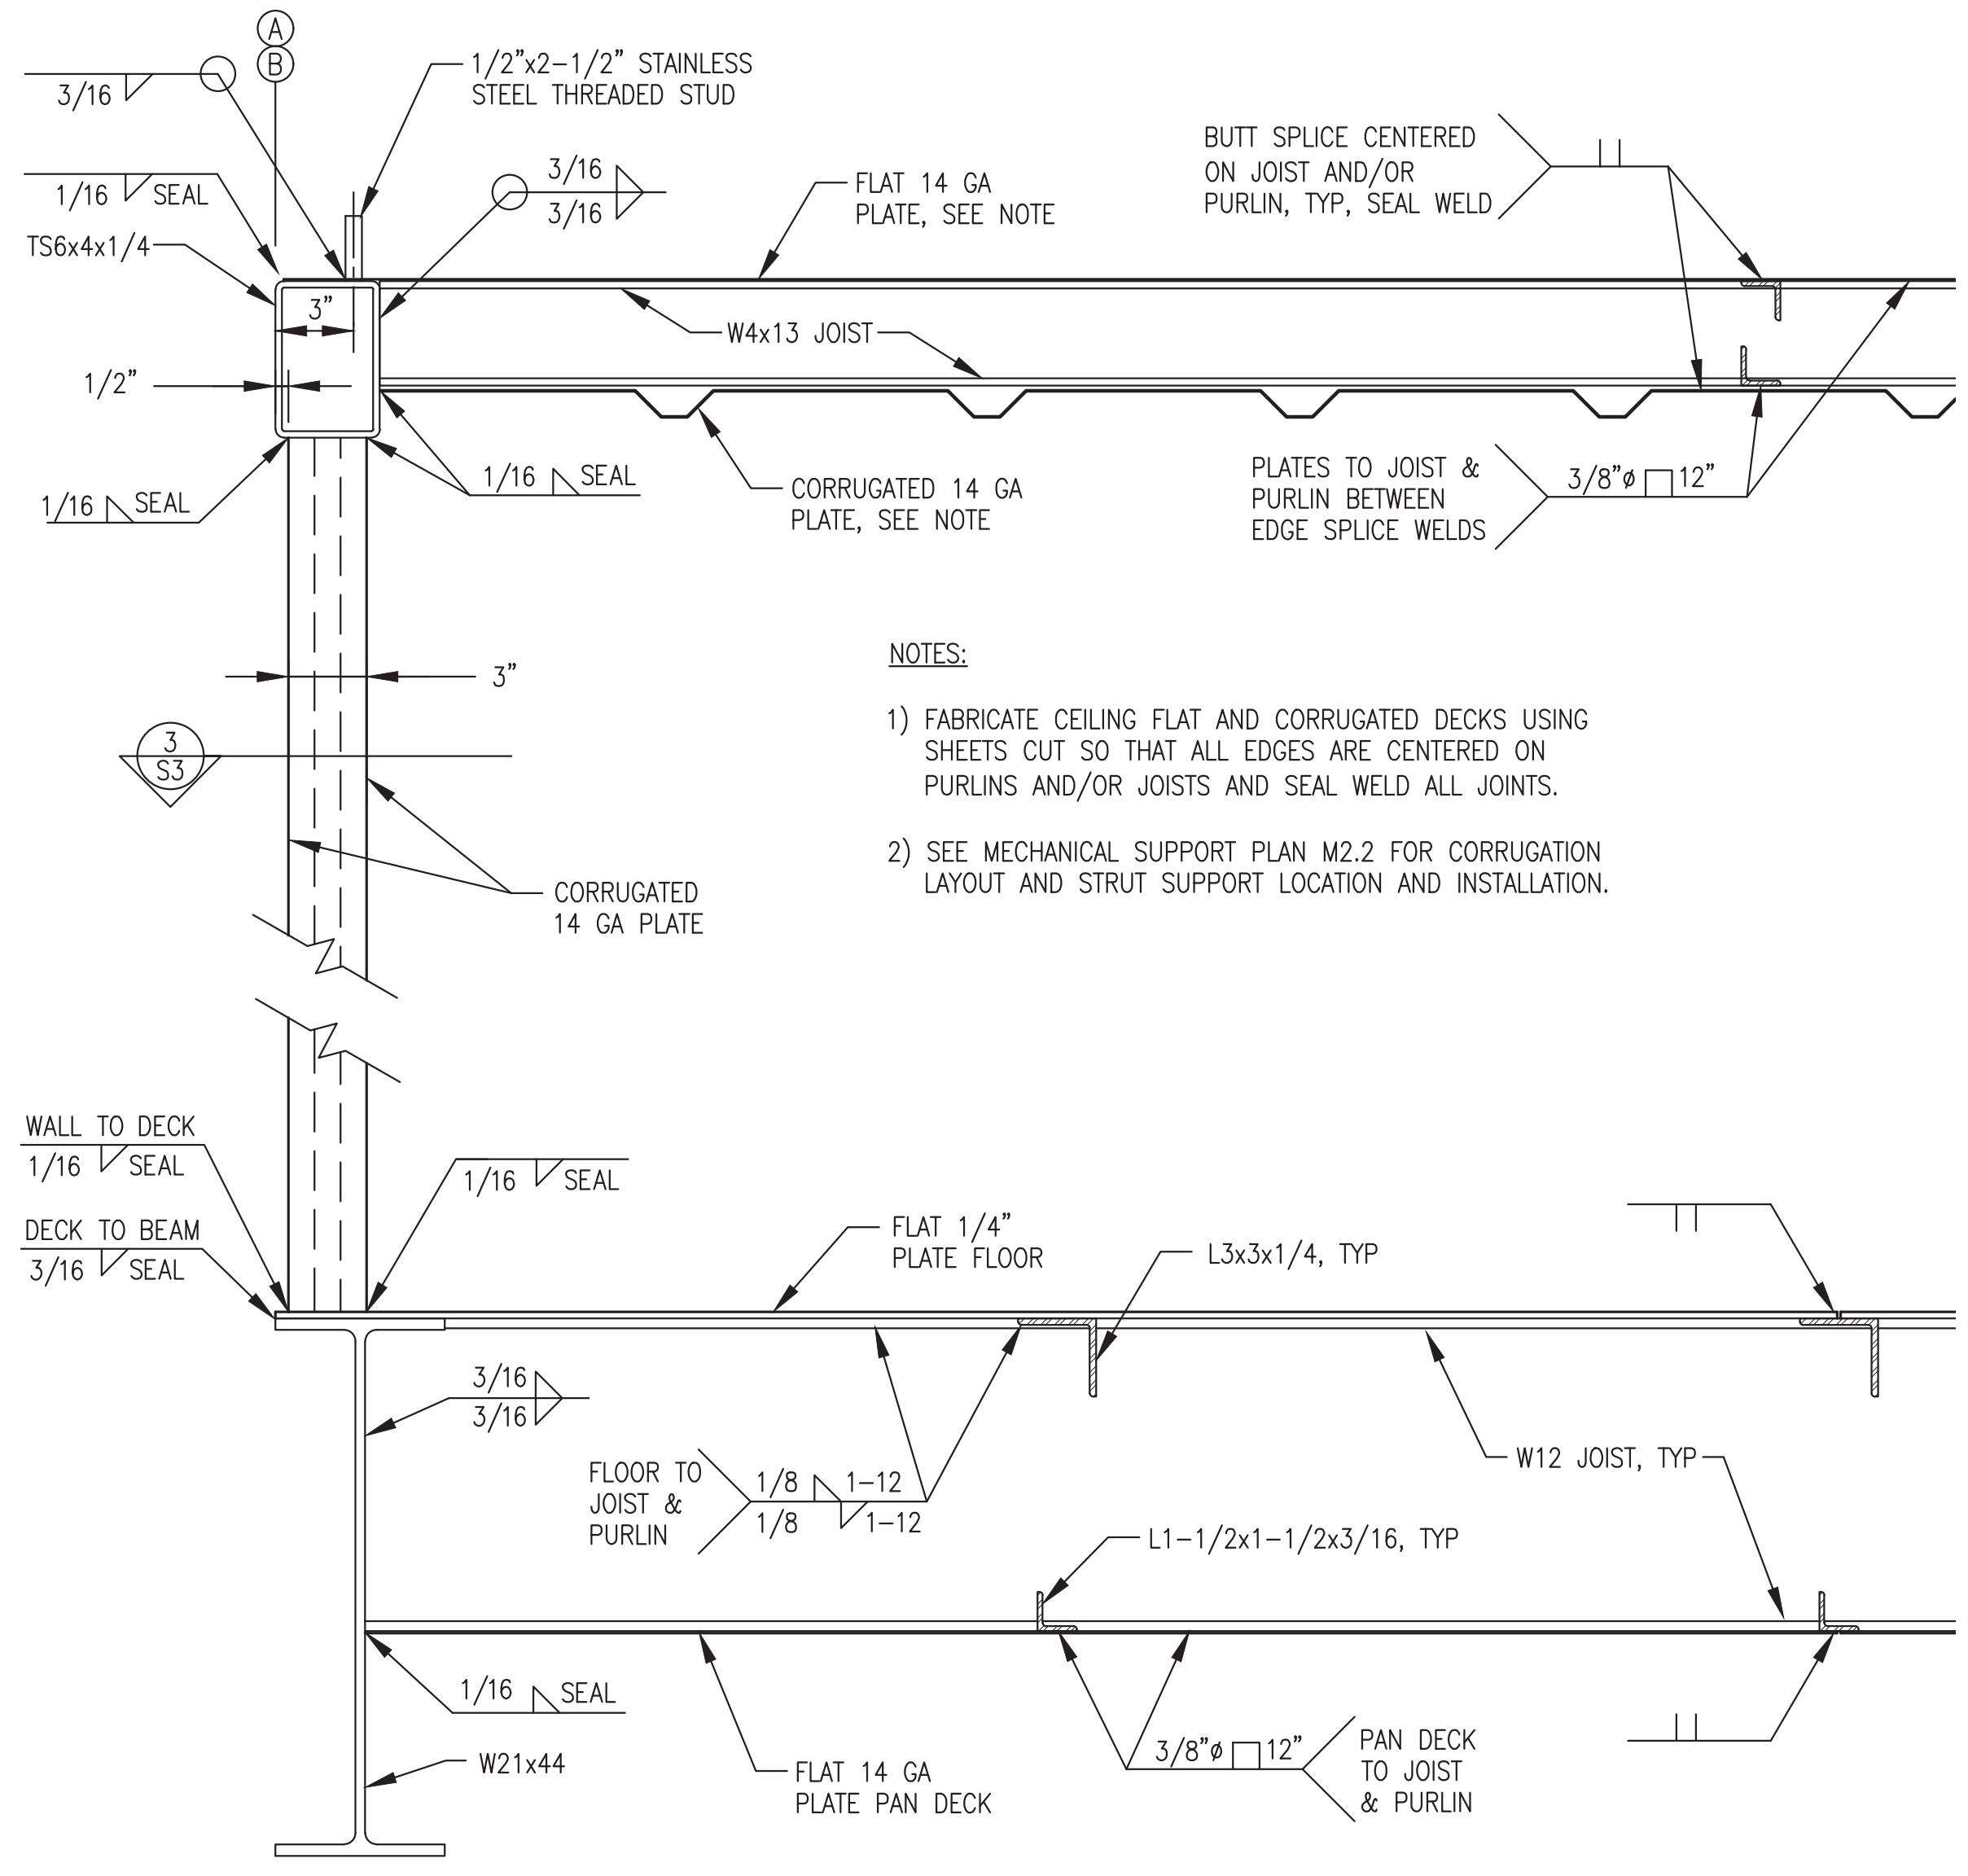


- NOTES:
- 1) FABRICATE CEILING FLAT AND CORRUGATED DECKS USING SHEETS CUT SO THAT ALL EDGES ARE CENTERED ON PURLINS AND/OR JOISTS AND SEAL WELD ALL JOINTS.
  - 2) SEE MECHANICAL SUPPORT PLAN M2.2 FOR CORRUGATION LAYOUT AND STRUT SUPPORT LOCATION AND INSTALLATION.


1 TYPICAL BUILDING SECTION  
S3 2"=1'-0"

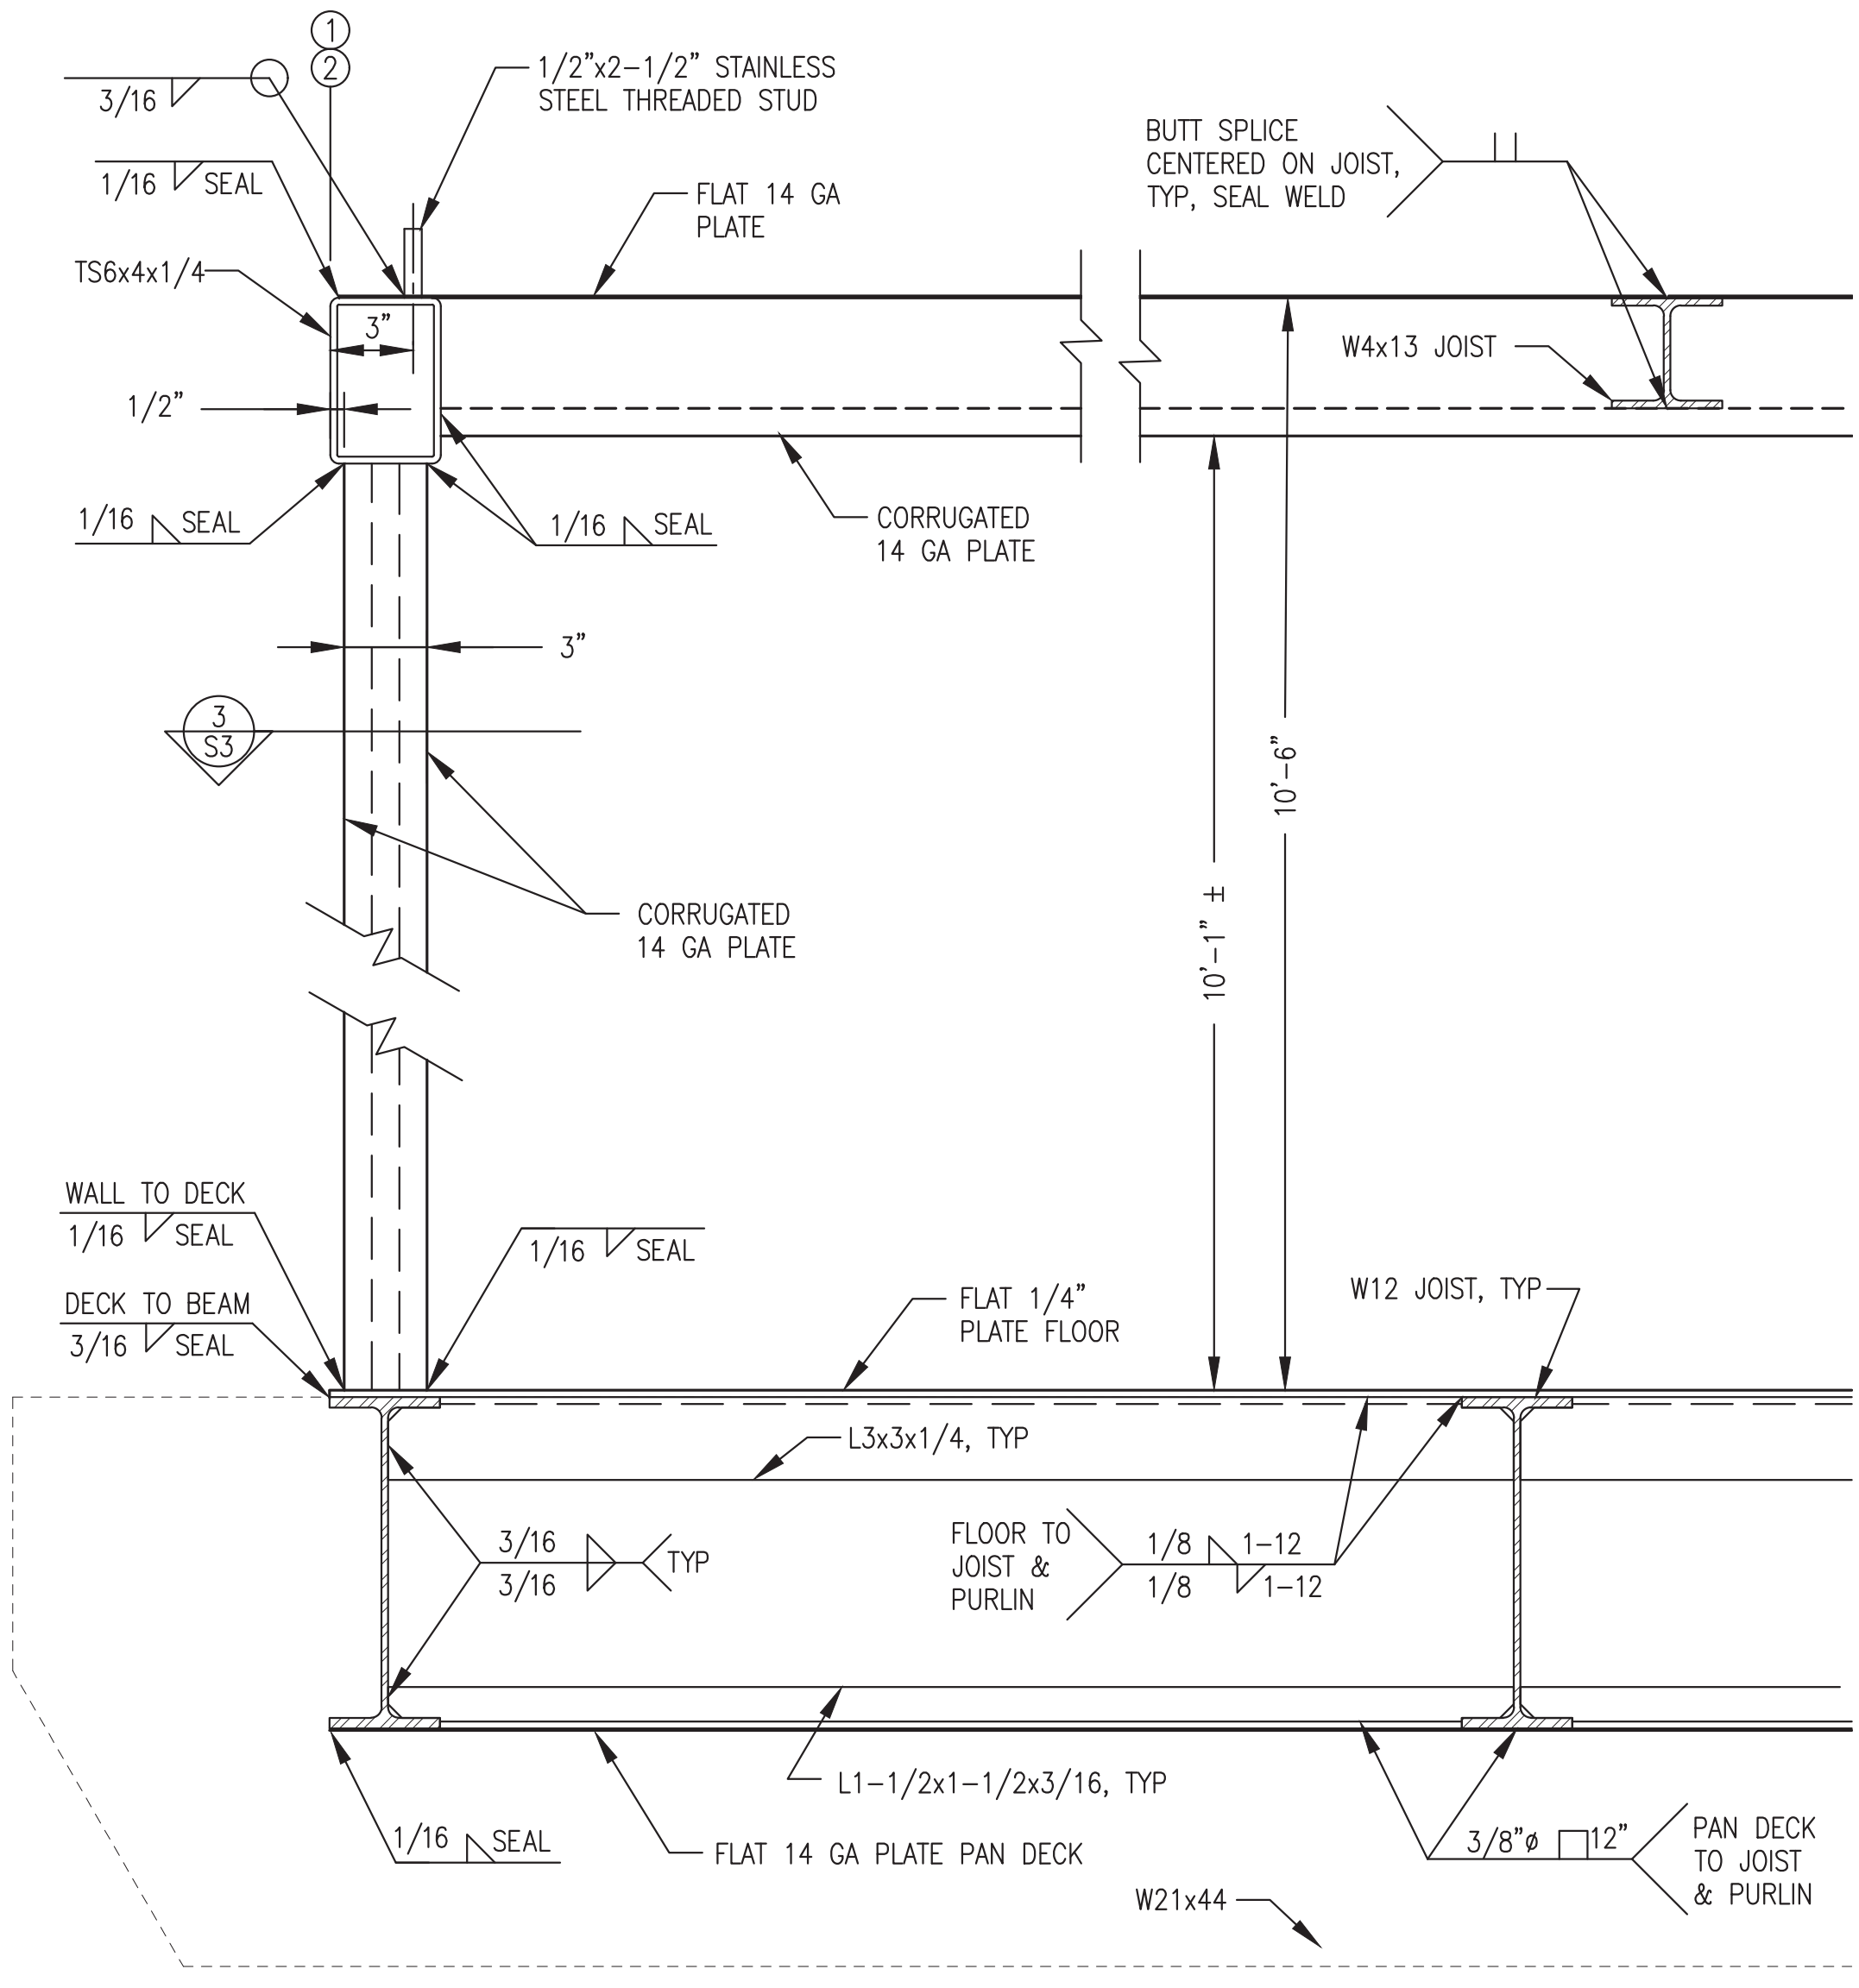

2 TYPICAL BUILDING SECTION  
S3 2"=1'-0"

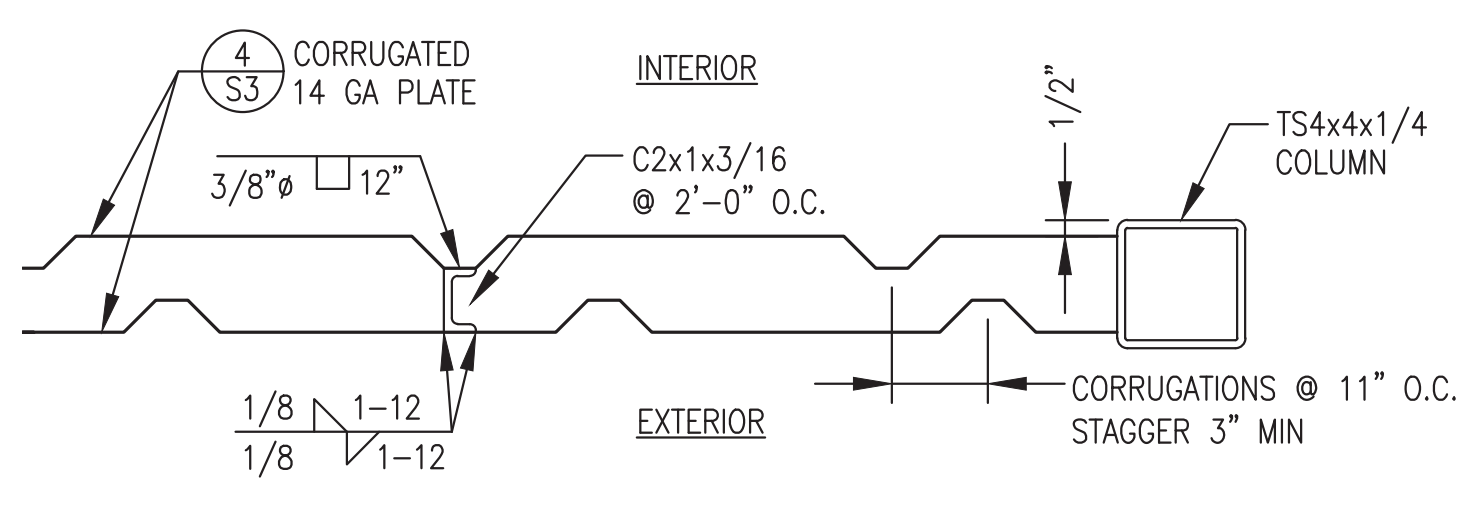


3 TYPICAL EXTERIOR WALL - PLAN VIEW  
S3 2"=1'-0"

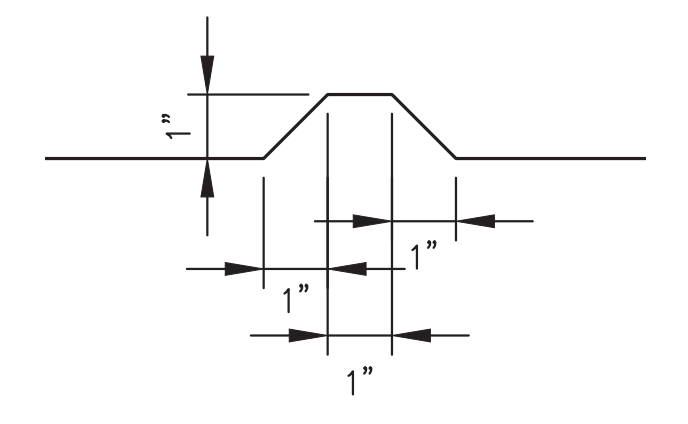


4 TYPICAL CORRUGATION  
S3 4"=1'-0"

ALL WORK ON THIS SHEET WAS PERFORMED AS PART OF THE PRIOR MODULE FABRICATION CONTRACT AND IS SHOWN HERE FOR REFERENCE ONLY.


ISSUED FOR CONSTRUCTION  
MARCH 2023

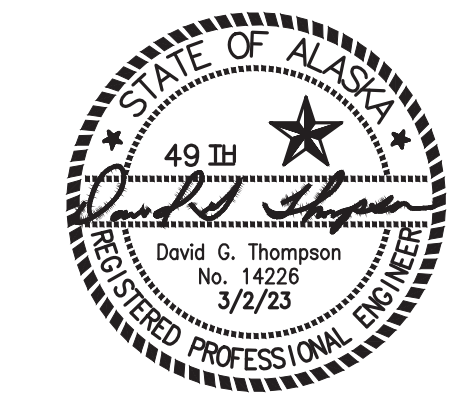


ALASKA ENERGY AUTHORITY		
PROJECT:	NELSON LAGOON POWER SYSTEM UPGRADE	
TITLE:	MODULE SECTIONS DETAILS	
DRAWN BY: JTD	SCALE: AS NOTED	
DESIGNED BY: DGT/BCG	DATE: 3/2/23	
FILE NAME: NELS_PP_S1-S5	SHEET:	S3
P.O. 111405, Anchorage, AK 99511 (907)349-0100	PROJECT NUMBER:	

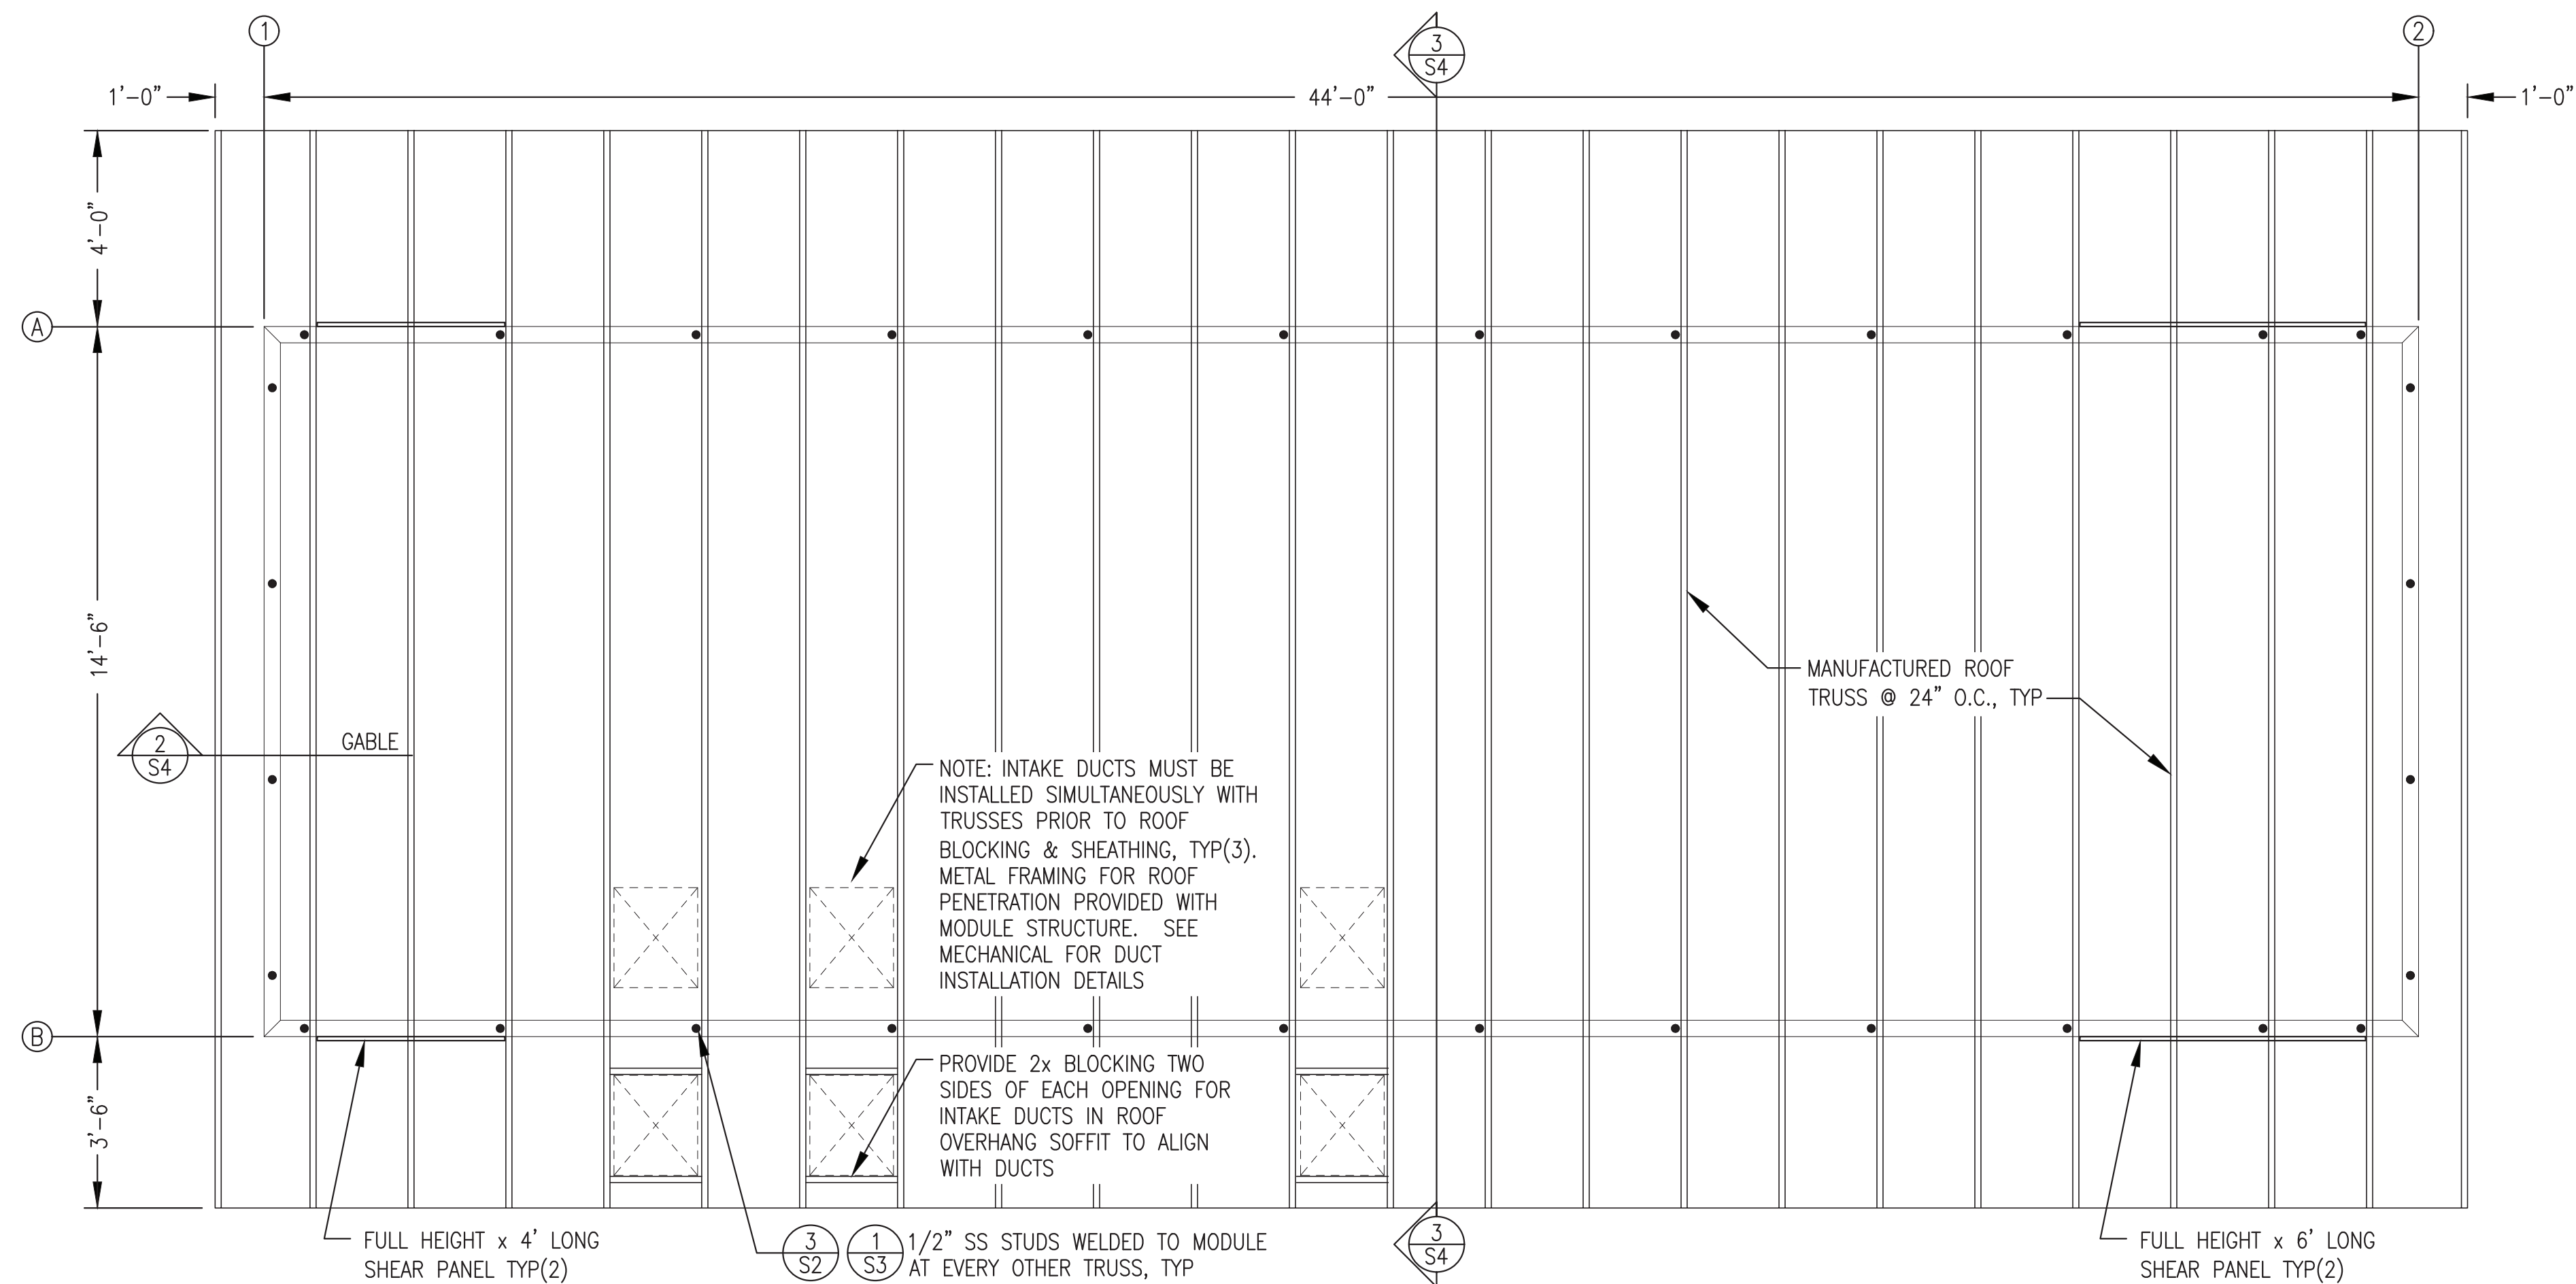

**1**  
S4  
ROOF FRAMING PLAN  
3/8"=1'-0"

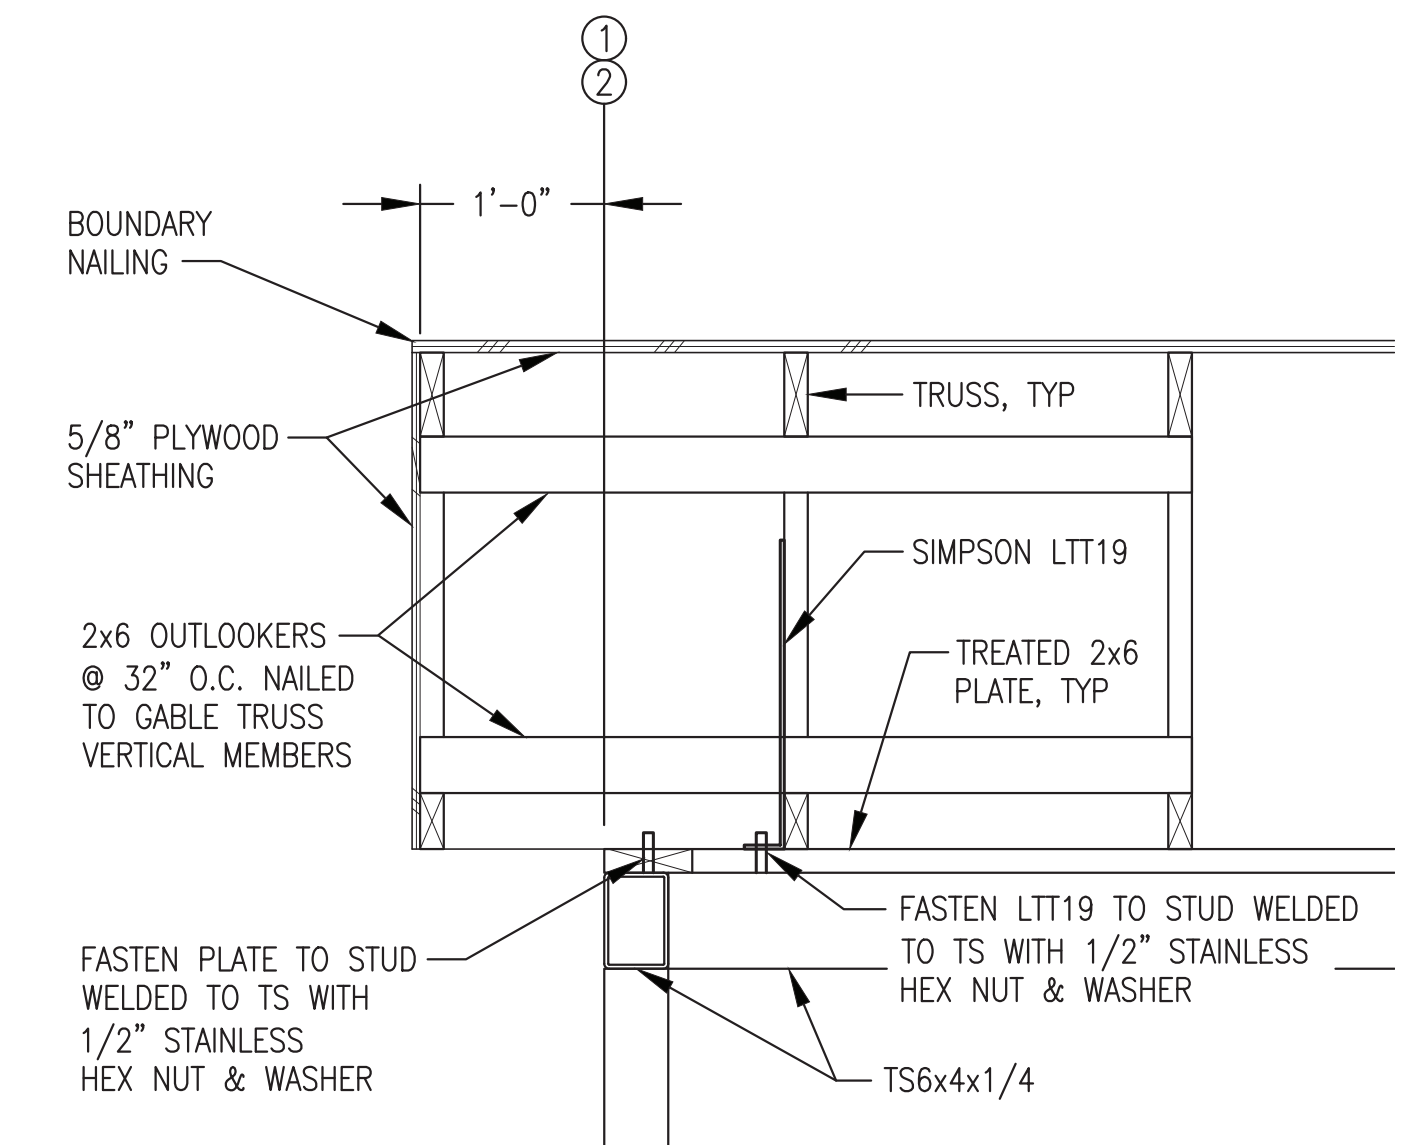


**2**  
S4  
TYPICAL GABLE  
1"=1'-0"

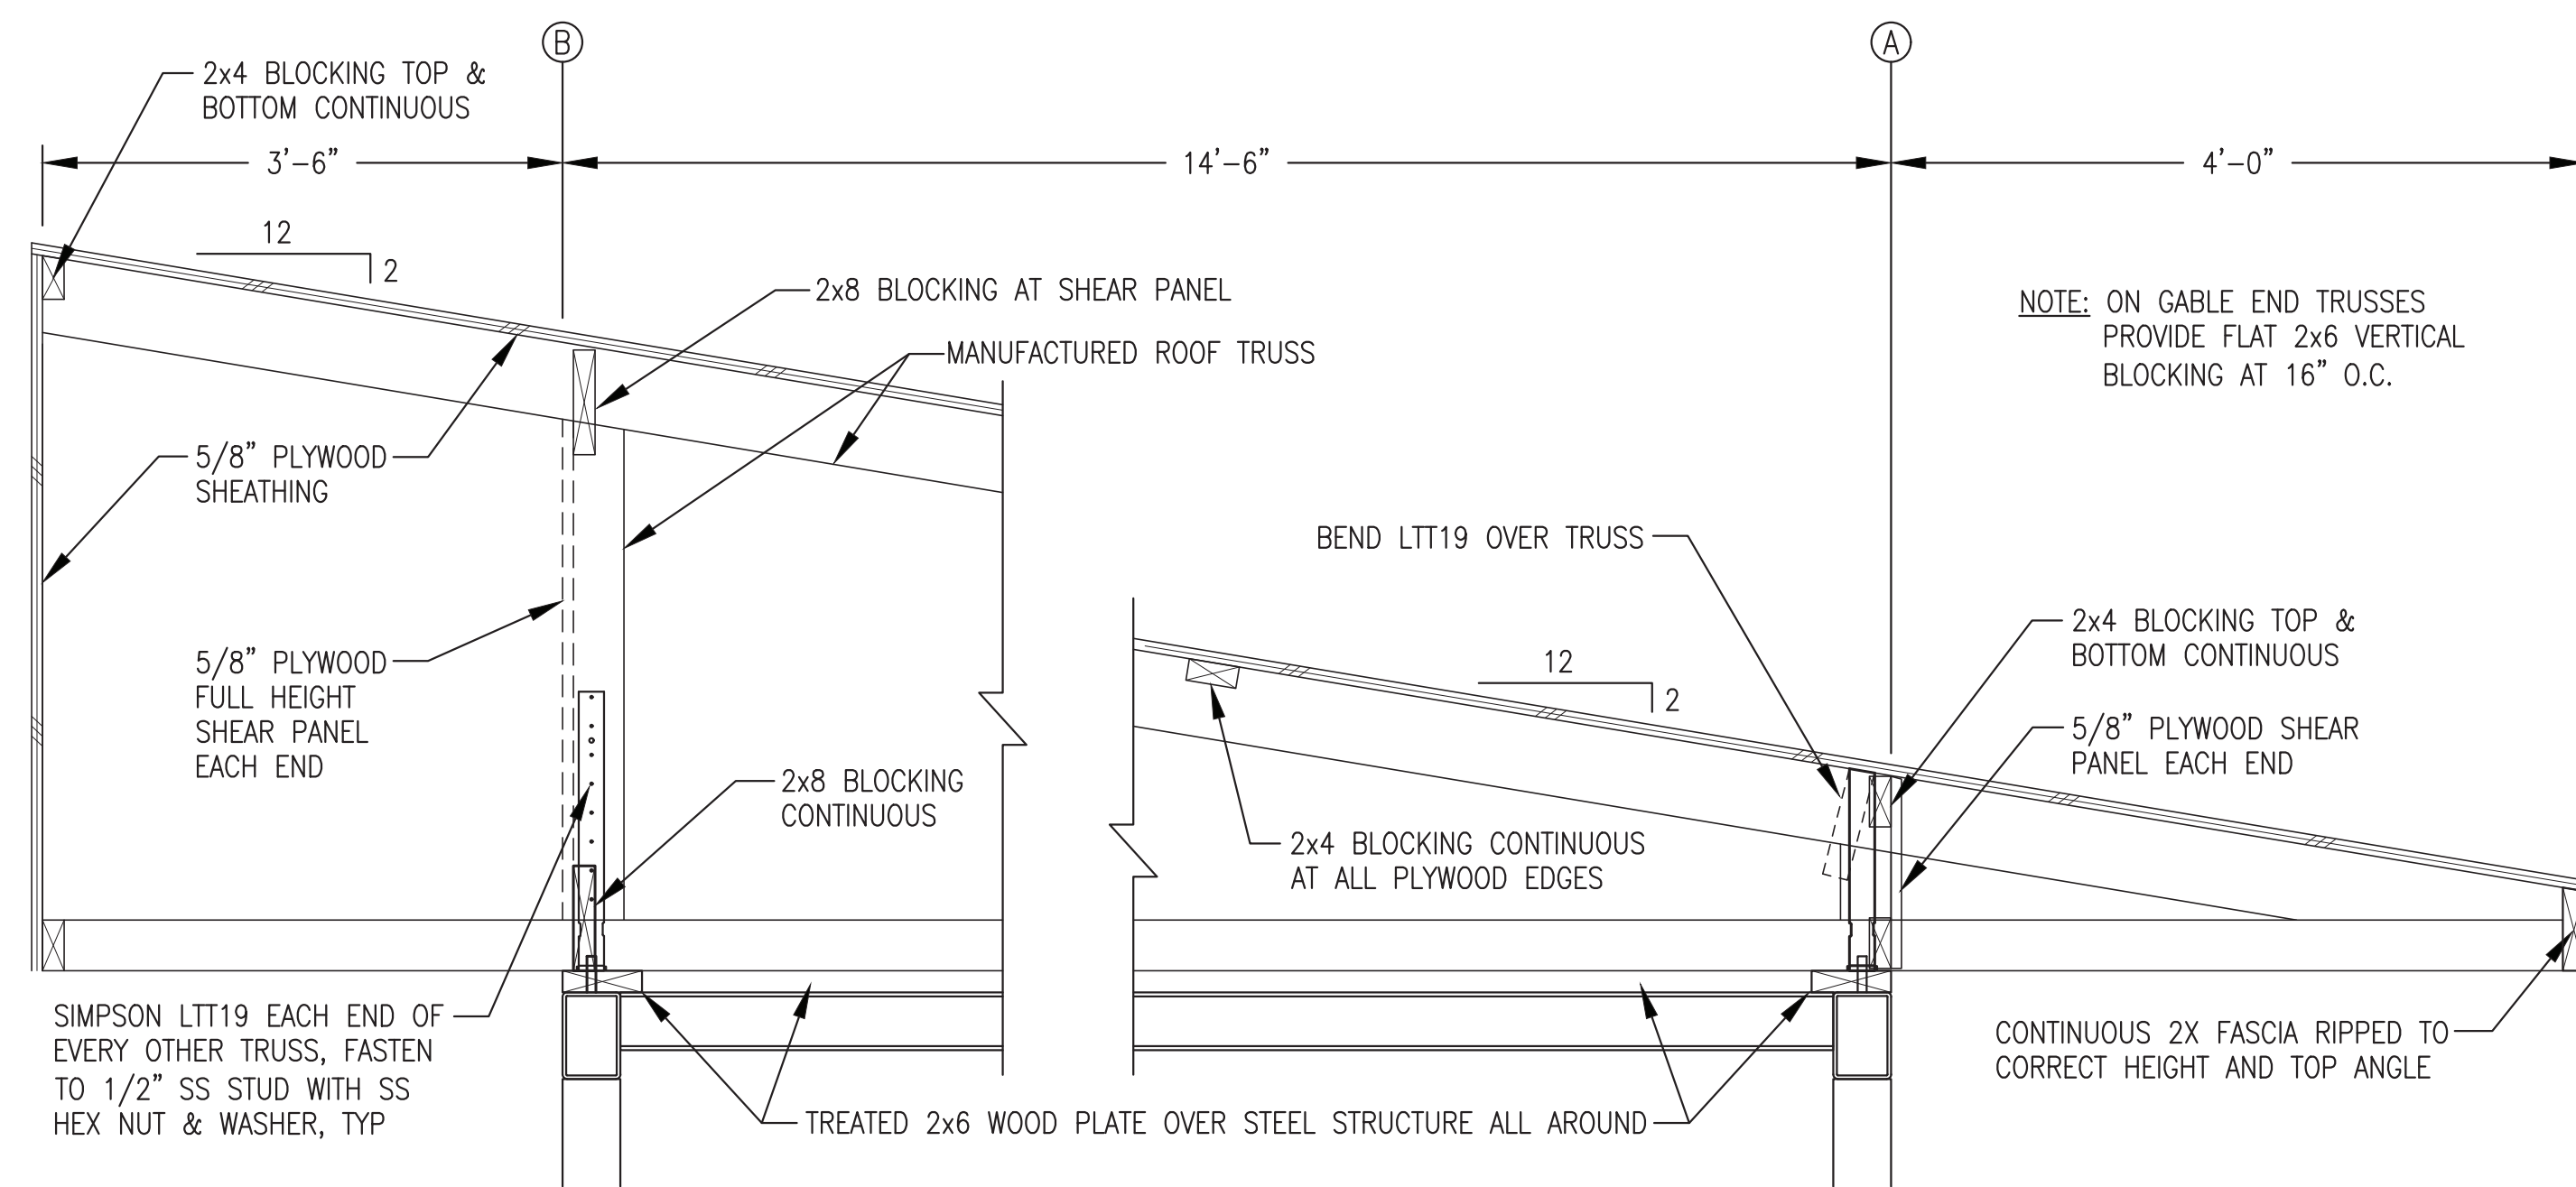


**3**  
S4  
ROOF TRUSS INSTALLATION  
NO SCALE

STAINLESS STEEL STUDS WERE WELDED TO THE MODULE AS PART OF THE PRIOR MODULE FABRICATION CONTRACT. ALL OTHER WORK THIS SHEET IS INCLUDED IN THE ON SITE SCOPE.

ISSUED FOR  
CONSTRUCTION  
MARCH 2023

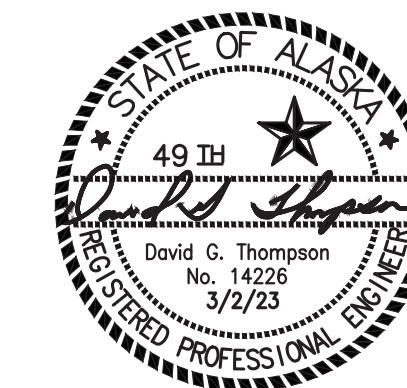

PROJECT: NELSON LAGOON POWER SYSTEM UPGRADE		
TITLE: ROOF FRAMING PLAN & DETAILS		
DRAWN BY: JTD	SCALE: AS NOTED	
DESIGNED BY: DGT/BCG	DATE: 3/2/23	
FILE NAME: NELS_PP_S1-S5	SHEET:	<b>S4</b>
PROJECT NUMBER:		
P.O. 111405, Anchorage, AK 99511 (907)349-0100		

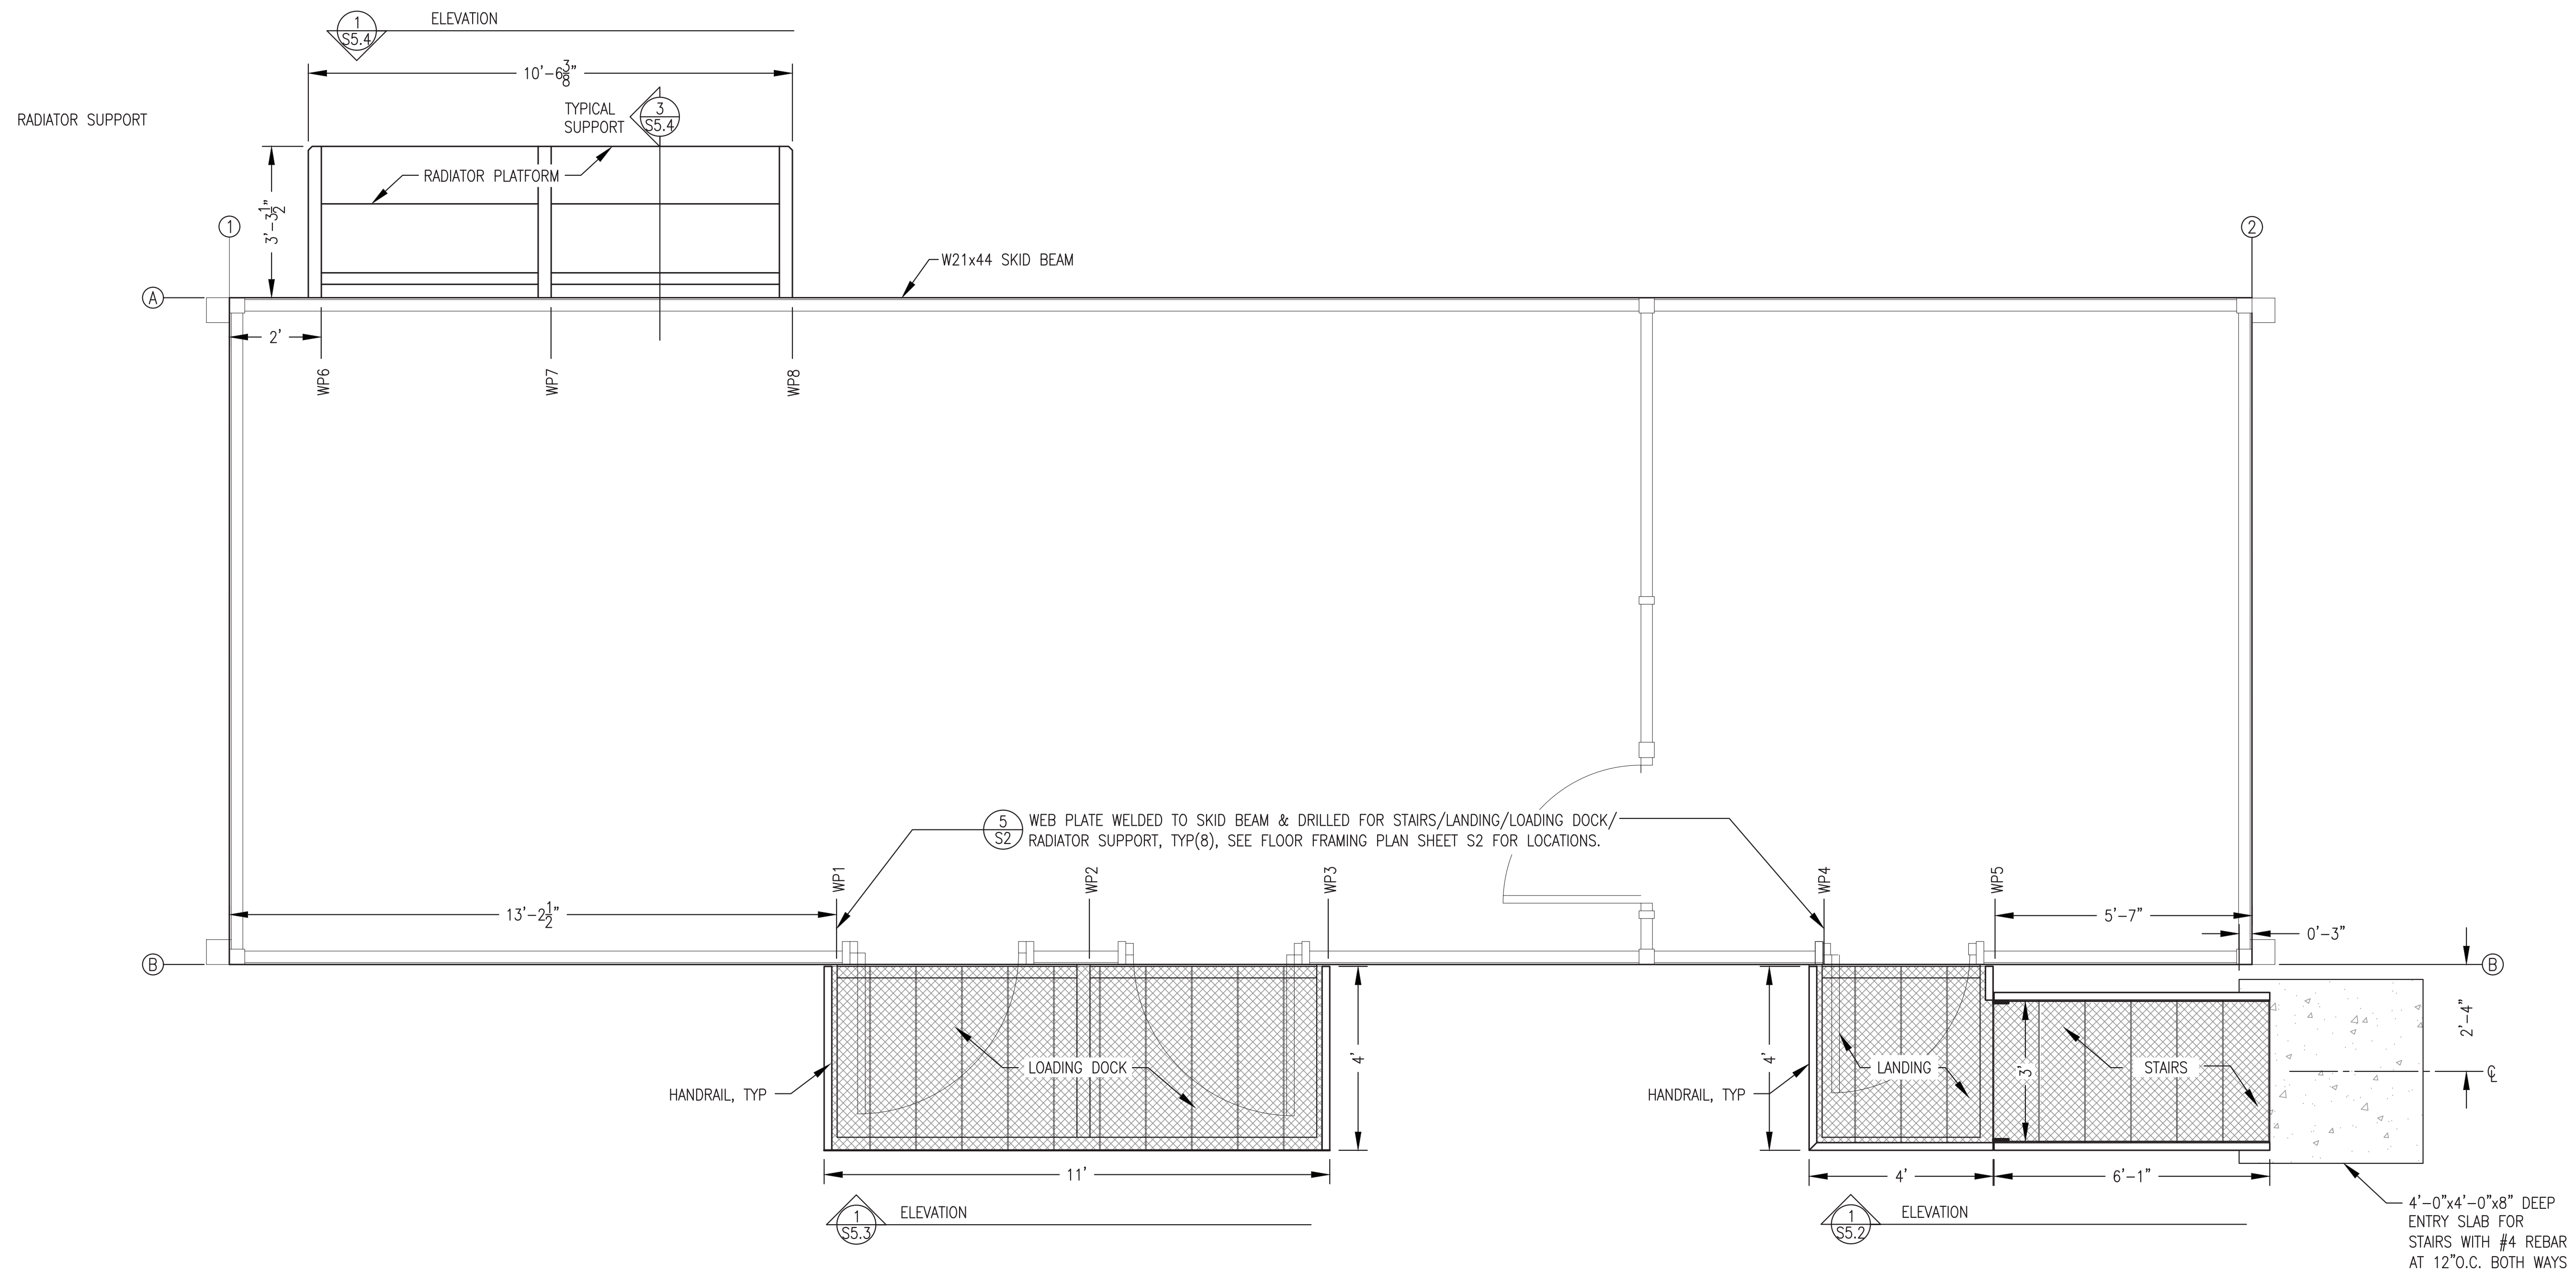


1 STAIRS, LANDINGS, LOADING DOCK & RADIATOR SUPPORT PLAN  
 S5.1 1/2"=1'-0"

- EXTERIOR ASSEMBLY FABRICATION GENERAL NOTES:**
- 1) THESE NOTES APPLY TO THE SHOP FABRICATION OF ALL EXTERIOR ASSEMBLIES SHOWN ON THE S5 SHEETS INCLUDING STAIRS, LANDINGS, LOADING DOCK, AND RADIATOR SUPPORT.
  - 2) FABRICATE FROM ASTM A-36 STEEL SHAPES AND PLATE. STAIR AND PLATFORM TREADS TO BE PRE-GALVANIZED 2"x11-3/4"x12 GA. GRIP STRUT.
  - 3) MAKE ALL JOINTS WITH CONTINUOUS GROOVE OR FILLET WELDS EXCEPT WHERE SPECIFICALLY INDICATED AS BOLTED.
  - 4) PRIOR TO FINAL WELDING, BOLT ASSEMBLIES TO SKIDS AND VERIFY ALL FRAMING IS LEVEL WITH AND PERPENDICULAR TO SKIDS. WELD OUT THEN REMOVE FOR COATING.
  - 5) UPON COMPLETION OF WELDING, ROUND CORNERS AND GRIND EDGES SMOOTH.
  - 6) SANDBLAST OR WIRE BRUSH ENDS OF PRE-GALV TREADS PRIOR TO WELDING TREADS TO FRAMING OR USE BOLT-ON END CAPS.
  - 7) SANDBLAST ALL FABRICATIONS EXCEPT PRE-GALVANIZED GRIP STRUT TO SSPC-SP-6 AND APPLY 3 COATS OF COLD GALVANIZING COMPOUND, ZRC OR EQUAL, TO 9 MILS MINIMUM DRY FILM THICKNESS.
  - 8) FURNISH GALVANIZED STEEL NUTS, BOLTS, AND WASHERS FOR FIELD ASSEMBLY.


ALL EXTERIOR ASSEMBLIES THIS SHEET WERE FABRICATED AS PART OF THE PRIOR MODULE FABRICATION. CONCRETE SLAB AND FINAL INSTALLATION OF EXTERIOR ASSEMBLIES IS INCLUDED IN THE ON SITE SCOPE.

ISSUED FOR CONSTRUCTION  
 MARCH 2023

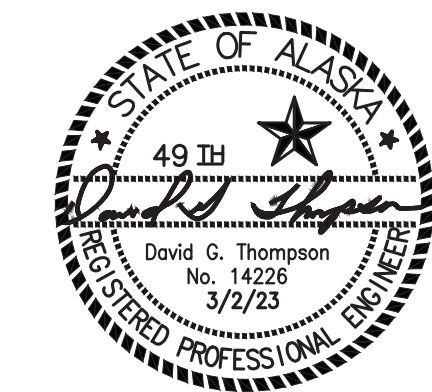


ALASKA ENERGY AUTHORITY		
PROJECT: NELSON LAGOON POWER SYSTEM UPGRADE		
TITLE: STAIRS, LANDINGS, LOADING DOCK, & RADIATOR SUPPORT PLAN		
	DRAWN BY: JTD	SCALE: AS NOTED
	DESIGNED BY: DGT/BCG	DATE: 3/2/23
FILE NAME: NELS PP S1-S5	SHEET:	<b>S5.1</b>
PROJECT NUMBER:		
P.O. 111405, Anchorage, AK 99511 (907)349-0100		




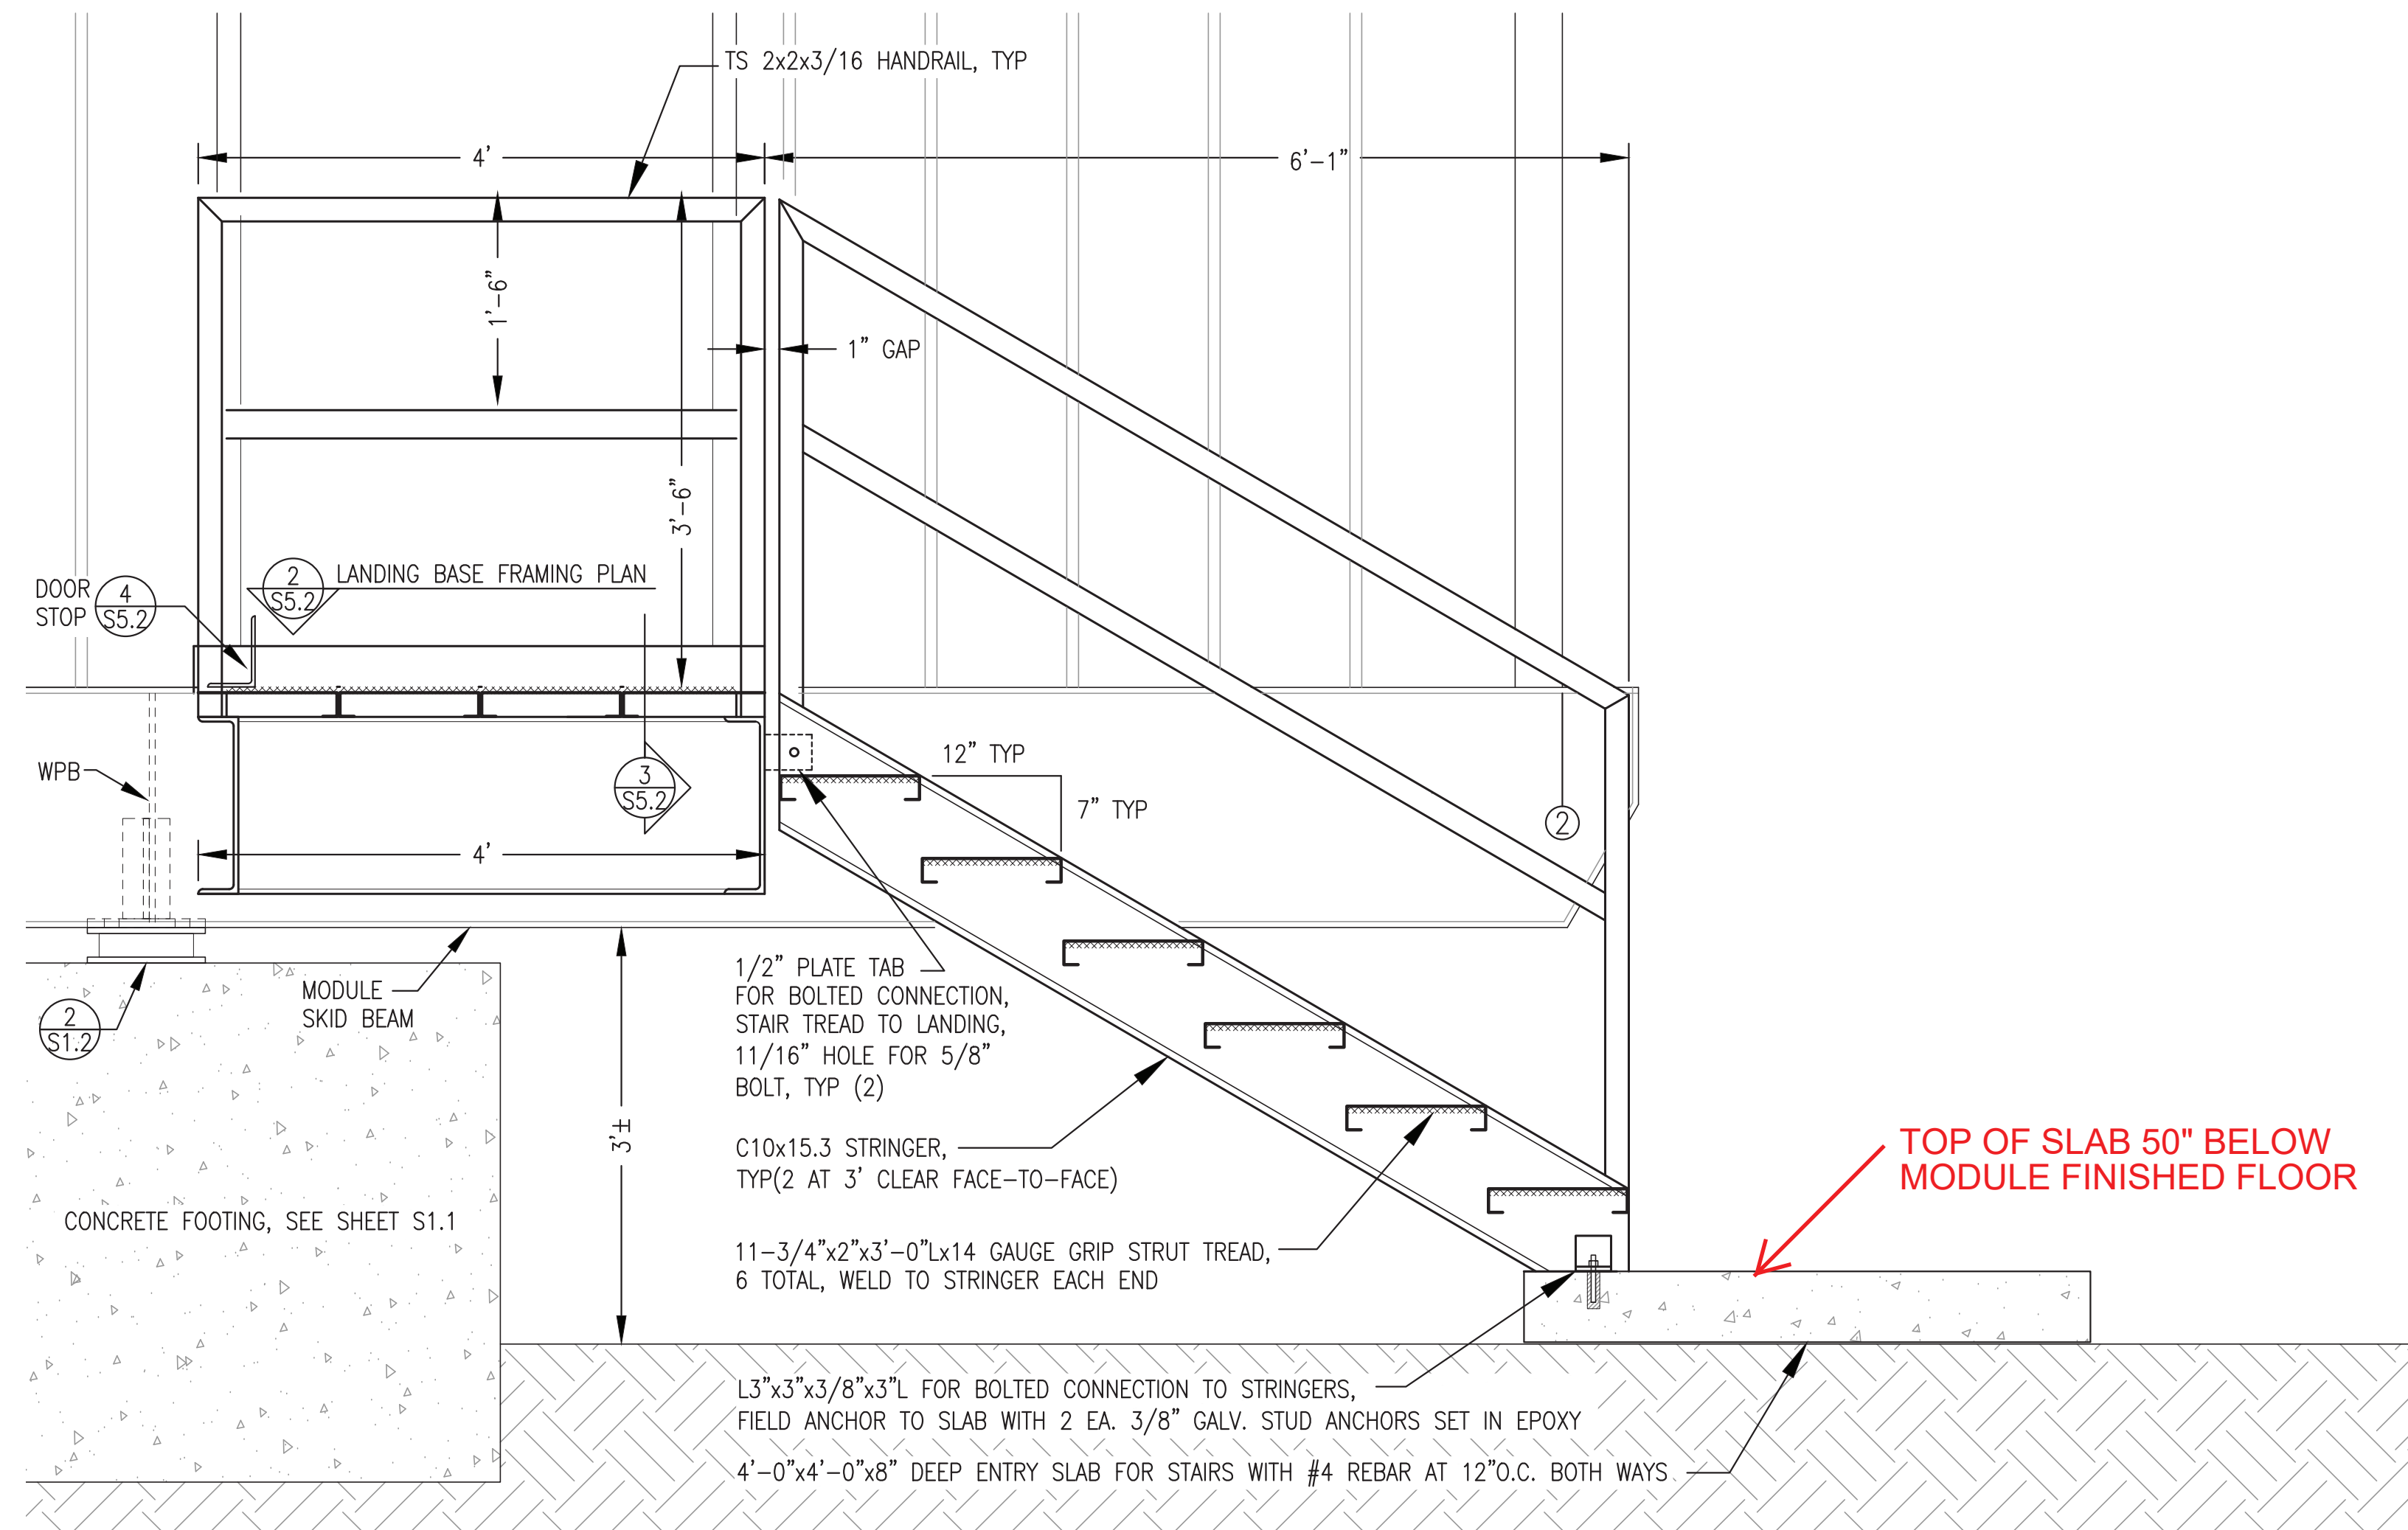


1 STAIR/LANDING ELEVATION  
S5.2 1"-1'-0"

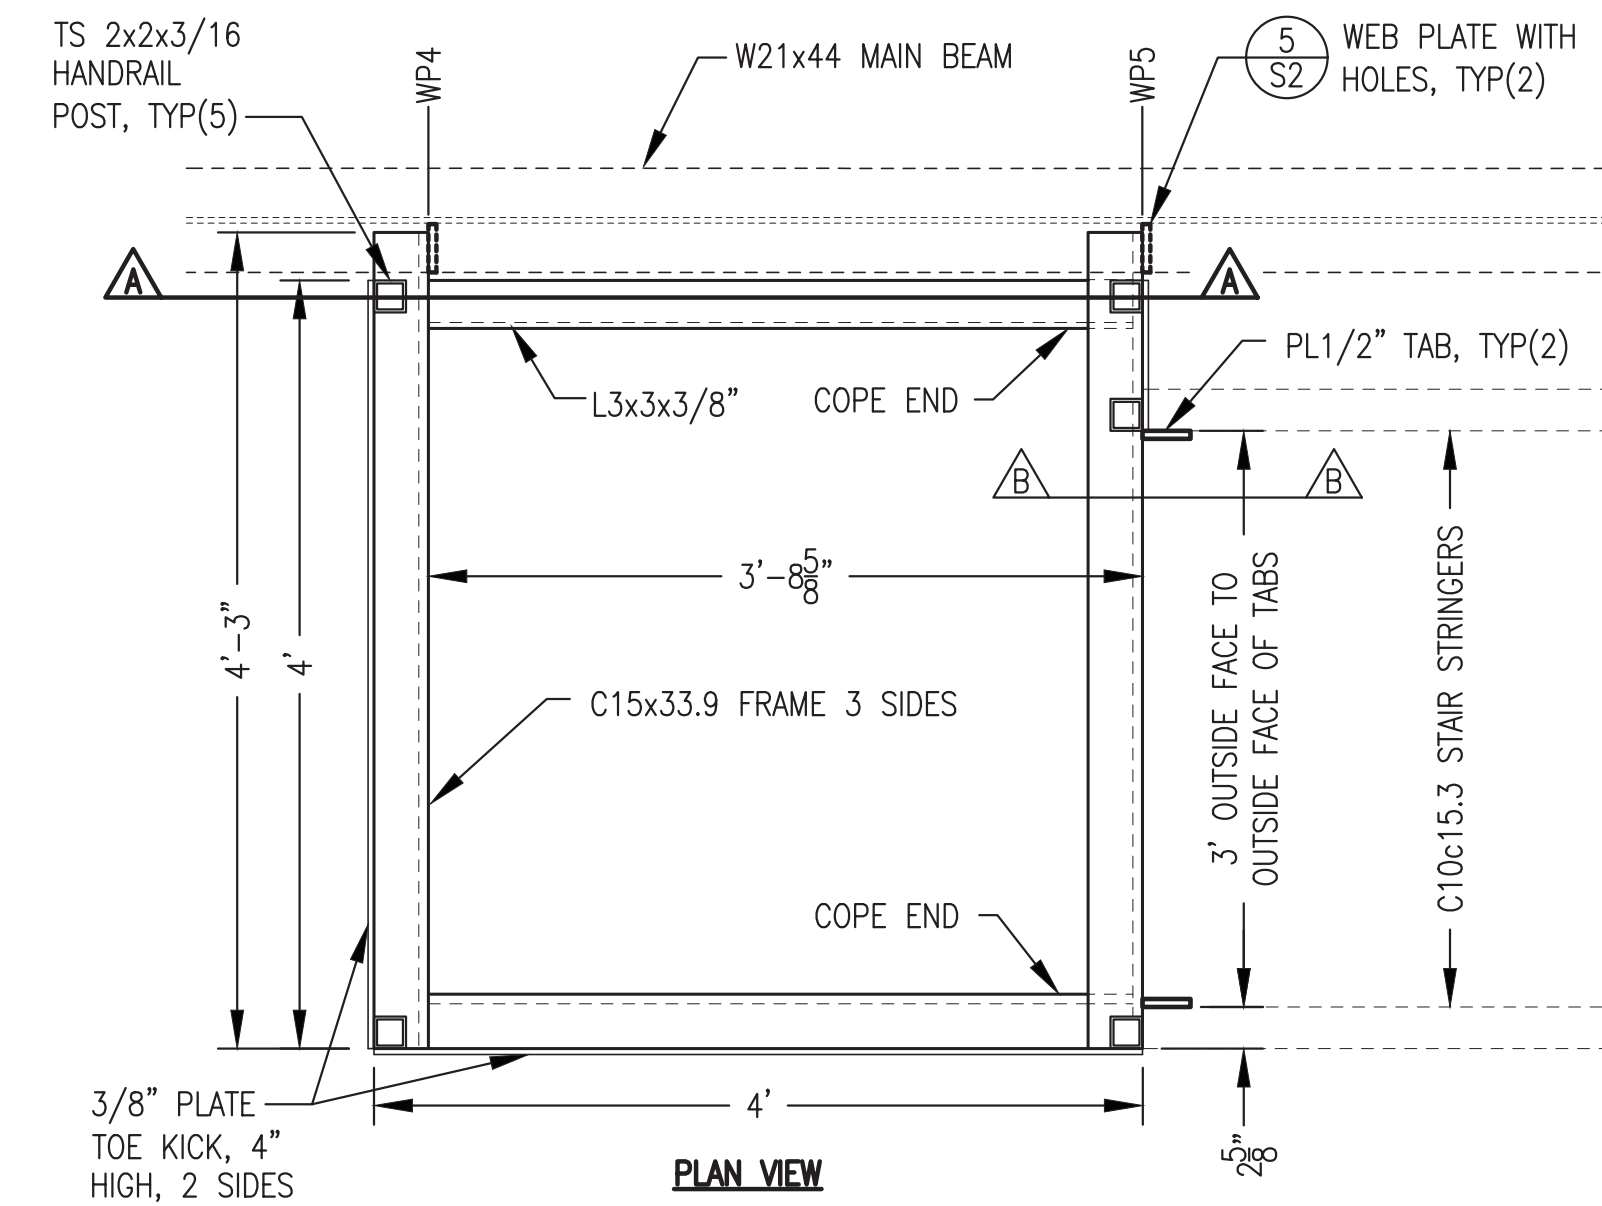

2 LANDING BASE FRAMING PLAN & SECTIONS  
S5.2 1"-1'-0"

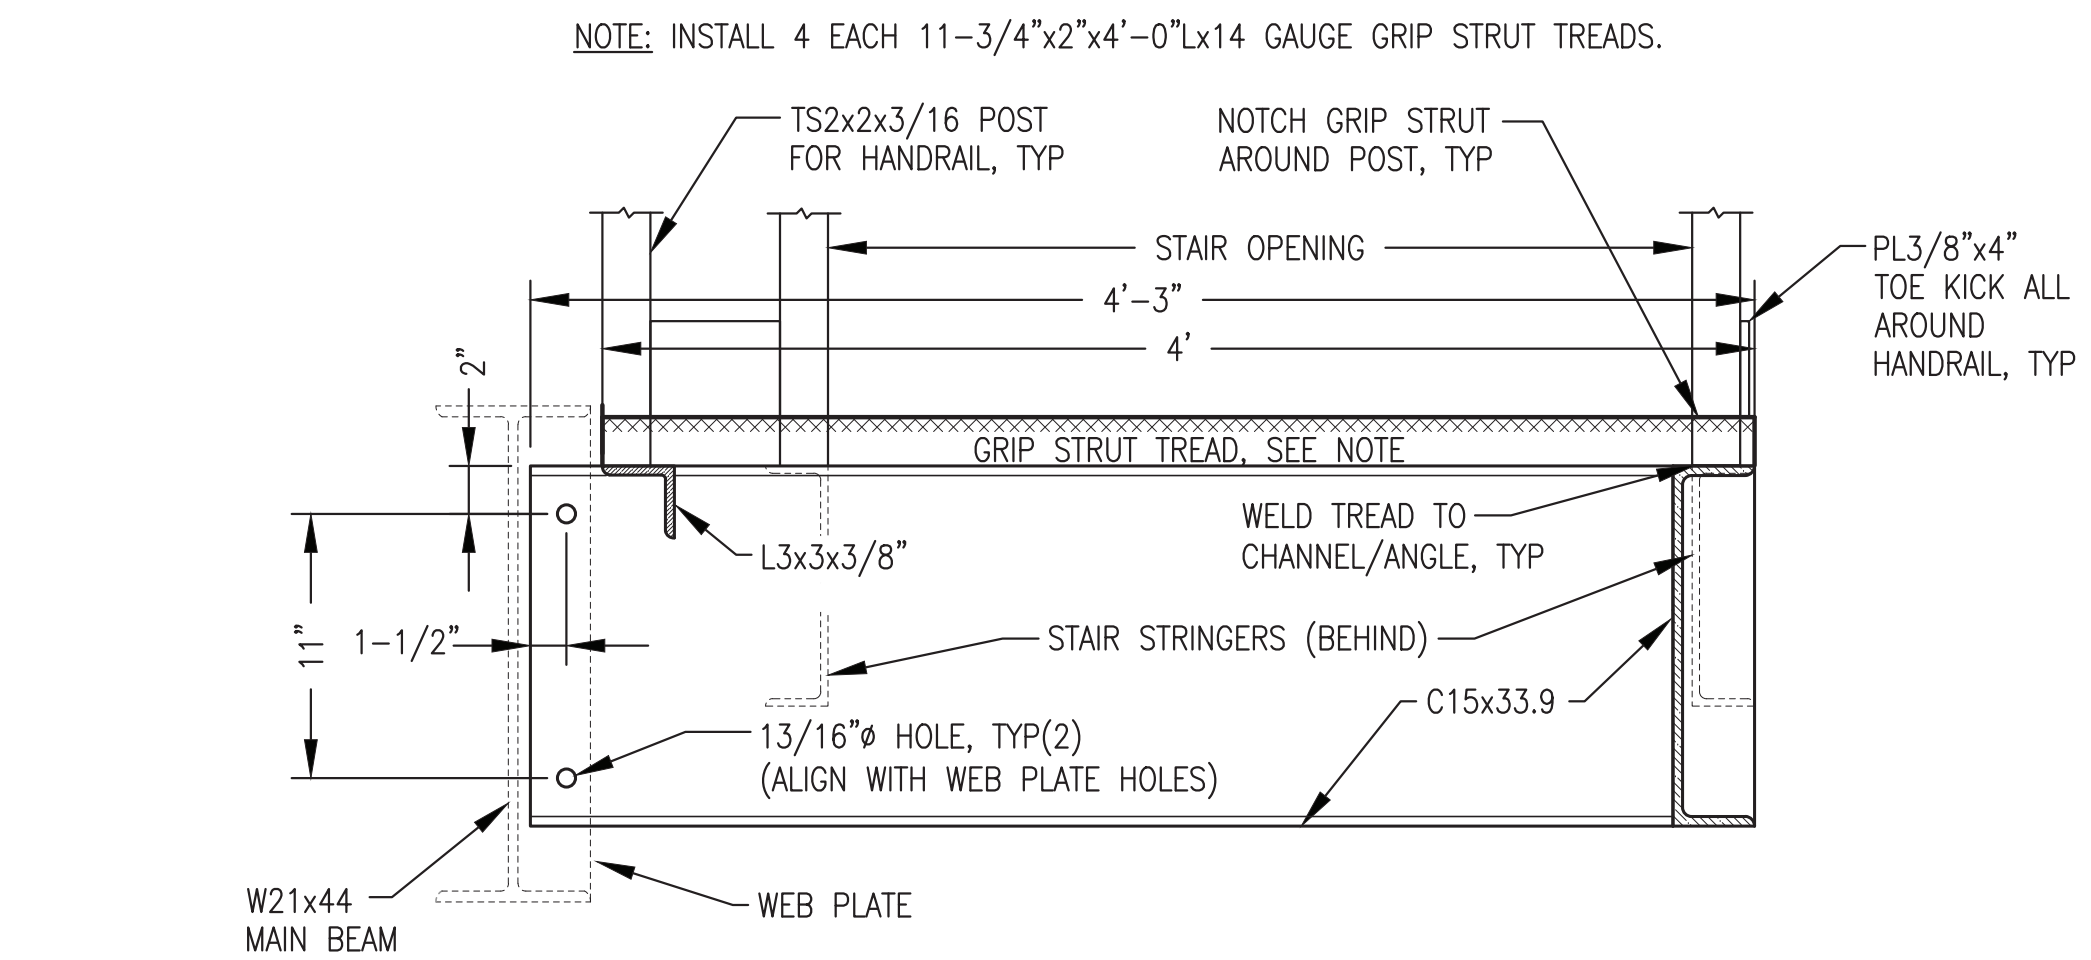


3 LANDING SECTION & MAIN BEAM CONNECTION DETAIL  
S5.2 1-1/2"-1'-0"

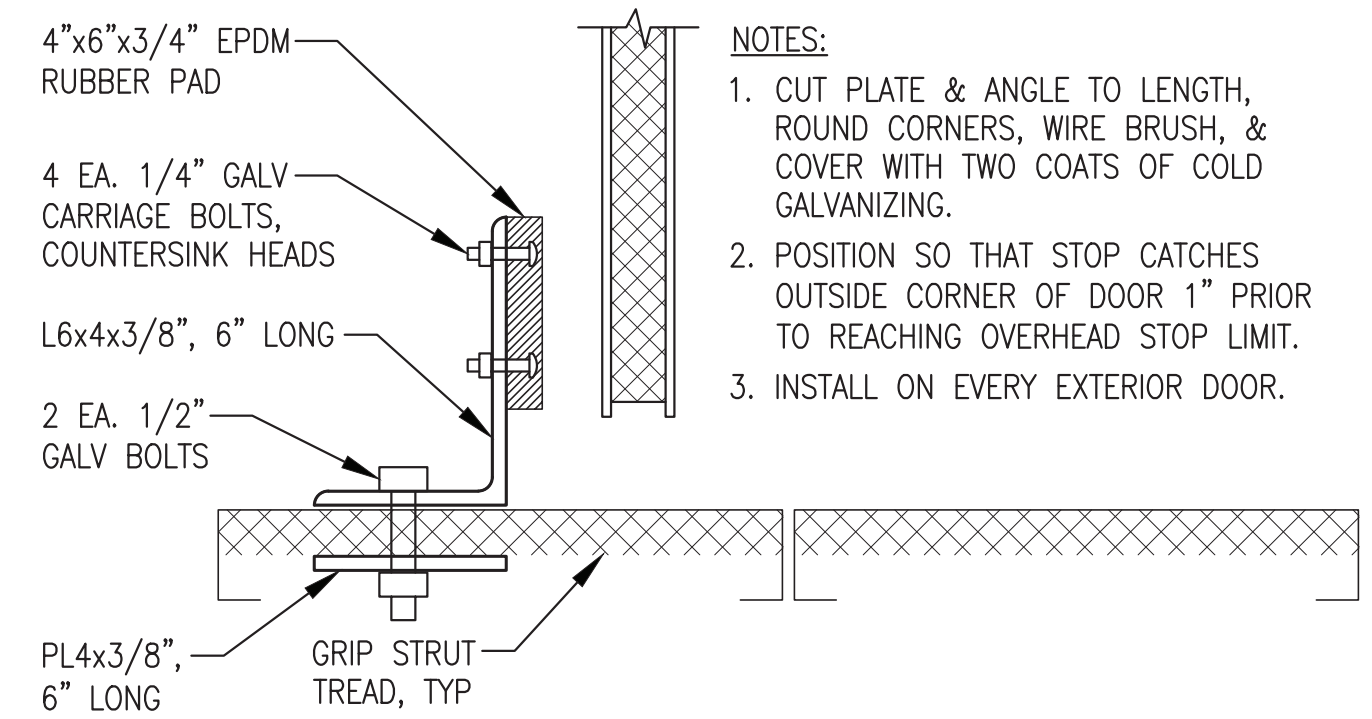


4 TYPICAL EXTERIOR DOOR BOTTOM STOP  
S5.2 NO SCALE

ALL EXTERIOR ASSEMBLIES THIS SHEET WERE FABRICATED AS PART OF THE PRIOR MODULE FABRICATION. CONCRETE SLAB AND FINAL INSTALLATION OF EXTERIOR ASSEMBLIES IS INCLUDED IN THE ON SITE SCOPE. FURNISH AND INSTALL DOOR STOPS AS PART OF THE ON SITE CONTRACT.


ISSUED FOR CONSTRUCTION  
MARCH 2023

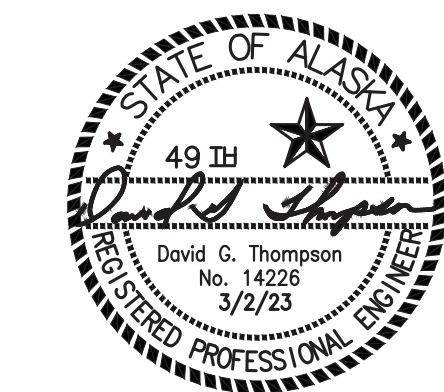


 ALASKA ENERGY AUTHORITY		
PROJECT: NELSON LAGOON POWER SYSTEM UPGRADE		
TITLE: STAIRS/LANDINGS FABRICATION DETAILS		
DRAWN BY: JTD	SCALE: AS NOTED	
DESIGNED BY: DGT/BCG	DATE: 3/2/23	
FILE NAME: NELS PP S1-S5	SHEET:	S5.2
P.O. 111405, Anchorage, AK 99511 (907)349-0100		

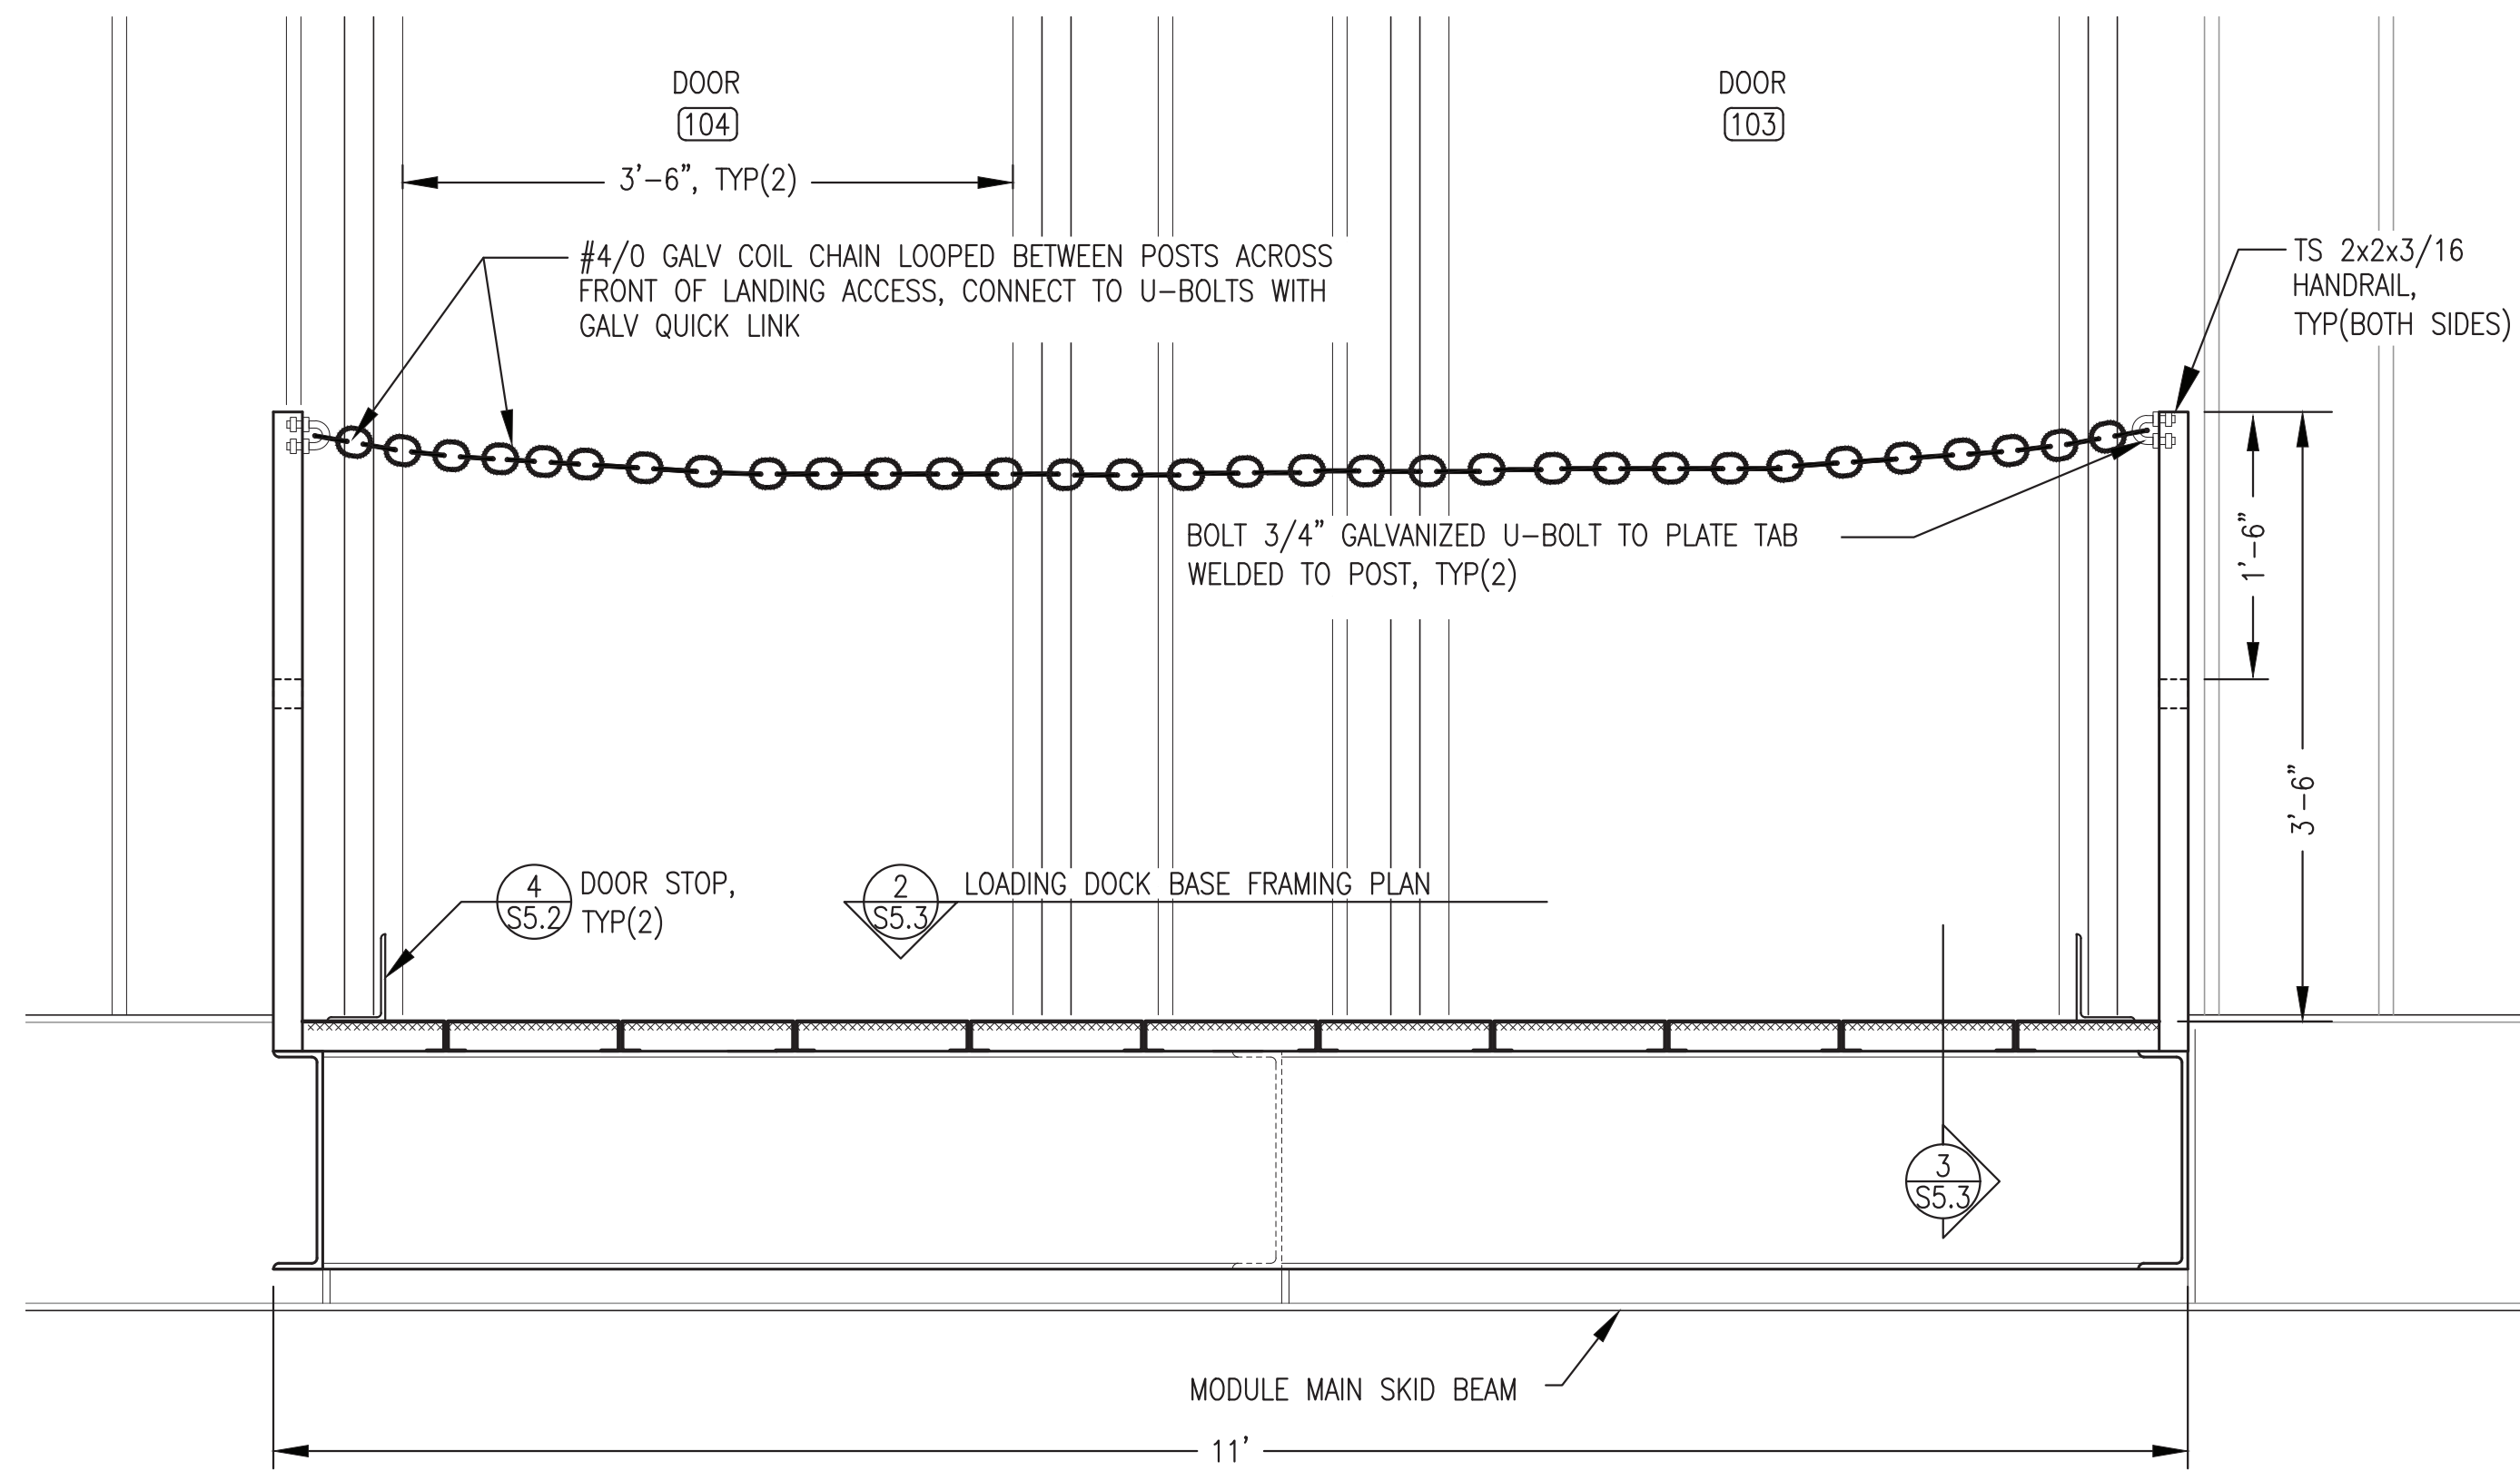

1 LOADING DOCK ELEVATION  
S5.3 1"=1'-0"

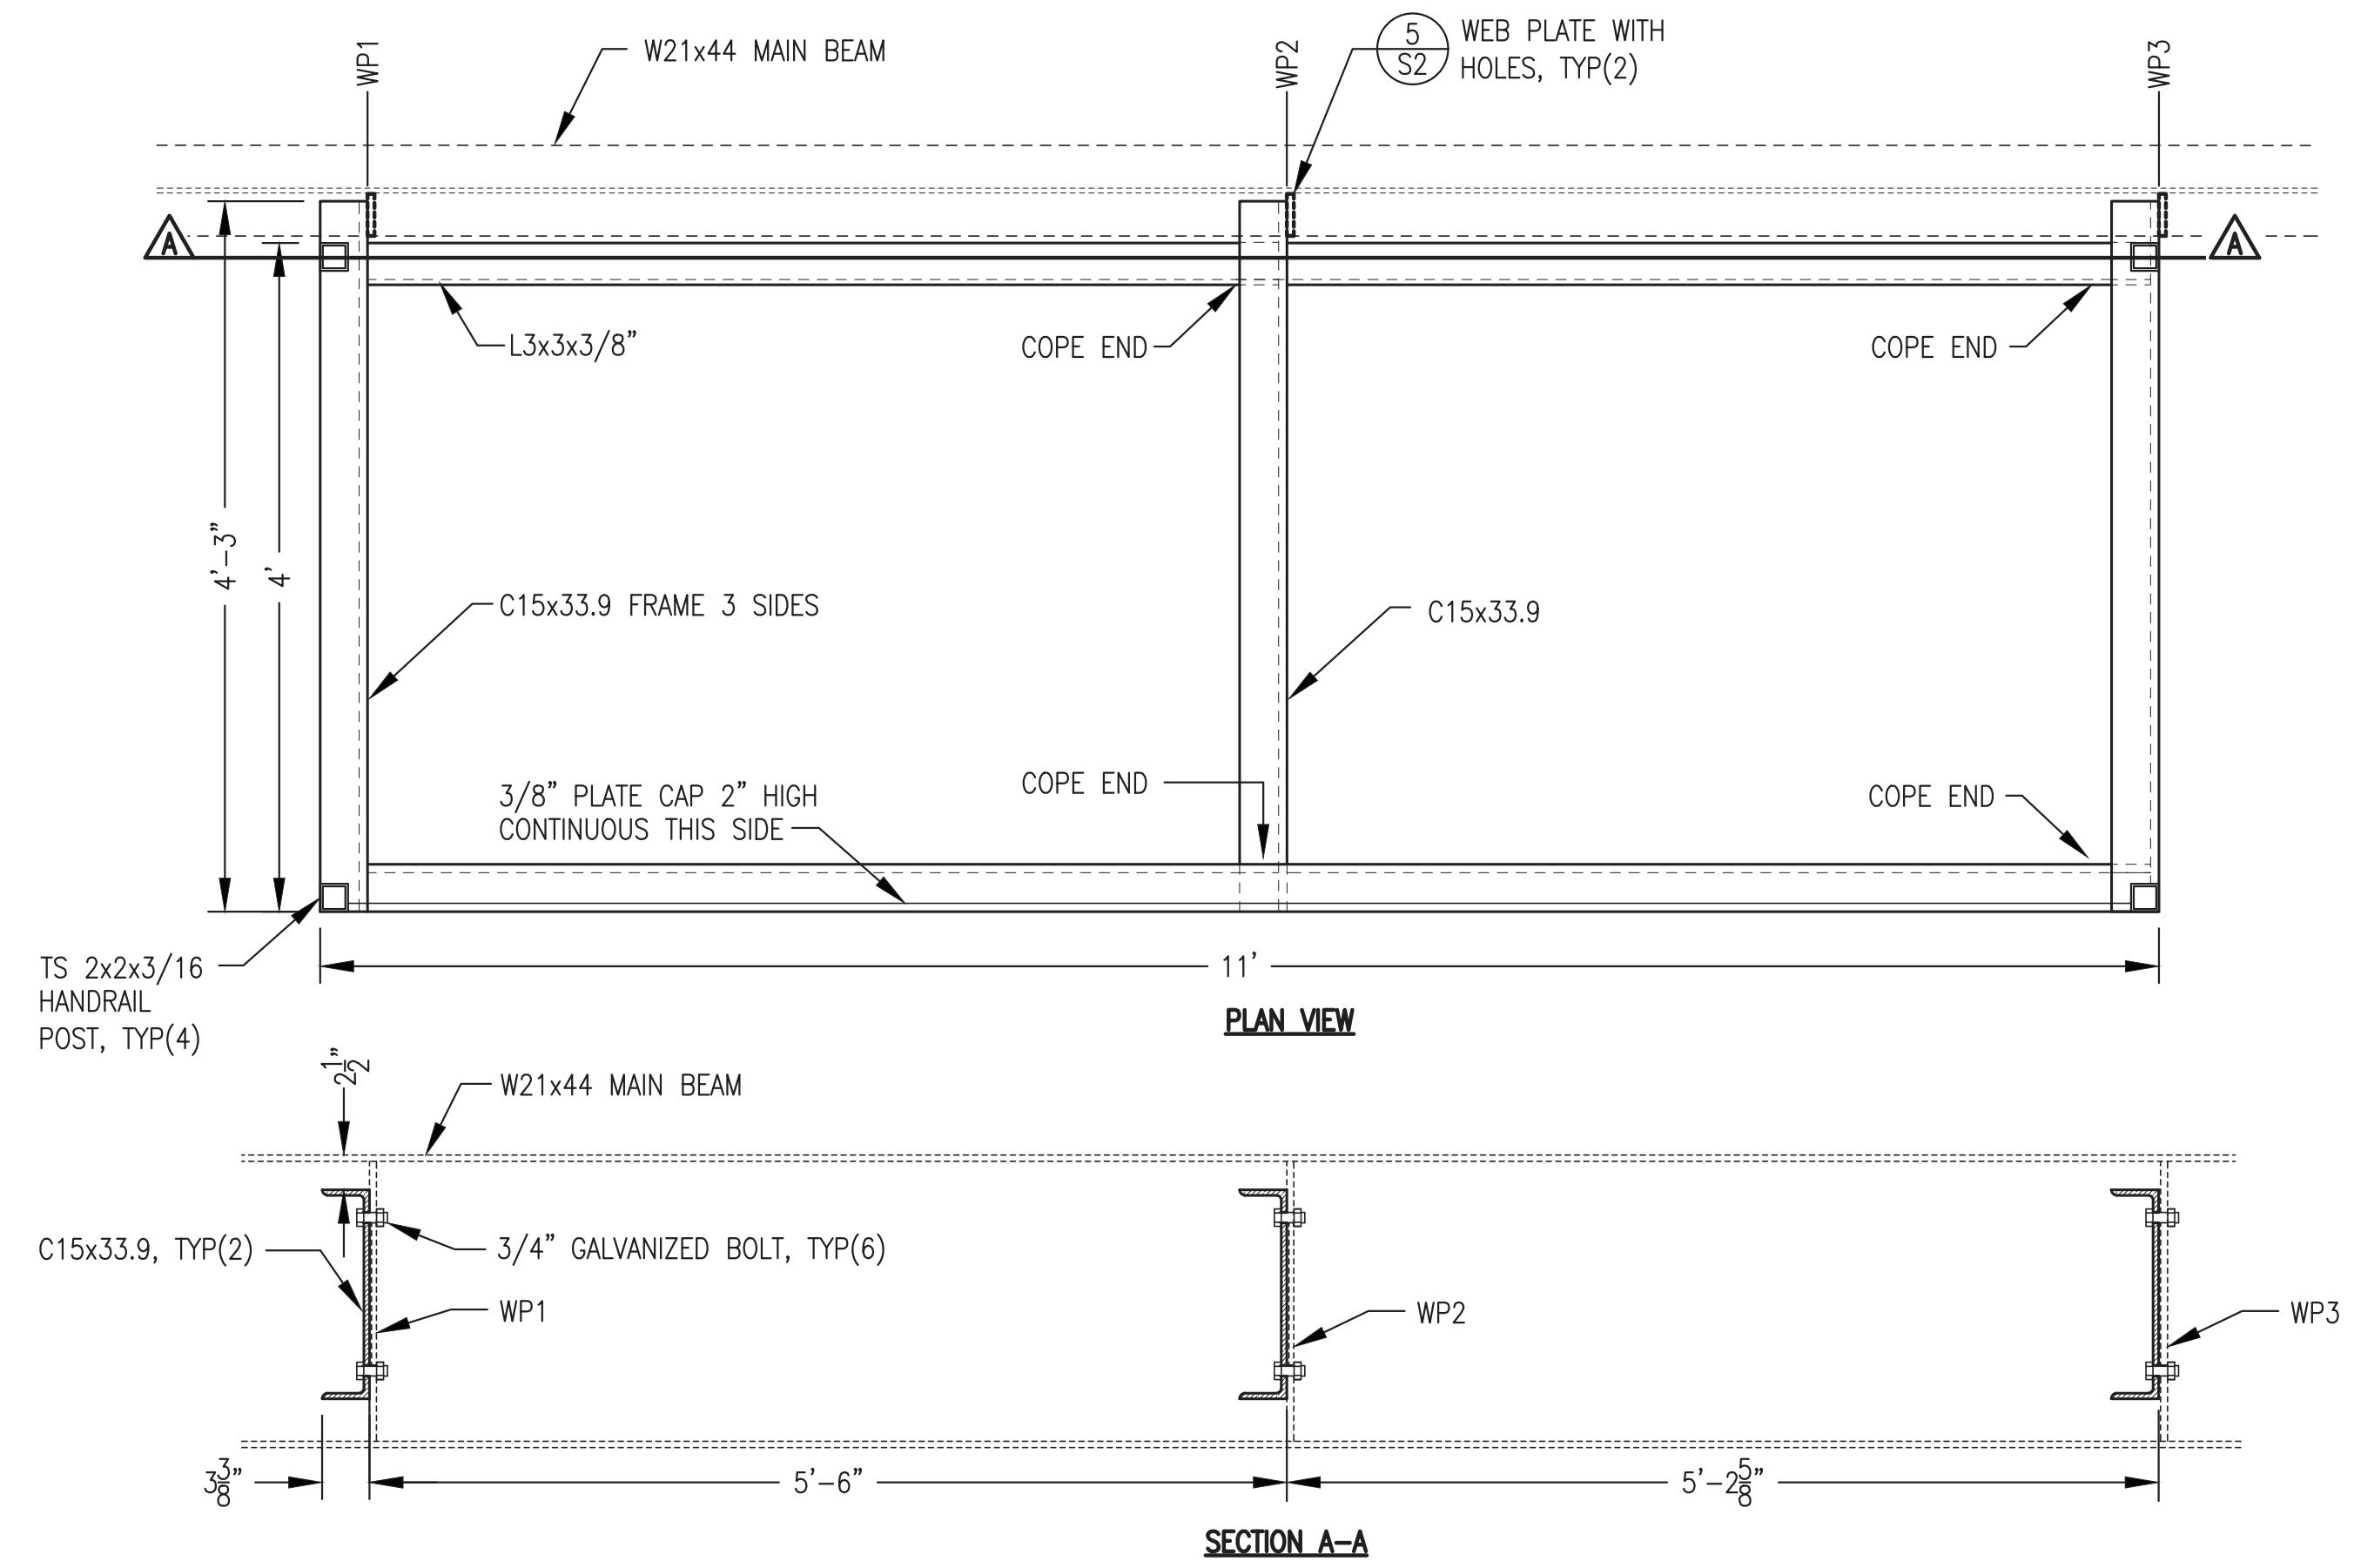

2 LOADING DOCK BASE FRAMING PLAN & SECTION  
S5.3 1"=1'-0"

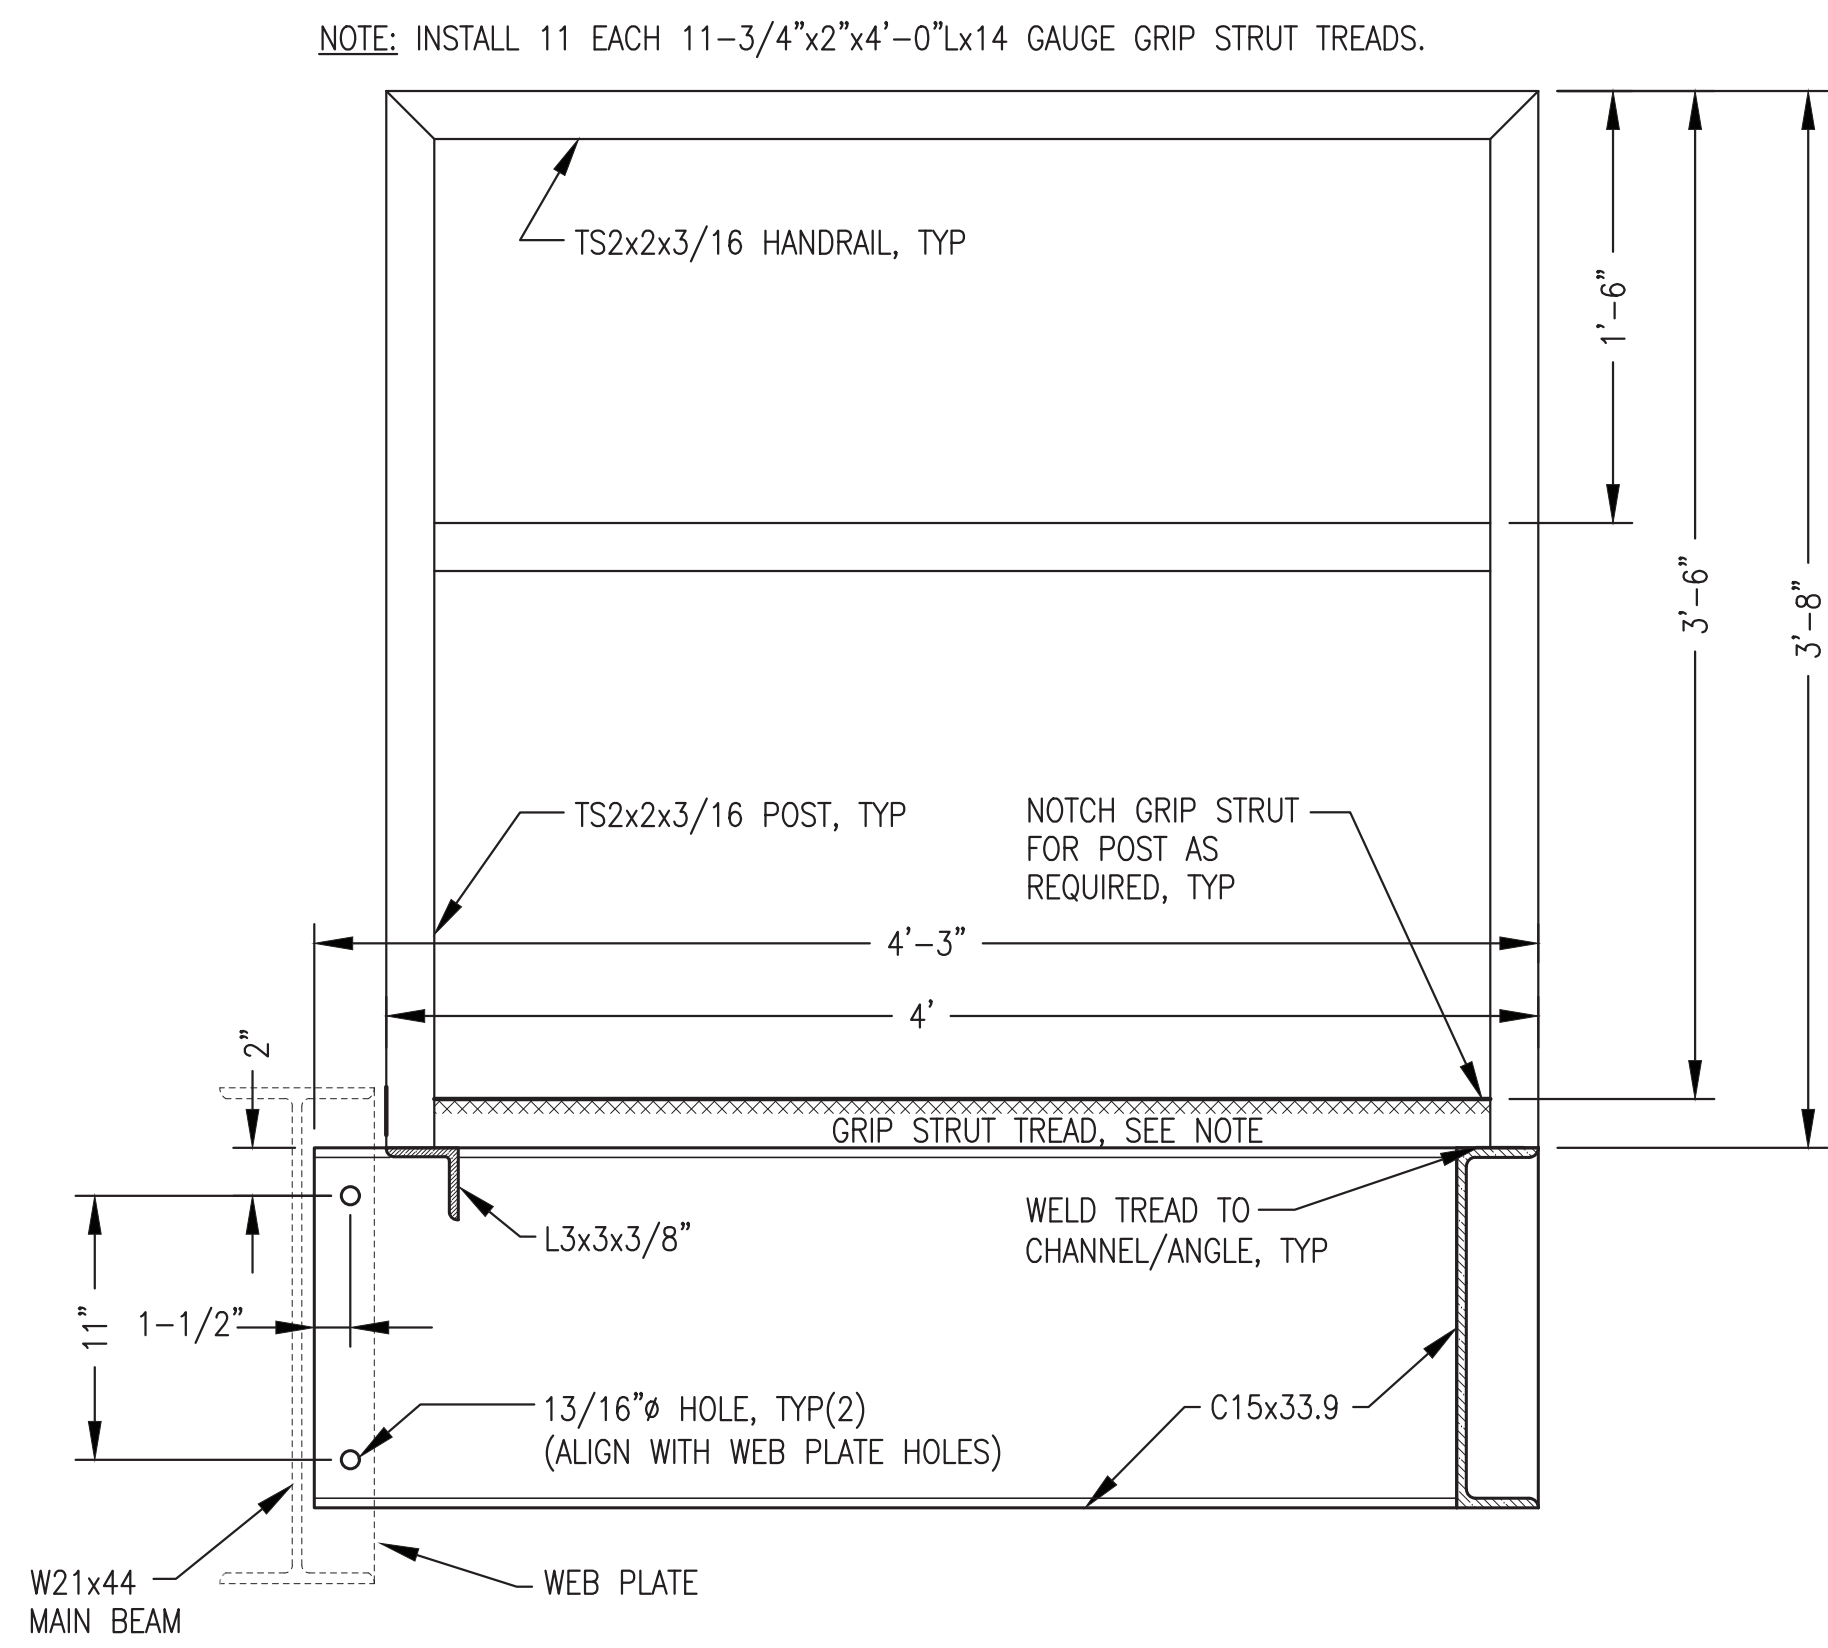


3 LOADING DOCK SECTION & MAIN BEAM CONNECTION DETAIL  
S5.3 1-1/2"=1'-0"

ALL EXTERIOR ASSEMBLIES THIS SHEET WERE FABRICATED AS PART OF THE PRIOR MODULE FABRICATION. FINAL INSTALLATION OF EXTERIOR ASSEMBLIES IS INCLUDED IN THE ON SITE SCOPE.


ISSUED FOR CONSTRUCTION  
MARCH 2023





<p>ALASKA ENERGY AUTHORITY</p>		
PROJECT: NELSON LAGOON POWER SYSTEM UPGRADE		
TITLE: LOADING DOCK FABRICATION DETAILS		
<p>Gray Stassel Engineering, Inc.</p>	DRAWN BY: JTD DESIGNED BY: DGT/BCG FILE NAME: NELS_PP_S1-S5 PROJECT NUMBER:	SCALE: AS NOTED DATE: 3/2/23 SHEET: S5.3
P.O. 111405, Anchorage, AK 99511 (907)349-0100		

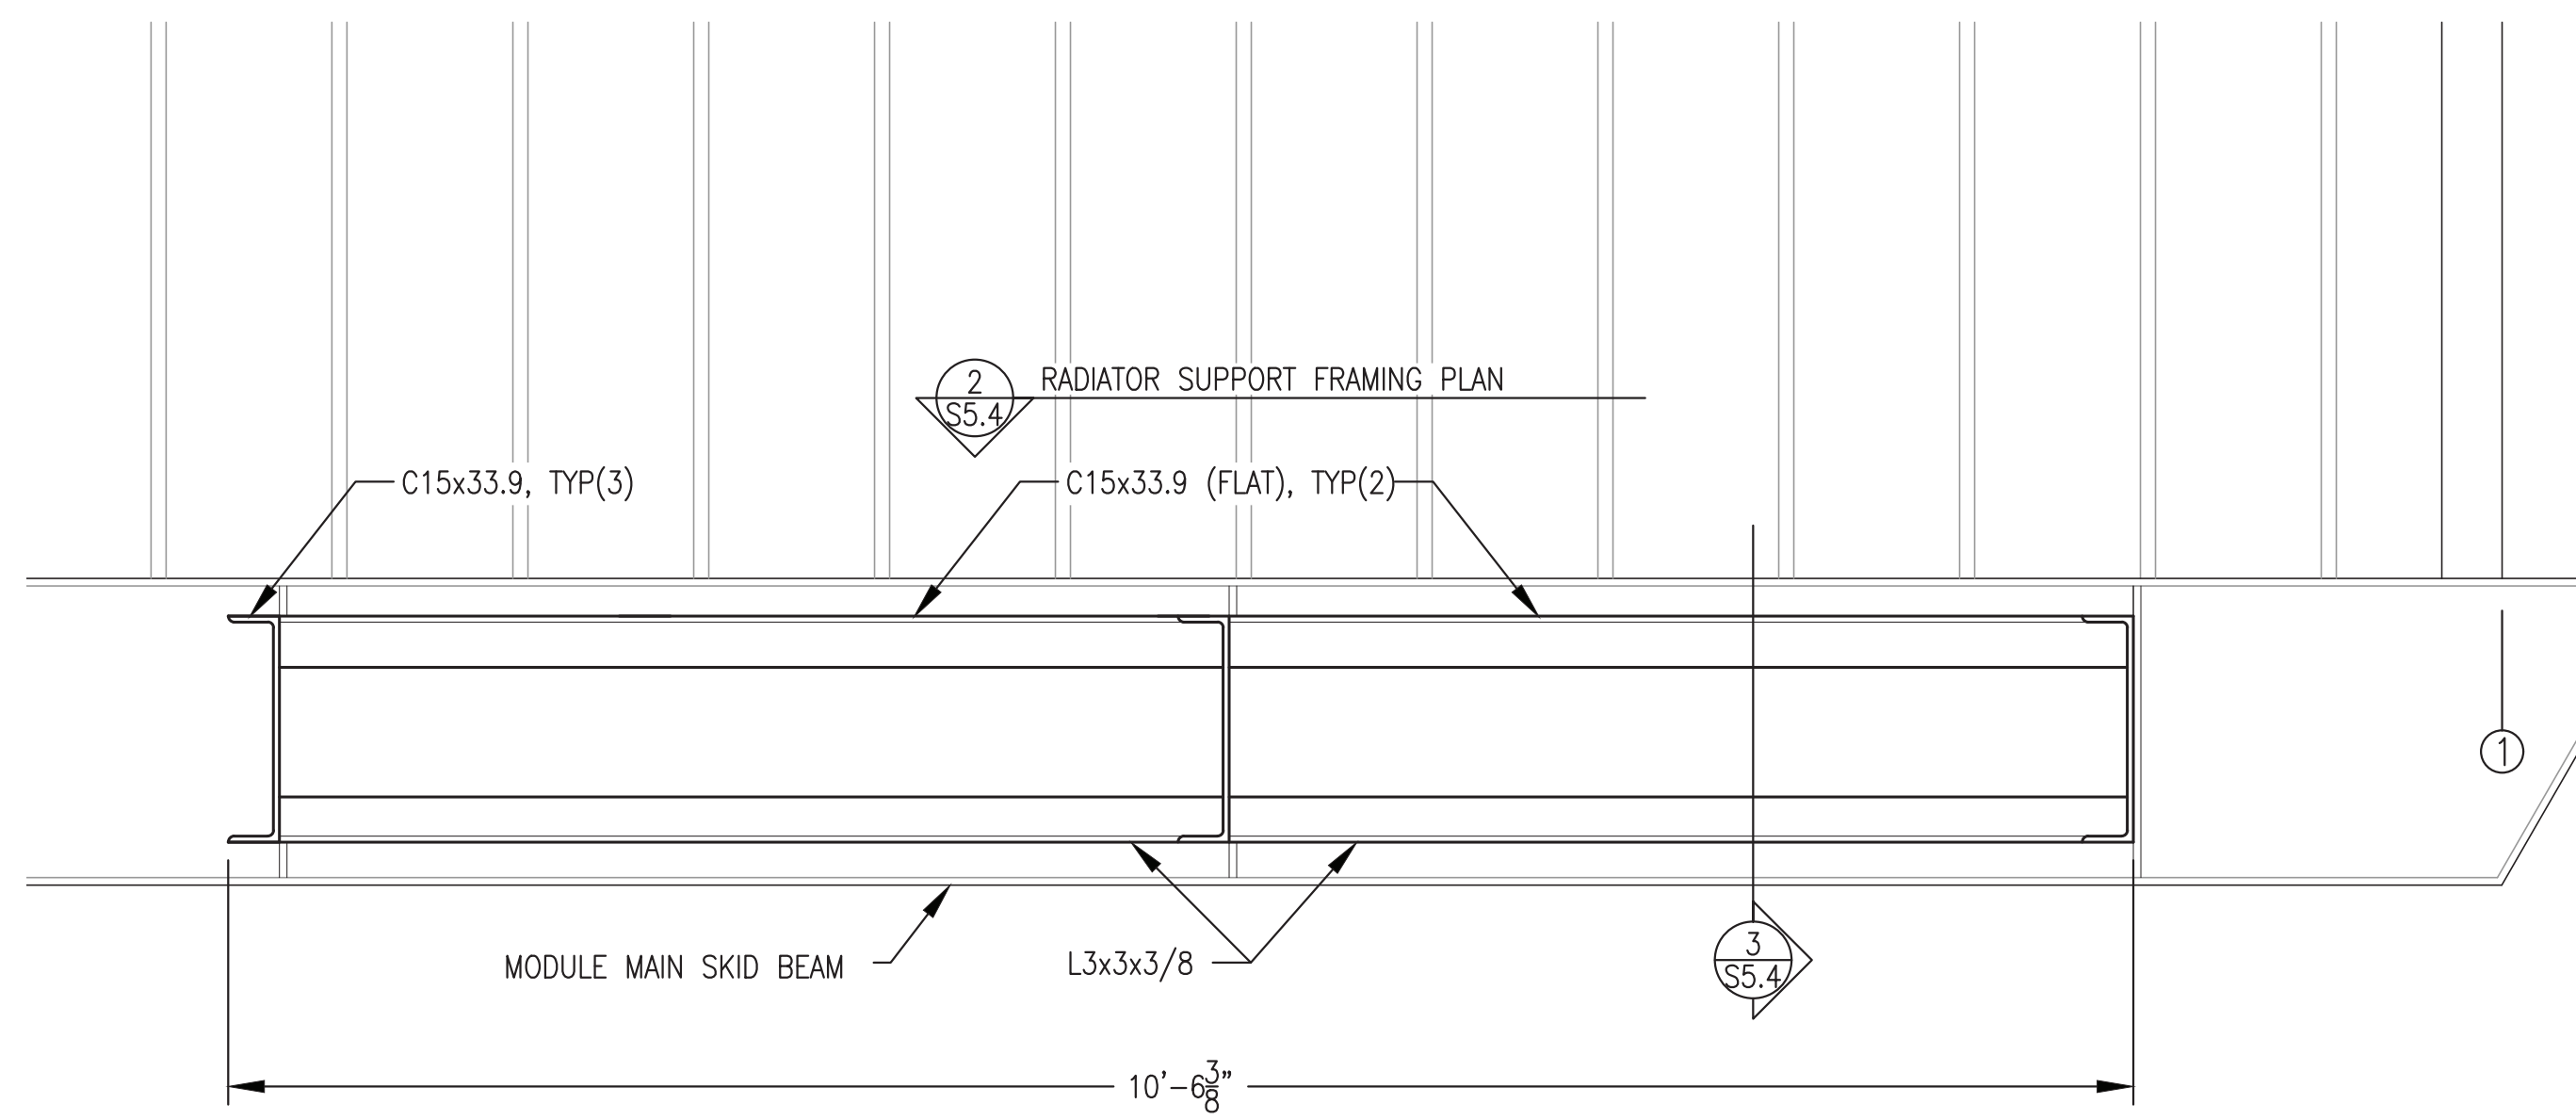

1 RADIATOR SUPPORT ELEVATION  
S5.4 1"=1'-0"

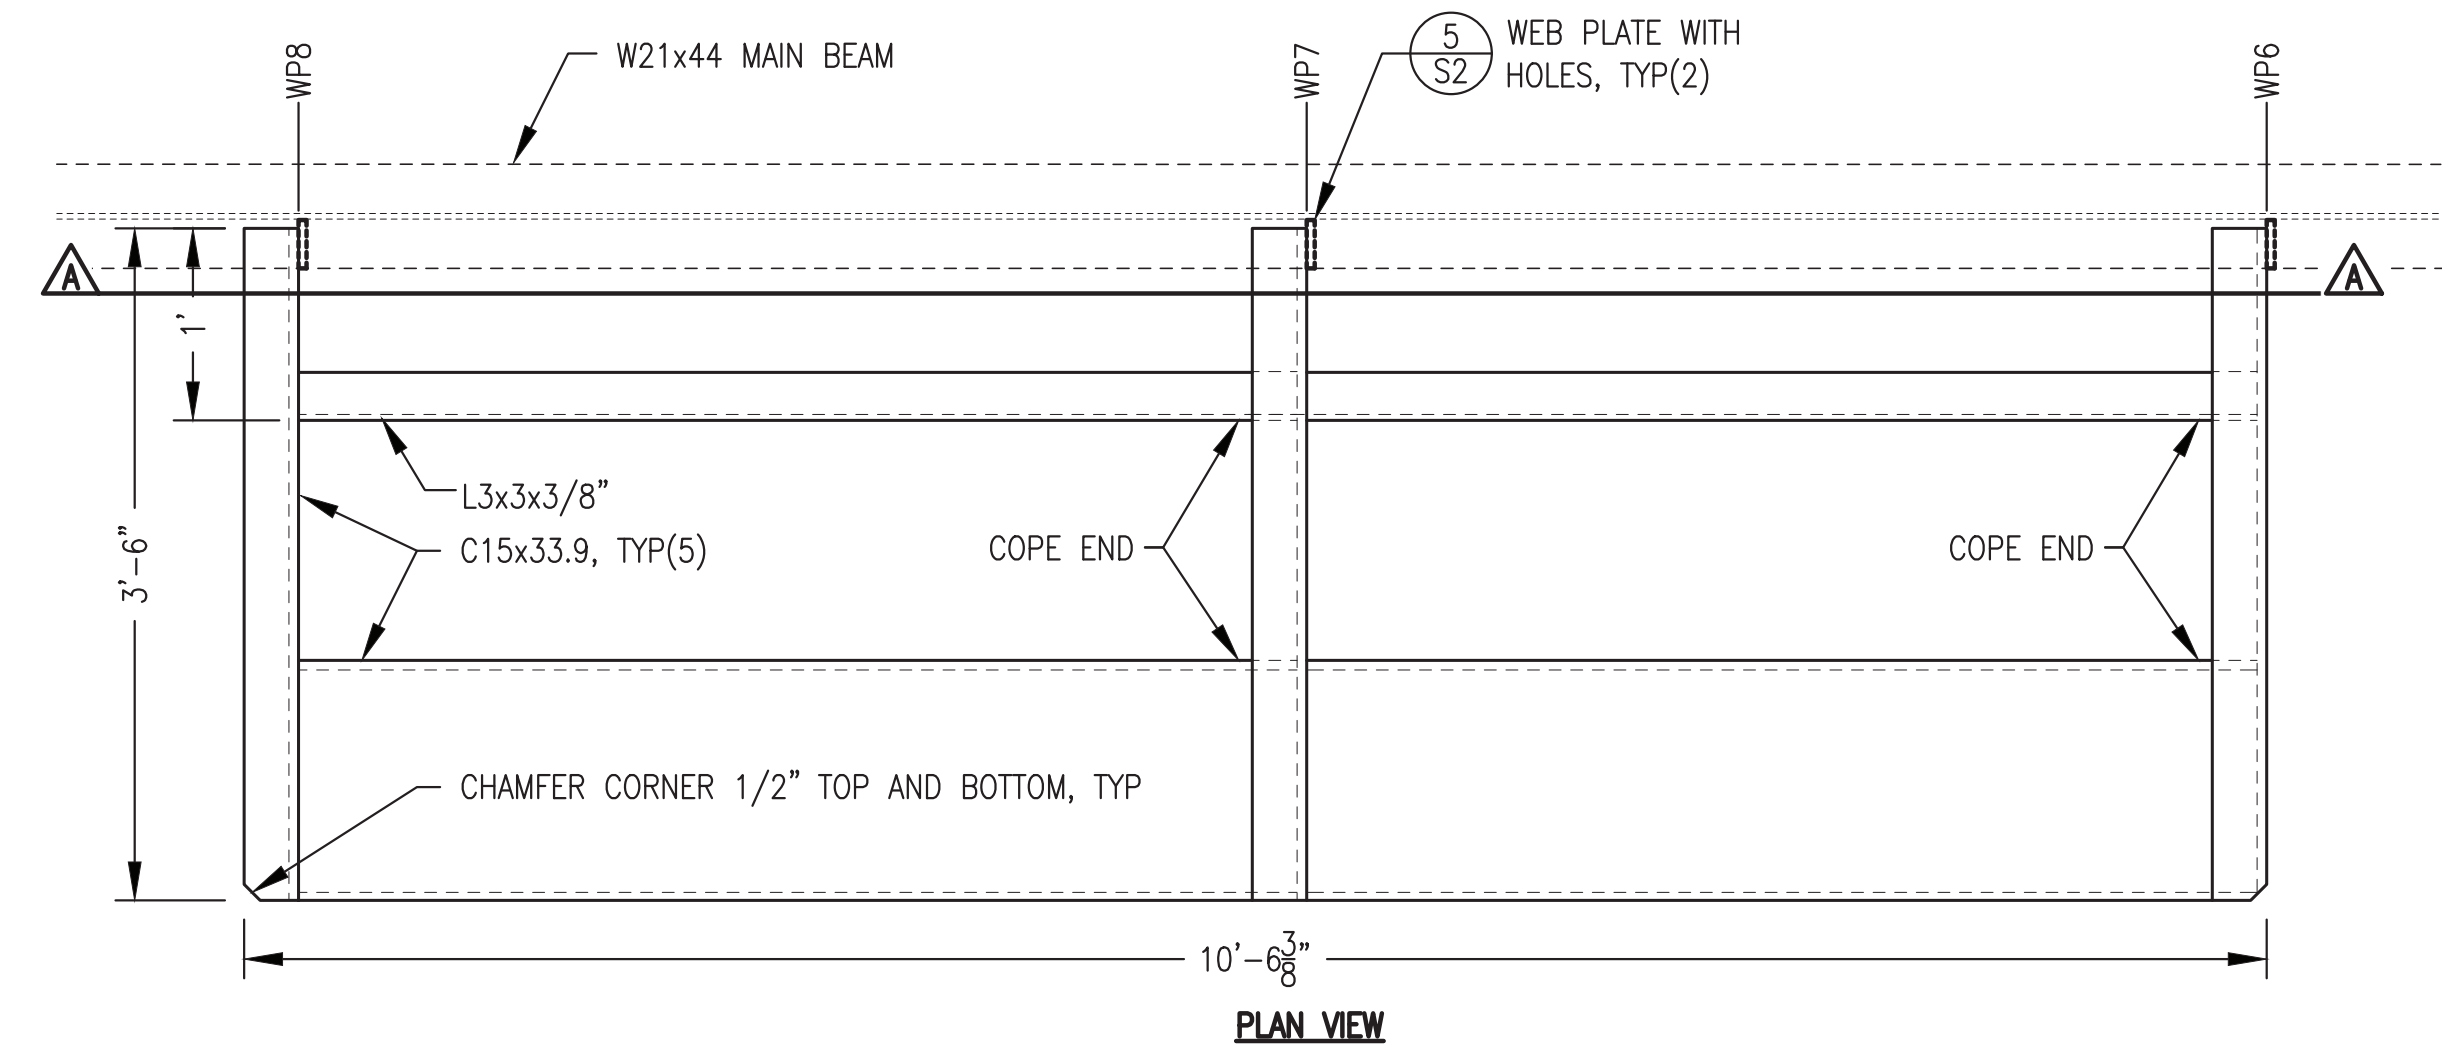


2 RADIATOR SUPPORT FRAMING PLAN & SECTION  
S5.4 1"=1'-0"

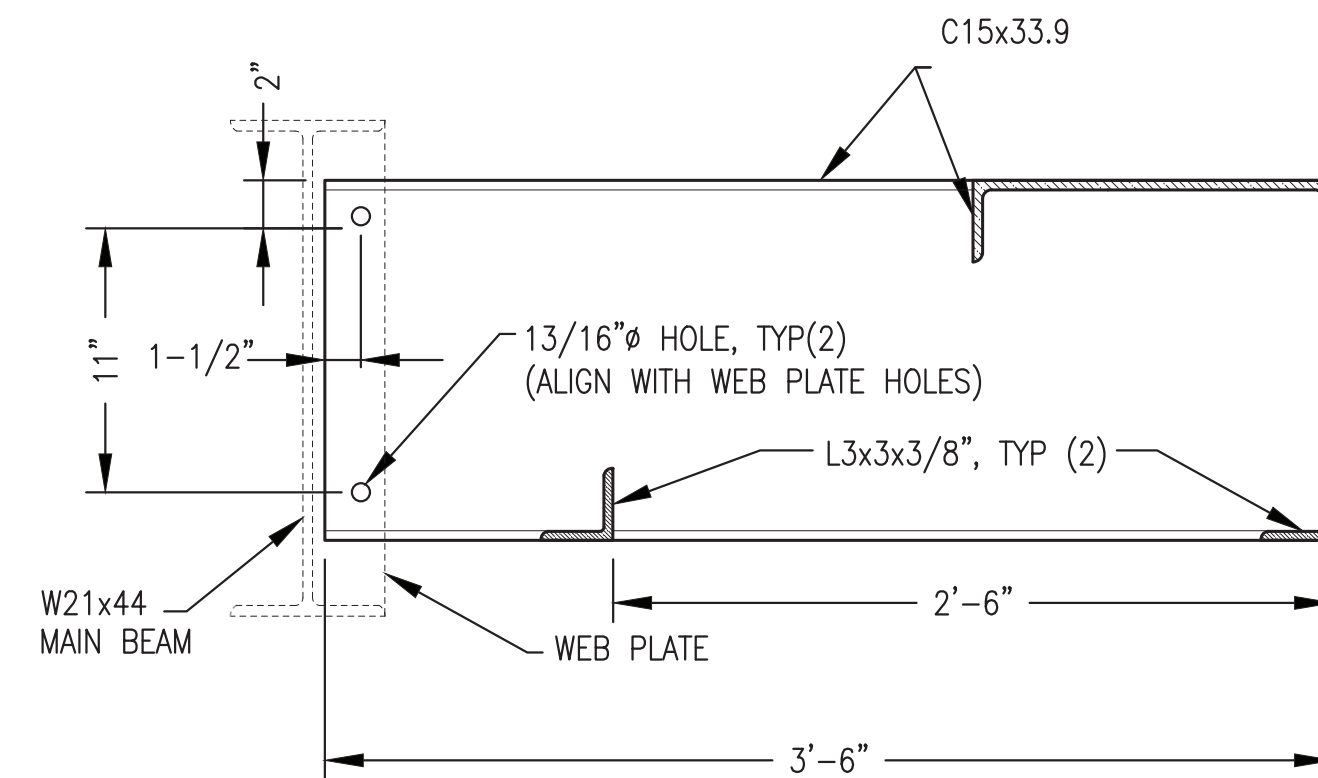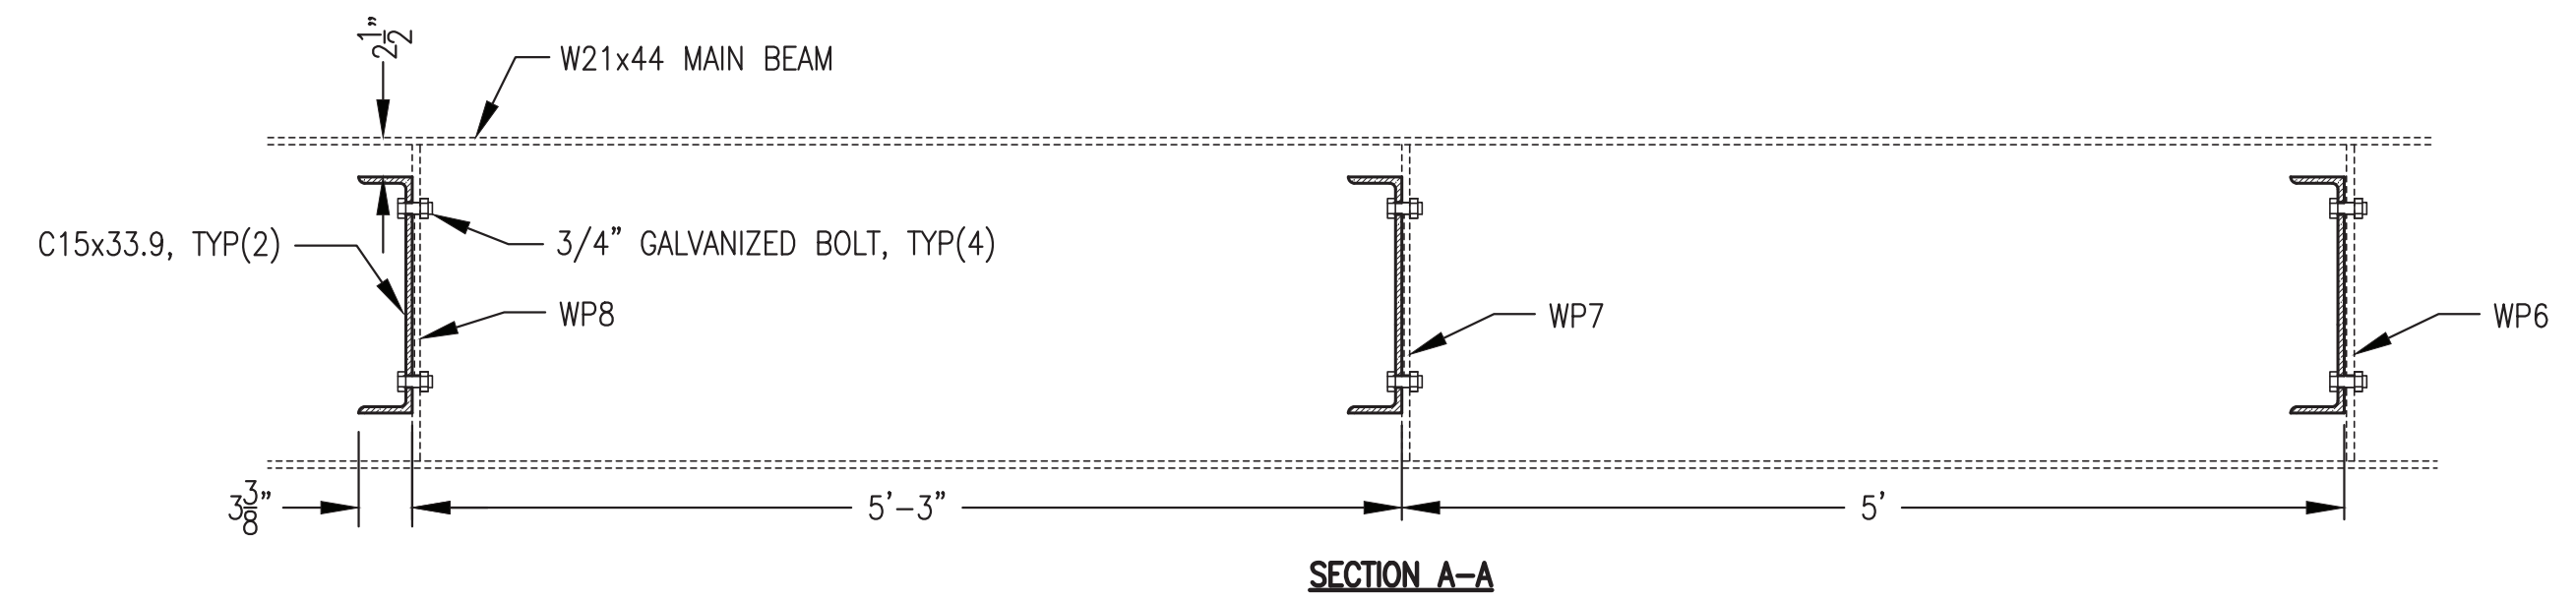

3 RADIATOR SUPPORT SECTION & MAIN BEAM CONNECTION DETAIL  
S5.4 1-1/2"=1'-0"

ALL EXTERIOR ASSEMBLIES THIS SHEET WERE FABRICATED AS PART OF THE PRIOR MODULE FABRICATION. FINAL INSTALLATION OF EXTERIOR ASSEMBLIES IS INCLUDED IN THE ON SITE SCOPE.

ISSUED FOR  
CONSTRUCTION  
MARCH 2023

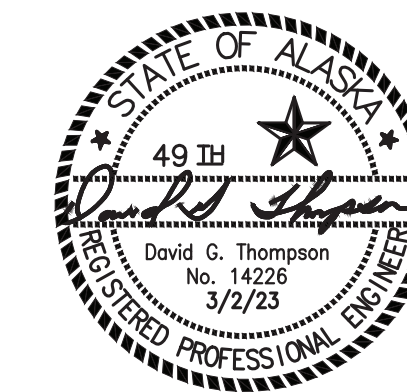

ALASKA ENERGY AUTHORITY		
PROJECT: NELSON LAGOON POWER SYSTEM UPGRADE		
TITLE: RADIATOR SUPPORT FABRICATION DETAILS		
DRAWN BY: JTD	SCALE: AS NOTED	
DESIGNED BY: DGT/BCG	DATE: 3/2/23	
FILE NAME: NELS PP S1-S5	SHEET:	S5.4
PROJECT NUMBER:		
P.O. 111405, Anchorage, AK 99511 (907)349-0100		

**PIPING LEGEND**

	BUTTERFLY VALVE
	BALL VALVE
	CHECK VALVE
	HOSE END DRAIN VALVE
	GAUGE COCK
	Y-STRAINER
	AUTOMATIC AIR VENT
	FLEXIBLE CONNECTOR
	FLANGED JOINT
	UNION
	ELBOW TURNED UP
	ELBOW TURNED DOWN
	PIPING CONNECTION (TEE)
	PIPING REDUCER
	DIRECTION OF FLOW

**INSTRUMENT/CONTROL LEGEND**

	PRESSURE GAUGE
	ANALOG THERMOMETER
	DIGITAL THERMOMETER
	TEMPERATURE TRANSMITTER
	PRESSURE TRANSMITTER
	DIFFERENTIAL PRES GAUGE
	FLOW METER
	FLOAT SWITCH
	LOW COOLANT SWITCH
	TANK LEVEL MONITOR
	LEVEL SENSOR PROBE
	GLYCOL LEVEL SENSOR

NOTE: SEE ELECTRICAL FOR ADDITIONAL DETAIL ON CONTROL & INSTRUMENTATION DEVICES

**ABBREVIATIONS**

∅	DIAMETER (PHASE)
A	AMPS
AFF	ABOVE FINISHED FLOOR
BTU	BRITISH THERMAL UNIT
DFR	DIESEL FUEL RETURN
DFS	DIESEL FUEL SUPPLY
ECR	ENGINE COOLANT RETURN
ECS	ENGINE COOLANT SUPPLY
EW	ENTERING WATER TEMPERATURE
EXIST	EXISTING
FPT	FEMALE PIPE THREAD
GA	GAUGE
GALV	GALVANIZED
GPM	GALLONS PER MINUTE
GRC	GALVANIZED RIGID CONDUIT
HP	HORSEPOWER
HYR	HYDRONIC RETURN
HYS	HYDRONIC SUPPLY
ID	INSIDE DIAMETER
KW	KILOWATT
LT	LIQUID TIGHT
LWT	LEAVING WATER TEMPERATURE
MAX	MAXIMUM
MBH	THOUSAND BTU PER HOUR
MIN	MINIMUM
MPT	MALE PIPE THREAD
NC	NORMALLY CLOSED
NO	NORMALLY OPEN
OC	ON CENTER
OD	OUTSIDE DIAMETER
PRV	PRESSURE RELIEF VALVE
PSI	POUNDS/PER SQUARE INCH
PSID	PSI DIFFERENTIAL
PSIG	PSI GAUGE
SCH	SCHEDULE
TDH	TOTAL DEVELOPED HEAD
TYP	TYPICAL
UOR	USED OIL RETURN
V	VOLTS
W	WATTS
WG	WATER GAUGE

**ENGINE COOLING SYSTEM EQUIPMENT SCHEDULE**

SYMBOL	SERVICE/FUNCTION	DESCRIPTION	MANUFACTURER/MODEL
R-1 R-2	GLYCOL RADIATOR	SINGLE PASS, 4 ROW, VERTICAL CORE, 3" FLANGED CONNECTIONS, GALVANIZED COATING, EXPANDED METAL GUARD. 6,000 BTU/MIN AT 77°F AMBIENT, 50 GPM 50% ETHYLENE GLYCOL AT 192°F IN. 0.22 PSI MAX GLYCOL PRESSURE DROP. 3 HP, 460 V, 3 PH, MOTOR SUITABLE FOR VFD OPERATION AT 10:1 TURNDOWN RATIO.	DIESEL RADIATOR PART NO. DR3490
TV-1	COOLANT THERMOSTATIC VALVE	3" ANSI 125# FLAT FACED FLANGES, CAST IRON BODY, FACTORY SET NON-ADJUSTABLE FIELD REPLACEABLE THERMOSTATIC ELEMENTS, 175F NOMINAL TEMPERATURE	FPE PART NO. A3010-175
TV-2	HEAT RECOV. THERMOSTATIC VALVE	2" ANSI 125# FLAT FACED FLANGES, CAST IRON BODY, FACTORY SET NON-ADJUSTABLE FIELD REPLACEABLE THERMOSTATIC ELEMENTS, 185F NOMINAL TEMPERATURE,	FPE PART NO. AF2012-185
ET-1	GEN COOLANT EXPANSION TANK	24 GALLON CAPACITY TANK, 12.75" O.D x 48" LONG FABRICATED STEEL TANK, SEE FABRICATION DETAIL	CUSTOM FABRICATION
HP-EC	ENGINE COOLANT FILL HAND PUMP	DOUBLE ACTION PISTON HAND PUMP, ALUM HOUSING, SS PISTON SHAFT & LINER, BUNA-N SEALS, ANTI-SIPHONING VALVE.	GPI MODEL HP-100
G-EC	ENGINE COOLANT GLYCOL TANK LEVEL GAUGE	MAGNETIC OPERATED SPIRAL GAUGE FOR #1 DIESEL, 25 PSIG MAX OPERATING PRESSURE, 35" LIQUID COLUMN PLUS 4" RISER.	ROCHESTER MODEL 8660
GT-1	ENGINE COOLANT GLYCOL STORAGE TANK	60 GALLON CAPACITY, 36"x10"x44" HIGH FABRICATED RECTANGULAR STEEL TANK, SEE FABRICATION DETAIL	CUSTOM FABRICATION

**HEAT RECOVERY & PLANT HEATING EQUIPMENT SCHEDULE:**

SYMBOL	SERVICE/FUNCTION	DESCRIPTION	MANUFACTURER/MODEL
HX-1	POWER PLANT HEAT EXCHANGER	316 SS PLATES, BRAZED CONST. 2" SOLDER CUP PORTS, 290 MBH MIN CAPACITY. PRIMARY: 35 GPM 195F EWT (50% ETHYLENE) 2.0 PSI MAX WPD, SECONDARY: 28 GPM 185F LWT (50% PROPYLENE) 1.3 PSI MAX WPD	SWEP INTERNATIONAL AB B120THx60/1P
P-CUH1	CONTROL ROOM HEAT	1 GPM AT 18' TDH, 1/25HP, 115V, 1∅. PROVIDE WITH 3/4" SOLDER COMPANION SHUT OFF FLANGES, GASKETS, & BOLTS.	GRUNDFOS UPS 15-58FC SPEED 3
P-HR1A	HEAT RECOV. PRIMARY	30 GPM AT 7' TDH, 1/8 HP, 115V, 1∅. PROVIDE WITH 1-1/4" NPT COMPANION FLANGES, GASKETS, & BOLTS. SET TO CP-1	GRUNDFOS MAGNA1 32-60 F CONSTANT PRESSURE
P-HR1B	HEAT RECOV. SECONDARY	20 GPM AT 21' TDH, 1/3 HP, 115V, 1∅. PROVIDE WITH 1-1/2" NPT COMPANION FLANGES, GASKETS, & BOLTS. SET TO CP-3. FIELD INSTALL OWNER FURNISHED CIM 500 MODULE.	GRUNDFOS MAGNA3 40-80 F CONSTANT PRESSURE CIM 500 PART# 98301408
CUH-1	CONTROL ROOM HEAT	WALL MOUNTED HOT WATER CABINET UNIT HEATER, 17 MBH AT 1 GPM 180F EWT & 60F EAT.	TOYOTOMI HC-190 WITH WALL MOUNT BRACKET
ET-2	HEAT RECOV. EXP. TANK	BLADDER TYPE EXPANSION TANK, 44 GALLON TANK, 22 GALLON ACCEPTANCE VOL, 125 PSIG WORKING PRESSURE, 12 PSIG PRE-CHARGE.	AMTROL AX-80

**PIPE/TUBING STRUT CLAMP SCHEDULE**

PIPE/TUBE	CLAMP #	PIPE/TUBE	CLAMP #	NOTES:
1/2" COPPER	BVT062	1/2" STEEL	B2008	1) ALL CLAMP NUMBERS ARE B-LINE. EQUIVALENT EQUALS ACCEPTABLE. 2) ALL COPPER TUBE CLAMPS TO BE CUSHIONED, VIBRA-CLAMP. 3) ALL STEEL PIPE CLAMPS NOT CUSHIONED. USE FOR ALL STEEL PIPE AND RIGID CONDUIT. 4) SEE PLANS, ELEVATIONS, ISOMETRICS, AND DETAILS FOR ACTUAL PIPE SIZES.
3/4" COPPER	BVT087	3/4" STEEL	B2009	
1" COPPER	BVT112	1" STEEL	B2010	
1-1/4" COPPER	BVT125	1-1/4" STEEL	B2011	
1-1/2" COPPER	BVT162	1-1/2" STEEL	B2012	
2" COPPER	BVT212	2" STEEL	B2013	
2-1/2" COPPER	BVT262	2-1/2" STEEL	B2014	
3" COPPER	BVT312	3" STEEL	B2015	

**VENTILATION EQUIPMENT SCHEDULE:**

SYMBOL	SERVICE/FUNCTION	DESCRIPTION	MANUFACTURER/MODEL
EF-1 EF-2	GENERATION ROOM EXHAUST FANS	DIRECT DRIVE 14" PROPELLER SIDEWALL EXHAUST FAN, 2,100 CFM AT 0.375" SP, 1,750 RPM. SPECIAL 1/2 HP, 115 V, 1 PH VARIGREEN MOTOR WITH OPTIONAL 0-10V LEADS AND OPTIONAL TRANSFORMER	GREENHECK SE1-14-436-VG (1/2 HP)
EF-1 EF-2 COMB.	FAN & INTAKE DAMPERS	OPPOSED BLADE LOW-LEAKAGE CONTROL DAMPER, AIRFOIL BLADES, GALV STEEL CONSTRUCTION, ACETAL BEARINGS, STAINLESS STEEL JAMB SEALS, TPE BLADE SEALS.	GREENHECK VCD-33
MD	MOTORIZED DAMPER ACTUATOR	MULTI-VOLTAGE SPRING RETURN ACTUATOR	BELIMO AF-BUP

**FUEL SYSTEM EQUIPMENT SCHEDULE**

SYMBOL	SERVICE/FUNCTION	DESCRIPTION	MANUFACTURER/MODEL
P-DF1	DAY TANK FILL PUMP	ROTARY GEAR PUMP, 5 GPM @ 25 PSID, C-FRAME MOUNT, 1" FPT INLET AND OUTLET, IRON CONSTRUCTION, STEEL SHAFT, CARBON GRAPHITE BUSHINGS, BUNA-N LIP SEAL, WITH 75 PSID INTERNAL PRV. DIRECT MOUNT TO FOOT MOUNT 56C FRAME MOTOR, 1,200 RPM, 1/2 HP, 115VAC.	GORMAN RUPP GMC1DC4-B-40C PUMP AND CENTURY #C827 MOTOR FOR FIELD ASSEMBLY
P-DF2	DIESEL CIRC. PUMP		
P-U01	USED OIL DRAIN PUMP		
P-U02	USED OIL INJECTION PUMP	ROTARY GEAR PUMP GEAR PUMP - 1.2 GPH @ 15 PSID, 1/8" FPT INLET AND OUTLET, PEEK GEARS, PTFE SEALS, MAGNETICALLY COUPLED TO FOOT MOUNT 56C FRAME MOTOR, 1,725 RPM, 1/2 HP, 115VAC.	MICROPUMP GA-V21J8FS.A PUMP WITH #81518 ADAPTER & CENTURY #C826V1 MOTOR
HP-DI	DAY TANK FILL HAND PUMP	DOUBLE ACTION PISTON HAND PUMP, ALUM HOUSING, SS PISTON SHAFT & LINER, BUNA-N SEALS, ANTI-SIPHONING VALVE.	GPI MODEL HP-100
G-DI	DAY TANK LEVEL GAUGE	MAGNETIC OPERATED SPIRAL GAUGE FOR #1 DIESEL, 25 PSIG MAX OPERATING PRESSURE, 35" LIQUID COLUMN PLUS 4" RISER.	ROCHESTER MODEL 8660
M-DI	DAY TANK METER	STEEL BODY, 1" ANSI 150# FLANGED ENDS, 20-800 GPH FLOW RANGE, O-RINGS AND SEALS COMPATIBLE WITH #1 DIESEL, DIRECT READ 6-DIGIT REGISTER TO 0.1 GAL, DRY CONTACT PULSER.	ISTEC CONTOIL 9226-F
F-DI	DAY TANK FILTER	THREE FILTER BANK WITH INDIVIDUAL FILTER ISOLATION VALVES, IMPACT RESISTANT "SEE-THRU" BOWLS, 15 PSIG WORKING PRESSURE. WITH 1/2" WATER PROBE PORT & 3 EACH WATER-IN-FUEL DETECTION KITS. INSTALL 3 EACH 10 MICRON AQUABLOC FILTER ELEMENTS & FURNISH 3 SPARES.	RACOR TURBINE 791000FV10-P WATER-IN-FUEL RR30880E ELEMENTS 2020V10
F-GEN	GENSET FILTER	SINGLE FILTER, IMPACT RESISTANT "SEE-THRU" BOWL, 15 PSIG WORKING PRESSURE. INSTALL 10 MICRON AQUABLOC FILTER ELEMENTS & FURNISH 1 SPARE.	RACOR TURBINE 1000FV-10 ELEMENT 2020V10
F-UOB	USED OIL BLENDER FILTER	CUSTOM FABRICATED FILTER BANK. FURNISH WITH TWO STAGE ELEMENTS: 10 MICRON HYDROSORB II FILTER 2 MICRON PARTICULATE FILTER PROVIDE 3 OF EACH ELEMENT TYPE	CIM-TEK #30034 (HYDROSORB) CIM-TEK #30066 (2 MICRON)

**ABV-1**



1" ACTUATED BALL VALVE (ON SITE)	ACTUATED BALL VALVE ASSEMBLY RATED TO -50F. TYPE 304 STAINLESS STEEL FABRICATED COUPLING BRACKET, SHAFT, AND FASTENERS CONFIGURED TO ALLOW WRENCH ACCESS FOR MANUAL OPERATION OF VALVE WITHOUT REMOVING ACTUATOR. LOW TEMP BALL VALVE, 150# RF FLANGED ENDS. ELECTRIC ACTUATOR WITH OPERATING VOLTAGE, NEMA RATING, AND TORQUE AS INDICATED. CONFIGURE WITHOUT MANUAL OVERRIDE SHAFT EXTENSION. FURNISH WITH PTC SELF REGULATING HEATER, AUXILIARY SWITCH SET (AUXILIARY SWITCHES 3 & 4), AND EXXON BEACON 325 SEVERE COLD LUBRICANT.	VALVE ASSEMBLY: DG VALVE (780) 413-1760  1" BALL VALVE - KECKLEY PART # BVF1RF2RSSRGS1-100  2" BALL VALVE - KECKLEY PART # BVF1RF2RSSRGS1-200  NEMA 7 ACTUATOR - 600 IN-LBS TORQUE, 10 SECOND STROKE TIME, 0.50 LOCKED ROTOR AMPS. RCS MODEL SXR-1023
----------------------------------	---------------------------------------------------------------------------------------------------------------------------------------------------------------------------------------------------------------------------------------------------------------------------------------------------------------------------------------------------------------------------------------------------------------------------------------------------------------------------------------------------------------------------------------	-------------------------------------------------------------------------------------------------------------------------------------------------------------------------------------------------------------------------------------------------------------------------

**INSTRUMENTATION SCHEDULE**


SYMBOL	SERVICE/FUNCTION	DESCRIPTION	MANUFACTURER/MODEL
TT	TEMPERATURE TRANSMITTER	RTD, 20-240°F RANGE, 4-20mA OUTPUT, 1/2" NPT PIPING CONNECTION, 6mm DIAMETER BY 2.5" LONG STEM, HIRSCHMANN ELECTRICAL CONNECTION	NOSHOK 800-20/240-1-1-8-8-025-6
PT	PRESSURE TRANSMITTER	0-60 PSIG RANGE, 4-20mA OUTPUT, 1/4" NPT PIPING CONNECTION, HIRSCHMANN ELECTRICAL CONNECTION	NOSHOK 100-60-1-1-2-7
LCA	GLYCOL TANK LOW COOLANT ALARM	LOW COOLANT LEVEL ALARM FLOAT SWITCH, SEE MECHANICAL FOR INSTALLATION DETAILS	MURPHY EL-150-K1
GLS	GLYCOL TANK LEVEL SENSOR PROBE	12" PROBE, 2" NPT TANK CONNECTION, SS FLOAT, 1/4" RESOLUTION, NEMA 4 ENCLOSURE WITH SIGNAL CONDITIONER AND 1/2" NPT CONDUIT CONNECTION	INNOVATIVE COMPONENTS CLM-2012-SS 5343A 2-WIRE TRANSMITTER
FS	DAY TANK/HOPPER FLOAT SWITCH	VERTICAL ACTION FLOAT SWITCH, REVERSIBLE 70VSPST NC/NO SWITCH, 1/8" NPT, 1" MAX Ø BUNA-N FLOAT FOR S.G.=.47, MINIMUM 60" LONG PVC COATED #20 AWG LEAD WIRES	INNOVATIVE COMPONENTS LS-12-111/2
TLM	TANK LEVEL MONITOR PANEL	TANK LEVEL MONITOR CONSOLE FOR UP TO SIX TANKS, COLOR LCD SCREEN, ETHERNET CONNECTION WITH WEB INTERFACE, PROGRAMMABLE VOLUME CALCULATIONS WITH TEMPERATURE COMPENSATION	FRANKLIN/INCON EVO 200
LSP	DAY TANK/HOPPER TANK LEVEL SENSOR PROBE (SHOP FAB.)	TOP-MOUNT TANK PROBE WITH INSTALLATION KIT FOR 2" NPT RISER, WATER TIGHT COMPRESSION GLAND FITTING FOR CABLE ENTRANCE. FRANKLIN FUEL SYSTEMS, NO SUBSTITUTES. PROBE AND RISER LENGTH AS INDICATED ON INSTALLATION DETAILS.	4' TANK PROBE: FMP-LL3-53-1 2' TANK PROBE: FMP-LL3-29-1 FLOAT: TSP-IDF2 2" FOR DIESEL INSTALLATION KIT: TSP-C2A
LSP	INTERMEDIATE TANK LEVEL SENSOR PROBE (ON SITE)	TOP-MOUNT TANK PROBE WITH INSTALLATION KIT FOR 2" NPT RISER, WATER TIGHT COMPRESSION GLAND FITTING FOR CABLE ENTRANCE. FRANKLIN FUEL SYSTEMS, NO SUBSTITUTES. PROBE AND RISER LENGTH AS INDICATED ON INSTALLATION DETAILS.	7' TANK PROBE: FMP-LL3-89-1 FLOAT: TSP-IDF2 2" FOR DIESEL INSTALLATION KIT: TSP-C2A
LS	INTERMEDIATE TANK THREE POINT FLOAT TYPE LEVEL SWITCH (ON SITE)	THREE POINT MAGNETIC FLOAT SWITCH - 2-1/2" ANSI 150# FLAT FACE FLANGE MOUNT, 3/4" NPT CONDUIT ENTRY, 8MM DIAMETER FIXED LENGTH STAINLESS STEEL STEM, 3 EACH 1.2" MAX. DIAMETER STAINLESS STEEL FLOATS FOR MINIMUM S.G.=.065, 50VA FORM A CONTACTS. 47.25" OVERALL STEM LENGTH. ACTUATION LENGTHS 13"(N.O.) & 18"(N.O.) & 46"(N.C.).	APG MODEL FLE-0A2-B3-B-A2-E-47.25in.-1.3in.N0-18in.N0-46in.NC




EQUIPMENT REQUIREMENTS FOR APPROVED EQUALS (APPLIES TO ALL SCHEDULES): SPECIFIC PARTS MANUFACTURER AND MODEL SELECTED NOT ONLY TO MEET PERFORMANCE FUNCTION BUT ALSO TO COORDINATE AND INTERFACE WITH OTHER DEVICES AND SYSTEMS. APPROVED EQUAL SUBSTITUTIONS WILL BE ALLOWED ONLY BY ENGINEER'S APPROVAL. TO OBTAIN APPROVAL, SUBMITTALS MUST CLEARLY DEMONSTRATE HOW SUBSTITUTE ITEM MEETS OR EXCEEDS SPECIFIED ITEM QUALITY AND PERFORMANCE CHARACTERISTICS AND ALSO COMPLIES WITH MECHANICAL AND/OR ELECTRICAL CONNECTIONS AND PHYSICAL LAYOUT REQUIREMENTS.

ALL MATERIALS AND EQUIPMENT ON SCHEDULES THIS SHEET WERE FURNISHED AS PART OF THE PRIOR MODULE ASSEMBLY PROJECT EXCEPT FOR THOSE ITEMS SPECIFICALLY INDICATED IN RED CLOUDS WHICH ARE TO BE FURNISHED AND INSTALLED AS PART OF THE ON SITE SCOPE.

1	DELETE FLOW METER, CHANGE P-HR1B TO MAGNA 3, & ADD OWNER FURN CIM 500	8/16/23	BCG
REV.	DESCRIPTION	DATE	BY
 ALASKA ENERGY AUTHORITY			
PROJECT: NELSON LAGOON POWER SYSTEM UPGRADE			
TITLE: MECHANICAL LEGENDS & SCHEDULES			
 Gray Stassel Engineering, Inc.		DRAWN BY: JTD DESIGNED BY: BCG FILE NAME: NELS PP M1 PROJECT NUMBER:	SCALE: AS NOTED DATE: 5/30/23 SHEET: M1.1

REV#1  
ISSUED FOR  
CONSTRUCTION  
AUGUST 2023



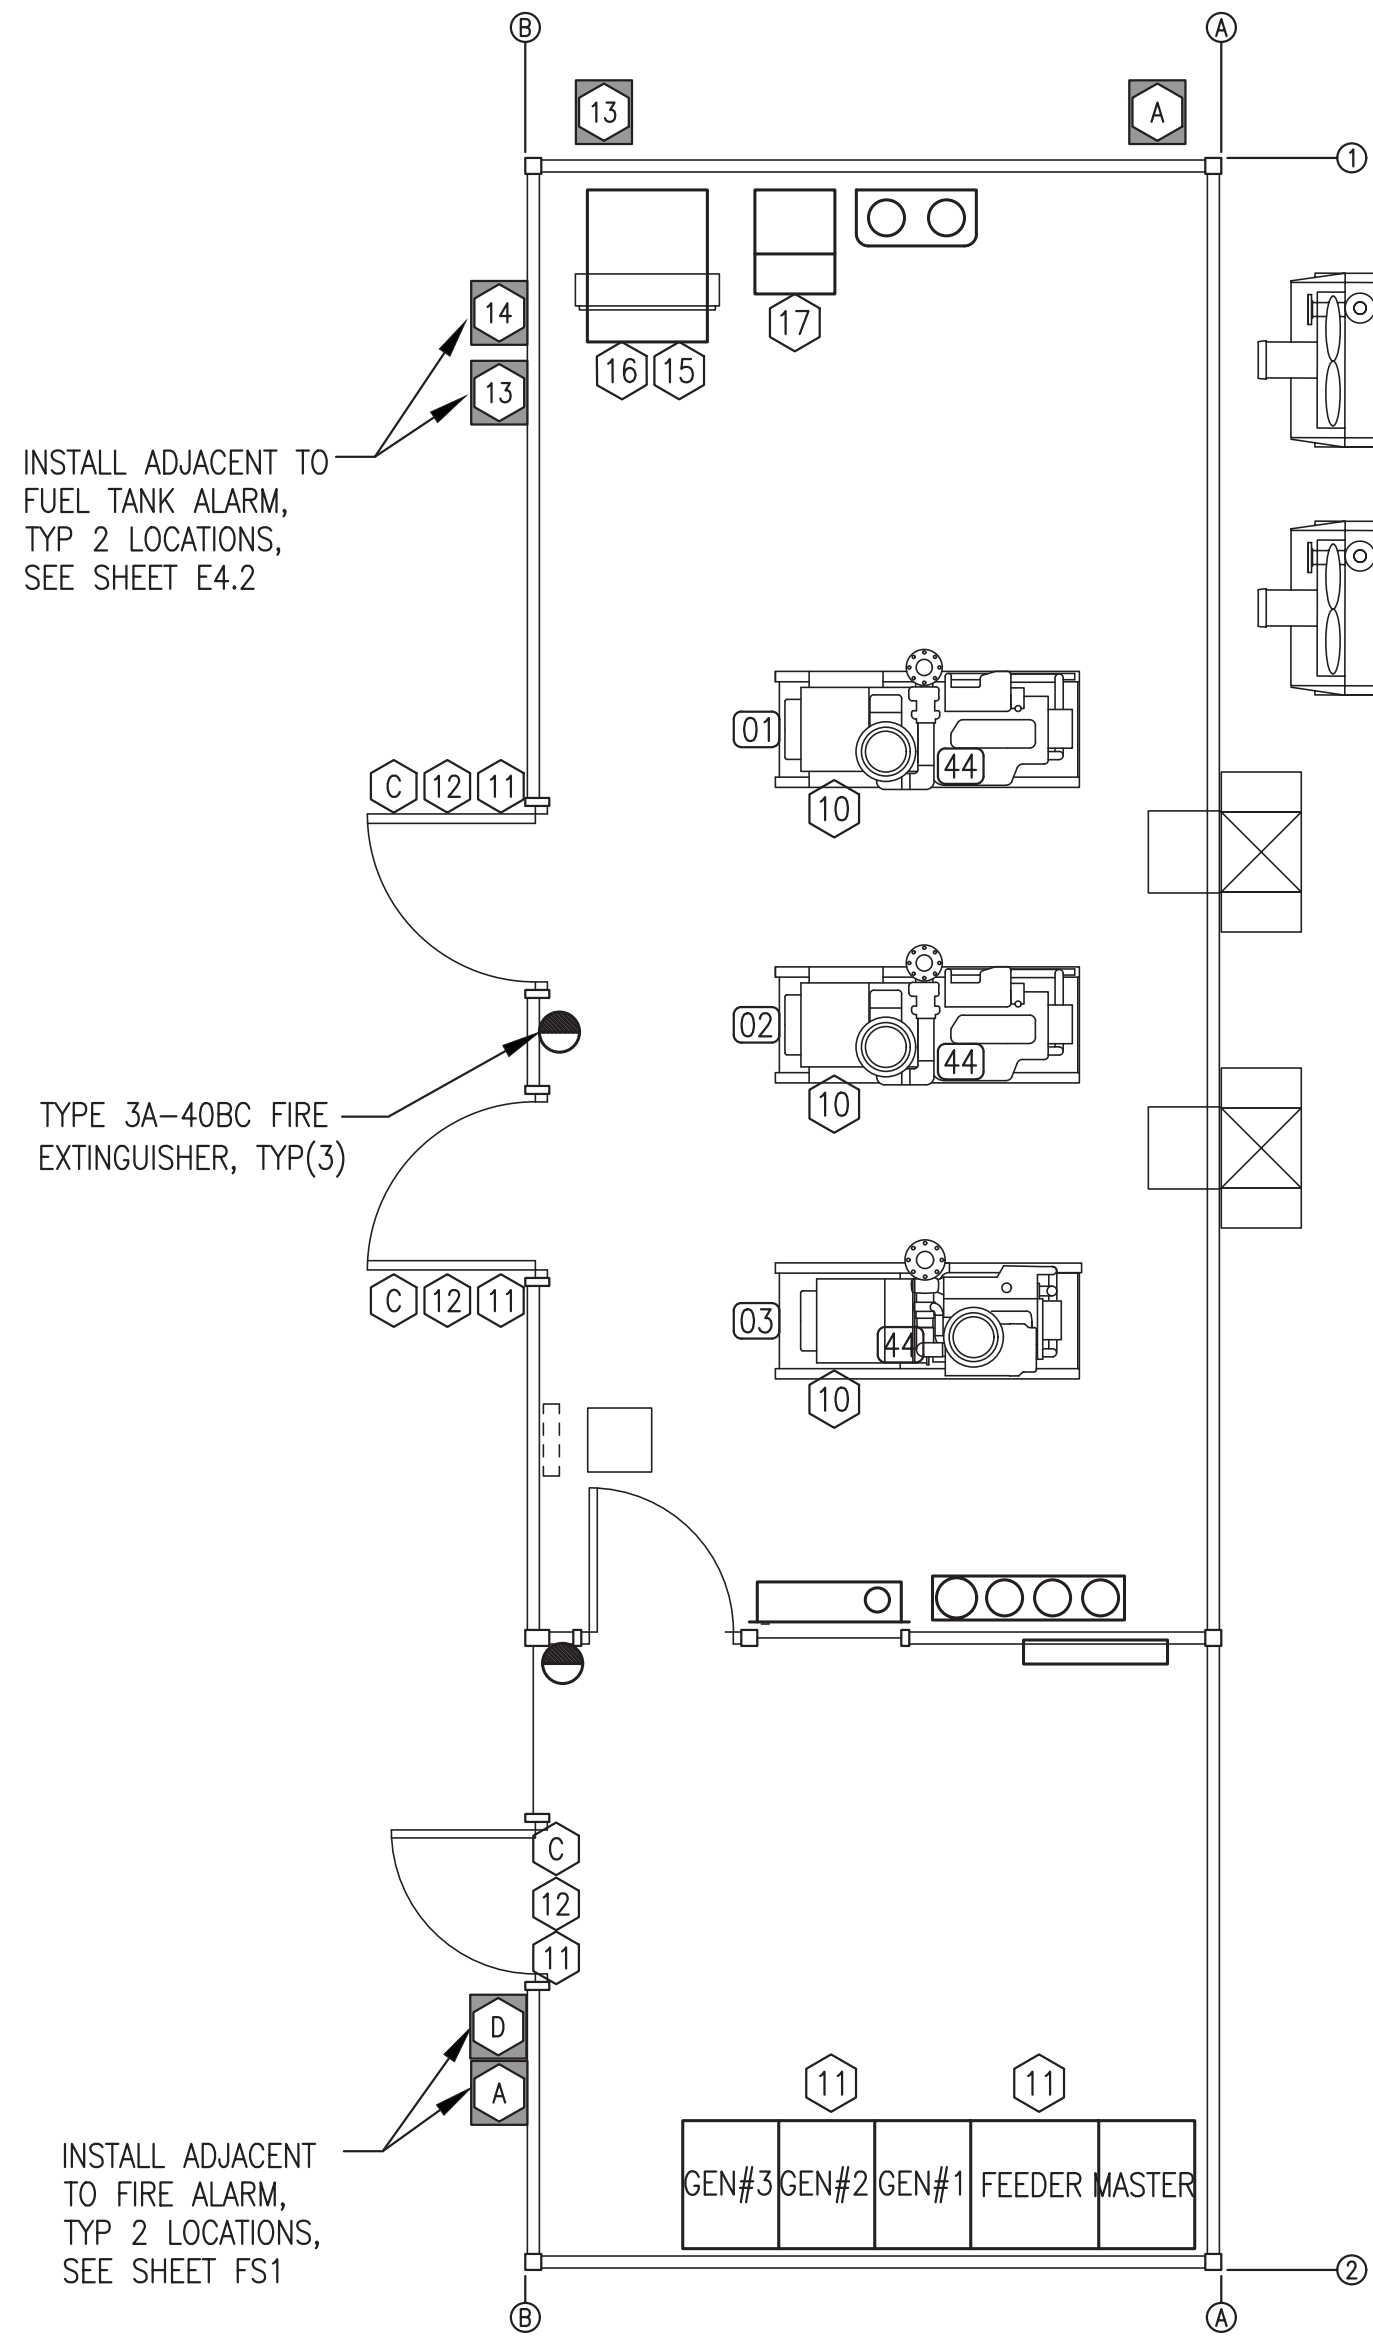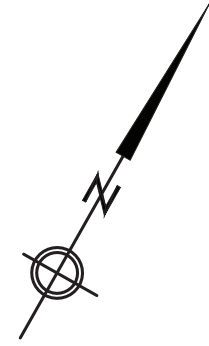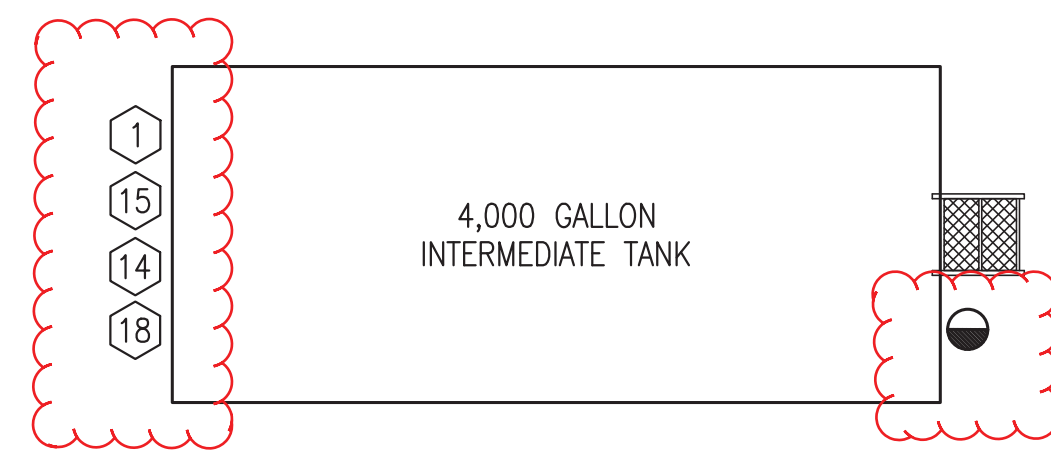

**VALVE TAG SCHEDULE:**

WHITE (EQUIPMENT)

01 "GEN#1 100KW" (DECAL)  
 02 "GEN#2 100KW" (DECAL)  
 03 "GEN#3 65KW" (DECAL)

GREEN (DIESEL FUEL)

21 "NORMALLY OPEN, CLOSE ONLY FOR EMERGENCIES & TEMPORARY MAINTENANCE OF DAY TANK & DEVICES"  
 22 "NORMALLY CLOSED, OPEN ONLY FOR HAND PRIMING DAY TANK"  
 23 "NORMALLY OPEN, CLOSE ONLY FOR TEMPORARY MAINTENANCE OF BLENDER"  
 24 "NORMALLY OPEN, CLOSE ONLY FOR TEMPORARY MAINTENANCE OF ENGINE"  
 25 "NORMALLY CLOSED, OPEN ONLY TO FILL TANK"

BROWN (USED OIL)

41 "NORMALLY CLOSED, OPEN ONLY FOR ENGINE OIL CHANGE"  
 42 "BLENDER FILTER #1, 10 MICRON HYDROSORB" (DECAL)  
 43 "BLENDER FILTER #2, 2 MICRON PARTICULATE" (DECAL)  
 44 "CHECK CONDENSATE LEVEL DAILY, DRAIN AT EACH OIL CHANGE" (DECAL)

PINK (COOLING/ETHYLENE GLYCOL)

51 "NORMALLY CLOSED, OPEN ONLY FOR ADDING COOLANT - ETHYLENE GLYCOL ONLY"  
 52 "NORMALLY CLOSED, OPEN ONLY ON HIGH COOLANT TEMPERATURE ALARM"  
 53 "NORMALLY OPEN, CLOSE ONLY ON HIGH COOLANT TEMPERATURE ALARM"  
 54 "NORMALLY OPEN, HEAT RECOVERY SUPPLY"  
 55 "NORMALLY OPEN, HEAT RECOVERY RETURN"

YELLOW (HEAT RECOVERY/PROPYLENE GLYCOL)

61 "NORMALLY CLOSED, OPEN ONLY FOR ADDING FLUID - PROPYLENE GLYCOL ONLY"  
 62 "NORMALLY OPEN, HEAT RECOVERY SUPPLY"  
 63 "NORMALLY OPEN, HEAT RECOVERY RETURN"  
 64 "NORMALLY CLOSED, OPEN ONLY FOR AIR BLEED & PURGE"  
 65 "NORMALLY OPEN, CLOSE ONLY TO CLEAN STRAINER"  
 66 "NORMALLY OPEN, CLOSE ONLY FOR TEMPORARY MAINTENANCE"

RED (ELECTRICAL)

71 "THIS PANEL IS POWERED FROM THE MAIN TANK FARM PANEL. LOCK & TAG OUT PRIOR TO SERVICING"

**SPECIFICATIONS:**  
 VALVE TAGS - 3"x5"x.08" ALUMINUM, 3/16" HOLES IN ALL FOUR CORNERS, BLACK GERBER THERMAL TRANSFER FILM PRINTED LETTERS ON GERBER 220 HIGH PERFORMANCE VINYL BACKGROUND, COLOR AS INDICATED, ONE SIDE ONLY. WARNING LITES OR APPROVED EQUAL.

DECALS - WHERE NOTED AS DECALS PROVIDE WITHOUT ALUMINUM BACKING PLATE.

**INSTALLATION NOTES:**  
 1) SEE DRAWINGS THAT FOLLOW FOR LOCATIONS OF ALL SPECIFIC FUNCTION TAGS.  
 2) SECURE EACH METAL TAG TIGHT TO VALVE, PIPE, OR DEVICE WITH STAINLESS STEEL SAFETY WIRE THROUGH ALL FOUR CORNERS OR FASTEN TO ADJACENT WALL OR SECTION OF STRUT WITH SCREWS.  
 3) APPLY DECALS TO SMOOTH SURFACES OF EQUIPMENT OR ON ADJACENT WALL. ENSURE SURFACE IS CLEAN, DRY, AND WARM PRIOR TO APPLICATION. USE HEAT GUN AS REQUIRED.  
 4) FOR ALL VALVES NOT INDICATED WITH A SPECIFIC FUNCTION TAG PROVIDE 1-1/2" ROUND BRASS TAG LABELED "N.O." FOR NORMALLY OPEN VALVES AND 1-1/2" SQUARE BRASS TAG LABELED "N.C." FOR NORMALLY CLOSED VALVES. SECURE TAGS TO VALVE OR ADJACENT PIPE WITH BEADED BRASS CHAIN.

**WARNING SIGN & INFORMATIONAL PLACARD SCHEDULE:**

PROVIDE DECALS AND SIGN BOARDS AS SPECIFIED BELOW IN ACCORDANCE WITH THE SCHEDULE. INSTALL WHERE SHOWN ON THE WARNING SIGN/PLACARD PLAN THIS SHEET AND OTHER REFERENCED SHEETS.

**DECALS**

# DECALS TO BE WHITE NON-REFLECTIVE VINYL BACKGROUND, 3M 3650-10, WITH 3M SERIES 225 HIGH PERFORMANCE VINYL LETTERS, ONE SIDE ONLY, SELF ADHESIVE BACK. NOMINAL 10"x14" SIZE UNLESS INDICATED OTHERWISE OR REQUIRED TO BE LARGER FOR SPECIFIED LETTER SIZE. WARNING LITES OR EQUAL. APPLY DECALS TO SMOOTH SURFACES OF DOORS, EQUIPMENT, OR ON ADJACENT WALL. ENSURE SURFACE IS CLEAN, DRY, AND WARM PRIOR TO APPLICATION. USE HEAT GUN AS REQUIRED.

# SIGN BOARDS TO BE EQUAL TO DECALS EXCEPT MOUNTED ON 0.08" ALUMINUM PLATE. PROVIDE 3/16" HOLES IN ALL FOUR CORNERS. ATTACH TO CHAIN LINK FENCING WITH HOG RINGS OR STAINLESS STEEL TIES. ATTACH TO WALLS OR STRUCTURES WITH STAINLESS STEEL SCREWS OR BOLTS.

**BOARDS**

WARNING SIGNS - RED LETTERING ON WHITE BACKGROUND.

A "FIRE ALARM"  
 C "CAUTION, ROOM PROTECTED BY WATER MIST FIRE PROTECTION SYSTEM, IN CASE OF FIRE KEEP DOOR CLOSED AND DO NOT ENTER"  
 D "FLASHING LIGHT MEANS FIRE SUPPRESSION AGENT HAS DISCHARGED"  
 1 "DANGER FLAMMABLE, NO SMOKING OR OPEN FLAMES"  
 10 "CAUTION: THIS UNIT STARTS AUTOMATICALLY, LOCK & TAG OUT PRIOR TO SERVICE"  
 11 "DANGER HIGH VOLTAGE, AUTHORIZED PERSONNEL ONLY"  
 12 "CAUTION HEARING & EYE PROTECTION REQUIRED"  
 13 "FUEL OIL DAY TANK ALARM"  
 14 "IN CASE OF SPILL CALL DEC 1-800-478-9300"


**INFORMATIONAL PLACARDS** - BLACK LETTERING ON WHITE BACKGROUND.

15 "CHECK INTERMEDIATE TANK LEVEL DAILY, FILL WHEN BELOW 3'-6"  
 16 "TO MANUALLY FILL DAY TANK IN CASE OF EMERGENCY:  
 1) TURN OFF POWER TO THE DAY TANK CONTROL PANEL  
 2) MANUALLY OPEN ACTUATOR VALVE AT INTERMEDIATE TANK USING A WRENCH  
 3) OPEN NORMALLY CLOSED VALVE BY HAND PUMP  
 4) OPERATE HAND PUMP WHILE MONITORING LEVEL GAUGE"  
 17 "TO CHANGE ENGINE OIL:  
 1) VERIFY ENGINE OIL HAS NOT BEEN CONTAMINATED WITH GLYCOL OR OTHER FLUIDS.  
 2) LOCK & TAG GENERATOR OUT OF SERVICE  
 3) OPEN NORMALLY CLOSED DRAIN VALVE AT GEN  
 4) TURN ON PUMP TIMER & PUMP OUT ENGINE OIL  
 5) CHANGE FILTER & PLACE OLD ONE IN HOPPER  
 6) CLOSE DRAIN VALVE & REFILL ENGINE  
 7) RUN ENGINE, SHUT OFF, & CHECK DIPSTICK  
 8) TOP OFF & PLACE ENGINE BACK IN SERVICE"  
 18 "INTERMEDIATE TANK MAX FILL LEVEL 5'-10" (90% TANK CAPACITY)

ALL DECALS, SIGN BOARDS, FIRE EXTINGUISHERS, AND VALVE TAGS WERE FURNISHED AND INSTALLED AS PART OF THE PRIOR MODULE ASSEMBLY PROJECT EXCEPT FOR THOSE ITEMS SPECIFICALLY INDICATED IN RED CLOUDS WHICH ARE TO BE FURNISHED AND INSTALLED AS PART OF THE ON SITE SCOPE.

1	ADD DECAL 44	8/16/23	BCG
REV.	DESCRIPTION	DATE	BY
PROJECT: NELSON LAGOON POWER SYSTEM UPGRADE			
TITLE: WARNING SIGN & FIRE EXTINGUISHER PLAN, SIGN & VALVE TAG SCHEDULES			
DRAWN BY: JTD		SCALE: AS NOTED	
DESIGNED BY: BCG		DATE: 5/30/23	
FILE NAME: NELS PP M1		SHEET: M1.2	
PROJECT NUMBER:			
P.O. 111405, Anchorage, AK 99511 (907)349-0100			

REV#1  
 ISSUED FOR  
 CONSTRUCTION  
 AUGUST 2023

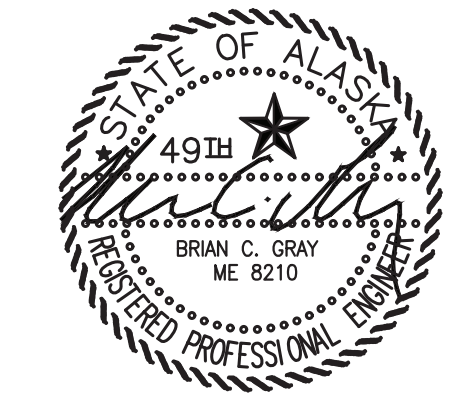

Demand Control Table (PLC)				
Demand Control	Generator(s) On Line	On-line kW (Overload)	Level Increase	Level Decrease
Level 1	#3	65	55	---
Level 2	#1 or #2	100	90	45
Level 3	#3 & #1 or #2	165	145	80
Level 4	All	265	---	125

Note : Gen #1 & #2 are equal capacity. Manually select lead unit.

Engine-Generator Alarm Settings (Easygen - EZGN)			
Function	Normal Range	Alarm	Shut Down
Overspeed	1795-1805	----	1900 RPM
Oil Pressure	30-50 PSI	14.5 PSI	10 PSI
Air Filter Vacuum	1-10" H <sub>2</sub> O	15" H <sub>2</sub> O	20" H <sub>2</sub> O
Coolant Temp.	180-200°F	210°F	215°F
Exhaust Temp.	500-850°F	900°F	-----
Under Frequency	59.5-60.5 Hz	----	58.2 Hz
Over Frequency	59.5-60.5 Hz	----	61.8 Hz
Under Voltage	470-490 V	----	432 V
Over Voltage	470-490 V	----	528 V
Reverse Power	0	----	10%

Generator Breaker Settings (Easygen - EZGN)	
Function	Setting
Gen #1 Breaker Trip Setpoint (EZGN Rated Current)	200 A
Gen #2 Breaker Trip Setpoint (EZGN Rated Current)	200 A
Gen #3 Breaker Trip Setpoint (EZGN Rated Current)	150 A
Gen Breaker Level 1 (100%) Time Over Current	3 sec.
Gen Breaker Level 2 (120%) Time Over Current	1 sec.
Gen Breaker Level 3 (250%) Time Over Current	0.4 sec.

Feeder Breaker Settings (Feeder Protection Relay - FPR)	
Function (Note: Element 1 is the only active element)	Setting
T.O.C. Trip Pickup (amps) Note: 5A = 100% of CT rating	5.0
T.O.C. Curve Selection	U4
T.O.C. Time Dial	5.00
E.M Reset delay (Y/N)	N
Constant Time Adder (seconds)	0.00
Minimum Response Time (seconds)	0.00
Maximum Phase T.O.C. Torque Control	1

Radiator VFD Settings	
Function	Setting
Min PID Feedback	20
Max PID Feedback	240
rSL (Wake UP Threshold)	1
PID Reference Temperature	175°F
Proportional Gain	0.93
Integral Gain	0.3
Derivative	0
Minimum Speed	10 Hz.
Low Speed Timeout	10 sec.
Loss of Phase	Ignore

POWER PLANT GENERATION SWITCHGEAR OPERATION

THIS POWER PLANT IS DESIGNED TO OPERATE IN AUTOMATIC MODE UNDER CONTROL OF THE PROGRAMMABLE LOGIC CONTROLLER (PLC). MONITORING AND CONTROL IS PRIMARILY DONE THROUGH THE OPERATOR INTERFACE UNIT (OIU). IN AN EMERGENCY SUCH AS A FAILURE OF THE PLC IT CAN ALSO BE OPERATED IN MANUAL MODE. EACH ENGINE IS CONTROLLED BY AN INDIVIDUAL EASYGEN (EZGN) GENSET CONTROLLER LOCATED IN EACH GENERATOR SECTION. FOLLOWING ARE INSTRUCTIONS FOR OPERATING THE SYSTEM. SEE SECTION 3.1 OF THE O&M MANUAL FOR DETAILED SEQUENCES.

AUTOMATIC OPERATION:

- 1) VERIFY THAT THE "SYSTEM MODE" SWITCH ON THE MASTER SECTION IS SET TO AUTO.
- 2) CHECK THE MASTER SECTION FOR ANY FAULTS AS INDICATED BY THE ALARM LAMPS. CORRECT THE CAUSE OF THE FAULT (EMERGENCY STOP, LOW COOLANT LEVEL, FEEDER BREAKER TRIPPED, ETC.) PRESS THE ALARM RESET BUTTON ON THE MASTER SECTION AND VERIFY THAT THE ALARMS CLEAR.
- 3) CHECK EACH GENERATOR SECTION FOR ANY FAULTS. FOR ENGINE-GENERATOR RELATED FAULTS CORRECT THE CAUSE OF THE FAULT (LOW OIL LEVEL, HIGH TEMPERATURE, CIRCUIT BREAKER TRIPPED, ETC.). TO CLEAR ANY ALARMS PRESS THE "ALARM RESET" BUTTON ON THE GENERATOR SECTION.
- 4) PLACE EACH AVAILABLE GENERATOR IN SERVICE BY PRESSING THE "AUTO" BUTTON. IF A GENERATOR IS OUT OF SERVICE FOR REPAIR, VERIFY THE STOP BUTTON IS ILLUMINATED.
- 5) THE PLC WILL AUTOMATICALLY START ALL GENERATORS IN AUTO AND PARALLEL THEM TO THE BUS, AS SOON AS THE BUS IS ENERGIZED THE STATION SERVICE POWER WILL TURN ON.
- 6) AFTER THE AVAILABLE GENERATORS ARE ON LINE, THE PLC WILL WAIT FOR A BRIEF INTERVAL (USUALLY 15 SECONDS) AND CLOSE THE FEEDER BREAKER TO ENERGIZE THE COMMUNITY. THE RED BREAKER CLOSED LAMP WILL ILLUMINATE.

DEMAND CONTROL OPERATION (AUTO MODE):

- 1) GENERATORS ARE CONSIDERED AVAILABLE FOR DEMAND CONTROL ONLY WHEN THEIR EZGN IS IN THE AUTO MODE AND THERE ARE NO ALARMS. THE DEMAND CONTROL SYSTEM WILL UTILIZE ALL AVAILABLE GENERATORS AS REQUIRED TO MEET THE LOAD ON THE SYSTEM.
- 2) ON INITIAL STARTUP THE DEMAND CONTROL IS ACTIVATED AFTER THE FEEDER BREAKER HAS BEEN CLOSED FOR ONE MINUTE. THIS ALLOWS THE PLC TIME TO DETERMINE THE POWER DEMAND ON THE SYSTEM. THE PLC MONITORS THE LOAD ON THE SYSTEM AND COMPARES IT TO THE CONNECTED GENERATING CAPACITY.
- 3) THE DEMAND CONTROL PROVIDES TWO TYPES OF CONTROL FOR INCREASING LOAD – INCREASE AND OVERLOAD. THE OVERLOAD SETPOINT IS TYPICALLY THE PRIME RATING OF THE GENSET AND THE INCREASE SETPOINT IS TYPICALLY 90% OF THE OVERLOAD SETPOINT. WHEN THE LOAD EXCEEDS THE INCREASE SETPOINT FOR A PRE-SET TIME DELAY (USUALLY 30 SECONDS) THE DEMAND CONTROL WILL SWITCH TO THE NEXT HIGHER LEVEL OF GENERATING CAPACITY. WHEN THE LOAD EXCEEDS THE OVERLOAD SETPOINT THE DEMAND CONTROL WILL IMMEDIATELY SWITCH TO THE NEXT HIGHER LEVEL OF GENERATING CAPACITY (NO TIME DELAY).
- 4) THE DEMAND CONTROL PROVIDES ONE TYPE OF CONTROL FOR DECREASING LOAD. THE DECREASE SETPOINT IS TYPICALLY 80% OF THE OVERLOAD SETPOINT. WHEN THE LOAD DROPS BELOW THE DECREASE SETPOINT FOR A PRE-SET TIME DELAY (USUALLY 2 MINUTES) THE DEMAND CONTROL WILL SWITCH TO THE NEXT LOWER LEVEL OF GENERATING CAPACITY.
- 5) NOTE THAT GENERATORS #1 & #2 ARE EQUAL CAPACITY AND THE OPERATOR MUST SELECT A LEAD GENERATOR USING THE SCADA SYSTEM.
- 6) SEE THE DEMAND CONTROL TABLE THIS SHEET FOR DEMAND LEVEL SETPOINTS AT THE TIME OF COMMISSIONING. ON THE SCADA SYSTEM GO TO THE DEMAND TAB TO VERIFY THE PRESENT SETPOINTS.

MANUAL OPERATION:

- 1) PLACE THE MASTER CONTROL "SYSTEM MODE" SWITCH IN THE MANUAL POSITION.
- 2) CHECK THE MASTER AND GENERATOR SECTIONS FOR ANY FAULTS AND CLEAR AS DESCRIBED UNDER AUTOMATIC OPERATION STEPS 2 AND 3.
- 3) TO PLACE A GENERATOR IN SERVICE, PRESS THE EZGN MAN BUTTON, THEN PRESS THE "I" (START) BUTTON. AFTER THE ENGINE STARTS AND STABILIZES, PRESS THE CONTACTOR CLOSE BUTTON ON THE EZGN. THE RED BREAKER CLOSED LAMP WILL ILLUMINATE.
- 4) REPEAT THIS PROCESS FOR AT LEAST ONE MORE GENERATOR.
- 5) WITH TWO GENERATORS ON LINE ROTATE THE FEEDER BREAKER CONTROL KNOB FOR THE MAIN FEEDER BREAKER TO THE CLOSE POSITION TO ENERGIZE THE COMMUNITY. MONITOR THE LOAD ON THE SYSTEM FOR ONE MINUTE THEN SELECT THE APPROPRIATE GENERATOR(S) TO MATCH THE LOAD.
- 6) TAKE ANY GENERATOR(S) NOT NEEDED OFF LINE BY PRESSING THE RED EZGN STOP BUTTON. THE ENGINE WILL COOL DOWN FOR THREE MINUTES THEN SHUT OFF. NOTE THAT PRESSING THE RED STOP BUTTON TWICE WILL IMMEDIATELY SHUT DOWN THE GENERATOR.
- 7) TO MANUALLY SWITCH TO A DIFFERENT GENERATOR AS THE LOAD CHANGES REPEAT STEPS 3 AND 6.

SERVICE DUE / OIL CHANGE PROCEDURE:

NOTE THAT UNDER AUTOMATIC OPERATION, WHENEVER THE SERVICE TIME HAS BEEN EXCEEDED THE GENERATOR WILL AUTOMATICALLY BE TAKEN OFF LINE AS LONG AS ANOTHER GENERATOR IS AVAILABLE IN AUTO. AN "ENGINE SERVICE" MESSAGE WILL DISPLAY ON THE EZGN AND THE RED "ENGINE ALARM" LAMP WILL ILLUMINATE.

- 1) IF THE SWITCHGEAR IS IN MANUAL MODE, PERFORM MANUAL OPERATION STEPS 3 AND 6 ABOVE THEN CONTINUE AT STEP 3 BELOW (LOCK OUT).
- 2) IF THE SWITCHGEAR IS IN AUTOMATIC MODE, PRESS THE EZGN MAN BUTTON ON THE GENERATOR TO BE SERVICED. THE PLC WILL START ANOTHER GENERATOR. ONCE THE OTHER GENERATOR IS ON LINE, PRESS THE EZGN STOP BUTTON ON THE GENERATOR TO BE SERVICED. NOTE THAT IF THE STOP BUTTON IS PRESSED BEFORE ANOTHER UNIT IS ONLINE, AN OUTAGE WILL OCCUR.
- 3) LOCK THE UNIT OUT USING THE KEY SWITCH AND TAG OUT OF SERVICE.
- 4) SERVICE ENGINE (OIL CHANGE, FUEL FILTER, AIR FILTER, ETC.).
- 5) REMOVE TAG AND TURN THE GENERATOR LOCKOUT SWITCH TO RUN.
- 6) PRESS THE "SERVICE HOURS RESET" BUTTON AND HOLD FOR 10 SECONDS.
- 7) PRESS THE "ALARM RESET" BUTTON.
- 8) AFTER ALL ALARMS HAVE BEEN CLEARED PRESS THE EZGN "HOME" BUTTON.
- 9) START THE ENGINE BY PRESSING THE MAN BUTTON AND THEN "I" (START) BUTTON.
  - a) AFTER THE ENGINE COMES UP TO SPEED VERIFY THAT THE ENGINE OIL PRESSURE IS IN THE NORMAL RANGE.
  - b) CHECK THE OIL FILTER FOR LEAKS.
- 10) AFTER THE ENGINE RUNS FOR ONE MINUTE PRESS THE STOP BUTTON.
- 11) CHECK THE OIL LEVEL USING THE DIPSTICK AND ADD OIL AS REQUIRED.
- 12) PLACE THE GENERATOR BACK IN SERVICE BY PRESSING THE AUTO BUTTON ON THE EZGN. NOTE: AT EACH OIL CHANGE THE LEAD SELECTION TO THE NEXT UNIT TO DISTRIBUTE THE RUN TIME EQUALLY.

ENGINE-GENERATOR PROTECTION ALARMS:

SEE THE TABLES THIS SHEET FOR ALARM LEVEL SETPOINTS AND BREAKER TRIP SETTINGS AT THE TIME OF COMMISSIONING. SEE SECTION 3.1 OF THE O&M MANUAL FOR DETAILED DESCRIPTIONS OF WARNING ALARM AND PROTECTION SEQUENCES.

FUEL/OIL SYSTEM

AUTOMATIC DAY TANK FILL – THE DAY TANK IS FILLED FROM THE INTERMEDIATE TANK. IT HAS AUTOMATIC FILL CONTROLS WITH REDUNDANT HIGH AND LOW LEVEL ALARMS AND TIMERS. SEE FUEL SYSTEM CONTROL PANEL DRAWING SHEET E7.3 FOR DETAILED SEQUENCE OF OPERATION.

DAY TANK FILTER – THE DAY FILTER HAS WATER DETECTION PROBES. AN ALARM LAMP WILL ILLUMINATE WHEN WATER IS PRESENT IN THE FUEL. SEE WATER INDICATION PANEL DRAWING SHEET E7.4.

MANUAL USED ENGINE OIL DRAIN – USED OIL PUMP P-U01 IS USED TO PUMP USED ENGINE OIL FROM THE ENGINE OIL PANS TO THE USED OIL HOPPER. P-U01 RUNS THROUGH A MANUAL 0-5 MINUTE TIMER SWITCH.

AUTOMATIC USED ENGINE OIL BLENDING SYSTEM – THE USED ENGINE OIL BLENDING SYSTEM FILTERS USED OIL AND MIXES IT WITH DIESEL FUEL IN THE DAY TANK TO BE BURNED BY THE ENGINES. THE PUMPING RATES ARE SET TO BLEND APPROXIMATELY 0.5% USED OIL TO 99.5% DIESEL FUEL. NOTE THAT WHEN THERE IS NO USED OIL IN THE HOPPER THE DIESEL PUMP STILL RUNS TO USE THE BLENDER AS A FUEL "POLISHING" FILTER. SEE FUEL SYSTEM CONTROL PANEL DRAWING SHEET E7.3 FOR DETAILED SEQUENCE OF OPERATION.

MANUAL INTERMEDIATE TANK FILL – THE INTERMEDIATE TANK IS LOCATED ADJACENT TO THE POWER PLANT. IT NEEDS TO BE FILLED WHENEVER IT DROPS BELOW THE 50% FULL LEVEL. FILLING THE INTERMEDIATE TANK IS A MANUAL PROCEDURE USING THE EXISTING INTERMEDIATE TANK FILL CONTROL PANEL THAT HAS BEEN RELOCATED TO THE NEW POWER PLANT.

ENGINE COOLING SYSTEM

RADIATORS – RADIATOR FAN MOTORS WILL OPERATE UNDER VARIABLE FREQUENCY DRIVE (VFD) CONTROL. WHEN THE COOLANT RETURN TEMP REACHES THE PID REFERENCE SETPOINT THE MOTOR WILL START AT MINIMUM SPEED AND RAMP UP TO THE REQUIRED SPEED. USING PID CONTROL, THE VFD WILL MODULATE THE FAN SPEED AS REQUIRED TO MAINTAIN COOLANT RETURN TEMP AT THE PID REFERENCE SETPOINT. AS THE COOLANT RETURN TEMP RISES, THE VFD WILL INCREASE THE SPEED OF THE FAN MOTOR UP TO 100%. ONCE THE FAN REACHES THE MINIMUM SPEED, THE VFD WILL MAINTAIN THAT SPEED UNTIL THE LOW SPEED TIME OUT EXPIRES. WHEN THE LOW SPEED TIME OUT EXPIRES THE MOTOR WILL STOP. THE MOTOR WILL REMAIN OFF UNTIL THE COOLANT RETURN TEMP RISES TO THE PID REFERENCE SETPOINT. SEE THE RADIATOR VFD SETTINGS TABLE THIS SHEET FOR SETPOINTS AT THE TIME OF COMMISSIONING.

THERMOSTATIC VALVE TV-1 WILL MIX HOT COOLANT FROM THE ENGINE DISCHARGE PIPE WITH COLD COOLANT FROM THE RADIATOR RETURN PIPE TO MAINTAIN 175°F +/- TEMPERATURE COOLANT RETURN TO THE ENGINES.

ENGINE COOLANT RETURN HIGH TEMPERATURE ALARM. WHEN THE ENGINE COOLANT RETURN TEMPERATURE RISES ABOVE 190°F FOR A MINIMUM OF 2 MINUTES, THE "HIGH COOLANT RETURN TEMPERATURE" LAMP SHALL ILLUMINATE. LAMP SHALL REMAIN ON UNTIL MASTER RESET BUTTON IS PRESSED.

POWER PLANT HEATING AND VENTILATION SYSTEM

GENERATION ROOM – THE OPERATING AND OFF LINE GENERATORS REJECT MORE HEAT TO THE GENERATION ROOM THAN IS REQUIRED SO EXHAUST FANS WITH INTAKE AIR DUCTS ARE INSTALLED TO PROVIDE COOLING.

GENERATION ROOM VENTILATION – THERE ARE THREE AIR INTAKES IN THE GENERATION ROOM CEILING. ONE OF THE AIR INTAKES IS USED FOR COMBUSTION AIR AND THE DAMPER IS OPEN ANY TIME THE STATION SERVICE POWER IS ON. THE OTHER TWO AIR INTAKES ARE LABELED "EF-1" AND "EF-2". THESE DAMPERS OPEN WHENEVER THE ASSOCIATED EXHAUST FAN RUNS. THE FANS ARE EACH EQUIPPED WITH A DISCHARGE MOTORIZED DAMPER THAT OPENS EACH TIME THE ASSOCIATED EXHAUST FAN RUNS.

EXHAUST FANS – THERE ARE TWO EXHAUST FANS ON THE WALL ABOVE THE FRONT OF THE GENERATORS, EF-1 AND EF-2. EACH FAN IS EQUIPPED WITH A MOTORIZED DAMPER THAT OPENS WHENEVER THE FAN RUNS ON A CALL FOR COOLING THROUGH A 24VAC DIGITAL MODULATING THERMOSTAT. THE THERMOSTAT WILL PROVIDE A 0-10V SIGNAL TO MODULATE THE FAN SPEED AS REQUIRED TO MAINTAIN GENERATING ROOM TEMP, TYPICALLY SET TO 80F.

MOTOR OPERATED DAMPERS – ALL DAMPER MOTORS ARE NORMALLY CLOSED SPRING RETURN AND WILL CLOSE ON LOSS OF POWER (FIRE ALARM) IN LESS THAN 30 SECONDS.

CONTROL ROOM VENTILATION – COOLING AND VENTILATION FOR THE CONTROL ROOM IS PROVIDED BY AN OPERABLE WINDOW.

CONTROL ROOM HEATING – THE CONTROL ROOM IS HEATED BY A CABINET UNIT HEATER. PUMP P-CUH1 CIRCULATES ENGINE COOLANT FROM THE PIPING MAINS THROUGH THE CABINET UNIT HEATER IN THE CONTROL ROOM. THE TEMPERATURE CONTROLLER ON THE HEATER CYCLES THE PUMP AND THE HEATER FAN ON AND OFF AS REQUIRED TO MAINTAIN TEMPERATURE IN THE CONTROL ROOM, TYPICALLY SET TO 65F.

HEAT RECOVERY SYSTEM

THE POWER PLANT HEAT EXCHANGER (HX-1), THE PRIMARY (HOT SIDE) ENGINE COOLANT CIRCULATING PUMP (P-HR1A), AND THE SECONDARY (COLD SIDE) HEAT RECOVERY FLUID MAIN CIRCULATING PUMP (P-HR1B) ARE LOCATED IN THE POWER PLANT. BOTH PUMPS OPERATE CONTINUOUSLY UNDER MANUAL CONTROL.

PEX ARCTIC PIPE TEMPERING SYSTEM – THE HEAT RECOVERY ARCTIC PIPE IS PEX (PLASTIC) PIPE WHICH HAS A LIMITED LIFE AT ELEVATED TEMPERATURES. THE HEAT RECOVERY SUPPLY TEMPERATURE IS TEMPERED BY A THREE-WAY THERMOSTATIC VALVE "TV-2" THAT IS INSTALLED BETWEEN THE HEAT EXCHANGER AND THE ARCTIC PIPE. THE VALVE MIXES COLD RETURN FLUID WITH HOT FLUID FROM THE HEAT EXCHANGER TO LIMIT THE SUPPLY TEMPERATURE TO APPROXIMATELY 185F.

HEAT RECOVERY LOSS OF PRESSURE – WHEN THE SYSTEM PRESSURE IN THE HEAT RECOVERY PIPING DROPS BELOW 15 PSIG FOR 15 MINUTES, A RED LAMP "HEAT RECOVERY LOSS OF PRESSURE" LOCATED IN THE SWITCHGEAR MASTER SECTION WILL ILLUMINATE.

NO LOAD ON HEAT RECOVERY SYSTEM – WHEN THE HEAT RECOVERY RETURN TEMP. IS EQUAL TO OR GREATER THAN THE HEAT RECOVERY SUPPLY TEMP. FOR 60 MINUTES, AN AMBER LAMP "NO LOAD ON HEAT RECOVERY" LOCATED IN THE SWITCHGEAR MASTER SECTION WILL ILLUMINATE. WHEN THE HEAT RECOVERY SUPPLY TEMP. IS A MIN. OF 1°F GREATER THAN THE HEAT RECOVERY RETURN TEMP. THE LAMP WILL TURN OFF.

HEAT RECOVERY LOSS OF FLOW – WHEN THE FLOW RATE IN THE HEAT RECOVERY PIPING FALLS BELOW 10 GPM FOR 15 MINUTES, A RED LAMP "HEAT RECOVERY LOSS OF FLOW" LOCATED IN THE SWITCHGEAR MASTER SECTION WILL ILLUMINATE.

THE HEAT RECOVERY SYSTEM PROVIDES INTERRUPTIBLE HEAT TO ADJACENT BUILDINGS IN THE COMMUNITY USING UNIT HEATERS AND CABINET UNIT HEATERS AS SHOWN ON SHEET M8.1.

SYSTEM STARTUP

FUEL OIL PUMPS – PRIOR TO STARTING FUEL AND OIL PUMPS PRIME CAVITIES WITH LUBE OIL AND RUN MOMENTARILY TO VERIFY CORRECT ROTATION AND TO CONFIRM INLET AND OUTLET CONNECTIONS.

FUEL OIL PIPING – AFTER PRESSURE TESTING, FILL ALL FILTER BODIES, PRIME ALL PIPING, AND BLEED OFF AIR.

VERIFY OPERATION OF ALL FUEL SYSTEM CONTROLS IN ACCORDANCE WITH SEQUENCES OF OPERATION ON THE CONTROL PANEL DRAWINGS.

ENGINE COOLANT PIPING – AFTER PRESSURE TESTING, FLUSHING, AND BLEEDING, FILL SYSTEM WITH ETHYLENE GLYCOL SOLUTION. SEE HYDRONIC PIPING SPECIFICATION 23 21 13.

HEAT RECOVERY PIPING – AFTER PRESSURE TESTING, FLUSHING, AND BLEEDING, FILL SYSTEM WITH PROPYLENE GLYCOL SOLUTION. SEE HYDRONIC PIPING SPECIFICATION 23 21 13.

VERIFY OPERATION AND CALIBRATION OF ENGINE COOLANT SYSTEM AND HEAT RECOVERY SYSTEM THERMOSTATIC VALVES.

VERIFY PROPER OPERATION OF THERMOMETERS, PRESSURE GAUGES, AND ELECTRICAL INSTRUMENTATION DEVICES. SET SWITCHES ON DIFFERENTIAL PRESSURE GAUGES TO SETPOINTS INDICATED. CALIBRATE THERMOMETERS AND ALL ELECTRICAL INSTRUMENTATION DEVICES INCLUDING TEMPERATURE TRANSMITTERS, PRESSURE TRANSMITTERS, DIFFERENTIAL PRESSURE SWITCHES, FLOW METERS, ENERGY METERS, LEVEL GAUGES, ETC. SEE INSTRUMENTATION AND CONTROL DEVICES SPECIFICATION 23 09 00.



CLEAN ALL PIPING STRAINERS AFTER FIRST 48 HOURS OR MORE OF OPERATION. MONITOR SYSTEM OPERATION FOR ONE WEEK MINIMUM BEFORE LEAVING SITE. CHANGE GLYCOL FILTER ELEMENTS ON ENGINES AT TIME OF FIRST OIL CHANGE ON EACH ENGINE.

**INITIAL TESTING WAS PERFORMED AS PART OF THE MODULE ASSEMBLY CONTRACT. FINAL SYSTEM STARTUP, TESTING, AND COMMISSIONING IS INCLUDED IN THE ON SITE SCOPE.**



ISSUED FOR  
CONSTRUCTION  
MAY 2023



PROJECT: <b>NELSON LAGOON POWER SYSTEM UPGRADE</b>		
TITLE: <b>SYSTEM START UP &amp; SEQUENCE OF OPERATIONS</b>		
	DRAWN BY: JTD DESIGNED BY: BCG FILE NAME: NELS PP M1 PROJECT NUMBER:	SCALE: AS NOTED DATE: 5/30/23 SHEET: <b>M1.3</b>
P.O. 111405, Anchorage, AK 99511 (907)349-0100		

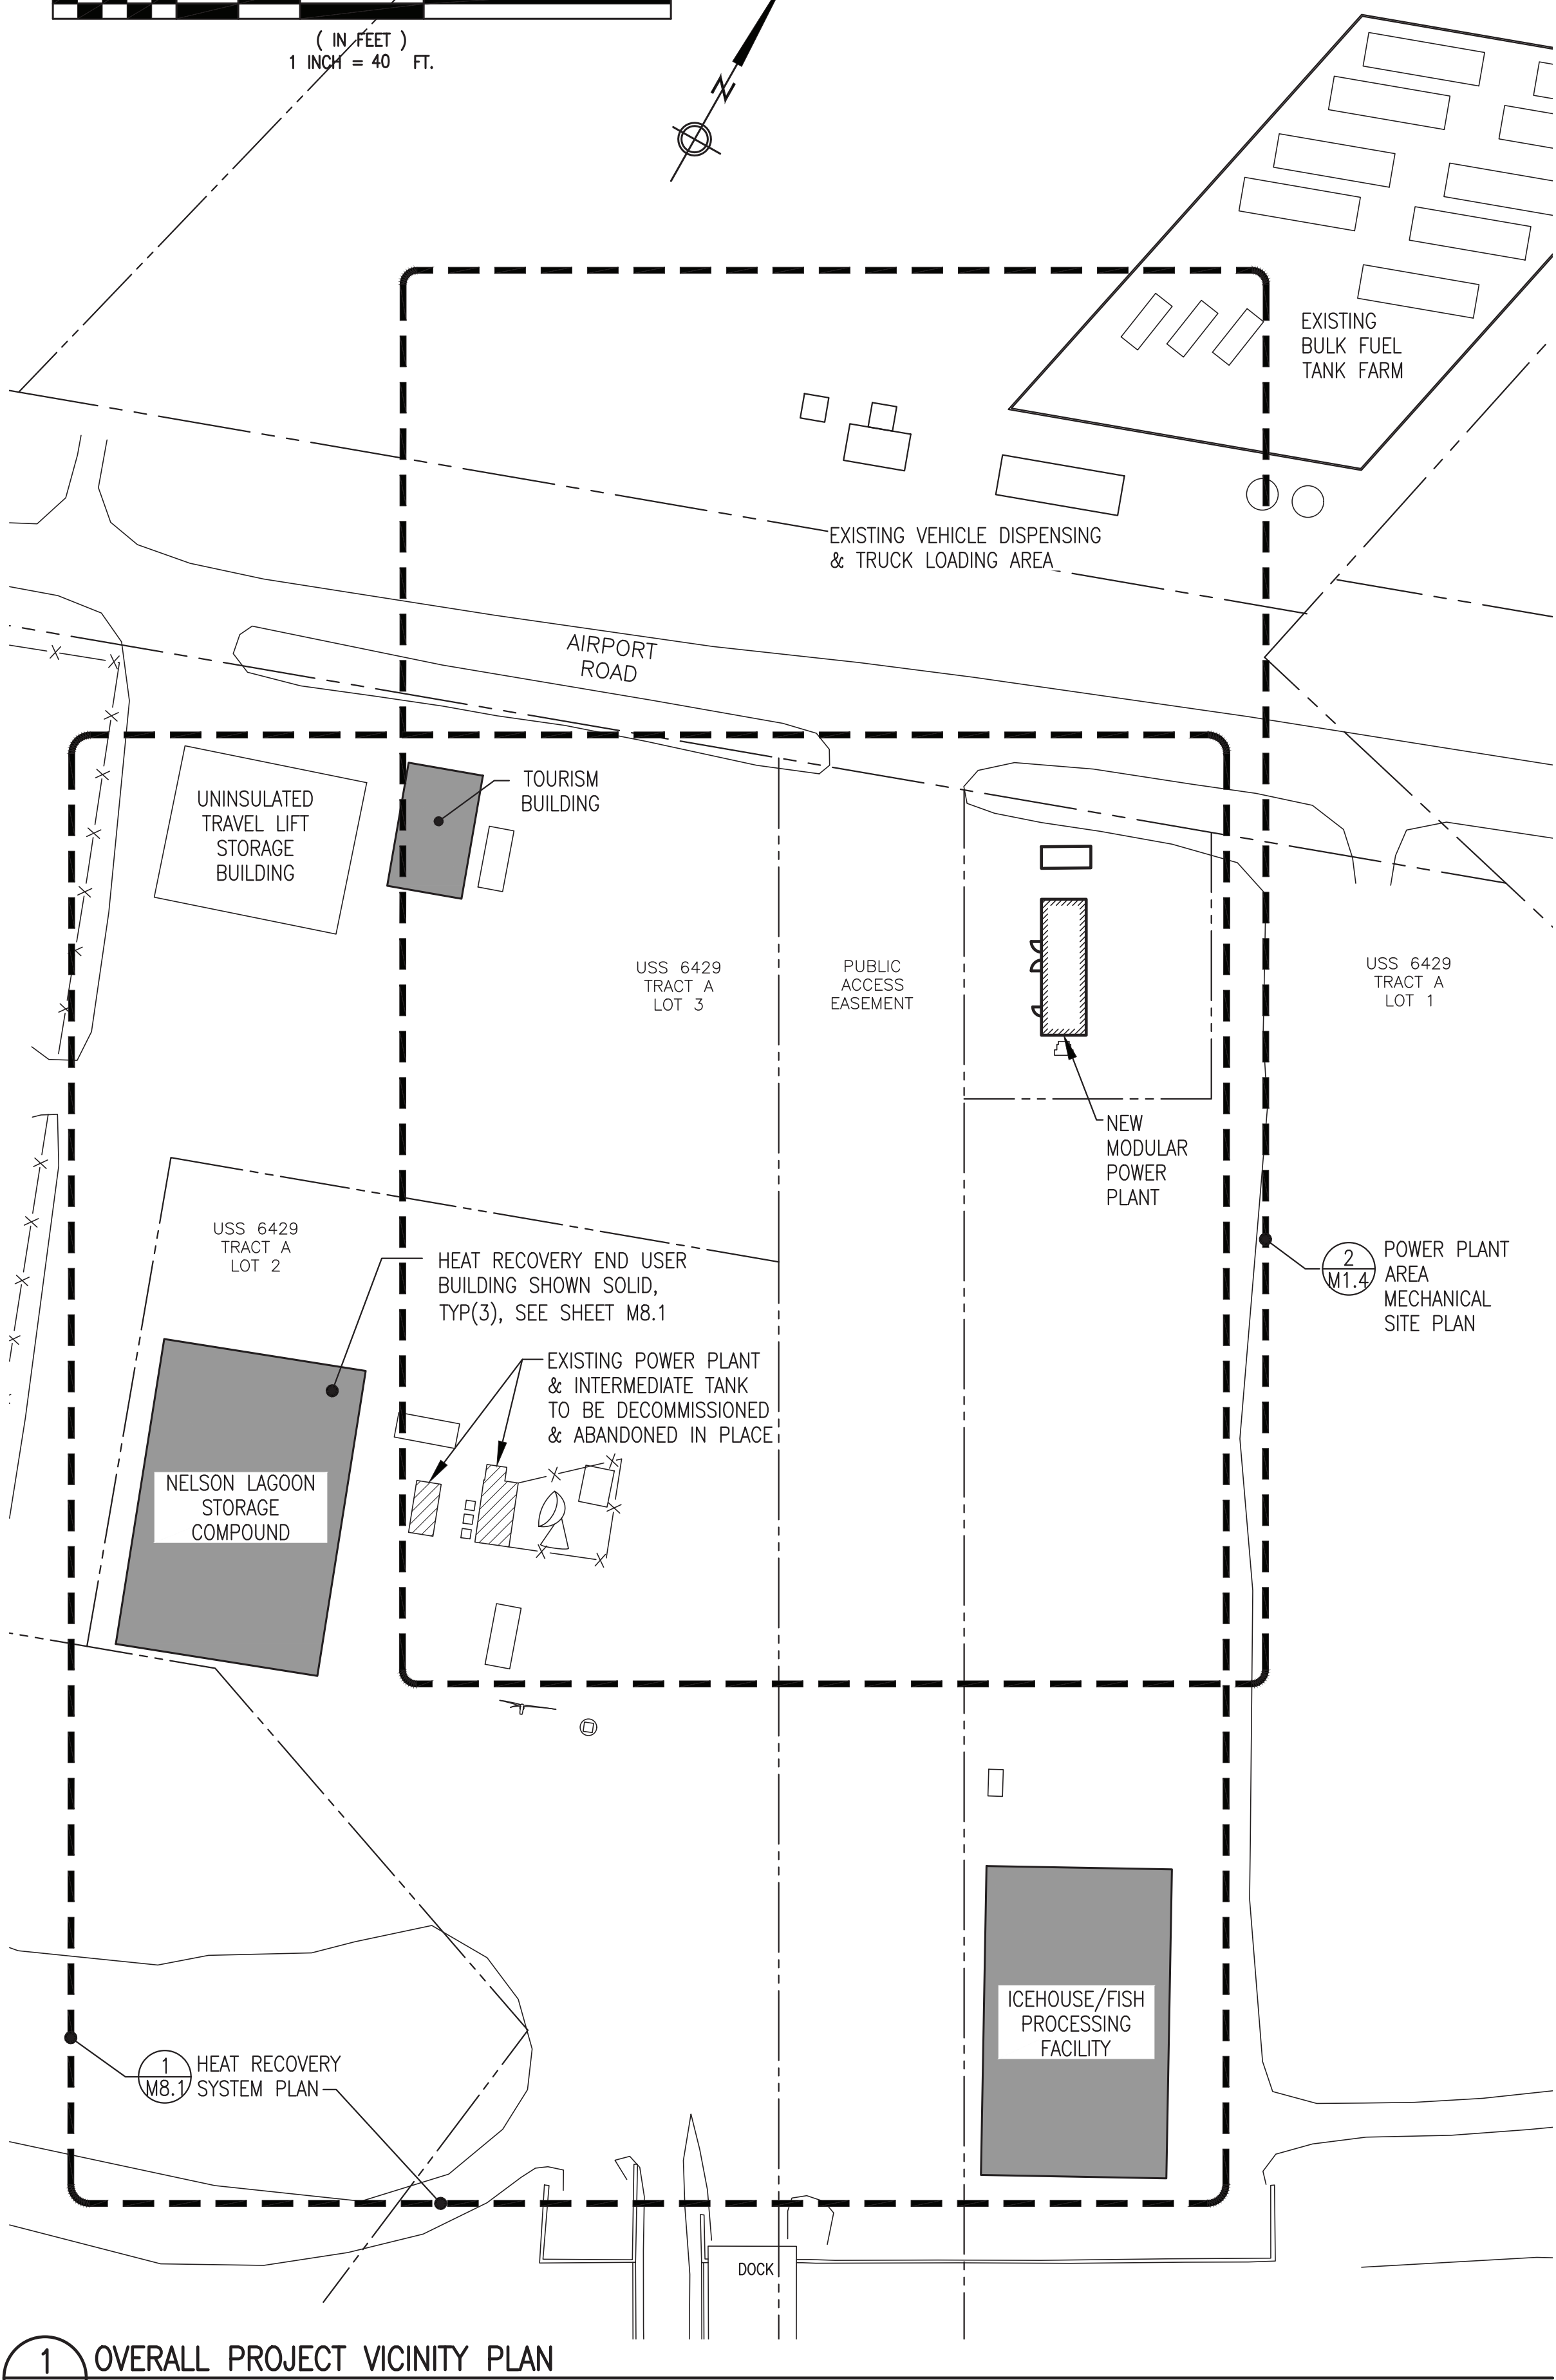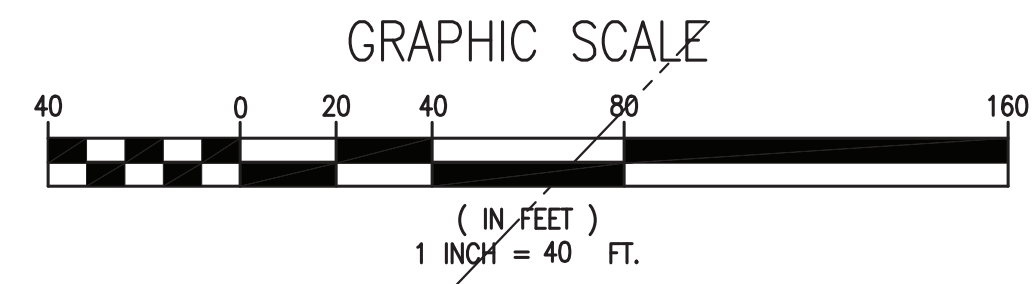

1 OVERALL PROJECT VICINITY PLAN  
M1.4 1"=40'

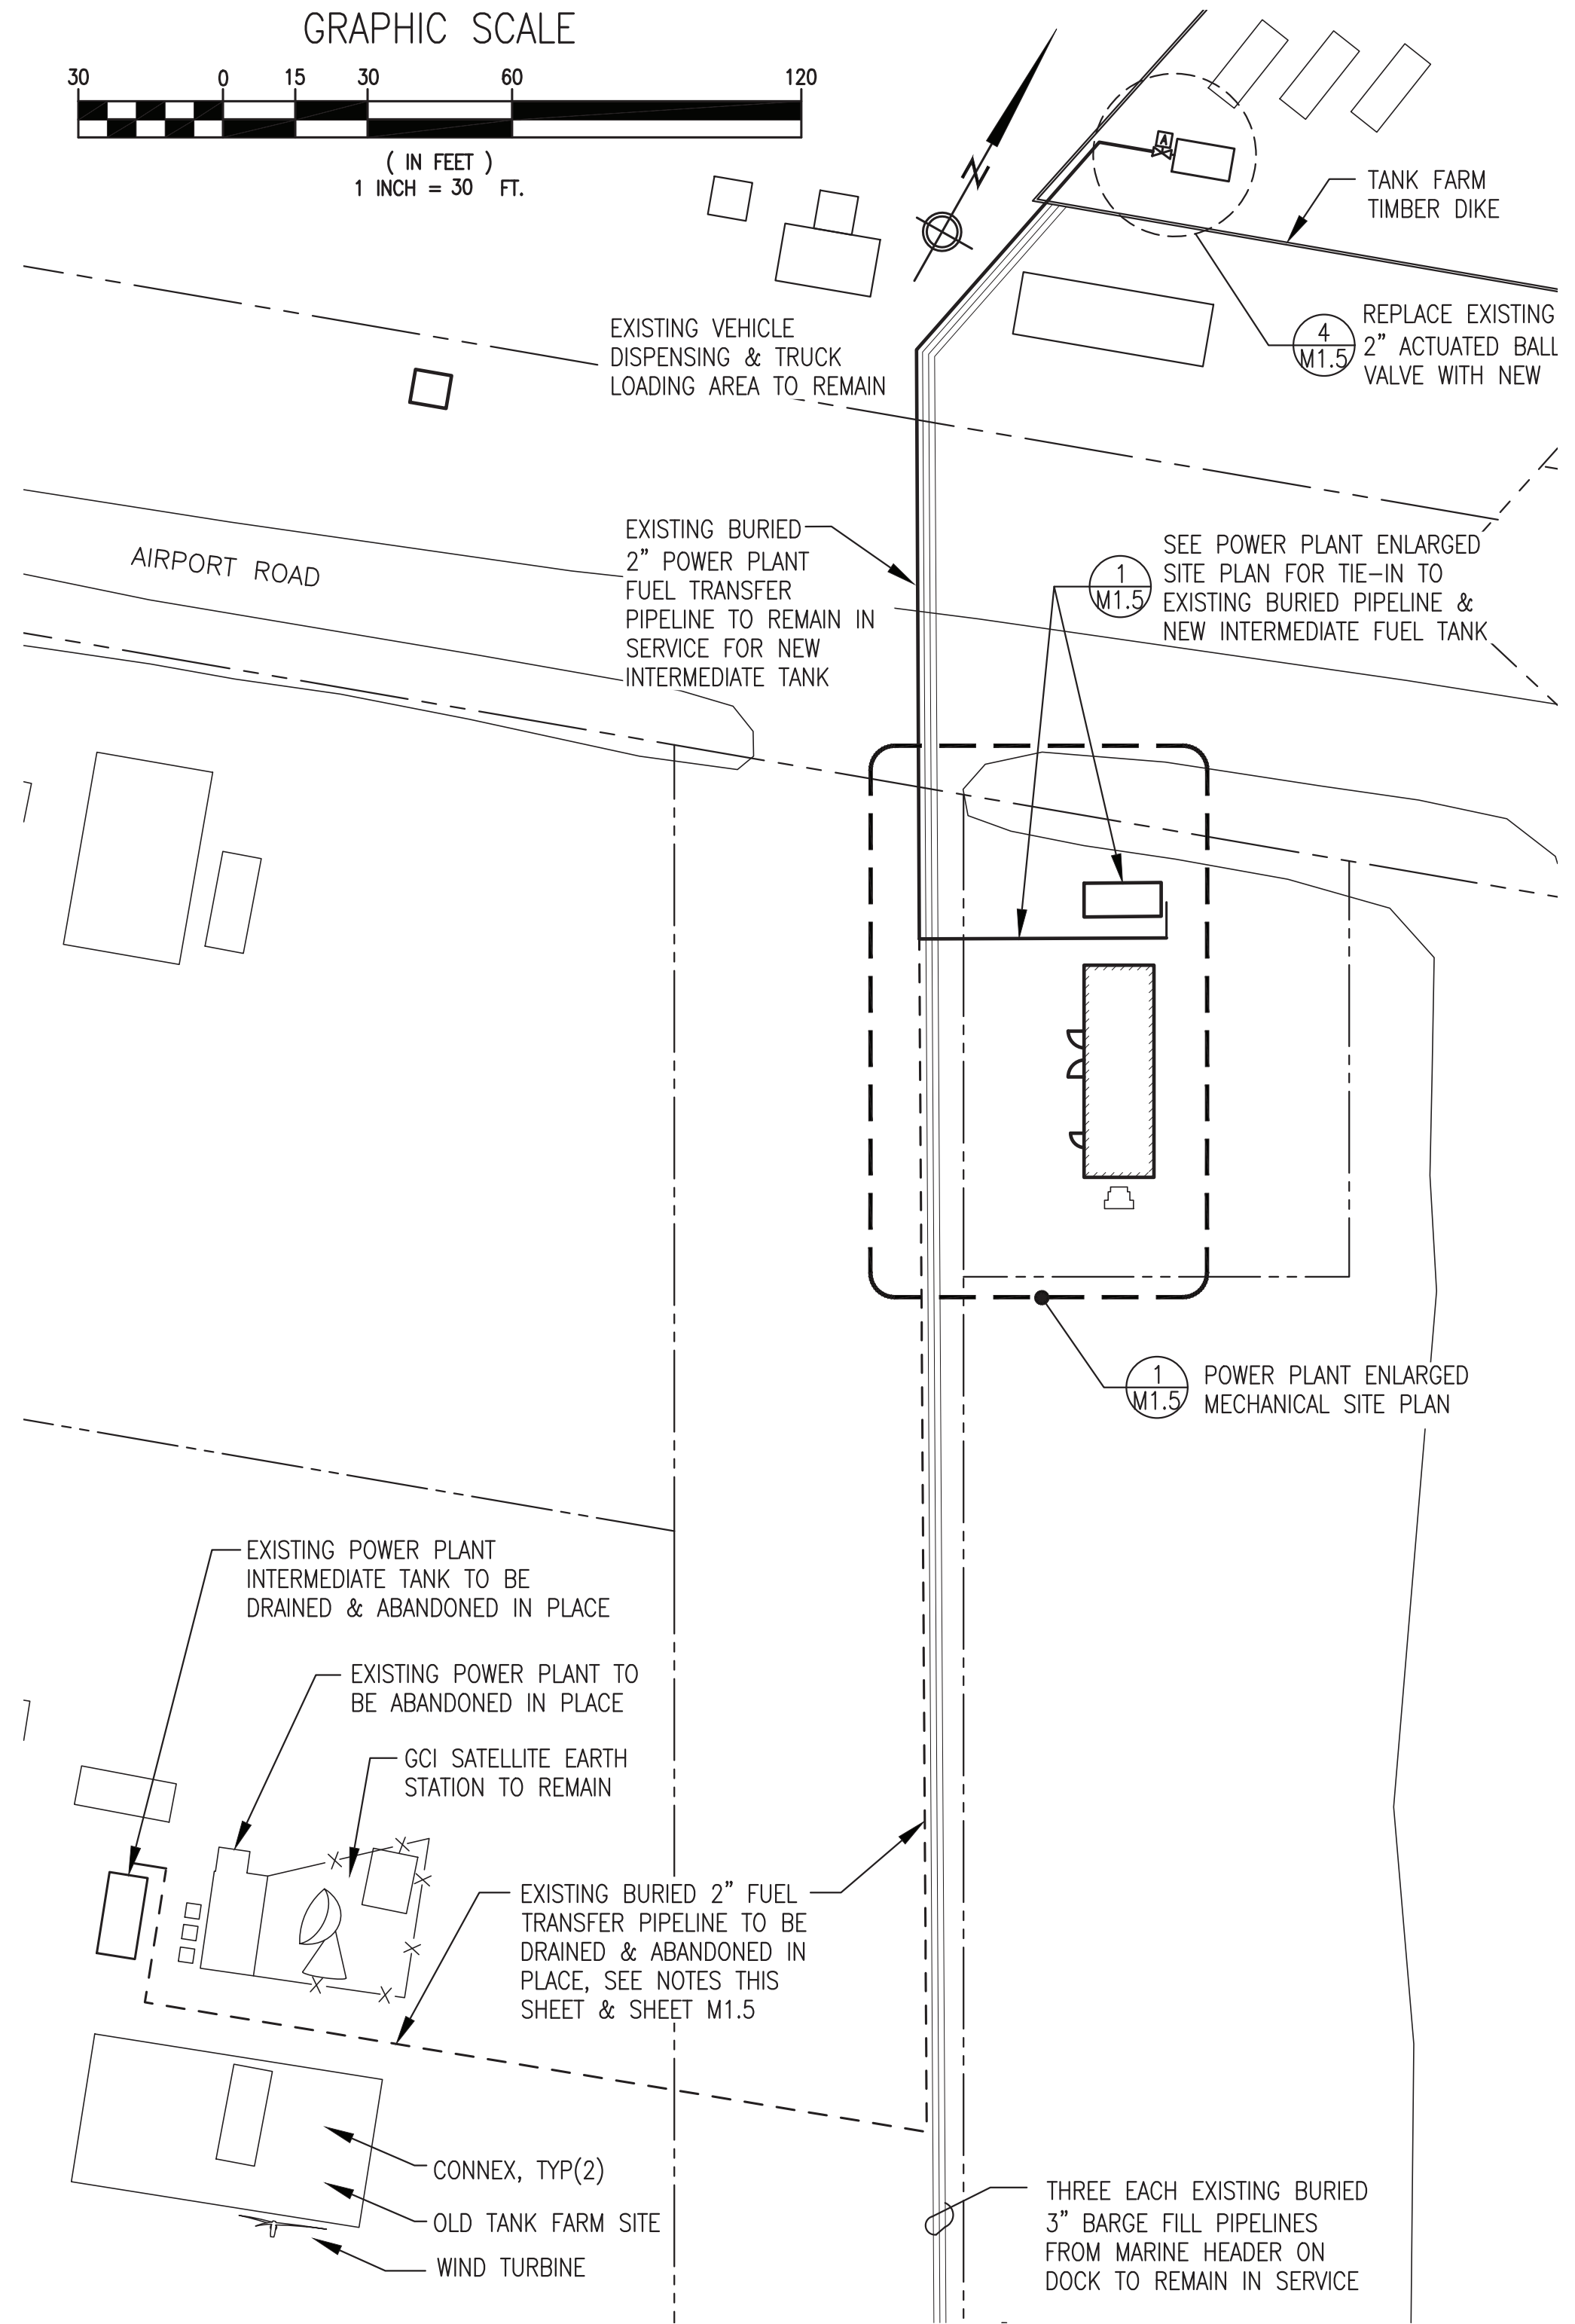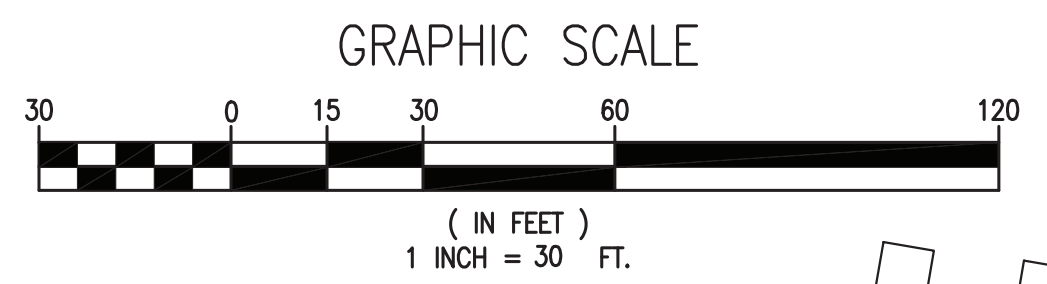


2 POWER PLANT AREA MECHANICAL SITE PLAN  
M1.4 1"=30'

- TEMPORARY FUEL TRANSFER SYSTEM GENERAL NOTES:**
- 1) THE EXISTING POWER PLANT INTERMEDIATE TANK IS FILLED UNDER MANUAL CONTROL FROM THE TANK FARM USING THE EXISTING 2" BURIED TRANSFER PIPELINE. IN ORDER TO MAINTAIN POWER IN THE COMMUNITY, AN ALTERNATIVE METHOD FOR FILLING THE INTERMEDIATE TANK MUST BE PROVIDED AT THE OLD POWER PLANT FROM THE TIME THE TRANSFER PIPELINE IS CUT UNTIL THE TIME THE NEW POWER PLANT IS COMMISSIONED. PLAN OUT WORK TO MINIMIZE THE TIME REQUIRED TO OPERATE ON THE TEMPORARY FUEL TRANSFER SYSTEM AND COORDINATE THE CHANGEOVER WITH THE UTILITY.
  - 2) DURING THE ENTIRE TIME THE TEMPORARY TRANSFER SYSTEM IS IN SERVICE, MONITOR THE INTERMEDIATE TANK LEVEL DAILY AND FILL AS REQUIRED TO MAINTAIN A MINIMUM OF 1,000 GALLONS OF FUEL AT ALL TIMES. NOTE THAT THE POWER PLANT IS ESTIMATED TO USE APPROXIMATELY 100 GALLONS PER DAY. USING THE TRUCK FILL CONTAINMENT AREA AT THE EXISTING TANK FARM, LOAD A PORTABLE TANK OR TRUCK AND TRANSFER INTO EXISTING INTERMEDIATE TANK IN A SAFE AND ENVIRONMENTALLY SOUND MANNER. PROVIDE A RECORD OF THE QUANTITY OF EACH TRANSFER TO THE UTILITY. ALL FUEL REQUIRED FOR POWER GENERATION WILL BE PROVIDED BY THE UTILITY AT NO COST TO THE CONTRACTOR.


- EXISTING PIPELINE DRAINING AND DECOMMISSIONING GENERAL NOTES:**
- 1) THE FOLLOWING NOTES APPLY TO THE EXISTING 2" POWER PLANT INTERMEDIATE TANK FUEL TRANSFER PIPELINE. NOTE THAT THIS WORK MUST BE COORDINATED WITH THE PRECEDING TEMPORARY FUEL TRANSFER SYSTEM NOTES.
  - 2) GROUND SURFACE ELEVATION ALONG THE PIPELINE ROUTE IS ESSENTIALLY LEVEL.
  - 3) IDENTIFY ISOLATION VALVE(S) AT TANK FARM, CLOSE VALVE(S) AND LOCKOUT PRIOR TO COMMENCING DRAINING AND DECOMMISSIONING OF PIPELINE.
  - 4) DRAIN ALL RESIDUAL FUEL FROM THE PIPELINE. USE 2" PIPE SIZE PIG FOR REMOVING ALL REMAINING FUEL FROM THE PIPELINE AS REQUIRED. CAPTURE FUEL IN CONTAINERS AND TURN OVER ALL CAPTURED FUEL TO THE UTILITY.
  - 5) ONE EXISTING MULT-CONDUCTOR C-L-X ARMORED CABLE IS ROUTED ADJACENT TO THE EXISTING PIPELINE, SEE ELECTRICAL. THREE EACH BARGE FILL PIPELINES ARE ALSO ROUTED ADJACENT TO THE EXISTING 2" TRANSFER PIPELINE. LOCATE CABLE AND PIPES CAREFULLY HAND EXCAVATE OR USE AIR SPADE TO AVOID DAMAGE.
  - 6) PERFORM ALL CUTTING IN ACCORDANCE WITH APPROPRIATE HOT WORK PROCEDURES PER NFPA 51B.
  - 7) SEE SHEET M1.5 FOR ADDITIONAL PIPELINE DEMOLITION & DECOMMISSIONING DETAILS.

ALL WORK ON THIS SHEET IS INCLUDED IN THE ON SITE CONTRACT

ISSUED FOR CONSTRUCTION  
MAY 2023

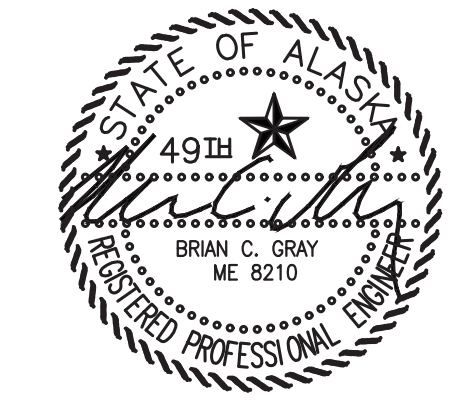

ALASKA ENERGY AUTHORITY		
PROJECT: NELSON LAGOON POWER SYSTEM UPGRADE		
TITLE: OVERALL PROJECT AREA PLAN & POWER PLANT AREA MECHANICAL SITE PLAN		
 Gray Stassel Engineering, Inc. P.O. 111405, Anchorage, AK 99511 (907)349-0100	DRAWN BY: JTD DESIGNED BY: BCG FILE NAME: NELS PP M1 PROJECT NUMBER:	SCALE: AS NOTED DATE: 5/30/23 SHEET: <b>M1.4</b>

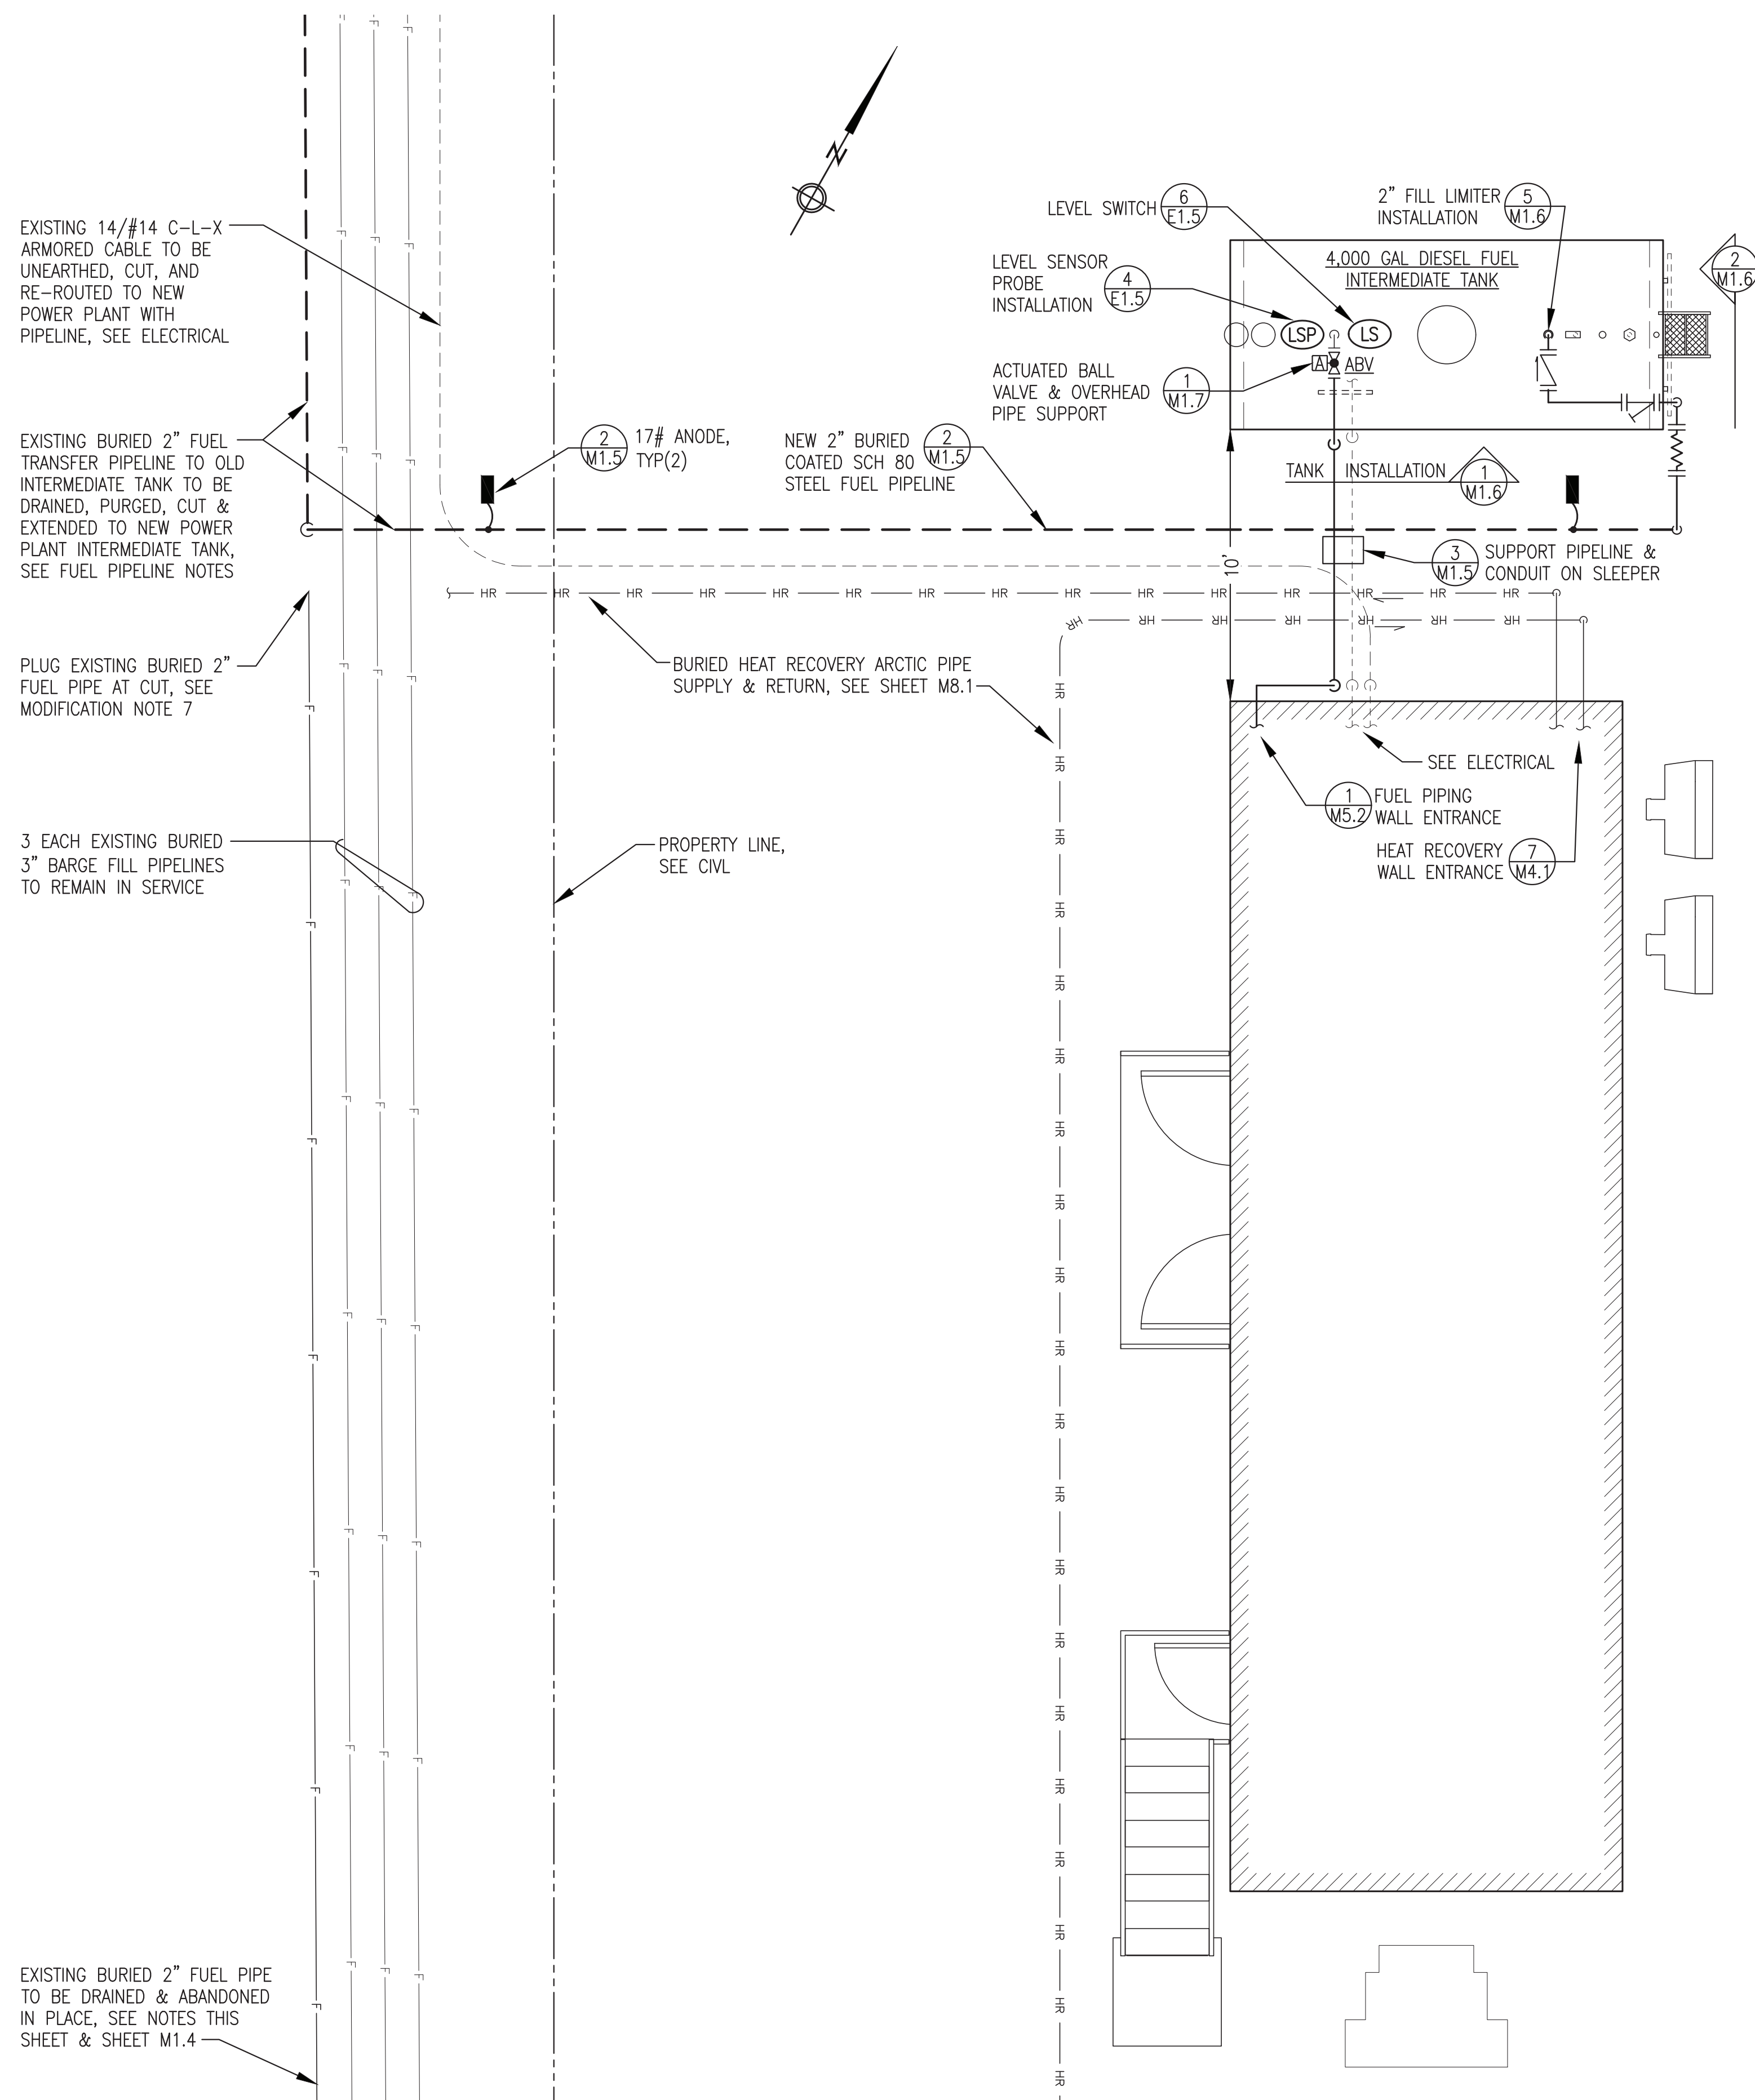


**1** POWER PLANT ENLARGED MECHANICAL SITE PLAN  
**M1.5** 1/4"=1'-0"

**CODE NOTES:**


- SEE CIVIL FOR SITE LAYOUT AND FOR DIMENSIONAL LOCATION OF POWER PLANT AND FUEL TANK ON SITE.
- SEE ARCHITECTURAL FOR CODE ANALYSIS.
- FOR 751-12,000 GALLON BULK STORAGE TANKS, THE INTERNATIONAL FIRE CODE REQUIRES 30' CLEARANCE TO THE NEAREST PROPERTY LINE WHICH IS OR CAN BE BUILT UPON AND 5' CLEARANCE TO THE NEAREST SIDE OF A PUBLIC WAY. THE LOCATION OF THE NEW 4,000 GALLON DOUBLE WALL FUEL TANK HAS A CLEARANCE OF APPROXIMATELY 39' TO THE NEAREST PROPERTY BOUNDARY AND 11' TO AIRPORT ROAD. SEE CIVIL.
- THE INTERNATIONAL BUILDING CODE REQUIRES 10' MINIMUM CLEARANCE FROM THE NEW POWER PLANT TO THE NEAREST PROPERTY LINE WHICH IS OR CAN BE BUILT UPON, SEE SHEET A1. THE LOCATION OF THE NEW POWER PLANT HAS A CLEARANCE OF APPROXIMATELY 20' TO THE NEAREST PROPERTY BOUNDARY. SEE CIVIL.
- THE INTERNATIONAL FIRE CODE REQUIRES FIRE APPARATUS ROADWAY TO PROVIDE ACCESS TO WITHIN 150' OF EVERY PORTION OF THE FACILITY. THE EXISTING GRAVEL ROAD AND GRAVEL PAD PROVIDES ACCESS TO WITHIN 25' OF ALL PORTIONS OF THE NEW POWER PLANT.

**FUEL PIPELINE MODIFICATION NOTES:**

- PRIOR TO EXCAVATING AND CUTTING EXISTING FUEL PIPELINE DISCONNECT THE FUEL TRANSFER PIPELINE FROM INTERMEDIATE TANK AT EXISTING POWER PLANT AND DRAIN PIPELINE AS INDICATED ON SHEET M1.4.
- FOUR EACH EXISTING FUEL PIPELINES (THREE EACH 3" AND ONE EACH 2") AND ONE MULTI-CONDUCTOR C-L-X ARMORED CABLE ARE ROUTED TOGETHER AS SHOWN. LOCATE EXISTING PIPES AND HAND EXCAVATE OR USE AIR SPADE AS REQUIRED TO EXPOSE PIPE BEING CAREFUL NOT TO DAMAGE ADJACENT CABLE OR PIPES.
- DRAIN AND PURGE EXISTING 2" TRANSFER PIPELINE IN PREPARATION FOR CUT AND RECONNECTION.
- PERFORM ALL CUTTING IN ACCORDANCE WITH APPROPRIATE HOT WORK PROCEDURES PER NFPA 51B. PRIOR TO WELDING INERT OR VAPOR FREE EXISTING PIPE AND COVER ADJACENT PIPE AND CONDUIT.
- WELD NEW 2" 90° ELBOW AND 2" SCH 80 COATED PIPE EXTENSION TO NEW POWER PLANT INTERMEDIATE TANK AS INDICATED. COPE ELBOW AS REQUIRED FOR PIPELINE ALIGNMENT.
- AFTER WELDING, PRESSURE TESTING, AND ANODE INSTALLATION, WRAP ALL BELOW GRADE JOINTS AND FITTINGS WITH HOPE HEAT-SHRINK TAPE TO FORM A CONTINUOUS WATER PROOF SEAL. EXTEND HEAT SHRINK 6" MINIMUM ONTO UNDAMAGED COATING ON EXISTING PIPE, 6" ONTO NEW COATING ON NEW COATED PIPE, AND 6" MINIMUM ABOVE GRADE.
- PLUG CUT END OF EXISTING PIPELINE THIS AREA WITH NON-SHRINK GROUT. CUT OTHER END AT OLD POWER PLANT 18" MIN BELOW GRADE AND PLUG WITH NON-SHRINK GROUT.

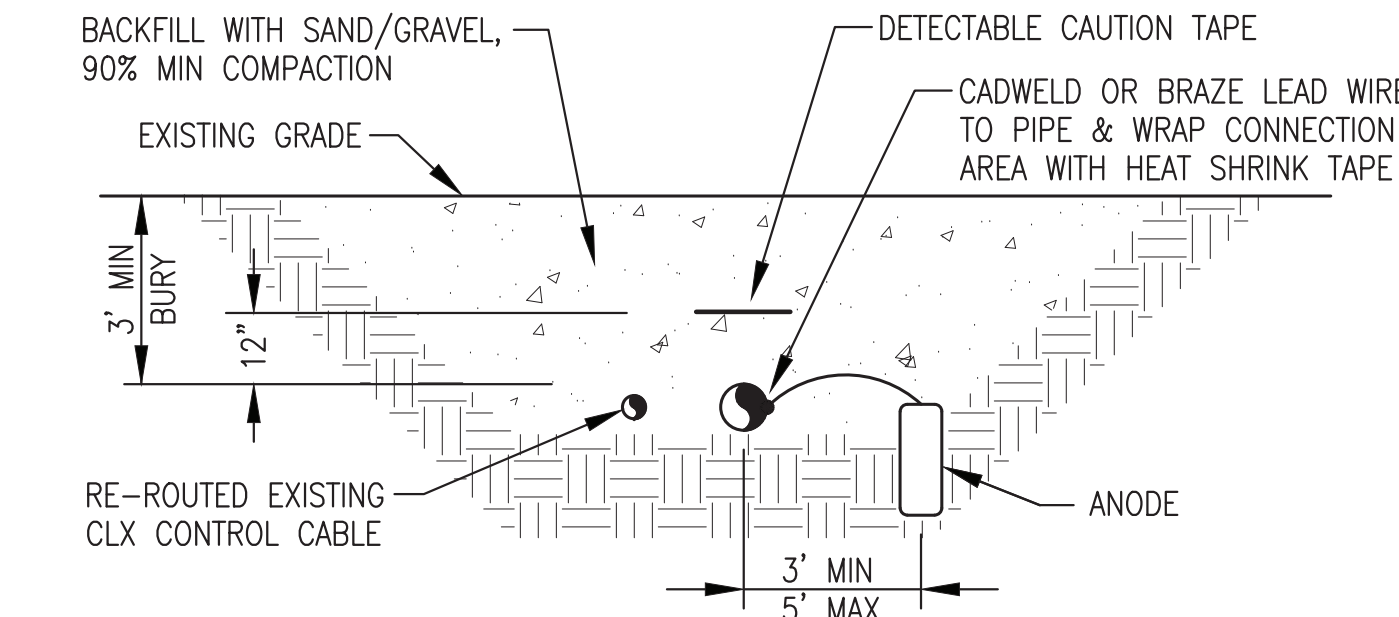


**2** BURIED FUEL PIPE & CONDUIT INSTALLATION  
**M1.5** NO SCALE

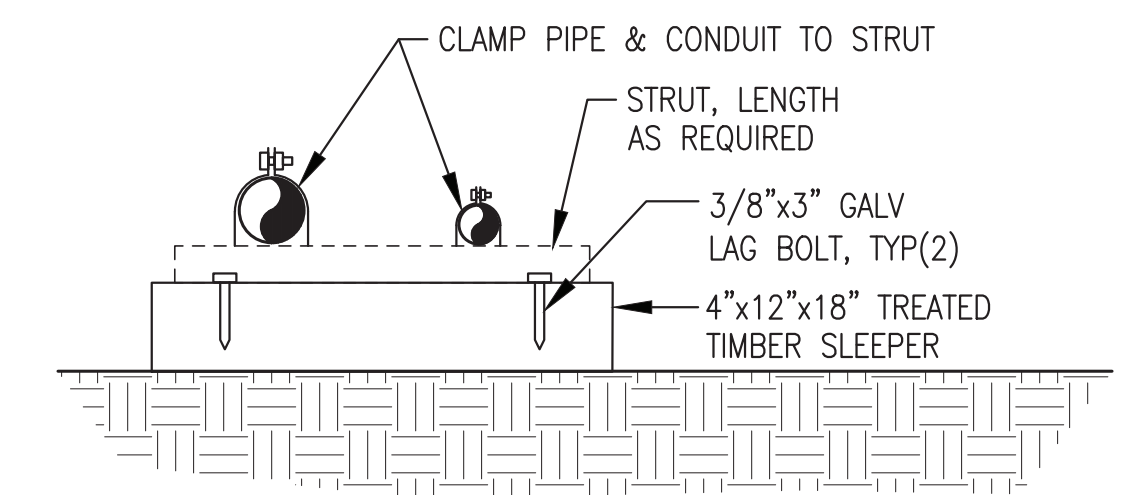

**3** FUEL PIPELINE & CONDUIT SLEEPER SUPPORT  
**M1.5** NO SCALE

**NOTES:**

- PRIOR TO REMOVING EXISTING VALVE, COORDINATE WITH ELECTRICAL FOR CONDUCTOR IDENTIFICATION.
- INSTALL NEW FLANGE GASKETS AND STAINLESS STEEL BOLT SETS.

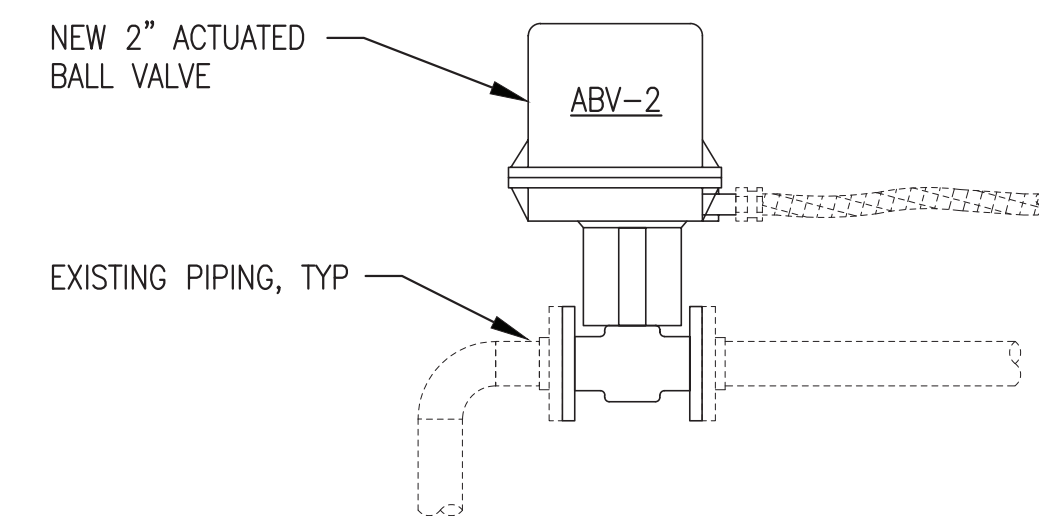


**4** TANK FARM ACTUATOR ABV-2 INSTALLATION  
**M1.5** NO SCALE



ALL WORK ON THIS SHEET IS INCLUDED IN THE ON SITE CONTRACT

ISSUED FOR CONSTRUCTION  
MAY 2023

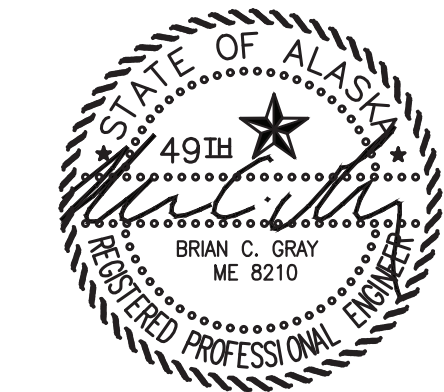

 ALASKA ENERGY AUTHORITY		
PROJECT: NELSON LAGOON POWER SYSTEM UPGRADE		
TITLE: POWER PLANT ENLARGED MECHANICAL SITE PLAN & DETAILS		
 Gray Stassel Engineering, Inc. P.O. 111405, Anchorage, AK 99511 (907)349-0100	DRAWN BY: JTD DESIGNED BY: BCG FILE NAME: NELS PP M1 PROJECT NUMBER:	SCALE: AS NOTED DATE: 5/30/23 SHEET: <b>M1.5</b>




**GENERAL NOTES:**


- 1) ALL NIPPLES AND RISER PIPES GALVANIZED STEEL PIPE OR GRC.
- 2) COAT ALL PIPING CONNECTIONS TO TANK WITH ANTI-SEIZE INCLUDING MALE PIPE THREADS, FLANGE GASKETS, AND BOLTS.

**SPECIFIC NOTES:**


- 1) 8" FLANGED SECONDARY EMERGENCY VENT.
- 2) 8" FLANGED PRIMARY EMERGENCY VENT.
- 3) THREE POINT FLOAT TYPE LOW/FULL/OVERFILL LEVEL SWITCH LS, SEE DETAIL 6/E1.5.
- 4) 1" FLANGED ACTUATOR VALVE & DROP TUBE IN 4" BUNG. SEE DETAIL 1/M1.7.
- 5) 89" LONG LEVEL SENSOR PROBE FOR TANK LEVEL MONITORING IN 2" BUNG, SEE DETAIL 4/E1.5.
- 6) 2" PRESSURE/VACUUM VENT WITH WHISTLE ALARM ON 3" BUNG, SEE INSTALLATION DETAIL 6/M1.6.
- 7) 24" MANHOLE. TEMPORARILY REMOVE BOLTS AND COAT WITH ANTI-SEIZE.
- 8) 2" FILL LIMITER & FLANGED CHECK VALVE, SEE INSTALLATION DETAIL 5/M1.6.
- 9) 2" MECHANICAL FUEL LEVEL GAUGE ON 2" BUNG, SEE INSTALLATION DETAIL 3/M1.6.
- 10) 1" WATER DRAW ON 2" BUNG. SEE INSTALLATION DETAIL 4/M1.6.
- 11) 2" FPT GAUGE HATCH ON 2"x4" NIPPLE.
- 12) 2" FLANGED STRAINER ON FUEL TRANSFER PIPELINE
- 13) 2" SECONDARY TANK MONITOR PORT WITH VENT CAP.
- 14) SHOP FABRICATED BOLT-ON LADDER.
- 15) 2" FUEL TRANSFER PIPELINE RISER ON FACE OF TANK.
- 16) 2" FLANGED BALL VALVE WITH 1" PRV BYPASS.
- 17) SUPPORT 2" FILL RISER PIPE FROM TANK HEAD, SEE DETAIL 2/M1.7.
- 18) 2" FLANGED FLEX BEHIND.
- 19) TRANSITION TO BURIED, SEE TANK END ELEVATION 2/M1.6.
- 20) ANCHOR TANK TO CONCRETE FOOTING, 4 LOCATIONS TOTAL, SEE DETAIL 7/M1.6.
- 21) SUPPORT OVERHEAD PIPING & CONDUIT WITH FIELD-MOUNTED STRUT RACK. SEE DETAIL 1/M1.7.

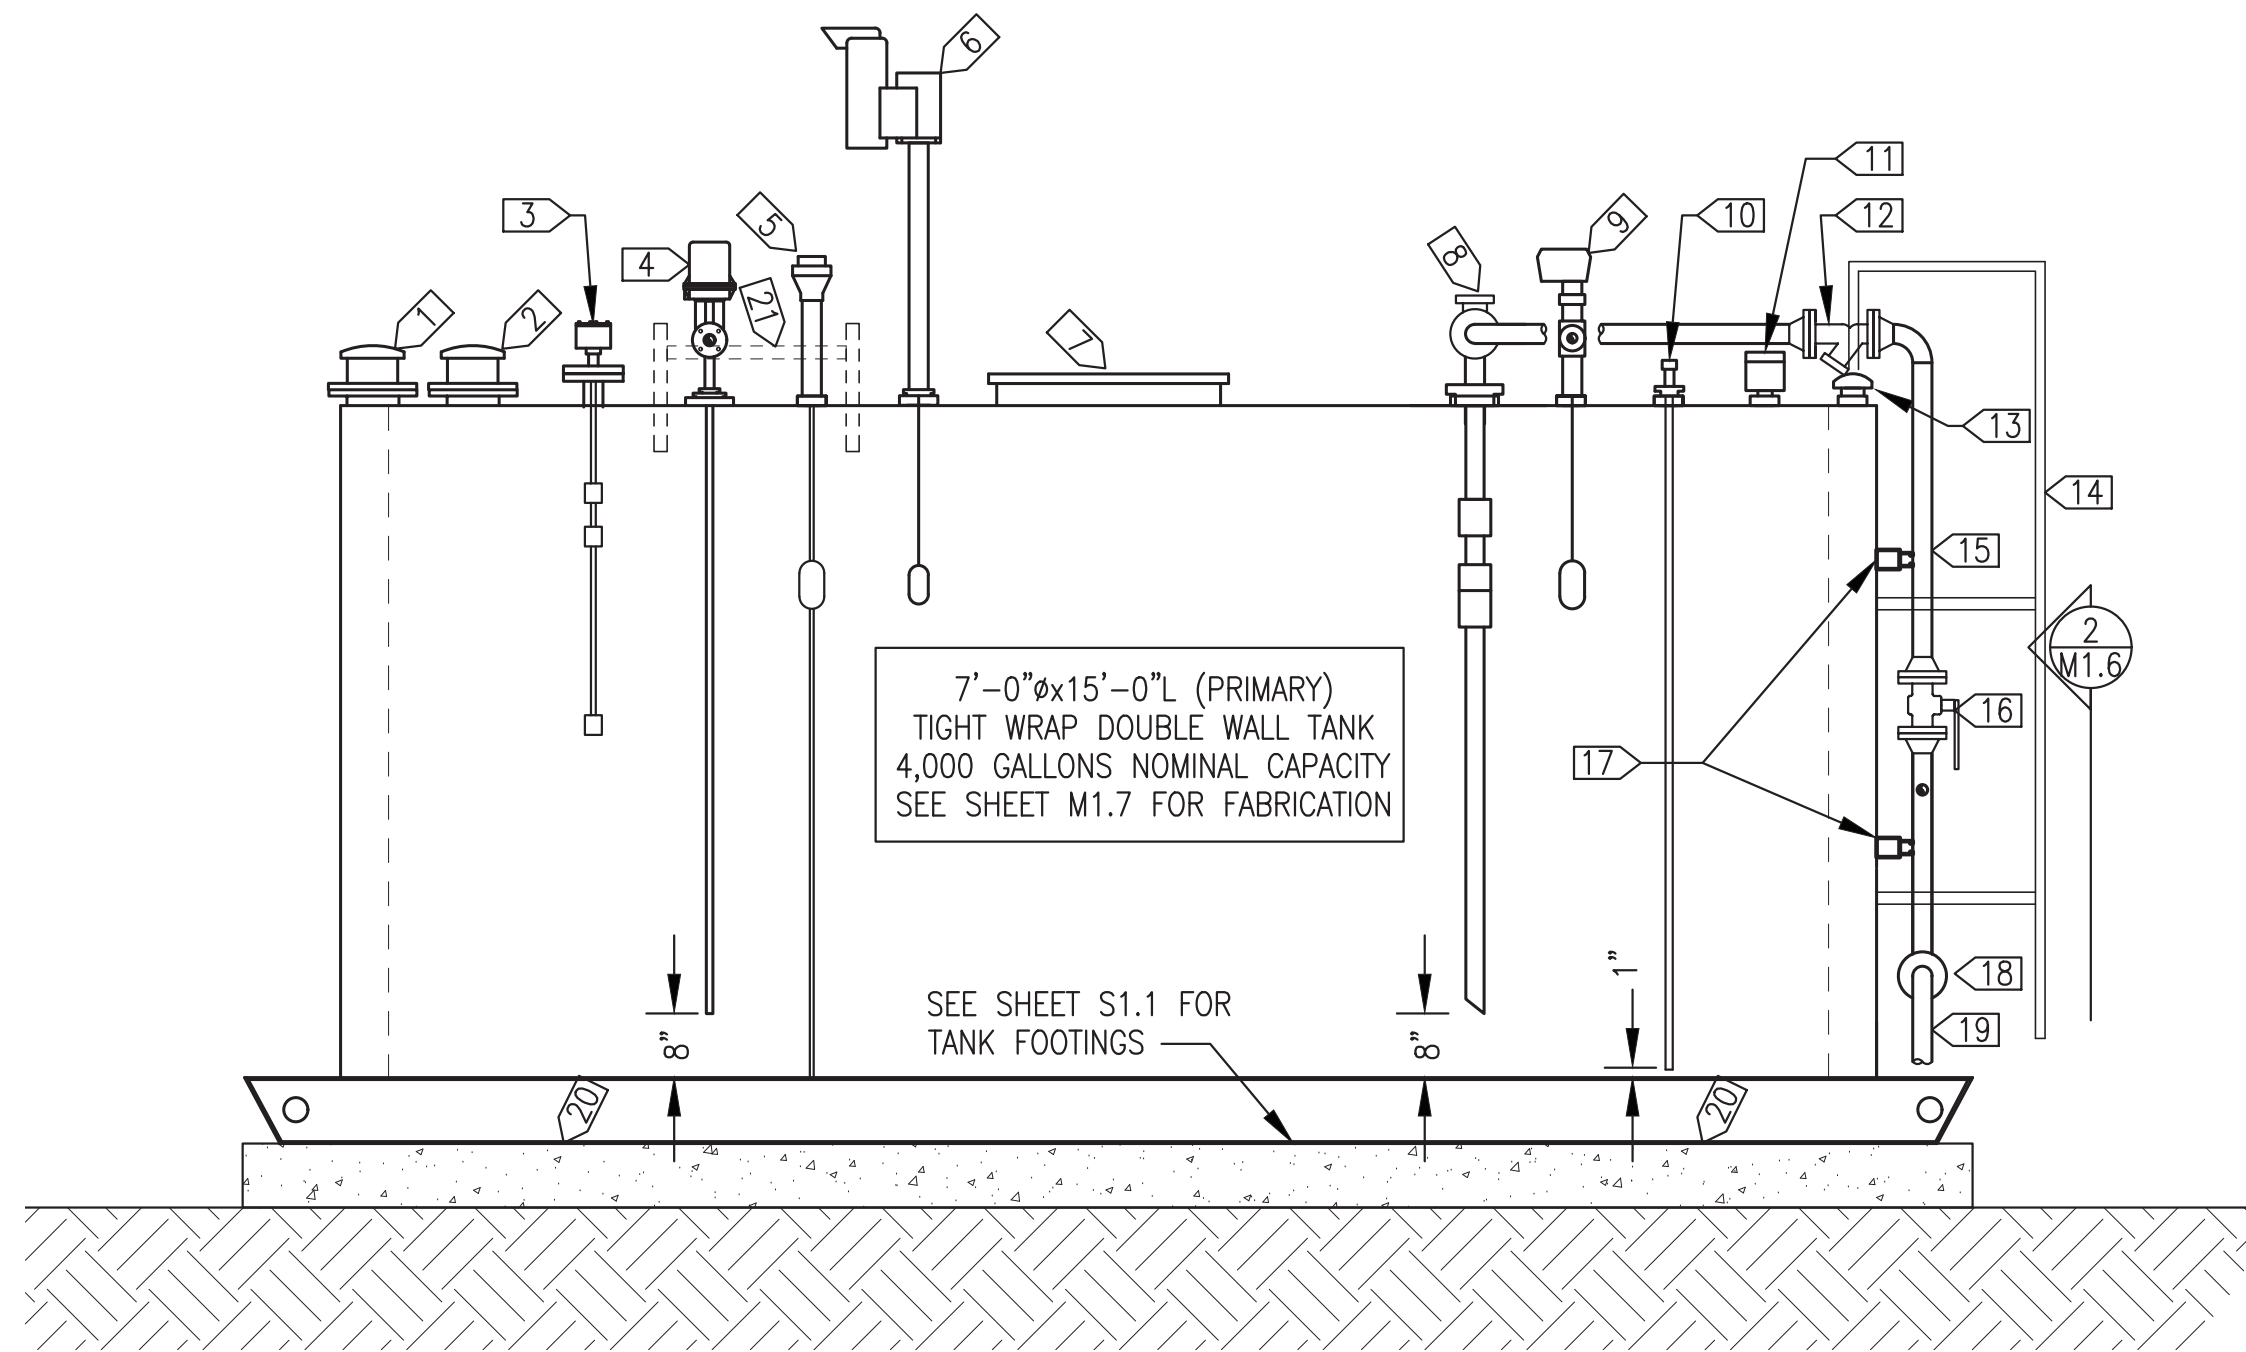

**1** 4,000 GALLON INTERMEDIATE TANK INSTALLATION  
M1.6 1/2"=1'-0"

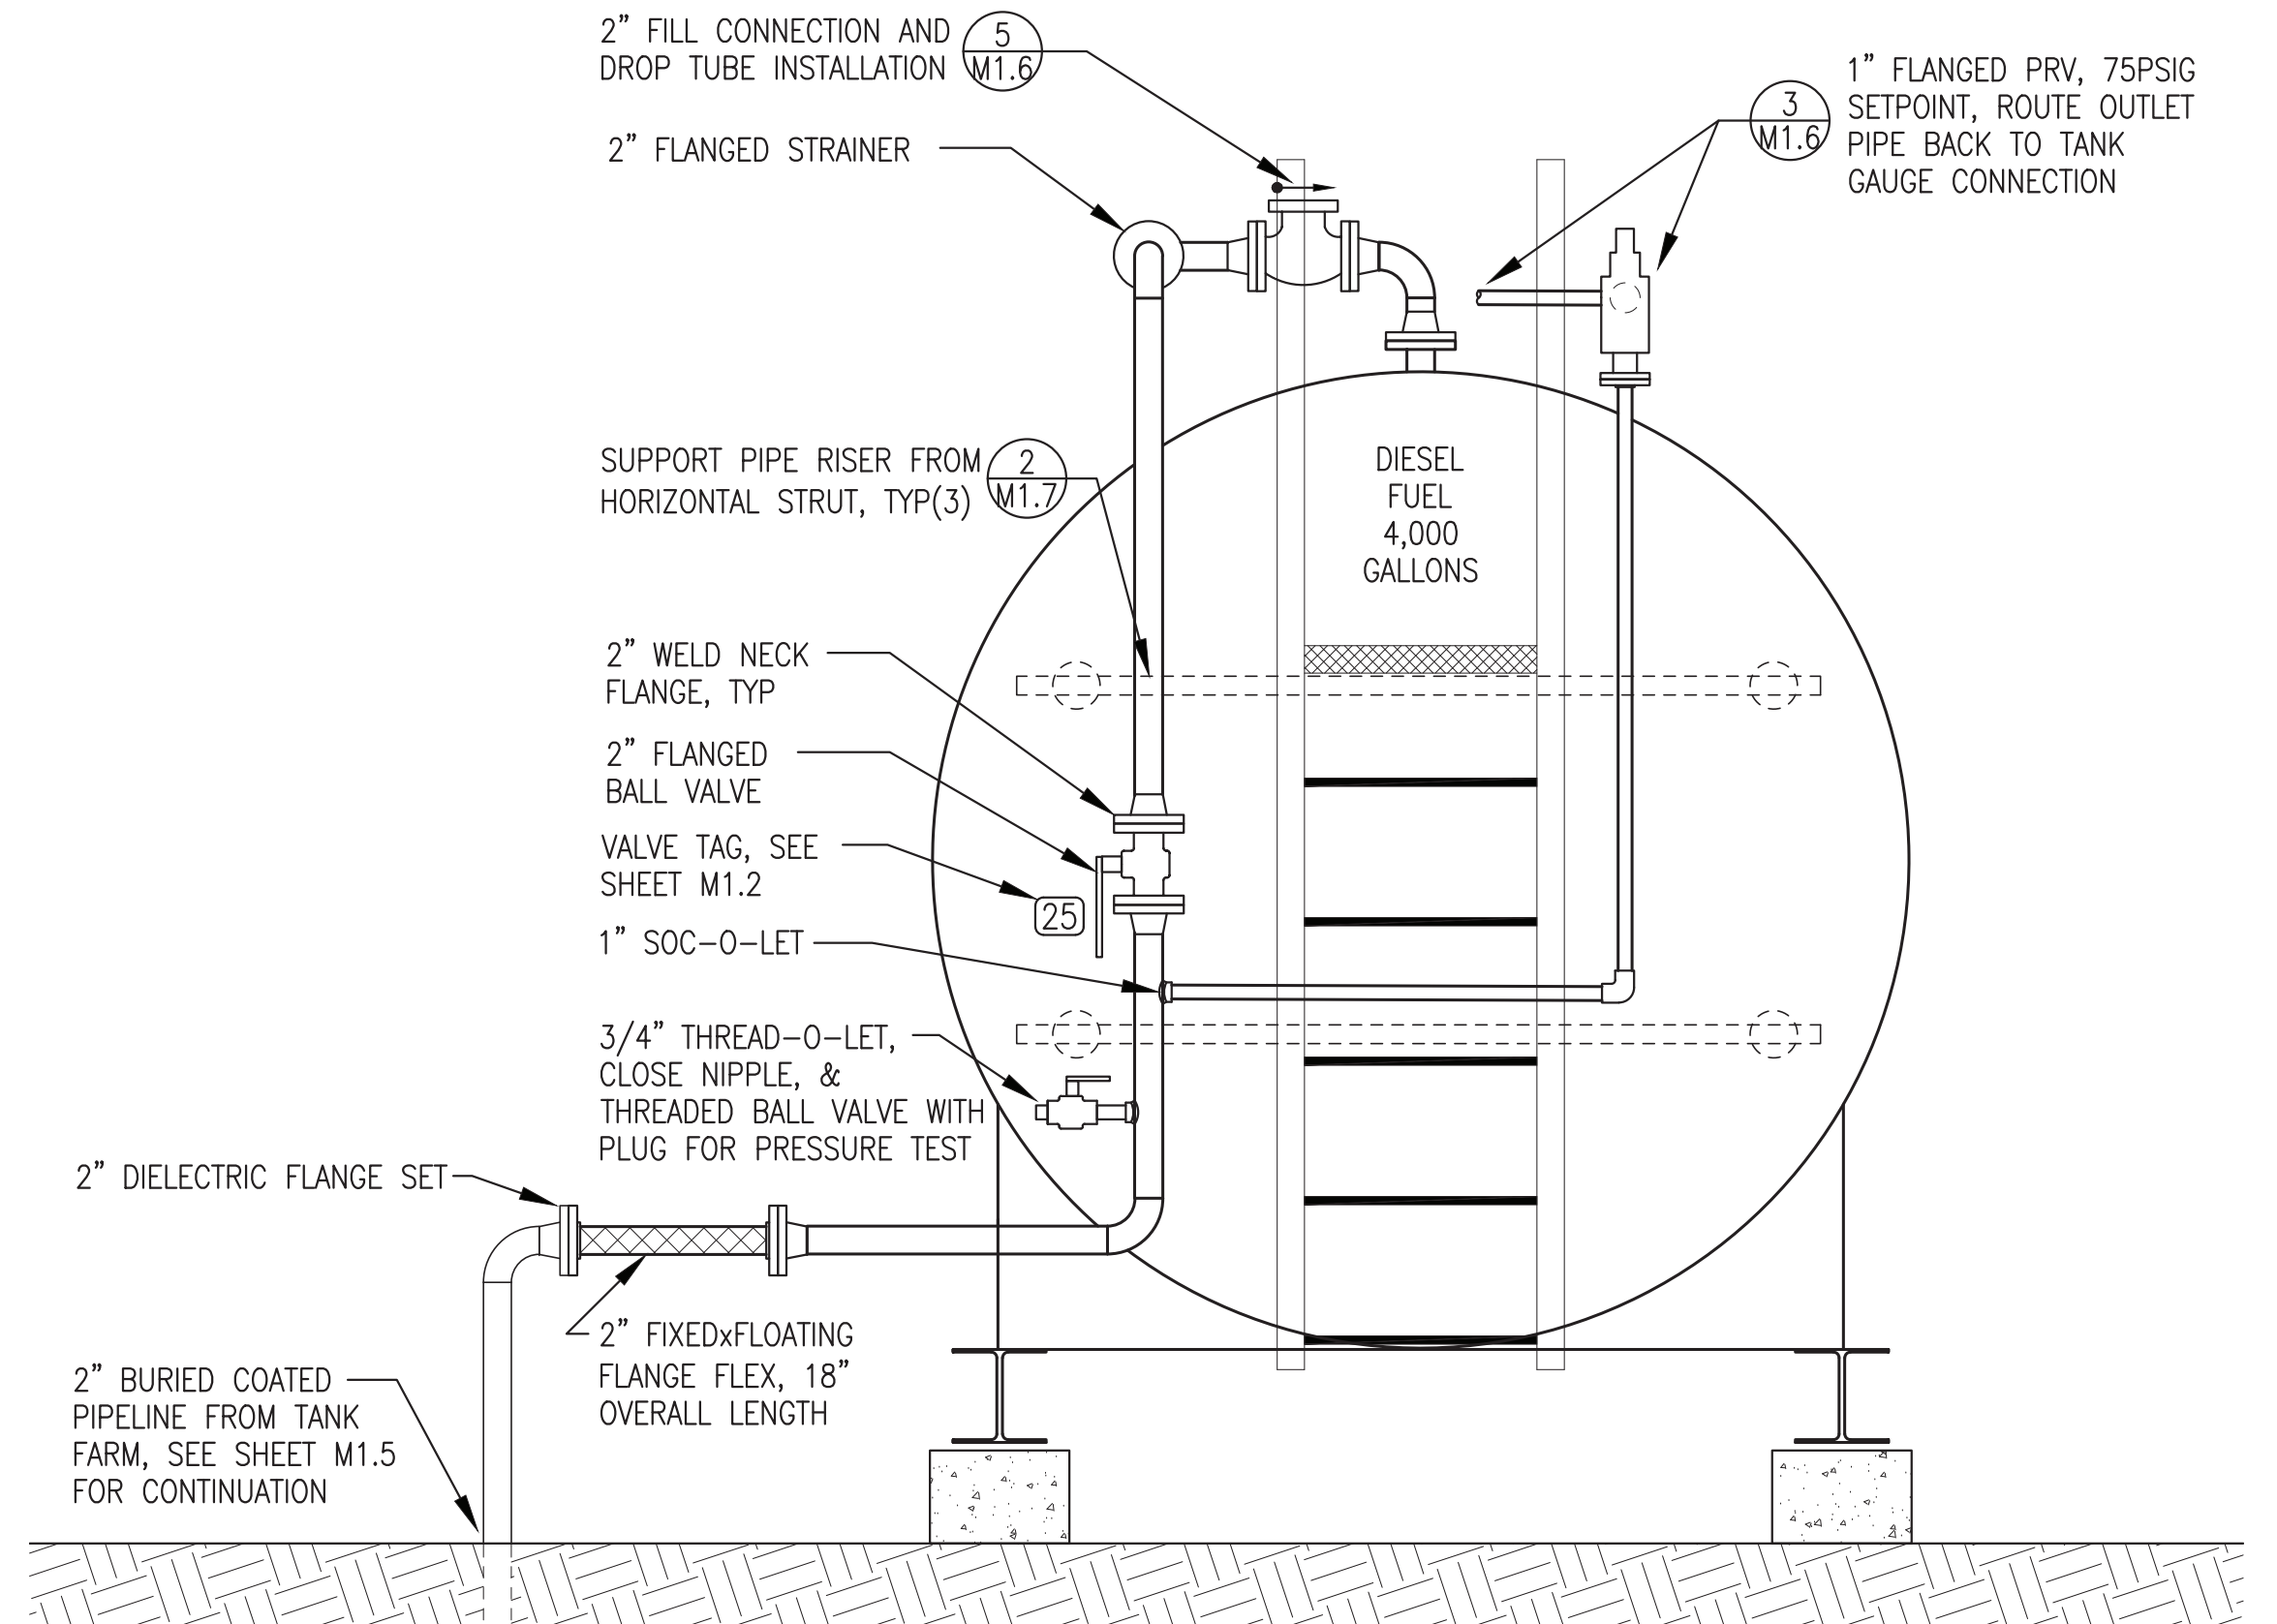


**2** 4,000 GALLON INTERMEDIATE TANK END ELEVATION  
M1.6 3/4"=1'-0"

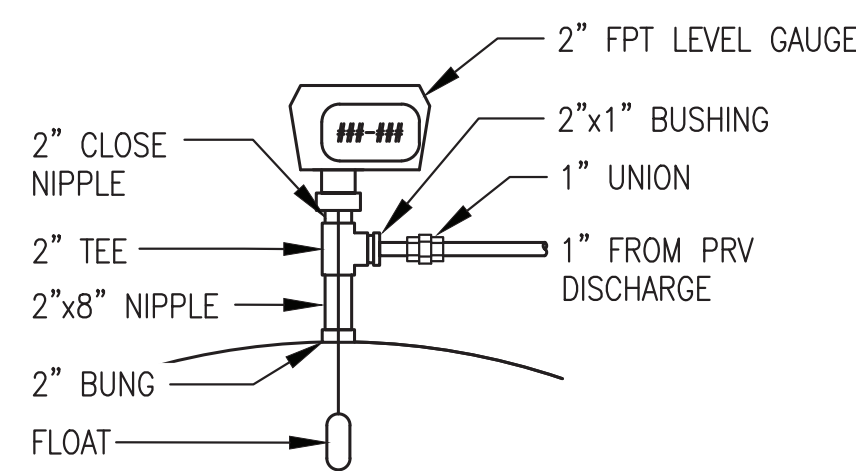

**NOTES:**


- 1) FEED FLOAT CABLE THROUGH NIPPLE PRIOR TO CONNECTING TO TANK.
- 2) GREASE FLOAT PRIOR TO INSTALLING IN TANK TO PREVENT FREEZING TO BOTTOM.
- 3) CALIBRATE GAUGE AFTER FILLING TANK AND VERIFY WITH MANUAL GAUGING ROD OR TAPE.

**3** MECHANICAL LEVEL GAUGE INSTALLATION  
M1.6 NO SCALE

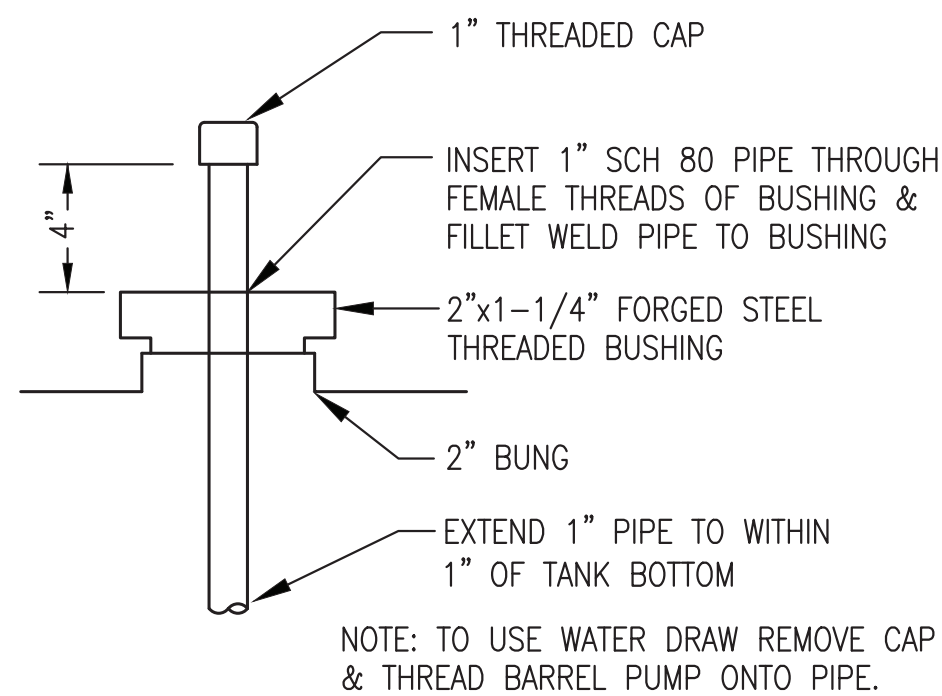


NOTE: TO USE WATER DRAW REMOVE CAP & THREAD BARREL PUMP ONTO PIPE.

**4** WATER DRAW INSTALLATION  
M1.6 NO SCALE

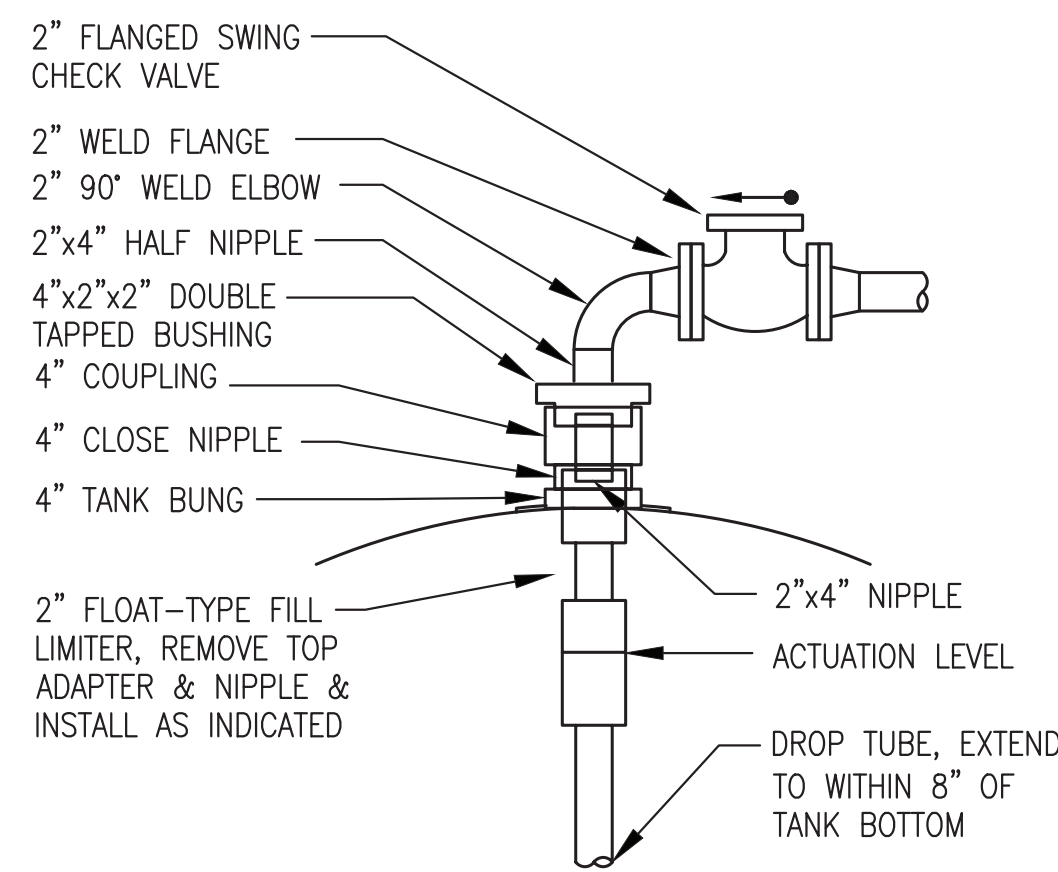

NOTE: PIPING SIZED TO PROVIDE SHUT OFF WHEN ACTUATION LEVEL IS AT 6'-3" ABOVE TANK BOTTOM (95% CAPACITY). FIELD VERIFY SHUT OFF HEIGHT & ADJUST LINKAGE AS REQUIRED.


**5** FILL LIMITER INSTALLATION  
M1.6 NO SCALE

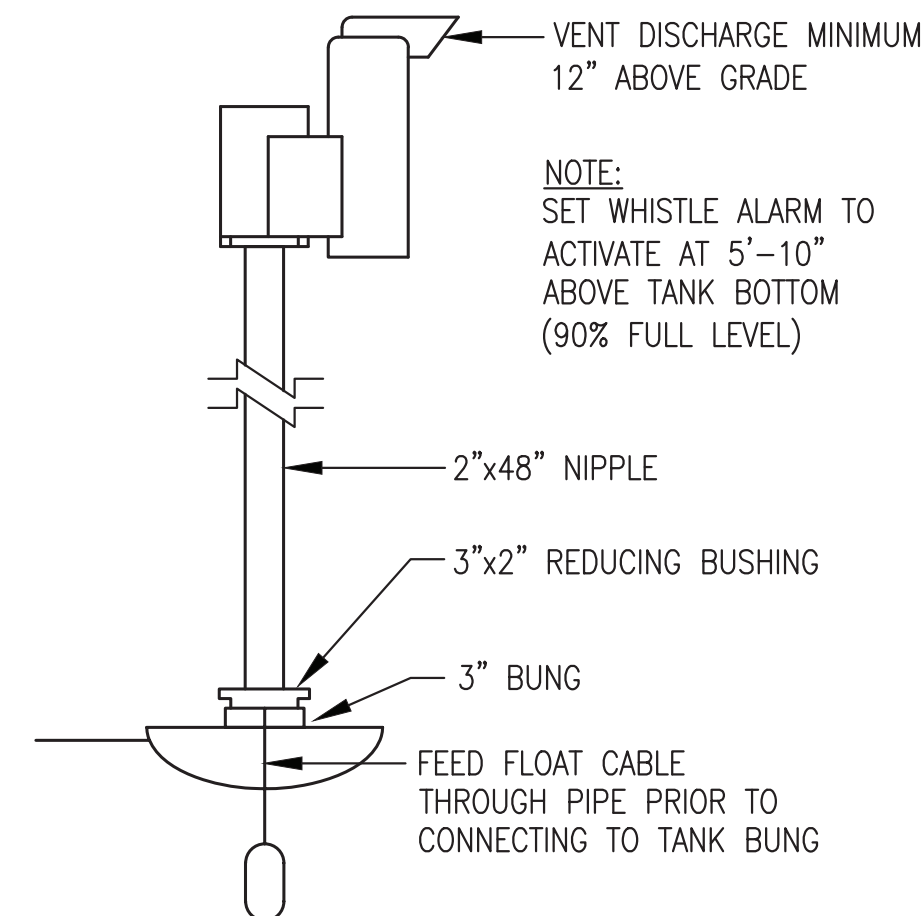

NOTE: SET WHISTLE ALARM TO ACTIVATE AT 5'-10" ABOVE TANK BOTTOM (90% FULL LEVEL)

**6** P/V WHISTLE VENT INSTALLATION  
M1.6 NO SCALE

**7** TYPICAL TANK ANCHOR  
M1.6 NO SCALE

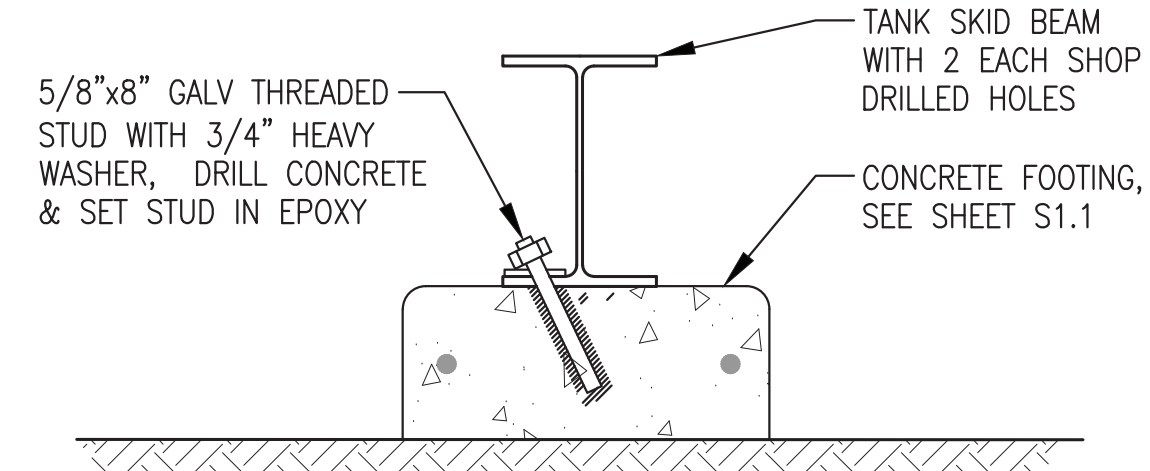


ALL WORK ON THIS SHEET IS INCLUDED IN THE ON SITE CONTRACT



ISSUED FOR CONSTRUCTION  
MAY 2023



ALASKA ENERGY AUTHORITY	
PROJECT: NELSON LAGOON POWER SYSTEM UPGRADE	
TITLE: INTERMEDIATE TANK INSTALLATION ELEVATIONS & DETAILS	
DESIGNED BY: BCG	SCALE: AS NOTED
DATE: 5/30/23	SHEET: M1.6
FILE NAME: NELS_PP_M1	PROJECT NUMBER:
P.O. 111405, Anchorage, AK 99511 (907)349-0100	

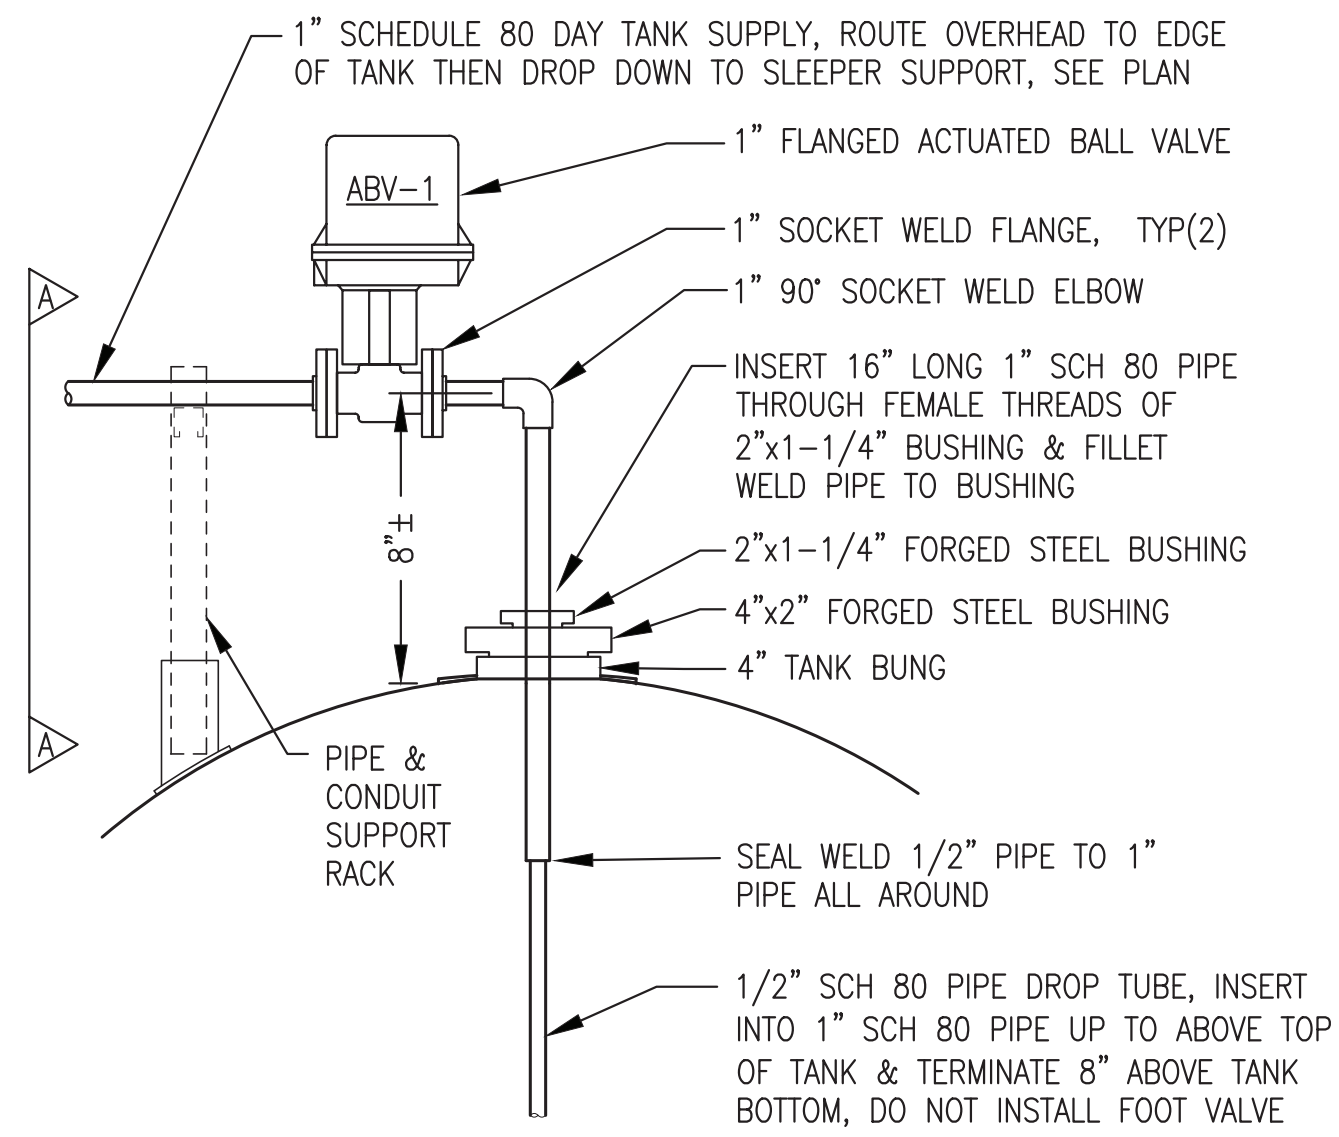


**1** ACTUATED BALL VALVE & DROP TUBE INSTALLATION  
M1.7 NO SCALE

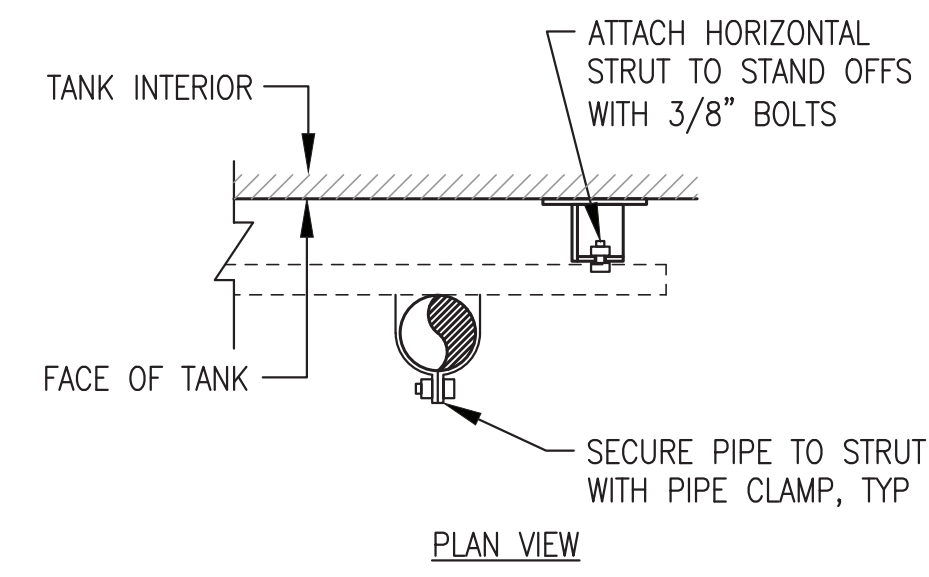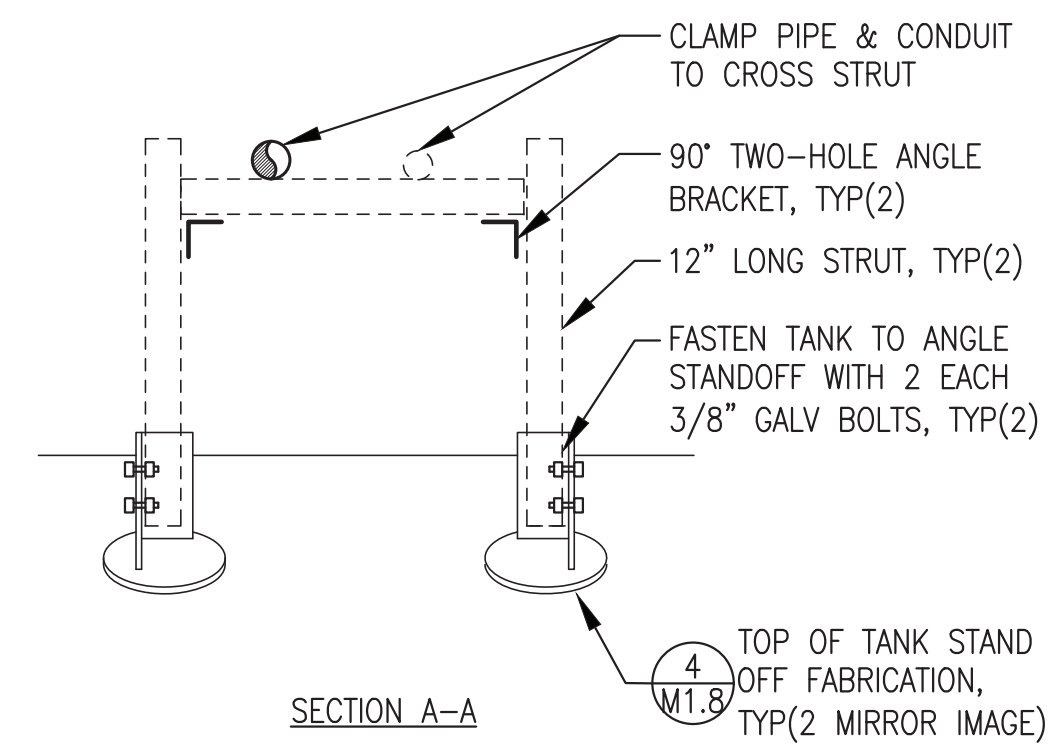


**2** TANK HEAD PIPE SUPPORT  
M1.7 NO SCALE

ALL WORK ON THIS SHEET IS INCLUDED IN THE ON SITE CONTRACT



ISSUED FOR  
CONSTRUCTION  
MAY 2023

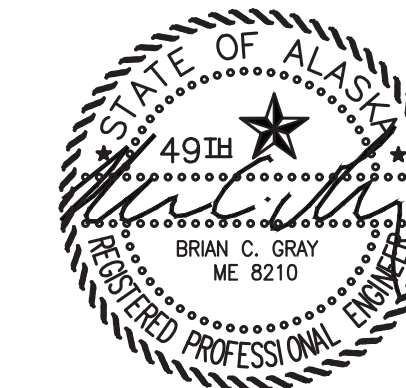

ALASKA ENERGY AUTHORITY		
PROJECT: NELSON LAGOON POWER SYSTEM UPGRADE		
TITLE: INTERMEDIATE TANK DETAILS		
	DRAWN BY: JTD	SCALE: AS NOTED
	DESIGNED BY: BCG	DATE: 5/30/23
FILE NAME: NELS PP M1	SHEET:	M1.7
PROJECT NUMBER:		
P.O. 111405, Anchorage, AK 99511 (907)349-0100		

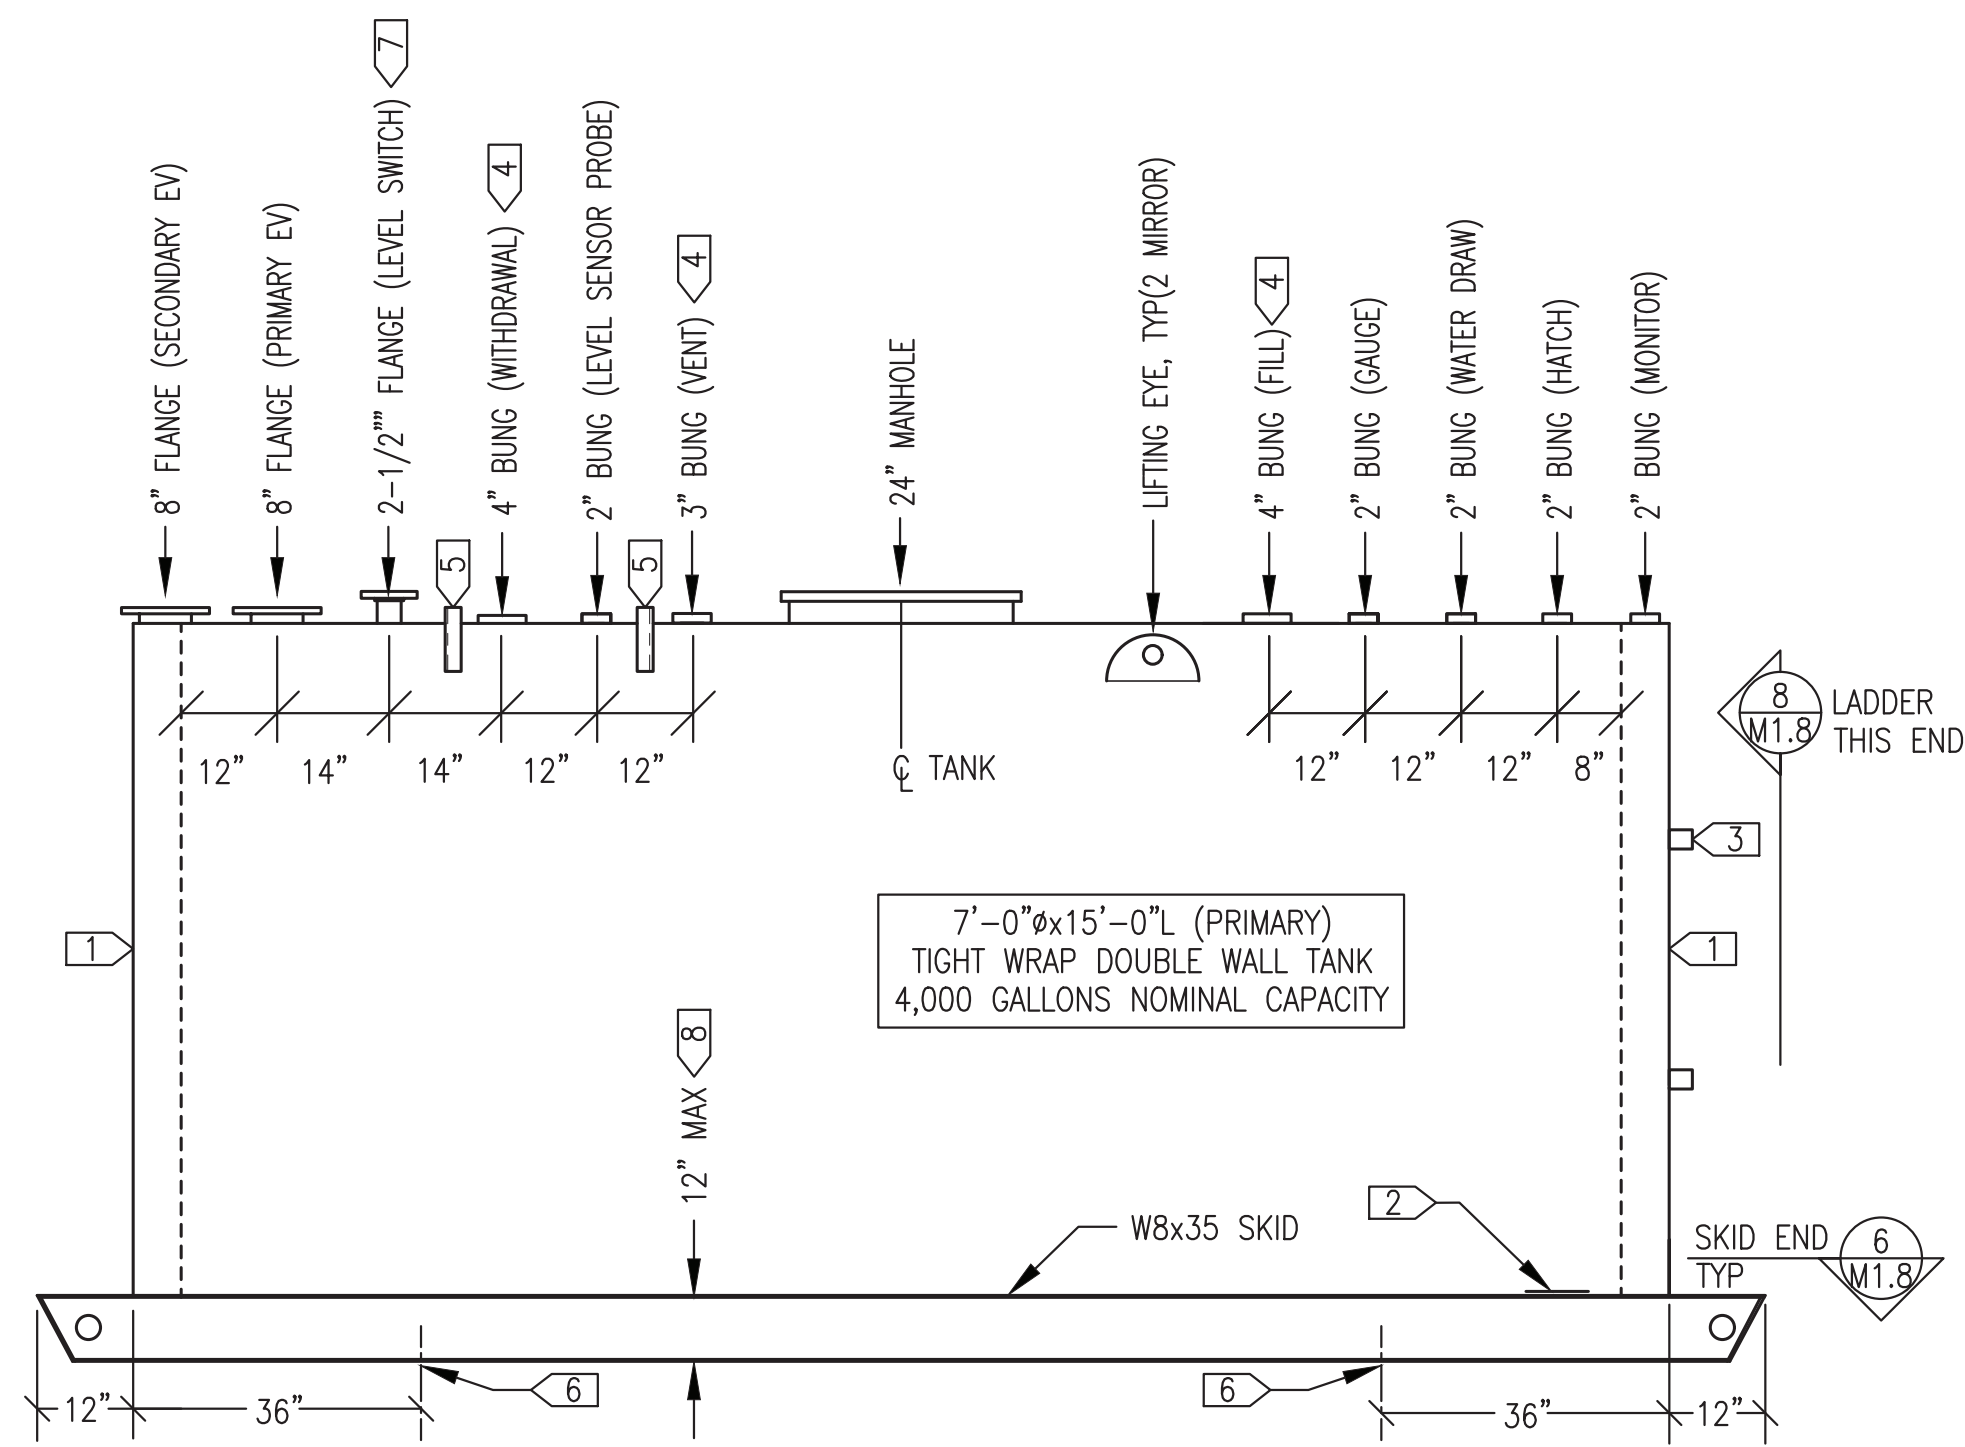



- TANK FABRICATION SPECIFIC DETAILS**
- 1 > 4" HIGH BLACK LETTERING x1/2" STROKE: "DIESEL FUEL 4,000 GALLONS"
  - 2 > SEAL WELD 1/4"x10"Ø STRIKER PLATE TO TANK BOTTOM DIRECTLY BELOW GAUGE HATCH TOP BUNG. PLATE TO BE ROLLED TO MATCH DIAMETER OF TANK.
  - 3 > PIPE SUPPORT STAND OFF, 4 THIS END OF TANK.
  - 4 > PROVIDE 1/4"x8" DIAMETER DOUBLER PLATE.
  - 5 > PIPE SUPPORT STANDOFF, SEE TOP OF TANK SUPPORT BRACKET LAYOUT 3/M1.8.
  - 6 > 1-1/8"Ø HOLE, 2 PLACES EACH SKID, SEE DETAIL 7/M1.8.
  - 7 > 2-1/2" FLAT FACED FLANGE. FACE OF FLANGE 4" ABOVE TOP OF TANK.
  - 8 > PROVIDE SADDLE/SKID ASSEMBLY WITH 12" MAX RISE FROM BOTTOM OF SKID TO BOTTOM OF TANK.

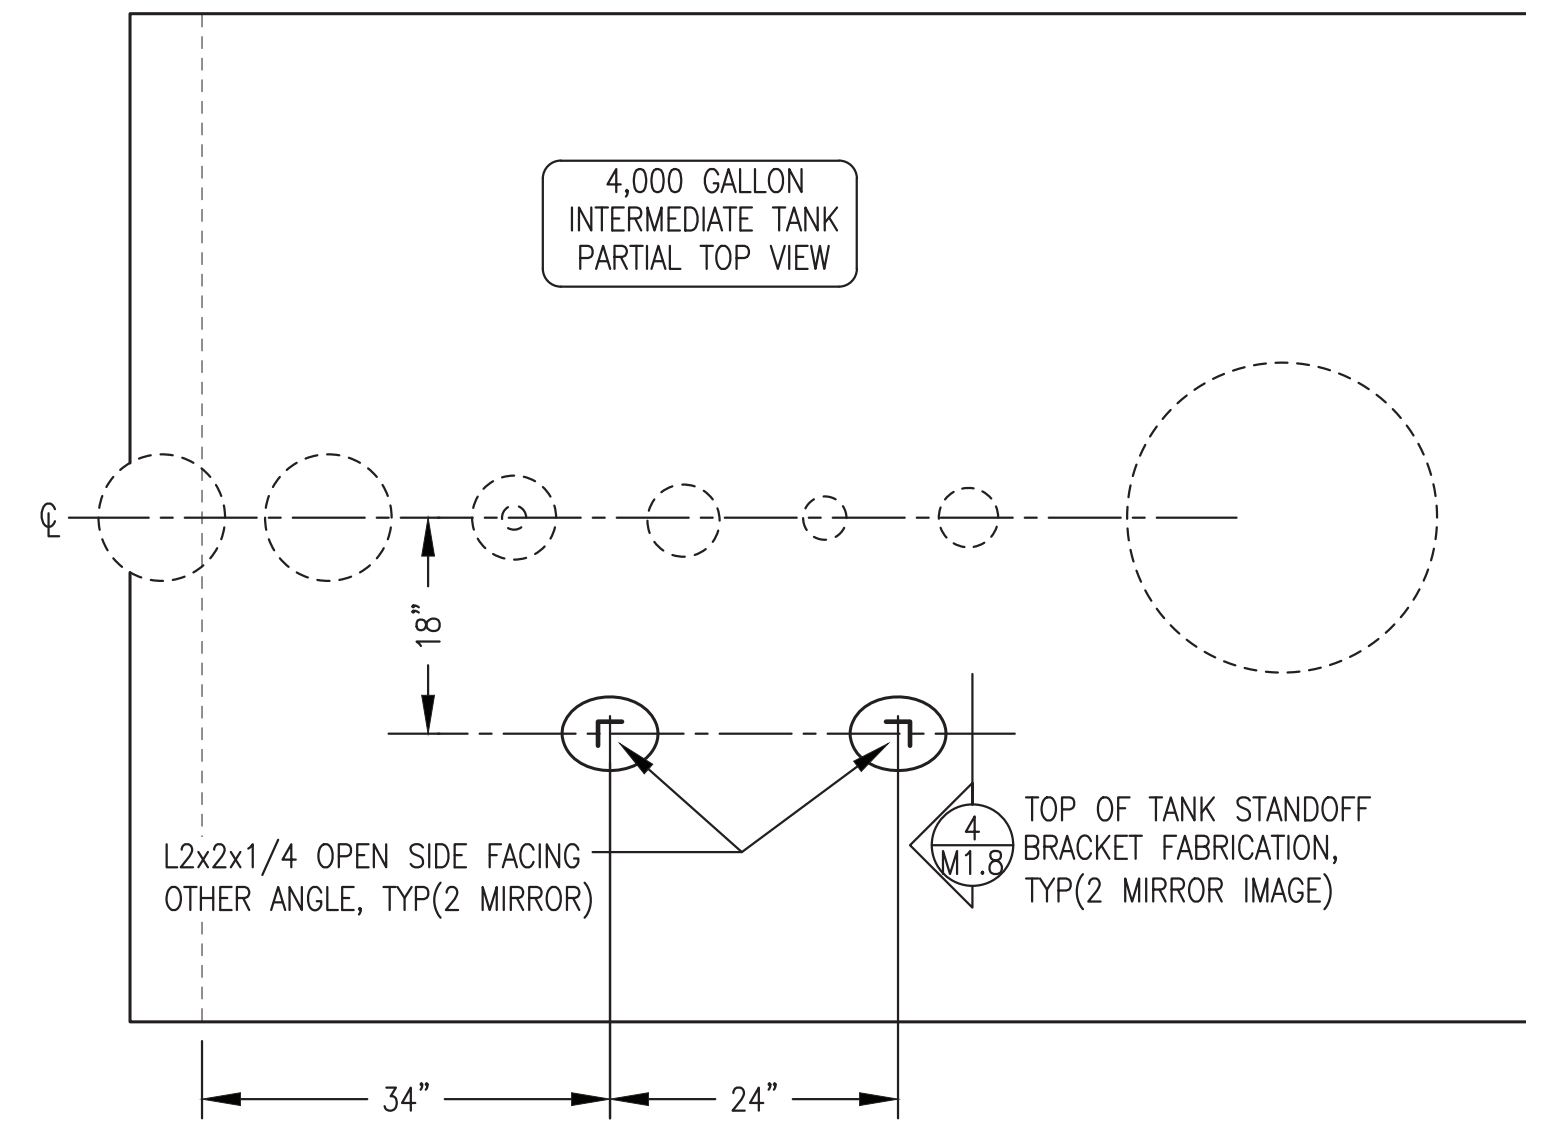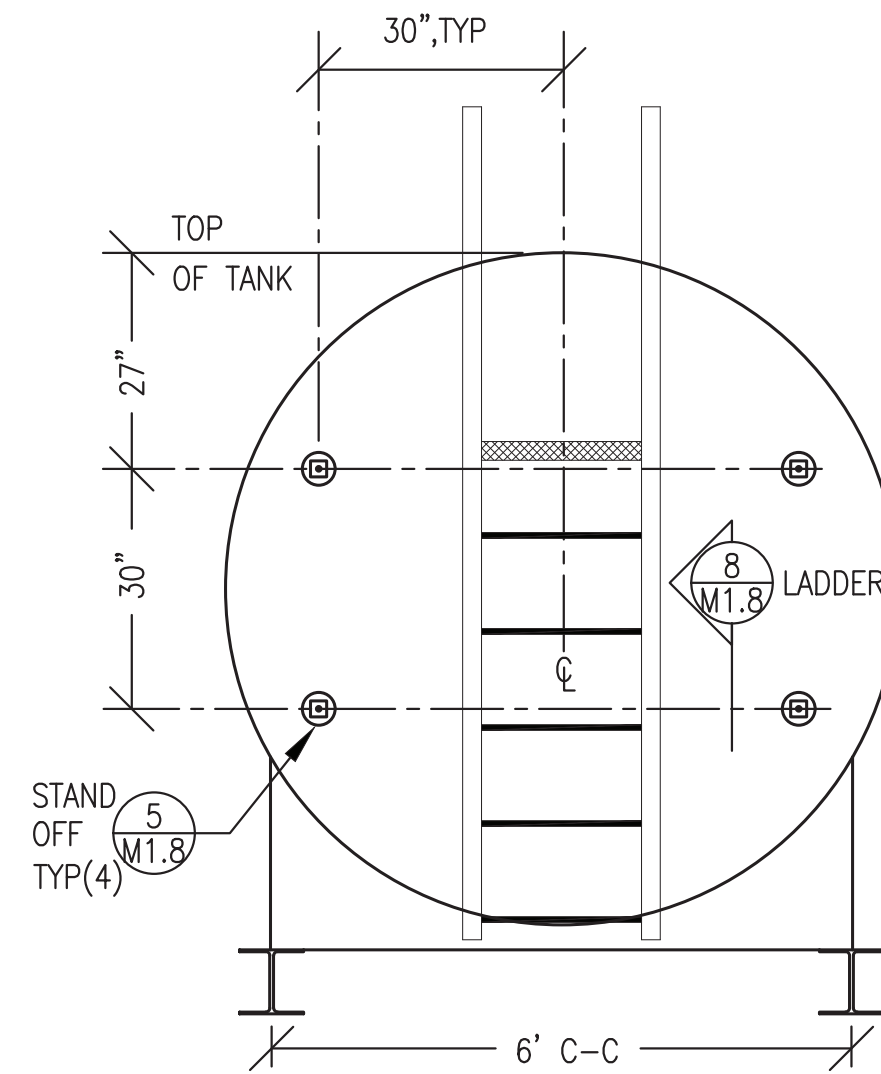

1 SECTION THROUGH TANK  
M1.8 1/2"=1'-0"



2 TANK END ELEVATION  
M1.8 NO SCALE

3 TOP OF TANK STANDOFF BRACKET LAYOUT  
M1.8 NO SCALE

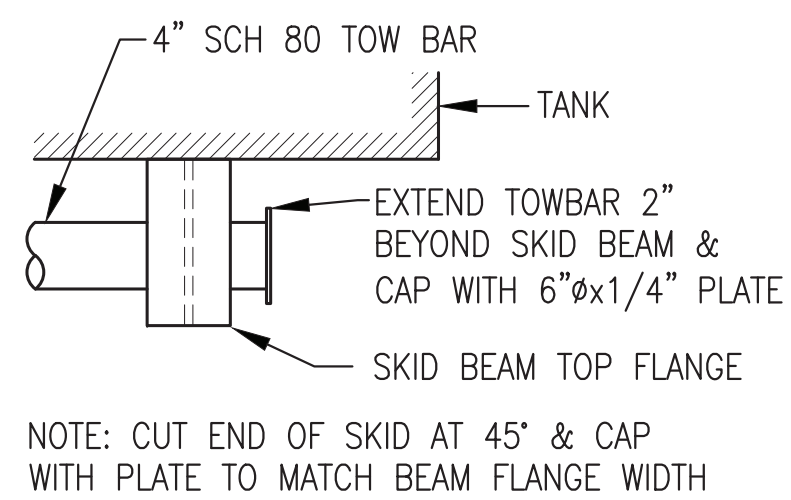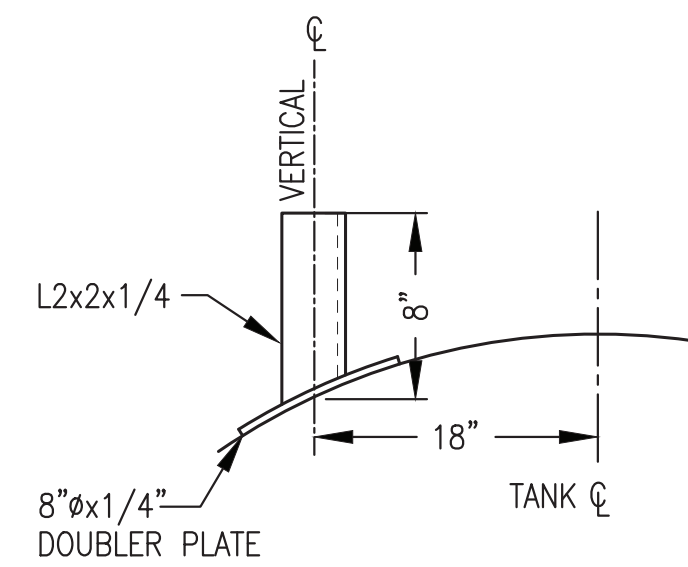


4 TOP OF TANK STANDOFF BRACKET FABRICATION  
M1.8 NO SCALE

6 END OF SKID (TOP VIEW)  
M1.8 NO SCALE

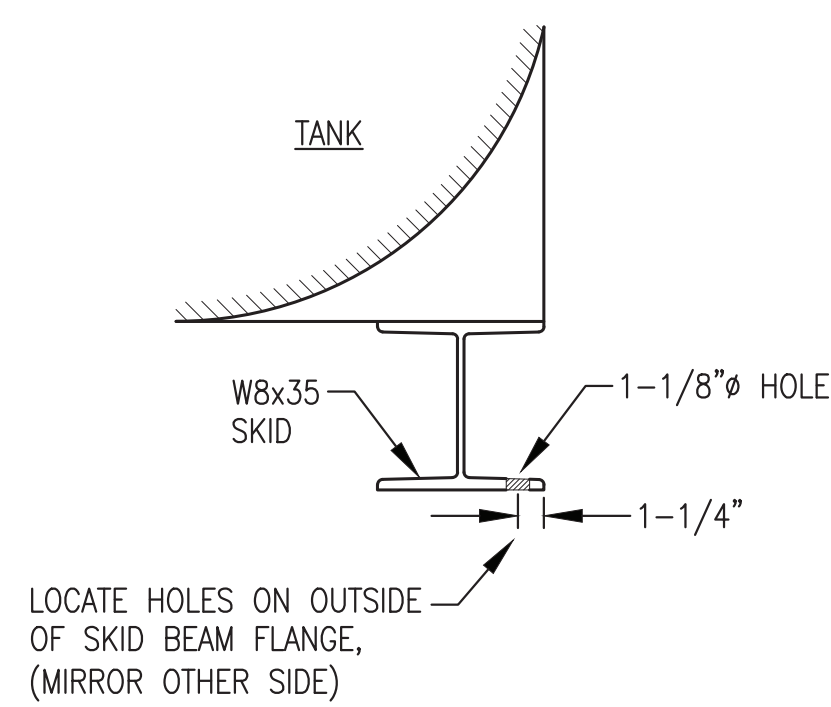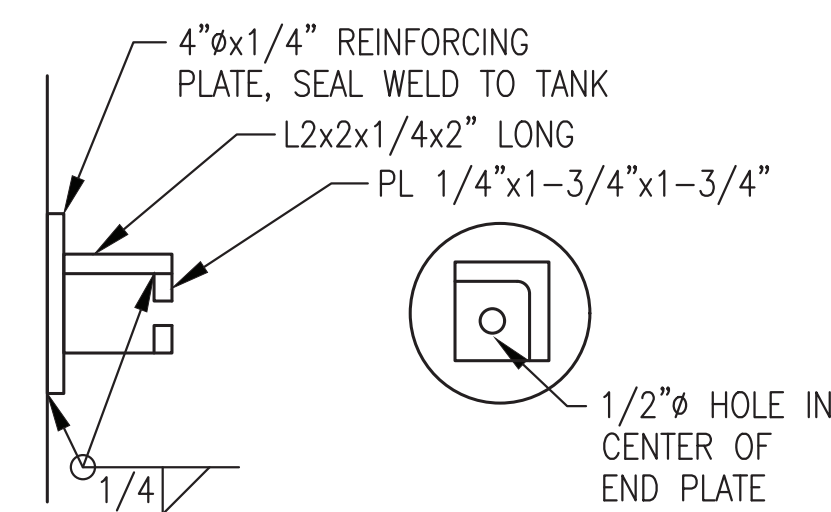

5 TYP. PIPE SUPPORT STAND OFF  
M1.8 NO SCALE

7 TYPICAL TANK SKID HOLE  
M1.8 NO SCALE

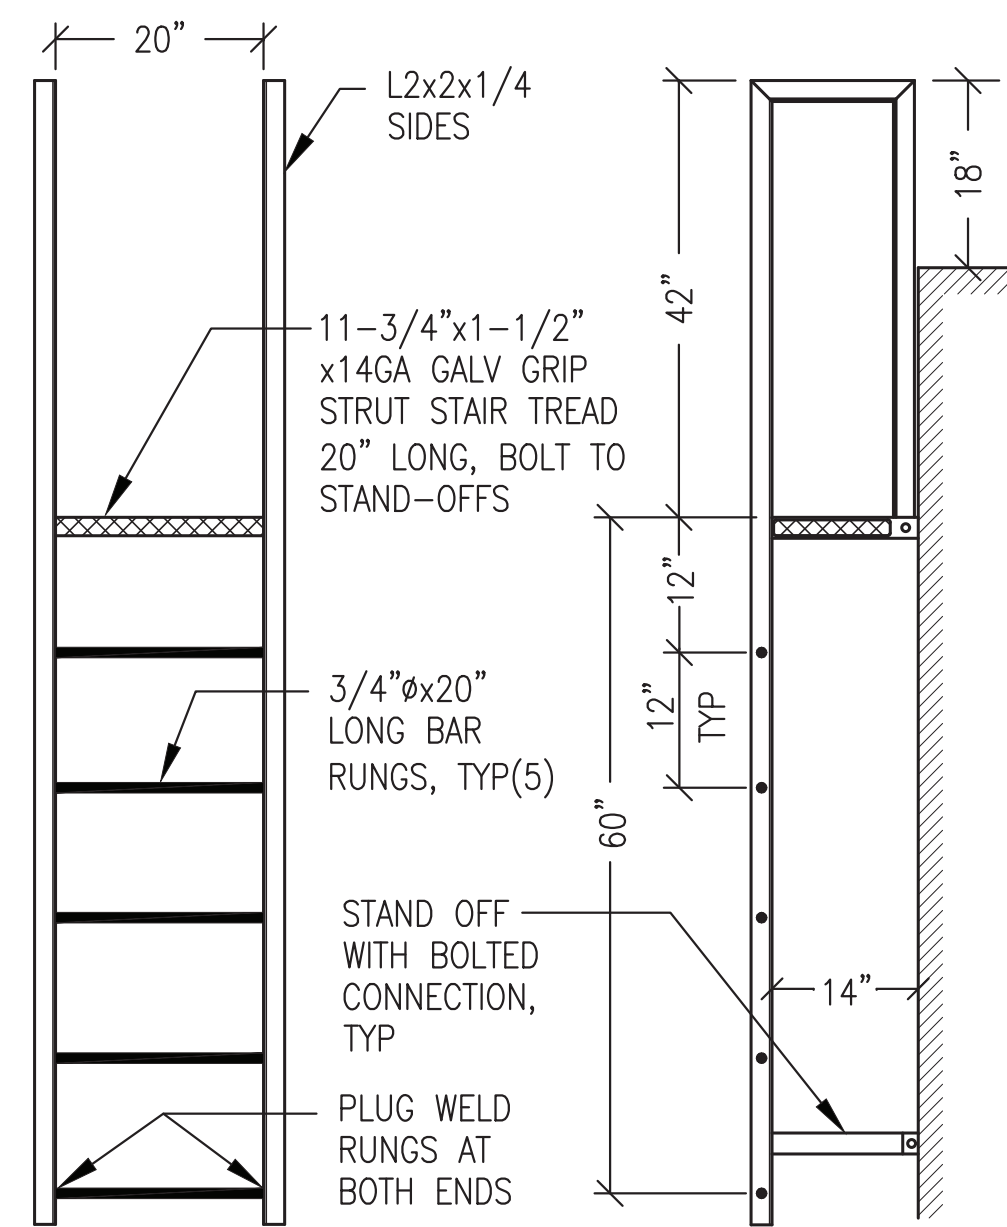

8 LADDER FABRICATION  
M1.8 NO SCALE

ALL WORK ON THIS SHEET IS INCLUDED IN THE ON SITE CONTRACT



ISSUED FOR CONSTRUCTION  
MAY 2023



ALASKA ENERGY AUTHORITY	
PROJECT:	NELSON LAGOON POWER SYSTEM UPGRADE
TITLE:	4,000 GALLON DOUBLE WALL INTERMEDIATE TANK FABRICATION DETAILS
DRAWN BY: JTD	SCALE: AS NOTED
DESIGNED BY: BCG	DATE: 5/30/23
FILE NAME: NELS_PP_M1	SHEET:
PROJECT NUMBER:	M1.8
P.O. 111405, Anchorage, AK 99511 (907)349-0100	



**Gray Stassel Engineering, Inc.**

3 GRID A MECHANICAL WALL PENETRATION LAYOUT

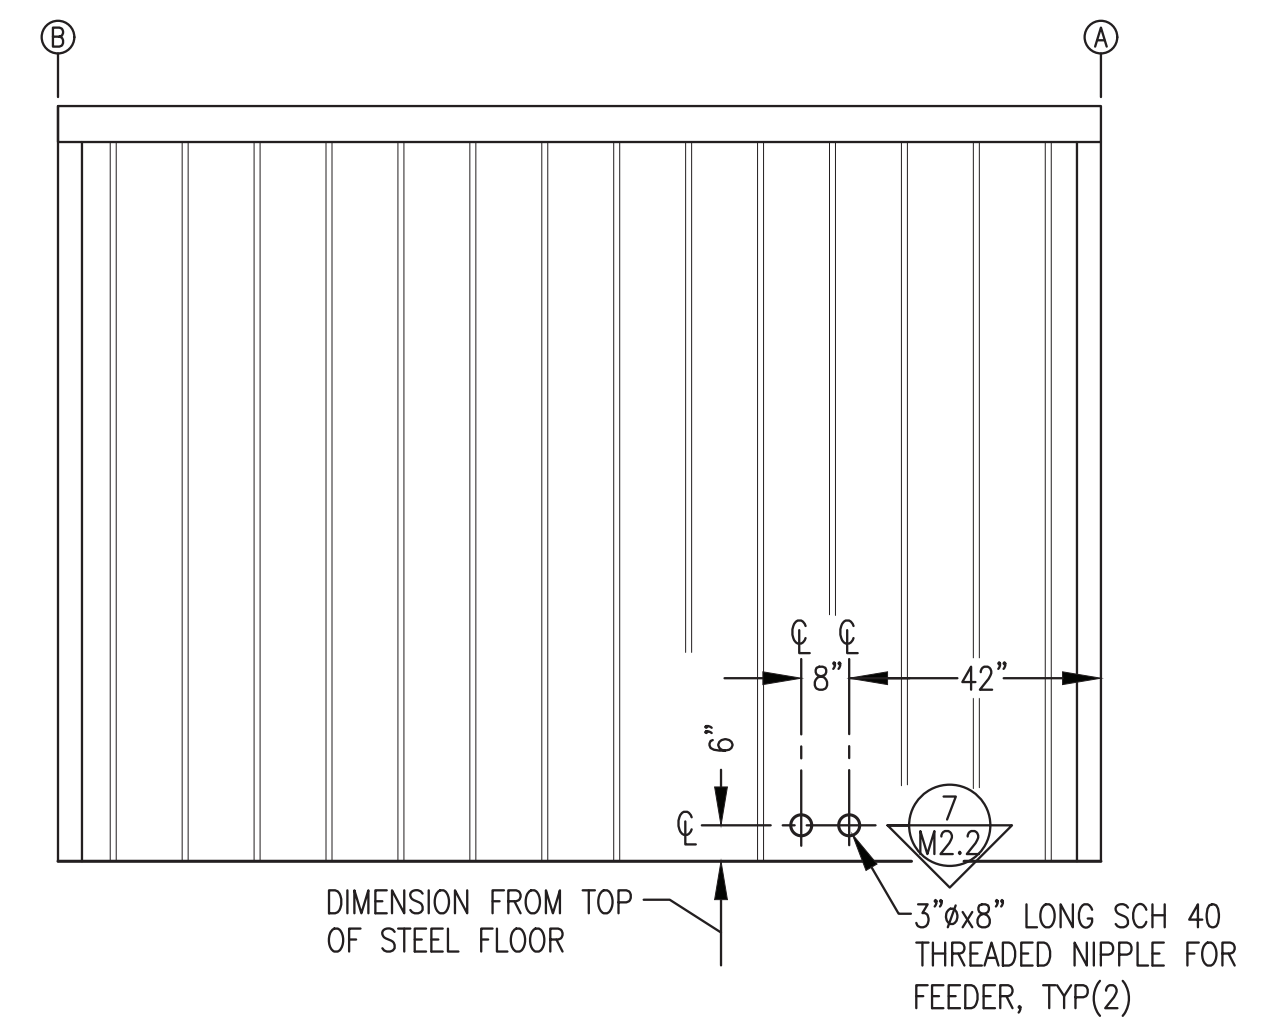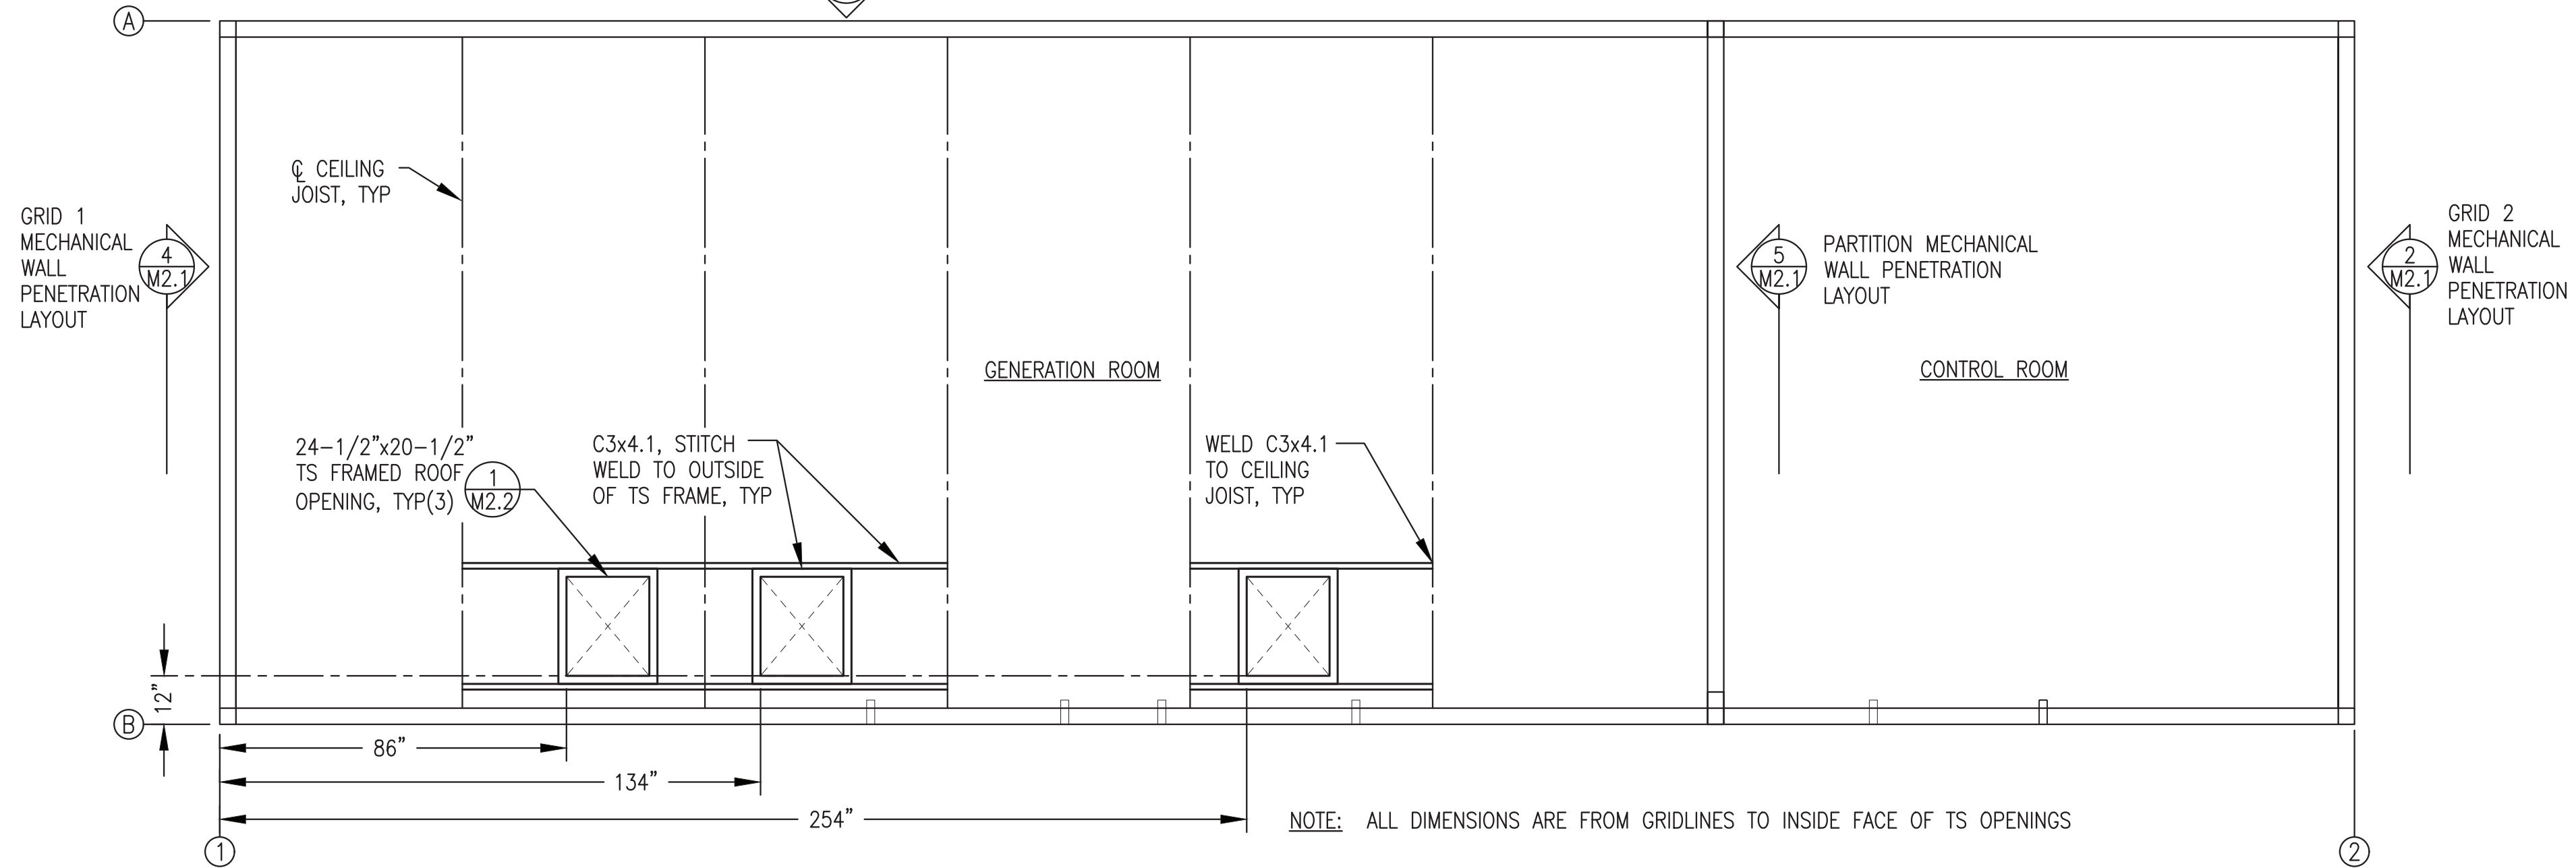


1 MECHANICAL PENETRATION LAYOUT & ROOF PLAN  
M2.1 3/8"=1'-0"

2 GRID 2 MECHANICAL WALL PENETRATION LAYOUT - EXTERIOR ELEVATION  
M2.1 3/8"=1'-0"

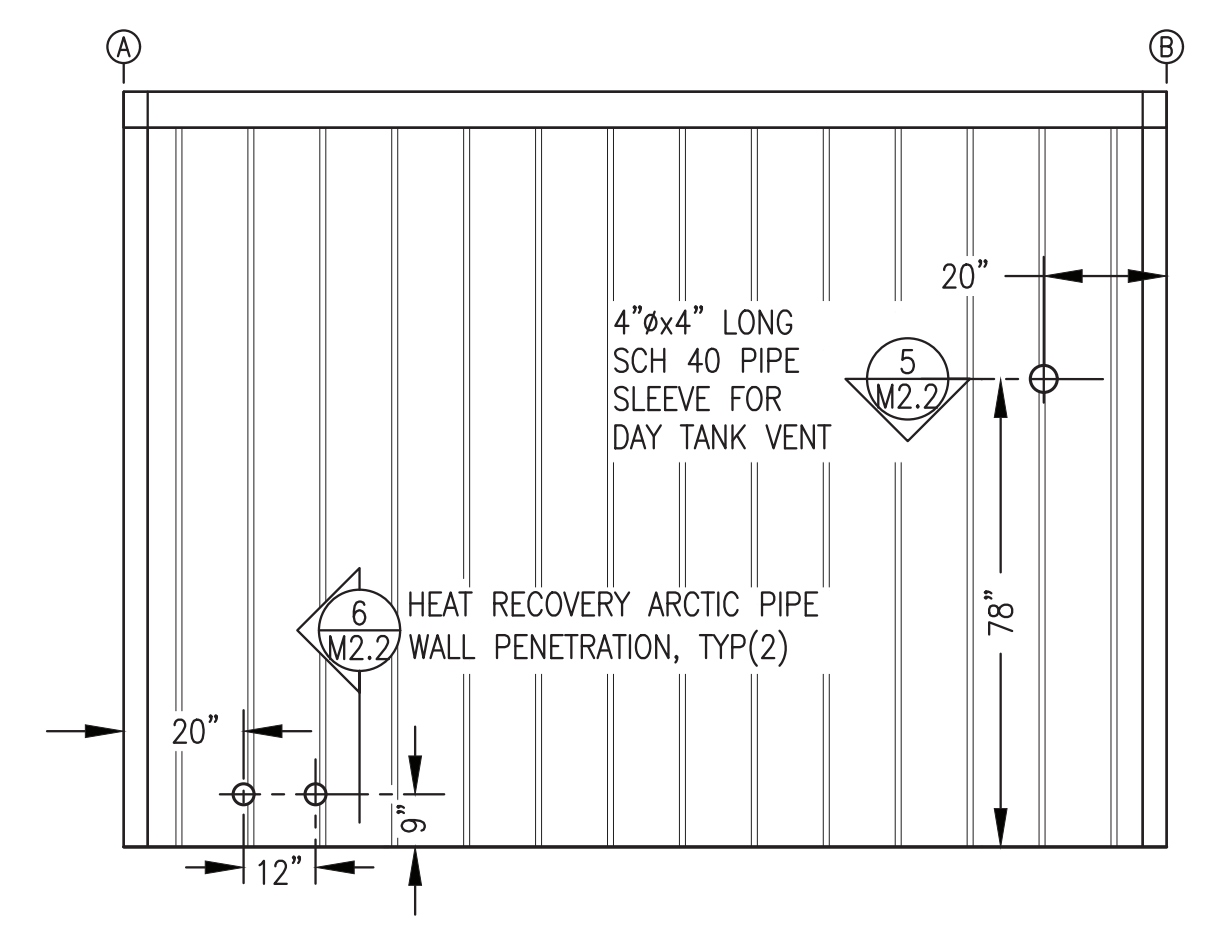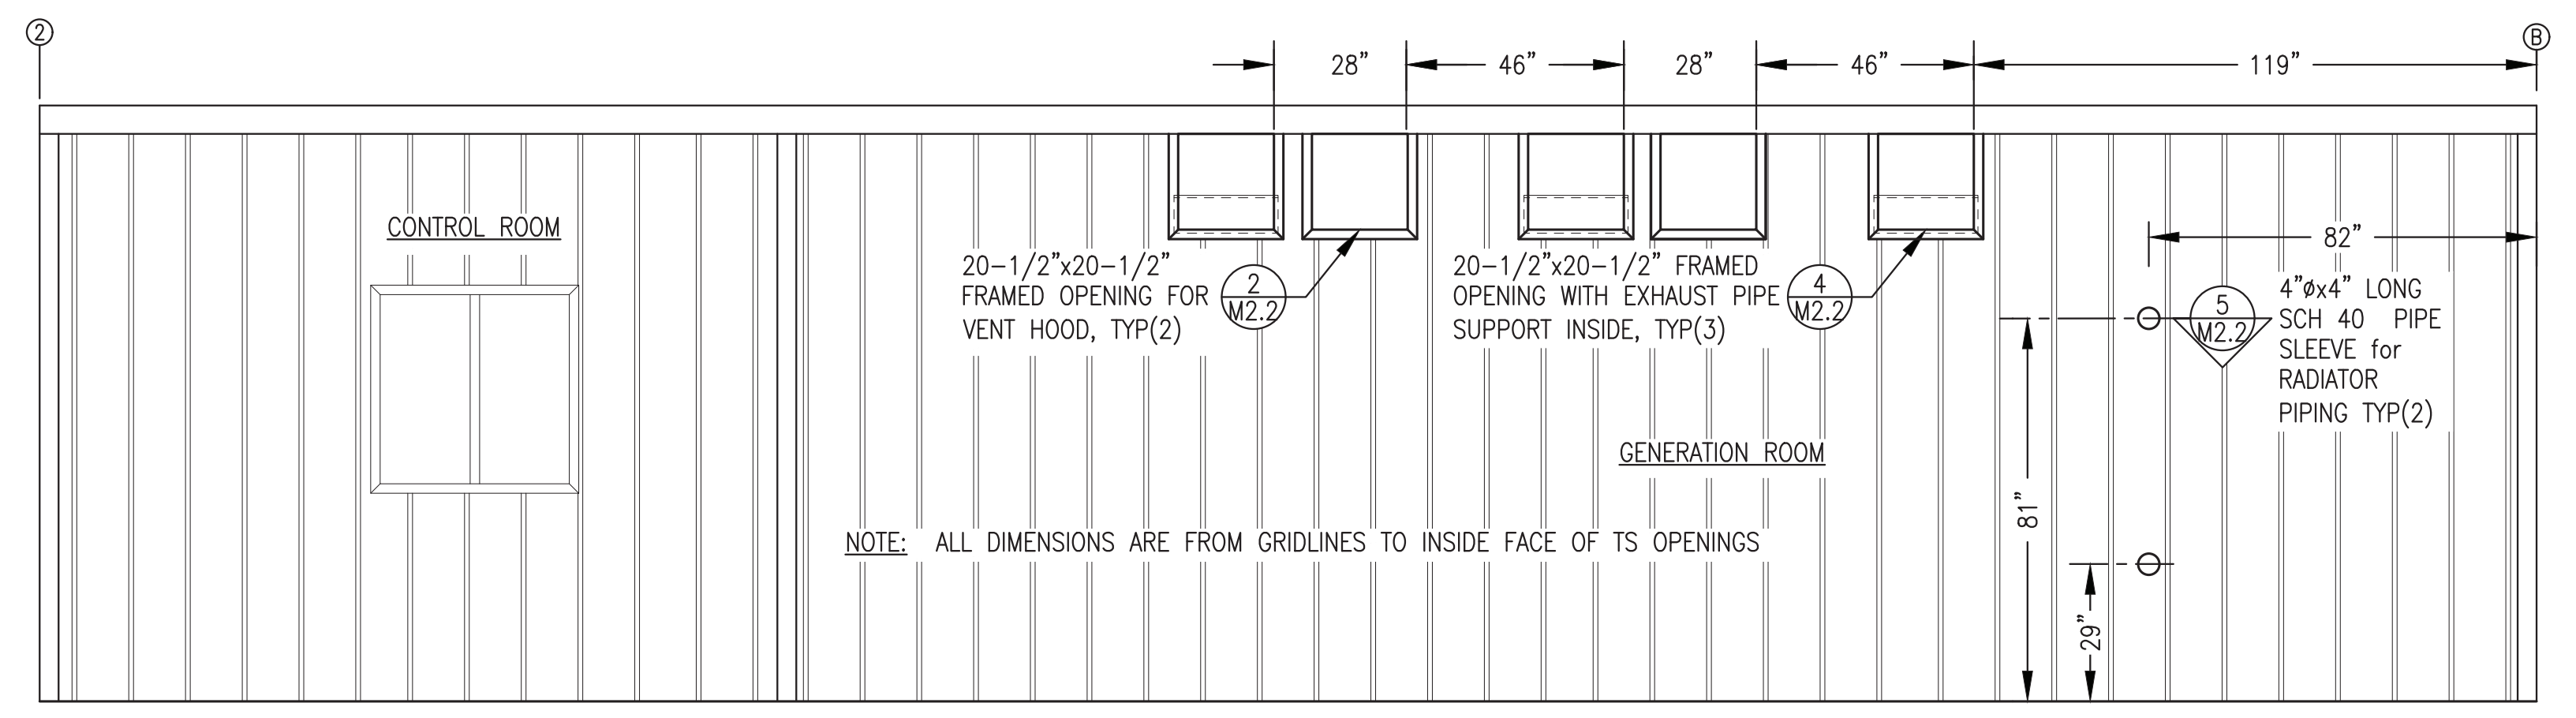

3 GRID A MECHANICAL WALL PENETRATION LAYOUT - EXTERIOR ELEVATION  
M2.1 3/8"=1'-0"

4 GRID 1 MECHANICAL WALL PENETRATION LAYOUT - EXTERIOR ELEVATION  
M2.1 3/8"=1'-0"

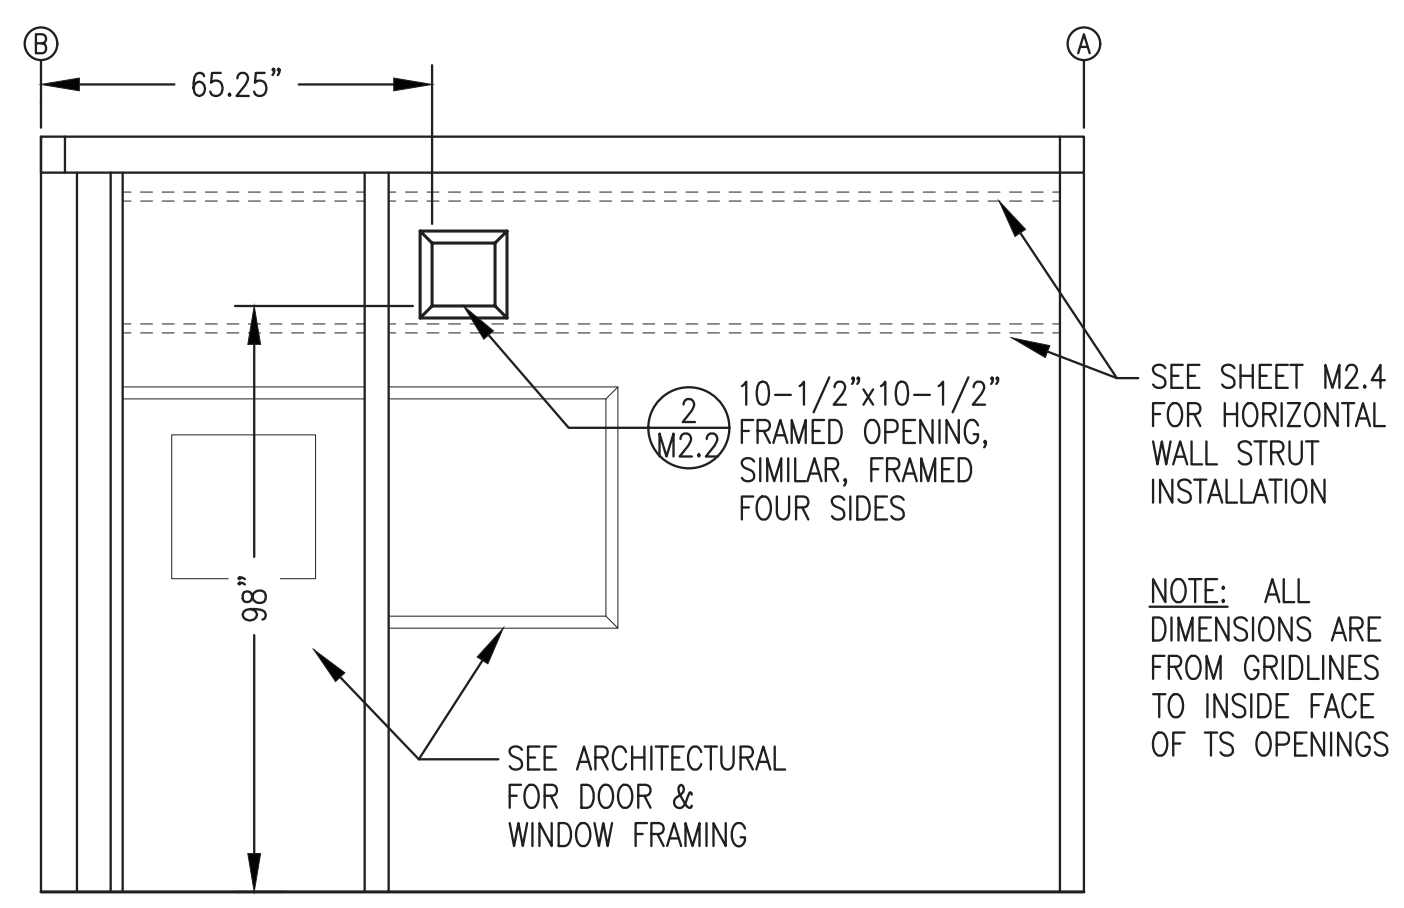


5 PARTITION MECHANICAL WALL PENETRATION LAYOUT - INTERIOR ELEVATION  
M2.1 3/8"=1'-0"

ALL WORK ON THIS SHEET WAS PERFORMED AS PART OF THE PRIOR MODULE ASSEMBLY CONTRACT AND IS SHOWN HERE FOR REFERENCE ONLY.


ISSUED FOR  
MODULE  
FABRICATION  
MARCH 2023




ALASKA ENERGY AUTHORITY		
PROJECT:	NELSON LAGOON POWER SYSTEM UPGRADE	
TITLE:	MECHANICAL PENETRATIONS PLAN, ELEVATIONS & DETAILS	
DRAWN BY: JTD	DESIGNED BY: BCG	SCALE: AS NOTED
FILE NAME: NELS PP M2-M7	PROJECT NUMBER:	SHEET: <b>M2.1</b>
P.O. 111405, Anchorage, AK 99511 (907)349-0100		

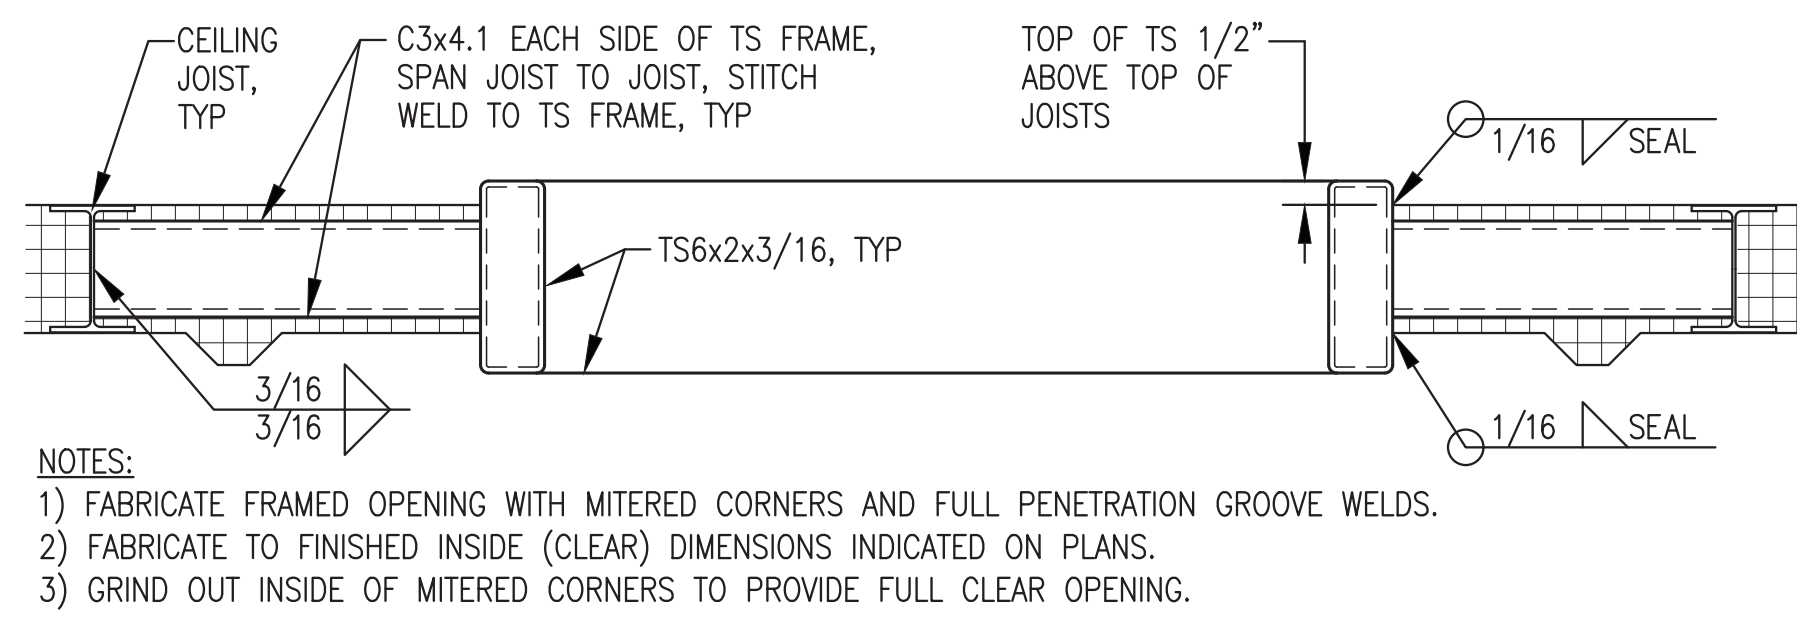


**1** TYPICAL ROOF OPENING DETAIL  
M2.2 2"=1'-0"

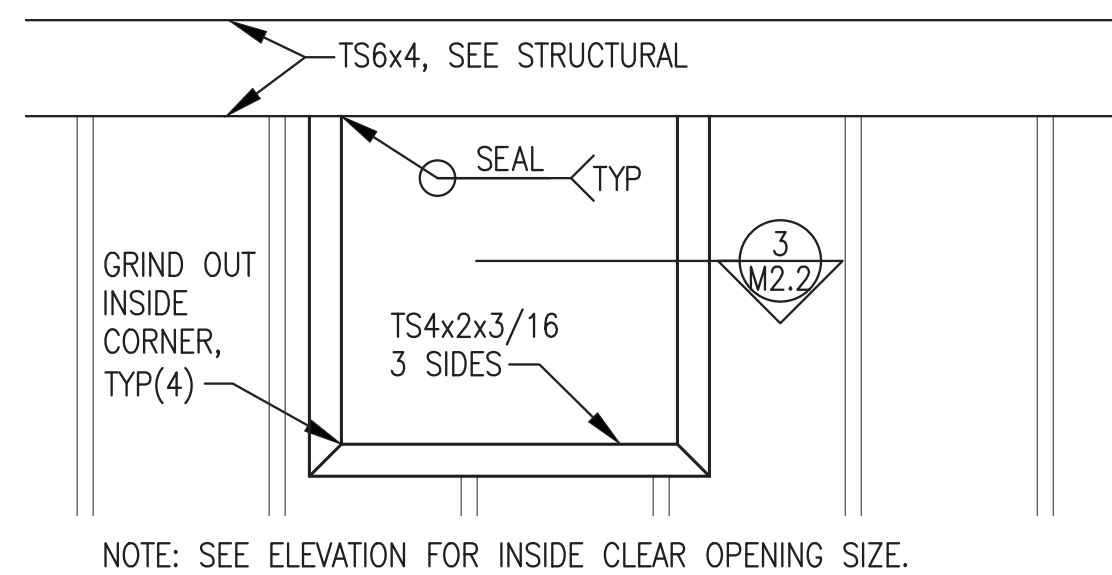


**2** TYPICAL WALL OPENING - ELEVATION  
M2.2 1"=1'-0"

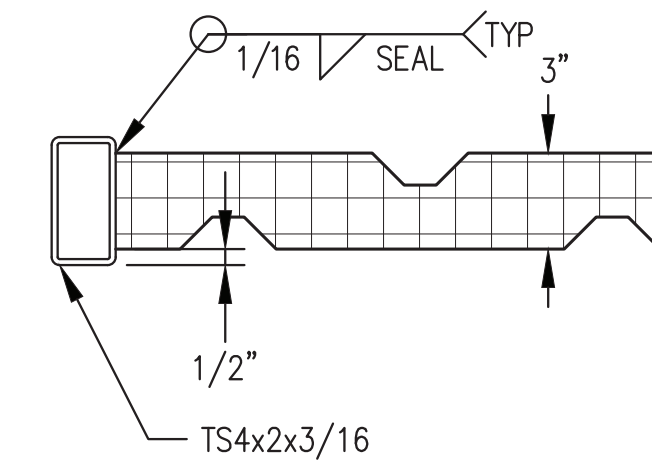


**3** TYPICAL SECTION THROUGH WALL OPENING  
M2.2 2"=1'-0"

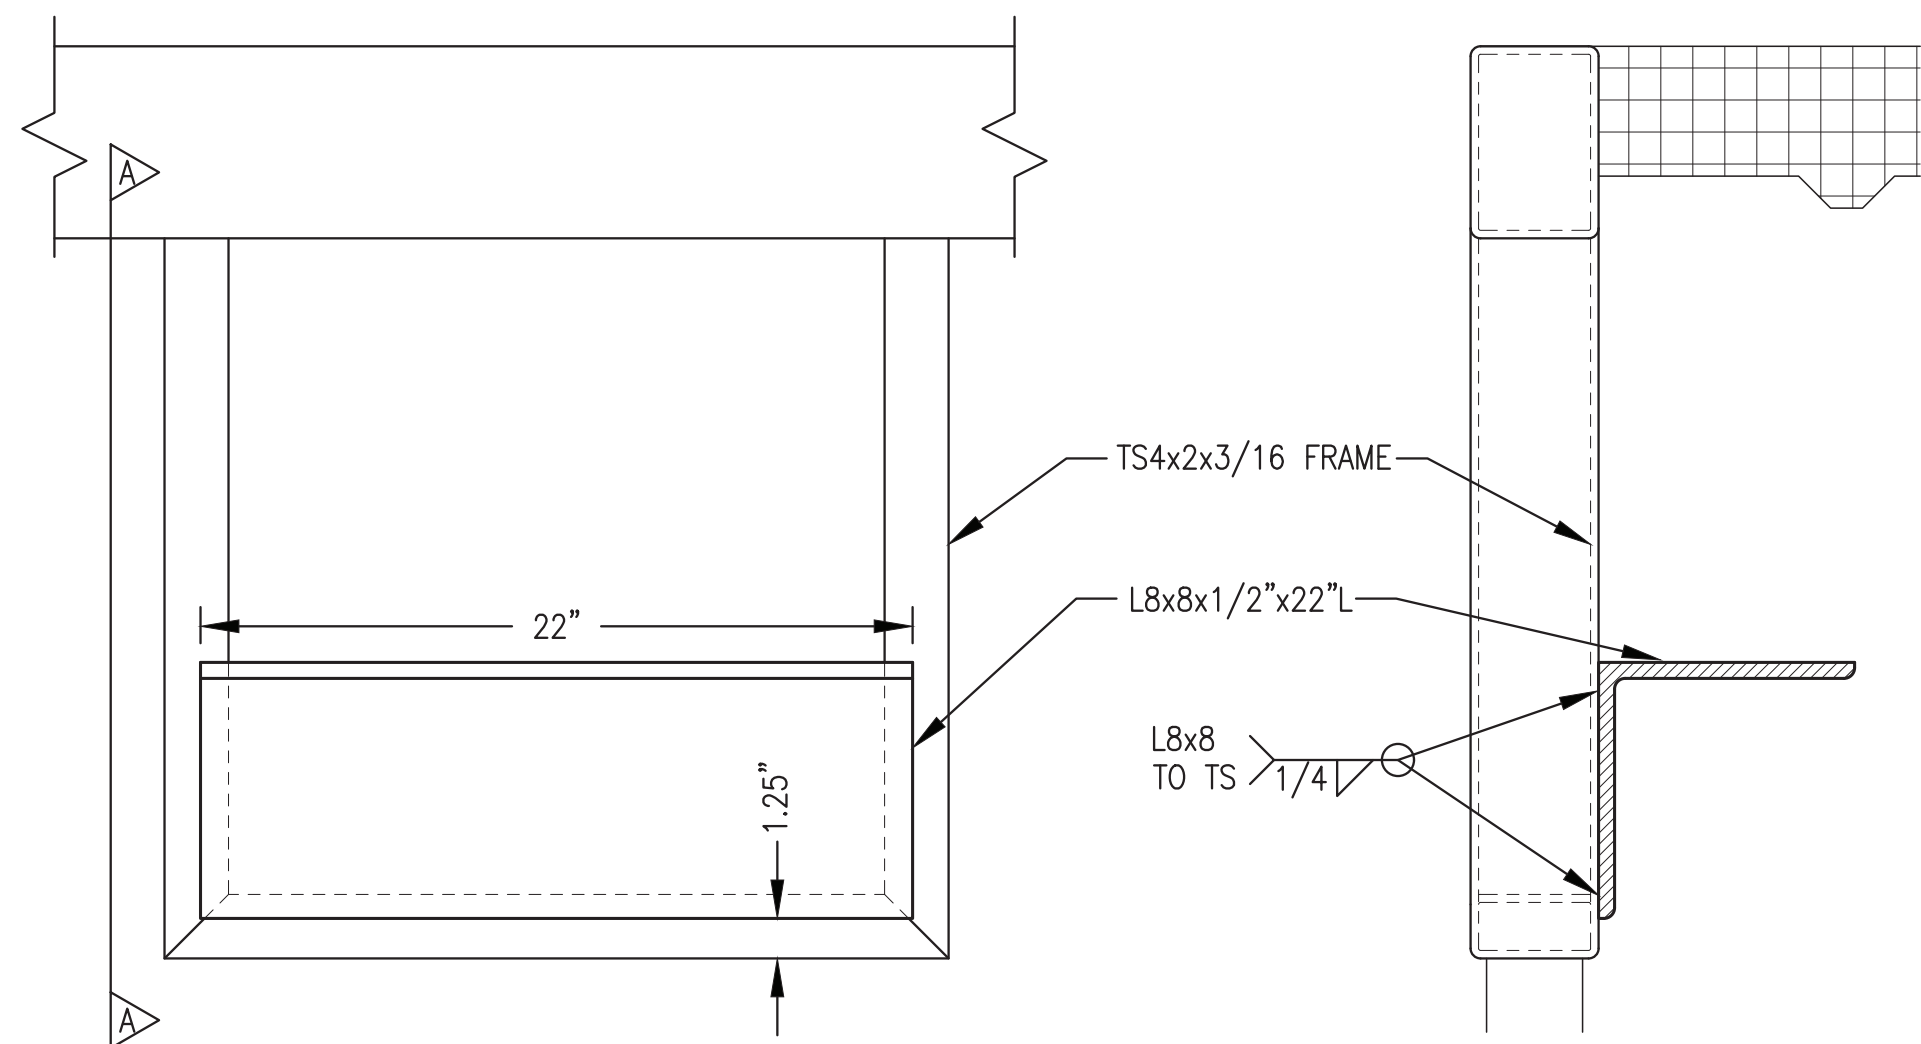


**4** EXHAUST PIPE SUPPORT AT FRAMED OPENING  
M2.2 2"=1'-0"

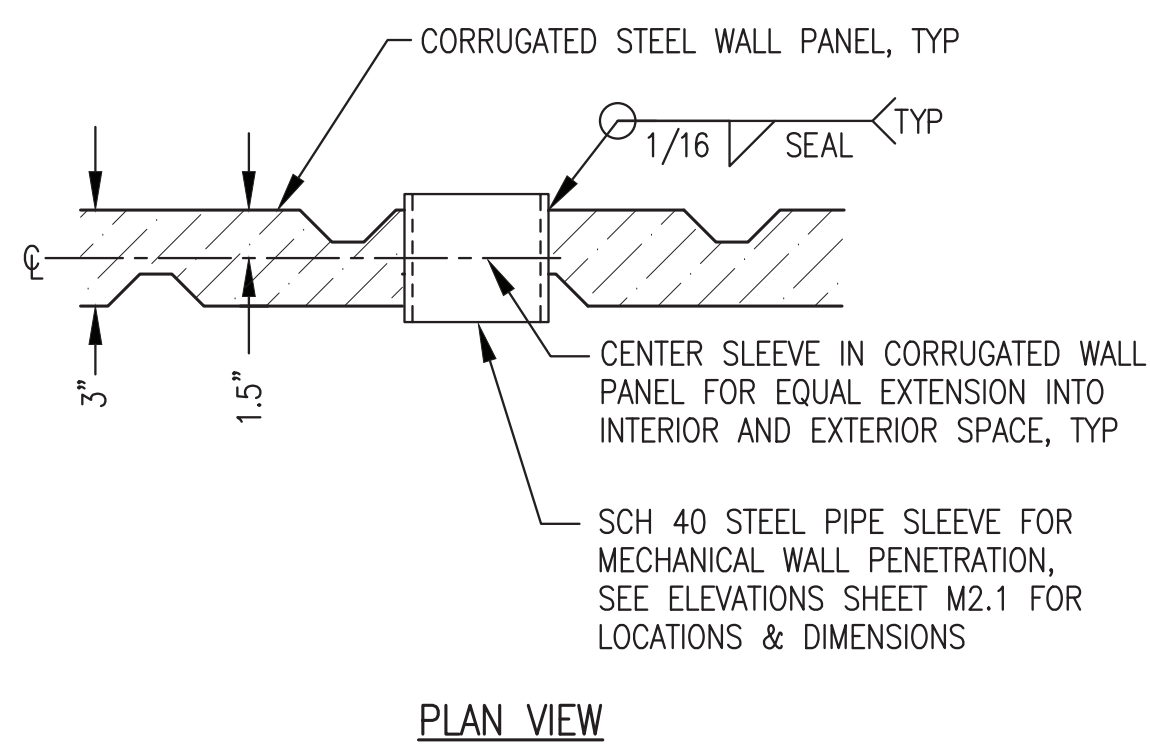

**5** TYPICAL WALL PENETRATION PIPE SLEEVE  
M2.2 2"=1'-0"

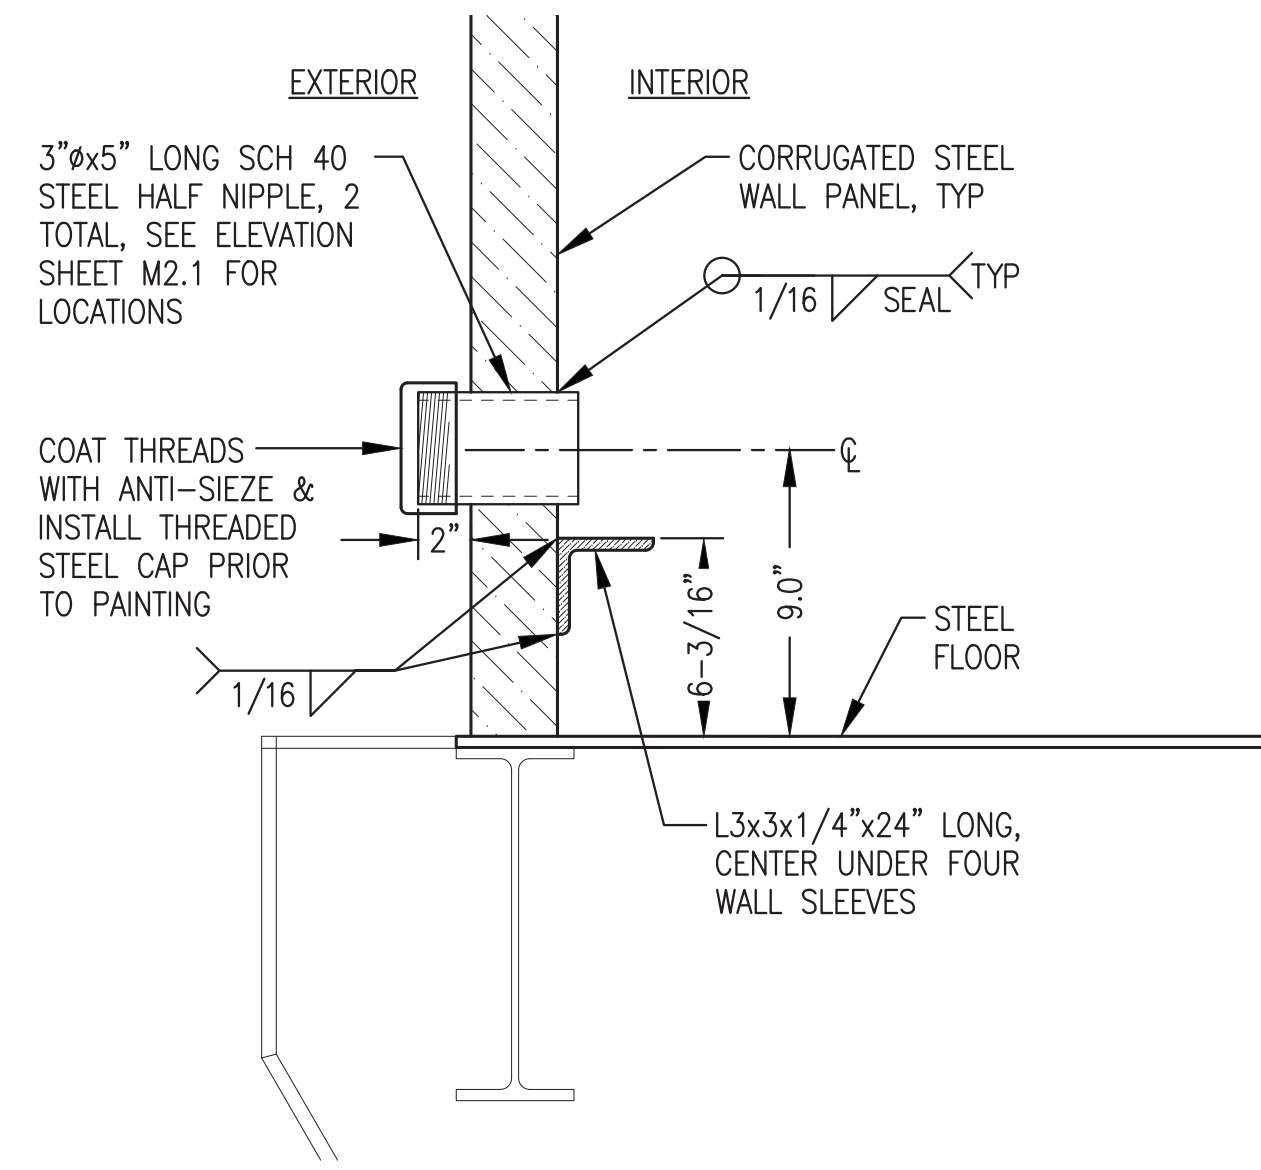


**6** TYPICAL HEAT RECOVERY ARCTIC PIPE WALL PENETRATION  
M2.2 2"=1'-0"

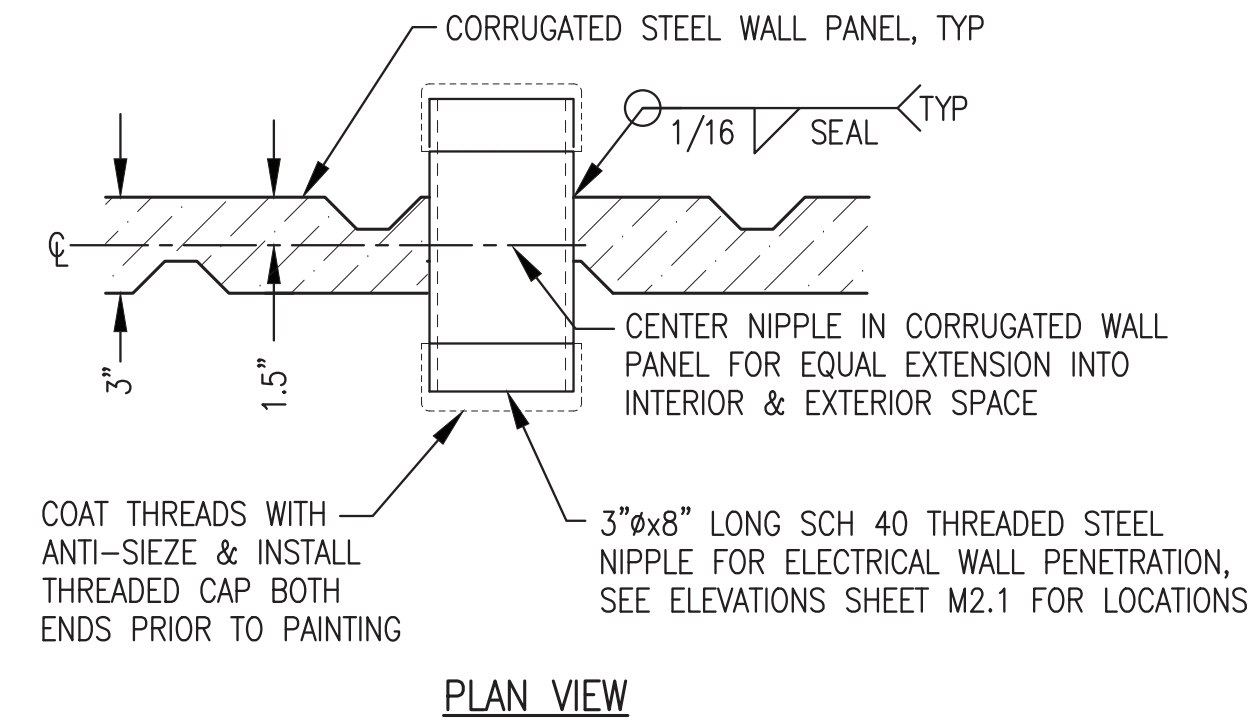


**7** TYPICAL ELECTRIC POWER FEEDER CONDUCTOR WALL PENETRATION  
M2.2 2"=1'-0"

ALL WORK ON THIS SHEET WAS PERFORMED AS PART OF THE PRIOR MODULE FABRICATION CONTRACT AND IS SHOWN HERE FOR REFERENCE ONLY.

ISSUED FOR  
MODULE  
FABRICATION  
MARCH 2023

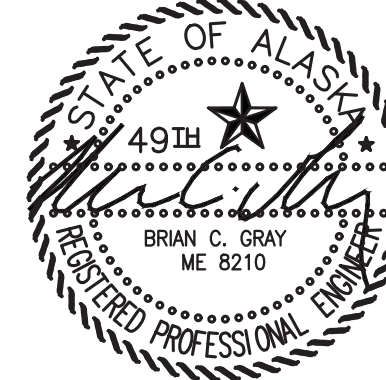


ALASKA ENERGY AUTHORITY		
PROJECT: NELSON LAGOON POWER SYSTEM UPGRADE		
TITLE: MECHANICAL PENETRATION DETAILS		
 Gray Stassel Engineering, Inc. P.O. 111405, Anchorage, AK 99511 (907)349-0100	DRAWN BY: JTD DESIGNED BY: BCG FILE NAME: NELS_PP_M2-M7 PROJECT NUMBER:	SCALE: AS NOTED DATE: 3/30/23 SHEET: M2.2

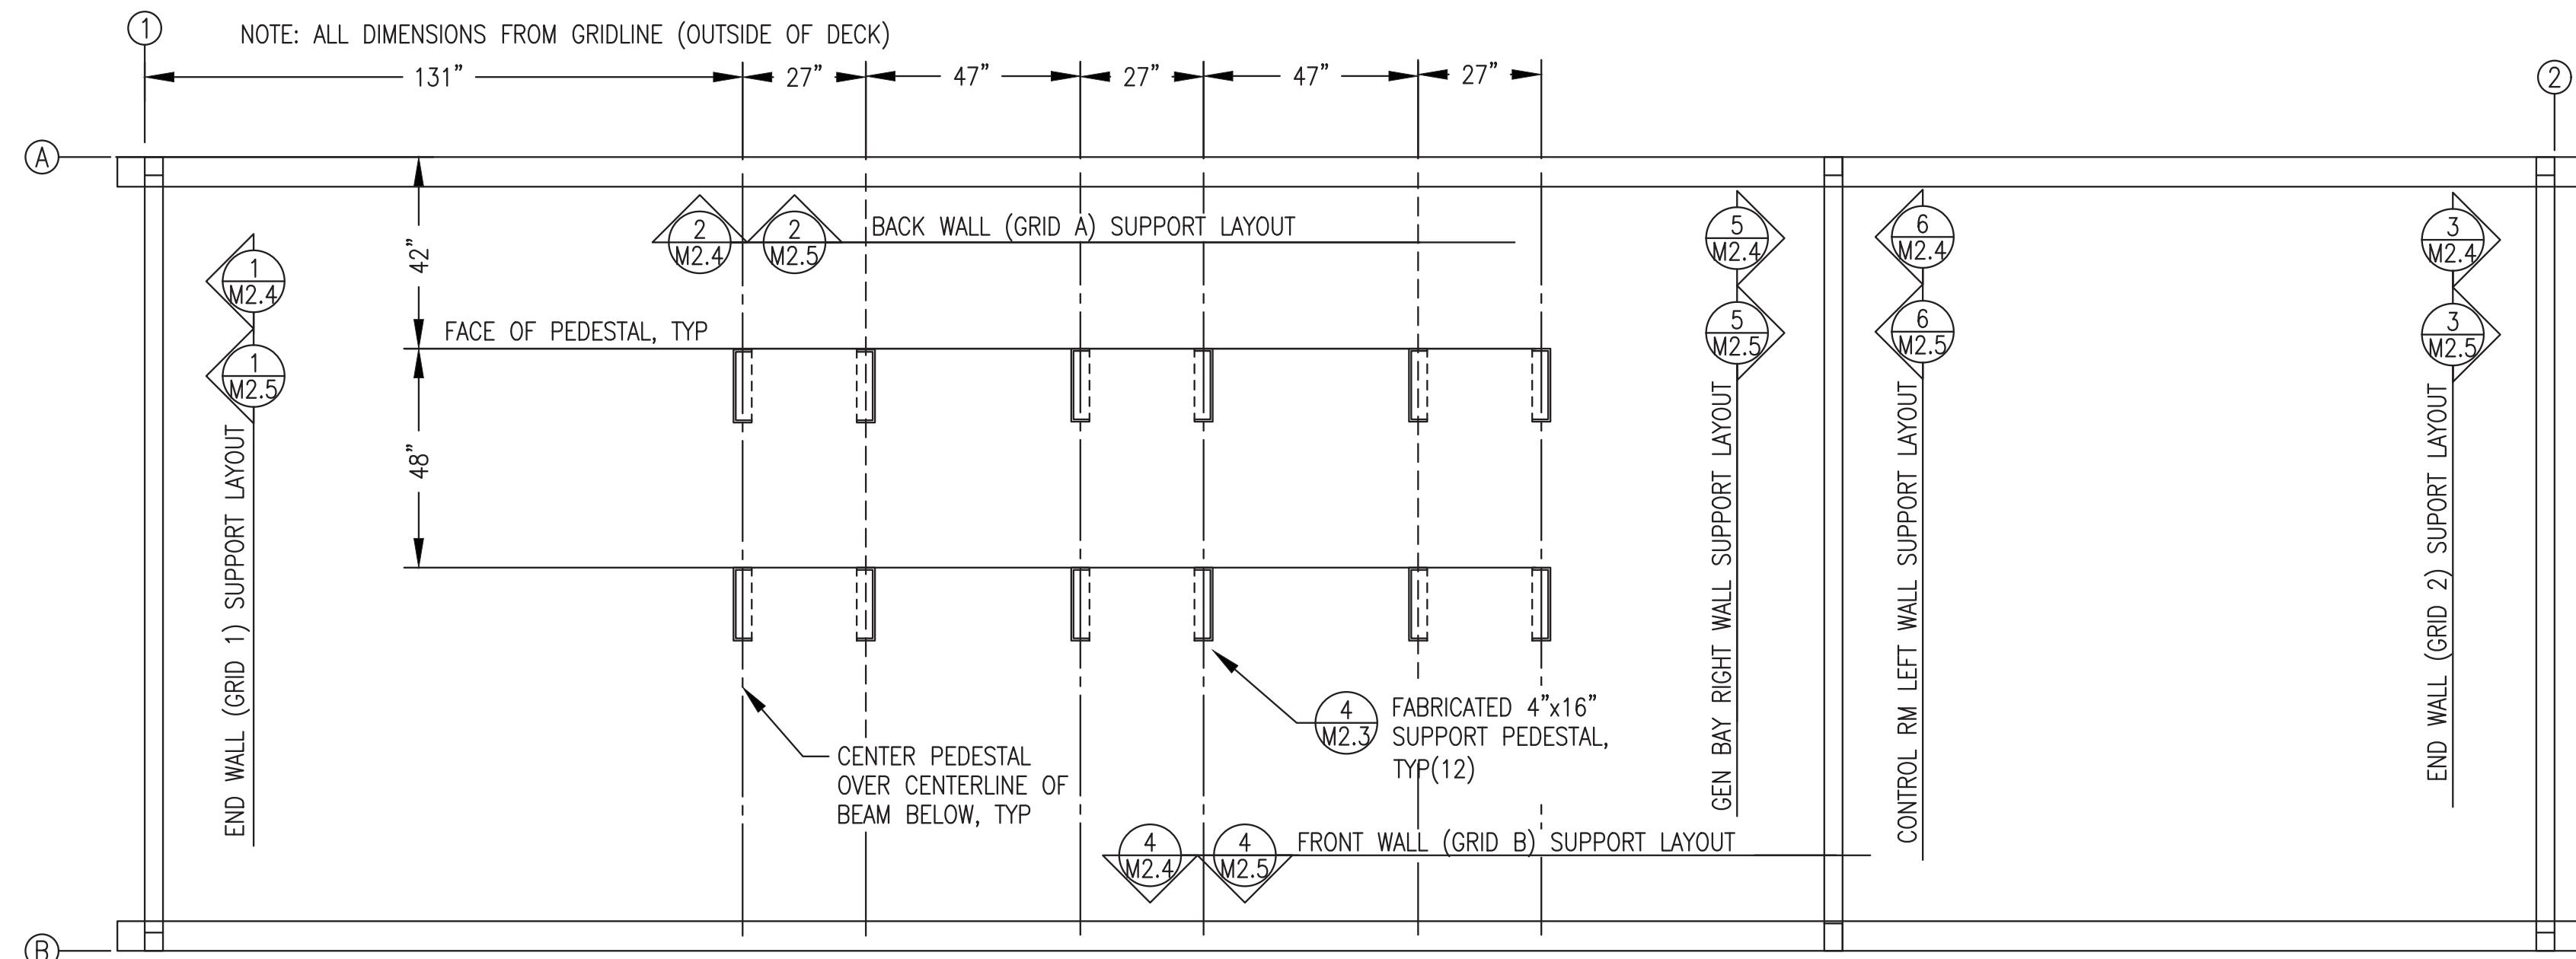


**1** MODULE MECHANICAL SUPPORT PLAN

M2.3 3/8"=1'-0"

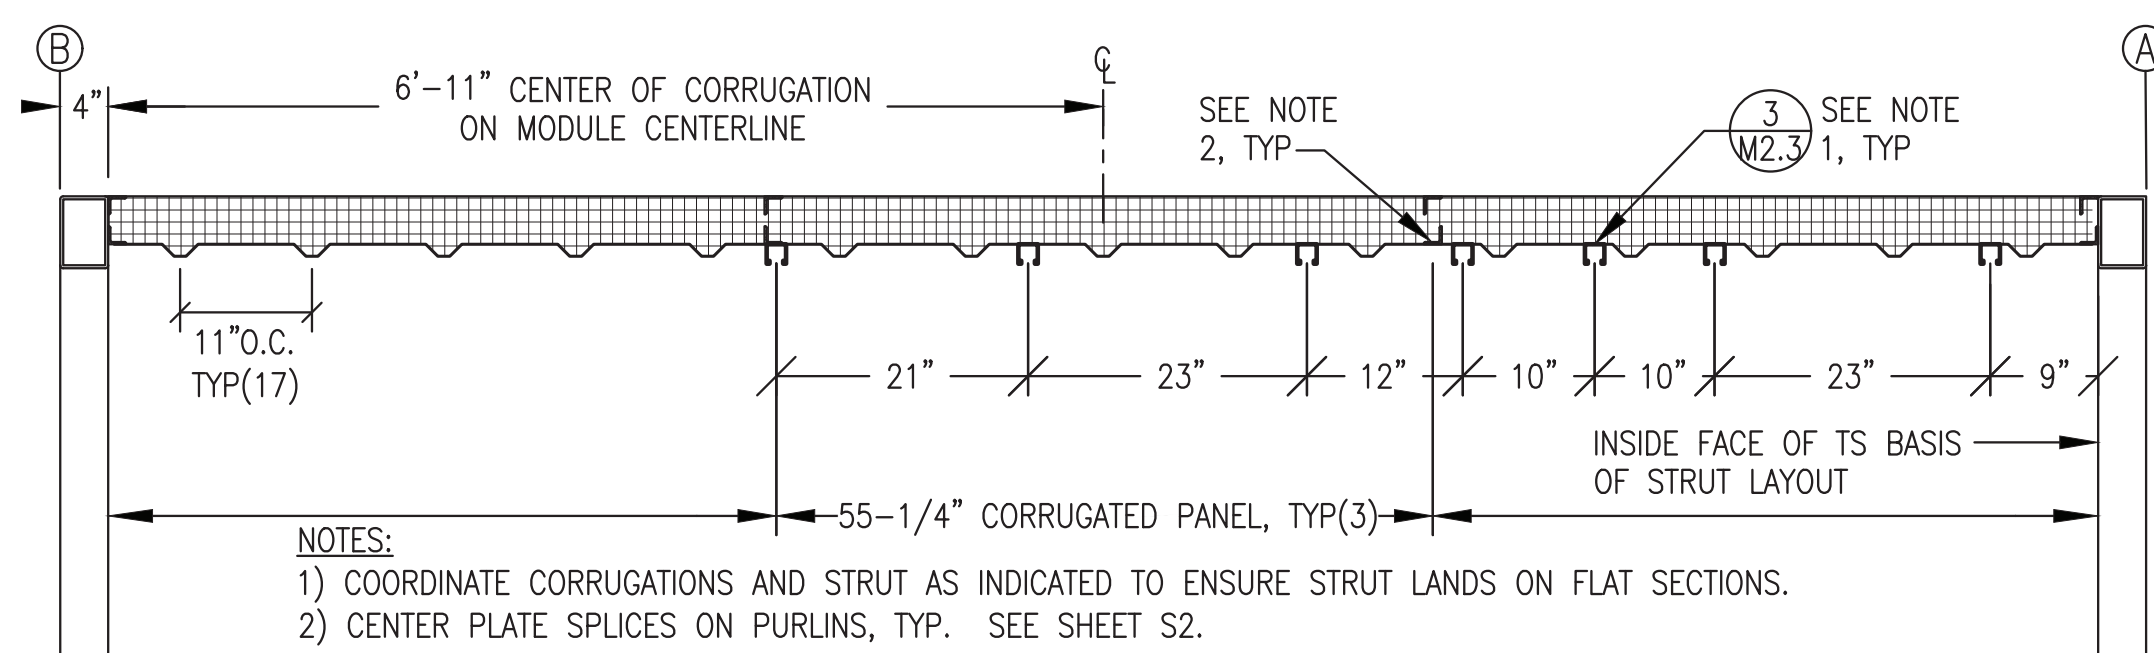

**2** SECTION THROUGH CEILING - CORRUGATION & STRUT LAYOUT

M2.3 3/4"=1'-0"


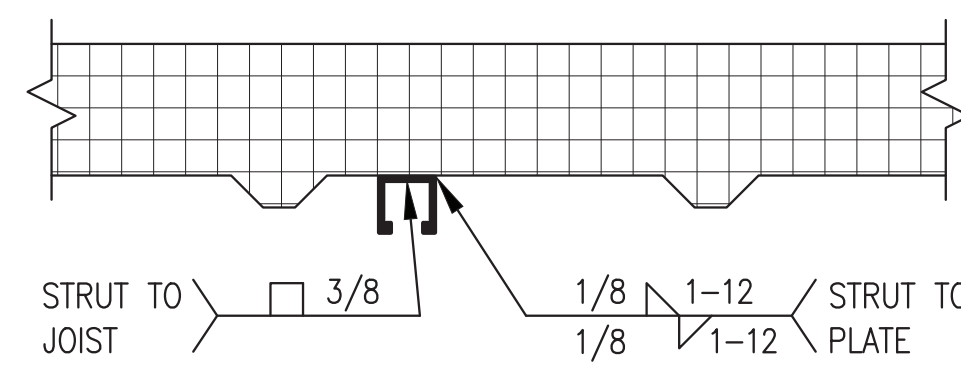


**3** STRUT ATTACHMENT TO CEILING

M2.3 NO SCALE

**GENERAL NOTES:**


- 1) FABRICATE PEDESTALS FROM ASTM A36 ANGLE AND PLATES AS SHOWN.
- 2) ALL STRUT 12 GAUGE 1-5/8"x1-5/8" SOLID BACK PLAIN (UNFINISHED). B-LINE B22-PLN OR EQUAL. PURCHASE IN 20' LENGTHS TO MINIMIZE SPLICES.
- 3) INSTALL ALL SUPPORTS INDICATED AND GRIND SMOOTH PRIOR TO SANDBLASTING MODULE. SANDBLAST AND PAINT ALL SUPPORTS THIS SHEET EQUIVALENT TO MODULE INTERIOR. SEE SHEET A1 FOR PAINTING SPECIFICATIONS.

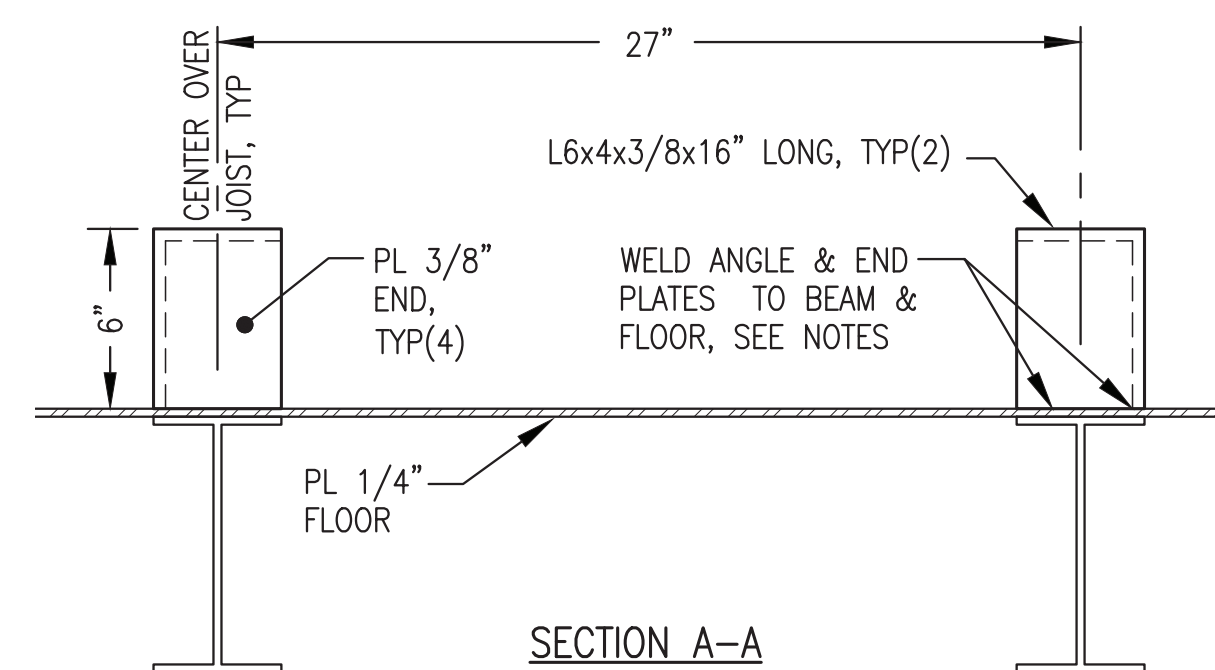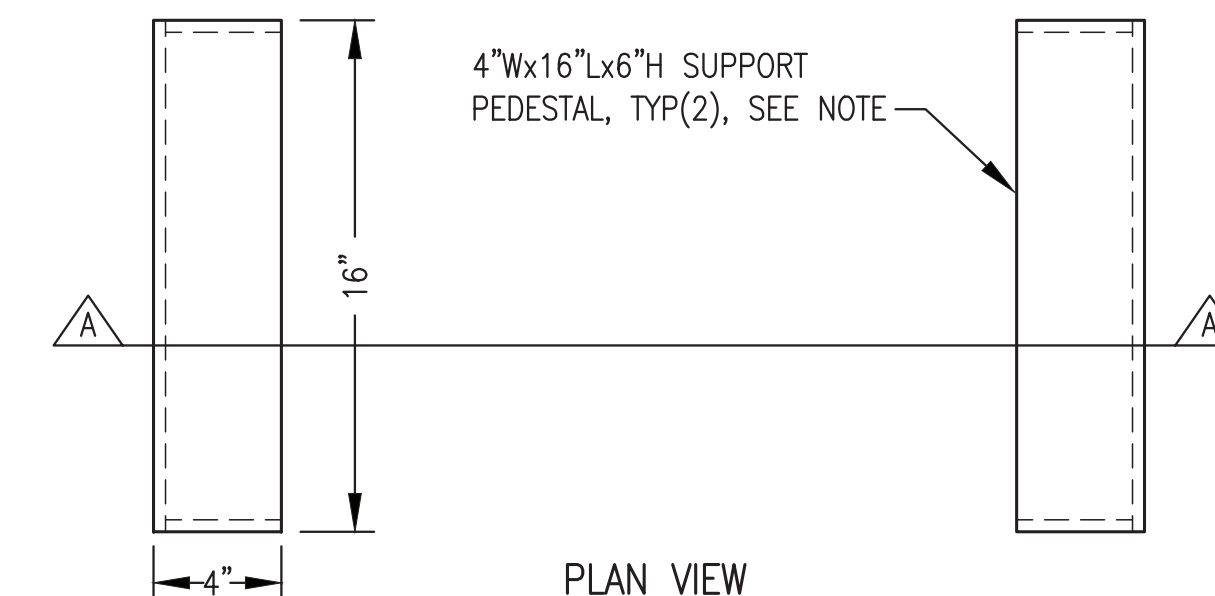

- NOTES: 1) MAKE ALL JOINTS WITH CONTINUOUS GROOVE OR FILLET WELDS.  
 2) SLOT FLOOR PLATE 3 SIDES, WELD PEDESTAL TO TOP OF BEAM, THEN SEAL WELD TO FLOOR PLATE ALL AROUND INSIDE & OUT.


**4** SUPPORT PEDESTAL FABRICATION

M2.3 2"=1'-0"

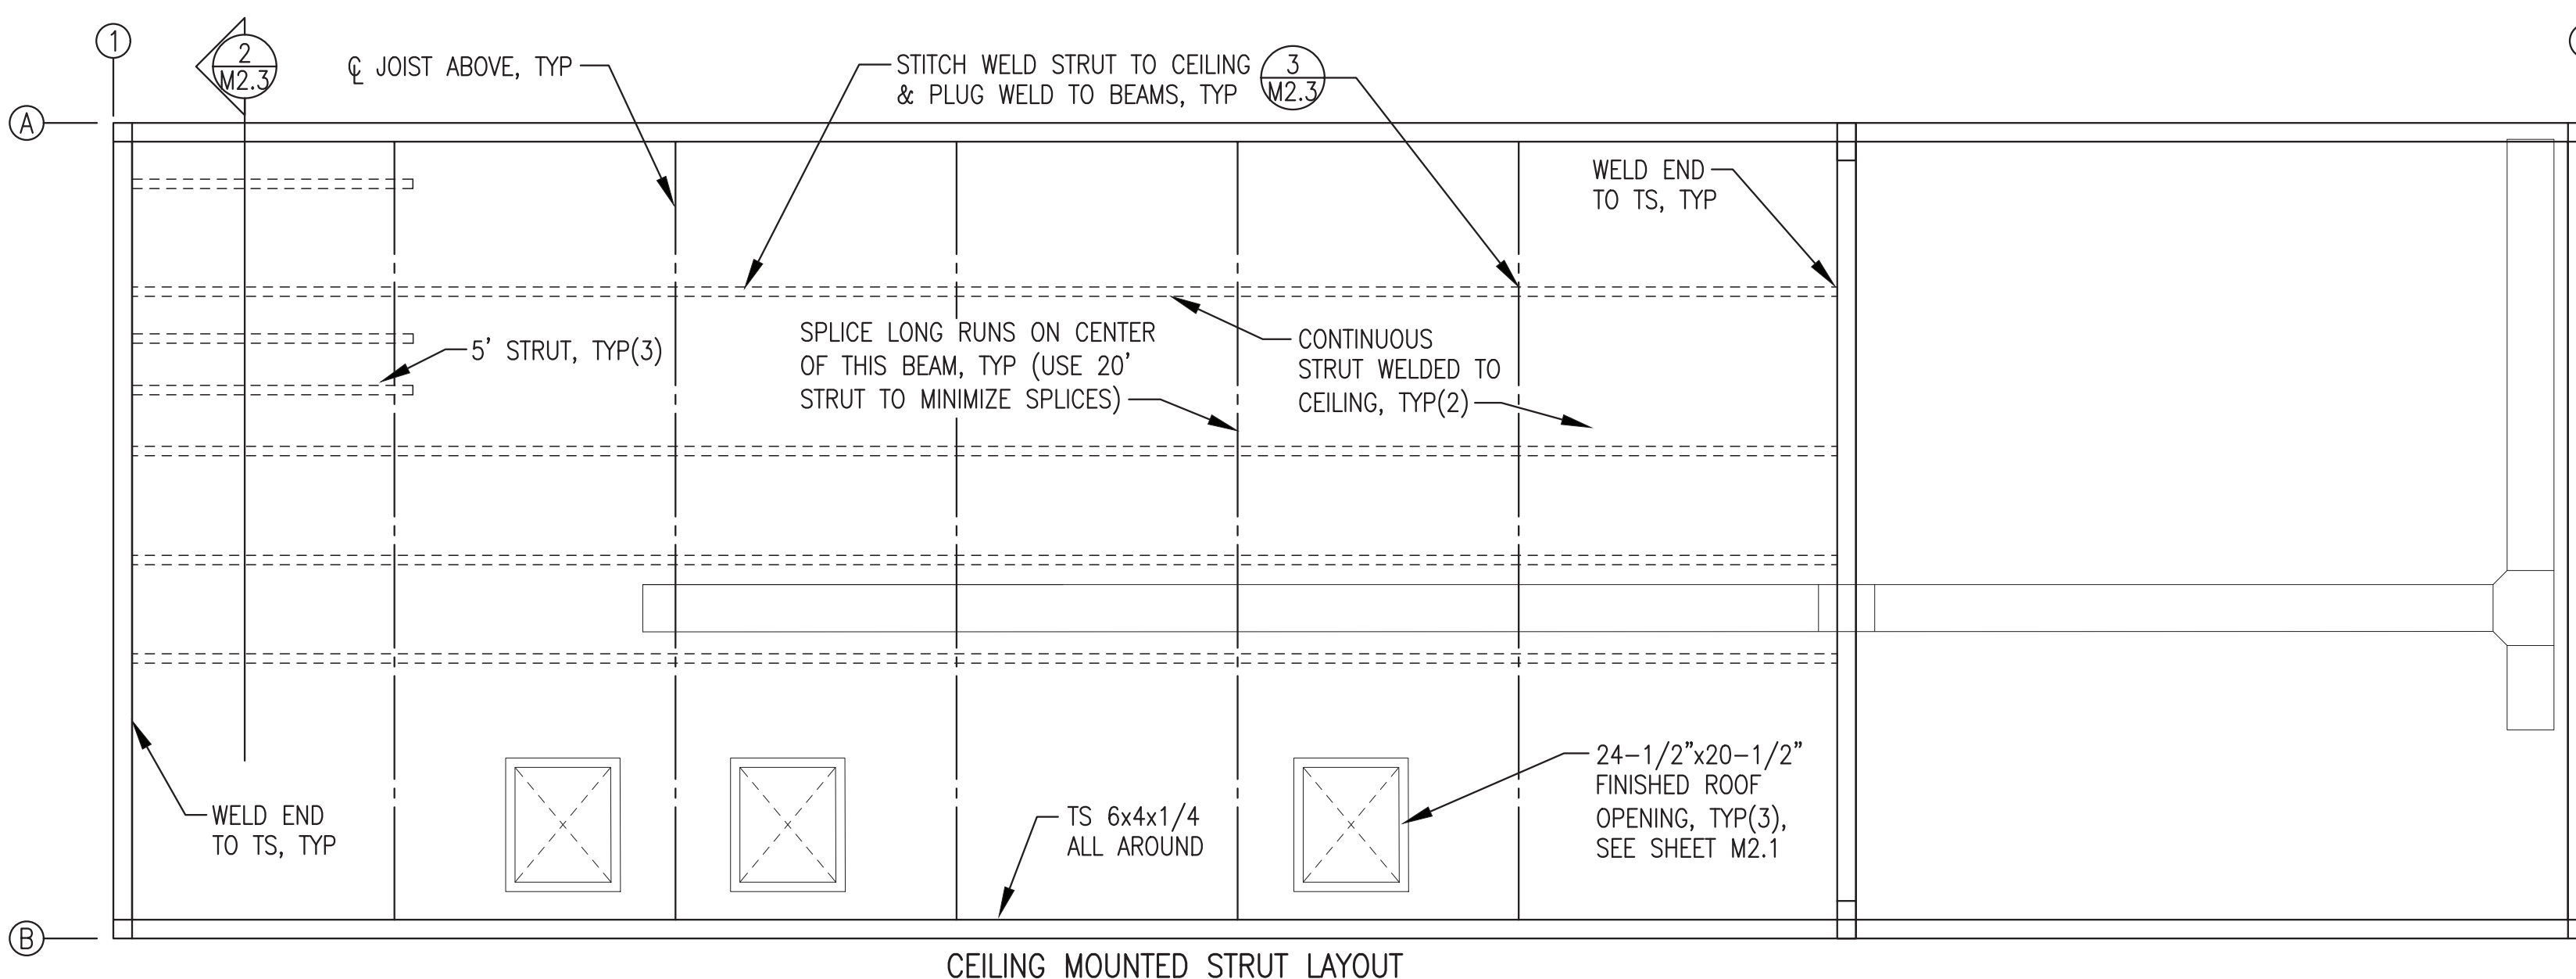


**5** CEILING STRUT SUPPORT LAYOUT PLAN

M2.3 3/8"=1'-0"

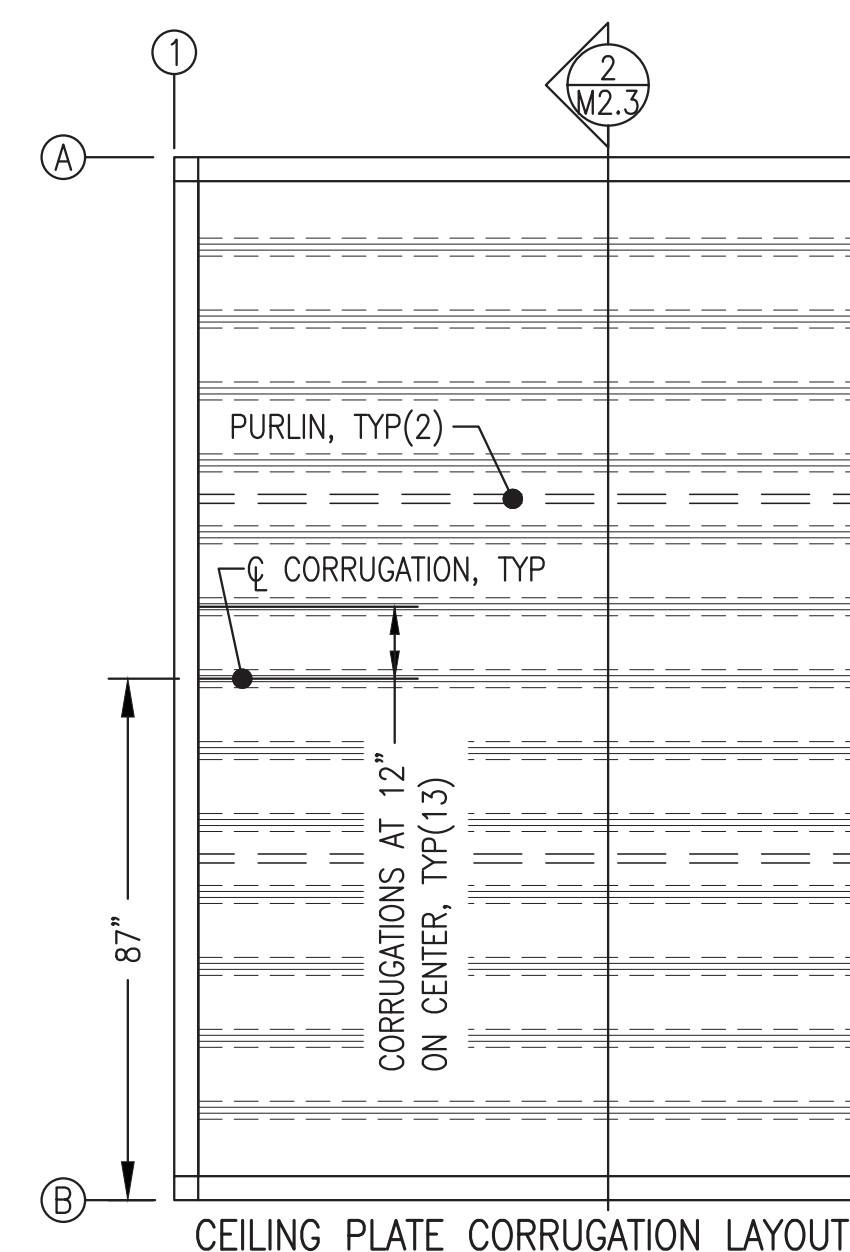


ALL WORK ON THIS SHEET WAS PERFORMED AS PART OF THE PRIOR MODULE FABRICATION CONTRACT AND IS SHOWN HERE FOR REFERENCE ONLY.


ISSUED FOR  
MODULE  
FABRICATION  
MARCH 2023

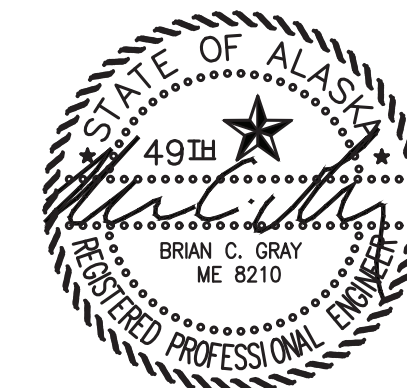


PROJECT: NELSON LAGOON POWER SYSTEM UPGRADE	
TITLE: MECHANICAL SUPPORT PLANS & DETAILS	
DRAWN BY: JTD	SCALE: AS NOTED
DESIGNED BY: BCG	DATE: 3/30/23
FILE NAME: NELS PP M2-M7	SHEET: M2.3
PROJECT NUMBER: P.O. 111405, Anchorage, AK 99511 (907)349-0100	

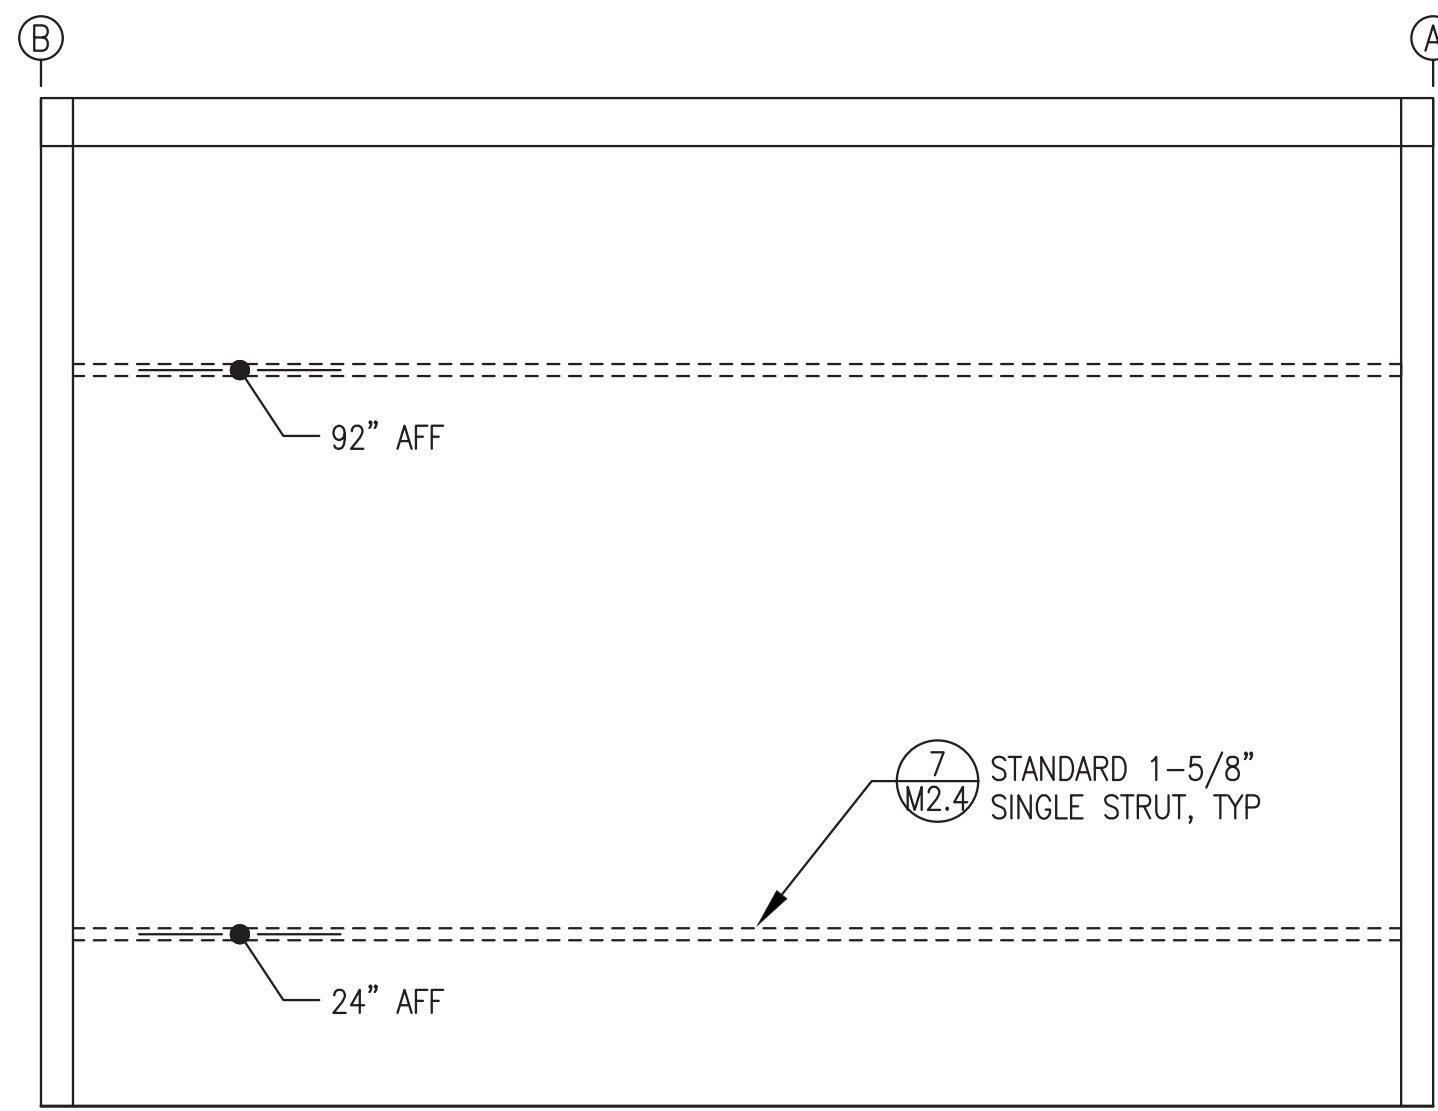


**1** END WALL (GRID 1) HORIZONTAL WALL STRUT LAYOUT  
**M2.4** 1/2"=1'-0"

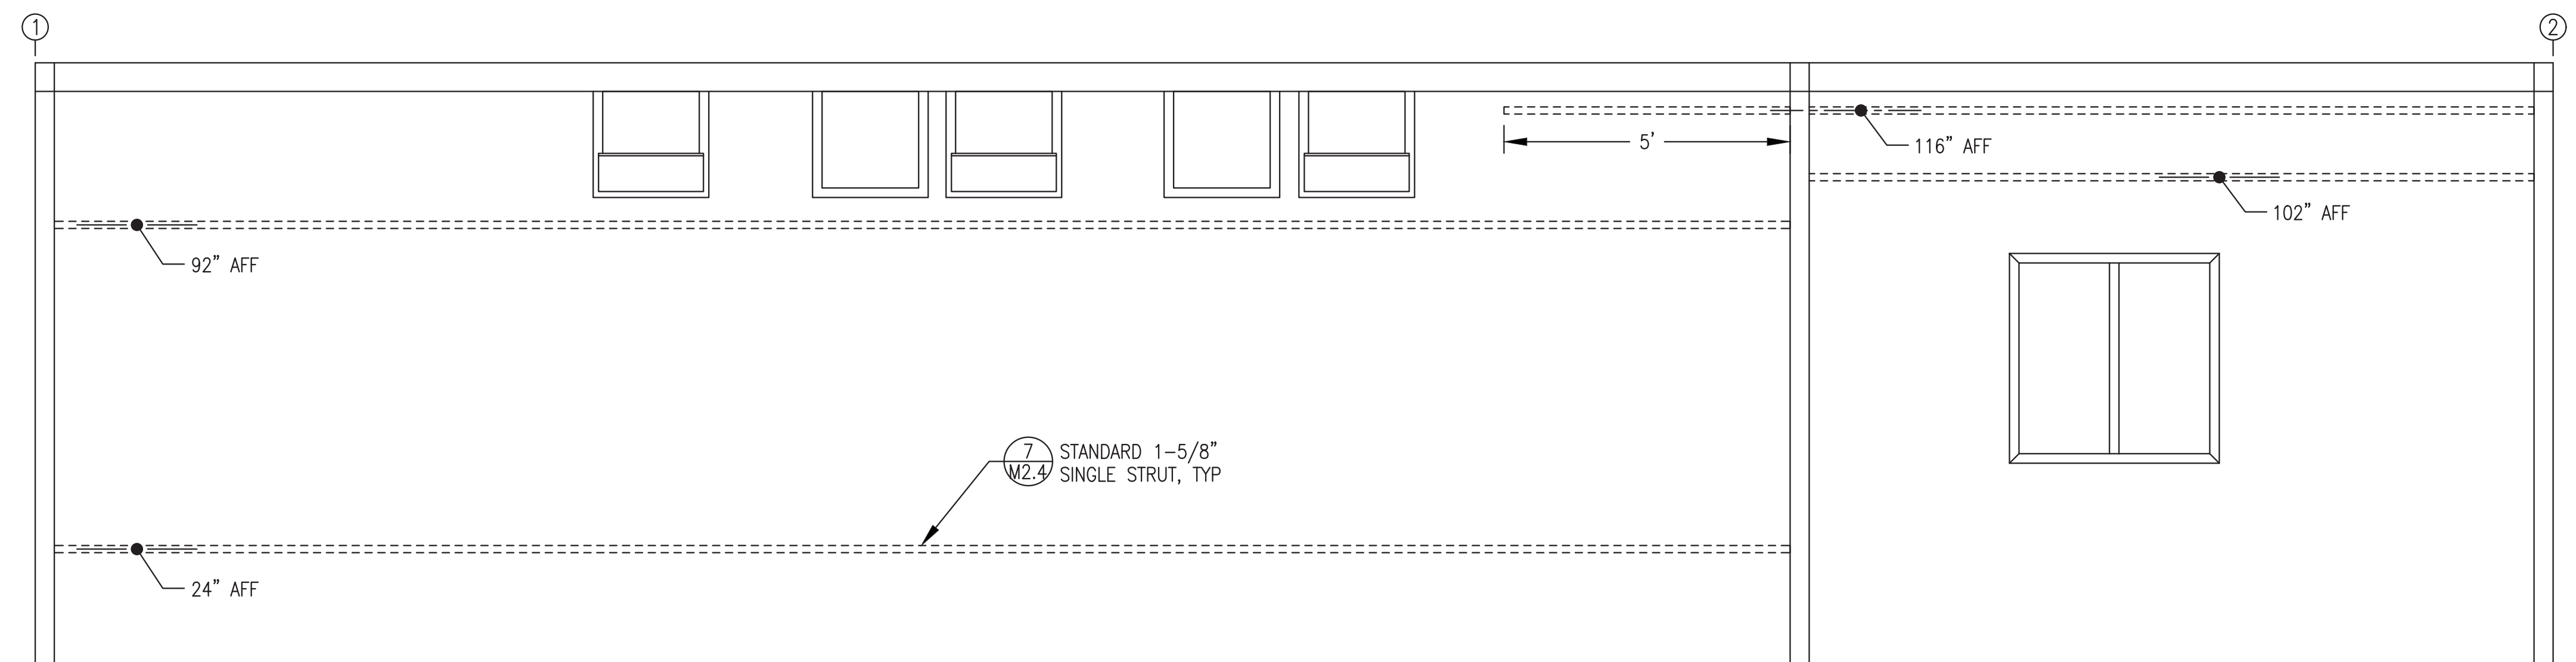


**2** BACK WALL (GRID A) HORIZONTAL WALL STRUT LAYOUT  
**M2.4** 1/2"=1'-0"

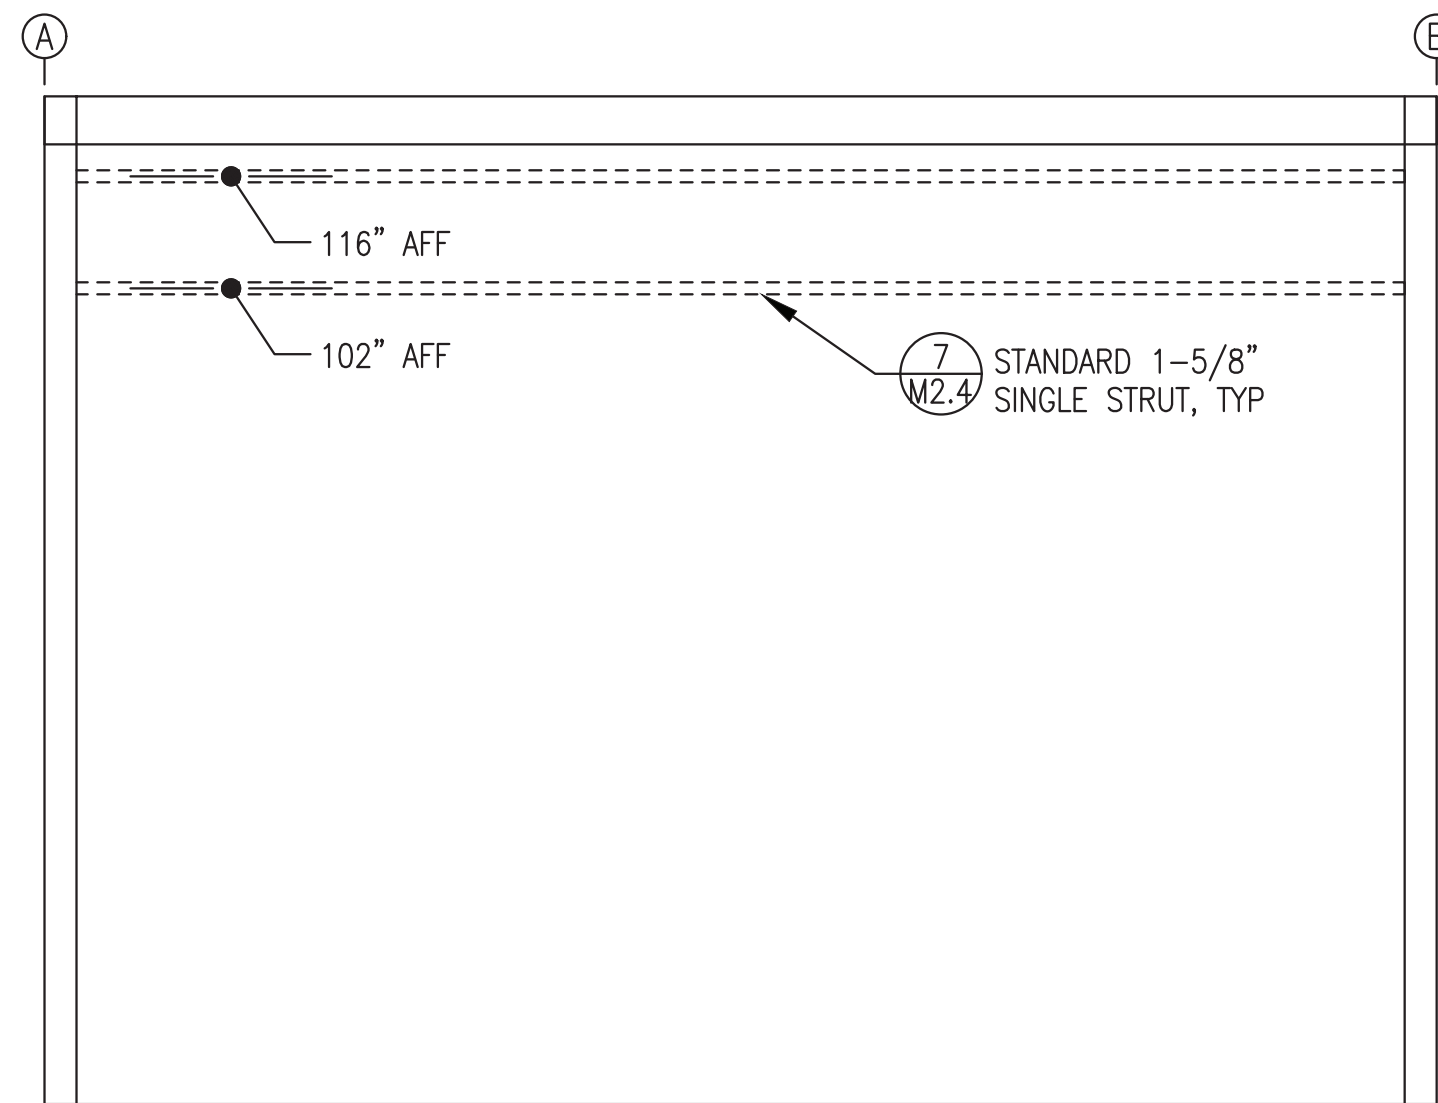


**3** END WALL (GRID 2) HORIZONTAL WALL STRUT LAYOUT  
**M2.4** 1/2"=1'-0"

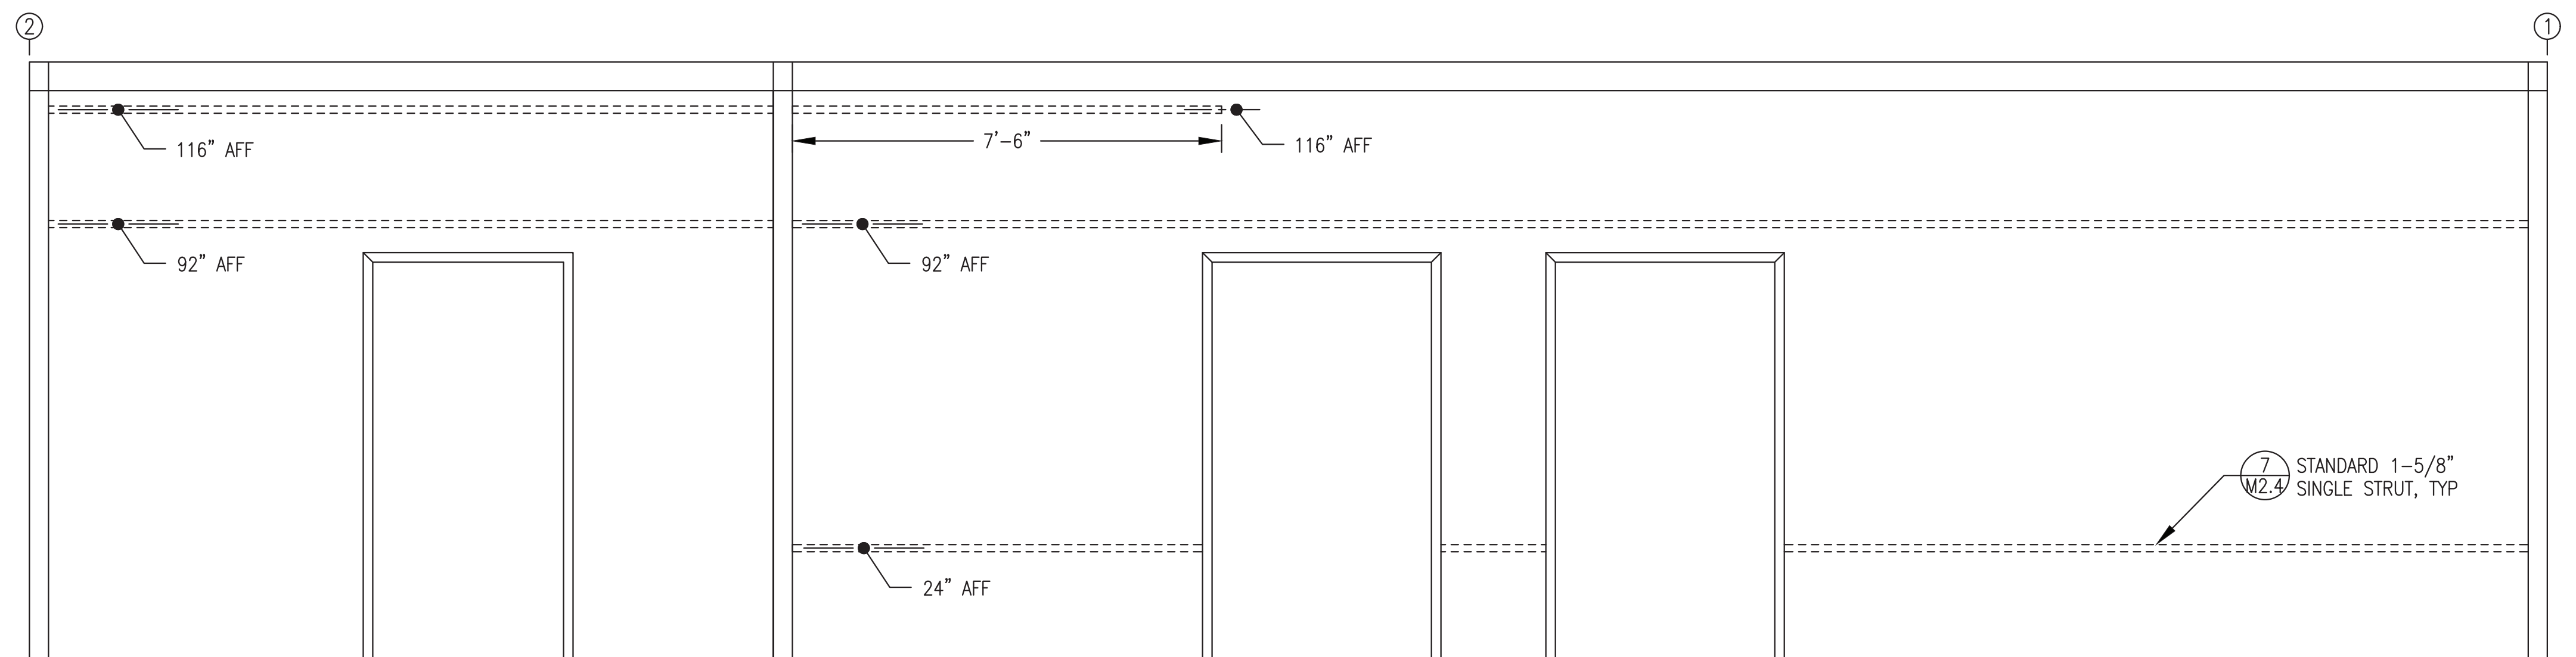

**4** FRONT WALL (GRID B) HORIZONTAL WALL STRUT LAYOUT  
**M2.4** 1/2"=1'-0"

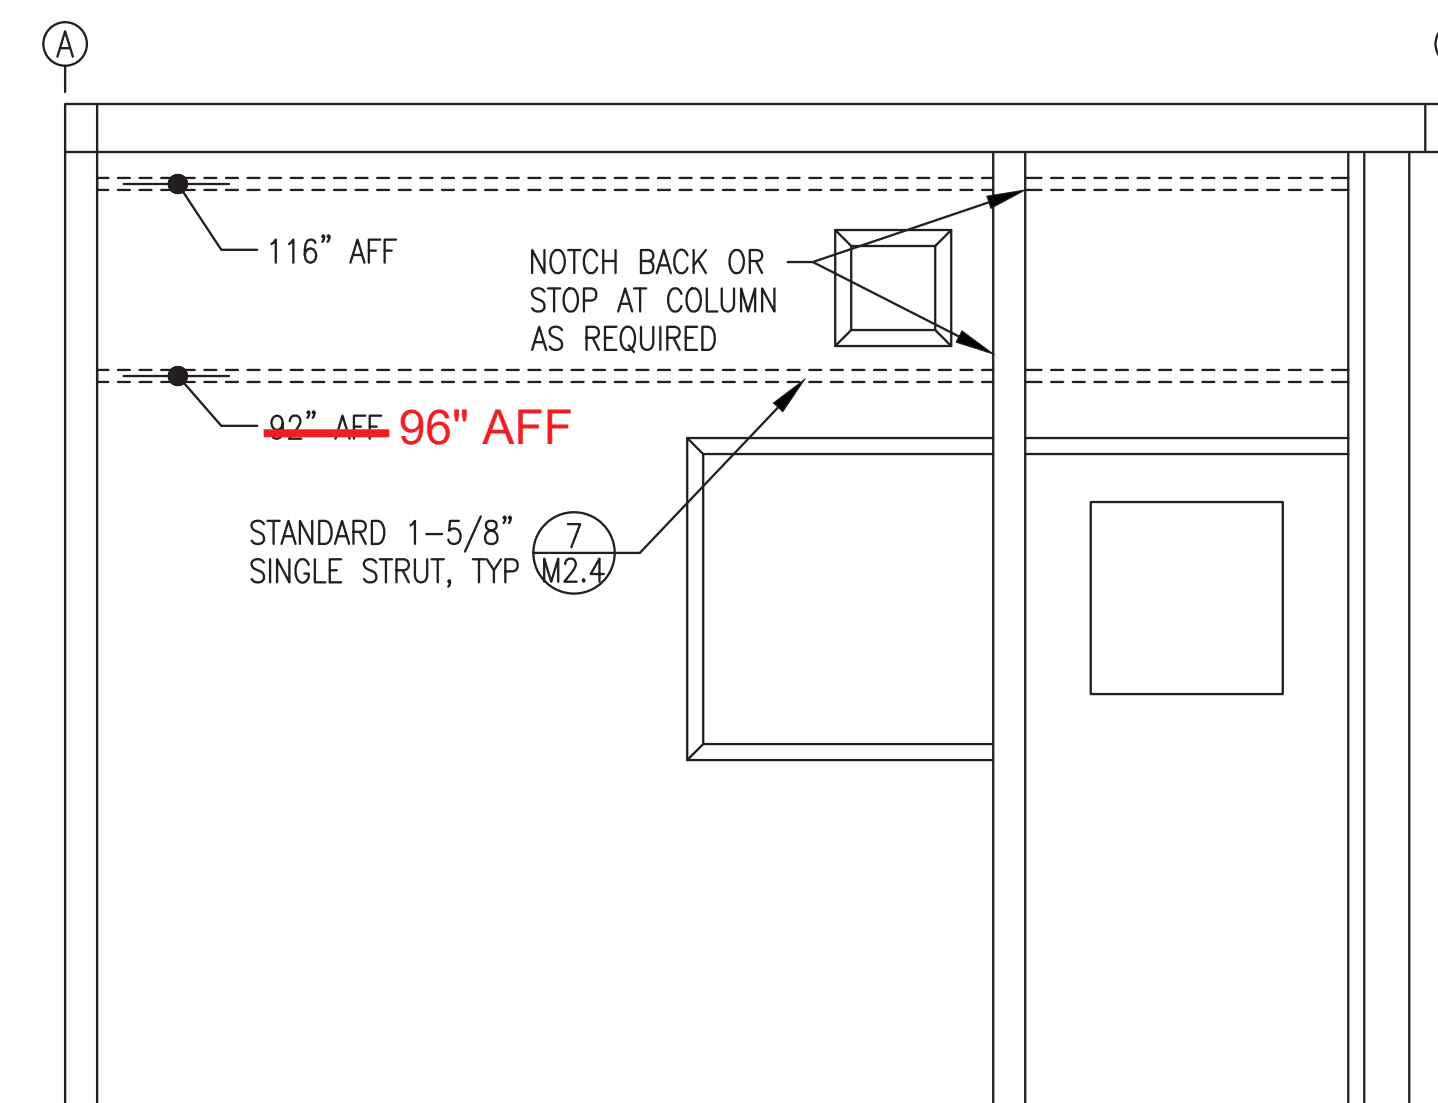


**5** GEN BAY RIGHT WALL HORIZONTAL WALL STRUT LAYOUT  
**M2.4** 1/2"=1'-0"

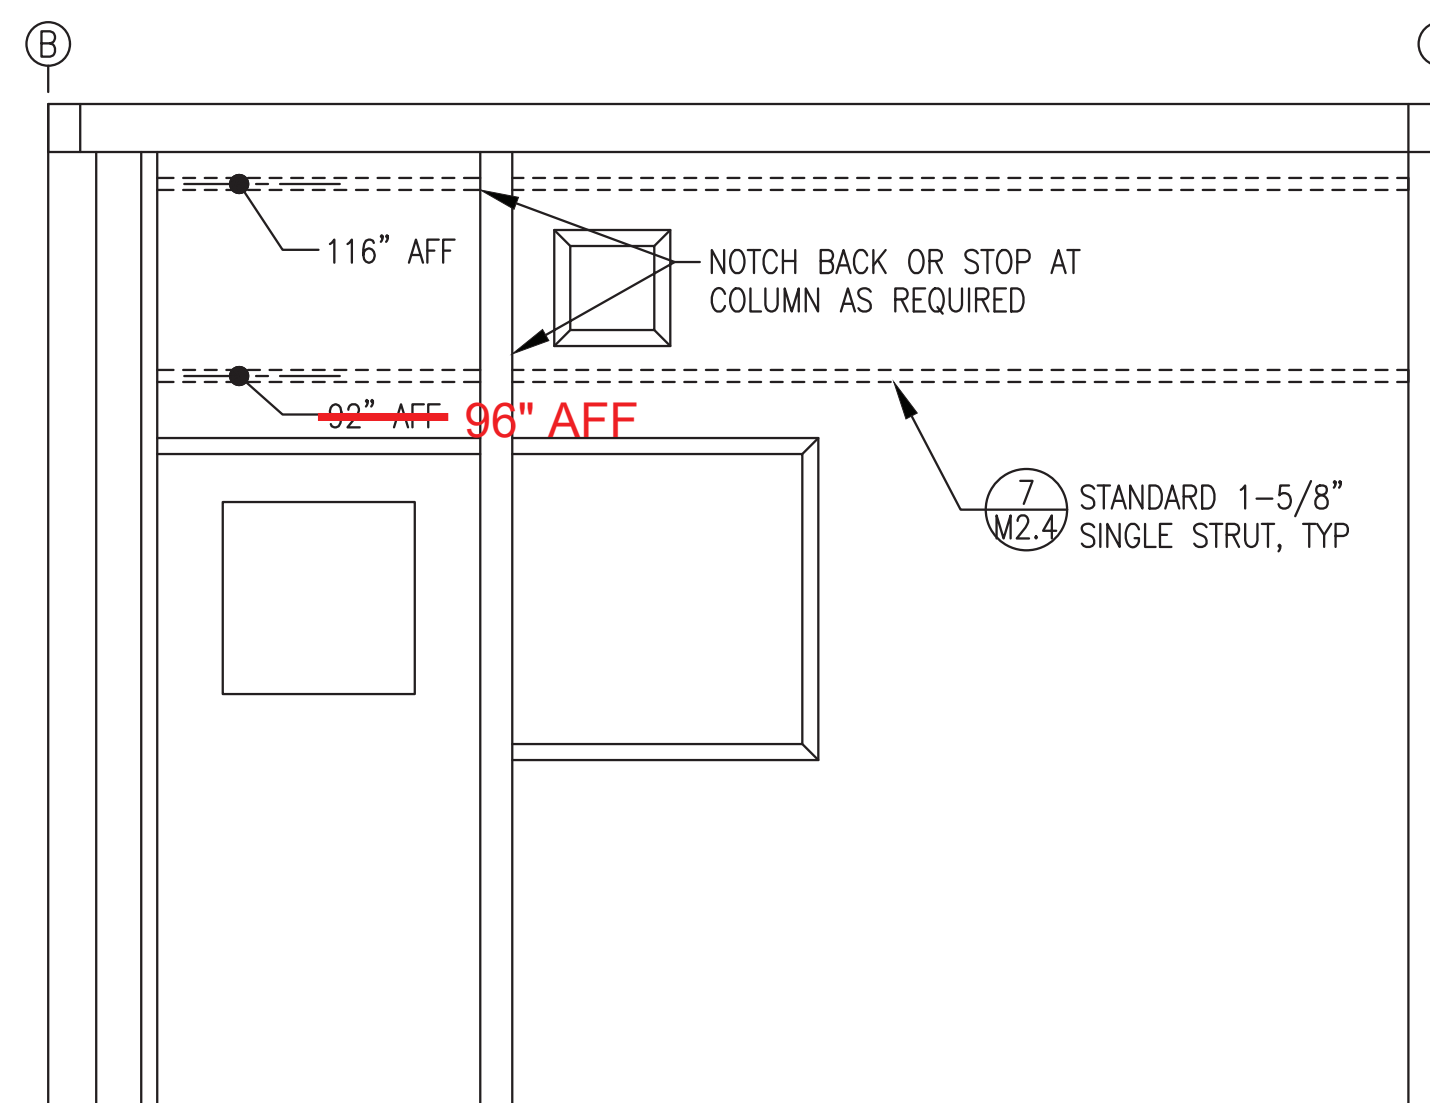

**6** CONTROL ROOM LEFT WALL HORIZONTAL WALL STRUT LAYOUT  
**M2.4** 1/2"=1'-0"

**HORIZONTAL WALL STRUT INSTALLATION NOTES:**

- 1) ALL LOCATIONS ARE CENTERLINE OF STRUT ABOVE FINISHED FLOOR (AFF).
- 2) ALL STRUT SHALL BE 12 GAUGE, 1-5/8" x 1-5/8", PLAIN (UN-FINISHED BLACK) WITH SOLID BACK, B-LINE B22-PLN OR EQUAL.
- 3) PRIOR TO PAINTING MODULE, WELD ALL HORIZONTAL STRUT SECTIONS TO WALLS AS SHOWN. SANDBLAST AND PAINT STRUT WITH MODULE INTERIOR WALLS. SEE SHEET A1 FOR PAINTING SPECIFICATIONS.

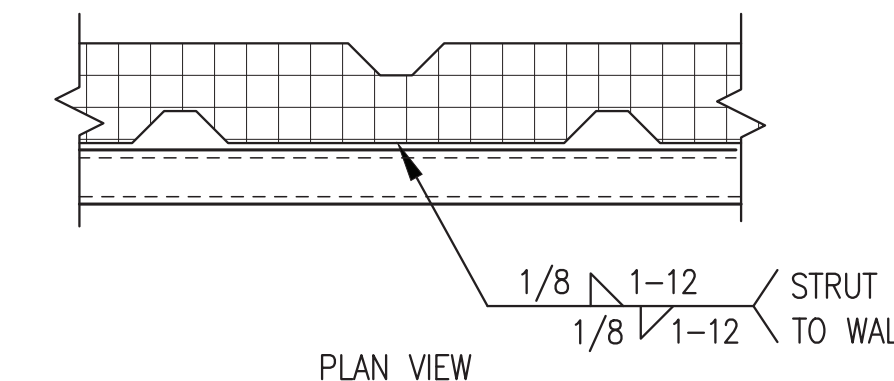

**7** HORIZONTAL WALL STRUT ATTACHMENT  
**M2.4** NO SCALE


ISSUED FOR  
 MODULE  
 FABRICATION  
 MARCH 2023




ALL WORK ON THIS SHEET WAS PERFORMED AS PART OF THE PRIOR MODULE FABRICATION CONTRACT AND IS SHOWN HERE FOR REFERENCE ONLY.

 ALASKA ENERGY AUTHORITY	
PROJECT: NELSON LAGOON POWER SYSTEM UPGRADE	
TITLE: MECHANICAL SUPPORT HORIZONTAL WALL STRUT INSTALLATION	
DRAWN BY: JTD DESIGNED BY: BCG FILE NAME: NELS_PP_M2-M7 PROJECT NUMBER:	SCALE: AS NOTED DATE: 3/30/23 SHEET: <b>M2.4</b>




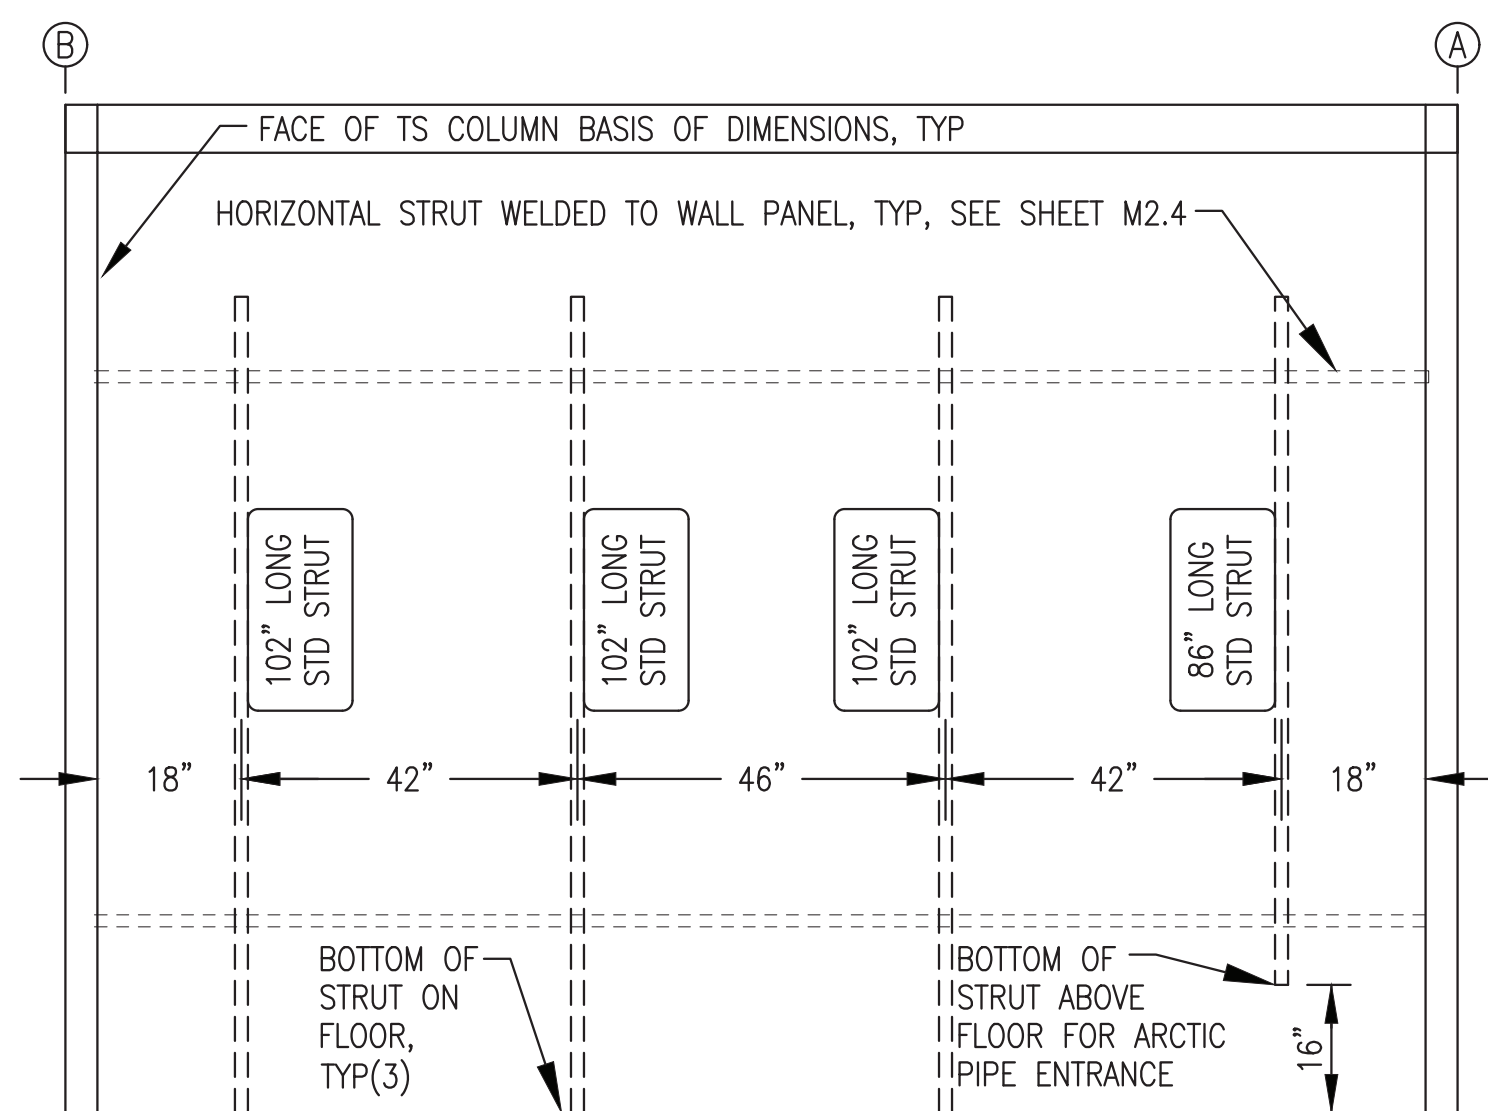


**1** END WALL (GRID 1) VERTICAL WALL STRUT LAYOUT  
M2.5 1/2"=1'-0"

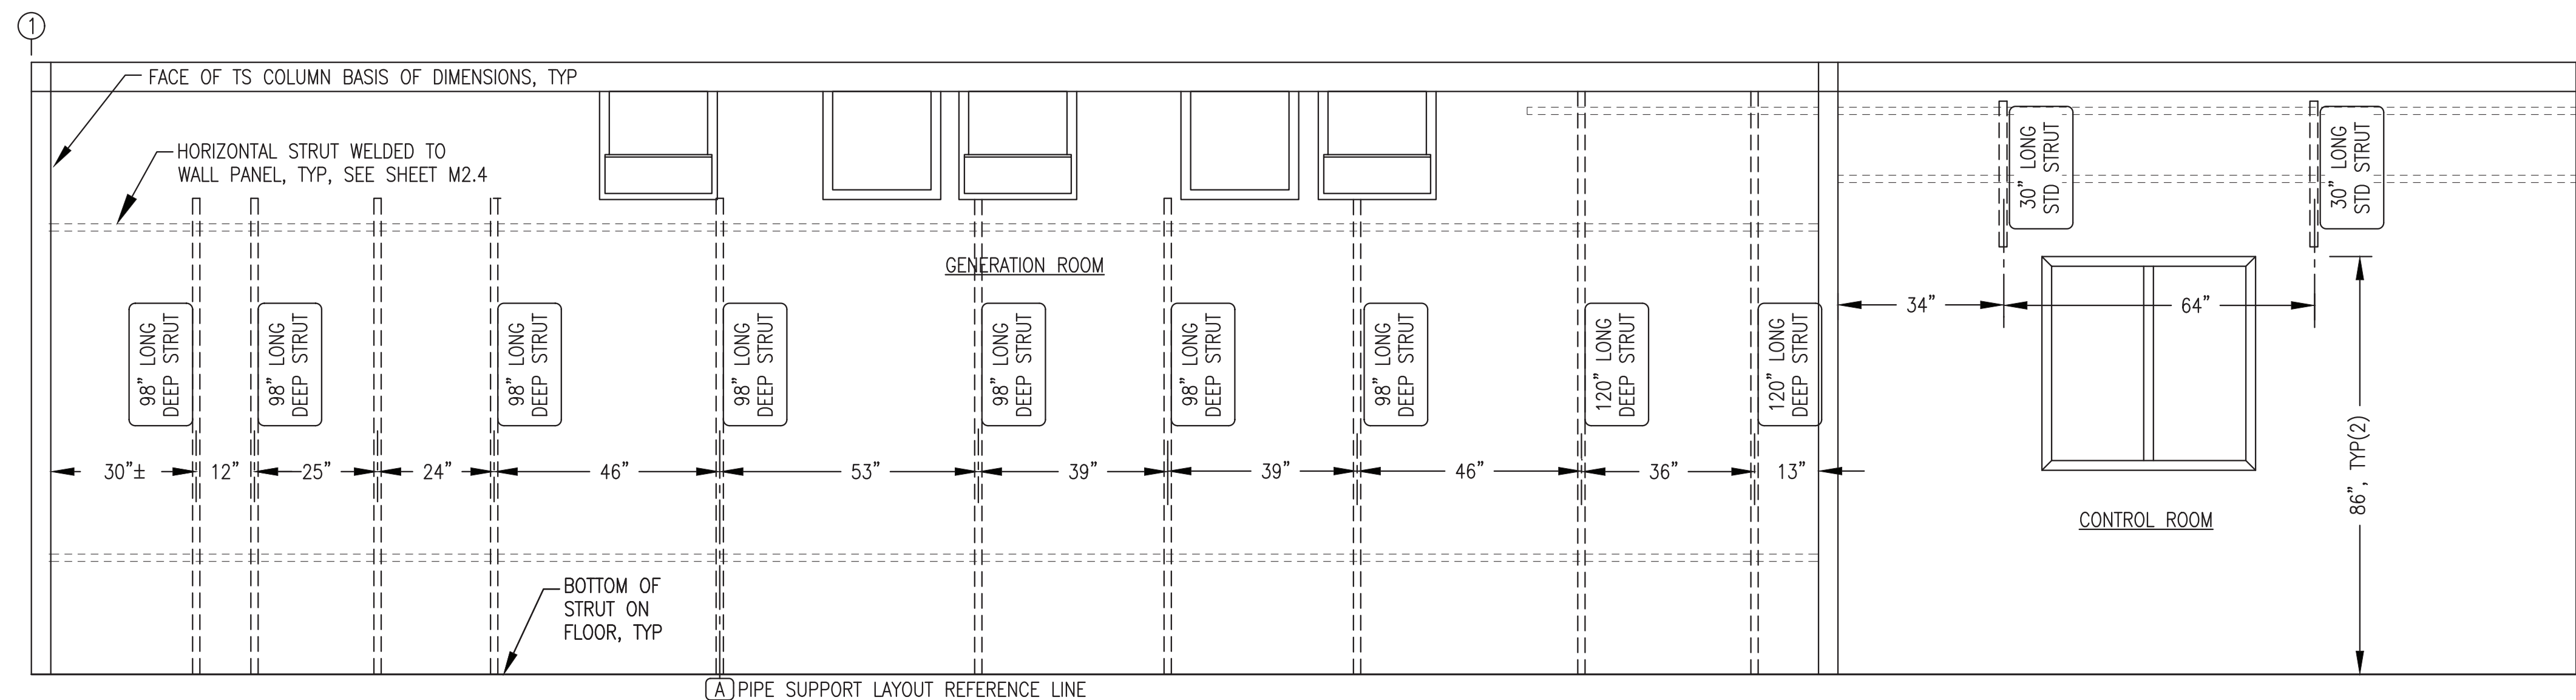


**2** BACK WALL (GRID A) VERTICAL WALL STRUT LAYOUT  
M2.5 1/2"=1'-0"

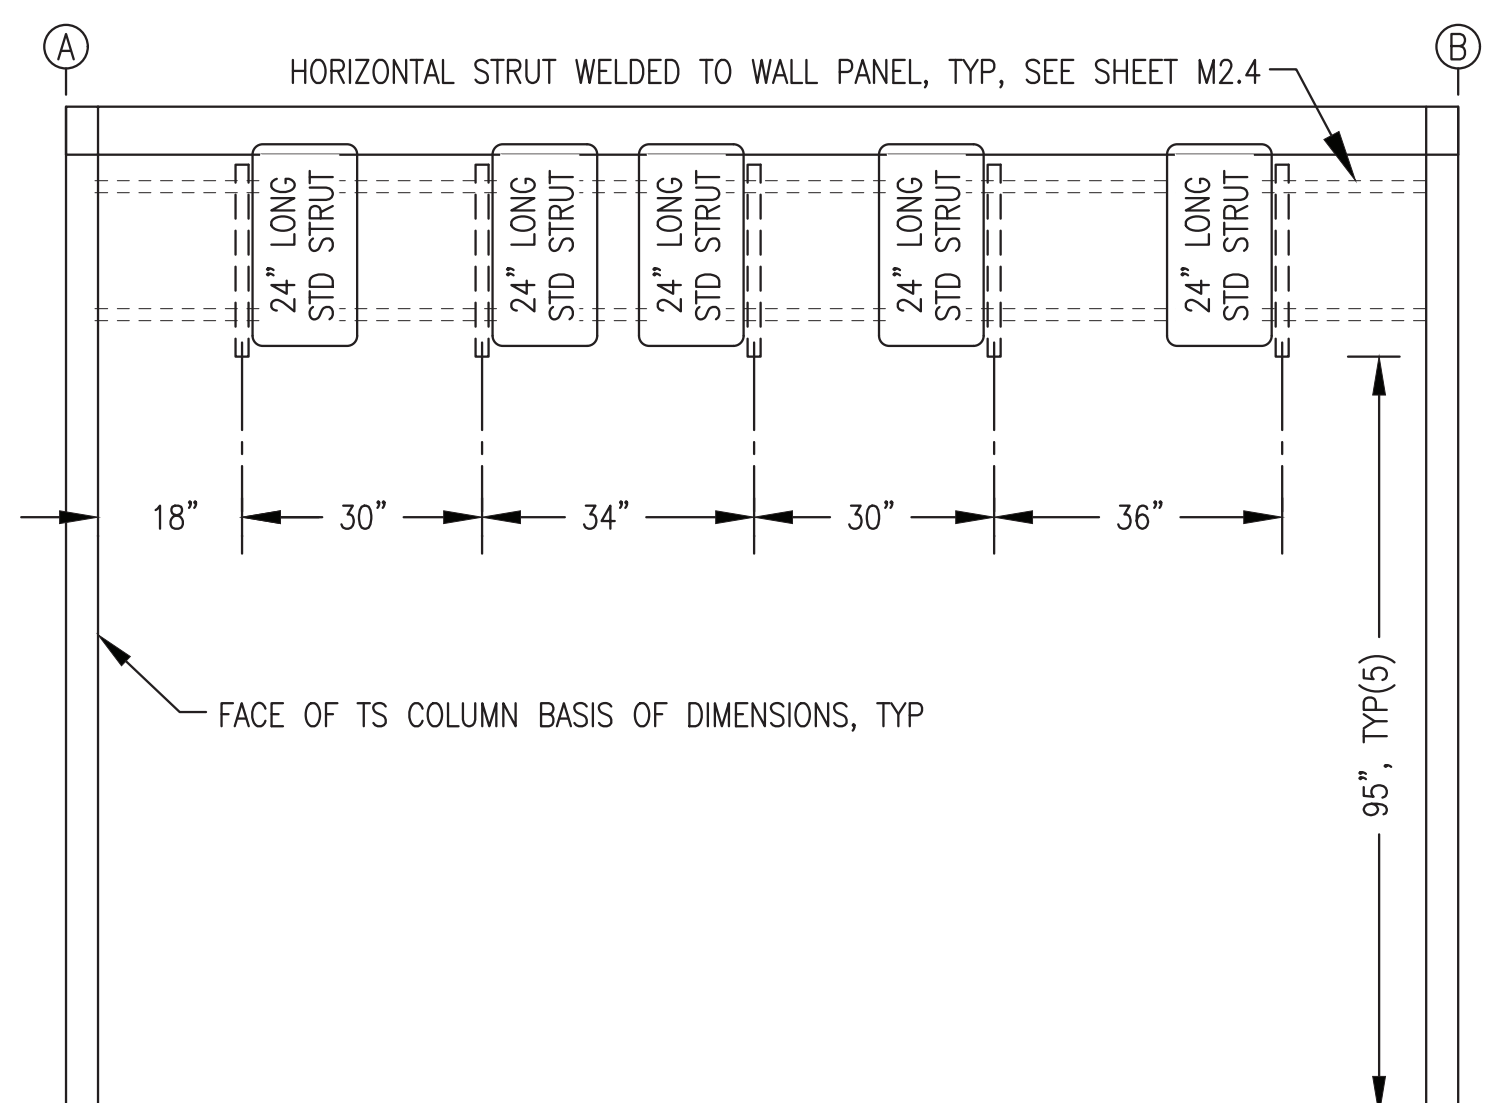


**3** END WALL (GRID 2) VERTICAL WALL STRUT LAYOUT  
M2.5 1/2"=1'-0"

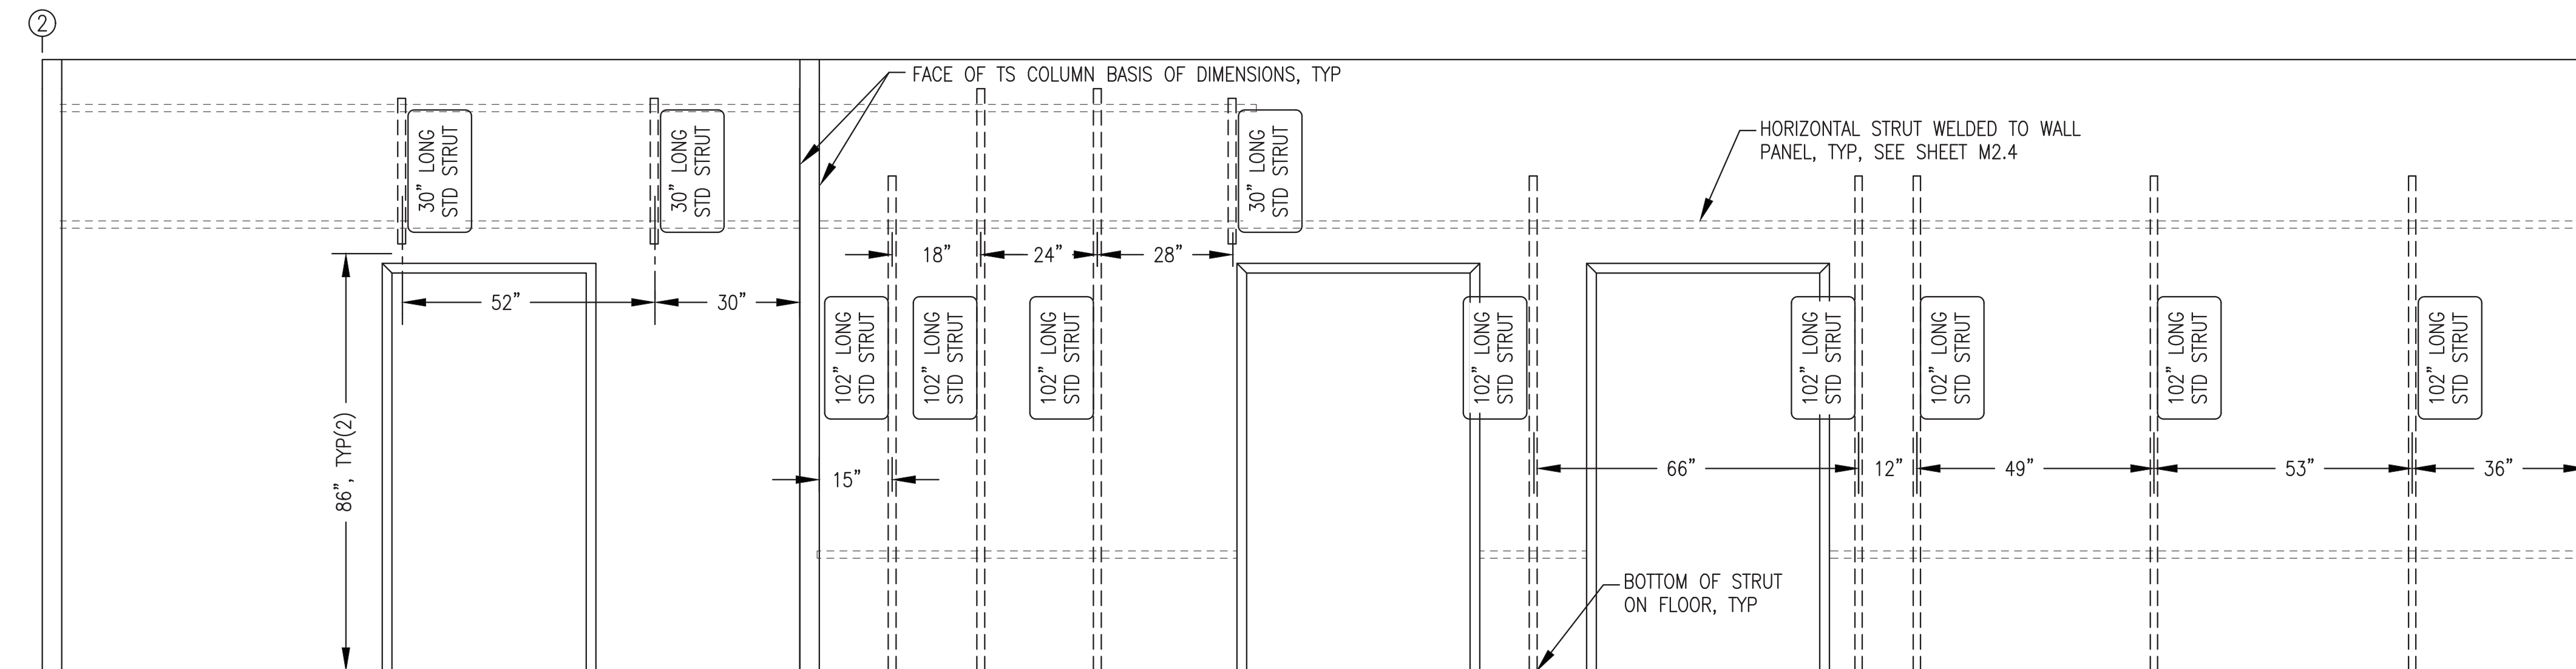

**4** FRONT WALL (GRID B) VERTICAL WALL STRUT LAYOUT  
M2.5 1/2"=1'-0"

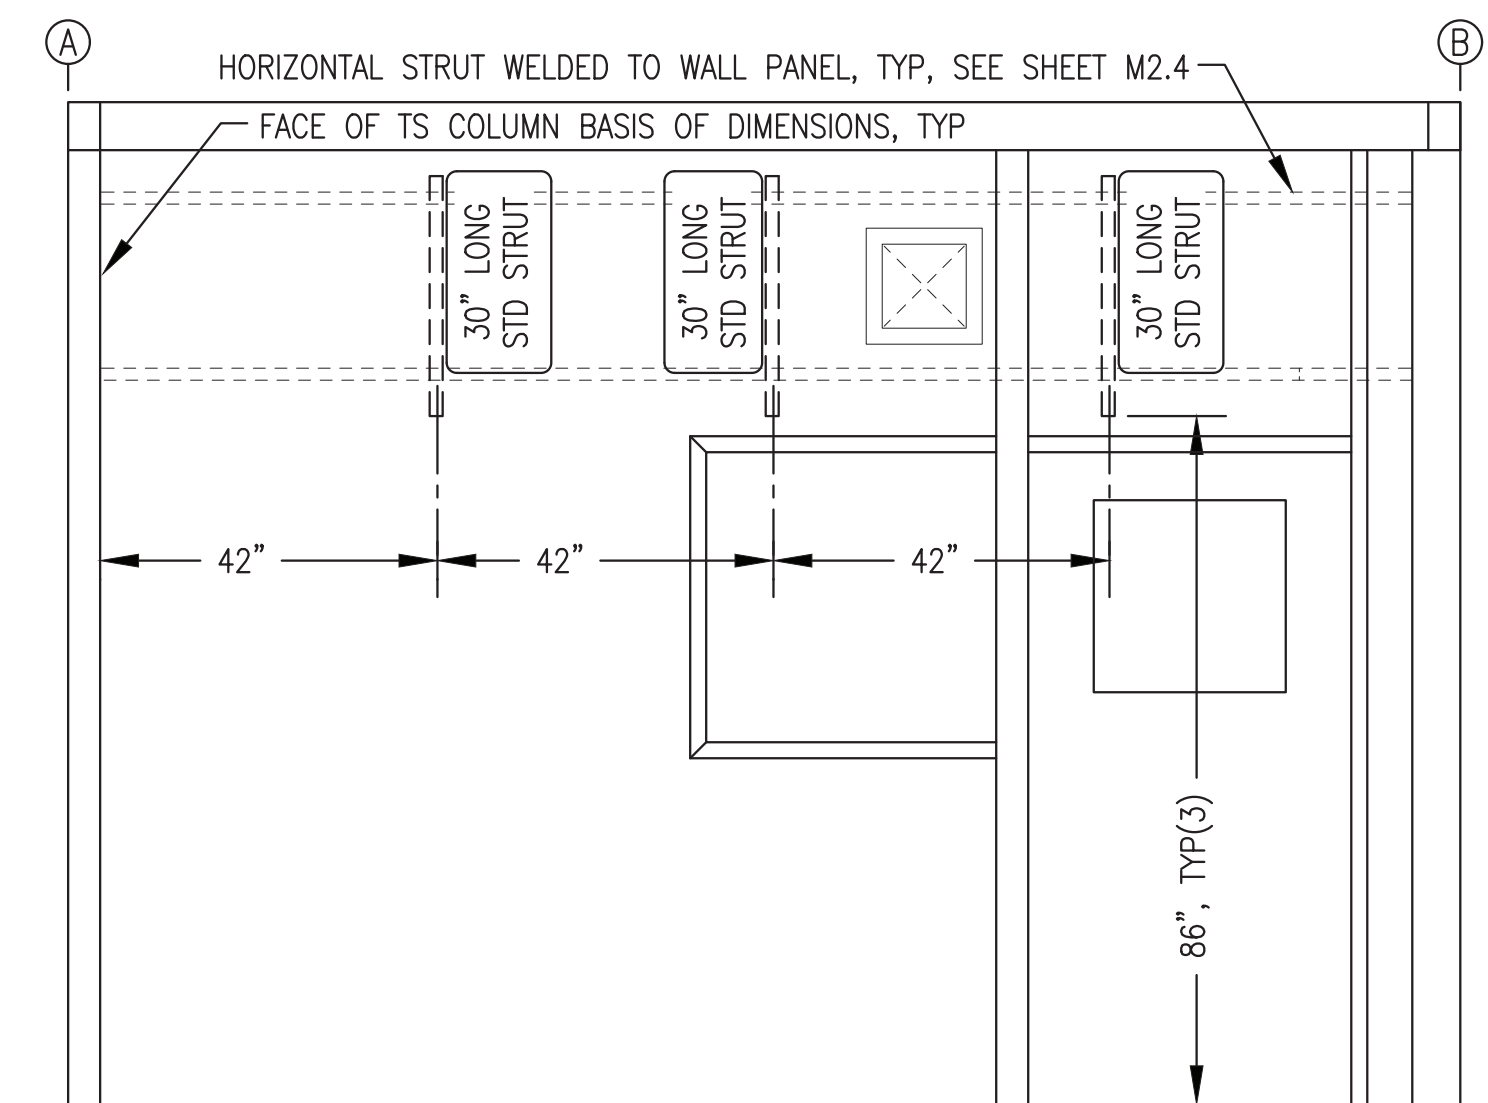

**5** GEN BAY RIGHT WALL VERTICAL WALL STRUT LAYOUT  
M2.5 1/2"=1'-0"

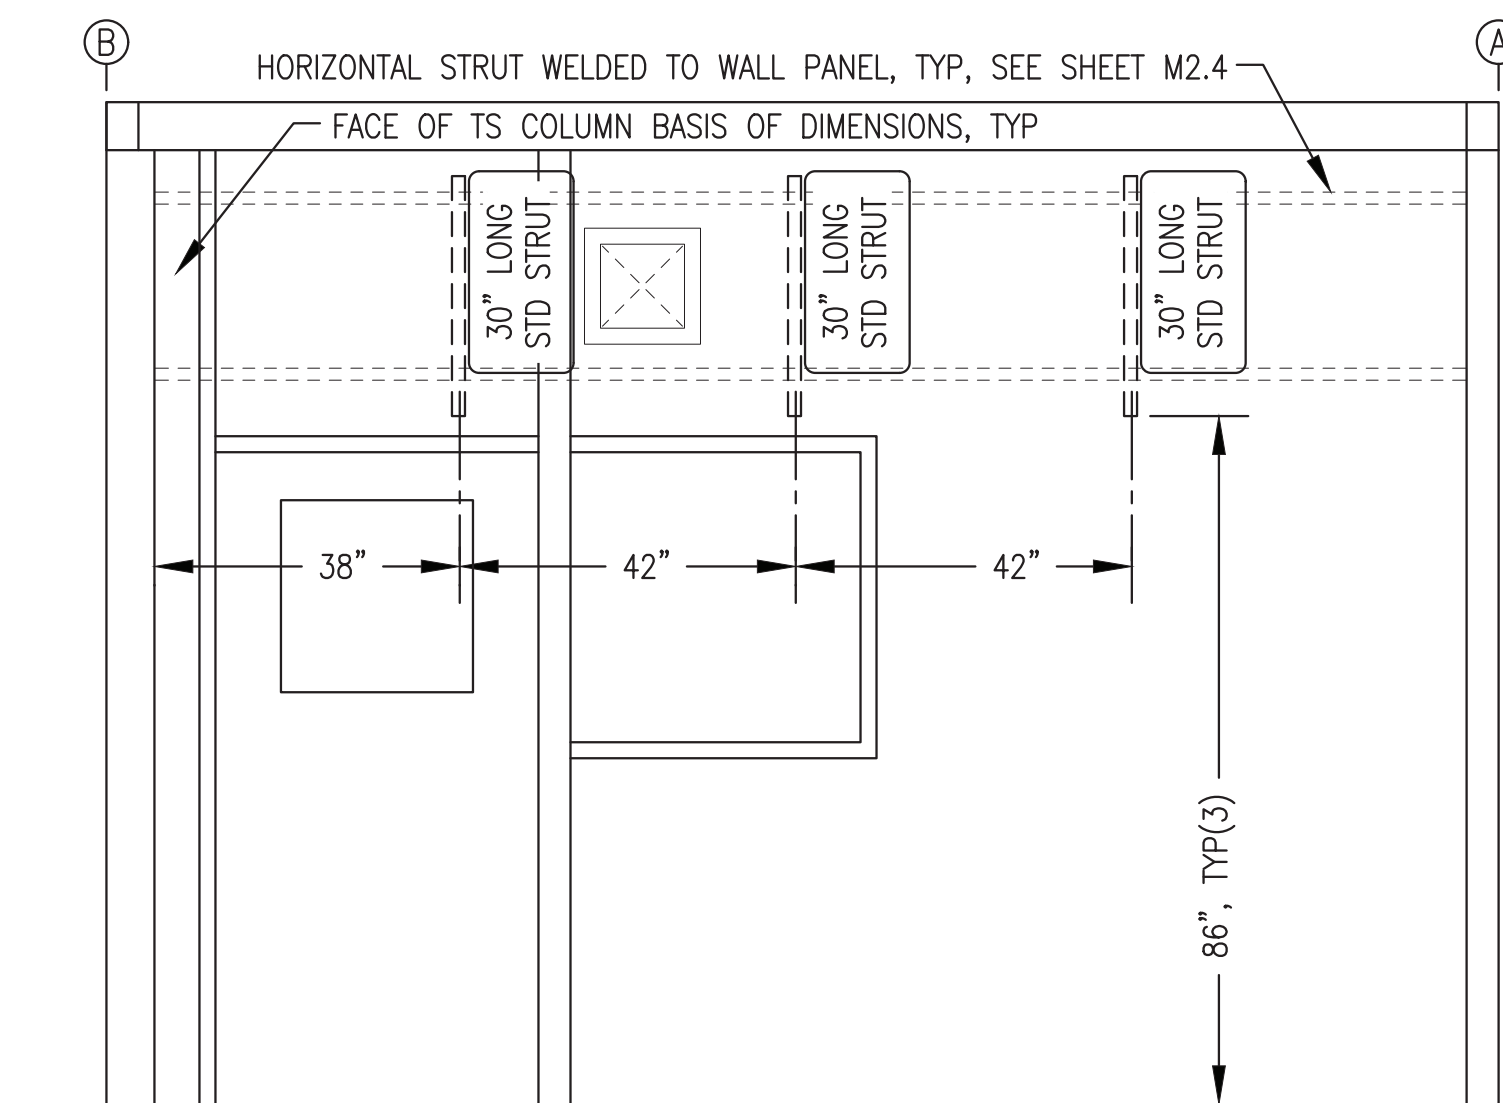

**6** CONTROL ROOM LEFT WALL VERTICAL WALL STRUT LAYOUT  
M2.5 1/2"=1'-0"

**VERTICAL WALL STRUT INSTALLATION NOTES:**

- 1) ALL HORIZONTAL LOCATIONS ARE CENTERLINE OF STRUT FROM FACE OF TS COLUMNS. ALL VERTICAL LOCATIONS ARE END OF STRUT ABOVE FINISHED FLOOR.
- 2) ALL STRUT SHALL BE 12 GAUGE, PRE-GALVANIZED FINISH WITH SLOTTED BACK. "STD" DESIGNATES STANDARD 1-5/8" x 1-5/8" SINGLE STRUT, B-LINE B22-SH-GALV OR EQUAL. "DEEP" DESIGNATES 3-1/4" x 1-5/8" SINGLE STRUT, B-LINE B11-SH-GALV OR EQUAL.
- 3) FASTEN ALL VERTICAL STRUT SECTIONS TO HORIZONTAL STRUT WITH 1/2"x1" ALLEN HEAD CAP SCREWS & STRUT NUTS.
- 4) ONLY MAJOR WALL MOUNTED EQUIPMENT SUPPORT STRUT SHOWN THIS SHEET. SEE MECHANICAL AND ELECTRICAL DRAWINGS FOR OTHER EQUIPMENT, PIPING, AND WIREWAY STRUT SUPPORT DETAILS.


ISSUED FOR  
CONSTRUCTION  
MAY 2023




ALL WORK ON THIS SHEET WAS PERFORMED AS PART OF THE PRIOR MODULE ASSEMBLY CONTRACT AND IS SHOWN HERE FOR REFERENCE ONLY.

<p>ALASKA ENERGY AUTHORITY</p>		
PROJECT: NELSON LAGOON POWER SYSTEM UPGRADE		
TITLE: MECHANICAL SUPPORT VERTICAL WALL STRUT INSTALLATION		
<p>Gray Stassel Engineering, Inc. P.O. 111405, Anchorage, AK 99511 (907)349-0100</p>	<p>DRAWN BY: JTD DESIGNED BY: BCG FILE NAME: NELS_PP_M2-M7 PROJECT NUMBER:</p>	<p>SCALE: AS NOTED DATE: 5/30/23 SHEET: M2.5</p>




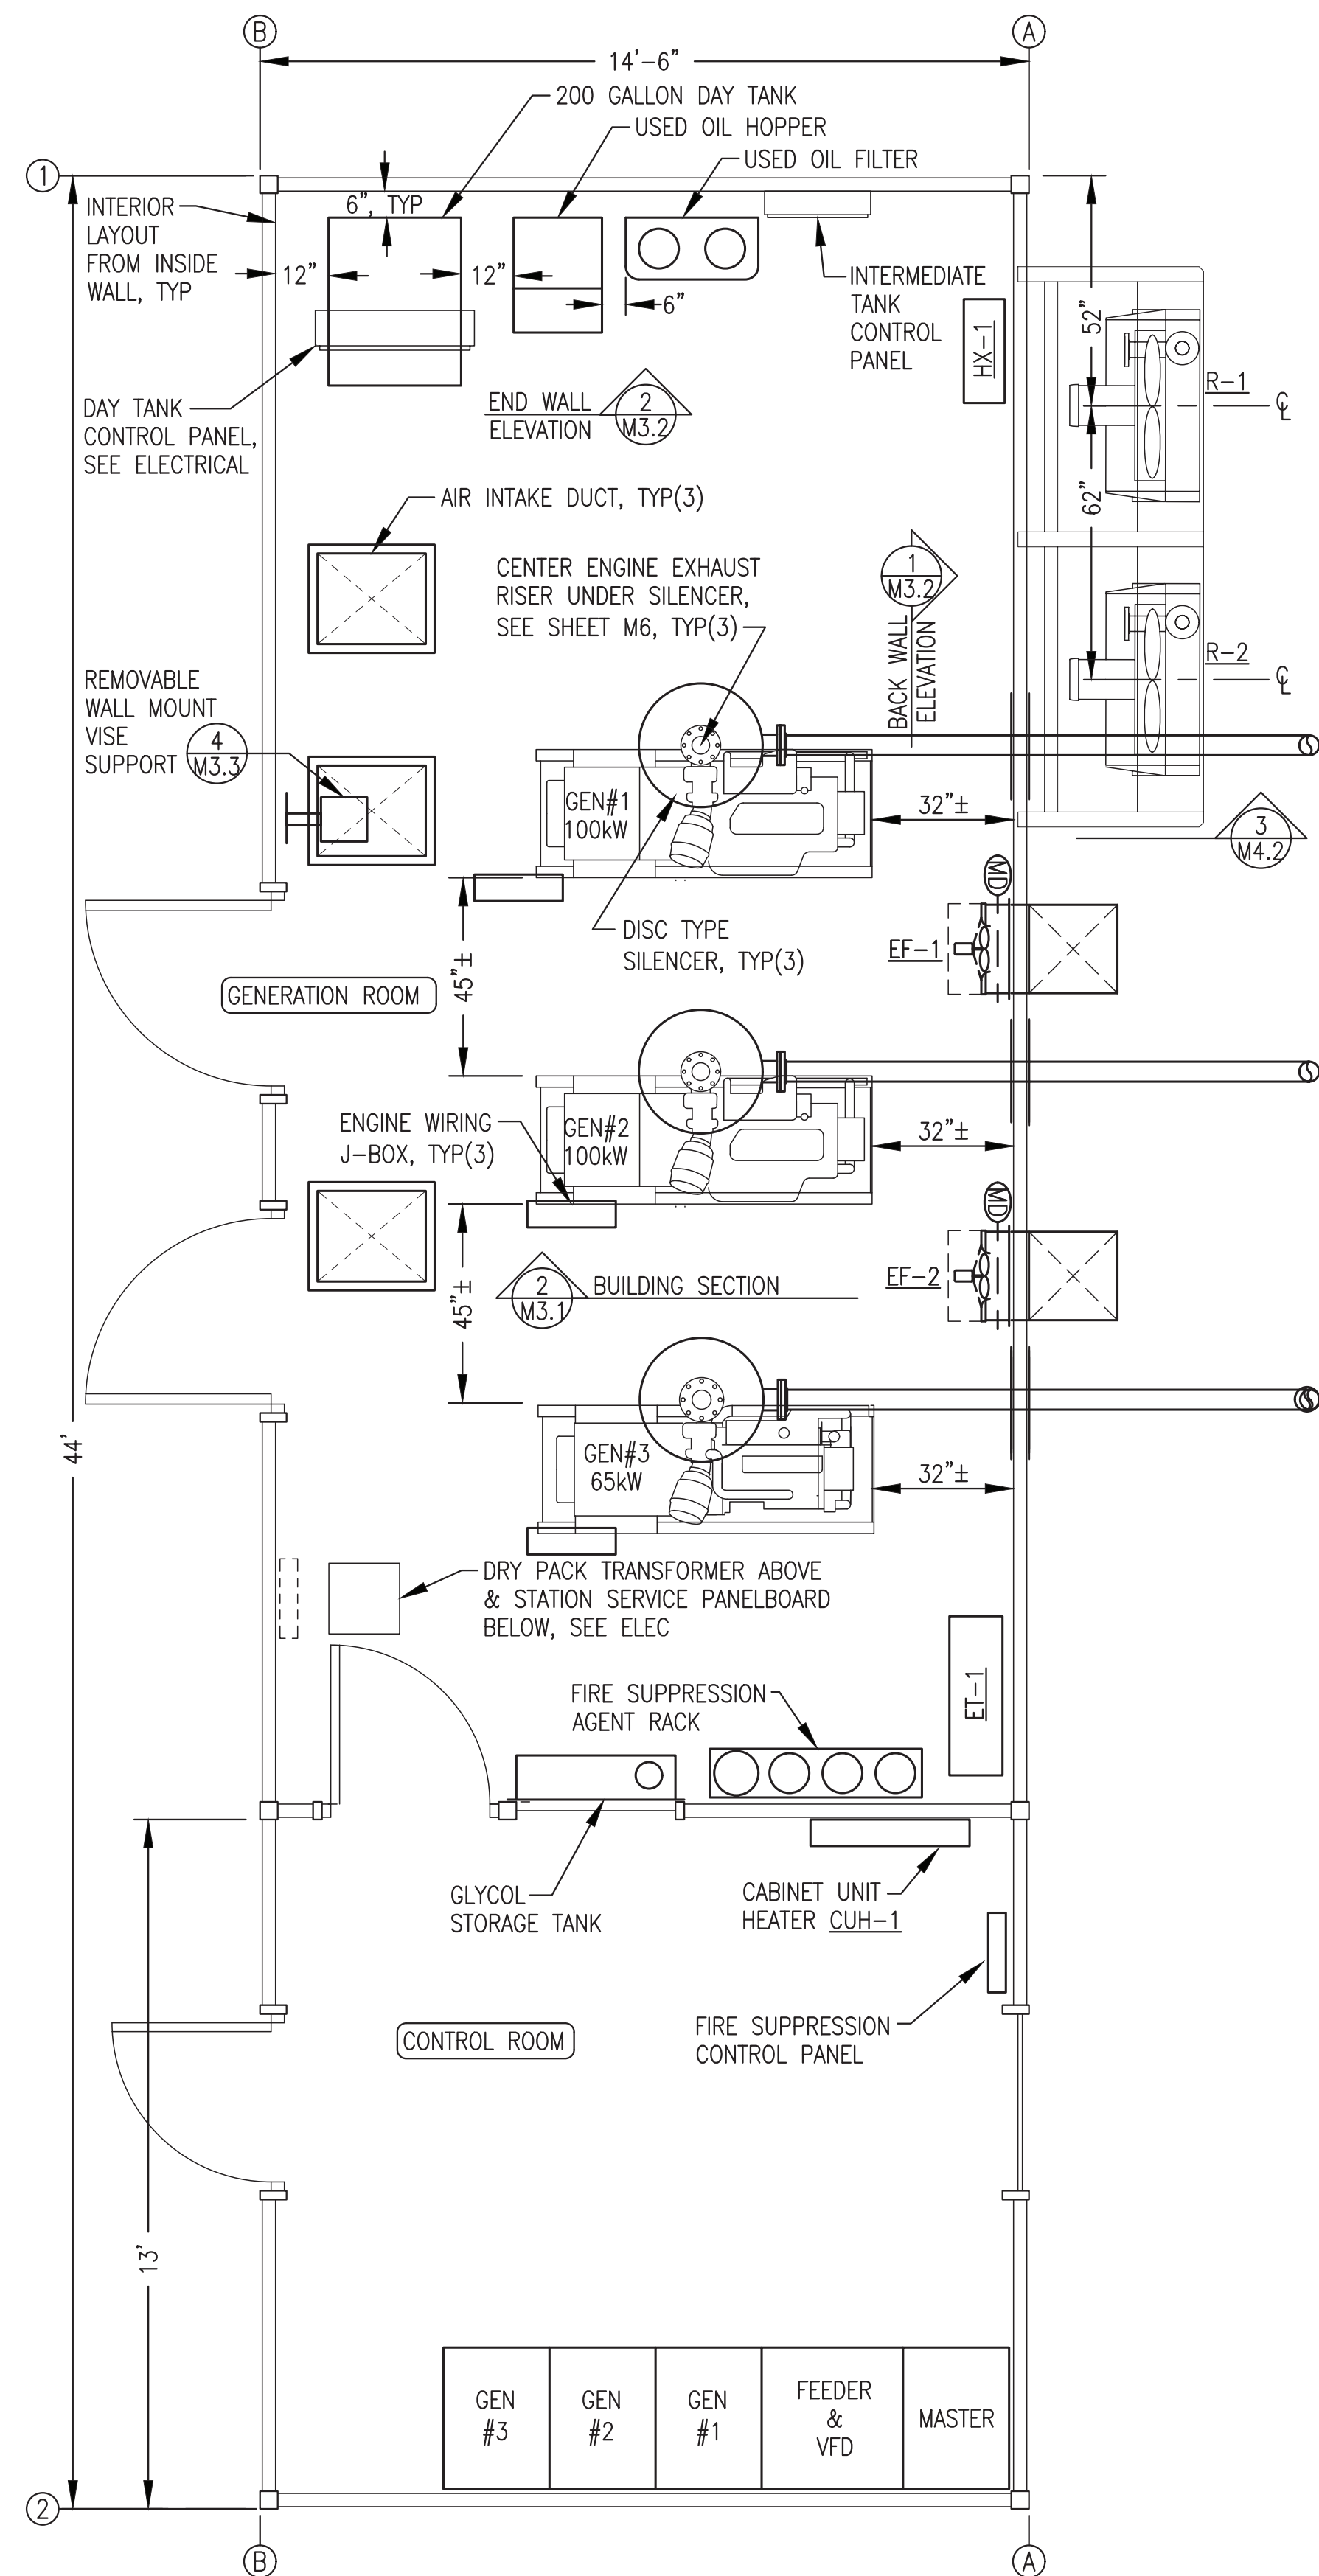

1 EQUIPMENT LAYOUT PLAN  
M3.1 3/8"=1'-0"

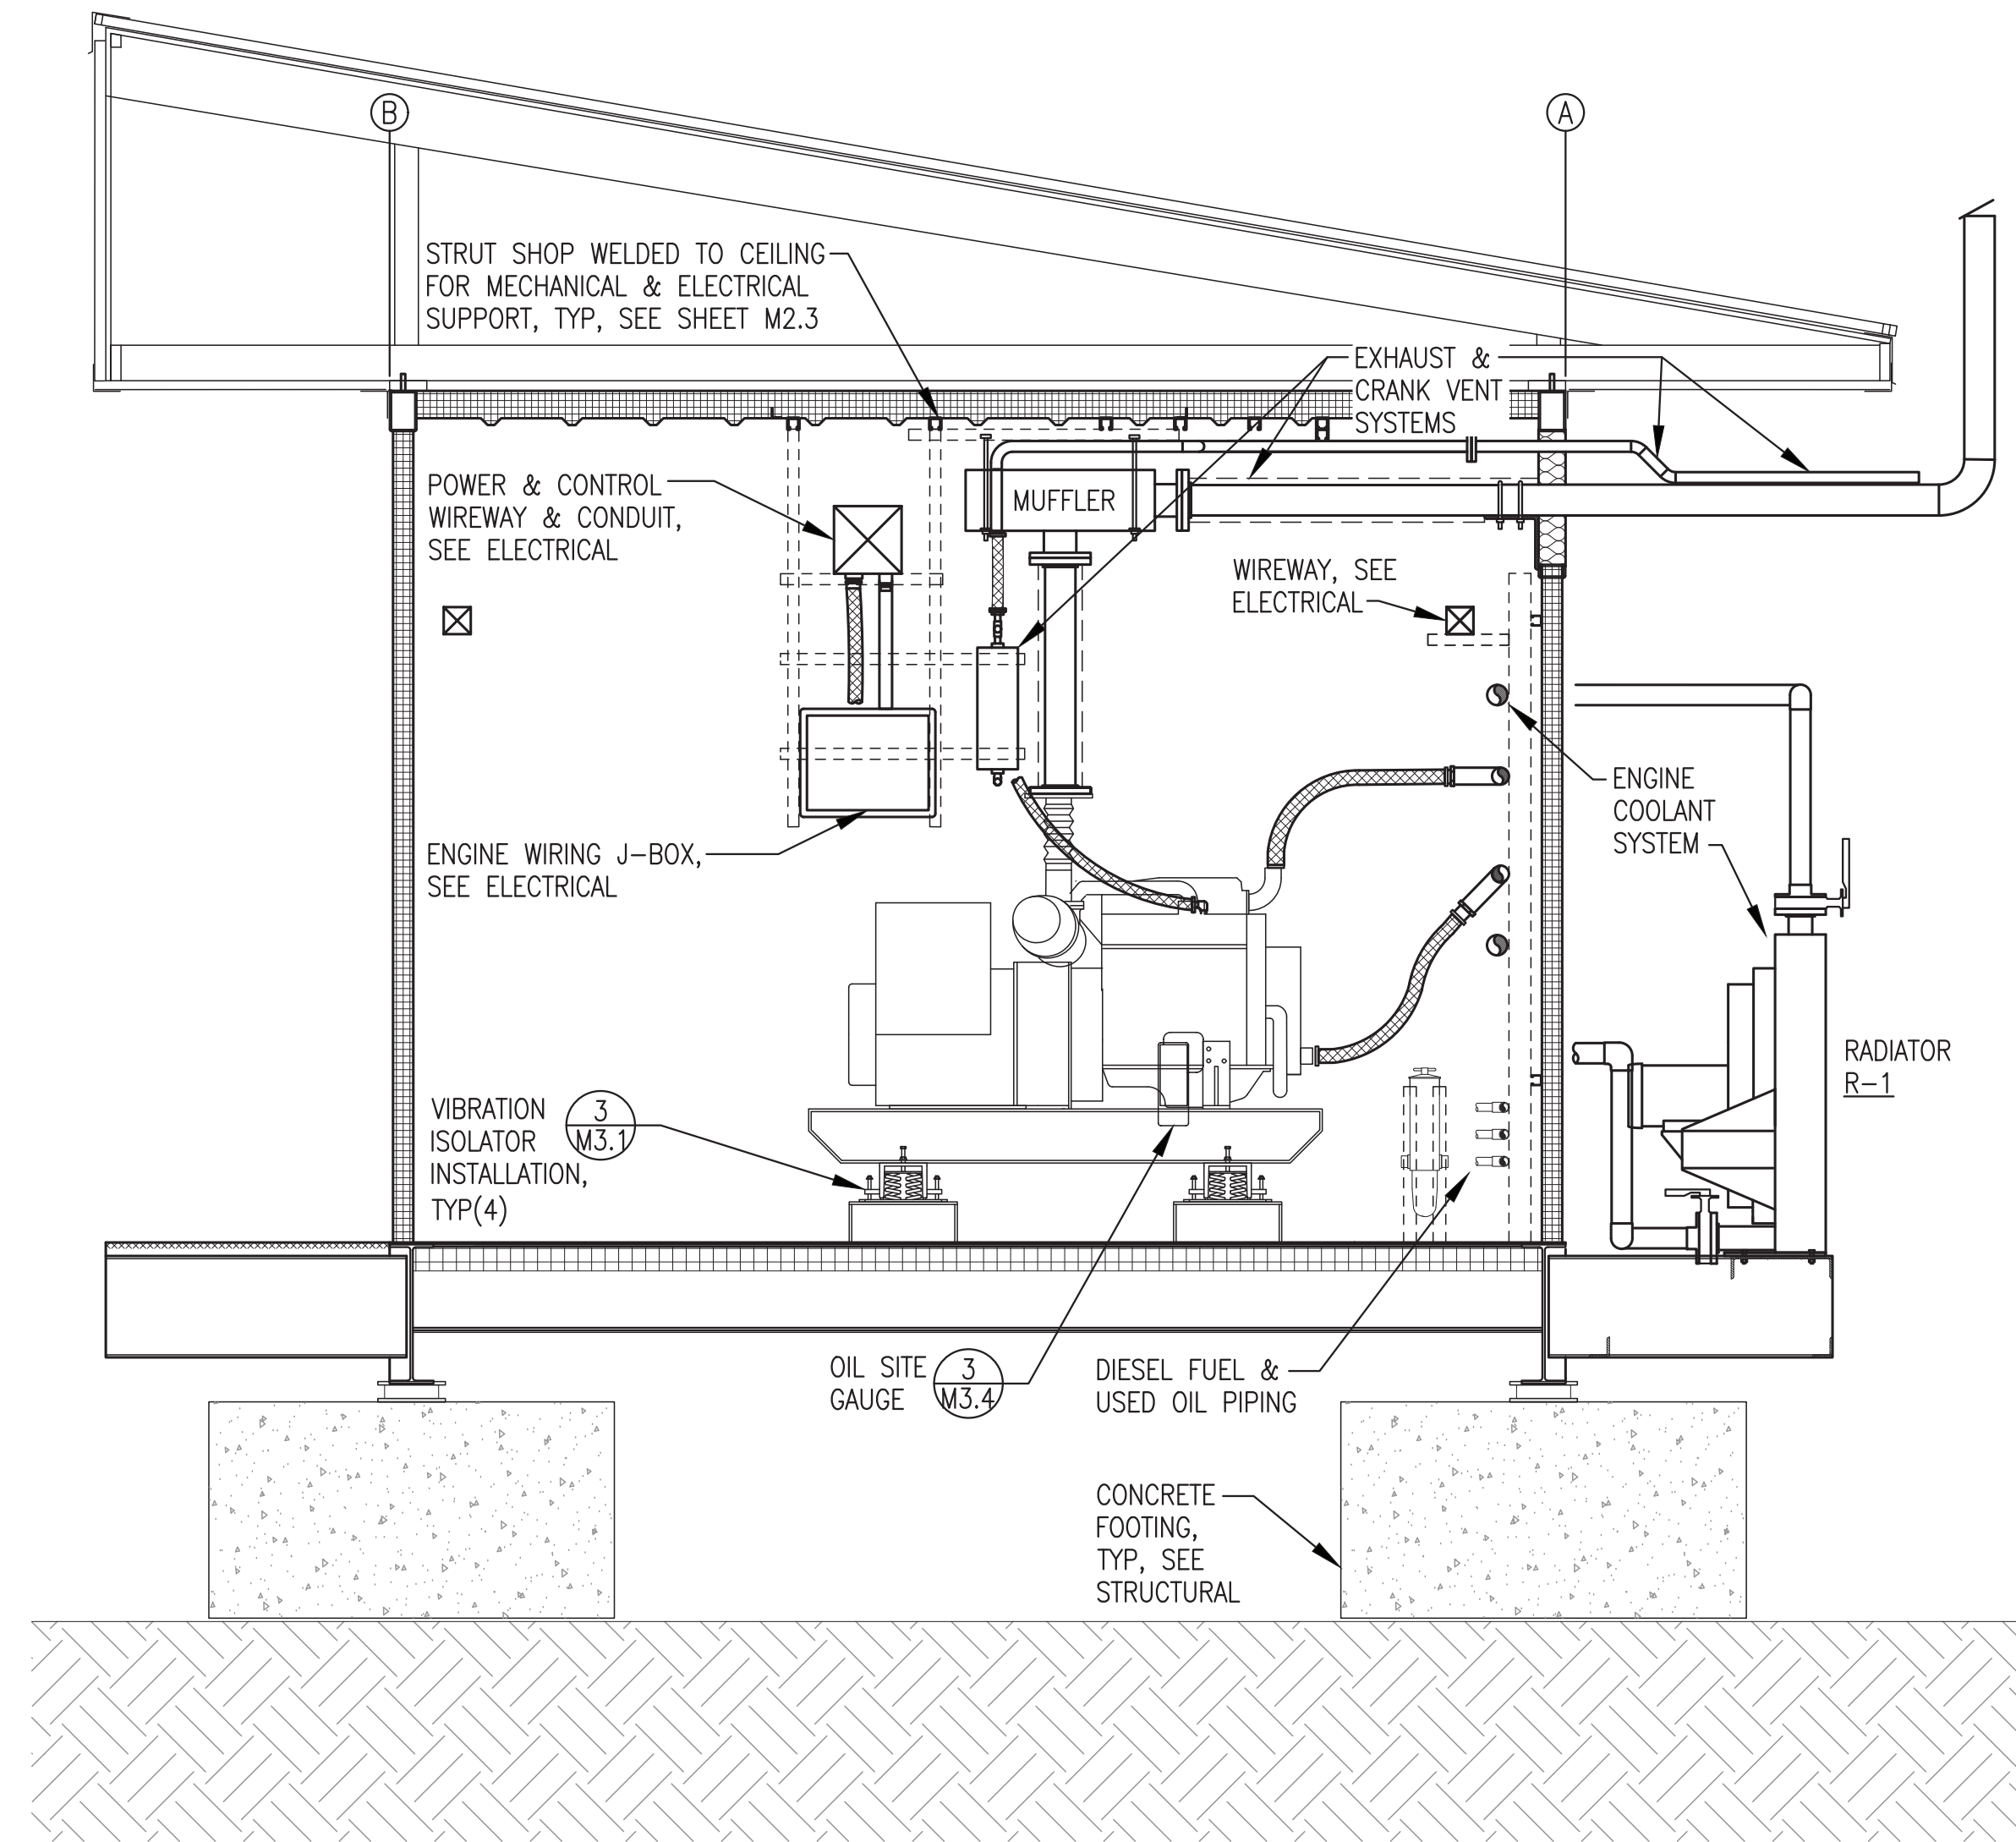

2 TYPICAL MODULE SECTION/GENERATOR INSTALLATION  
M3.1 1/2"=1'-0"

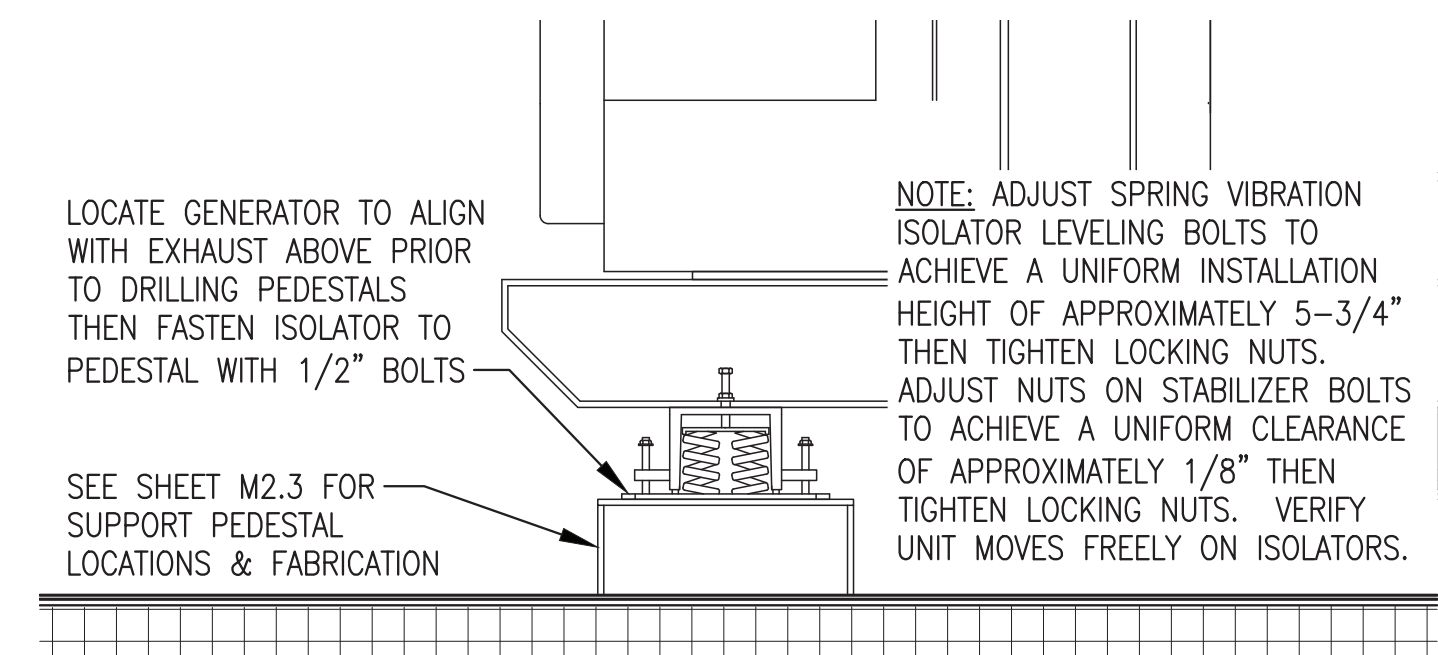

3 VIBRATION ISOATOR INSTALLATION  
M3.1 1"=1'-0"

**EQUIPMENT LAYOUT GENERAL NOTES:**

- SEE M2 SHEETS FOR MECHANICAL AND ELECTRICAL SUPPORTS AND PENETRATIONS
- SEE M3 SHEETS FOR GENERAL EQUIPMENT LAYOUT, BASE SUPPORT, FABRICATIONS, AND GENERATOR ASSEMBLY DETAILS.
- SEE M4 SHEETS FOR ENGINE COOLANT SYSTEM AND HEAT RECOVERY SYSTEM PLANS, ISOMETRICS, AND DETAILS.
- SEE M5 SHEETS FOR DIESEL FUEL AND USED OIL SYSTEM PLANS AND DETAILS.
- SEE SHEET M6 FOR EXHAUST AND CRANK CASE VENTILATION PLANS AND DETAILS.
- SEE M7 SHEETS FOR VENTILATION SYSTEM PLANS AND SHEET METAL FABRICATIONS.

ENGINE-GENERATOR SCHEDULE	
GENSET	DESCRIPTION
GEN #1	ENGINE - 148 HP, 100 EKW PRIME, JOHN DEERE 4045AFM85, TIER 3 MARINE. 24 VDC STARTING & CONTROL. GENERATOR - MINIMUM 125 KW CONTINUOUS AT 105°C RISE, NEWAGE/STAMFORD UC1274E.
GEN #2	ENGINE - 148 HP, 100 EKW PRIME, JOHN DEERE 4045AFM85, TIER 3 MARINE. 24 VDC STARTING & CONTROL. GENERATOR - MINIMUM 125 KW CONTINUOUS AT 105°C RISE, NEWAGE/STAMFORD UC1274E.
GEN #3	ENGINE - 99 HP, 65 EKW PRIME, JOHN DEERE 4045TFM85, TIER 3 MARINE. 24 VDC STARTING & CONTROL. GENERATOR - MINIMUM 90 KW CONTINUOUS AT 105°C RISE, NEWAGE/STAMFORD UC1274C.

**ENGINE-GENERATOR CODE COMPLIANCE NOTES**

- PER IMC 915.1 THE ENGINE-GENERATORS AND ASSOCIATED MECHANICAL SYSTEMS SHALL BE IN INSTALLED COMPLIANCE WITH NFPA 37. SEE THE ABOVE REFERENCED DRAWINGS FOR ADDITIONAL DETAIL.
- PER IMC 915.1 THE ENGINE-GENERATORS SHALL BE FABRICATED AND ASSEMBLED IN ACCORDANCE WITH U.L. 2200. SEE ENGINE-GENERATOR SPECIFICATIONS FOR ADDITIONAL DETAIL.

THE MAJORITY OF WORK ON THIS SHEET WAS PERFORMED AS PART OF THE PRIOR MODULE ASSEMBLY CONTRACT AND IS SHOWN HERE FOR REFERENCE ONLY. FIELD INSTALLATION OF COMPONENTS EXTERIOR TO THE MODULE UNDER THE ON SITE CONTRACT ARE DELINEATED ON SHEETS THAT FOLLOW.

ISSUED FOR CONSTRUCTION  
MAY 2023




ALASKA ENERGY AUTHORITY

PROJECT: NELSON LAGOON POWER SYSTEM UPGRADE


TITLE: EQUIPMENT LAYOUT PLAN, SECTION, & DETAILS

DRAWN BY: JTD	SCALE: AS NOTED
DESIGNED BY: BCG	DATE: 5/30/23
FILE NAME: NELS_PP_M2-M7	SHEET: M3.1
PROJECT NUMBER:	


Gray Stassel Engineering, Inc.  
P.O. 111405, Anchorage, AK 99511 (907)349-0100

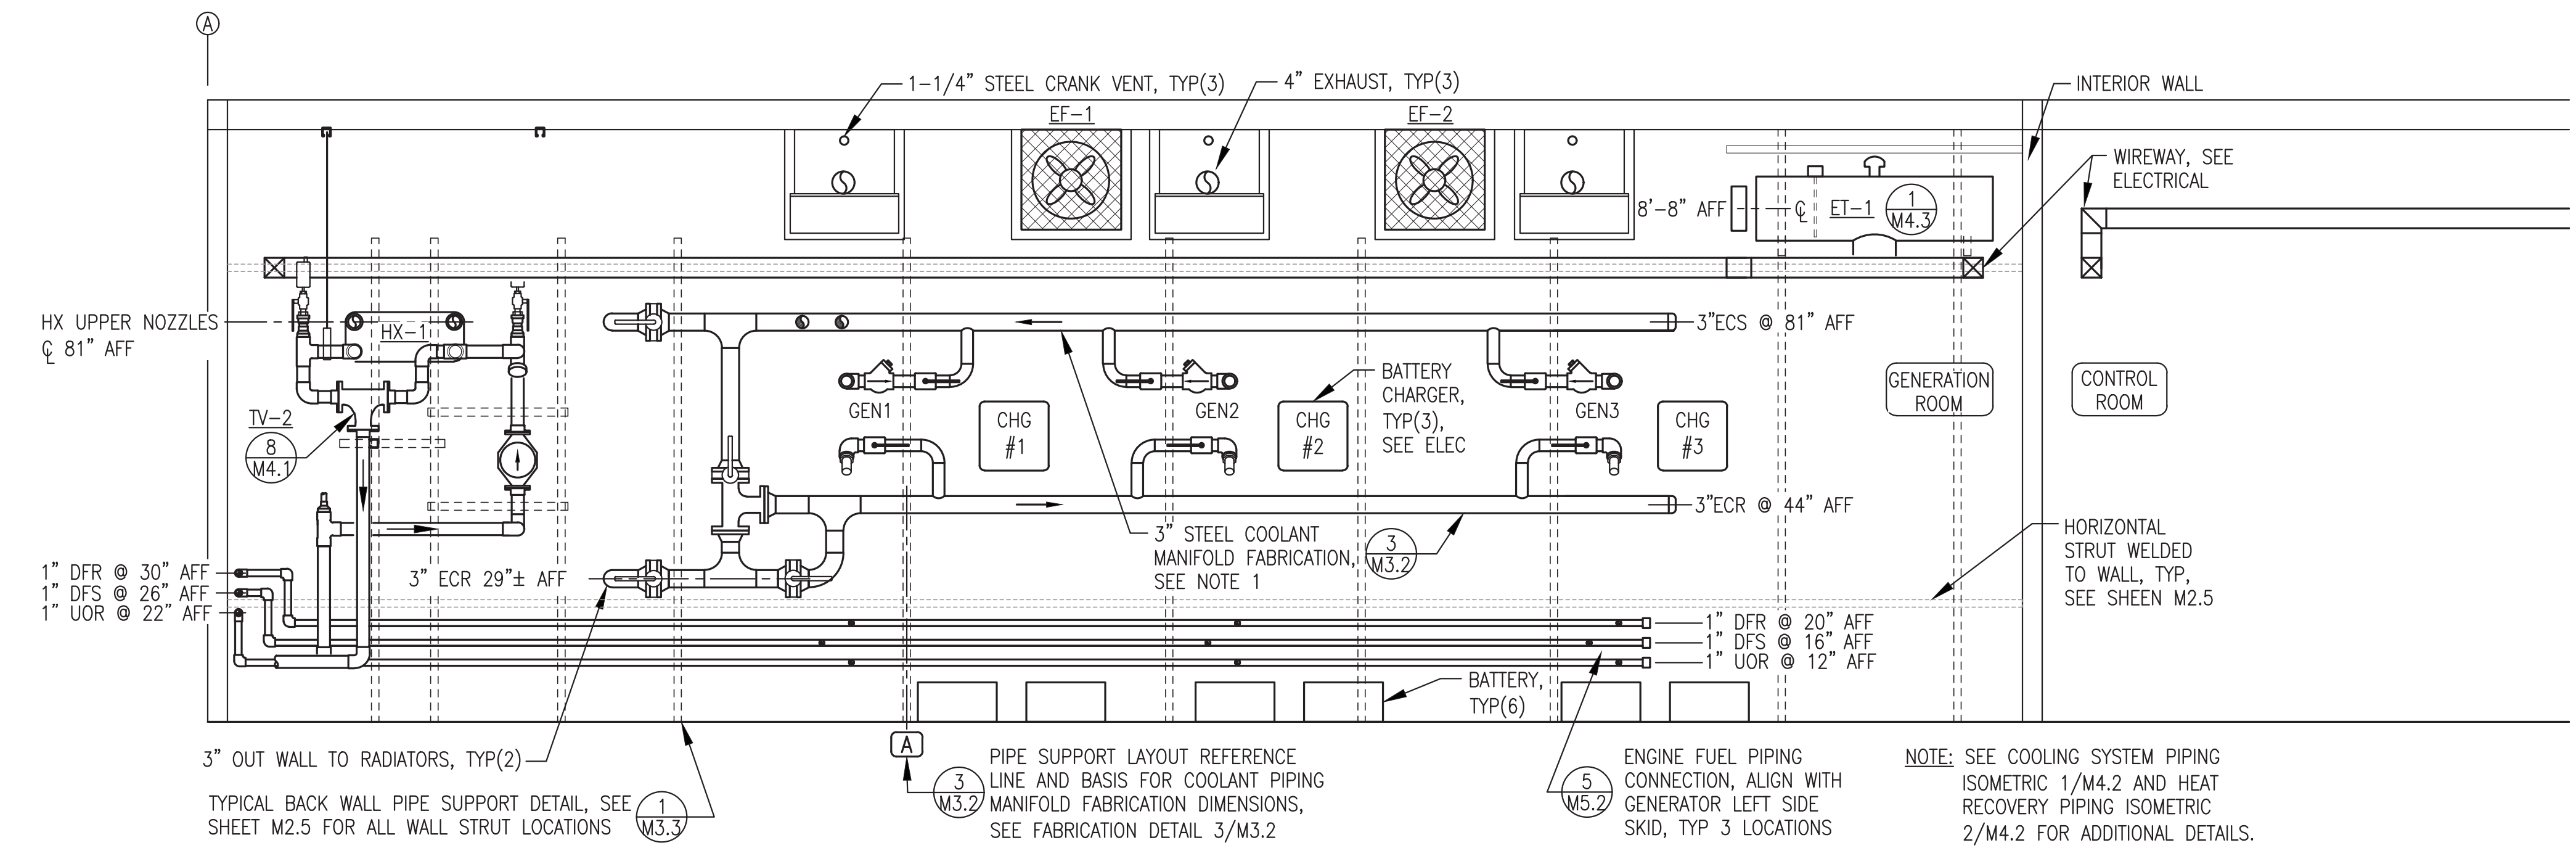

**1** BACK WALL ELEVATION  
M3.2 1/2"=1'-0"

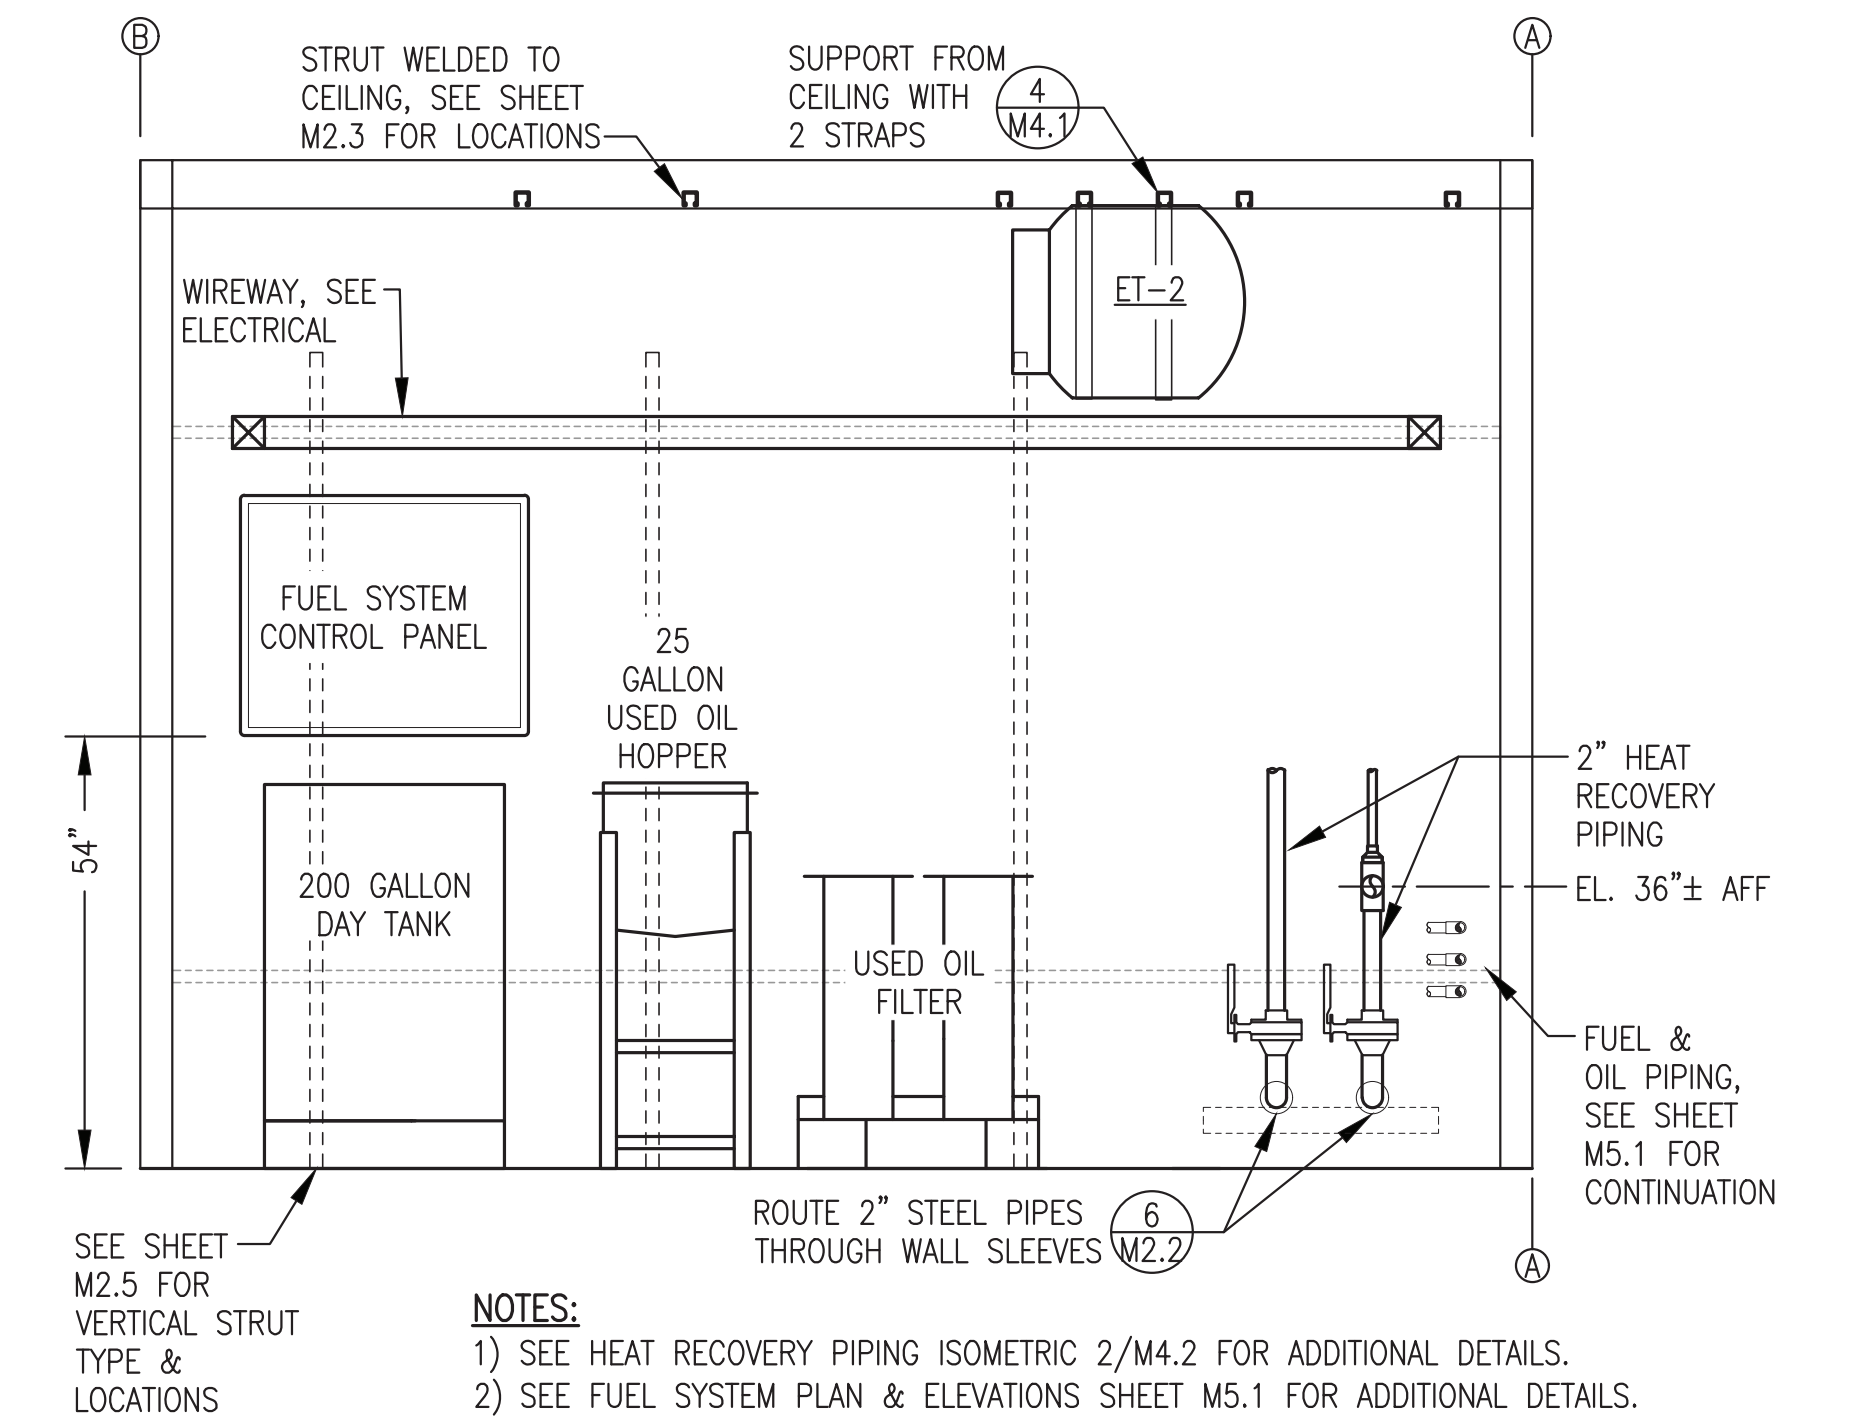

**2** END WALL ELEVATION  
M3.2 1/2"=1'-0"

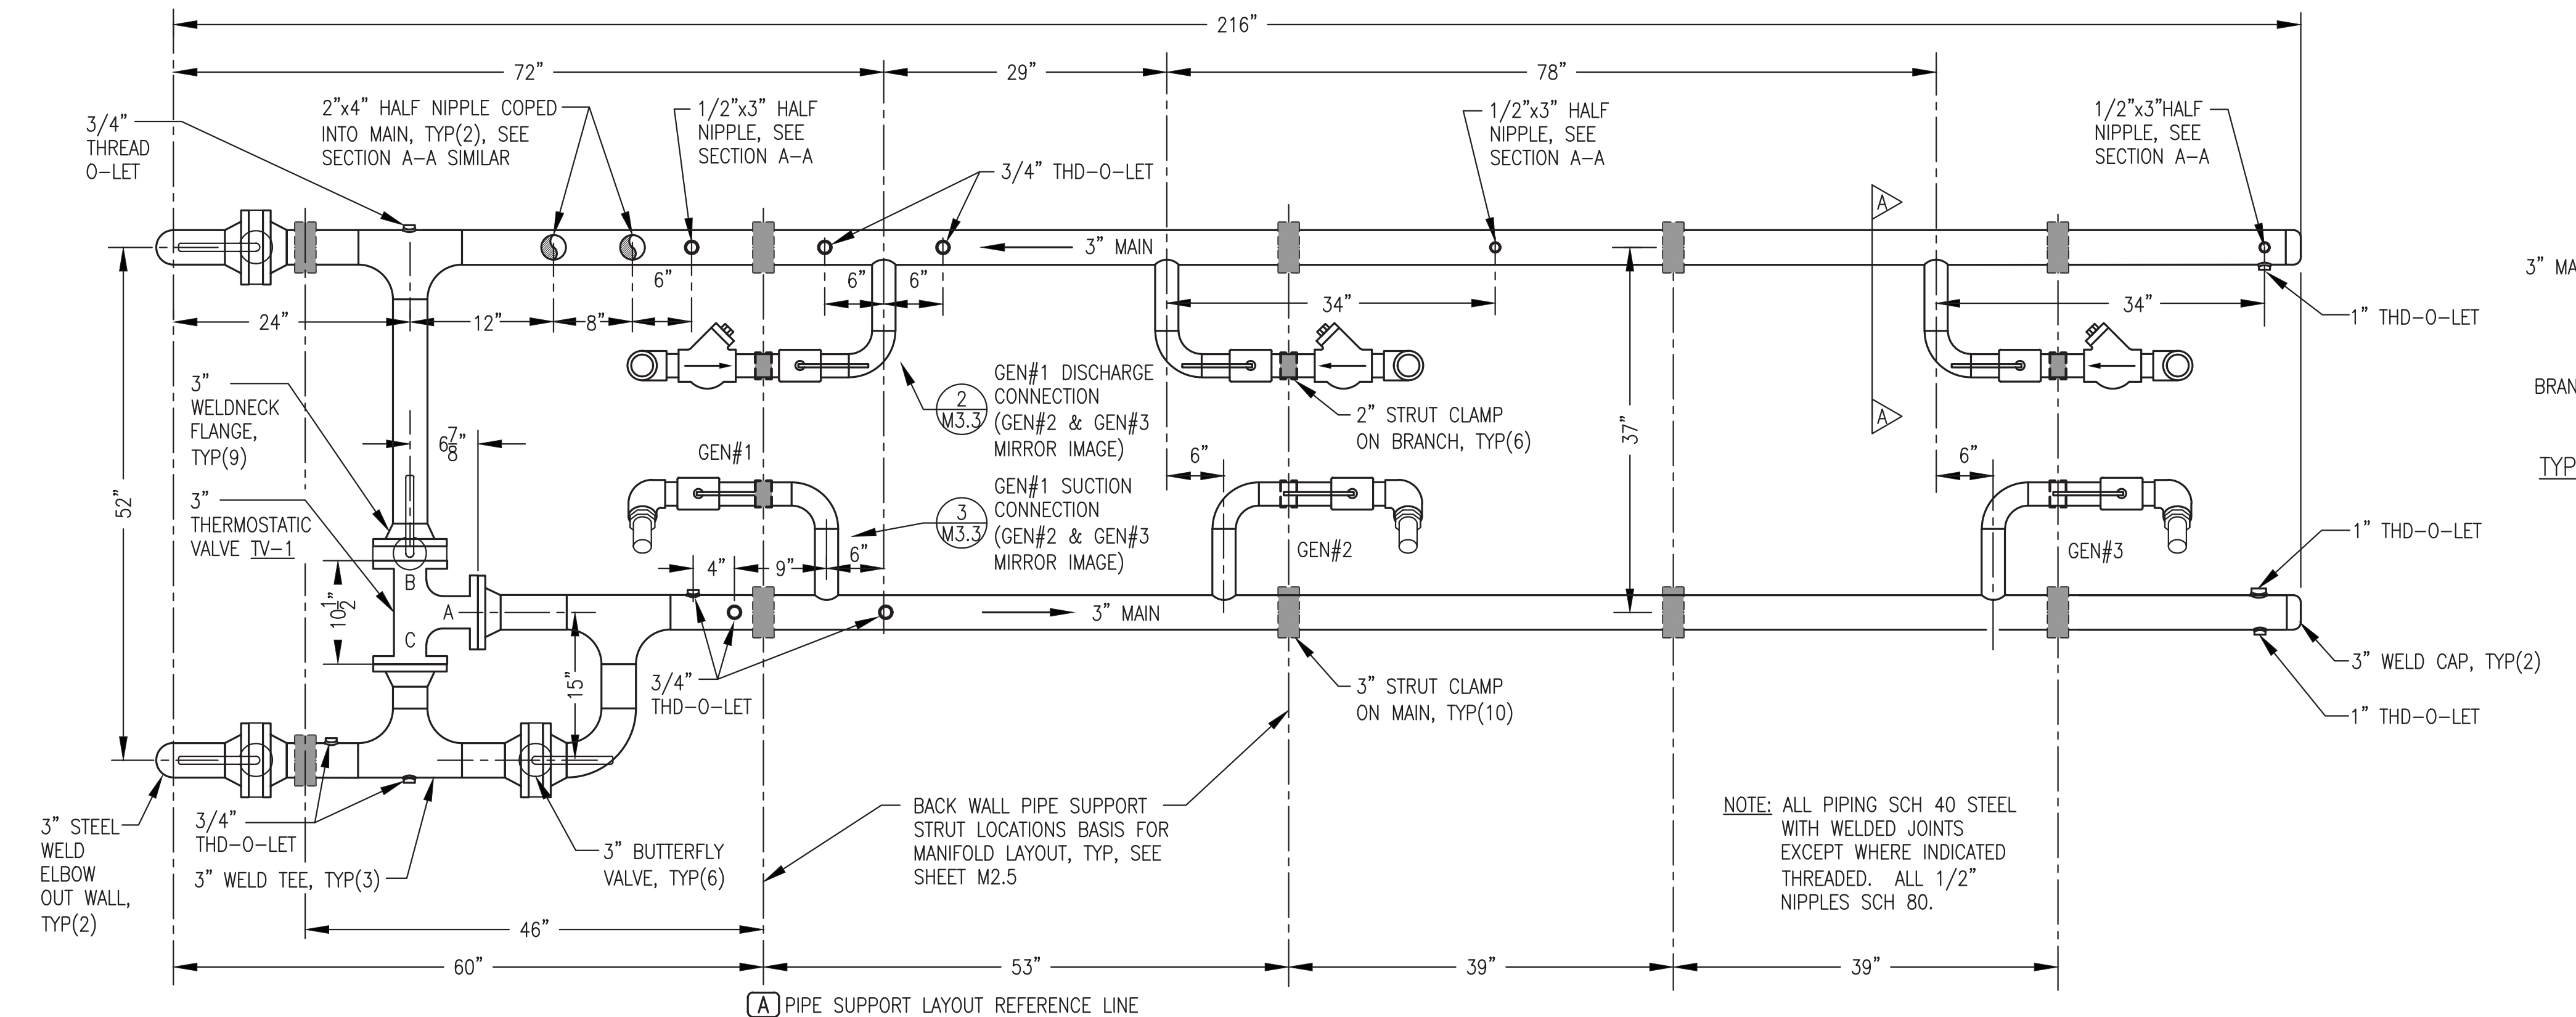



**3** COOLANT MANIFOLD ENLARGED FABRICATION DETAIL  
M3.2 1"=1'-0"

ALL WORK ON THIS SHEET WAS PERFORMED AS PART OF THE PRIOR MODULE ASSEMBLY CONTRACT AND IS SHOWN HERE FOR REFERENCE ONLY.


1	DELETE FLOW METER, DELETE BUTTERFLY VALVES FROM TV-1 PORTS A & C	8/16/23	BCG
REV.	DESCRIPTION	DATE	BY
PROJECT: NELSON LAGOON POWER SYSTEM UPGRADE			
TITLE: WALL ELEVATIONS & PIPING DETAILS			
DRAWN BY: JTD		SCALE: AS NOTED	
DESIGNED BY: BCG		DATE: 5/30/23	
FILE NAME: NELS_PP_M2-M7		SHEET: M3.2	
PROJECT NUMBER:			

REV#1  
ISSUED FOR  
CONSTRUCTION  
AUGUST 2023

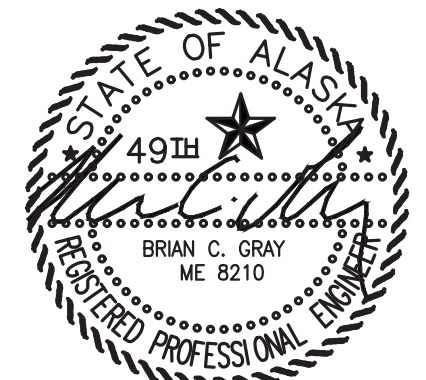


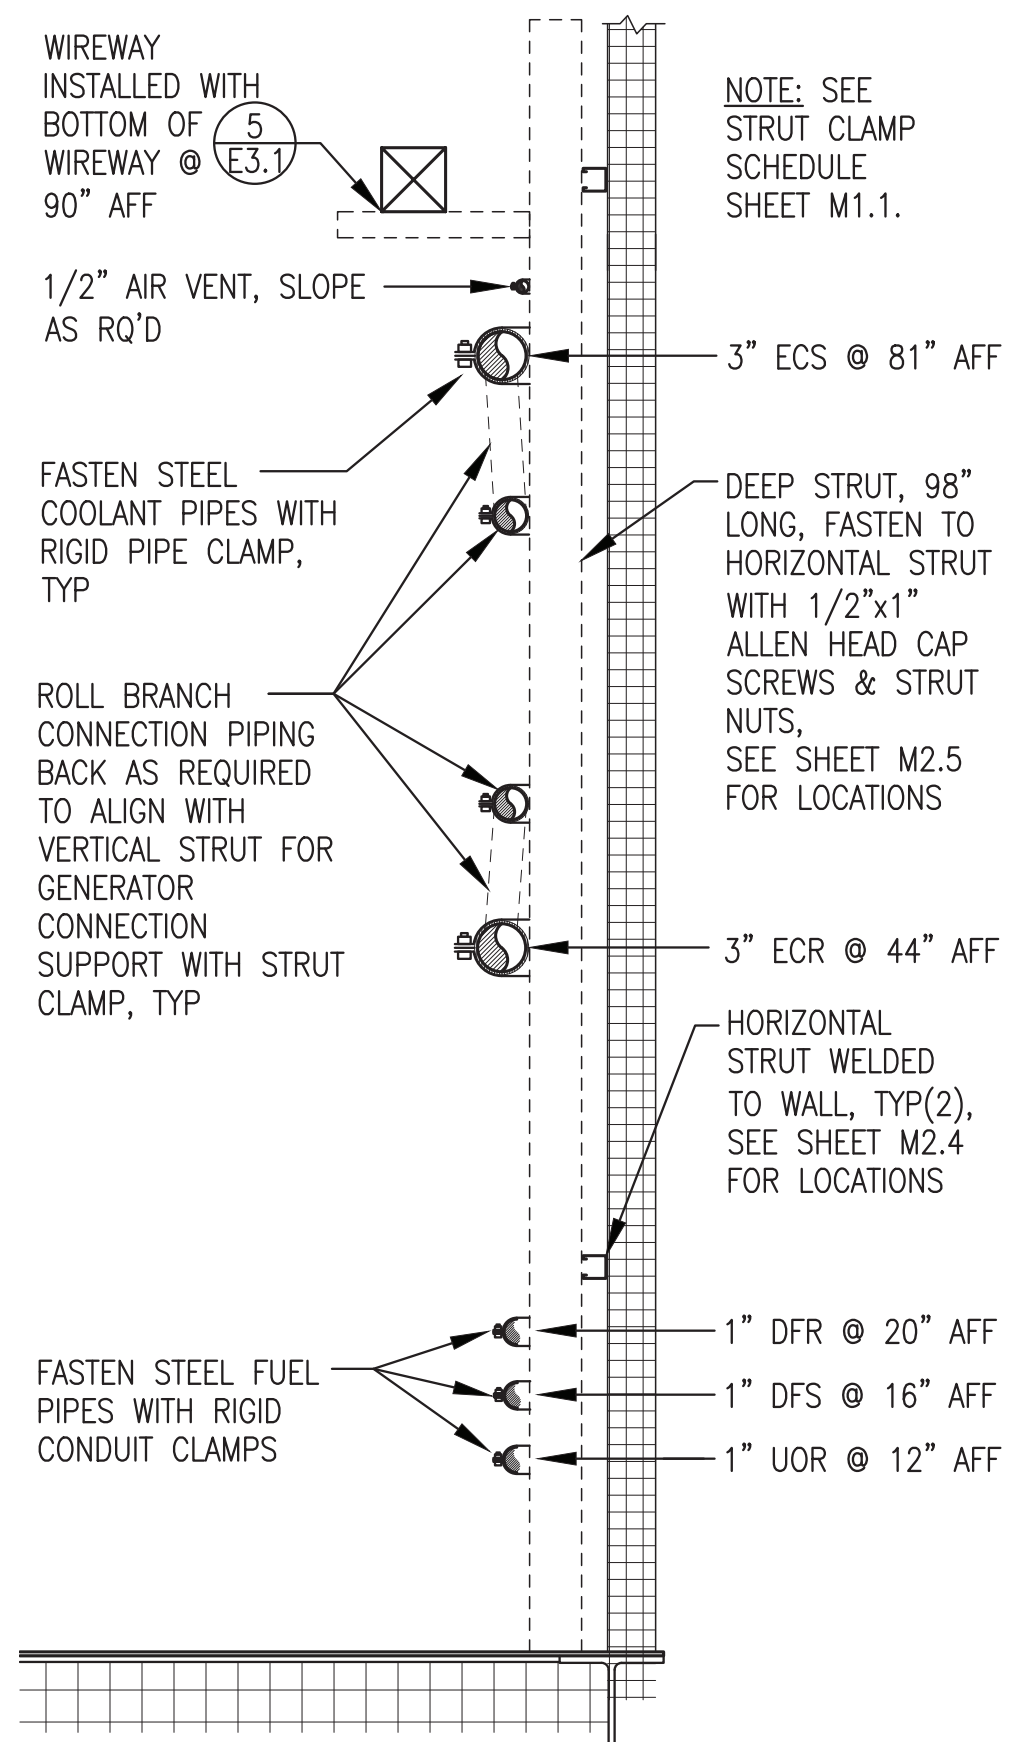

NOTE: SEE STRUT CLAMP SCHEDULE SHEET M1.1.

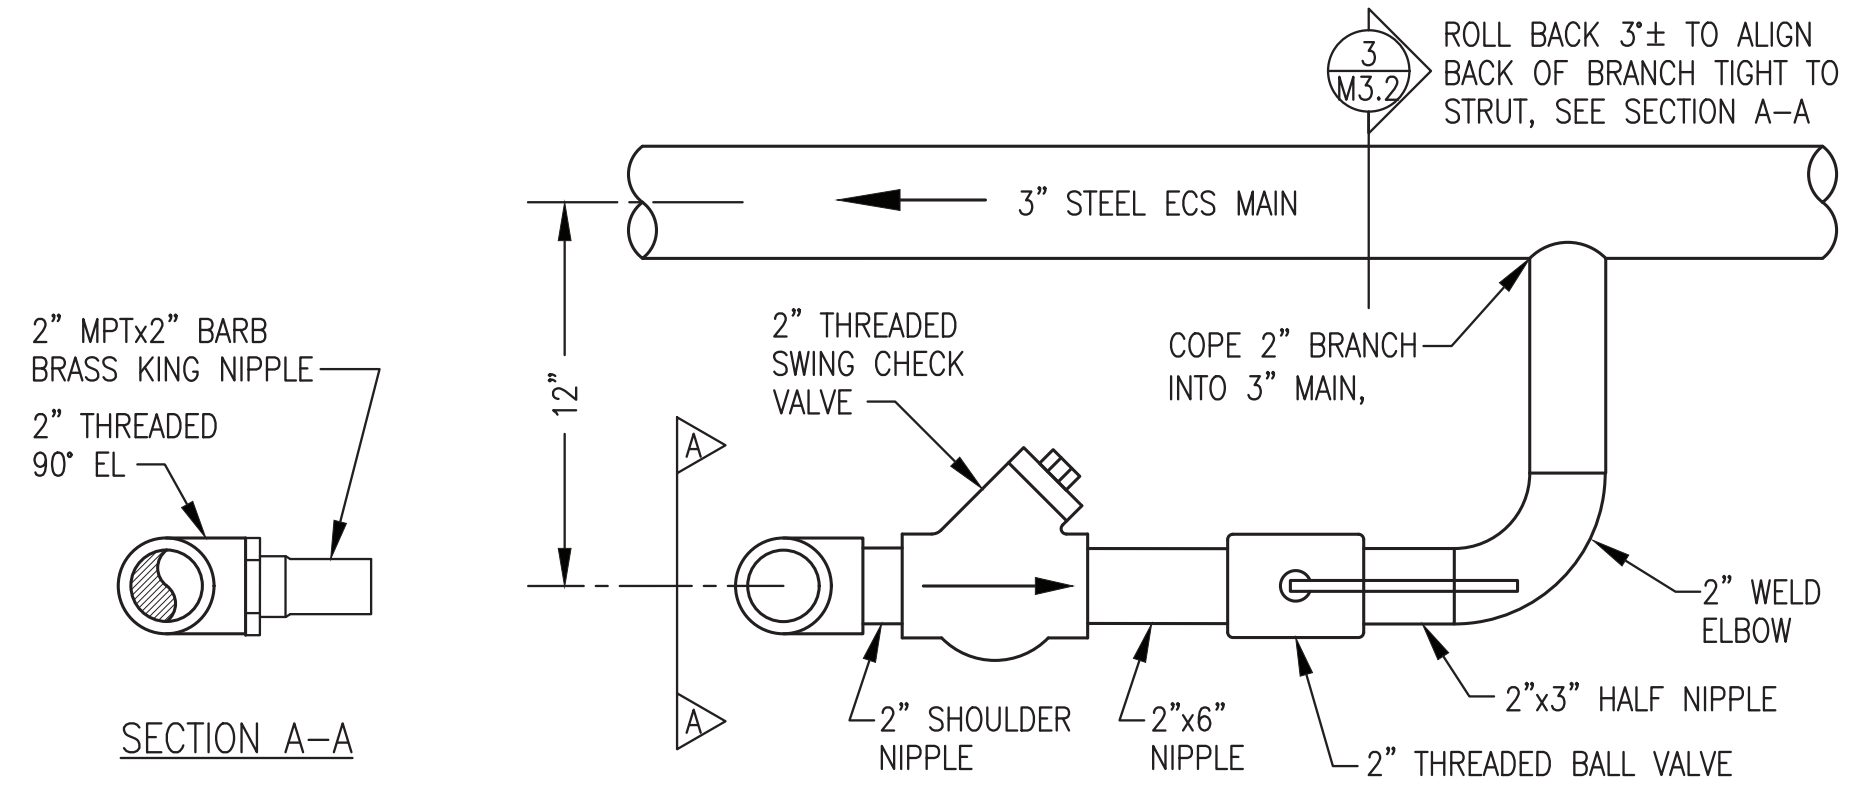

NOTES:  
 1) GEN#1 DISCHARGE CONNECTION SHOWN, GEN#2 & GEN#3 MIRROR IMAGE  
 2) MAIN PIPING 3\"/>

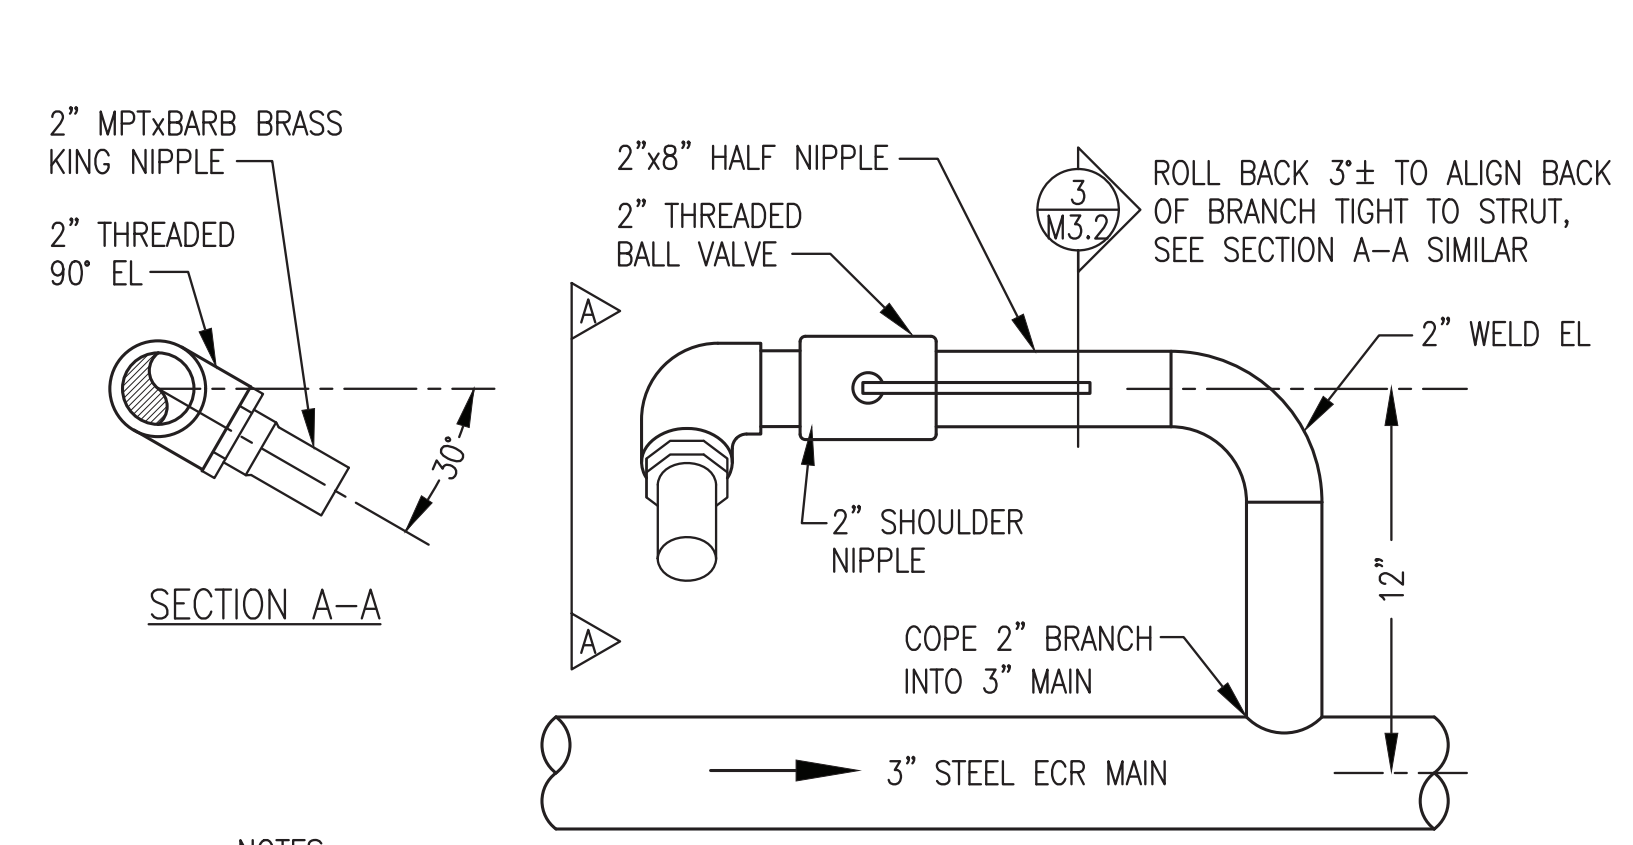


NOTES:  
 1) GEN#1 SUCTION CONNECTION SHOWN, GEN#2 & GEN#3 MIRROR IMAGE  
 2) MAIN PIPING 3\"/>

1 TYPICAL PIPE SUPPORT AT BACK WALL  
 M3.3 1\"/>

2 GEN#1 DISCHARGE CONNECTION (GEN#2 & GEN#3 MIRROR IMAGE)  
 M3.3 NO SCALE

3 GEN#1 SUCTION CONNECTION (GEN#2 & GEN#3 MIRROR IMAGE)  
 M3.3 NO SCALE

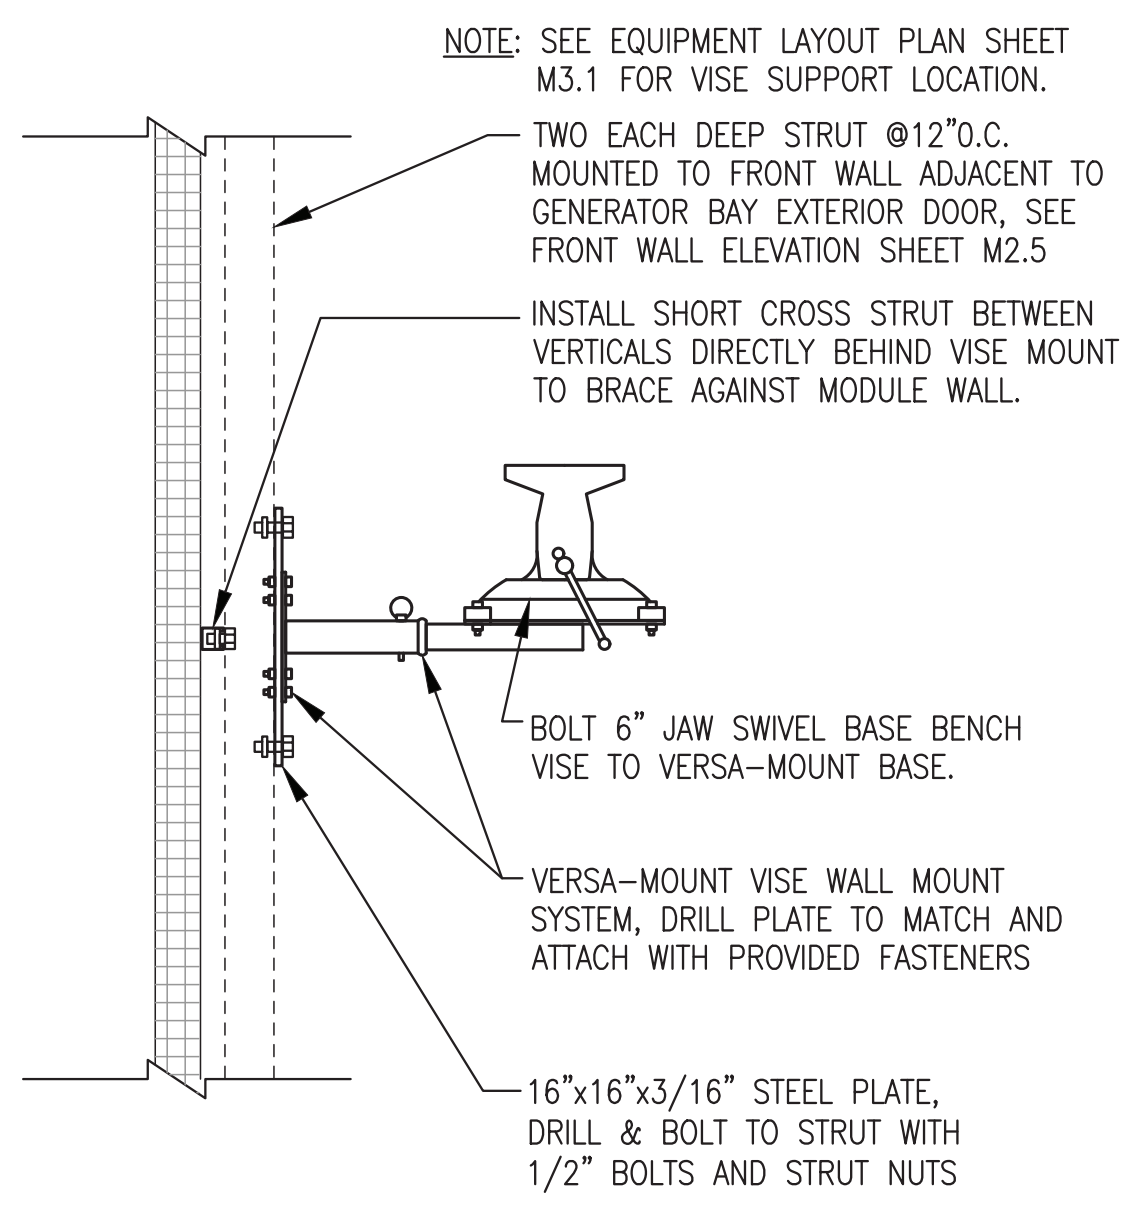


4 REMOVABLE BENCH VISE INSTALLATION  
 M3.3 NO SCALE

ALL WORK ON THIS SHEET WAS PERFORMED AS PART OF THE PRIOR MODULE ASSEMBLY CONTRACT AND IS SHOWN HERE FOR REFERENCE ONLY.


ISSUED FOR CONSTRUCTION  
 MAY 2023




PROJECT: NELSON LAGOON POWER SYSTEM UPGRADE		
TITLE: MECHANICAL DETAILS		
	DRAWN BY: JTD	SCALE: AS NOTED
	DESIGNED BY: BCG	DATE: 5/30/23
	FILE NAME: NELS_PP_M2-M7	SHEET: <b>M3.3</b>
P.O. 111405, Anchorage, AK 99511 (907)349-0100		

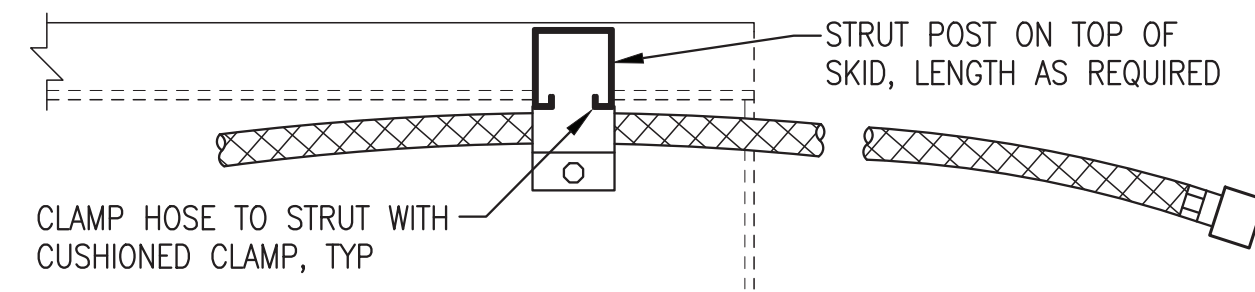

LEFT SKID PLAN (TOP) VIEW

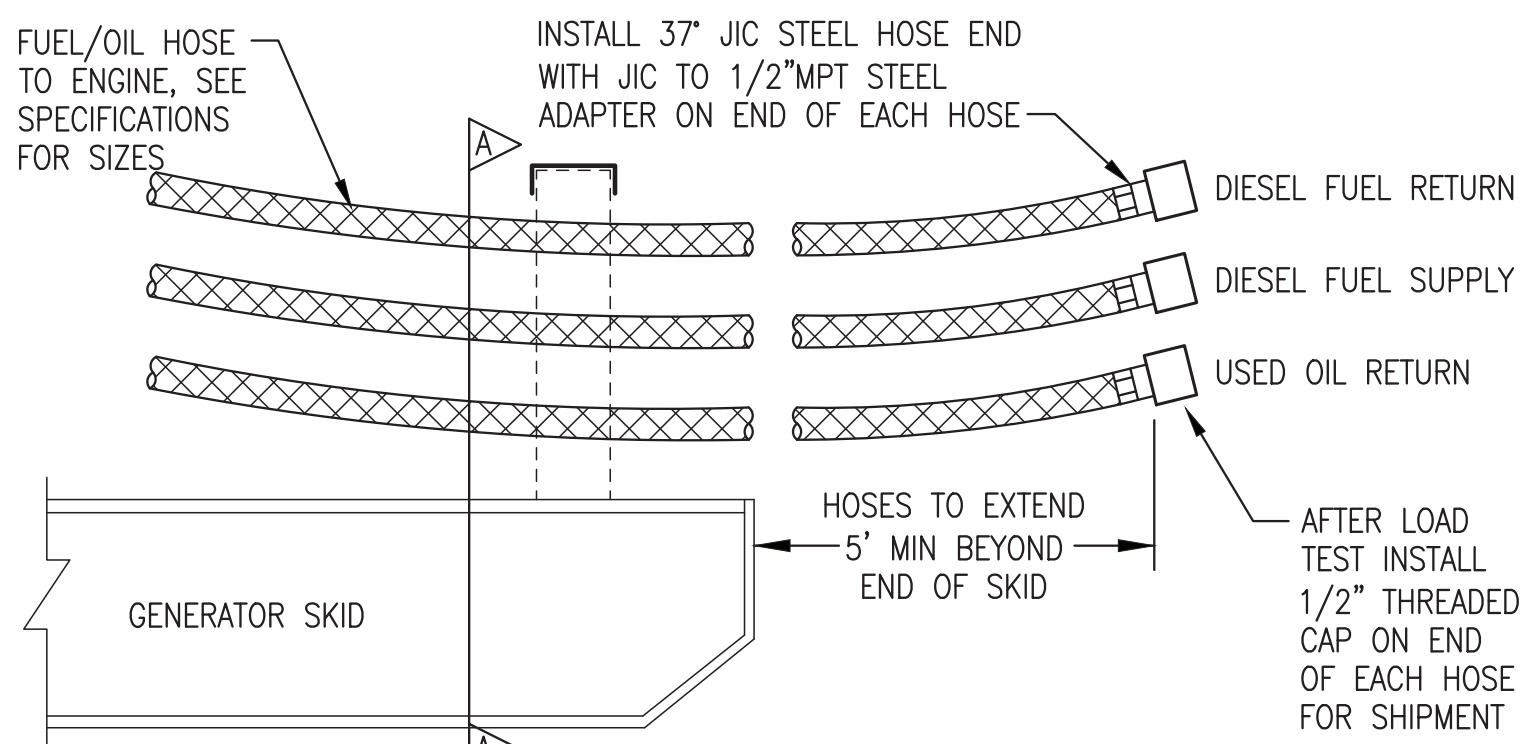


ELEVATION (SIDE) VIEW

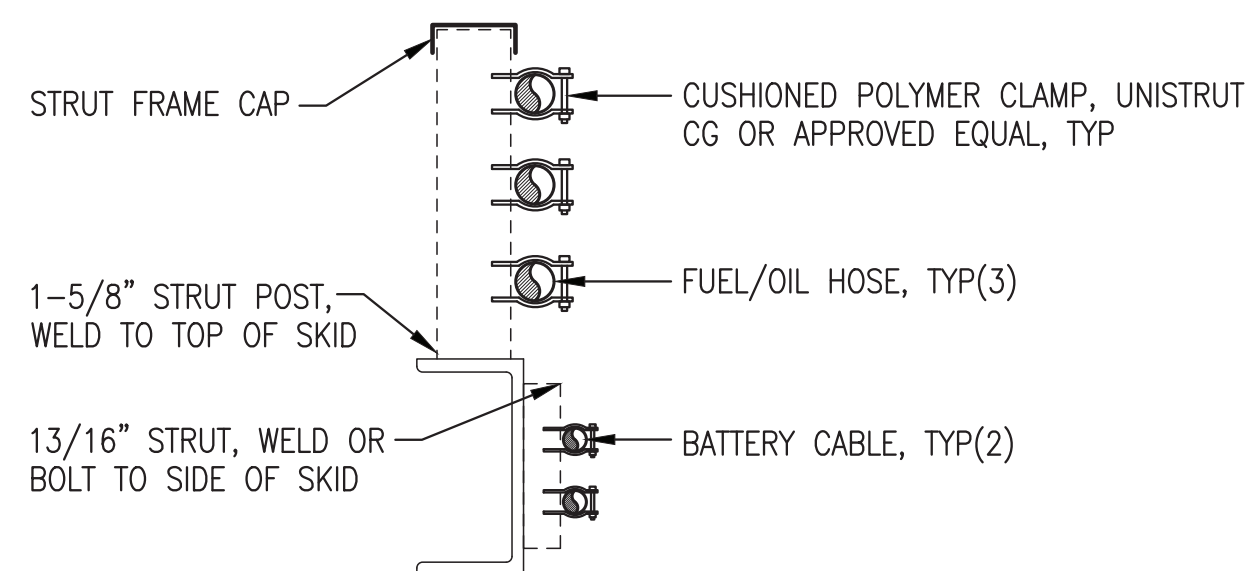


SECTION A-A

NOTE:  
GROUP HOSES ON LEFT SKID AS SHOWN TO COORDINATE WITH COOLANT HOSES ABOVE.


1 FUEL/OIL HOSE & BATTERY CABLE INSTALLATION  
M3.4 NO SCALE

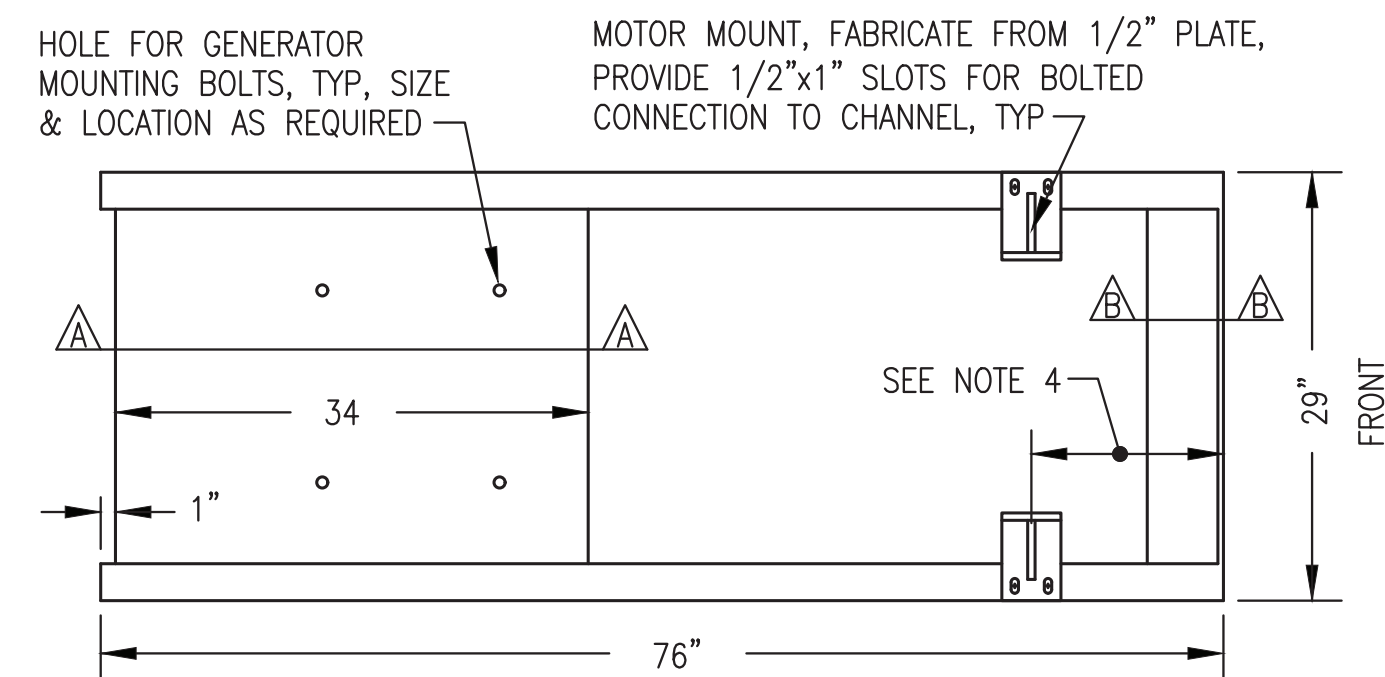


PLAN (TOP) VIEW

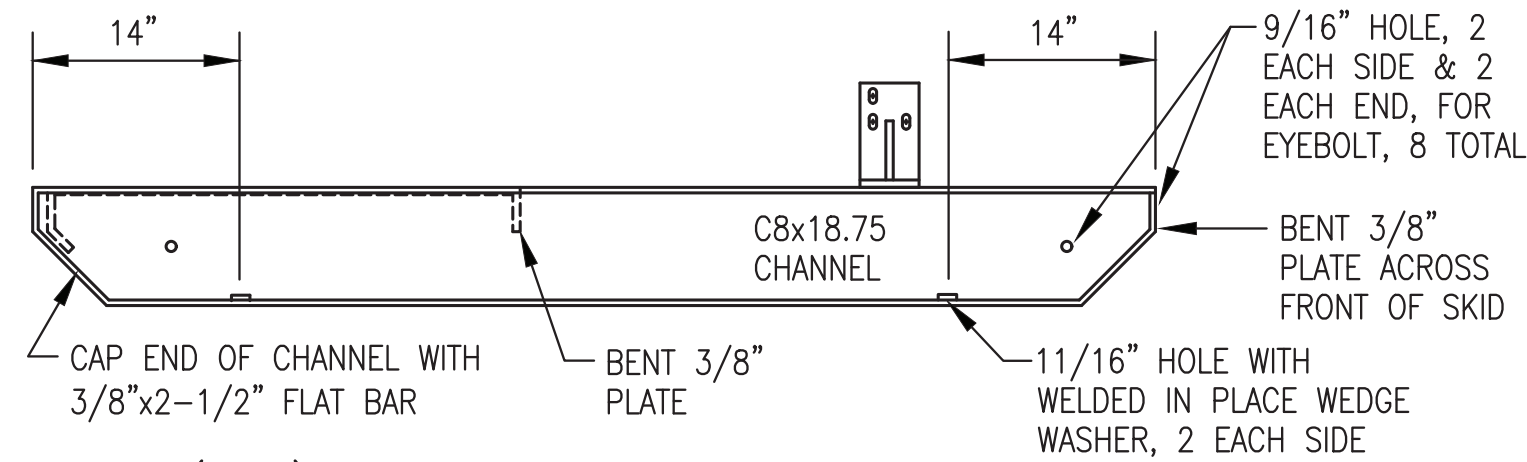

ELEVATION (SIDE) VIEW

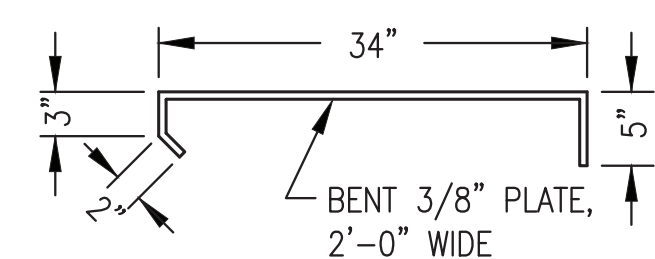

SECTION A-A

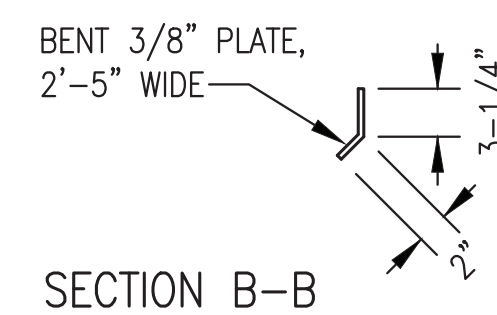


SECTION B-B

NOTES:

- 1) FABRICATE FROM ASTM A-36 STEEL. BEND PLATES & CUT ENDS OF CHANNELS AT 90° & 45° AS SHOWN.
- 2) EXCEPT WHERE INDICATED AS BOLTED MAKE ALL CONNECTIONS WITH CONTINUOUS WELDS (FILLET OR FULL-PENETRATION GROOVE AS REQUIRED) IN ACCORDANCE WITH CURRENT AWS STANDARD CODE.
- 3) ROUND ALL CORNERS & GRIND WELDS SMOOTH AFTER FABRICATION. PAINT TO MATCH ENGINE-GENERATOR.
- 4) PLACE UNIT ON SKID SO THAT THE EXHAUST RISER CENTERLINE IS 39" FROM THE FRONT OF THE SKID.


2 TYPICAL GENERATOR SKID FABRICATION  
M3.4 NO SCALE

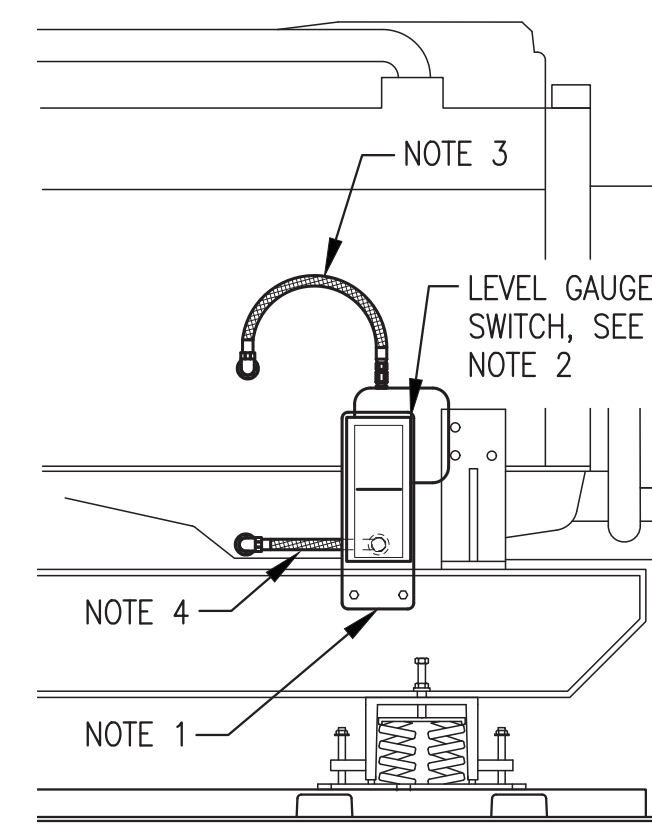

NOTES:

- 1) 1/4" STEEL SUPPORT PLATE PRE-DRILLED TO MATCH GAUGE/SWITCH MOUNTS AND BOTTOM HOSE ENTRANCE. BOLT TO INSIDE (BACK) OF CHANNEL SKID AT HEIGHT AS REQUIRED TO CENTER GAUGE AT NORMAL FULL OIL LEVEL.
- 2) MOUNT OIL LEVEL GAUGE/SWITCH TO STEEL SUPPORT PLATE WITH RUBBER SHOCK MOUNTS. ADJUST SWITCH CONTACTS TO 1/2" ABOVE AND BELOW NORMAL FULL LEVEL. PAINT MARK A RED LINE AT BOTH SWITCH LEVELS.
- 3) CONNECT TOP (VENT) PORT TO ENGINE CRANK CASE WITH #8 HOSE WITH 1/2" OR 3/8" NPT JIC SWIVEL ENDS. ROUTE UPPER HOSE WITH HIGH POINT 4" MIN ABOVE TOP OF GAUGE.
- 4) CONNECT BOTTOM PORT TO ENGINE OIL PAN WITH #8 HOSE WITH 1/2" OR 3/8" NPT JIC SWIVEL ENDS. DO NOT TEE INTO OIL DRAIN LINE. ROUTE LOWER HOSE BACK THROUGH PRE-DRILLED HOLE IN STEEL PLATE.


3 TYPICAL OIL LEVEL GAUGE/SWITCH INSTALLATION  
M3.4 NO SCALE

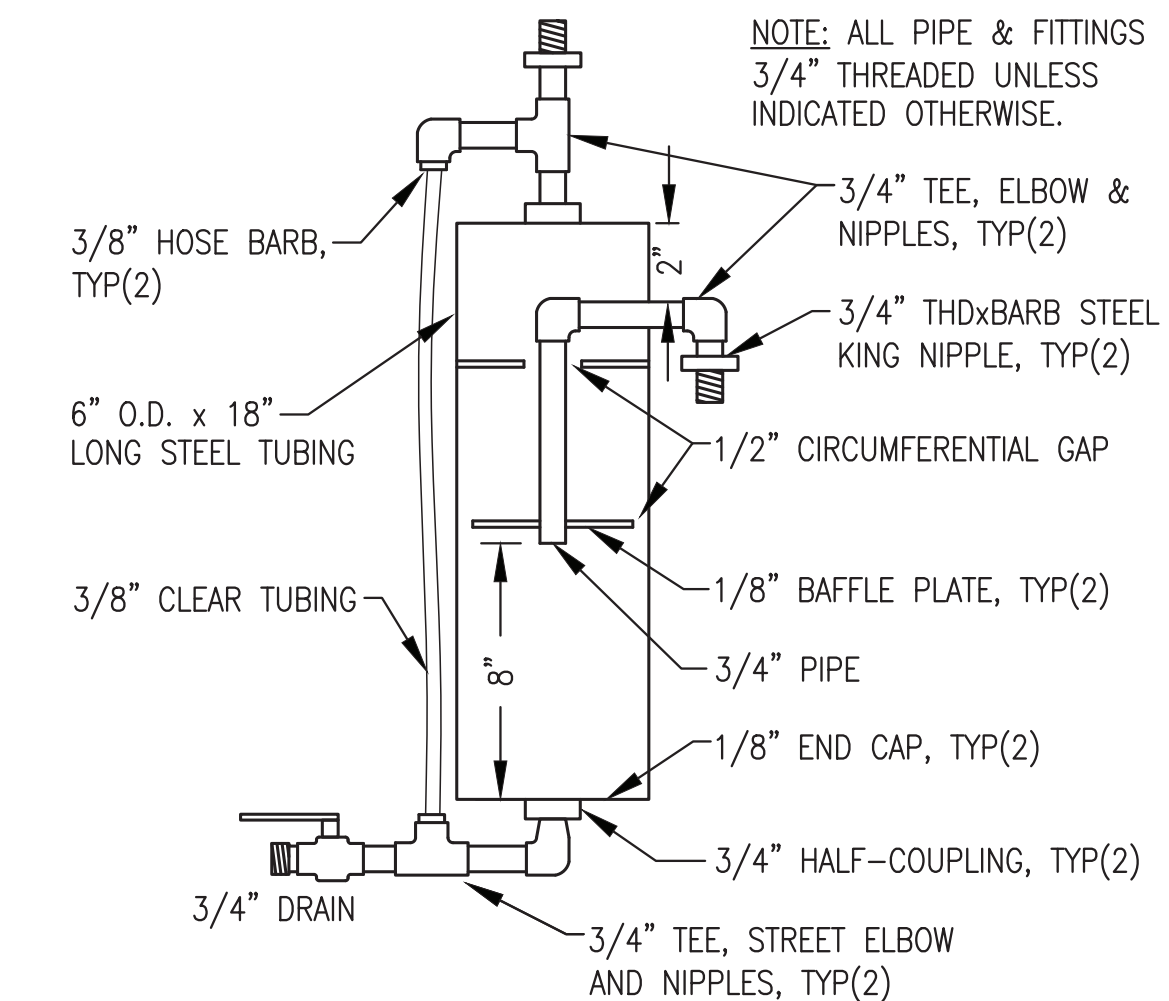

4 CONDENSATE TRAP FABRICATION  
M3.4 NO SCALE




ALL WORK ON THIS SHEET WAS PERFORMED AS PART OF THE PRIOR MODULE ASSEMBLY CONTRACT AND IS SHOWN HERE FOR REFERENCE ONLY.

ISSUED FOR CONSTRUCTION  
MAY 2023

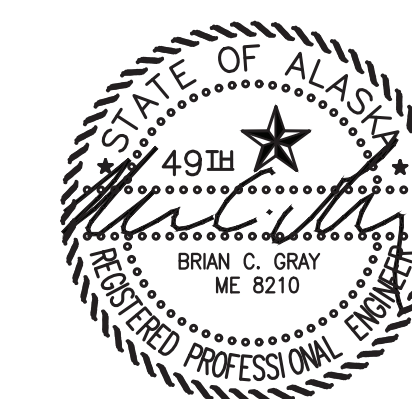


PROJECT: NELSON LAGOON POWER SYSTEM UPGRADE		
TITLE: GENERATOR FABRICATION DETAILS		
DRAWN BY: JTD	SCALE: AS NOTED	
DESIGNED BY: BCG	DATE: 5/30/23	
FILE NAME: NELS_PP_M2-M7	SHEET:	M3.4
PROJECT NUMBER:		




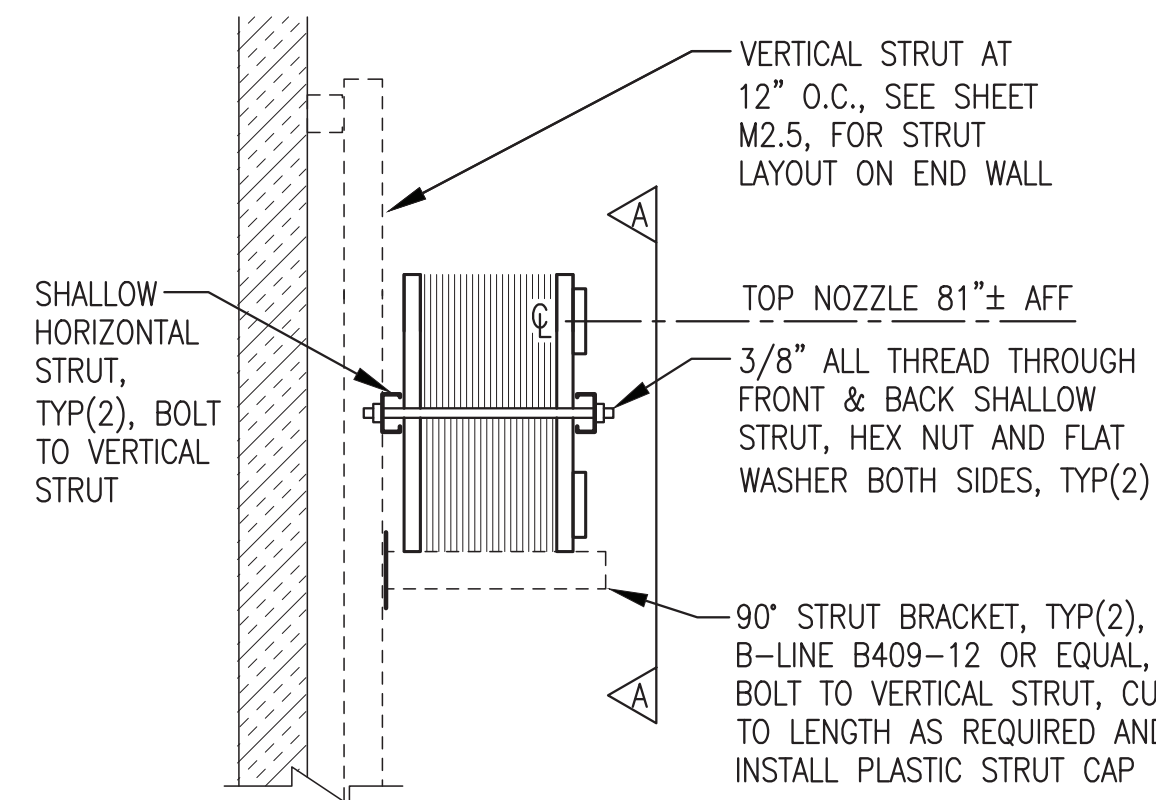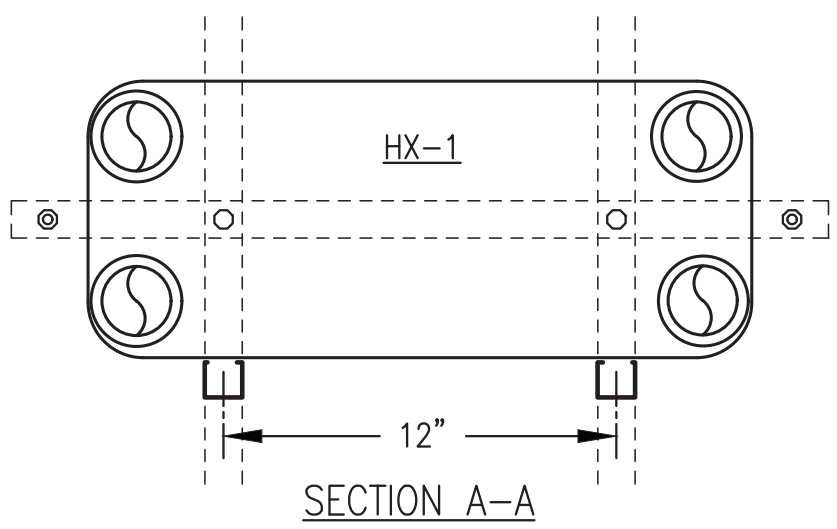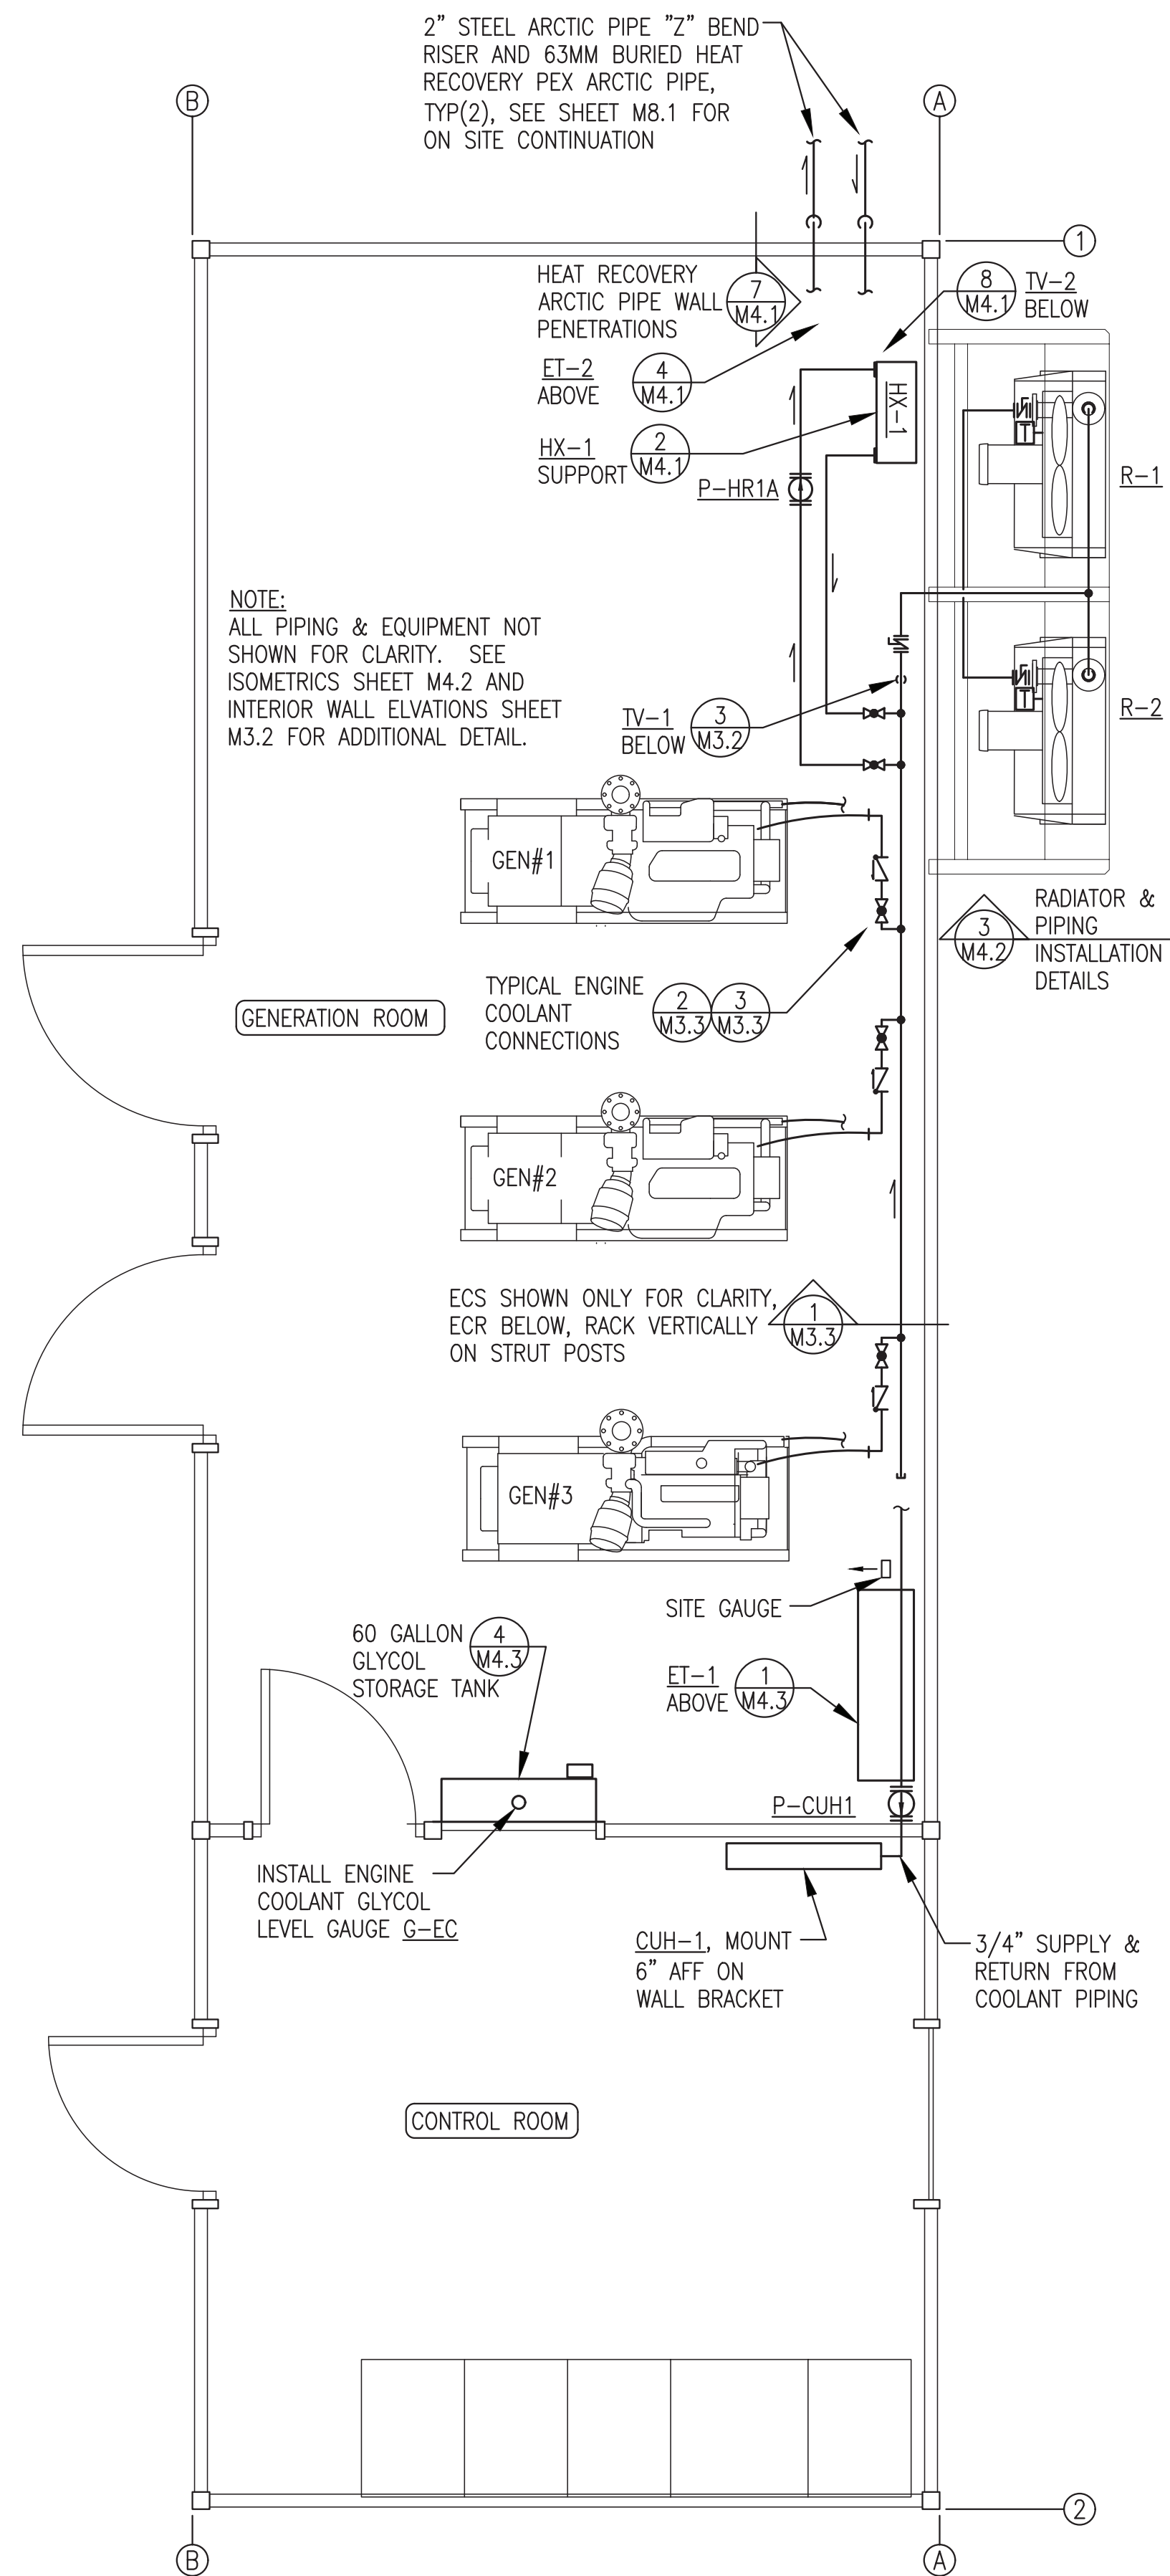

2 HEAT EXCHANGER HX-1 SUPPORT FROM WALL  
M4.1 NO SCALE

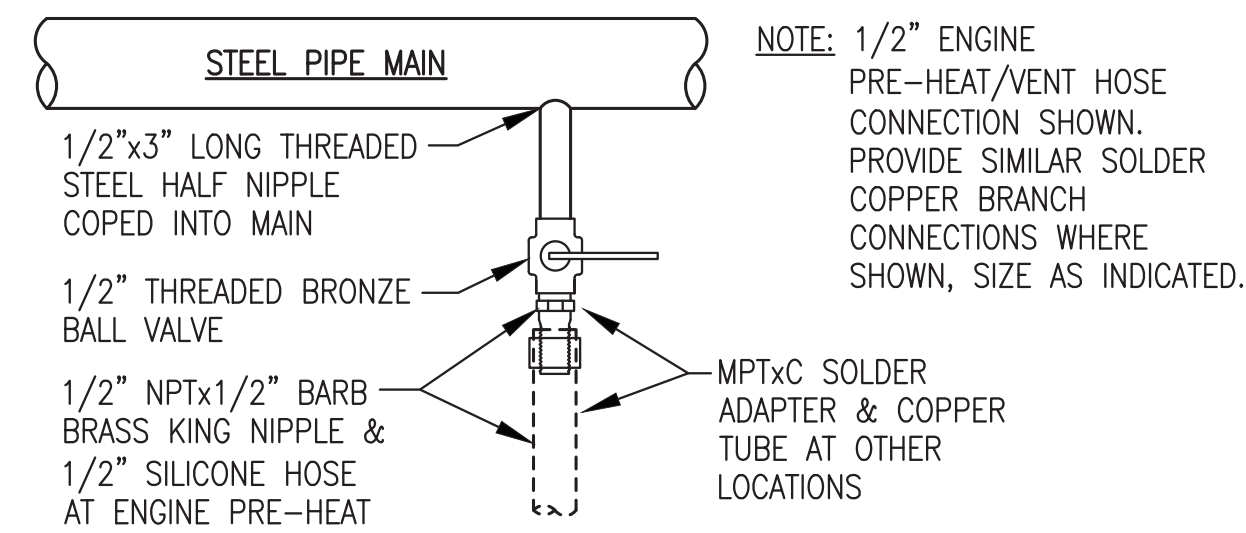


5 TYP VALVED BRANCH CONNECTION TO STEEL MAIN  
M4.1 NO SCALE

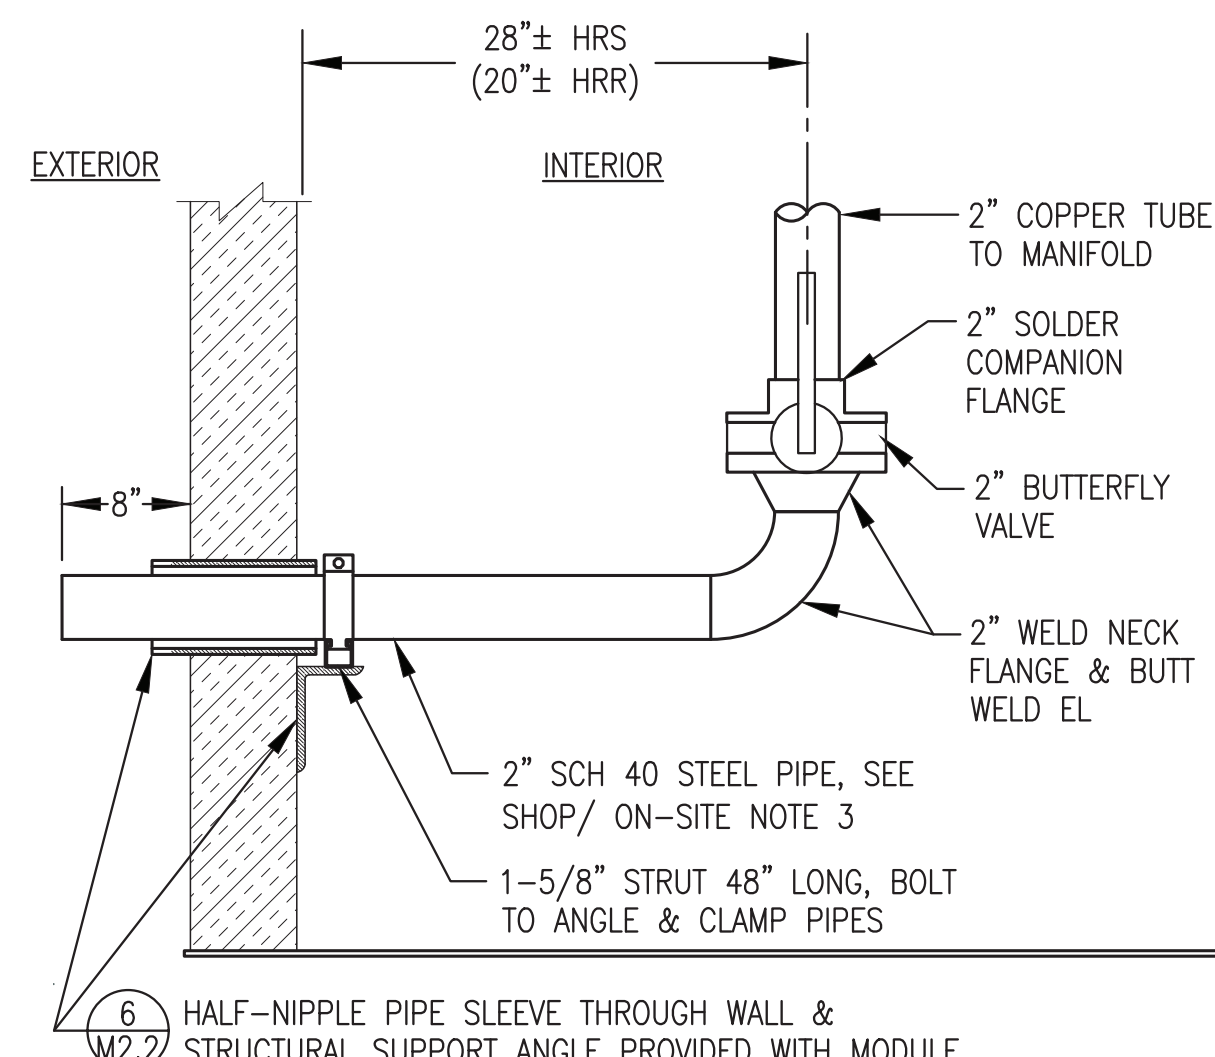


7 HEAT RECOVERY ARCTIC PIPE WALL PENETRATIONS  
M4.1 NO SCALE

HX CONNECTION NOTES:

- 1) PROVIDE MINIMUM 9" LONG STRAIGHT COPPER TUBE SECTION BETWEEN ALL HEAT EXCHANGER NOZZLES AND FIRST SOLDER FITTING TO ALLOW FUTURE INSTALLATION OF NON-DIMPLED REPAIR COUPLING FOR HEAT EXCHANGER TEMPORARY REMOVAL AND/OR REPLACEMENT.

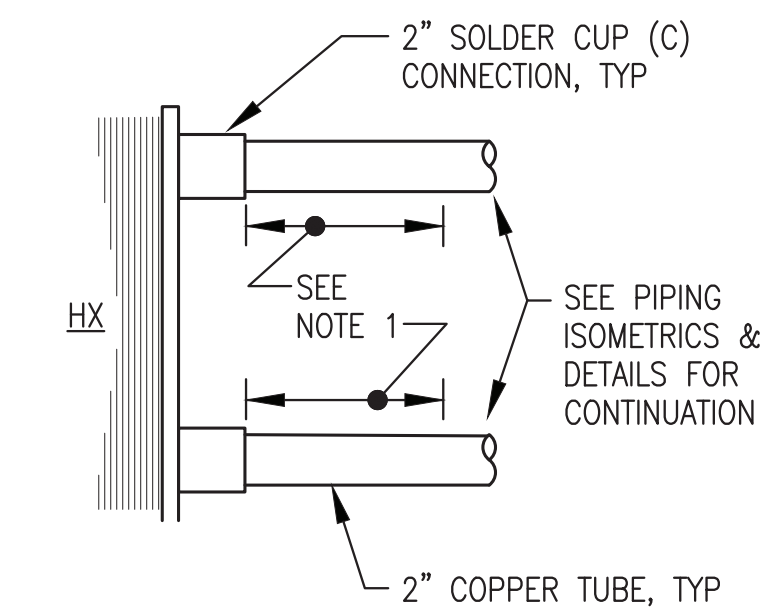


3 TYPICAL HX PIPING CONNECTION  
M4.1 NO SCALE

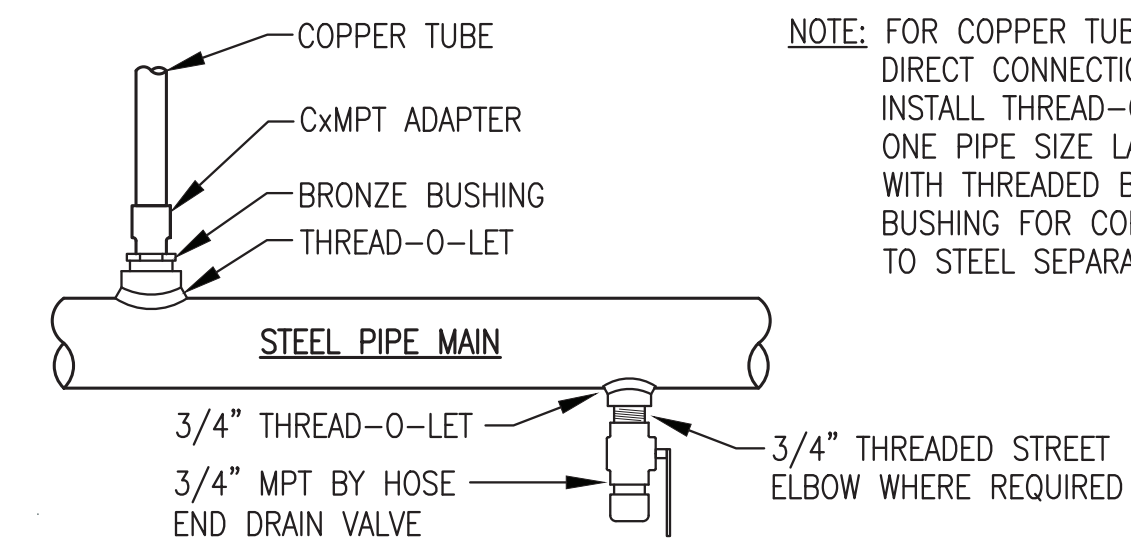

NOTE: FOR COPPER TUBE DIRECT CONNECTION INSTALL THREAD-0-LET ONE PIPE SIZE LARGER WITH THREADED BRONZE BUSHING FOR COPPER TO STEEL SEPARATION.


6 TYP DIRECT CONNECTION TO STEEL MAIN  
M4.1 NO SCALE

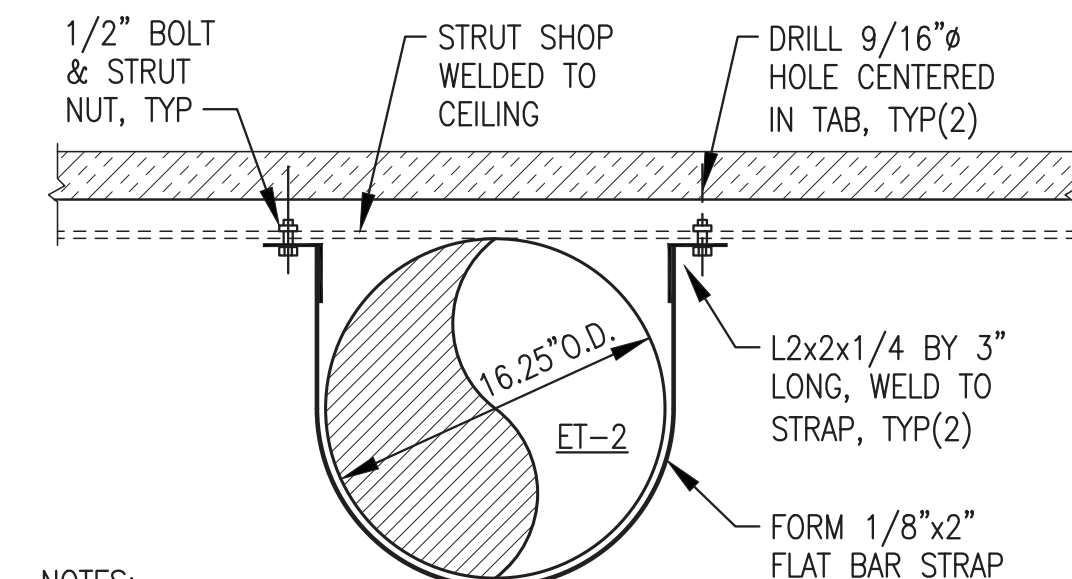

NOTES:

- 1) SMOOTH EDGES AFTER FABRICATION, WIRE BRUSH, SOLVENT CLEAN, AND PAINT WITH TWO COATS OF COLD GALVANIZING COMPOUND.
- 2) ONE STRAP SHOWN. INSTALL FOUR IDENTICAL STRAPS.

4 HEAT RECOVERY EXP TANK ET-2 SUPPORT  
M4.1 NO SCALE

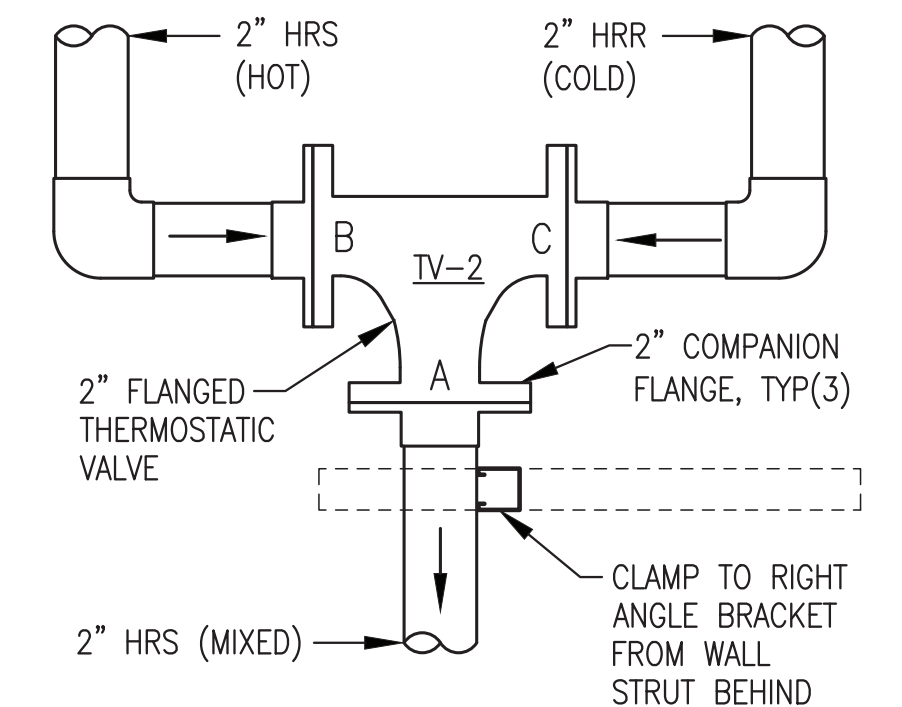

8 TV-2 INSTALLATION  
M4.1 NO SCALE

ARCTIC PIPE GENERAL NOTES:

- 1) SEE END WALL ELEVATION 2/M3.2 FOR PIPE WALL PENETRATION LAYOUT.
- 2) ONE PIPE SHOWN. PROVIDE TWO SIMILAR.

ARCTIC PIPE SHOP/ON-SITE NOTES:

- 1) SHOP INSTALLATION SHOWN. STUB PIPE 8" MIN BEYOND WALL & TEMPORARILY CONNECT SUPPLY TO RETURN FOR TESTING.
- 2) AFTER TESTING REMOVE TEMPORARY CONNECTION, BREAK FLANGE JOINT, AND STORE PIPE IN MODULE. INSTALL THREADED PIPE CAP FOR SHIPPING.
- 3) AS PART OF ON-SITE INSTALLATION REMOVE THREADED PIPE CAP, REINSTALL PIPE THROUGH WALL AND CONNECT TO ARCTIC PIPE, SEE SHEET M8.
- 4) SHOP INSULATE COPPER TUBE UP TO BUTTERFLY VALVE. SHOP CUT & FIT INSULATION & JACKET FOR STEEL PIPE TO WALL BUT SHIP LOOSE FOR FIELD INSTALLATION.

ISSUED FOR CONSTRUCTION  
MAY 2023



ALL WORK ON THIS SHEET WAS PERFORMED AS PART OF THE PRIOR MODULE ASSEMBLY CONTRACT EXCEPT AS SPECIFICALLY INDICATED IN THE SHOP/ON SITE NOTES.



PROJECT: NELSON LAGOON POWER SYSTEM UPGRADE	
TITLE: COOLANT & HEAT RECOVERY PIPING PLAN & DETAILS	
DRAWN BY: JTD	SCALE: AS NOTED
DESIGNED BY: BCG	DATE: 5/30/23
FILE NAME: NELS PP M2-M7	SHEET: M4.1
PROJECT NUMBER:	

1 COOLANT AND HEAT RECOVERY PIPING PLAN  
M4.1 3/8"=1'-0"

**COOLING SYSTEM ISOMETRIC NOTES:**


- 1) ALL PIPING SHOWN THIS ISOMETRIC 4" SCH 40 STEEL WITH WELDED JOINTS UNLESS SPECIFICALLY INDICATED OTHERWISE, SEE DETAIL 3/M3.2 FOR COOLING MANIFOLD DETAILS. ALL ENGINE BRANCH CONNECTIONS SCH 40 STEEL WITH WELDED AND THREADED JOINTS. ALL OTHER PIPE SHOWN THIS ISOMETRIC TYPE "L" HARD DRAWN COPPER WITH SOLDER JOINTS UNLESS SPECIFICALLY INDICATED OTHERWISE.
- 2) SEE COOLANT MANIFOLD FABRICATION DETAIL 3/M3.2 FOR CONNECTIONS TO STEEL MAINS. SEE DETAILS 2&3/M3.3 FOR BRANCH PIPING CONNECTIONS. SEE DETAILS 2/M4.3 FOR INSTRUMENTATION CONNECTIONS.

- 3) ALL COOLANT PRESSURE GAUGES 0-30 PSIG.
- 4) SEE ELECTRICAL INSTRUMENTATION SCHEDULE FOR TEMPERATURE TRANSMITTERS AND OTHER INSTRUMENTATION.
- 5) UPON COMPLETION OF FABRICATION VALVE OFF CABINET UNIT HEATER AND FLUSH PIPING TO REMOVE ALL DEBRIS, SEE SPECIFICATIONS.


- 6) SHOP INSULATE COOLANT PIPING MAINS FROM GENERATOR VALVES TO BUTTERFLY VALVES AT WALL PENETRATIONS. SHOP CUT & FIT INSULATION & JACKET FROM VALVES TO WALL BUT SHIP LOOSE FOR FIELD INSTALLATION. ALL OTHER PIPING NOT INSULATED.
- 7) 3/4" THREADED BALL VALVE, 3/4" MPTx5/8" BARB BRASS KING NIPPLE, & 1/2" HOSE FOR ENGINE VENT & PRE-HEAT.
- 8) SET P-HR1A TO OPERATE ON SPEED CP1.  
SET P-CUH1 TO OPERATE ON SPEED 3

**HYDRONIC PIPING SHOP/ON-SITE NOTES:**

- 1) SEE SPECIFICATION 23 21 13 FOR COOLING AND HEAT RECOVERY PIPING TESTING, FLUSHING, DRAINING, AND FILLING REQUIREMENTS.
- 2) SEE DETAILS 7/M4.1, 3/M4.2, AND 5/M4.3 FOR SHOP/FIELD REQUIREMENTS FOR PIPING THROUGH THE EXTERIOR WALLS.

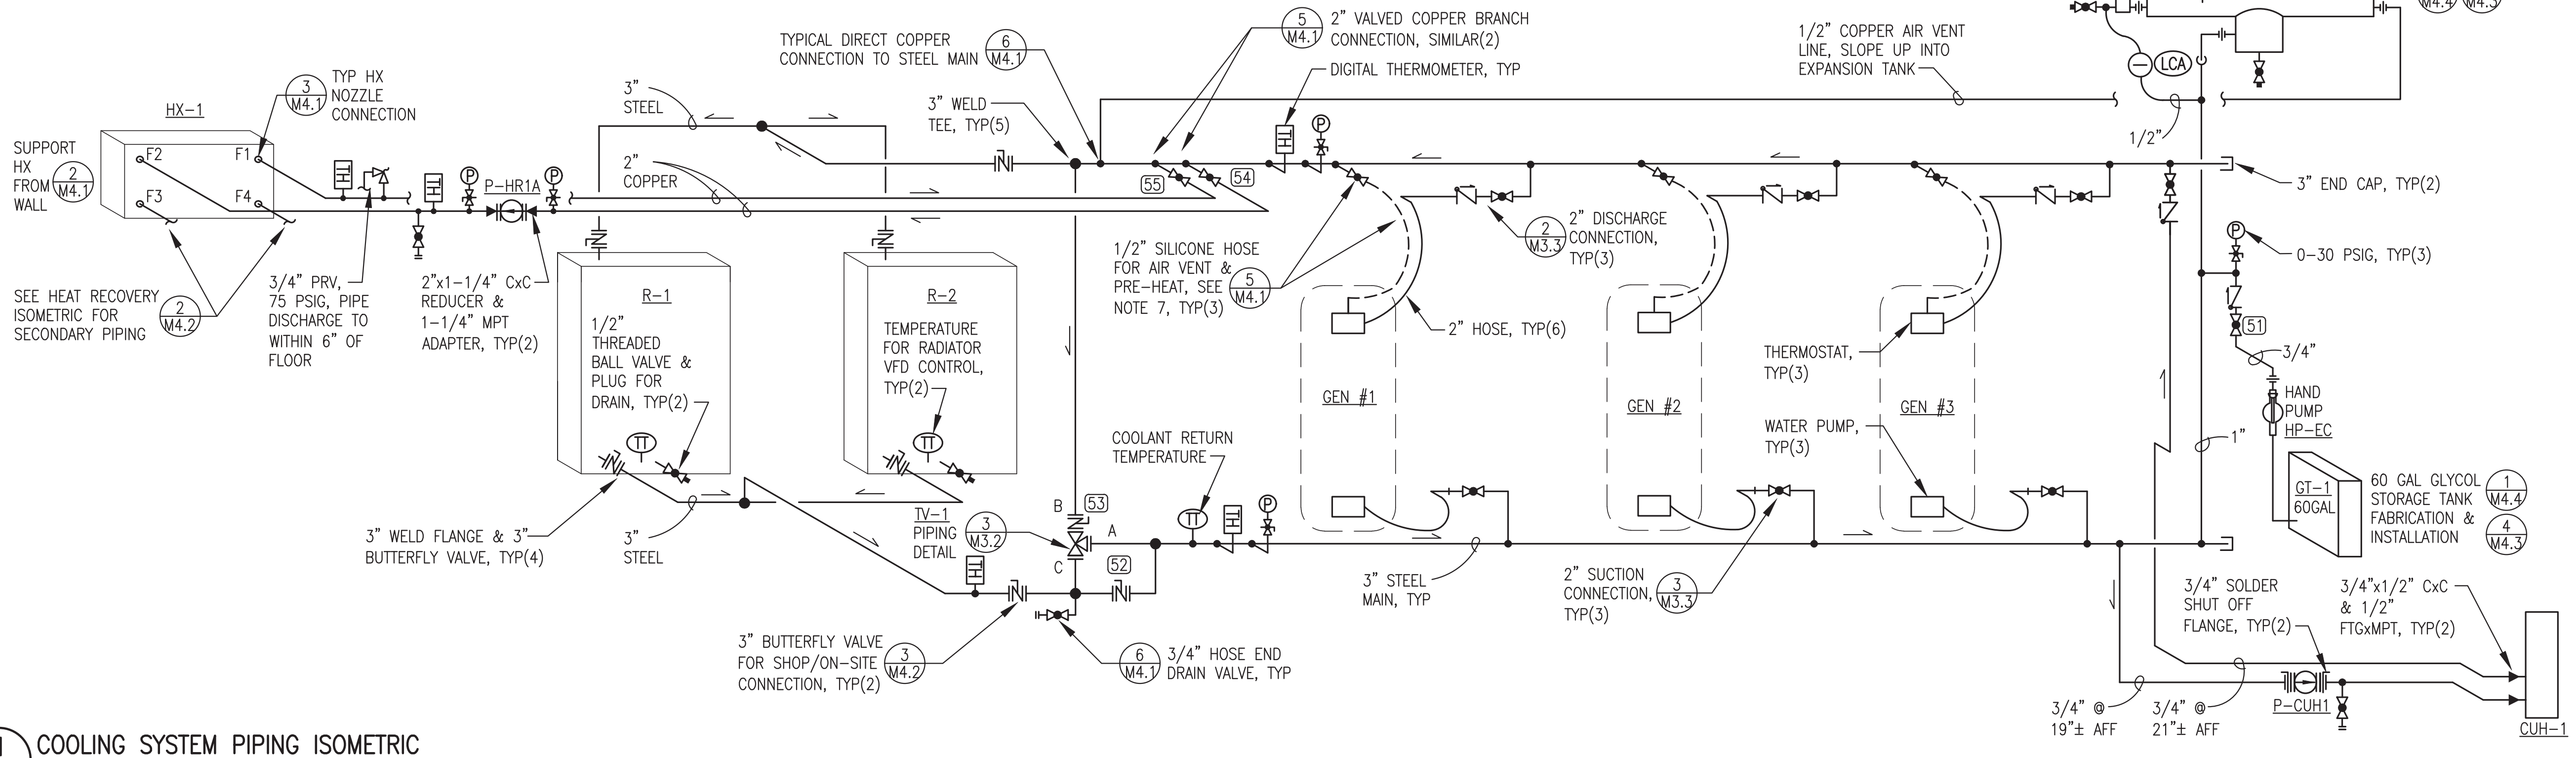


1 COOLING SYSTEM PIPING ISOMETRIC  
M4.2 NO SCALE

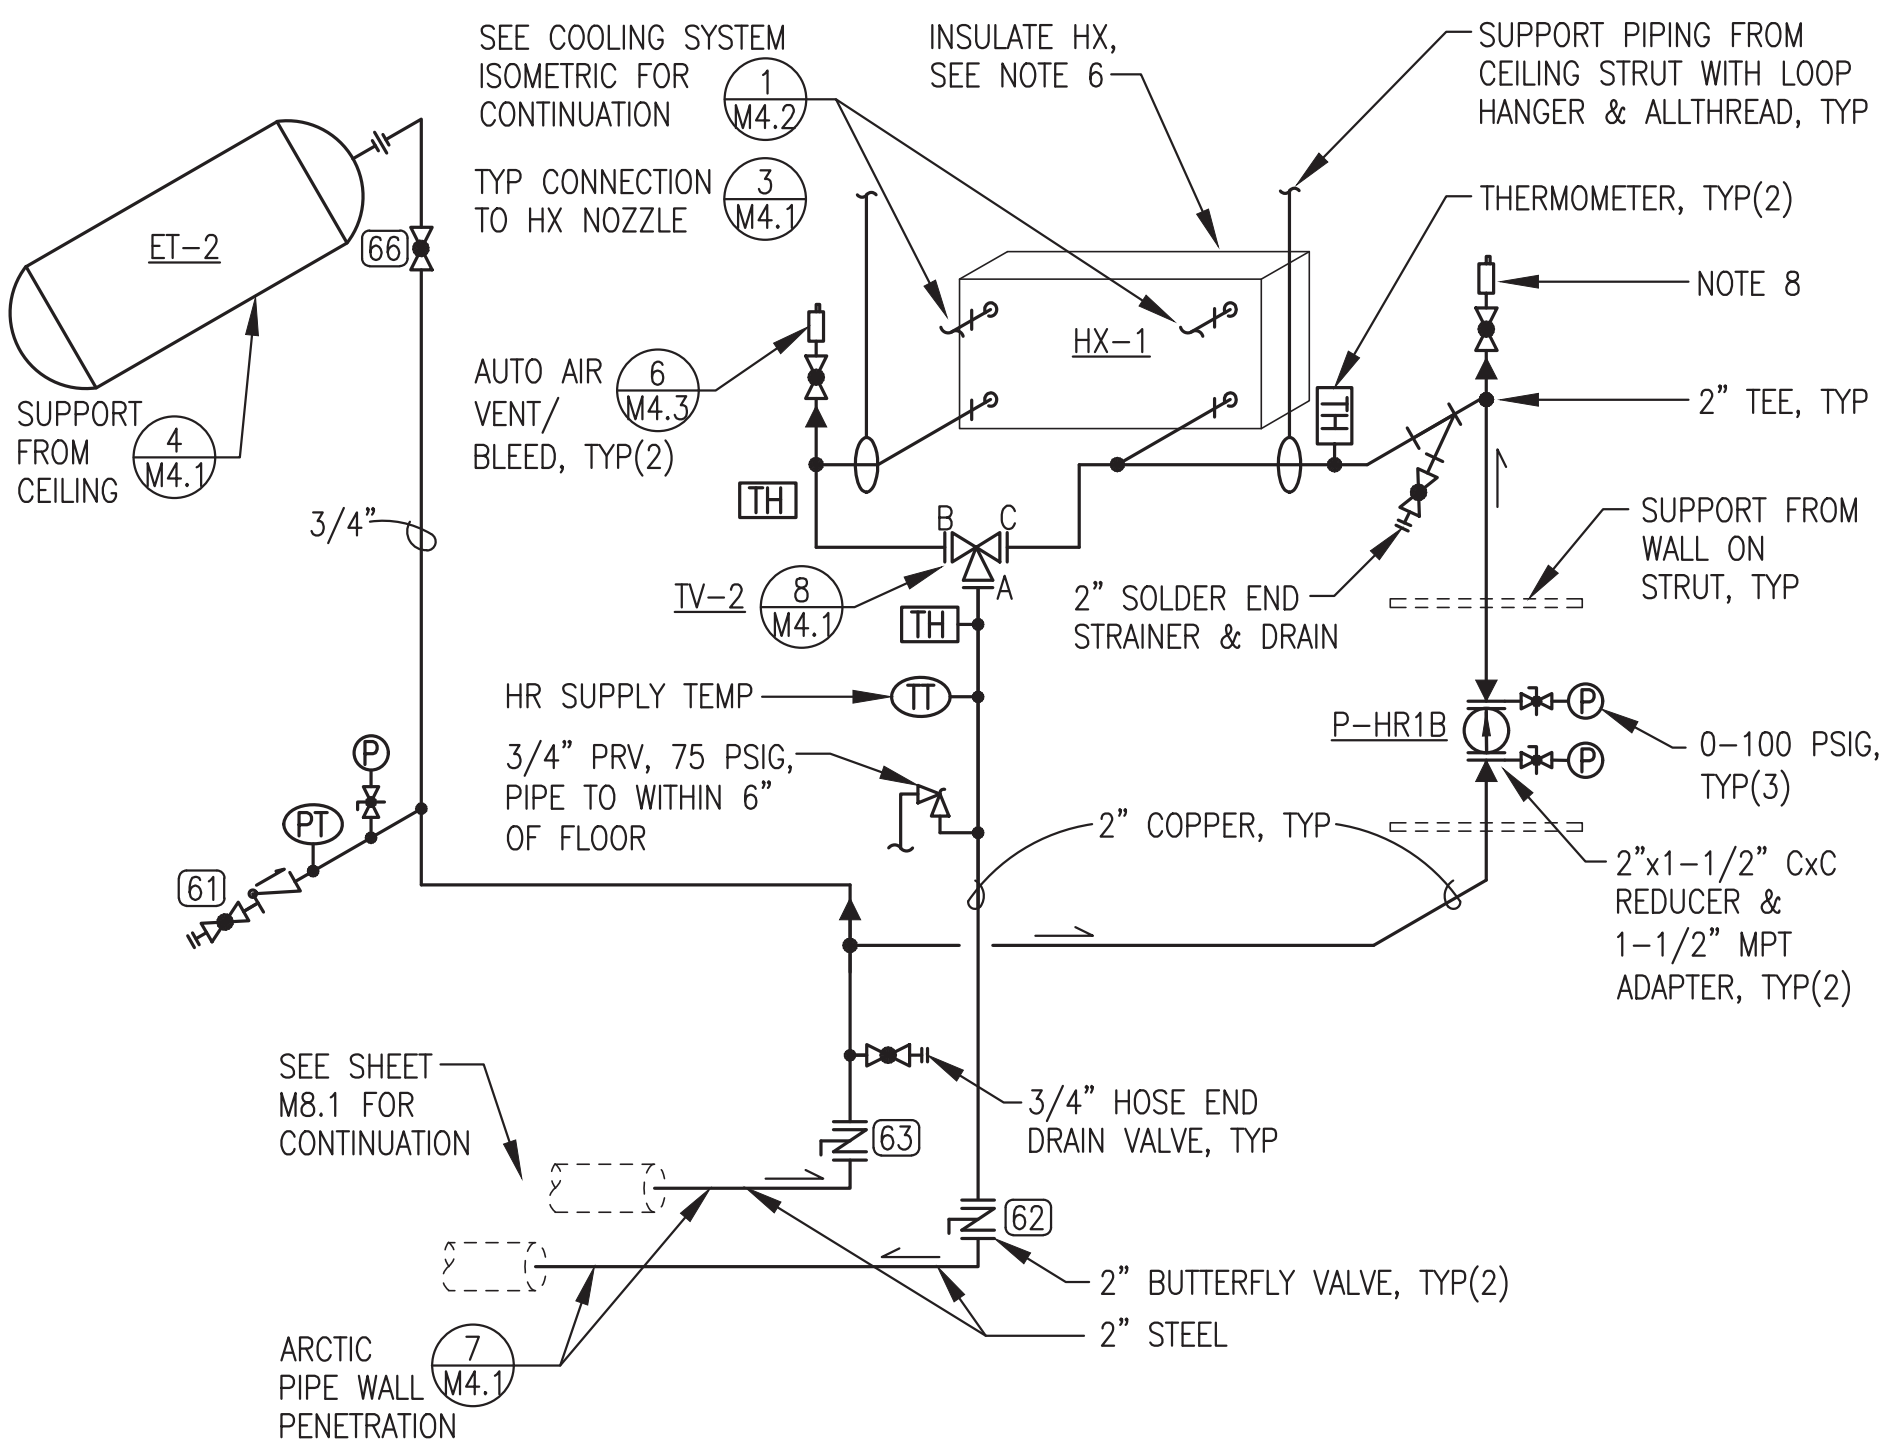

2 HEAT RECOVERY SYSTEM PIPING ISOMETRIC  
M4.2 NO SCALE

**HEAT RECOVERY ISOMETRIC NOTES:**

- 1) ALL PIPING SHOWN THIS ISOMETRIC TYPE "L" COPPER WITH SOLDER JOINTS, 2"Ø EXCEPT WHERE SPECIFICALLY INDICATED OTHERWISE. ALL FLANGES ANSI 150# PATTERN TWO-PIECE WITH POWDER COATED STEEL FLANGE AND SOLDER COPPER TUBE ADAPTER. FOR ALL JOINTS EXCEPT BUTTERFLY VALVES INSTALL SPIRAL WOUND METALLIC GASKETS AND COAT GASKETS WITH ANTI-SEIZE COMPOUND PRIOR TO ASSEMBLING.
- 2) MAKE ALL CONNECTIONS FOR INSTRUMENTATION WITH T-DRILL TAP OR REDUCING TEE. SEE DETAIL 3/M4.3.
- 3) ALL HEAT RECOVERY PRESSURE GAUGES 0-100 PSIG.
- 4) SEE INSTRUMENTATION SCHEDULE SHEET M1.1 FOR TEMPERATURE AND PRESSURE TRANSMITTERS.
- 5) UPON COMPLETION OF FABRICATION FLUSH PIPING TO REMOVE ALL DEBRIS, SEE SPECIFICATIONS.
- 6) INSULATE ALL 2" HEAT RECOVERY PIPING MAINS. WRAP HEAT EXCHANGER WITH 1" RIGID FOIL-BACK FIBERGLASS INSULATION ALL AROUND AND TAPE ALL SEAMS.
- 7) SET P-HR1B TO OPERATE ON CP3
- 8) RISE UP BEHIND WIREWAY FOR THIS AIR VENT CONNECTION.

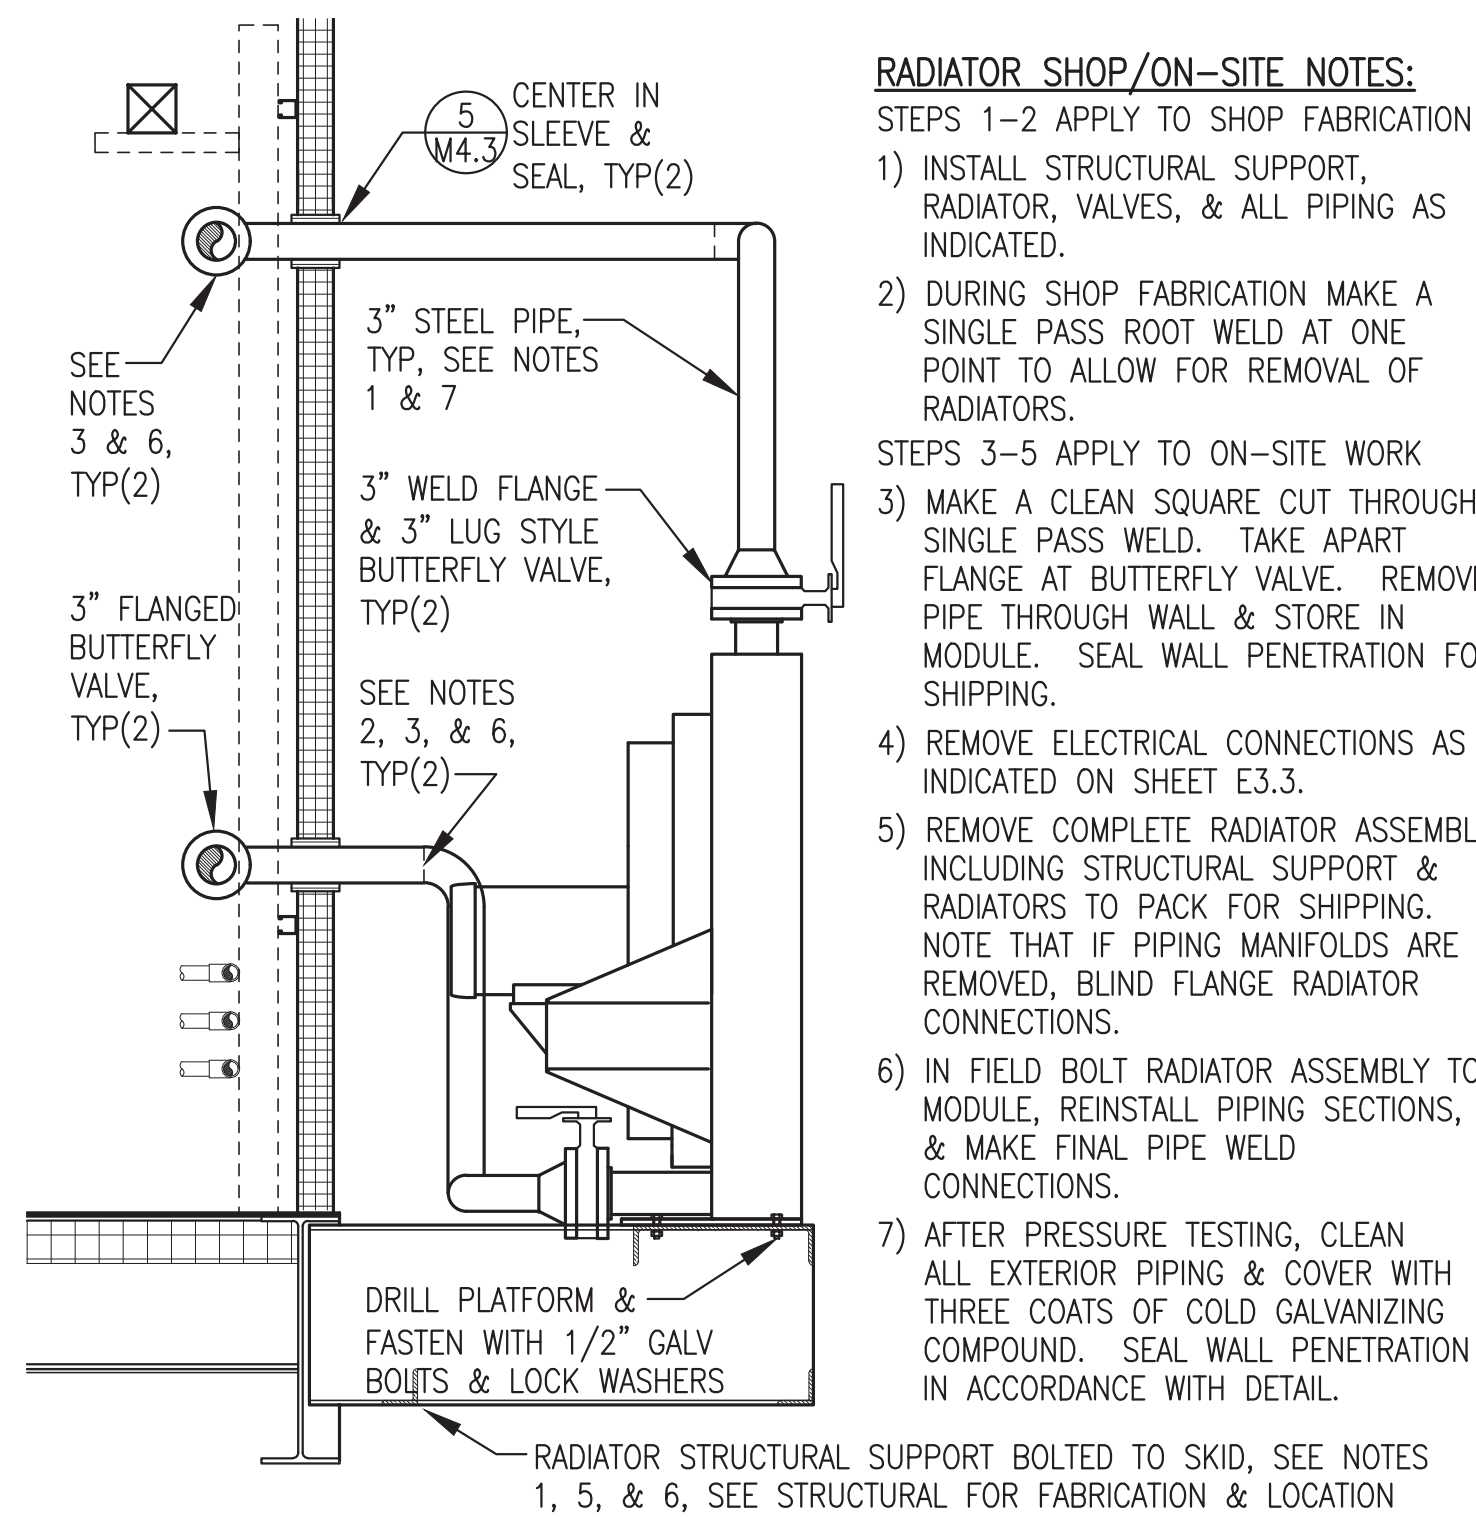

3 RADIATOR & PIPING INSTALLATION  
M4.2 3/4"=1'-0"


**RADIATOR SHOP/ON-SITE NOTES:**


- STEPS 1-2 APPLY TO SHOP FABRICATION
- 1) INSTALL STRUCTURAL SUPPORT, RADIATOR, VALVES, & ALL PIPING AS INDICATED.
  - 2) DURING SHOP FABRICATION MAKE A SINGLE PASS ROOT WELD AT ONE POINT TO ALLOW FOR REMOVAL OF RADIATORS.
- STEPS 3-5 APPLY TO ON-SITE WORK
- 3) MAKE A CLEAN SQUARE CUT THROUGH SINGLE PASS WELD. TAKE APART FLANGE AT BUTTERFLY VALVE. REMOVE PIPE THROUGH WALL & STORE IN MODULE. SEAL WALL PENETRATION FOR SHIPPING.
  - 4) REMOVE ELECTRICAL CONNECTIONS AS INDICATED ON SHEET E3.3.
  - 5) REMOVE COMPLETE RADIATOR ASSEMBLY INCLUDING STRUCTURAL SUPPORT & RADIATORS TO PACK FOR SHIPPING. NOTE THAT IF PIPING MANIFOLDS ARE REMOVED, BLIND FLANGE RADIATOR CONNECTIONS.
  - 6) IN FIELD BOLT RADIATOR ASSEMBLY TO MODULE, REINSTALL PIPING SECTIONS, & MAKE FINAL PIPE WELD CONNECTIONS.
  - 7) AFTER PRESSURE TESTING, CLEAN ALL EXTERIOR PIPING & COVER WITH THREE COATS OF COLD GALVANIZING COMPOUND. SEAL WALL PENETRATION IN ACCORDANCE WITH DETAIL.

ALL WORK ON THIS SHEET WAS PERFORMED AS PART OF THE PRIOR MODULE ASSEMBLY CONTRACT EXCEPT AS SPECIFICALLY INDICATED IN THE SHOP/ON SITE NOTES.


1	DELETE FLOW METER & HR RETURN TEMP SENSOR, DELETE VALVES TV-1 PORTS A & C	8/16/23	BCG
REV.	DESCRIPTION	DATE	BY
<p>ALASKA ENERGY AUTHORITY</p>			
PROJECT: NELSON LAGOON POWER SYSTEM UPGRADE			
TITLE: COOLANT & HEAT RECOVERY ISOMETRICS & DETAILS			
<p>Gray Stassel Engineering, Inc.</p>		DRAWN BY: JTD	SCALE: AS NOTED
P.O. 111405, Anchorage, AK 99511 (907)349-0100		DESIGNED BY: BCG	DATE: 5/30/23
PROJECT NUMBER:		FILE NAME: NELS PP M2-M7	SHEET: M4.2

REV#1  
ISSUED FOR  
CONSTRUCTION  
AUGUST 2023

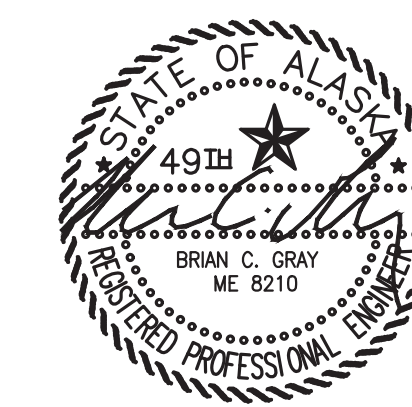


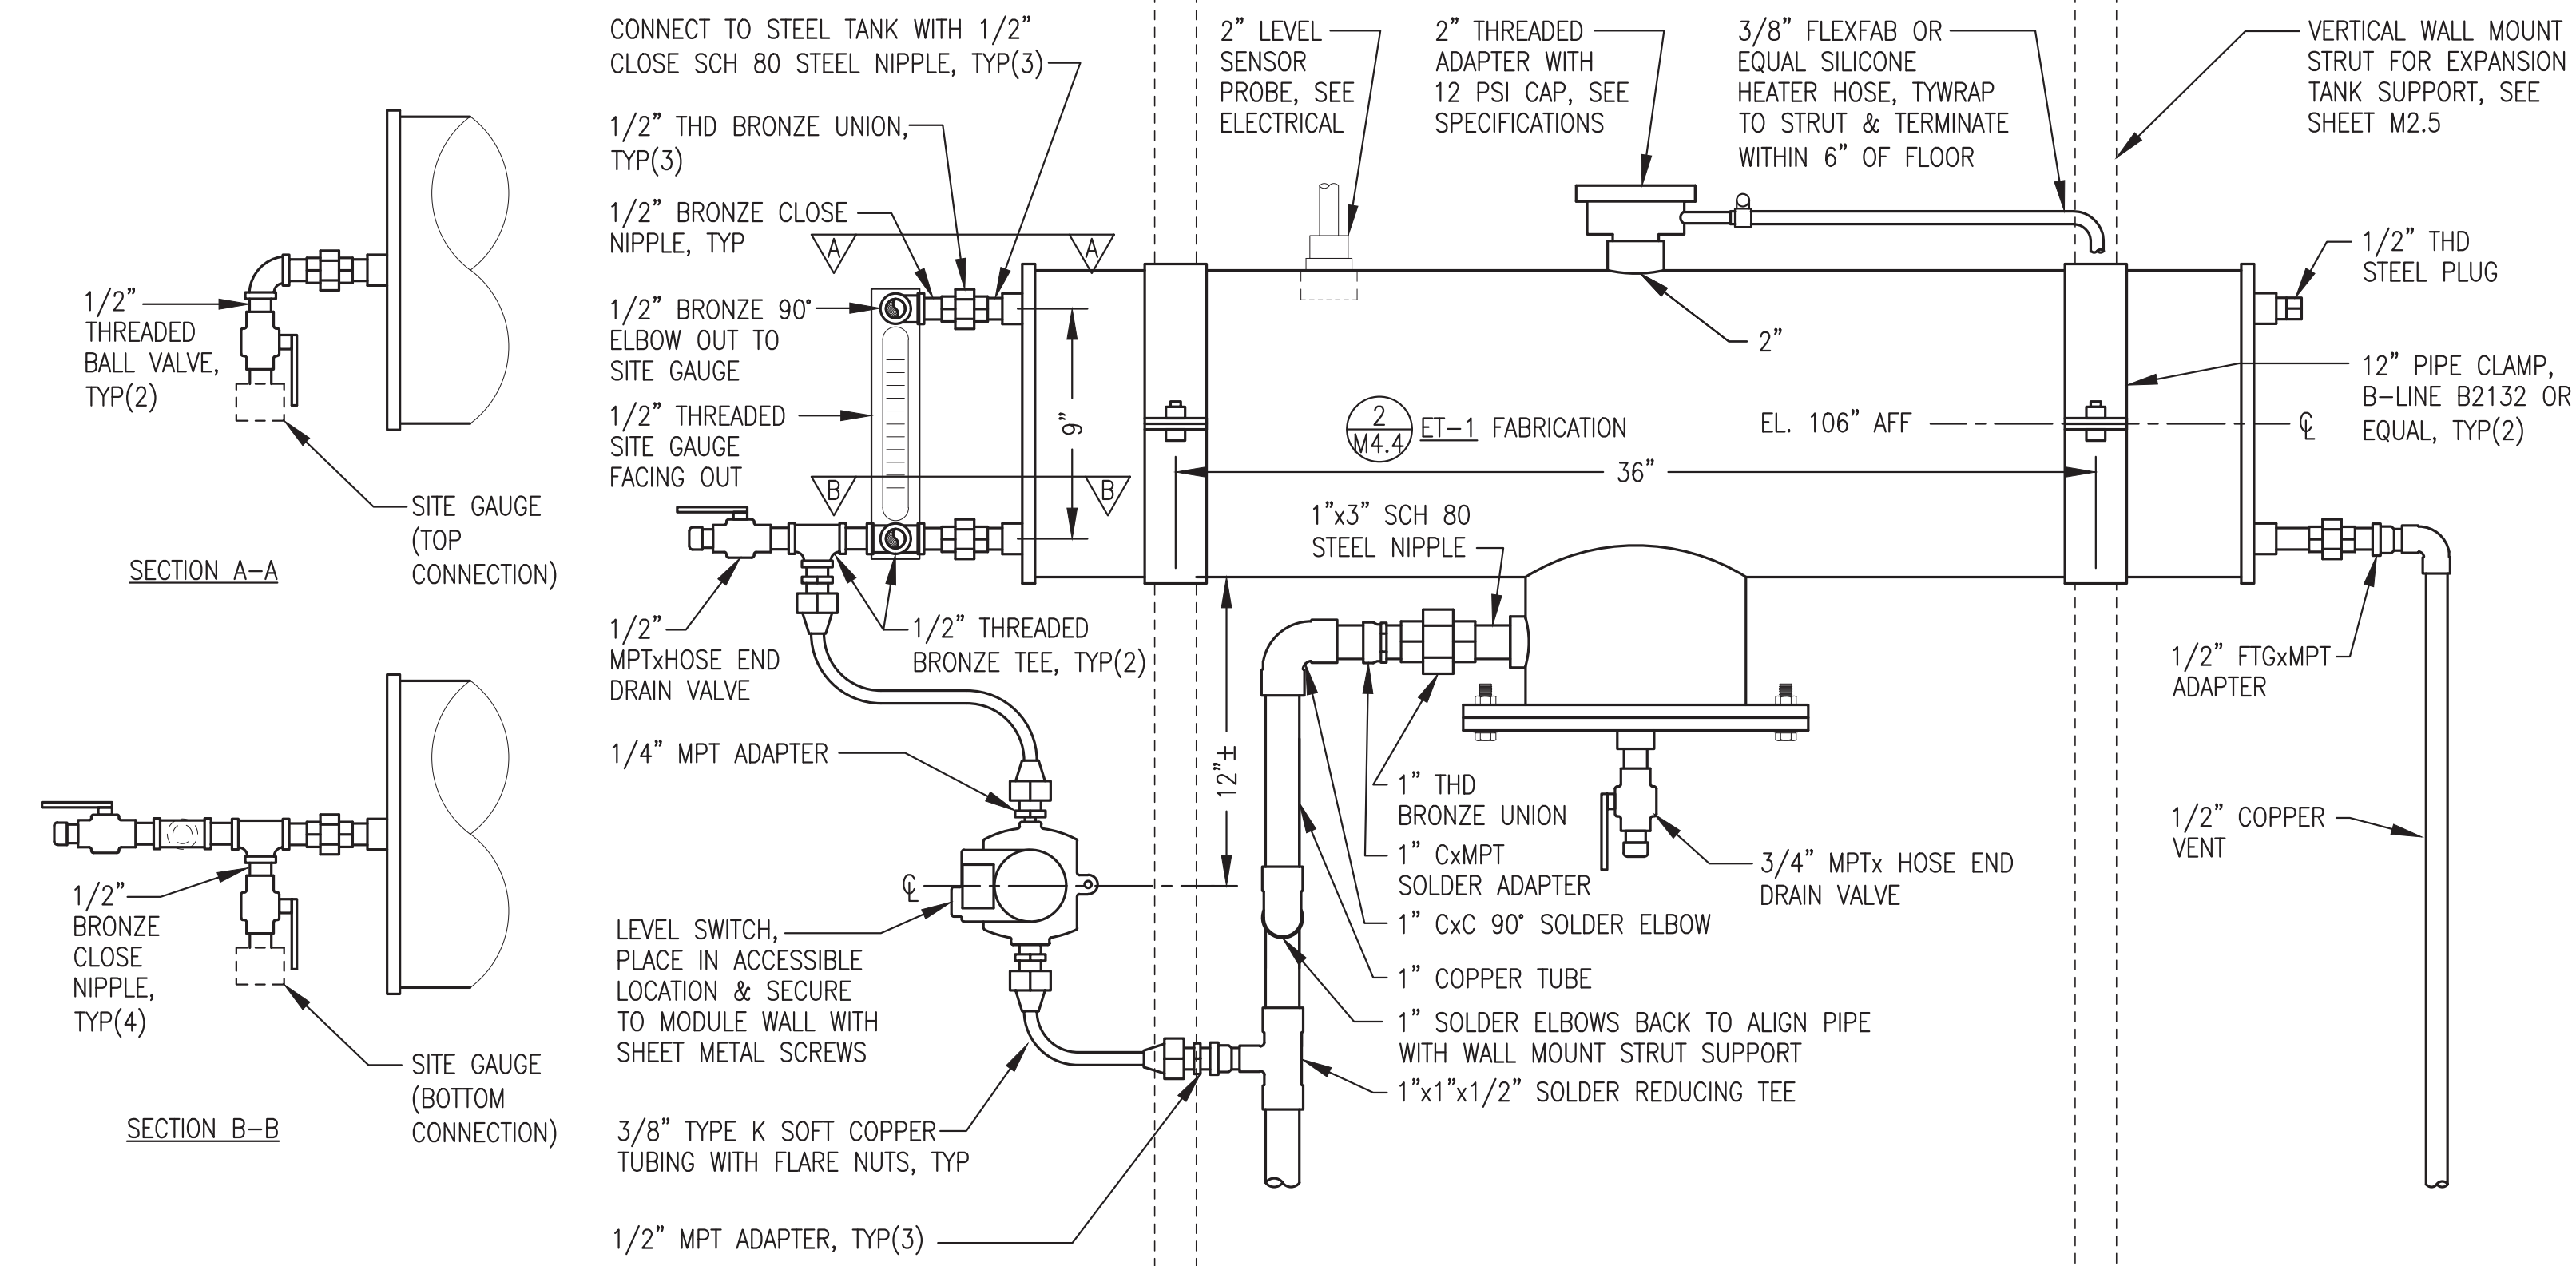


1 24 GAL EXPANSION TANK ET-1 INSTALLATION  
M4.3 NO SCALE

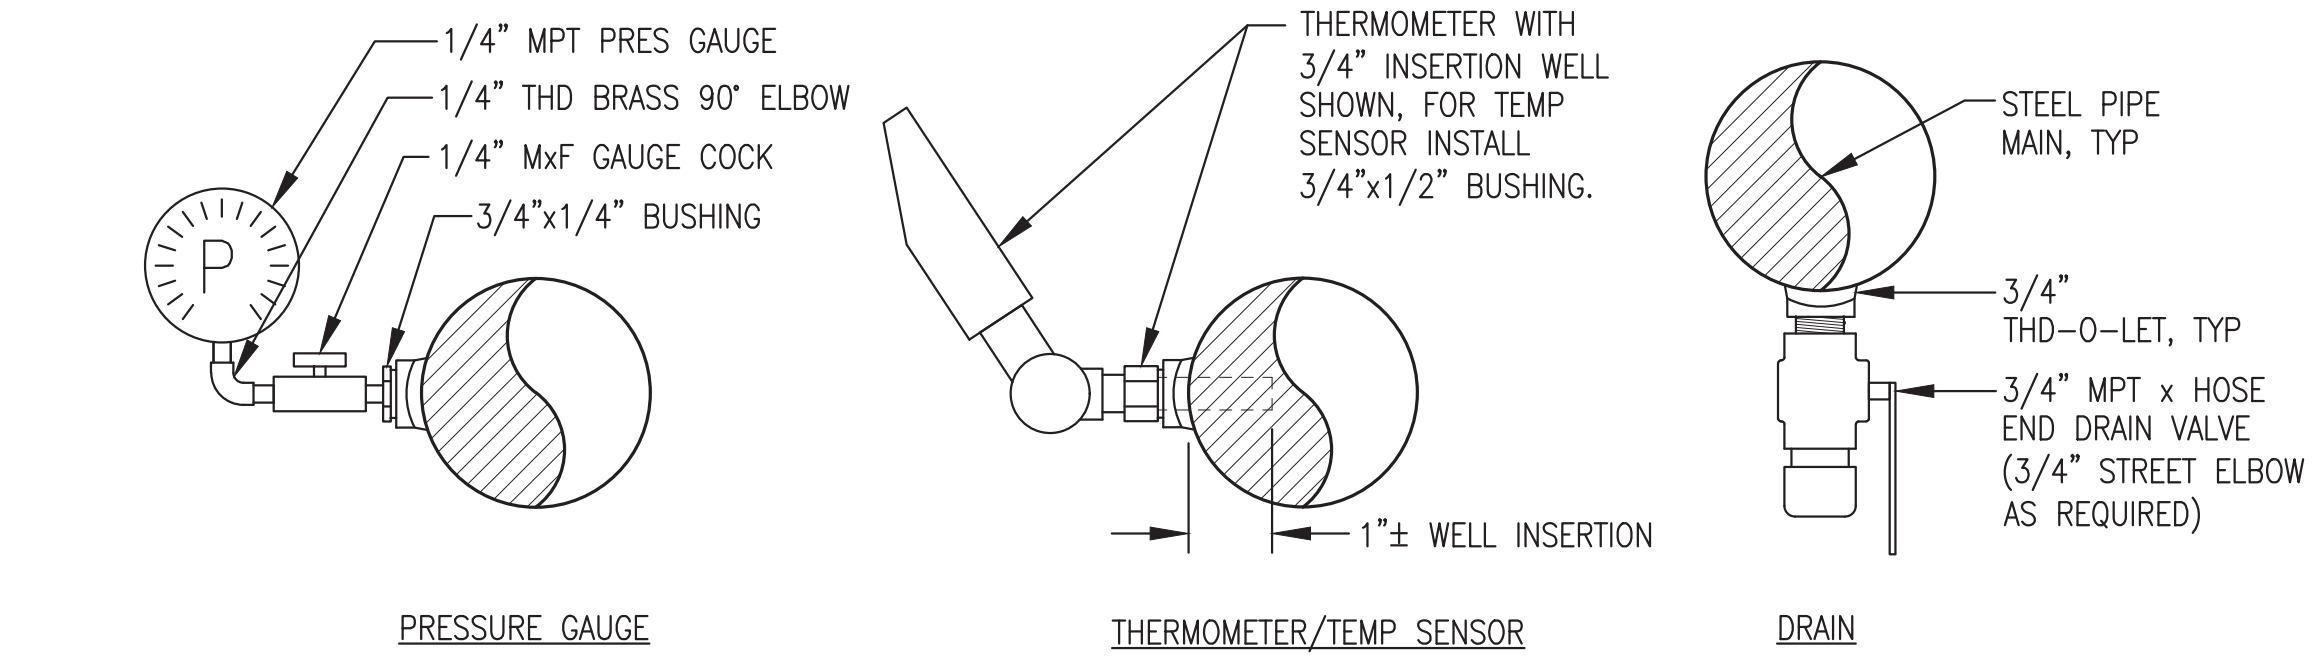


2 TYP INSTRUMENT/DRAIN INSTALLATION IN STEEL PIPE  
M4.3 NO SCALE

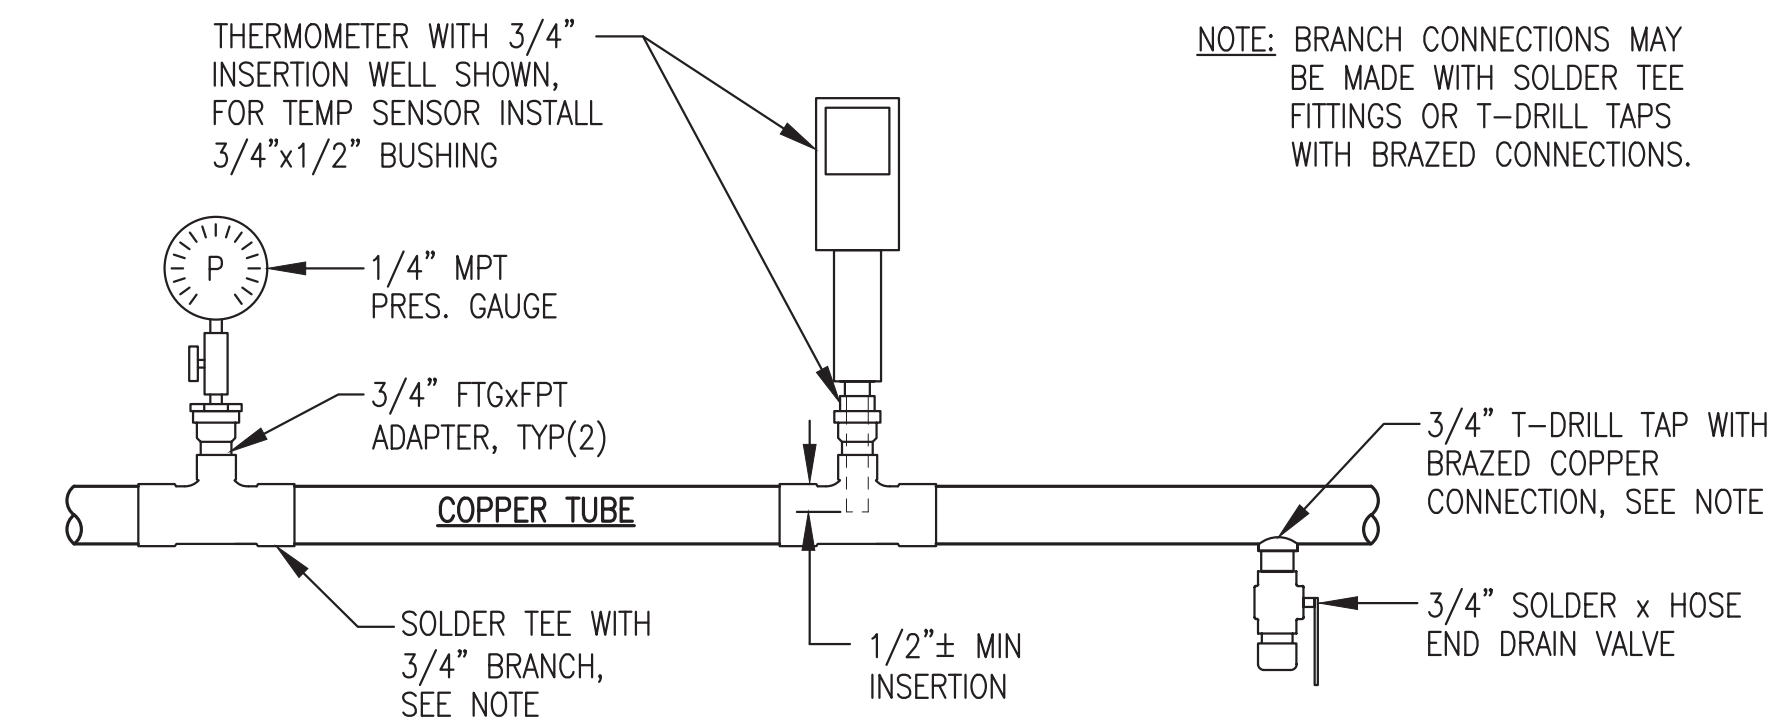

3 TYP INSTRUMENT/DRAIN INSTALLATION IN COPPER TUBE  
M4.3 NO SCALE

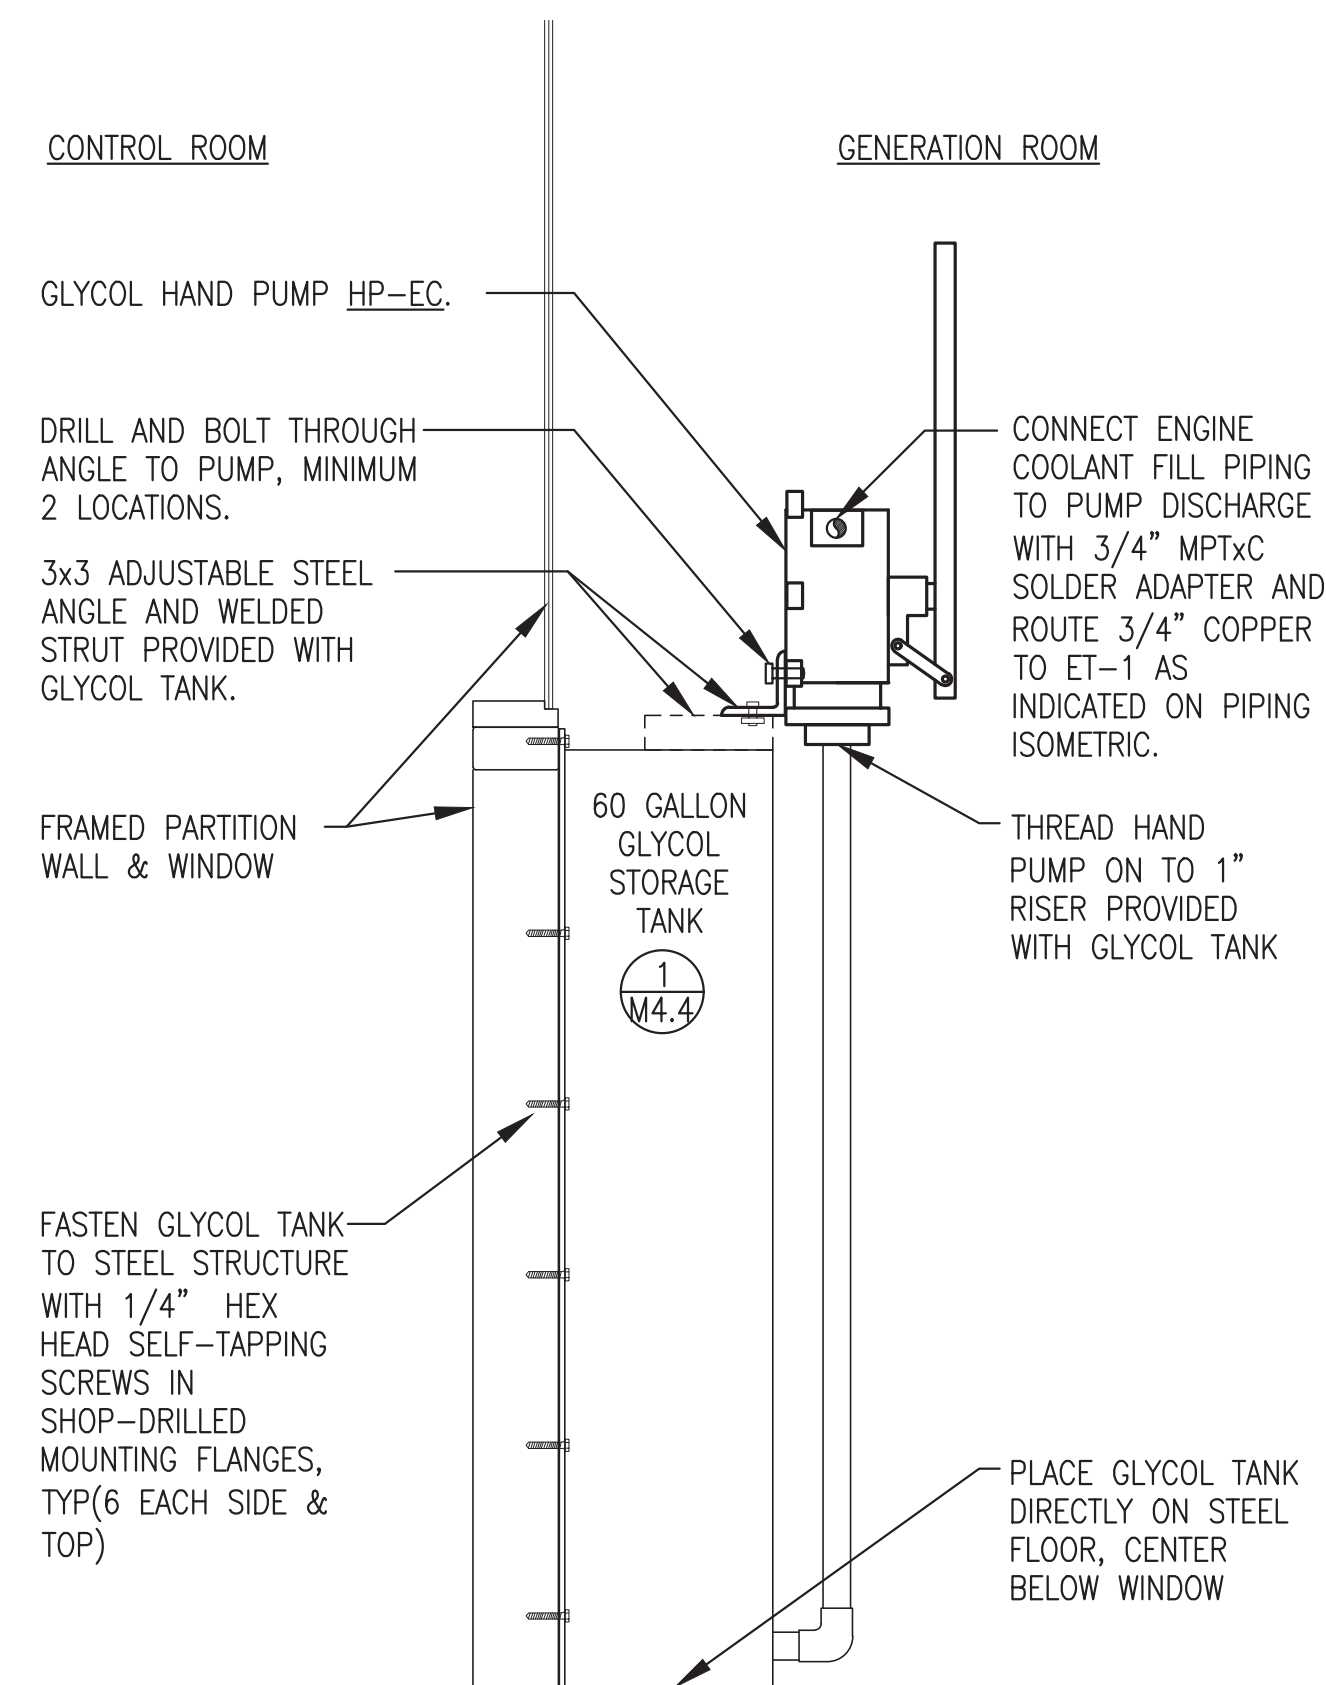

4 GLYCOL STORAGE TANK & HAND PUMP HP-EC INSTALLATION DETAIL  
M4.3 NO SCALE

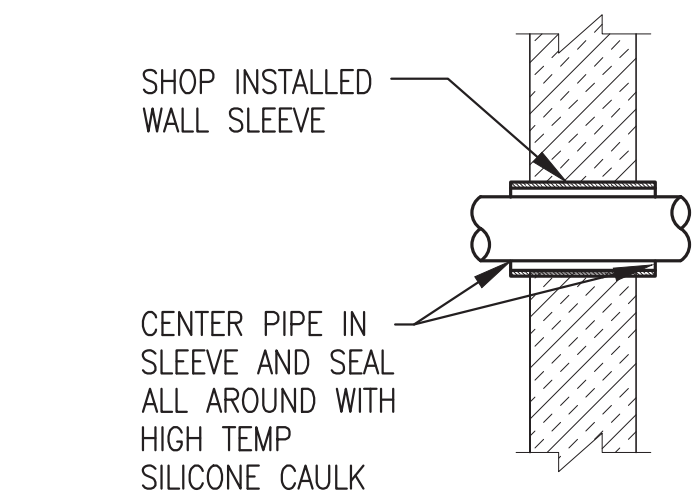


5 COOLANT PIPING WALL PENETRATION  
M4.3 NO SCALE

**SHOP/ON-SITE NOTES:**

1) SEAL OPENINGS AS PART OF ON-SITE WORK.

**GENERAL NOTES:**

- THIS DETAIL FOR COOLANT PIPING WITH SHOP INSTALLED WALL SLEEVES.
- FOR ALL PIPE/CONDUIT LESS THAN 2" O.D. AND WITHOUT A SHOP INSTALLED WALL SLEEVE, HOLE SAW OPENING APPROXIMATELY 1/4" LARGER THAN PIPE O.D. THROUGH WALL & SEAL ALL AROUND WITH POLYURETHANE CAULKING.

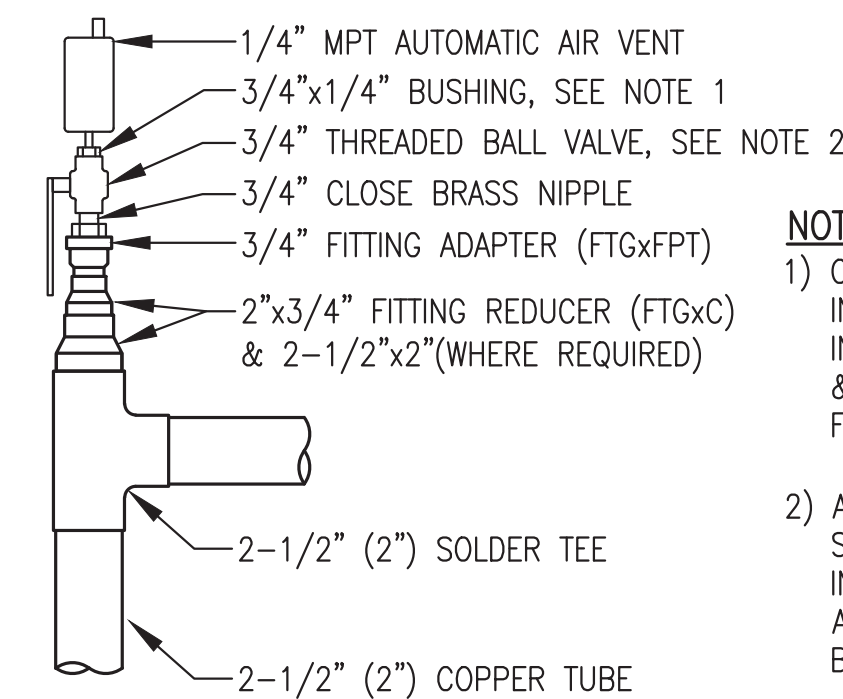


6 TYPICAL AIR VENT INSTALLATION IN COPPER  
M4.3 NO SCALE


**NOTES:**

- ON INITIAL STARTUP INSTALL HOSE ADAPTER IN PLACE OF BUSHING & USE HOSE TO FLUSH & BLEED.
- AFTER BLEEDING SYSTEM OF AIR INSTALL BUSHING & AIR VENT & CLOSE BALL VALVE.

ALL WORK ON THIS SHEET WAS PERFORMED AS PART OF THE PRIOR MODULE ASSEMBLY CONTRACT EXCEPT AS SPECIFICALLY INDICATED IN THE SHOP/ON SITE NOTES.

1	ADDED ISOLATION VALVES TO ET-1 SITE GAUGE	2/22/24	BCG
REV.	DESCRIPTION	DATE	BY
 ALASKA ENERGY AUTHORITY			
PROJECT: NELSON LAGOON POWER SYSTEM UPGRADE			
TITLE: COOLANT & HEAT RECOVERY PIPING DETAILS			
DRAWN BY: JTD		SCALE: AS NOTED	
DESIGNED BY: BCG		DATE: 5/30/23	
FILE NAME: NELS_PP_M2-M7		SHEET: M4.3	
PROJECT NUMBER:			

REV#1  
ISSUED FOR  
CONSTRUCTION  
FEB 2024

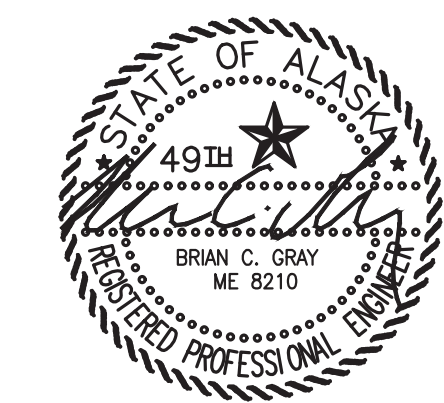


**Gray Stassel Engineering, Inc.**  
P.O. 111405, Anchorage, AK 99511 (907)349-0100

**GLYCOL TANK GENERAL NOTES:**

- FABRICATE SINGLE WALL 60 GALLON NOMINAL CAPACITY GLYCOL TANK.
- FABRICATE FROM ASTM A-36 STEEL PLATE, 10 GAUGE MINIMUM EXCEPT FOR TOP 3/16" MINIMUM. ALL TANK SEAM JOINTS TO BE FULL CONTINUOUS WELDS.
- PROVIDE WITH ALL OPENINGS AND ATTACHMENTS INDICATED. SEAL WELD ALL TANK ATTACHMENTS.
- ALL FPT OPENINGS TO BE FORGED STEEL HALF COUPLINGS.
- PRESSURE TEST COMPLETED ASSEMBLY TO 5 PSIG MAXIMUM USING SOAPY WATER SOLUTION ON ALL WELD JOINTS.
- UPON COMPLETION OF FABRICATION, ROUND ALL CORNERS AND SHARP EDGES. SANDBLAST TANK EXTERIOR AND ALL ATTACHMENTS IN ACCORDANCE WITH SSPC-SP-6. PRIME AND COVER WITH TWO COATS OF EPOXY, PPG AMERLOC 2 VOC OR APPROVED EQUAL, COLOR ANSI 61 GRAY.
- UPON COMPLETION FLUSH INTERIOR OF TANK TO REMOVE ALL DIRT AND DEBRIS AND AIR DRY INTERIOR. INSTALL 2" SCREENED VENT ON 2" FPT FILL CONNECTION WITH 2" CLOSE NIPPLE FOR SHIPPING. SEAL ALL OTHER OPENINGS WITH PLASTIC OR STEEL PLUGS..


**GLYCOL TANK SPECIFIC NOTES:**

- 1-1/2" FPT (TANK GAUGE)
- 2" FPT (VENT) - INSTALL 2" THREADED VENT CAP
- 1" SCHEDULE 80 PIPE WITH THREADED TOP CONNECTION (WITHDRAWAL)
- 1" SOCKETWELD 90° ELBOW
- 6" LONG STRUT, END FLUSH WITH FRONT OF TANK
- 2x1/4" FLAT BAR CONTINUOUS THREE SIDES
- 3/8" HOLE AT 8" O.C. ALL AROUND
- L3x3x1/4"x6" LONG FOR FUTURE CONNECTION TO HAND PUMP BY OTHERS. PAINT TO MATCH TANK AND FASTEN TO STRUTS WITH 1/2" BOLTS & STRUT NUTS.

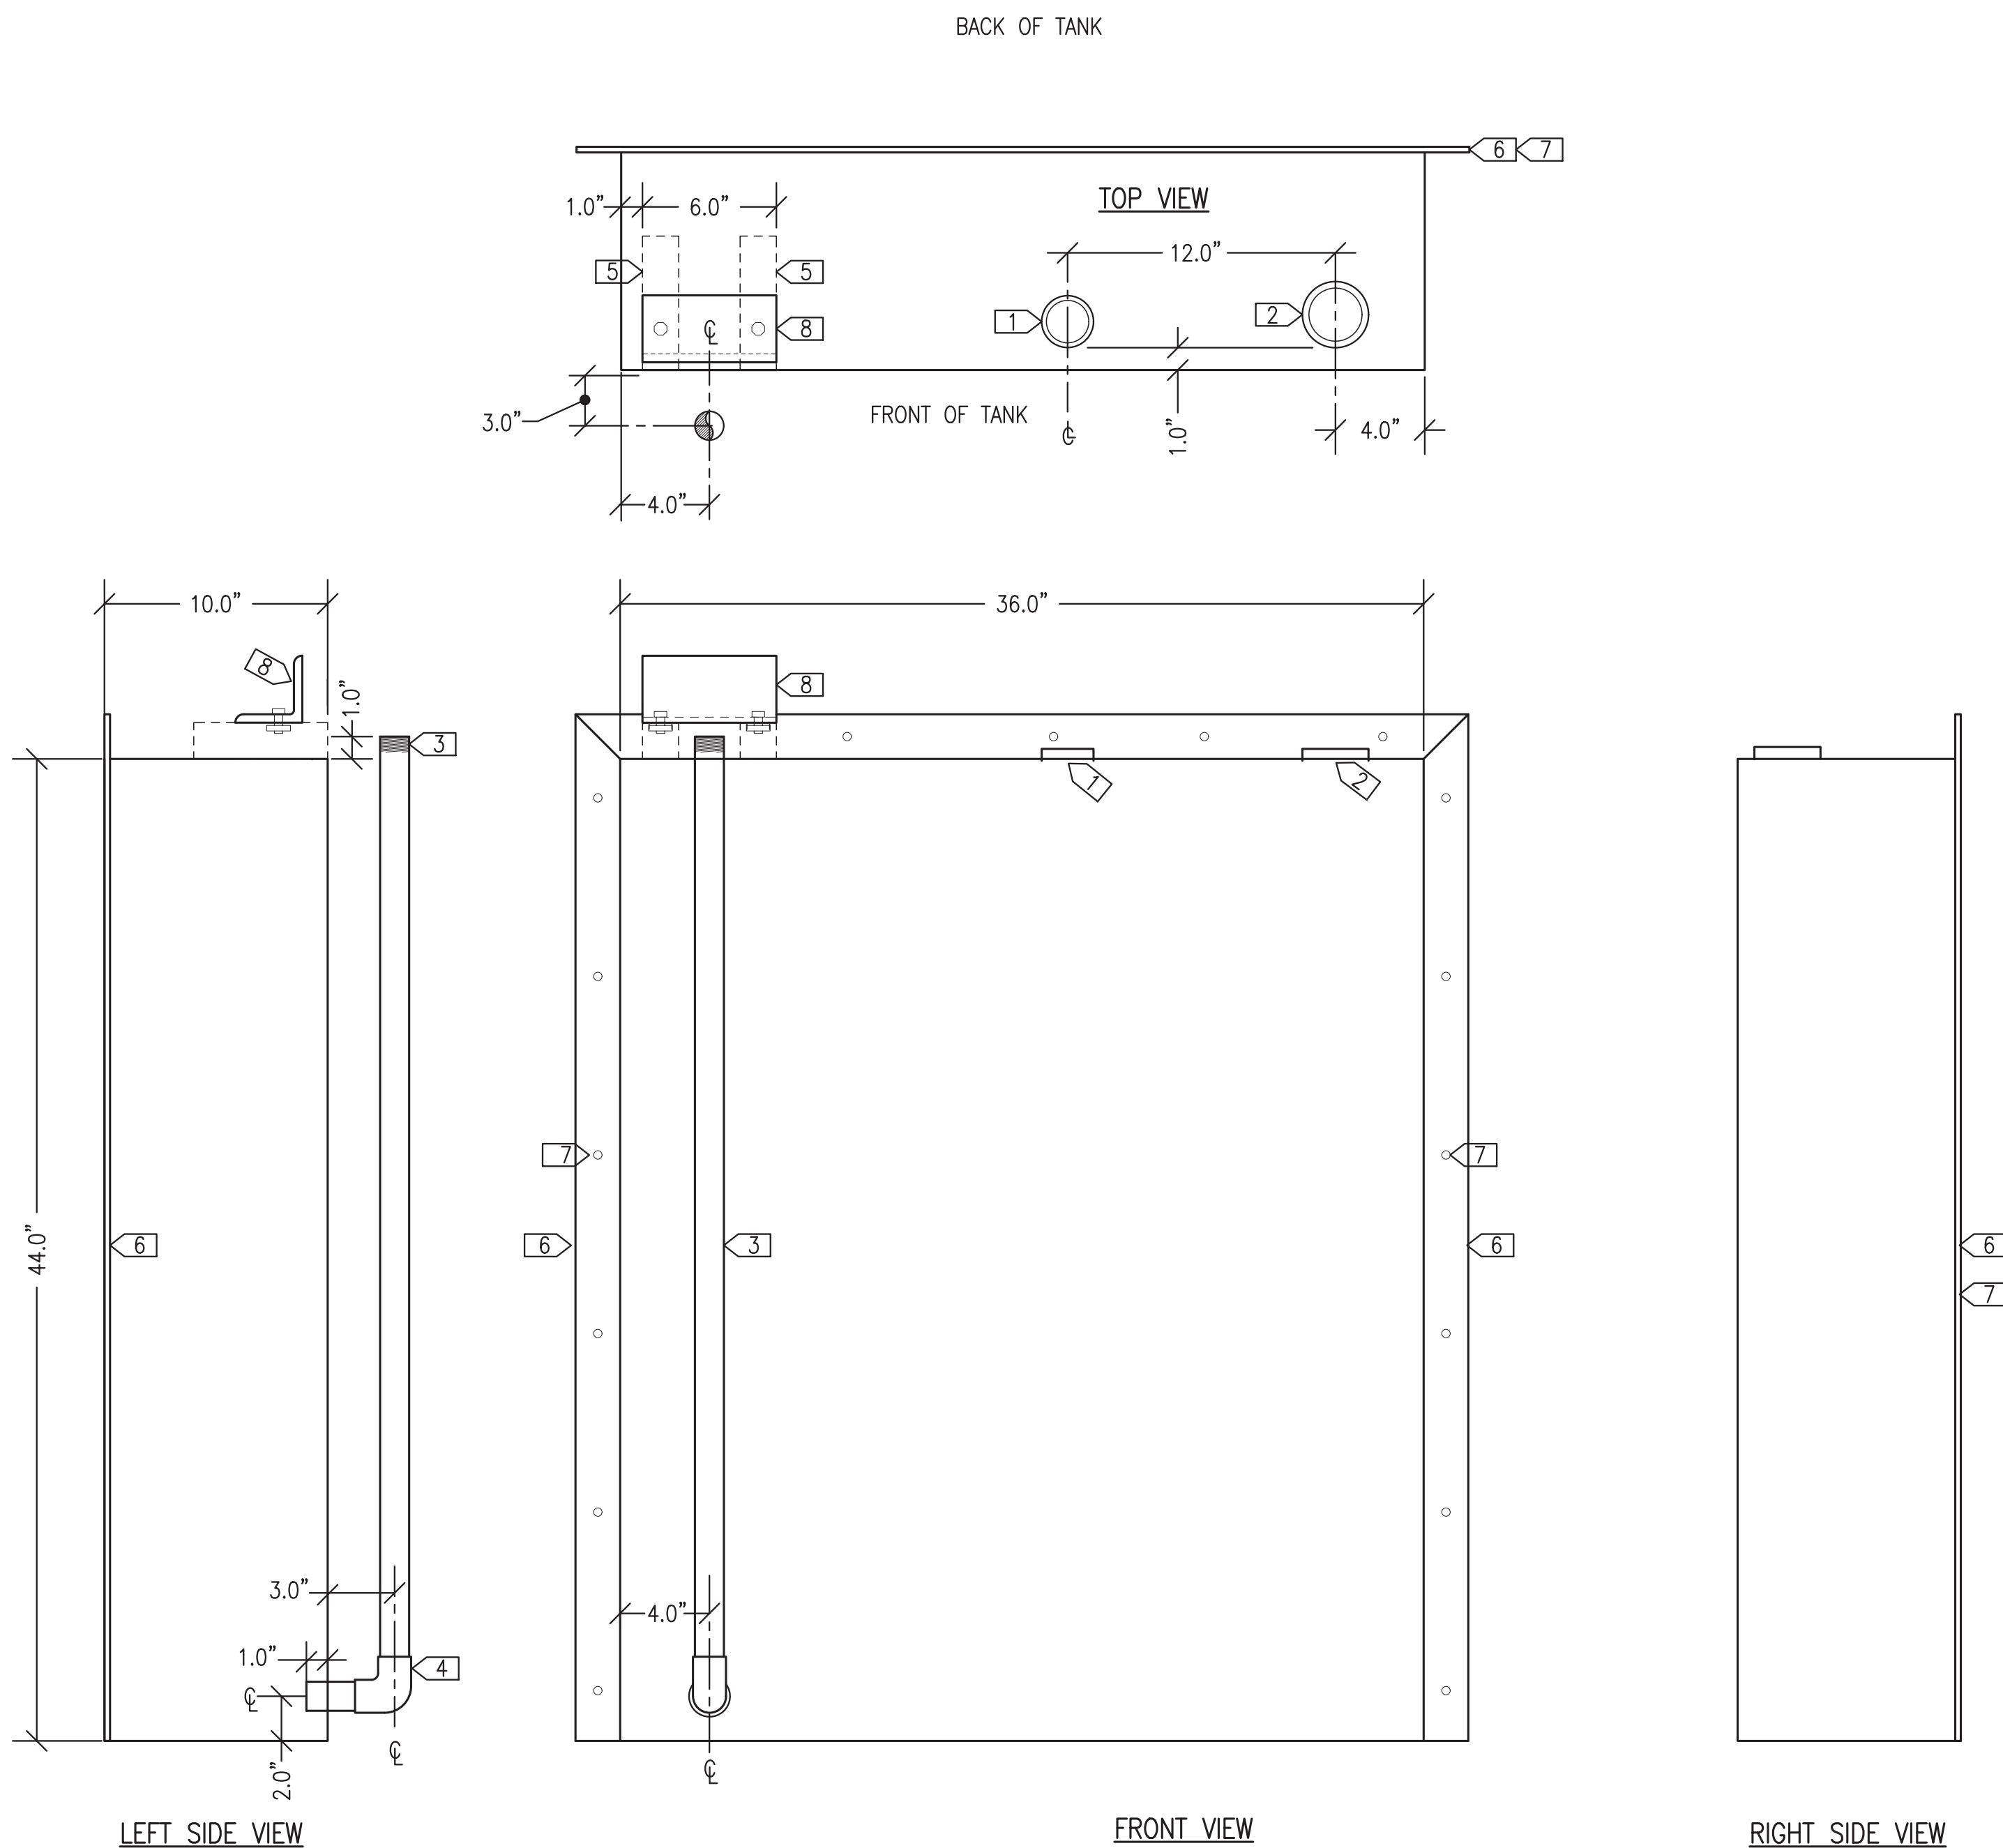

**EXPANSION TANK GENERAL NOTES:**

- FABRICATE SINGLE WALL 24 GALLON NOMINAL CAPACITY GLYCOL EXPANSION TANK.
- FABRICATE SHELL FROM MINIMUM 3/16" ASTM A-36 PLATE STEEL ROLLED AND WELDED OR 12"Ø SCHEDULE 10 LIGHTWALL ASTM A53 STEEL PIPE. FABRICATE HEADS FROM 1/4" THICK ASTM A-36 PLATE STEEL. FABRICATE SUMP FROM 8"Ø SCHEDULE 40 ASTM A53 STEEL PIPE. FABRICATE SUMP HEAD FROM 1/2" THICK ASTM A-36 PLATE STEEL. MAKE ALL JOINTS WITH CONTINUOUS FULL-PENETRATION WELDS.
- PROVIDE WITH ALL OPENINGS INDICATED USING MINIMUM 3000# FORGED STEEL PIPE HALF COUPLINGS IN ACCORDANCE WITH U.I. 142 FIGURE 7.1 #2.
- PRESSURE TEST COMPLETED ASSEMBLY TO 15 PSIG MINIMUM.
- UPON COMPLETION OF FABRICATION, ROUND ALL CORNERS AND SHARP EDGES. SANDBLAST TANK EXTERIOR AND ALL ATTACHMENTS IN ACCORDANCE WITH SSPC-SP-6. PAINT WITH TWO COATS EPOXY, PPG AMERLOC 2 VOC OR APPROVED EQUAL, COLOR ANSI 61 GRAY.
- UPON COMPLETION FLUSH INTERIOR OF TANK TO REMOVE ALL DIRT AND DEBRIS, AIR DRY INTERIOR, AND SEAL ALL TANK OPENINGS WITH PLASTIC PLUGS.

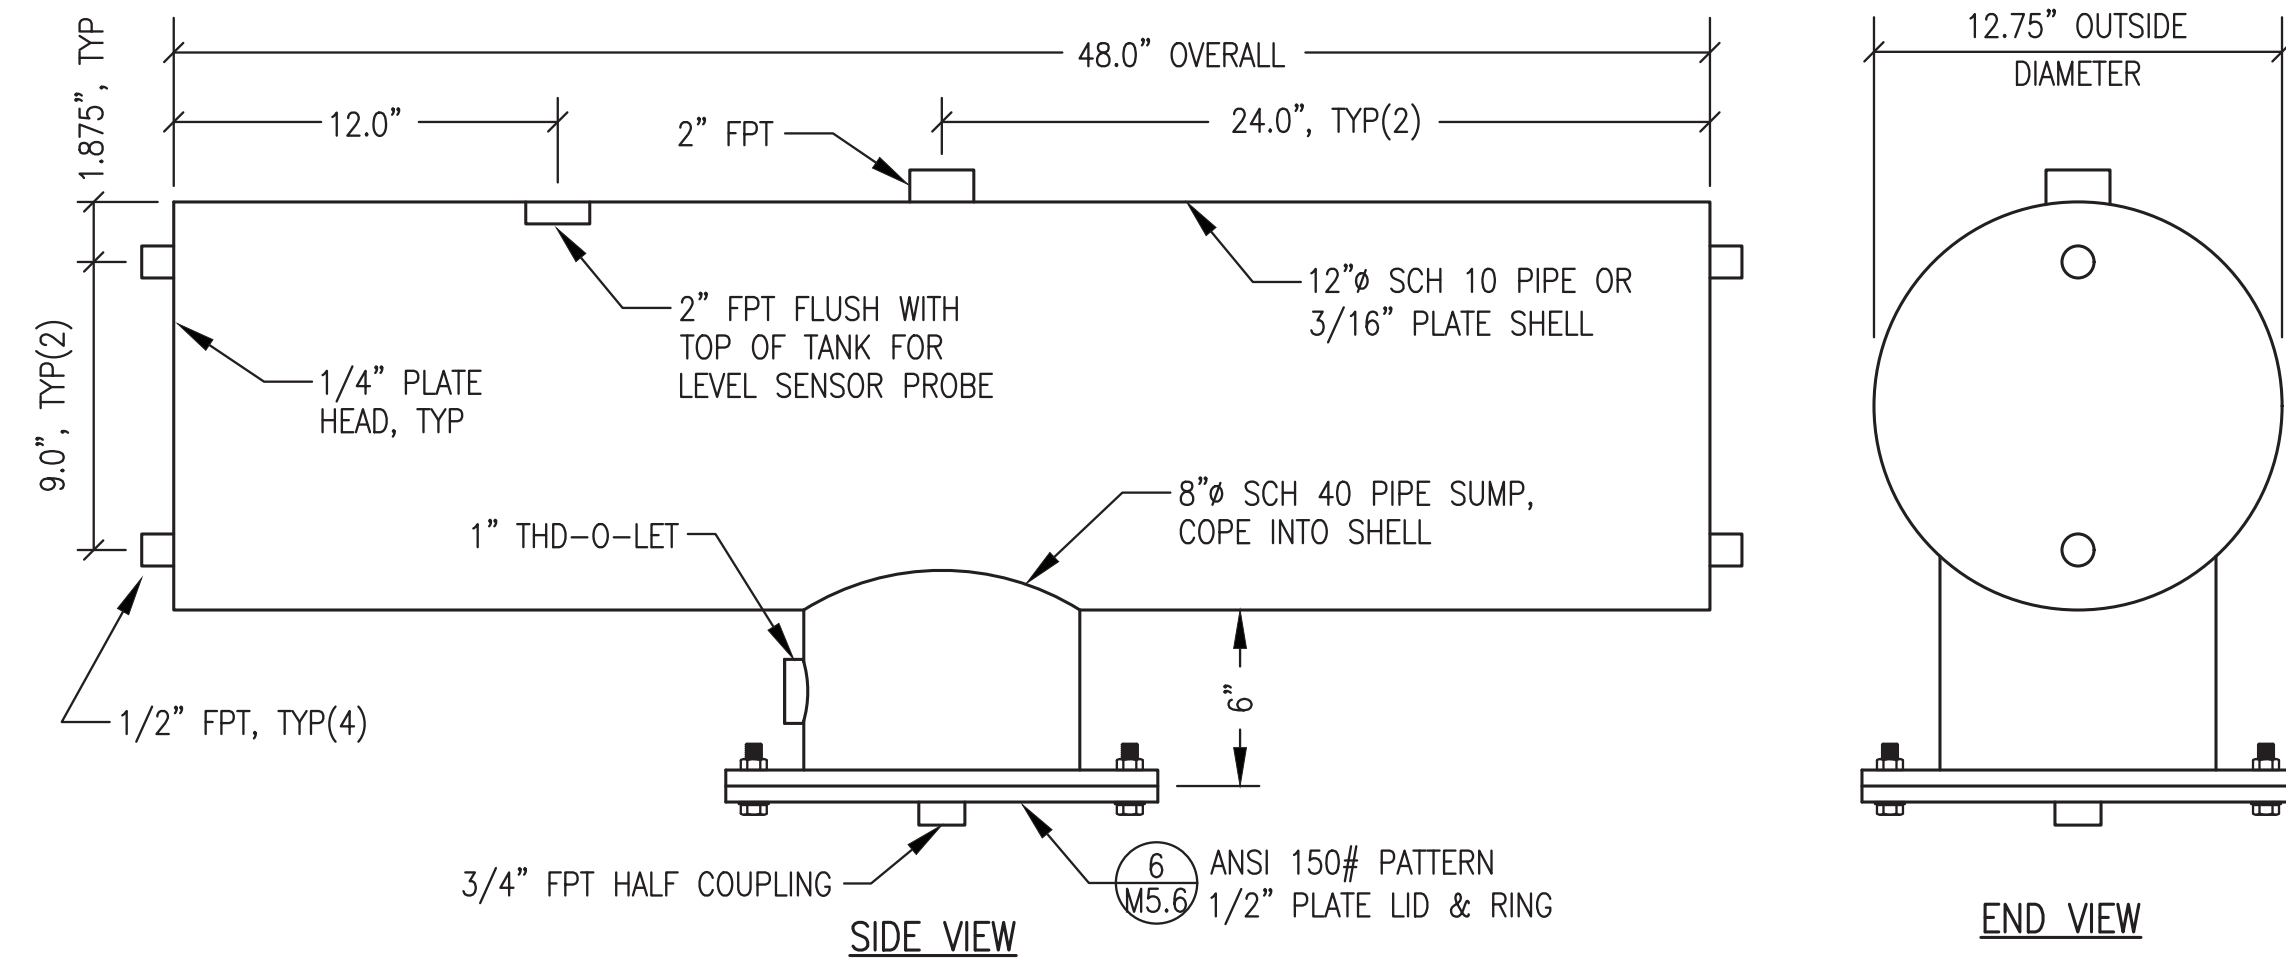

**2** 24 GALLON GLYCOL EXPANSION TANK  
M4.4 1"=6"

**1** 60 GALLON GLYCOL STORAGE TANK  
M4.4 1"=6"


ALL WORK ON THIS SHEET WAS PERFORMED AS PART OF THE PRIOR MODULE ASSEMBLY CONTRACT AND IS SHOWN HERE FOR REFERENCE ONLY.

ISSUED FOR CONSTRUCTION  
MAY 2023




PROJECT: NELSON LAGOON POWER SYSTEM UPGRADE		
TITLE: GLYCOL STORAGE & EXPANSION TANKS FABRICATION		
DRAWN BY: JTD	DESIGNED BY: BCG	SCALE: AS NOTED
FILE NAME: NELS_PP_M2-M7	PROJECT NUMBER:	SHEET: <b>M4.4</b>
P.O. 111405, Anchorage, AK 99511 (907)349-0100		



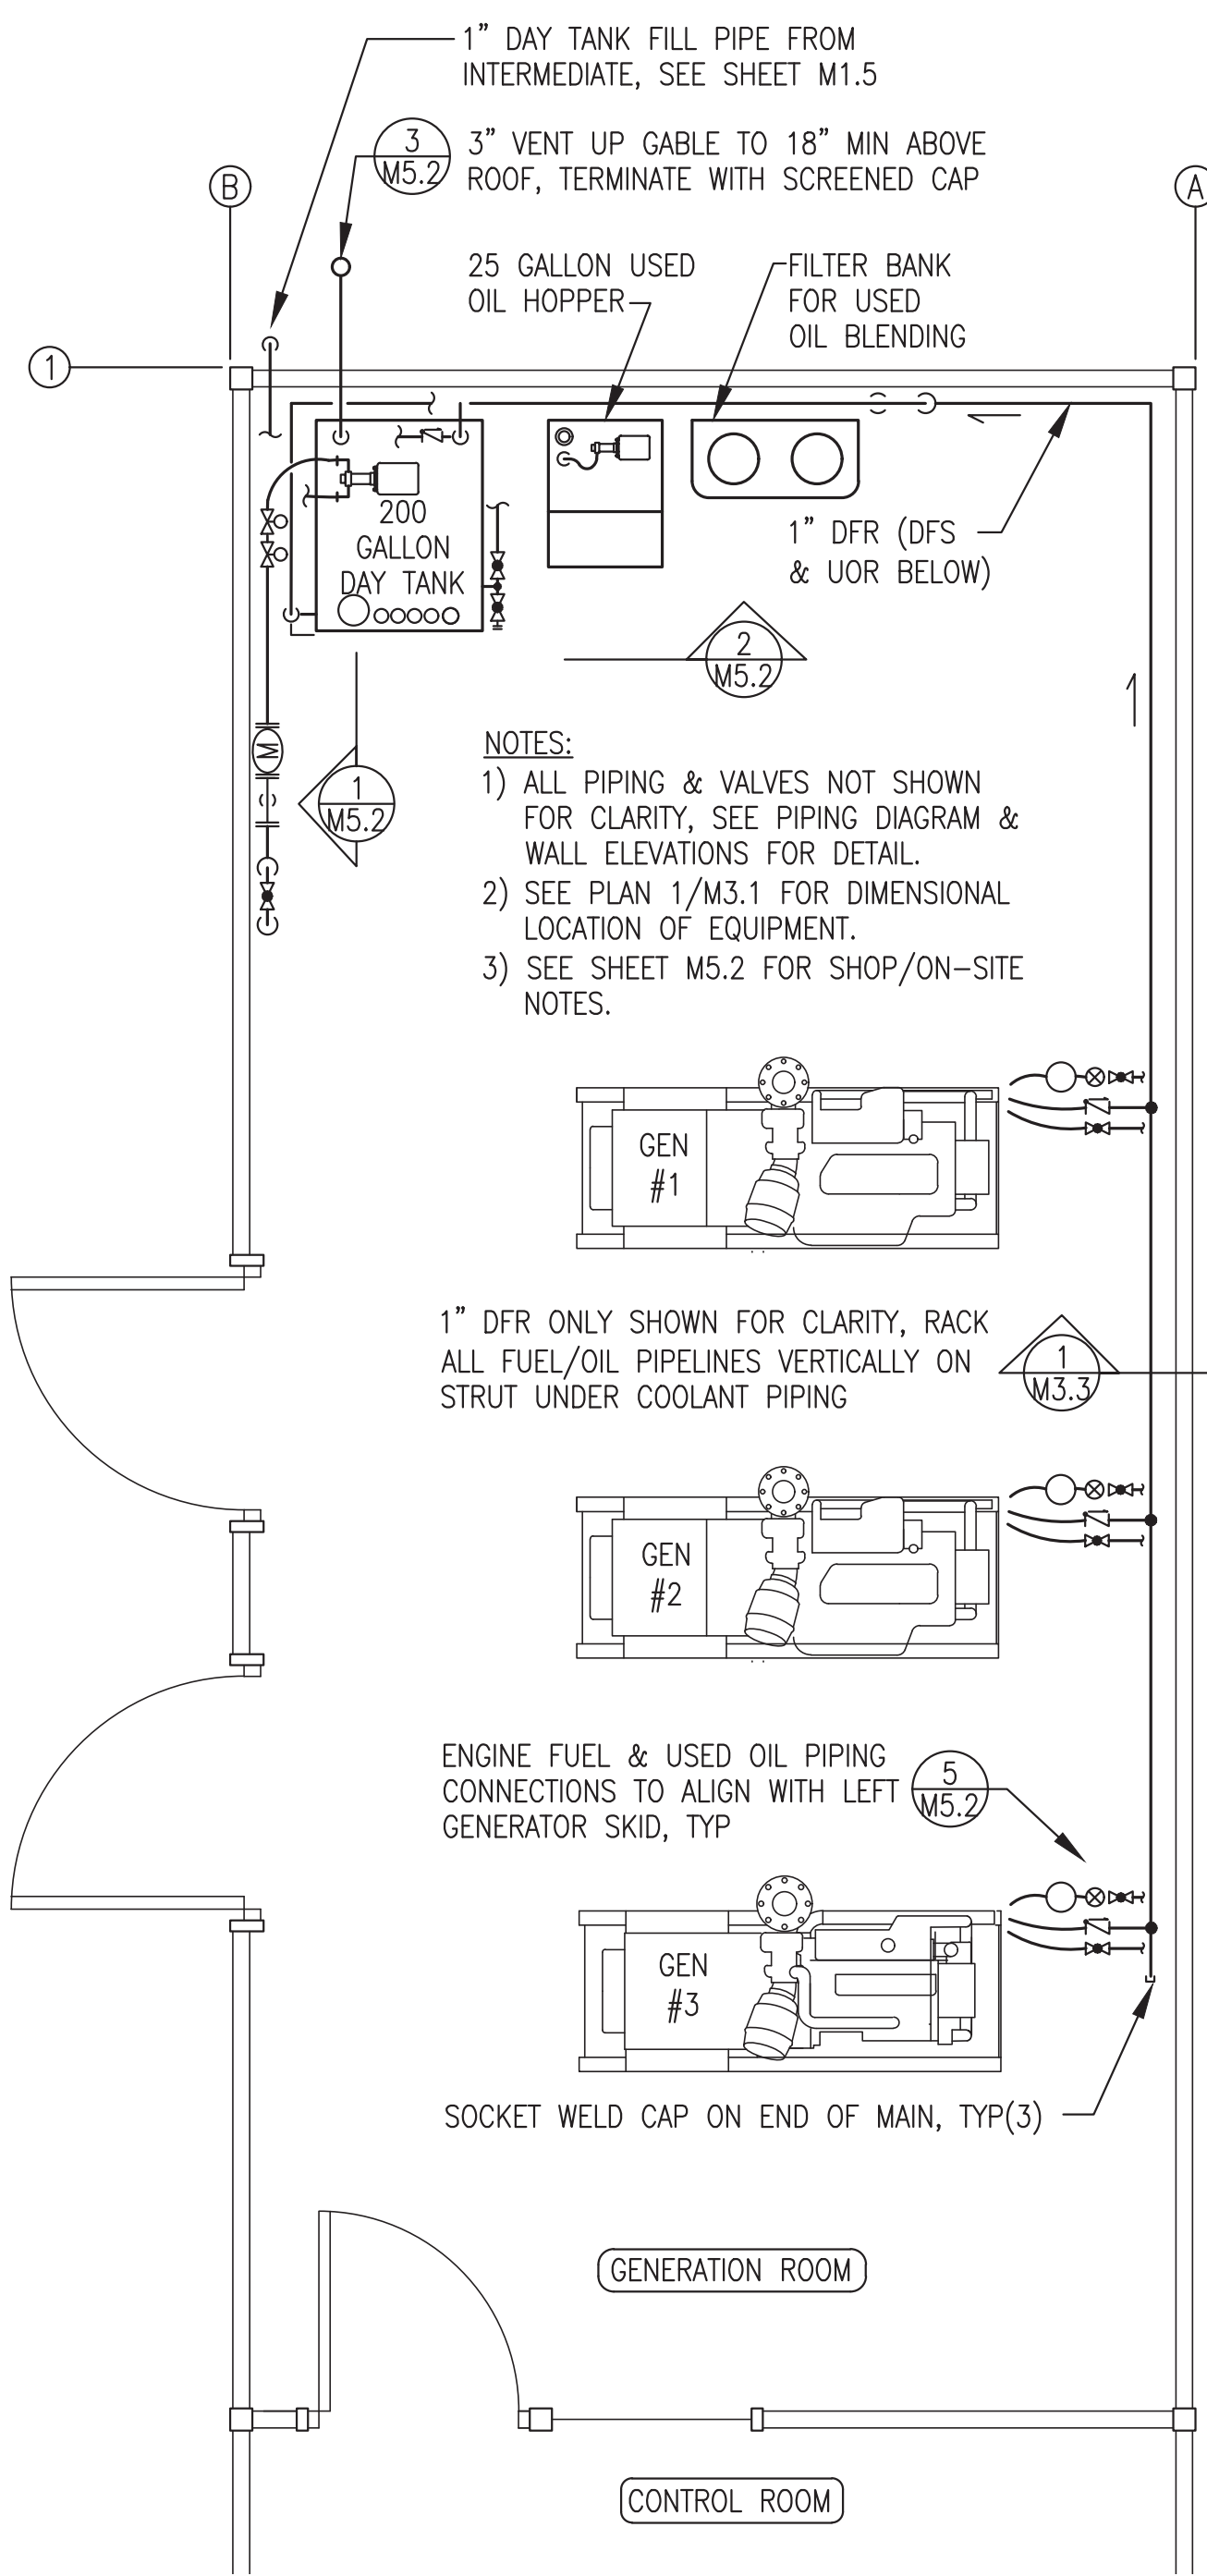

**1** DIESEL FUEL SYSTEM & USED OIL PIPING PLAN  
M5.1 3/8"=1'

- NOTES:**
- 1) ALL PIPING & VALVES NOT SHOWN FOR CLARITY, SEE PIPING DIAGRAM & WALL ELEVATIONS FOR DETAIL.
  - 2) SEE PLAN 1/M3.1 FOR DIMENSIONAL LOCATION OF EQUIPMENT.
  - 3) SEE SHEET M5.2 FOR SHOP/ON-SITE NOTES.

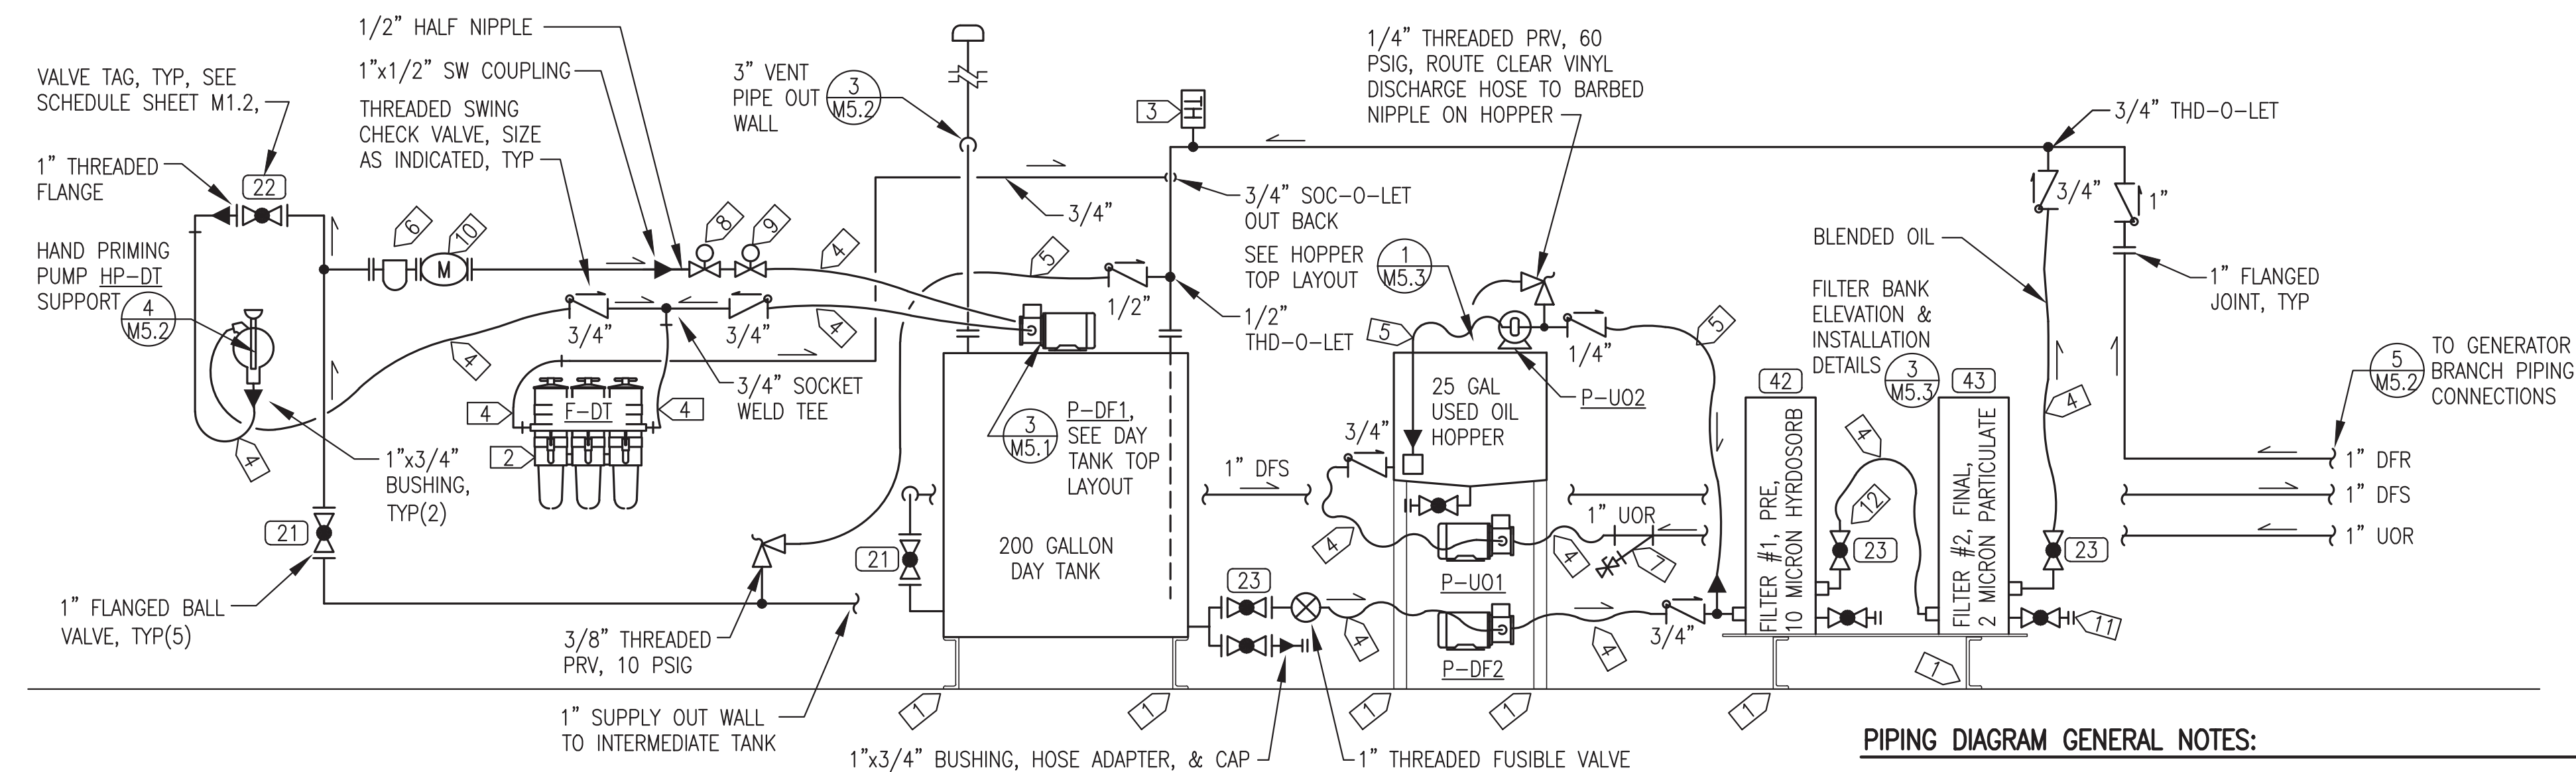


**PIPING DIAGRAM SPECIFIC NOTES:**

- |                                                                                                                             |                                                                                |                                                               |
|-----------------------------------------------------------------------------------------------------------------------------|--------------------------------------------------------------------------------|---------------------------------------------------------------|
| 1) FASTEN DEVICE TO FLOOR WITH MIN 1"x3/16" FILLET WELD ALL 4 CORNERS, WIRE BRUSH AND RE-PAINT WELD AREA TO MATCH EXISTING. | 5) #6 HOSE WITH 1/8", 1/4", OR 3/8" NPT ENDS.                                  | 9) 1/2" NC SOLENOID VALVE.                                    |
| 2) 3/4" THREADED DUAL FILTER BANK F-DI.                                                                                     | 6) 1" FLANGED BASKET STRAINER IN 1" DAY TANK SUPPLY WITH GAUGE COCK BLOW DOWN. | 10) METER M-DI EQUIPPED WITH 1" ANSI 150# FLANGED ENDS.       |
| 3) DIGITAL THERMOMETER, INSTALL WELL IN 3/4" THREAD-O-LET.                                                                  | 7) 1" THREADED "Y" STRAINER IN 1" UOR WITH GAUGE COCK BLOW DOWN.               | 11) 3/4" THREADED BALL VALVE WITH HOSE ADAPTER & CAP, TYP(3). |
| 4) #10 HOSE WITH 1/2" OR 3/4" NPT ENDS TO MATCH EQUIPMENT.                                                                  | 8) 1/2" NO SOLENOID VALVE.                                                     | 12) 3/4" THREADED BALL VALVE, TYP(2).                         |


**PIPING DIAGRAM GENERAL NOTES:**

- 1) FABRICATE DAY TANK, FILTER BANK, & HOPPER IN ACCORDANCE WITH FABRICATION DETAILS.
- 2) ALL DFS, DFR & UOR PIPING 1" SCH 80 EXCEPT WHERE INDICATED AS 3/4". ALL VENT PIPING 3" SCH 40.
- 3) ALL DFS, DFR & UOR PIPING JOINTS SOCKET OR BUTT WELD EXCEPT FOR THREADED CONNECTIONS TO EQUIPMENT & VALVES. ALL VENT PIPING JOINTS THREADED.
- 4) ON ALL HOSES FIELD INSTALL JIC/NPT SWIVEL ENDS, SIZE REQUIRED TO MATCH PIPING, PUMPS, OR EQUIPMENT.
- 5) PRIOR TO CONNECTING HOSES TO PUMPS, FILL CAVITIES WITH LUBE OIL AND VERIFY PROPER ROTATION AND INLET/OUTLET CONNECTIONS.


**2** DIESEL FUEL & USED OIL PIPING DIAGRAM  
M5.1 NO SCALE

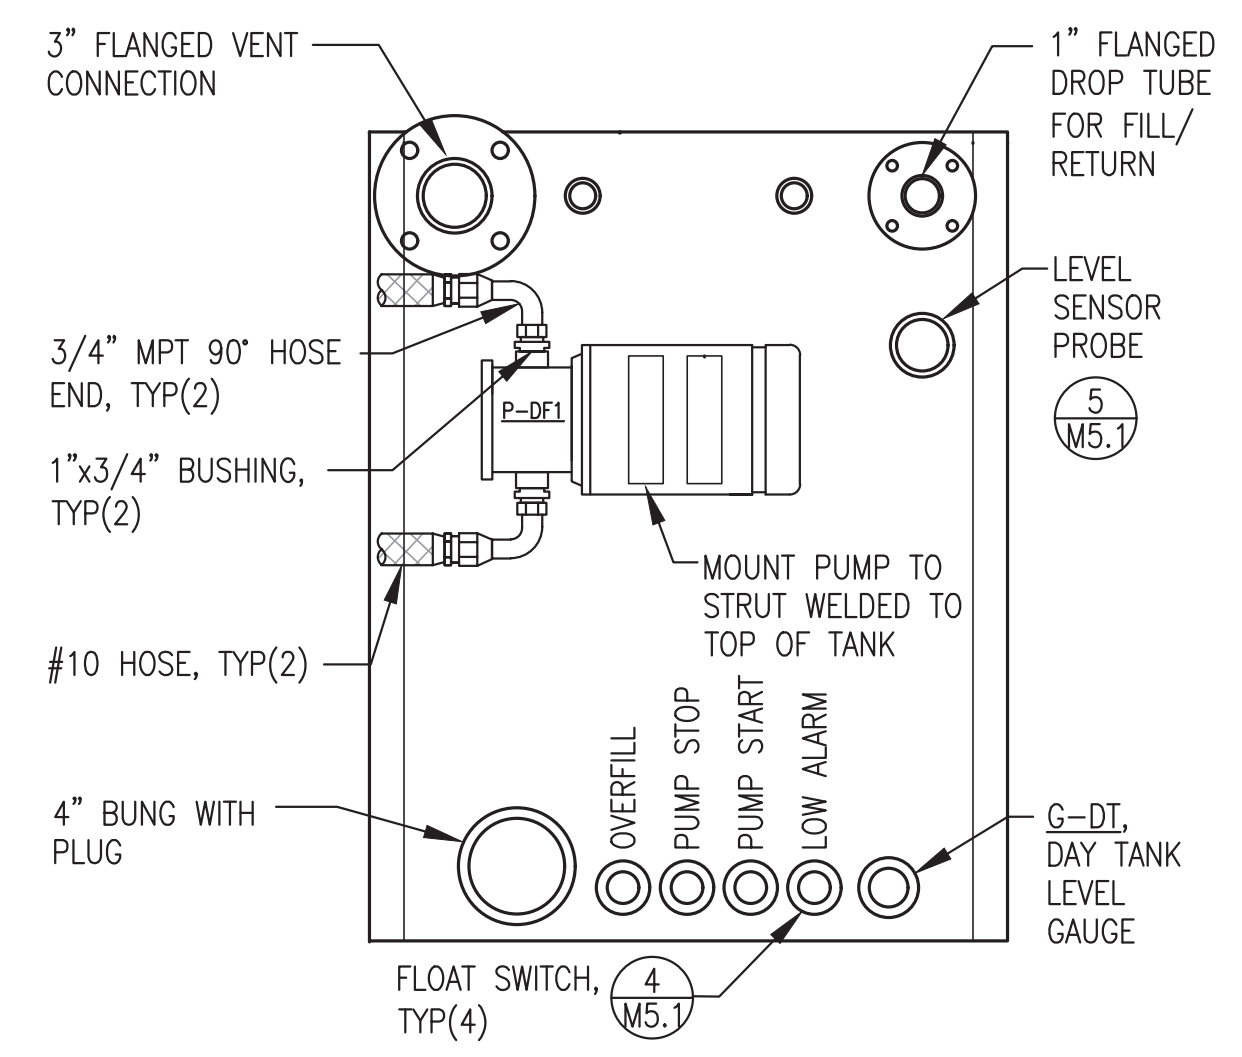

**3** TOP OF DAY TANK - PLAN VIEW  
M5.1 NO SCALE

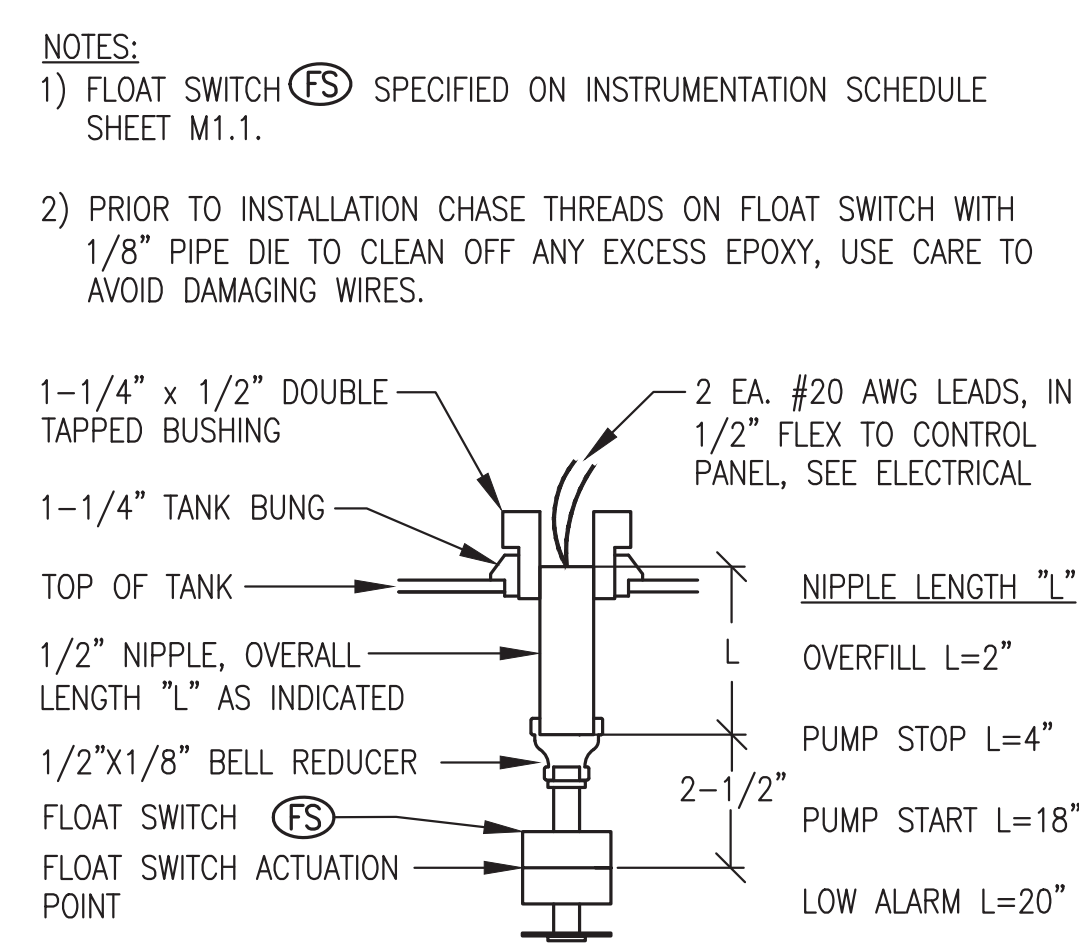


**4** DAY TANK FLOAT SWITCH INSTALLATION  
M5.1 NO SCALE

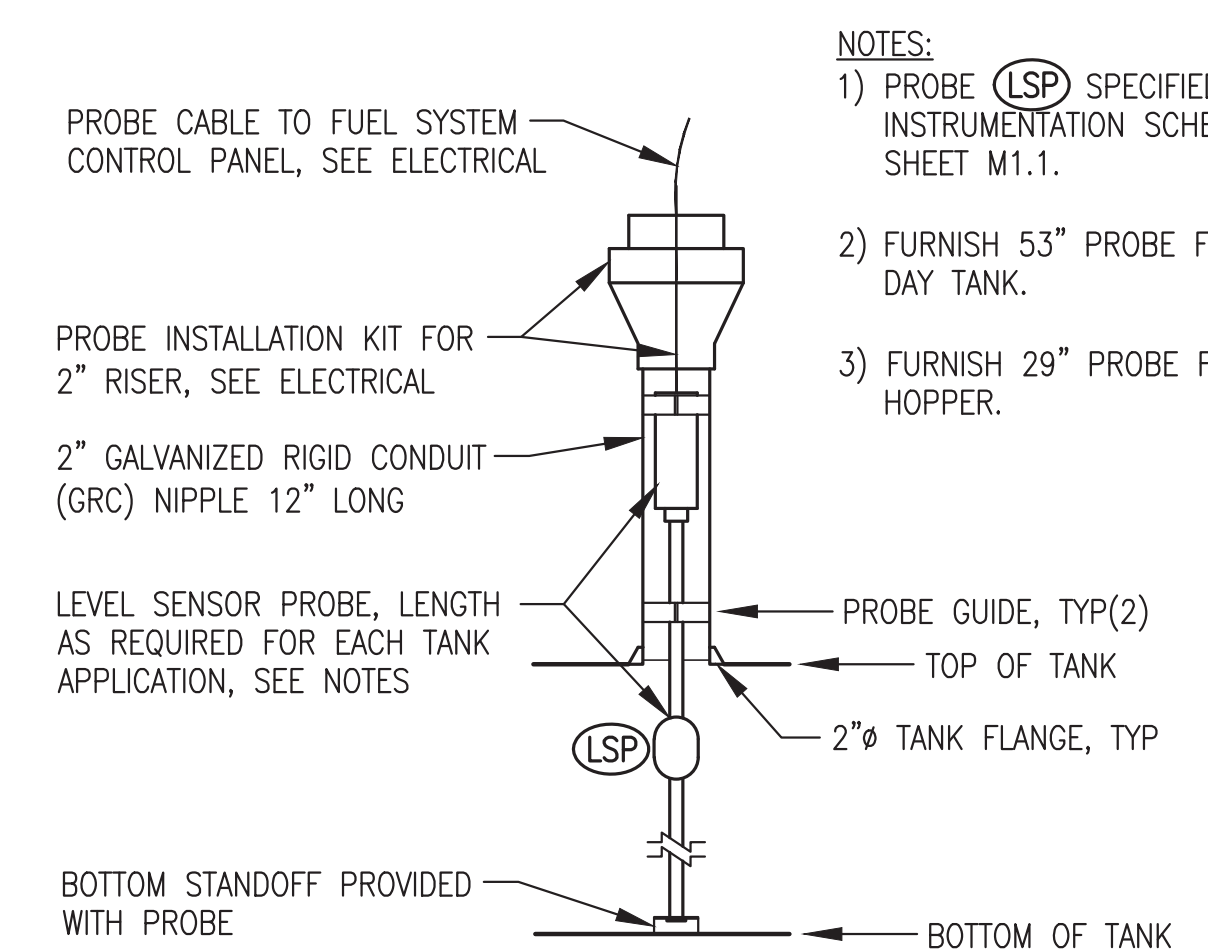

**5** TYPICAL LEVEL SENSOR PROBE INSTALLATION  
M5.1 NO SCALE

ALL WORK ON THIS SHEET WAS PERFORMED AS PART OF THE PRIOR MODULE ASSEMBLY CONTRACT AND IS SHOWN HERE FOR REFERENCE ONLY.


ISSUED FOR CONSTRUCTION  
MAY 2023

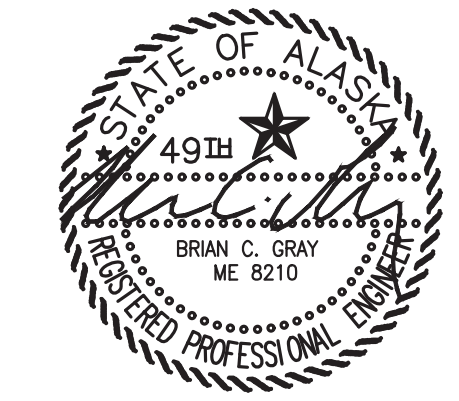

PROJECT: <b>NELSON LAGOON POWER SYSTEM UPGRADE</b>	
TITLE: <b>DIESEL FUEL &amp; USED OIL PIPING PLAN, DIAGRAM, &amp; DETAILS</b>	
DESIGNED BY: BCG	SCALE: AS NOTED
FILE NAME: NELS PP M2-M7	DATE: 5/30/23
PROJECT NUMBER:	SHEET: <b>M5.1</b>




P.O. 111405, Anchorage, AK 99511 (907)349-0100

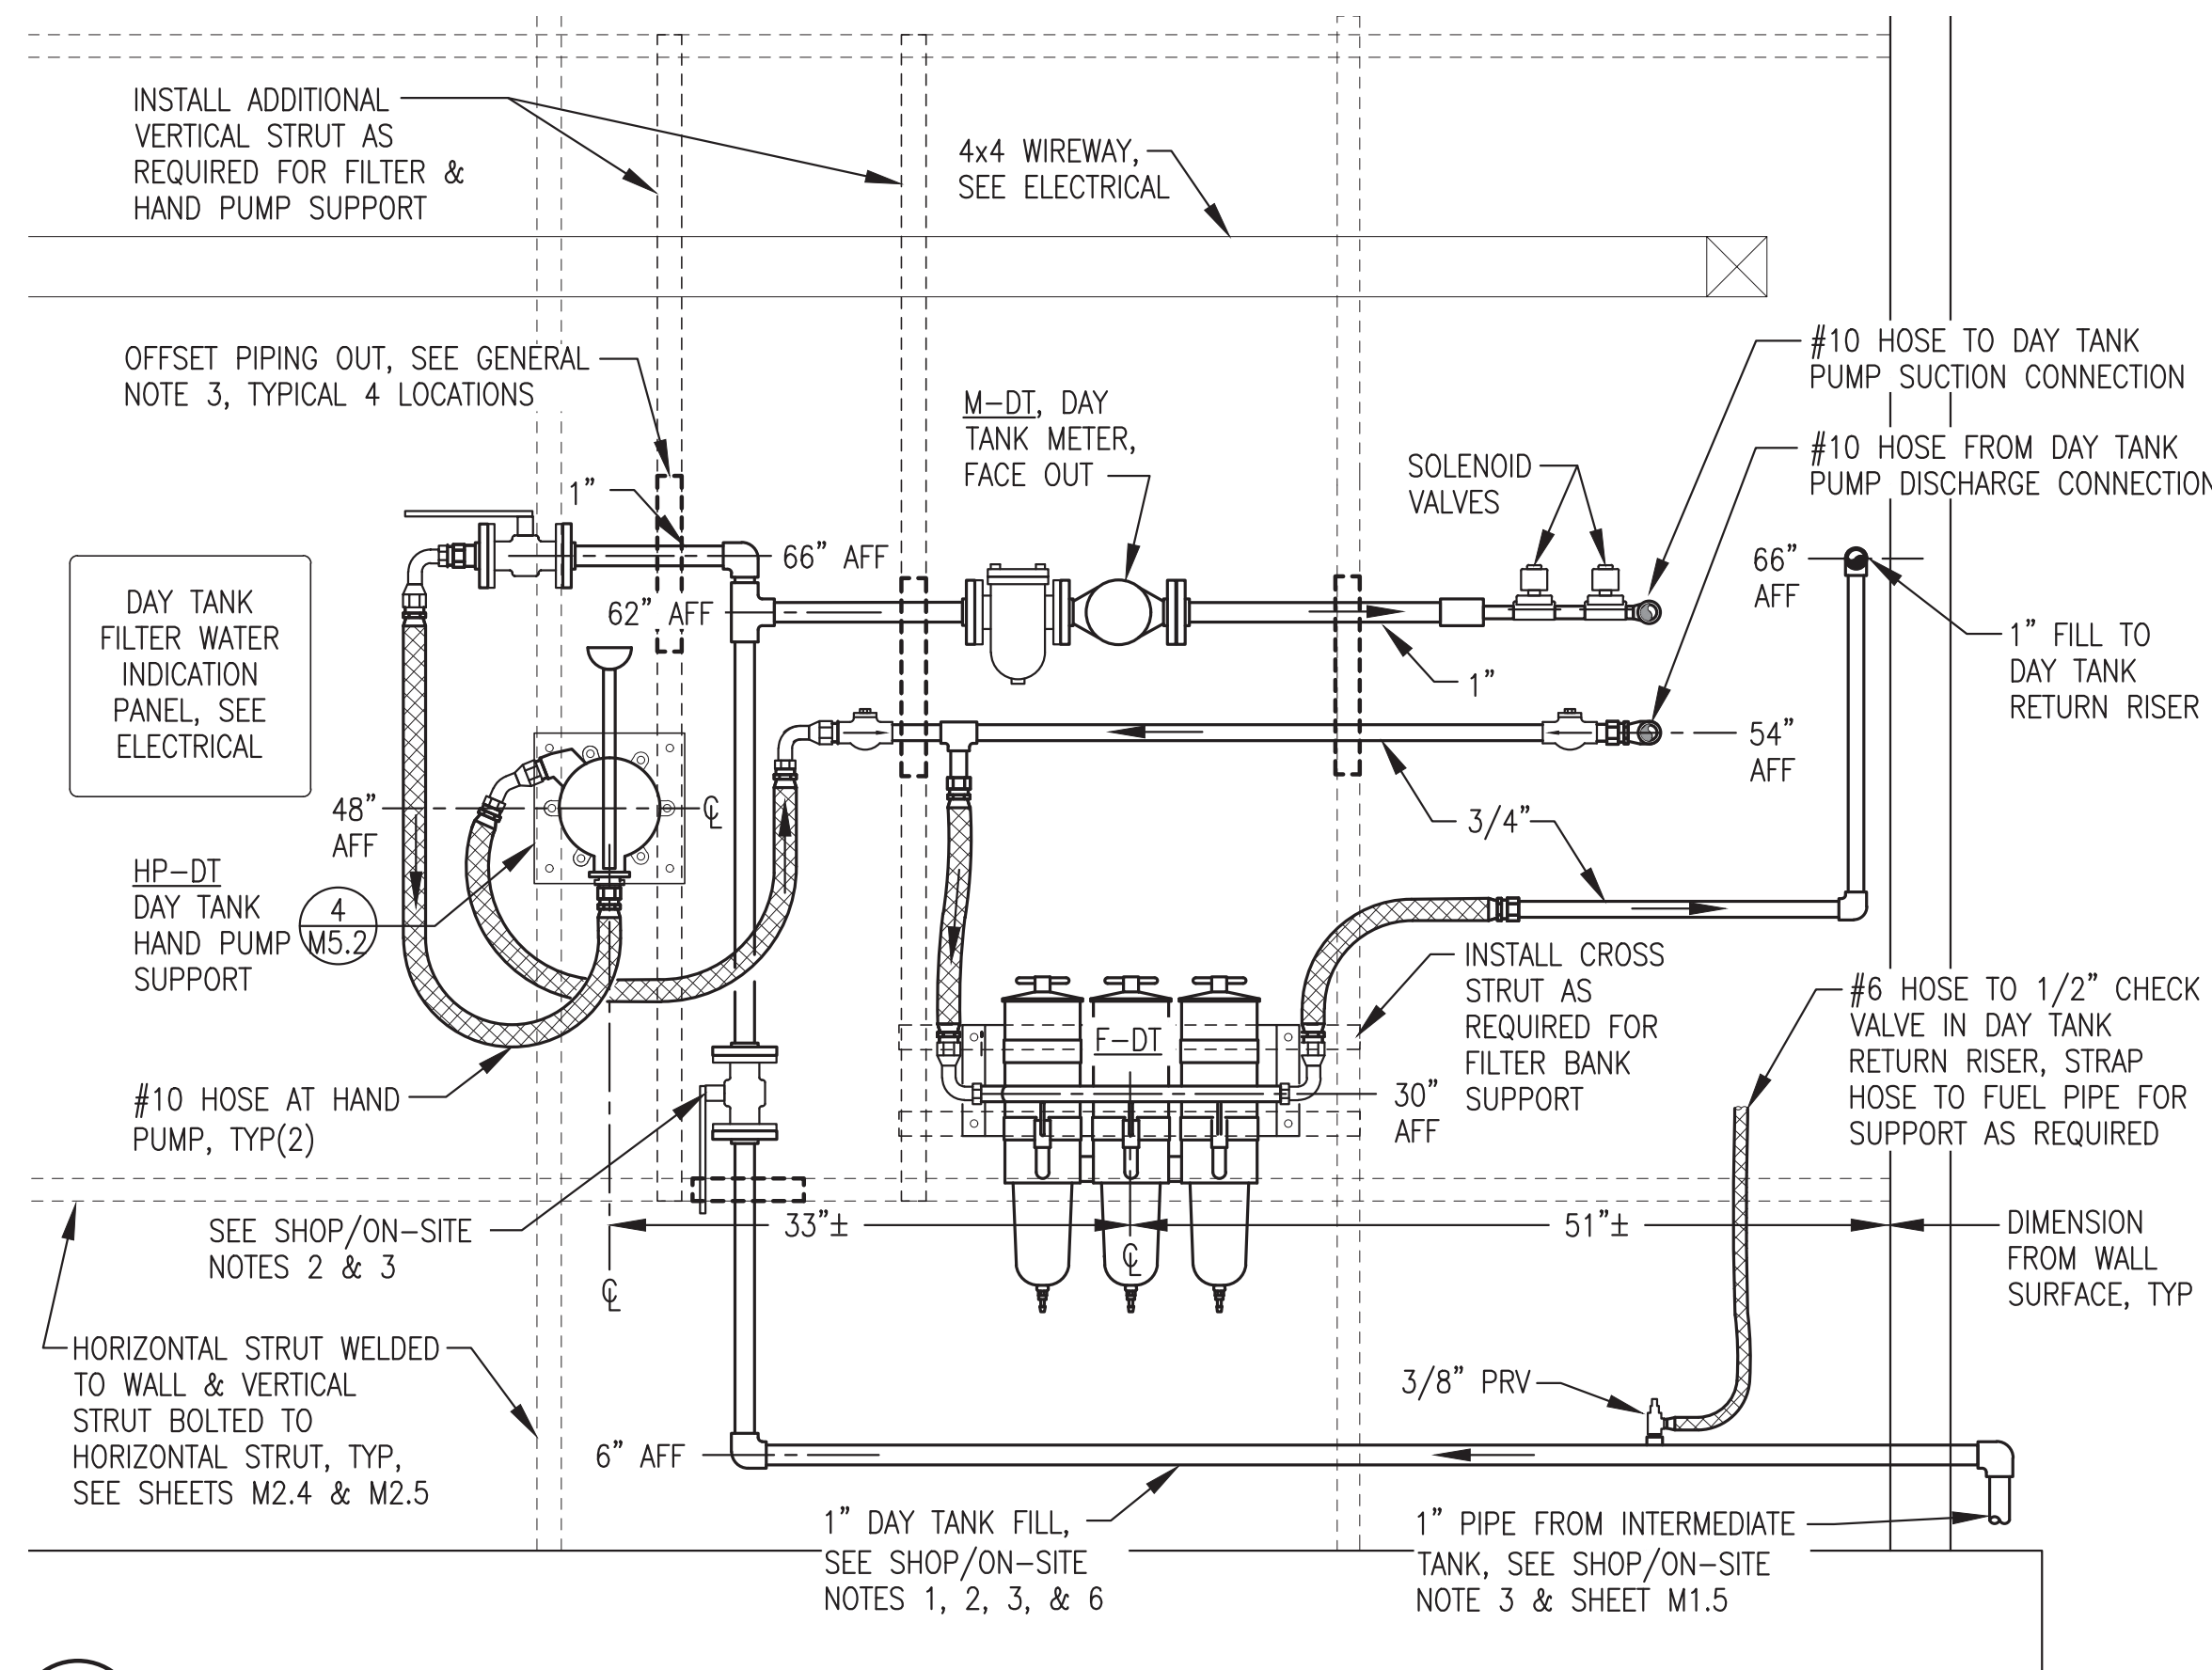


1 DIESEL FUEL FRONT WALL ELEVATION  
M5.2 1"=1"

- GENERAL NOTES:**
- GENERAL LAYOUT SHOWN ONLY THIS ELEVATION. SEE PIPING DIAGRAM FOR COMPLETE INSTALLATION DETAILS.
  - CLAMP PIPE TO STRUT INSTALLED ON WALL, SEE SHEET M2.5.
  - ADD SHORT SECTIONS OF SHALLOW STRUT AT 4 LOCATIONS SHOWN TO OFFSET PIPING OUT TO ALLOW DAY TANK METER TO BE INSTALLED FACING OUT.
- FUEL SHOP/ON-SITE NOTES:**
- DURING SHOP FABRICATION HOLE SAW 1-1/2" Ø OPENING FOR DAY TANK FILL PIPE, STUB PIPE 12" MIN BEYOND WALL, & TERMINATE WITH 1" MALE THREAD FOR TESTING.
  - UPON COMPLETION OF TESTING CLOSE VALVE, DRAIN PIPE, DISCONNECT FLANGE FROM VALVE THEN SLIDE PIPE OVER & SECURE FOR SHIPPING. SEAL WALL OPENING.
  - AS PART OF ON-SITE INSTALLATION REINSTALL FILL PIPE THEN CUT THREADS OFF EXTERIOR END & INSTALL SOCKET WELD ELBOW.
  - DURING SHOP FABRICATION INSTALL TEMPORARY VENT PIPE OUT WALL. UPON COMPLETION OF TESTING REMOVE TEMPORARY PIPE & SEAL WALL OPENING FOR SHIPPING.
  - AS PART OF ON-SITE INSTALLATION INSTALL 3" GALVANIZED THREADED VENT PIPE OUT WALL & UP TO VENT CAP. SEE DETAIL 3/M5.2.
  - UPON FINAL ON-SITE ASSEMBLY SEAL 1" FILL PIPE TO EXTERIOR WALL & 3" VENT PIPE TO WALL SLEEVE WITH POLYURETHANE CAULKING ALL AROUND.

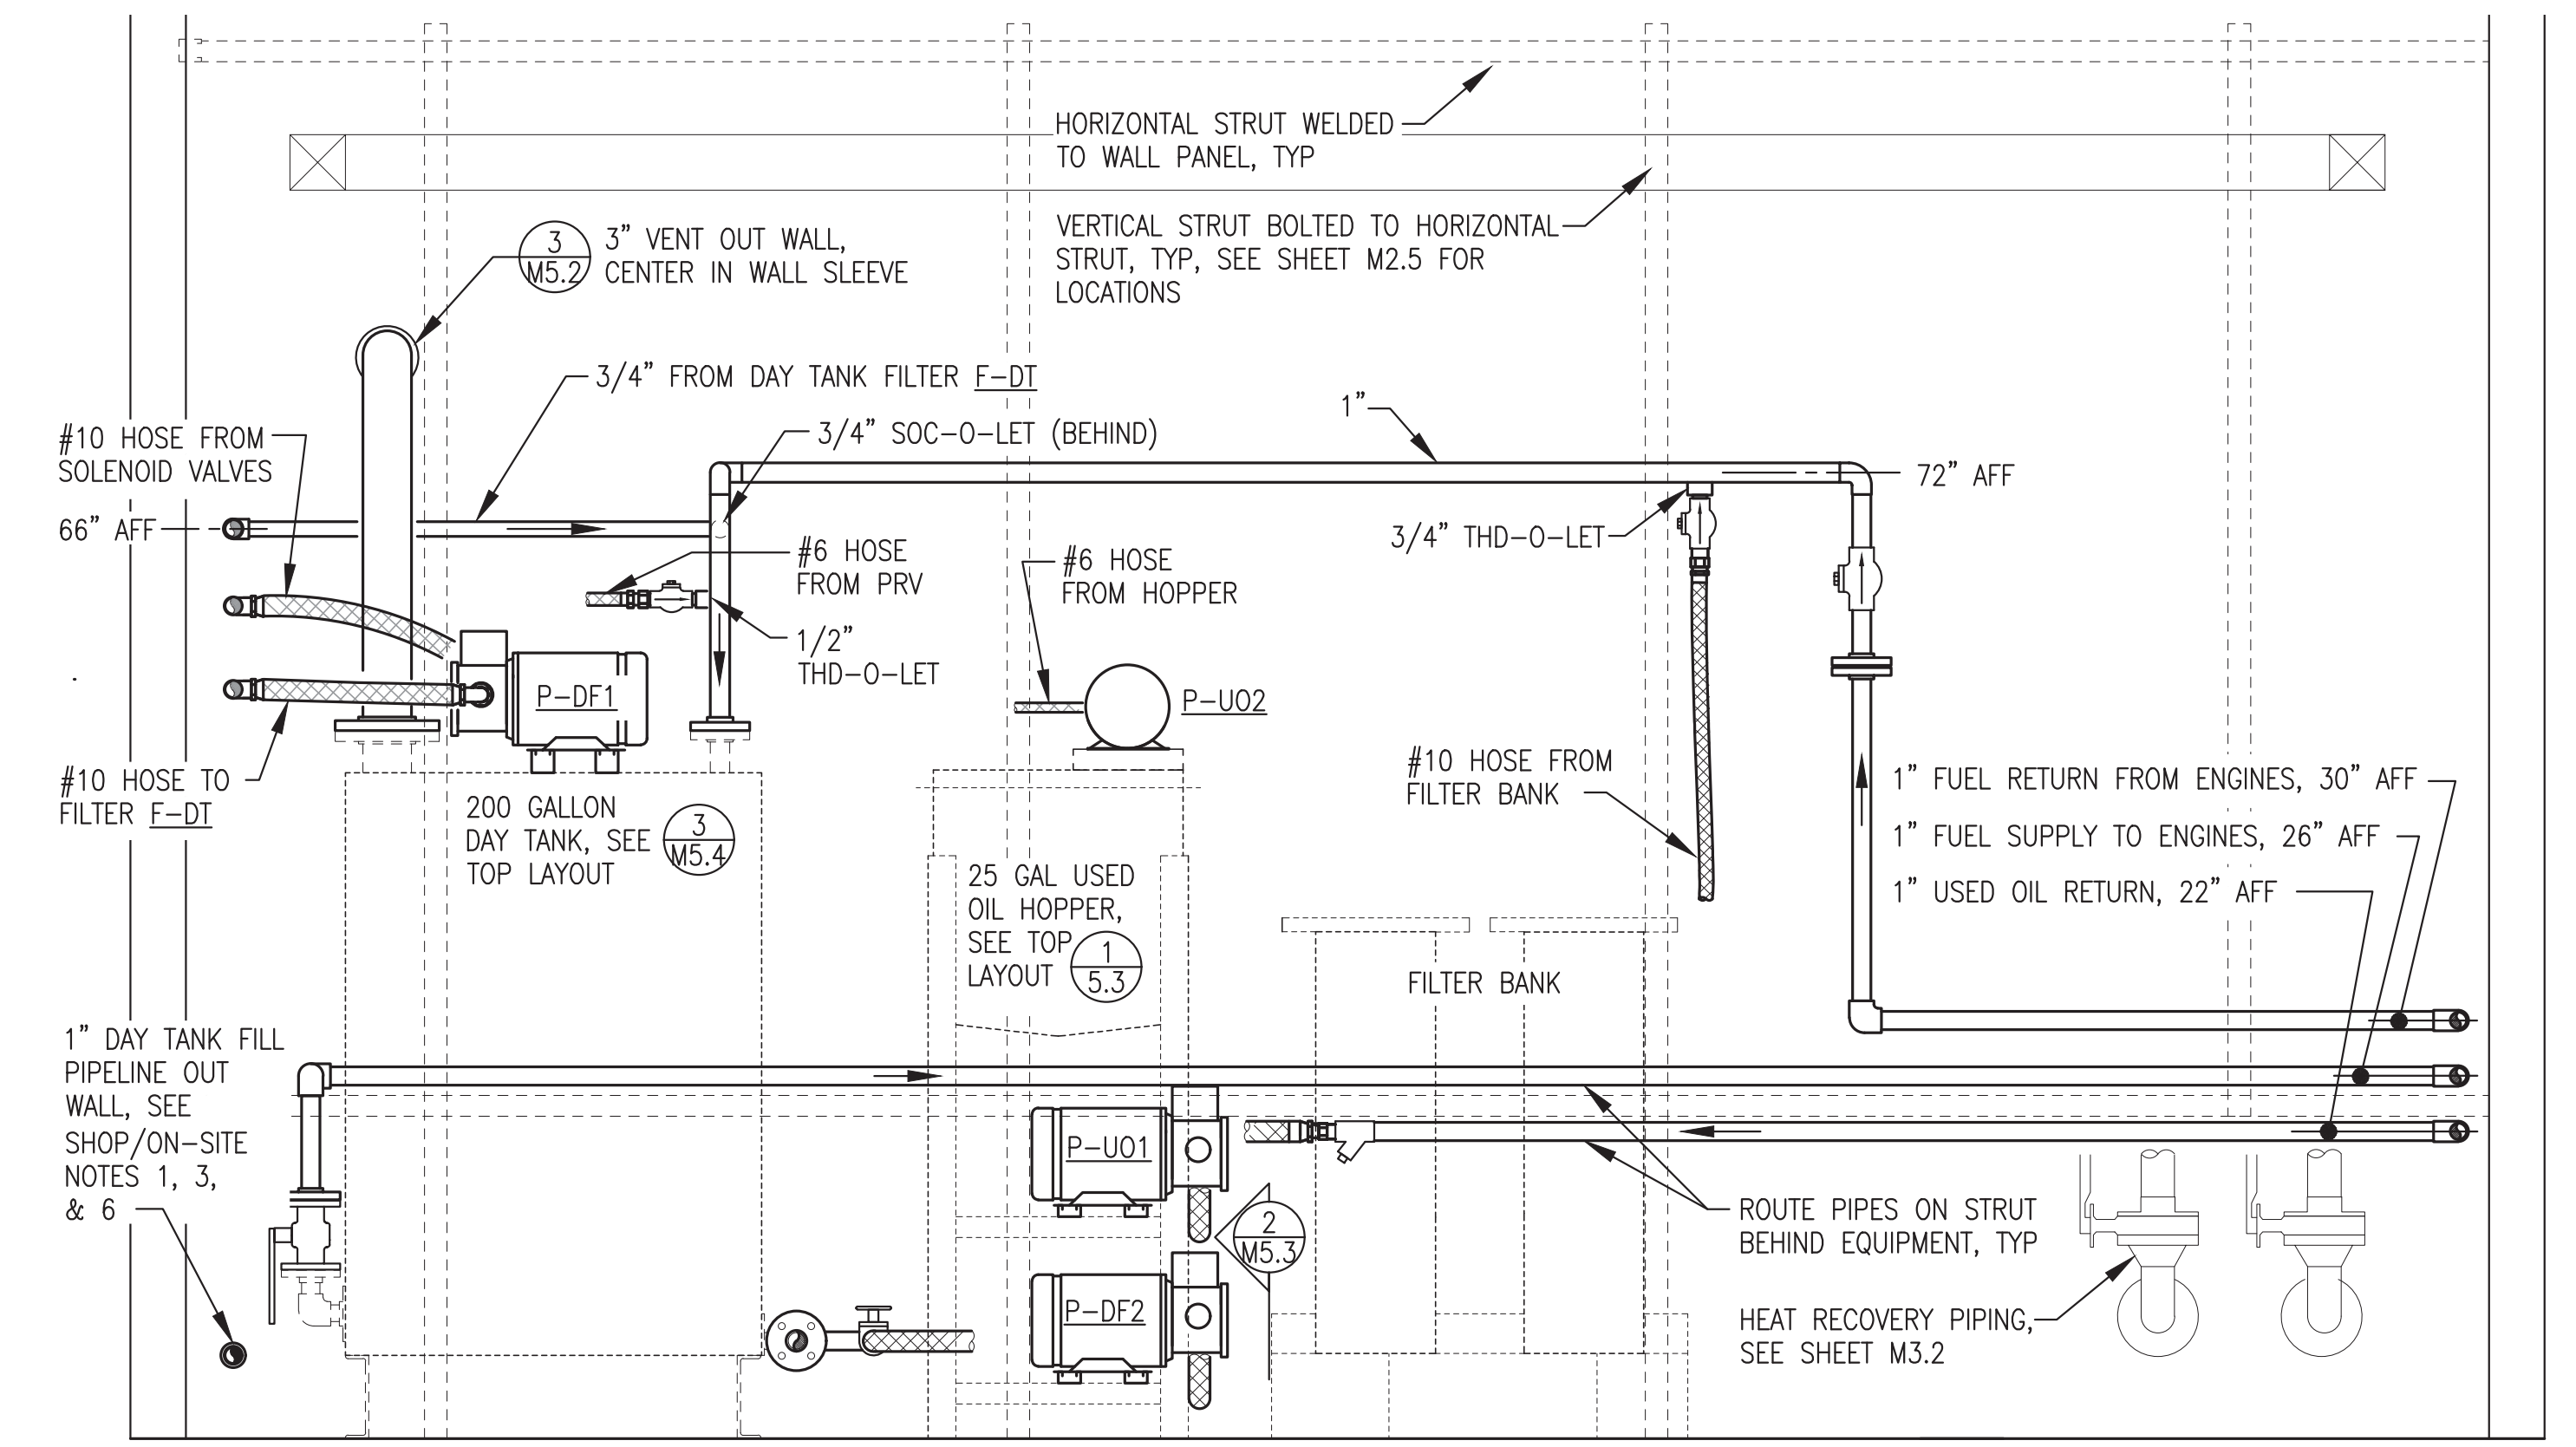


2 DIESEL FUEL & USED OIL END WALL ELEVATION  
M5.2 1"=1"

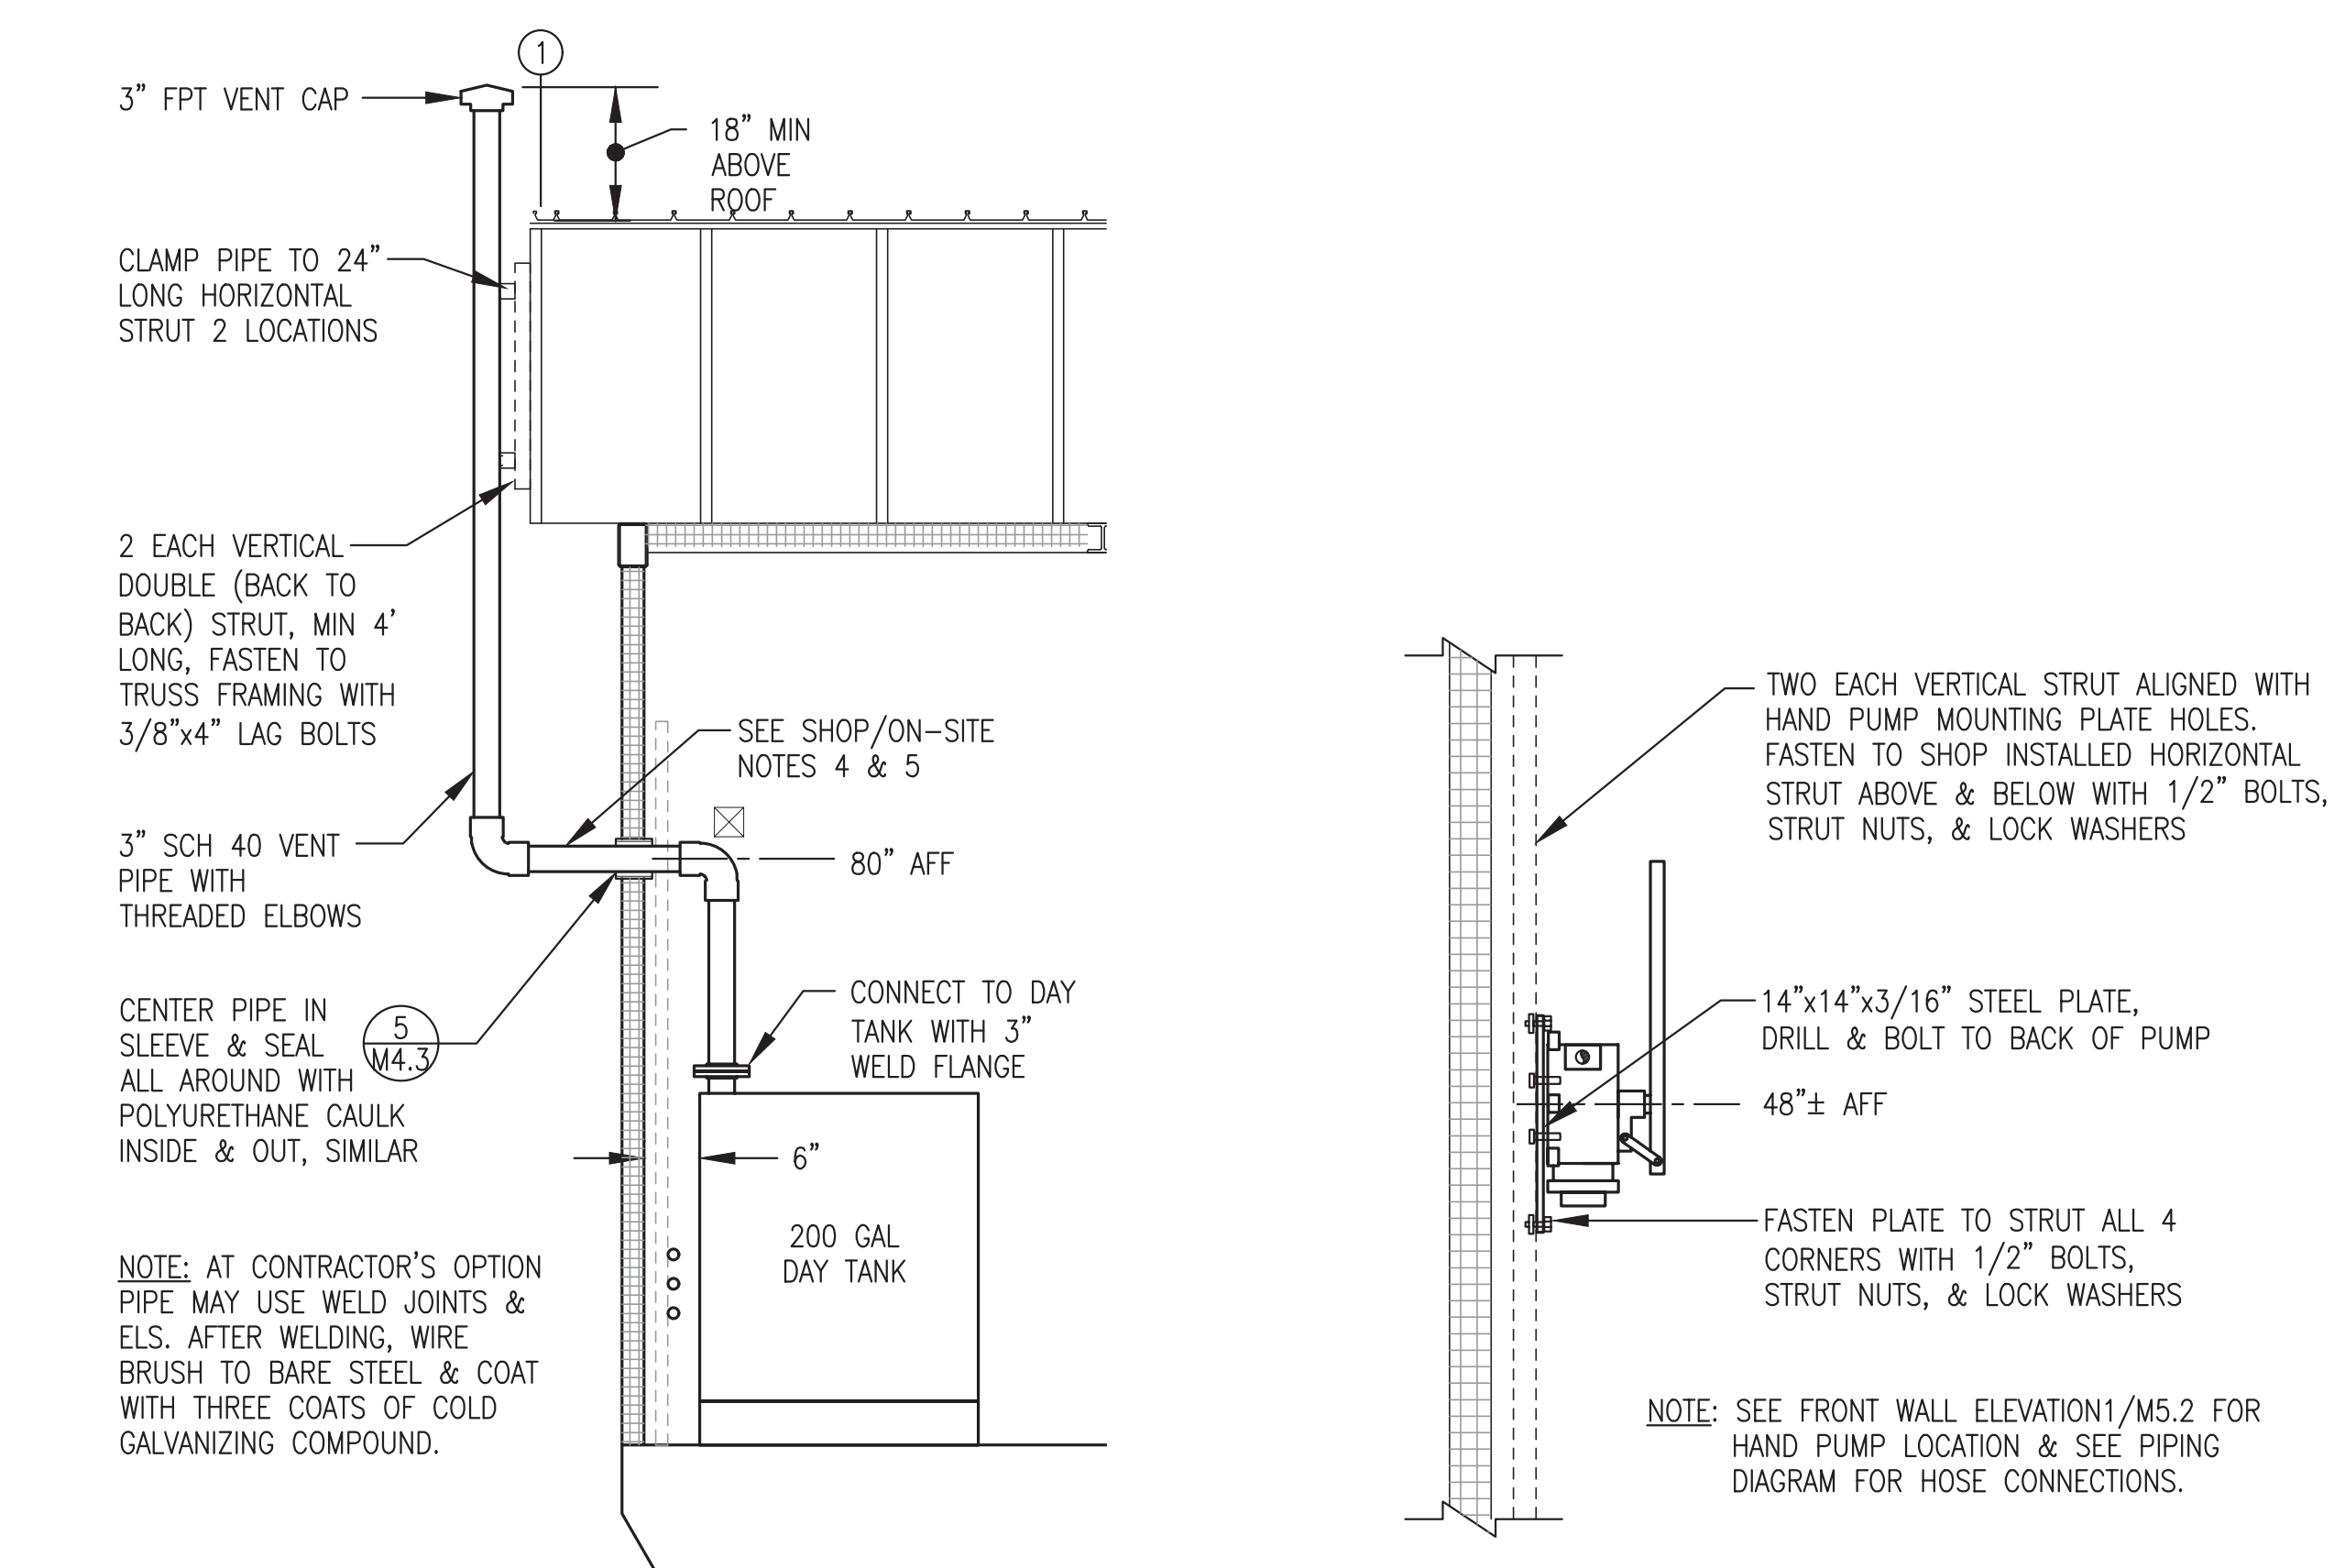

3 DAY TANK VENT INSTALLATION  
M5.2 1/2"=1'-0"

4 DAY TANK HAND PUMP HP-DT WALL SUPPORT  
M5.2 NO SCALE

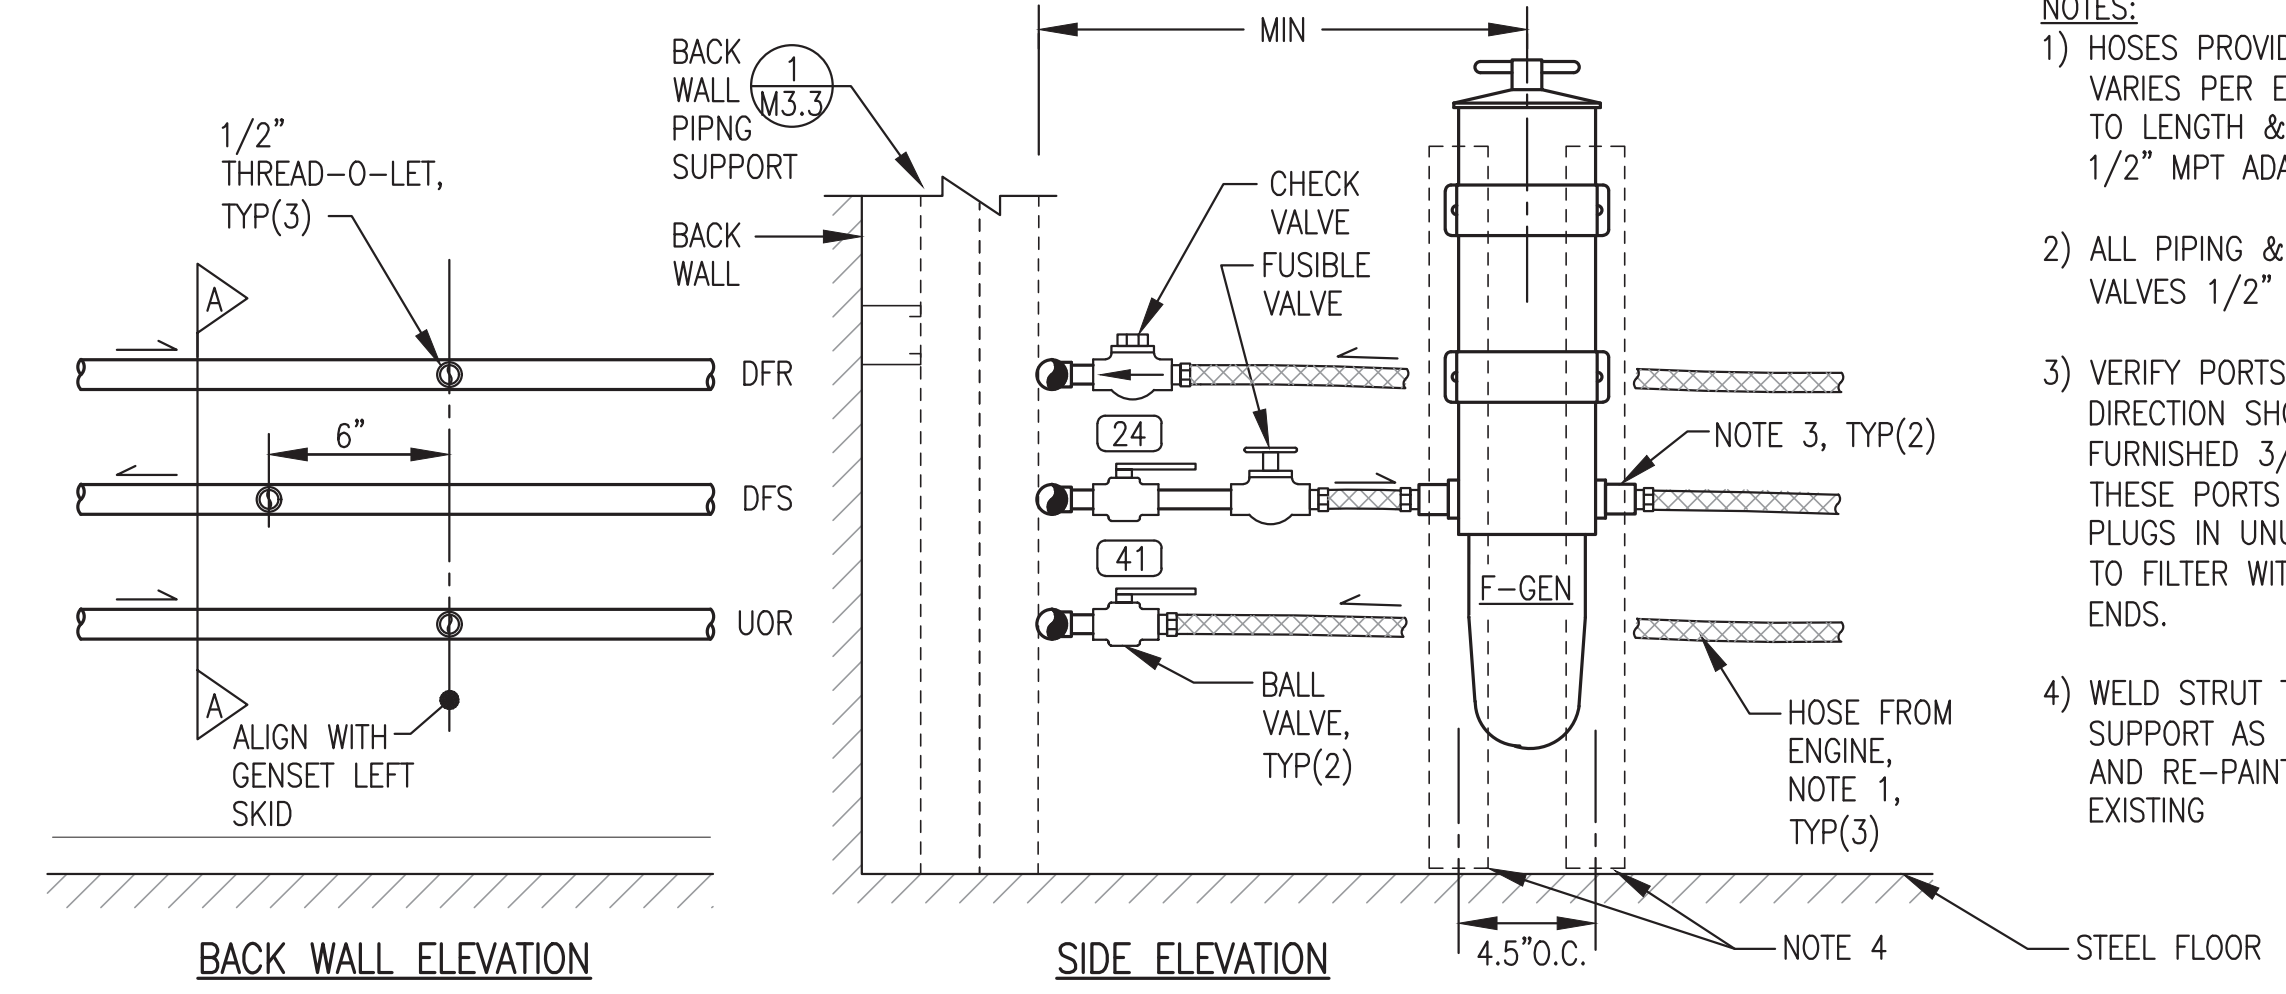


5 ENGINE FUEL PIPING CONNECTION  
M5.2 NO SCALE

- NOTES:**
- HOSES PROVIDED WITH ENGINE, SIZE VARIES PER ENGINE & PRODUCT. CUT TO LENGTH & INSTALL JIC SWIVELS & 1/2" MPT ADAPTERS.
  - ALL PIPING & NIPPLES SCH 80. ALL VALVES 1/2" SIZE, THREADED BODY.
  - VERIFY PORTS TO USE FOR FLOW IN DIRECTION SHOWN. INSTALL RACOR FURNISHED 3/4" FPT ADAPTERS IN THESE PORTS & RACOR FURNISHED PLUGS IN UNUSED PORTS. CONNECT TO FILTER WITH JIC TO 3/4" MPT HOSE ENDS.
  - WELD STRUT TO FLOOR FOR FILTER SUPPORT AS INDICATED, WIRE BRUSH AND RE-PAINT WELD AREA TO MATCH EXISTING


ALL WORK ON THIS SHEET WAS PERFORMED AS PART OF THE PRIOR MODULE ASSEMBLY CONTRACT EXCEPT AS SPECIFICALLY INDICATED IN THE SHOP/ON SITE NOTES.

ISSUED FOR CONSTRUCTION  
MAY 2023

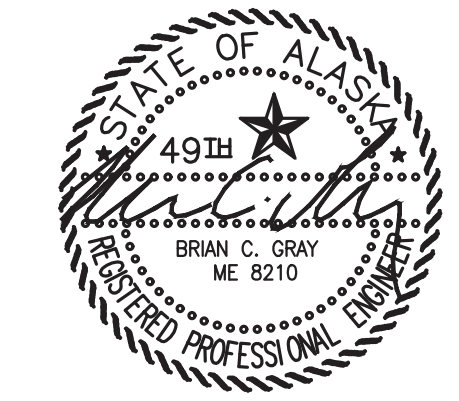


PROJECT: <b>NELSON LAGOON POWER SYSTEM UPGRADE</b>		
TITLE: <b>DIESEL FUEL &amp; USED OIL PIPING ELEVATIONS &amp; DETAILS</b>		
DRAWN BY: JTD	SCALE: AS NOTED	DESIGNED BY: BCG
FILE NAME: NELS_PP_M2-M7	DATE: 5/30/23	SHEET: M5.2
PROJECT NUMBER:		




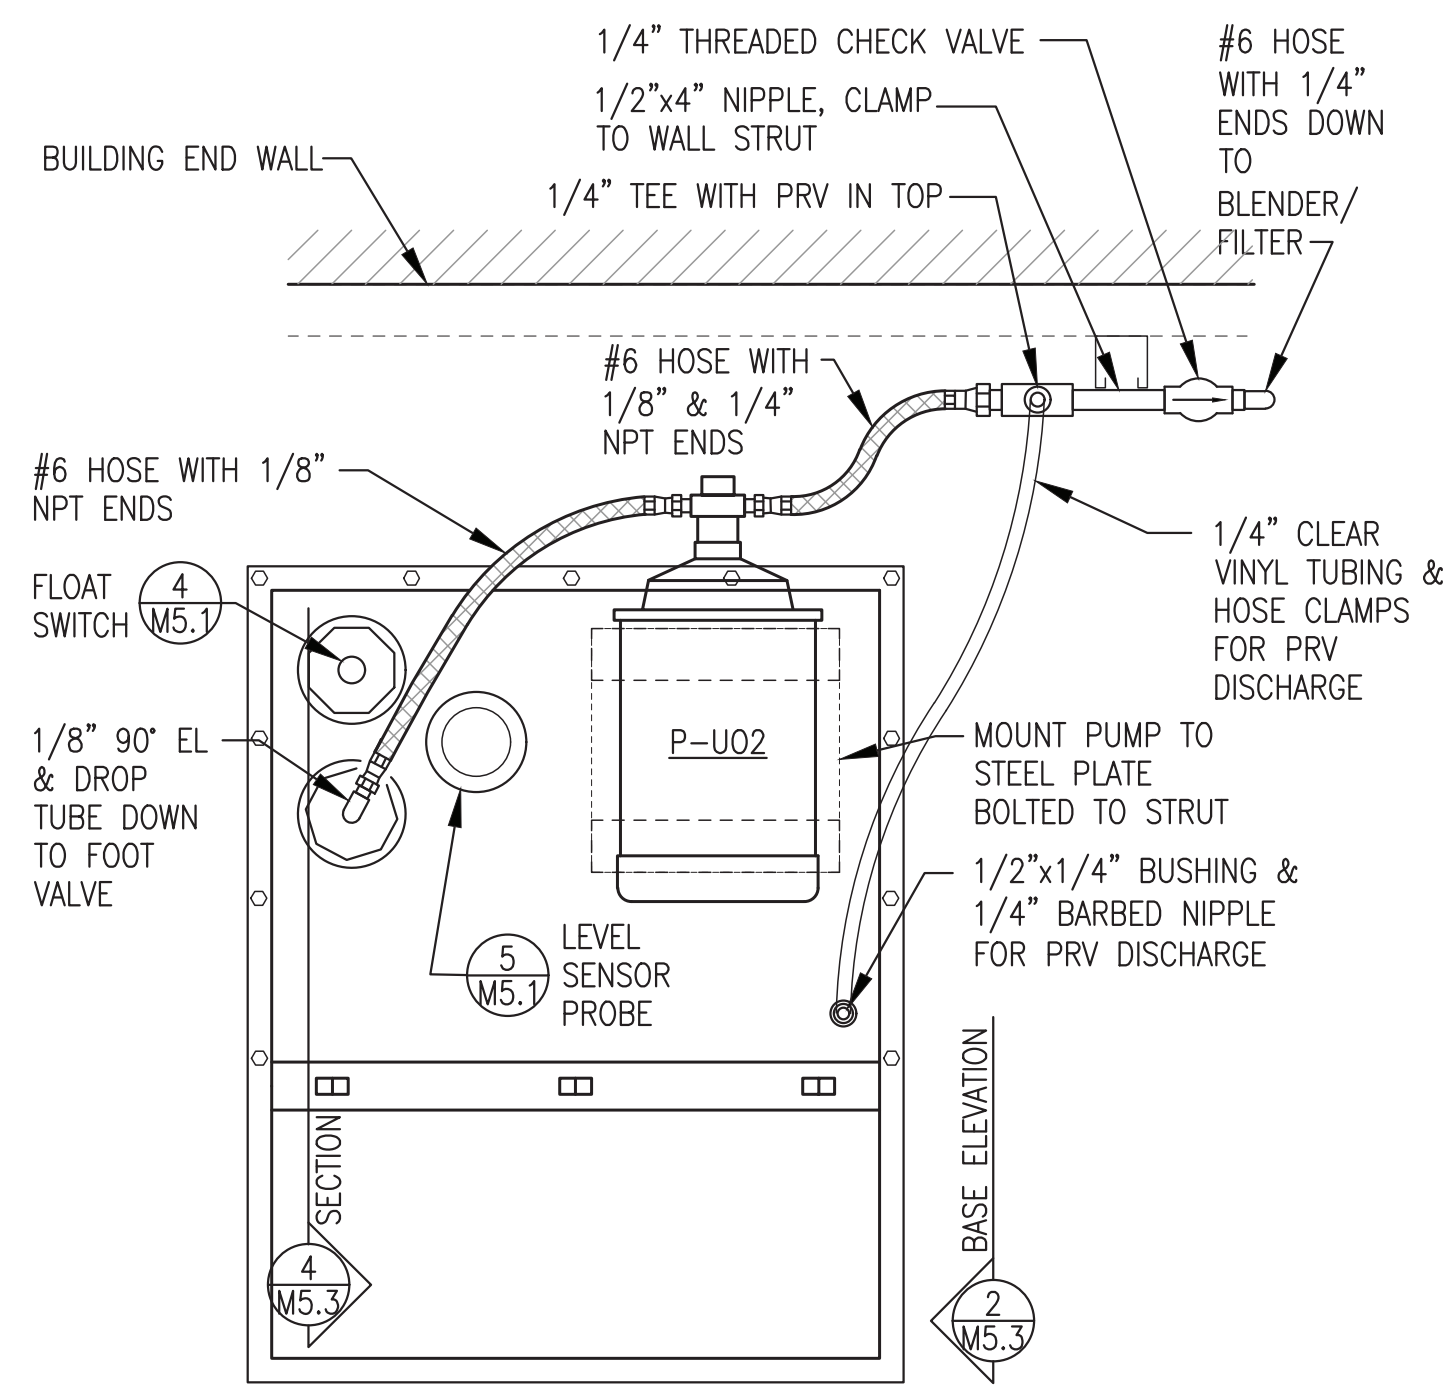


1 TOP OF HOPPER - PLAN VIEW  
M5.3 NO SCALE

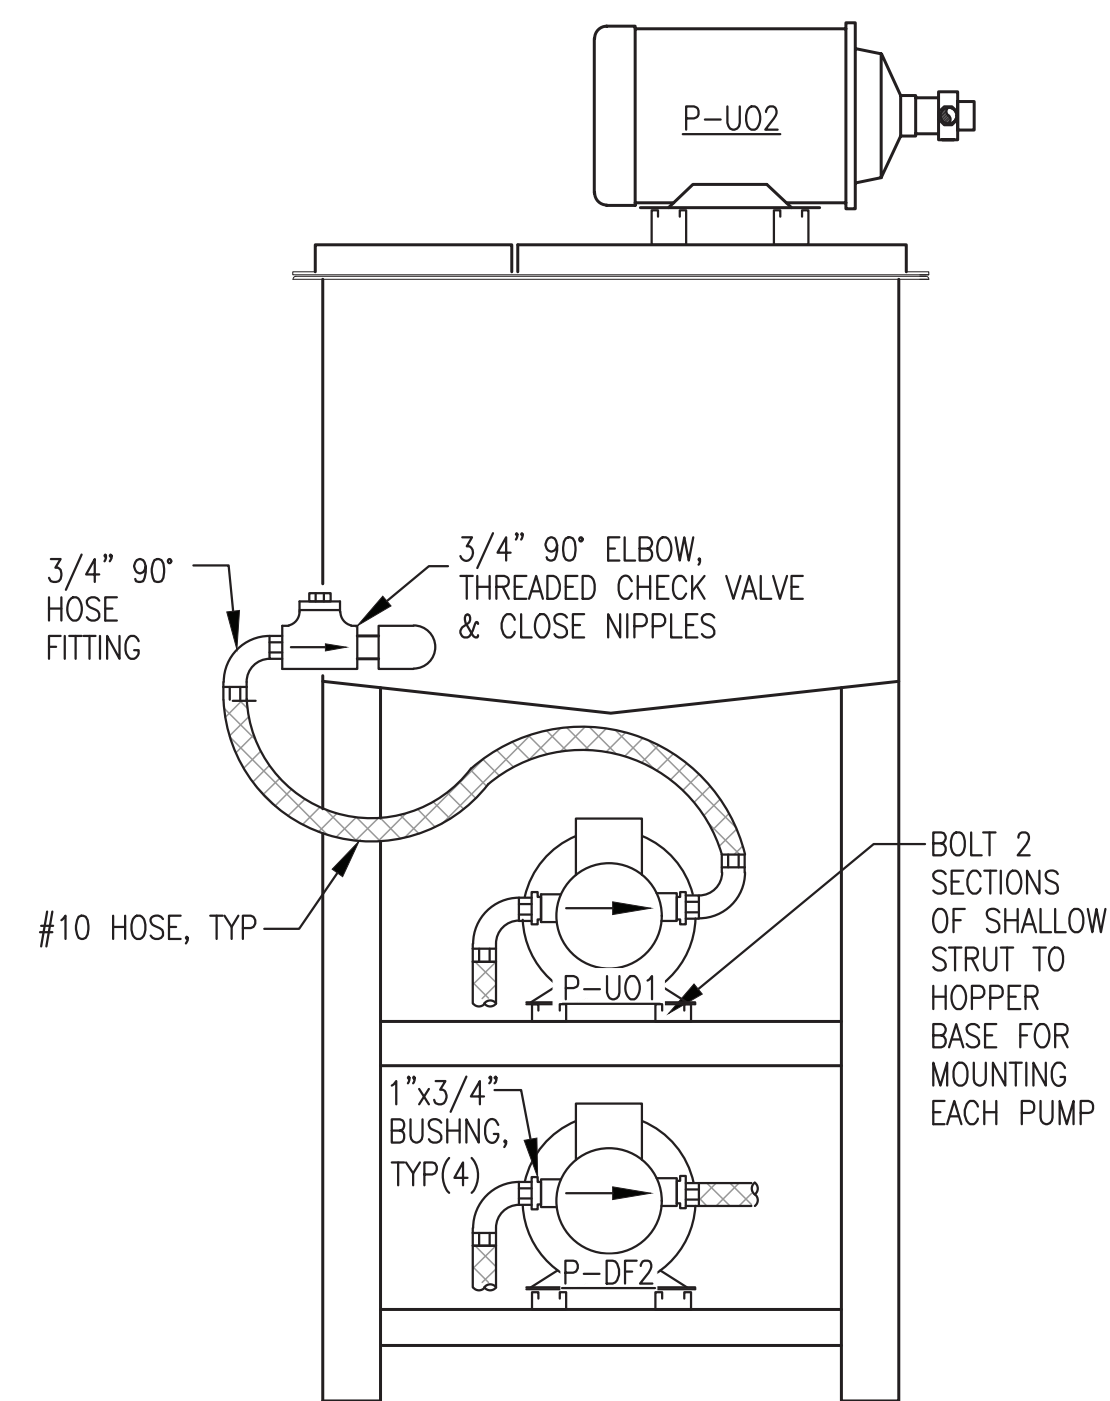

2 HOPPER BASE ELEVATION  
M5.3 NO SCALE

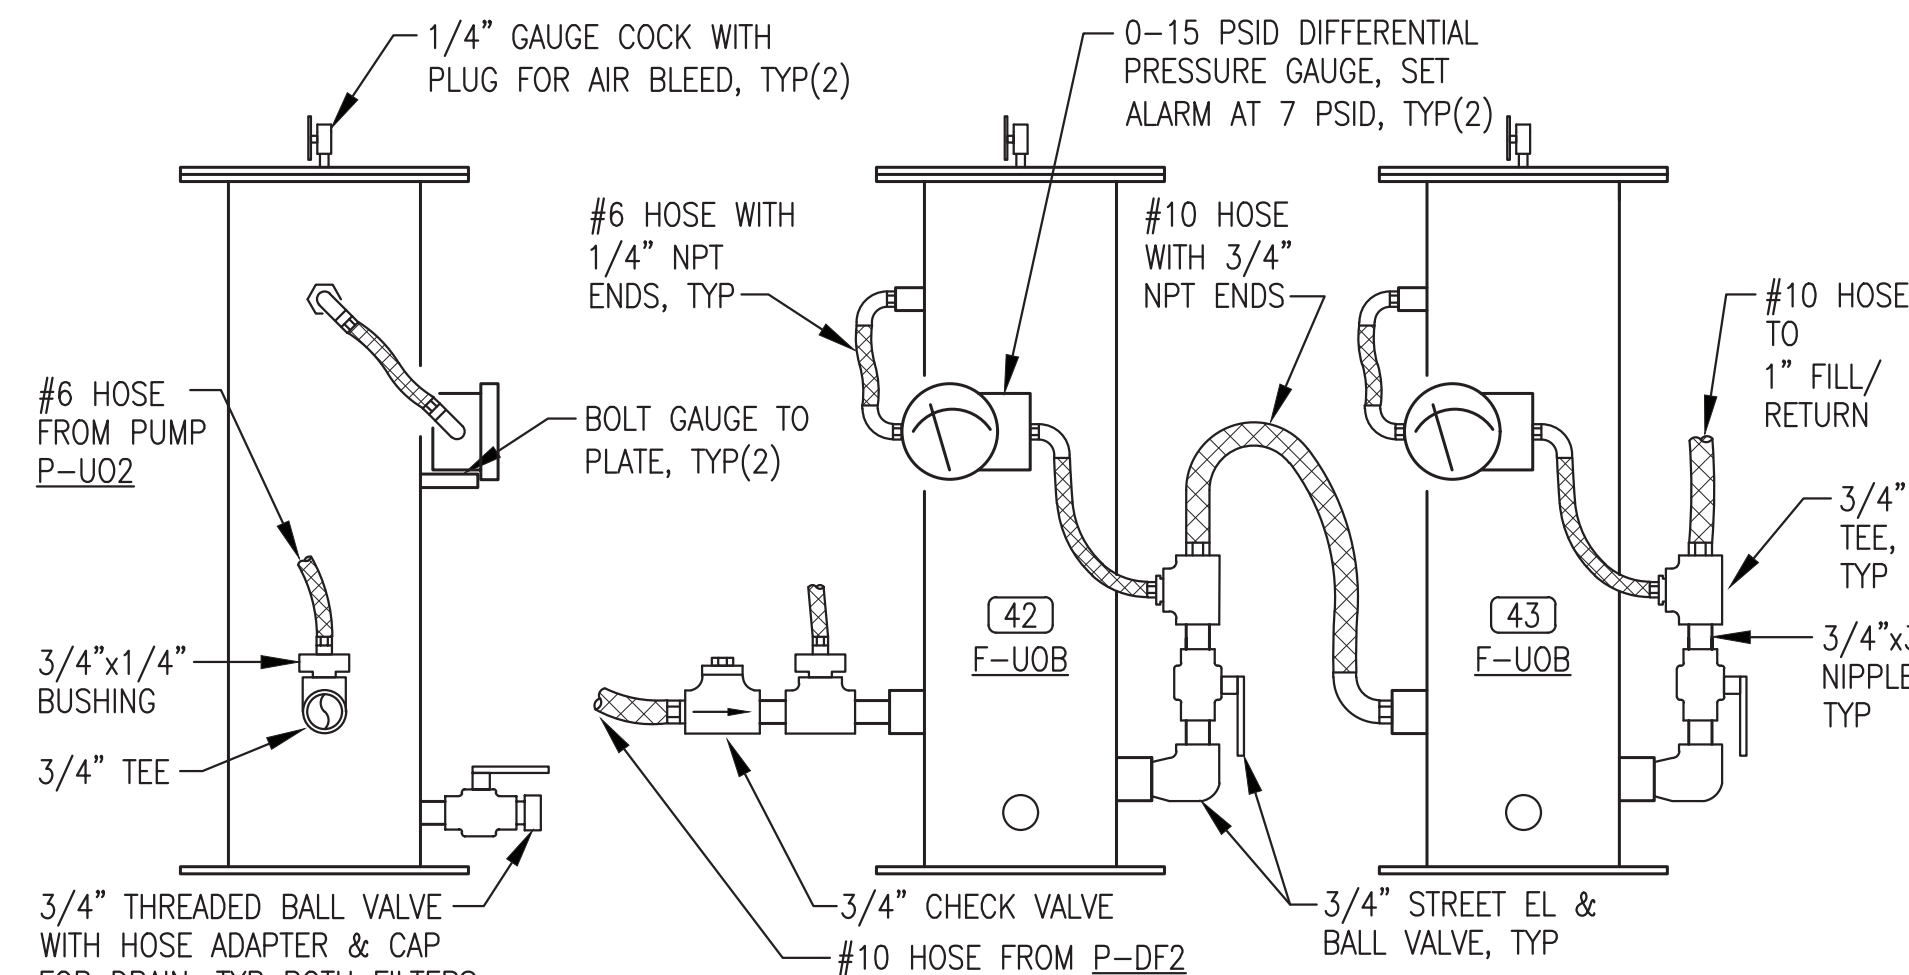

3 FILTER BANK ELEVATIONS  
M5.3 NO SCALE

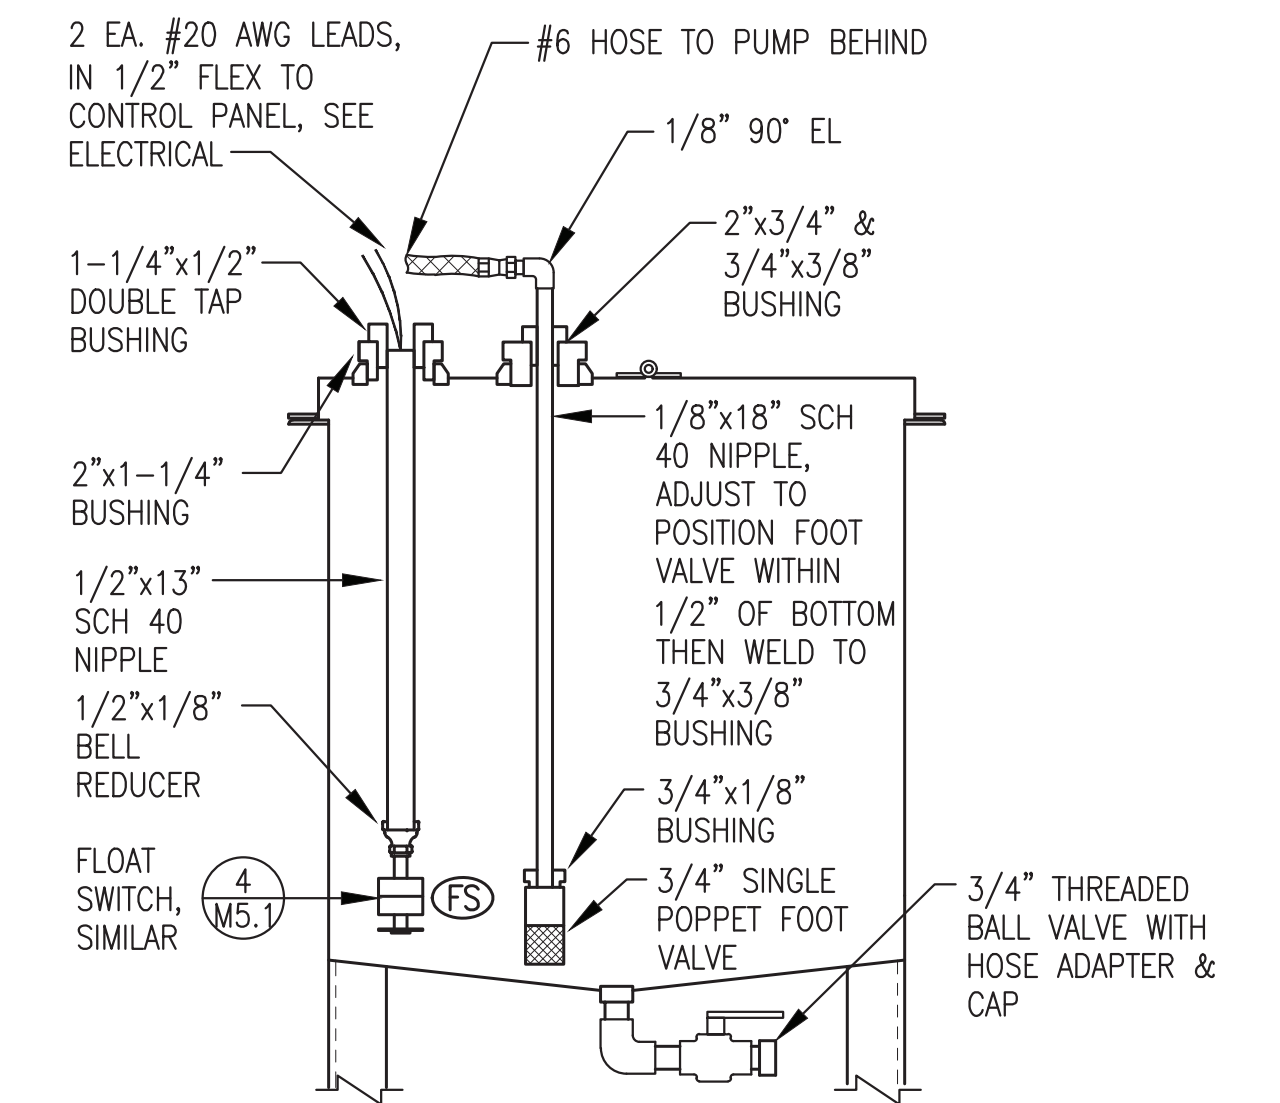

4 SECTION THROUGH HOPPER  
M5.3 NO SCALE

ALL WORK ON THIS SHEET WAS PERFORMED AS PART OF THE PRIOR MODULE ASSEMBLY CONTRACT AND IS SHOWN HERE FOR REFERENCE ONLY.


ISSUED FOR CONSTRUCTION  
MAY 2023



PROJECT: NELSON LAGOON POWER SYSTEM UPGRADE		
TITLE: USED OIL HOPPER & BLENDER INSTALLATION DETAILS		
DESIGNED BY: BCG	SCALE: AS NOTED	DATE: 5/30/23
FILE NAME: NELS_PP_M2-M7	SHEET: <b>M5.3</b>	
PROJECT NUMBER:		



P.O. 111405, Anchorage, AK 99511 (907)349-0100

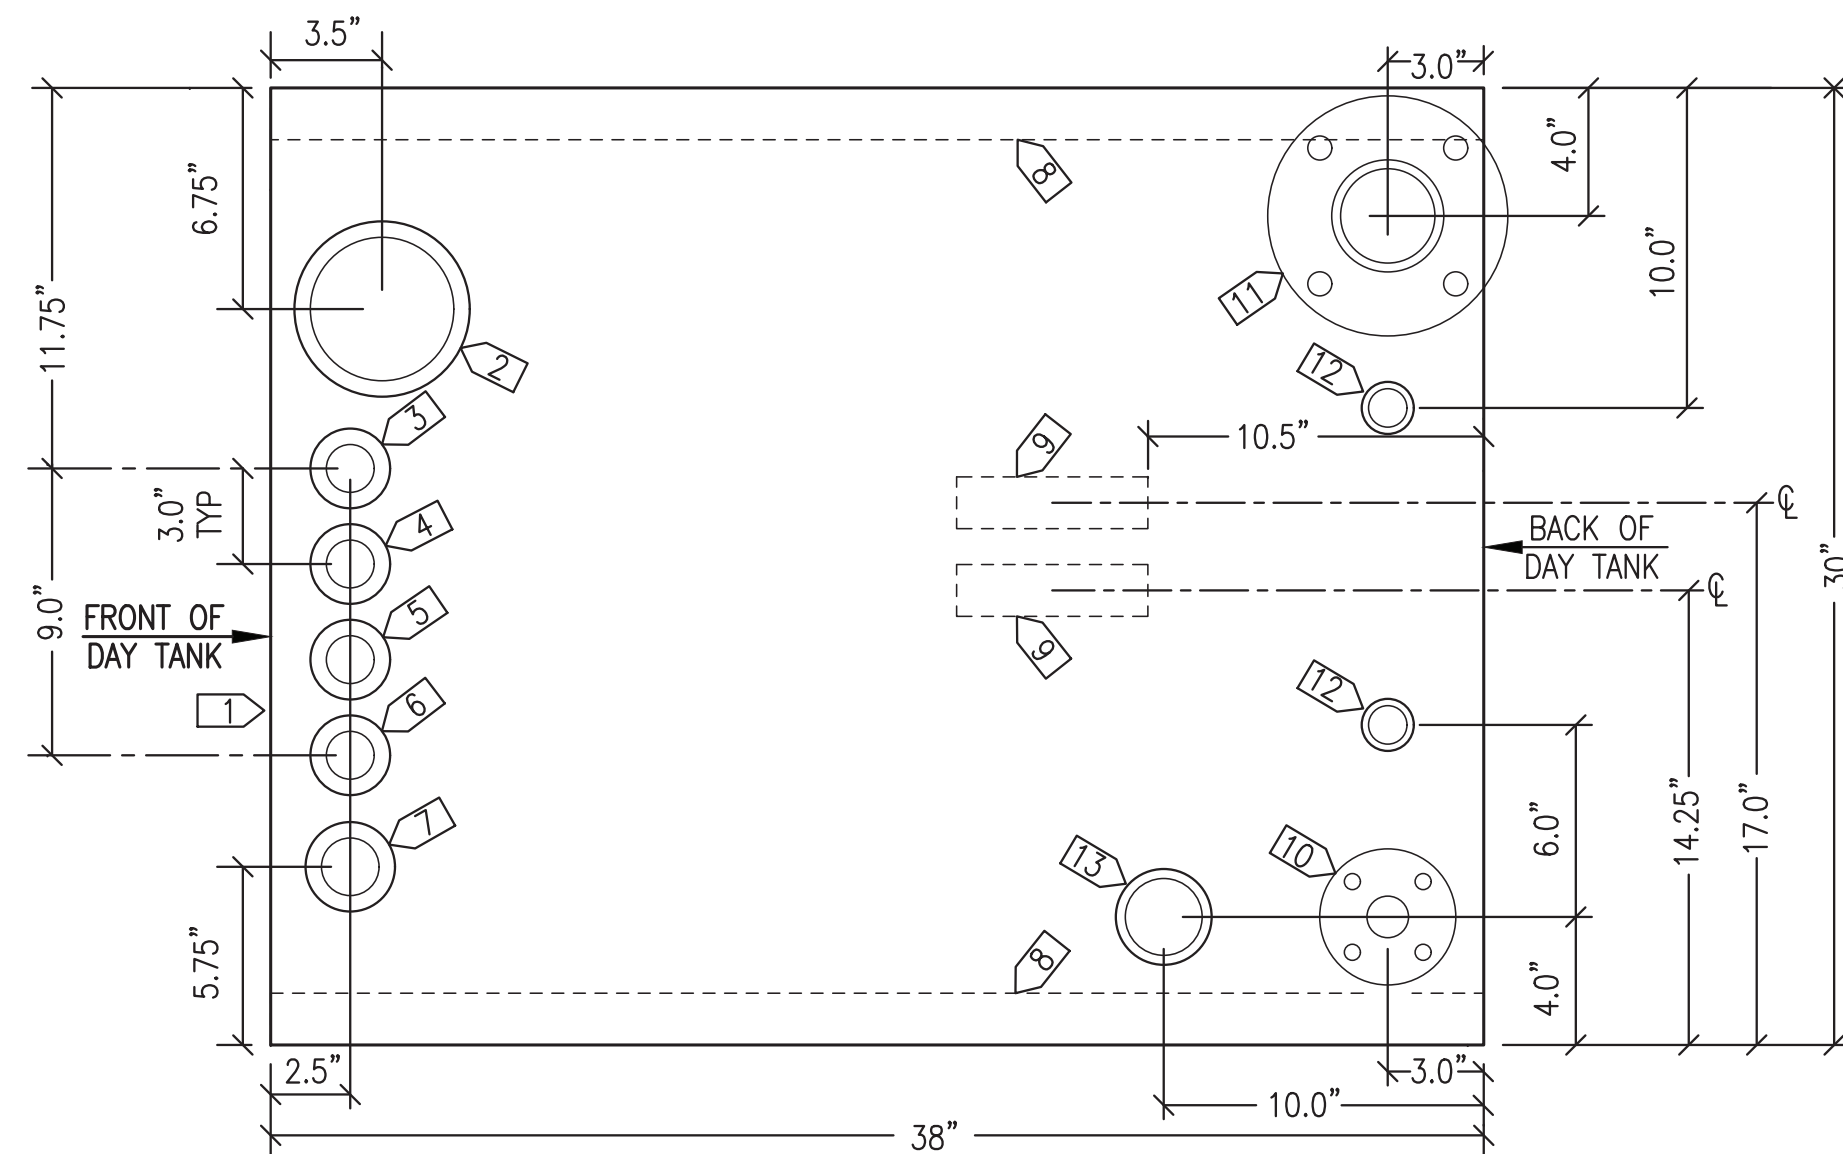


TOP VIEW

**DAY TANK SPECIFICATIONS:**


- 1) FABRICATE SINGLE WALL 200 GALLON NOMINAL CAPACITY DAY TANK. FABRICATE IN ACCORDANCE WITH UL 142.
- 2) FABRICATE FROM ASTM A-36 STEEL PLATE, 10 GAUGE MINIMUM EXCEPT FOR TOP 3/16" MINIMUM. ALL TANK SEAM JOINTS TO BE FULL CONTINUOUS WELDS IN ACCORDANCE WITH UL 142 FIGURE 6.5 - #1, #6, #7, OR #8.
- 3) PROVIDE WITH ALL OPENINGS AND ATTACHMENTS INDICATED. ALL STRUT TO BE 1-5/8"x1-5/8"x12 GA SOLID BACK PLAIN (BLACK), B-LINE B22 PLN OR EQUAL. SEAL WELD ALL TANK ATTACHMENTS.
- 4) INSTALL ALL FPT OPENINGS IN ACCORDANCE WITH UL 142 FIGURE 7.1 - #4 UNLESS INDICATED OTHERWISE. ALL DROP TUBES SCH 40 ASTM A53 STEEL PIPE WITH MPT OR FLANGED END AS INDICATED.
- 5) PRESSURE TEST COMPLETED ASSEMBLY TO 5 PSIG MAXIMUM USING SOAPY WATER SOLUTION ON ALL WELD JOINTS.
- 6) UPON COMPLETION OF FABRICATION, ROUND ALL CORNERS AND SHARP EDGES. SANDBLAST TANK EXTERIOR AND ALL ATTACHMENTS IN ACCORDANCE WITH SSPC-SP-6. PAINT WITH TWO COATS EPOXY, PPG AMERLOC 2 VOC OR APPROVED EQUAL, COLOR ANSI 61 GRAY.
- 7) LABEL ALL OPENINGS WITH 1/4" BLACK LETTERS INDICATING FUNCTION AS LISTED IN PARENTHESES IN SPECIFIC NOTES.
- 8) UPON COMPLETION FLUSH INTERIOR OF TANK TO REMOVE ALL DIRT AND DEBRIS AND AIR DRY INTERIOR. SEAL ALL MPT OPENINGS WITH THREADED STEEL CAPS. SEAL FPT TANK OPENINGS WITH THREADED STEEL PIPE PLUGS WHERE INDICATED. INSTALL 1-1/4" VENT CAP WHERE INDICATED. SEAL ALL OTHER FPT OPENINGS WITH PLASTIC OR STEEL PLUGS.

**DAY TANK SPECIFIC NOTES:**


- 1) PROVIDE 2" HIGH LETTERING: "DIESEL FUEL 200 GALLONS"
- 2) 4" FPT (MANUAL FILL) - INSTALL THREADED STEEL PLUG
- 3) 1-1/4" FPT (OVERFILL) - INSTALL VENT CAP FOR SHIPPING
- 4) 1-1/4" FPT (PUMP STOP)
- 5) 1-1/4" FPT (PUMP START)
- 6) 1-1/4" FPT (LOW ALARM)
- 7) 1-1/2" FPT (TANK GAUGE)
- 8) 38"L STRUT, ENDS FLUSH WITH TANK
- 9) 6"L STRUT
- 10) 1" SCH 40 DROP TUBE (FILL) WITH 1" 150# FLANGE
- 11) 3" 150# FLANGED VENT CONNECTION
- 12) 1" FPT (SPARE) - INSTALL THREADED STEEL PLUG
- 13) 2" FPT (TANK LEVEL PROBE)
- 14) C6x8.2, 38" LONG

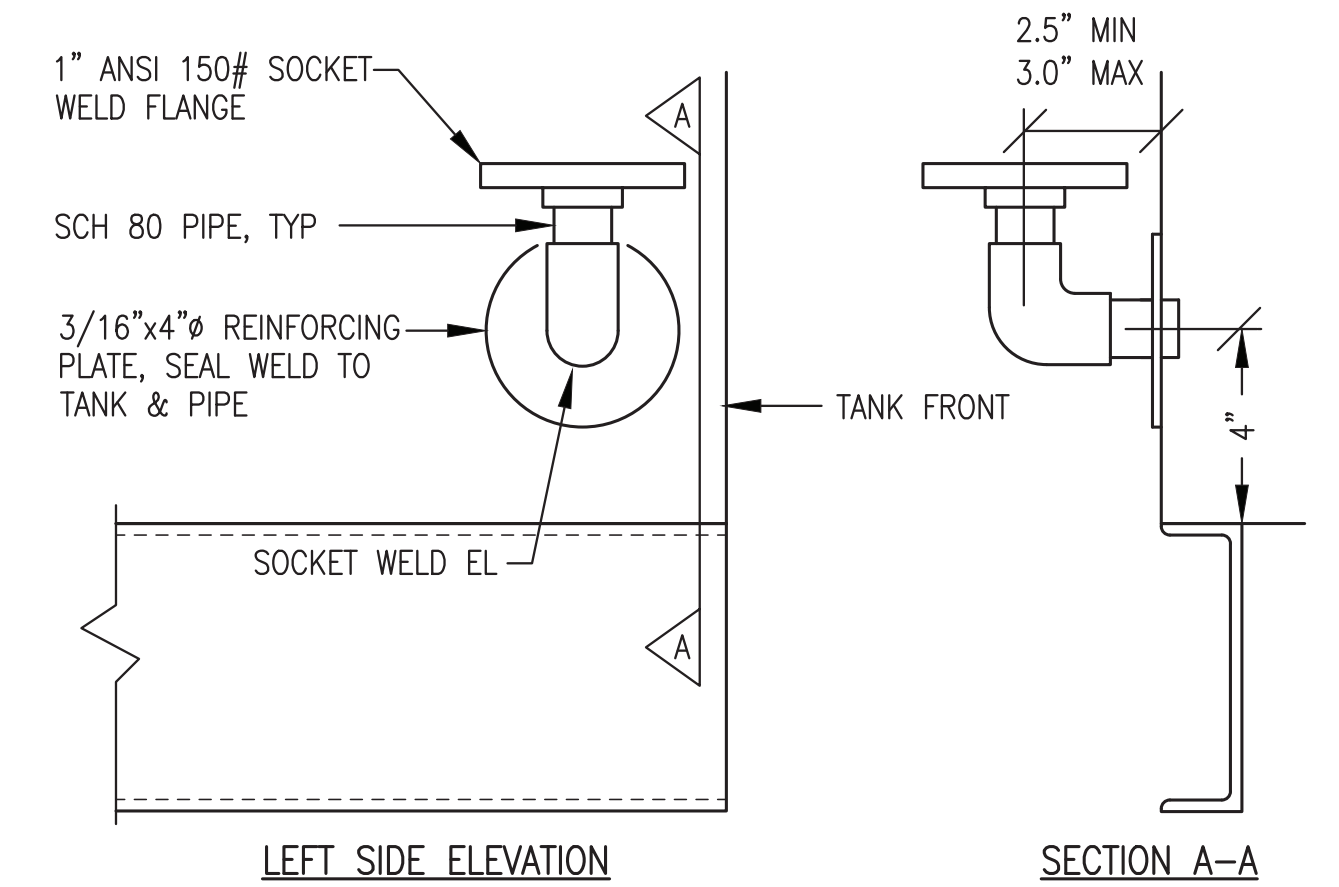

2 1" FLANGED SUPPLY CONNECTION  
M5.4 NO SCALE

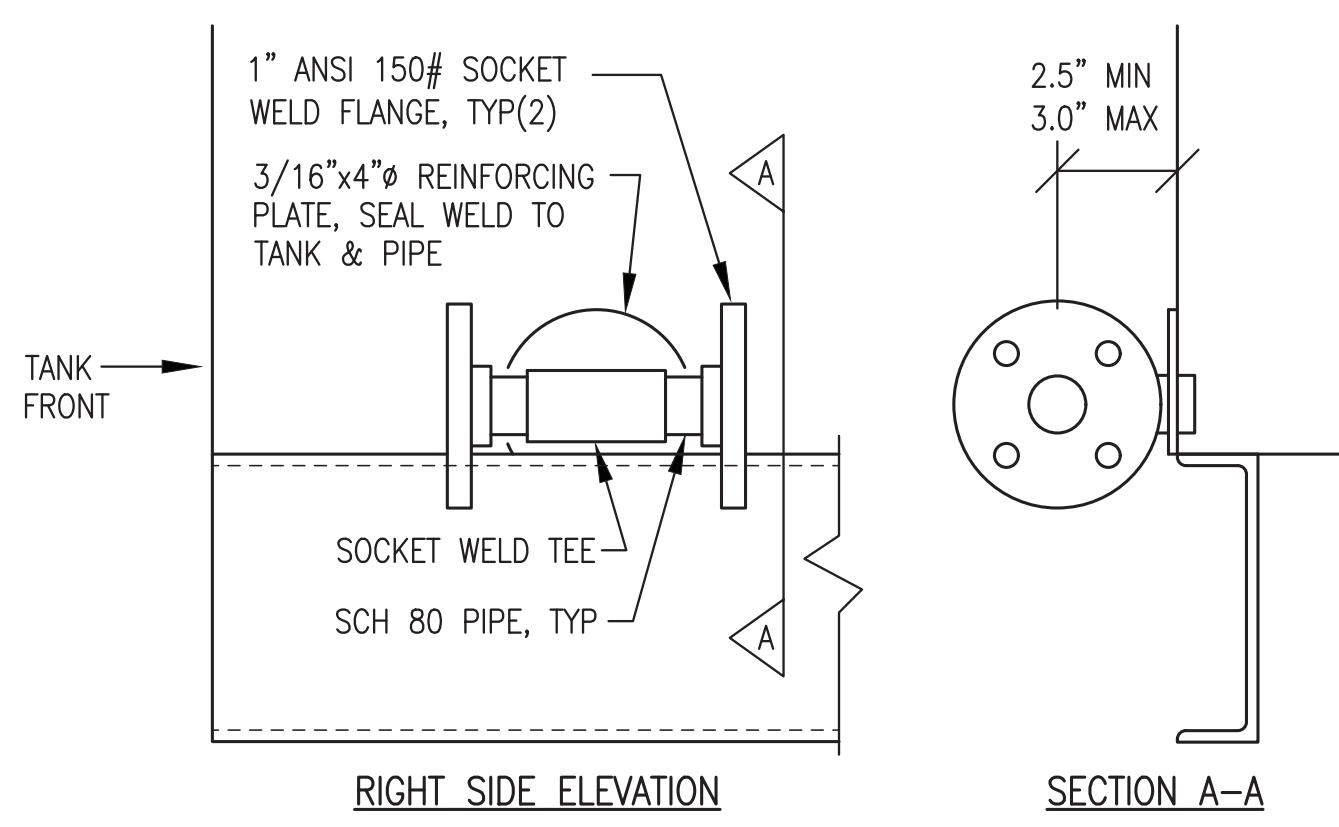

3 1" FLANGED DRAIN CONNECTION  
M5.4 NO SCALE

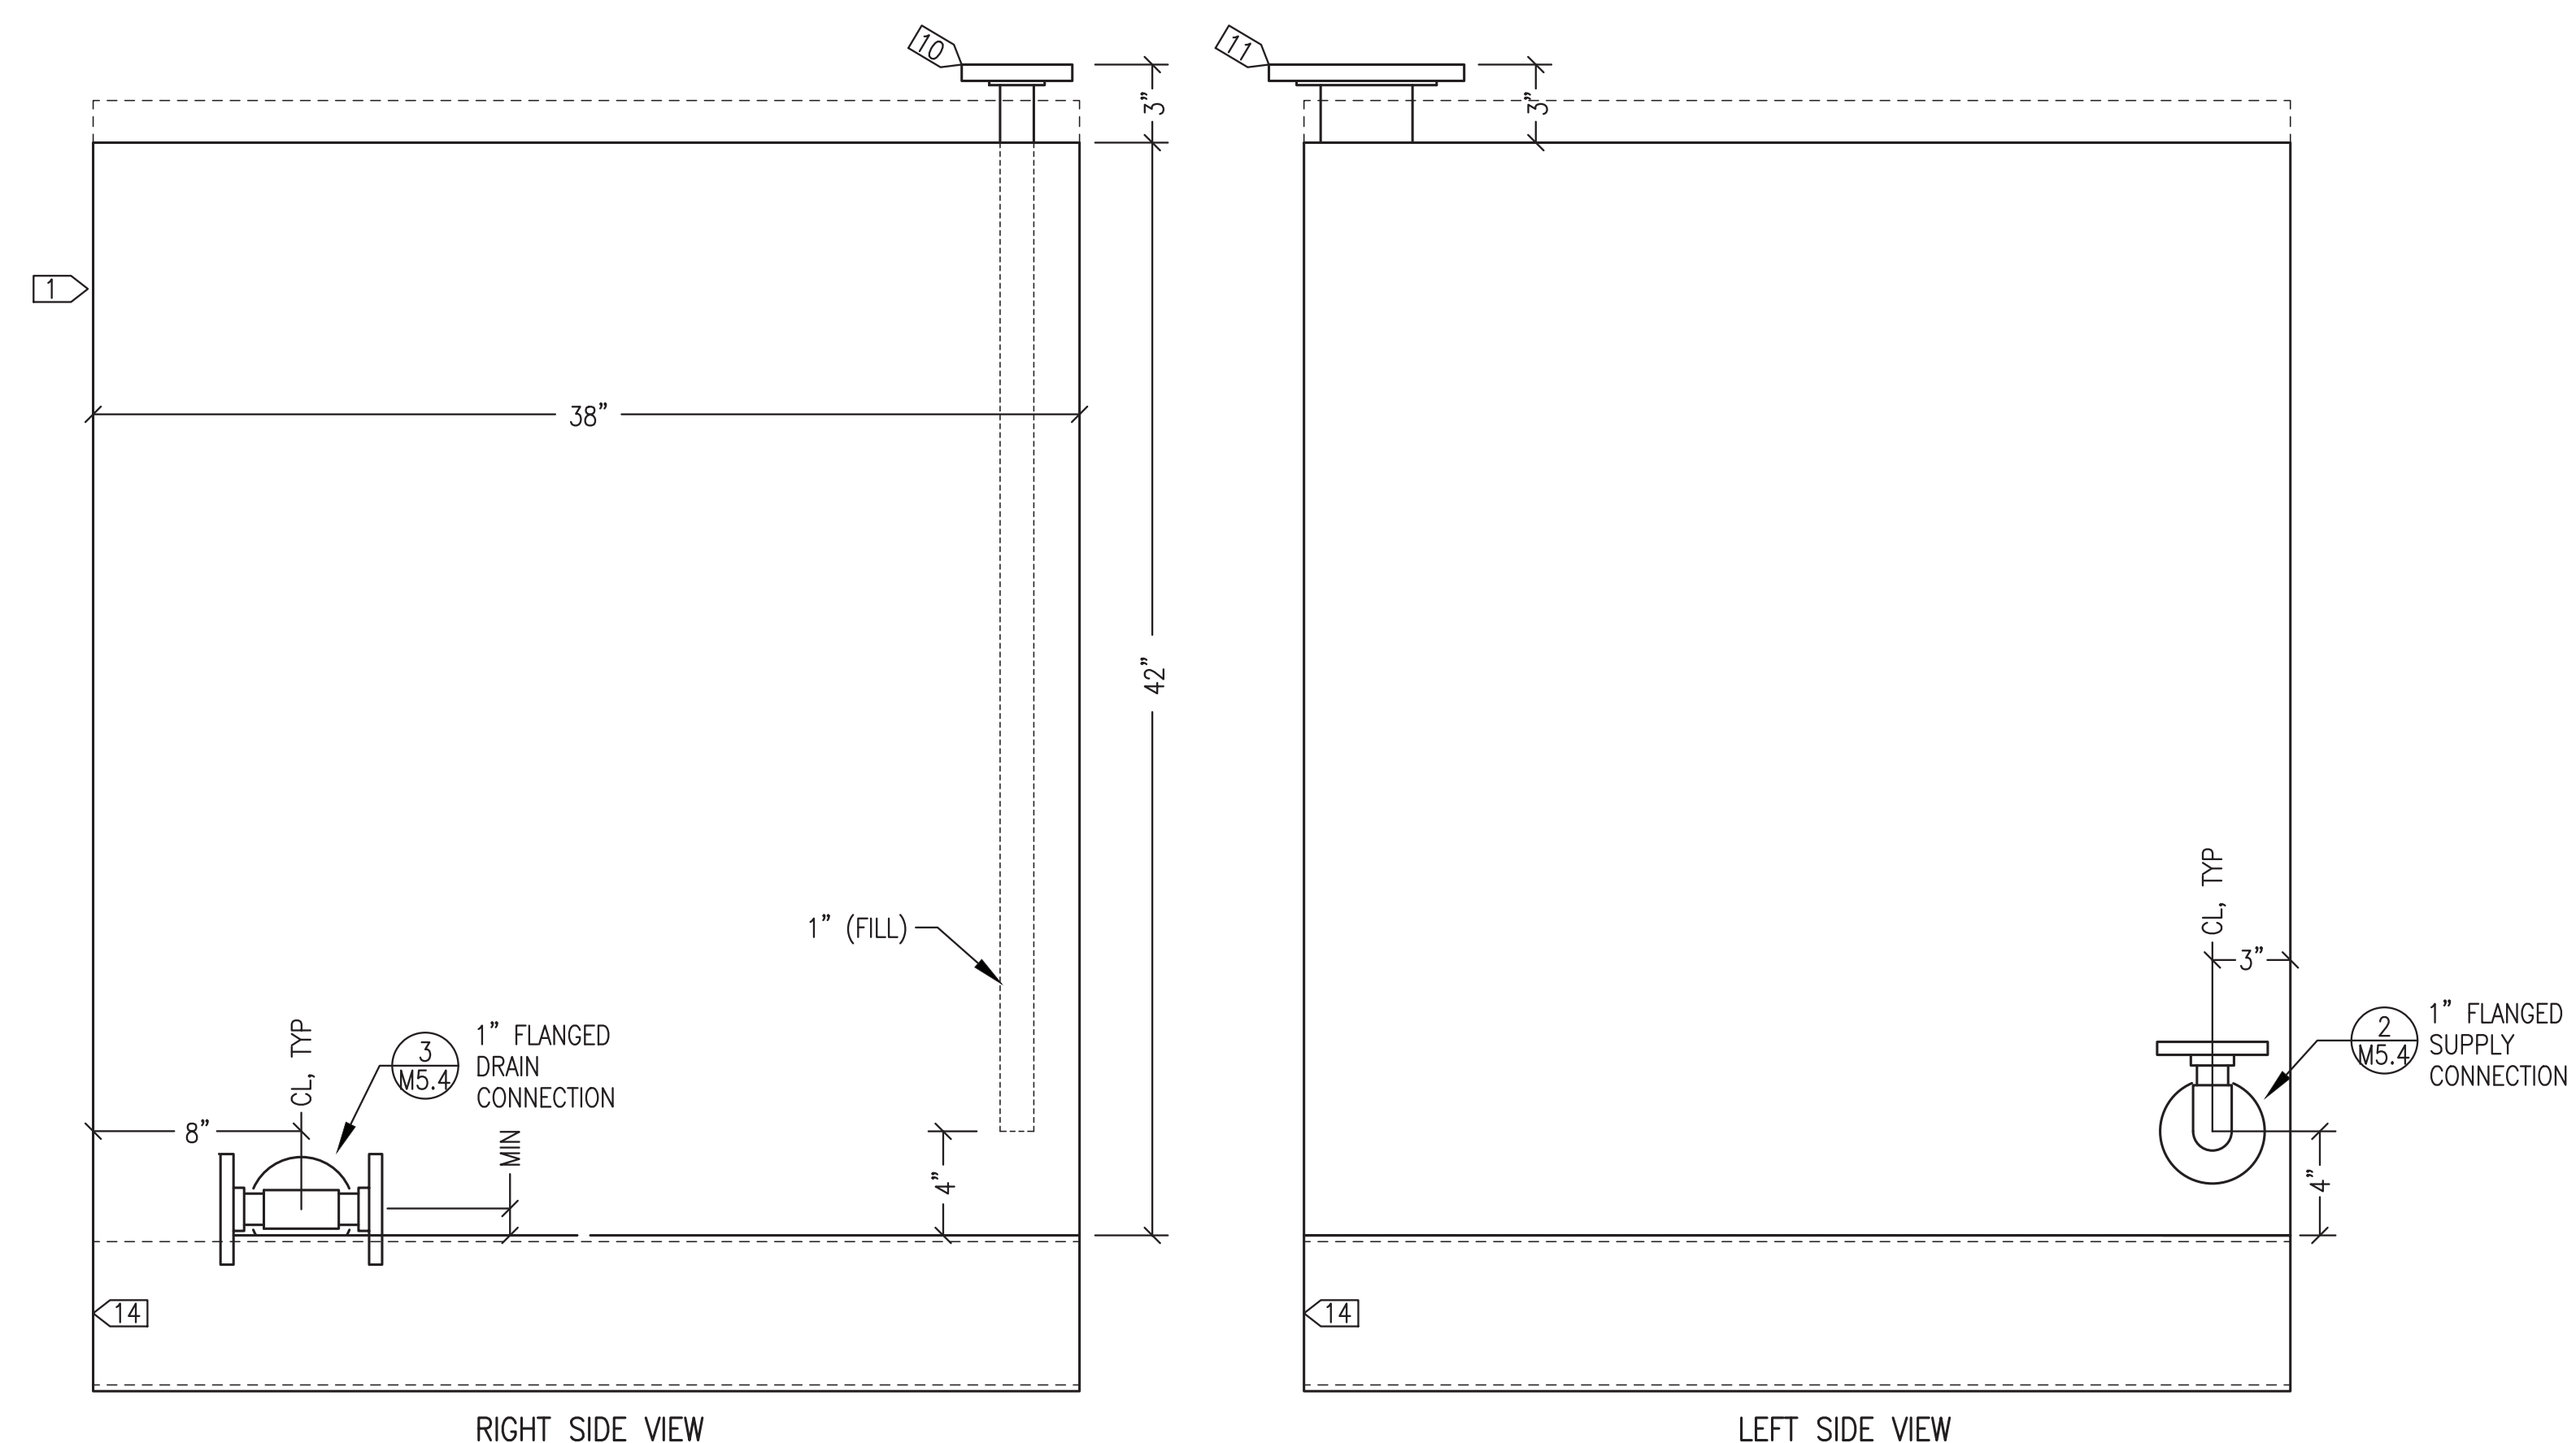

RIGHT SIDE VIEW

LEFT SIDE VIEW


ALL WORK ON THIS SHEET WAS PERFORMED AS PART OF THE PRIOR MODULE ASSEMBLY CONTRACT AND IS SHOWN HERE FOR REFERENCE ONLY.

1 200 GALLON SINGLE WALL DAY TANK  
M5.5 1"=6"


ISSUED FOR CONSTRUCTION  
MAY 2023




ALASKA ENERGY AUTHORITY		
PROJECT: NELSON LAGOON POWER SYSTEM UPGRADE		
TITLE: 200 GALLON DAY TANK FABRICATION		
DESIGNED BY: BCG	DRAWN BY: JTD	SCALE: AS NOTED
FILE NAME: NELS_PP_M2-M7	PROJECT NUMBER:	DATE: 5/30/23
P.O. 111405, Anchorage, AK 99511 (907)349-0100	Gray Stassel Engineering, Inc.	SHEET: M5.4

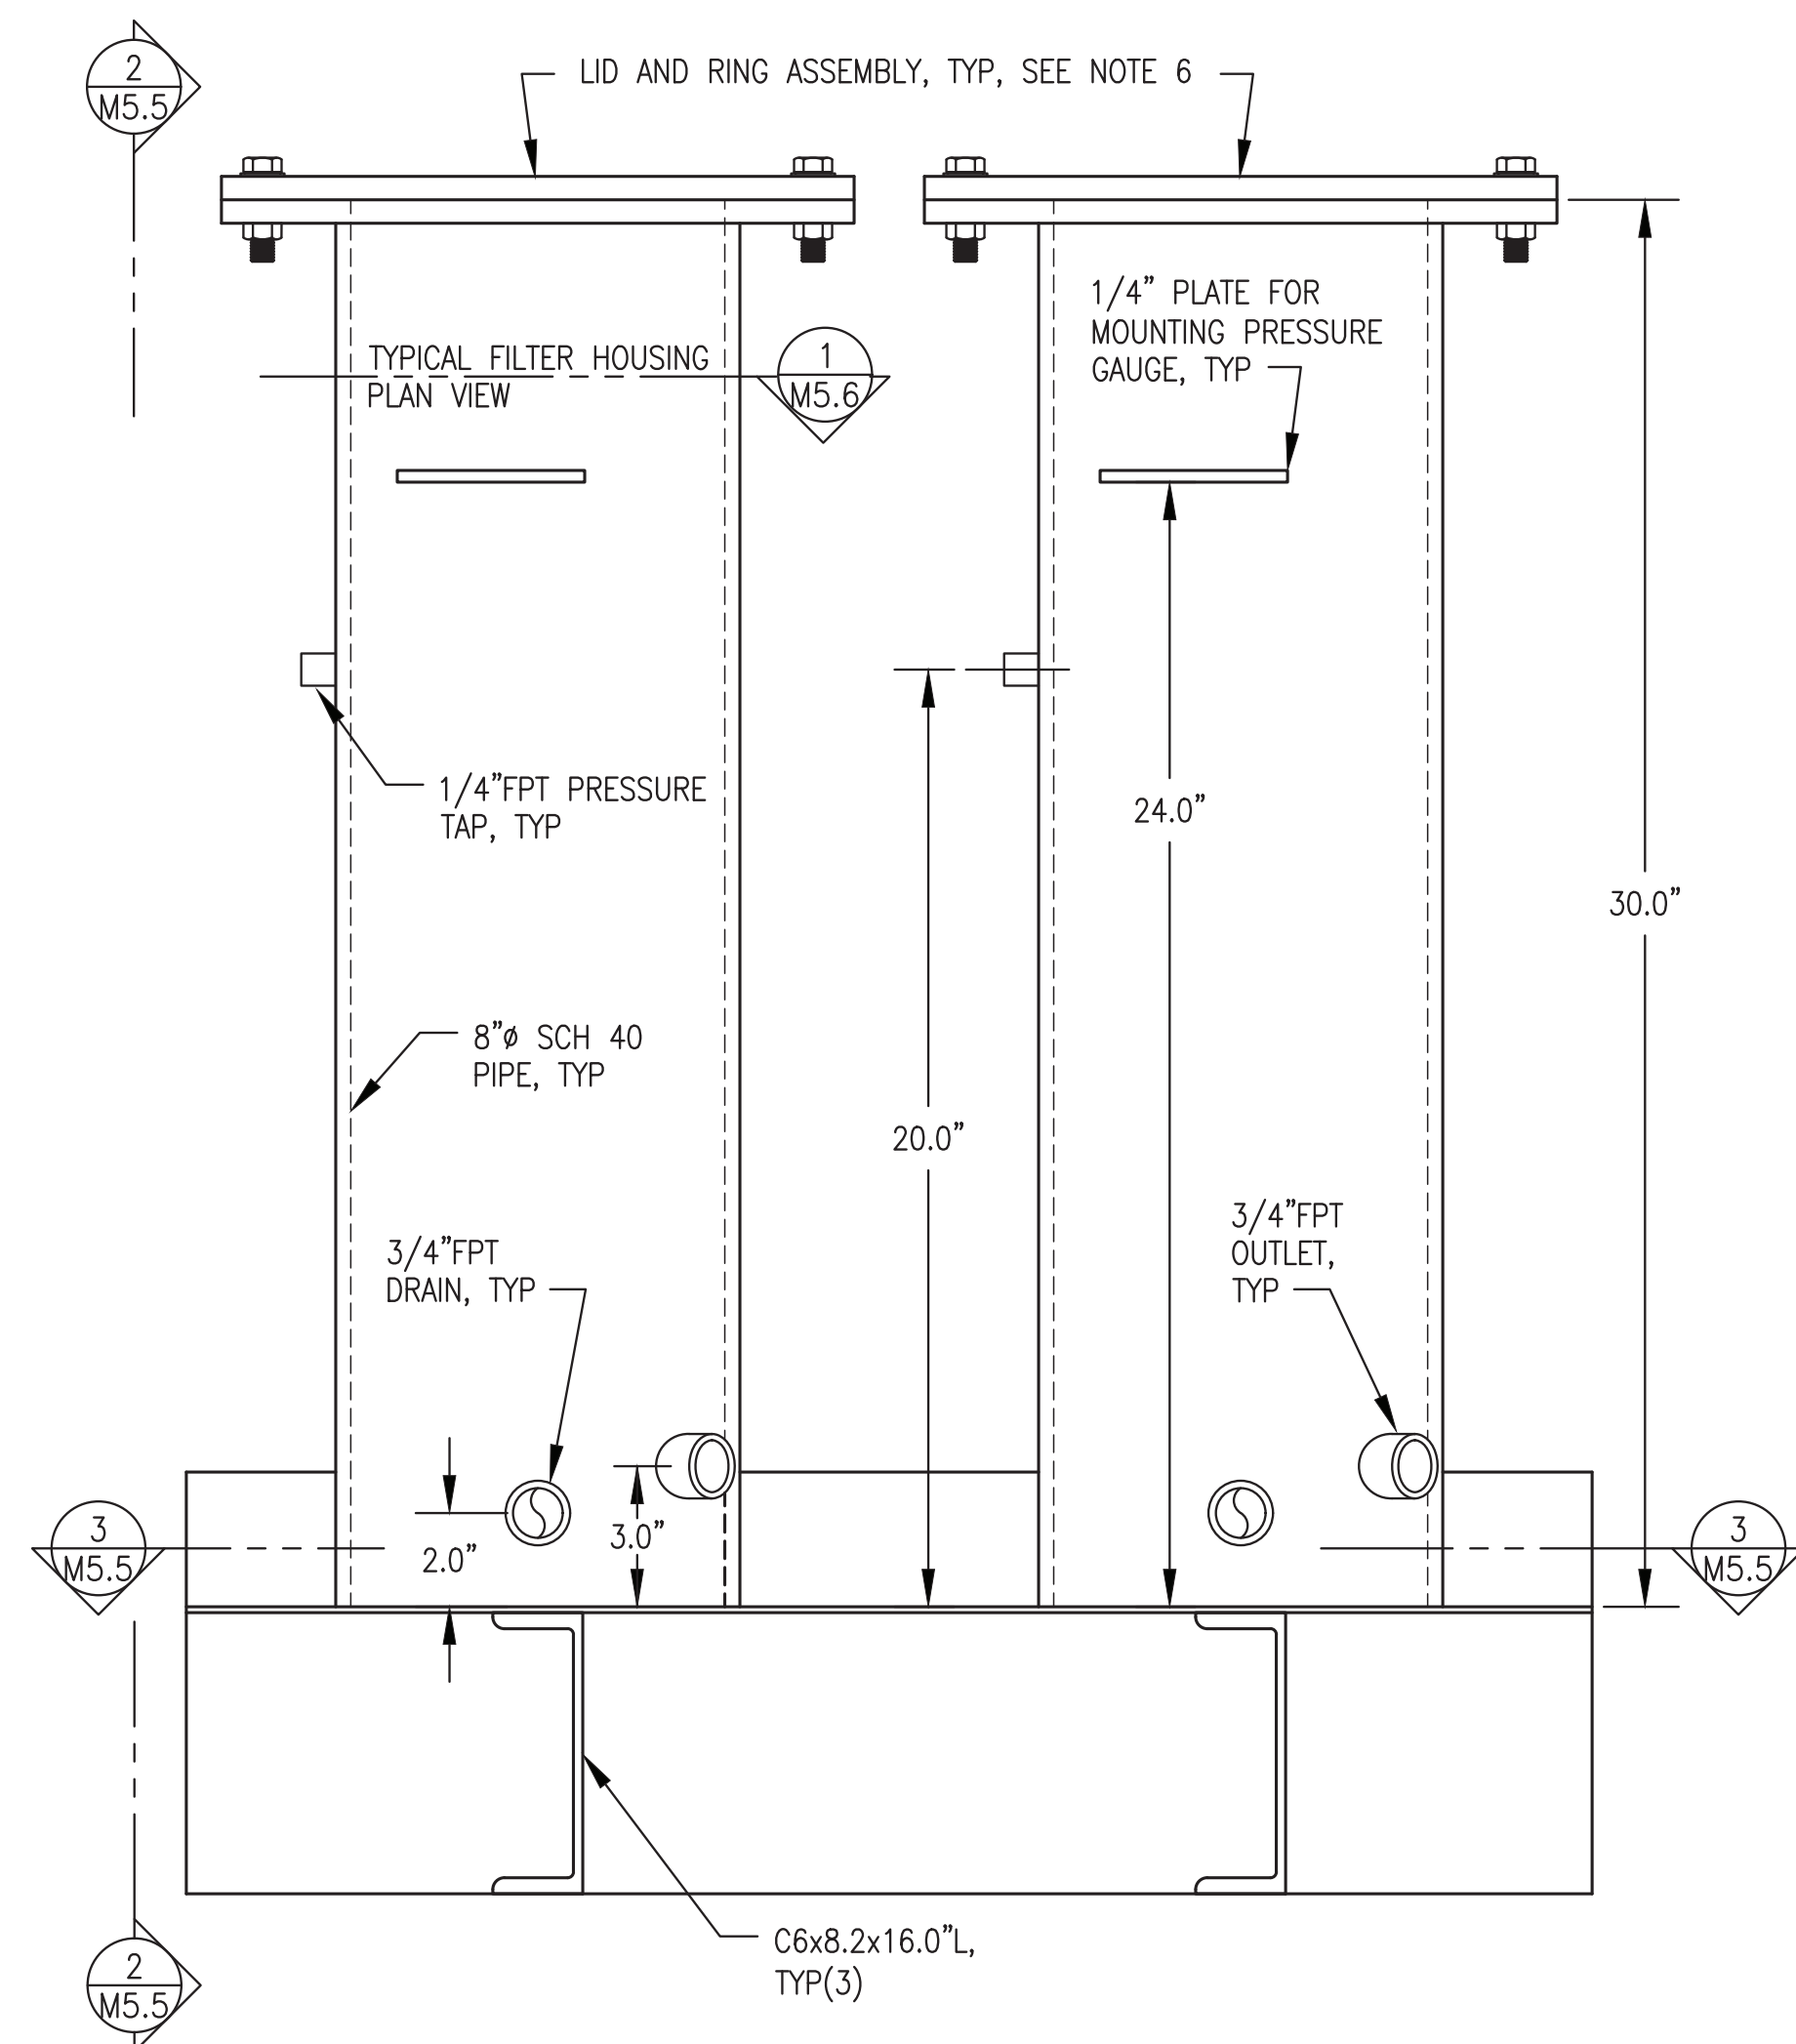

1 OIL FILTER BANK FRONT ELEVATION  
1/4" = 1"

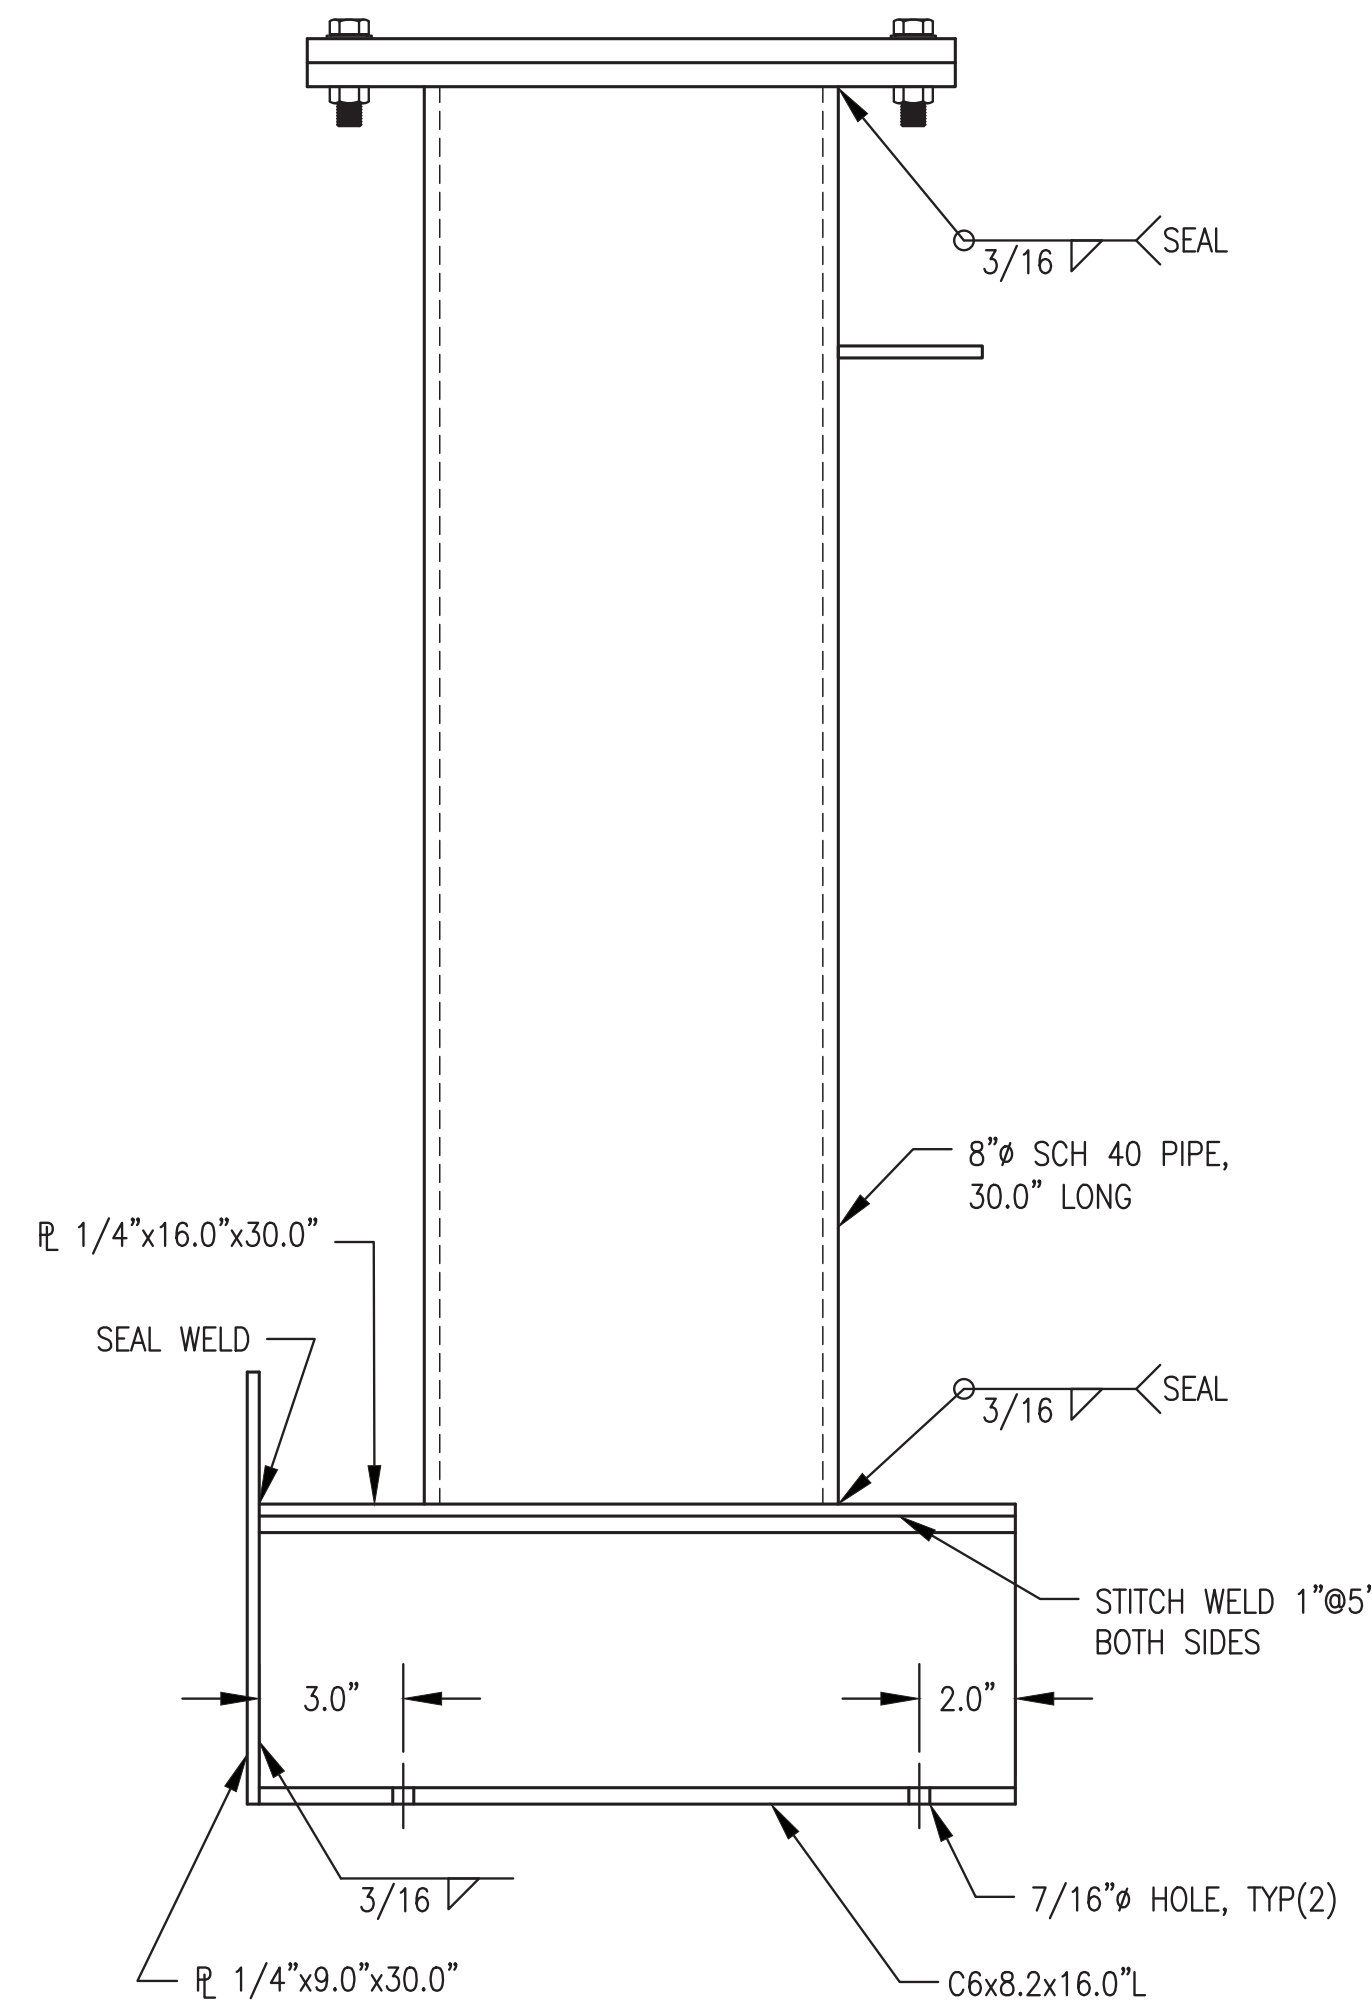

2 SECTION THROUGH FILTER & BASE  
1/4" = 1"

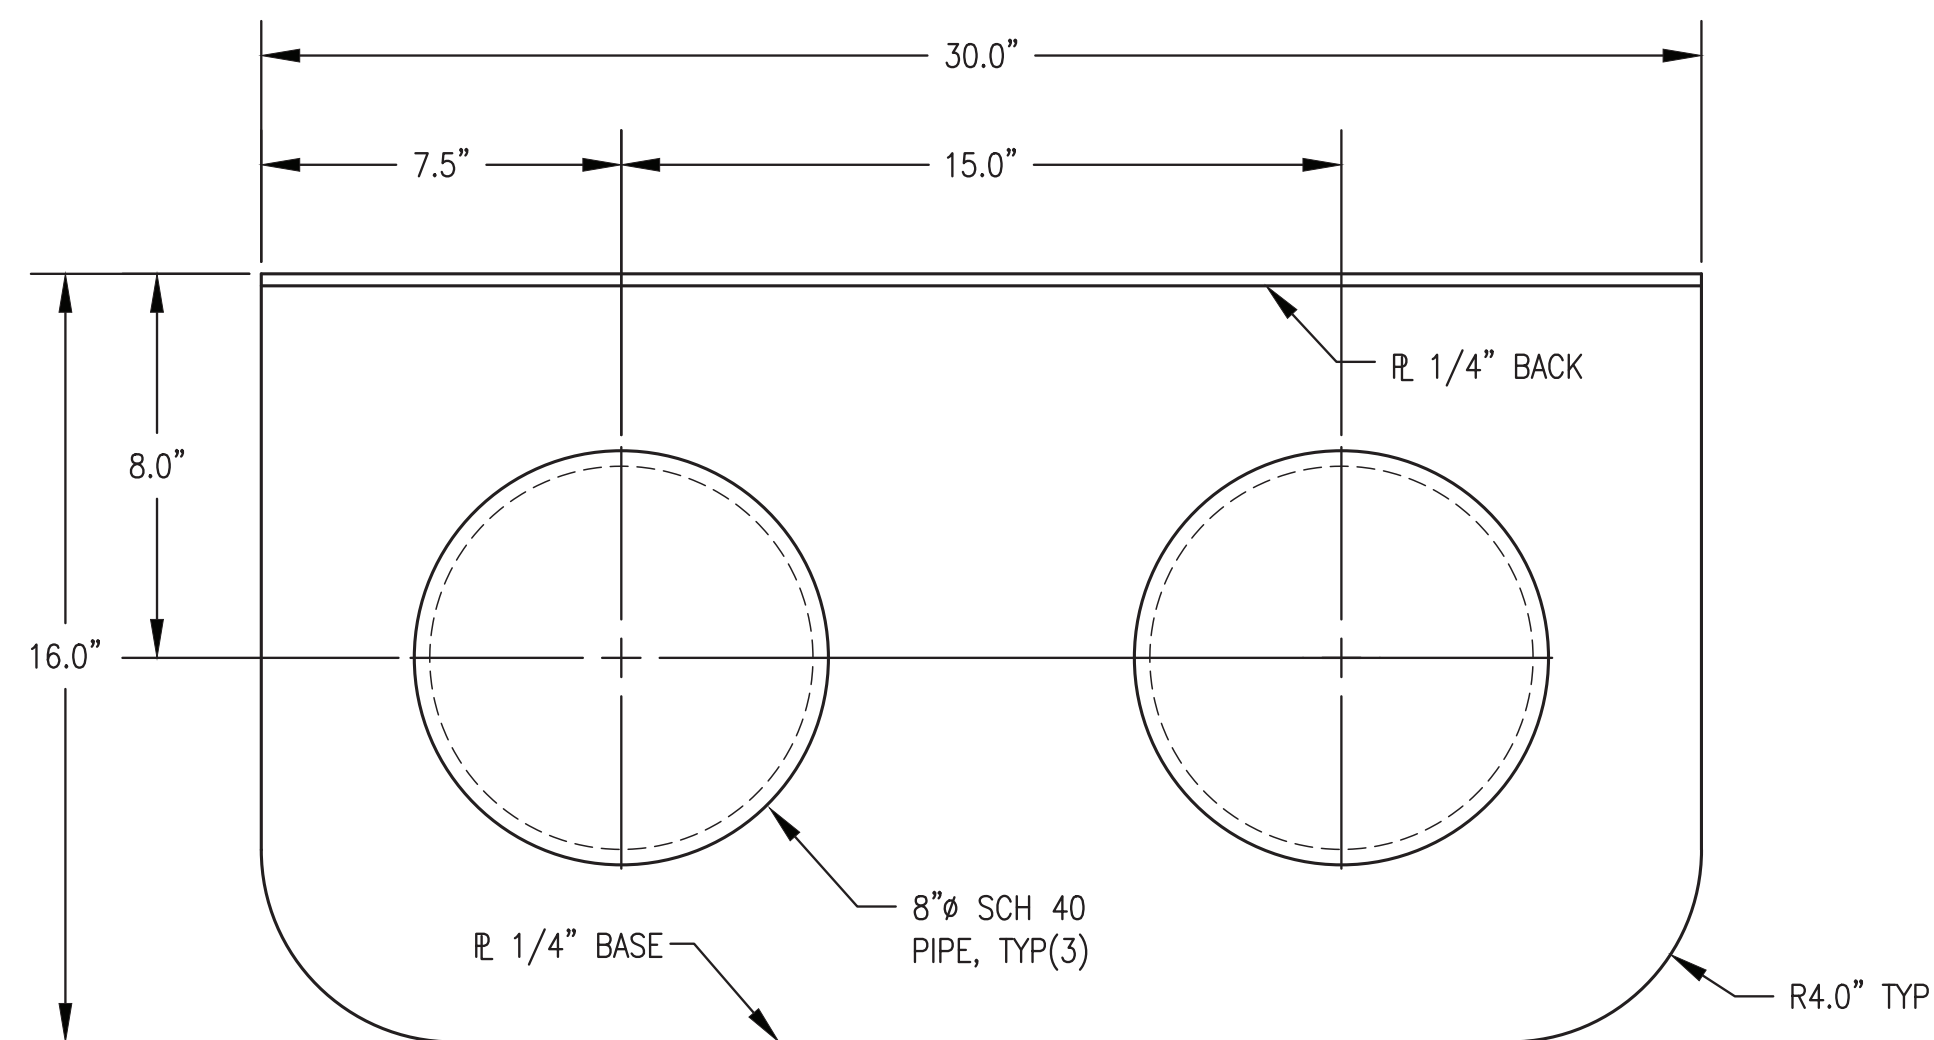

3 OIL FILTER BANK BASE PLAN  
1/4" = 1"

FILTER BANK GENERAL NOTES:

1. FABRICATE TWO CHAMBER FILTER BANK AS INDICATED. SEE SHEET M5.5 FOR INTERNAL DETAILS.
2. FABRICATE FROM ASTM A-36 STEEL PLATE AND SHAPES AND ASTM A-53 PIPE. ALL JOINTS TO BE FULL CONTINUOUS SEAL WELDS EXCEPT WHERE SPECIFICALLY INDICATED OTHERWISE.
3. PROVIDE WITH ALL OPENINGS AND ATTACHMENTS INDICATED. INSTALL MINIMUM 3,000# FORGED STEEL HALF COUPLINGS FOR ALL FPT OPENINGS IN ACCORDANCE WITH UL 142 FIGURE 7.1 - #2.
4. PRESSURE TEST COMPLETED ASSEMBLY TO MINIMUM 50 PSIG USING SOAPY WATER SOLUTION ON ALL WELD JOINTS.
5. UPON COMPLETION OF FABRICATION, ROUND ALL CORNERS AND SHARP EDGES. SANDBLAST TANK EXTERIOR AND ALL ATTACHMENTS IN ACCORDANCE WITH SSPC-SP-6. PAINT WITH TWO COATS EPOXY, PPG AMERLOC 2 VOC OR APPROVED EQUAL, COLOR ANSI 61 GRAY.
6. AFTER PAINTING REMOVE LID, WIRE BRUSH MATING SURFACES OF LID AND RING TO REMOVE ALL PAINT AND POLISH SURFACES SMOOTH. APPLY A LIGHT COAT OF GREASE OR ANTI-SIEZE PASTE TO BOTH FACES PRIOR TO INSTALLING GASKET. INSTALL 13.5" O.D. FULL-FACED 1/4" BUNA-N RUBBER GASKET (ALASKA RUBBER OR EQUAL) ON FILTER LIDS.
7. FURNISH FASTENERS AS INDICATED AND COAT WITH ANTI-SIEZE.
8. PRESSURE TEST EACH FILTER HOUSING ASSEMBLY TO 50 PSIG MINIMUM.
9. UPON COMPLETION FLUSH INTERIOR OF TANK TO REMOVE ALL DIRT AND DEBRIS, AIR DRY INTERIOR, AND SEAL ALL TANK OPENINGS WITH PLASTIC PLUGS.


ALL WORK ON THIS SHEET WAS PERFORMED AS PART OF THE PRIOR MODULE ASSEMBLY CONTRACT AND IS SHOWN HERE FOR REFERENCE ONLY.

ISSUED FOR  
CONSTRUCTION  
MAY 2023




PROJECT: NELSON LAGOON POWER SYSTEM UPGRADE	
TITLE: USED OIL BLENDER FILTER BANK LAYOUT & CONFIGURATION	
DRAWN BY: JTD	SCALE: AS NOTED
DESIGNED BY: BCG	DATE: 5/30/23
FILE NAME: NELS_PP_M2-M7	SHEET: M5.5
PROJECT NUMBER:	





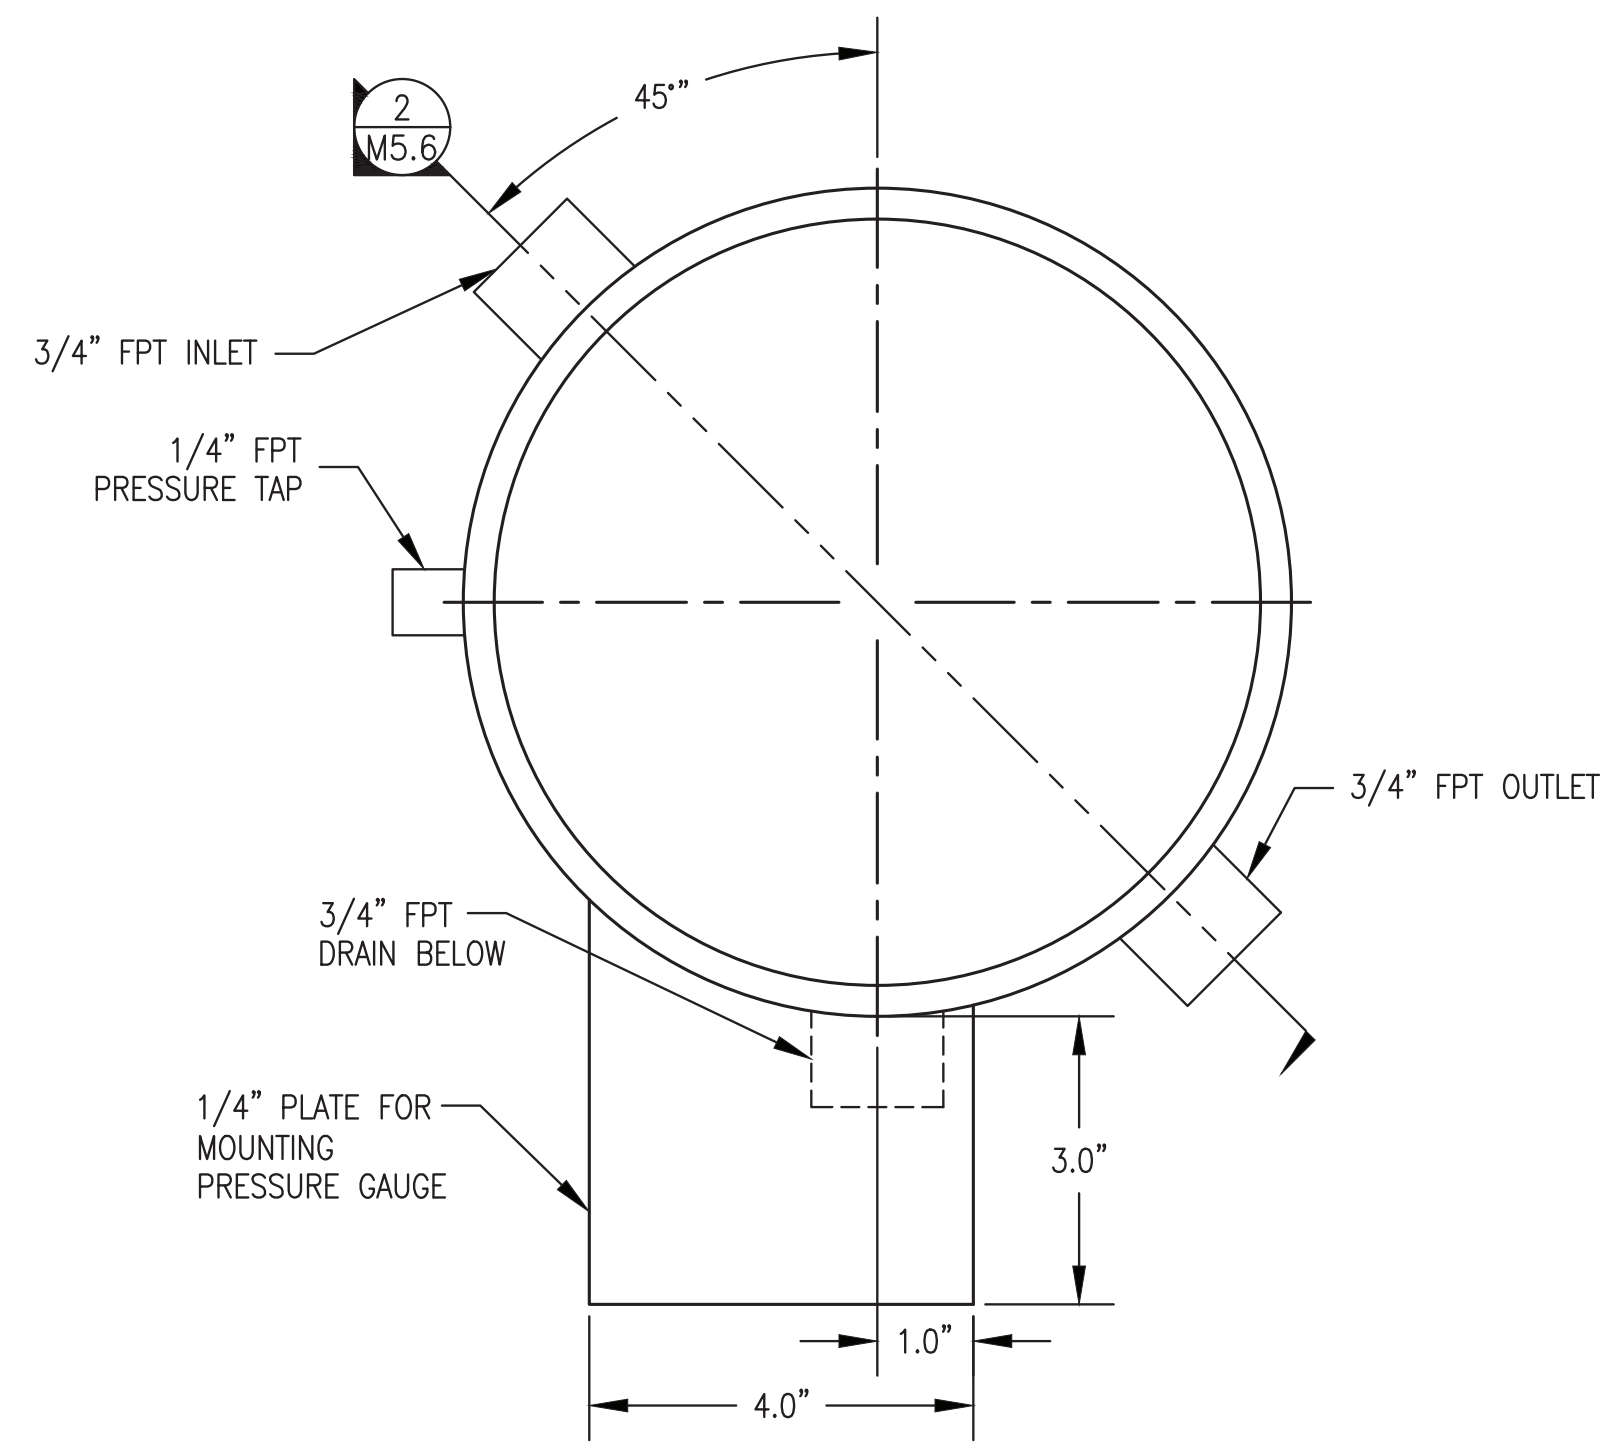


**1** TYPICAL FILTER HOUSING – PLAN VIEW  
 M5.6 1/2" = 1"

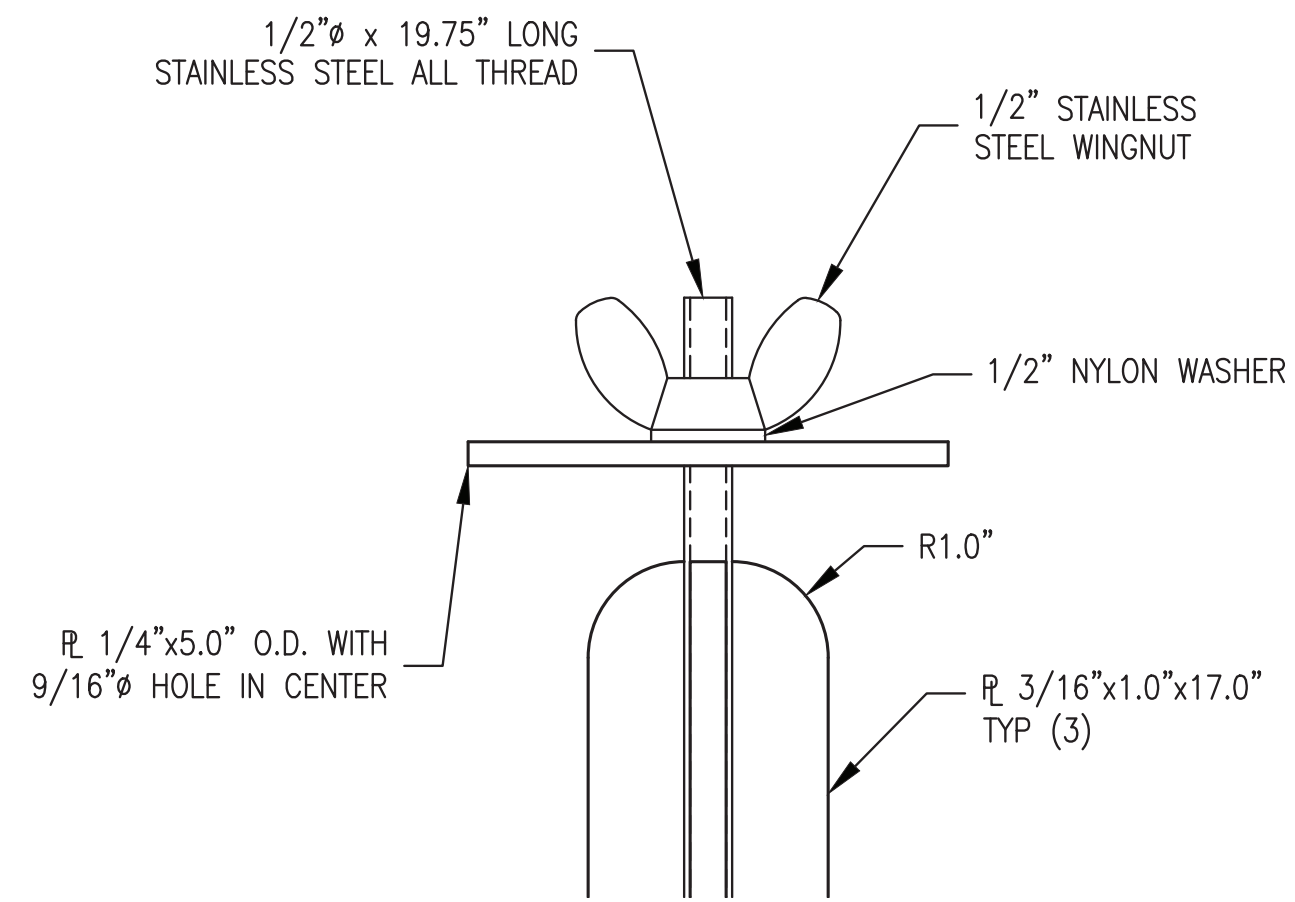


**3** ELEMENT RETAINER CAP  
 M5.6 1/2" = 1"

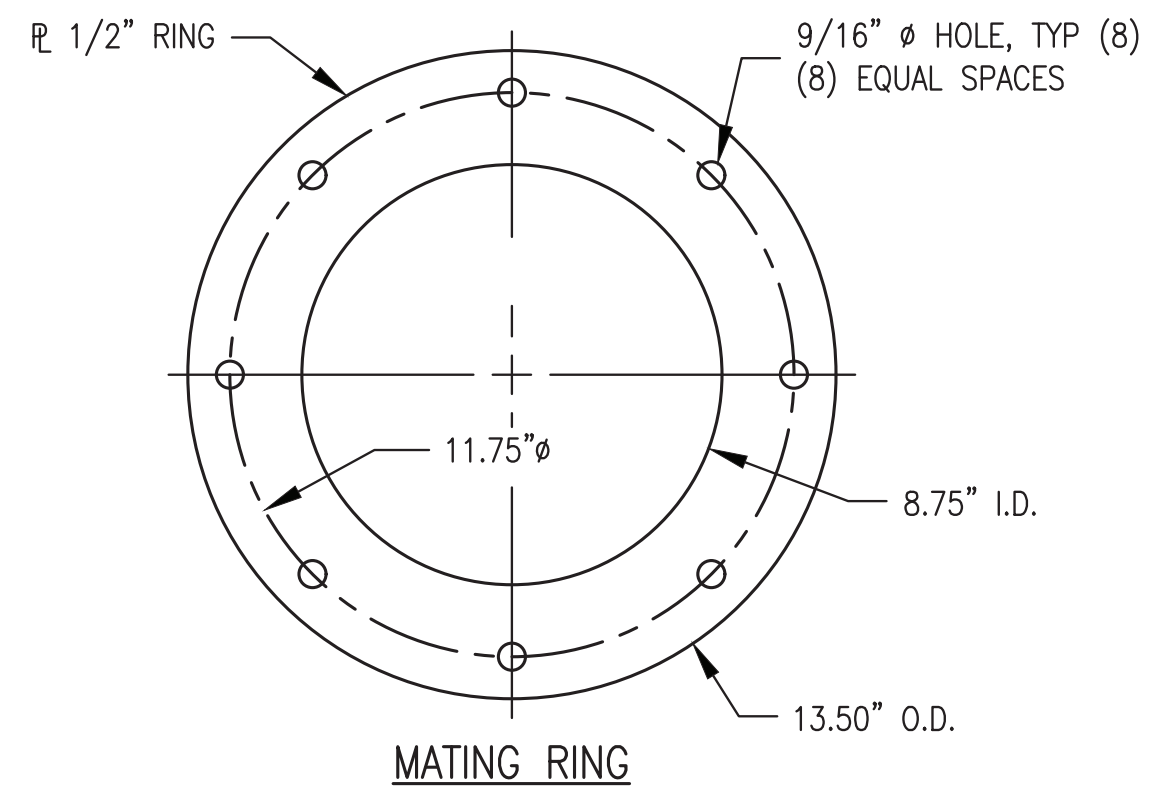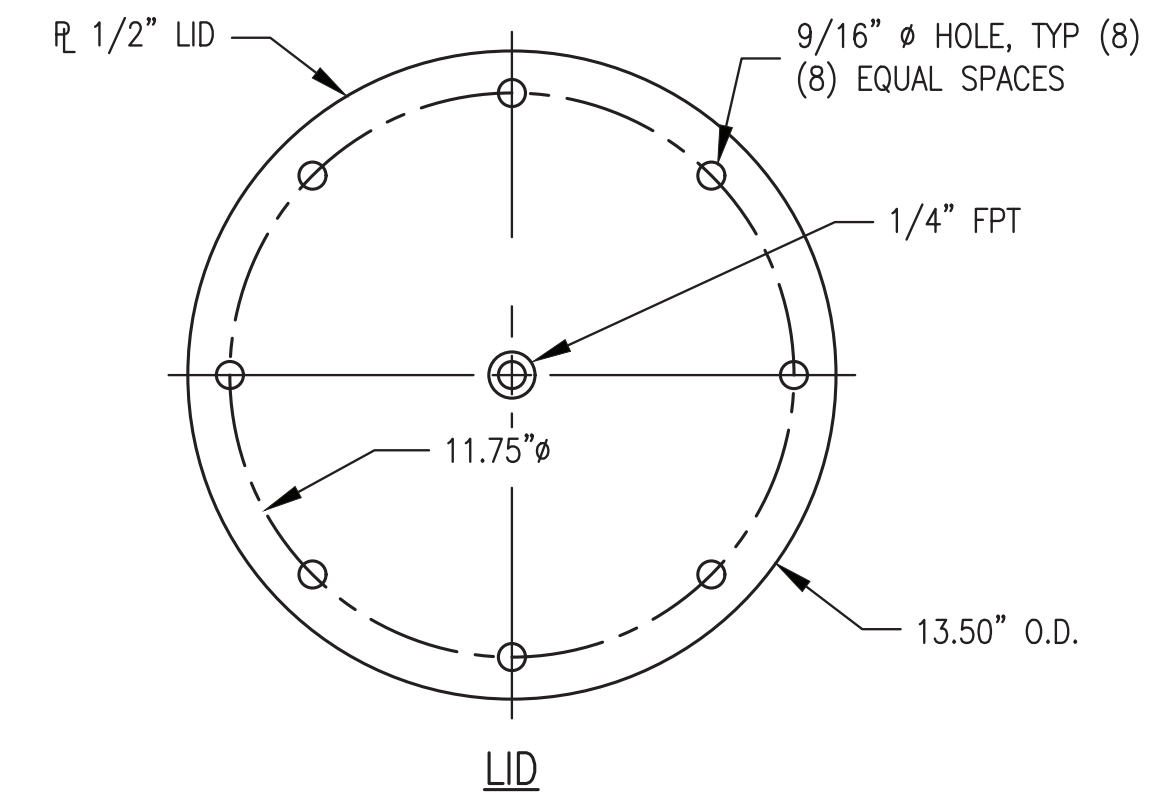


**6** LID & MATING RING – PLAN VIEW  
 M5.6 1/4" = 1"

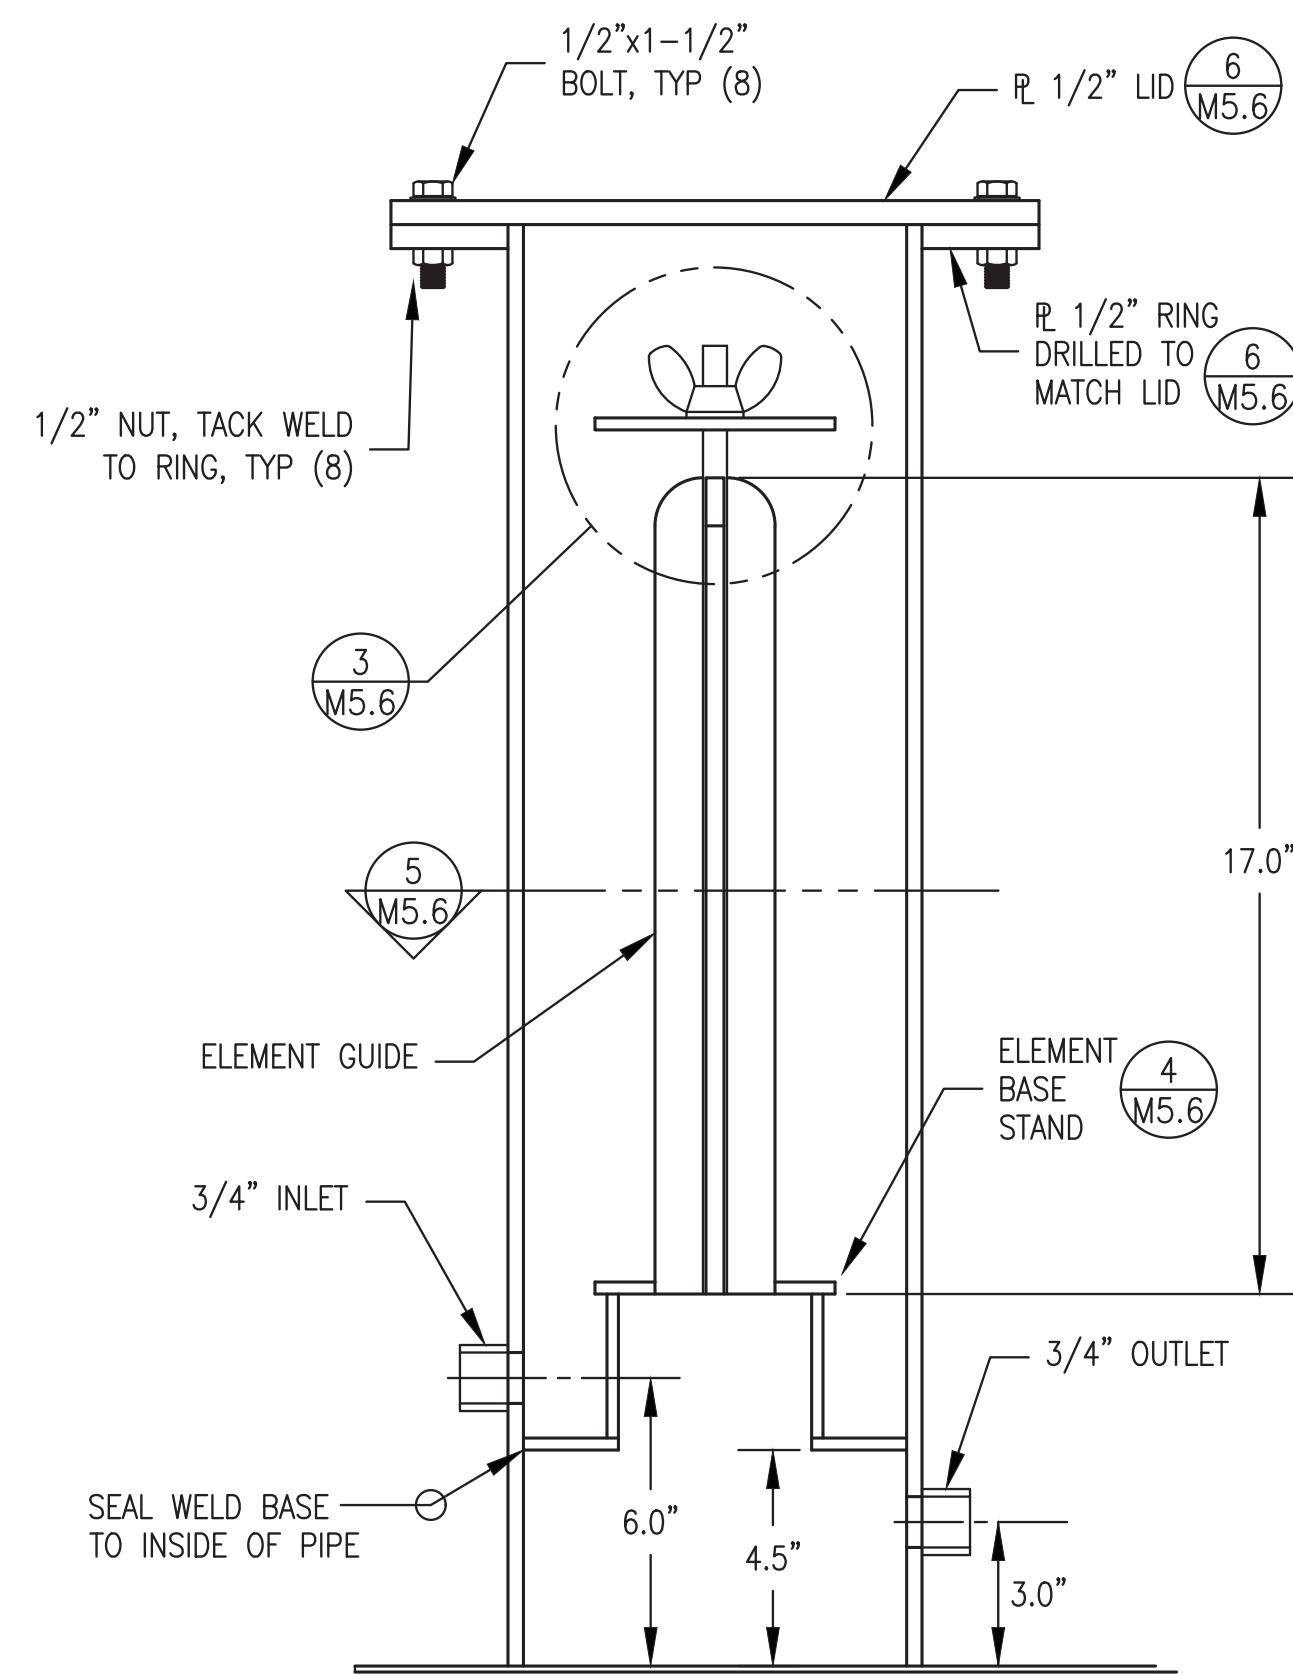

**2** TYPICAL SECTION THROUGH FILTER HOUSING  
 M5.6 1/4" = 1"

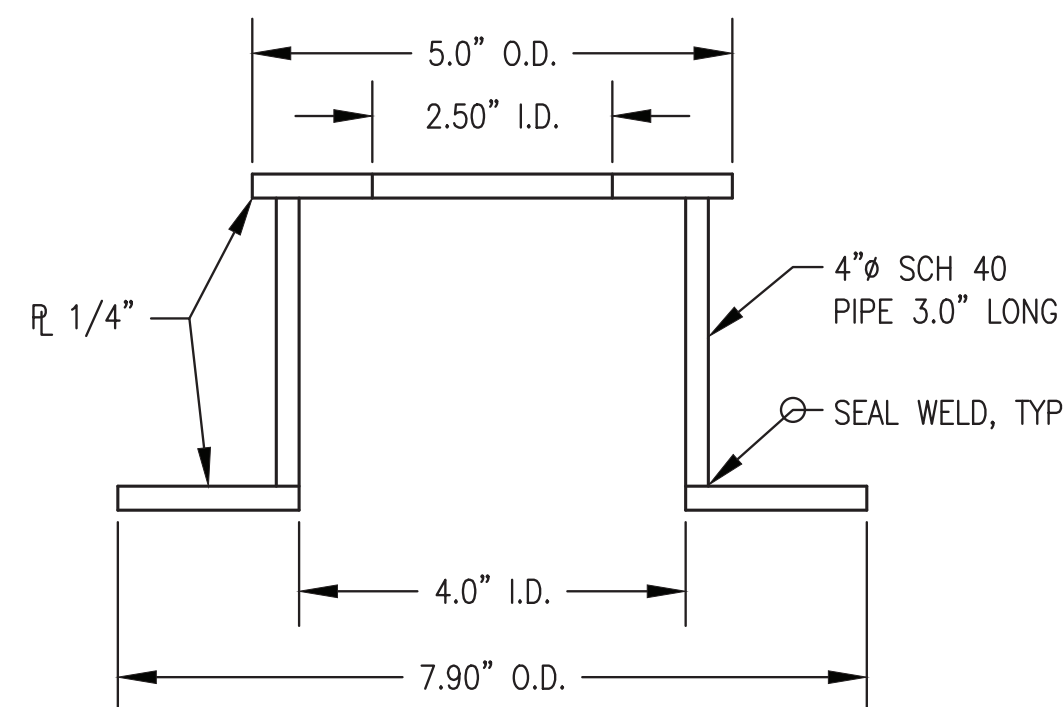

**4** ELEMENT BASE STAND  
 M5.6 1/2" = 1"

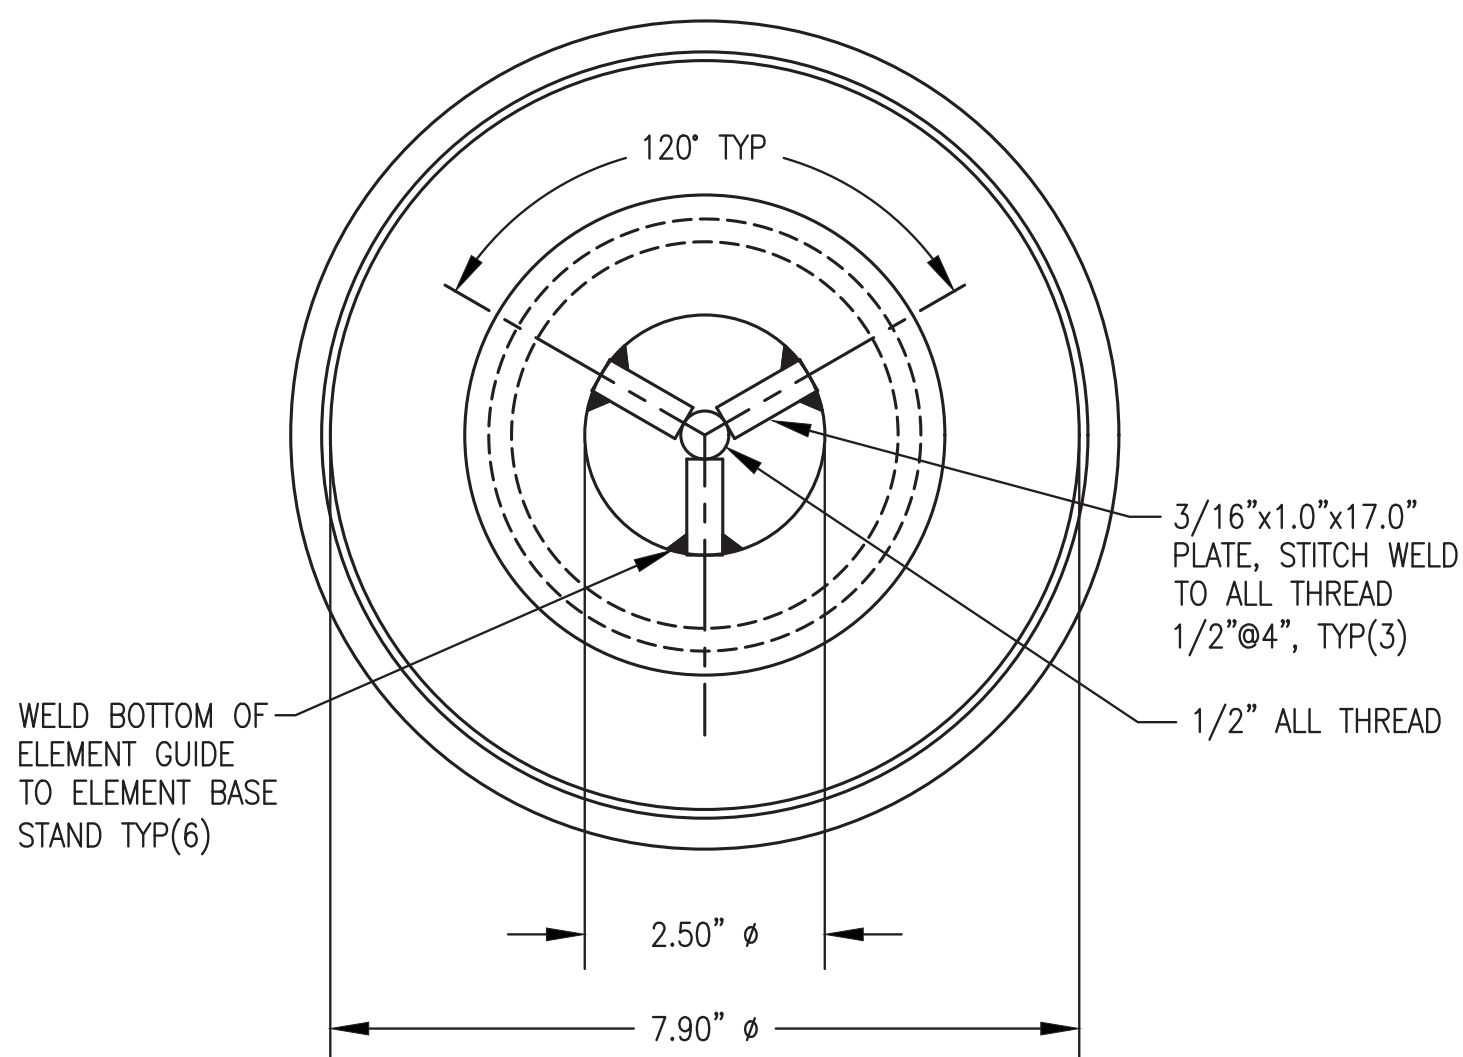

**5** SECTION THROUGH ELEMENT GUIDE  
 M5.6 1/2" = 1"







ALL WORK ON THIS SHEET WAS PERFORMED AS PART OF THE PRIOR MODULE ASSEMBLY CONTRACT AND IS SHOWN HERE FOR REFERENCE ONLY.

ISSUED FOR CONSTRUCTION  
 MAY 2023



PROJECT: NELSON LAGOON POWER SYSTEM UPGRADE		
TITLE: USED OIL BLENDER TYPICAL FILTER HOUSING DETAILS		
DRAWN BY: JTD	SCALE: AS NOTED	DATE: 5/30/23
DESIGNED BY: BCG	FILE NAME: NELS_PP_M2-M7	SHEET: M5.6
PROJECT NUMBER:		



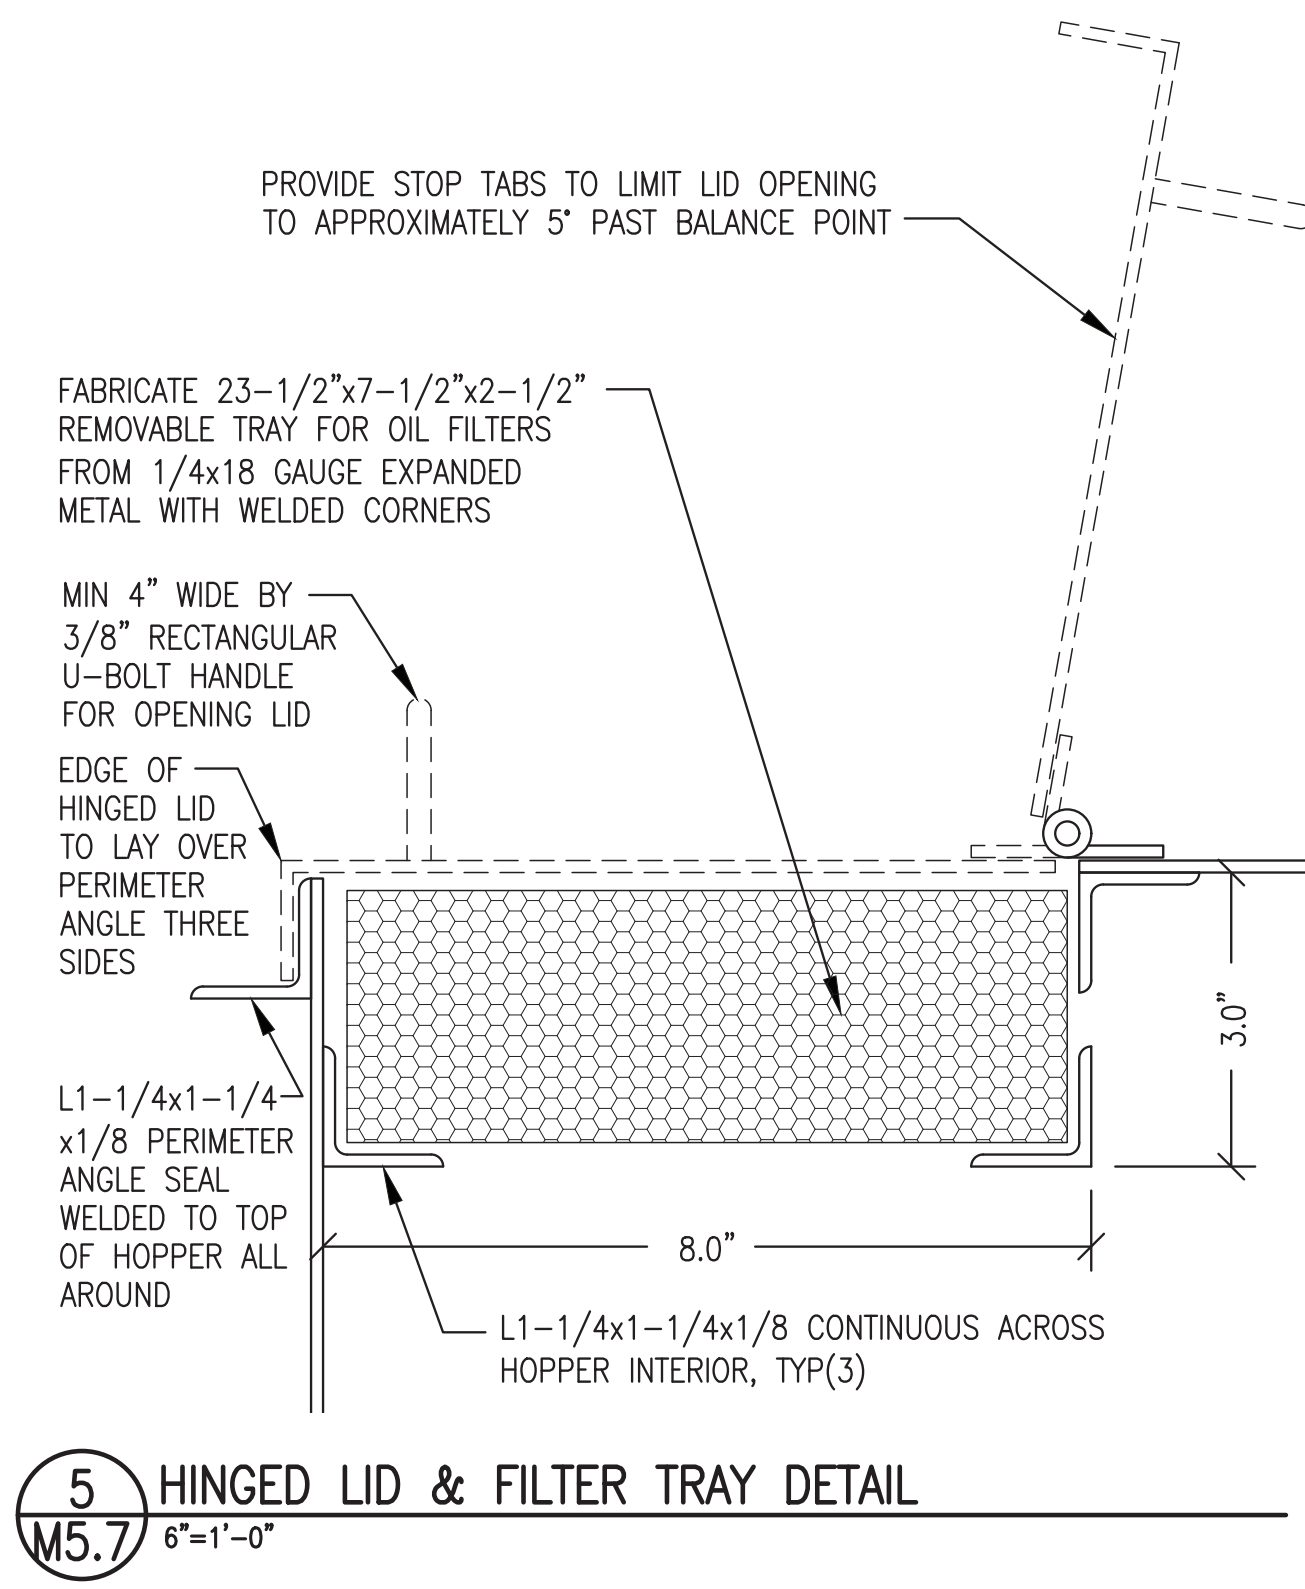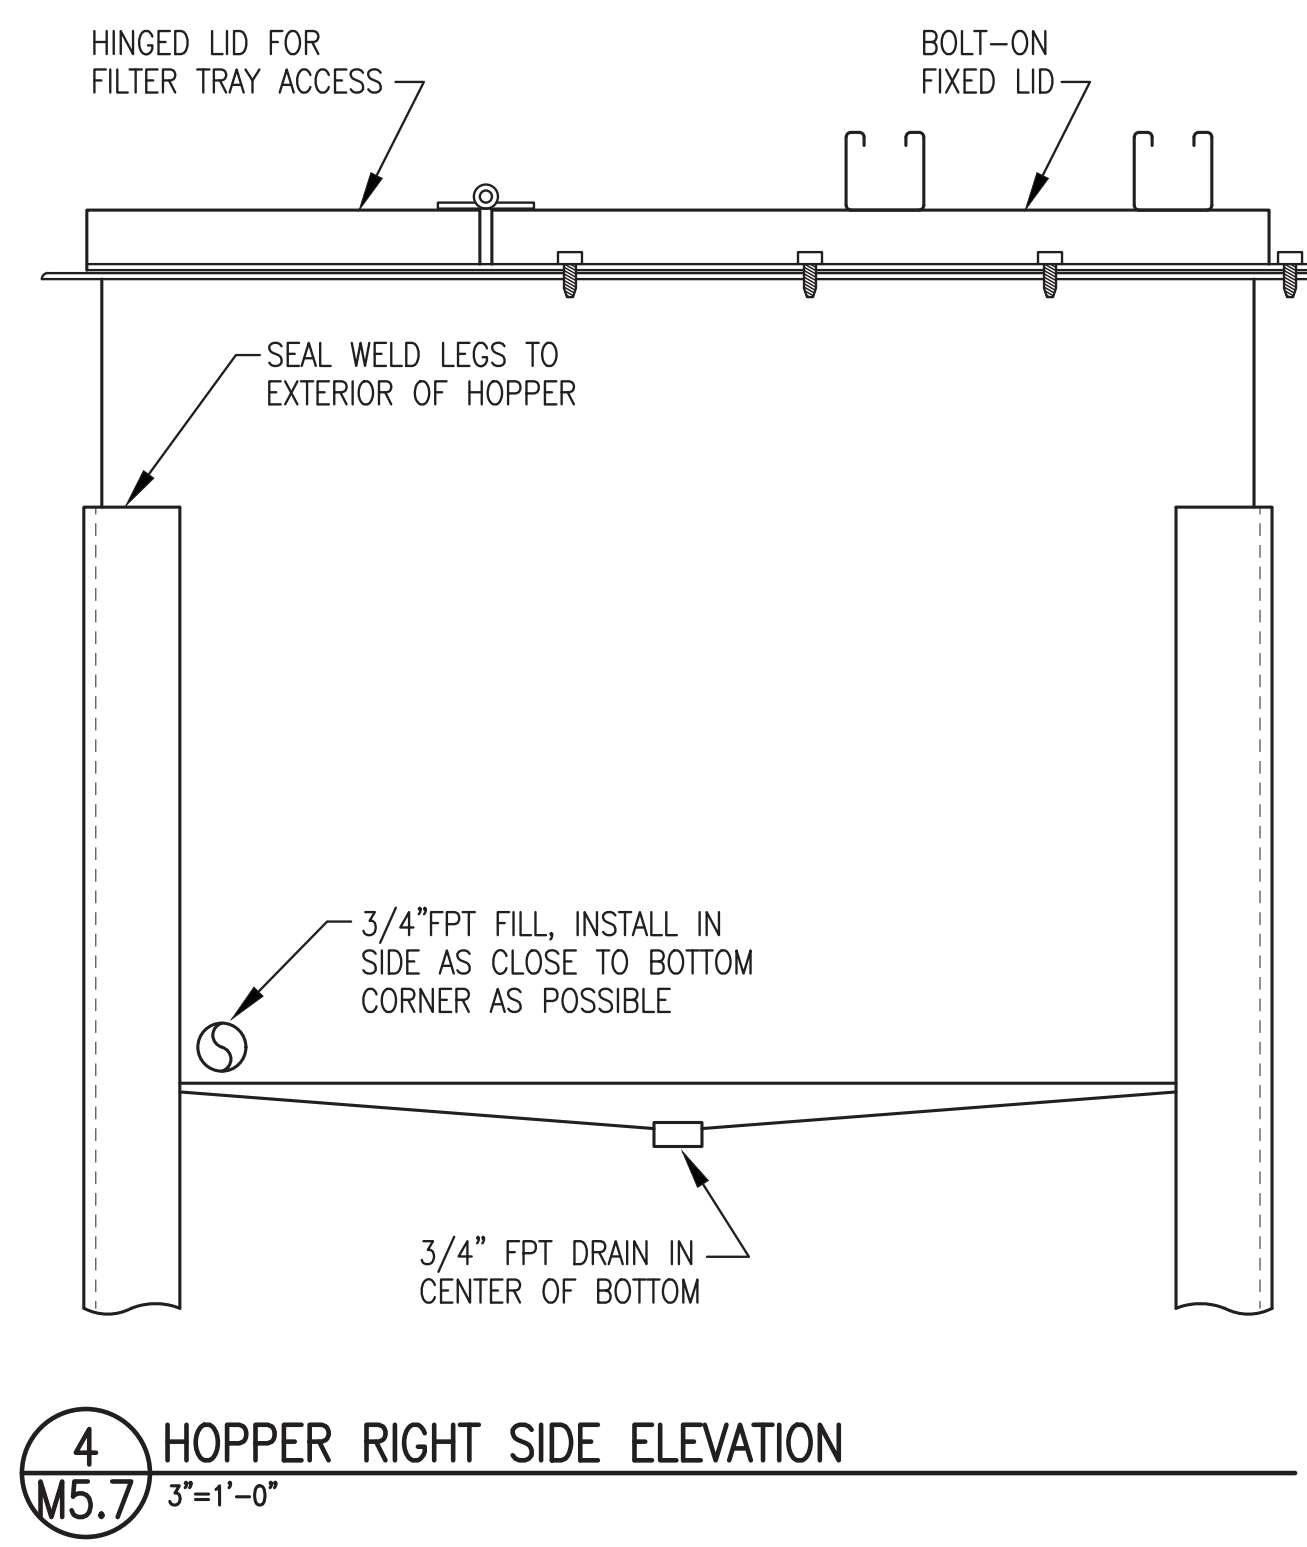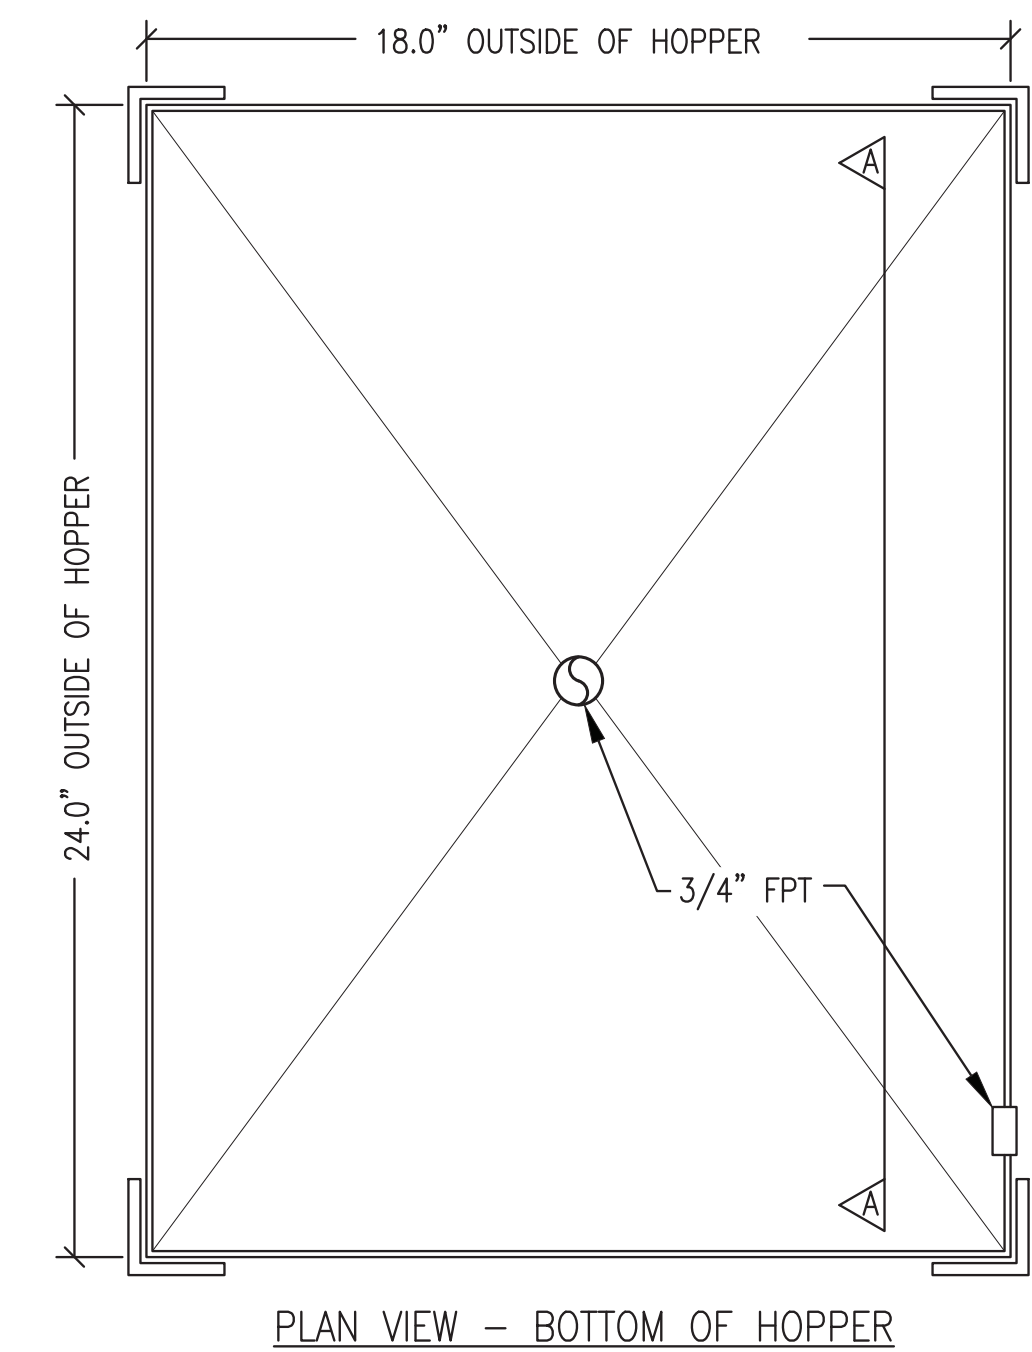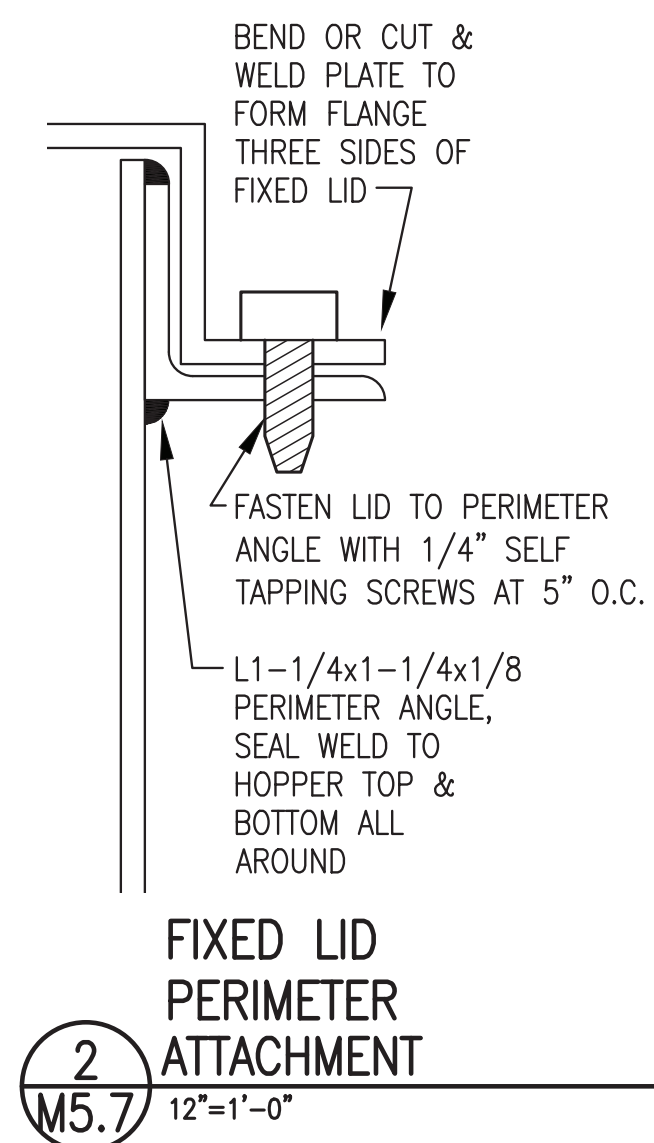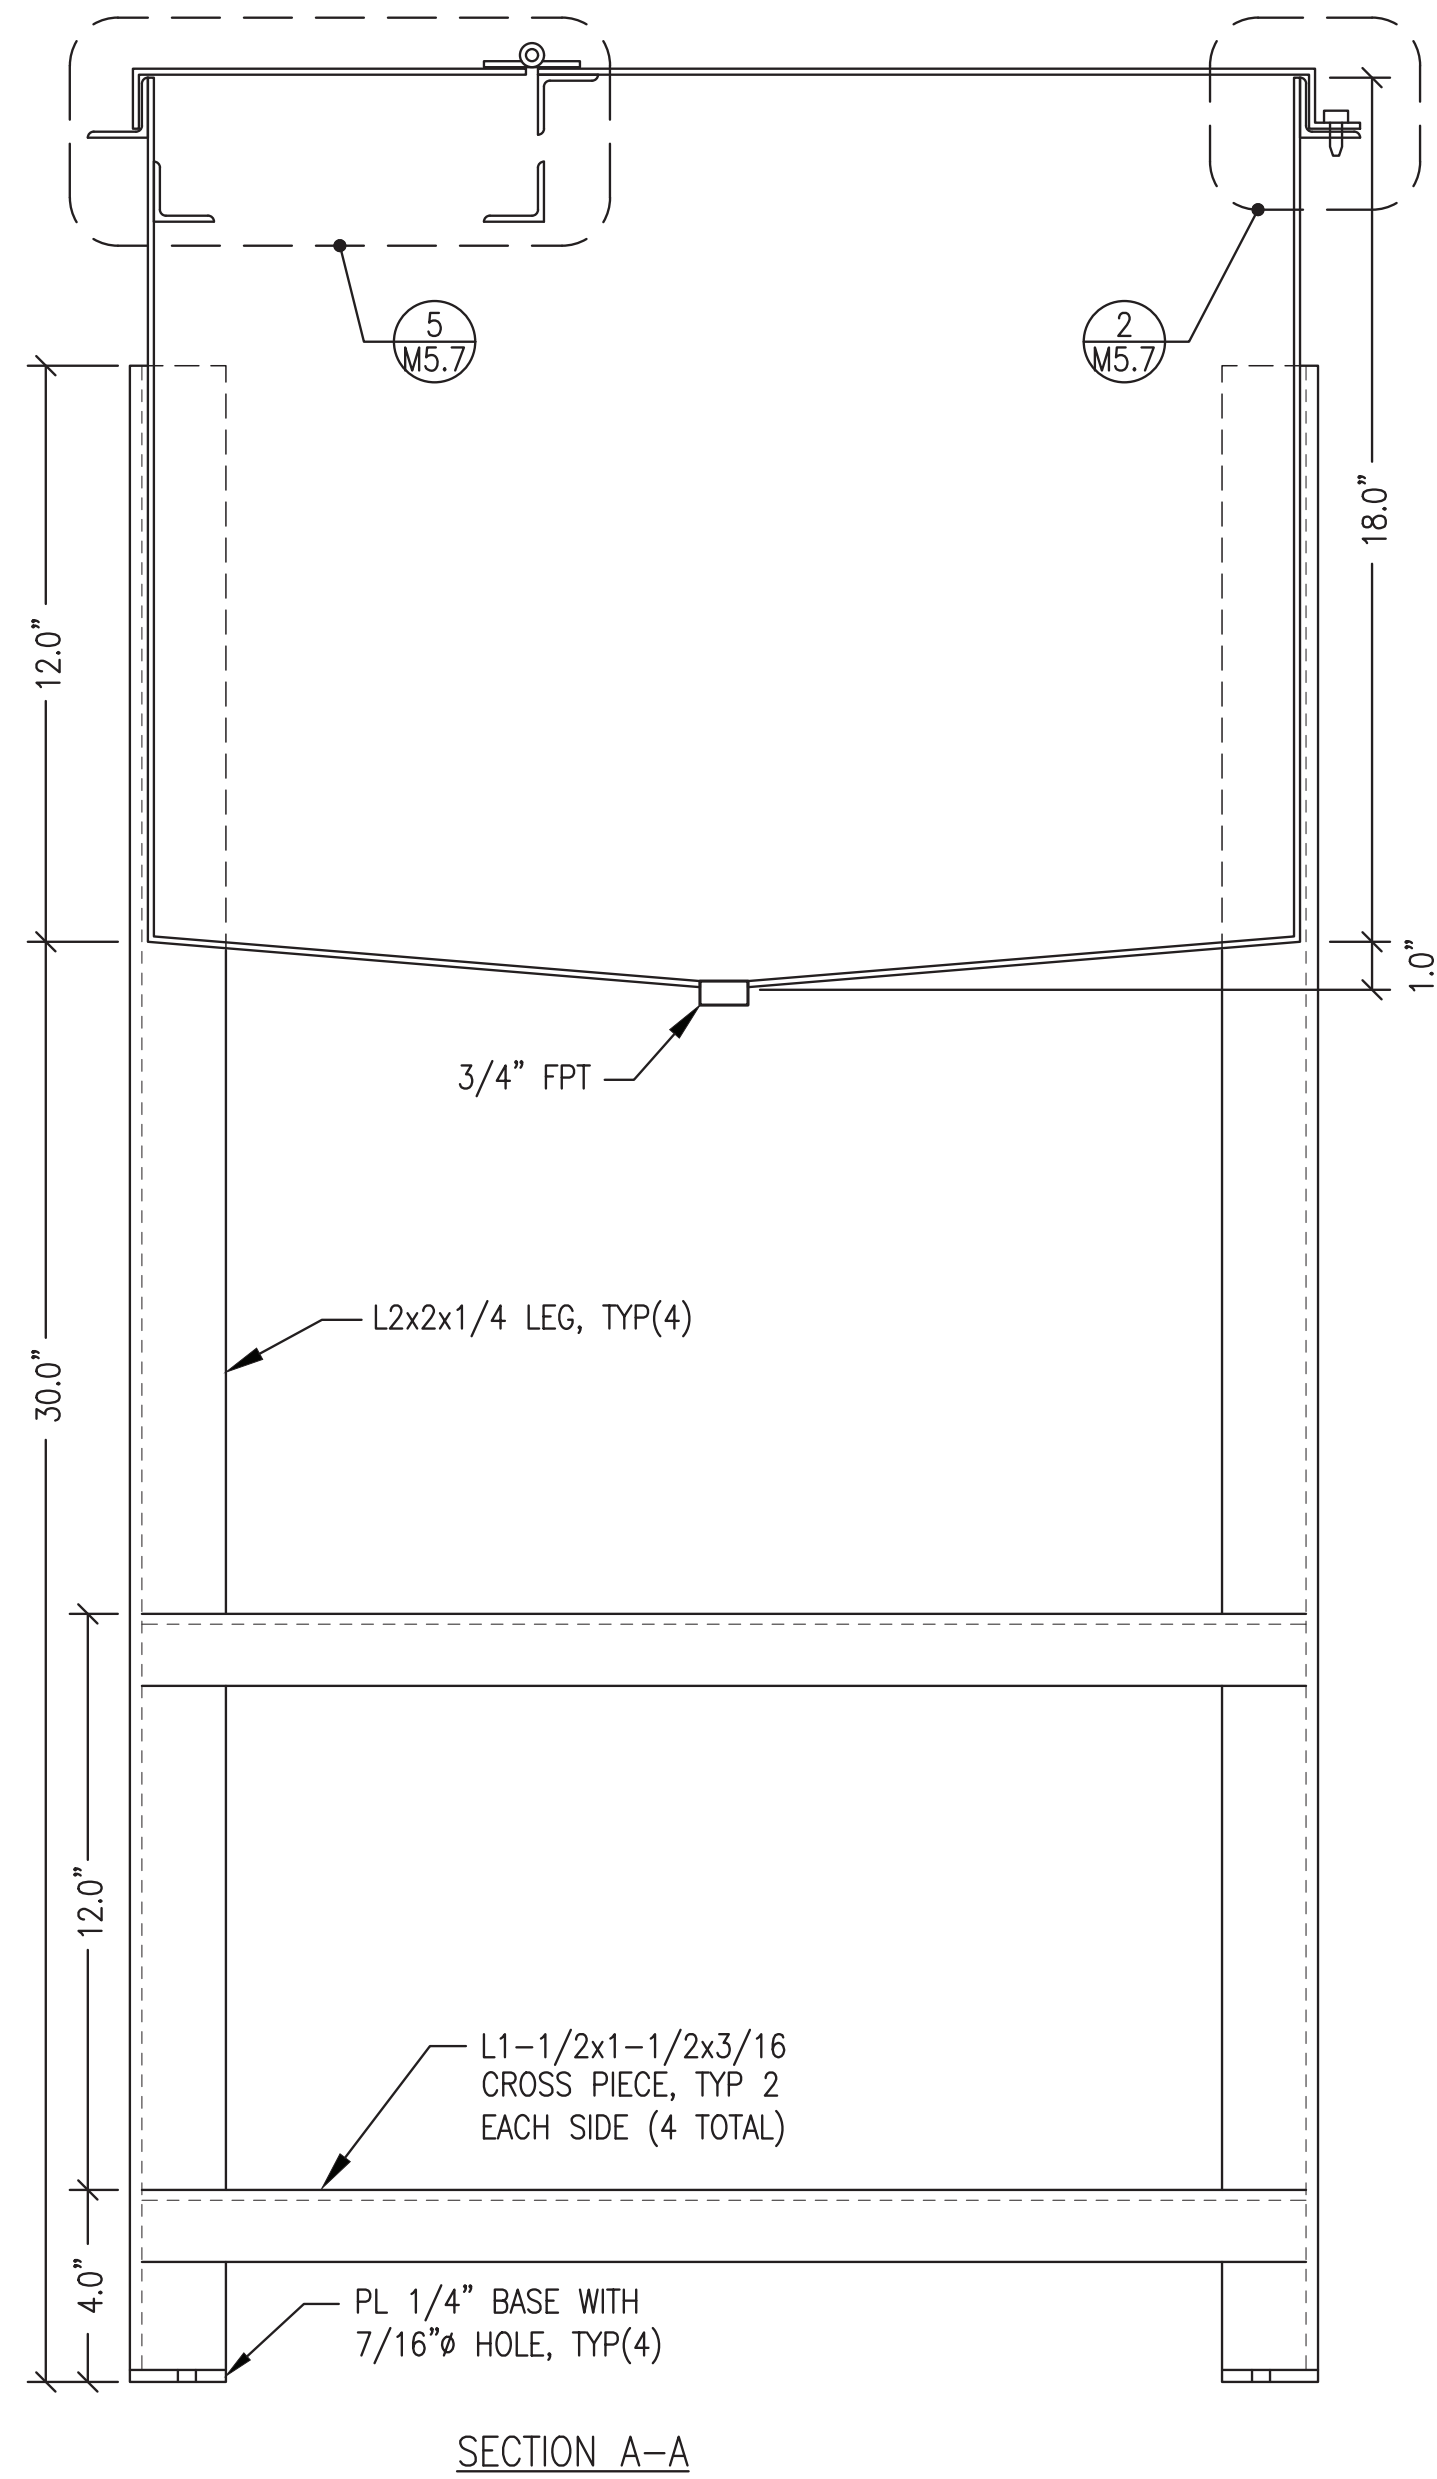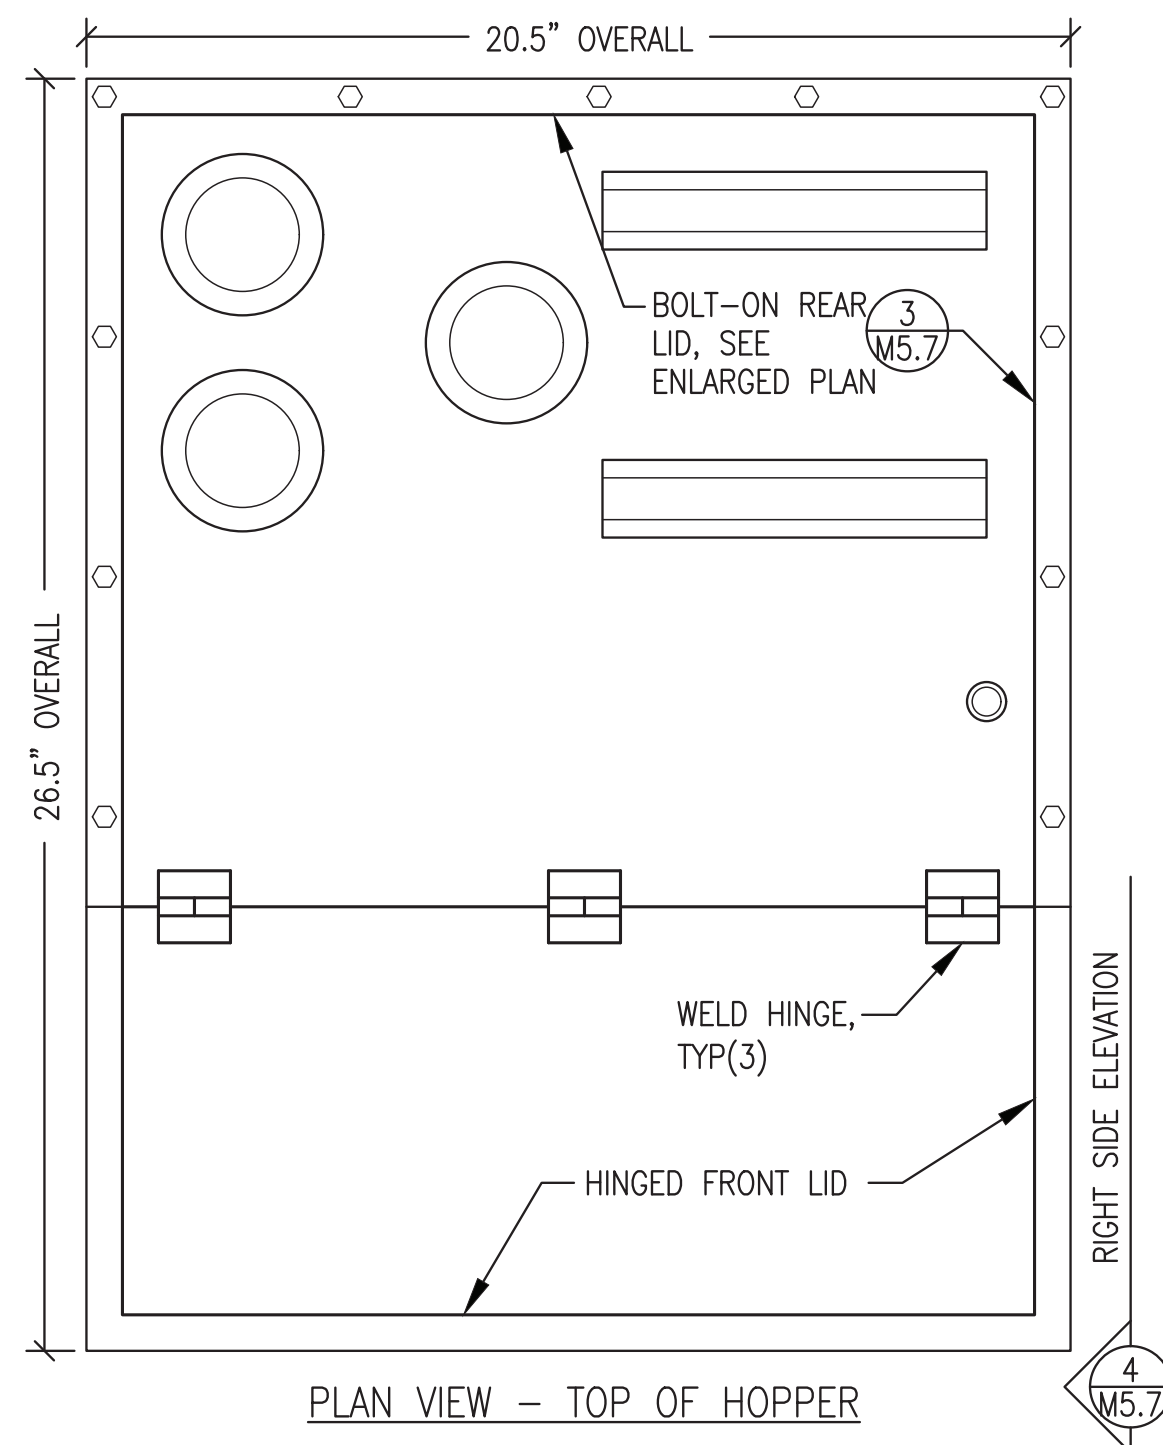


1 M5.7 HOPPER PLAN & SECTION  
3"=1'-0"



FABRICATION NOTES:


- FABRICATE SINGLE WALL 25 GALLON USABLE CAPACITY HOPPER.
- FABRICATE FROM MINIMUM 10 GAUGE ASTM A-36 STEEL PLATE. ALL TANK SEAM JOINTS TO BE FULL CONTINUOUS WELDS. SEAL WELD ALL TANK ATTACHMENTS.
- PROVIDE WITH ALL OPENINGS AND ATTACHMENTS INDICATED. INSTALL ALL FPT OPENINGS IN ACCORDANCE WITH UL 142 FIGURE 7.1 - #1, #2, #4, OR #6. ALL STRUT TO BE 1-5/8"x1-5/8"x12 GA SOLID BACK PLAIN (BLACK), B-LINE B22 PLN OR EQUAL. FURNISH ALL FASTENERS AS INDICATED.
- UPON COMPLETION OF FABRICATION, ROUND ALL CORNERS AND SHARP EDGES. SANDBLAST TANK EXTERIOR AND ALL ATTACHMENTS IN ACCORDANCE WITH SSPC-SP-6. PAINT WITH TWO COATS EPOXY, PPG AMERLOC 2 VOC OR APPROVED EQUAL, COLOR ANSI 61 GRAY.
- PRIOR TO SHIPPING, SEAL ALL FPT OPENINGS WITH PLASTIC OR STEEL PLUGS.

ALL WORK ON THIS SHEET WAS PERFORMED AS PART OF THE PRIOR MODULE ASSEMBLY CONTRACT AND IS SHOWN HERE FOR REFERENCE ONLY.

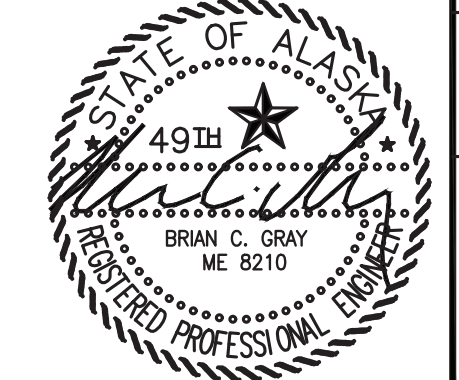ISSUED FOR CONSTRUCTION  
MAY 2023



 ALASKA ENERGY AUTHORITY	
PROJECT: NELSON LAGOON POWER SYSTEM UPGRADE	
TITLE: USED OIL BLENDER 25 GALLON HOPPER FABRICATION	
 Gray Stassel Engineering, Inc. P.O. 111405, Anchorage, AK 99511 (907)349-0100	DRAWN BY: JTD DESIGNED BY: BCG FILE NAME: NELS_PP_M2-M7 PROJECT NUMBER:
SCALE: AS NOTED DATE: 5/30/23 SHEET: M5.7	

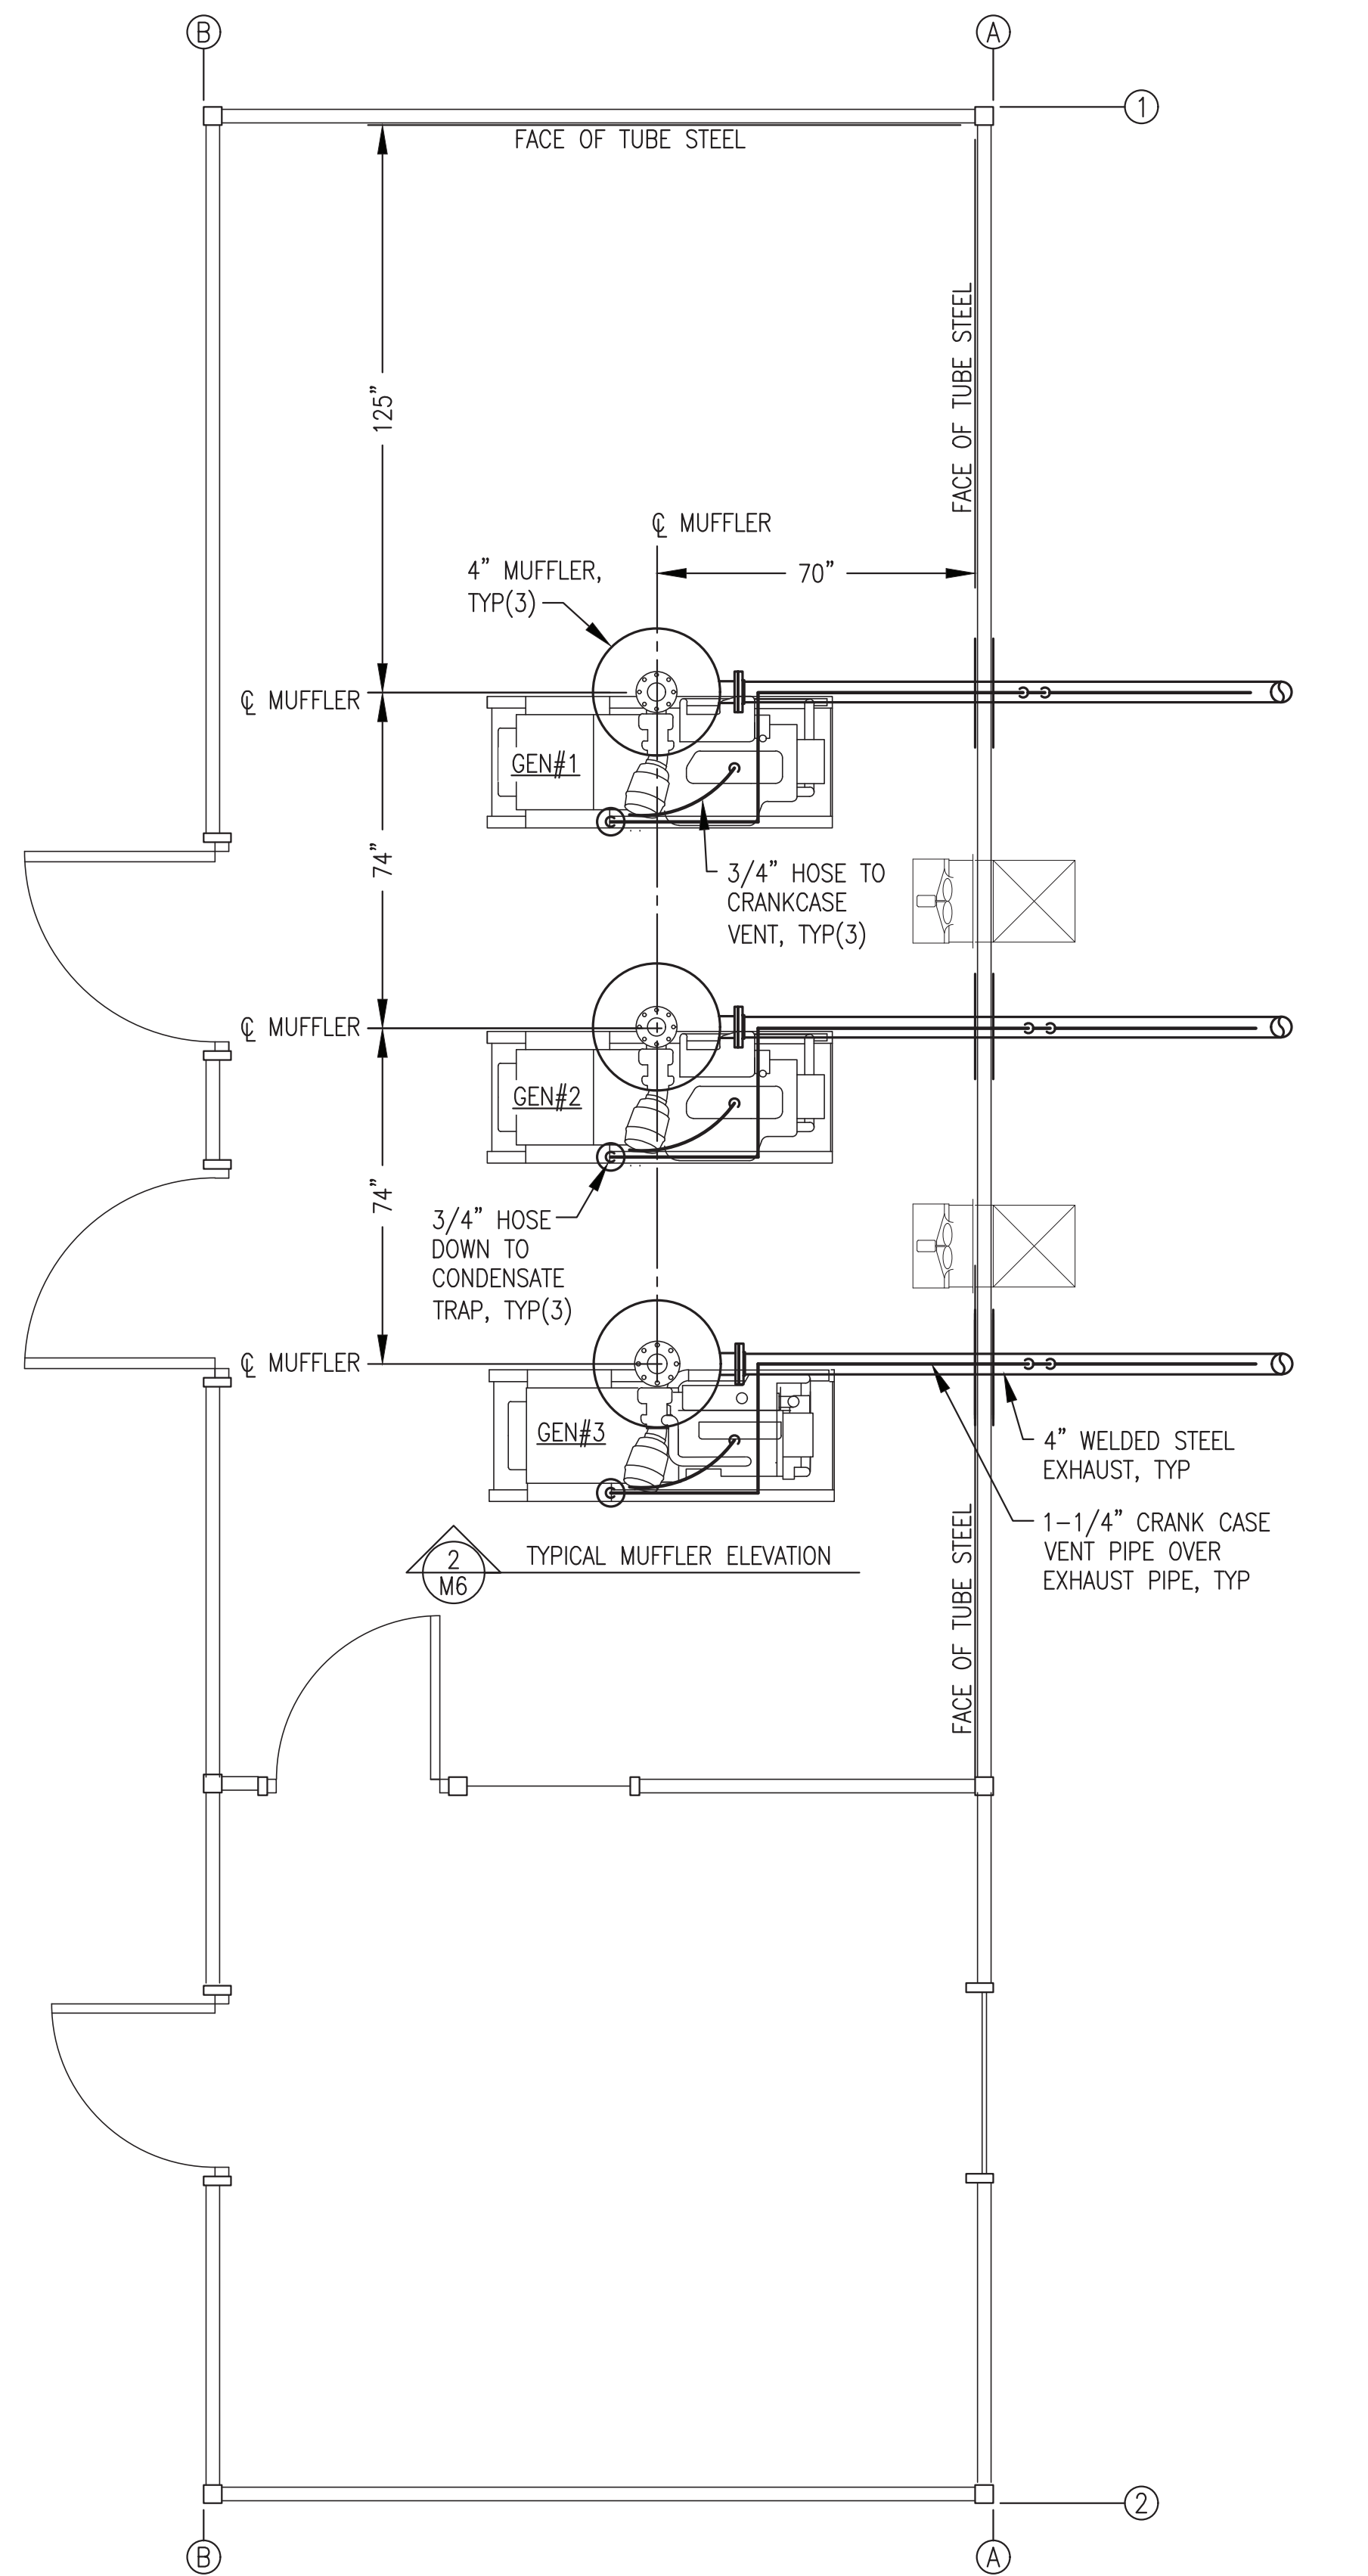

**EXHAUST & CRANK VENT GENERAL NOTES:**


- 1) THE MAXIMUM EXHAUST TEMPERATURE FOR THE ENGINES IS LESS THAN 1400°F. THE WALLS AND CEILING ARE NON-COMBUSTIBLE CONSTRUCTION CONSISTING OF STEEL WITH HIGH TEMPERATURE ROCKWOOL INSULATION.
- 2) ALL EXTERIOR EXHAUST PIPE AND FITTINGS (FROM MUFFLER TO RAIN CAP) TYPE 304L STAINLESS STEEL WITH BUTT WELD FITTINGS. INTERIOR EXHAUST PIPE RISER (FROM FLEX TO MUFFLER) CARBON STEEL OR MAY BE STAINLESS AT CONTRACTORS OPTION. ALL FLANGES ANSI 150# FLAT FACED SLIP ON.
- 3) ALL EXTERIOR CRANK VENT PIPE AND FITTINGS TYPE 304L STAINLESS STEEL WITH BUTT WELD FITTINGS. ALL INTERIOR CRANK VENT PIPE AND FITTINGS CARBON STEEL WITH SOCKET WELD FITTINGS OR MAY BE STAINLESS AT CONTRACTORS OPTION. ALL FLANGES ANSI 150# RAISED FACE SOCKET WELD.
- 4) ALL EXHAUST FLANGE BOLTS BLACK OR STAINLESS STEEL. COAT WITH HIGH TEMPERATURE ANTI-SIEZE COMPOUND. ALL EXHAUST FLANGE GASKETS HIGH TEMPERATURE FULL FACE.

**EXHAUST & CRANK VENT SHOP/ON-SITE NOTES:**

- 1) SHOP FABRICATE COMPLETE EXHAUST AND CRANK VENT PIPING SYSTEM AS INDICATED.
- 2) SHOP INSTALL BLANKET INSULATION ON FLEX AND RIGID INSULATION FROM FLEX TO MUFFLER. SHOP FIT INSULATION FROM MUFFLER TO WALL, LABEL FOR THE ASSOCIATED GENERATOR AND STORE INSIDE MODULE.
- 3) SHOP FABRICATE STAINLESS STEEL COVER PLATES BUT DO NOT INSTALL. LABEL COVER PLATES FOR THE ASSOCIATED GENERATOR AND STORE INSIDE MODULE. SHOP FURNISH ROCK WOOL INSULATION AND PACKAGE LOOSE SHIP WITH COVER PLATES.
- 4) UPON COMPLETION OF TESTING BREAK EXHAUST FLANGE JOINT ON MUFFLER OUTLET AND CRANK VENT FLANGE JOINT AND REMOVE U-BOLTS. REMOVE PIPING FOR SHIPPING AND TEMPORARILY SEAL WALL PENETRATION.
- 5) IN FIELD REINSTALL PIPING WITH NEW FLANGE GASKETS. RE-INSTALL PIPING INSULATION. INSULATE WALL PENETRATION, INSTALL COVER PLATES, AND SEAL TO WALL.


**1**  
M6 3/8"=1'-0"

**MUFFLER, EXHAUST & CRANK VENT PIPE PLAN**

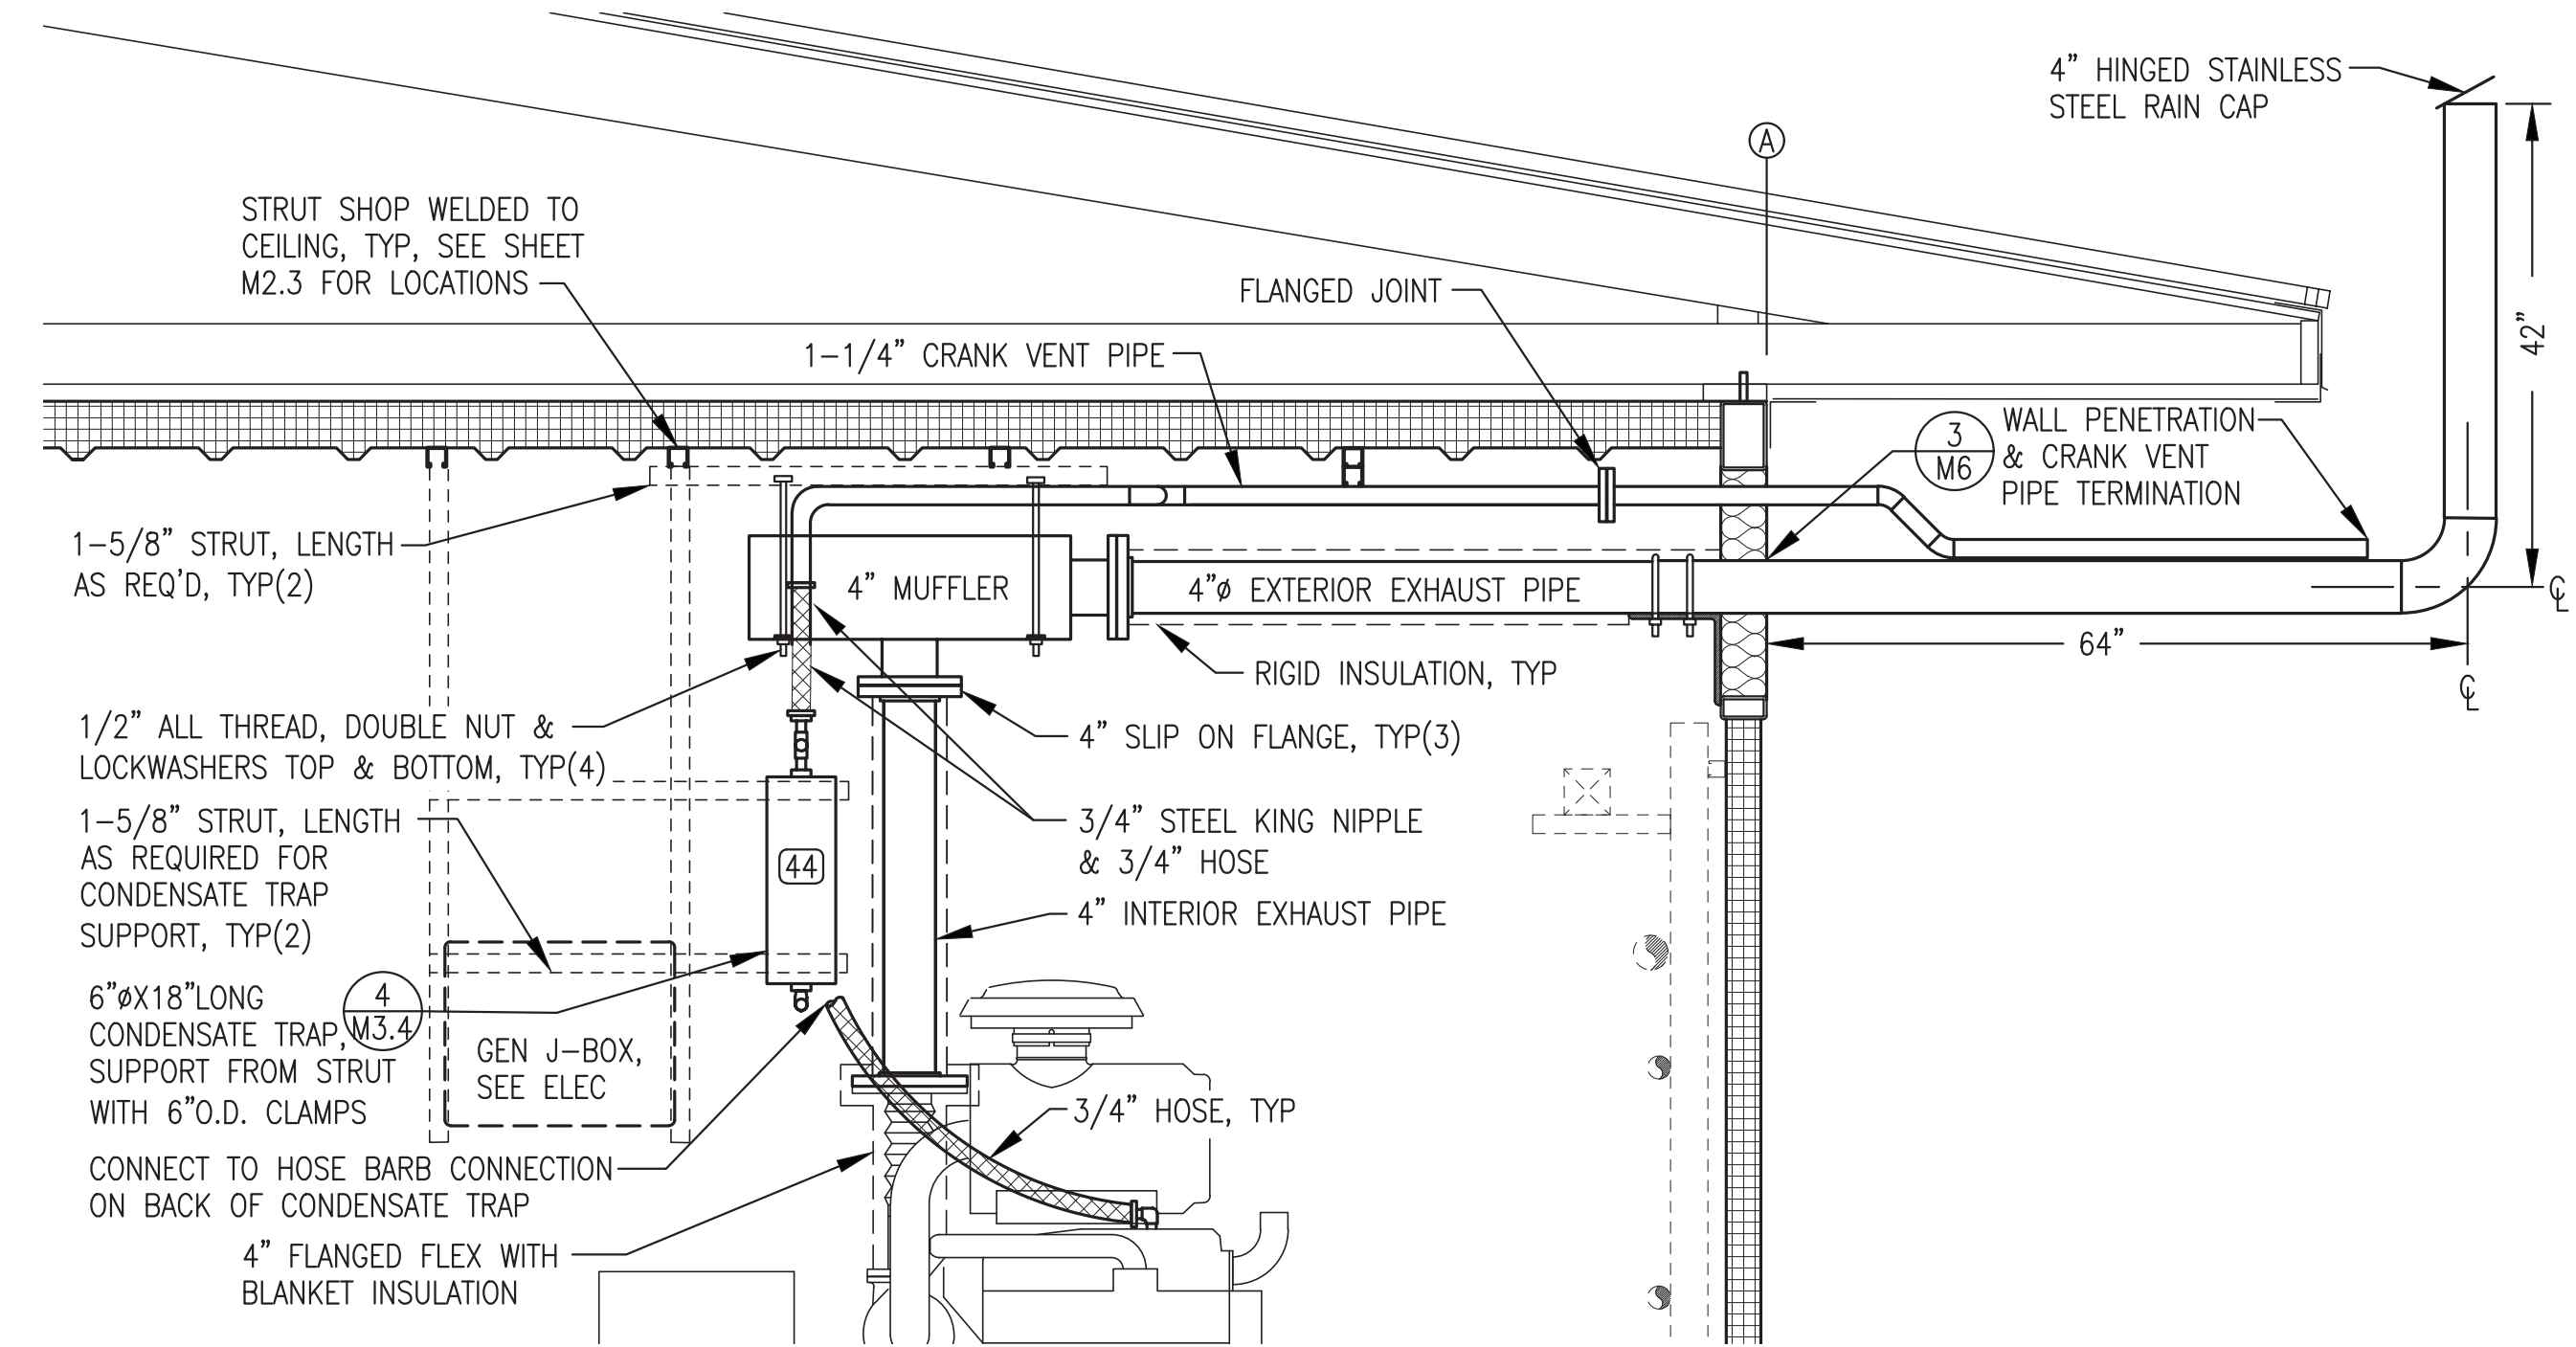

**2**  
M6 3/4"=1'-0"

**TYPICAL MUFFLER, EXHAUST, CONDENSATE TRAP & CRANK VENT PIPE INSTALLATION**

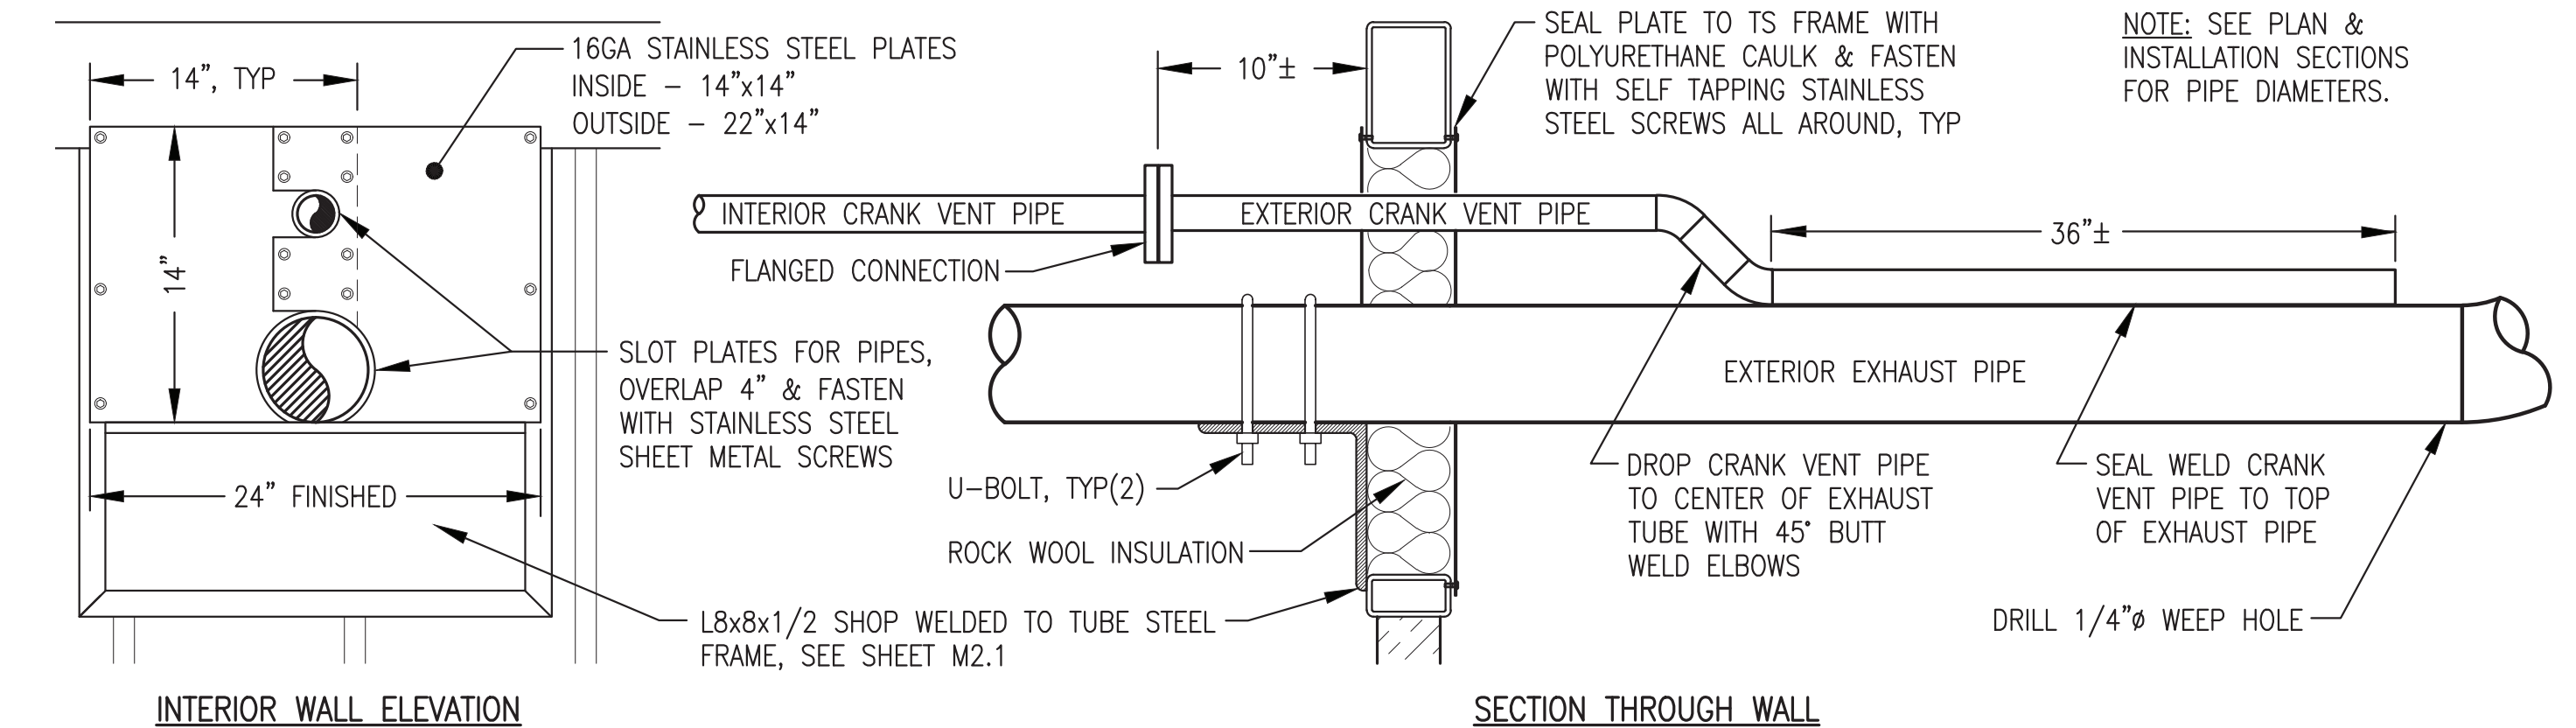


**3**  
M6 NO SCALE

**WALL PENETRATION & CRANK VENT PIPE TERMINATION**


ALL WORK ON THIS SHEET WAS PERFORMED AS PART OF THE PRIOR MODULE ASSEMBLY CONTRACT EXCEPT AS SPECIFICALLY INDICATED IN THE SHOP/ON SITE NOTES.

REV#1  
ISSUED FOR  
CONSTRUCTION  
AUGUST 2023

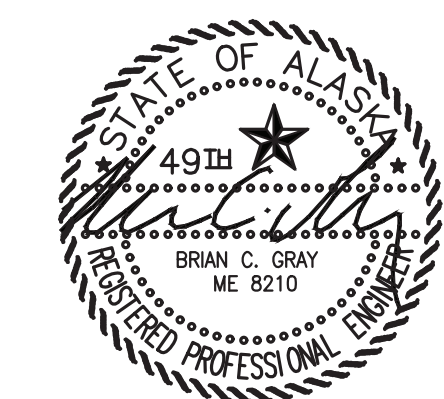


1	ADD DECAL 44 TO CONDENSATE TRAP	8/16/23	BCG
REV.	DESCRIPTION	DATE	BY
<p>ALASKA ENERGY AUTHORITY</p>			
PROJECT: NELSON LAGOON POWER SYSTEM UPGRADE			
TITLE: EXHAUST & CRANK VENT PLAN & DETAILS			
DRAWN BY: JTD		SCALE: AS NOTED	
DESIGNED BY: BCG		DATE: 5/30/23	
FILE NAME: NELS PP M2-M7		SHEET: M6	
PROJECT NUMBER:			
P.O. 111405, Anchorage, AK 99511 (907)349-0100			




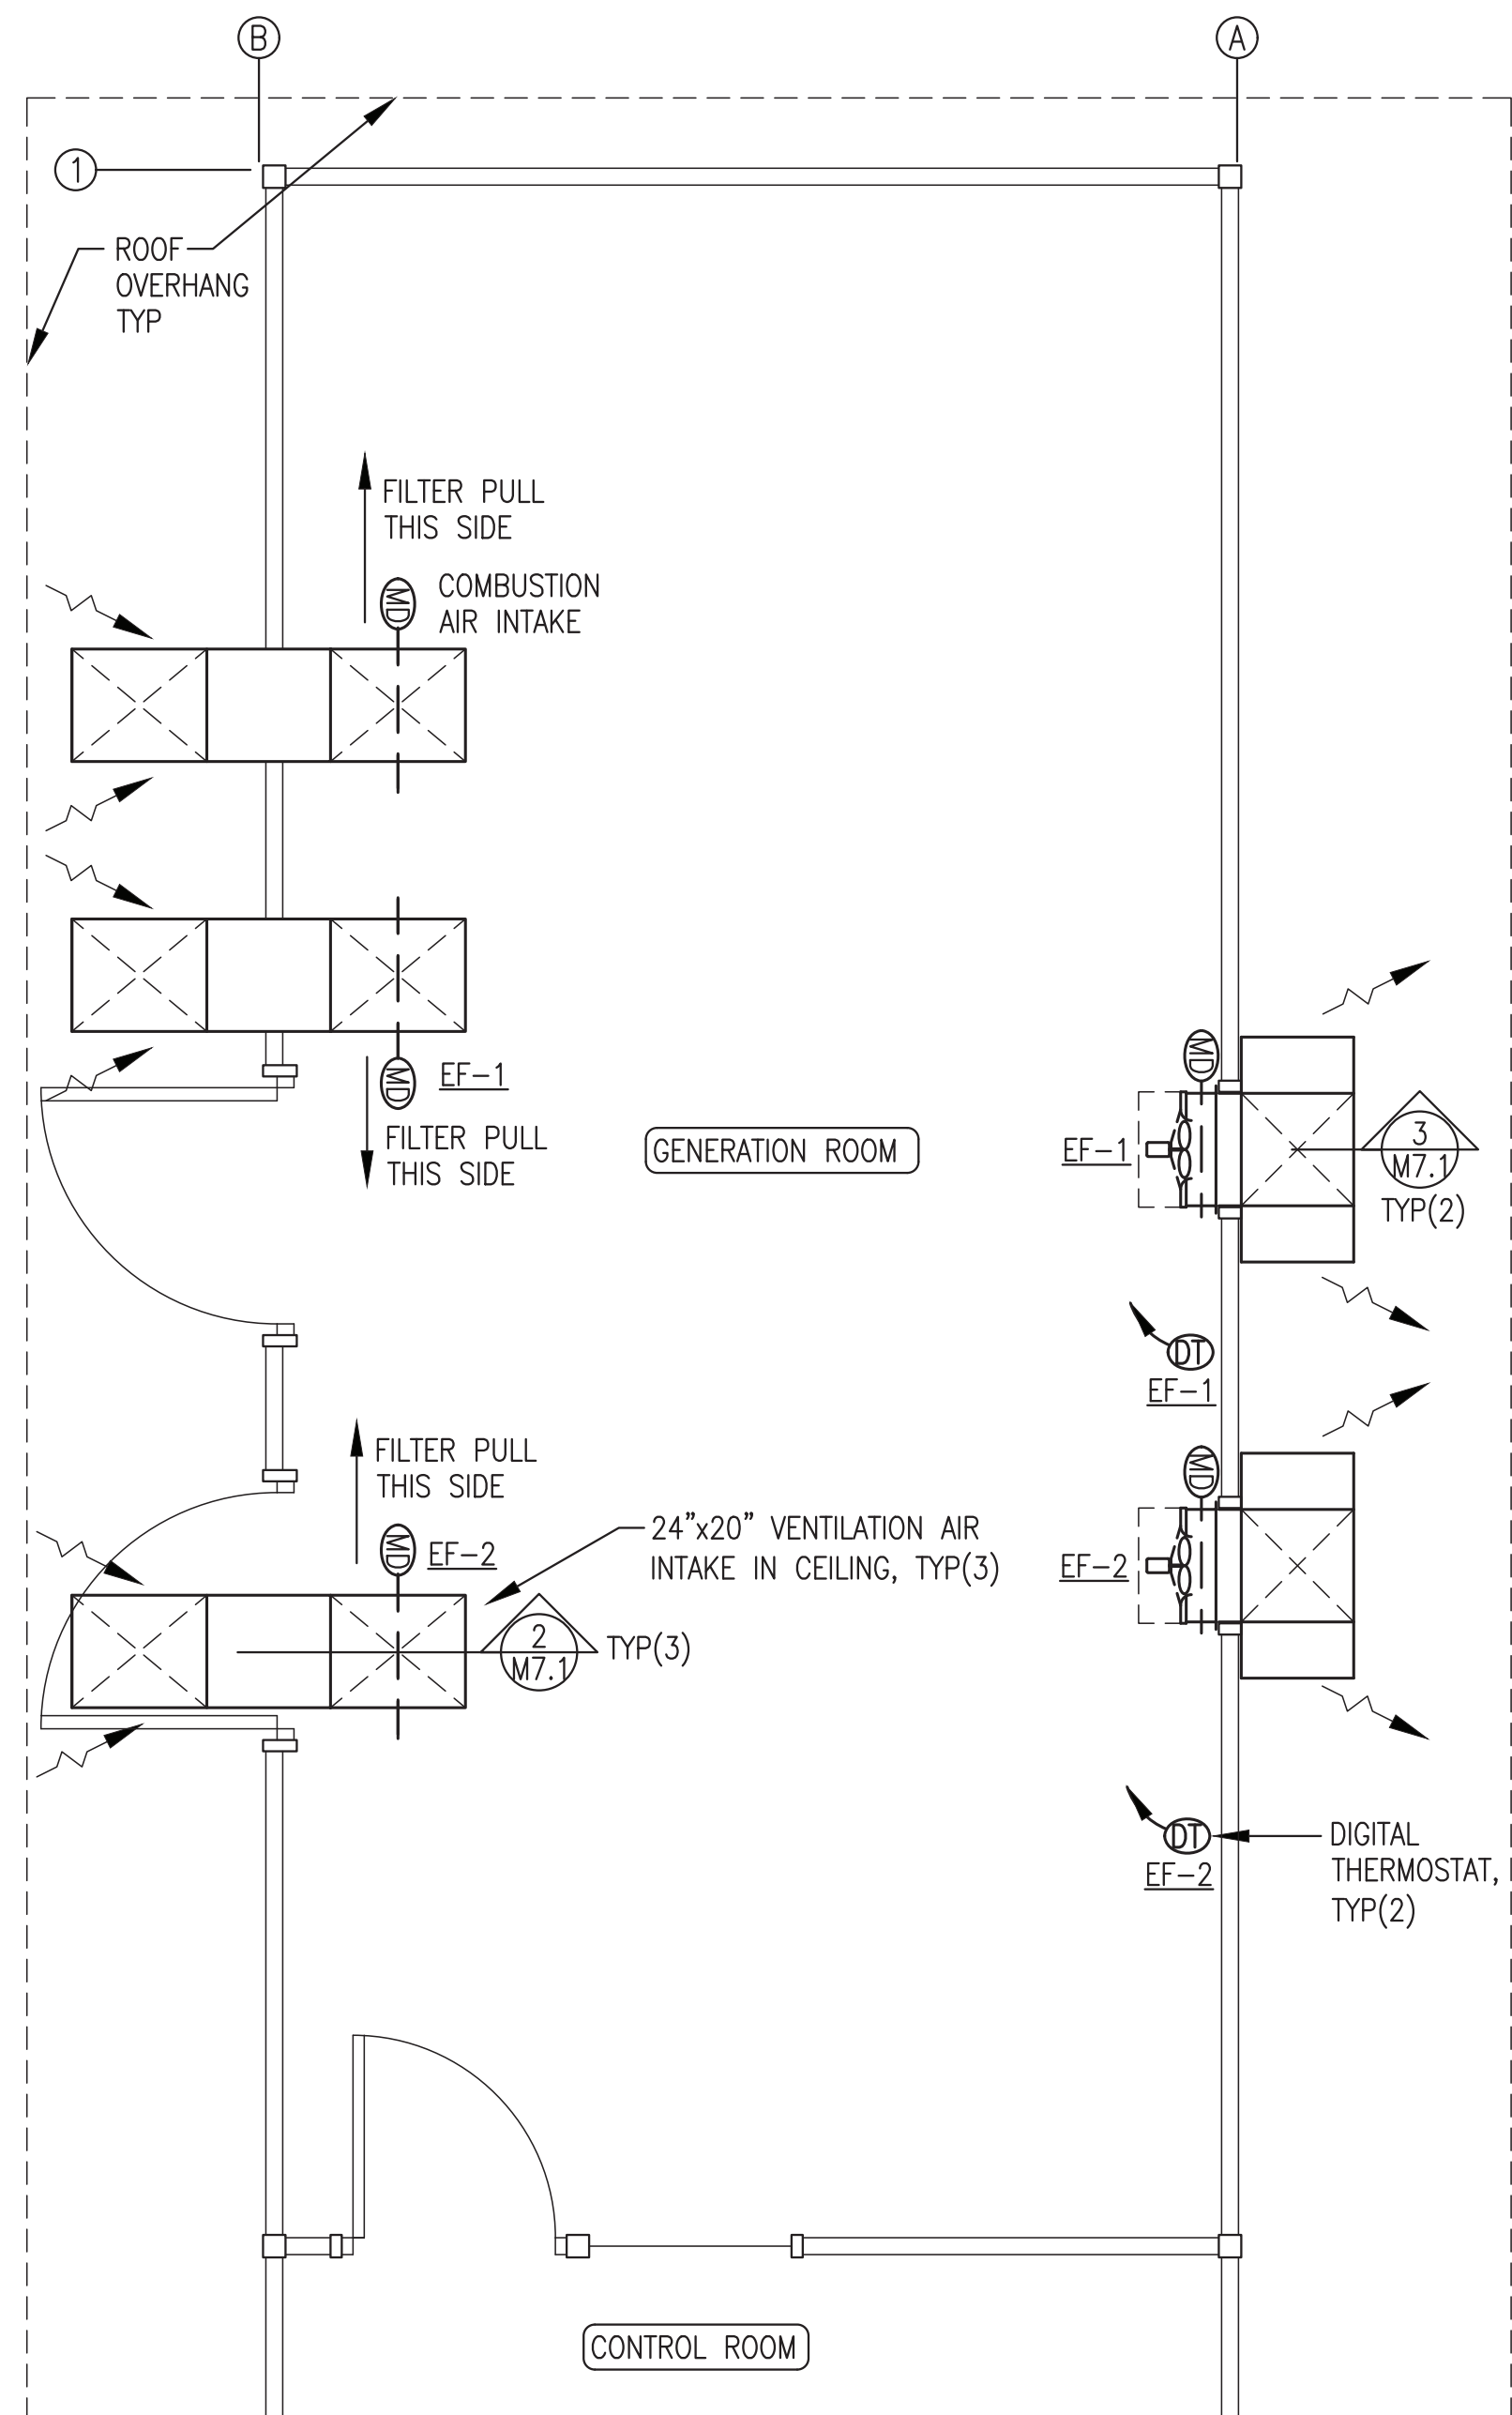


**1** VENTILATION PLAN  
M7.1 3/8"=1'-0"

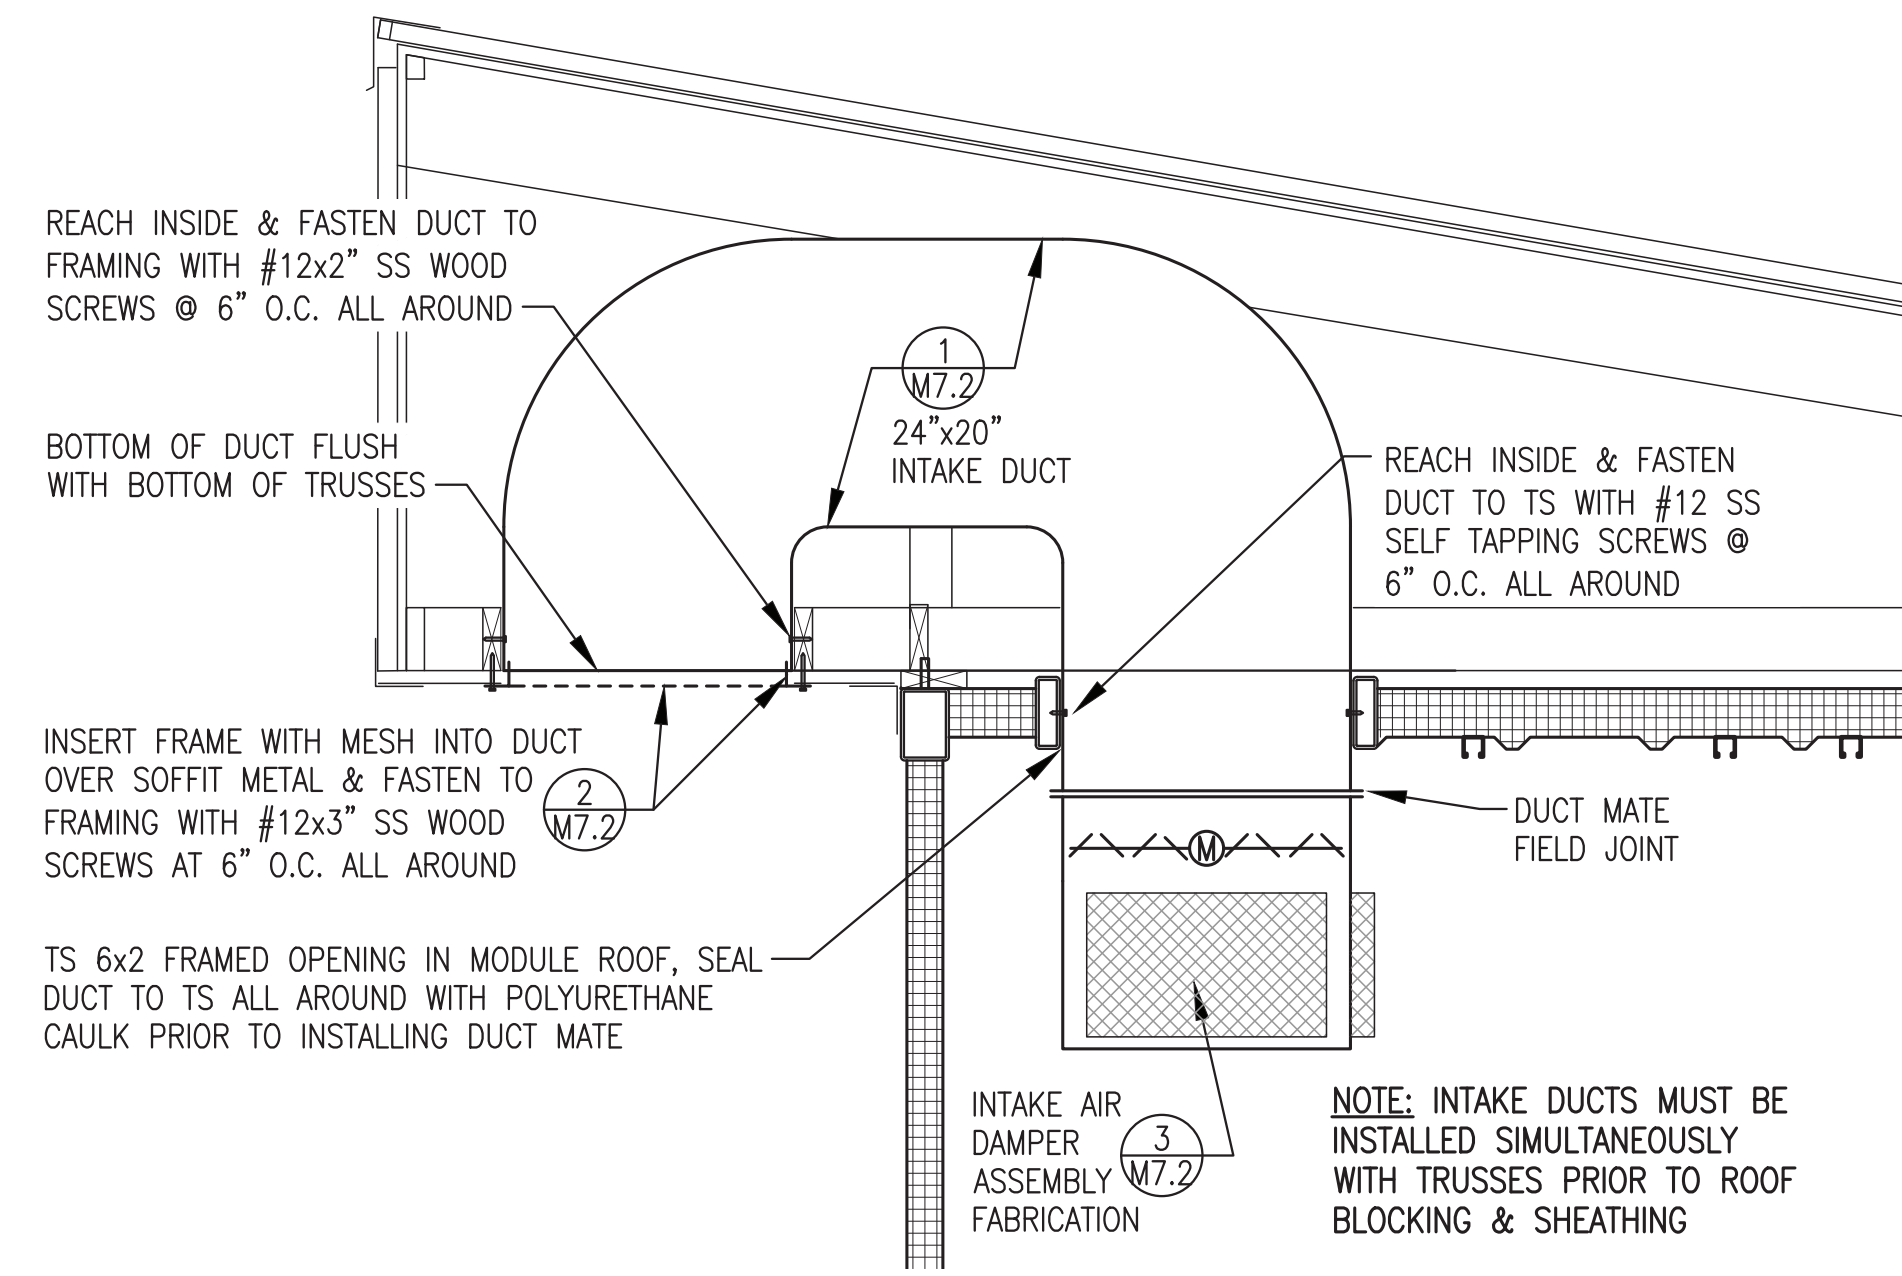

**2** INTAKE DUCT INSTALLATION  
M7.1 3/4"=1'-0"

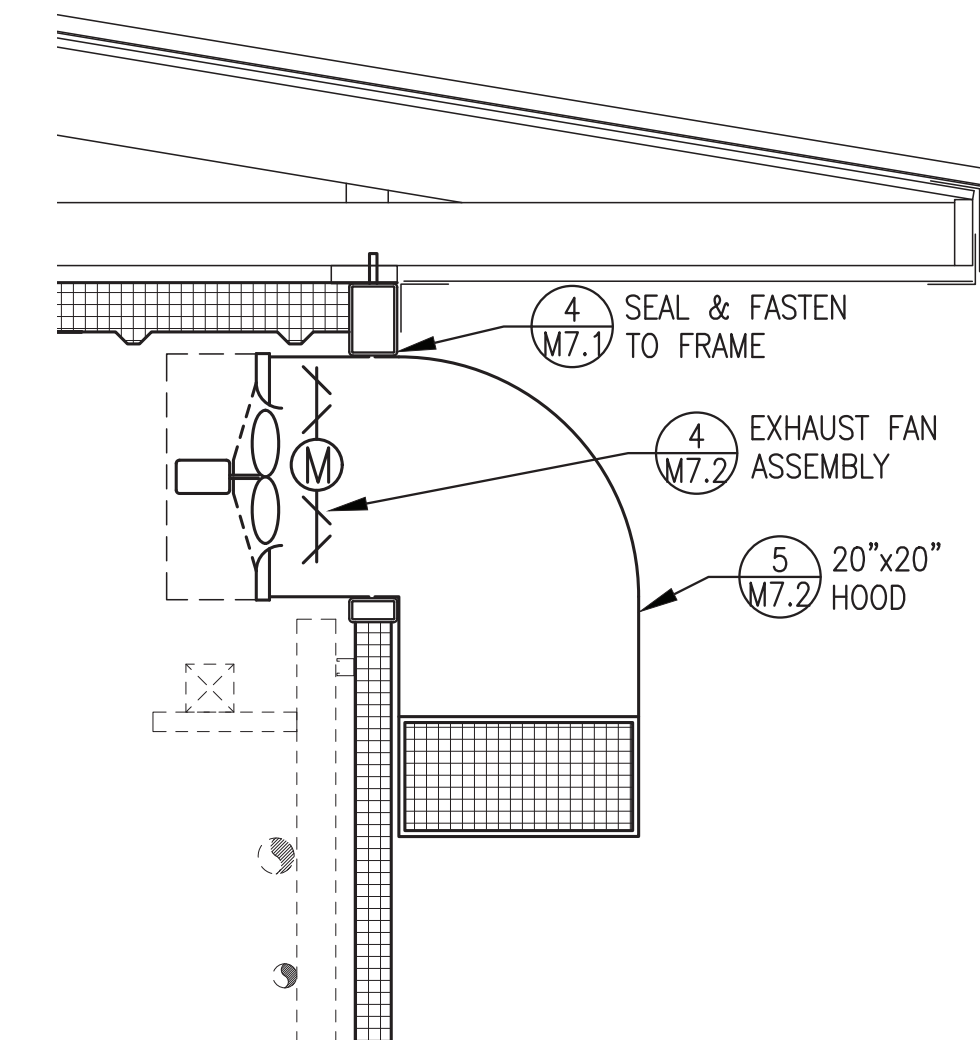

**3** EXHAUST FAN INSTALLATION  
M7.1 3/4"=1'-0"

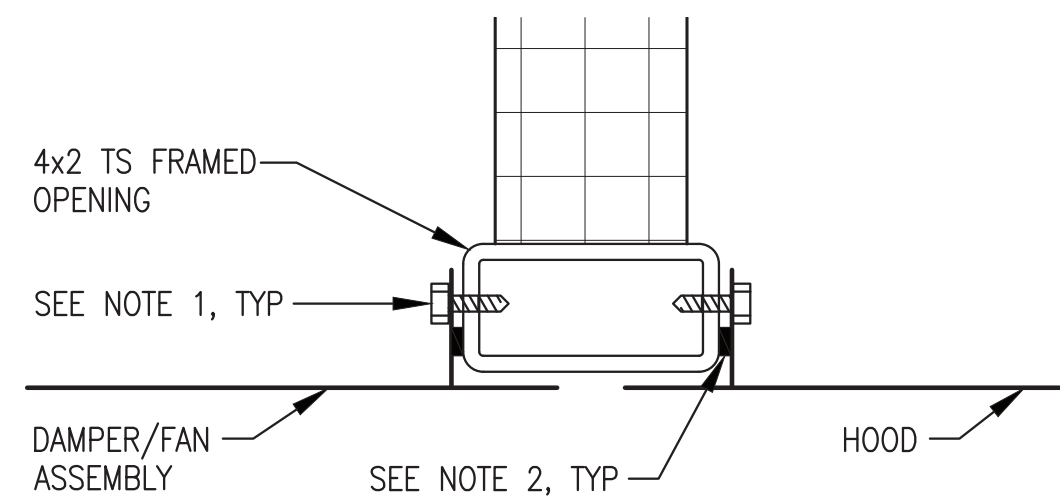

**4** TYPICAL WALL PENETRATION  
M7.1 4"=1'-0"


**VENTILATION SYSTEM SHOP/ON-SITE NOTES:**

- 1) FURNISH ENTIRE VENTILATION SYSTEM AS PART OF MODULE SHOP FABRICATION.
- 2) DURING SHOP FABRICATION INSTALL EXHAUST FAN ASSEMBLIES. TEST FIT EXTERIOR HOODS AND INTAKE DUCTS BUT DO NOT INSTALL.
- 3) DURING SHOP FABRICATION TEMPORARILY CONNECT INTAKE DAMPERS TO ELECTRICAL ROUGH IN AND TEST TO VERIFY FUNCTION. SEE SHEET E4.2.
- 4) AS PART OF ON-SITE WORK INSTALL EXHAUST HOODS AND INTAKE DUCTING AS INDICATED.

- NOTES:**
- 1) FASTEN MOUNTING FLANGE TO TS WITH #12 STAINLESS STEEL SELF TAPPING SCREWS. ON HOODS FASTEN ON TOP AND SIDES ONLY. ON EXHAUST FANS FASTEN ON SIDES ONLY.
  - 2) SEAL MOUNTING FLANGE TO TS WITH CONTINUOUS BEAD OF POLYURETHANE CAULKING ALL AROUND.


ALL WORK ON THIS SHEET WAS PERFORMED AS PART OF THE PRIOR MODULE ASSEMBLY CONTRACT EXCEPT AS SPECIFICALLY INDICATED IN THE SHOP/ON SITE NOTES.

ISSUED FOR CONSTRUCTION  
MAY 2023

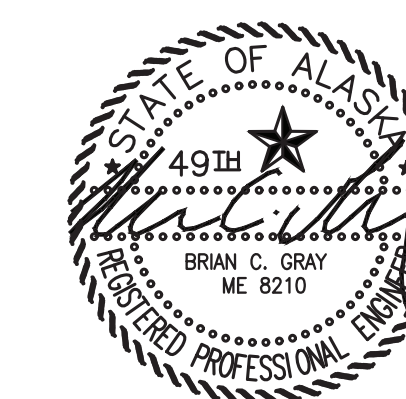


PROJECT: NELSON LAGOON POWER SYSTEM UPGRADE		
TITLE: VENTILATION PLAN & DETAILS		
DRAWN BY: JTD	SCALE: AS NOTED	DESIGNED BY: BCG
FILE NAME: NELS PP M2-M7	PROJECT NUMBER:	DATE: 5/30/23
SHEET: M7.1		

**Gray Stassel Engineering, Inc.**  
P.O. 111405, Anchorage, AK 99511 (907)349-0100

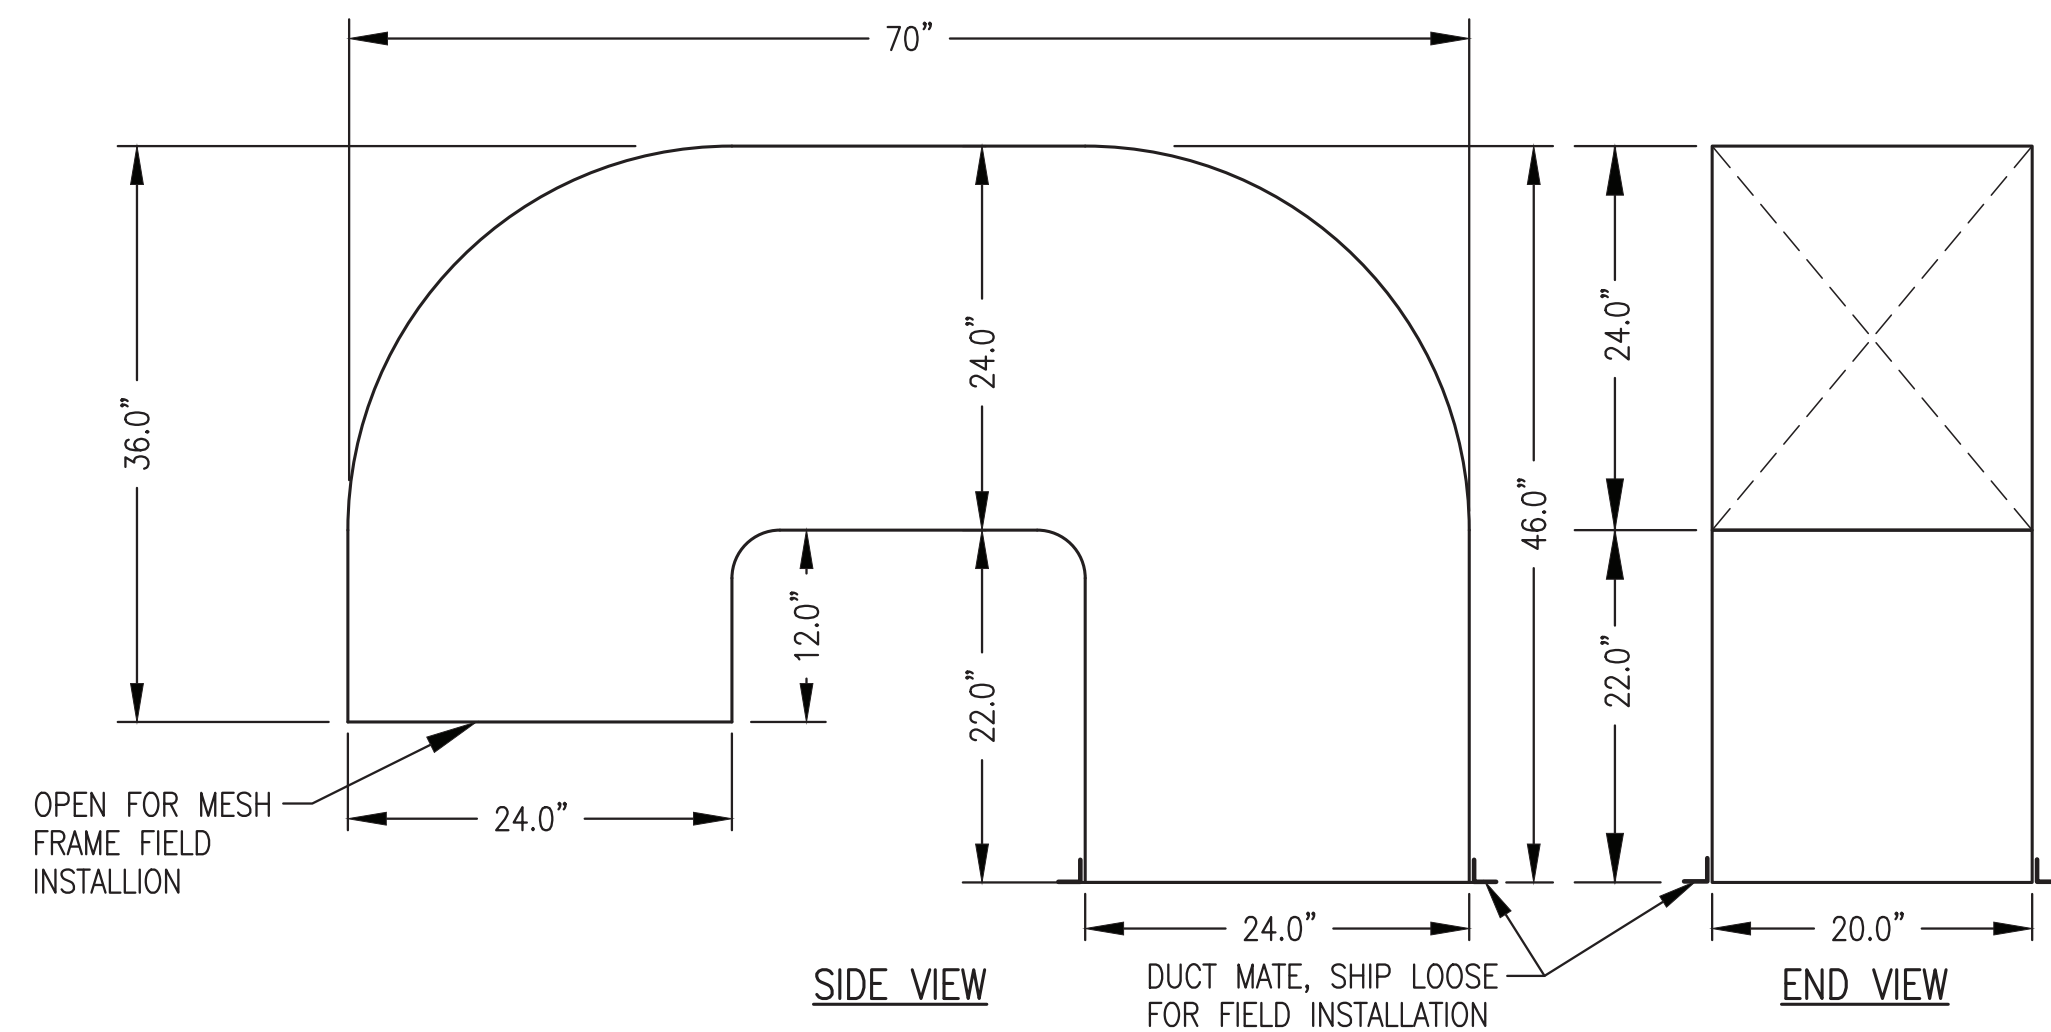


- NOTES:
- 1) FABRICATE 3 IDENTICAL DUCTS FROM MIN 18 GAUGE GALV SHEET METAL WITH SEALED MECHANICAL JOINTS OR AT CONTRACTORS OPTION 0.090" THICK TYPE 5052 ALUMINUM WITH ALL WELDED SEAMS.
  - 2) DUCTS ARE DESIGNED TO FIELD INSTALL BETWEEN TRUSSES. DO NOT ADD JOINTS.

**1** INTAKE DUCT FABRICATION  
M7.2 1"=1'-0"

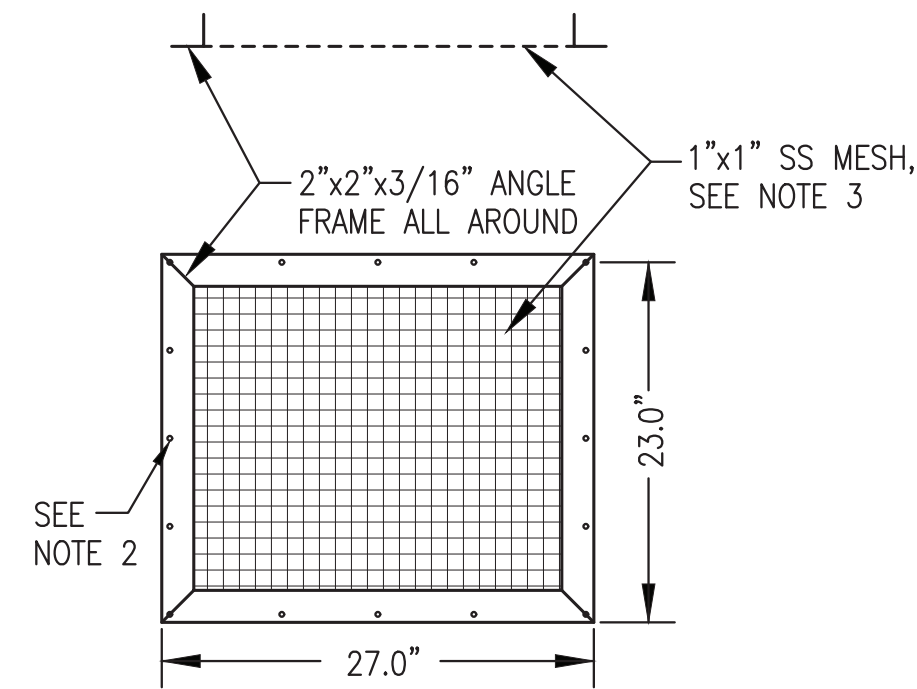


- NOTES:
- 1) FABRICATE 3 IDENTICAL AIR INTAKE MESH FRAMES.
  - 2) FABRICATE FRAME FROM 2"x2"x3/16" ALUMINUM ANGLE WITH MITERED AND WELDED CORNERS AND 1/4" HOLES AT 6" O.C. ALL AROUND, 1/2" FROM OUTSIDE EDGE OF FRAME.
  - 3) INSTALL 1"x1" STAINLESS STEEL WIRE MESH IN HEMMED STAINLESS STEEL FRAME AND FASTEN TO ANGLE FRAME WITH STAINLESS STEEL SCREWS ALL AROUND.

**2** INTAKE MESH FRAME  
M7.2 1"=1'-0"

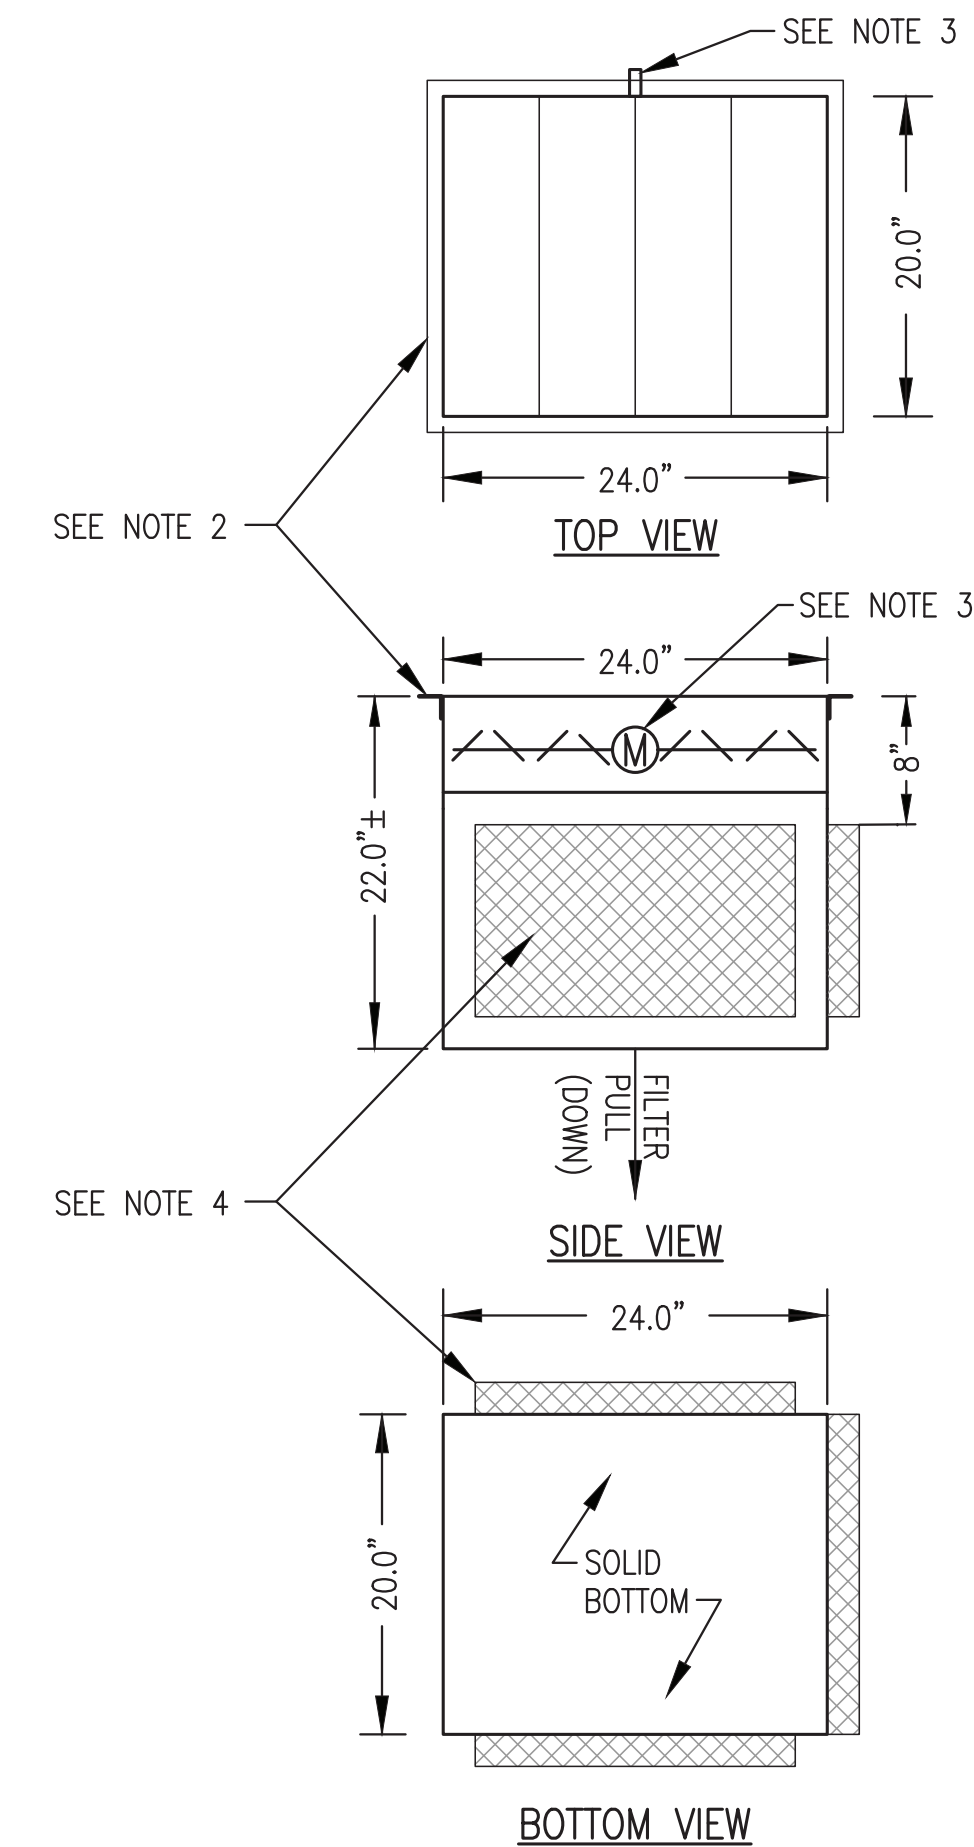


- NOTES:
- 1) FABRICATE 4 IDENTICAL VENTILATION INTAKE ASSEMBLIES.
  - 2) SHOP MOUNT DUCTMATE FLANGE.
  - 3) PROVIDE MIN 3" DAMPER ROD EXTENSION ON SIDE INDICATED AND FABRICATE SHEET METAL STAND-OFF BRACKET TO FULLY SUPPORT THE ACTUATOR FROM THE DAMPER FRAME. SEE PLAN VIEW FOR DAMPER ACTUATOR ORIENTATION.
  - 4) INSTALL FRAME FOR REMOVABLE 20"x12"x2" MERV 8 FILTERS. FABRICATE FROM "C" CHANNEL THREE SIDES WITH LATCHING HINGED COVER ON BOTTOM TO ALLOW FILTERS TO SLIDE DOWN FOR REMOVAL. ON 20" SIDE EXTEND FILTER FRAME BEYOND DUCT EACH WAY AS REQUIRED.

**3** INTAKE AIR DAMPER FABRICATION  
M7.2 1"=1'-0"

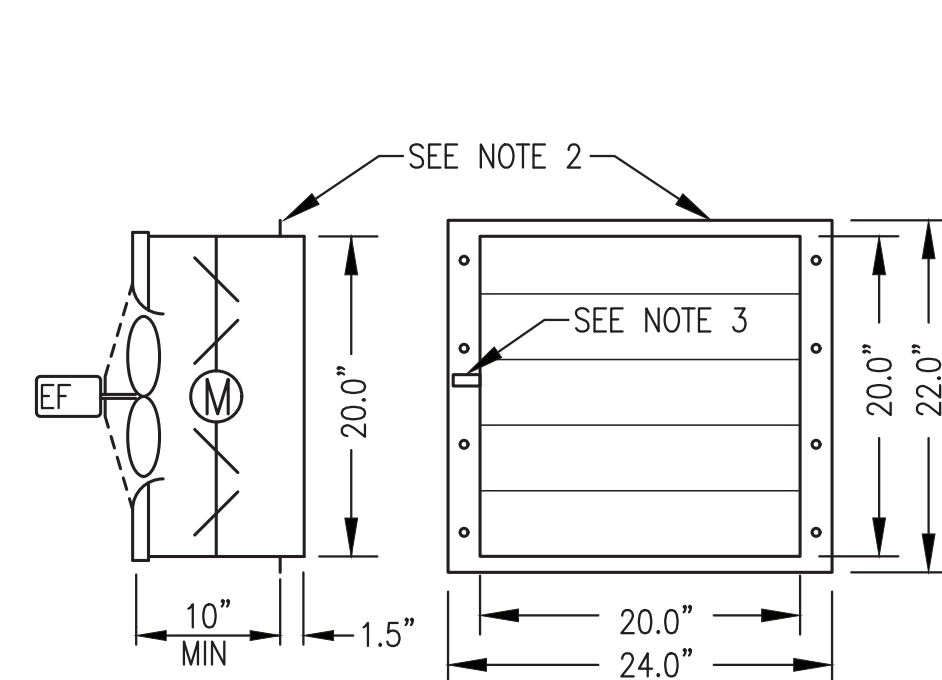

- NOTES:
- 1) FABRICATE 2 IDENTICAL ASSEMBLIES COMPLETE WITH FAN AND DAMPER MOUNTED AND SEALED TO DUCT.
  - 2) PROVIDE 2" WIDE MOUNTING FLANGE ON SIDES WITH 1/4" HOLES AT 5" O.C. PROVIDE 1" MOUNTING FLANGE ON TOP AND BOTTOM WITHOUT HOLES.
  - 3) PROVIDE MIN 3" DAMPER ROD EXTENSION ON THE LEFT SIDE AND FABRICATE SHEET METAL STAND-OFF BRACKET TO FULLY SUPPORT THE ACTUATOR FROM THE DAMPER FRAME.

**4** EXHAUST FAN ASSEMBLY FABRICATION  
M7.2 1"=1'-0"

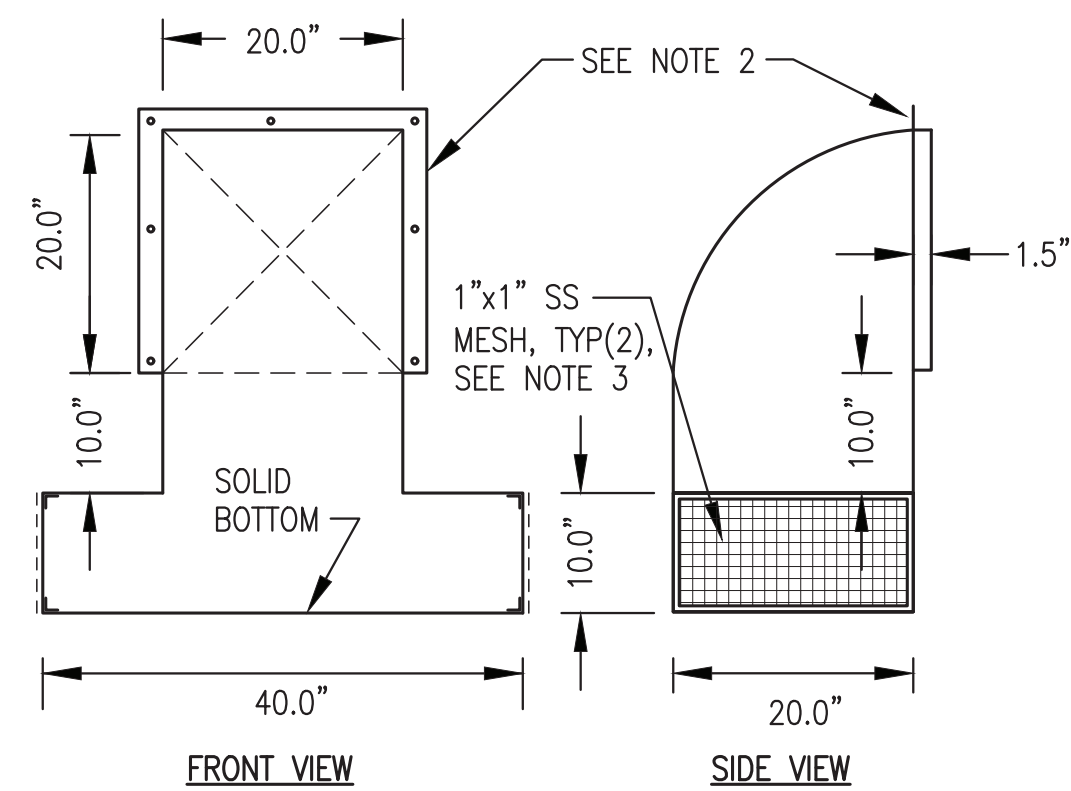

- NOTES:
- 1) FABRICATE HOODS FROM 0.090" THICK TYPE 5052 ALUMINUM WITH ALL WELDED SEAMS.
  - 2) PROVIDE 2" WIDE MOUNTING FLANGE ON TOP & SIDES WITH 1/4" HOLES AT 9" O.C.
  - 3) INSTALL 1"x1" STAINLESS STEEL WIRE MESH IN HEMMED STAINLESS STEEL FRAME AND FASTEN TO ANGLE FRAME WITH STAINLESS STEEL SCREWS ALL AROUND, TYP(2).


**5** EXHAUST HOOD FABRICATION  
M7.2 3/4"=1'-0"

ALL WORK ON THIS SHEET WAS PERFORMED AS PART OF THE PRIOR MODULE ASSEMBLY CONTRACT AND IS SHOWN HERE FOR REFERENCE ONLY.

ISSUED FOR CONSTRUCTION  
MAY 2023




PROJECT: NELSON LAGOON POWER SYSTEM UPGRADE		
TITLE: SHEET METAL FABRICATION DETAILS		
DESIGNED BY: BCG	DRAWN BY: JTD	SCALE: AS NOTED
FILE NAME: NELS_PP_M2-M7	PROJECT NUMBER:	SHEET: M7.2
P.O. 111405, Anchorage, AK 99511 (907)349-0100		

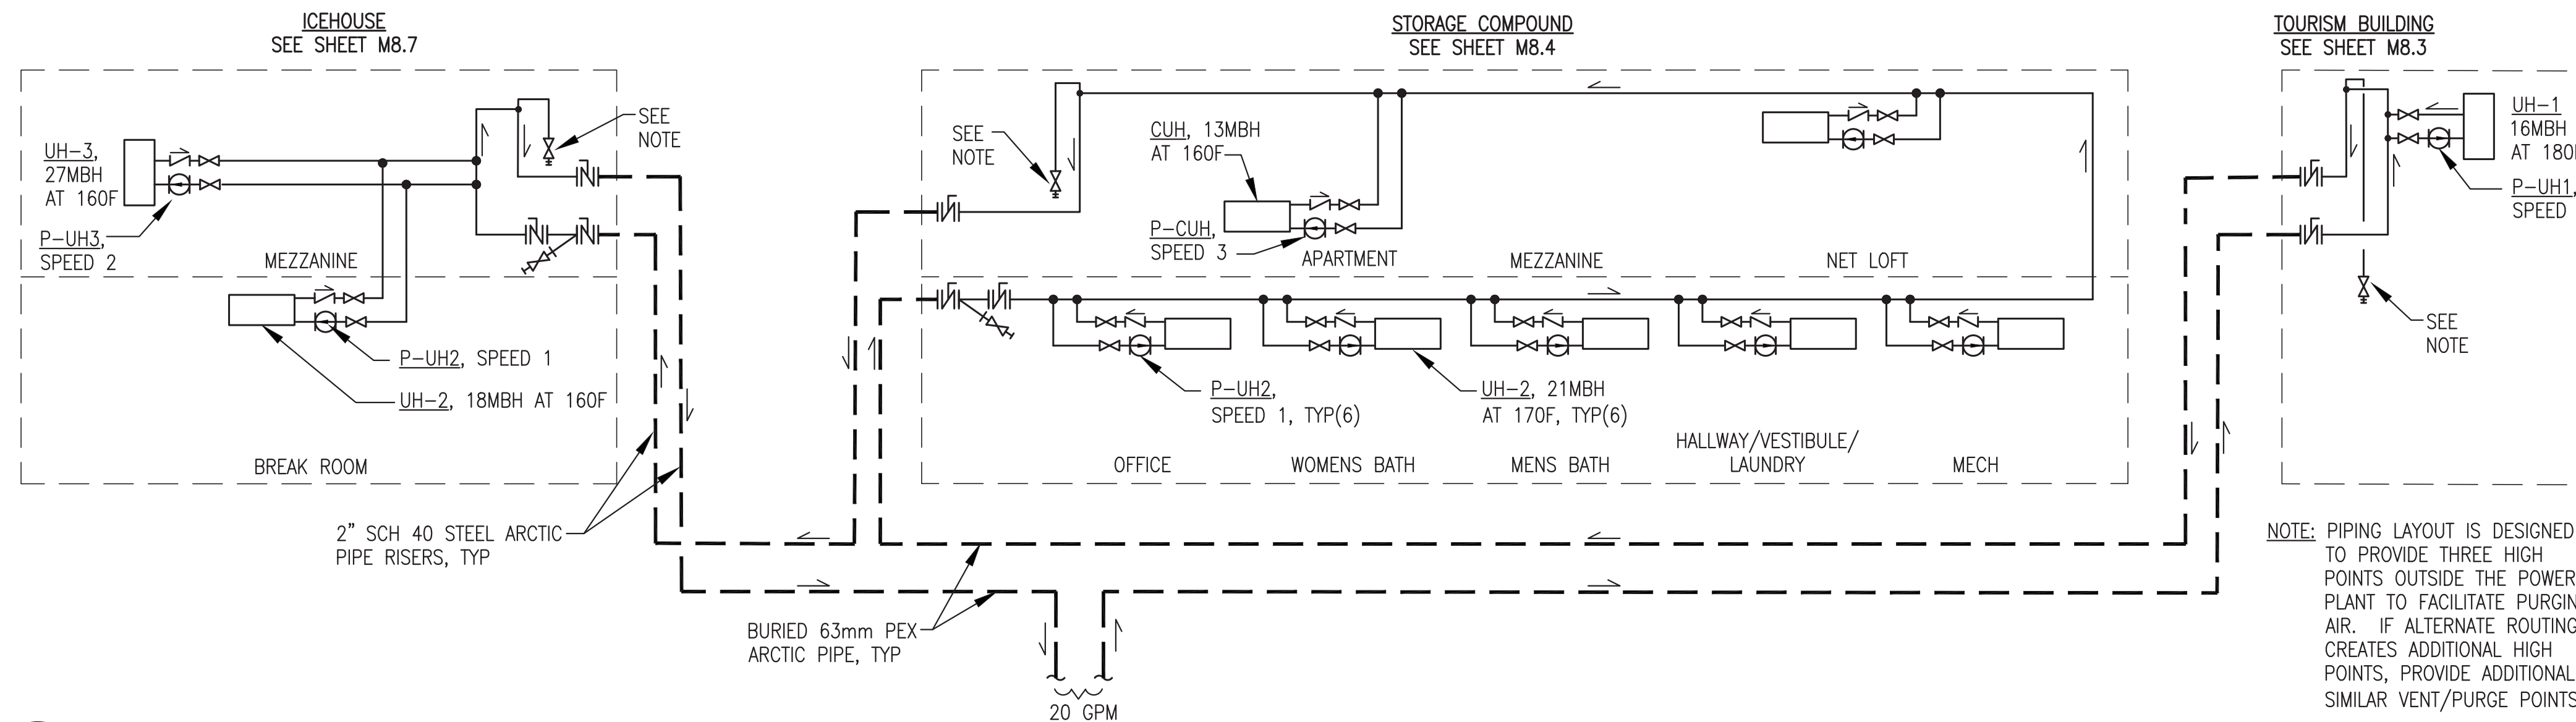

- ARCTIC PIPE GENERAL NOTES:**
- 1) THE DRAWINGS SHOW APPROXIMATE LOCATION OF SOME EXISTING UNDERGROUND ELECTRIC POWER. PRIOR TO BEGINNING EXCAVATION, LOCATE ALL UNDERGROUND UTILITIES INCLUDING BUT NOT LIMITED TO ELECTRIC POWER, TELECOMMUNICATIONS, WATER, SEWER, AND FUEL.
  - 2) TAKE CARE TO PROTECT EXISTING BUILDING FOUNDATIONS, SLABS, SIDEWALKS, AND OTHER EXISTING FEATURES WHEN EXCAVATING FOR ARCTIC PIPE. BACKFILL WITH EXCAVATION SPOILS OR SANDY GRAVEL, COMPACT, AND BLEND INTO EXISTING GRADE. RESTORE ALL EXCAVATION AREAS TO ORIGINAL CONDITION UPON COMPLETION.
  - 3) ANY UTILITIES DAMAGED DURING EXCAVATION SHALL BE REPAIRED PROMPTLY TO THE SATISFACTION OF THE AUTHORITY AND THE UTILITY AT NO COST TO THE AUTHORITY.
  - 4) WHERE MULTIPLE UTILITIES ARE BURIED IN A COMMON TRENCH, PLAN OUT WORK AND COORDINATE TRADES TO INSTALL ALL BURIED UTILITIES TOGETHER.
  - 5) ALL BURIED ARCTIC PIPE IS 63mm PEX. ALL ARCTIC PIPE RISERS AT BELOW TO ABOVE GRADE TRANSITIONS ARE WELDED 2" SCH 40 STEEL WITH POLYURETHANE INSULATION AND WATERPROOF HDPE CASING. ALL END USER BUILDING INTERIOR PIPING IS COPPER TUBING.
  - 6) LENGTHS OF BURIED RUNS INDICATED THIS PLAN ARE APPROXIMATE, FIELD VERIFY. FURNISH 63mm PEX ARCTIC PIPE IN ADEQUATE LENGTHS TO ALLOW CONTINUOUS RUNS BETWEEN BUILDING RISERS. DO NOT INSTALL SPLICE JOINTS BETWEEN RISERS.

- HEAT RECOVERY SYSTEM FILLING, FLUSHING, AND PURGING PROCEDURES:**
- A. AFTER PRESSURE TESTING ALL PIPING, BLEED AIR RESERVOIR ON THE EXPANSION TANK IN THE MODULE AS REQUIRED TO MAINTAIN 10 PSIG RESIDUAL WITH THE SYSTEM EMPTY.
  - B. AT END USER BUILDINGS, CLOSE ISOLATION VALVES AT EACH UNIT HEATER AND CABINET UNIT HEATER TO ENSURE NO FLOW THROUGH THE HEATER COILS PRIOR TO FILLING SYSTEM.
  - C. FILL THE ENTIRE HEAT RECOVERY PIPING SYSTEM WITH PROPYLENE GLYCOL SOLUTION TO 20 PSIG MINIMUM WITH SYSTEM COLD. VENT AIR FROM HIGH POINT VENT IN POWER PLANT AND FROM MANUAL VENT/PURGE VALVES IN EACH END USER BUILDING.
  - D. CYCLE MAIN HEAT RECOVERY LOOP CIRC PUMP P-HR1B ON AND OFF AND VENT HIGH POINTS UNTIL ALL AIR HAS BEEN PURGED FROM THE MAIN PIPING LOOP. USE HOSES AND BUCKETS TO PURGE AND CAPTURE SALVAGED GLYCOL.
  - E. ADD PROPYLENE GLYCOL SOLUTION AS REQUIRED TO MAINTAIN 20 PSIG MINIMUM WITH SYSTEM COLD. WITH DIESEL GENERATOR(S) RUNNING, START THE HEAT RECOVERY SYSTEM PRIMARY AND SECONDARY CIRCULATION PUMPS P-HR1A AND P-HR1B. BRING THE ENTIRE HEAT RECOVERY SYSTEM UP TO NORMAL TEMPERATURE (170°F MINIMUM) AND ADD PROPYLENE GLYCOL SOLUTION AS REQUIRED TO BRING SYSTEM PRESSURE TO 30 PSIG MINIMUM AT EXPANSION TANK.
  - F. CIRCULATE HOT GLYCOL IN MAIN LOOP FOR 24 HOURS MINIMUM THEN SHUT MAIN CIRCULATION LOOP PUMP P-HR1B OFF. ISOLATE AND CLEAN PIPING STRAINERS WHICH ARE LOCATED IN THE POWER PLANT, STORAGE COMPOUND, AND ICEHOUSE. AFTER CLEANING STRAINERS OPEN STRAINER ISOLATION VALVES.
  - G. USE HOSE AND BUCKET TO PURGE AIR AND DEBRIS FROM HIGH POINT BLEEDS IN END USER BUILDINGS THEN GO TO THE MODULE AND ADD PROPYLENE GLYCOL SOLUTION AS REQUIRED TO BRING SYSTEM PRESSURE TO 30 PSIG MINIMUM AT EXPANSION TANK. START THE MAIN PUMPS P-HR1A AND P-HR1B.
  - H. GO TO EACH UNIT HEATER (UH-1, UH-2, UH-3) IN THE SYSTEM, SET TO THE PUMP TO THE SPECIFIED SPEED, OPEN THE ISOLATION VALVES, AND TURN UP THE THERMOSTAT TO START THE ASSOCIATED CIRC PUMP.
  - I. AT THE MEZZANINE APARTMENT CABINET UNIT HEATER (CUH), OPEN THE ISOLATION VALVES AND USING THERMOSTAT CONTROL, CYCLE CABINET UNIT HEATER PUMP ON AND OFF AND VENT BLEED FITTING ON TOP OF CABINET UNIT HEATER.
  - J. PURGE ANY REMAINING AIR FROM HIGH POINT BLEEDS IN END USER BUILDINGS.
  - K. WHEN THE ENTIRE SYSTEM COMES UP TO NORMAL TEMPERATURE (170°F MINIMUM) ADD PROPYLENE GLYCOL SOLUTION AS REQUIRED TO BRING SYSTEM PRESSURE TO 30 PSIG MINIMUM AT EXPANSION TANK.
  - L. VERIFY PROPER FUNCTION OF ALL INSTRUMENTATION AND CALIBRATE ALL DEVICES. VERIFY POWER PLANT HEAT RECOVERY READINGS ON SWITCHGEAR SCADA SYSTEM.
  - M. GO THROUGH THE ENTIRE SYSTEM INCLUDING ALL END USER BUILDINGS AND CHECK FOR LEAKS. PERFORM FUNCTIONAL TEST OF EACH UNIT HEATER AND CABINET UNIT HEATER THERMOSTATIC CONTROLS VERIFYING THAT FAN AND PUMP CYCLE ON AND OFF TOGETHER.
  - N. ADD PROPYLENE GLYCOL SOLUTION AS REQUIRED TO BRING SYSTEM PRESSURE TO 30 PSIG MINIMUM AT EXPANSION TANK. FILTER SALVAGED GLYCOL WITH 30 MICRON FILTER AND PLACE BACK IN DRUMS. STORE ALL EXCESS PROPYLENE GLYCOL SOLUTION IN THE ORIGINAL DRUMS SEALED FOR LONG-TERM STORAGE. VERIFY THAT DRUMS ARE CLEARLY LABELED "PROPYLENE GLYCOL" WITH YELLOW LETTERING.

**1** HEAT RECOVERY SYSTEM OVERALL PIPING SCHEMATIC  
M8.1 NO SCALE

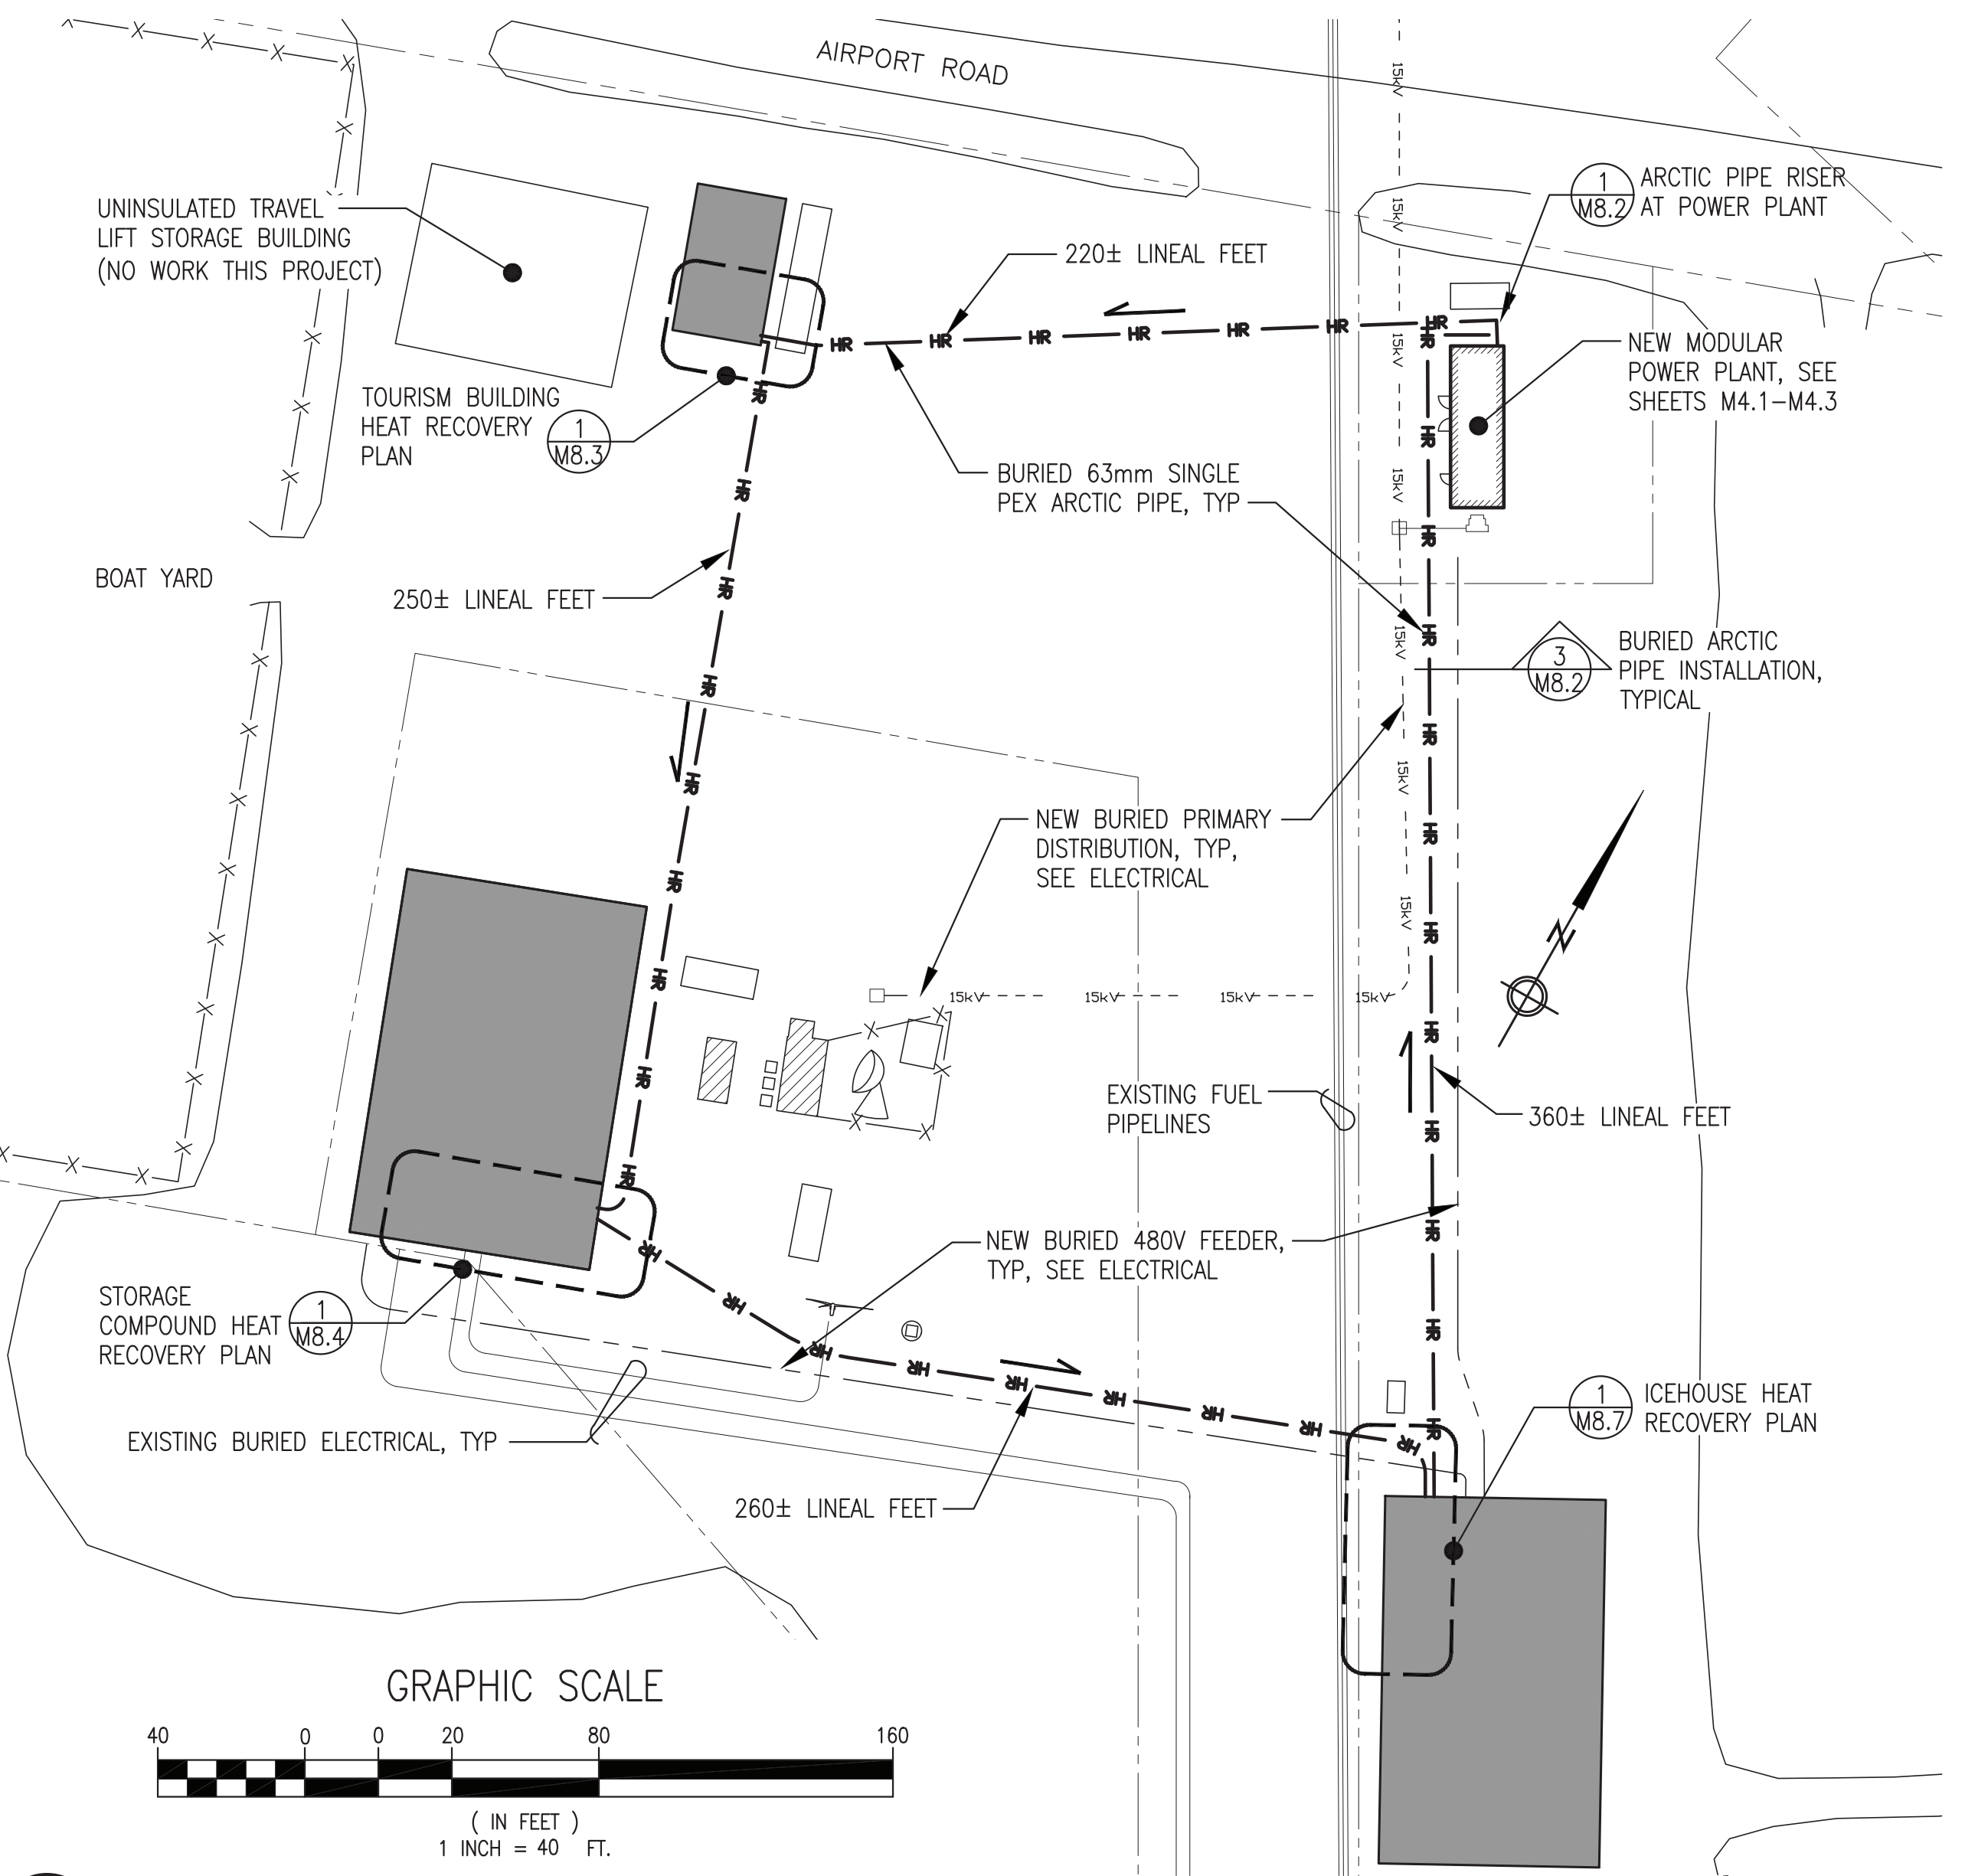

**END USER BUILDING HEAT RECOVERY EQUIPMENT SCHEDULE:**

SYMBOL	SERVICE/FUNCTION	DESCRIPTION	MANUFACTURER/MODEL
CUH	STORAGE COMPOUND APARTMENT SPACE HEAT	HOT WATER CABINET UNIT HEATER, 17 MBH AT 1 GPM 180F EWT & 60F EAT	TOYOTOMI HC-190
UH-1	TOURISM BUILDING SPACE HEAT	HORIZONTAL DISCHARGE HOT WATER UNIT HEATER, 21.7 MBH AT 2.3 GPM, 200F EWT AND 60F EAT, 1/25HP, 120V, 1Ø	MODINE HC-33
UH-2	STORAGE COMPOUND & ICEHOUSE OCCUPIED AREAS SPACE HEAT	LOW PROFILE HOT WATER UNIT HEATER, 30.9 MBH AT 2 GPM, 180F EWT AND 60F EAT, 405 CFM, 1/20HP, 120V, 1Ø	MODINE "HOT DAWG" HHD30
UH-3	ICEHOUSE MAIN FLOOR AREA HEAT	HORIZONTAL DISCHARGE HOT WATER UNIT HEATER, 45.6 MBH AT 4.7 GPM, 200F EWT AND 60F EAT, 1/12HP, 120V, 1Ø	MODINE HC-63
P-CUH	CABINET UNIT HEATER CIRC PUMP	1 GPM AT 18' TDH, 1/25HP, 115V, 1Ø WITH 1/2" SOLDER SHUT-OFF FLANGES	GRUNDFOS UPS 15-58FC SPEED 3
P-UH1	TOURISM BUILDING UNIT HEATER CIRC PUMP	4 GPM AT 6' TDH, 1/25HP, 115V, 1Ø WITH 1/2" SOLDER SHUT-OFF FLANGES	GRUNDFOS UPS 15-58FC SPEED 1
P-UH2	STORAGE COMPOUND & ICEHOUSE OCCUPIED AREAS HEATER CIRC PUMP	2 GPM AT 9' TDH, 1/25HP, 115V, 1Ø WITH 1/2" SOLDER SHUT-OFF FLANGES	GRUNDFOS UPS 15-58FC SPEED 1
P-UH3	ICEHOUSE PROCESSING AREA UNIT HEATER CIRC PUMP	5 GPM AT 10' TDH, 1/25HP, 115V, 1Ø WITH 3/4" SOLDER SHUT-OFF FLANGES	GRUNDFOS UPS 15-58FC SPEED 2

NOTE: UNIT HEATER AND CABINET UNIT HEATER RATINGS ON SCHEDULE ARE BASED ON WATER AT STANDARD TEMPERATURE. RATINGS SHOWN ON SCHEMATIC ARE REDUCED FOR 50% GLYCOL AT REDUCED TEMPERATURE.

**2** HEAT RECOVERY SYSTEM OVERALL PLAN  
M8.1 1"=40'

ALL WORK THIS SHEET IS INCLUDED IN THE ON SITE CONTRACT UNDER ADDITIVE ALTERNATE #1.

ISSUED FOR CONSTRUCTION  
MAY 2023




**ALASKA ENERGY AUTHORITY**

PROJECT: **NELSON LAGOON POWER SYSTEM UPGRADE**


TITLE: **HEAT RECOVERY SYSTEM OVERALL PLAN, SCHEMATIC, & EQUIPMENT SCHEDULE**

DRAWN BY: JTD	SCALE: AS NOTED
DESIGNED BY: BCG	DATE: 5/30/23
FILE NAME: NELS_PP_M8	SHEET: <b>M8.1</b>
PROJECT NUMBER:	


P.O. 111405, Anchorage, AK 99511 (907)349-0100

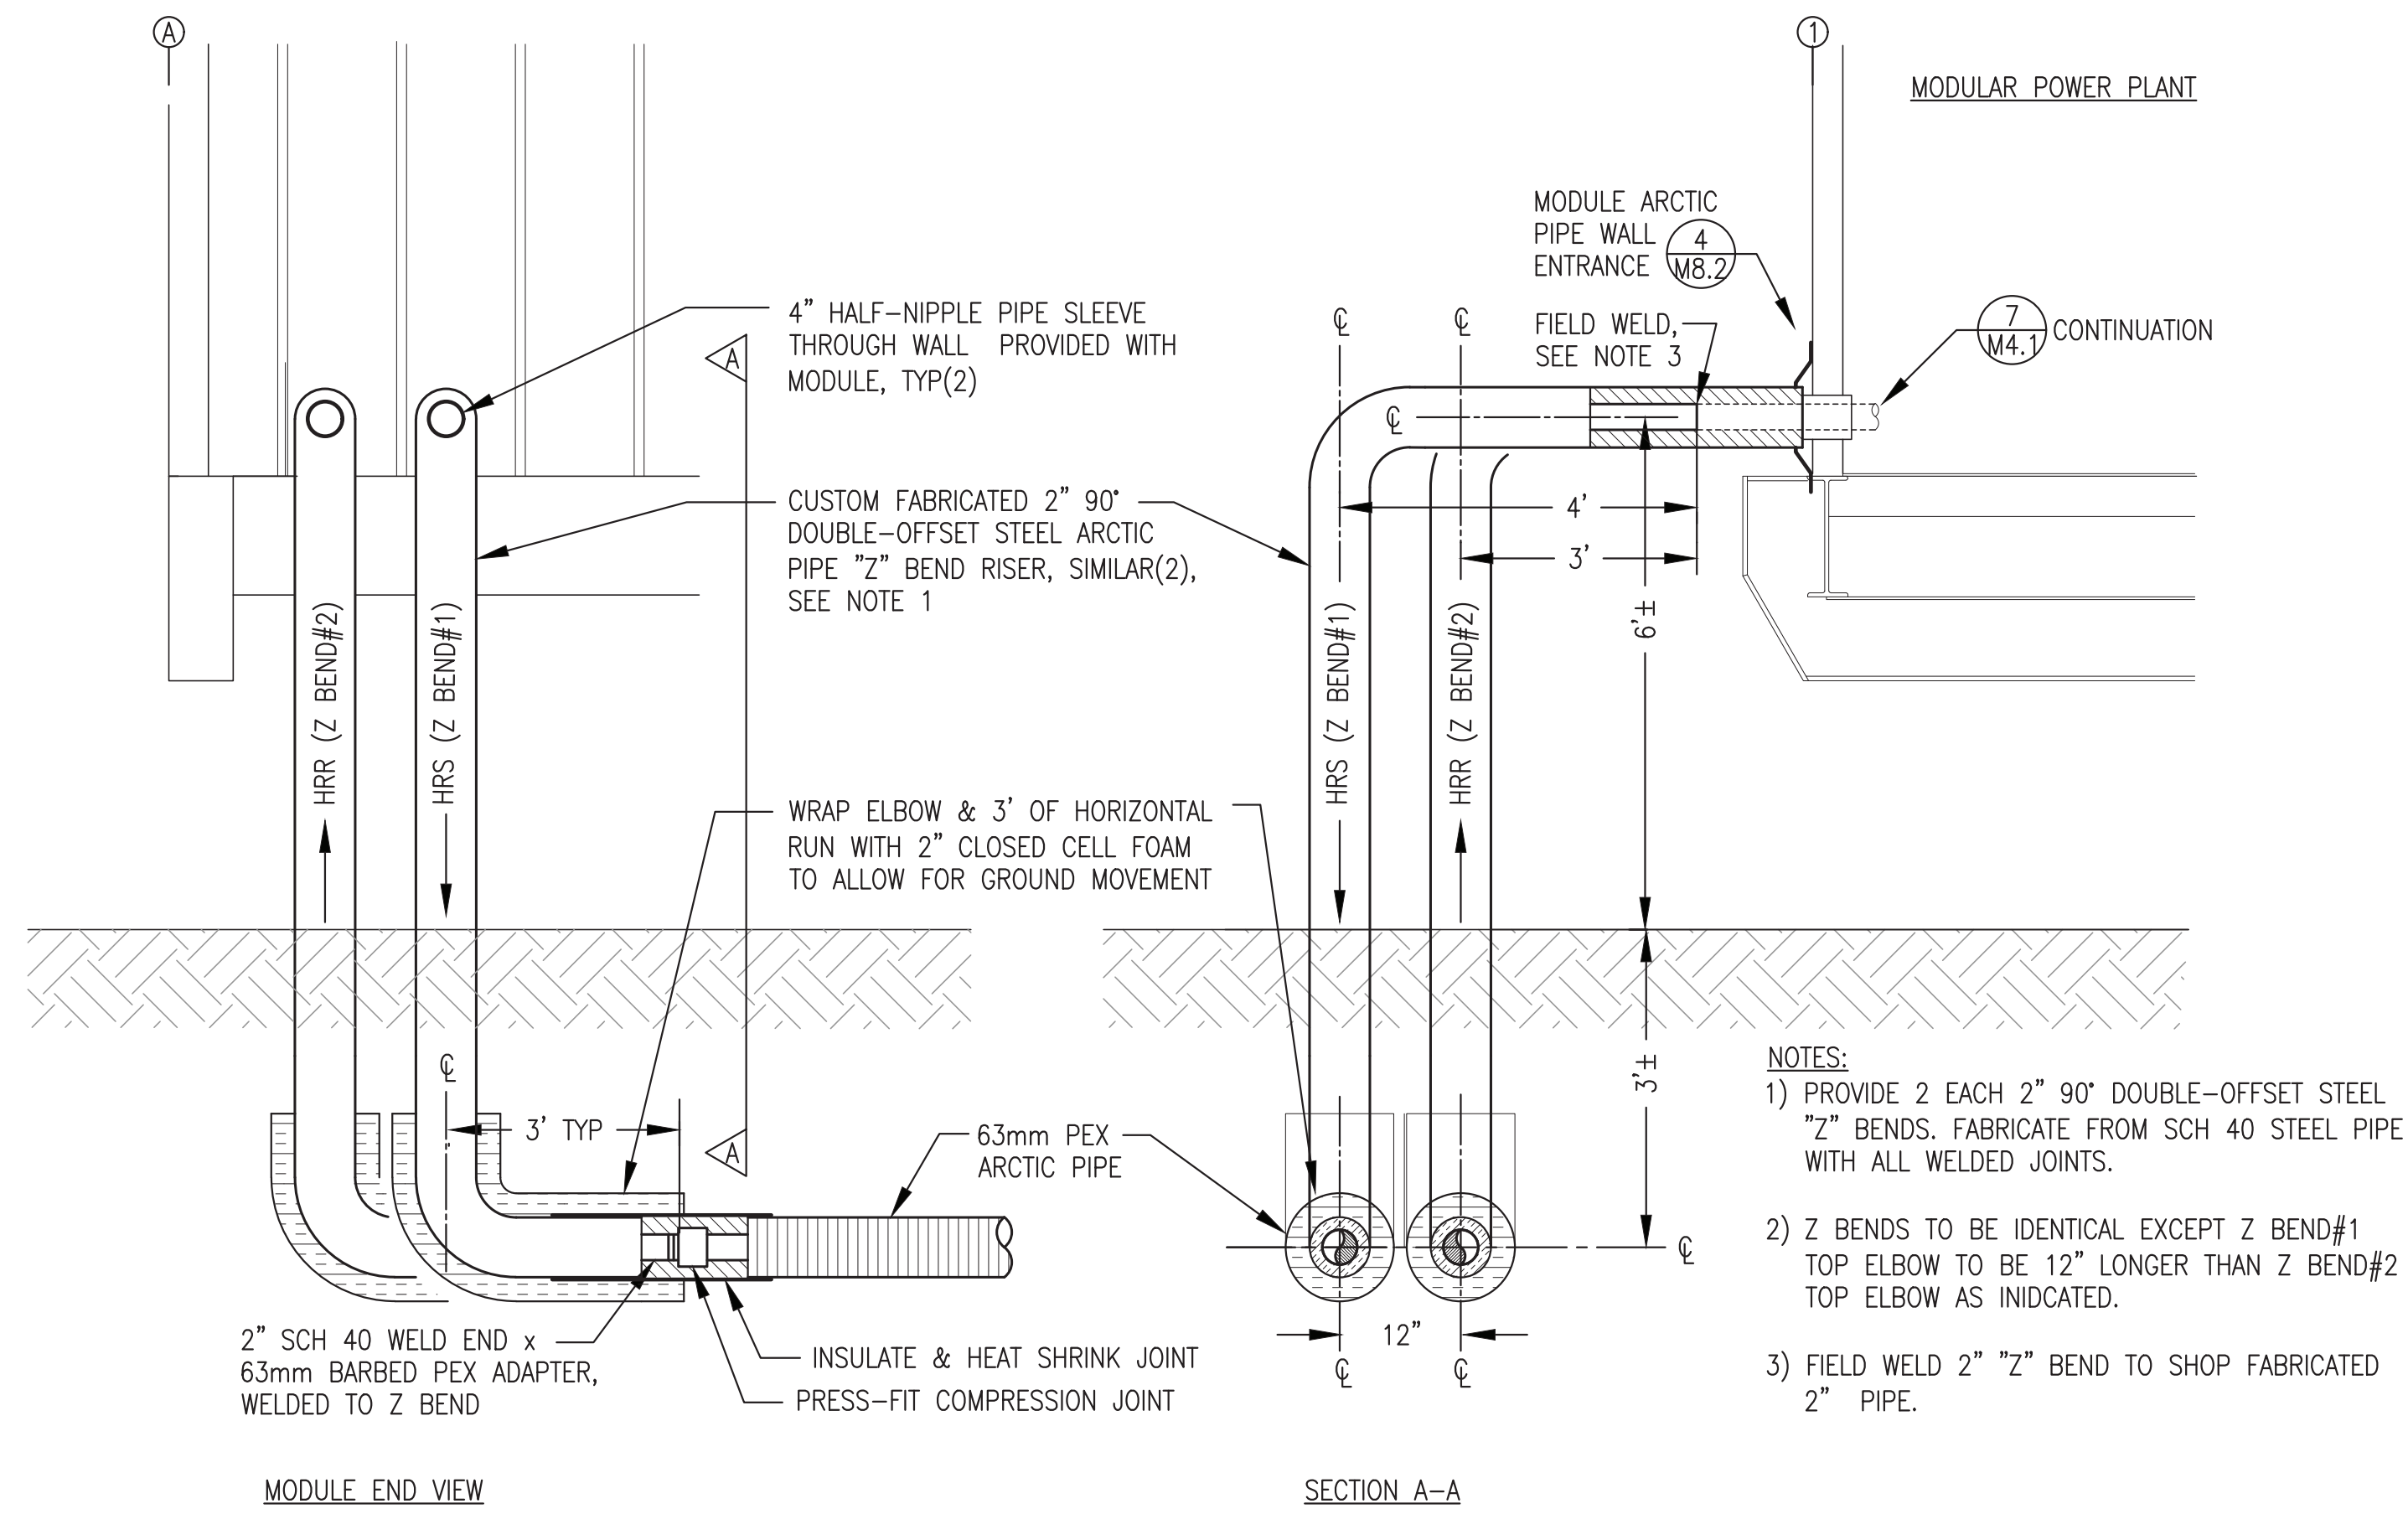

**1** ARCTIC PIPE RISER AT NEW MODULAR POWER PLANT  
**M8.2** 3/4"=1'-0"

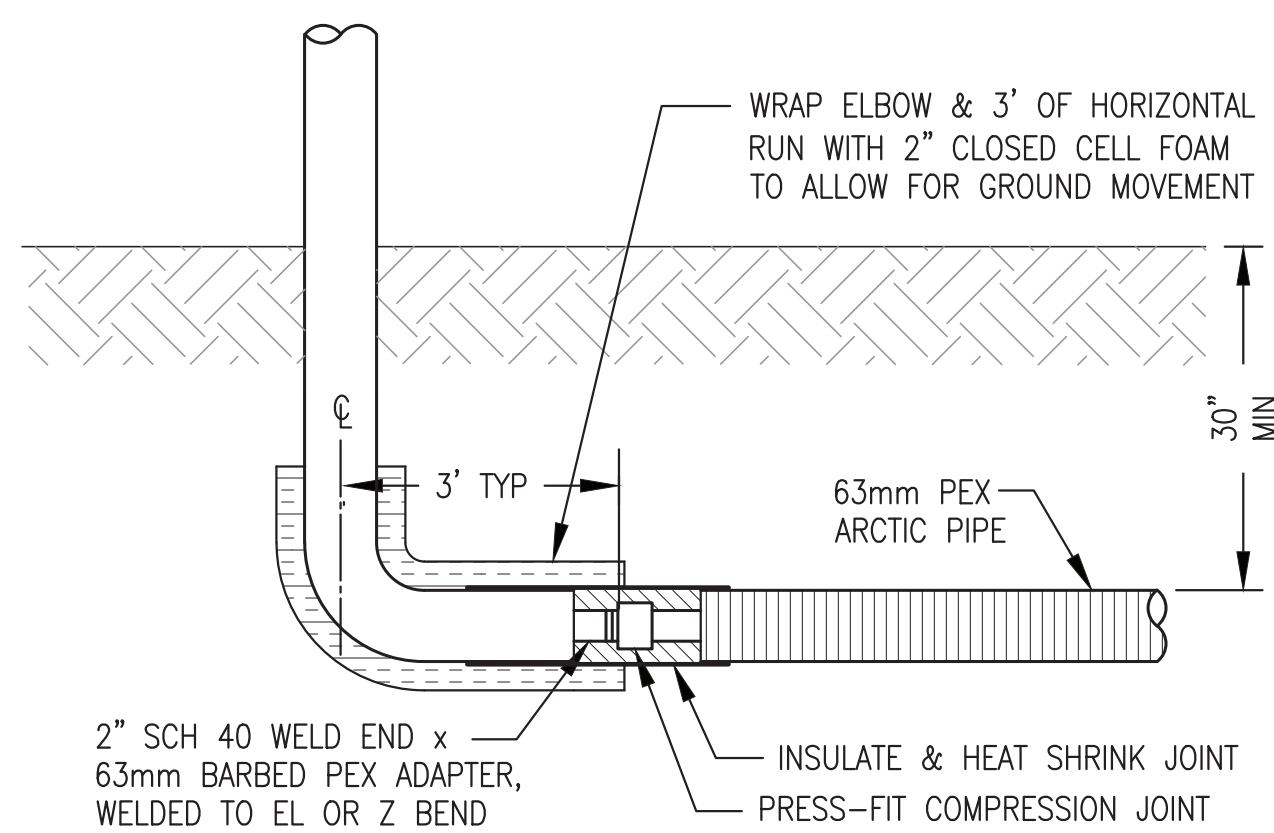


**4** TYPICAL ARCTIC PIPE RISER AT END USER BUILDING  
**M8.2** 3/4"=1'-0"

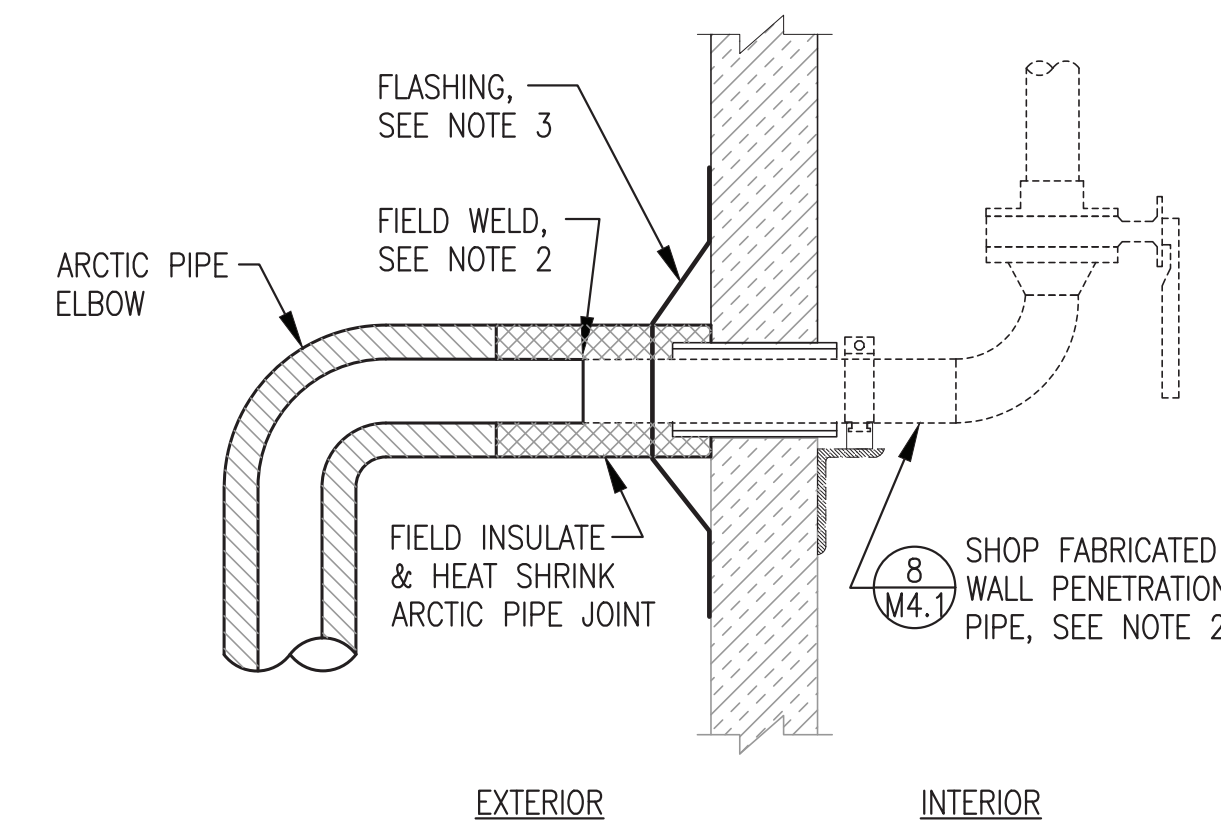

- NOTES:**
- 1) ONE ARCTIC PIPE SHOWN. PROVIDE TWO IDENTICAL.
  - 2) FIELD REINSTALL SHOP FABRICATED PIPE SECTION THROUGH WALL AND WELD TO ARCTIC PIPE.
  - 3) INSTALL MULTI-FLASH #5 RETROFIT MF501BA WALL FLASHING OVER ARCTIC PIPE. SEAL TO WALL SURFACE WITH POLYURETHANE CAULKING & FASTEN TO WALL WITH STAINLESS STEEL SHEET METAL SCREWS ALL AROUND.

**2** ARCTIC PIPE WALL ENTRANCE AT MODULE  
**M8.2** NO SCALE

- NOTES:**
- 1) SEE ELECTRICAL FOR LOCATIONS WHERE POWER CABLES ARE BURIED WITH ARCTIC PIPE.
  - 2) COORDINATE TRADES TO INSTALL ALL BURIED UTILITIES TOGETHER.
  - 3) ARCTIC PIPE INSTALLATION WITHOUT POWER SIMILAR.

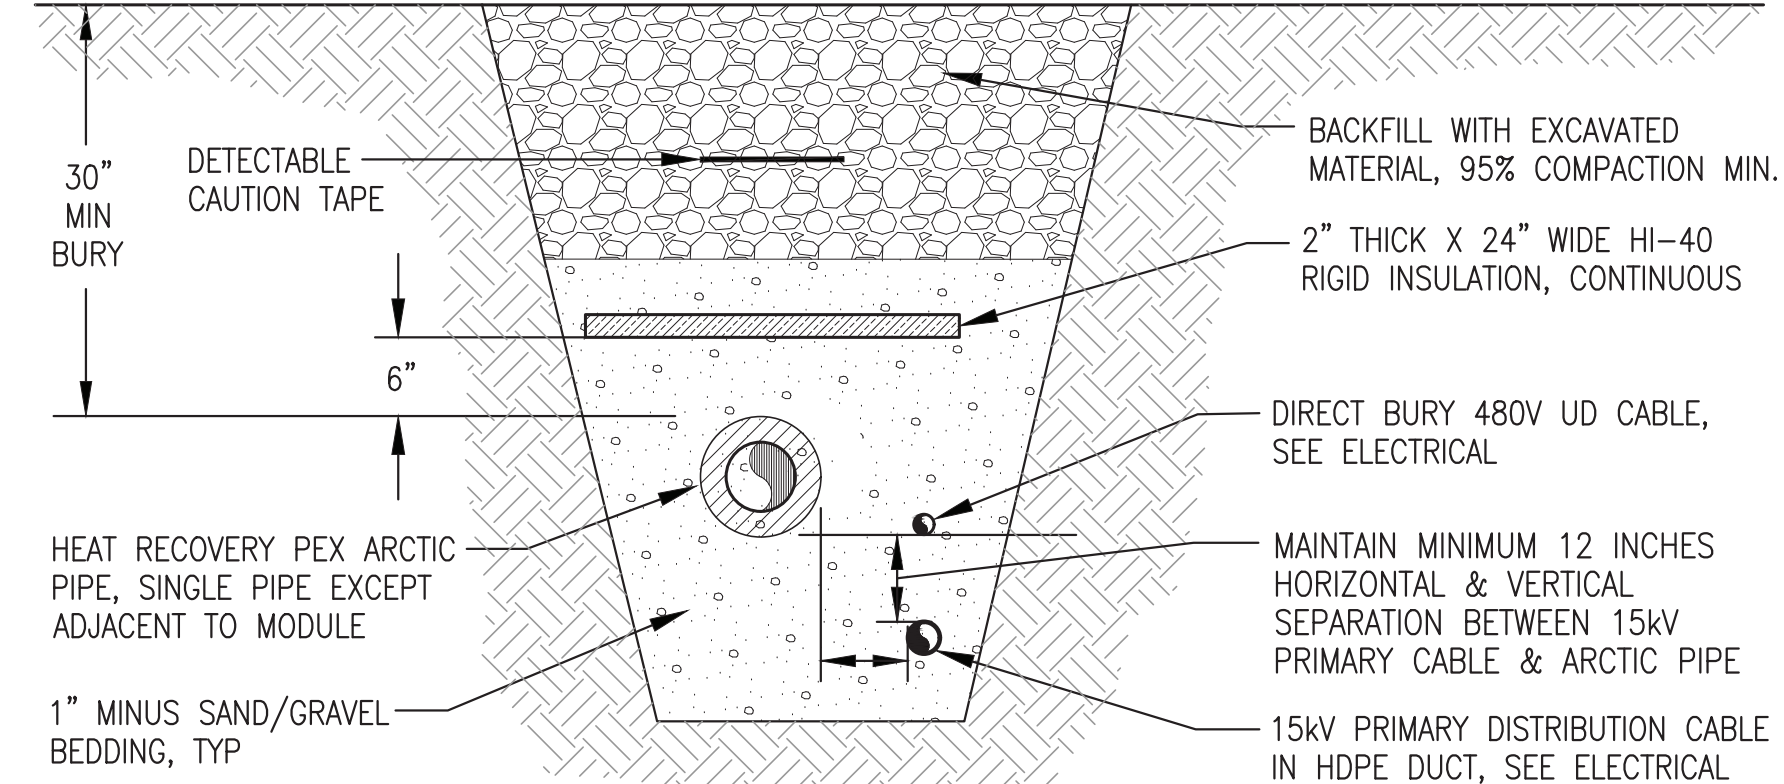

**3** TYPICAL BURIED ARCTIC PIPE INSTALLATION WITH ELECTRICAL POWER  
**M8.2** NO SCALE

ALL WORK THIS SHEET IS INCLUDED IN THE ON SITE CONTRACT UNDER ADDITIVE ALTERNATE #1.



ISSUED FOR  
 CONSTRUCTION  
 MAY 2023



PROJECT: NELSON LAGOON POWER SYSTEM UPGRADE		
TITLE: HEAT RECOVERY SYSTEM ARCTIC PIPE DETAILS		
DRAWN BY: JTD	SCALE: AS NOTED	
DESIGNED BY: BCG	DATE: 5/30/23	
FILE NAME: NELS PP M8	SHEET:	<b>M8.2</b>
PROJECT NUMBER:		





P.O. 111405, Anchorage, AK 99511 (907)349-0100

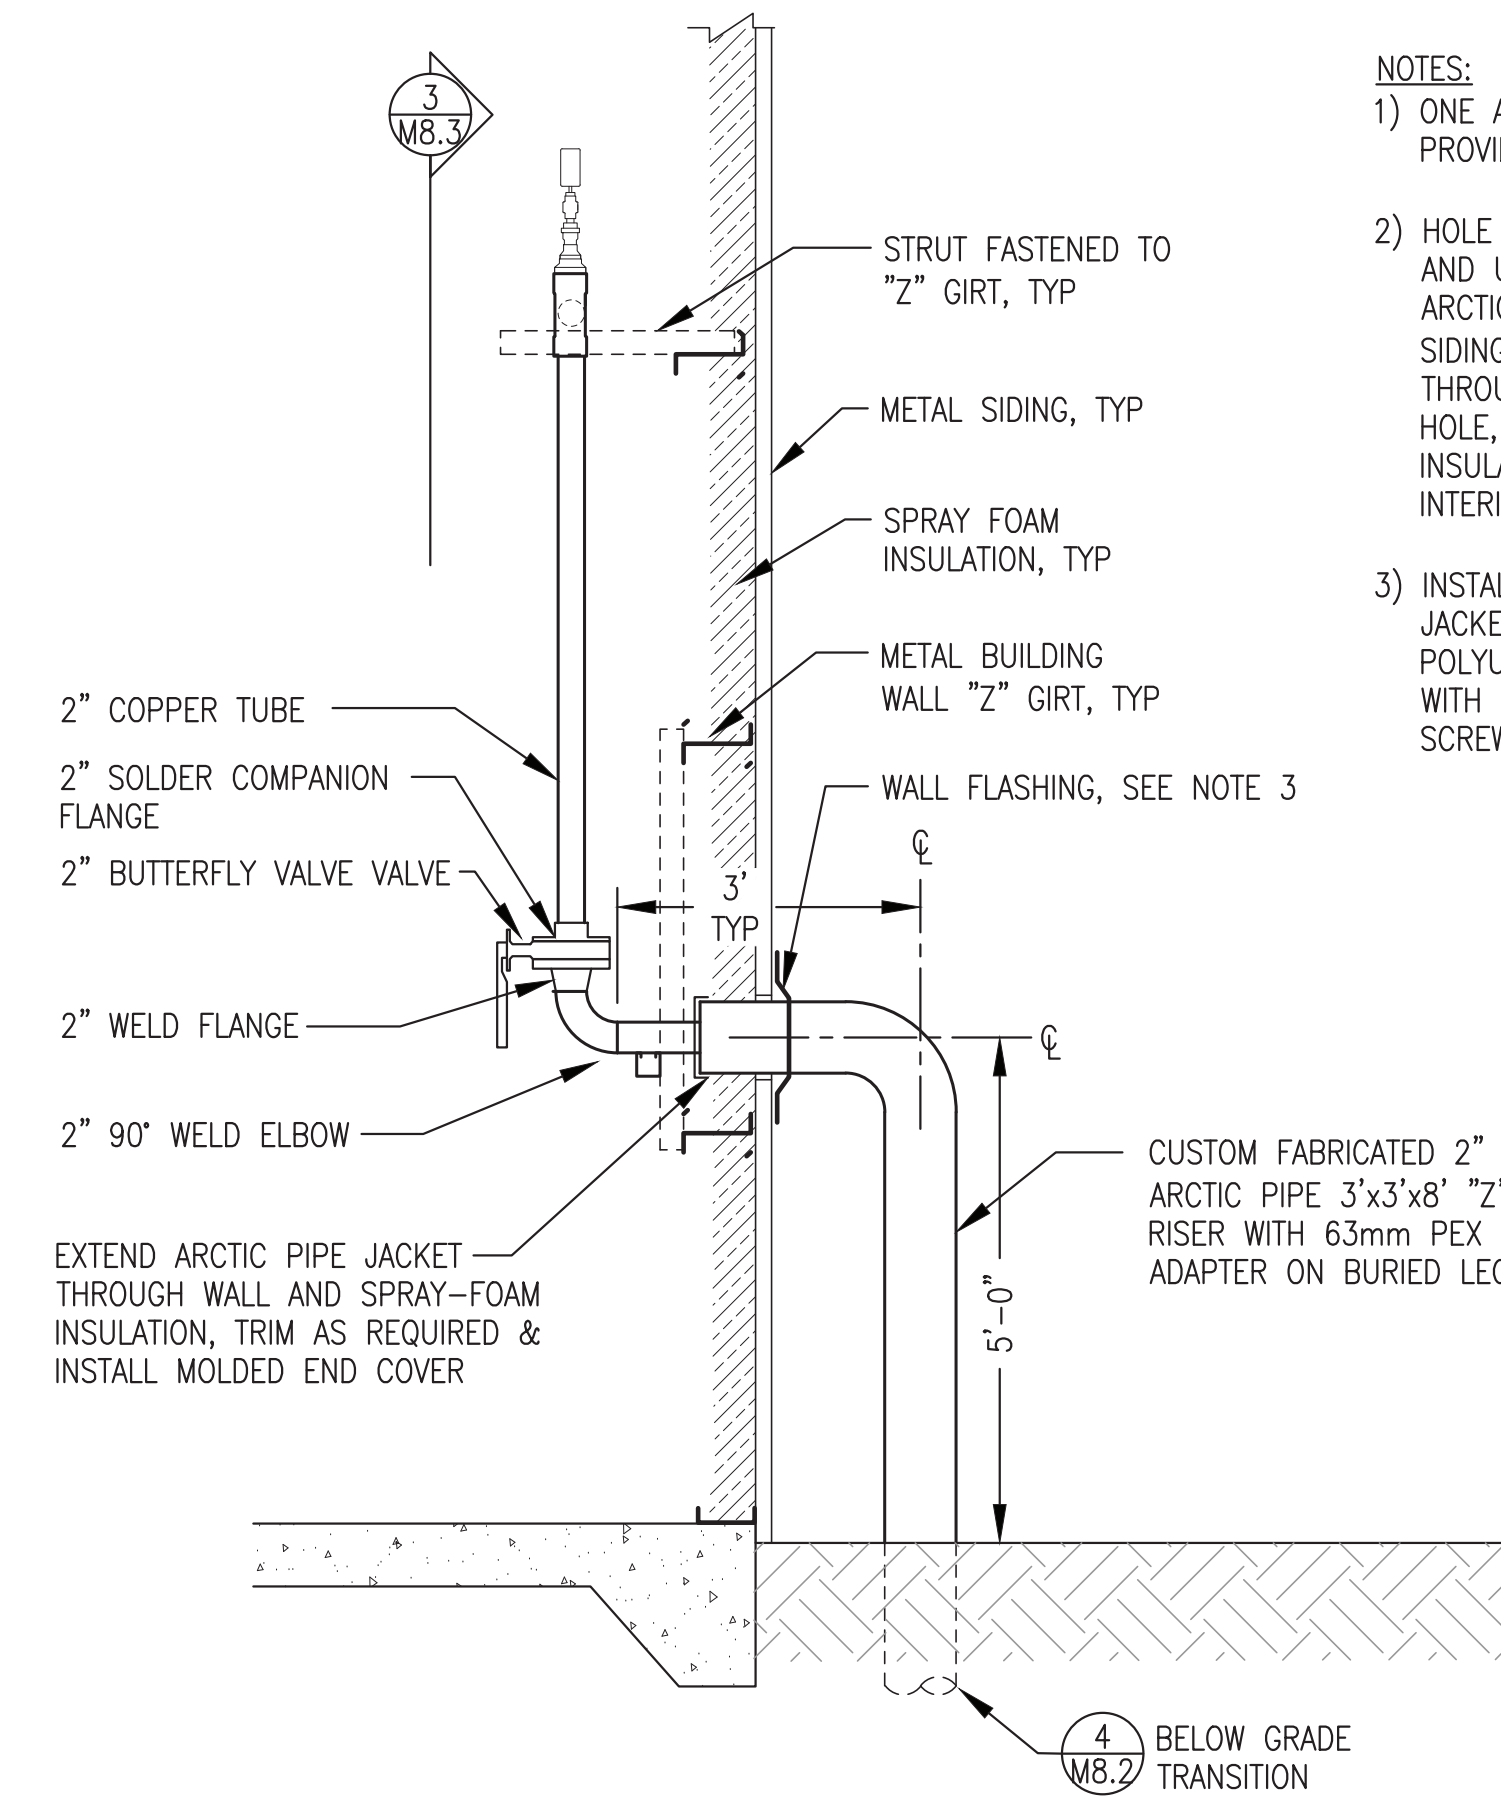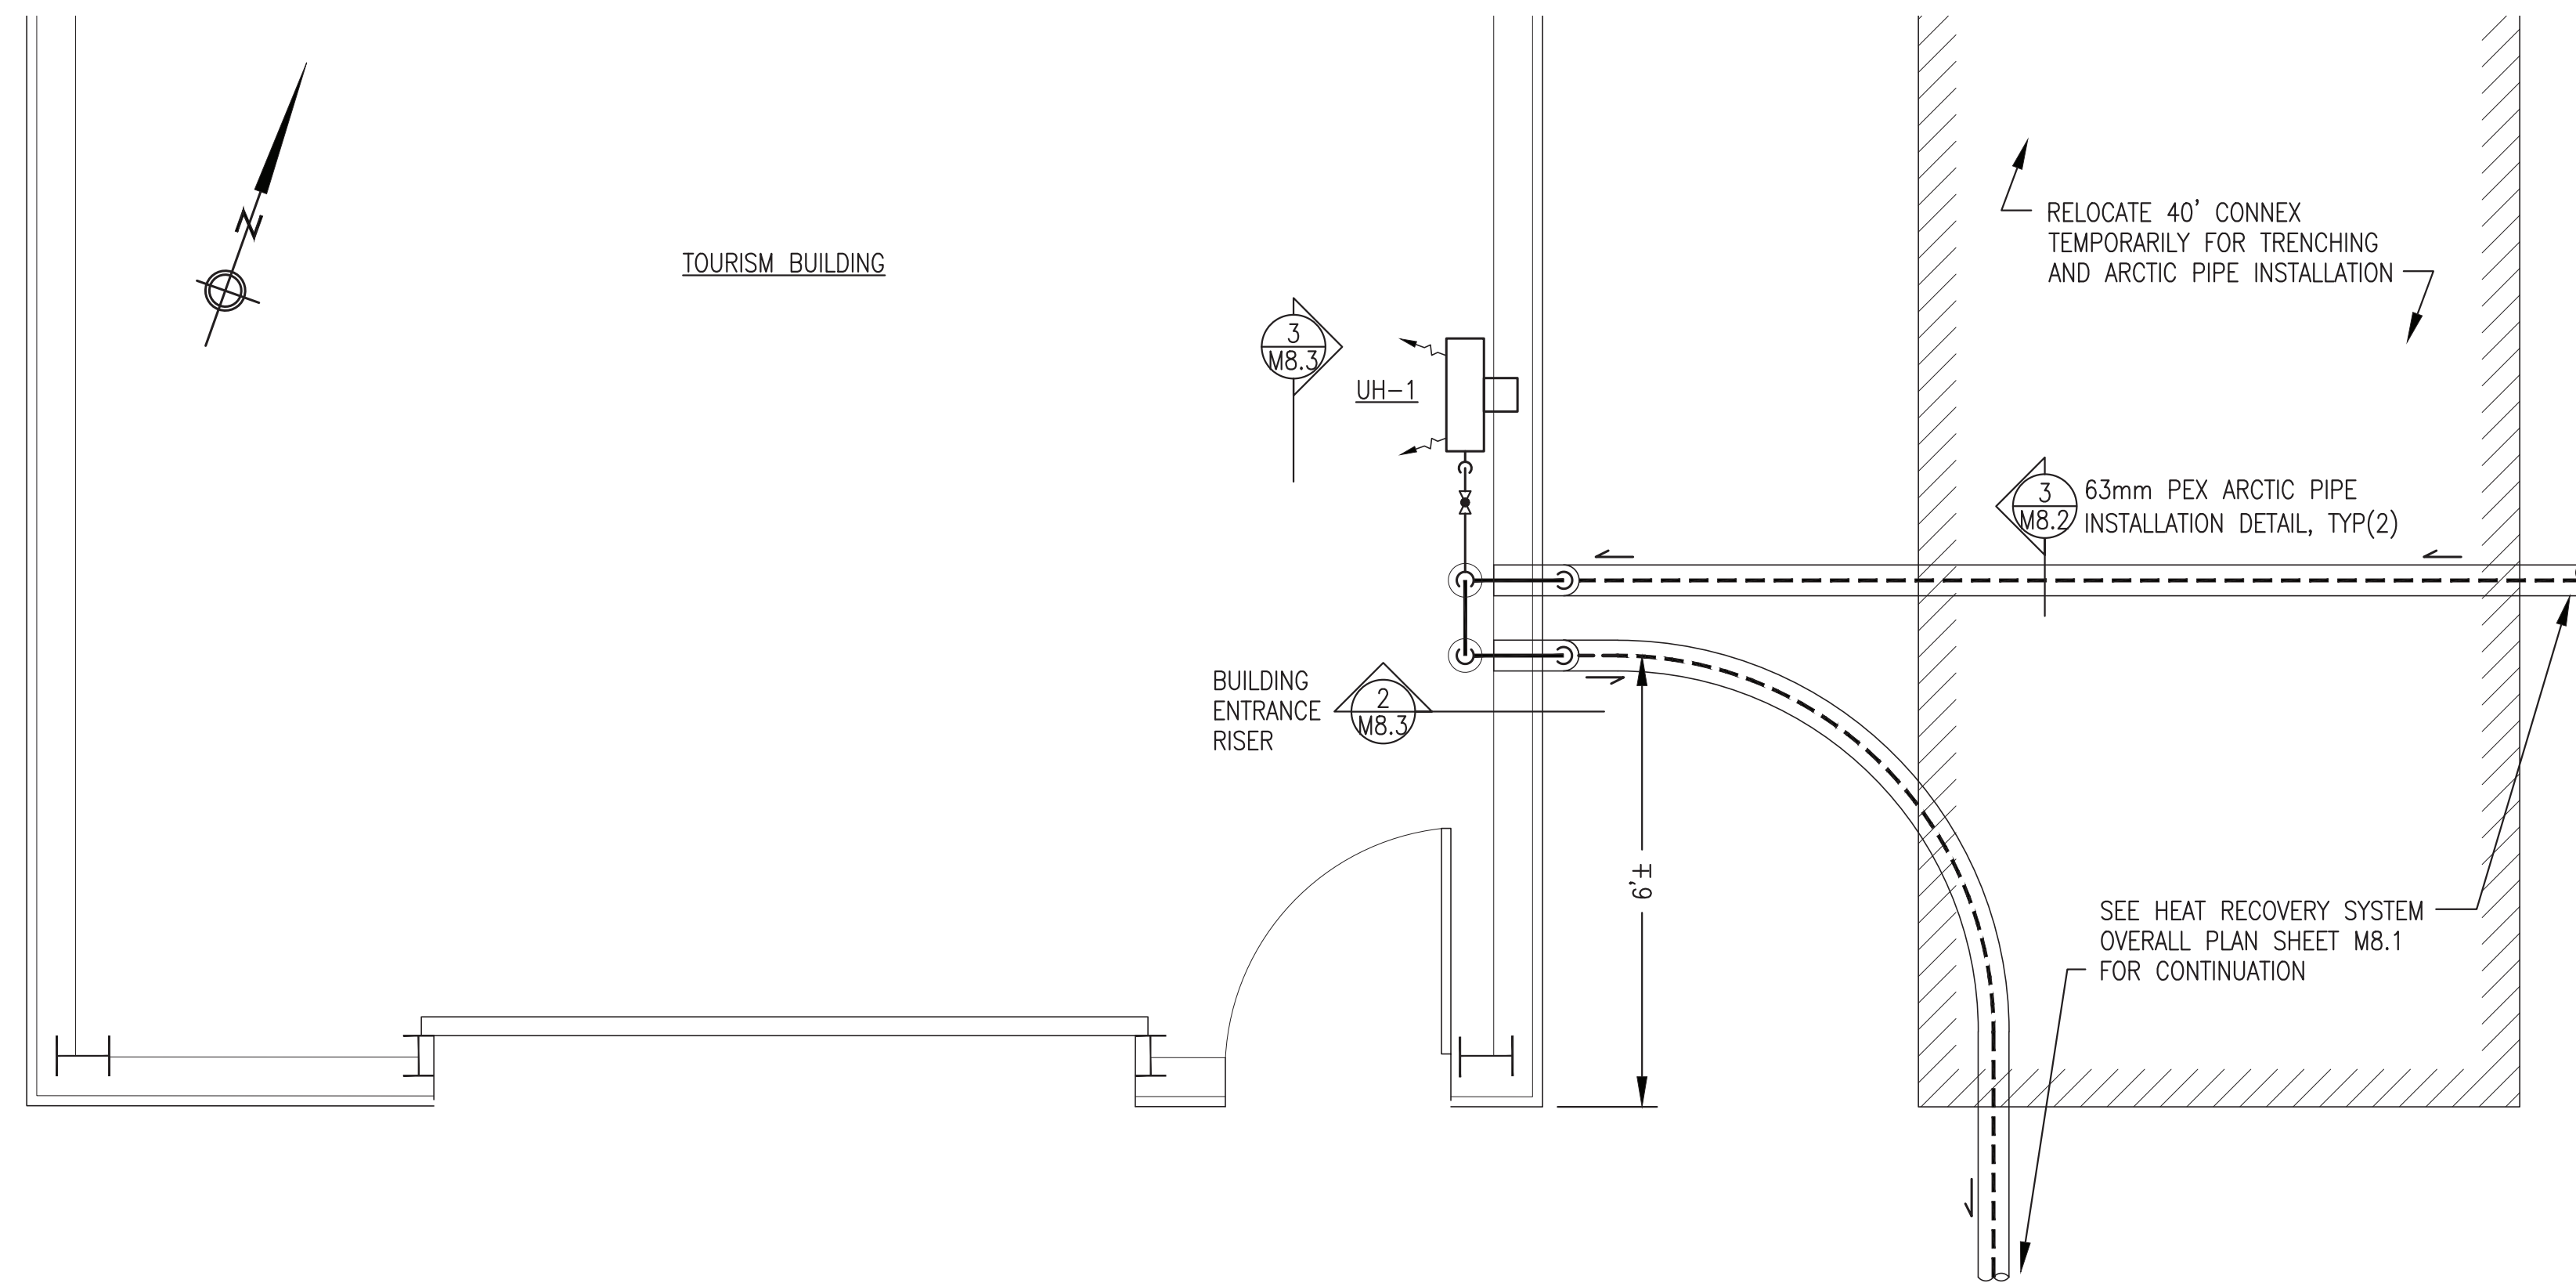

- NOTES:
- 1) ONE ARCTIC PIPE ENTRANCE SHOWN. PROVIDE TWO IDENTICAL.
  - 2) HOLE SAW 3"Ø THROUGH WALL SIDING AND URETHANE INSULATION. TRIM ARCTIC PIPE JACKET AT EXTERIOR OF SIDING AND EXTEND 2" STEEL PIPE THROUGH WALL. CENTER PIPE IN HOLE, PACK GAP WITH FIBERGLASS INSULATION, AND SEAL ALL AROUND INTERIOR WITH POLYURETHANE CAULK.
  - 3) INSTALL FLASHING OVER ARCTIC PIPE JACKET. SEAL TO SIDING WITH POLYURETHANE CAULKING AND FASTEN WITH STAINLESS STEEL SHEET METAL SCREWS ALL AROUND.

**1** TOURISM BUILDING HEAT RECOVERY PLAN  
**M8.3** 1/2"=1'-0"

**2** TOURISM BUILDING ARCTIC PIPE ENTRANCE  
**M8.3** NO SCALE

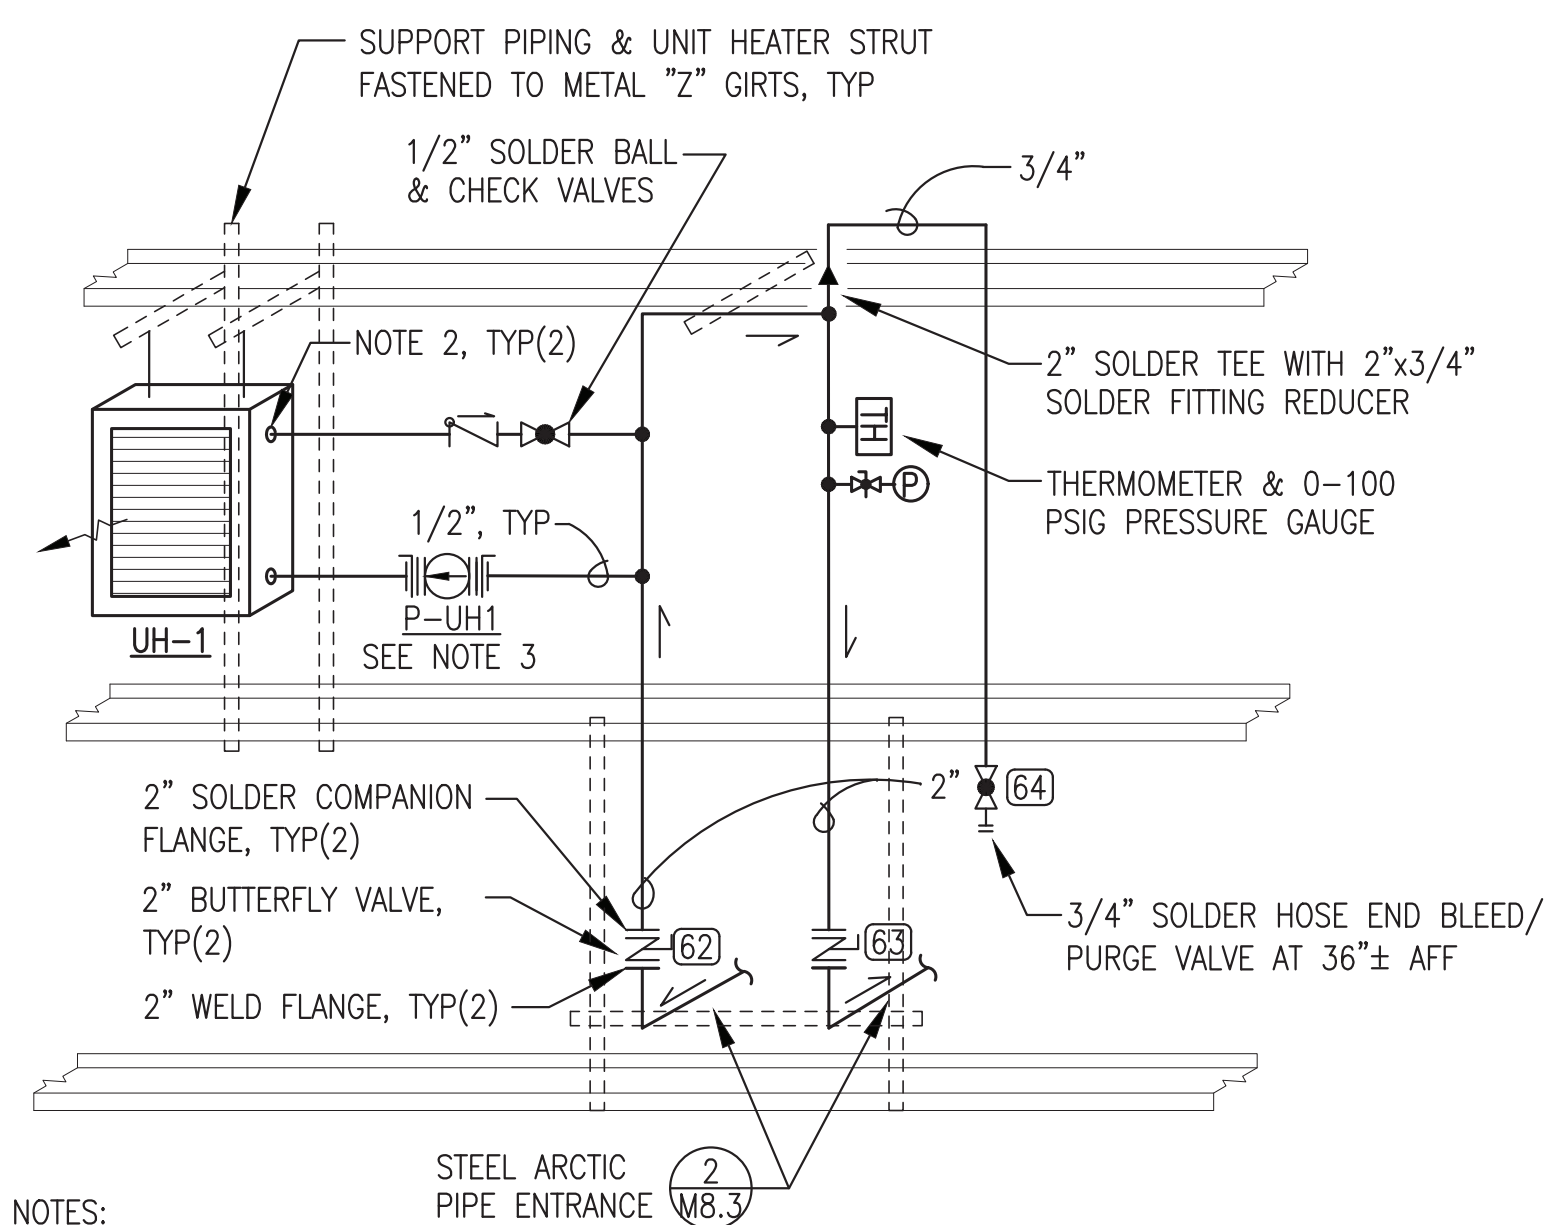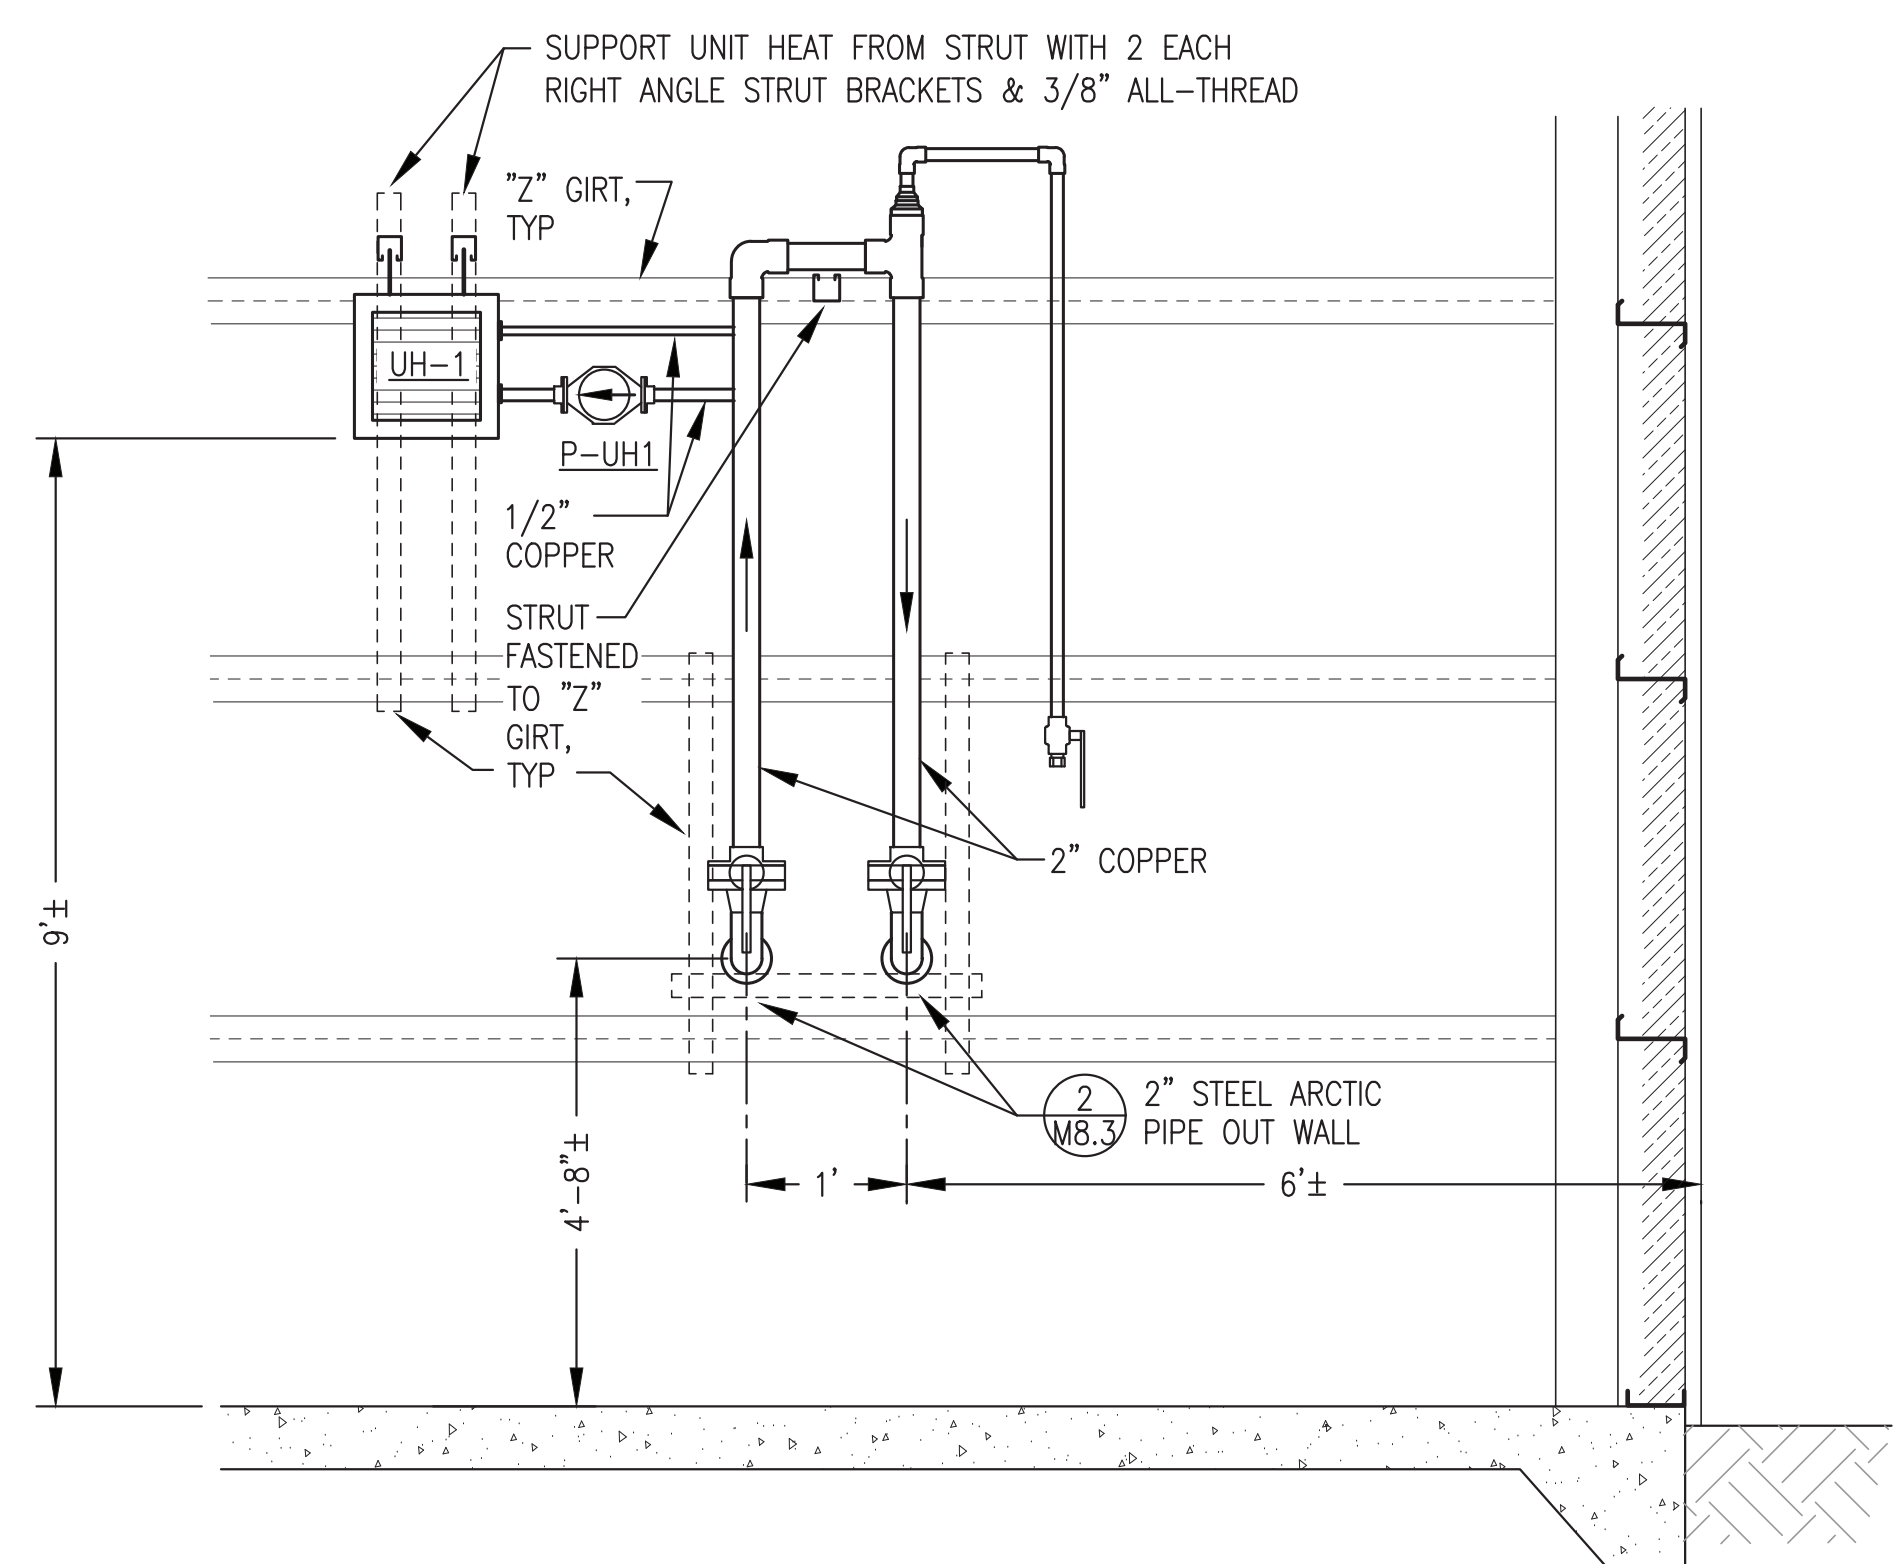

- NOTES:
1. ALL PIPE THIS ISOMETRIC COPPER TUBING UNLESS SPECIFICALLY INDICATED OTHERWISE.
  2. CONNECT TO UNIT HEATER WITH 3/4"x1/2" BUSHING & 1/2" MPTxC ADAPTER.
  3. PUMP P-UH1 WITH 1/2" SOLDER SHUT OFF FLANGES. SET TO SPEED 1.

- GENERAL NOTES:
1. ALL PLANS AND ELEVATIONS THIS SHEET FOR GENERAL PIPING LAYOUT AND ARRANGEMENT ONLY. NOT ALL PIPE, FITTINGS, AND ACCESSORIES SHOWN FOR CLARITY, SEE PIPING ISOMETRIC THIS SHEET FOR ADDITIONAL DETAIL.
  2. ALL PIPING INSIDE BUILDING TYPE L COPPER TUBING, 2" MAINS, 1/2" BRANCH.
  3. INSULATE ALL 2" MAIN PIPING WITH FIBERGLASS INSULATION WITH PVC JACKET. ALL BRANCH PIPING NOT INSULATED.

ALL WORK THIS SHEET IS INCLUDED IN THE ON SITE CONTRACT UNDER ADDITIVE ALTERNATE #1.


**3** TOURISM BUILDING ARCTIC PIPE ENTRANCE ELEVATION  
**M8.3** NO SCALE

**4** TOURISM BUILDING HEAT RECOVERY PIPING ISOMETRIC  
**M8.3** NO SCALE


ISSUED FOR CONSTRUCTION  
MAY 2023




ALASKA ENERGY AUTHORITY	
PROJECT: NELSON LAGOON POWER SYSTEM UPGRADE	
TITLE: HEAT RECOVERY SYSTEM TOURISM BUILDING PLAN & DETAILS	
DESIGNED BY: BCG	SCALE: AS NOTED
DATE: 5/30/23	SHEET: M8.3
FILE NAME: NELS PP M8	PROJECT NUMBER:
P.O. 111405, Anchorage, AK 99511 (907)349-0100	

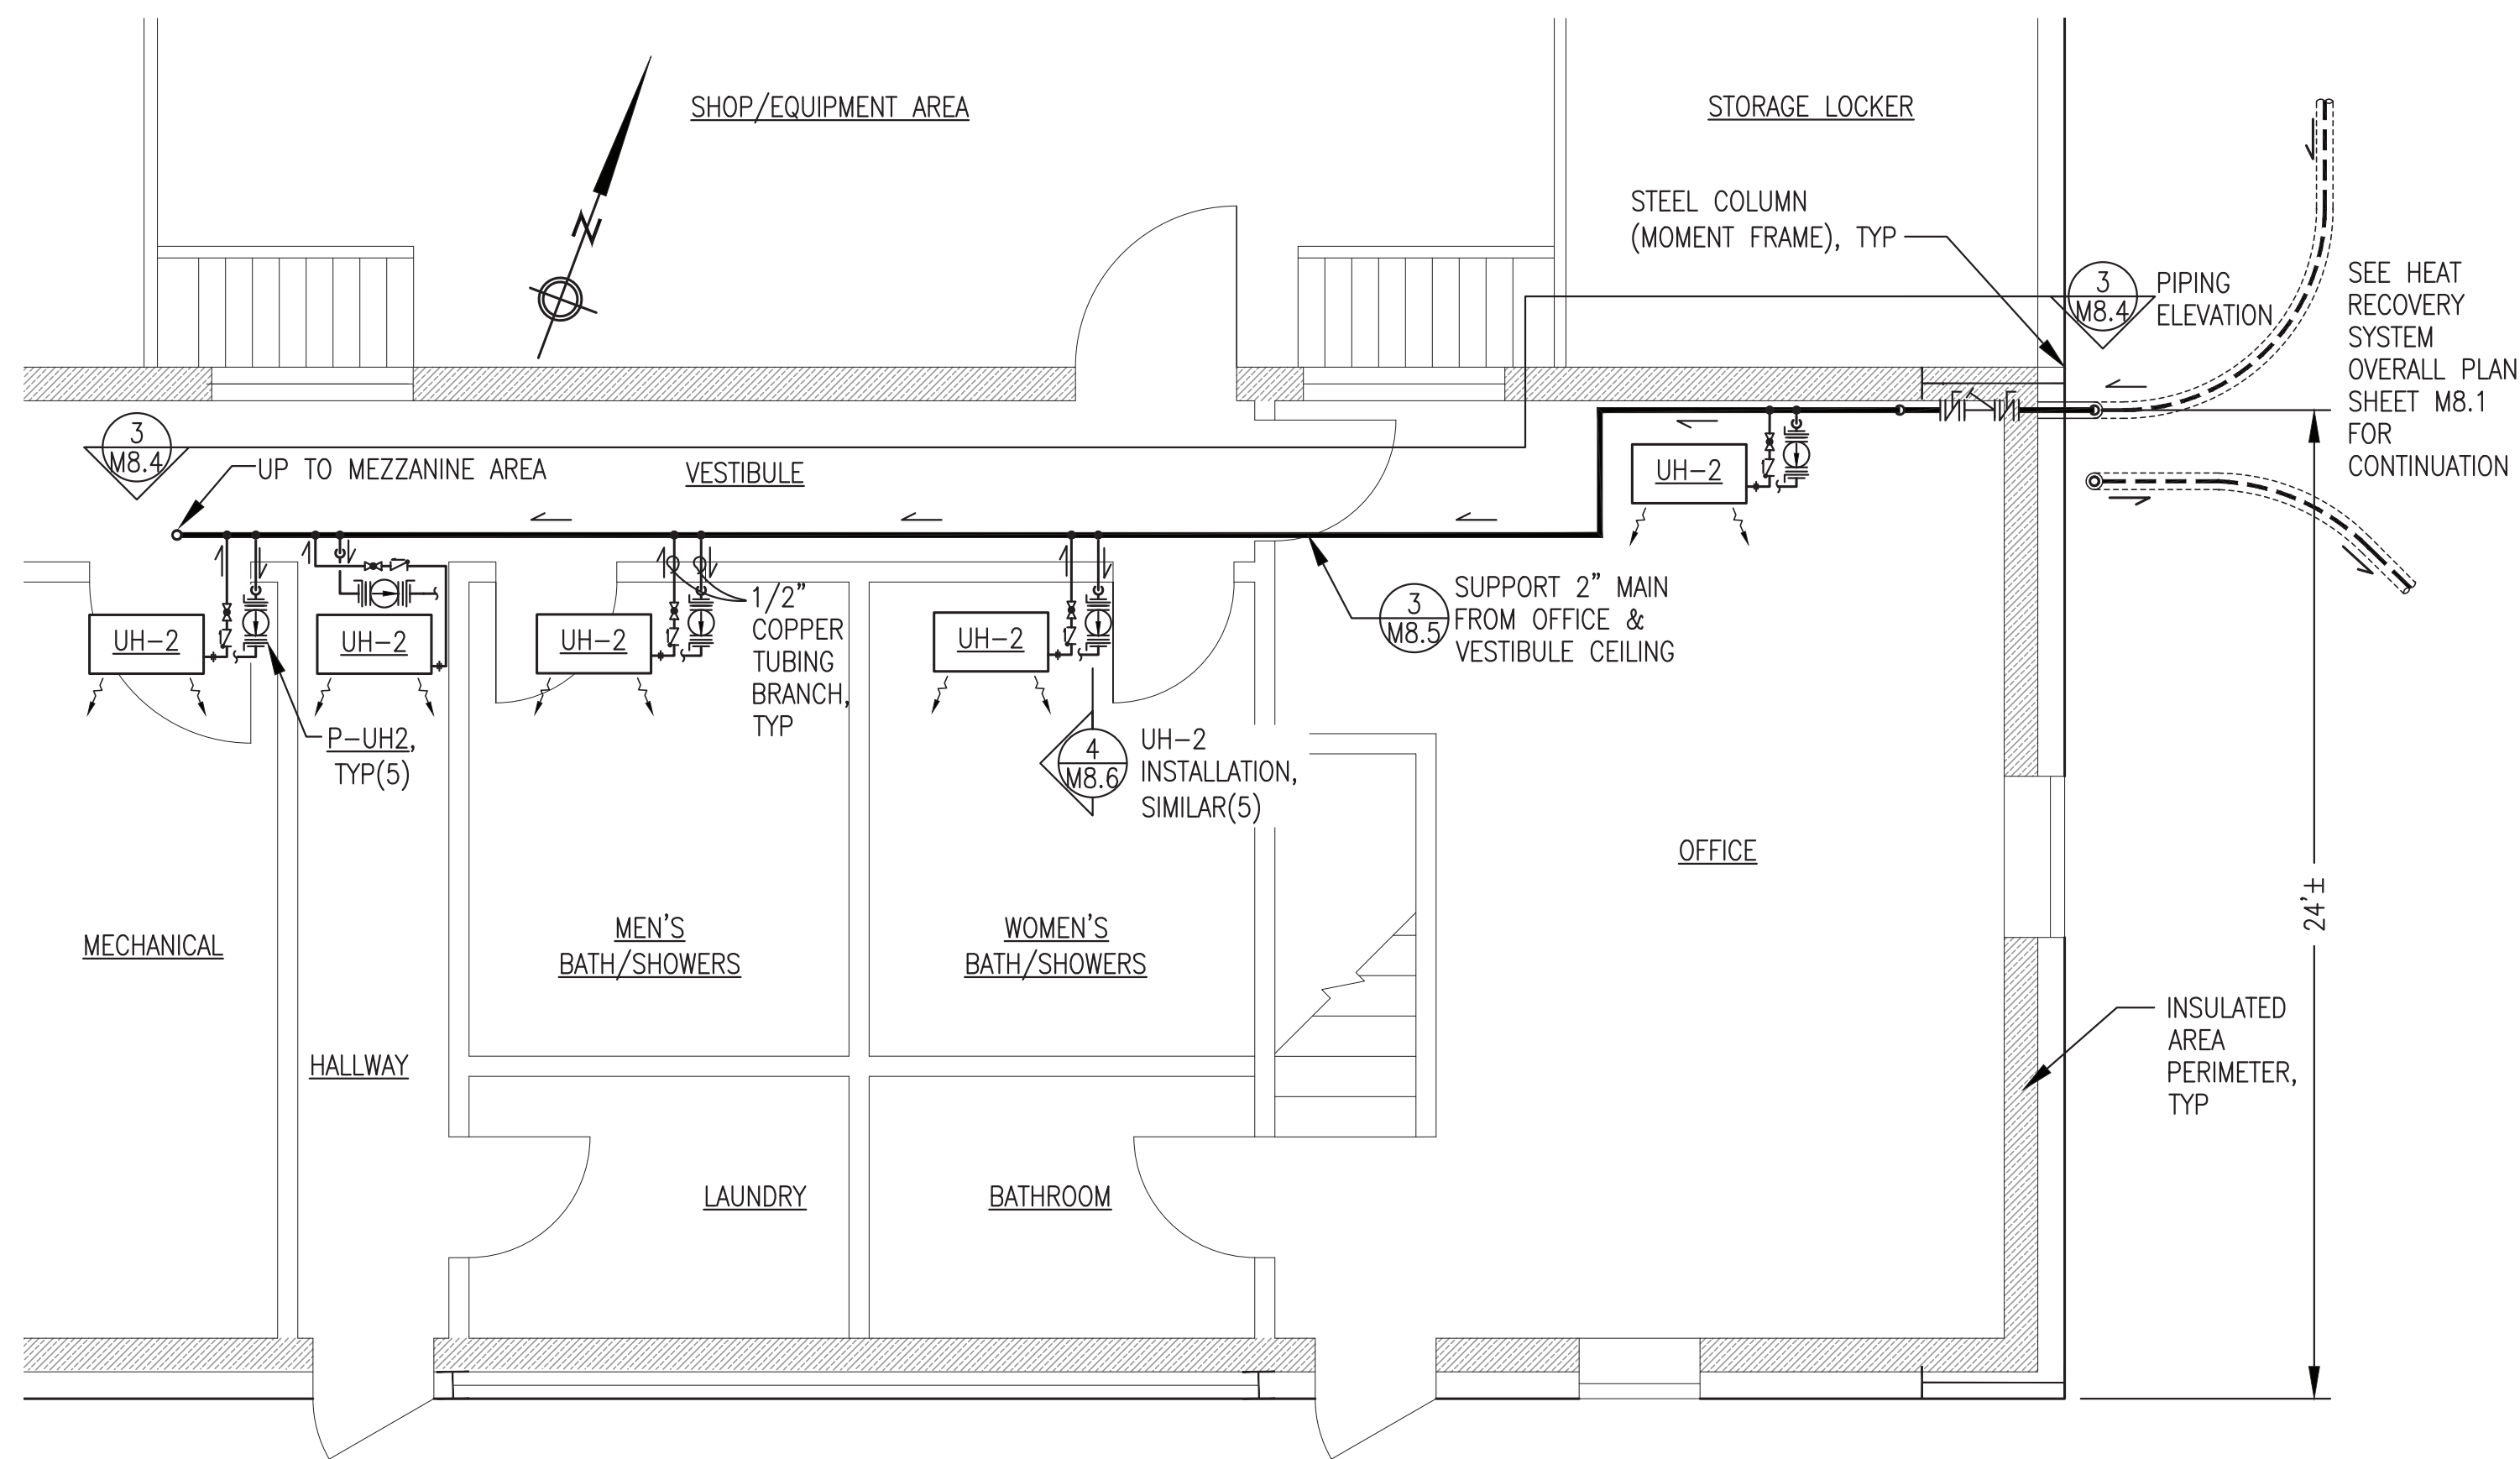

1 STORAGE COMPOUND FIRST FLOOR LEVEL HEAT RECOVERY PLAN  
M8.4 1/4"=1'-0"

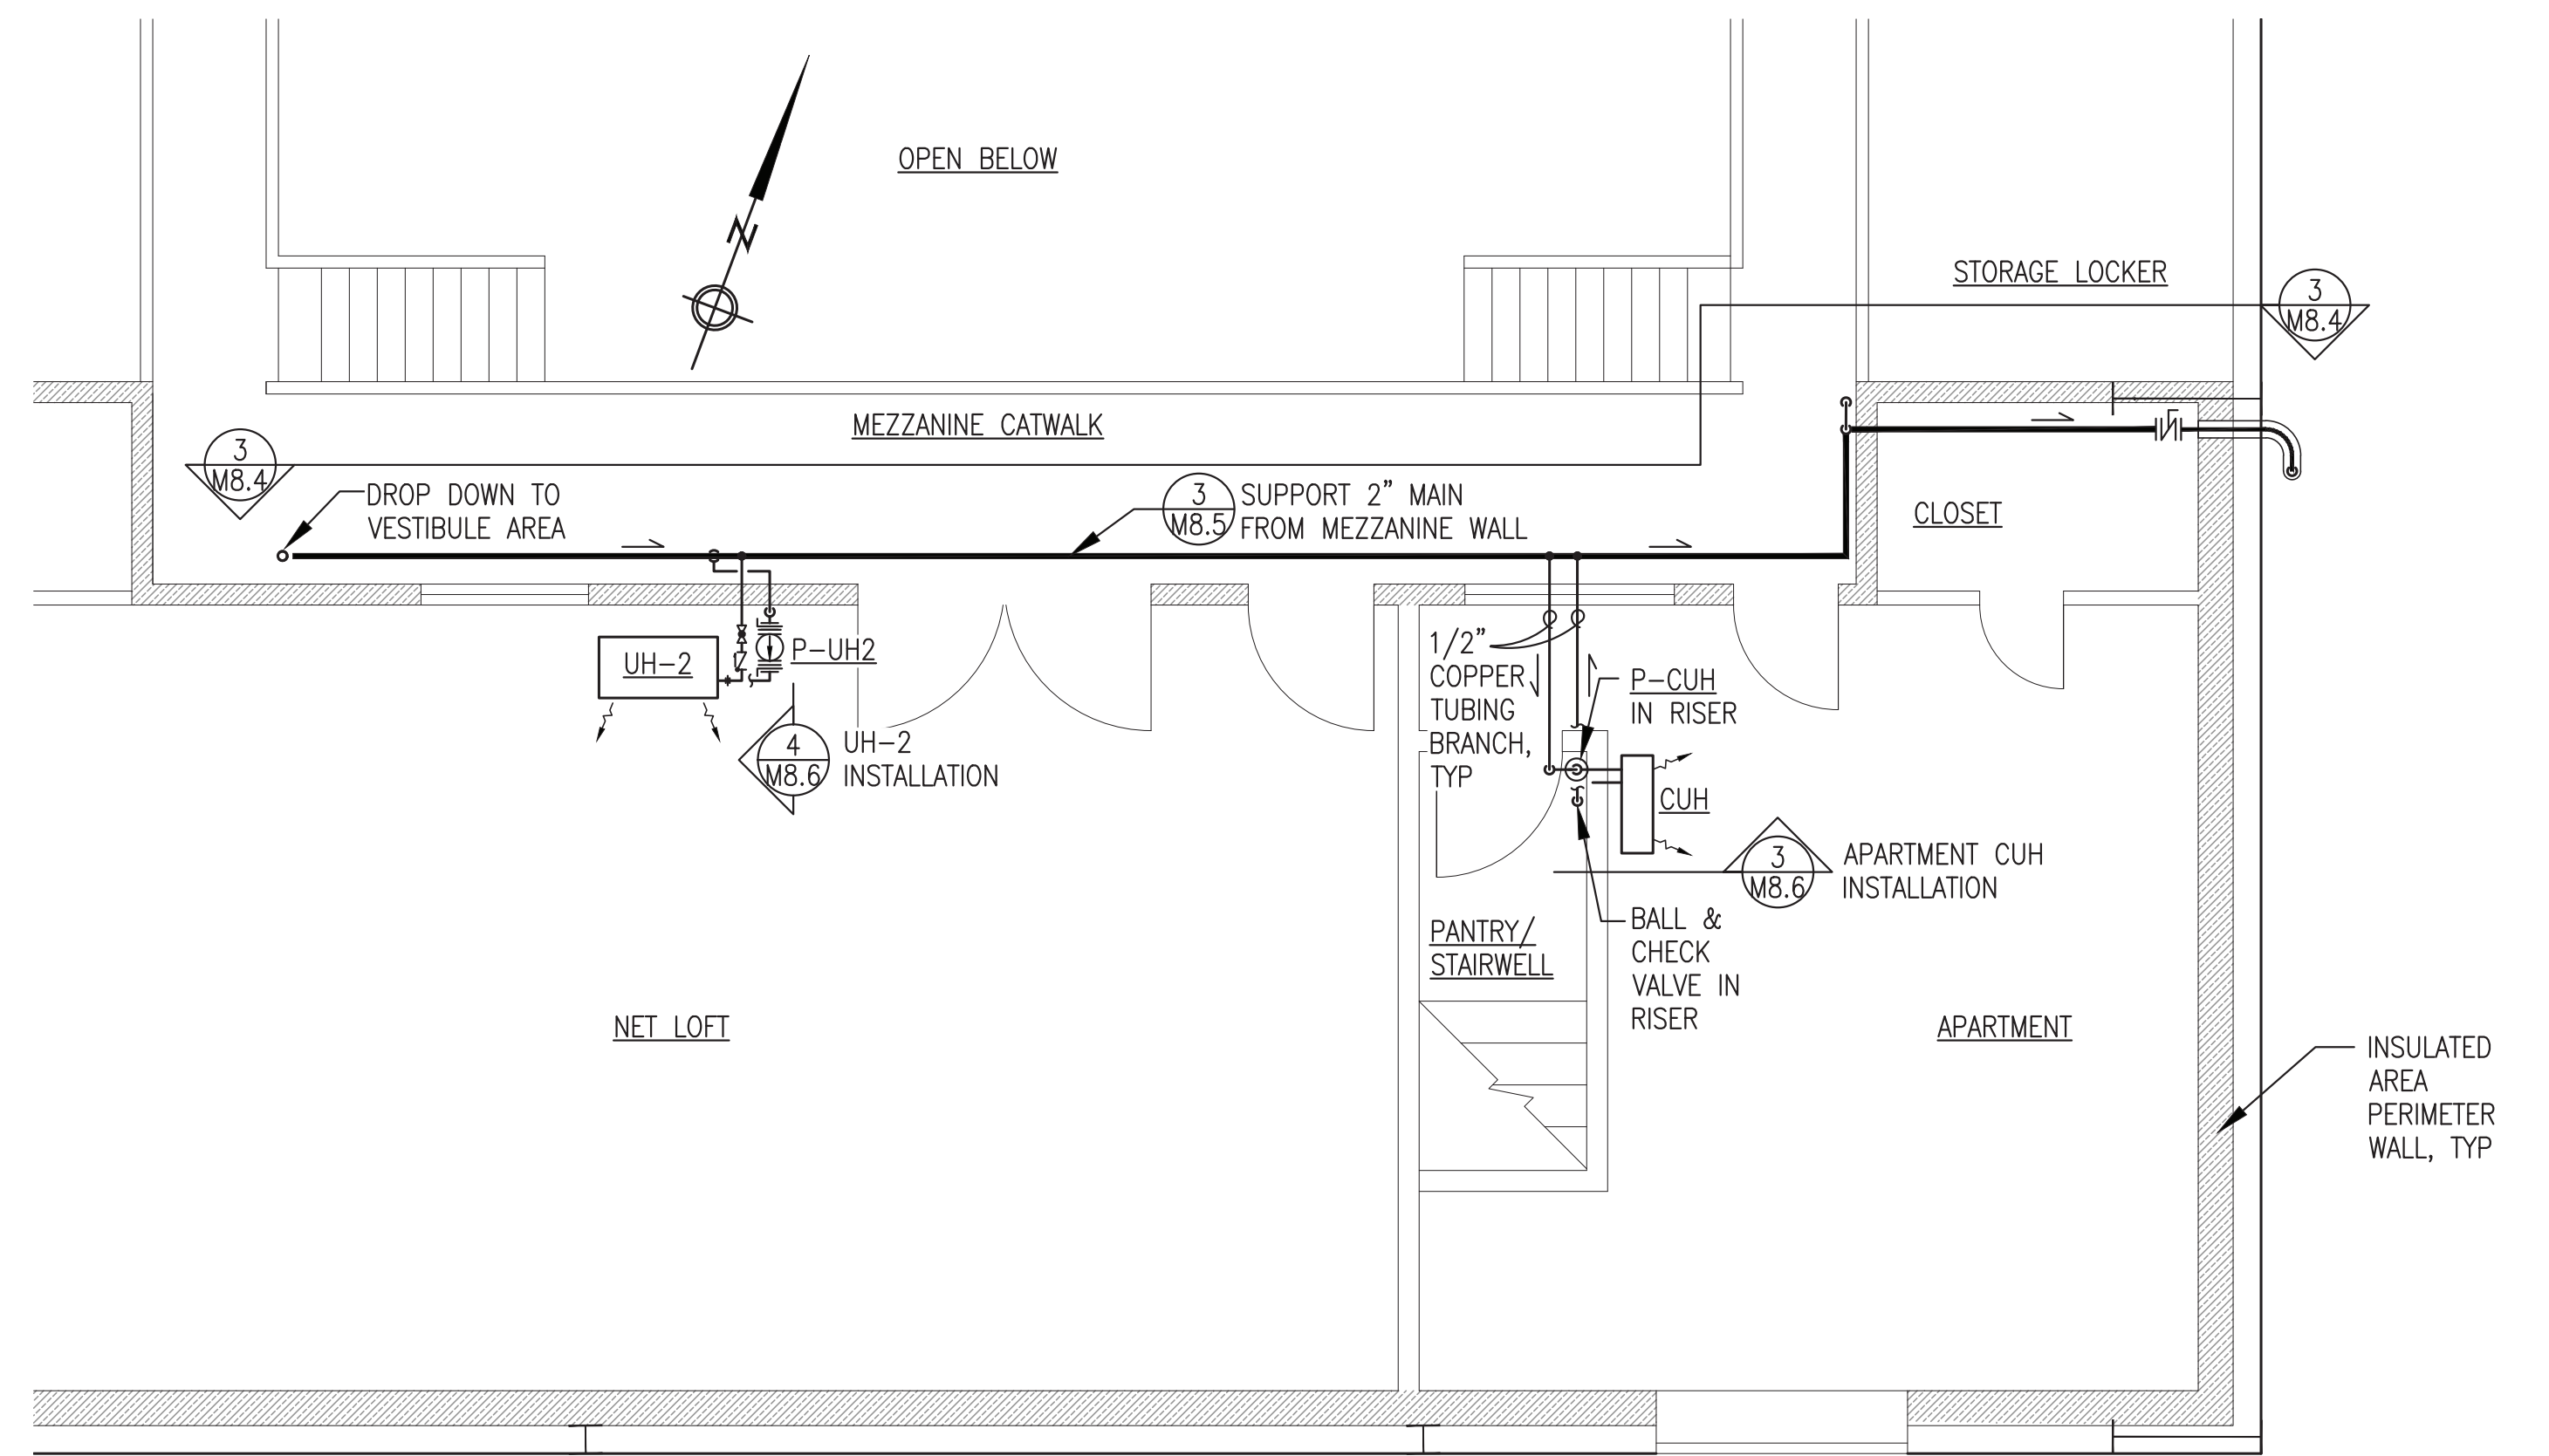

2 STORAGE COMPOUND MEZZANINE LEVEL HEAT RECOVERY PLAN  
M8.4 1/4"=1'-0"

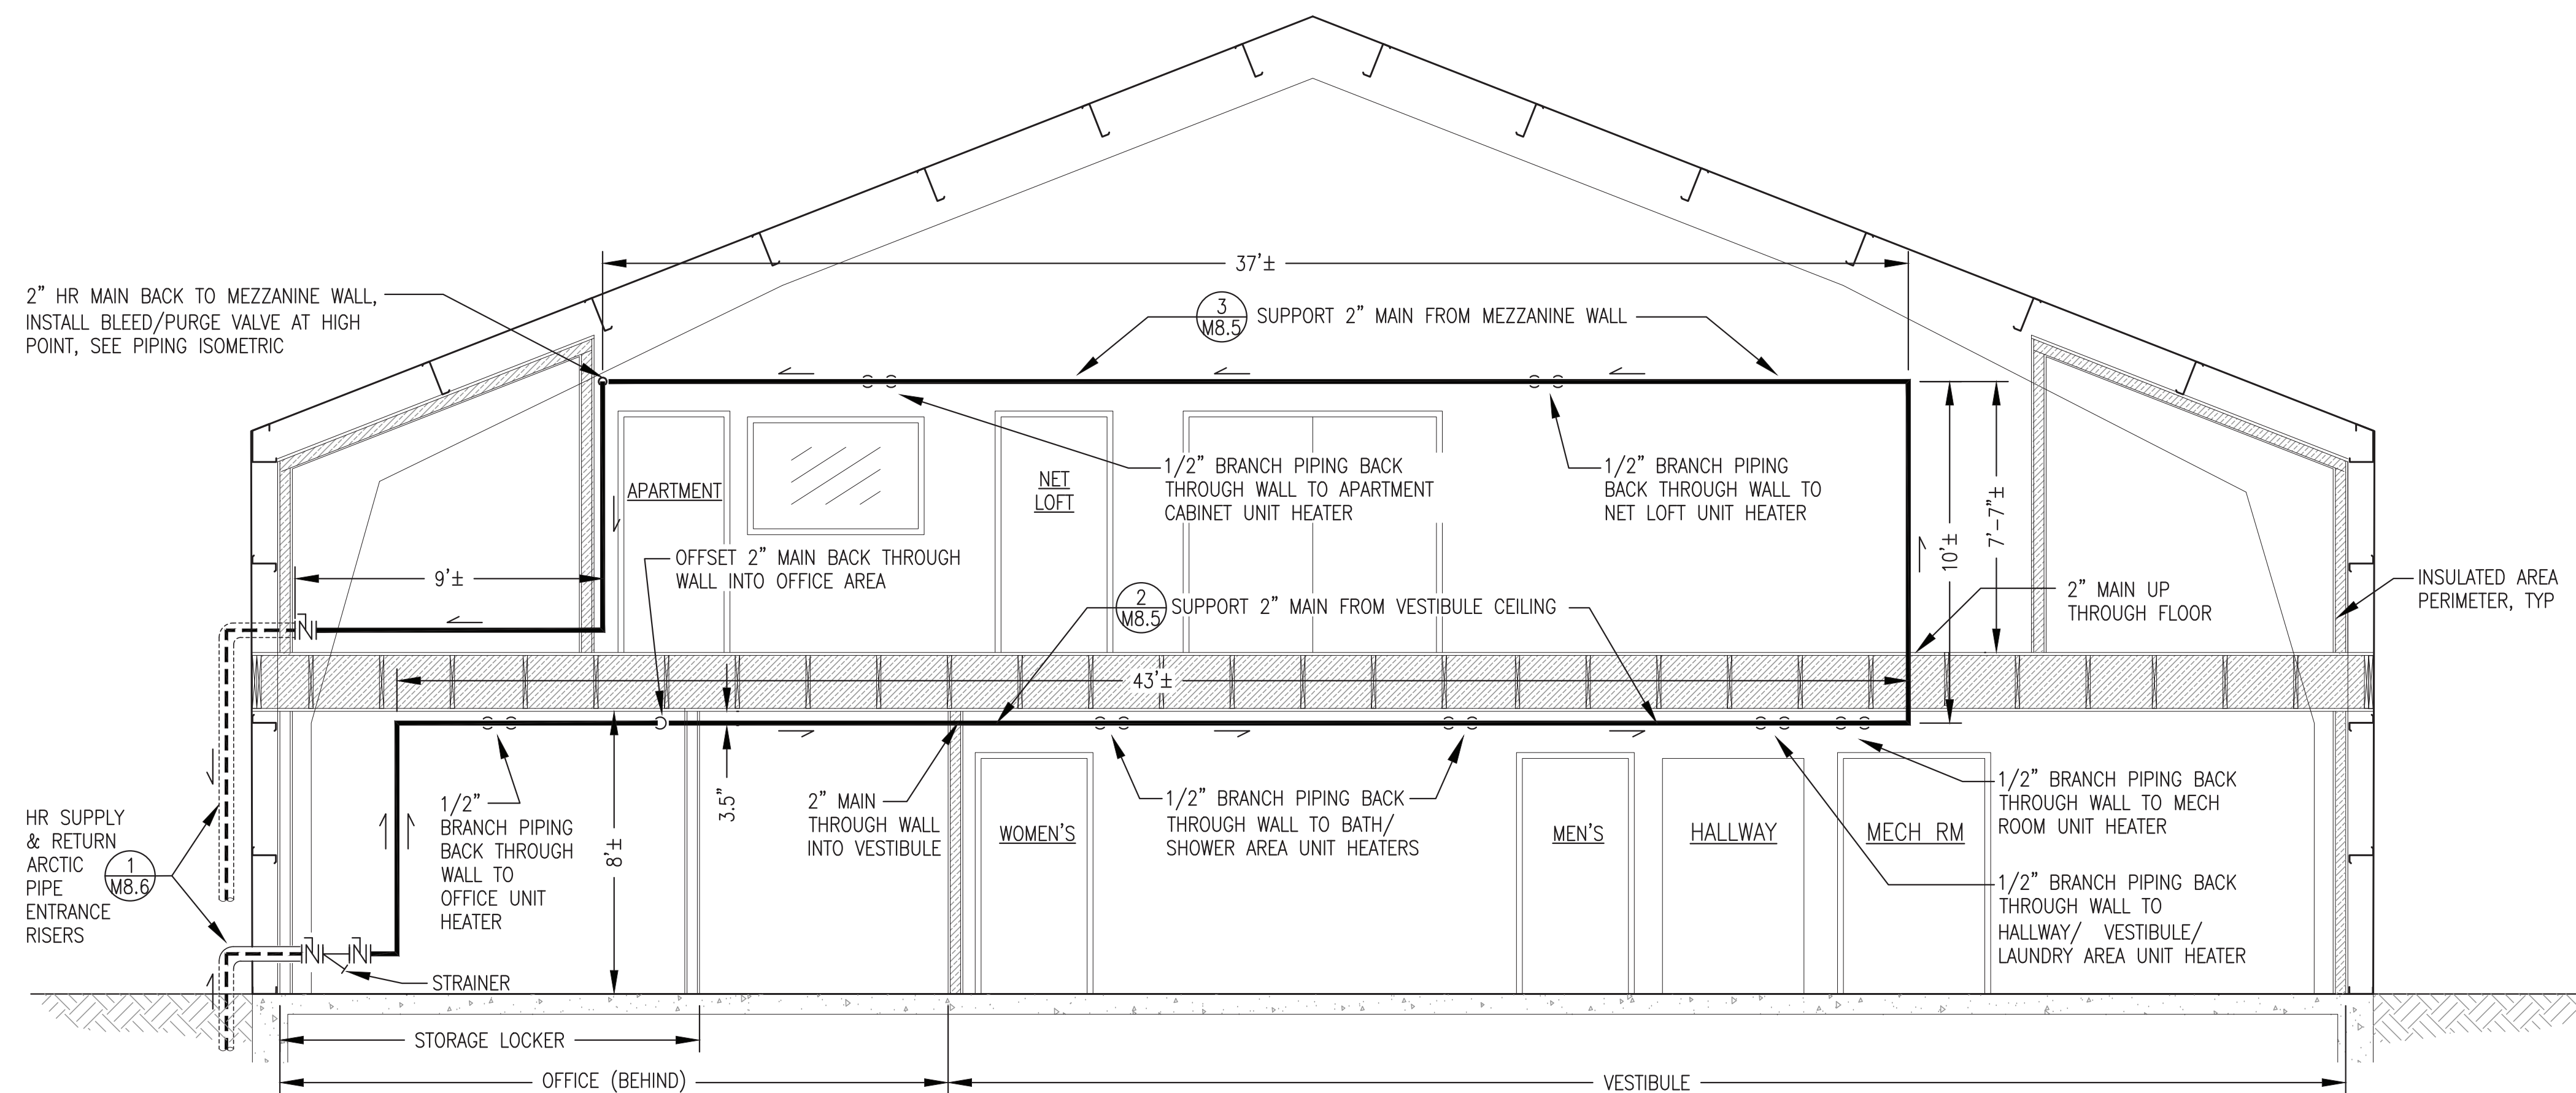


3 STORAGE COMPOUND HEAT RECOVERY 2" MAIN PIPING ELEVATION  
M8.4 NO SCALE

GENERAL NOTES:

1. ALL PLANS AND ELEVATIONS THIS SHEET FOR GENERAL PIPING LAYOUT AND ARRANGEMENT ONLY. NOT ALL PIPE, FITTINGS, AND ACCESSORIES SHOWN FOR CLARITY, SEE PIPING ISOMETRIC SHEET M8.5 FOR ADDITIONAL DETAIL.
2. ALL PIPING INSIDE BUILDING TYPE L COPPER TUBING, 2" MAINS, 1/2" BRANCH.
3. INSULATE ALL 2" MAIN PIPING WITH FIBERGLASS INSULATION WITH PVC JACKET. ALL BRANCH PIPING NOT INSULATED..
4. WHERE 2" MAINS PENETRATE A WALL, SEAL INSULATION JACKET TO WALL ALL AROUND WITH POLYURETHANE CAULK.
5. WHERE 1/2" BRANCH PIPING PENETRATES A WALL, PROVIDE ESCUTCHEON PLATES ON BOTH SIDES.


ALL WORK THIS SHEET IS INCLUDED IN THE ON SITE CONTRACT UNDER ADDITIVE ALTERNATE #1.

ISSUED FOR CONSTRUCTION  
MAY 2023

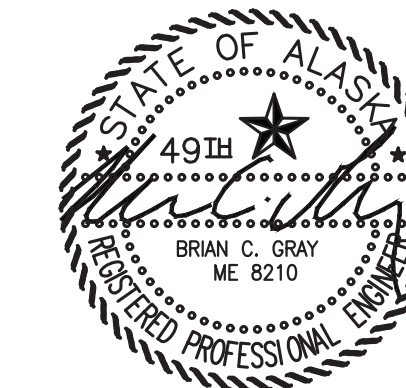


PROJECT: NELSON LAGOON POWER SYSTEM UPGRADE		
TITLE: HEAT RECOVERY SYSTEM STORAGE COMPOUND PLANS & PIPING ELEVATION		
DRAWN BY: JTD	SCALE: AS NOTED	
DESIGNED BY: BCG	DATE: 5/30/23	
FILE NAME: NELS PP M8	SHEET:	M8.4
PROJECT NUMBER:		

P.O. 111405, Anchorage, AK 99511 (907)349-0100

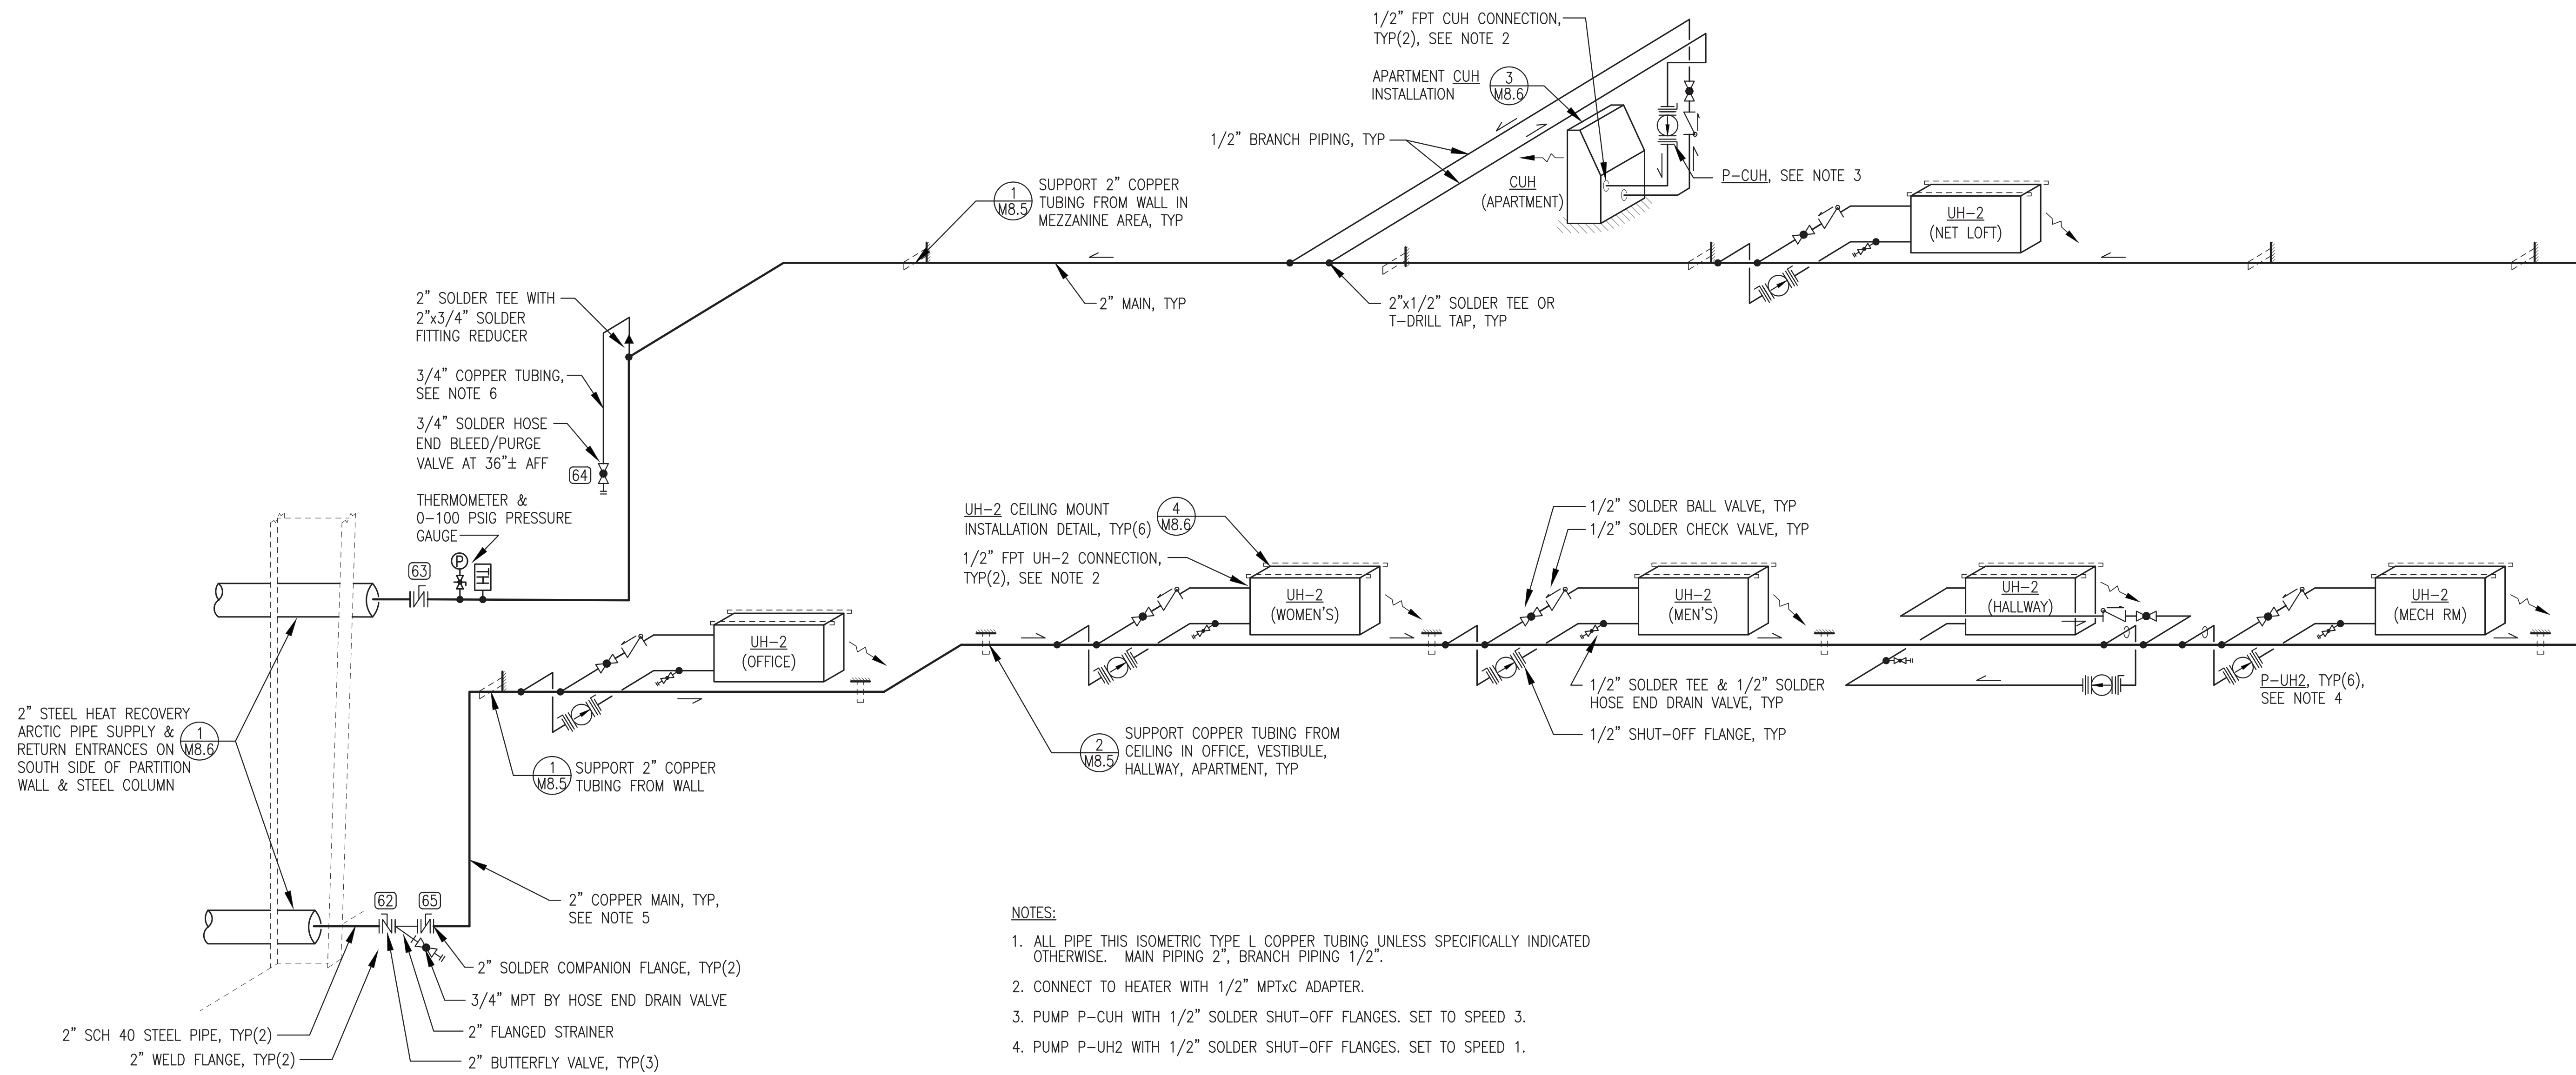


- NOTES:**
1. ALL PIPE THIS ISOMETRIC TYPE L COPPER TUBING UNLESS SPECIFICALLY INDICATED OTHERWISE. MAIN PIPING 2", BRANCH PIPING 1/2".
  2. CONNECT TO HEATER WITH 1/2" MPTxC ADAPTER.
  3. PUMP P-CUH WITH 1/2" SOLDER SHUT-OFF FLANGES. SET TO SPEED 3.
  4. PUMP P-UH2 WITH 1/2" SOLDER SHUT-OFF FLANGES. SET TO SPEED 1.

**1** STORAGE COMPOUND HEAT RECOVERY PIPING ISOMETRIC  
M8.5 NO SCALE

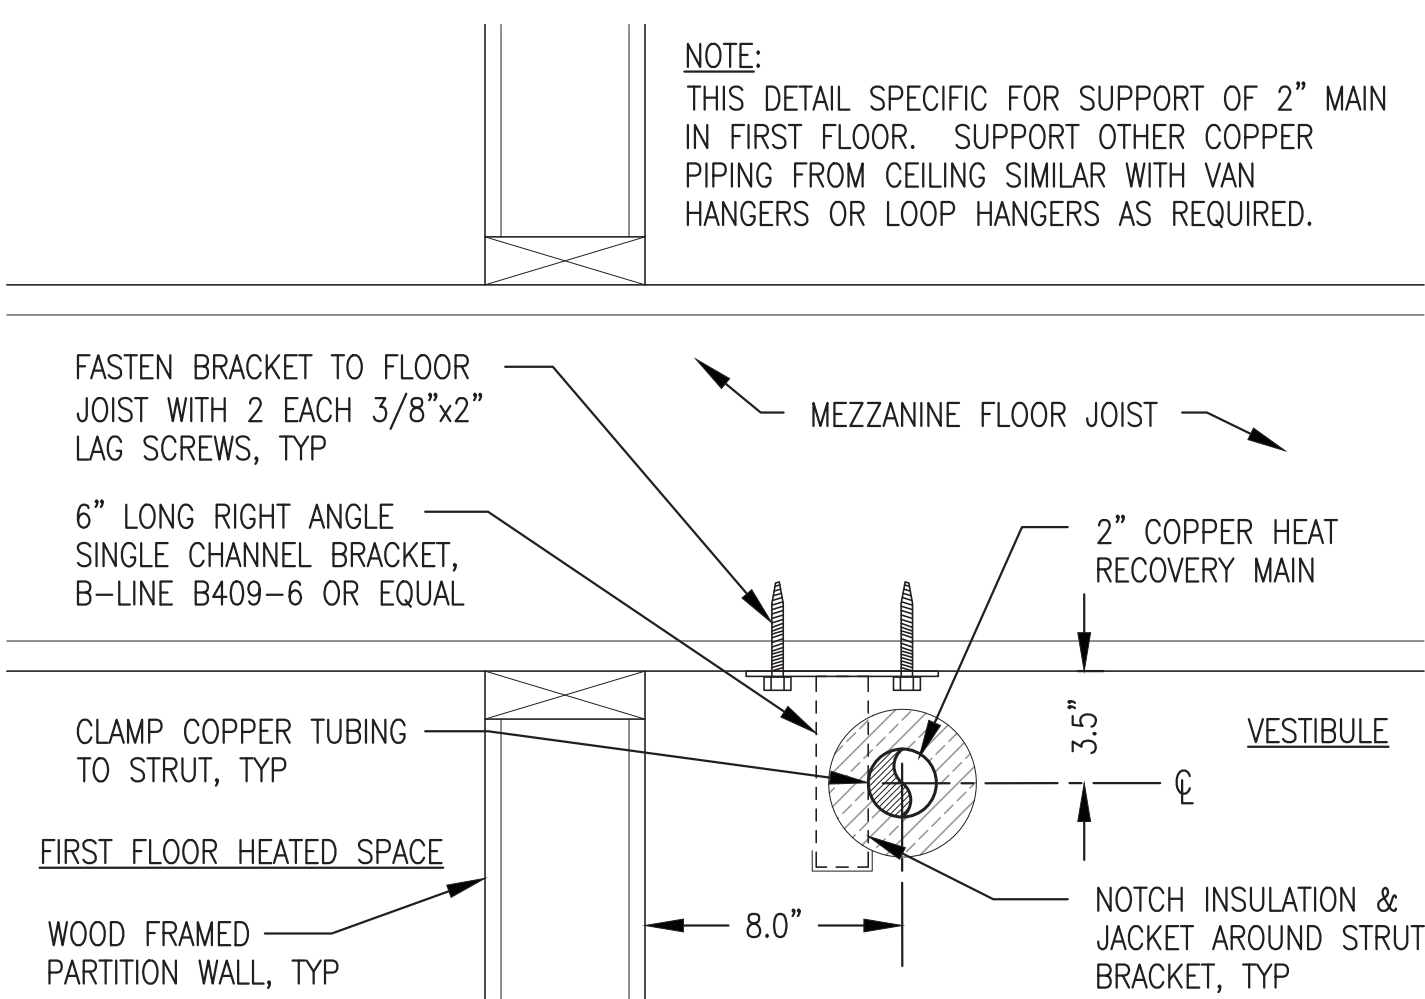

**2** TYPICAL PIPE SUPPORT FROM VESTIBULE CEILING  
M8.5 NO SCALE

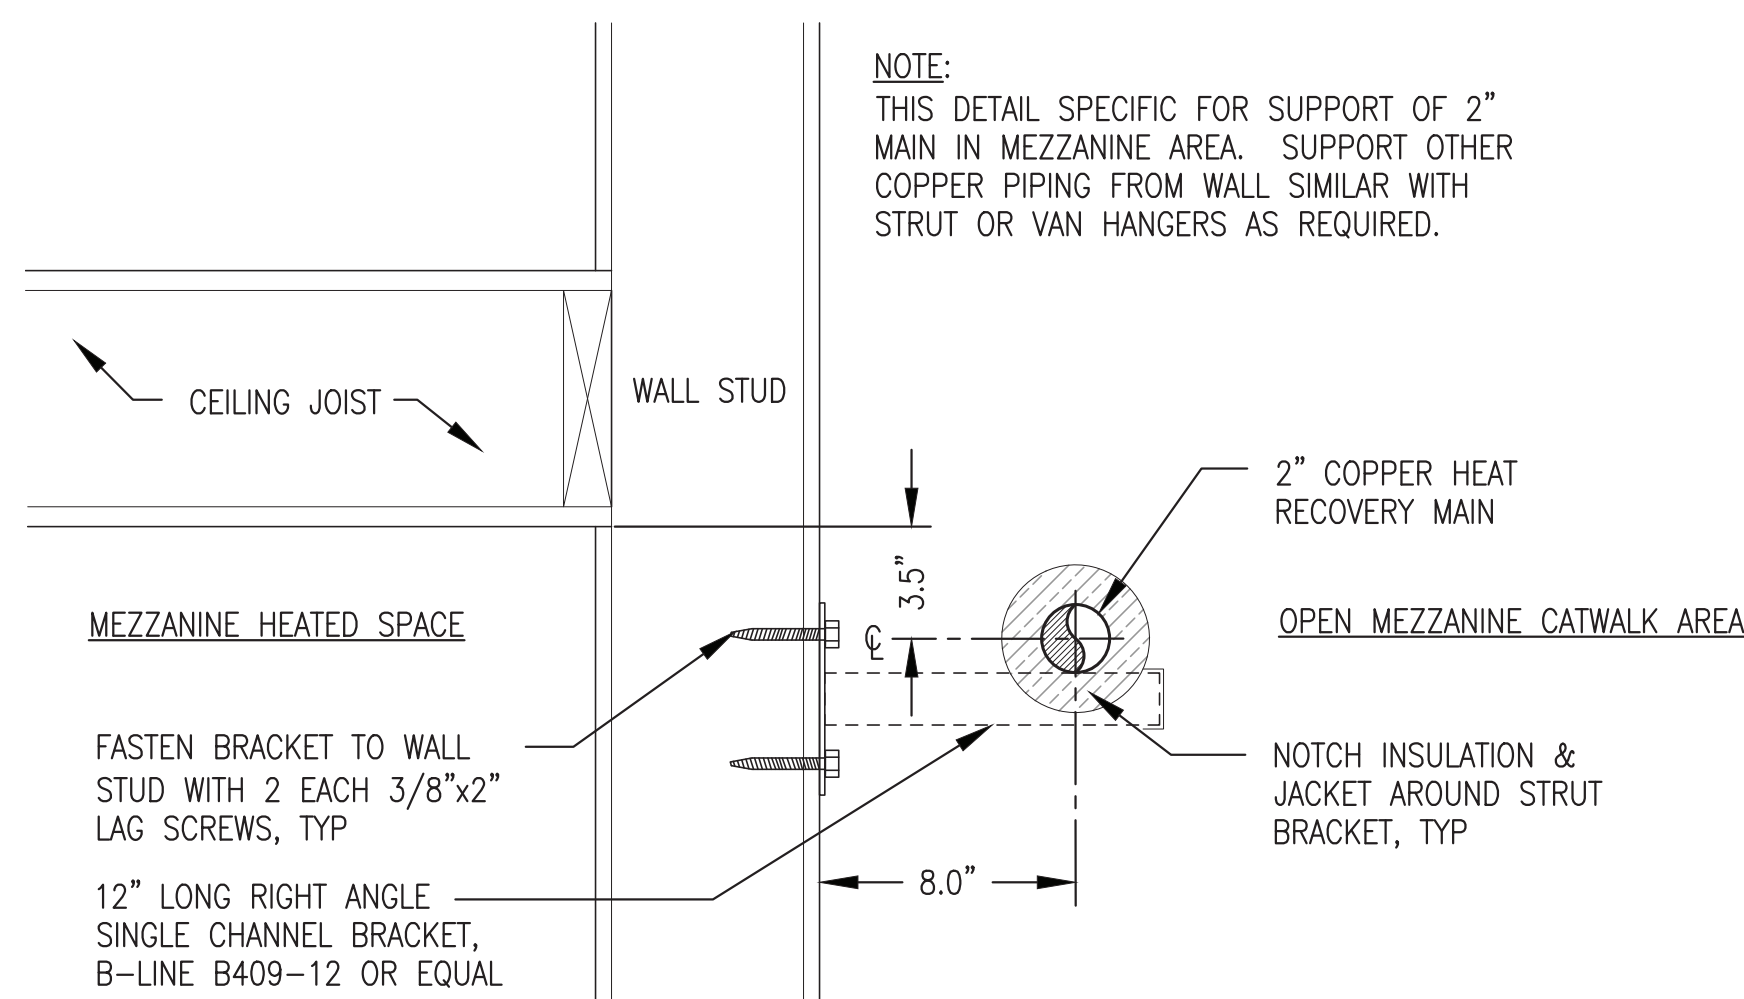


**3** TYPICAL PIPE SUPPORT FROM MEZZANINE WALL  
M8.5 NO SCALE

ALL WORK THIS SHEET IS INCLUDED IN THE ON SITE CONTRACT UNDER ADDITIVE ALTERNATE #1.

ISSUED FOR CONSTRUCTION  
MAY 2023




PROJECT: NELSON LAGOON POWER SYSTEM UPGRADE		
TITLE: HEAT RECOVERY SYSTEM STORAGE COMPOUND PIPING ISOMETRIC & DETAILS		
DRAWN BY: JTD	SCALE: AS NOTED	DESIGNED BY: BCG
FILE NAME: NELS PP M8	SHEET:	
PROJECT NUMBER:		<b>M8.5</b>
P.O. 111405, Anchorage, AK 99511 (907)349-0100		

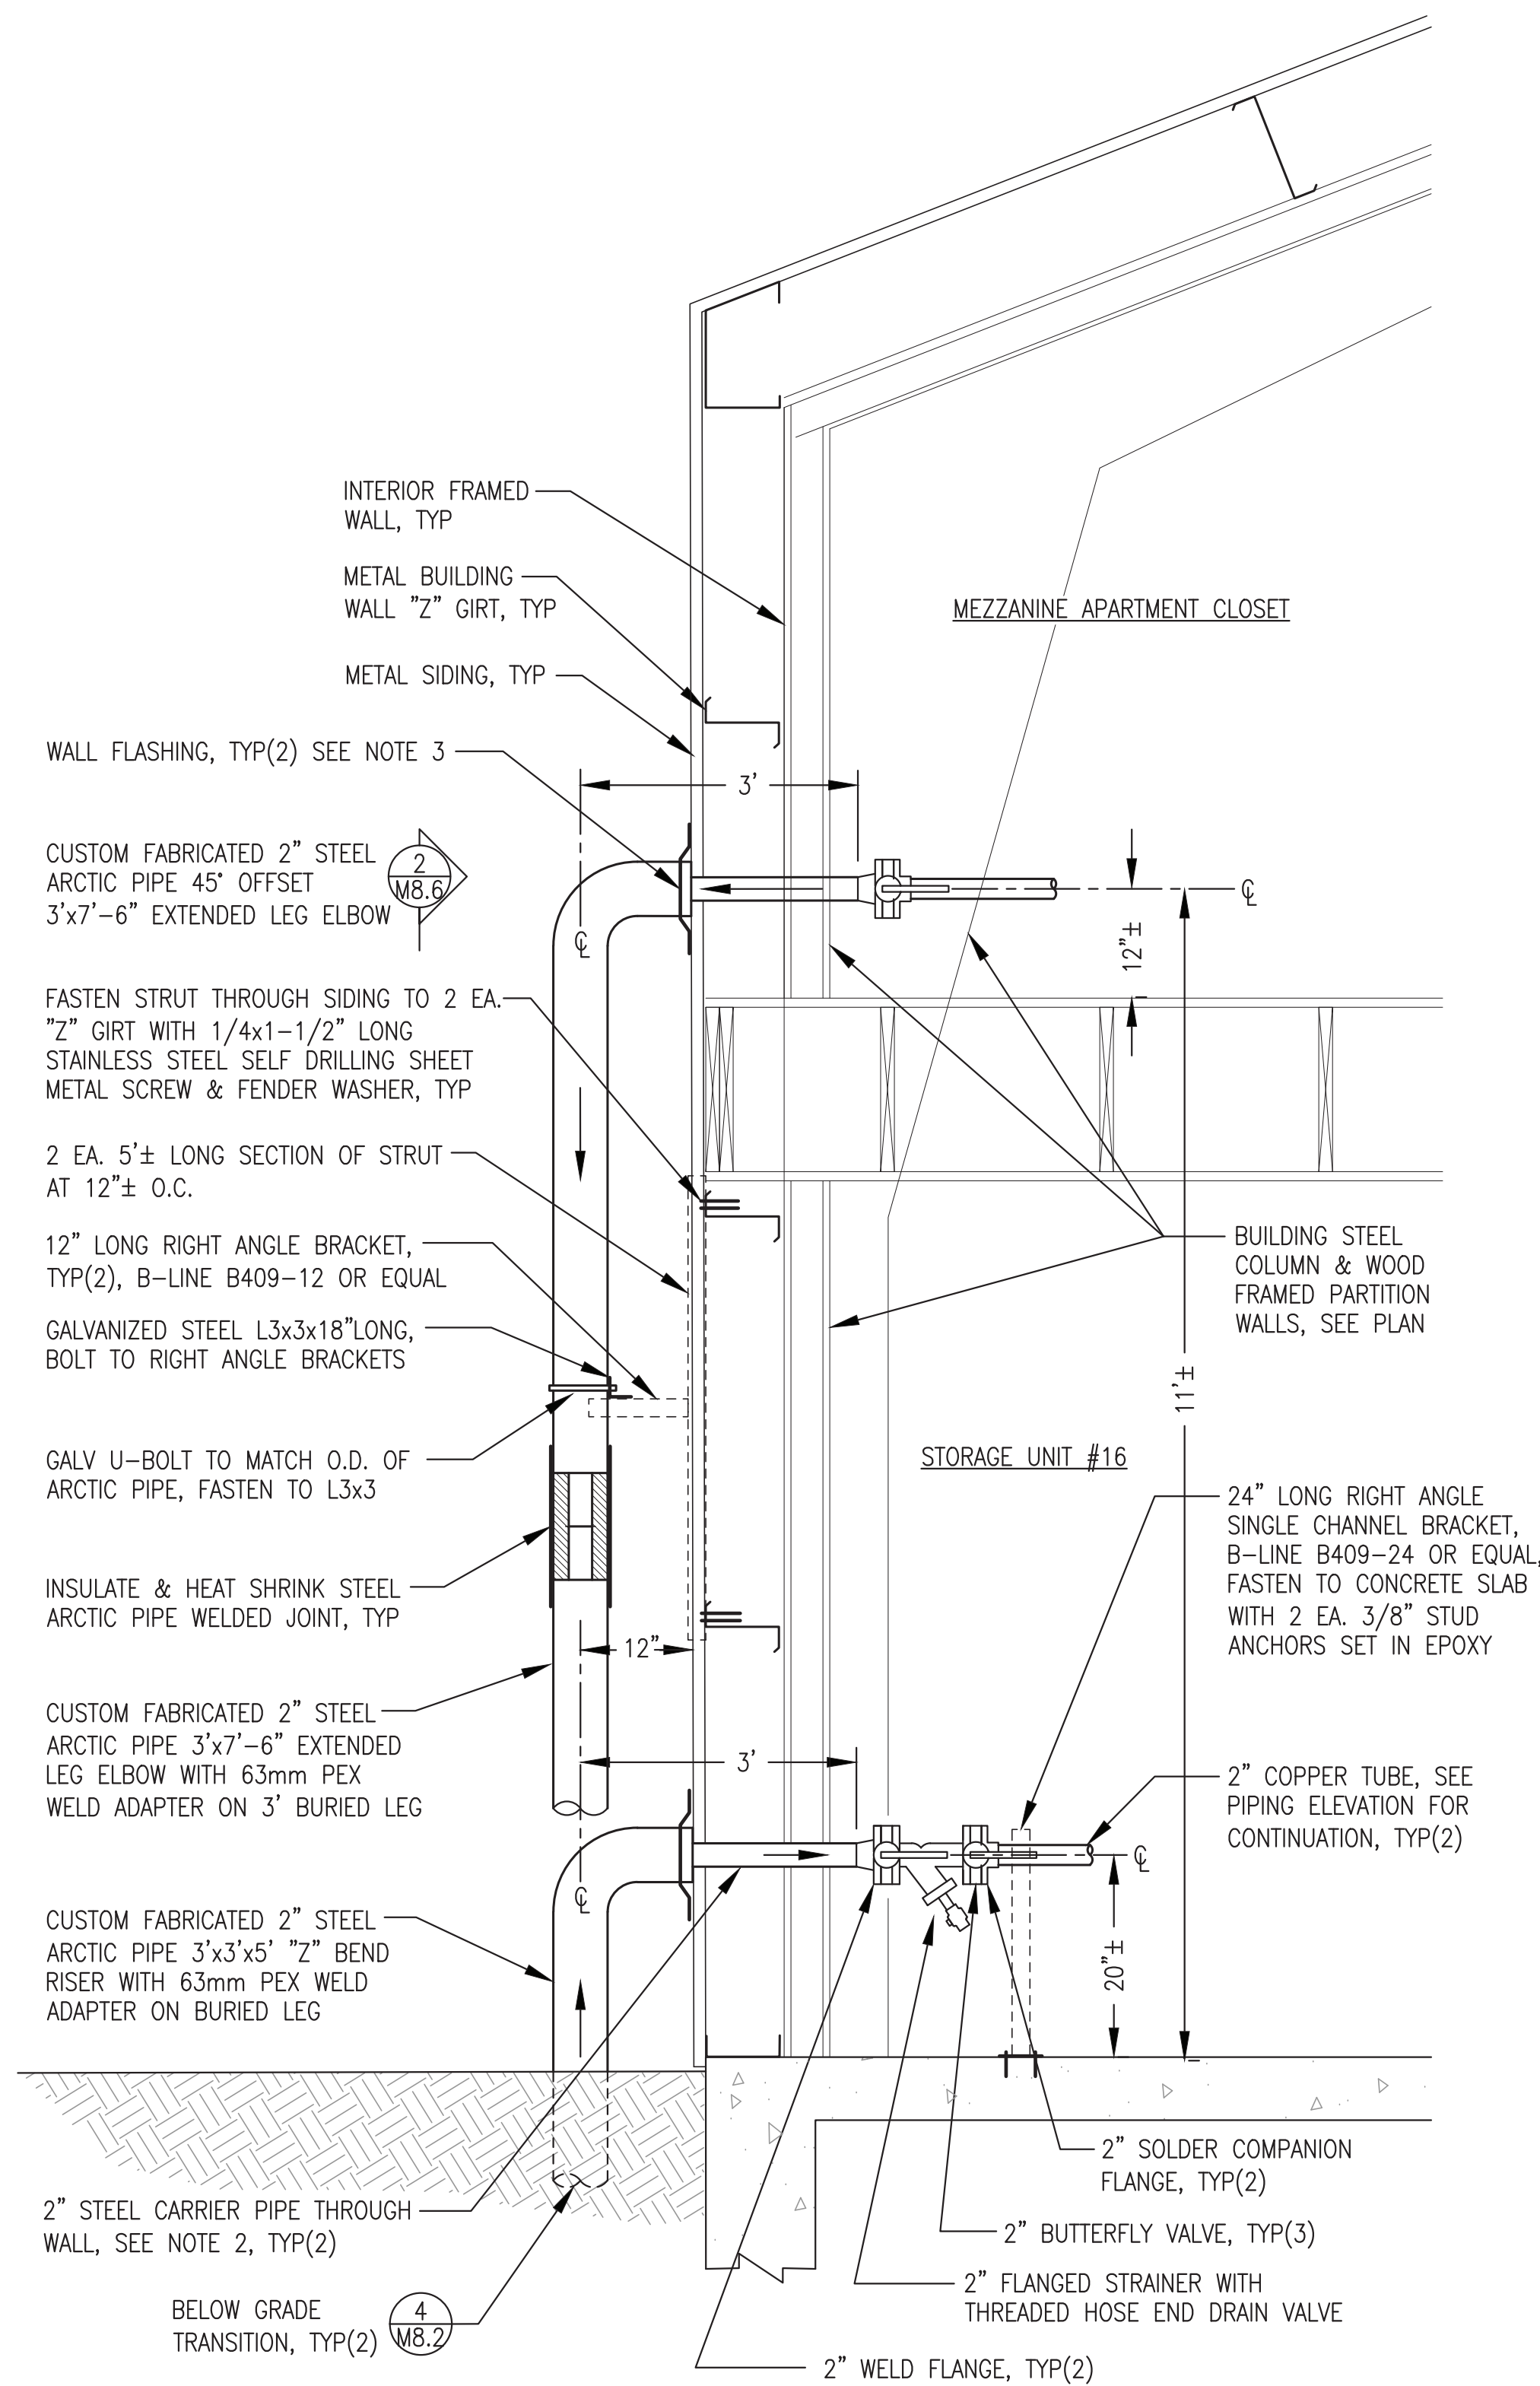


- NOTES:**
- 1) HEAT RECOVERY ARCTIC PIPE SUPPLY AND RETURN ENTRANCES ON OPPOSITE SIDES OF PARTITION WALL AND MOMENT FRAME (STEEL COLUMN), SEE PLAN M8.4.
  - 2) HOLE SAW 3"Ø THROUGH SIDING AND INTERIOR PARTITION WALL. TRIM ARCTIC PIPE JACKET AT EXTERIOR WALL SIDING EXTEND 2" STEEL PIPE THROUGH WALL. CENTER PIPE IN HOLE AND SEAL ALL AROUND INTERIOR WITH POLYURETHANE CAULK.
  - 3) INSTALL FLASHING OVER ARCTIC PIPE JACKET. SEAL TO SIDING WITH POLYURETHANE CAULKING AND FASTEN WITH STAINLESS STEEL SHEET METAL SCREWS ALL AROUND.


**1** STORAGE COMPOUND HEAT RECOVERY ARCTIC PIPE ENTRANCE  
M8.6 NO SCALE

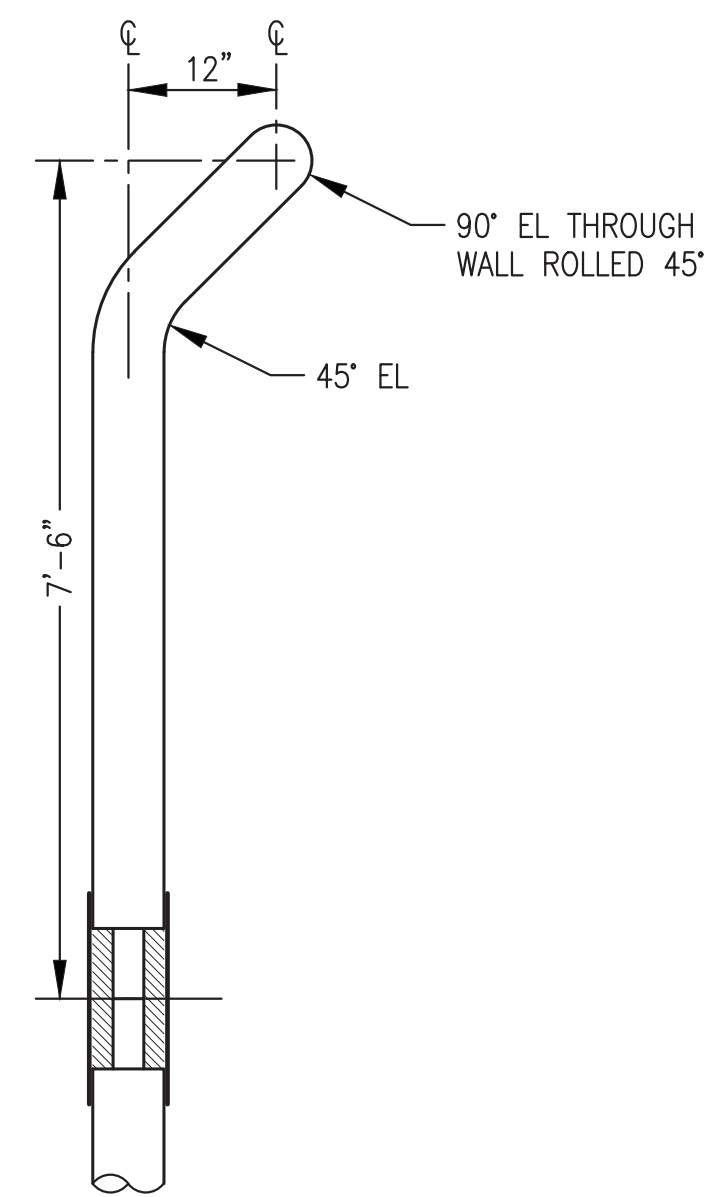

**2** ARCTIC PIPE 45° OFFSET EXTENDED LEG ELBOW  
M8.6 NO SCALE

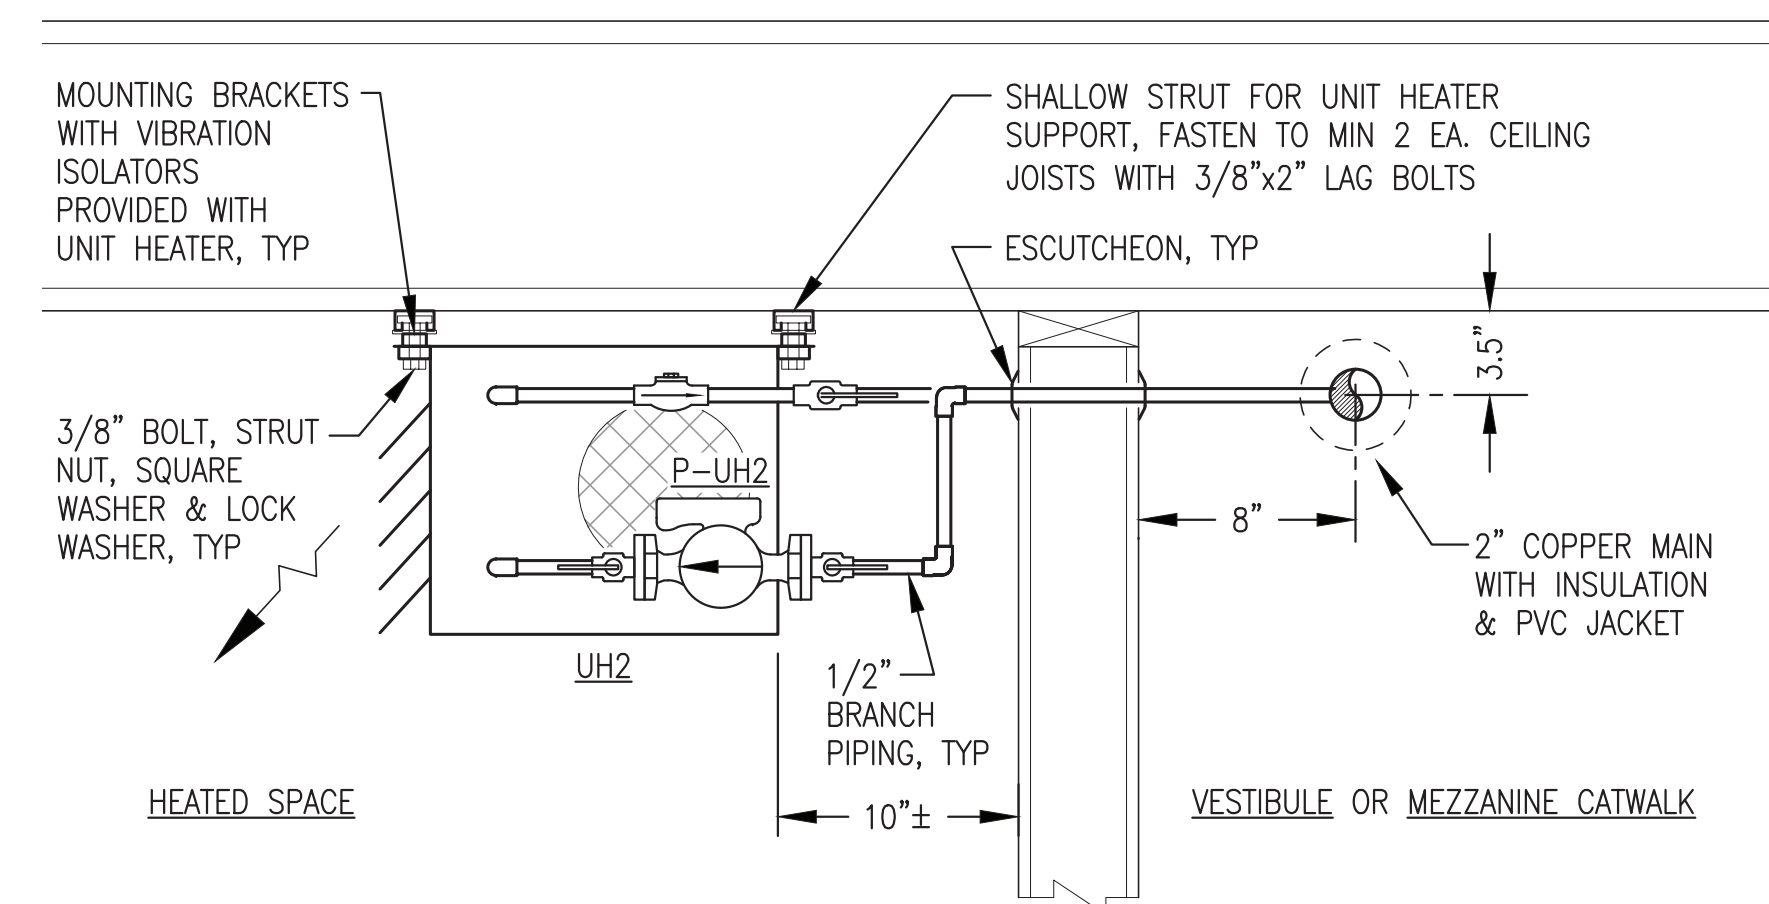

**4** TYPICAL UNIT HEATER UH-2 CEILING MOUNT INSTALLATION  
M8.6 1-1/2"=1'-0"

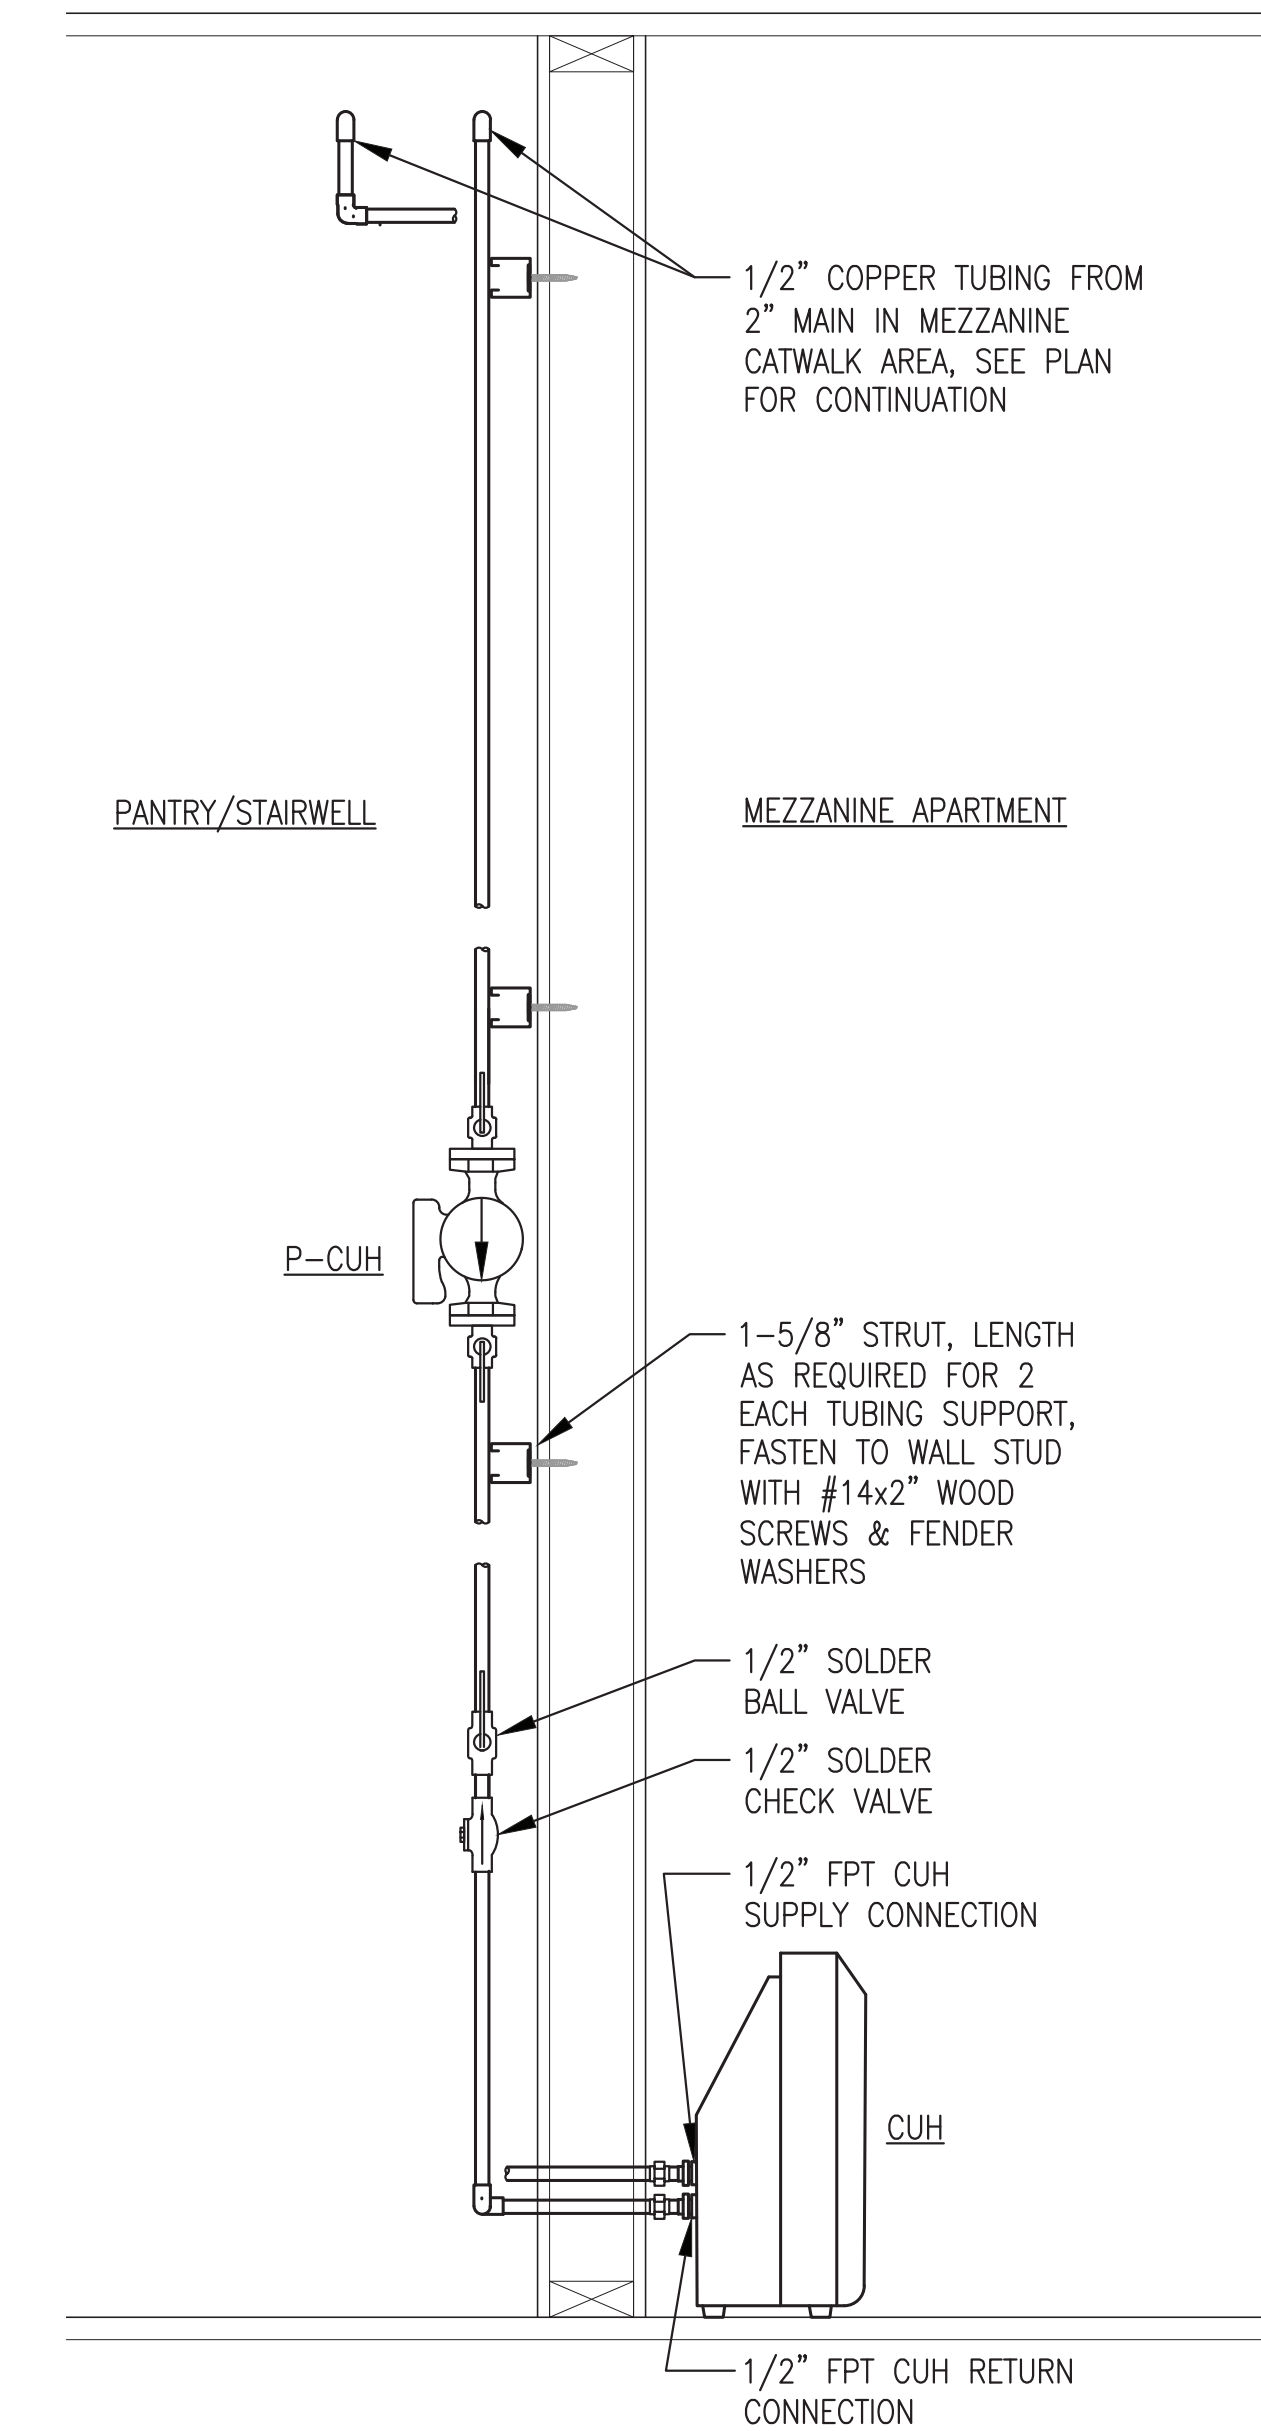

**3** APARTMENT CABINET UNIT HEATER INSTALLATION  
M8.6 1-1/2"=1'-0"



ALL WORK THIS SHEET IS INCLUDED IN THE ON SITE CONTRACT UNDER ADDITIVE ALTERNATE #1.

ISSUED FOR CONSTRUCTION  
MAY 2023




PROJECT: NELSON LAGOON POWER SYSTEM UPGRADE		
TITLE: HEAT RECOVERY SYSTEM STORAGE COMPOUND PIPING DETAILS		
DRAWN BY: JTD	SCALE: AS NOTED	DESIGNED BY: BCG
FILE NAME: NELS PP M8	DATE: 5/30/23	SHEET:
P.O. 111405, Anchorage, AK 99511 (907)349-0100	PROJECT NUMBER:	<b>M8.6</b>



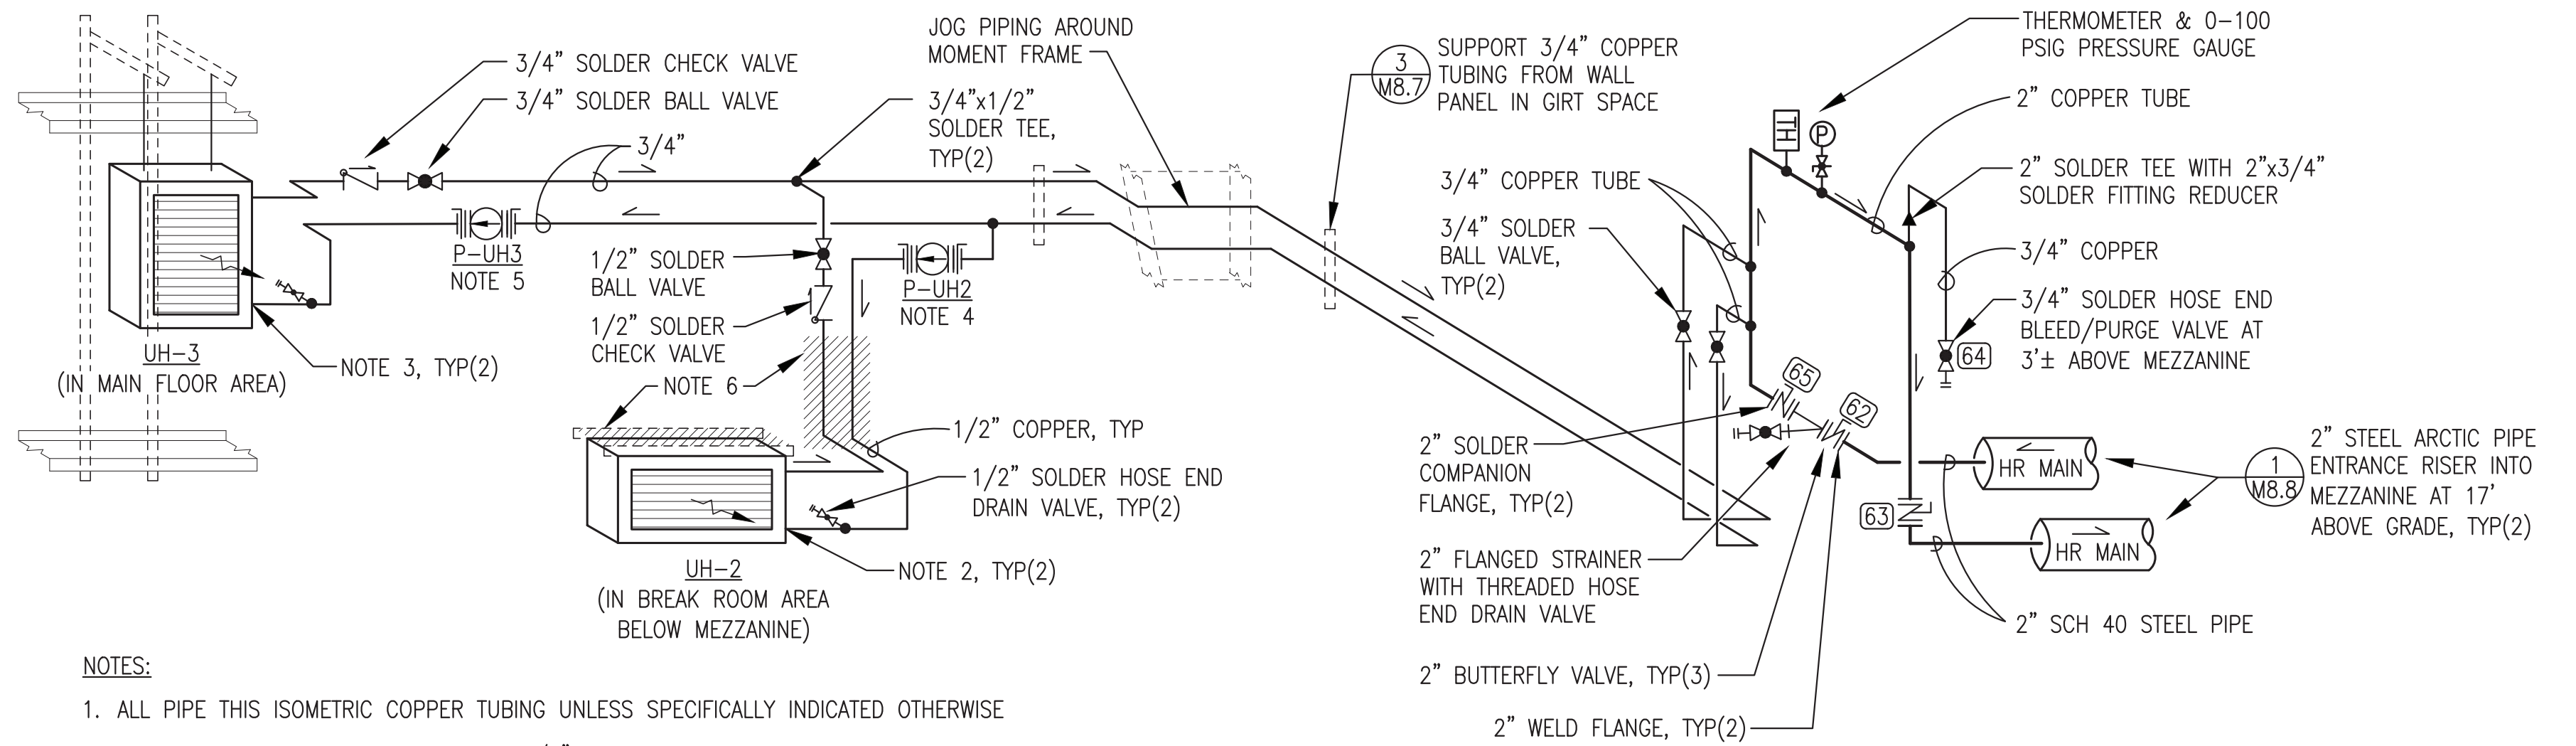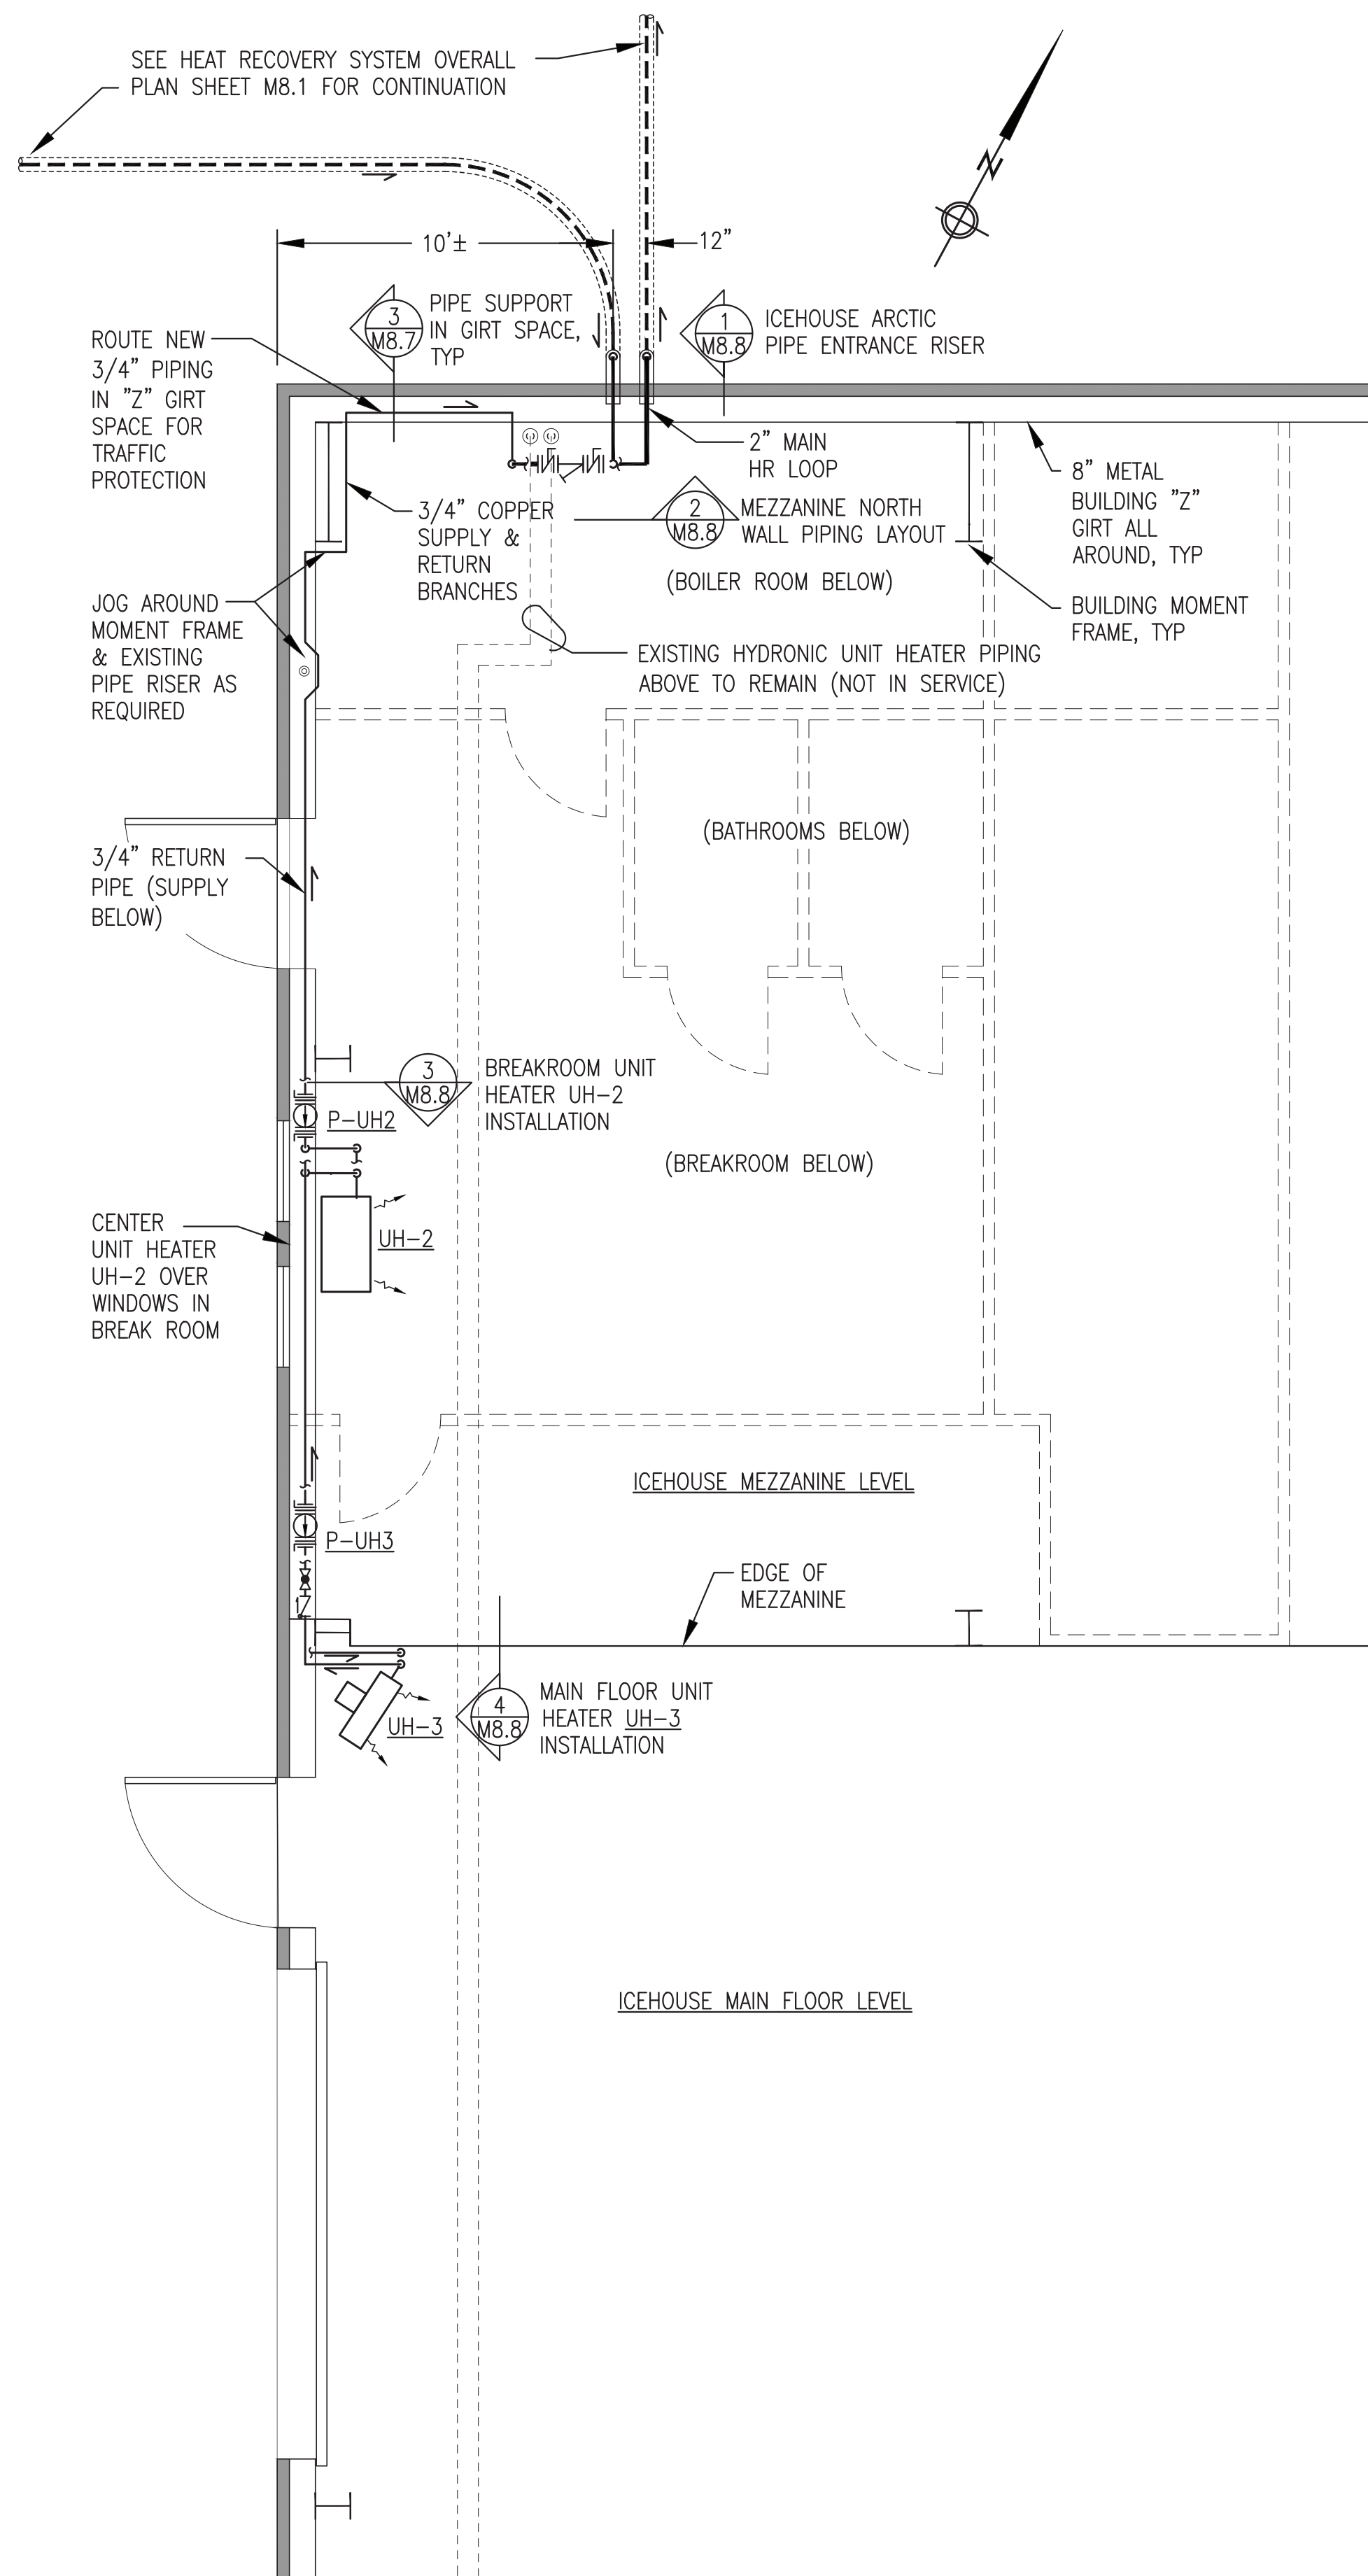

- NOTES:**
1. ALL PIPE THIS ISOMETRIC COPPER TUBING UNLESS SPECIFICALLY INDICATED OTHERWISE
  2. CONNECT TO UNIT HEATER UH-2 WITH 1/2" MPTXC ADAPTER.
  3. CONNECT TO UNIT HEATER UH-3 WITH 3/4" MPTXC ADAPTER.
  4. PUMP P-UH2 WITH 1/2" SOLDER SHUT-OFF FLANGES. SET TO SPEED 1.
  5. PUMP P-UH3 WITH 3/4" SOLDER SHUT-OFF FLANGES. SET TO SPEED 2.
  6. ROUTE 1/2" COPPER TUBE DOWN THROUGH MEZZANINE FLOOR IN GIRT SPACE BEHIND BREAK ROOM WALL AND FASTEN UH-2 TO BREAK ROOM CEILING STRUCTURE WITH SHALLOW STRUT. SEE DETAIL 3/M8.8.

**2** ICEHOUSE MEZZANINE HEAT RECOVERY PIPING ISOMETRIC  
NO SCALE

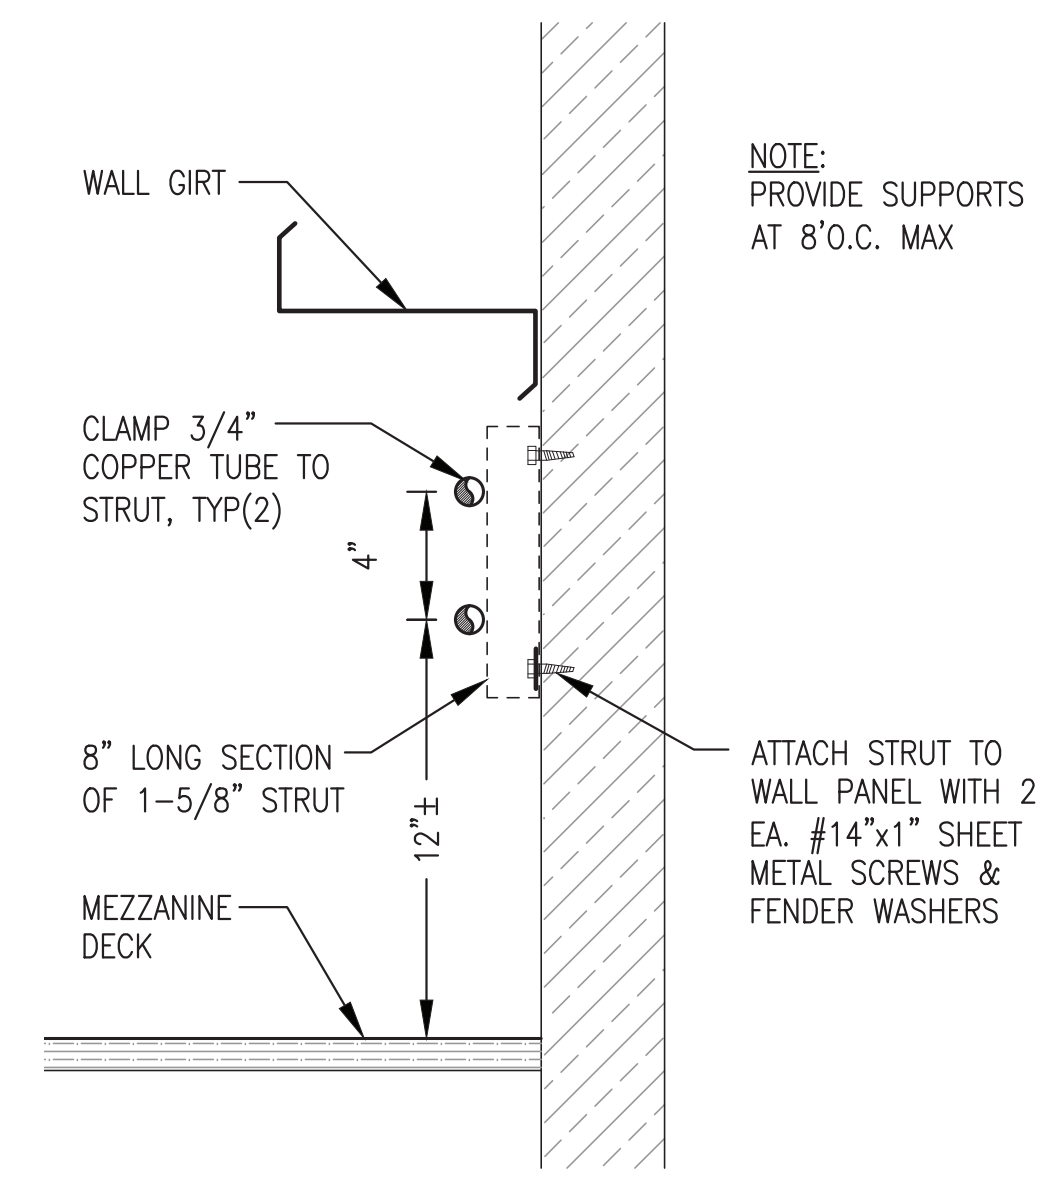


**3** 3/4" COPPER TUBING SUPPORT IN GIRT SPACE  
NO SCALE


- GENERAL NOTES:**
1. ALL PLANS AND ELEVATIONS THIS SHEET FOR GENERAL PIPING LAYOUT AND ARRANGEMENT ONLY. NOT ALL PIPE, FITTINGS, AND ACCESSORIES SHOWN FOR CLARITY, SEE PIPING ISOMETRIC THIS SHEET FOR ADDITIONAL DETAIL.
  2. ALL PIPING INSIDE BUILDING TYPE L COPPER TUBING, 2" MAINS, BRANCHES 1/2" AND 3/4" AS INDICATED.
  3. INSULATE ALL 2" MAIN PIPING WITH FIBERGLASS INSULATION WITH PVC JACKET. ALL BRANCH PIPING NOT INSULATED.


**ALL WORK THIS SHEET IS INCLUDED IN THE ON SITE CONTRACT UNDER ADDITIVE ALTERNATE #1.**

**1** ICEHOUSE HEAT RECOVERY PLAN  
1/4"=1'-0"

ISSUED FOR CONSTRUCTION  
MAY 2023

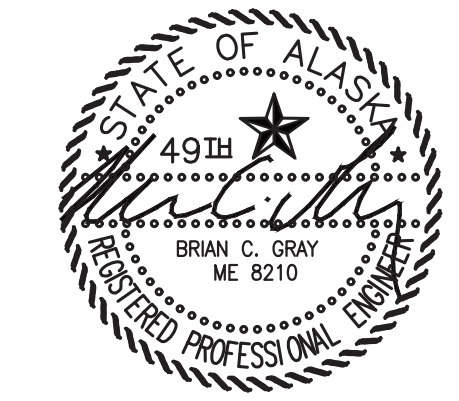


 ALASKA ENERGY AUTHORITY		
PROJECT: NELSON LAGOON POWER SYSTEM UPGRADE		
TITLE: HEAT RECOVERY SYSTEM ICEHOUSE PLAN, PIPING ISOMETRIC, & DETAILS		
DESIGNED BY: BCG	DATE: 5/30/23	SCALE: AS NOTED
DRAWN BY: JTD	FILE NAME: NELS PP M8	SHEET: M8.7
PROJECT NUMBER: P.O. 111405, Anchorage, AK 99511 (907)349-0100		

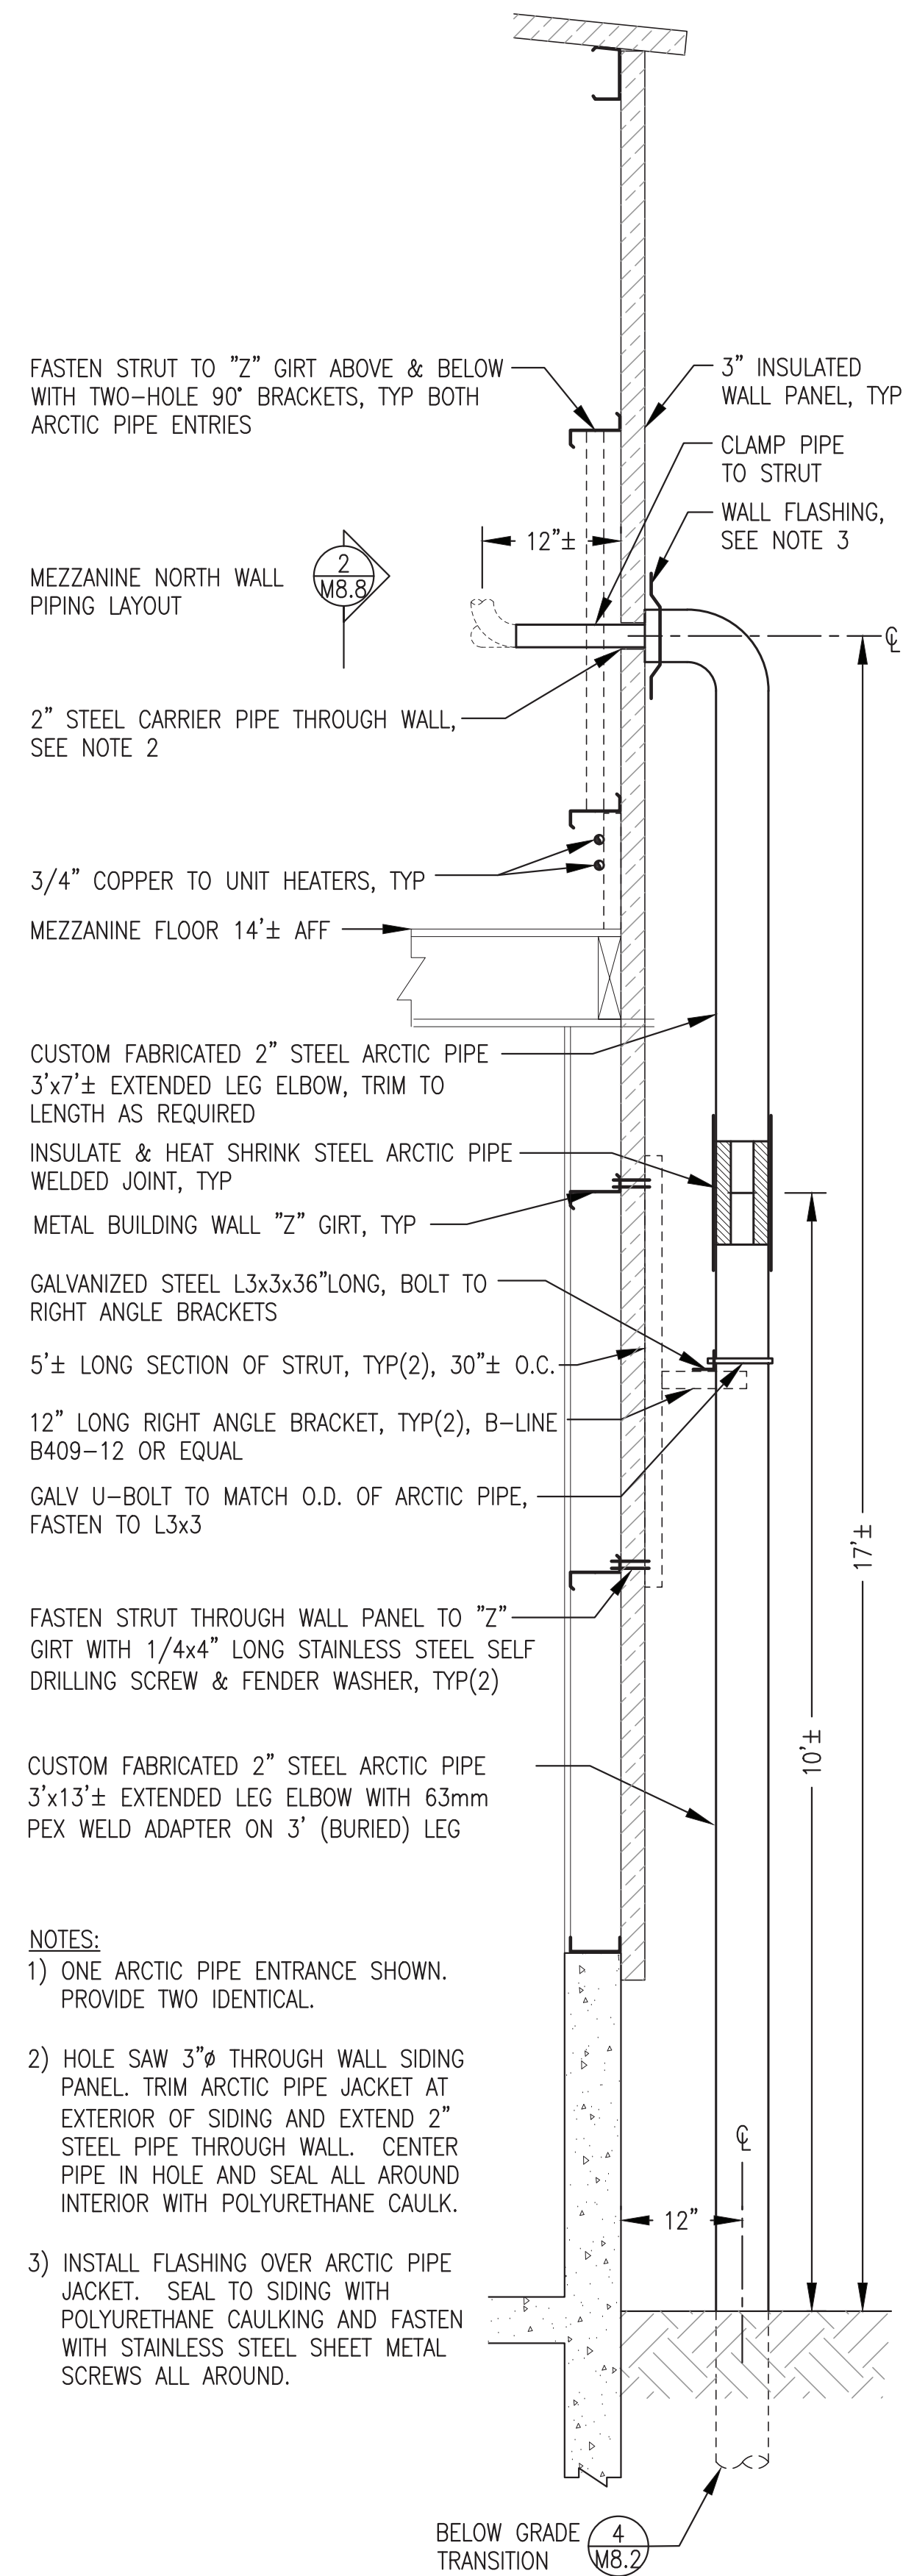


**1** ICEHOUSE ARCTIC PIPE ENTRANCE RISER  
M8.8 NO SCALE


- NOTES:
- ONE ARCTIC PIPE ENTRANCE SHOWN. PROVIDE TWO IDENTICAL.
  - HOLE SAW 3"Ø THROUGH WALL SIDING PANEL. TRIM ARCTIC PIPE JACKET AT EXTERIOR OF SIDING AND EXTEND 2" STEEL PIPE THROUGH WALL. CENTER PIPE IN HOLE AND SEAL ALL AROUND INTERIOR WITH POLYURETHANE CAULK.
  - INSTALL FLASHING OVER ARCTIC PIPE JACKET. SEAL TO SIDING WITH POLYURETHANE CAULKING AND FASTEN WITH STAINLESS STEEL SHEET METAL SCREWS ALL AROUND.

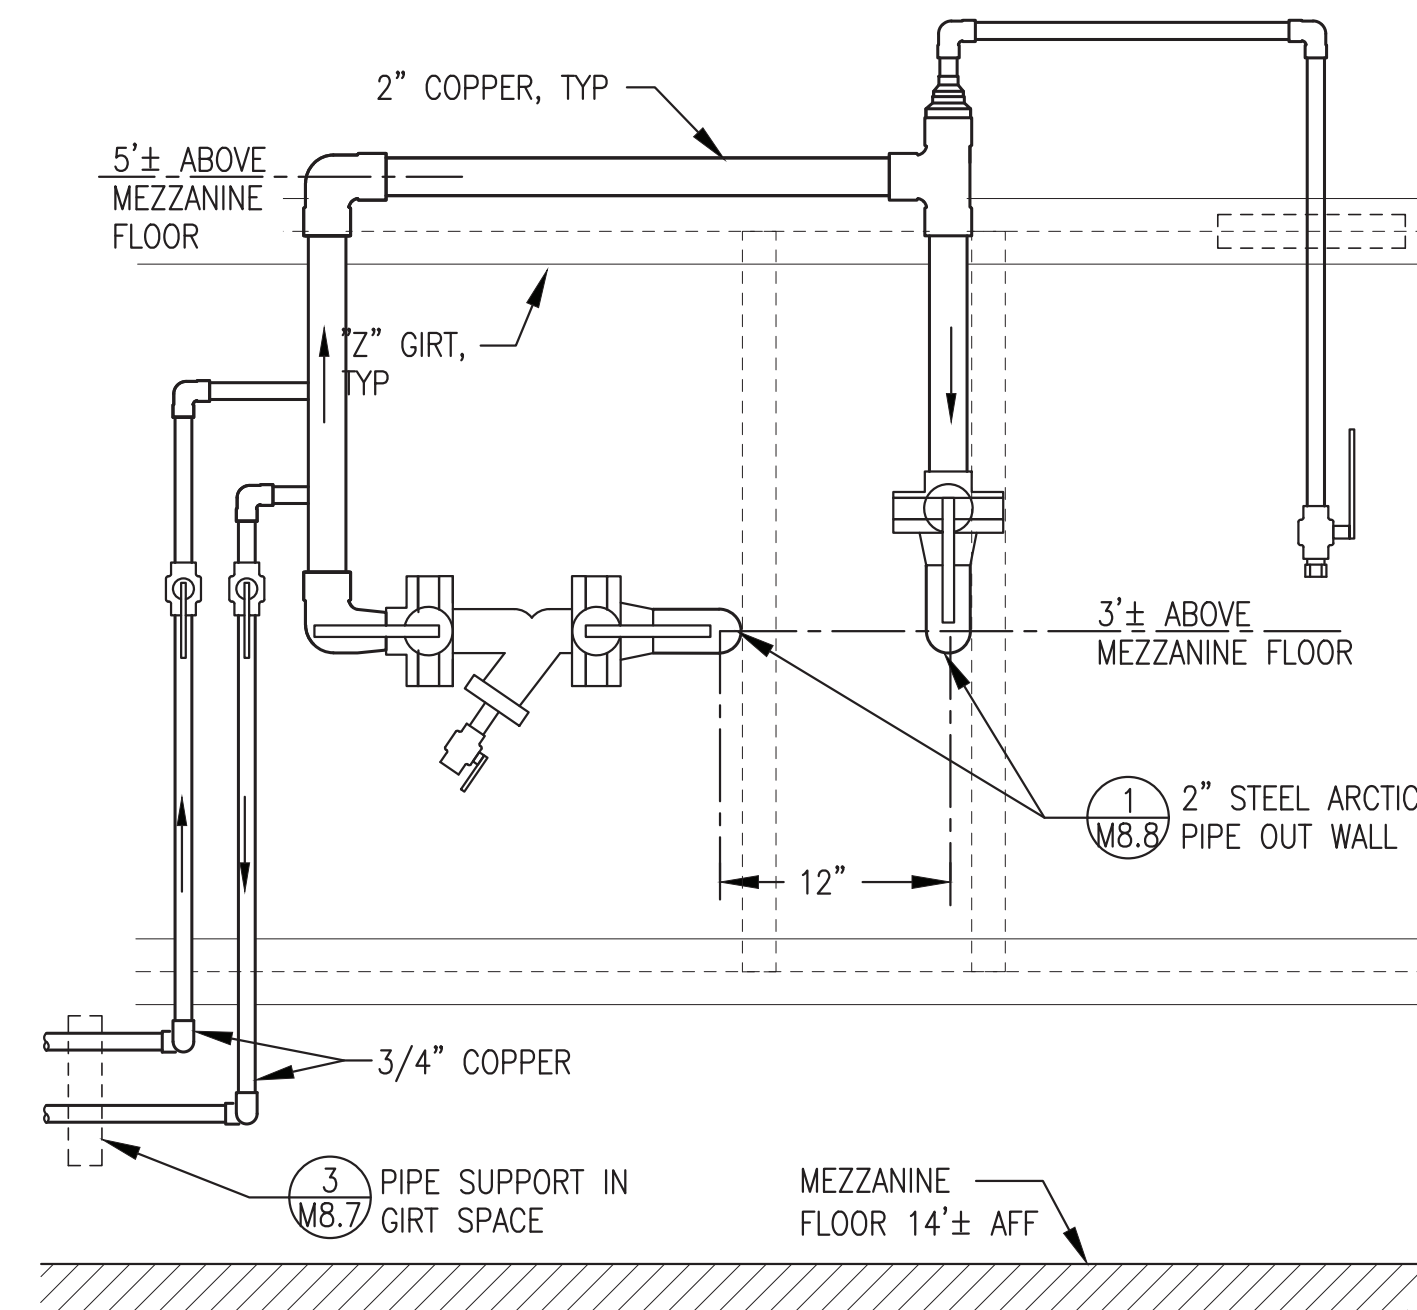


**2** MEZZANINE NORTH WALL PIPING LAYOUT  
M8.8 NO SCALE

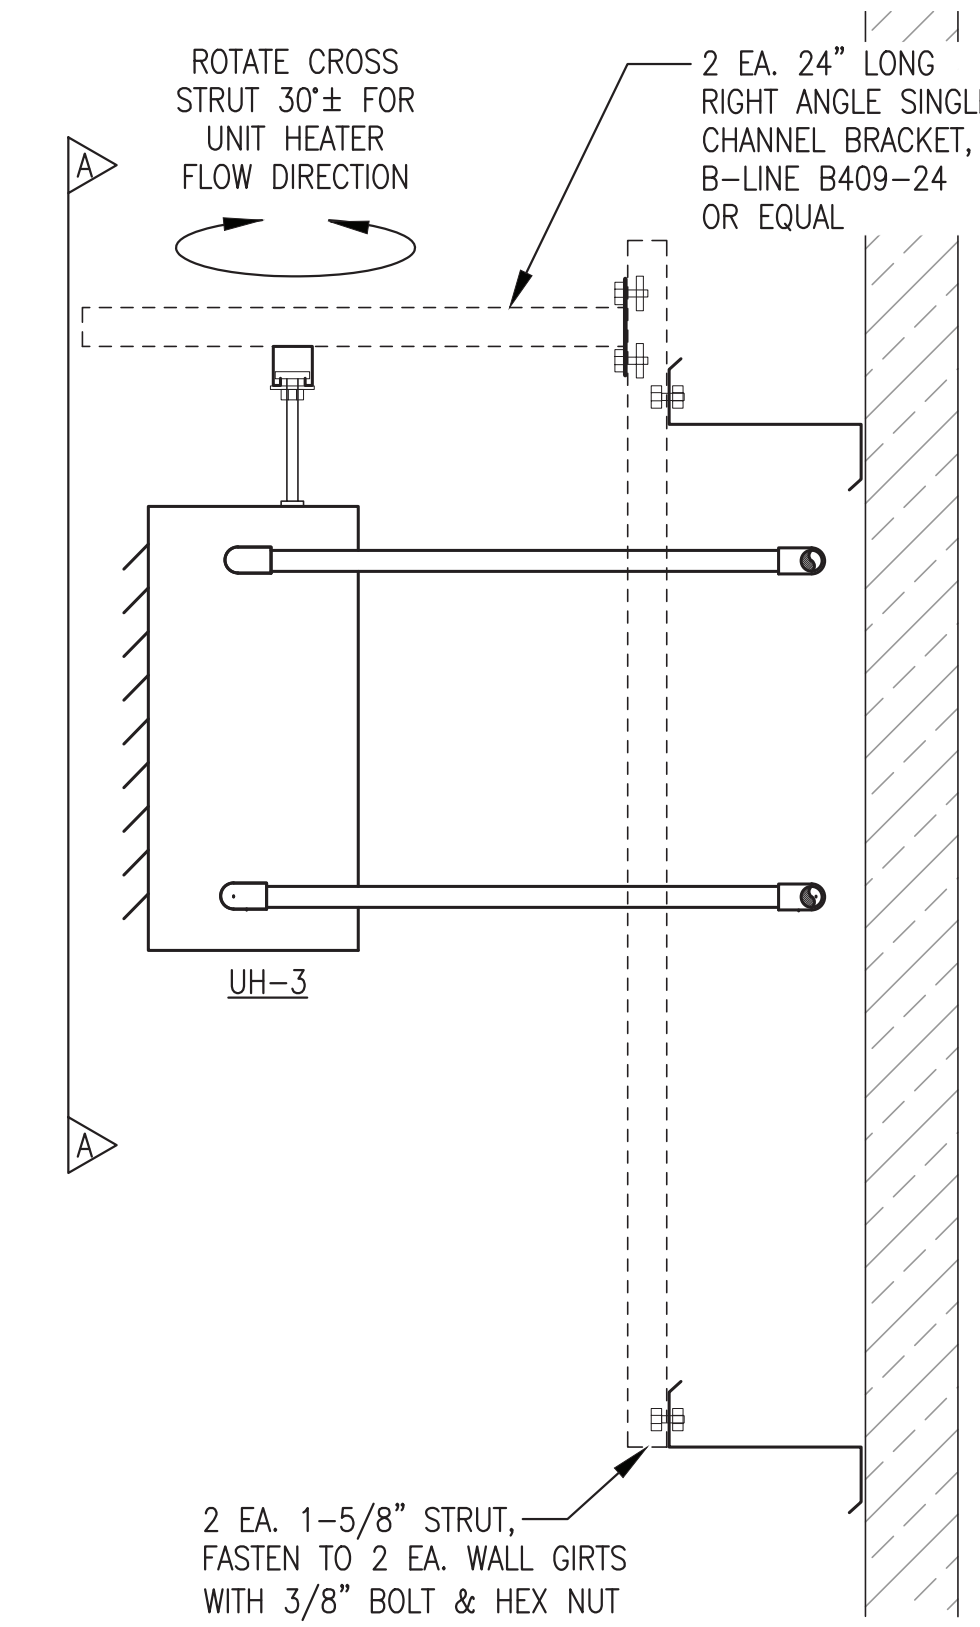

**4** UNIT HEATER UH-3 INSTALLATION  
M8.8 1-1/2"=1'-0"

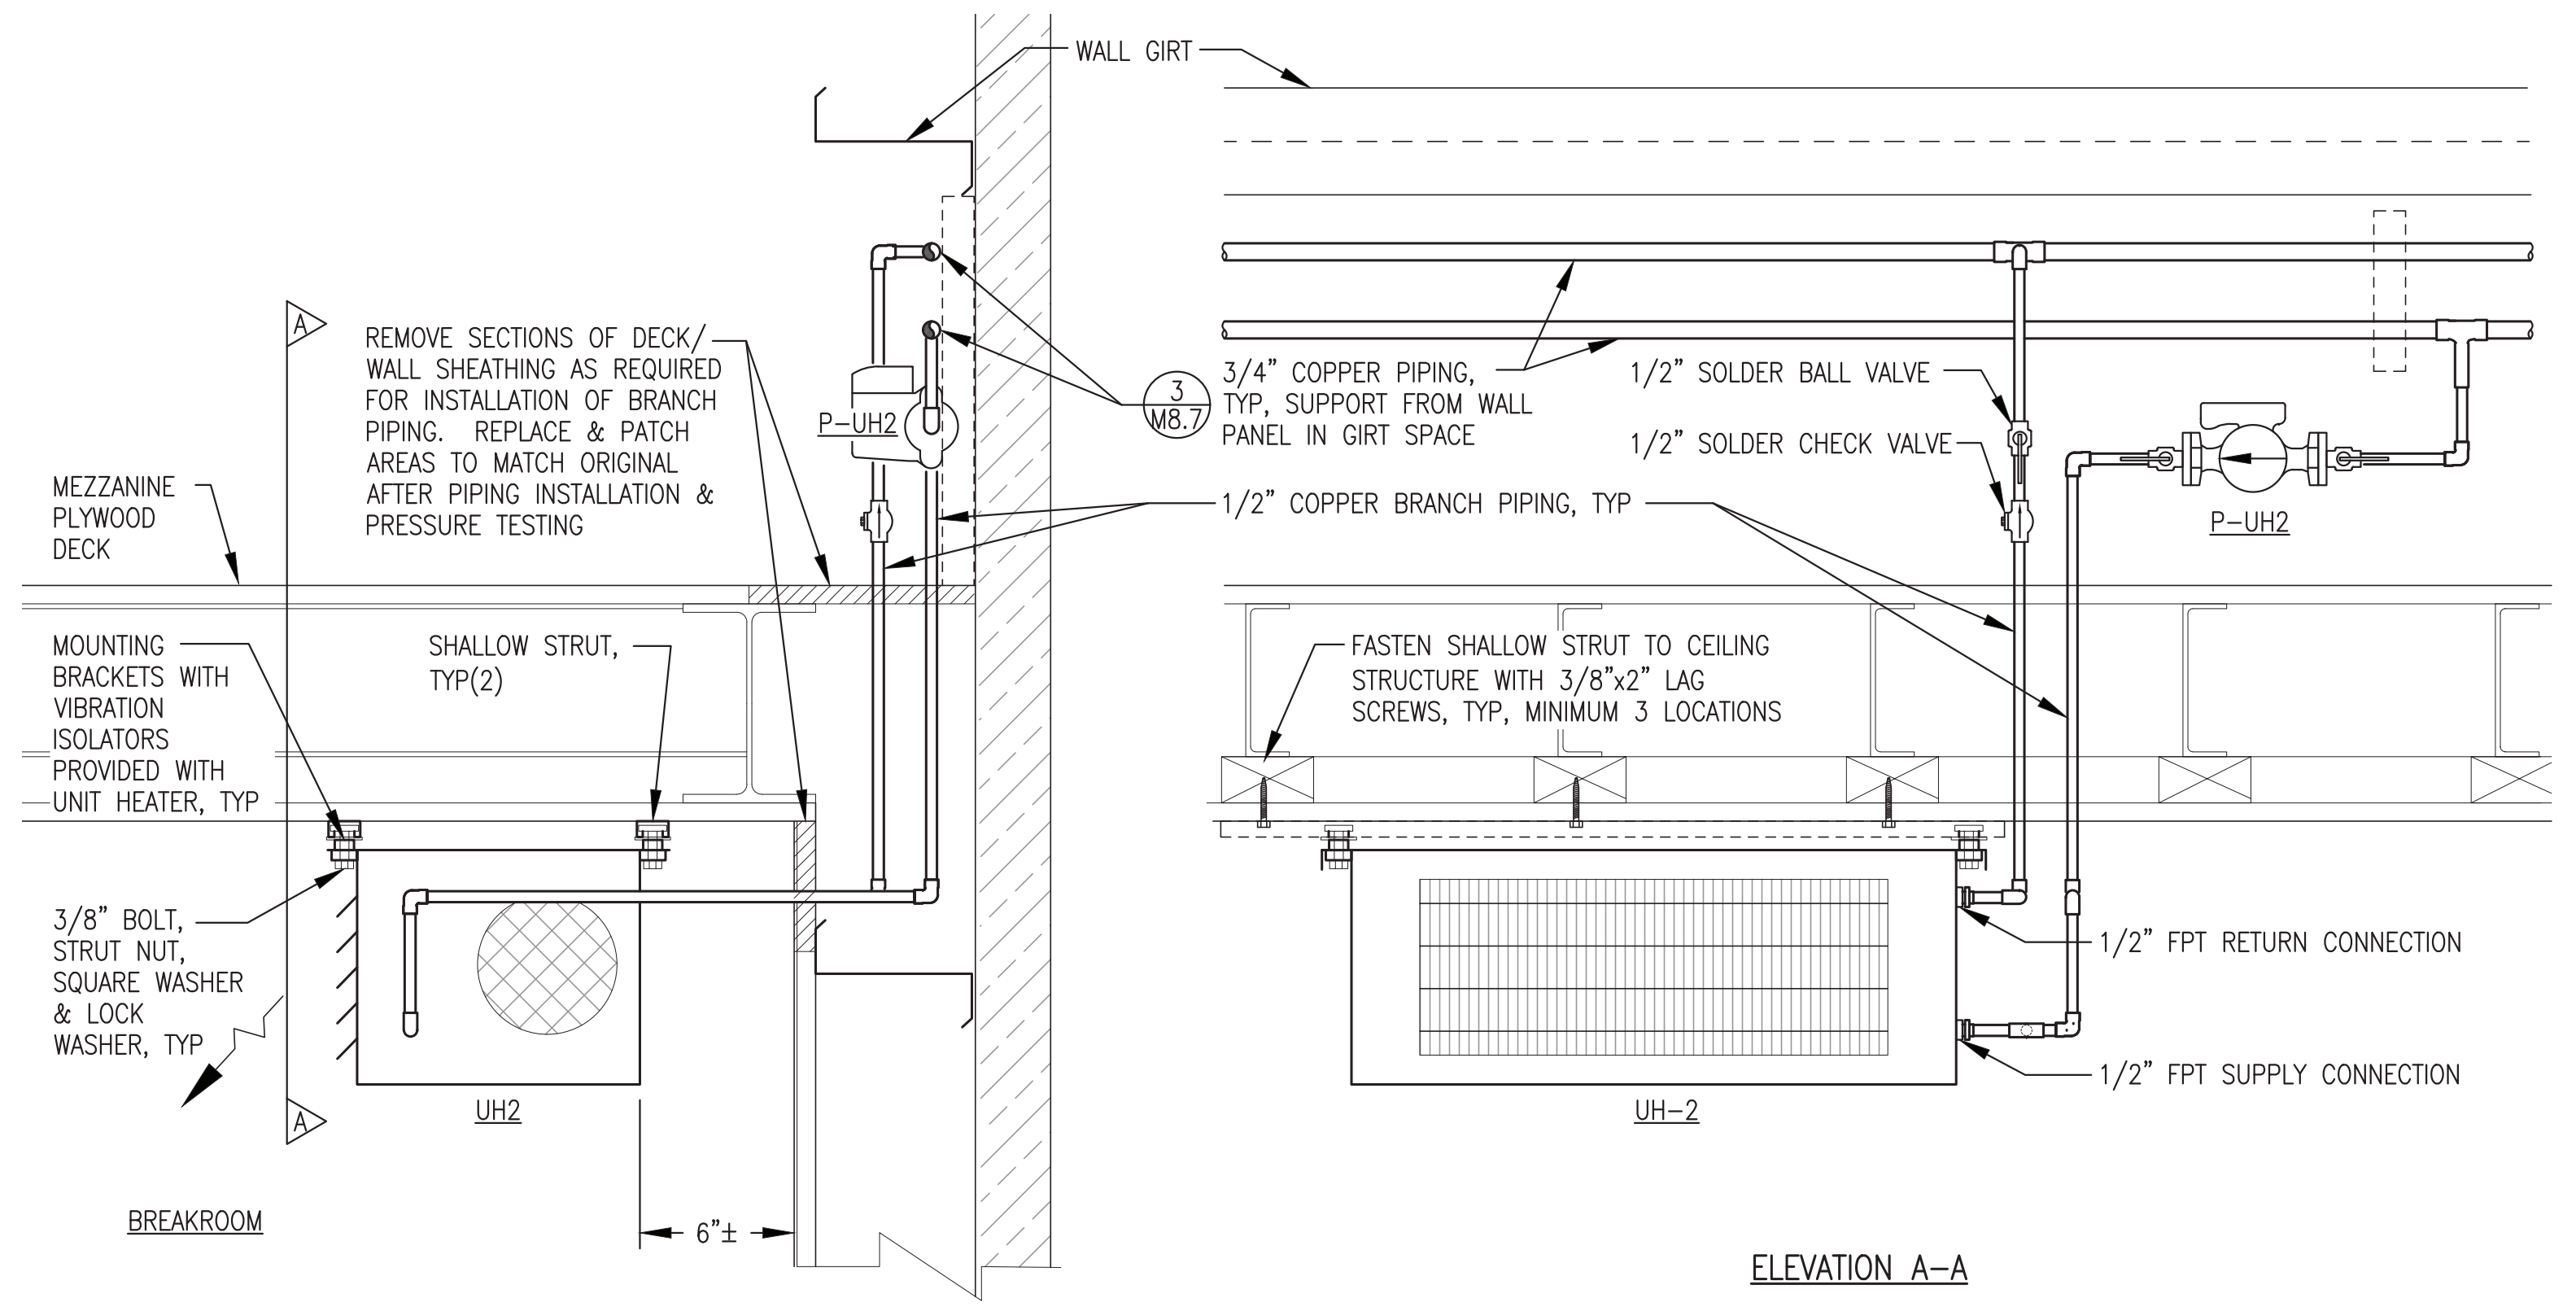

**3** BREAKROOM UNIT HEATER UH-2 INSTALLATION  
M8.8 1-1/2"=1'-0"

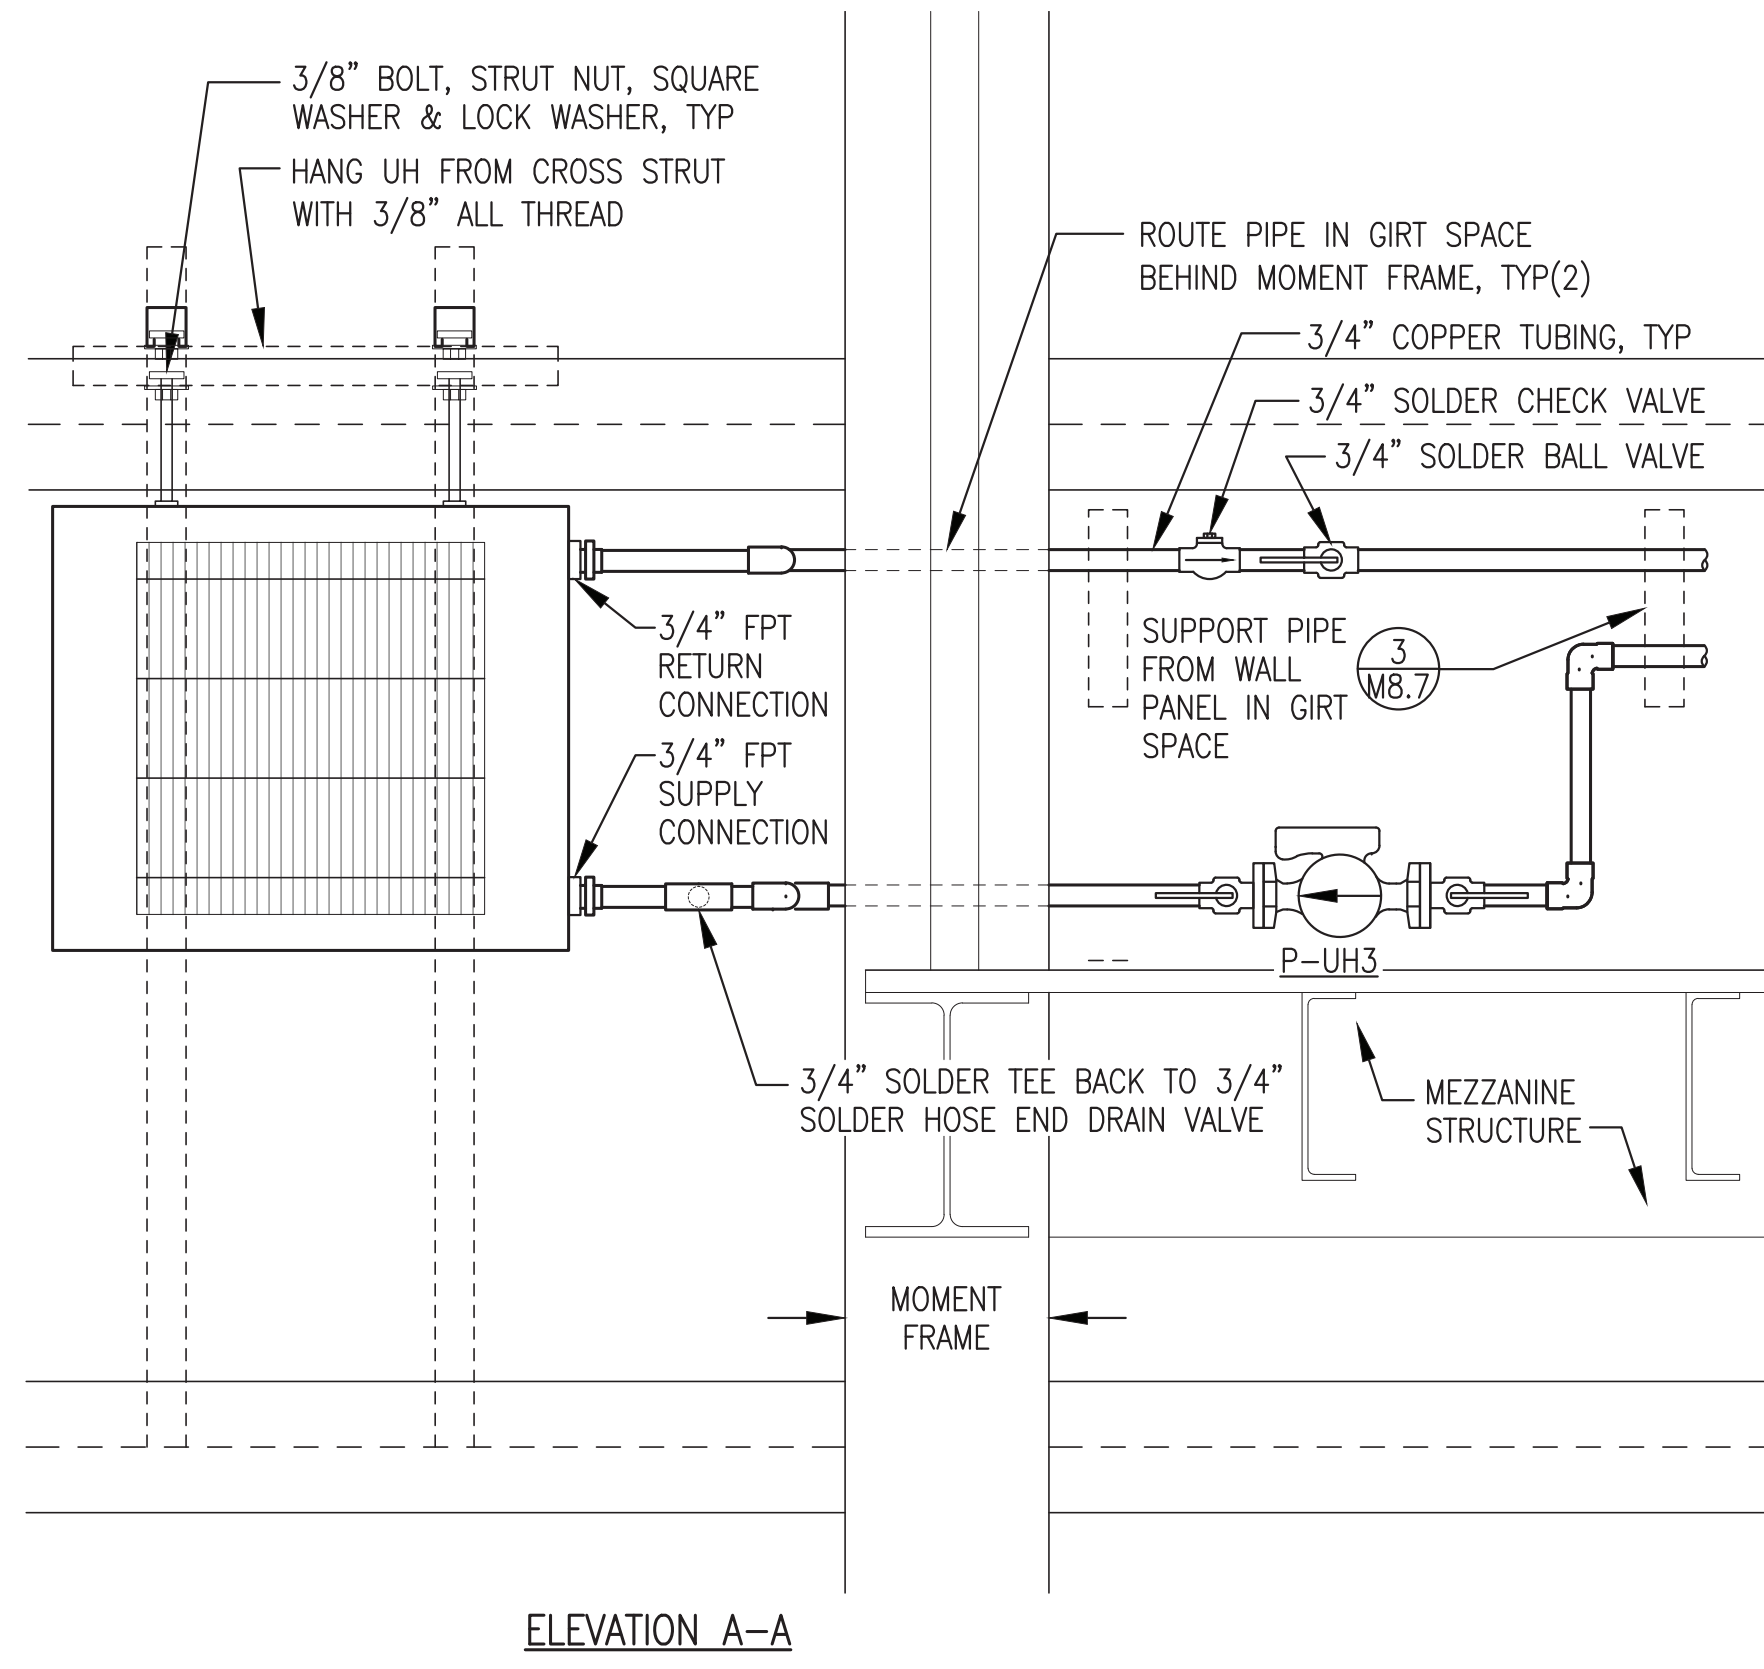


ELEVATION A-A

ALL WORK THIS SHEET IS INCLUDED IN THE ON SITE CONTRACT UNDER ADDITIVE ALTERNATE #1.


ISSUED FOR CONSTRUCTION  
MAY 2023



ALASKA ENERGY AUTHORITY		
PROJECT: NELSON LAGOON POWER SYSTEM UPGRADE		
TITLE: HEAT RECOVERY SYSTEM ICEHOUSE PIPING DETAILS		
DRAWN BY: JTD	SCALE: AS NOTED	DESIGNED BY: BCG
FILE NAME: NELS PP M8	SHEET: M8.8	PROJECT NUMBER:
P.O. 111405, Anchorage, AK 99511 (907)349-0100		

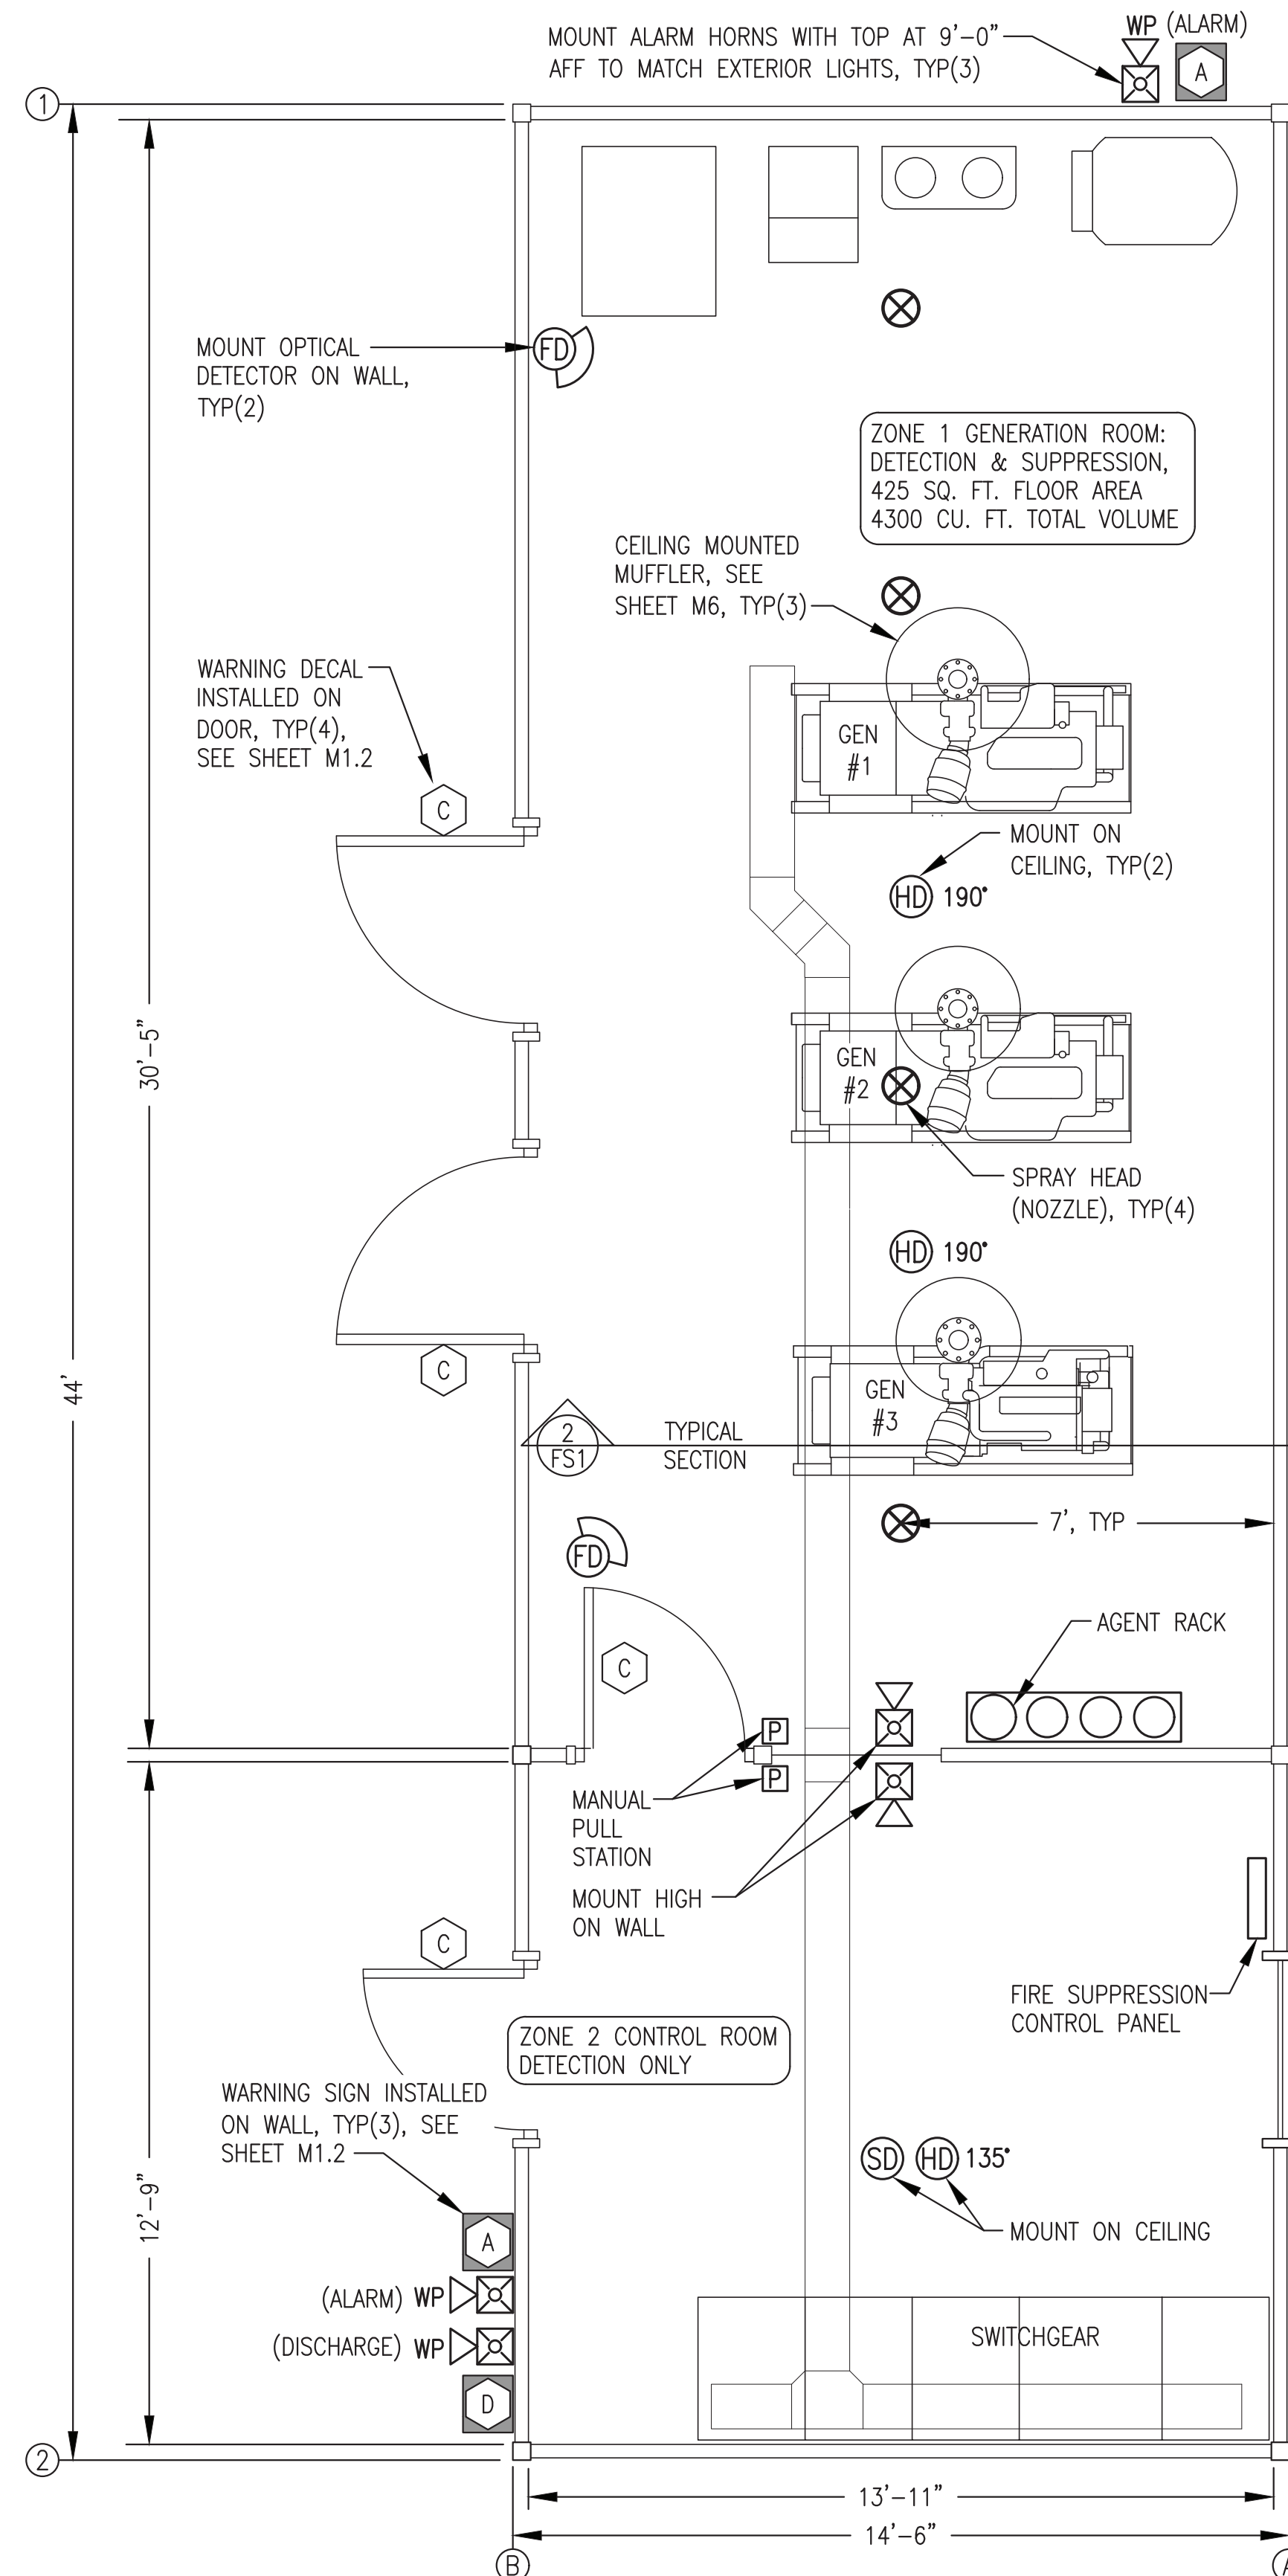

**1** FIRE SUPPRESSION SYSTEM PLAN  
3/8"=1'-0"

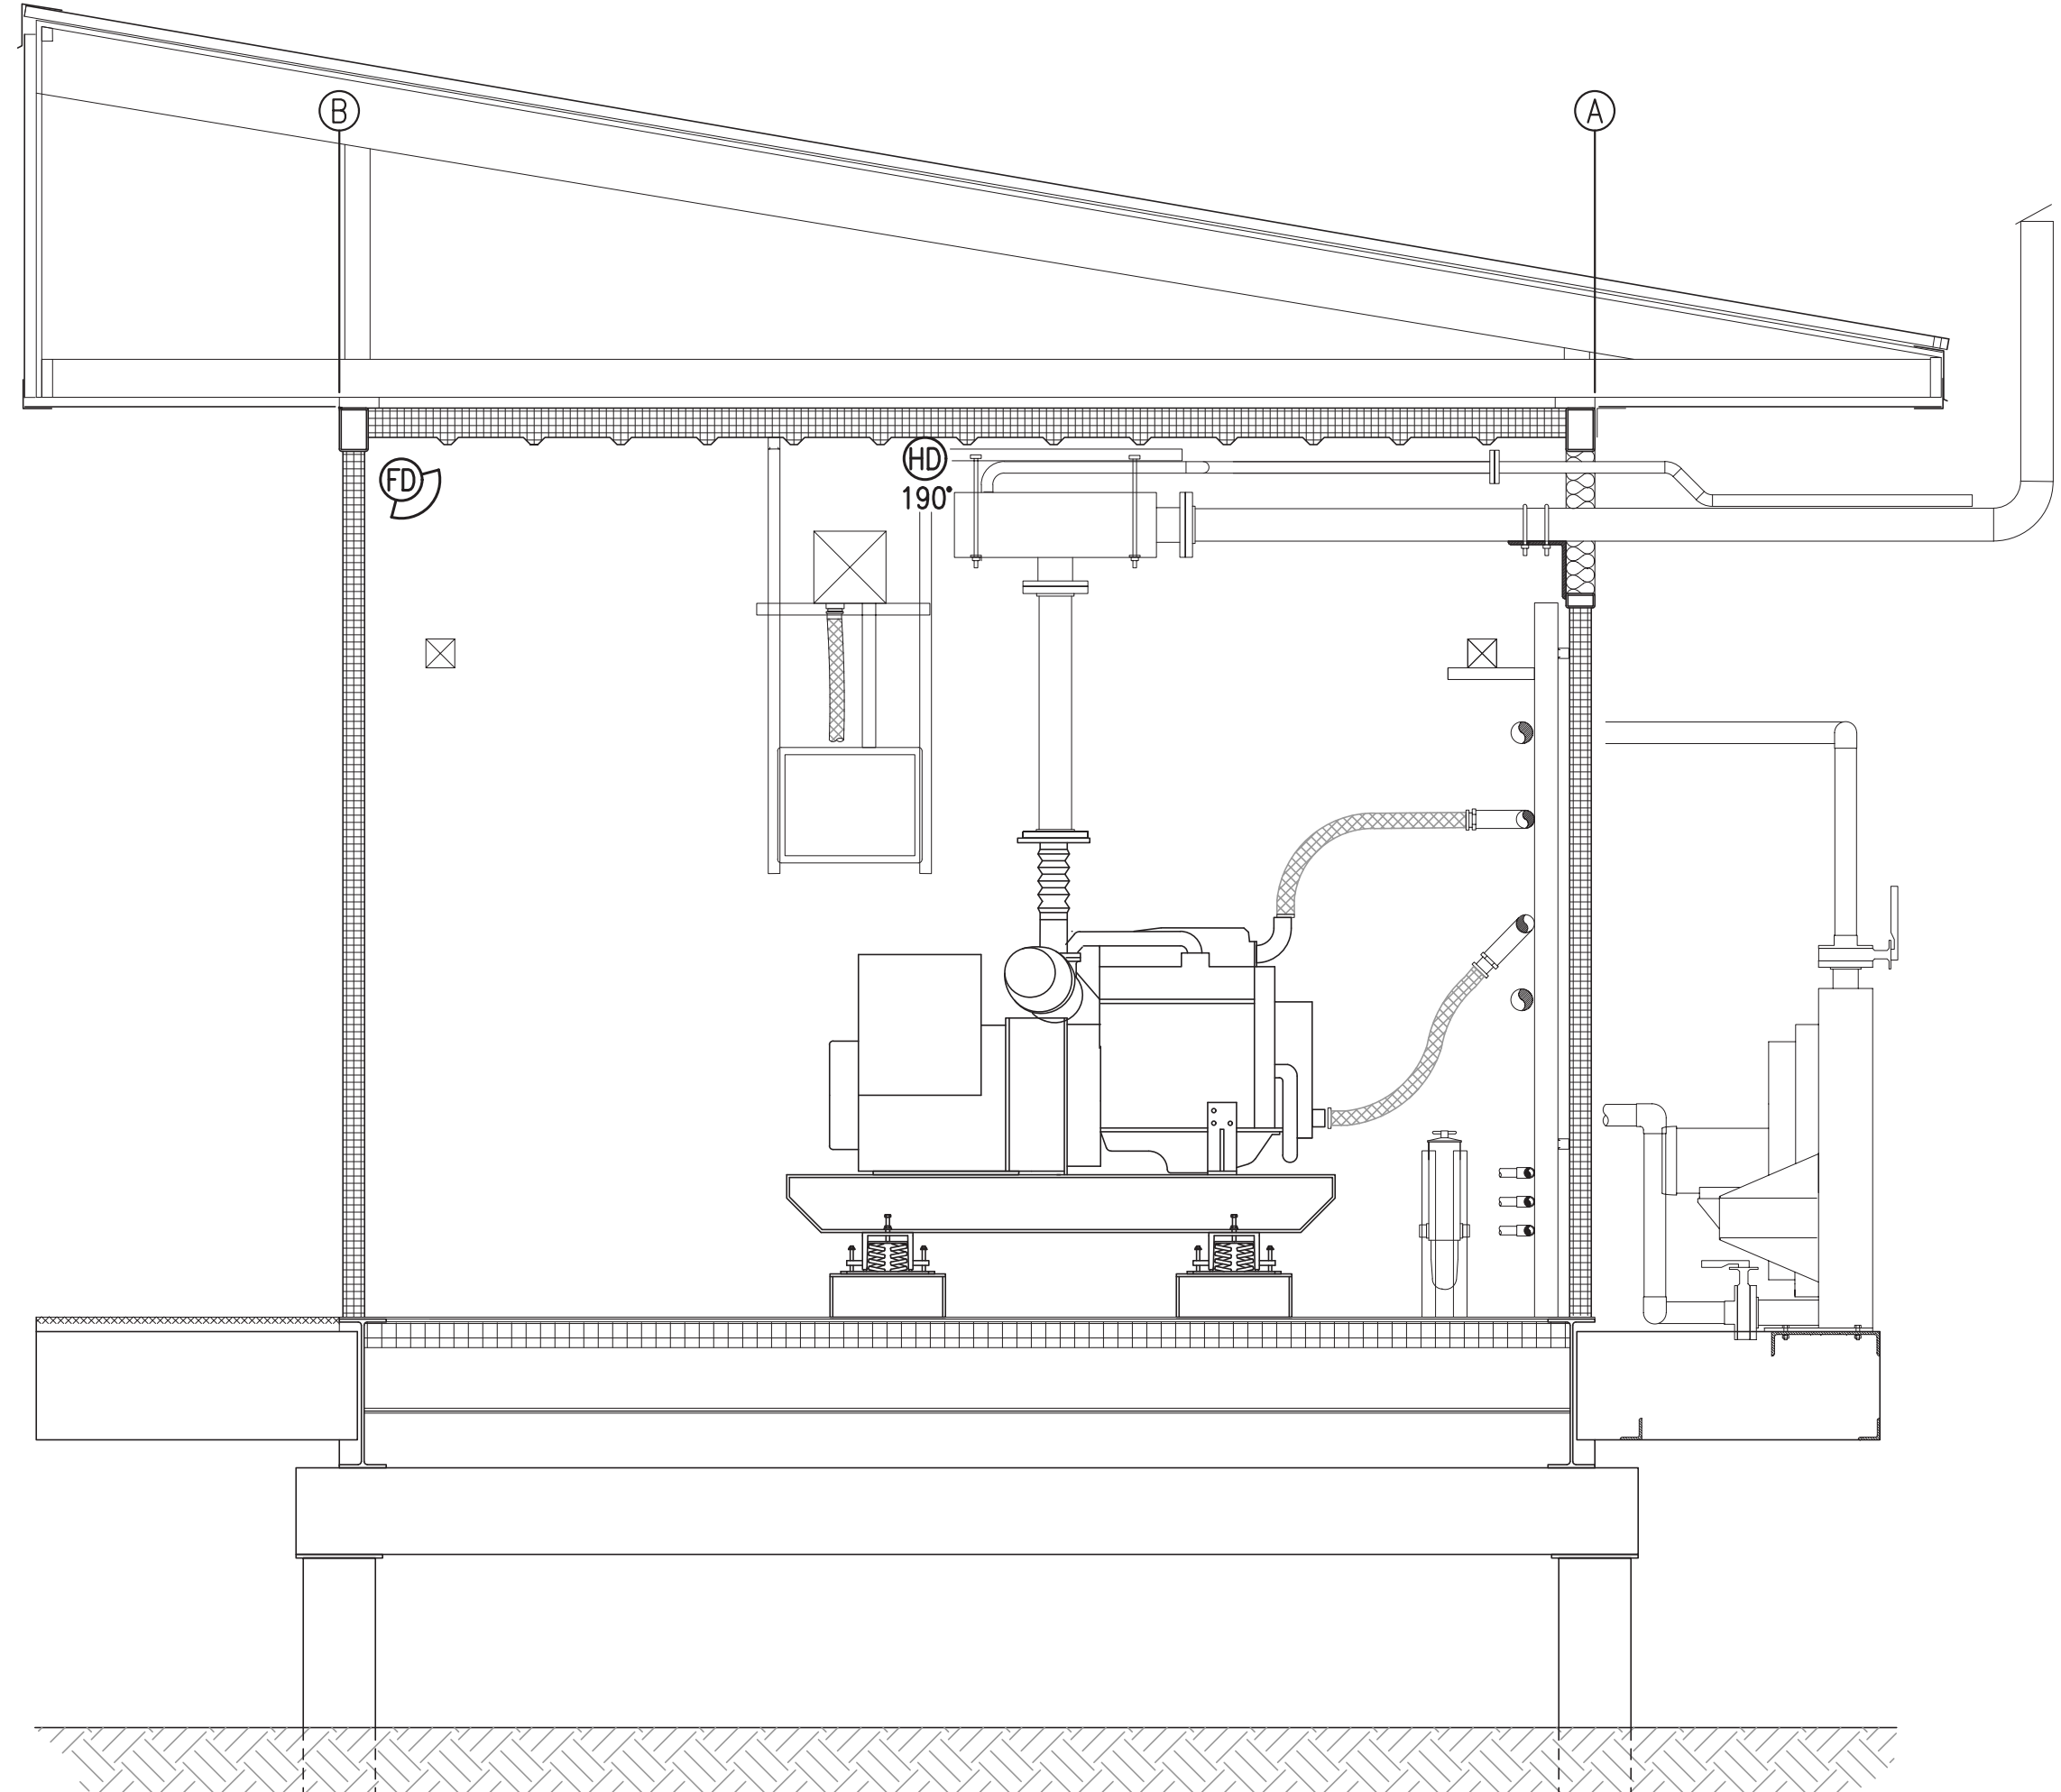

**2** TYPICAL SECTION THROUGH BUILDING  
3/8"=1'-0"

FIRE SUPPRESSION SYMBOL LEGEND			
SYMBOL	DESCRIPTION	SYMBOL	DESCRIPTION
HD 135°	NORMAL TEMP. (135°F) DETECTOR	P	MANUAL PULL STATION
HD 190°	HIGH TEMP. (190°F) DETECTOR	WP	INTERIOR ALARM HORN/STROBE
FD	FLAME (OPTICAL) DETECTOR	WP	EXTERIOR ALARM HORN/STROBE
SD	SMOKE (IONIZATION) DETECTOR		

FIRE SUPPRESSION PLACARD SCHEDULE (SEE SHEET M1.2)	
SYMBOL	DESCRIPTION
A	"FIRE ALARM"
C	"CAUTION, ROOM PROTECTED BY WATER MIST FIRE PROTECTION SYSTEM, IN CASE OF FIRE KEEP DOOR CLOSED AND DO NOT ENTER"
D	"FLASHING LIGHT MEANS FIRE SUPPRESSION AGENT HAS DISCHARGED"

FIRE SUPPRESSION WIRE SCHEDULE			
SYMBOL	CIRCUIT DESCRIPTION	WIRE TYPE	WIRE COLOR
A	24V DC POWER	#14 AWG SOLID	RED & BLACK
B	DETECTION CIRCUITS	#14 AWG SOLID	BLUE & YELLOW
C	ANNUNCIATION ALARM	#14 AWG SOLID	BROWN & ORANGE
D	ANNUNCIATION DISCHARGE	#14 AWG SOLID	WHITE, & GRAY
E	24V DC AUX POWER	#14 AWG SOLID	RED & BLACK WITH GRAY STRIPE

**GENERAL NOTES:**

- INTERIOR FINISH OF ALL WALLS AND CEILING METAL SIDING. INTERIOR FINISH OF FLOOR WELDED STEEL PLATE. CEILING HEIGHT IN ALL ROOMS 10'-2" ABOVE FINISHED FLOOR.
- ALL DOORS SELF-CLOSING WITH GASKETS. ALL BUILDING PIPING AND CONDUIT PENETRATIONS SEALED LIQUID TIGHT. ALL BUILDING DUCT PENETRATIONS EQUIPPED WITH MOTORIZED DAMPERS THAT CLOSE ON GENERATOR SHUT DOWN.

ALL WORK ON THIS SHEET WAS PERFORMED AS PART OF THE PRIOR MODULE ASSEMBLY CONTRACT AND IS SHOWN HERE FOR REFERENCE. SEE SPECIFICATION 21 13 30 FOR DELINEATION OF FINAL RE-ASSEMBLY, TESTING, AND COMMISSIONING THAT IS INCLUDED IN THE ON SITE SCOPE.

ISSUED FOR CONSTRUCTION  
MAY 2023



ALASKA ENERGY AUTHORITY		
PROJECT: NELSON LAGOON POWER SYSTEM UPGRADE		
TITLE: FIRE SUPPRESSION SYSTEM PLAN, SECTION, LEGEND, & NOTES		
 Gray Stassel Engineering, Inc. P.O. 111405, Anchorage, AK 99511 (907)349-0100	DRAWN BY: BCG DESIGNED BY: BCG FILE NAME: NELS PP FS1 PROJECT NUMBER:	SCALE: AS NOTED DATE: 5/20/23 SHEET: <b>FS1</b> OF 1

EQUIPMENT REQUIREMENTS FOR APPROVED EQUALS (APPLIES TO ALL SCHEDULES):  
 SPECIFIC PARTS MANUFACTURER AND MODEL SELECTED NOT ONLY TO MEET PERFORMANCE FUNCTION BUT ALSO TO COORDINATE AND INTERFACE WITH OTHER DEVICES AND SYSTEMS. APPROVED EQUAL SUBSTITUTIONS WILL BE ALLOWED ONLY BY ENGINEER'S APPROVAL. TO OBTAIN APPROVAL, SUBMITTALS MUST CLEARLY DEMONSTRATE HOW SUBSTITUTE ITEM MEETS OR EXCEEDS SPECIFIED ITEM QUALITY AND PERFORMANCE CHARACTERISTICS AND ALSO COMPLIES WITH MECHANICAL AND/OR ELECTRICAL CONNECTIONS AND PHYSICAL LAYOUT REQUIREMENTS.

**ELECTRICAL EQUIPMENT SCHEDULE**

SYMBOL	SERVICE/FUNCTION	DESCRIPTION	MANUFACTURER/MODEL
1	DAY TANK ALARM HORN/STROBE	MULTI-TONE ALARM WITH STROBE, 115V, NEMA 3R, WEATHER RESISTANT SURFACE MOUNT BELL BOX	WHEELOK MT4-115-WH-VNS
2	DIGITAL THERMOSTAT	MULTIPLE OUTPUT MODULATING DIGITAL THERMOSTAT	HONEYWELL TB7980B
3	LINE VOLTAGE THERMOSTAT	HEATING/COOLING THERMOSTAT, 16 FLA @ 120V, SPDT, 50F TO 80F RANGE.	DAYTON 1UHH2
4	EXTERIOR LIGHT	AREA LIGHT, WIDE DISPERSION WALL PACK WITH PHOTO CONTROL LED, 17.7W, 120-277V DRIVER	HUBBELL NRC-356L-5K-U-PC
5	EMERGENCY LIGHT	WHITE PLASTIC ENCLOSURE, 120-347V INPUT, DUAL 5.3W LED LAMPS, LITHIUM IRON PHOSPHATE BATTERY	LITHONIA EML6L UVOLT LTP SRDT
6	EMERGENCY/EXIT LIGHT COMBO	WHITE PLASTIC ENCLOSURE, RED EXIT SIGN, 277/120V INPUT, DUAL 1.5W 9.6V LED LAMPS. OPTIONAL HIGH OUTPUT NI-CAD BATTERY	LITHONIA LHQM LED R HO
7	EMERGENCY EXIT REMOTE LIGHT	REMOTE LAMP FIXTURE, DUAL HEAD, RATED FOR EXTERIOR INSTALLATION IN DAMP/WET LOCATIONS, 1.5W 9.6V LED LAMPS.	LITHONIA ELA T QWP L0309
8	INTERIOR LIGHT	SURFACE MOUNTED LED STRIPLIGHT FIXTURE, 48" LONG, 34W, 5000°K WITH SNAP ON FROSTED DIFFUSER	LITHONIA L1N-L48-5000LM-FST
9	TIMER SWITCH	0-5 MINUTE, 120V, 20A, 1HP RATED, INSTALL IN 4"x4" PRESSED STEEL BOX WITH METAL COVER.	INTERMATIC FF5M
10	LIGHT SWITCH	SINGLE POLE SNAP SWITCH, 120V, 20A, METAL, 1-1/2HP RATED, INSTALL IN 4"x4" STEEL BOX WITH METAL COVER, IVORY.	HUBBELL 1221-1
11	1Ø SMALL MOTOR DISCONNECT	SINGLE POLE SNAP SWITCH WITH RED PILOT LIGHT, 120V, 20A, 1HP RATED, INSTALL IN 4"x4" STEEL BOX WITH METAL COVER	HUBBELL 1221-PL
12	NOT USED	NOT USED	
13	STATION SERVICE TRANSFORMER	DRY TYPE, ENERGY STAR, ENCLOSURE TYPE 1 WITH INTEGRAL WALL MOUNT BRACKETS, 15 KVA, HV 480 DELTA, LV 208Y/120	HAMMOND HPS SENTINEL CAT. NO. SG3A0015KB
14	STATION SERVICE PANELBOARD	COPPER BUS, 3 PHASE, 4 WIRE, 120/208V, 125A MAIN BREAKER, 42 CIRCUITS, BOLT-IN BREAKERS, 20" WIDE NEMA 1 ENCLOSURE, SURFACE MOUNT, NO KNOCKOUTS	SIEMENS TYPE P1 OR SQUARE D TYPE NQ
15	STANDARD RECEPTACLE	SURFACE MOUNT 125V NEMA 5-20R RECEPTACLE. INSTALL IN 4"x4" STEEL BOX WITH METAL COVER	PASS & SEYMOUR 5362W
16	EXTERIOR GFCI RECEPTACLE	125V NEMA 5-20R GFCI RECEPTACLE. MOUNT IN CAST FDA BOX WITH WEATHERPROOF COVER	PASS & SEYMOUR 2095-W
17	BATTERY CHARGER	12/24-VOLT SOLID STATE 20-AMP AUTO-EQUALIZING BATTERY CHARGER FOR 120 VAC INPUT, WITH OPTIONAL HIGH/LOW VOLTAGE, AC POWER FAILURE, & REMOTE SUMMARY ALARM RELAYS	SENS NRC22-20-RCLS OR LEMARCHE ECSR-40/20-12/24V-AV1
18	WELDER/COMPR. RECEPTACLE	NEMA 6-30R, BLACK, 250V, 30A, 2 POLE, WITH GROUND. INSTALL IN DEEP 4"x4" STEEL BOX WITH 2.15"Ø HOLE METAL COVER	PASS & SEYMOUR 3801
19	NOT USED	NOT USED	
20	RADIATOR MOTOR DISCONNECT	NON-FUSED LOCKABLE SAFETY SWITCH, NEMA 4X ENCLOSURE, 3PST, 600V, 30A, MIN. 5HP RATED	SIEMENS HNF361S OR SQUARE D HU361S
21	24VAC CONTROL TRANSFORMER	120V PRIMARY, 24V SECONDARY, 20VA OUTPUT, 1/2" THREADED HUB MOUNT	FUNCTIONAL DEVICES TR20VA001
22	ENCLOSED POWER RELAY (RIB)	20A, 1HP RATED CONTACT, SPDT, 24VAC COIL, NEMA 1 ENCLOSURE, RED LED PILOT LIGHT	FUNCTIONAL DEVICES RIB2401B
23	SNAP SWITCH WITH THERMAL UNIT	600VAC, 1HP, 1ØA MANUAL MOTOR STARTER WITH TYPE S, TYPE A, MELTING ALLOY, CLASS 20 THERMAL UNIT	SQUARE D 2510F01 MOTOR STARTER WITH A14.8 THERMAL UNIT
24	ROUTER - HIGH SPEED INTERNET	4-PORT GIGABIT ROUTER, DUAL 2.4 AND 5 GHz WIFI WITH ADJUSTABLE ANTENNAS, 4 GIGABIT LAN, 1 GIGABIT WAN, USB 2.0 AND USB 4.0, MINIMUM 256 MB RAM	ASUS RT-ACI-900P
25	480V NON-FUSED SVC. DISCONNECT	NON-FUSED LOCKABLE SAFETY SWITCH, NEMA 4X ENCLOSURE, 3PST, 600V, 200A	SIEMENS HNF364S OR SQUARE D HU364S
26	480V FUSED SVC. DISCONNECT	FUSED LOCKABLE SAFETY SWITCH, NEMA 4X ENCLOSURE, 3PST, 600V, 200A, PROVIDE WITH 3 EA. 125A TYPE R FUSES PLUS 3 IDENTICAL SPARE FUSES	SIEMENS HF364S OR SQUARE D H364S

**ELECTRICAL CONDUCTOR SCHEDULE**

SERVICE/FUNCTION	DESCRIPTION	MANUFACTURER/MODEL	NOTES:
GENERATOR LEADS (ENGINE STARTER CABLES SIMILAR)	HIGH TEMPERATURE, EXTRA FLEXIBLE CABLE, TIN COATED COPPER CONDUCTOR. THERMOSET EPDM INSULATION, UL 3340/3374, MINIMUM 600V, LISTED 150°C FOR NON-FLEXING	COBRA CABLE, BELDEN, OR OMINI	TERMINATE WITH COPPER COMPRESSION LUGS RATED FOR THE FULL AMPACITY OF THE CABLE AT 150°C
GENERAL USE CONDUCTORS	CLASS B CONCENTRIC STRANDED, SOFT DRAWN COPPER. TYPE XHHW2 INSULATION, 600V AND 90C RATED.		
SHIELDED/TWISTED INSTRUMENT & CONTROL & CANBUS CONDUCTORS	#18 AWG STRANDED TINNED COPPER CONDUCTORS, 600V POLYETHYLENE INSULATION, 100% COVERAGE ALUMINUM FOIL-POLYESTER TAPE SHIELD WITH STRANDED TINNED COPPER DRAIN WIRE & PVC OUTER JACKET	BELDEN PART #S SINGLE PAIR: #1120A FOUR PAIR: #1049A SINGLE TRIAD: #1121A	GROUND SHIELD DRAIN WIRE AT PANEL END ONLY.
EHTERNET (CAT5e) COMMUNICATION CONDUCTORS	SOLID BARE COPPER CONDUCTORS, 300V FEP INSULATION & JACKET, 100% COVERAGE ALUMINUM FOIL-POLYESTER TAPE SHIELD WITH STRANDED TINNED COPPER DRAIN WIRE	FOUR PAIR #24 BELDEN 1585LC	GROUND SHIELD DRAIN WIRE AT PANEL END ONLY. ROUTE ALL DEVICENET & CAT5e CABLES IN SEPARATE DEDICATED RACEWAY.
UNLESS INDICATED OTHERWISE ALL CONDUCTORS SHALL USE THE FOLLOWING COLOR CODE: 480-VOLT POWER (PHASE) CONDUCTORS PHASE A: BROWN PHASE B: ORANGE PHASE C: YELLOW 120/208-VOLT POWER (PHASE) CONDUCTORS PHASE A: BLACK PHASE B: RED PHASE C: BLUE NEUTRAL: WHITE, NO EXCEPTIONS GROUND: GREEN OR BARE, NO EXCEPTIONS 24 VOLT DC CONDUCTORS +24VDC: RED OR RED W/GRAY STRIPE -24VDC: BLACK OR BLACK W/GRAY STRIPE CONTROL AND INSTRUMENT CONDUCTORS MAY BE COLOR CODED PER MANUFACTURER'S STANDARD		<b>NOTES:</b> 1) COLOR CODING FOR NO. 6 AWG AND SMALLER CONDUCTORS SHALL BE BY USING CONDUCTORS WITH CONTINUOUS COLOR EMBEDDED IN THE INSULATION. 2) COLOR CODING FOR CONDUCTORS LARGER THAN NO. 6, SHALL BE BY: A) CONTINUOUS COLOR EMBEDDED IN THE INSULATION, OR B) BLACK CABLE WITH SCOTCH 35 OR APPROVED EQUAL MARKING (PHASE) TAPE. AT EVERY ACCESSIBLE LOCATION A MINIMUM 3" LONG SECTION OF CONDUCTOR SHALL BE SPIRAL WRAPPED. NOTE THAT PHASE TAPE MAY NOT BE USED ON COLORED CABLE, BLACK CABLE ONLY. 3) GROUNDING - PROVIDE A SEPARATE GREEN INSULATED EQUIPMENT GROUNDING CONDUCTOR IN EACH RACEWAY. DO NOT USE THE CONDUIT AS AN EQUIPMENT GROUNDING CONDUCTOR. EQUIPMENT GROUNDING CONDUCTORS SHALL BE OF THE SAME TYPE AS THE PHASE CONDUCTORS AND SHALL BE SIZED AS INDICATED ON THE DRAWINGS. CONDUCTORS NOT INDICATED SHALL BE SIZED IN ACCORDANCE WITH THE NATIONAL ELECTRICAL CODE.	

**WIRING & DEVICE SYMBOL LEGEND**

SYMBOL	DESCRIPTION	SYMBOL	DESCRIPTION
SS-##	HOME RUN TO PANEL & BREAKER(S) INDICATED. SHORT DASH INDICATES HOT CONDUCTOR, LONG DASH INDICATES NEUTRAL CONDUCTOR, CURVED DASH INDICATES GROUND CONDUCTOR. IF NOT SPECIFICALLY INDICATED, PROVIDE 2#12 AWG & 1#12 AWG GROUND.	⊖	125V, 20A, DUPLEX RECEPTACLE
⊖		⊖	LINE VOLTAGE THERMOSTAT
⊖		⊖	DIGITAL THERMOSTAT, MODULATING
⊖		⊖	ELECTRICAL ITEM - SEE EQUIPMENT SCHEDULE
⊖		⊖	SNAP SWITCH / SMALL MOTOR DISCONNECT
⊖		⊖	MOTOR (HORESPOWER INDICATED)
⊖		⊖	TIMER SWITCH
⊖		⊖	MOTORIZED DAMPER - SEE MECHANICAL
⊖		⊖	GROUND

**DISTRIBUTION PLAN SYMBOL LEGEND**

EXISTING	NEW		
		PADMOUNT TRANSFORMER	ID AND KVA INDICATED
		PRIMARY SECTIONALIZING CABINET, ID INDICATED,	3Ø OR 1Ø AS INDICATED IN STAKING SHEETS
		3Ø BURIED 15kV PRIMARY JCN CIC (NEW)	
		1Ø BURIED 15kV PRIMARY JCN CIC (NEW)	
		3Ø BURIED 15kV PRIMARY JCN CIC (EXISTING)	
		3Ø DIRECT BURIED 600V UD CABLE	

**INSTRUMENTATION & ENERGY MEASUREMENT LEGEND**


NOTE: SEE SCHEDULES SHEET M1.1 FOR EQUIPMENT SPECIFICATIONS.


SYMBOL	SERVICE/FUNCTION	SYMBOL	SERVICE/FUNCTION
⊖	TEMPERATURE TRANSMITTER	⊖	DAY TANK/HOPPER FLOAT SWITCH
⊖	PRESSURE TRANSMITTER	⊖	GLYCOL TANK LEVEL SENSOR PROBE
⊖	TANK LEVEL MONITOR PANEL	⊖	GLYCOL TANK LOW COOLANT ALARM
⊖	TANK LEVEL SENSOR PROBE		

ALL MATERIALS AND EQUIPMENT ON SCHEDULES THIS SHEET WERE FURNISHED AS PART OF THE PRIOR MODULE ASSEMBLY PROJECT EXCEPT FOR THOSE ITEMS SPECIFICALLY INDICATED IN RED CLOUDS WHICH ARE TO BE FURNISHED AND INSTALLED AS PART OF THE ON SITE SCOPE.

1	DELETED FLOW METER	7/7/23	BCG
REV.	DESCRIPTION	DATE	BY
 PROJECT: NELSON LAGOON POWER SYSTEM UPGRADE TITLE: ELECTRICAL LEGENDS & SCHEDULES			
 DRAWN BY: JTD DESIGNED BY: CWV/BCG FILE NAME: NELS_PP_E1 PROJECT NUMBER:		SCALE: NO SCALE DATE: 5/30/23 SHEET: E1.1	
P.O. 111405, Anchorage, AK 99511 (907)349-0100			

REV#1  
 ISSUED FOR  
 CONSTRUCTION  
 AUGUST 2023

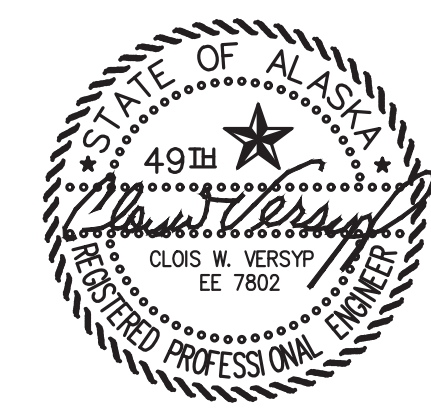

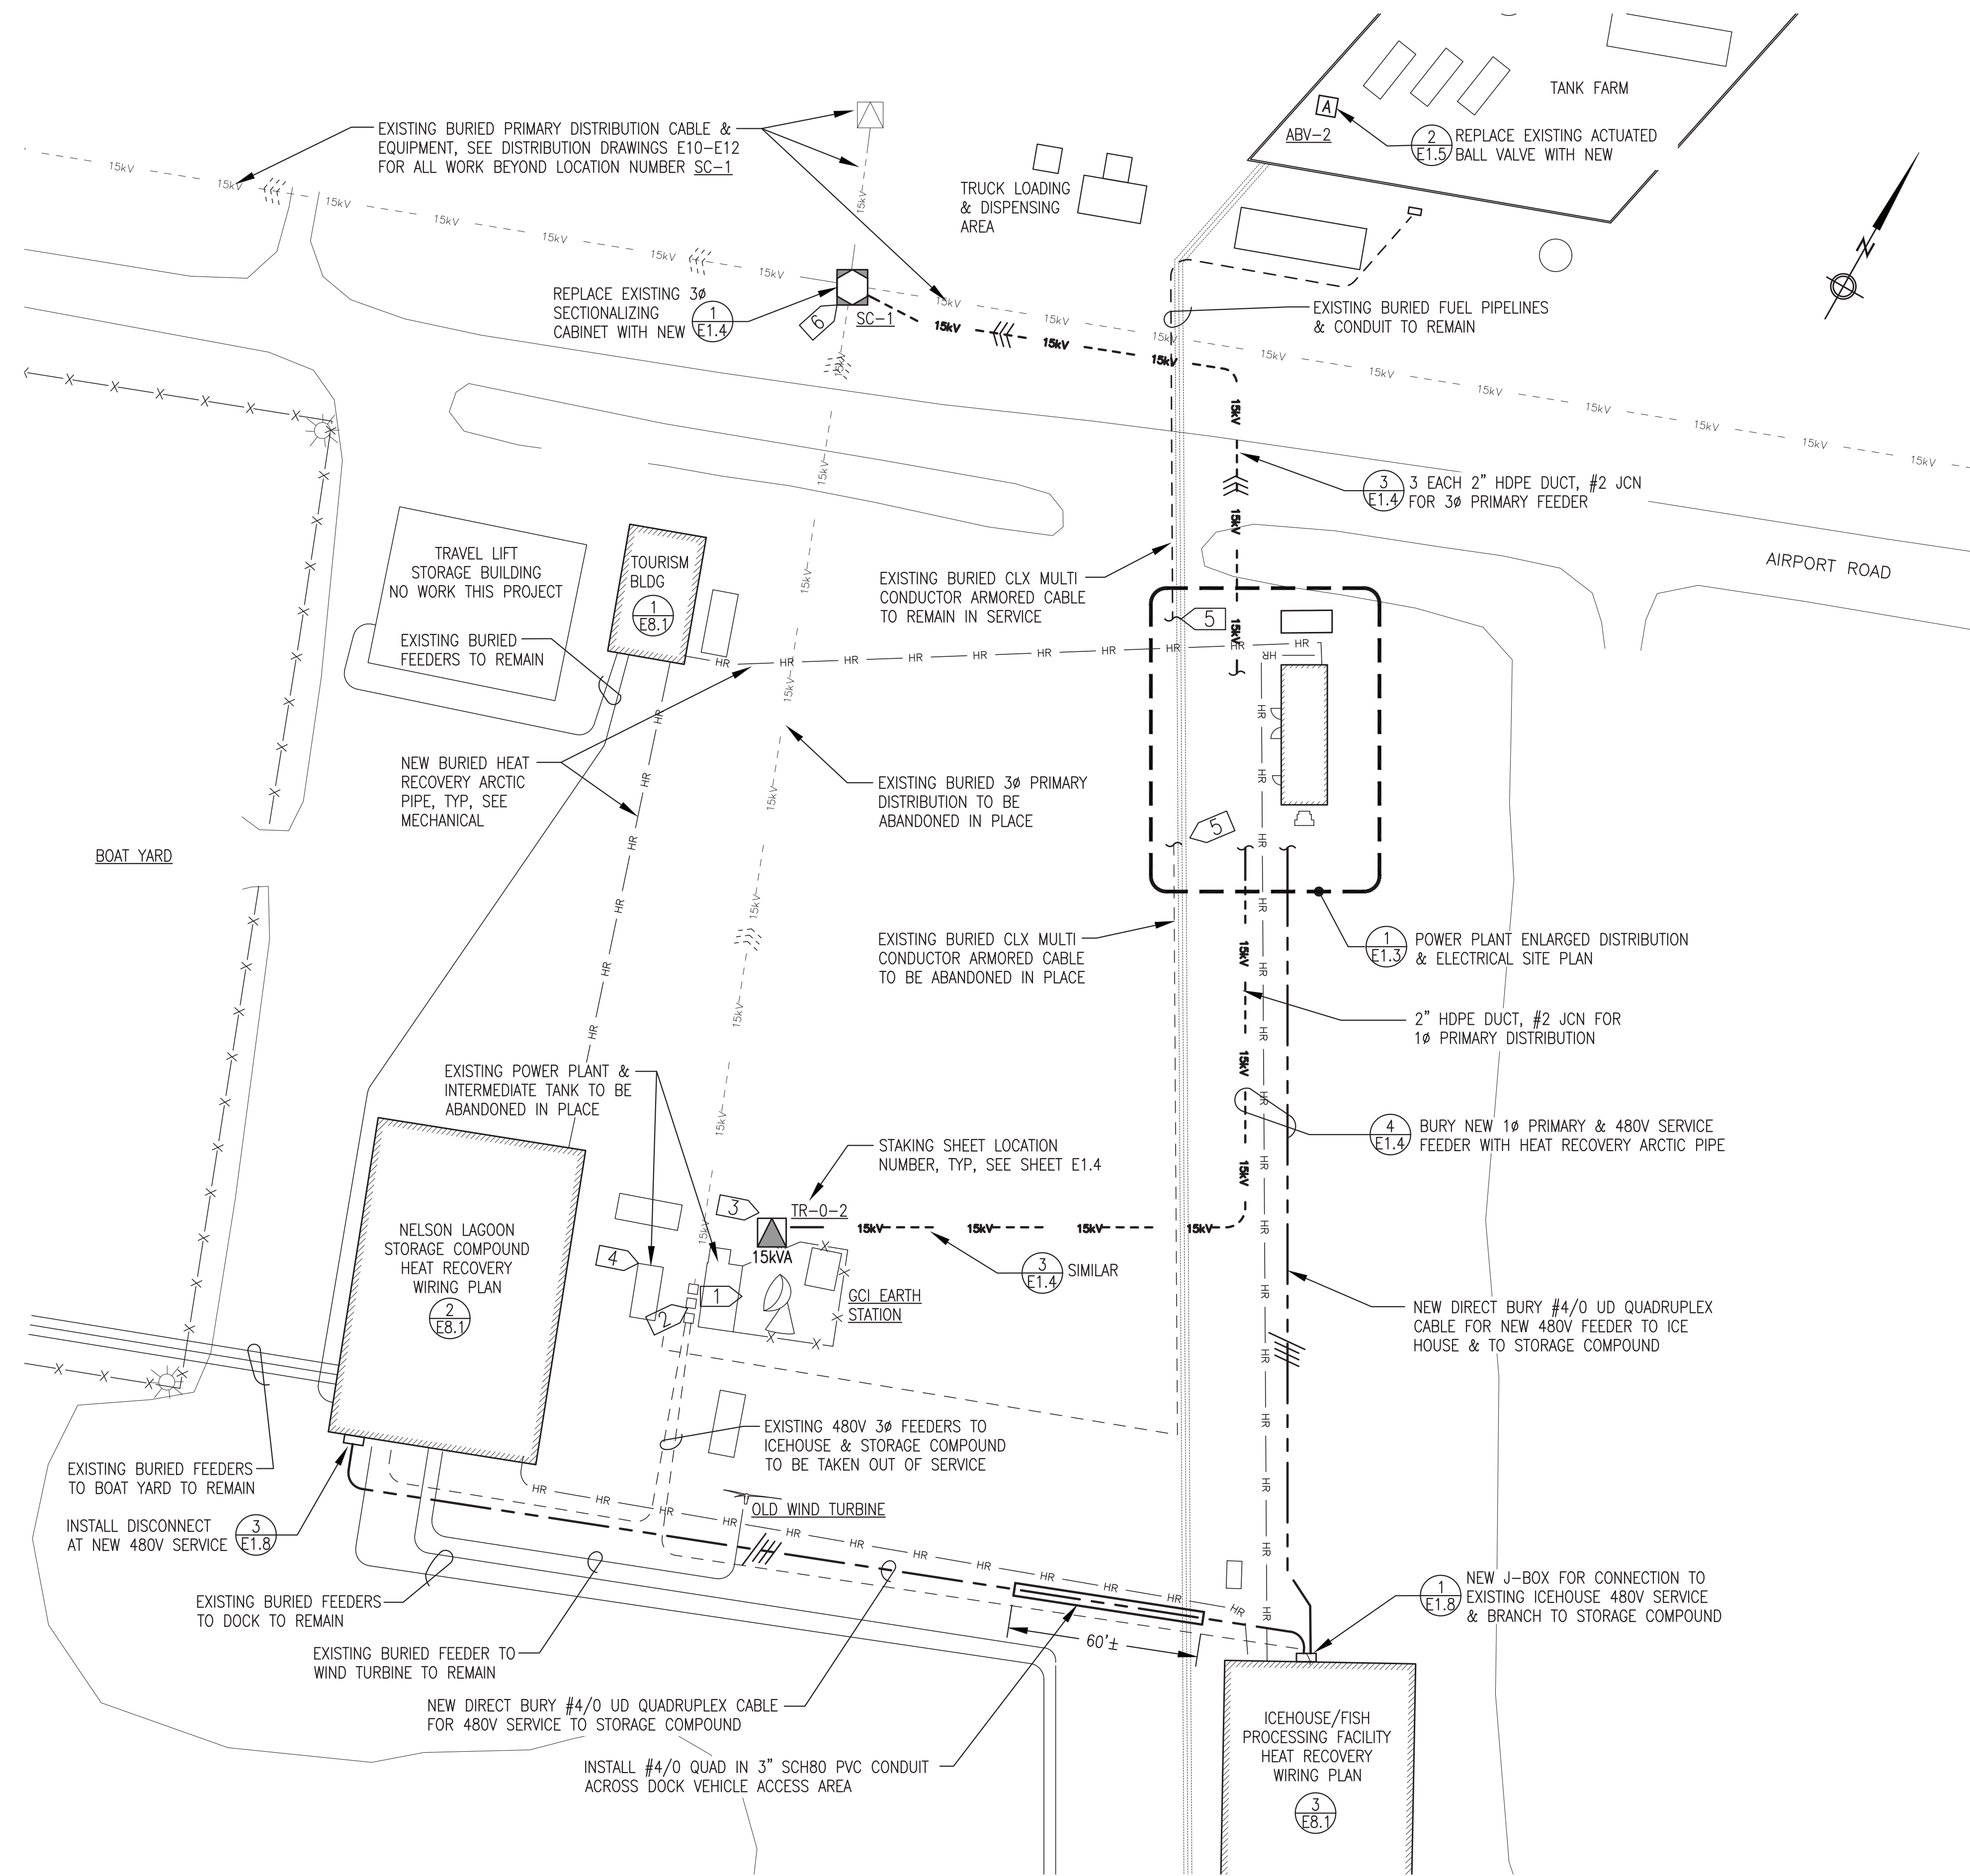

**DEMOLITION GENERAL NOTES:**

- 1) ALL EXISTING ENERGY INFRASTRUCTURE REPLACED THIS PROJECT TO BE ABANDONED IN PLACE UNLESS SPECIFICALLY INDICATED OTHERWISE.
- 2) ALL UNDERGROUND CONDUCTORS BEING TAKEN OUT OF SERVICE SHALL BE CUT OFF AT BOTH ENDS 18" MINIMUM BELOW GRADE AT BOTH ENDS AND ABANDONED IN PLACE.

**NEW WORK GENERAL NOTES:**

- 1) ALL INSTALLATION SHALL MEET THE LATEST ADOPTED EDITION OF THE NATIONAL ELECTRICAL SAFETY CODE (NEC), ANSI C2, AND THE NATIONAL ELECTRICAL CODE, NFPA 70, INCLUDING ANY STATE OF ALASKA AMENDMENTS. RUS BULLETIN 1728F-806 (RD-GD-2018-93), SPECIFICATIONS AND DRAWINGS FOR UNDERGROUND ELECTRIC DISTRIBUTION SHALL BE FOLLOWED UNLESS SPECIFICALLY MODIFIED BY THESE DRAWINGS OR SPECIFICATIONS. ALL MATERIAL SHALL BE RUS APPROVED. OBTAIN COPIES OF THE RUS BULLETINS AND MAINTAIN COPIES OF THE BULLETINS AND SPECIFICATIONS AT THE JOB SITE AT ALL TIMES.
- 2) THE DRAWINGS SHOW APPROXIMATE LOCATION OF SOME EXISTING UNDERGROUND ELECTRIC POWER. PRIOR TO BEGINNING EXCAVATION, LOCATE ALL UNDERGROUND UTILITIES INCLUDING BUT NOT LIMITED TO ELECTRIC POWER, TELECOMMUNICATIONS, WATER, SEWER, AND FUEL.
- 3) ANY UTILITIES DAMAGED DURING EXCAVATION SHALL BE REPAIRED PROMPTLY TO THE SATISFACTION OF THE AUTHORITY AND THE UTILITY AT NO COST TO THE AUTHORITY.
- 4) WHERE MULTIPLE UTILITIES ARE BURIED IN A COMMON TRENCH, PLAN OUT WORK AND COORDINATE TRADES TO INSTALL ALL BURIED UTILITIES TOGETHER.
- 5) TAKE CARE TO PROTECT EXISTING BUILDING FOUNDATIONS, SLABS, SIDEWALKS, AND OTHER EXISTING FEATURES WHEN EXCAVATING FOR ARCTIC PIPE. BACKFILL WITH EXCAVATION SPOILS OR SANDY GRAVEL, COMPACT, AND BLEND INTO EXISTING GRADE. RESTORE ALL EXCAVATION AREAS TO ORIGINAL CONDITION UPON COMPLETION.

**SPECIFIC NOTES:**


- 1) EXISTING POWER PLANT TO BE TAKEN OUT OF SERVICE AND ABANDONED IN PLACE UPON COMMISSIONING OF NEW POWER PLANT.
- 2) EXISTING STEP UP TRANSFORMER BANK TO BE TAKEN OUT OF SERVICE AND ABANDONED IN PLACE UPON COMMISSIONING OF NEW POWER PLANT. CUT OFF ALL BELOW GRADE CONDUCTORS AND REMOVE 480V SECONDARY CONDUCTORS FROM POWER PLANT.
- 3) INSTALL NEW 1Ø TRANSFORMER TO SERVE GCI EARTH STATION. CONNECT NEW 240/120V SERVICE TO EXISTING METER BASE.
- 4) CAREFULLY REMOVE EXISTING INTERMEDIATE TANK CONTROL PANEL AND SALVAGE FOR REUSE IN NEW MODULAR POWER PLANT.
- 5) THE EXISTING BURIED CLX MULTI-CONDUCTOR ARMORED CABLE PRESENTLY CONNECTS THE EXISTING INTERMEDIATE TANK CONTROL PANEL TO THE TANK FARM MAIN CONTROL PANEL FOR CONTROL OF POWER PLANT FUEL TRANSFERS. CUT AND REROUTE TO NEW POWER PLANT, SEE ENLARGED PLAN SHEET E1.3.
- 6) EXISTING SECTIONALIZING CABINET IS PROTECTED BY PIPE RAIL BOLLARD, SEE PHOTO BELOW. POSITION NEW SECTIONALIZING CABINET TO CONNECT TO EXISTING CABLES, TO PROVIDE REQUIRED ACCESS, AND TO INSTALL IN ACCORDANCE WITH DETAIL. REMOVE HORIZONTAL PIPE RAIL ACROSS FRONT OF SECTIONALIZING CABINET AND GRIND CUTS SMOOTH. WIRE BRUSH REMAINING PIPE RAIL BOLLARD AND PAINT SAFETY YELLOW. SEE PHOTO BELOW.




ALL WORK ON THIS SHEET IS INCLUDED IN THE ON SITE CONTRACT.

1 POWER PLANT AREA ELECTRICAL SITE PLAN  
E1.2 1"=30'

ISSUED FOR CONSTRUCTION  
MAY 2023

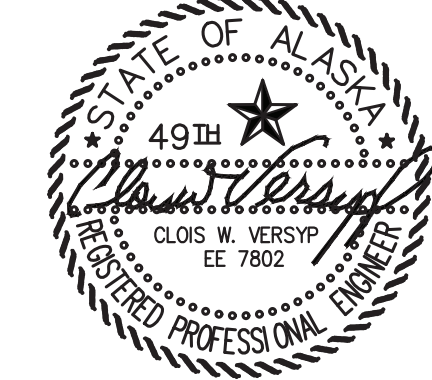

ALASKA ENERGY AUTHORITY		
PROJECT: NELSON LAGOON POWER SYSTEM UPGRADE		
TITLE: POWER PLANT AREA ELECTRICAL SITE PLAN		
	DRAWN BY: JTD	SCALE: NO SCALE
	DESIGNED BY: CWV/BCG	DATE: 5/30/23
	FILE NAME: NELS_PP_E1	SHEET: E1.2
	PROJECT NUMBER:	
P.O. 111405, Anchorage, AK 99511 (907)349-0100		

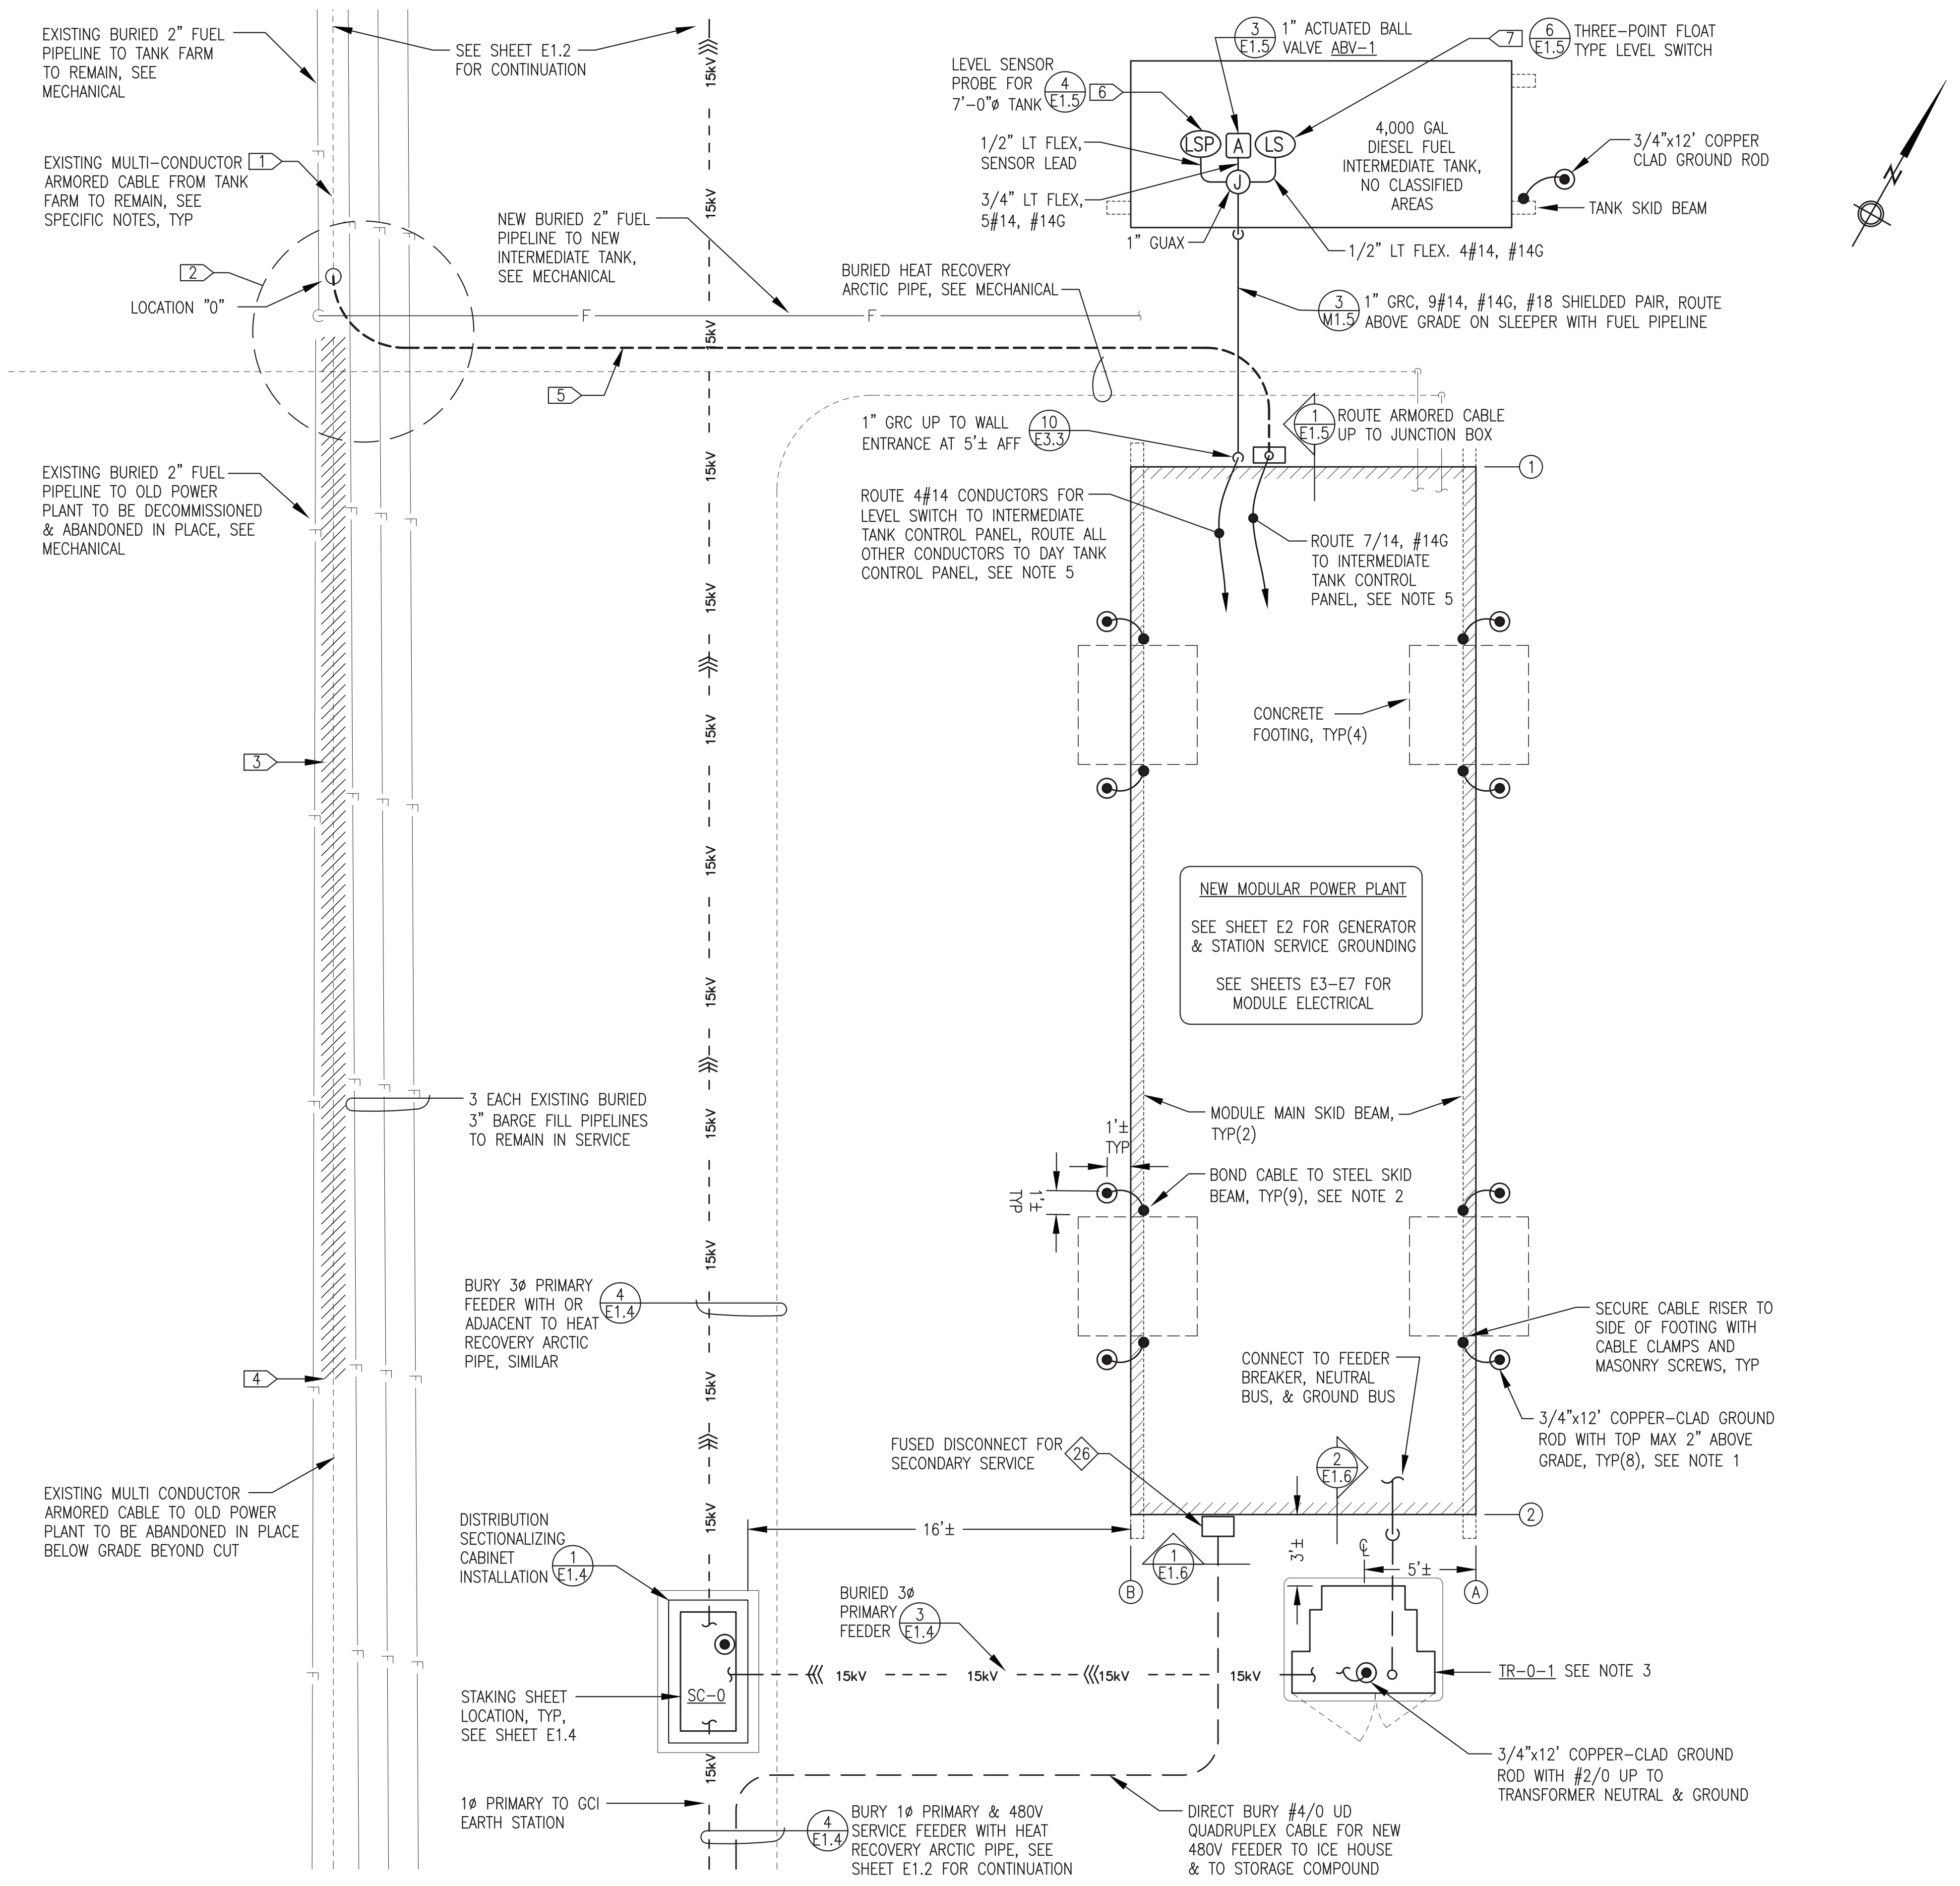

**EXISTING BURIED CABLE SPECIFIC NOTES:**

- 1 EXISTING BURIED MULTI-CONDUCTOR DIRECT BURY ARMORED CABLE IS 14-#14 AWG TYPE CLX CABLE WITH ALUMINUM SHEATH AND PVC JACKET, APPROXIMATELY 1.25" O.D.
- 2 LOCATE EXISTING ARMORED CABLE & FUEL PIPELINES IN THIS AREA. HAND EXCAVATE OR USE AIR SPADE AS REQUIRED TO EXPOSE ARMORED CABLE, BEING CAREFUL NOT TO DAMAGE CABLE OR FUEL PIPELINES. MEASURE THE LINEAL FEET FROM A POINT ON THE ARMORED CABLE (LOCATION "0" AS SHOWN ON PLAN) TO THE NEW MODULE CABLE ENTRANCE FOLLOWING THE NEW TRENCH ROUTE. THIS MEASUREMENT IS DESIGNATED AS DISTANCE "L".
- 3 CAREFULLY EXCAVATE AND EXPOSE L+15' OF ADDITIONAL EXISTING ARMORED CABLE FOR RE-ROUTING TO MODULE
- 4 CAREFULLY CUT ARMORED CABLE AT DISTANCE L+15' FROM LOCATION "0".
- 5 L+15' LENGTH OF UNEARTHED ARMORED CABLE TO BE ROUTED TO MODULE WITH NEW BURIED FUEL PIPELINE.
- 6 AFTER FILLING TANK, MEASURE FUEL HEIGHT THEN CALIBRATE LEVEL SENSOR PROBE USING TANK LEVEL MONITOR PANEL IN FACE OF DAY TANK CONTROL PANEL.
- 7 PRIOR TO INSTALLING FLOAT SWITCH IN TANK, MAKE TEMPORARY ELECTRICAL CONNECTIONS AND MANUALLY MANIPULATE EACH FLOAT IN ORDER TO TO VERIFY ACTUATION LENGTH AND N.O./N.C. FUNCTION IN ACCORDANCE WITH SPECIFICATIONS ON INSTRUMENTATION SCHEDULE SHEET M1.1. AFTER INSTALLATION, VERIFY PROPER CONTROL FUNCTION USING TEMPORARY JUMPERS.

**GENERAL GROUNDING & FEEDER NOTES:**

1. CAD-WELD ALL GROUNDING GRID CABLE AND GROUND ROD CONNECTIONS.
2. MAKE ALL GROUND CONNECTIONS TO SKID BEAMS WITH COPPER COMPRESSION LUGS AND STAINLESS STEEL BOLTS. DRILL AND TAP BEAMS TO ENSURE FULL CONTACT OF THREADS TO CLEAN BARE STEEL. SEE DETAIL 2/E2, SIMILAR. ALTERNATELY, CAD WELD TO UNPAINTED BOTTOM FACE OF BEAM.
3. NEW PAD MOUNT TRANSFORMER, SEE SHEET E1.4 FOR SCHEDULE AND INSTALLATION DETAIL.
4. FOR ALL EXTERIOR GRC, CLEAN AND DE-GREASE THREADS AFTER CUTTING AND SPRAY WITH COLD GALV PRIOR TO ASSEMBLY.
5. SEE STATION SERVICE SHEET E4.2 AND SHEETS E7.1-E7.4 FOR INTERIOR FUEL SYSTEM WIRING ROUTING AND TERMINATIONS.

**ALL WORK ON THIS SHEET IS INCLUDED IN THE ON SITE CONTRACT.**

PROJECT: NELSON LAGOON POWER SYSTEM UPGRADE		
TITLE: POWER PLANT ENLARGED ELECTRICAL SITE PLAN		
	DRAWN BY: JTD	SCALE: NO SCALE
	DESIGNED BY: CWV/BCG	DATE: 5/30/23
FILE NAME: NELS_PP_E1	SHEET:	<b>E1.3</b>
PROJECT NUMBER:		

ISSUED FOR CONSTRUCTION  
MAY 2023




**1 POWER PLANT ENLARGED ELECTRICAL SITE PLAN**  
E1.3 1/4"=1'-0"

STAKING SHEET																
LOCATION NUMBER	PRIMARY						SECONDARY CONDUCTOR						MISCELLANEOUS CONSTRUCTION UNITS		REMARKS, COMMENTS, NOTES	
	CONDUCTOR			PRIMARY ASSEMBLY			SERVICE			BACKFEED			SECONDARY SERVICE			
	No.	SIZE/TYPE	BACK SPAN	No.	UNITS	No.	UNITS	No.	SIZE/TYPE	BACK SPAN	No.	SIZE/TYPE	No.	UNITS		
TR-0-1				1	UF3.BNa	1	UG3.3-150							1	UH1.1	STEP-UP TRANSFORMER. SEE DETAILS AND ONE-LINE DIAGRAM FOR CONDUCTORS FROM SWITCHGEAR TO SECONDARY TERMINALS.
				3	UM6.EL2									6	UM6.C2	
				3	UM6.PK2											
SC-0	3	#2 AL JCN, CIC	15	1	15US3.PJ.2222a									1	UH1.1	SEE NOTE 2.
				7	UM6.EL2									8	UM6.C2	
				3	UM6.PK2											
TR-0-2	1	#2 AL JCN, CIC	170	1	UF1.BNa	1	UG1.3-15	2	#2 TPLX					2	SEE PLAN DWG	ONE SINGLE-PHASE SERVICE TO GCI LAND STATION.
				1	UM6.EL2									2	UM6.C2	
				1	UM6.PK2											
SC-1	3	#2 AL JCN, CIC	260	1	15US3.PJ.2222a									4	UM6.C2	SEE NOTES 2, 4, AND 5. FOR 7 EXISTING CONDUCTORS BEING RECONNECTED REMOVE OLD LOAD BREAK ELBOWS AND REPLACE WITH NEW.
				8	UM6.EL2											
				3	UM6.PK2											
				3	UM6.JN2222											

**STAKING SHEET NOTES**

- DIMENSIONS SHOWN IN STAKING SHEET ARE APPROXIMATE. CONTRACTOR SHALL FIELD VERIFY ALL DIMENSIONS.
- SEE PLAN DRAWINGS FOR ADDITIONAL REQUIREMENTS.
- INSTALL NEW CONDUCTORS TO SECTIONALIZING CABINET AND INSTALL EQUIPMENT SHOWN OR SPECIFIED. CABLE SHALL BE INSTALLED AS INDICATED FOR NEW SECTIONALIZING CABINETS.
- INSTALL NEW SECTIONALIZING CABINET IN LOCATION OF THE EXISTING SECTIONALIZING CABINET. MODIFY PIPE RAIL BOLLARD AS REQUIRED TO PROVIDE FRONT ACCESS TO THE NEW SECTIONALIZING CABINET. RECONNECT THE EXISTING DISTRIBUTION PRIMARY CONDUCTORS TO THE NEW CABINET. PERFORM WORK IN A MANNER TO MINIMIZE COMMUNITY POWER OUTAGES.
- AFTER OLD POWER PLANT IS DE-ENERGIZED, REMOVE THE EXISTING STEP-UP TRANSFORMER FEED AND INSTALL INSULATED CAPS OVER JUNCTION POINTS. CUT THE EXISTING DE-ENERGIZED CABLES OUTSIDE OF THE CABINET.
- BURY SECONDARY CABLE 24" DEEP.
- ALL HARDWARE AND FASTENERS SHALL BE 316 STAINLESS STEEL.
- RUS UNIT US3.PJa, SECTIONALIZING CABINET, IS NOT COMPLETE AS SHOWN ON THE RUS CONSTRUCTION UNIT. REFER TO DETAILS ON THE DRAWINGS AND SPECIFICATIONS TO DETERMINE COMPLETE REQUIREMENTS FOR SECTIONALIZING CABINETS.

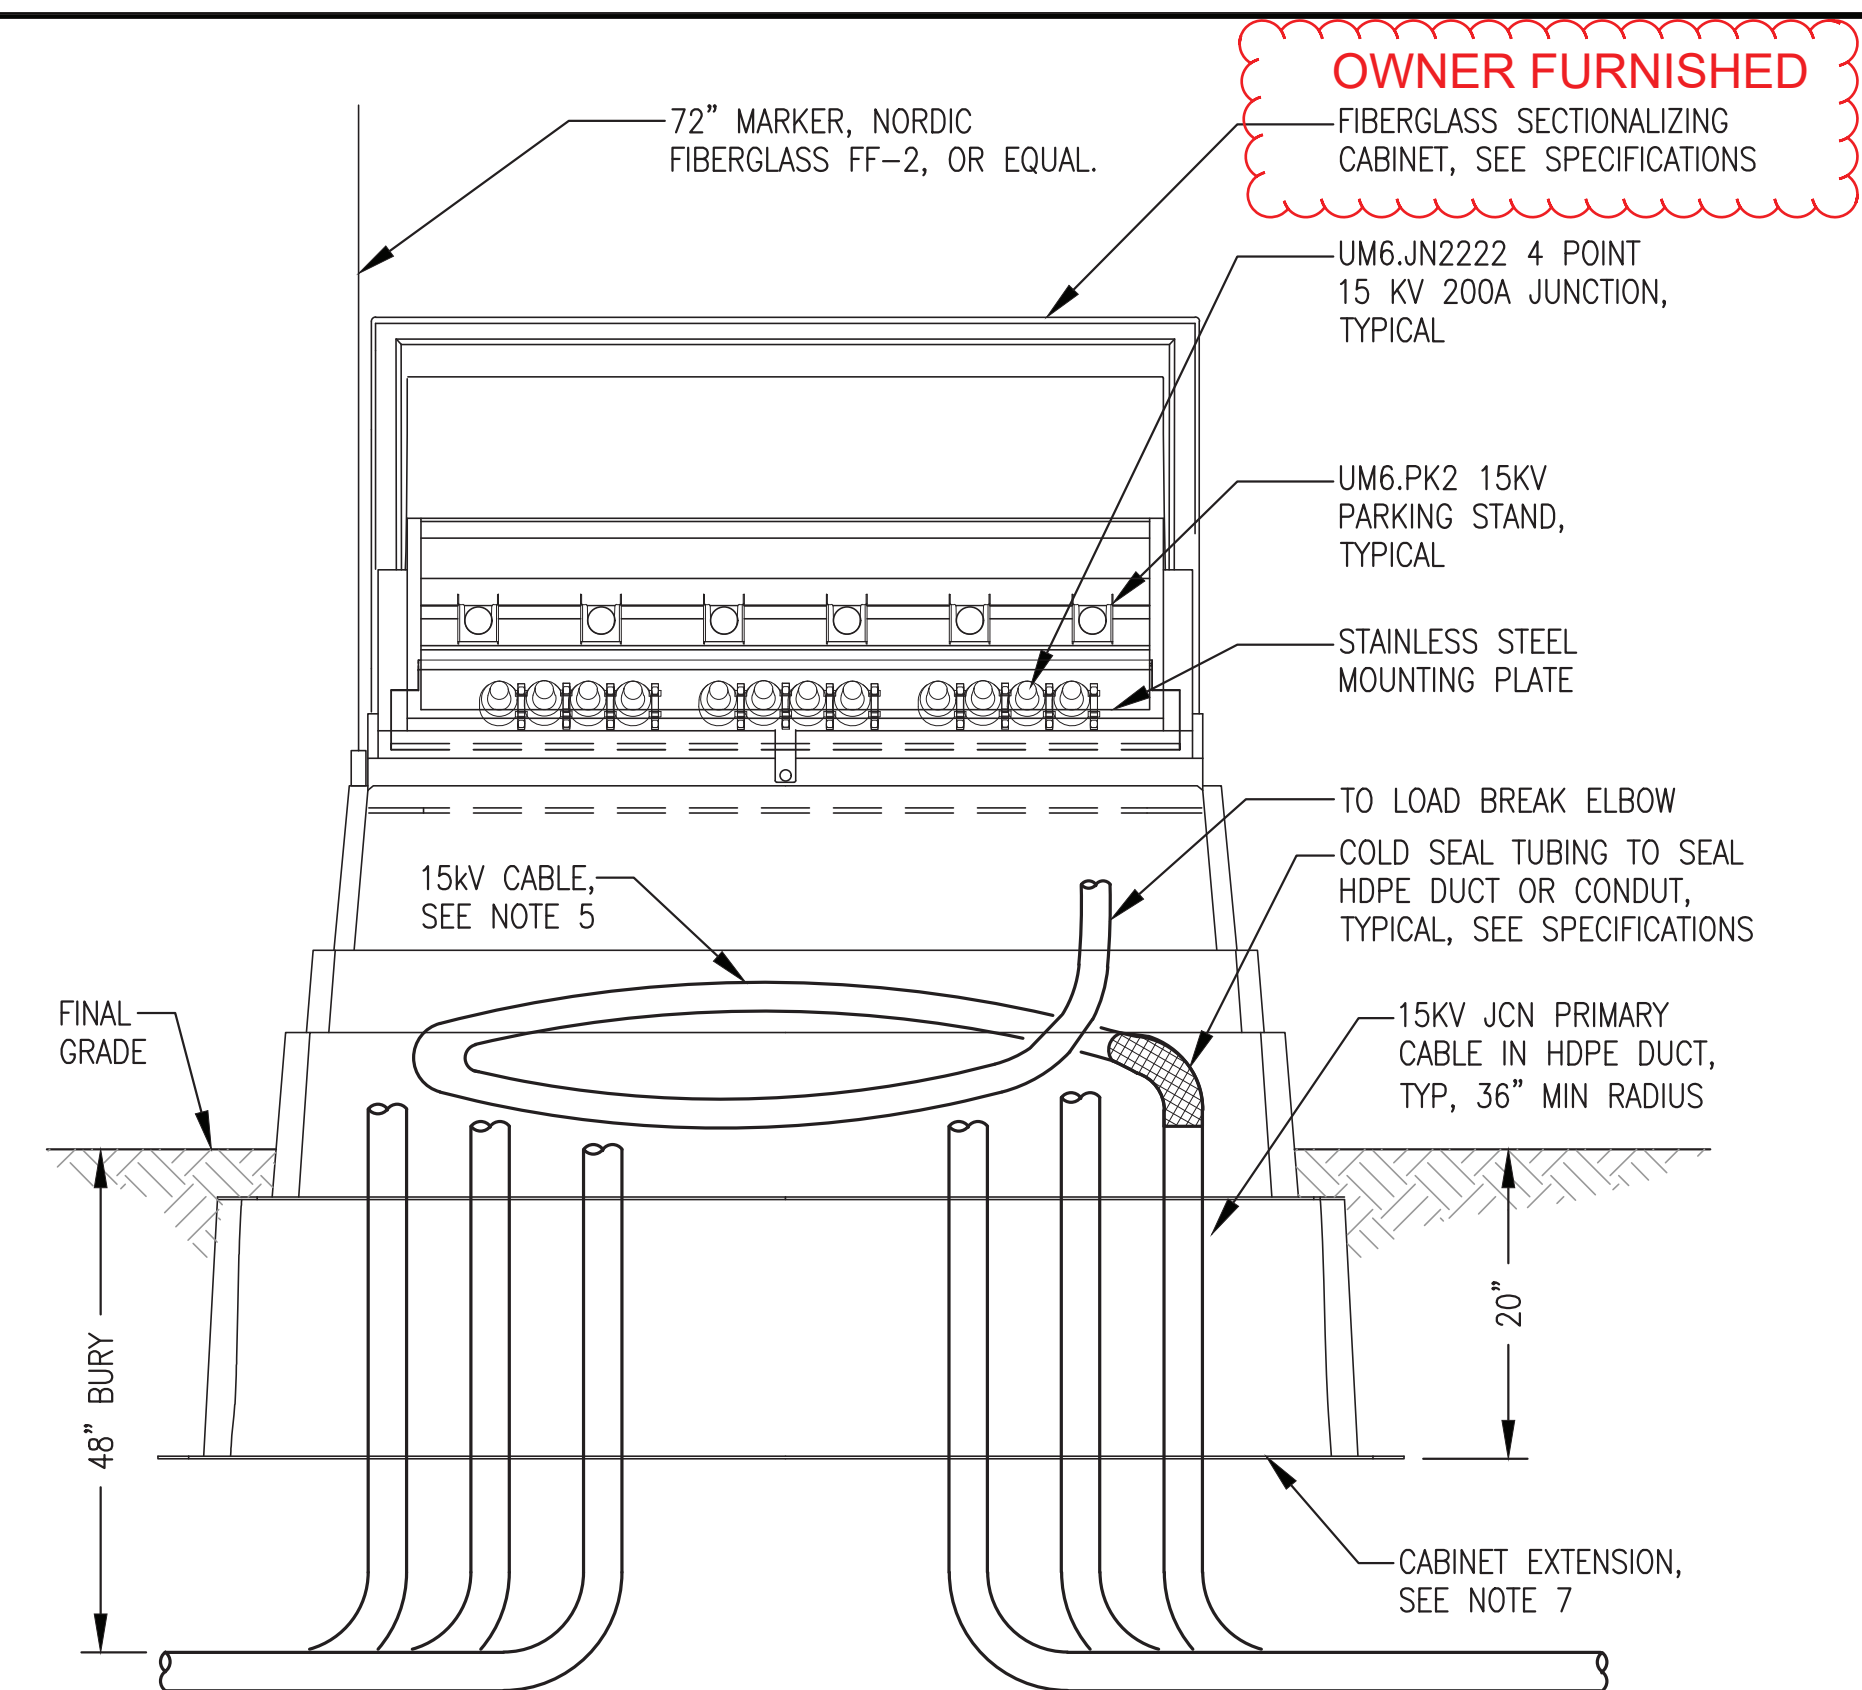

- NOTES:**
- INSTALL GROUNDING LUG, HUBBELL/FARGO CC-207P ON EACH MOUNTING BOARD AND CONNECT TO GROUND.
  - SEE RUS US3.PJ FOR ADDITIONAL GROUNDING NOTES.
  - INSTALL DRAIN WIRE ON EACH UM6.C2.
  - ENSURE THAT ALL METAL COMPONENTS ARE GROUNDING.
  - PROVIDE SLACK IN THE CABLE TO THE MAXIMUM EXTENT PRACTICABLE. IF POSSIBLE, PROVIDE ONE FULL LOOP AROUND THE BASE OF THE GROUND SLEEVE OR SECTIONALIZING CABINET. SEE SPECIFICATIONS.
  - INSTALL EQUIPMENT NAME ON OUTSIDE OF CABINET. SEE SPECIFICATIONS.
  - PROVIDE 18" CABINET EXTENSION. SEE SPECIFICATIONS
  - RUS CONSTRUCTION UNITS MAY NOT BE COMPLETE. SEE STAKING SHEET FOR COMPLETE UNIT NUMBERS.
  - ALL METAL MATERIAL SHALL BE TYPE 316 STAINLESS STEEL.

**1** RUS US3.PJa PRIMARY SECTIONALIZING CABINET INSTALLATION  
NO SCALE

**OWNER FURNISHED**  
TRANSFORMER GROUND SLEEVE, TRANSFORMER NOT SHOWN. SEE NOTE 1.


- NOTES:**
- THREE PHASE OR SINGLE PHASE AS INDICATED ON THE DRAWINGS AND STAKING SHEETS.
  - PROVIDE SLACK IN THE CABLE TO THE MAXIMUM EXTENT PRACTICABLE. IF POSSIBLE, PROVIDE ONE FULL LOOP AROUND THE BASE OF THE GROUND SLEEVE.
  - INSTALL DRAIN WIRE TO EACH UM6.EL2 AND UM6.C2.
  - SEE RUS CONSTRUCTION UNITS UH1.1 FOR ADDITIONAL REQUIREMENTS.
  - RUS CONSTRUCTION UNITS MAY NOT BE COMPLETE. SEE STAKING SHEET FOR COMPLETE UNIT NUMBERS.

**GENERAL NOTES**

- ALL INSTALLATION SHALL MEET THE LATEST ADOPTED EDITION OF THE NATIONAL ELECTRICAL SAFETY CODE (NEC), ANSI C2, INCLUDING ANY STATE OF ALASKA AMENDMENTS. RUS BULLETIN 1728F-806 (RD-GD-2018-93), SPECIFICATIONS AND DRAWINGS FOR UNDERGROUND ELECTRIC DISTRIBUTION SHALL BE FOLLOWED UNLESS SPECIFICALLY MODIFIED BY THESE DRAWINGS OR SPECIFICATIONS. ALL MATERIAL SHALL BE RUS APPROVED. OBTAIN COPIES OF THE RUS BULLETINS AND MAINTAIN COPIES OF THE BULLETINS AND SPECIFICATIONS AT THE JOB SITE AT ALL TIMES.
- THE DRAWINGS, STAKING SHEETS, AND SPECIFICATIONS ARE COMPLEMENTARY. WHAT IS SHOWN ON ONE IS BINDING WHETHER SHOWN ON THE OTHER OR NOT. DEFECTS OR DEFICIENCIES SHALL BE CORRECTED IN ACCORDANCE WITH ALL REQUIREMENTS OF THE DRAWINGS, STAKING SHEETS, AND SPECIFICATIONS.


**DISTRIBUTION TRANSFORMER SCHEDULE (OWNER FURNISHED)**

TRANSFORMER NUMBER	CAPACITY	PHASE	HIGH VOLTAGE	LOW VOLTAGE	NOTES
TR-0-1 COMMUNITY FEEDER	150kVA	3φ	12.47/7.2 kV GROUNDED WYE	480/277V	WITH FIBERGLASS GROUND SLEEVE
TR-0-2 GCI EARTH STATION	15kVA	1φ	7.2kV	240/120V	WITH FIBERGLASS GROUND SLEEVE

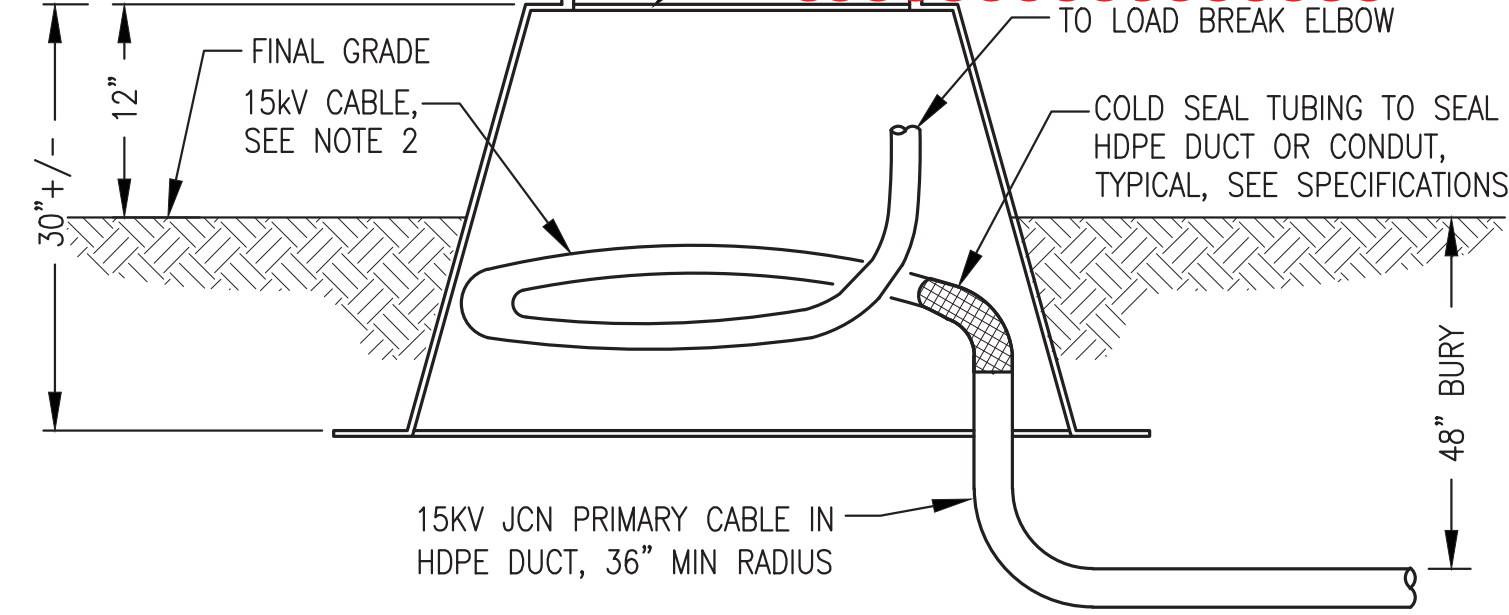


**2** RUS UF1.BNa & UF3.BNa TRANSFORMER GROUND SLEEVE INSTALLATION  
NO SCALE

- NOTES:**
- BURY PRIMARY CABLE IN DUCT 48" MIN. BURY SECONDARY UD CABLE 36" MIN.
  - INSTALL SECONDARY UD CABLE IN PVC CONDUIT WHERE INDICATED ON PLANS.

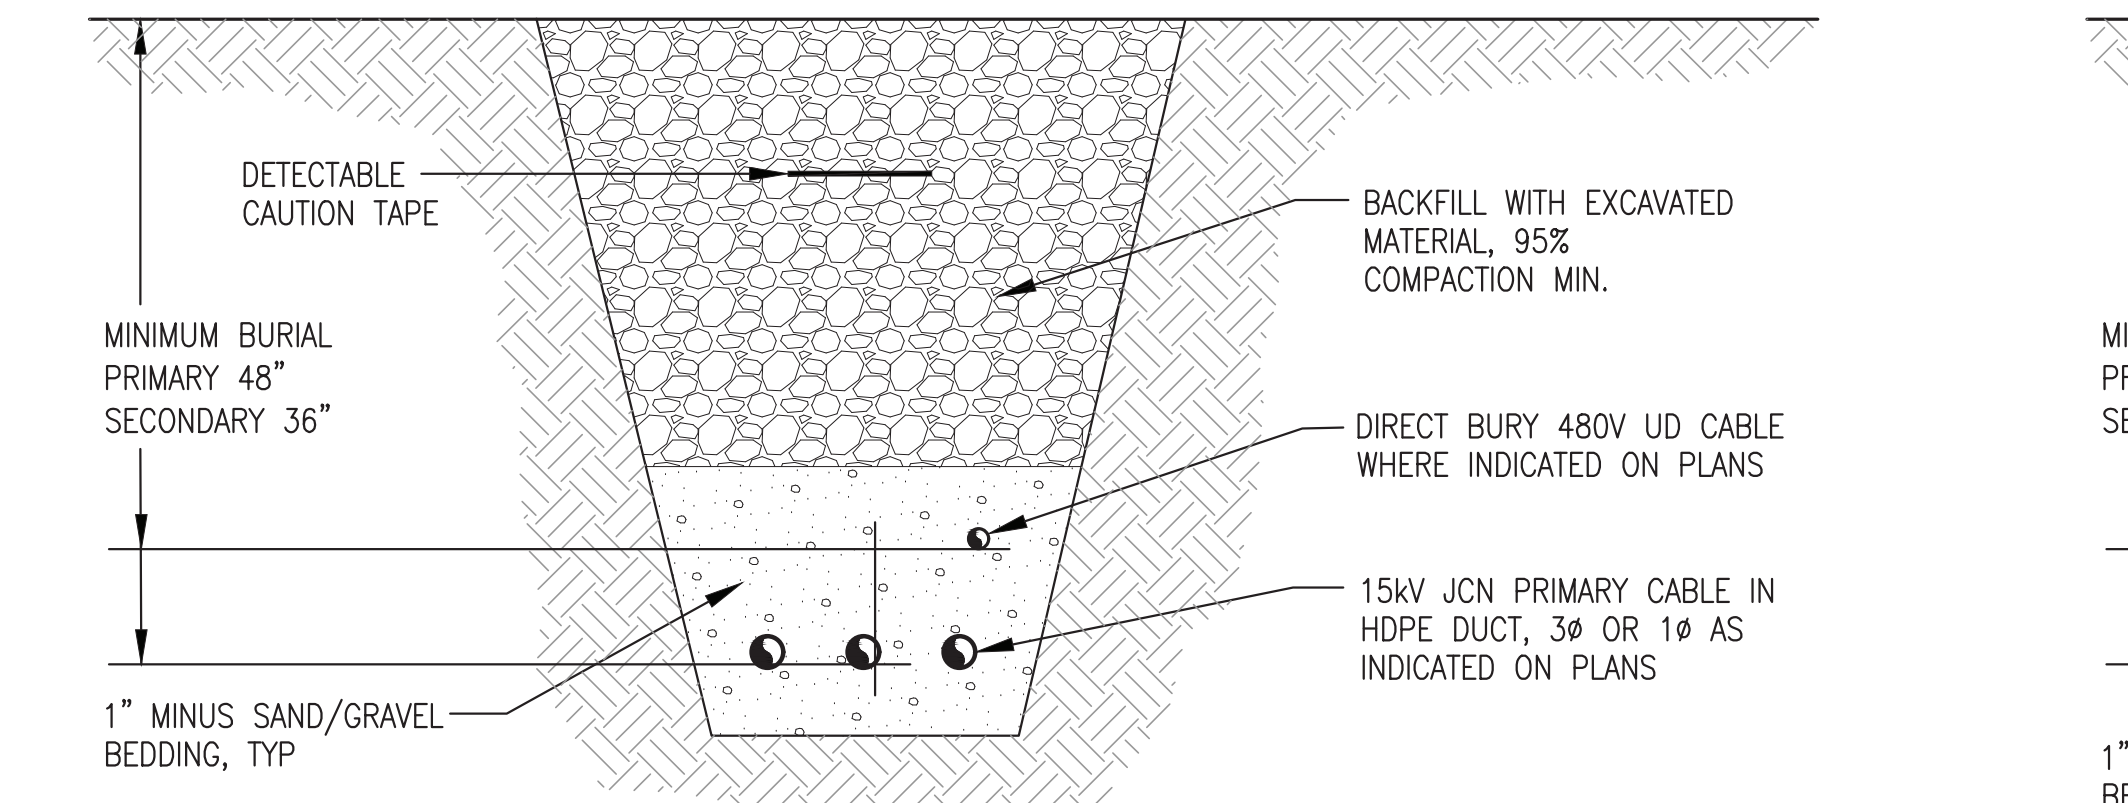

**3** TYPICAL BURIED PRIMARY INSTALLATION  
NO SCALE

- NOTES:**
- SEE MECHANICAL FOR LOCATIONS WHERE POWER CABLES ARE BURIED WITH ARCTIC PIPE.
  - COORDINATE TRADES TO INSTALL ALL BURIED UTILITIES TOGETHER.

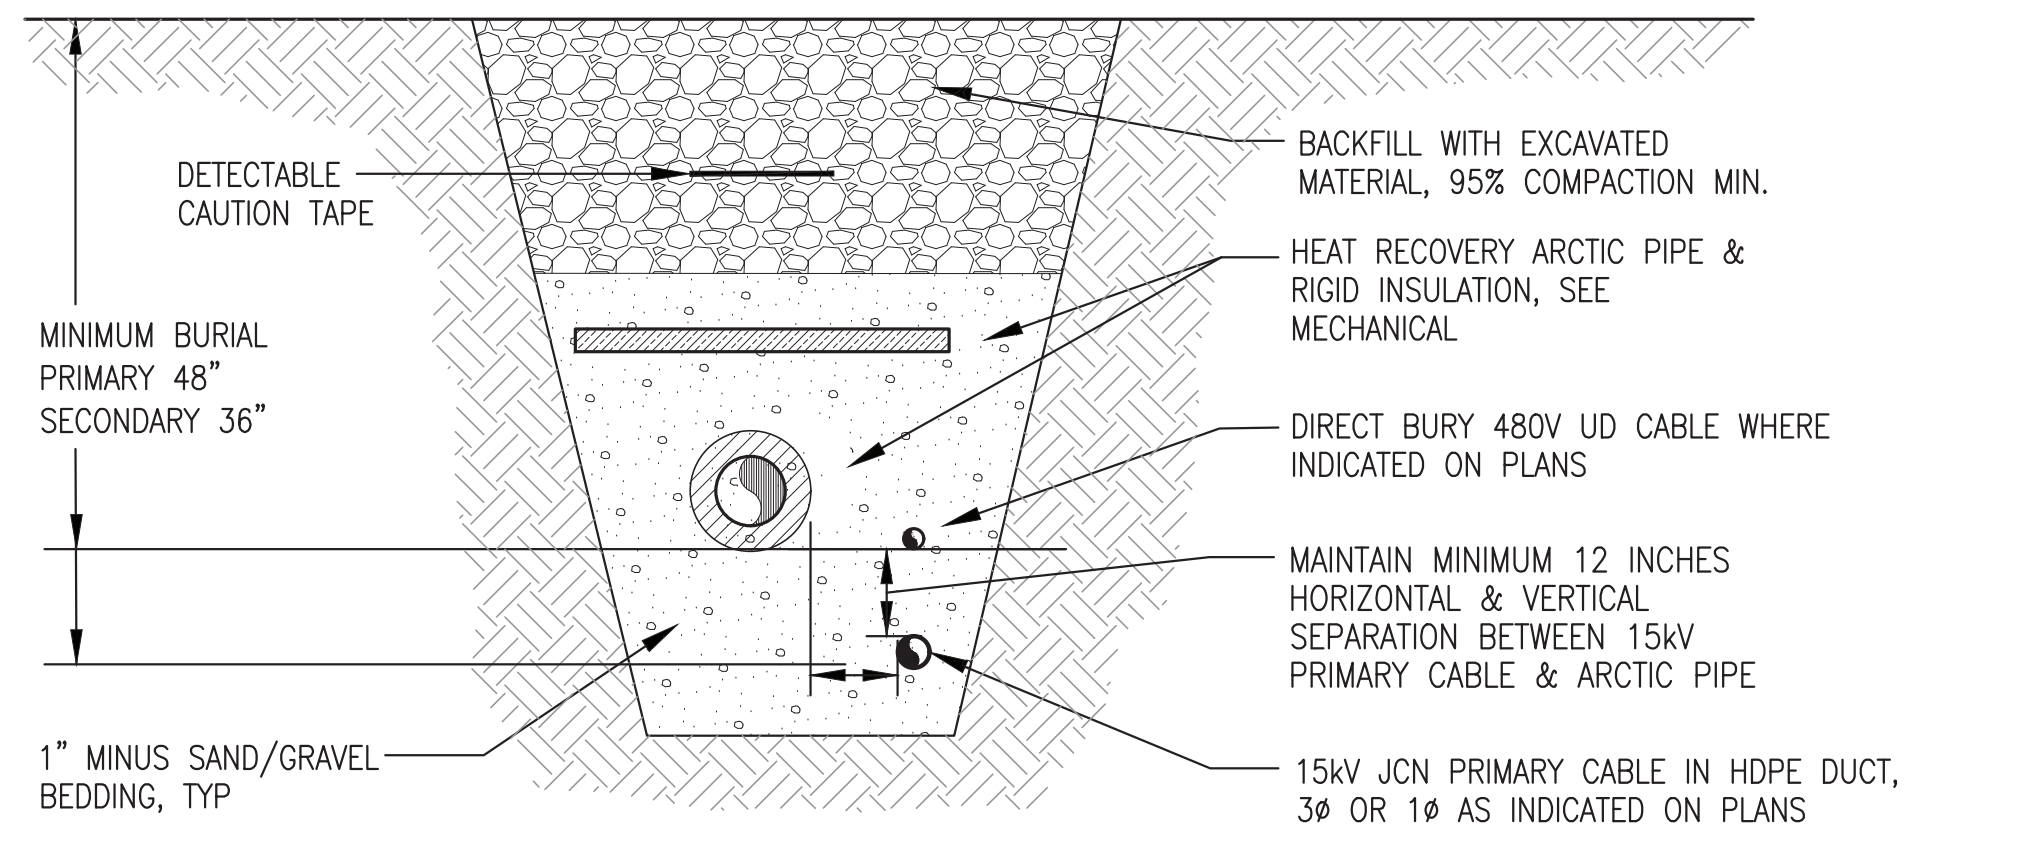

**4** TYPICAL BURIED PRIMARY INSTALLATION WITH OTHER UTILITIES  
NO SCALE

ALL WORK ON THIS SHEET IS INCLUDED IN THE ON SITE CONTRACT. NOTE THAT THE PAD MOUNT TRANSFORMERS, GROUND SLEEVES, AND FIBERGLASS SECTIONALIZING CABINETS ARE OWNER PROVIDED AND CONTRACTOR INSTALLED.

ISSUED FOR CONSTRUCTION  
MAY 2023



**ALASKA ENERGY AUTHORITY**

PROJECT: NESLON LAGOON POWER SYSTEM UPGRADE


TITLE: POWER PLANT AREA STAKING SHEET & DISTRIBUTION DETAILS

DESIGNED BY: CWV/BCG  
FILE NAME: NELS PP E1  
PROJECT NUMBER:

DRAWN BY: JTD  
SCALE: NO SCALE

DATE: 5/30/23  
SHEET: E1.4

Gray Stassel Engineering, Inc.  
P.O. 111405, Anchorage, AK 99511 (907)349-0100

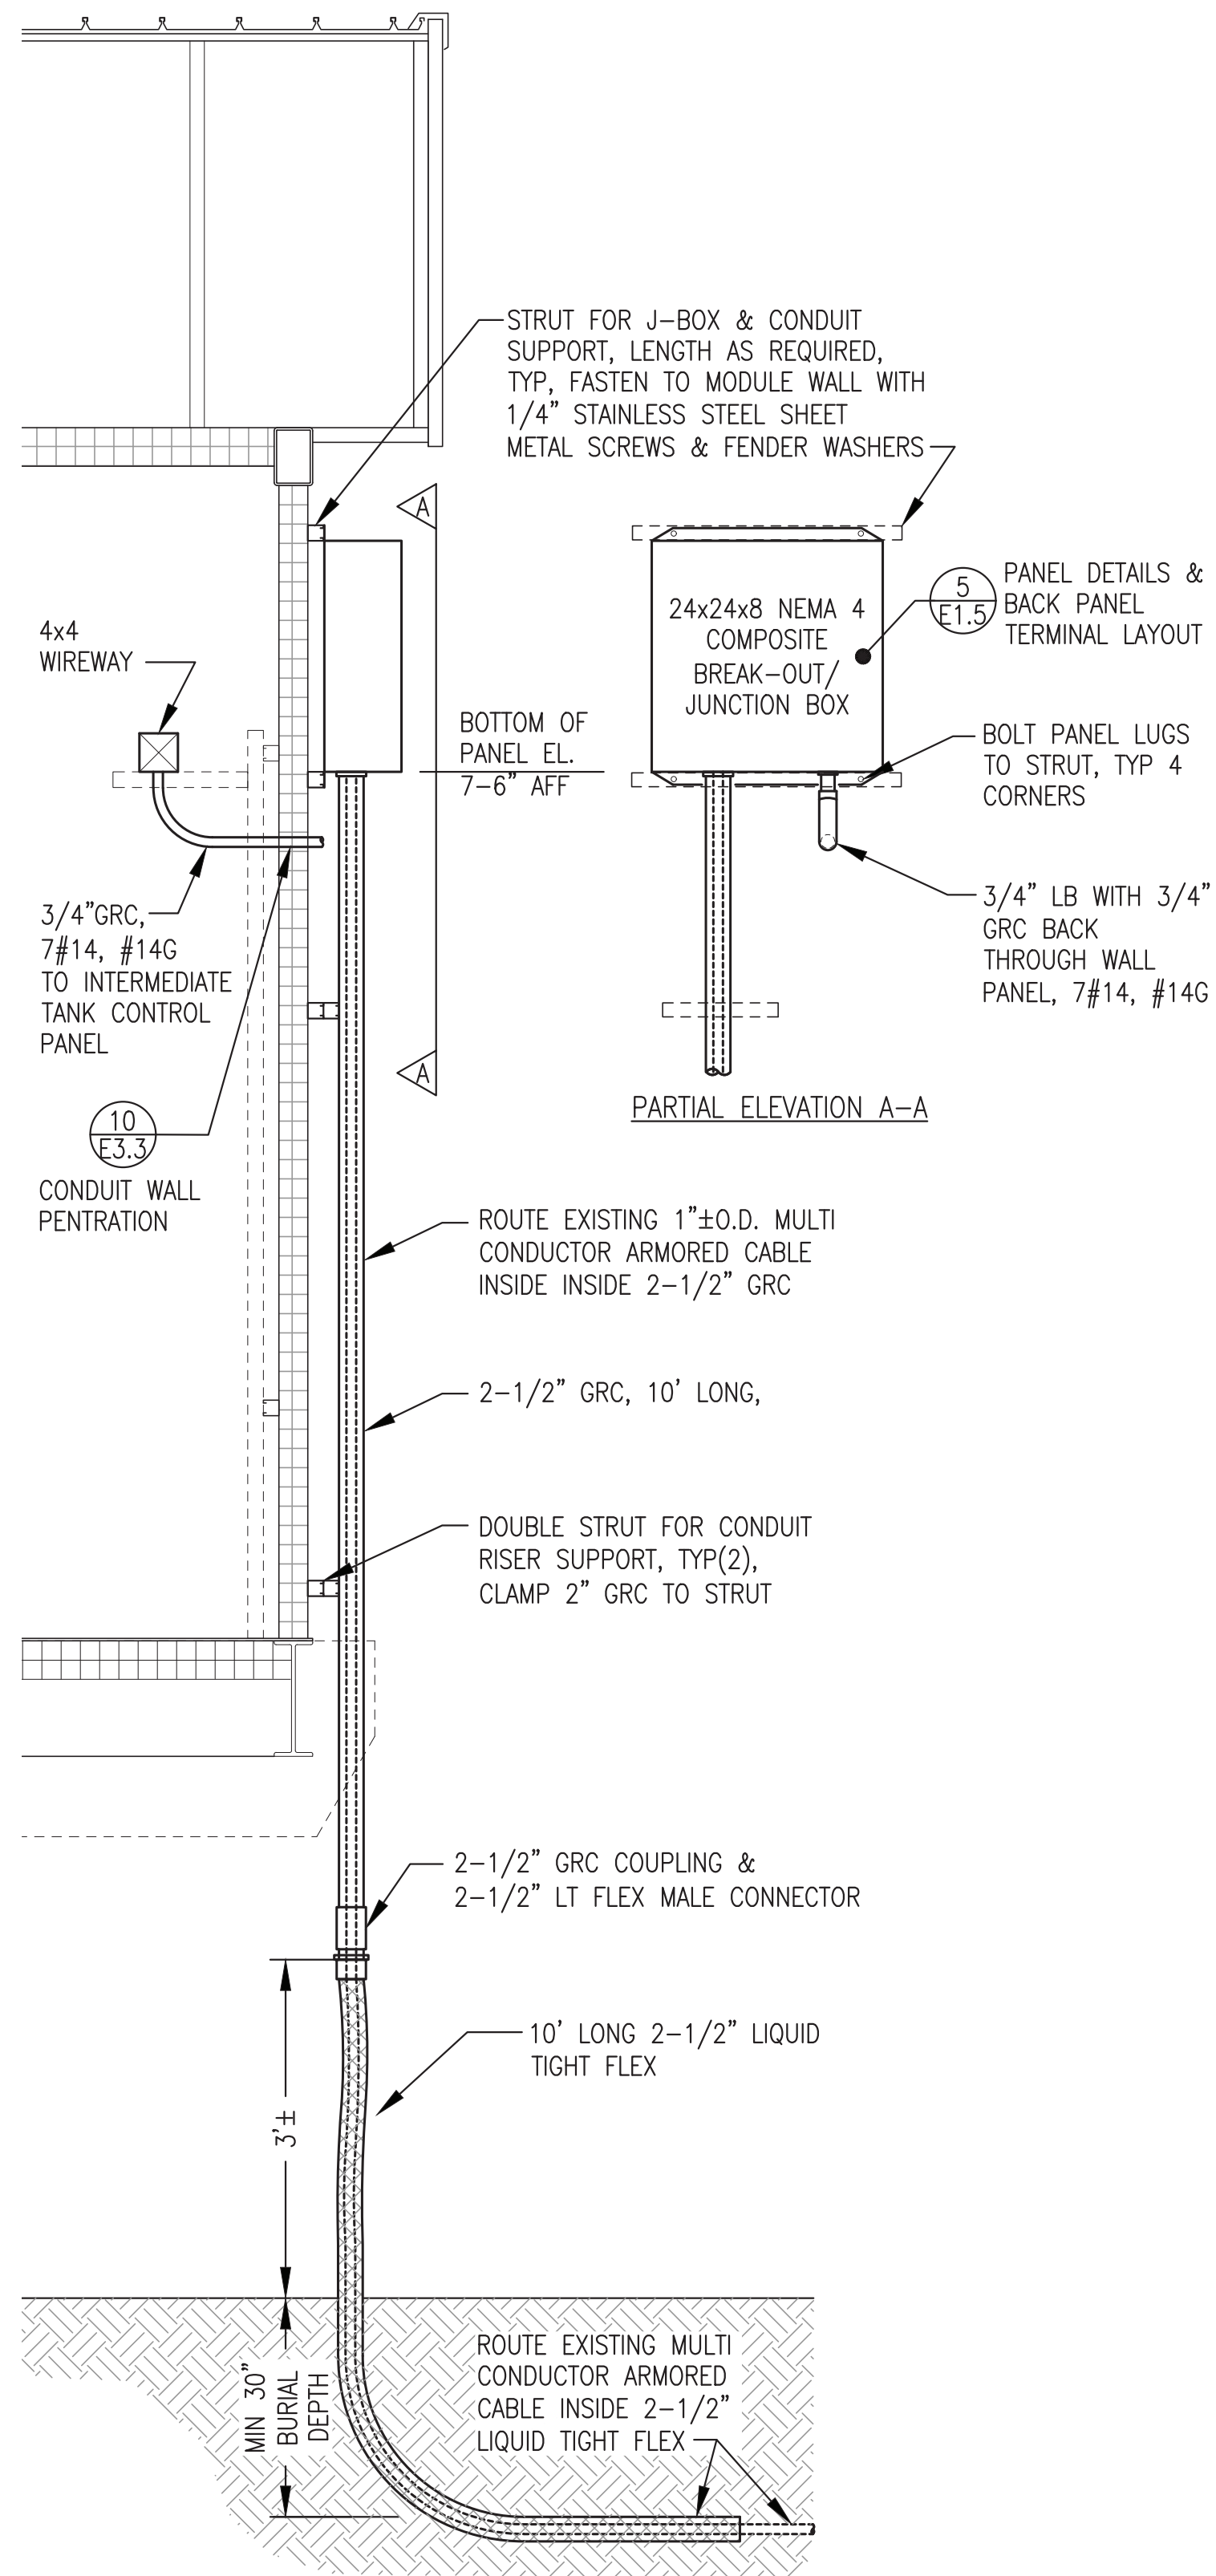


**1** TANK FARM CONDUCTOR BREAK-OUT/J-BOX INSTALLATION  
E1.5 NO SCALE

NOTES:  
1) PRIOR TO REMOVING EXISTING VALVE, VERIFY CONNECTIONS & FUNCTION. RECONNECT EXISTING CONDUCTORS TO NEW VALVE TO MATCH FUNCTION.

2) SEE MECHANICAL FOR ACTUATED BALL VALVE SPECIFICATIONS & INSTALLATION.

RECONNECT EXISTING 4#14, #14G & EXISTING 3/4\"/>


NEW 2\"/>

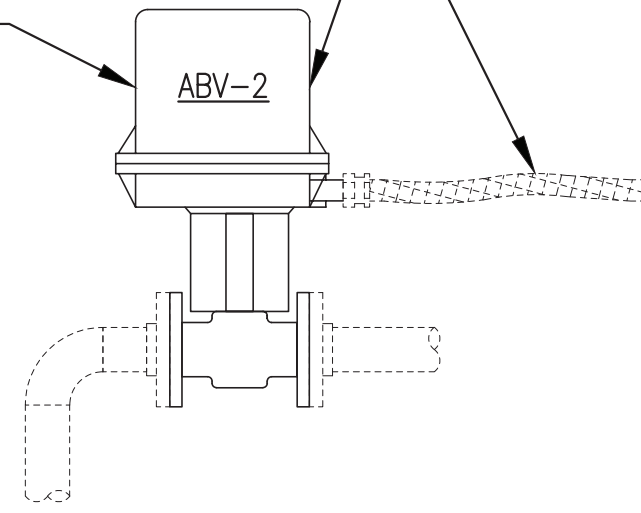

**2** TANK FARM ACTUATOR ABV-2 CONNECTION  
E1.5 NO SCALE

NOTES:  
1) ACTUATED BALL VALVE CONTROLLED FROM FUEL SYSTEM CONTROL PANEL IN POWER PLANT, SEE LOGIC DIAGRAM SHEET E7.1 FOR CONDUCTOR TERMINATIONS.

2) SEE MECHANICAL FOR ACTUATED BALL VALVE SPECIFICATIONS & INSTALLATION.

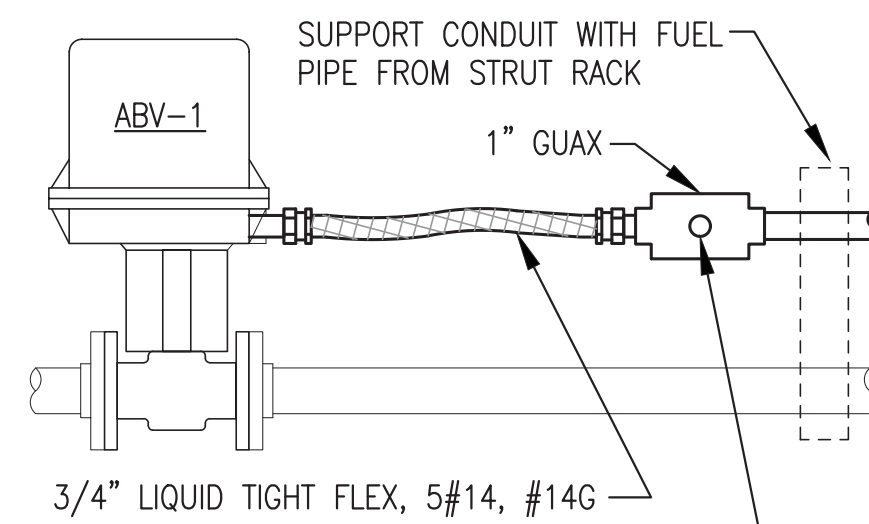


**3** INT. TANK ACTUATOR ABV-1 CONNECTION  
E1.5 NO SCALE


ROUTE LEVEL PROBE LEAD WIRE THROUGH 1/2\"/>

NOTES:  
1) PROBE (LSP) SPECIFIED ON INSTRUMENTATION SCHEDULE SHEET M1.1.

2) FURNISH 89\"/>

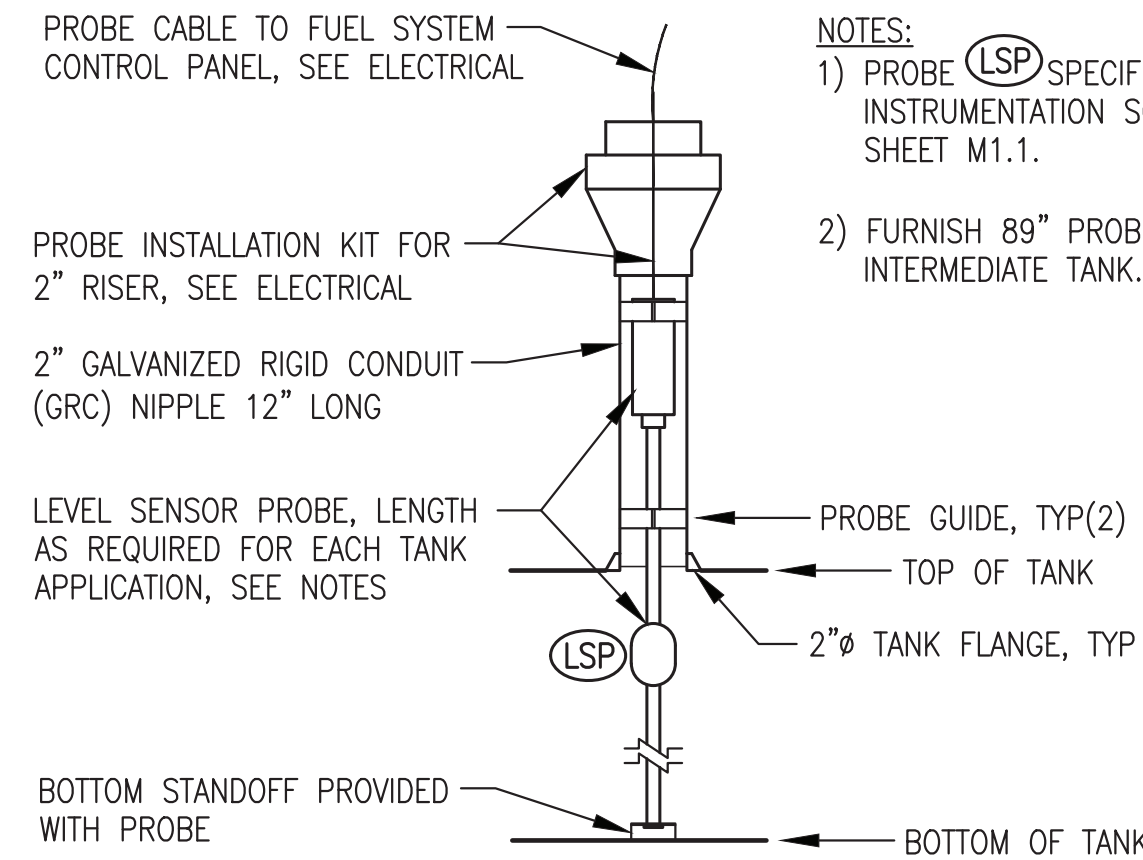


**4** INTERMEDIATE TANK LEVEL SENSOR PROBE INSTALLATION  
E1.5 NO SCALE

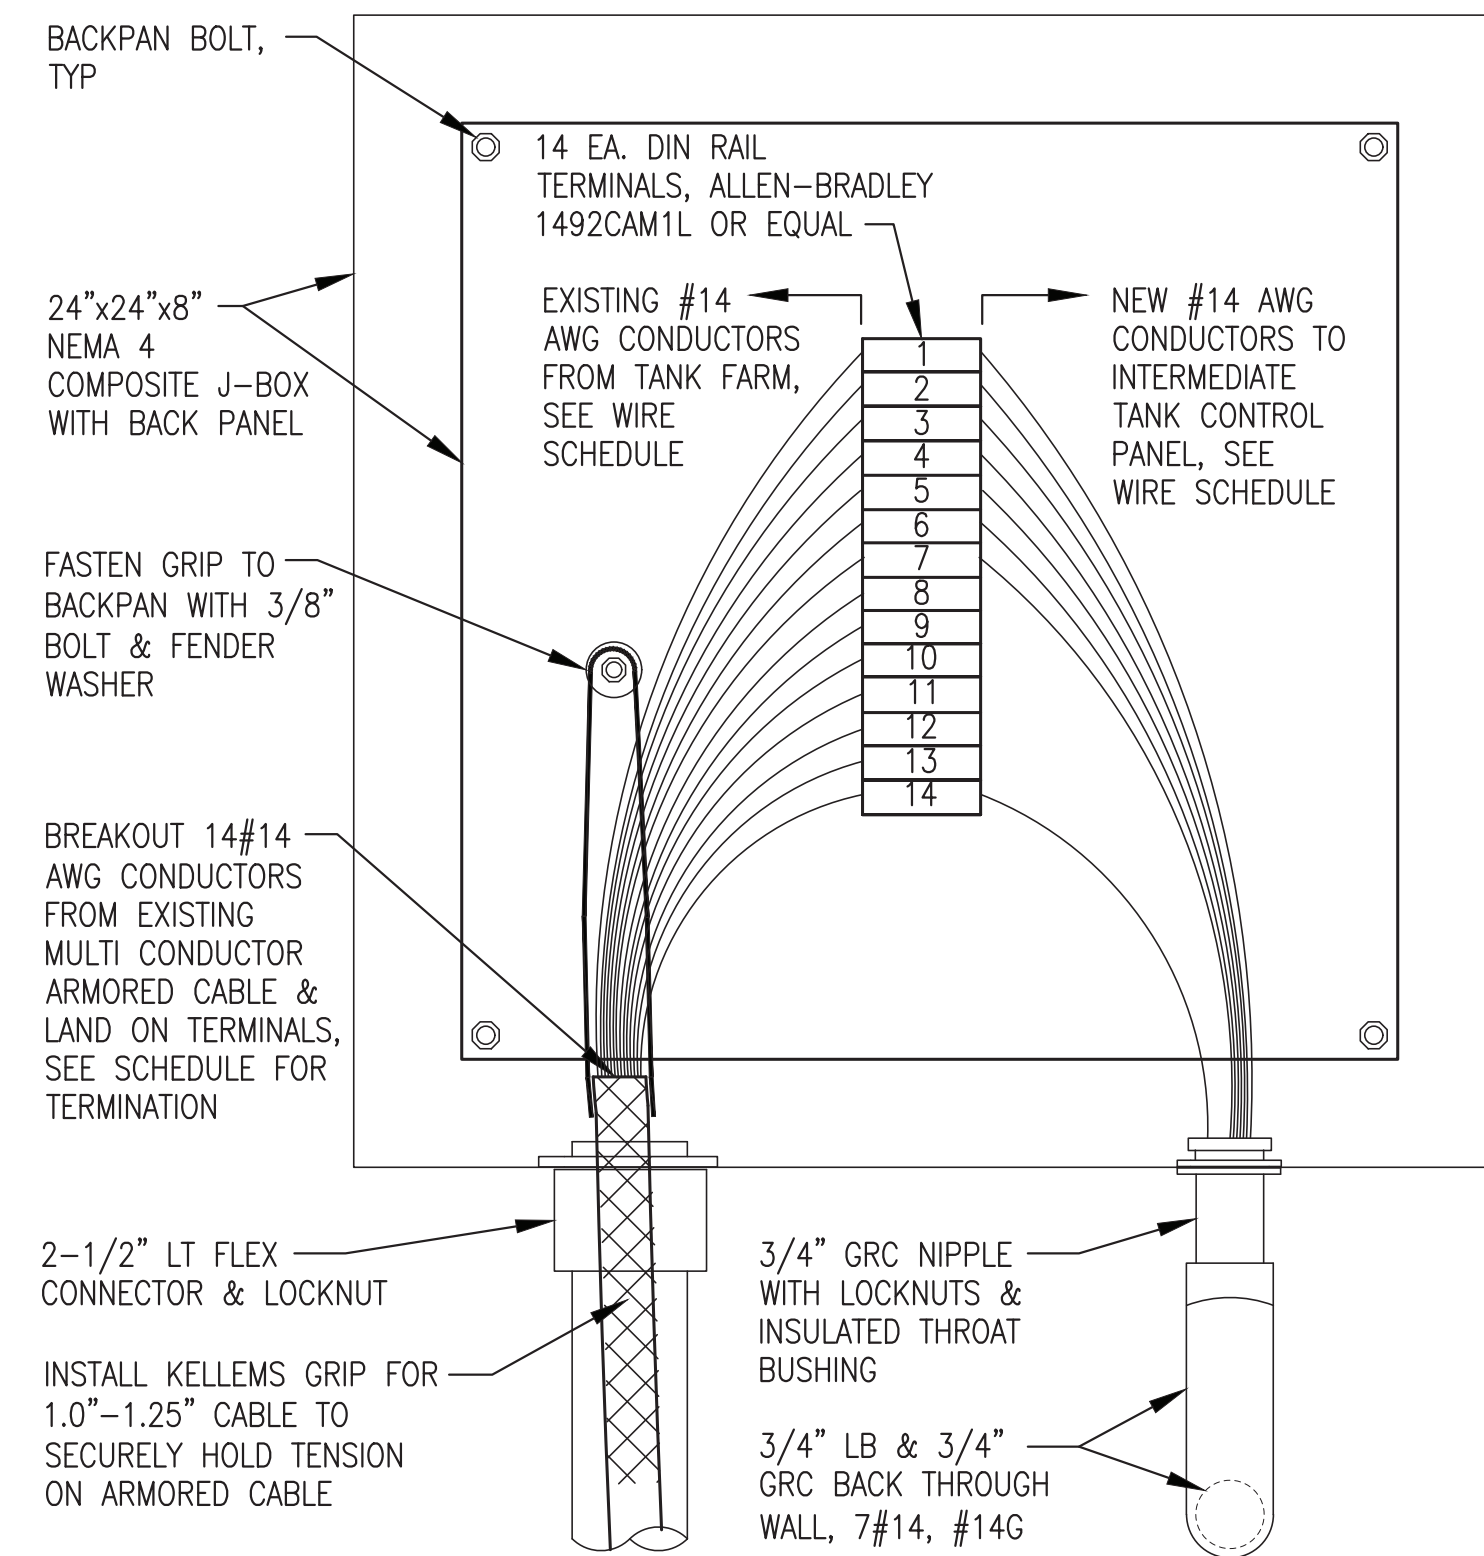

NEW J-BOX TERMINAL NUMBER (ABOVE)	WIRE TAG NUMBER	INTERMEDIATE TANK CONTROL PANEL TERMINAL NUMBER	FUNCTION	EXISTING WIRE COLORS: #14 BREAK OUT CONDUCTORS FROM TANK FARM TO NEW J-BOX TERMINAL	NEW WIRE COLORS: CONDUCTORS FROM NEW J-BOX TERMINAL TO INTERMEDIATE TANK CONTROL PANEL
1	73	101	PANEL POWER	BLACK	BLACK
2	74	102	PANEL NEUTRAL	WHITE	WHITE
3	76	105	PUMP TP-1 LATCH	BLACK/DARK BLUE	BLUE WITH 105 TAG
4	77	106	CONTACTOR M1 COIL	BLACK/ORANGE	BLUE WITH 106 TAG
5	71	107	REMOTE ALARM HORN	BLACK/LIGHT BLUE	BLUE WITH 107 TAG
6	72	108	REMOTE ALARM HORN	RED/BLUE	BLUE WITH 108 TAG
7	77	109	OVERFILL INDICATION	BROWN/RED	BLUE WITH 109 TAG
8	N/A	8	SPARE	RED	
9	N/A	9	SPARE	BLUE	
10	N/A	10	SPARE	ORANGE	
11	N/A	11	SPARE	YELLOW	
12	N/A	12	SPARE	BROWN	
13	N/A	13	SPARE	BLACK/BROWN	
14		GROUND	GROUND	GREEN	GREEN

**5** TANK FARM CONDUCTOR BREAK-OUT/JUNCTION BOX DETAILS  
E1.5 NO SCALE

NOTE: ALL NEW CONDUCTORS THIS SCHEDULE #14 AWG XHHW. COLOR & TAG AS INDICATED.

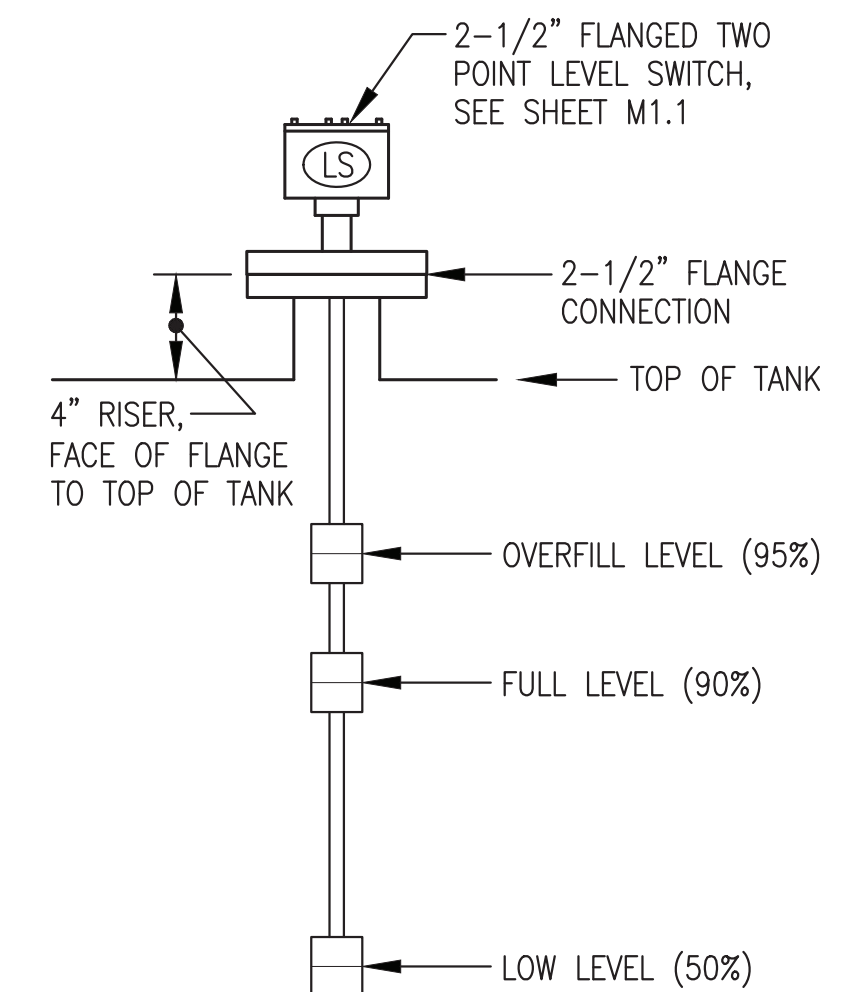

NOTES:  
1) PRIOR TO INSTALLING IN TANK, MAKE TEMPORARY ELECTRICAL CONNECTIONS AND MANUALLY MANIPULATE EACH FLOAT IN ORDER TO VERIFY ACTUATION LENGTH AND N.O./N.C. FUNCTION IN ACCORDANCE WITH SPECIFICATIONS ON INSTRUMENTATION SCHEDULE SHEET M1.1.

2) LABEL FLOAT SWITCH TERMINALS WITH THE NUMBER OF THE ASSOCIATED HOME RUN LANDING ON THE TERMINALS IN THE INTERMEDIATE TANK CONTROL PANEL. SEE EXISTING TANK FARM PANEL REFERENCE DRAWINGS SHEET E-09.

3) AFTER INSTALLATION, VERIFY PROPER CONTROL FUNCTION USING TEMPORARY JUMPERS.

**6** LEVEL SWITCH INSTALLATION  
E1.5 NO SCALE


ALL WORK ON THIS SHEET IS INCLUDED IN THE ON SITE CONTRACT.

ISSUED FOR CONSTRUCTION  
MAY 2023




ALASKA ENERGY AUTHORITY	
PROJECT: NESLON LAGOON POWER SYSTEM UPGRADE	
TITLE: POWER PLANT SITE ELECTRICAL DETAILS	
Gray Stassel Engineering, Inc.	SCALE: NO SCALE
DRAWN BY: JTD	DATE: 5/30/23
DESIGNED BY: CWV/BCG	SHEET: E1.5
FILE NAME: NELS PP E1	PROJECT NUMBER:
P.O. 111405, Anchorage, AK 99511 (907)349-0100	



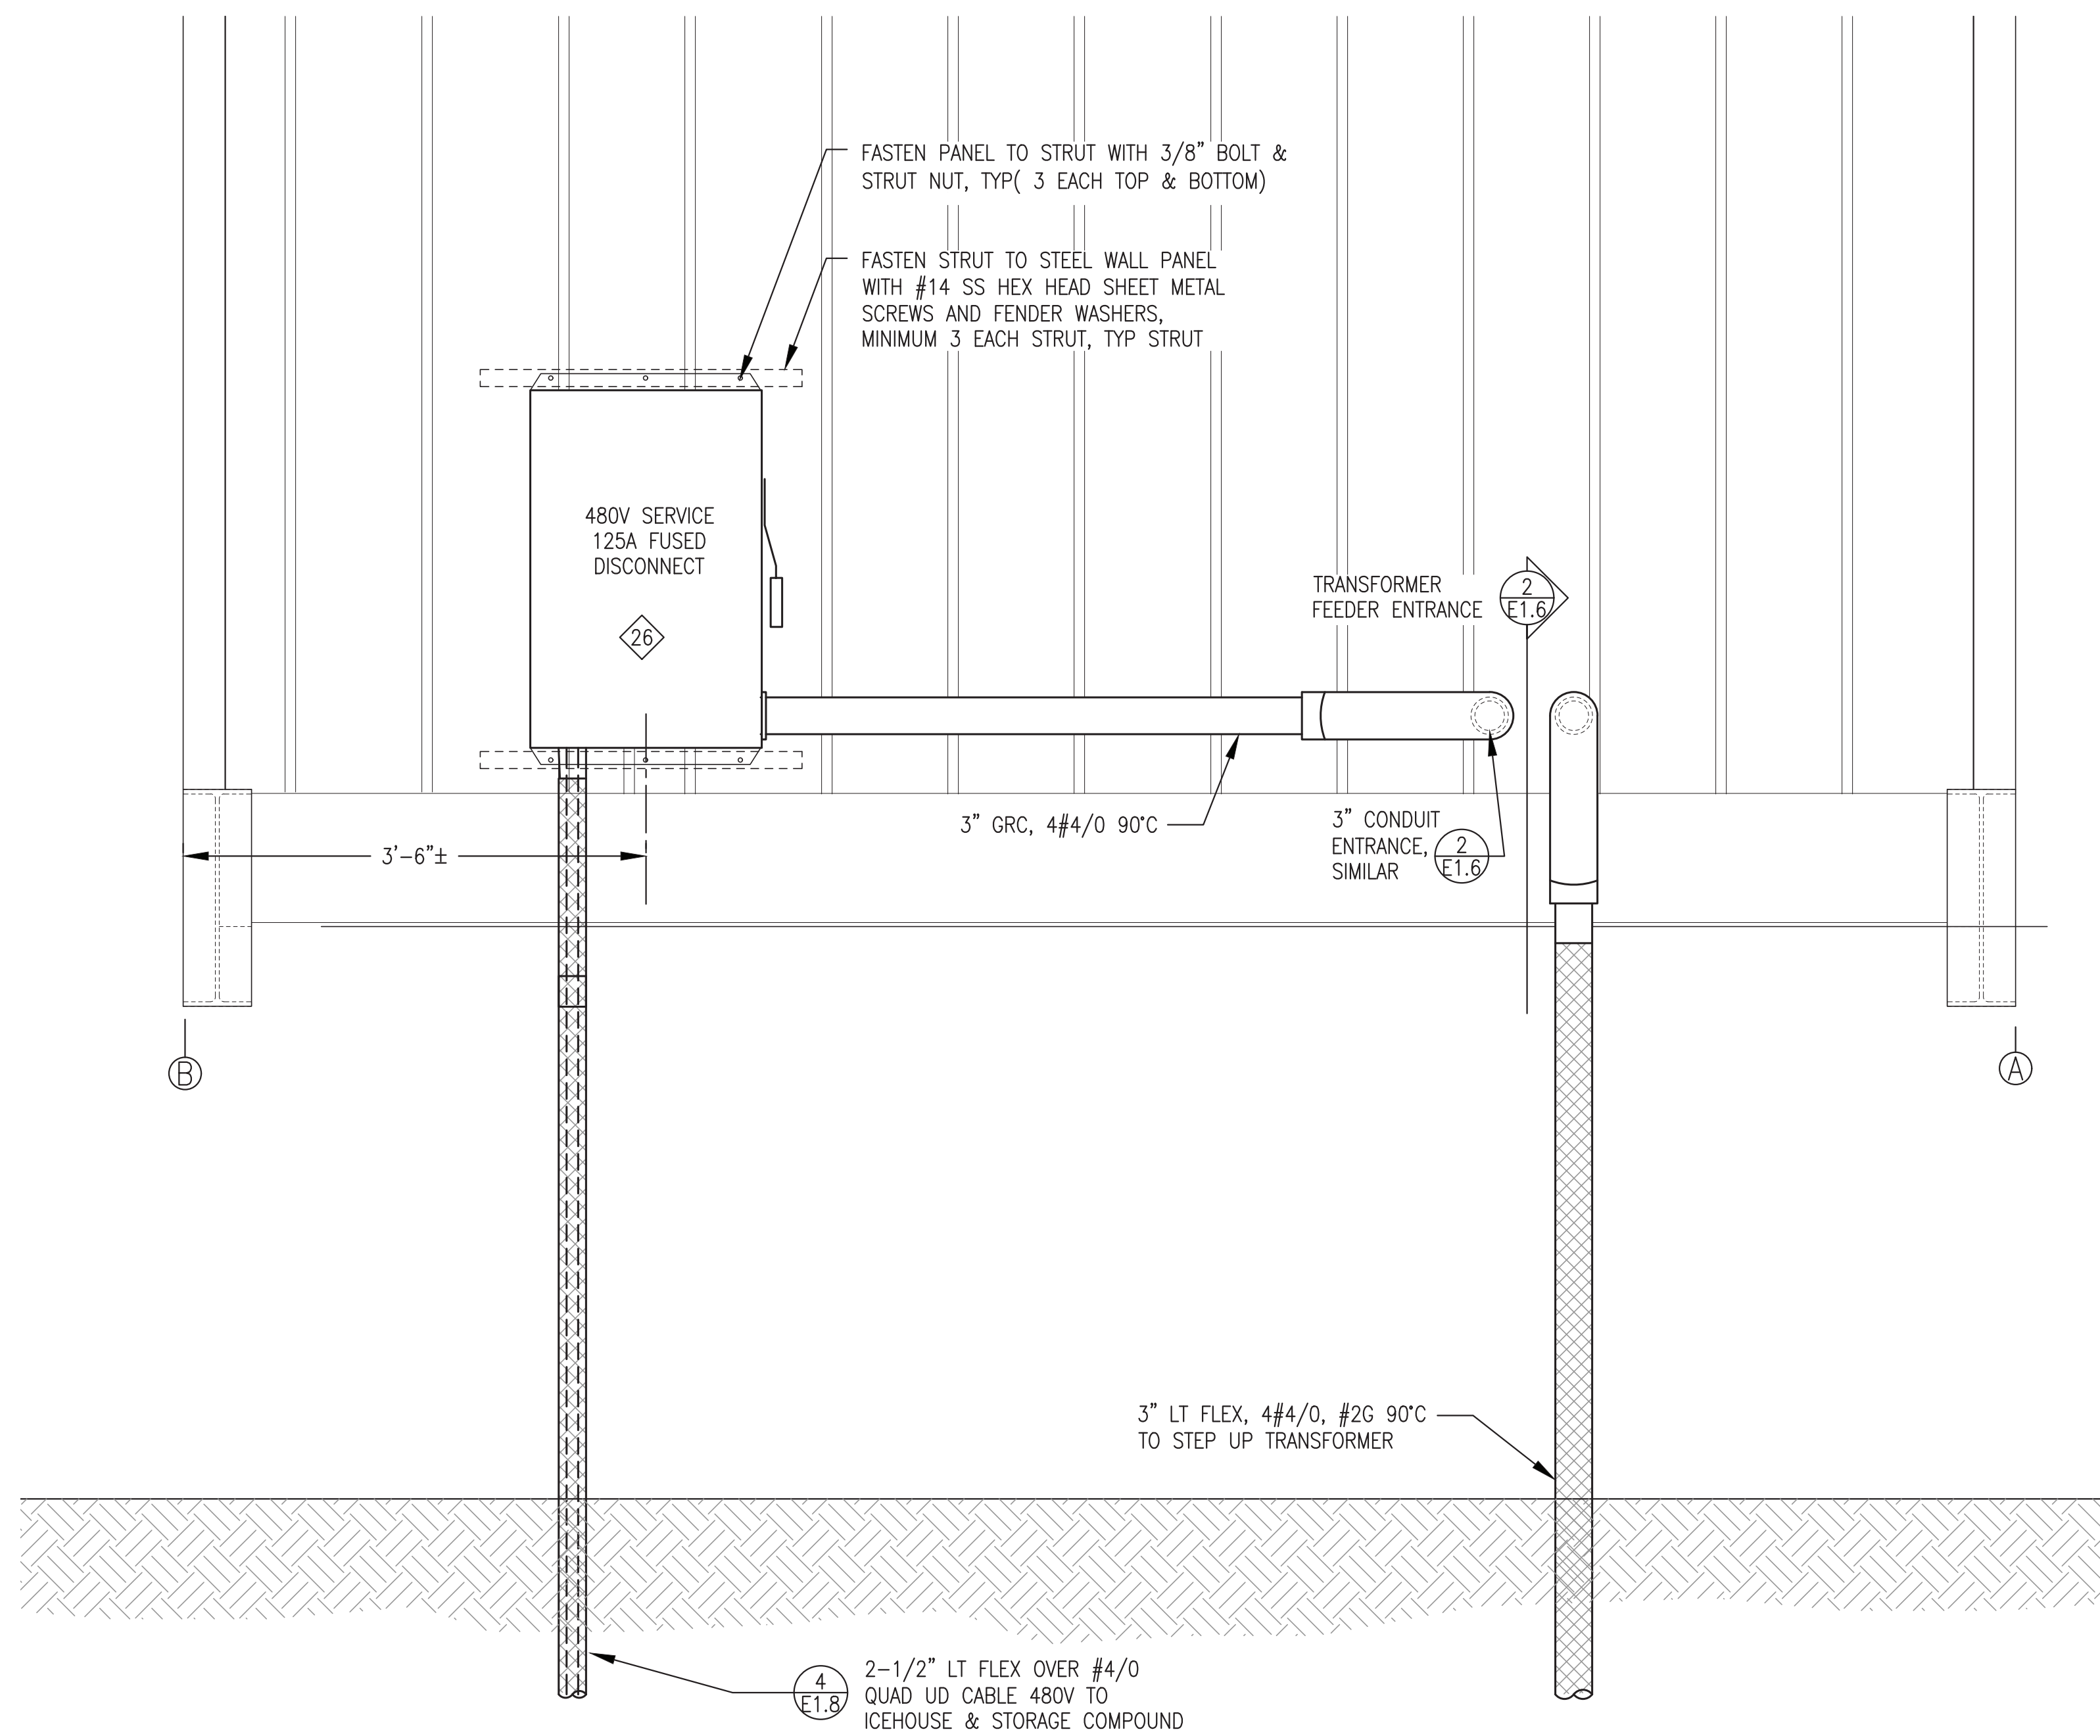

**1** MODULE PARTIAL SOUTH END WALL FEEDER ELEVATION  
**E1.6** NO SCALE

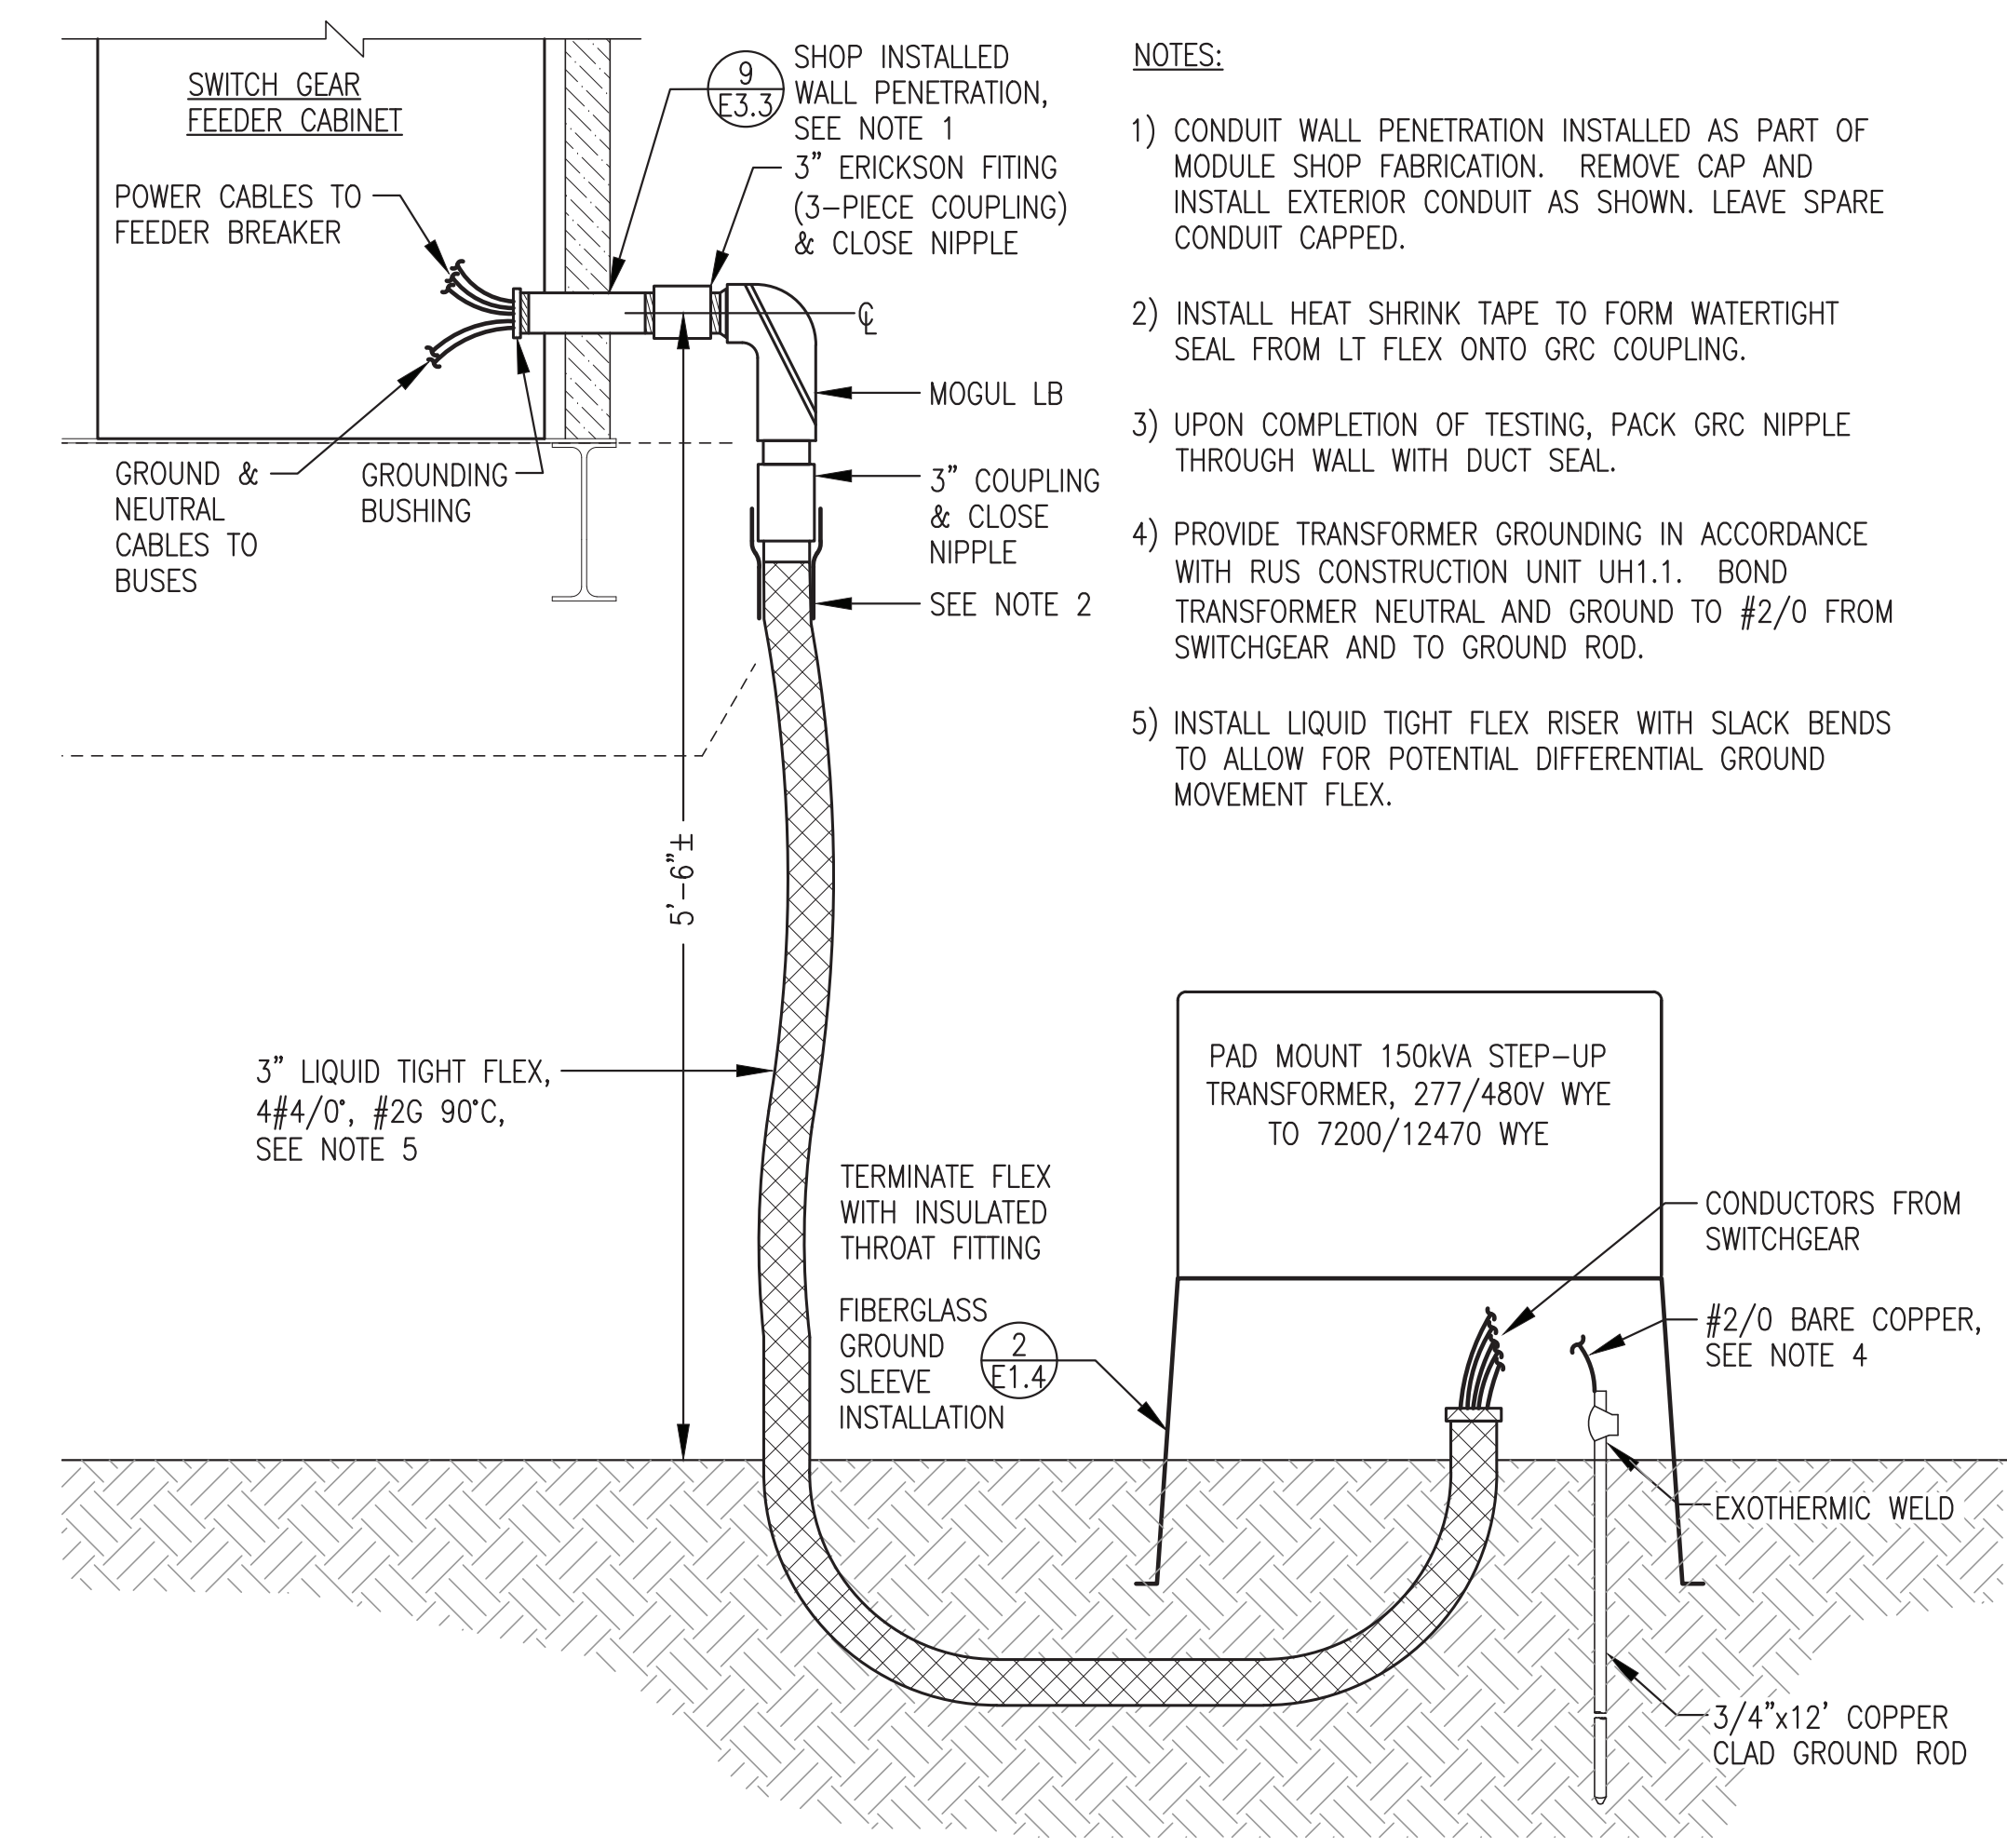

**2** TRANSFORMER FEEDER ENTRANCE  
**E1.6** NO SCALE


- NOTES:**
- 1) CONDUIT WALL PENETRATION INSTALLED AS PART OF MODULE SHOP FABRICATION. REMOVE CAP AND INSTALL EXTERIOR CONDUIT AS SHOWN. LEAVE SPARE CONDUIT CAPPED.
  - 2) INSTALL HEAT SHRINK TAPE TO FORM WATERTIGHT SEAL FROM LT FLEX ONTO GRC COUPLING.
  - 3) UPON COMPLETION OF TESTING, PACK GRC NIPPLE THROUGH WALL WITH DUCT SEAL.
  - 4) PROVIDE TRANSFORMER GROUNDING IN ACCORDANCE WITH RUS CONSTRUCTION UNIT UH1.1. BOND TRANSFORMER NEUTRAL AND GROUND TO #2/0 FROM SWITCHGEAR AND TO GROUND ROD.
  - 5) INSTALL LIQUID TIGHT FLEX RISER WITH SLACK BENDS TO ALLOW FOR POTENTIAL DIFFERENTIAL GROUND MOVEMENT FLEX.

ALL WORK ON THIS SHEET IS INCLUDED IN THE ON SITE CONTRACT.

ISSUED FOR  
 CONSTRUCTION  
 MAY 2023




ALASKA ENERGY AUTHORITY		
PROJECT: NESLON LAGOON POWER SYSTEM UPGRADE		
TITLE: MODULE FEEDER DETAILS		
 Gray Stassel Engineering, Inc. P.O. 111405, Anchorage, AK 99511 (907)349-0100	DRAWN BY: JTD DESIGNED BY: CWV/BCG FILE NAME: NELS_PP_E1 PROJECT NUMBER:	SCALE: NO SCALE DATE: 5/30/23 SHEET: <b>E1.6</b>

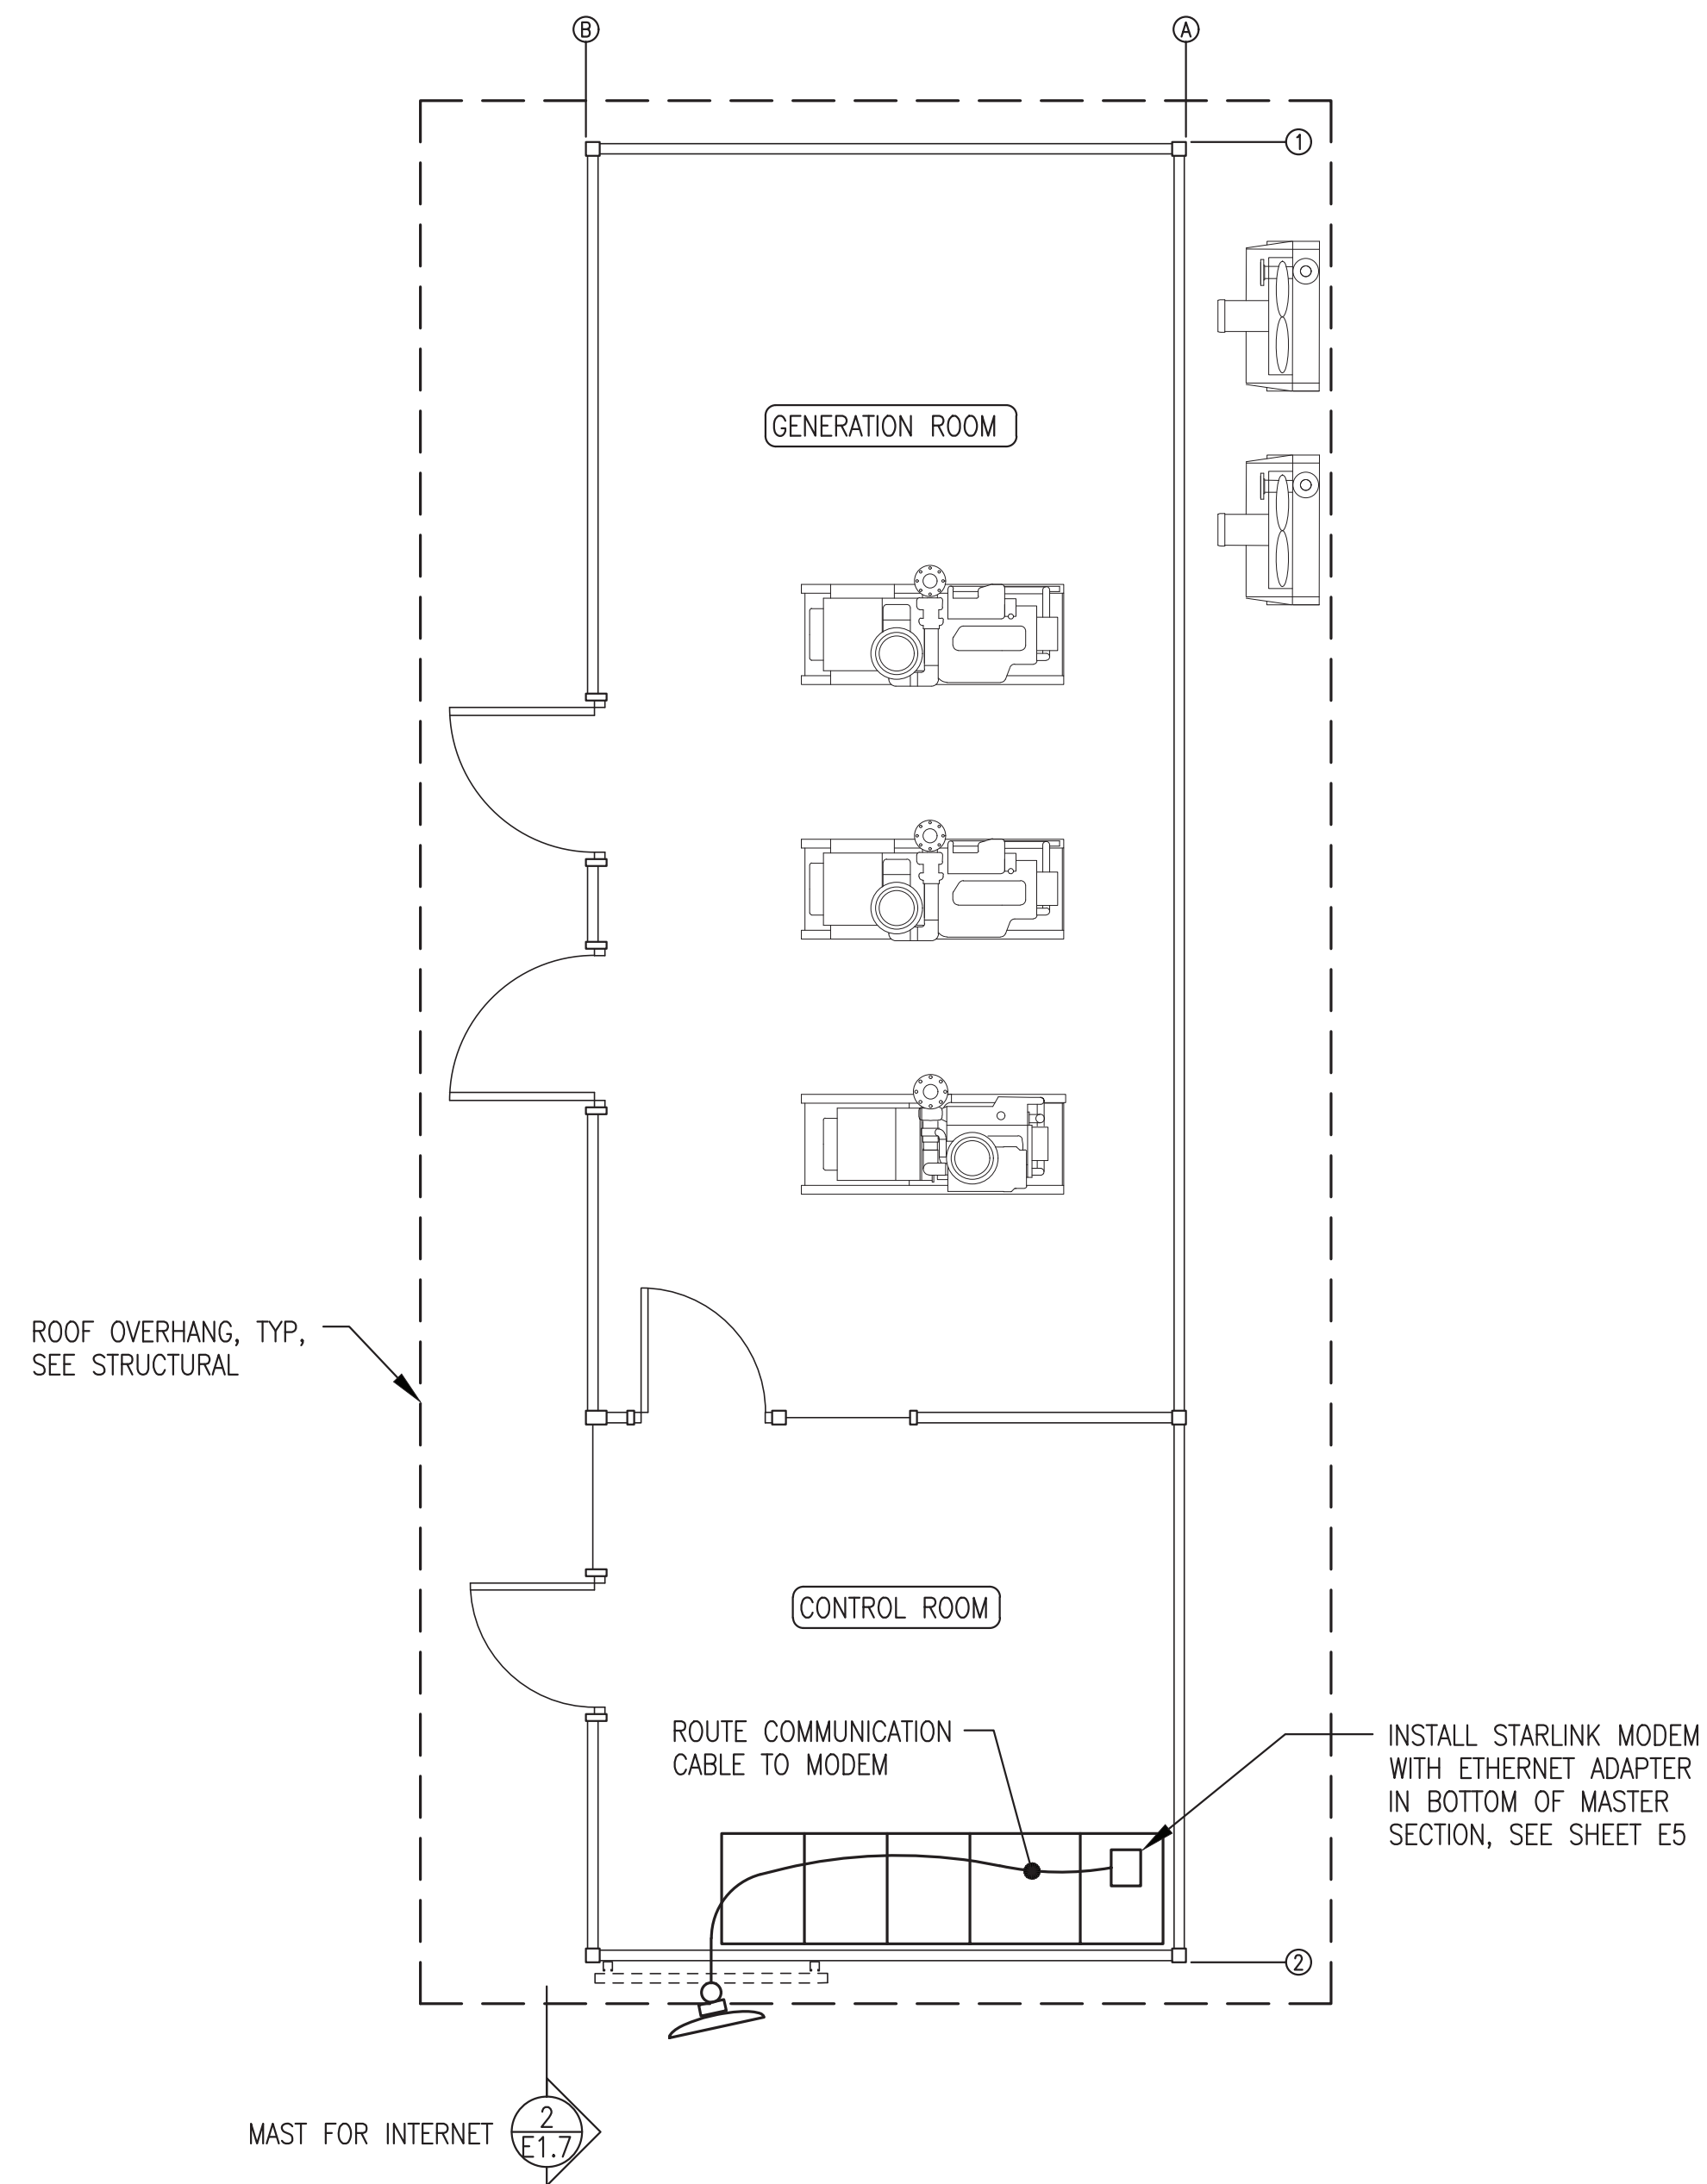


**1** POWER PLANT COMMUNICATIONS PLAN  
 E1.7 1/4"=1'-0"

- INTERNET SERVICE GENERAL NOTES:**
- 1) THE INTERNET SERVICE SHALL HAVE THE FOLLOWING MINIMUM PERFORMANCE CHARACTERISTICS:  
 20 MBPS DOWNLOAD  
 5 MBPS UPLOAD  
 NO MONTHLY DATA LIMIT  
 STARLINK STANDARD OR APPROVED EQUAL.
  - 2) FURNISH AND INSTALL COMPLETE SYSTEM WITH ANTENNA, PIPE MOUNT ADAPTER, MODEM, CABLE, CONNECTORS, ETHERNET ADAPTER, AND ACCESSORIES REQUIRED TO PROVIDE INTERNET SERVICE TO THE NEW POWER PLANT.
  - 3) UPON COMPLETION OF INSTALLATION THE INTERNET SYSTEM SHALL BE COMMISSIONED IN ACCORDANCE WITH THE SERVICE PROVIDER'S REQUIREMENTS.
  - 4) IN ADDITION TO FURNISHING AND INSTALLING SYSTEMS, THE CONTRACTOR SHALL PRE-PAY FOR A 1 YEAR INTERNET SERVICE CONTRACT.

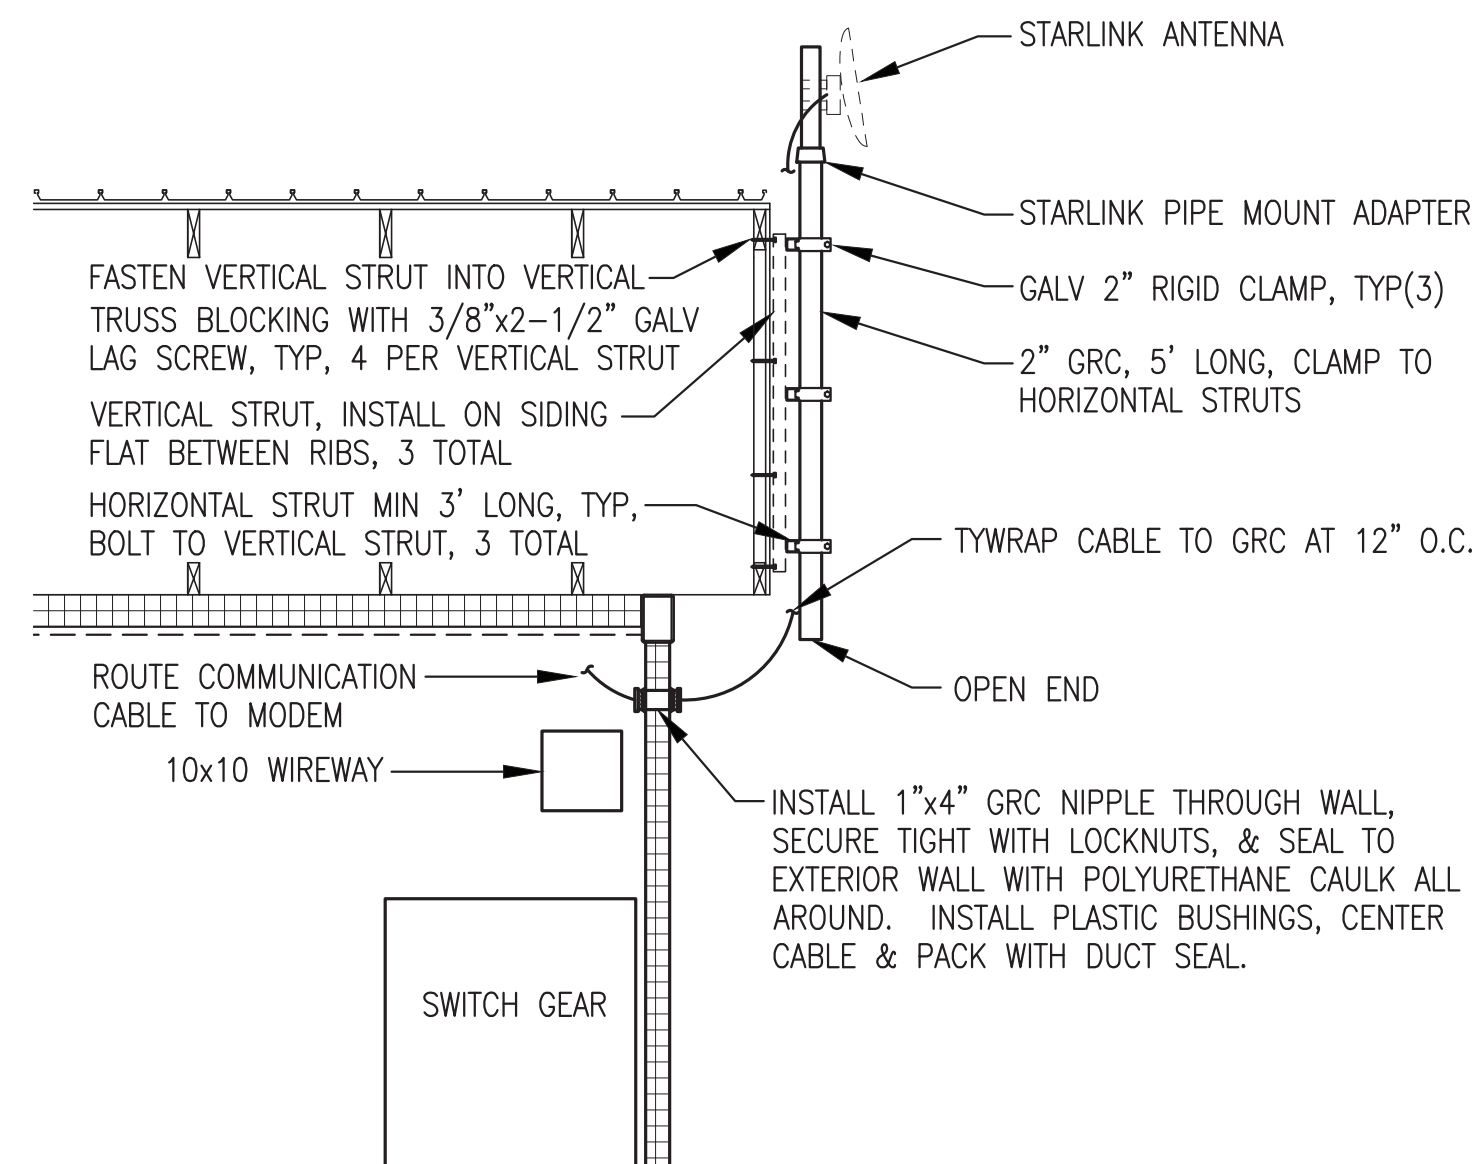


**2** COMMUNICATIONS ANTENNA & MAST INSTALLATION DETAILS  
 E1.7 1/2"=1'-0"

ALL WORK ON THIS SHEET IS INCLUDED IN THE ON SITE CONTRACT.

1	CHANGED INTERNET SERVICE TO STARLINK	11/13/23	BCG
REV.	DESCRIPTION	DATE	BY
 ALASKA ENERGY AUTHORITY			
PROJECT: NESLON LAGOON POWER SYSTEM UPGRADE			
TITLE: POWER PLANT COMMUNICATION PLAN & DETAILS			
DRAWN BY: JTD		SCALE: NO SCALE	
DESIGNED BY: CWV/BCG		DATE: 5/30/23	
FILE NAME: NELS PP E1		SHEET:	
PROJECT NUMBER:		<b>E1.7</b>	
P.O. 111405, Anchorage, AK 99511 (907)349-0100			

REV#1  
 ISSUED FOR  
 CONSTRUCTION  
 NOV 2023

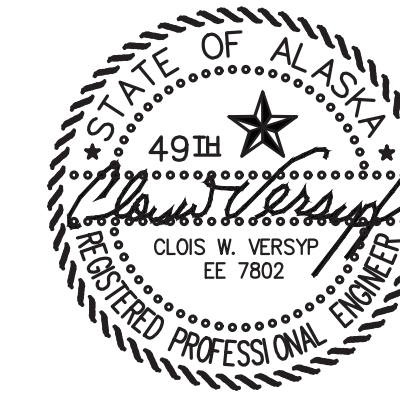




EXISTING METER BASE, SERVICE DISCONNECT, AND TRANSFER SWITCH TO REMAIN, SEE NEW WORK FOR METER BASE REFURBISHMENT


DISCONNECT EXISTING FEEDER CONDUCTORS FROM MAIN BREAKER IN METER BASE

DEMOLISH EXISTING FEEDER CONDUCTORS & CONDUIT TO 18" BELOW GRADE & ABANDON IN PLACE

ICE HOUSE 480v 3Ø SERVICE DEMOLITION

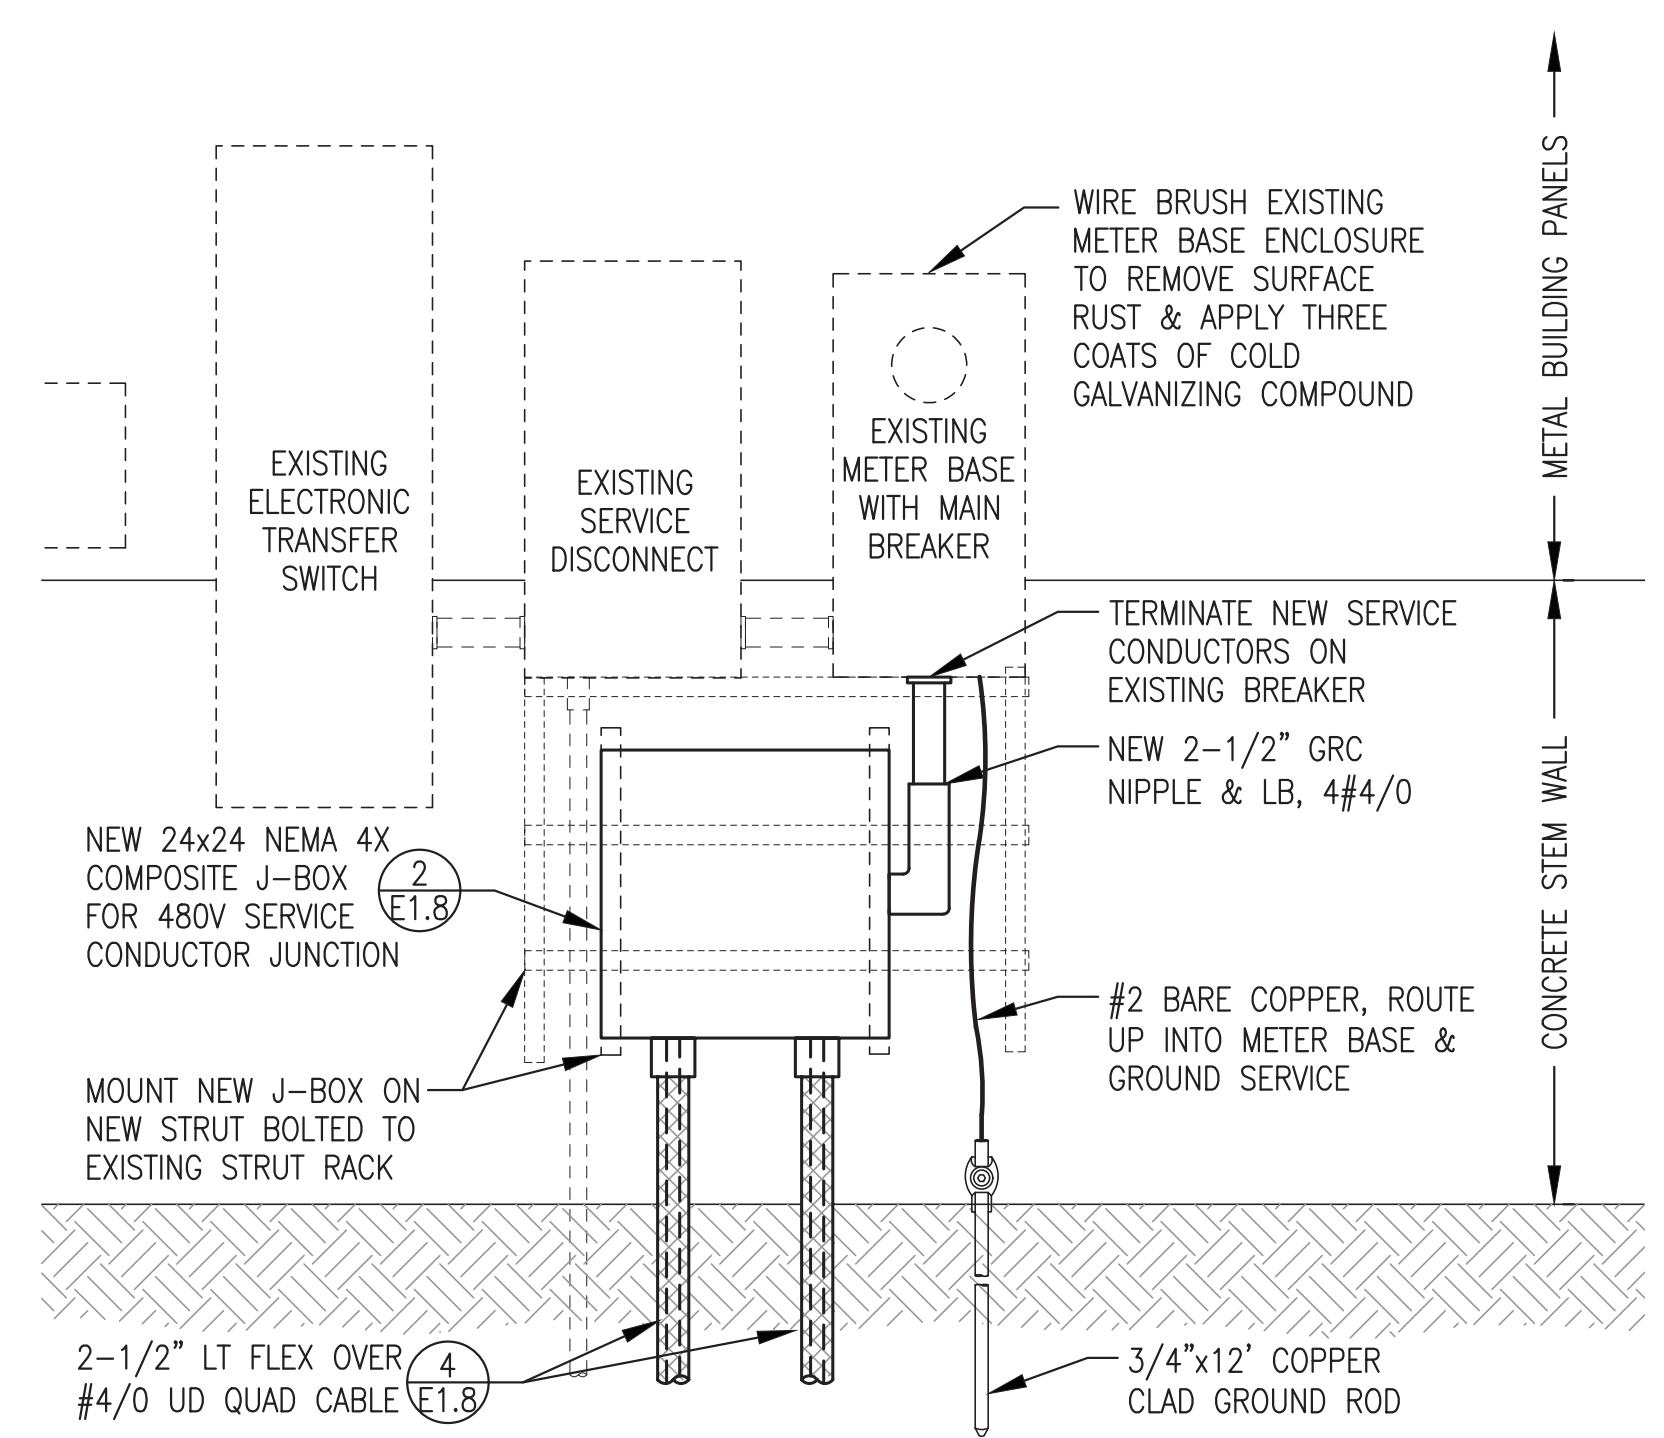

ICE HOUSE 480V 3Ø SERVICE NEW WORK

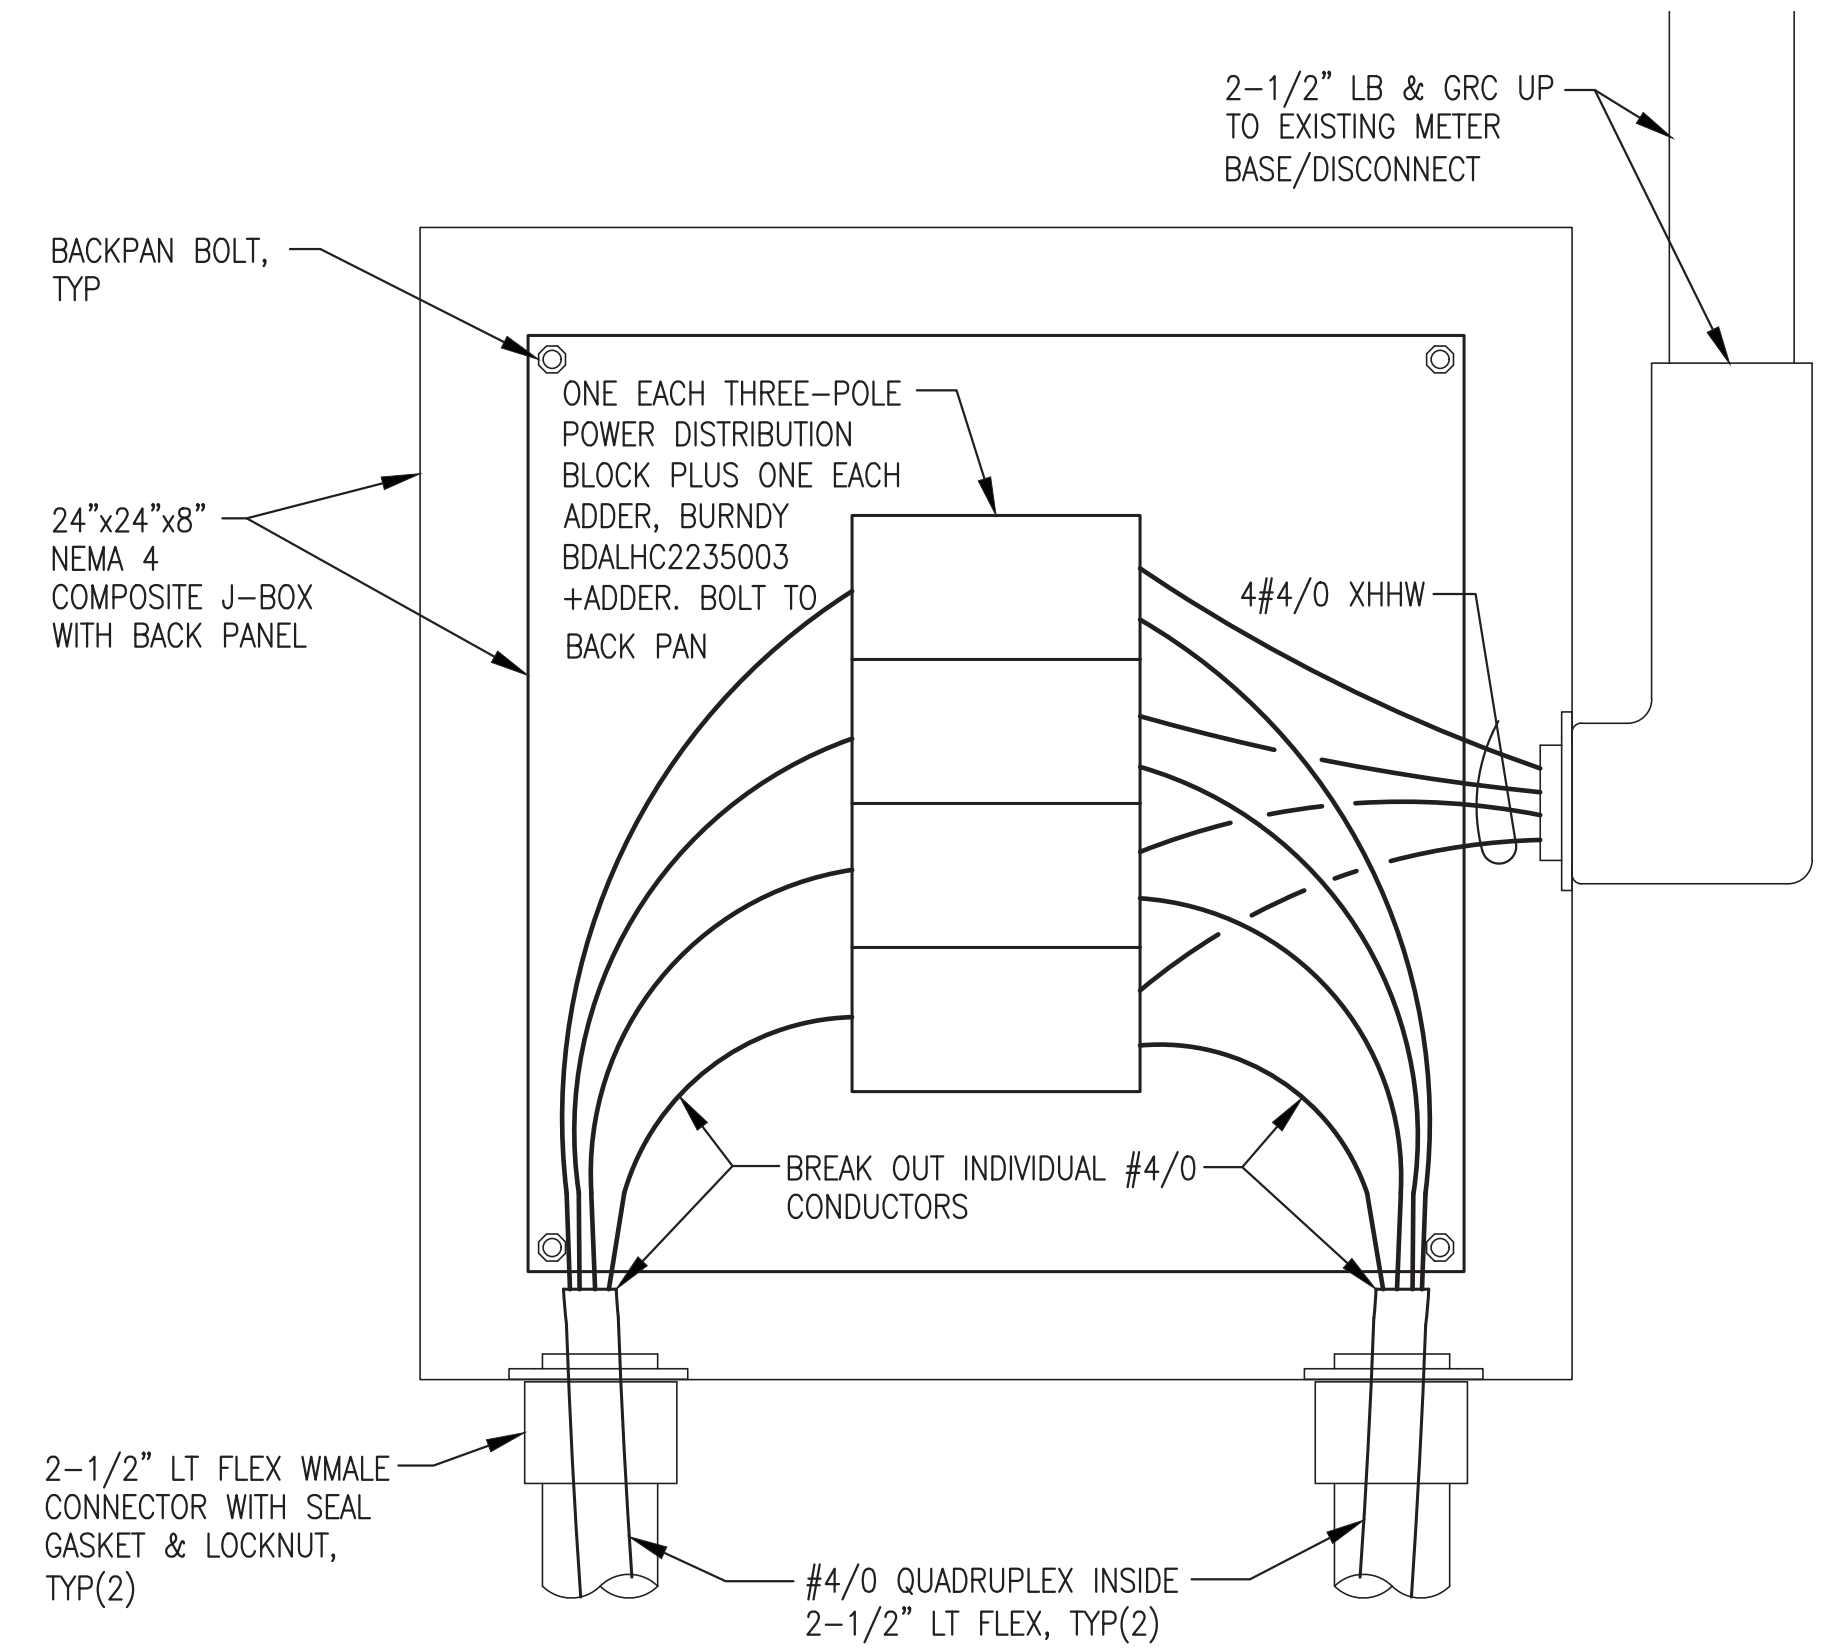

2 ICEHOUSE 480V SERVICE CONDUCTOR SPLICE J-BOX  
E1.8 NO SCALE

1 ICE HOUSE 480V SERVICE ENTRANCE ELEVATION  
E1.8 3/4"=1'-0"




DISCONNECT EXISTING FEEDER CONDUCTORS FROM MAIN BREAKER IN INTERIOR PANEL MDP-1

EXISTING 3" LB CONDUIT BODY TO REMAIN, SEE NEW WORK FOR REFURBISHMENT


EXISTING BURIED FEEDERS TO REMAIN, TYP(3)

DEMOLISH EXISTING FEEDER CONDUCTOR & CONDUIT TO 12" BELOW GRADE AND ABANDON IN PLACE

STORAGE COMPOUND 480v 3Ø SERVICE DEMOLITION

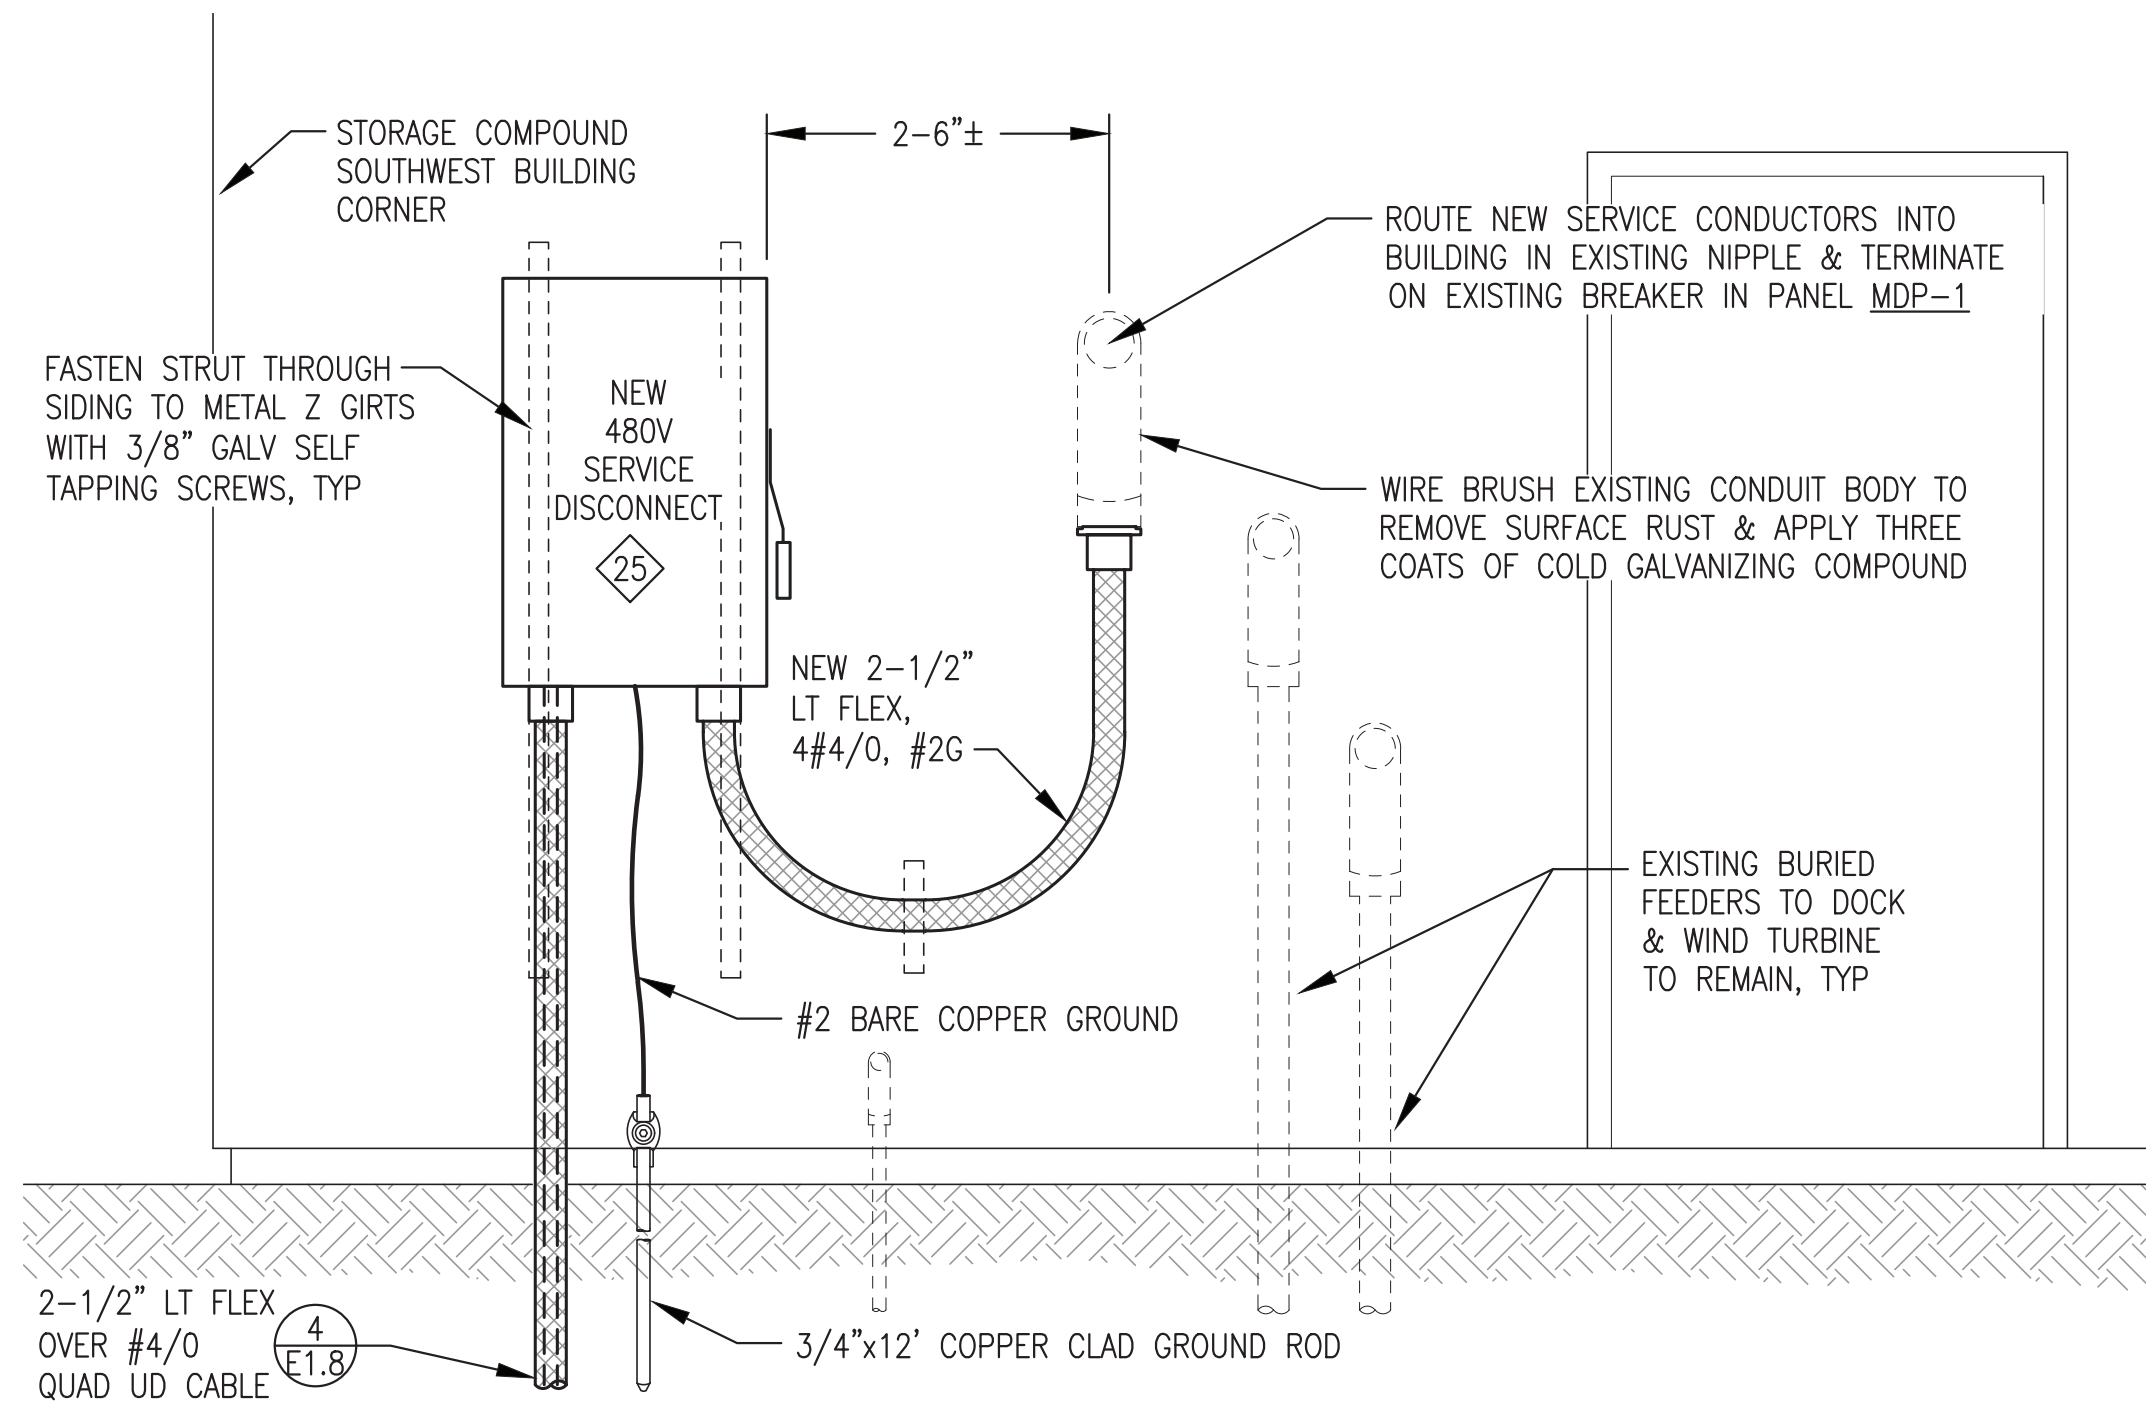

STORAGE COMPOUND 480V 3Ø SERVICE NEW WORK

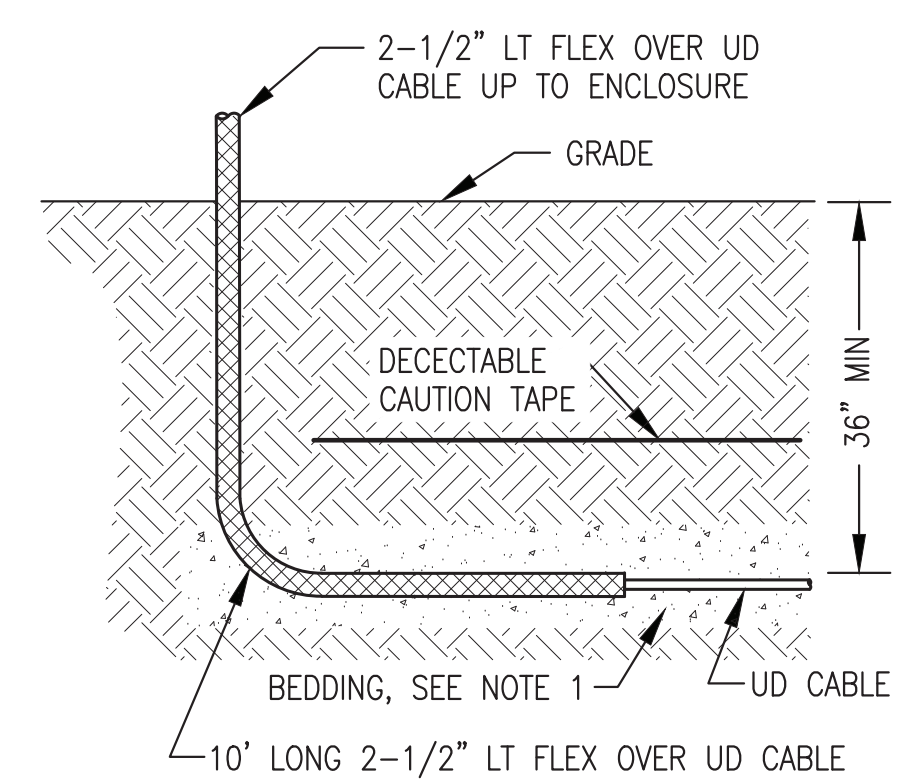

NOTES:

- BED UD CABLE WITH 3/4" MINUS SAND/GRAVEL MINIMUM 4" ALL AROUND.
- BACKFILL WITH EXCAVATED MATERIAL AND COMPACT TO 95% DENSITY.

4 TRANSITION TO DIRECT BURY UD CABLE  
E1.8 NO SCALE



3 STORAGE COMPOUND 480V SERVICE ENTRANCE ELEVATION  
E1.8 3/4"=1'-0"

ALL WORK ON THIS SHEET IS INCLUDED IN THE ON SITE CONTRACT.

ISSUED FOR CONSTRUCTION  
MAY 2023



ALASKA ENERGY AUTHORITY		
PROJECT: NESLON LAGOON POWER SYSTEM UPGRADE		
TITLE: ICE HOUSE & STORAGE COMPOUND ELECTRICAL SERVICE DETAILS		
DRAWN BY: JTD	SCALE: NO SCALE	
DESIGNED BY: CWV/BCG	DATE: 5/30/23	
FILE NAME: NELS_PP_E1	SHEET: E1.8	
PROJECT NUMBER:		
P.O. 111405, Anchorage, AK 99511 (907)349-0100		

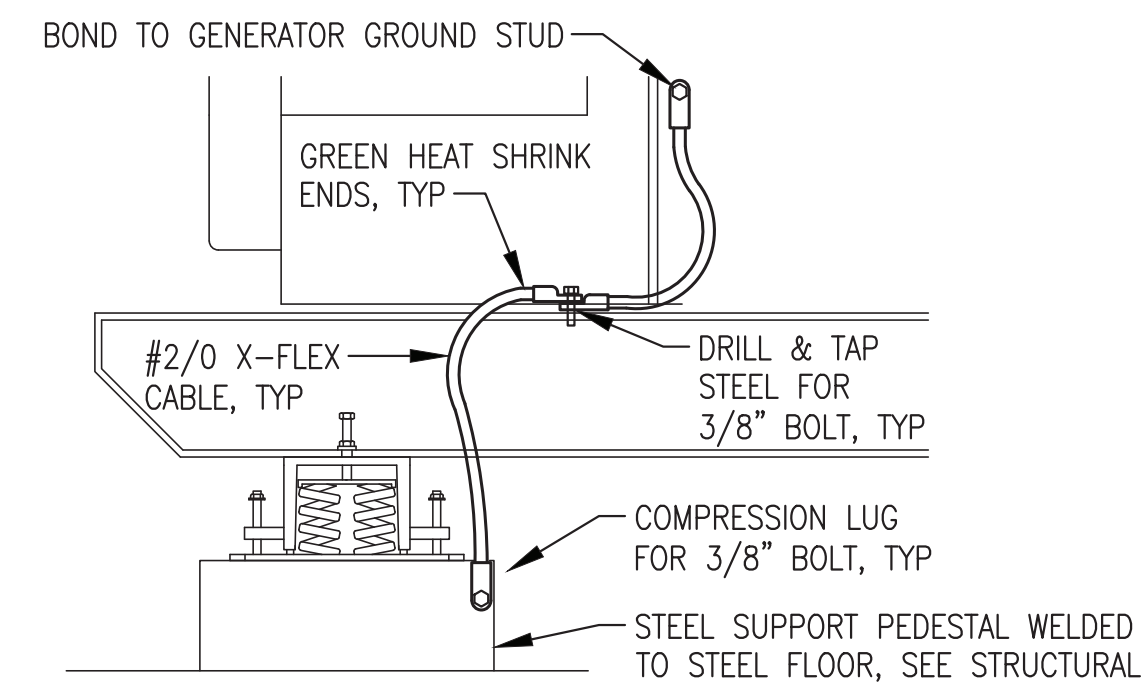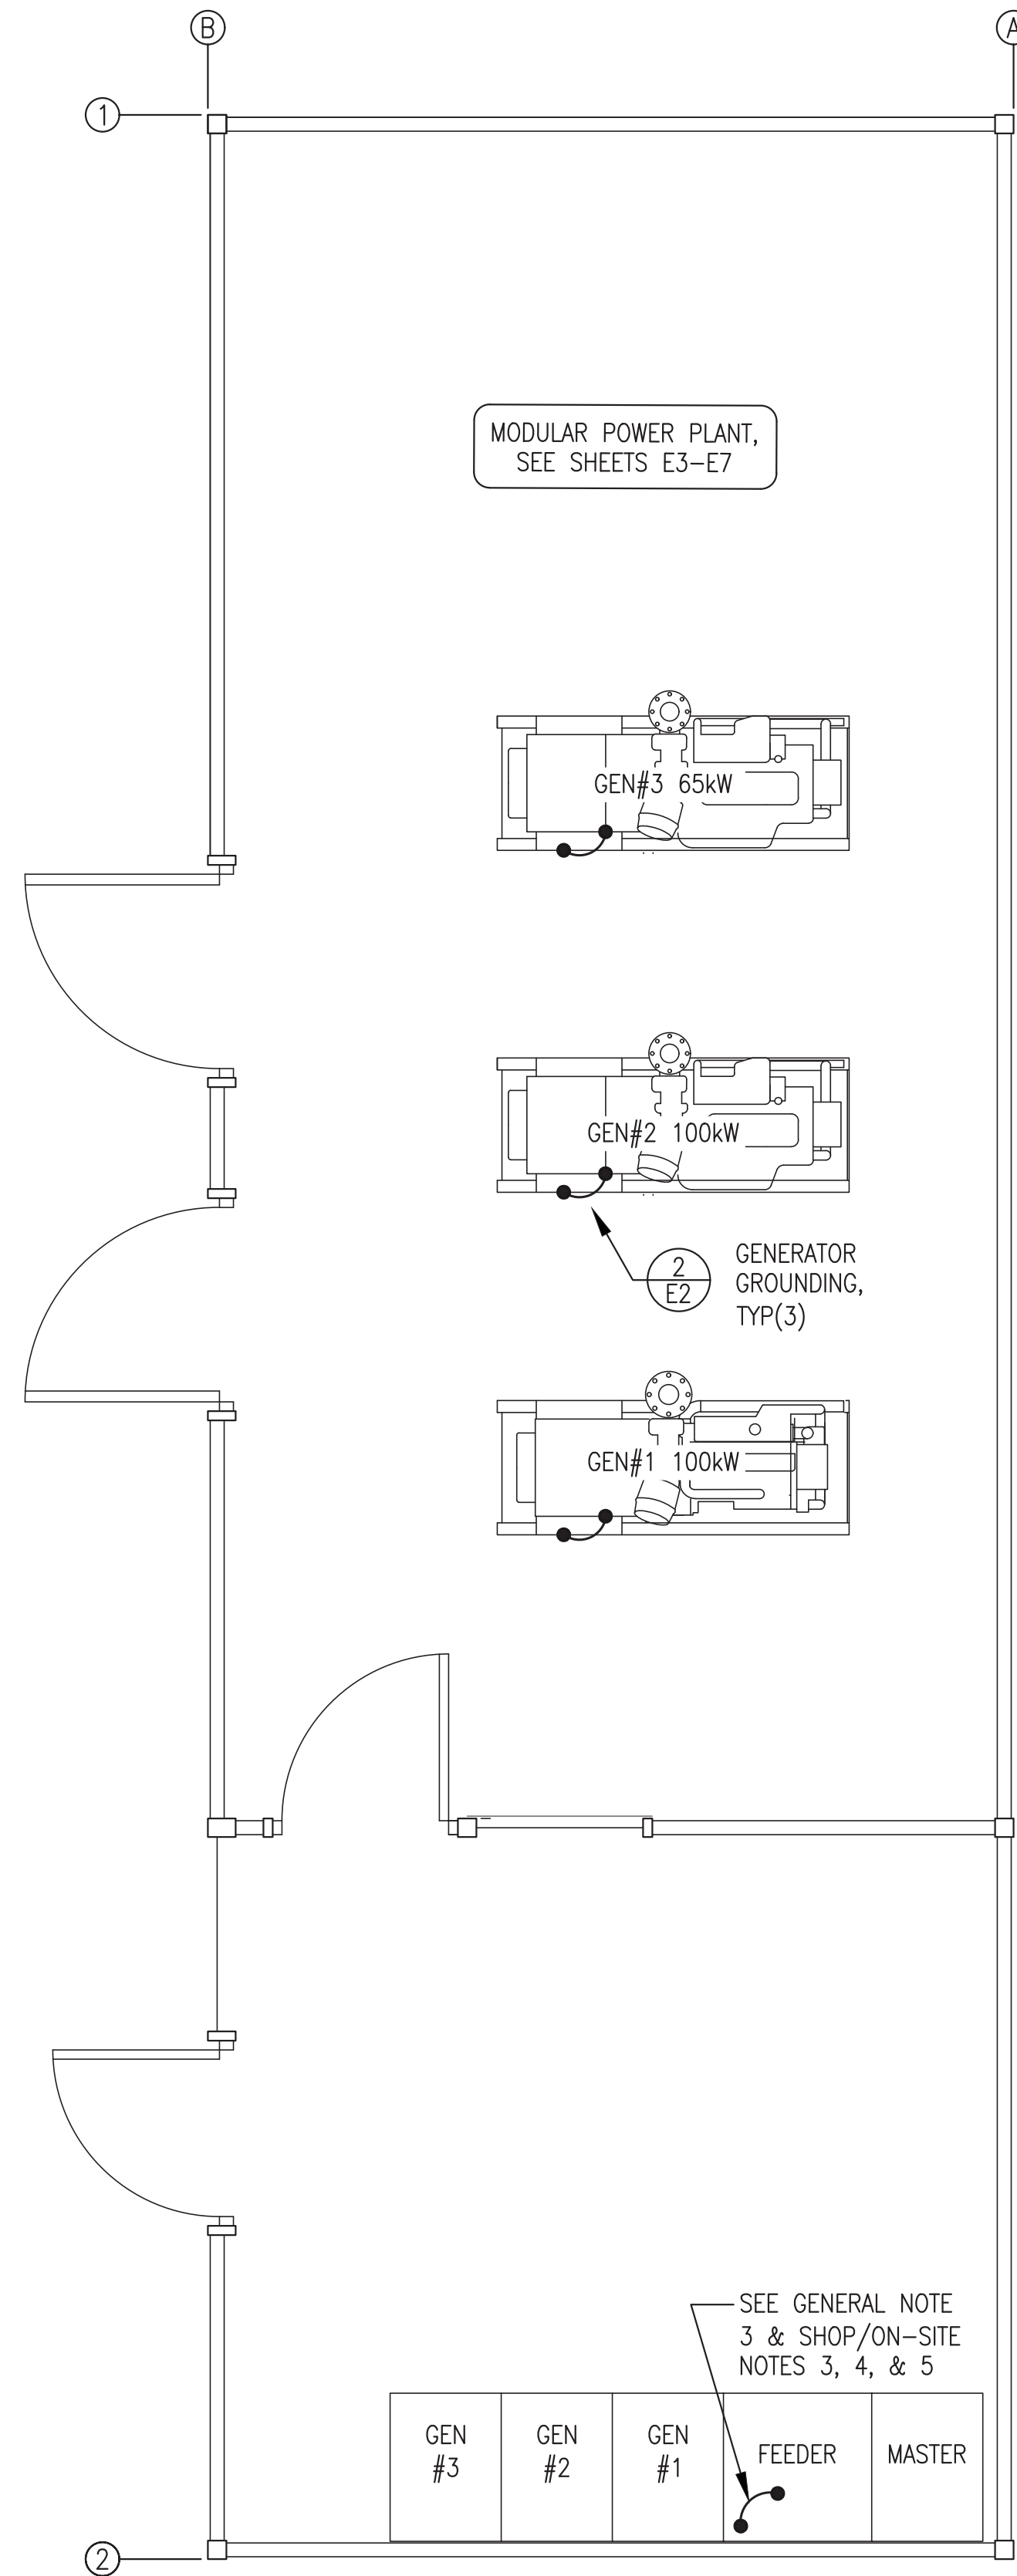

**2**  
**E2** GENERATOR GROUNDING  
NO SCALE

**GROUNDING GENERAL NOTES:**

- 1) SEE ON-SITE WORK FOR POWER PLANT GROUNDING GRID.
- 2) CONTINUOUSLY WELDED STEEL STRUCTURE PROVIDES GROUND PATH THROUGH MODULE.
- 3) IN FEEDER SECTION PROVIDE #2/0 BARE COPPER JUMPER FROM GROUND BUS TO STEEL FLOOR. SEE DETAIL 2/E2, SIMILAR.


**GROUNDING SHOP/ON-SITE NOTES:**

- 1) ALL WORK SHOWN THIS SHEET TO BE PERFORMED AS PART OF THE MODULE ASSEMBLY SHOP FAB WORK.
- 2) AS PART OF MODULE ASSEMBLY WORK, TEMPORARILY BOND SWITCHGEAR NEUTRAL BUS TO GROUND BUS FOR LOAD BANK TESTING AND LEAVE IN PLACE.
- 3) AS PART OF ON-SITE WORK LEAVE NEUTRAL TO GROUND BUS BONDING JUMPER IN PLACE AS REQUIRED FOR LOAD BANK TESTING.
- 4) REMOVE JUMPER AFTER LOAD BANK TESTING AND PRIOR TO CONNECTING TO THE GRID FOR COMMISSIONING.


ALL WORK ON THIS SHEET WAS PERFORMED AS PART OF THE PRIOR MODULE ASSEMBLY CONTRACT EXCEPT AS SPECIFICALLY INDICATED IN THE SHOP/ON SITE NOTES.

**1**  
**E2** POWER PLANT GROUNDING PLAN  
3/8"=1'-0"


ISSUED FOR  
CONSTRUCTION  
MAY 2023

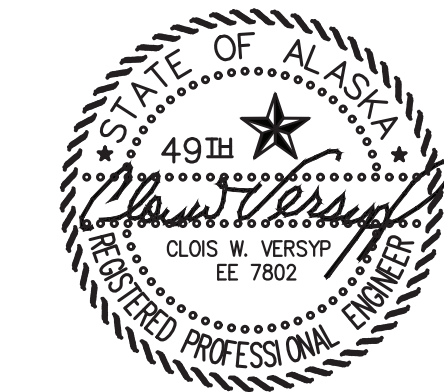


PROJECT: NELSON LAGOON POWER SYSTEM UPGRADE		
TITLE: MODULE GROUNDING PLAN & DETAILS		
	DRAWN BY: JTD DESIGNED BY: CWV/BCG FILE NAME: NELS_PP_E2-E5 PROJECT NUMBER:	SCALE: AS NOTED DATE: 5/30/23 SHEET: <b>E2</b>

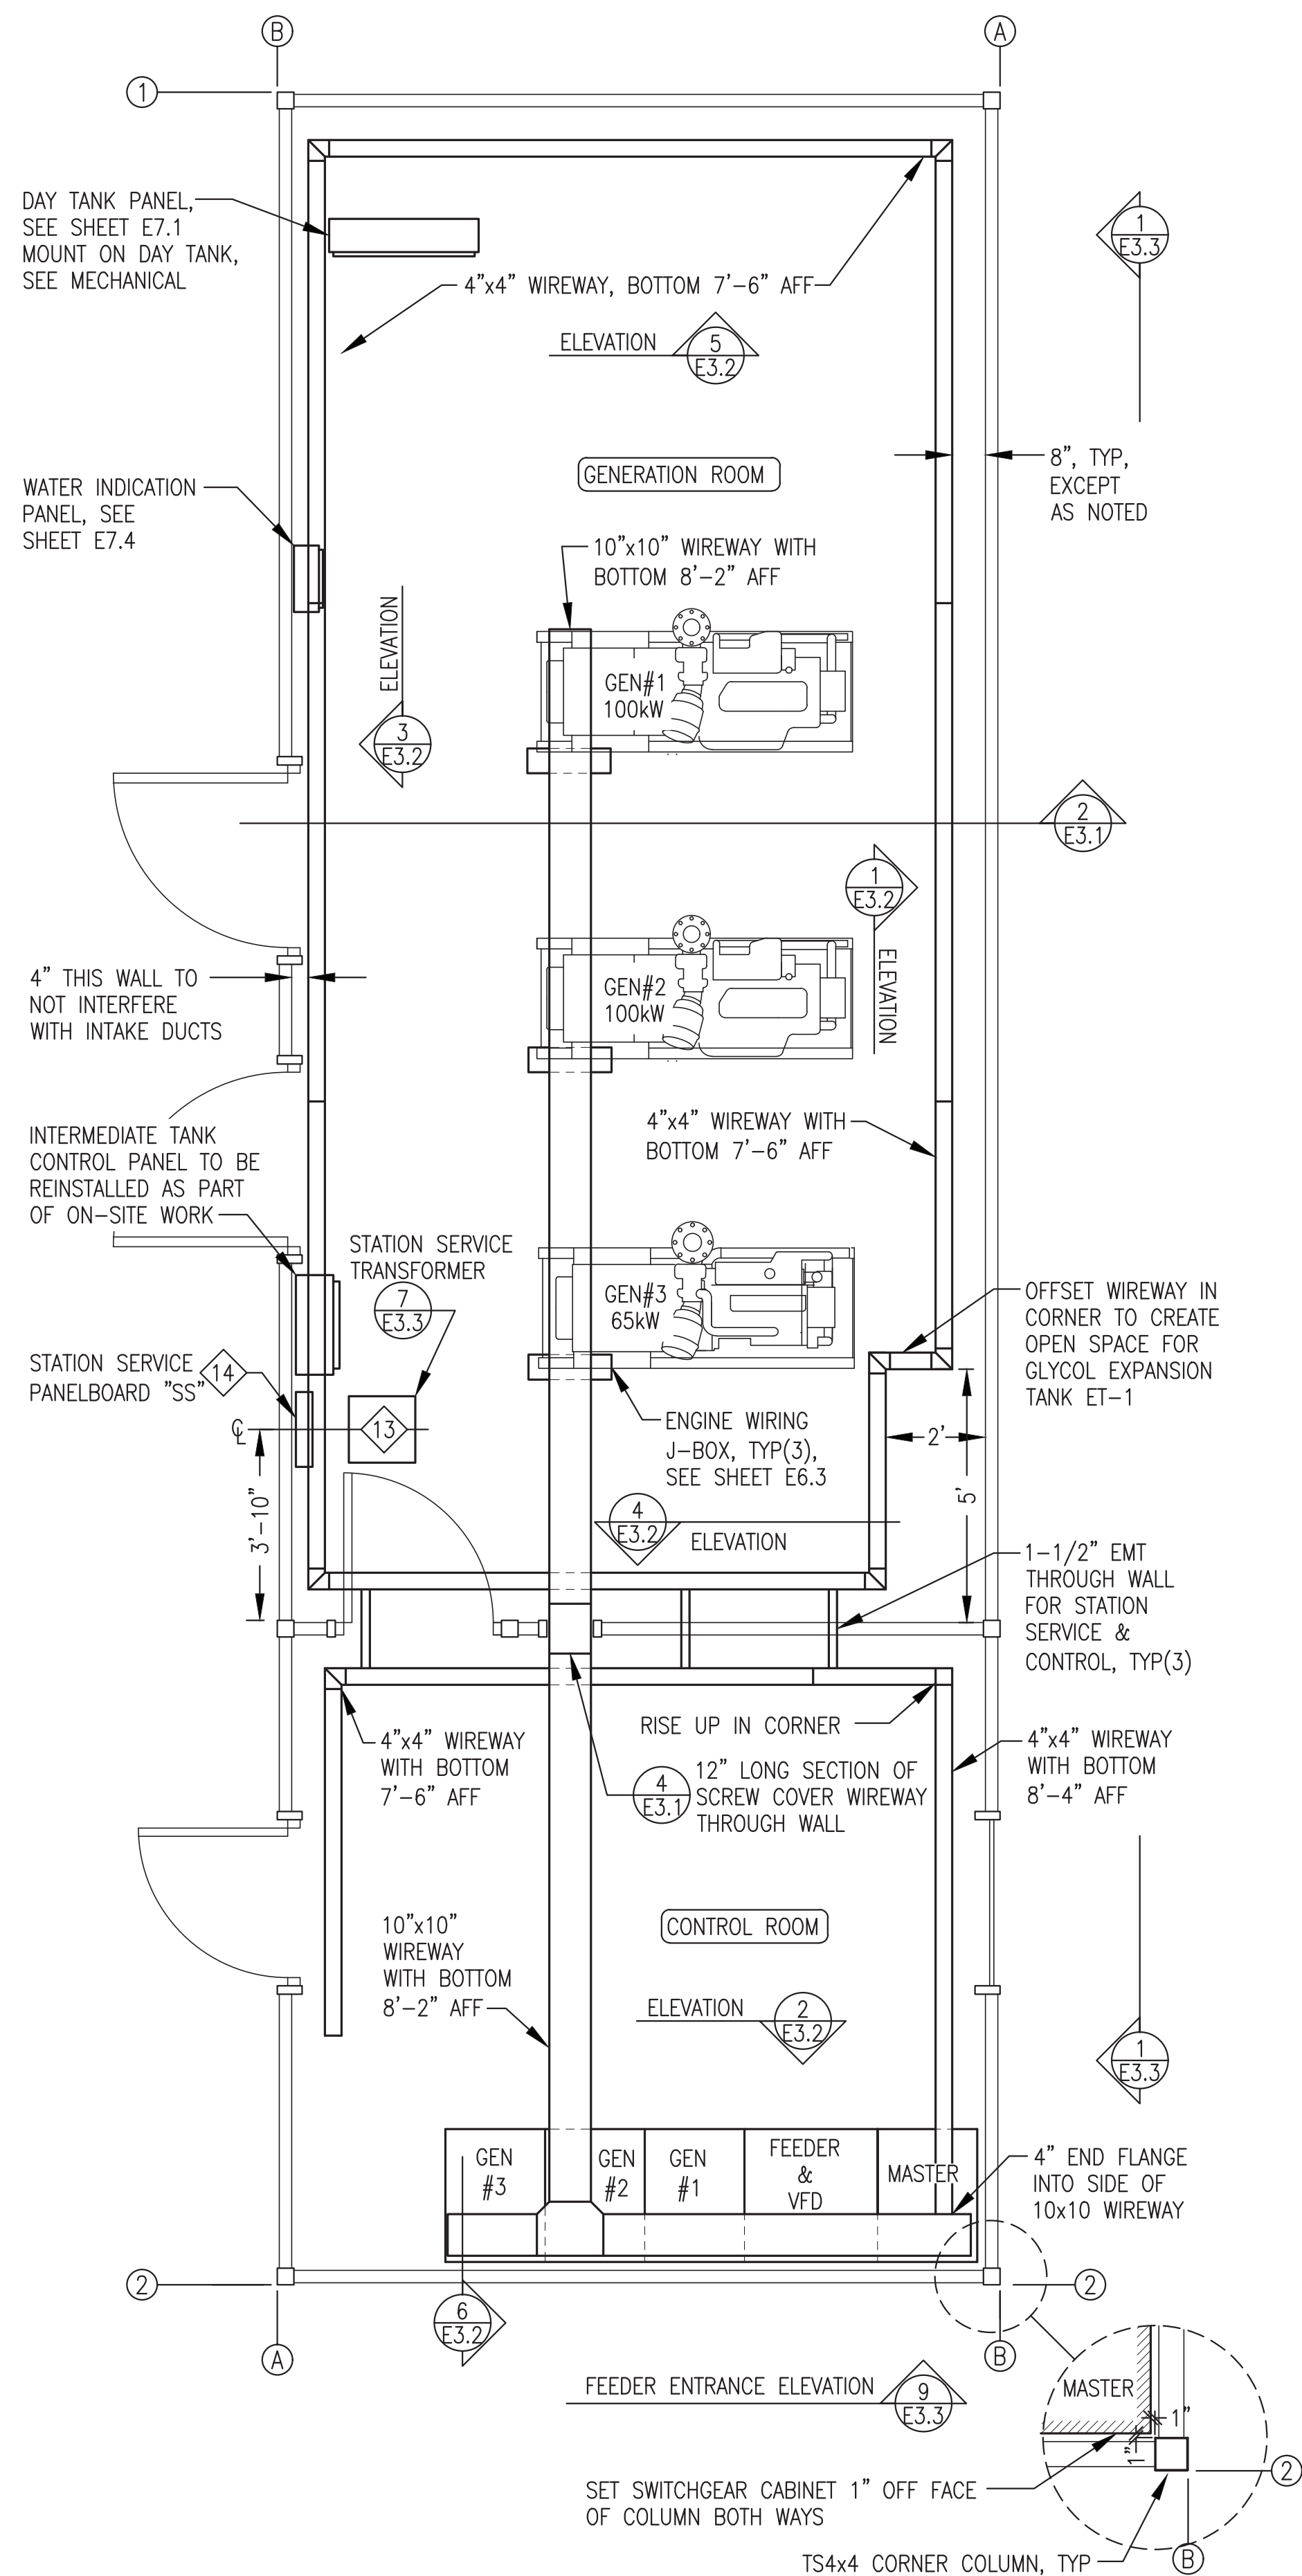


**1** EQUIPMENT LAYOUT & WIREWAY PLAN  
E3.1 3/8"=1'-0"

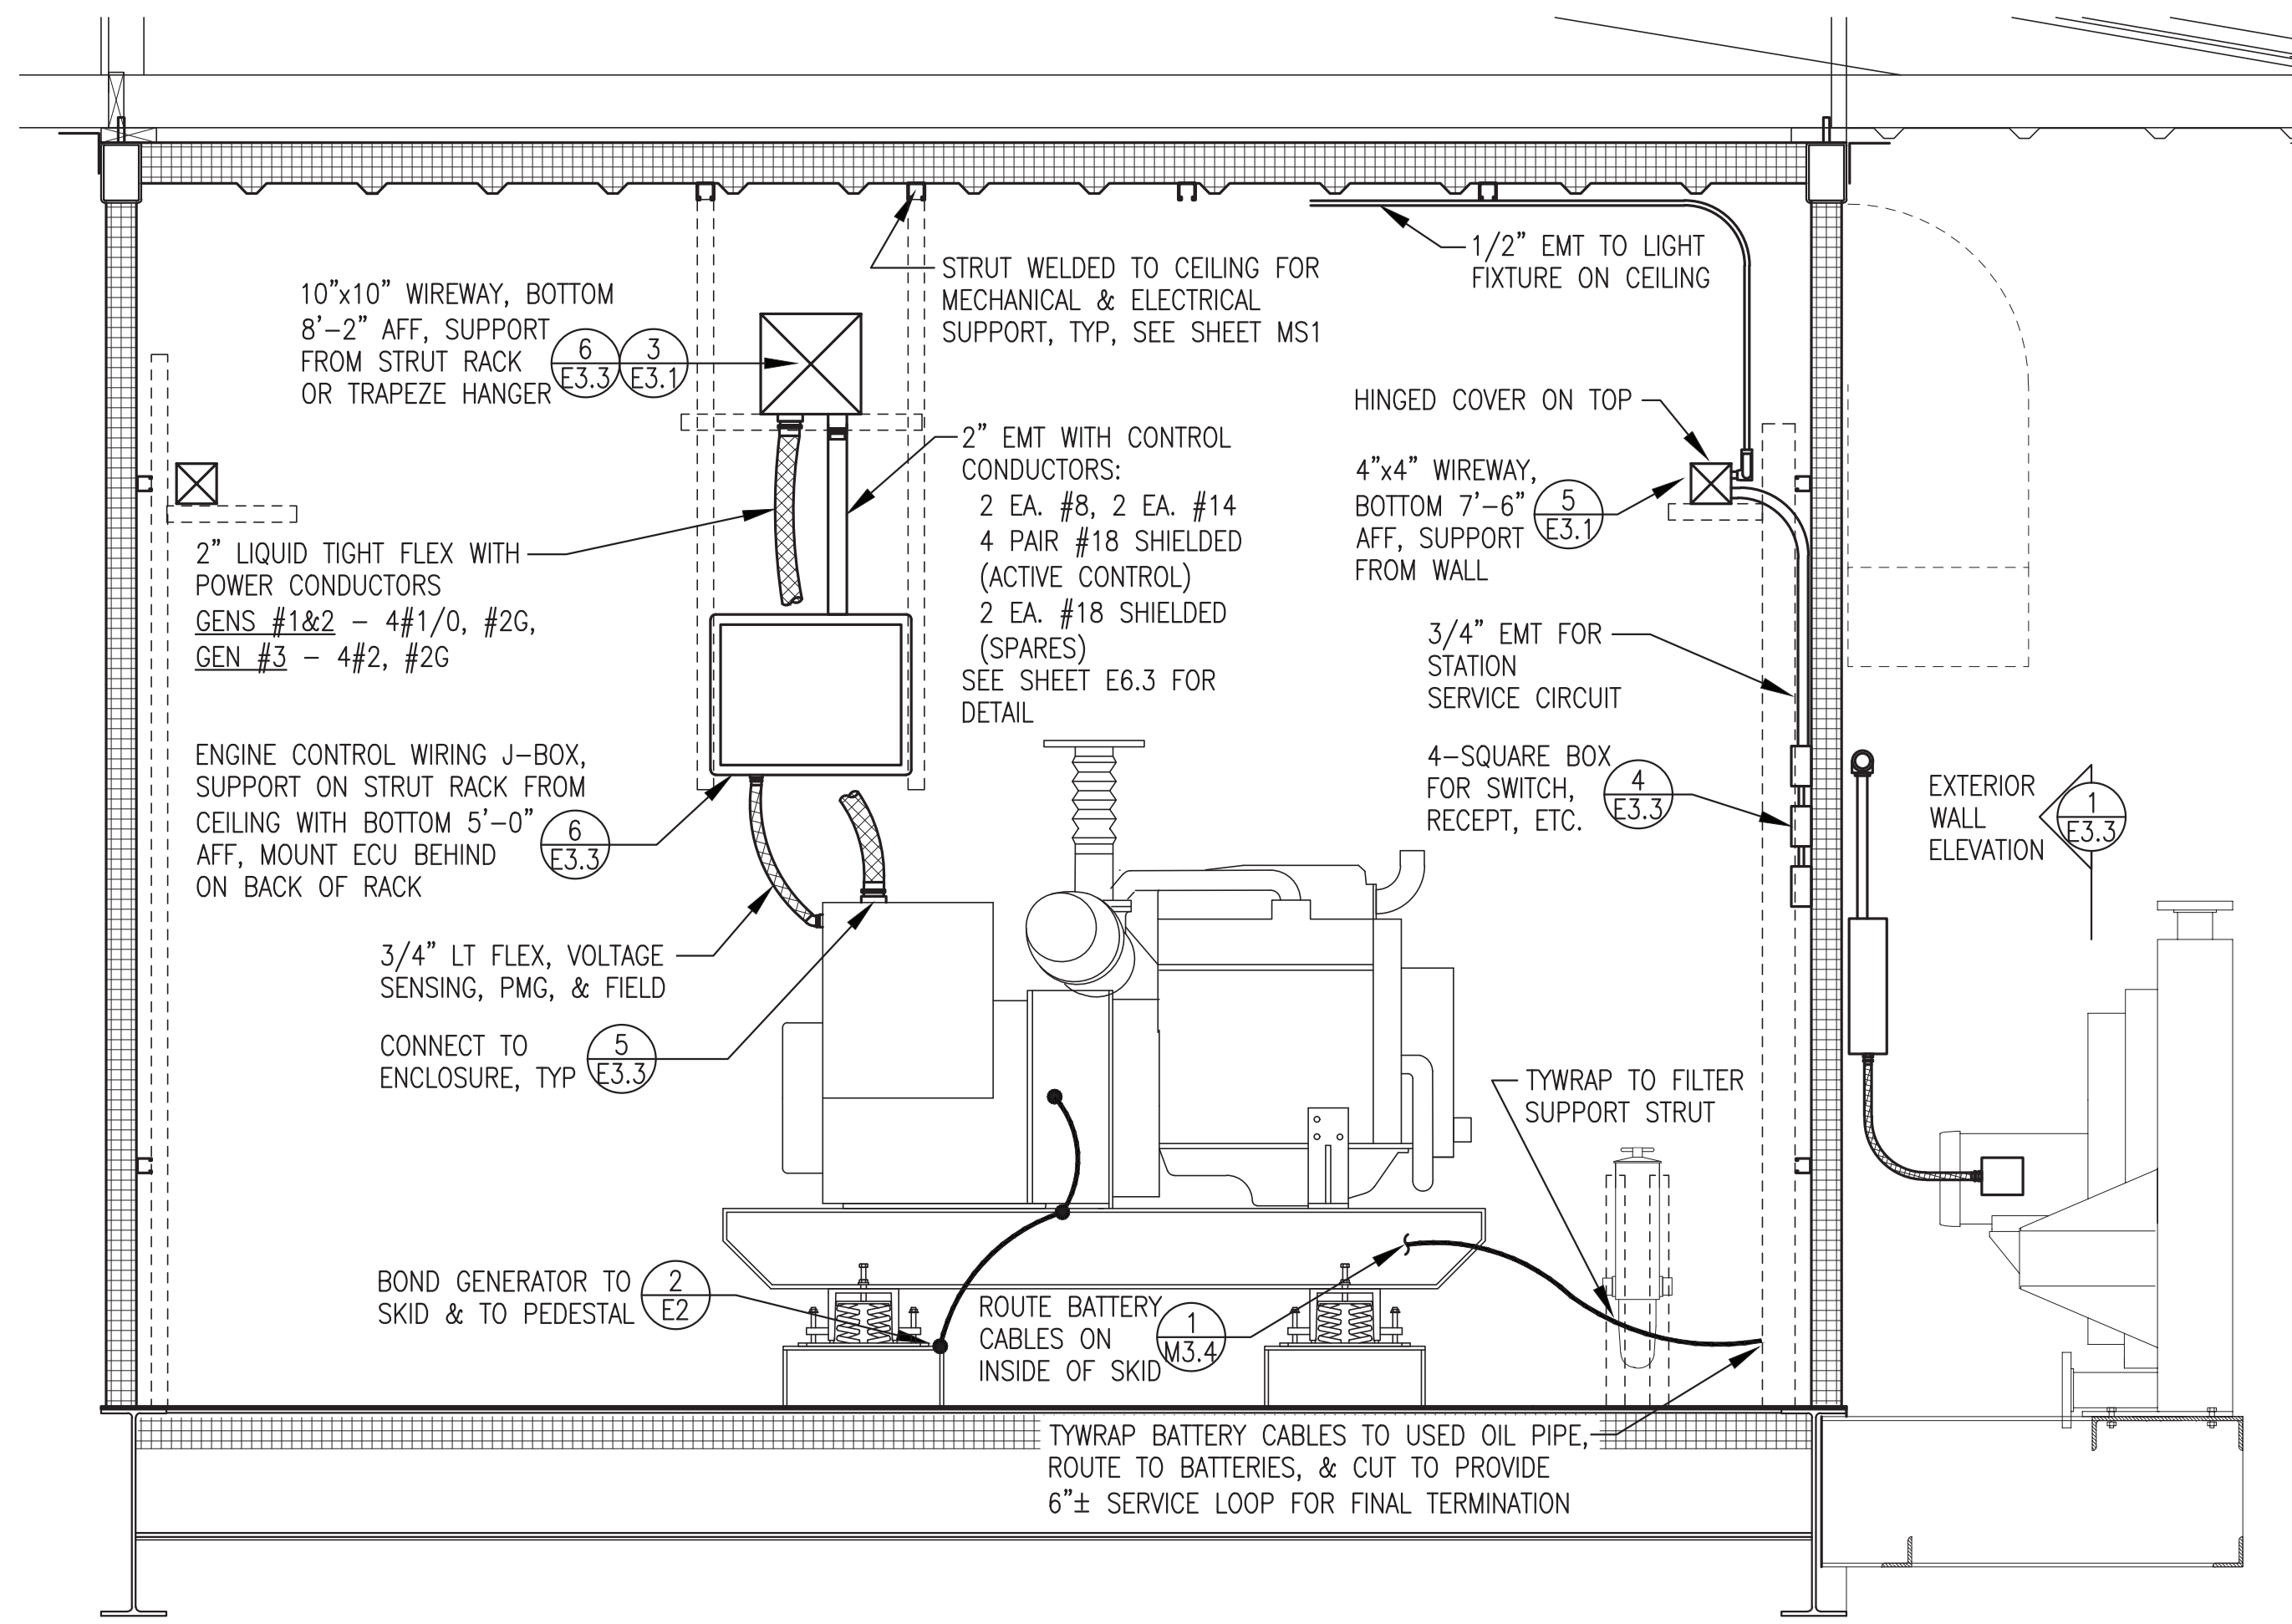


**2** TYPICAL MODULE SECTION  
E3.1 3/4"=1'-0"

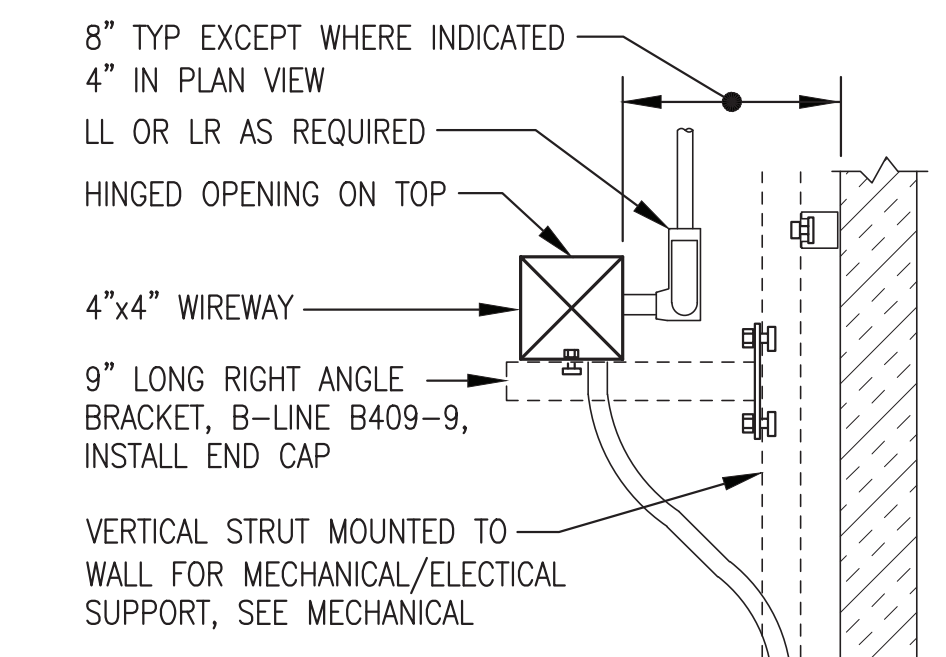

**5** 4" WIREWAY SUPPORT FROM WALL  
E3.1 NO SCALE

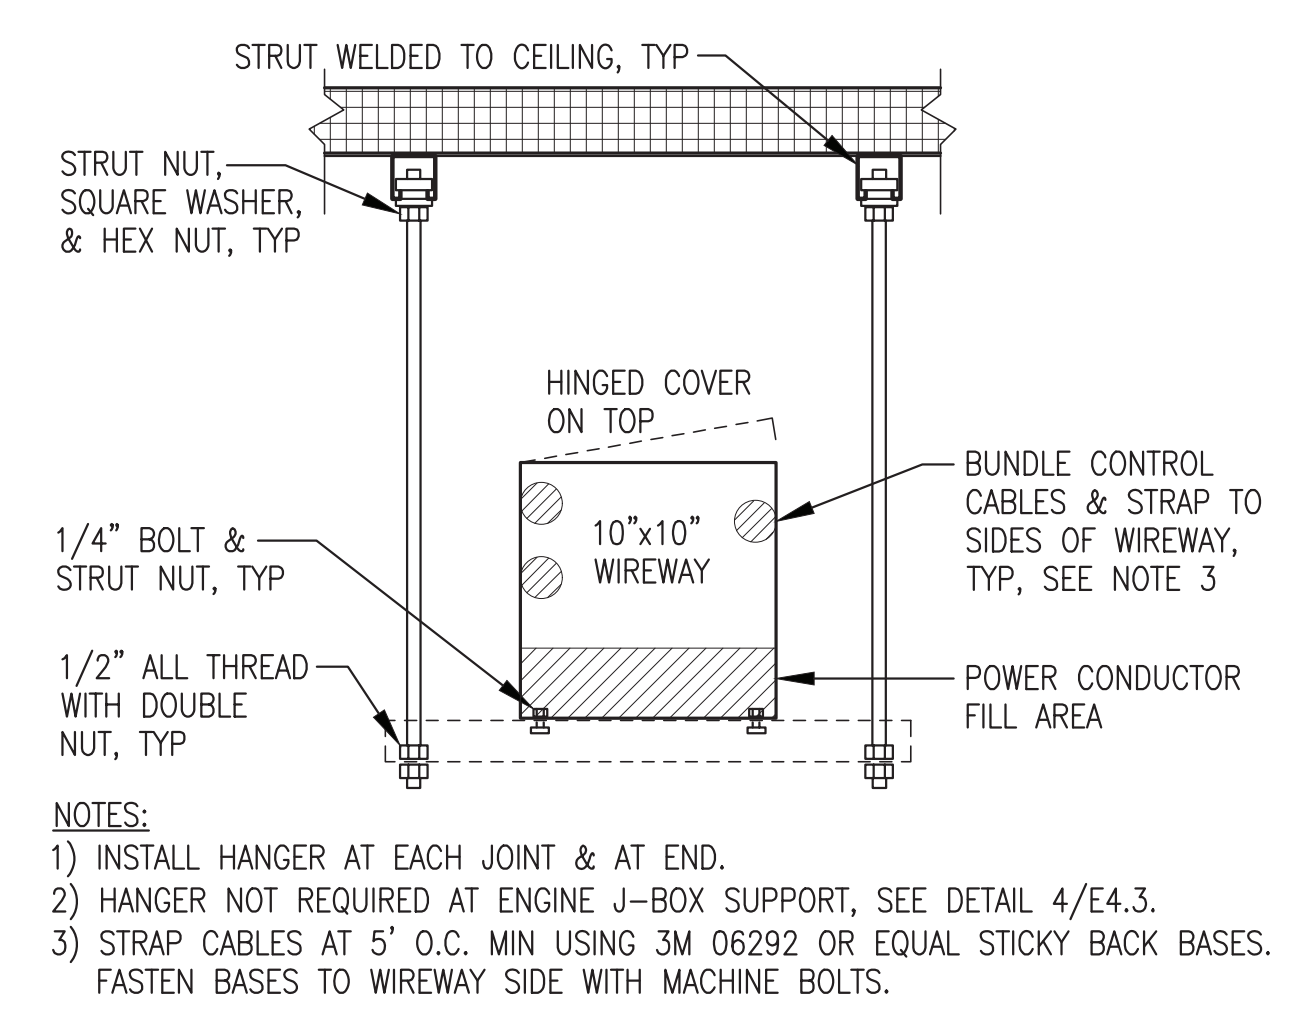

**3** 10" WIREWAY TRAPEZE HANGER  
E3.1 NO SCALE

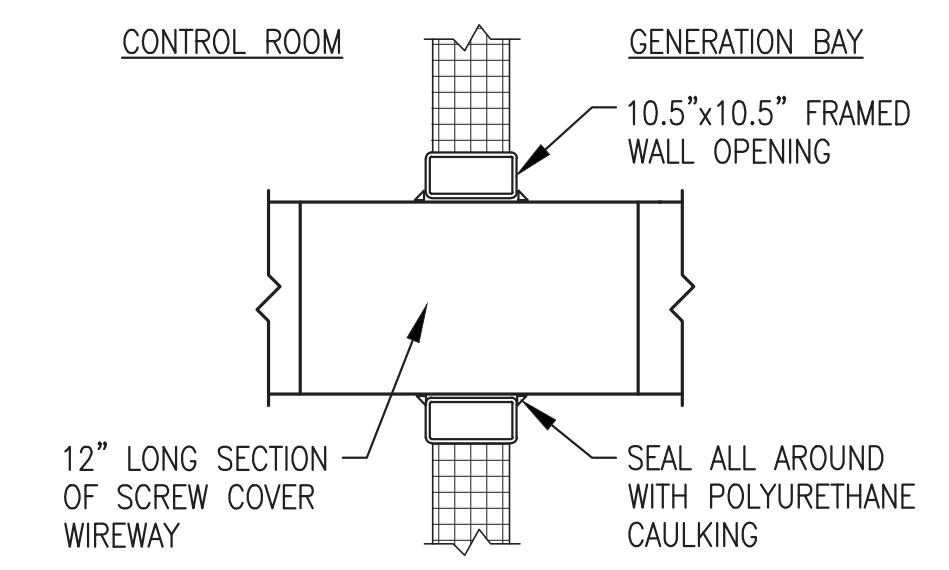

**4** WIREWAY WALL PENETRATION  
E3.1 NO SCALE


ENGINE-GENERATOR SCHEDULE	
GENSET	DESCRIPTION
GEN #1	ENGINE - 148 HP, 100 EKW PRIME, JOHN DEERE 4045AFM85, TIER 3 MARINE. 24 VDC STARTING & CONTROL. GENERATOR - MINIMUM 125 KW CONTINUOUS AT 105°C RISE, NEWAGE/STAMFORD UC1274E.
GEN #2	ENGINE - 148 HP, 100 EKW PRIME, JOHN DEERE 4045AFM85, TIER 3 MARINE. 24 VDC STARTING & CONTROL. GENERATOR - MINIMUM 125 KW CONTINUOUS AT 105°C RISE, NEWAGE/STAMFORD UC1274E.
GEN #3	ENGINE - 99 HP, 65 EKW PRIME, JOHN DEERE 4045TFM85, TIER 3 MARINE. 24 VDC STARTING & CONTROL. GENERATOR - MINIMUM 90 KW CONTINUOUS AT 105°C RISE, NEWAGE/STAMFORD UC1274C.

REV#1  
ISSUED FOR  
CONSTRUCTION  
AUGUST 2023




ALL WORK ON THIS SHEET WAS PERFORMED AS PART OF THE PRIOR MODULE ASSEMBLY CONTRACT AND IS SHOWN HERE FOR REFERENCE ONLY.

1	CHANGED CONTROL CONDUCTOR SHIELDED PAIR COUNT PER NEW ENGINE MONITORING	8/15/23	BCG
REV.	DESCRIPTION	DATE	BY
PROJECT: NELSON LAGOON POWER SYSTEM UPGRADE			
TITLE: WIREWAY PLAN, BUILDING SECTION, & DETAILS			
DRAWN BY: JTD		SCALE: AS NOTED	
DESIGNED BY: CWV/BCG		DATE: 5/30/23	
FILE NAME: NELS PP E2-E5		SHEET:	
PROJECT NUMBER:		E3.1	
P.O. 111405, Anchorage, AK 99511 (907)349-0100			

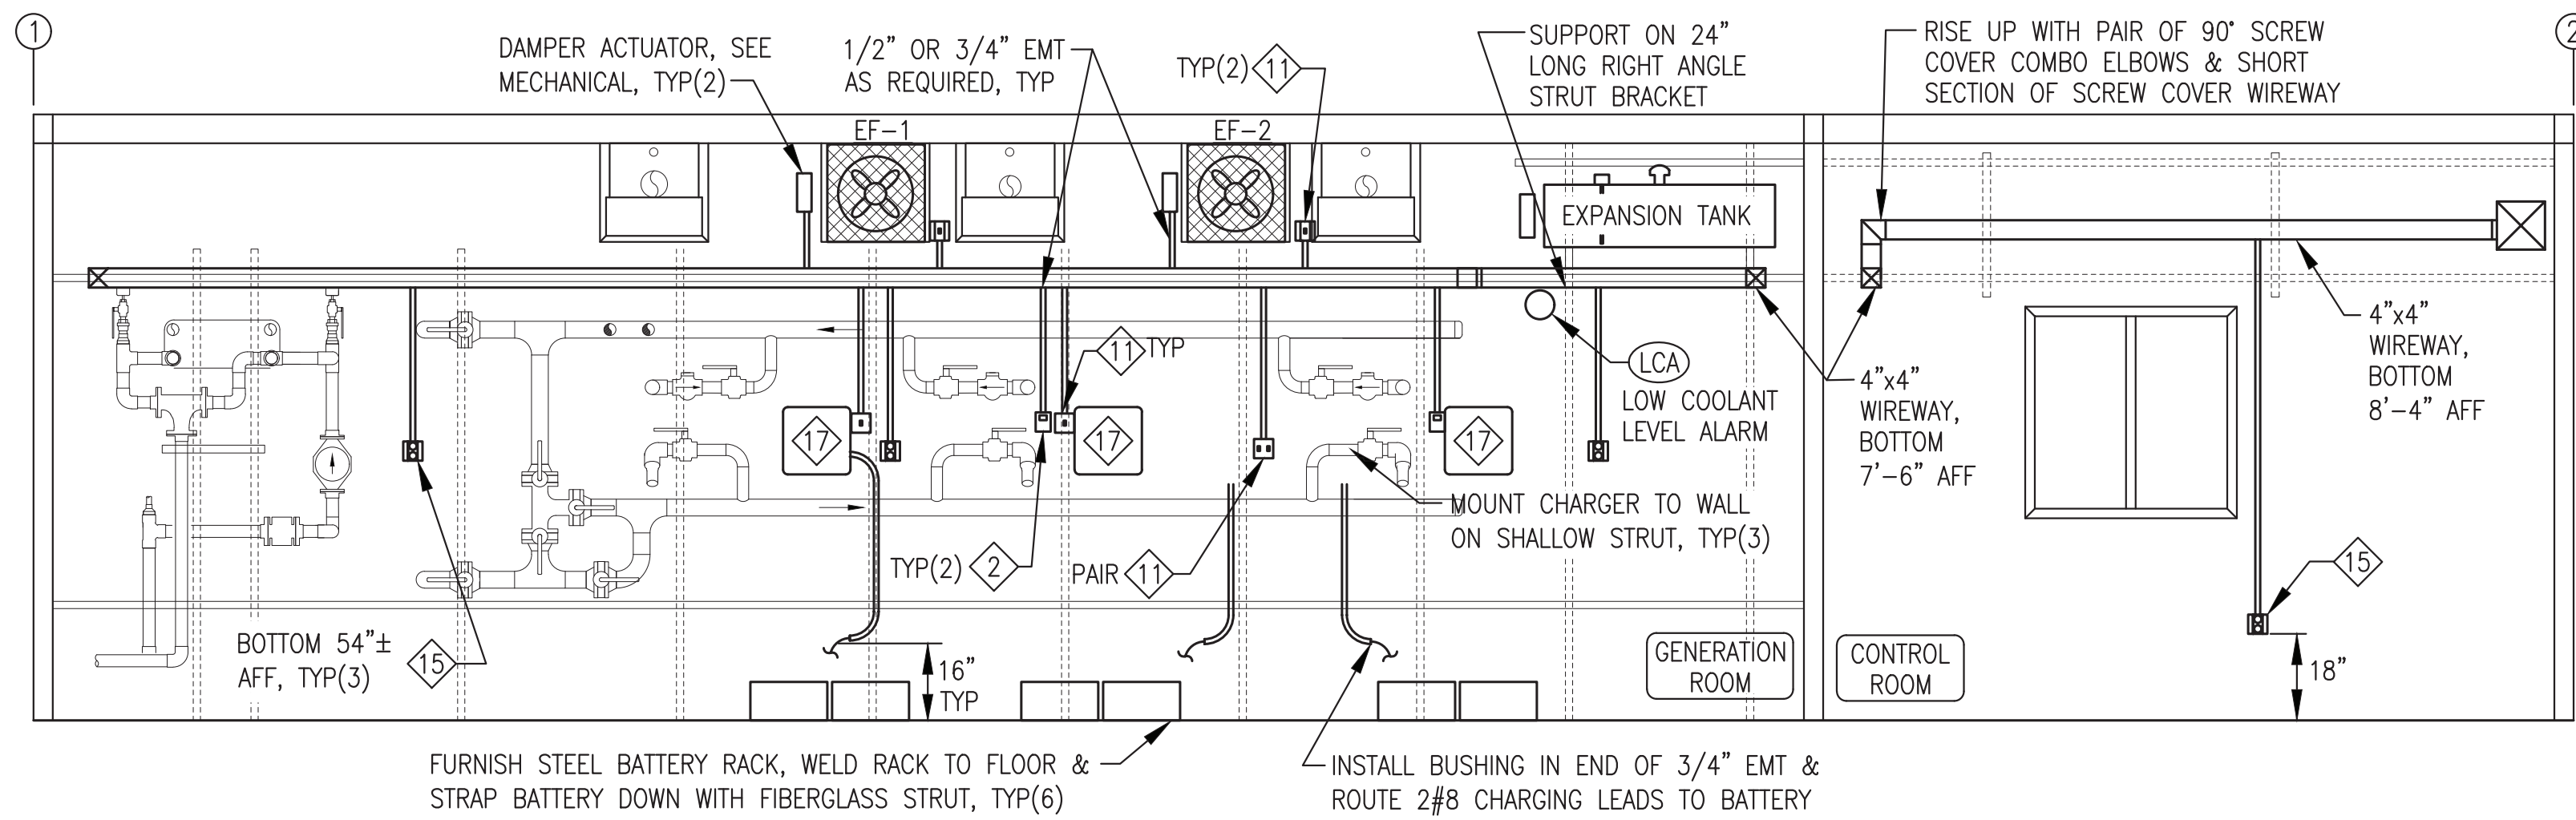


**1** WALL ELEVATION AT GRID A  
E3.2 3/8"=1'-0"

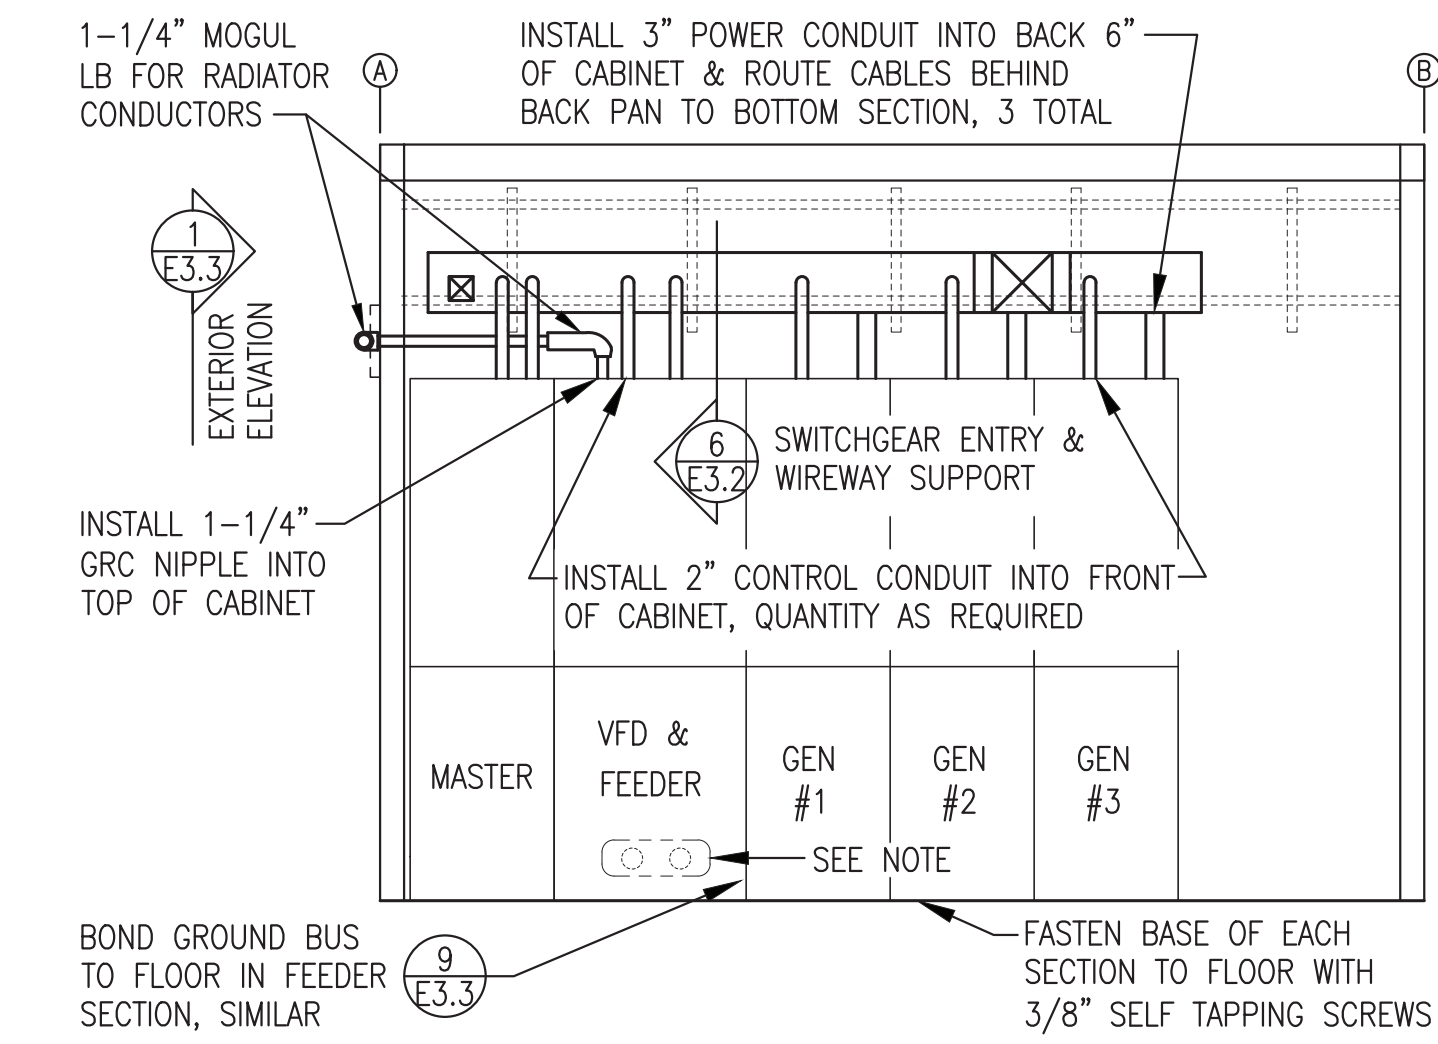


**2** WALL ELEVATION AT GRID 2  
E3.2 3/8"=1'-0"

NOTE:  
CENTER OPENING IN BACK  
OF FEEDER/VFD SECTION  
OVER TWO STEEL NIPPLES  
SHOP WELDED IN WALL  
FOR FEEDER CABLE  
ENTRANCE. SEE DETAIL  
9/E3.3.

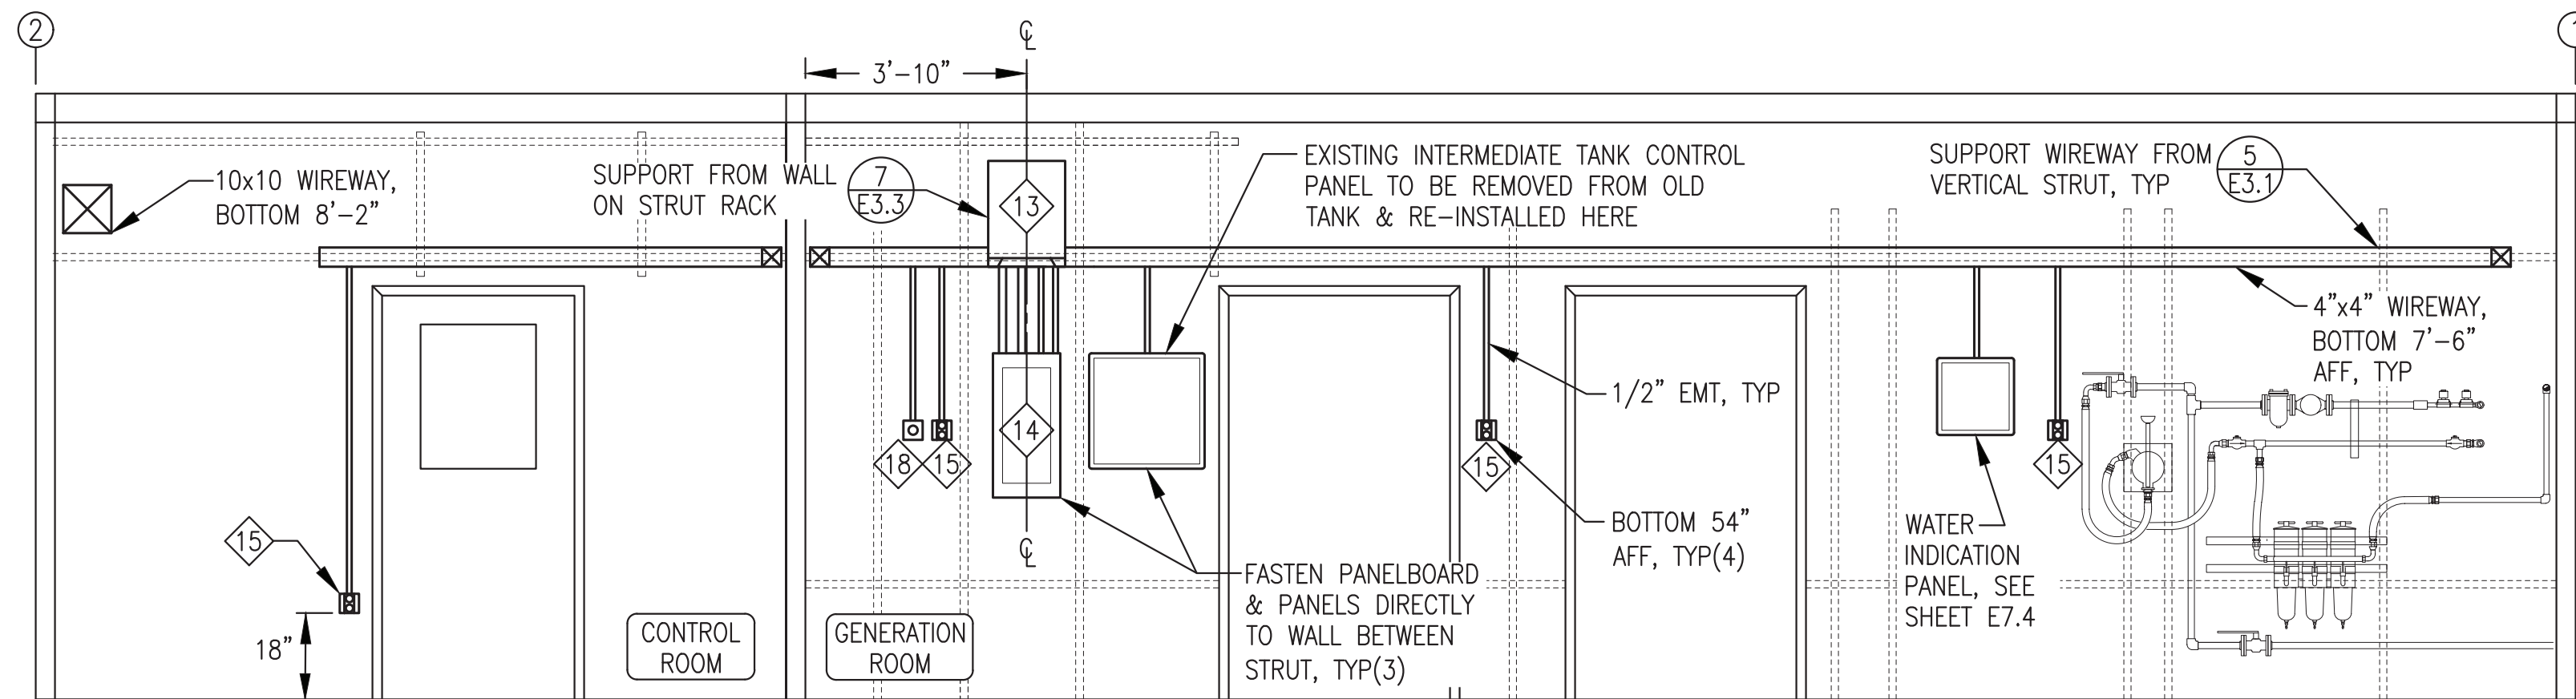


**3** WALL ELEVATION AT GRID B  
E3.2 3/8"=1'-0"

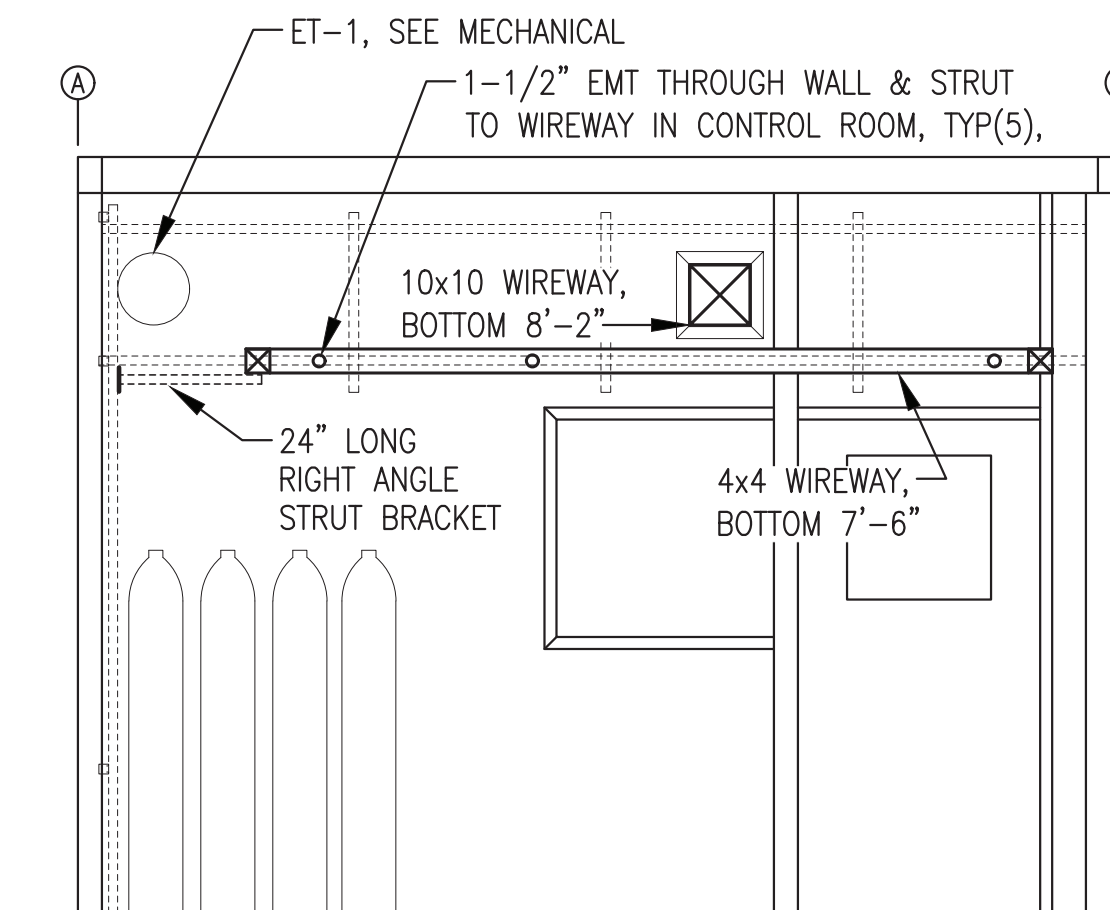


**4** INTERIOR WALL ELEVATION  
E3.2 3/8"=1'-0"

GENERAL NOTE:  
WALL ELEVATIONS SHOWN PRIMARILY FOR GENERAL  
LAYOUT OF MAJOR RACEWAY, EQUIPMENT, AND  
DEVICES REQUIRING REGULAR ACCESS FOR  
NORMAL PLANT OPERATIONS. ALL EQUIPMENT,  
DEVICES & INSTRUMENTATION CIRCUITS NOT  
SHOWN FOR CLARITY. SEE PLANS & DETAILS  
FOR COMPLETE ELECTRICAL INSTALLATIONS.

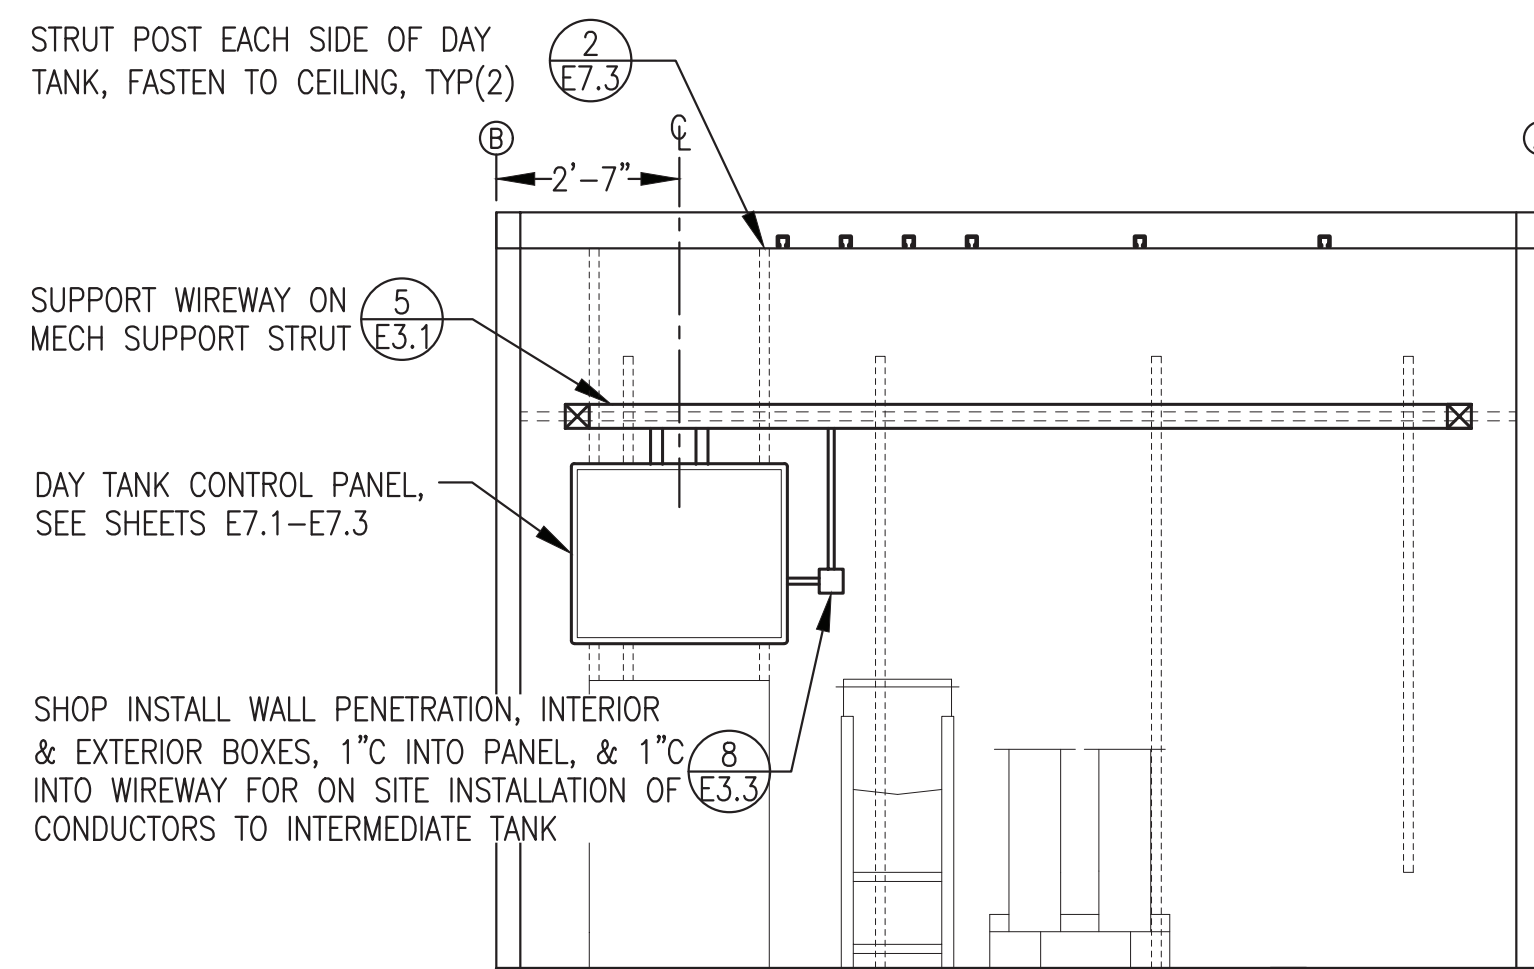

**5** WALL ELEVATION AT GRID 1  
E3.2 3/8"=1'-0"

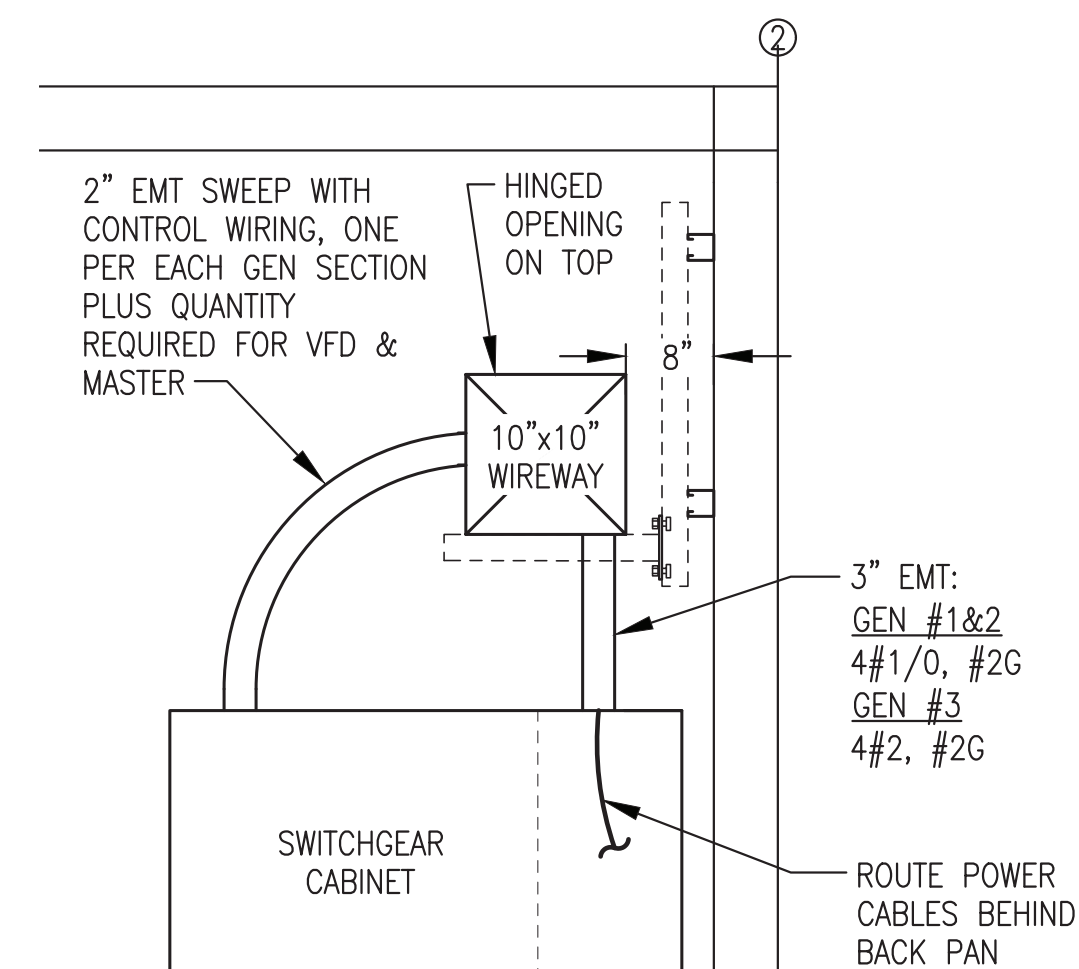


**6** SWITCHGEAR ENTRY & WIREWAY SUPPORT  
E3.2 NO SCALE

ALL WORK ON THIS SHEET WAS PERFORMED AS PART OF  
THE PRIOR MODULE ASSEMBLY CONTRACT AND IS  
SHOWN HERE FOR REFERENCE ONLY.


ISSUED FOR  
CONSTRUCTION  
MAY 2023



ALASKA ENERGY AUTHORITY	
PROJECT: NELSON LAGOON POWER SYSTEM UPGRADE	
TITLE: ELEVATIONS & DETAILS	
DRAWN BY: JTD	SCALE: AS NOTED
DESIGNED BY: CWV/BCG	DATE: 5/30/23
FILE NAME: NELS_PP_E2-E5	SHEET:
PROJECT NUMBER:	<b>E3.2</b>
P.O. 111405, Anchorage, AK 99511 (907)349-0100	

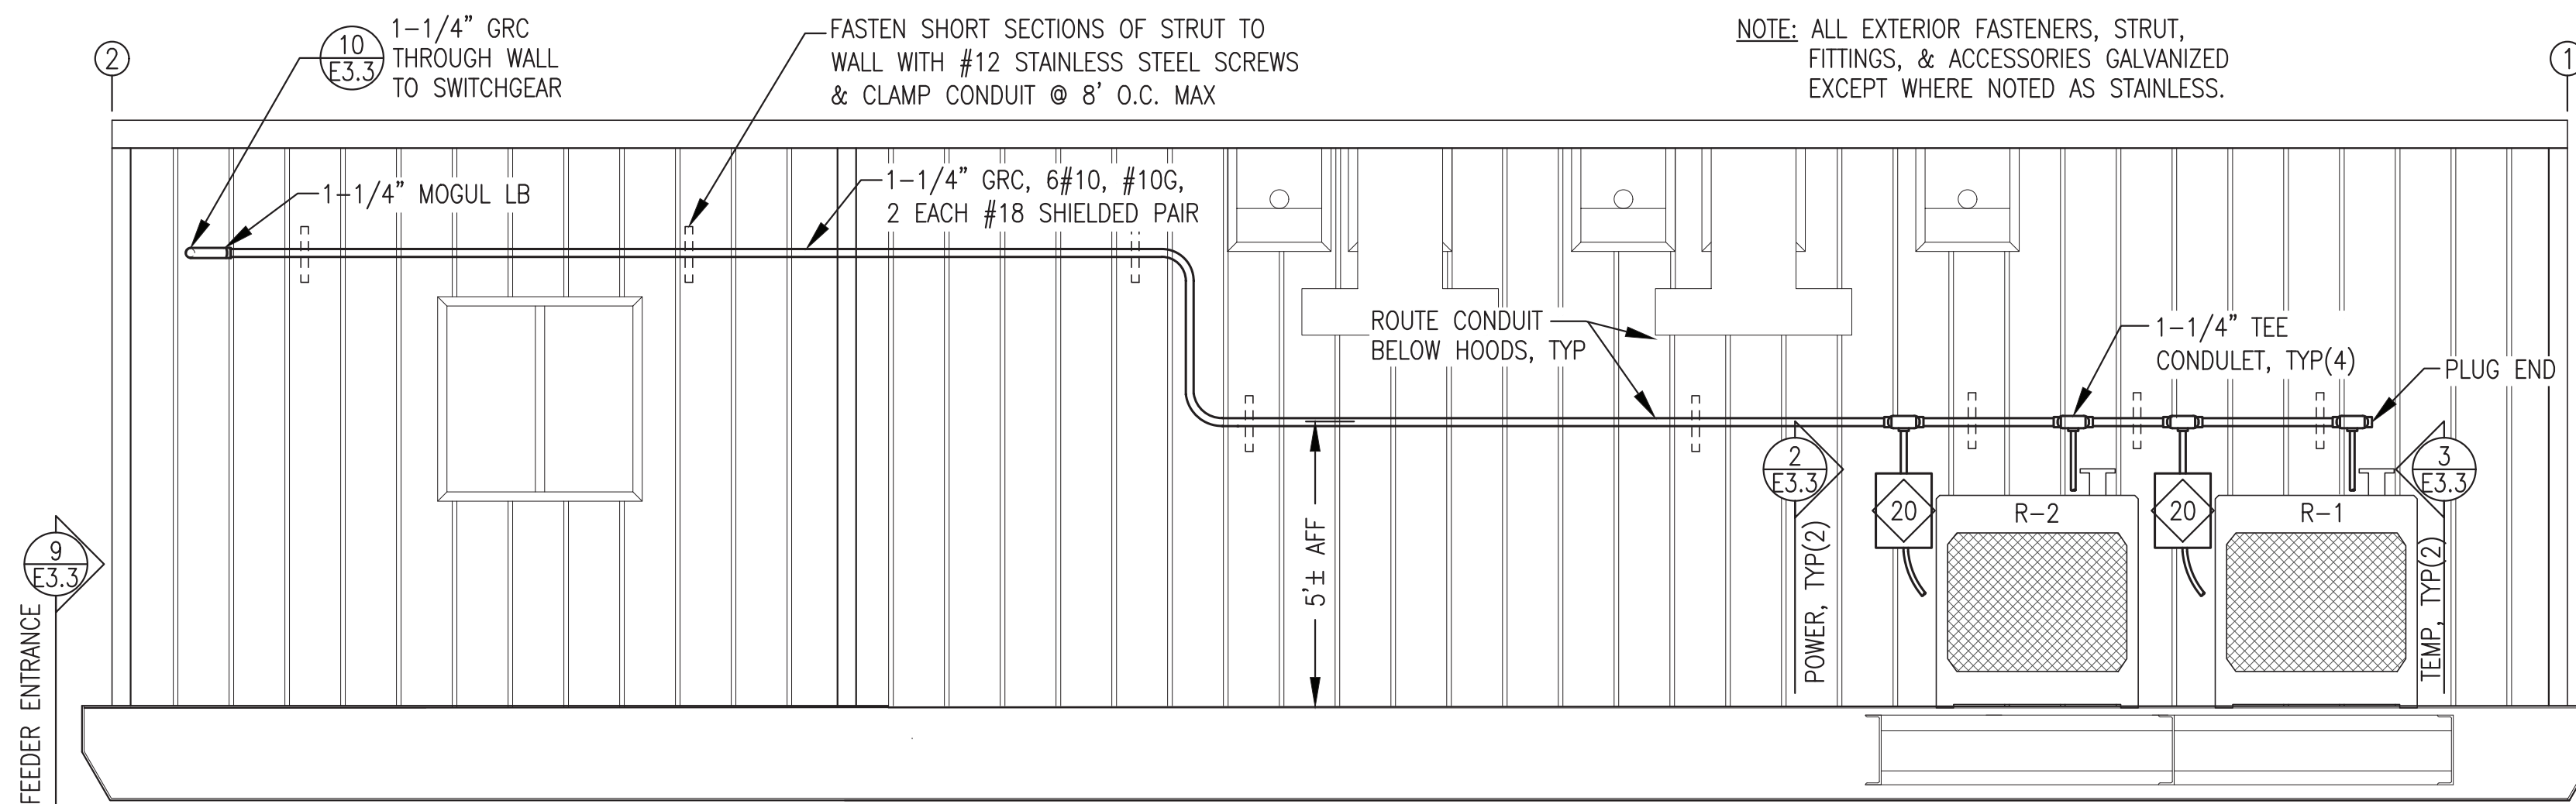


**1** BACK WALL EXTERIOR ELEVATION  
E3.3 3/8"=1'-0"

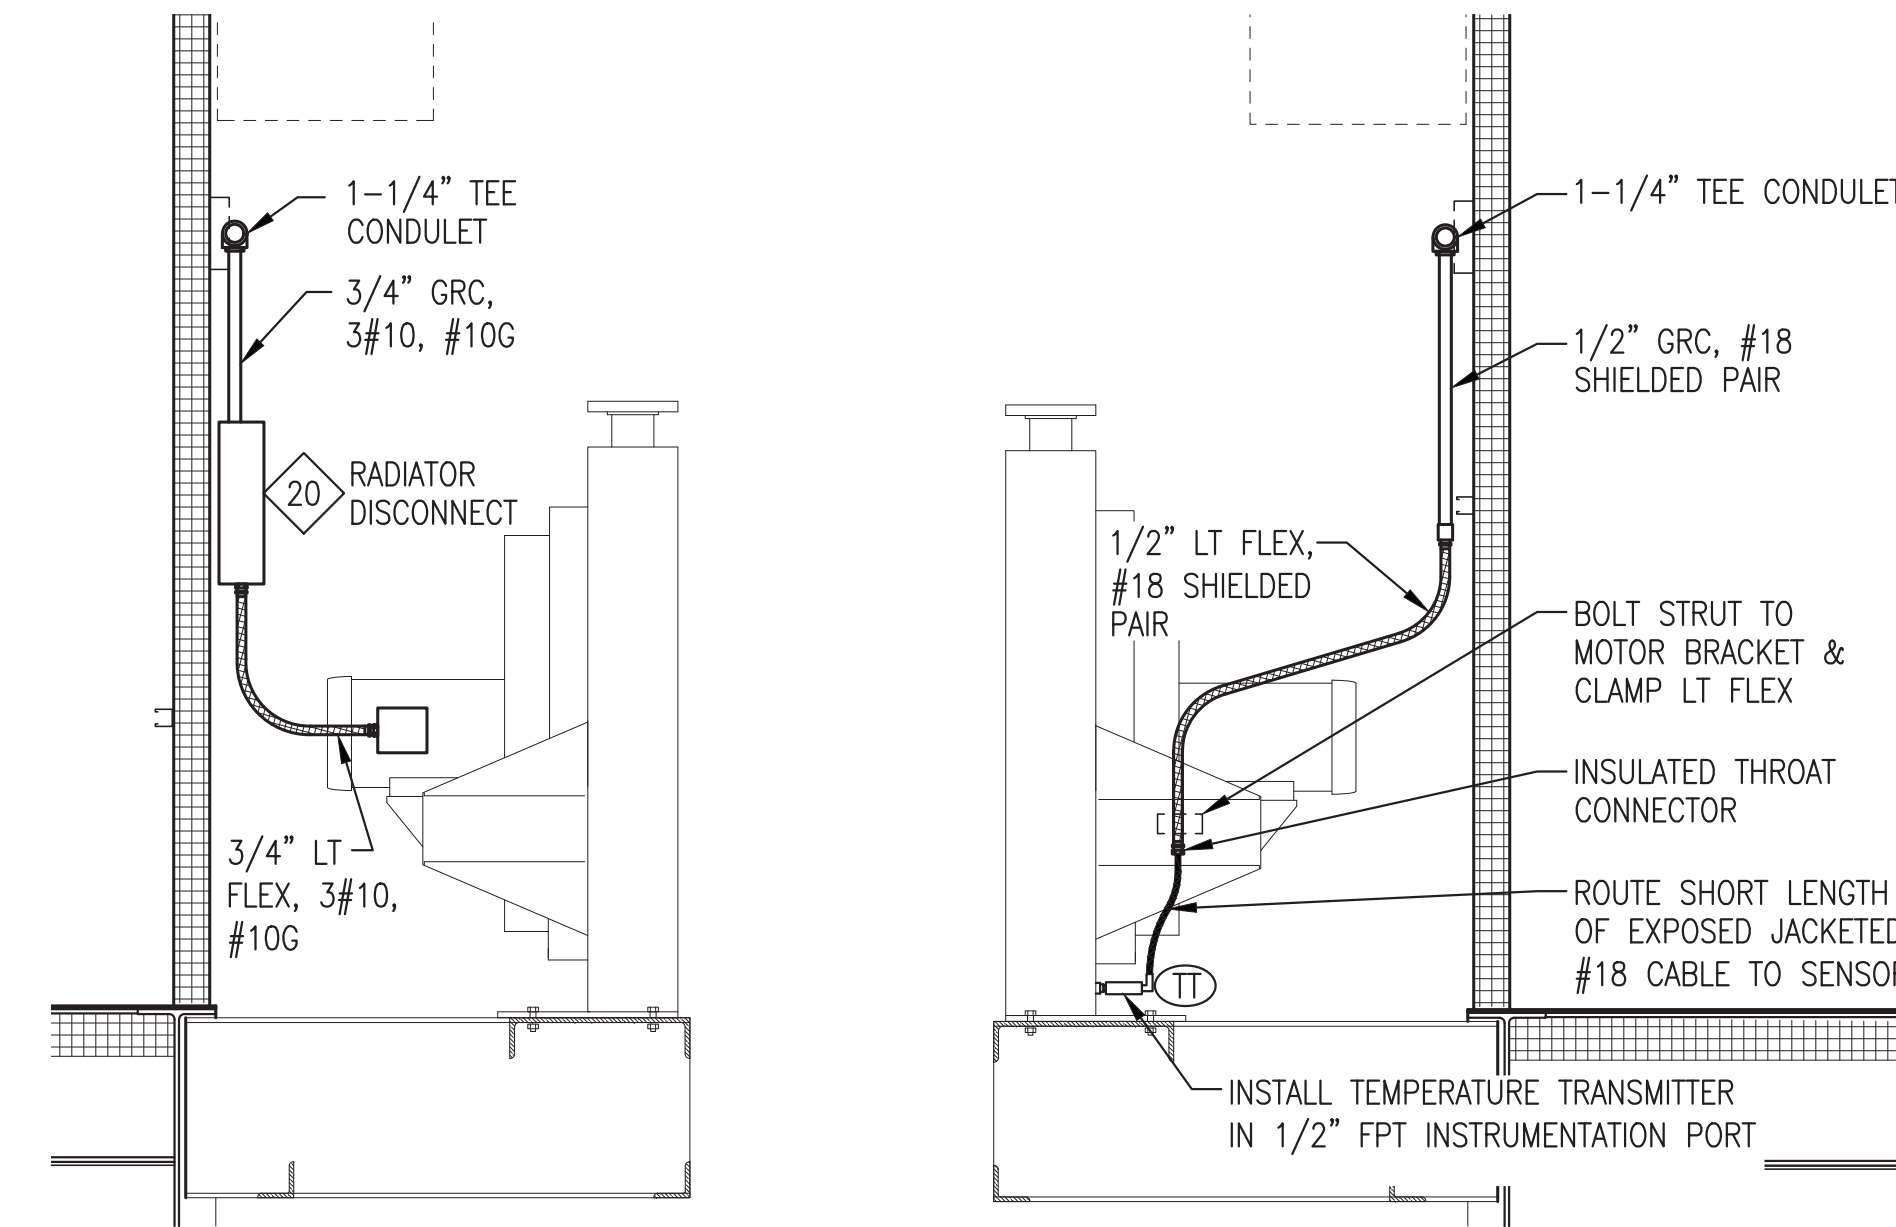


**2** RADIATOR POWER CONNECTION  
E3.3 3/4"=1'-0"

**3** RADIATOR TEMPERATURE TRANSMITTER  
E3.3 3/4"=1'-0"

- RADIATOR SHOP/ON-SITE NOTES:**
- 1) DURING SHOP FABRICATION INSTALL ALL DEVICES AND RACEWAYS AS INDICATED.
  - 2) AS PART OF ON-SITE WORK, IF RADIATORS ARE REMOVED FOR SHIPPING DISCONNECT LIQUID TIGHT FLEXES AND SEAL ENDS. COIL AND SECURE CONDUCTORS AND FLEXES FOR SHIPPING.
  - 3) AS PART OF ON-SITE WORK REINSTALL AS INDICATED.

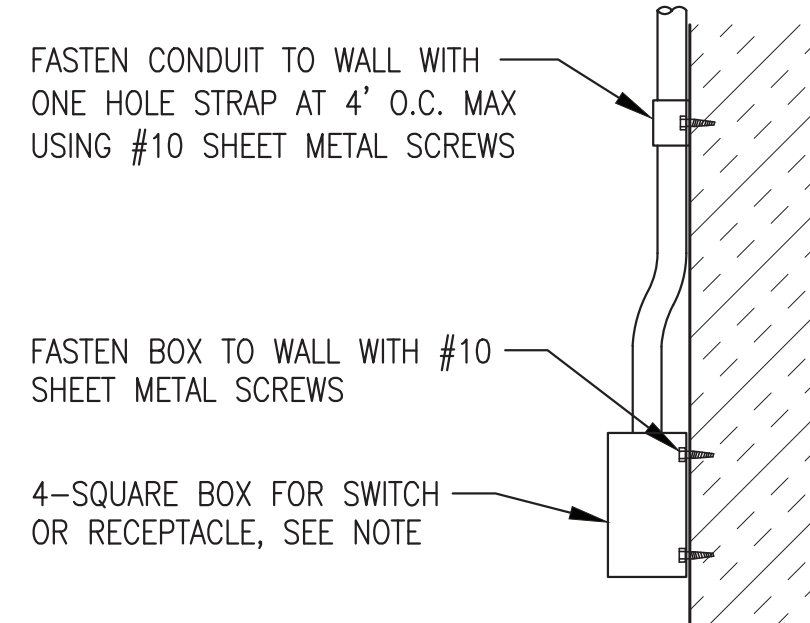


**4** TYPICAL INTERIOR DEVICE MOUNTING  
E3.3 NO SCALE

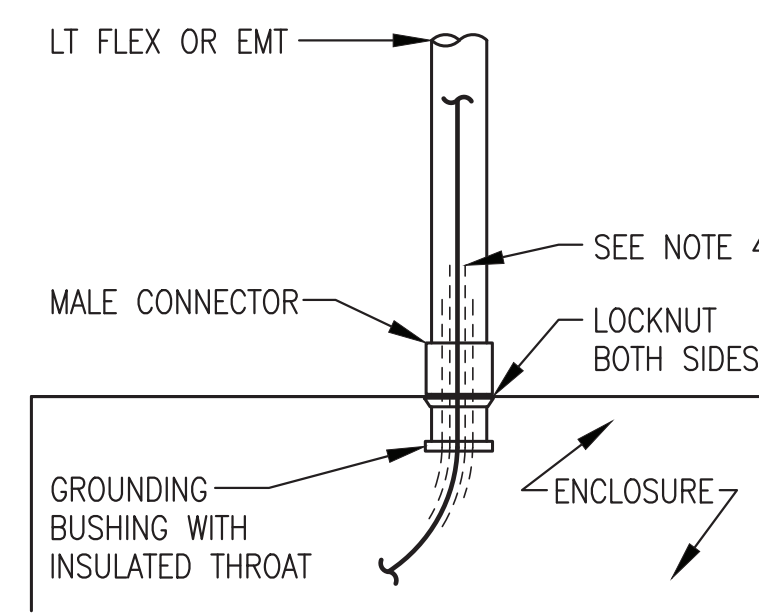


**5** TYP ENCLOSURE CONNECTION  
E3.3 NO SCALE


- NOTES:**
- 1) THIS DETAIL APPLIES TO CONNECTIONS TO WIREWAY, GENERATOR ENCLOSURES, SWITCHGEAR, AND PANELS.
  - 2) AT A MINIMUM INSTALL GROUNDING BUSHING ON ALL GENERATOR POWER CONDUIT, COMMUNITY FEEDER CONDUIT, STATION SERVICE FEEDERS, AND WHERE OTHERWISE INDICATED OR REQUIRED. BOND GROUNDING BUSHING TO EQUIPMENT GROUNDING CONDUCTOR.
  - 3) INSTALL PLASTIC BUSHING WHERE GROUNDING BUSHING IS NOT REQUIRED.
  - 4) ON GENERATOR ENCLOSURES PROTECT CABLES FROM WEAR BY INSTALLING 2 LAYERS OF HEAVY WALL HEAT SHRINK. BASE LAYER 12" LONG & SECOND LAYER 8" LONG, CENTERED IN CONNECTOR.

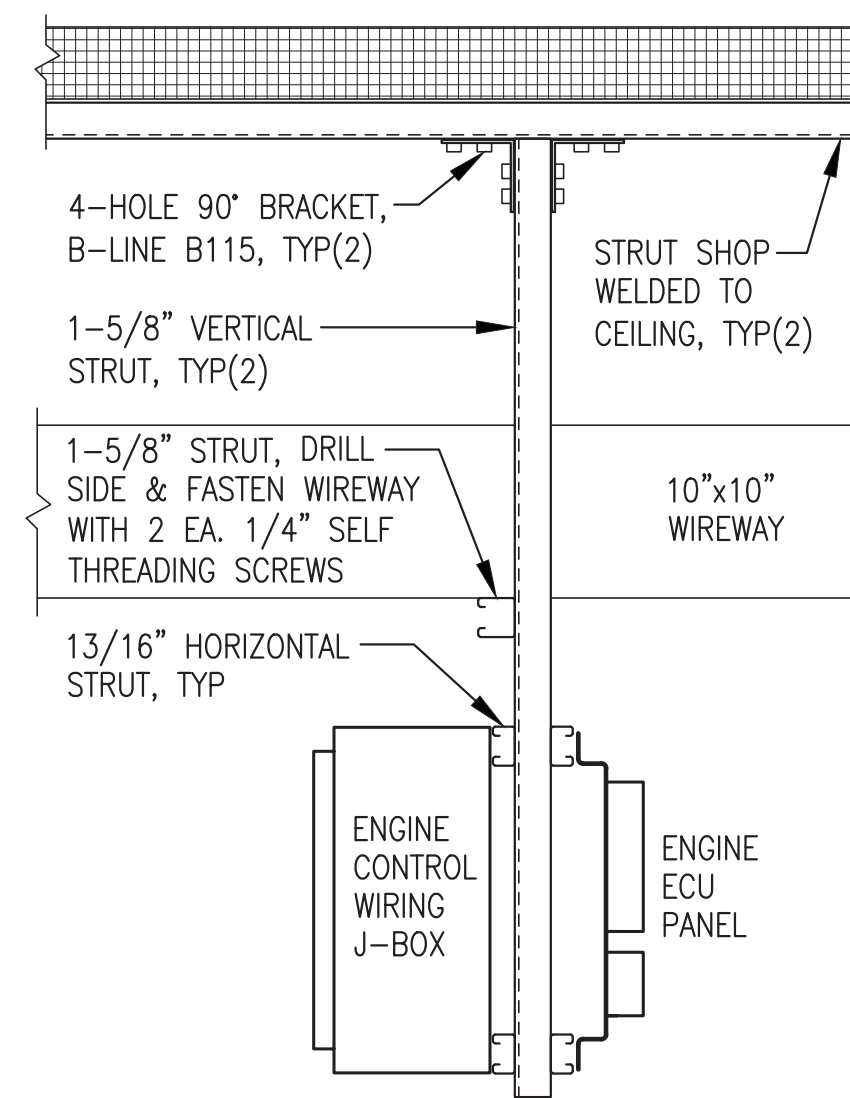


**6** ENGINE WIRING J-BOX SUPPORT  
E3.3 NO SCALE

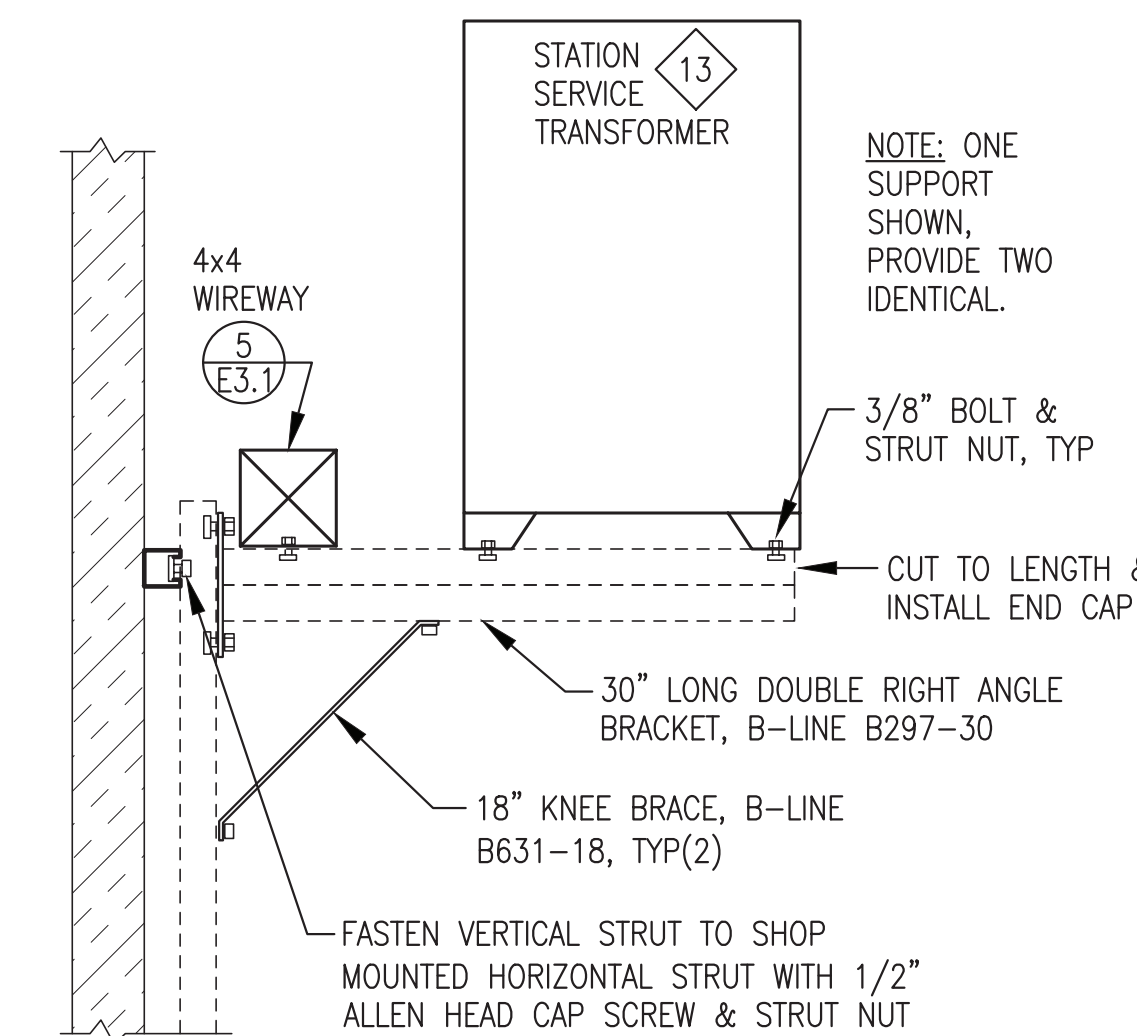


**7** STATION SERVICE TRANSFORMER SUPPORT  
E3.3 NO SCALE

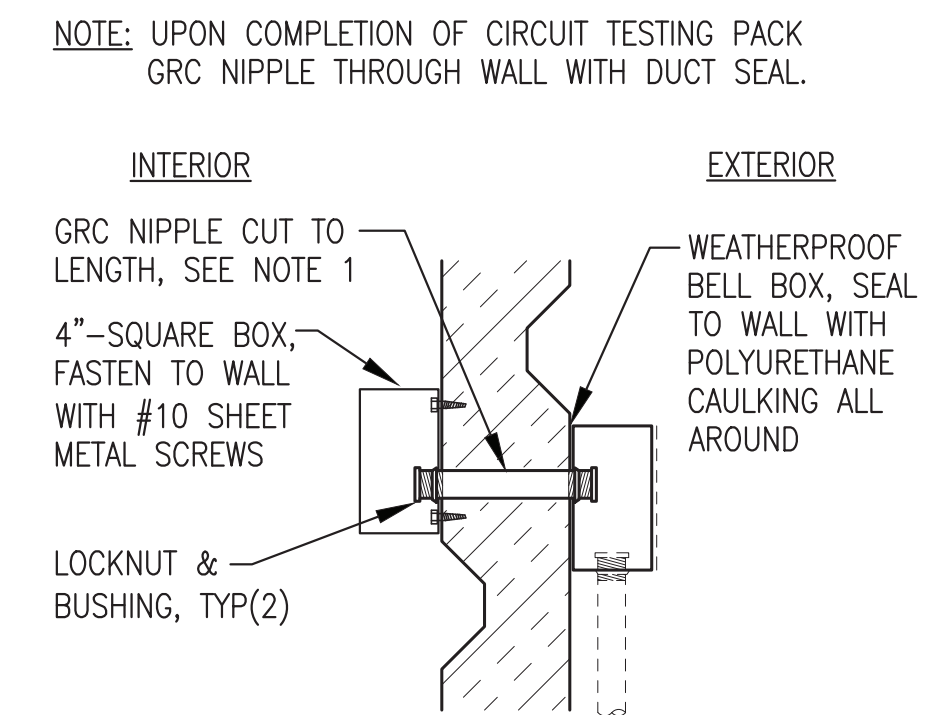

**8** TYP EXTERIOR WALL-MOUNT DEVICE  
E3.3 NO SCALE

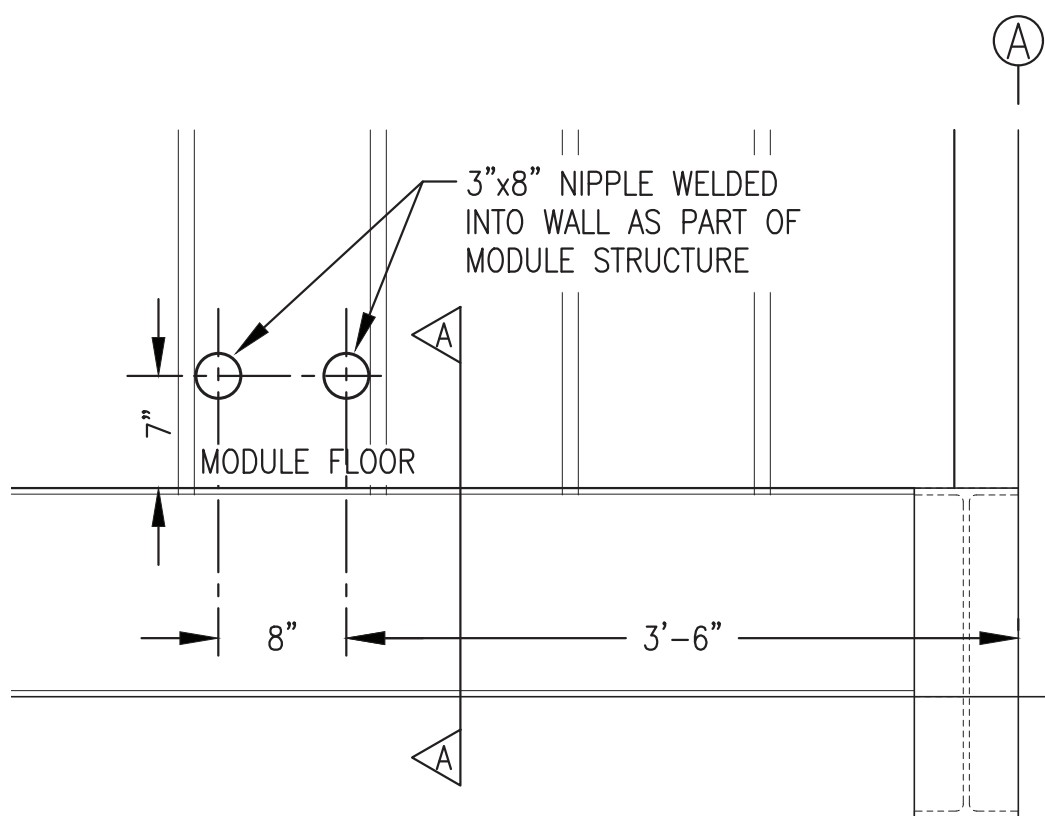

**9** FEEDER ENTRANCE DETAIL  
E3.3 1"=1'-0"

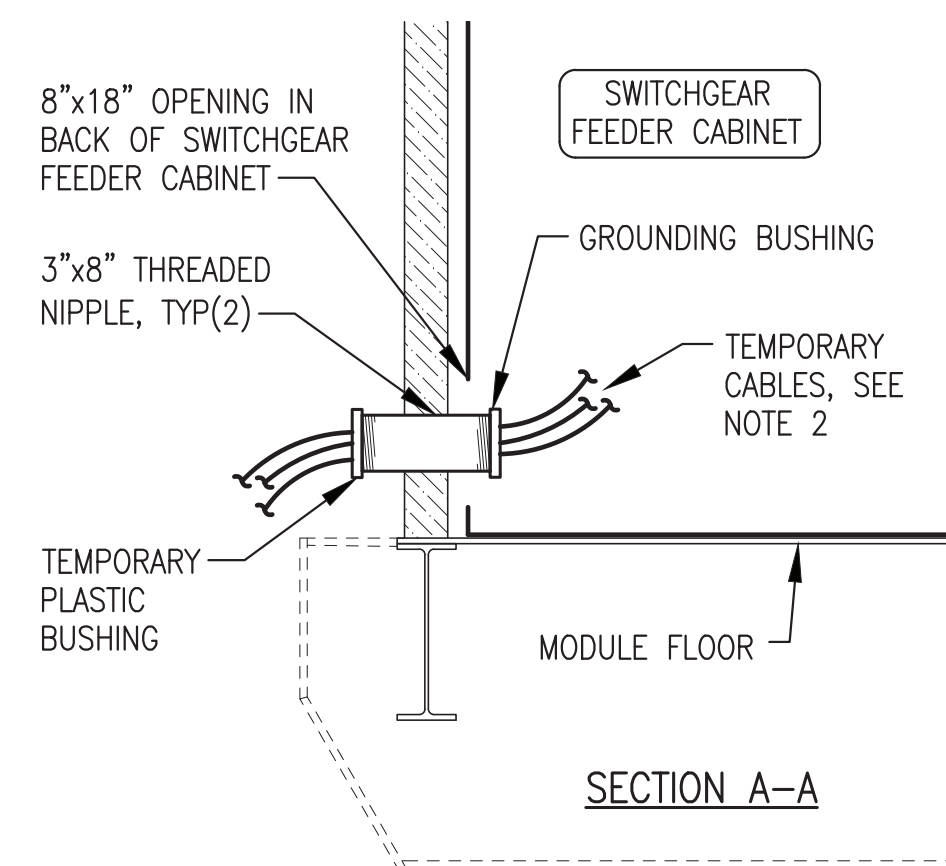


**10** TYP CONDUIT WALL PENETRATION  
E3.3 NO SCALE

**FEEDER SHOP/ON-SITE NOTES:**

- 1) DURING SHOP FABRICATION INSTALL TEMPORARY FEEDER CABLES THROUGH ONE NIPPLE AS SHOWN. SPARE NIPPLE TO REMAIN CAPPED.
- 2) ROUTE TEMPORARY CABLES TO LOAD BANK FOR TESTING. AFTER TESTING INSTALL THREADED CAP ON EXTERIOR END OF NIPPLE.
- 3) INSTALL FEEDER TO TRANSFORMER AS PART OF ON-SITE WORK, SEE SHEET E1.3 FOR CONTINUATION.
- 4) UPON COMPLETION OF TESTING PACK GRC NIPPLES THROUGH WALL WITH DUCT SEAL.

**NOTE:** UPON COMPLETION OF CIRCUIT TESTING PACK GRC NIPPLE THROUGH WALL WITH DUCT SEAL.

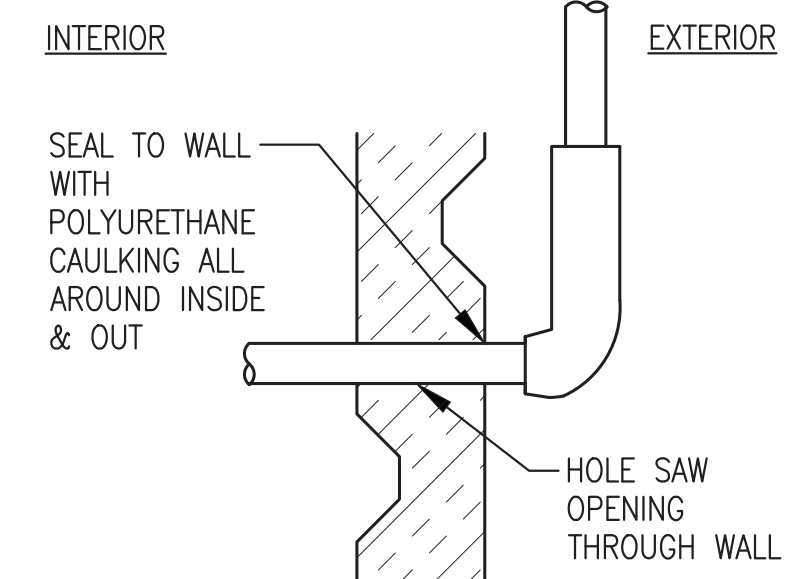


**ALL WORK ON THIS SHEET WAS PERFORMED AS PART OF THE PRIOR MODULE ASSEMBLY CONTRACT EXCEPT AS SPECIFICALLY INDICATED IN THE SHOP/ON SITE NOTES.**

ISSUED FOR CONSTRUCTION  
MAY 2023




PROJECT: <b>NELSON LAGOON POWER SYSTEM UPGRADE</b>	
TITLE: <b>ELEVATIONS &amp; DETAILS</b>	
DRAWN BY: JTD	SCALE: AS NOTED
DESIGNED BY: CWV/BCG	DATE: 5/30/23
FILE NAME: NELS_PP_E2-E5	SHEET: <b>E3.3</b>
PROJECT NUMBER:	


**Gray Stassel Engineering, Inc.**  
P.O. 111405, Anchorage, AK 99511 (907)349-0100

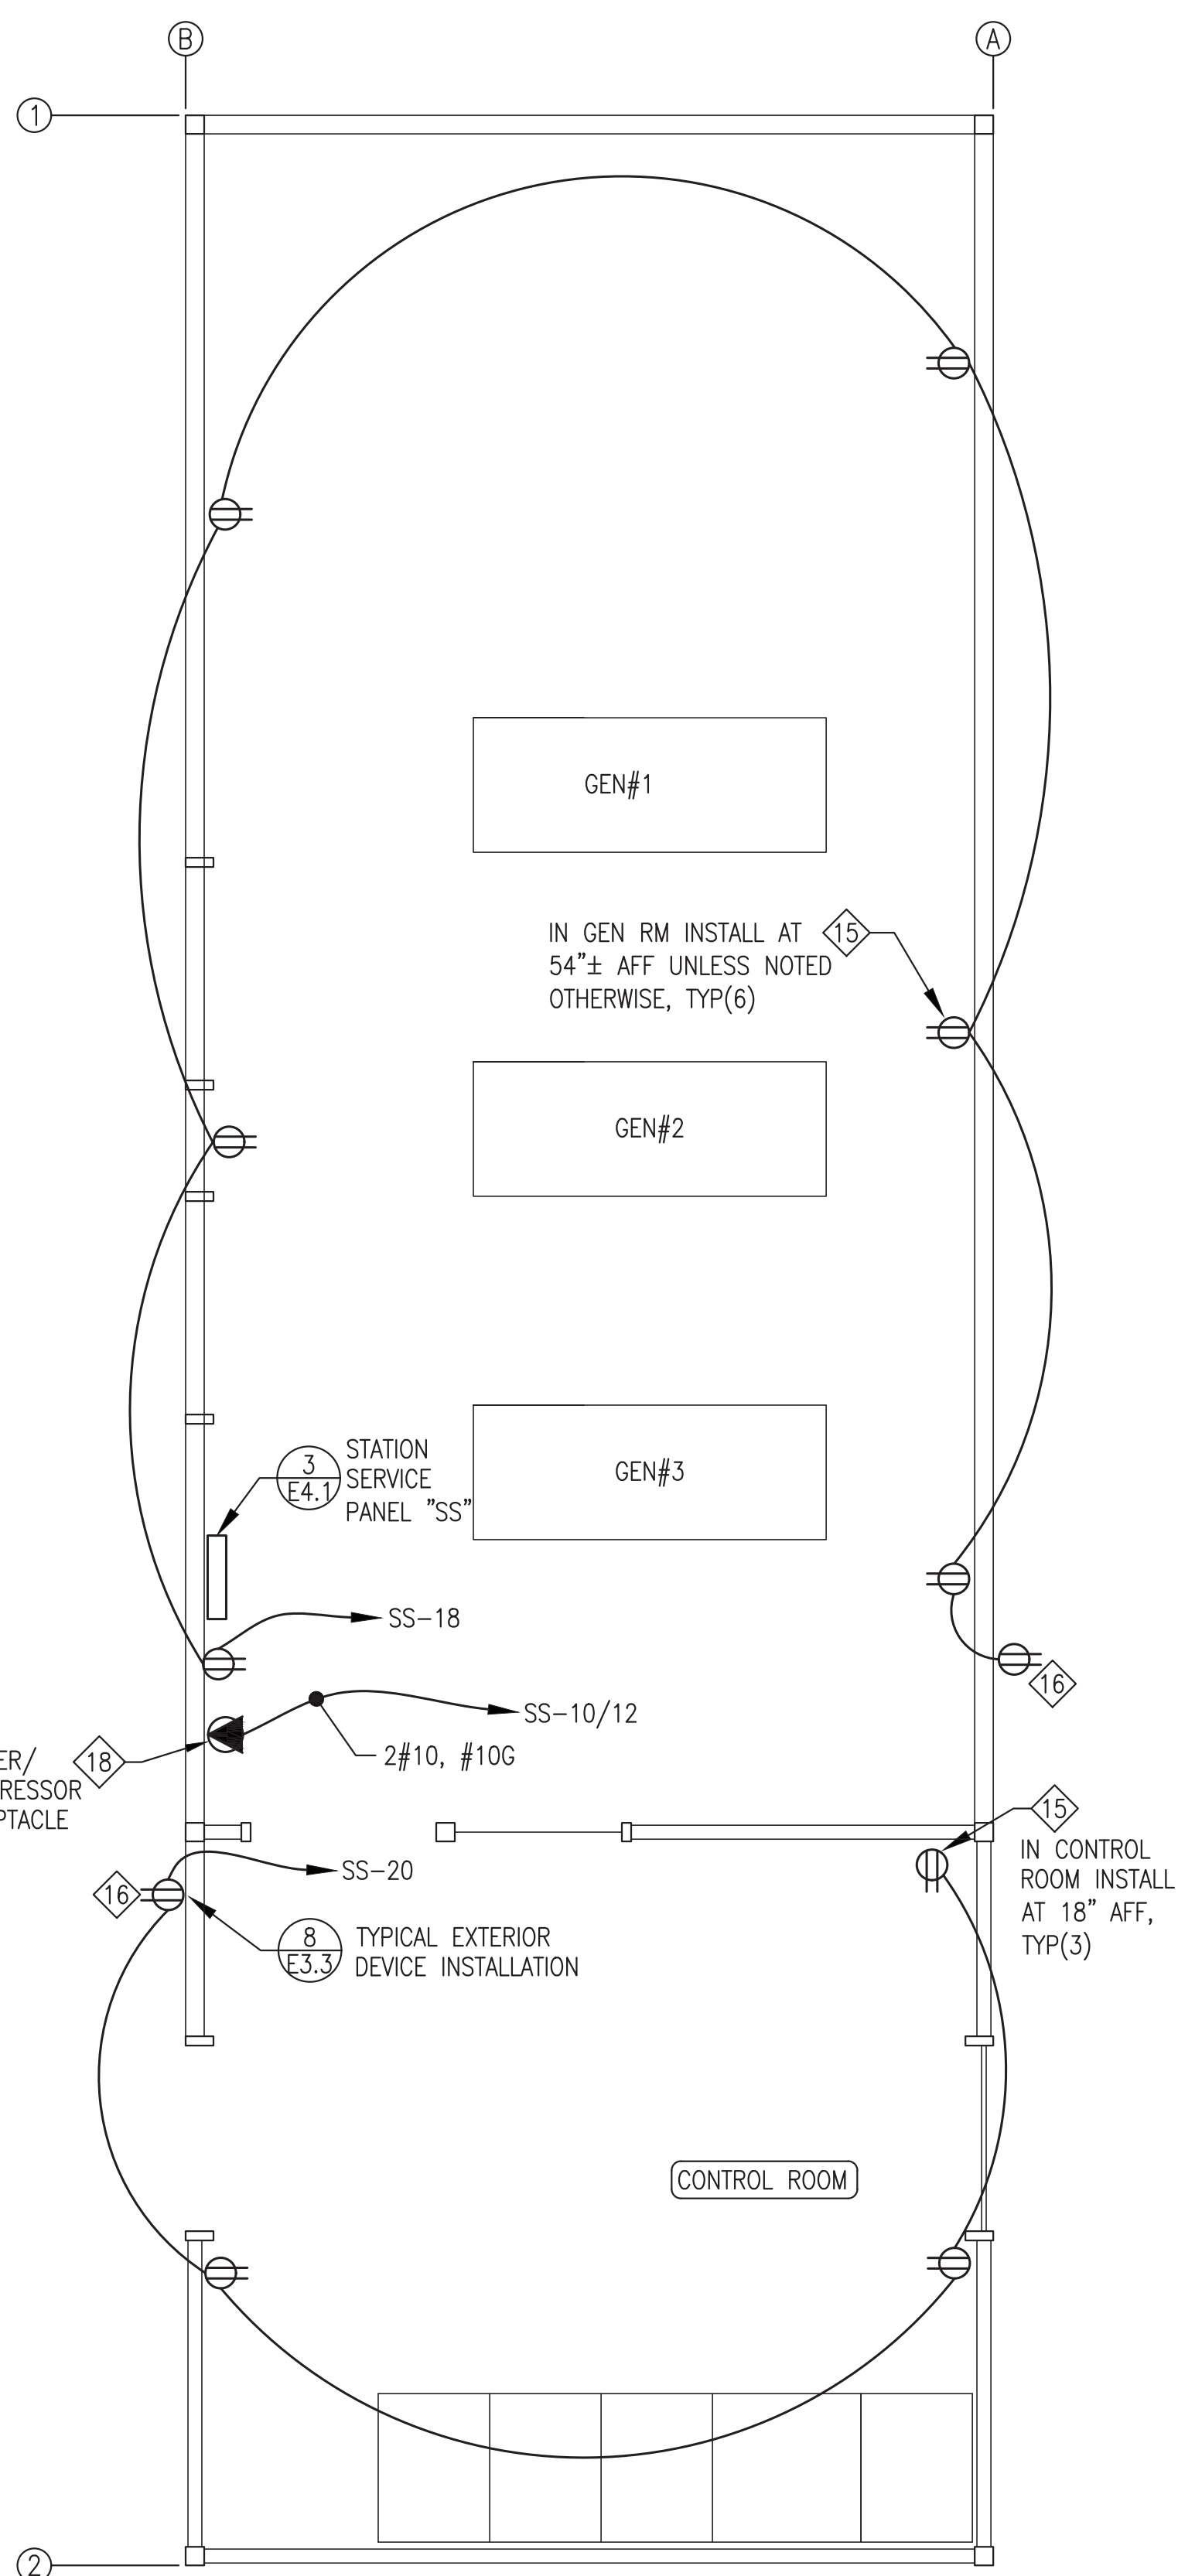

NOTES:  
 1) ALL WIRING RUNS 2#12, #12G UNLESS SPECIFICALLY NOTED OTHERWISE.

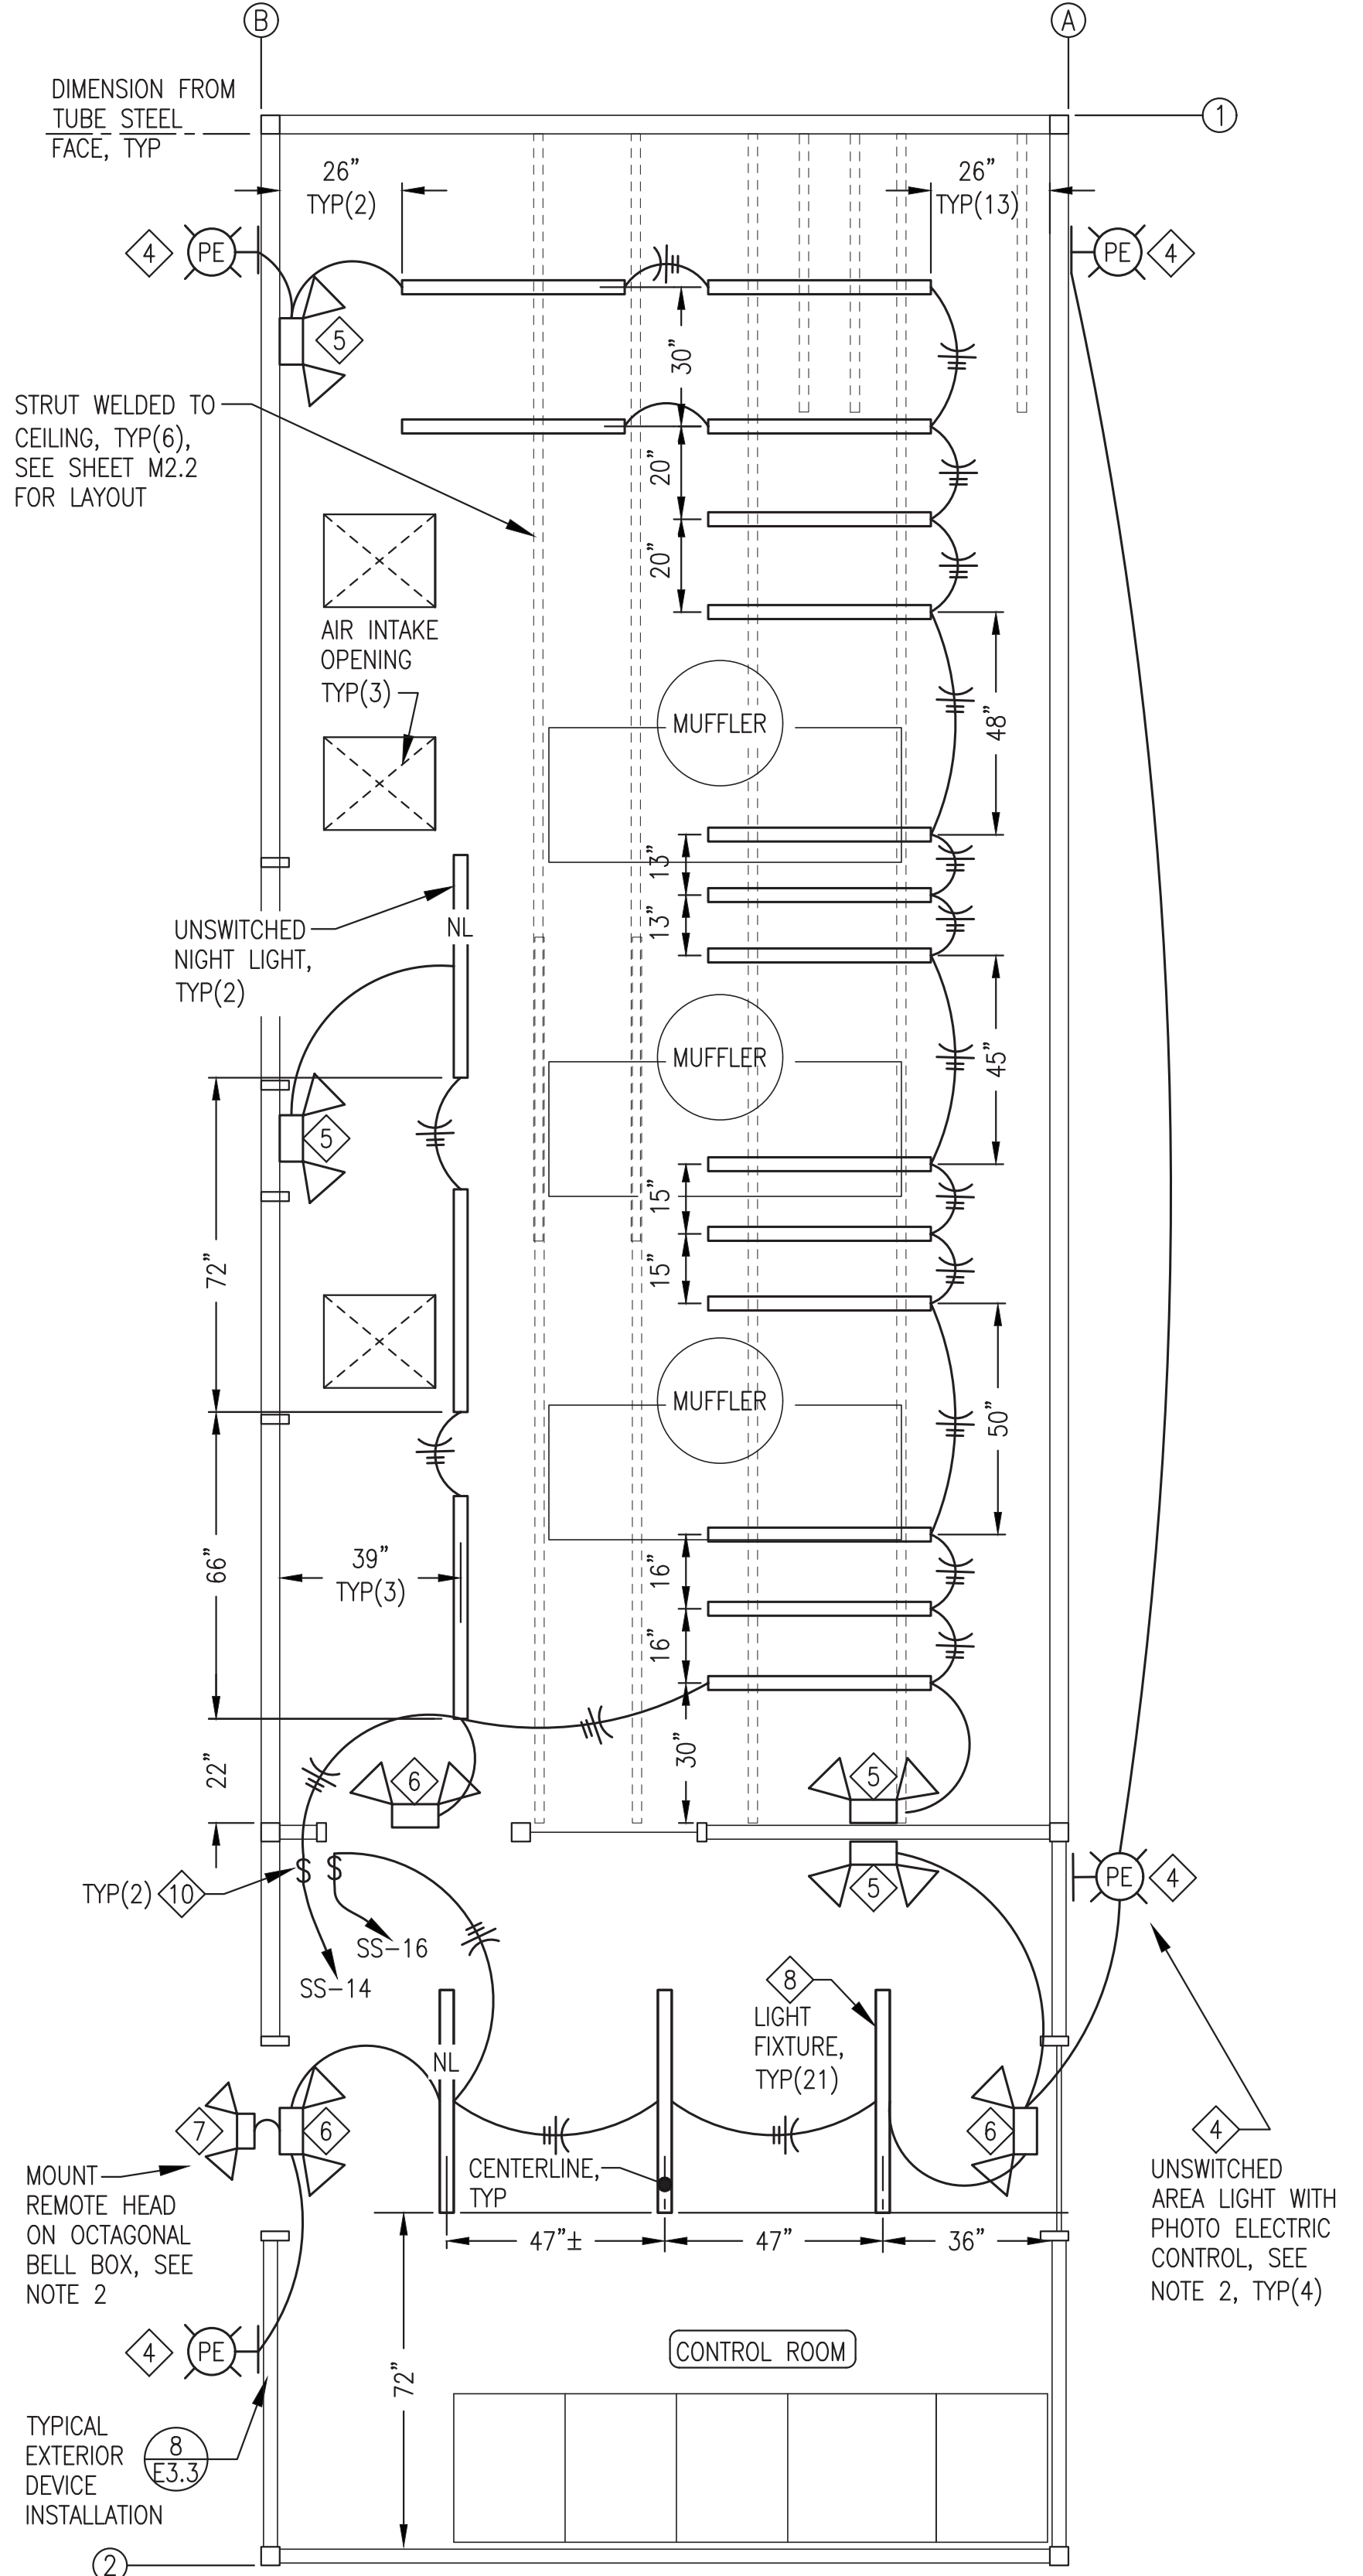

NOTES:  
 1) ALL WIRING RUNS 2#12, #12G UNLESS SPECIFICALLY NOTED OTHERWISE.  
 2) MOUNT EXTERIOR AREA AND EMERGENCY LIGHTS WITH TOP 9'-0" AFF.  
 3) FASTEN INTERIOR LIGHTS TO CEILING WITH #12 SHEET METAL SCREWS EXCEPT WHERE LIGHTS CROSS STRUT USE 1/4" BOLTS & STRUT NUTS, TYP

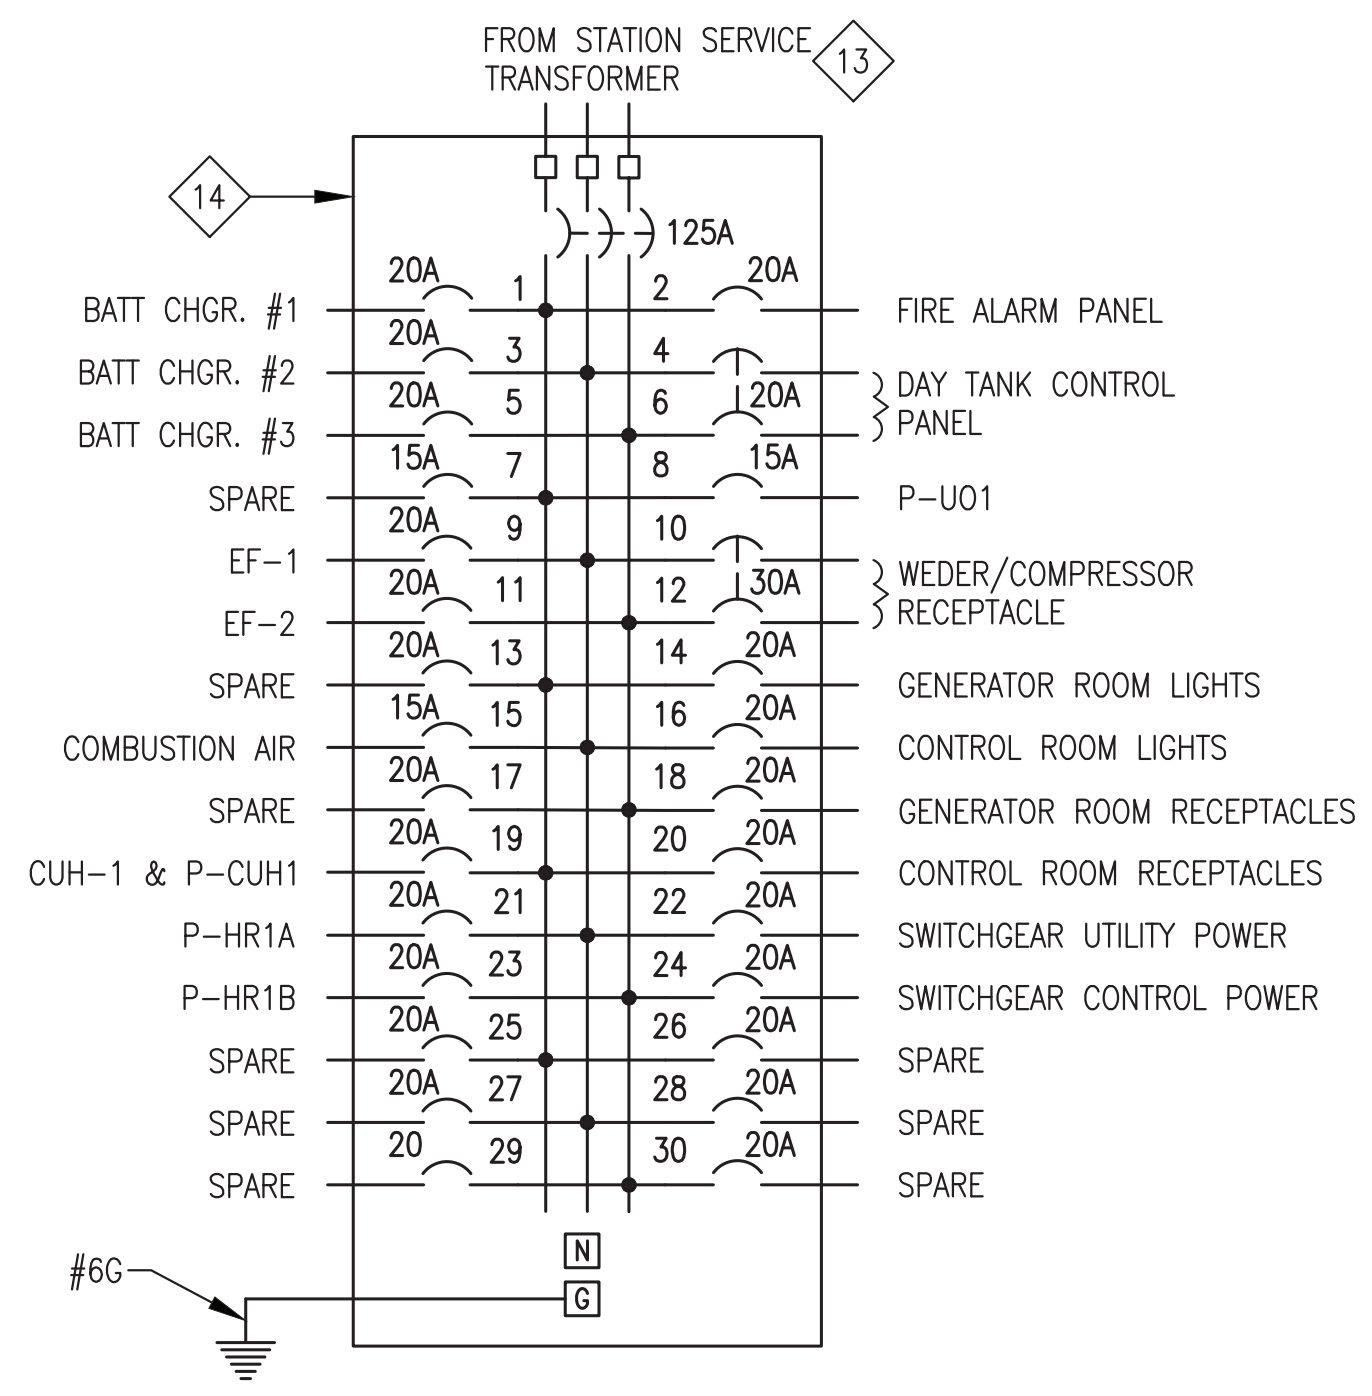

3 STATION SERVICE PANEL "SS"  
 E4.1 NO SCALE

ALL WORK ON THIS SHEET WAS PERFORMED AS PART OF THE PRIOR MODULE ASSEMBLY CONTRACT AND IS SHOWN HERE FOR REFERENCE ONLY.

1 RECEPTACLE PLAN  
 3/8"=1'-0"

2 LIGHTING PLAN  
 3/8"=1'-0"


ISSUED FOR CONSTRUCTION  
 MAY 2023



ALASKA ENERGY AUTHORITY	
PROJECT: NELSON LAGOON POWER SYSTEM UPGRADE	
TITLE: RECEPTACLE & LIGHTING PLANS & PANELBOARD	
DESIGNED BY: CWV/BCG	SCALE: AS NOTED
FILE NAME: NELS_PP_E2-E5	SHEET: E4.1
PROJECT NUMBER: E4.1	





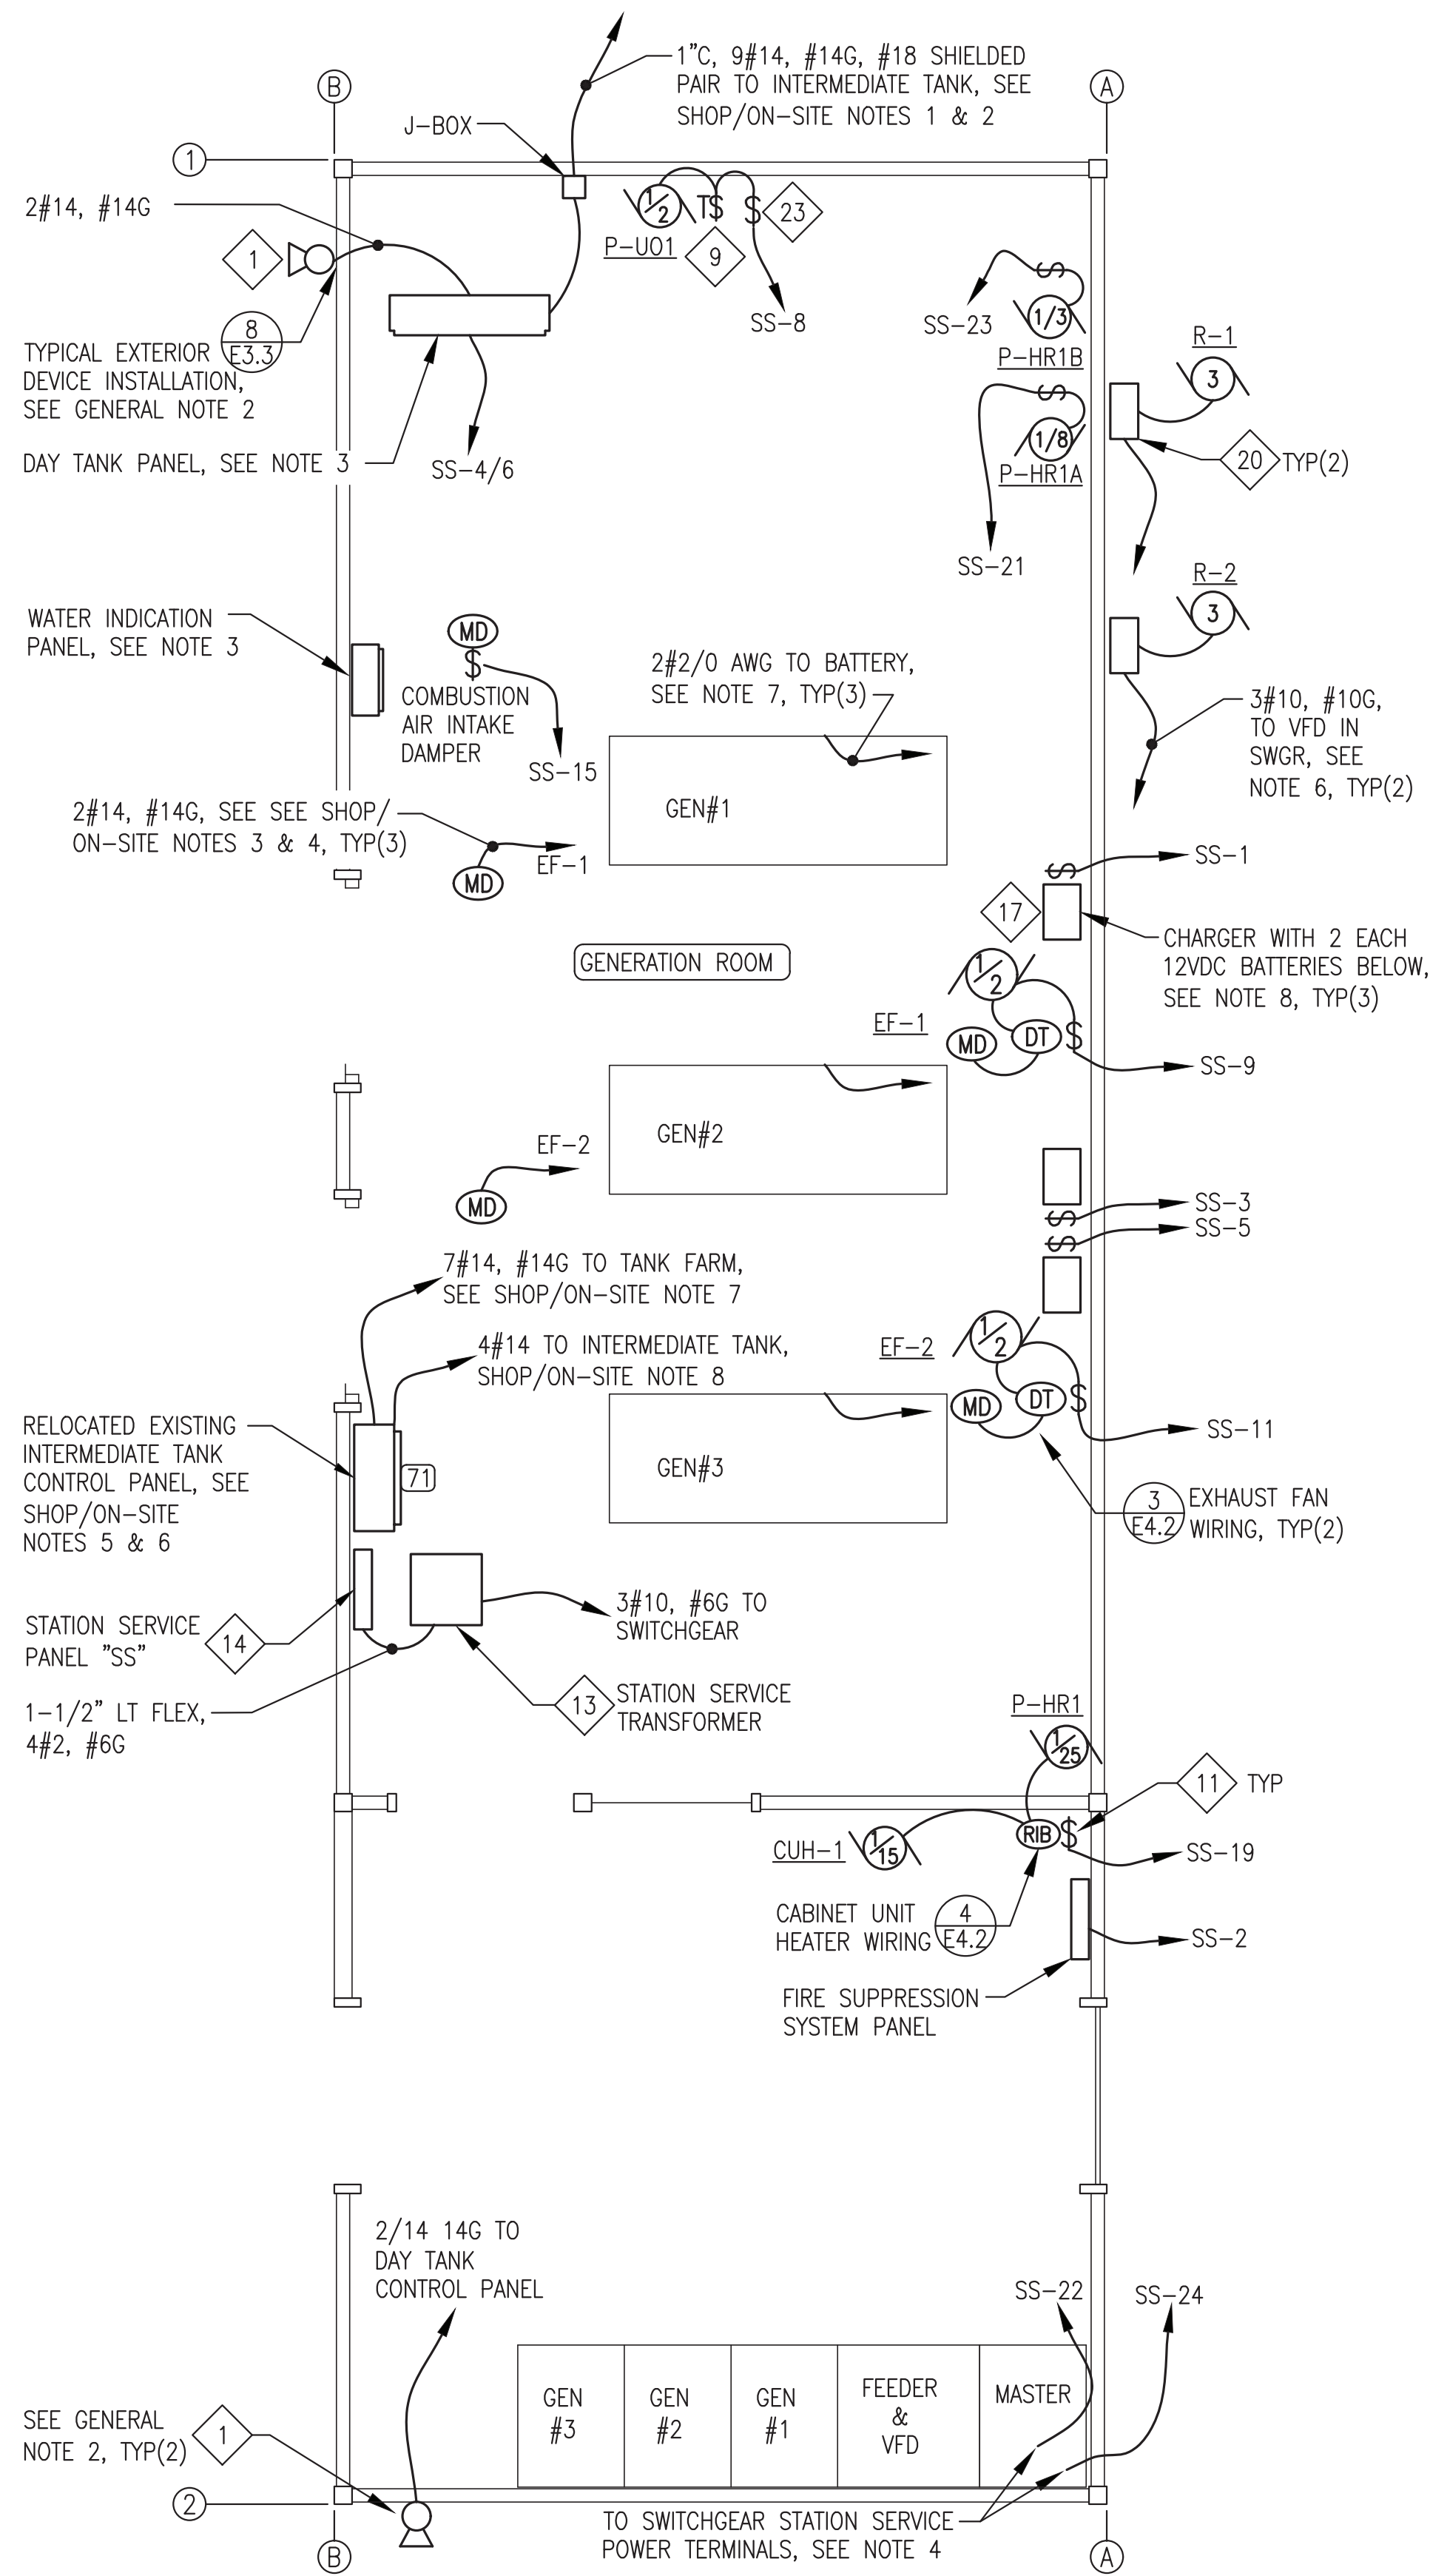

**1** STATION SERVICE PLAN  
E4.2 3/8"=1'-0"


**STATION SERVICE GENERAL NOTES:**

- 1) ALL WIRING RUNS 2#12, #12G UNLESS SPECIFICALLY NOTED OTHERWISE.
- 2) MOUNT ALARMS HORNS WITH TOP AT 9'-0" AFF TO MATCH EXTERIOR LIGHTS, SEE SHEET E4.1
- 3) SEE SHEETS E7.1-E7.4 FOR DAY TANK AND WATER INDICATION PANEL DESIGN AND WIRING TERMINATIONS. ALL ACCESSORIES NOT SHOWN ON PLANS. SEE LOGIC DIAGRAMS FOR ADDITIONAL DETAIL.
- 4) SEE SWITCHGEAR SHOP DRAWINGS FOR TERMINATION OF ALL POWER AND CONTROL WIRING.
- 5) NOT USED.
- 6) ROUTE RADIATOR VFD POWER CONDUCTORS IN SEPARATE EXTERIOR CONDUIT, SEE ELEVATION 1/E3.3. DO NOT ROUTE IN WIREWAY. NOTE THAT CONDUCTORS ARE OVERSIZED FOR 80% DE-RATE AND PROVIDED WITH 15A BREAKER IN SWITCHGEAR.
- 7) ROUTE BATTERY CABLES TO FRONT OF SKID SUPPORTED WITH CUSHIONED CLAMPS, SEE SHEET M3.4. ROUTE FROM SKID DIRECTLY UNDER FUEL HOSES TO WALL AND TYWRAP CABLES TO USED OIL PIPE ALONG WALL, SEE DETAIL 2/E3.1. CUT TO PROVIDE 6"± SERVICE LOOP FOR FINAL TERMINATION ON BATTERIES.
- 8) MOUNT BATTERY CHARGER TO WALL ON SHALLOW STRUT AND INSTALL BATTERIES IN RACK ON FLOOR BELOW, SEE ELEVATION 1/E3.2.


**STATION SERVICE SHOP/ON-SITE NOTES:**

- 1) DURING SHOP FABRICATION INSTALL WALL PENETRATION AND CONDUIT INTO DAY TANK PANEL. SEE ELEVATION 5/E3.2.
- 2) AS PART OF ON-SITE WORK INSTALL CONDUIT AND CONDUCTORS TO INTERMEDIATE TANK, SEE SHEET E1.6.
- 3) DURING SHOP FABRICATION INSTALL CEILING MOUNTED BOX ADJACENT TO DAMPER ACTUATOR AND TEMPORARILY CONNECT DAMPER TO VERIFY OPERATION.
- 4) AS PART OF ON-SITE WORK INSTALL CONDUIT AND CONDUCTORS TO DAMPER ACTUATOR. SEE SHEET M7.
- 5) EXISTING INTERMEDIATE TANK CONTROL PANEL SALVAGED FROM OLD INTERMEDIATE TANK AND INSTALLED IN MODULE AS PART OF ON-SITE WORK. SEE SHEET E1.2 FOR EXISTING LOCATION OF PANEL. SEE WALL ELEVATION 3/E3.2 FOR NEW LOCATION AND MOUNTING.
- 6) SEE ORIGINAL BULK FUEL UPGRADE PROJECT SHEETS E6-E9 FOR PANEL DESIGN AND LOGIC. NOTE THAT THIS PANEL IS POWERED FROM THE TANK FARM CONTROL PANEL, NOT THE MODULE. INSTALL DECAL 71 ON FACE. SEE SHEET M1.2.
- 7) SEE SHEET E1.5 FOR RE-CONNECTION OF EXISTING RE-ROUTED ARMORED CABLE FROM TANK FARM.
- 8) ROUTE NEW CONDUCTORS TO NEW INTERMEDIATE TANK FLOAT SWITCH IN SAME RACEWAY AS DAY TANK CONTROL PANEL CONDUCTORS, SEE SHEET E1.3. CONNECT NEW SWITCH TO MATCH ORIGINAL TERMINATIONS IN PANEL AND VERIFY FUNCTION.


MAKE THE FOLLOWING SETTINGS ON DIGITAL THERMOSTAT:  
 APPLICATION = 0 (INTERNAL SENSOR)  
 OUTPUT 1 = 0 (COOL/0-10V)  
 OUTPUT 2 = 0 (NOT USED)  
 OUTPUT 3 = 0 (NOT USED)  
 OUTPUT 3 ACTIVATION = 0 (100%)  
 NSB VALUE = 3 (6'F)  
 OUTPUT 1 MIN = 0 (0%)  
 MAX SETPOINT = 90'F  
 MIN SETPOINT = 50'F

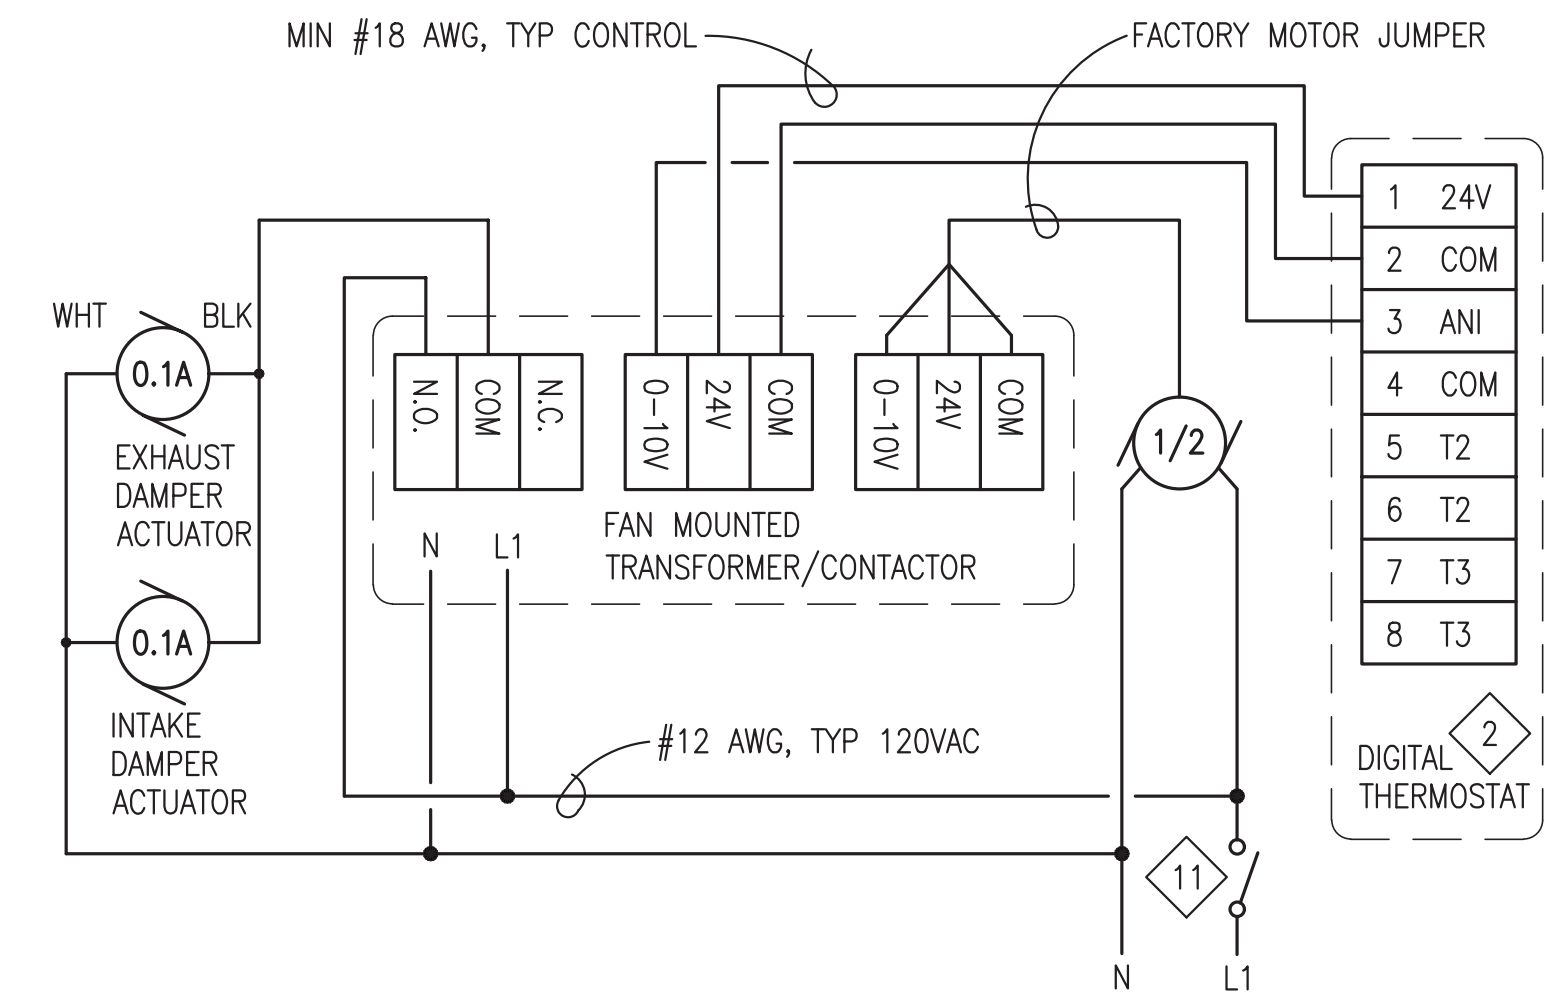

**3** EXHAUST FAN WIRING DIAGRAM  
E4.2 NO SCALE

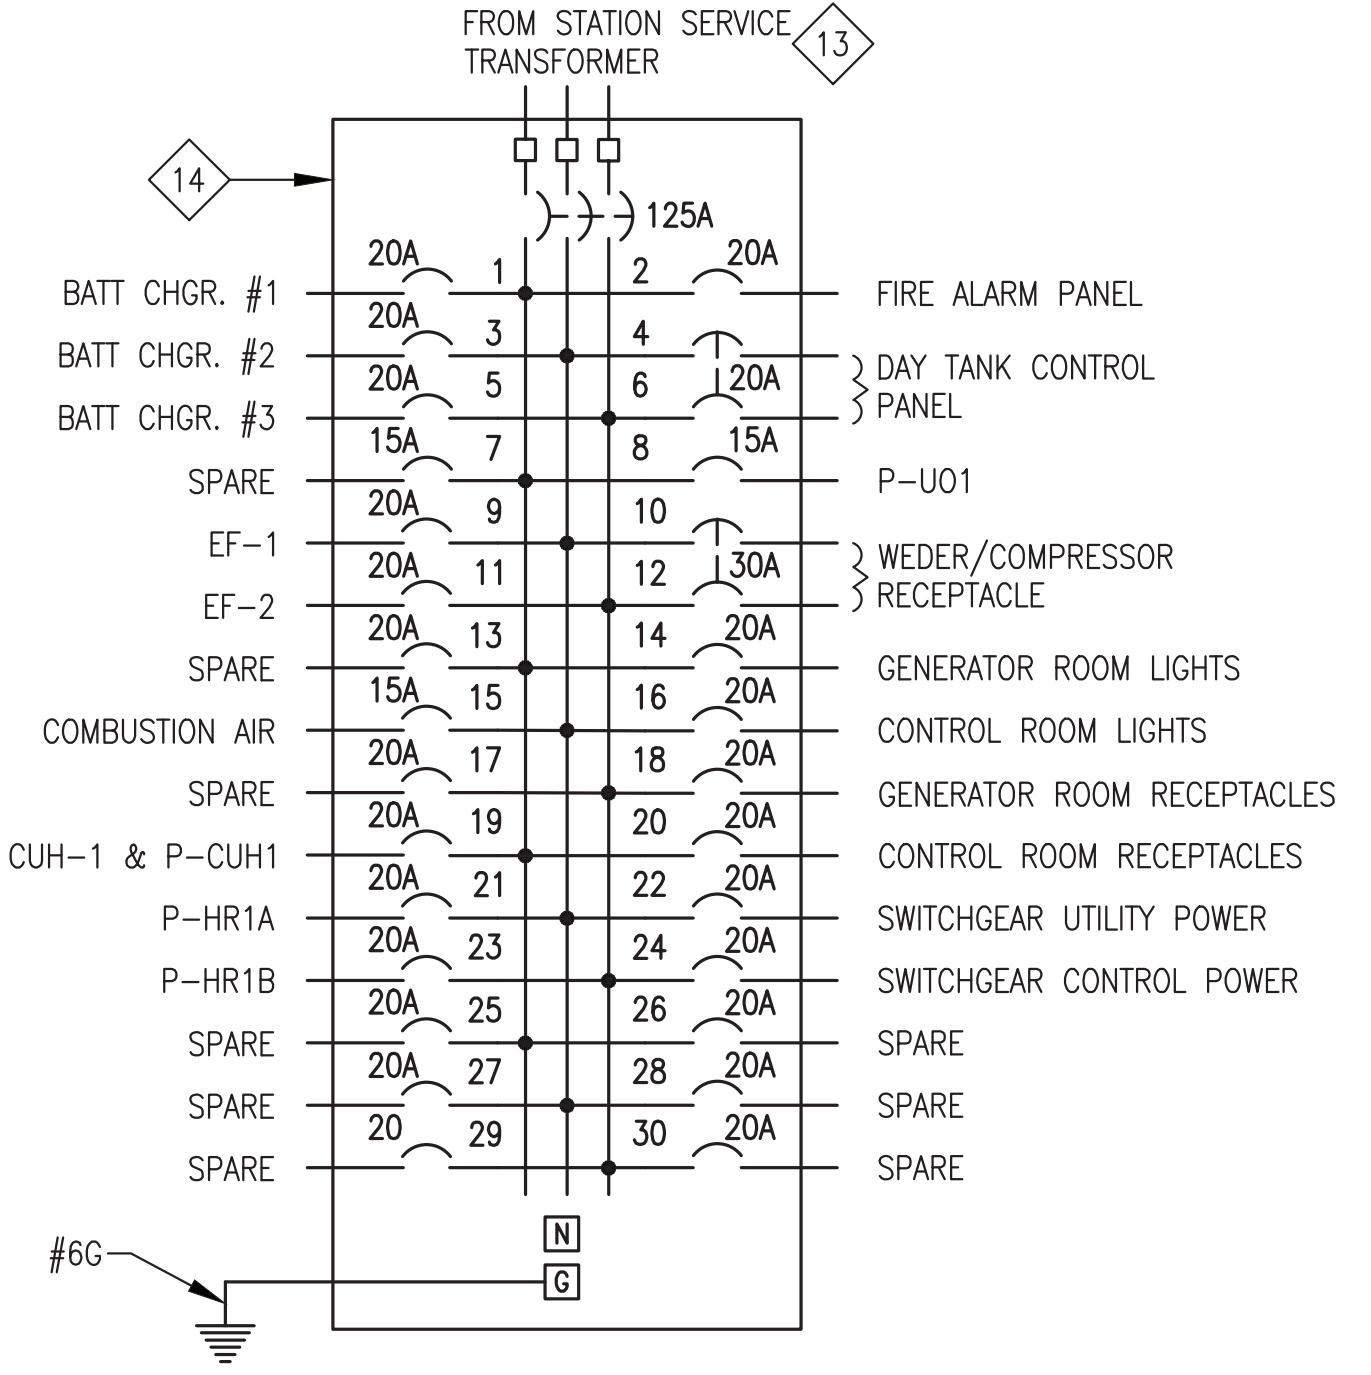

**2** STATION SERVICE PANEL "SS"  
E4.2 NO SCALE

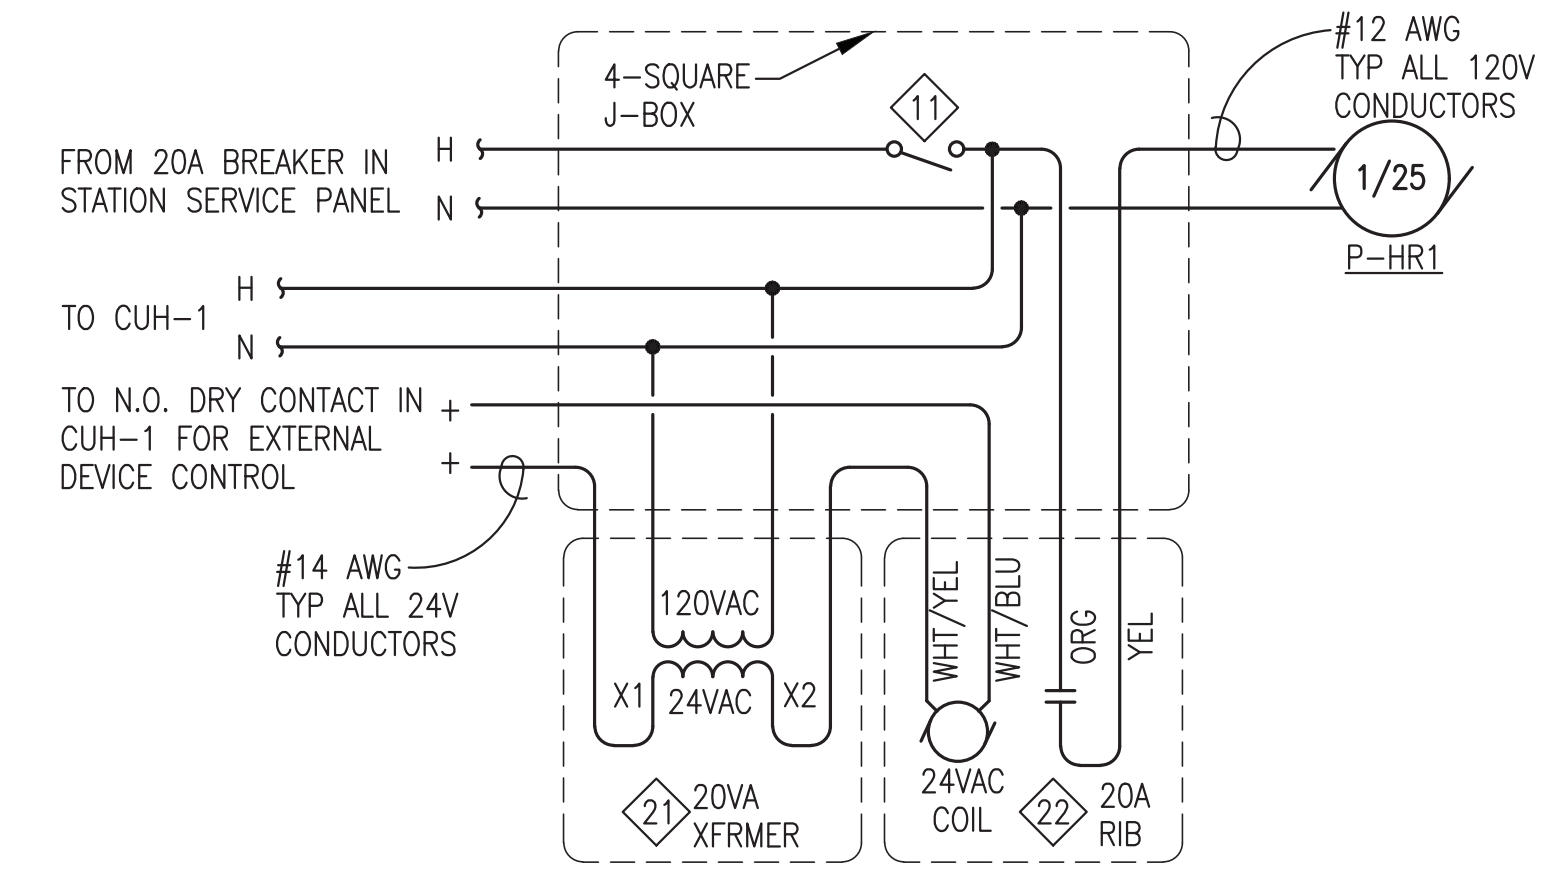


**4** CUH-1 WIRING DIAGRAM  
E4.2 NO SCALE

ALL WORK ON THIS SHEET WAS PERFORMED AS PART OF THE PRIOR MODULE ASSEMBLY CONTRACT EXCEPT AS SPECIFICALLY INDICATED IN THE SHOP/ON SITE NOTES.

1	DELETED FLOW METER & ADDED CAT5e FROM PUMP P-HR1B	8/15/23	BCG
REV.	DESCRIPTION	DATE	BY
PROJECT: NELSON LAGOON POWER SYSTEM UPGRADE			
TITLE: STATION SERVICE PLAN, DETAILS, & PANELBOARD			
DRAWN BY: JTD		SCALE: AS NOTED	
DESIGNED BY: CWV/BCG		DATE: 5/30/23	
FILE NAME: NELS PP E2-E5		SHEET: E4.2	
PROJECT NUMBER:			

REV#1  
ISSUED FOR  
CONSTRUCTION  
AUGUST 2023

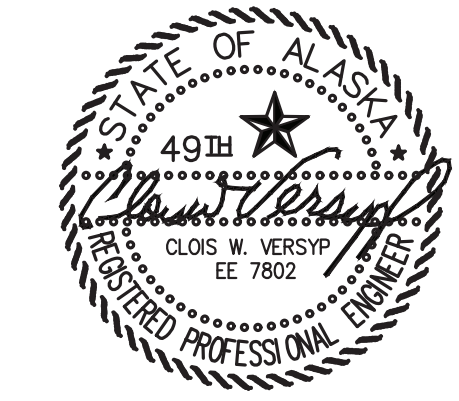


**INSTRUMENTATION & DATA PLAN NOTES:**


- RTD TEMPERATURE SENSOR PROVIDED WITH SWITCHGEAR. ROUTE #18 SHIELDED PAIR TO SWITCHGEAR MASTER SECTION. SEE DETAIL 3/E5 AND NOTE 10.
- INSTALL DSL MODEM AND INTERNET ROUTER ON TOP OF MASTER SECTION IN RACK OR CABINET. CONNECT MODEM TO ROUTER AND TO TELEPHONE LINE. CONNECT ROUTER TO ETHERNET SWITCH INSIDE MASTER SECTION. CONNECT BOTH TO 120VAC UPS. SEE NOTE 10 AND SHOP/ON SITE NOTES 1 AND 2.
- LOW COOLANT LEVEL ALARM SWITCH INSTALLED AT EXPANSION TANK, SEE MECHANICAL. CONNECT TO N.C. SWITCH (WHITE & RED) AND ROUTE 2#14 TO SWITCHGEAR MASTER SECTION. SEE NOTE 10.
- GLYCOL LEVEL SENSOR PROBE INSTALLED IN EXPANSION TANK, SEE MECHANICAL. ROUTE #18 SHIELDED PAIR TO SWITCHGEAR. SEE NOTE 10.
- INSTALL TEMP TRANSMITTER IN EACH RADIATOR, SEE DETAIL 3/E3.3. ROUTE #18 SHIELDED PAIR FROM EACH TO SWITCHGEAR VFD SECTION. SEE ELEVATION 1/E3.3 AND NOTE 10.
- INSTALL COOLANT RETURN TEMP TRANSMITTER IN PIPING MAIN WHERE SHOWN ON COOLING PIPING ISOMETRIC 1/M4.2. ROUTE #18 SHIELDED PAIR TO SWITCHGEAR MASTER SECTION, SEE NOTE 10.
- INSTALL ONE TEMP TRANSMITTER (SUPPLY) AND ONE PRESSURE TRANSMITTER FOR HEAT RECOVERY MONITORING WHERE SHOWN ON HEAT RECOVERY PIPING ISOMETRIC 2/M4.2. ROUTE #18 SHIELDED PAIR FROM EACH TO SWITCHGEAR MASTER SECTION. SEE NOTE 10.
- PUMP P-HR1B HAS INTERNAL MONITORING FOR FLOW RATE AND TEMPERATURE. INSTALL OWNER FURNISHED PUMP CIM CARD AND ROUTE CAT5e TO ETHERNET SWITCH IN MASTER SECTION. INSTALL IN SEPARATE DEDICATED RACEWAY OR WITH OTHER INSTRUMENT CABLES. DO NOT ROUTE WITH STATION SERVICE OR POWER CONDUCTORS.
- ROUTE 2#14 FROM BATTERY CHARGER ALARM CONTACTS TO ASSOCIATED SWITCHGEAR GENERATOR SECTION, SEE NOTE 10 AND WIRING DIAGRAM 2/E5.
- SEE SWITCHGEAR SHOP DRAWINGS FOR TERMINATION OF ALL INSTRUMENTATION AND DATA WIRING INCLUDING CONTROL POWER.
- ROUTE ENGINE-GENERATOR CONTROL CONDUCTORS TO SWITCHGEAR IN 10x10 WIREWAY WITH POWER CONDUCTORS. SEE DETAIL 2/E3.1, SHEET E6.3, AND NOTE 10.
- SEE SHEETS E7.1-E7.4 FOR DAY TANK AND WATER INDICATION CONTROL PANEL DESIGN AND WIRING TERMINATIONS. ALL ACCESSORIES NOT SHOWN ON PLANS. SEE LOGIC DIAGRAMS FOR ADDITIONAL DETAIL.
- ROUTE CAT5e CONDUCTORS FROM DAY TANK PANEL REMOTE I/O AND TANK LEVEL MONITOR TO ETHERNET SWITCH IN SWITCHGEAR MASTER SECTION. INSTALL IN SEPARATE DEDICATED RACEWAY. DO NOT ROUTE WITH STATION SERVICE OR POWER CONDUCTORS.
- ROUTE CAT5e FOR DATA AND 2#14 FOR GENERATOR SHUT DOWN FROM FIRE PANEL TO SWITCHGEAR MASTER SECTION, SEE SHEET FS1 AND NOTE 10. INSTALL IN SEPARATE DEDICATED RACEWAY, COLOR RED. DO NOT ROUTE WITH STATION SERVICE OR POWER CONDUCTORS.
- ROUTE CAT5e FROM RJ-45 JACK TO ETHERNET SWITCH IN MASTER SECTION. INSTALL IN SEPARATE DEDICATED RACEWAY. DO NOT ROUTE WITH STATION SERVICE OR POWER CONDUCTORS.

**INSTRUMENTATION SHOP/ON-SITE NOTES:**

- AS PART OF SHOP FABRICATION INSTALL ETHERNET SWITCH IN MASTER SECTION.
- AS PART OF ON-SITE WORK INSTALL STARLINK MODEM WITH ETHERNET ADAPTER IN BOTTOM OF MASTER SECTION. CONNECT MODEM TO ETHERNET SWITCH AND TO 120VAC UPS INSIDE MASTER SECTION. SEE NOTE 10.
- AS PART OF SHOP FABRICATION INSTALL WALL PENETRATION AND CONDUIT INTO DAY TANK PANEL. SEE ELEVATION 5/E3.2.
- AS PART OF ON-SITE WORK INSTALL CONDUIT AND CONDUCTORS TO INTERMEDIATE TANK, SEE SHEET E1.6.

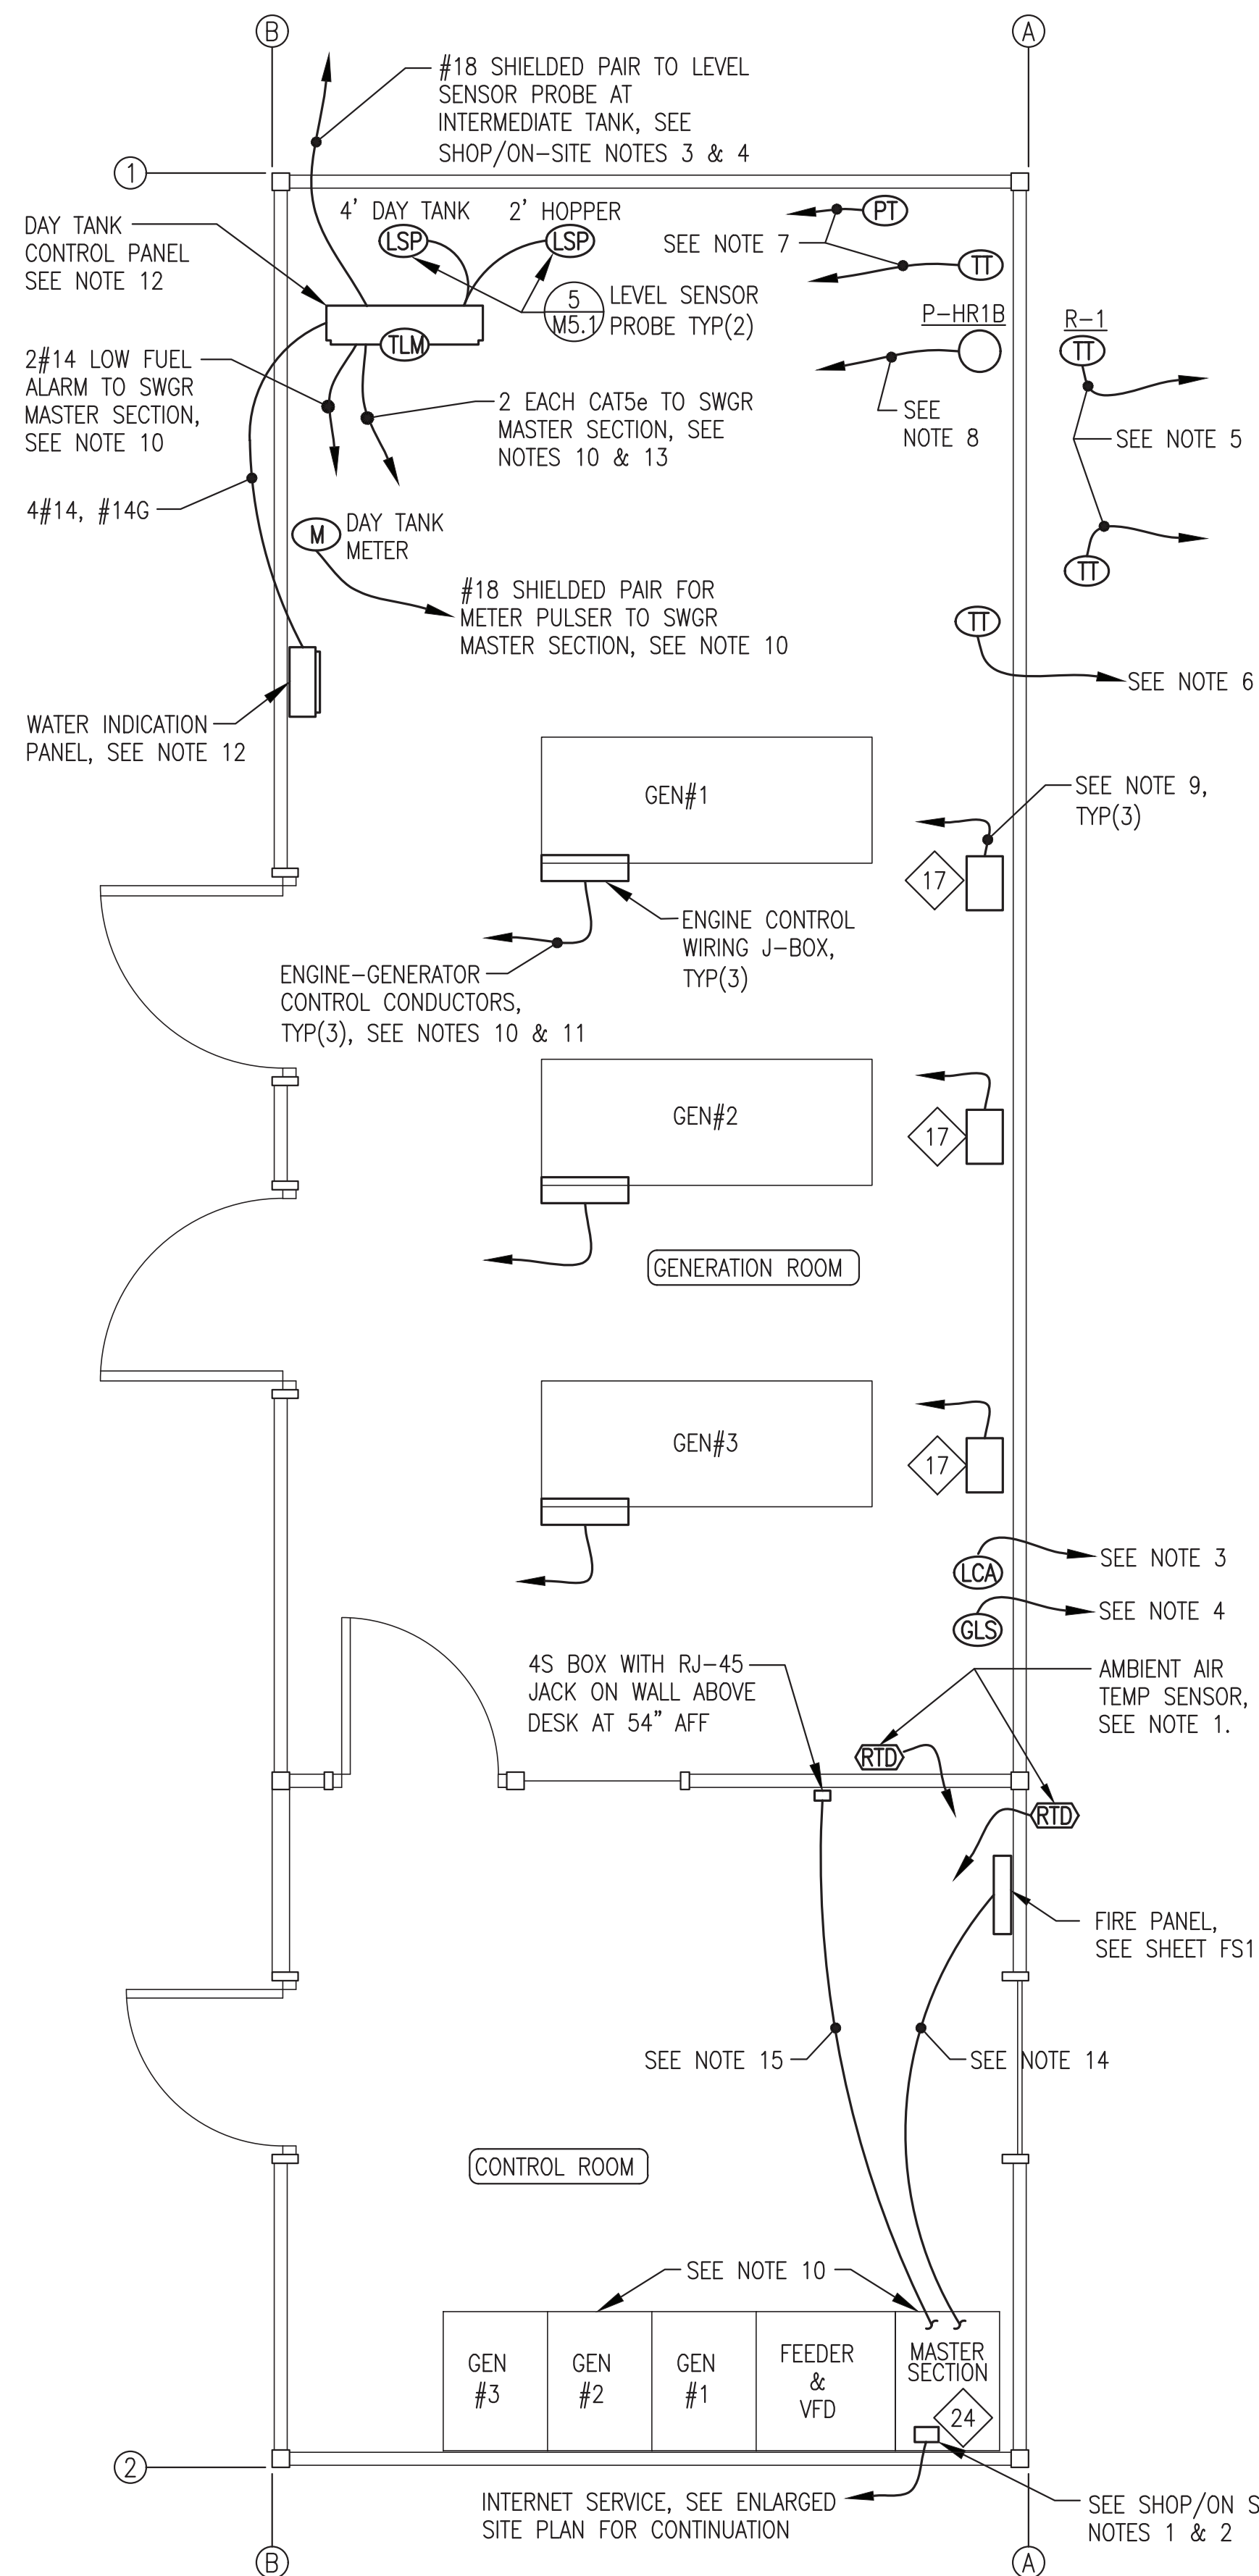


**1 INSTRUMENTATION & DATA PLAN**  
E5 3/8"=1'-0"

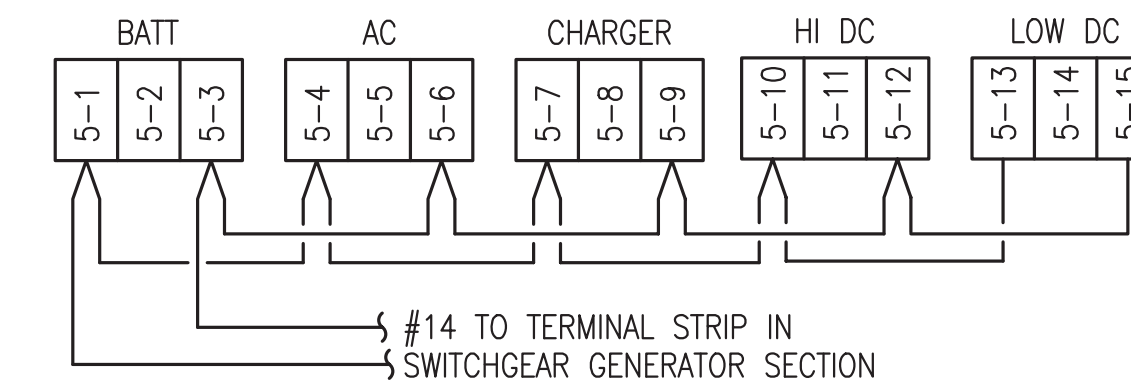

NOTE: PRIOR TO ENERGIZING MAKE THE FOLLOWING SETTINGS ON CHARGER:  
 1) AC LINE VOLTAGE SWITCH TO "115V".  
 2) AUTO BOOST JUMPER TO "NORM".  
 3) FLOAT VOLTAGE JUMPER TO "13.50/27.00" (FOR GEL CELL).  
 4) BATTERY RANGE JUMPER TO "24V".

**2 BATTERY CHARGER ALARM WIRING DIAGRAM**  
E5 NO SCALE

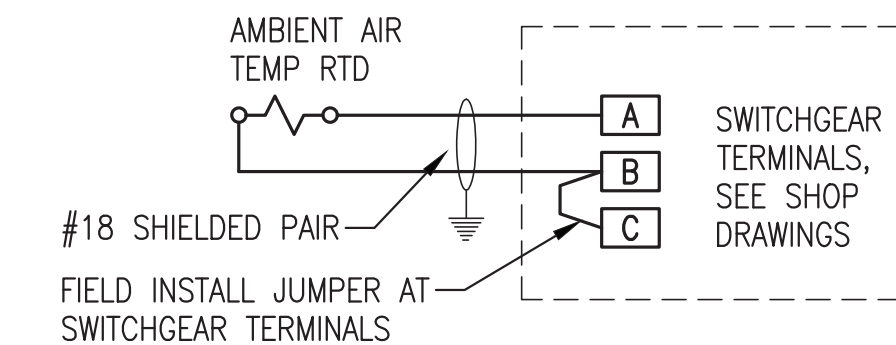

**3 AMBIENT AIR TEMP RTD TERMINATION**  
E5 NO SCALE

ALL WORK ON THIS SHEET WAS PERFORMED AS PART OF THE PRIOR MODULE ASSEMBLY CONTRACT EXCEPT AS SPECIFICALLY INDICATED IN THE SHOP/ON SITE NOTES.

2	CHANGED INTERNET SERVICE TO STARLINK	11/13/23	BCG
1	DELETED FLOW METER & HRR, ADDED CAT5e FROM PUMP P-HR1B, SEE NOTES 7 & 8	8/15/23	BCG
REV.	DESCRIPTION	DATE	BY



PROJECT:	NELSON LAGOON POWER SYSTEM UPGRADE		
TITLE:	INSTRUMENTATION & DATA PLAN & DETAILS		

REV#1  
ISSUED FOR  
CONSTRUCTION  
NOV 2023



Gray Stassel Engineering, Inc.	DRAWN BY: JTD	SCALE: AS NOTED
P.O. 111405, Anchorage, AK 99511 (907)349-0100	DESIGNED BY: CWV/BCG	DATE: 5/30/23
	FILE NAME: NELS_PP_E2-E5	SHEET: E5
	PROJECT NUMBER:	

Demand Control Table (PLC)				
Demand Control	Generator(s) On Line	On-line kW (Overload)	Level Increase	Level Decrease
Level 1	#3	65	55	---
Level 2	#1 or #2	100	90	45
Level 3	#3 & #1 or #2	165	145	80
Level 4	All	265	---	125


Note : Gen #1 & #2 are equal capacity. Manually select lead unit.

Engine-Generator Alarm Settings (Easygen - EZGN)			
Function	Normal Range	Alarm	Shut Down
Overspeed	1795-1805	----	1900 RPM
Oil Pressure	30-50 PSI	14.5 PSI	10 PSI
Air Filter Vacuum	1-10" H2O	15" H2O	20" H2O
Coolant Temp.	180-200°F	210°F	215°F
Exhaust Temp.	500-850°F	900°F	----
Under Frequency	59.5-60.5 Hz	----	58.2 Hz
Over Frequency	59.5-60.5 Hz	----	61.8 Hz
Under Voltage	470-490 V	----	432 V
Over Voltage	470-490 V	----	528 V
Reverse Power	0	----	10%


Generator Breaker Settings (Easygen - EZGN)	
Function	Setting
Gen #1 Breaker Trip Setpoint (EZGN Rated Current)	200 A
Gen #2 Breaker Trip Setpoint (EZGN Rated Current)	200 A
Gen #3 Breaker Trip Setpoint (EZGN Rated Current)	150 A
Gen Breaker Level 1 (100%) Time Over Current	3 sec.
Gen Breaker Level 2 (120%) Time Over Current	1 sec.
Gen Breaker Level 3 (250%) Time Over Current	0.4 sec.

Feeder Breaker Settings (Feeder Protection Relay - FPR)	
Function (Note: Element 1 is the only active element)	Setting
T.O.C. Trip Pickup (amps) Note: 5A = 100% of CT rating	5.0
T.O.C. Curve Selection	U4
T.O.C. Time Dial	5.00
E.M Reset delay (Y/N)	N
Constant Time Adder (seconds)	0.00
Minimum Response Time (seconds)	0.00
Maximum Phase T.O.C. Torque Control	1


Radiator VFD Settings	
Function	Setting
Min PID Feedback	20
Max PID Feedback	240
rSL (Wake UP Threshold)	1
PID Reference Temperature	175°F
Proportional Gain	0.93
Integral Gain	0.3
Derivative	0
Minimum Speed	10 Hz.
Low Speed Timeout	10 sec.
Loss of Phase	Ignore

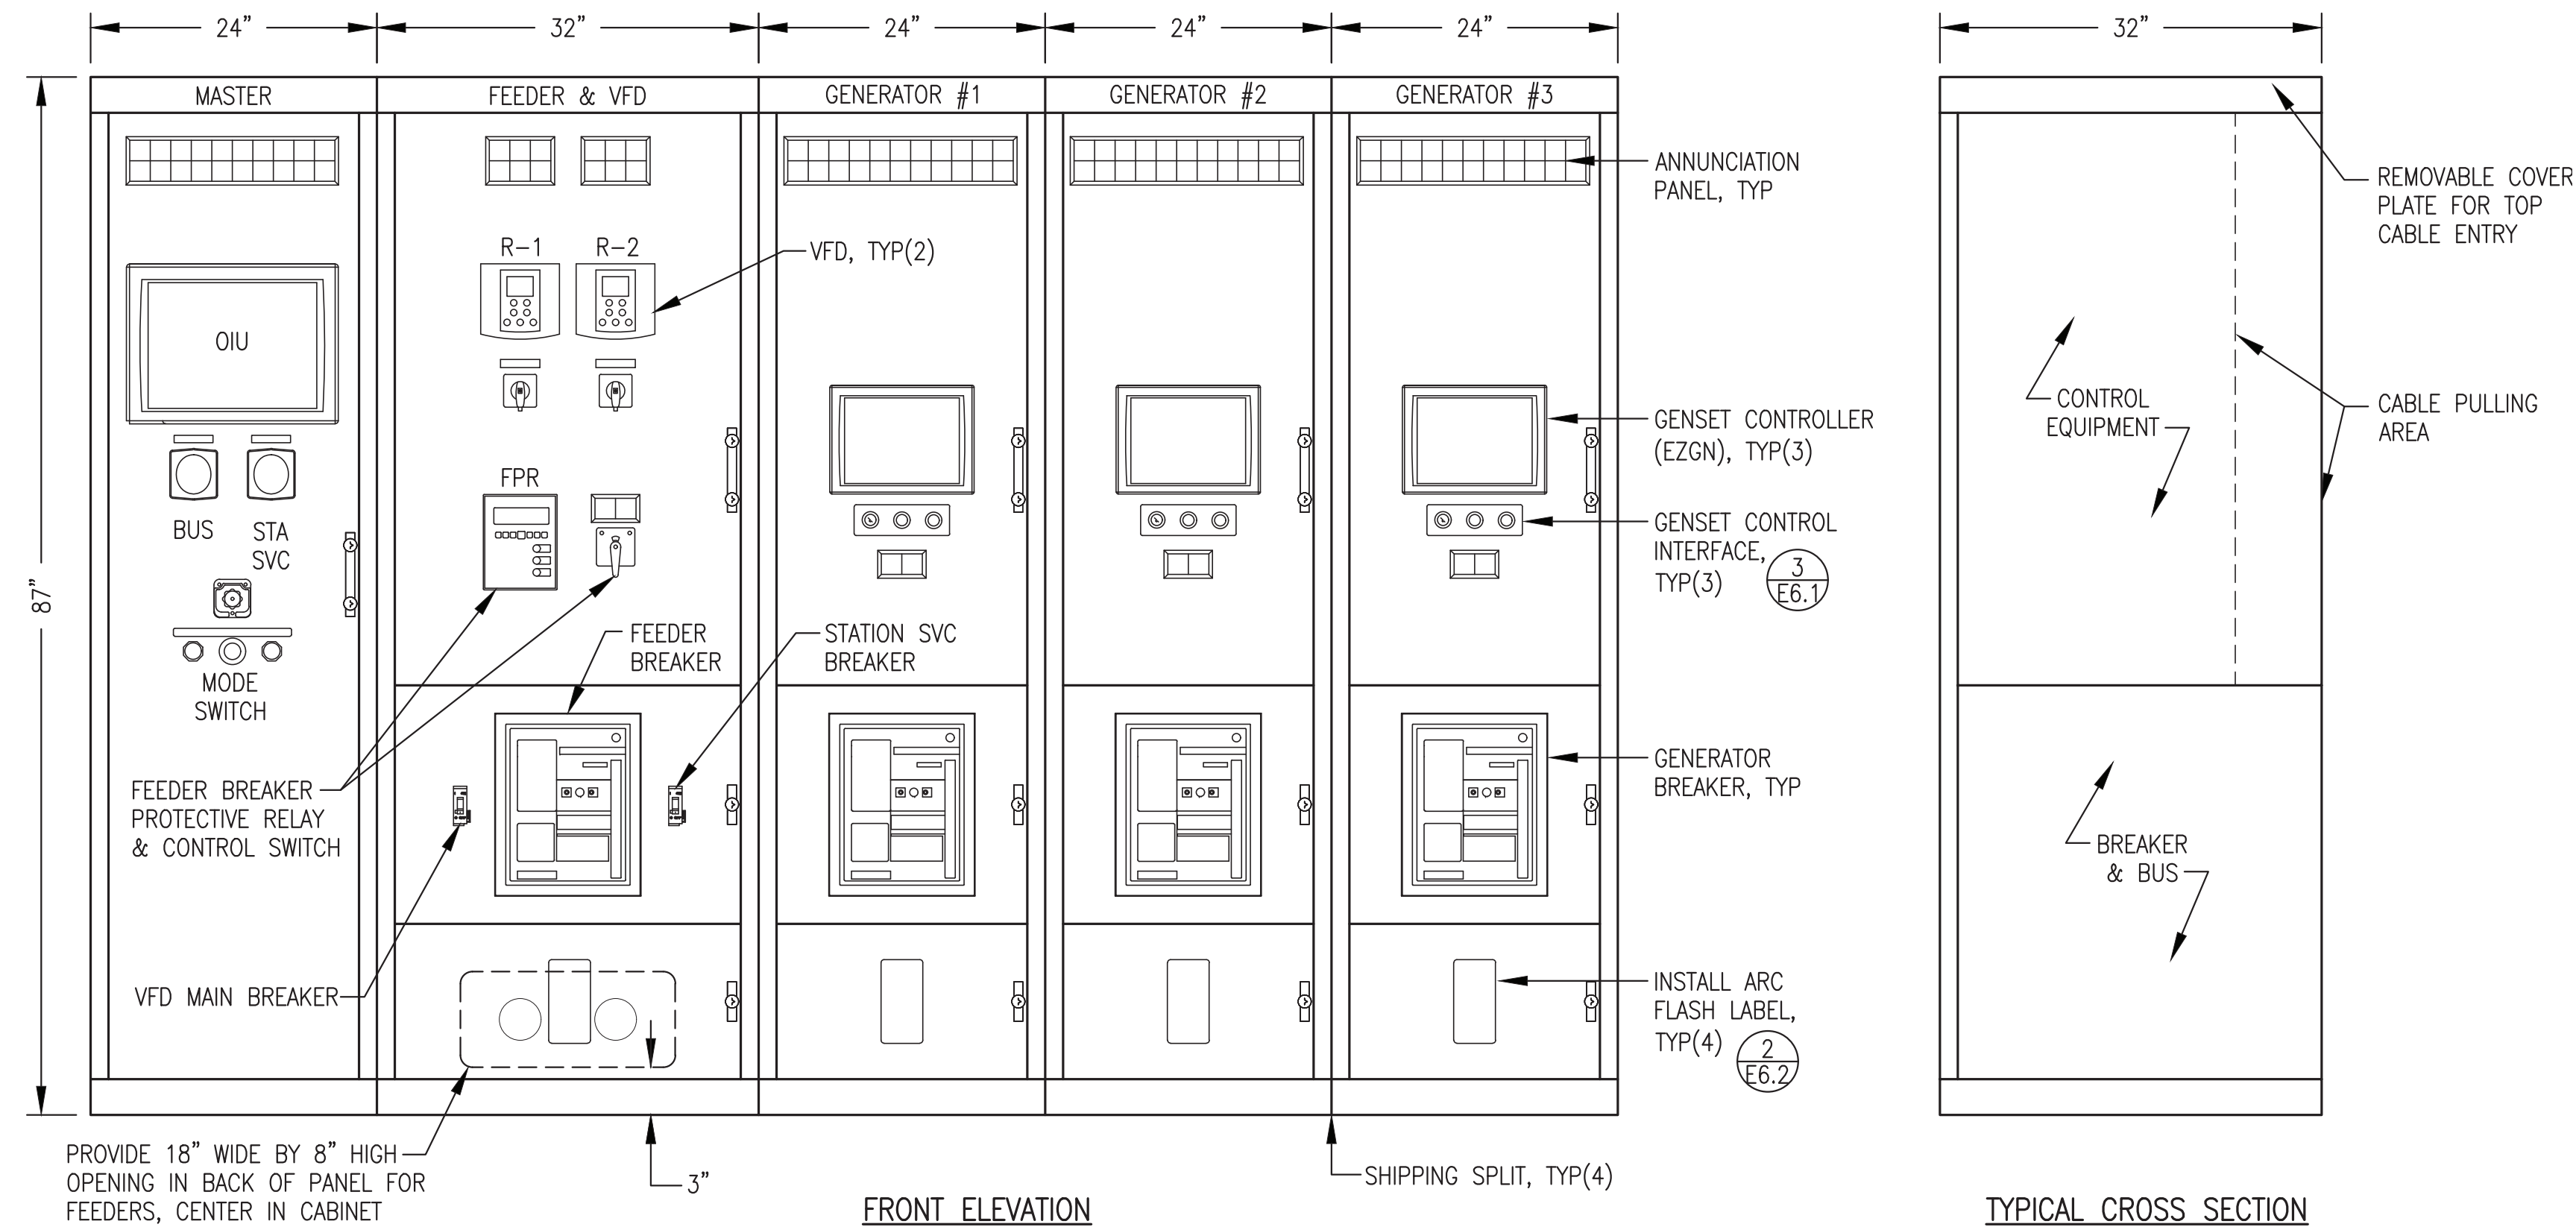

1 SWITCHGEAR ENCLOSURE LAYOUT  
E6.1 NO SCALE

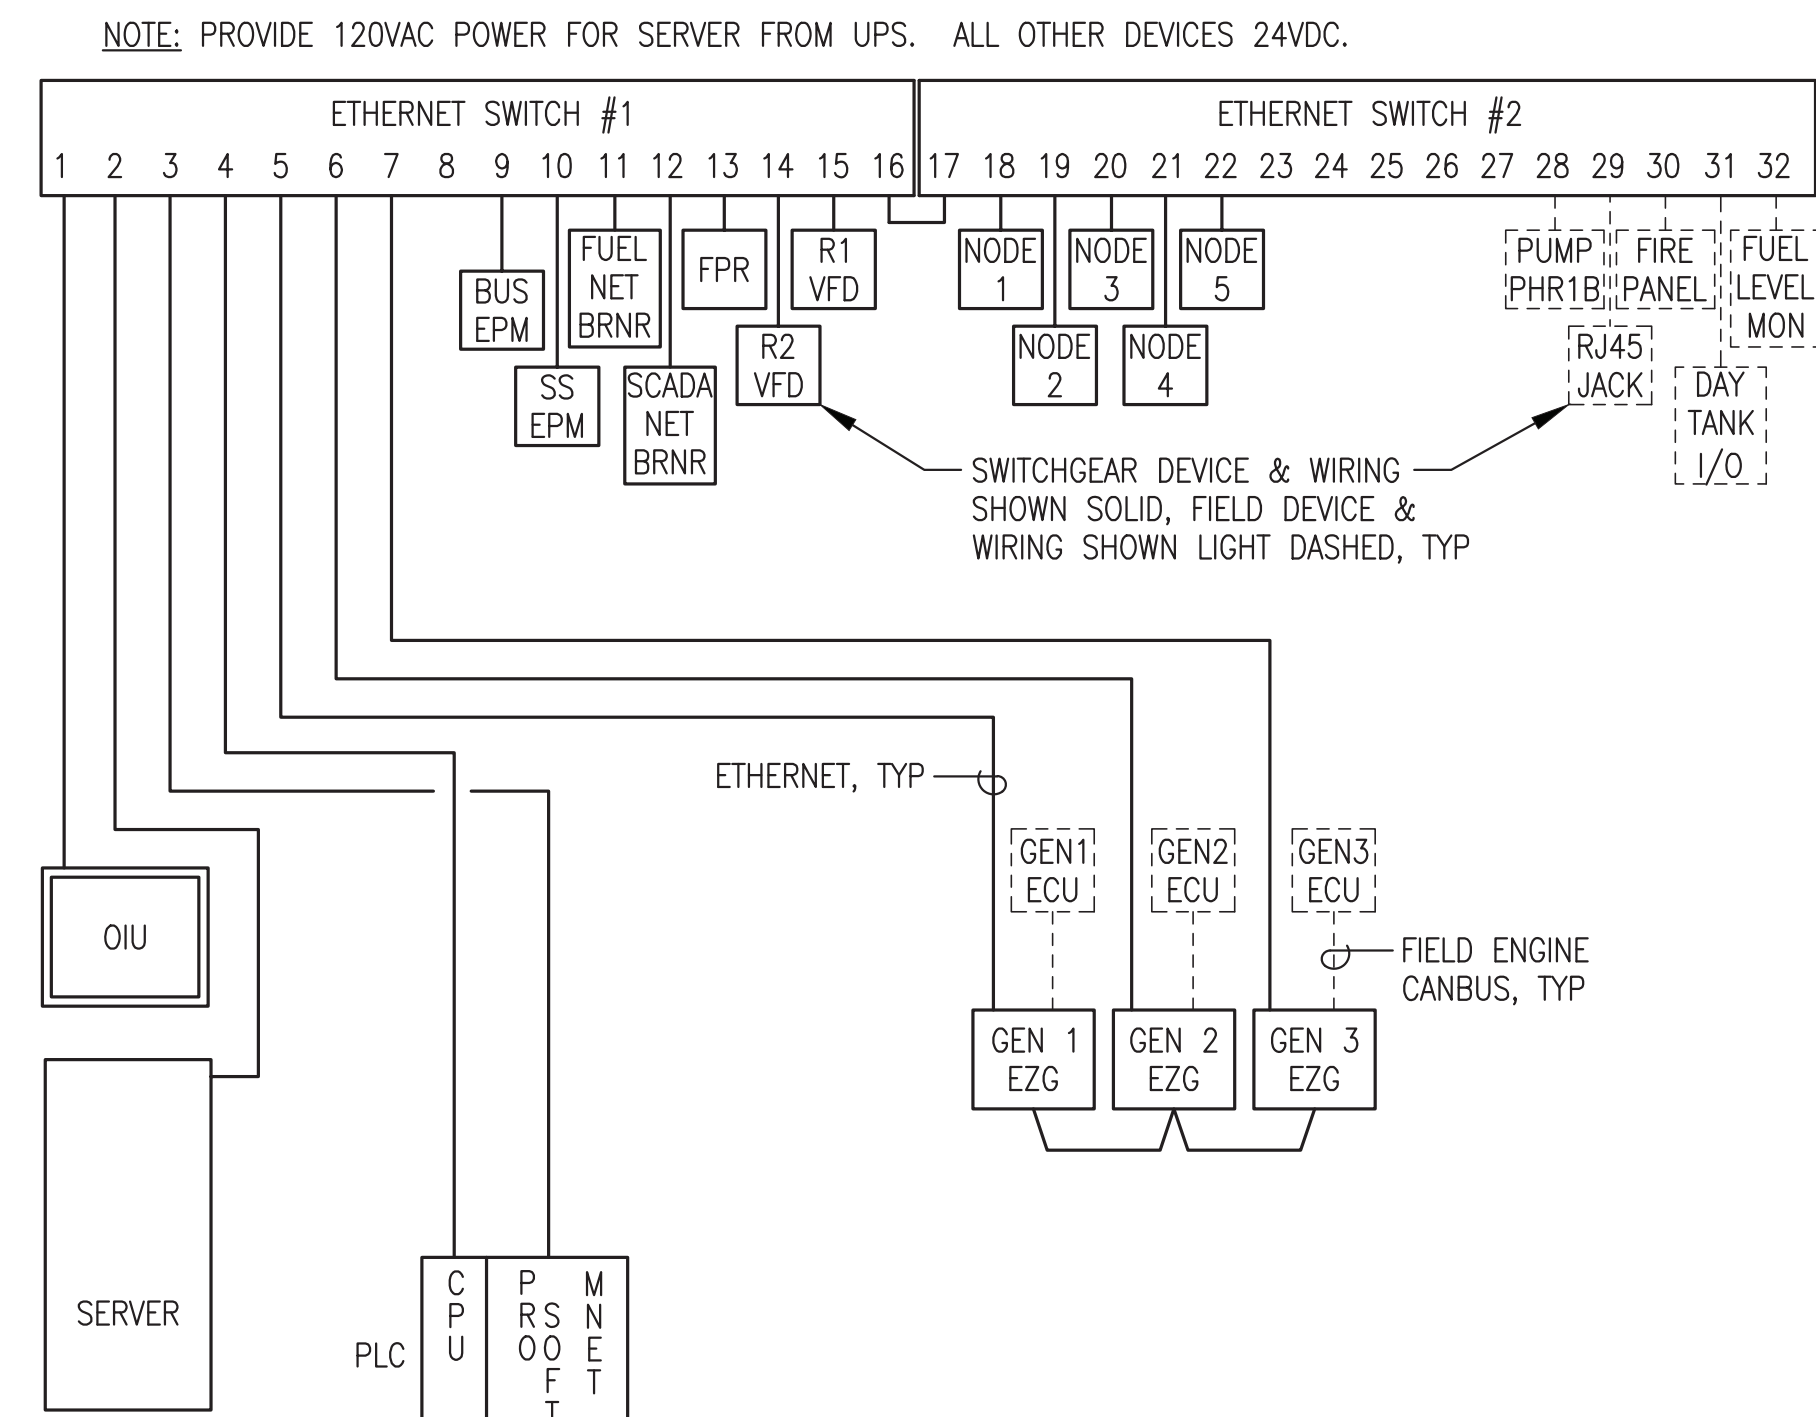

2 COMMUNICATION SCHEMATIC  
E6.1 NO SCALE

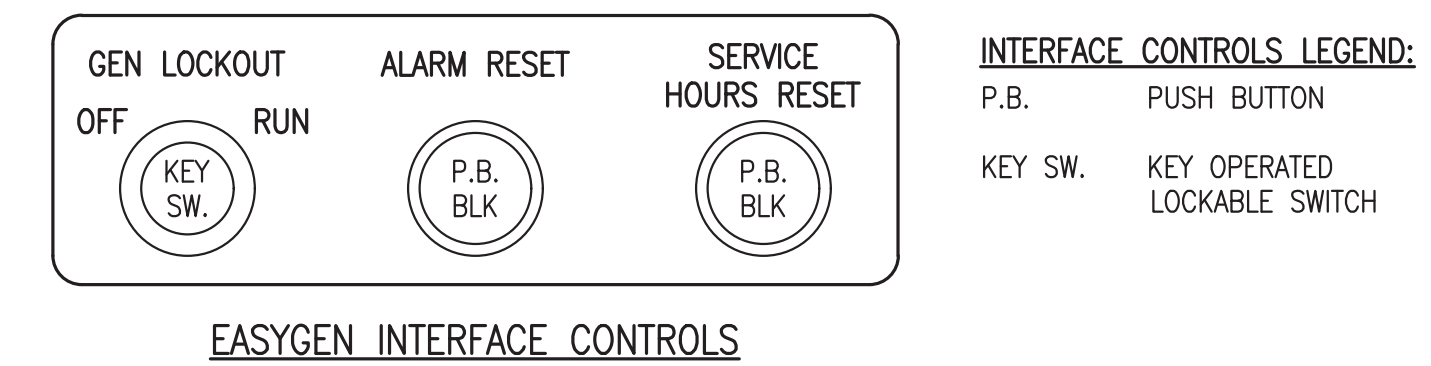

3 GENSET CONTROL (EZGN) INTERFACE CONTROLS  
E6.1 NO SCALE

ALL WORK ON THIS SHEET WAS PERFORMED AS PART OF THE PRIOR MODULE ASSEMBLY CONTRACT AND IS SHOWN HERE FOR REFERENCE ONLY.

REV.	DESCRIPTION	DATE	BY
1	CHANGED COMM SCHEMATIC TO MATCH SWITCHGEAR SHOP DRAWINGS & ADDED P-HR1B	8/15/23	BCG

PROJECT: NELSON LAGOON POWER SYSTEM UPGRADE

TITLE: SWITCHGEAR ENCLOSURE LAYOUT, SETTING TABLE, & DETAILS


ALASKA ENERGY AUTHORITY


Gray Stassel Engineering, Inc.  
P.O. 111405, Anchorage, AK 99511 (907)349-0100

DRAWN BY: JTD  
DESIGNED BY: CWV/BCG  
FILE NAME: NELS PP E6  
PROJECT NUMBER:

SCALE: NO SCALE  
DATE: 4/10/23  
SHEET: E6.1

REV#1  
ISSUED FOR  
CONSTRUCTION  
AUGUST 2023

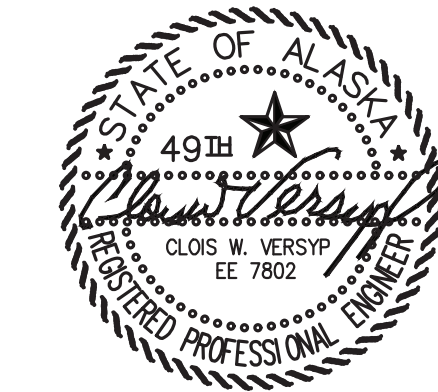

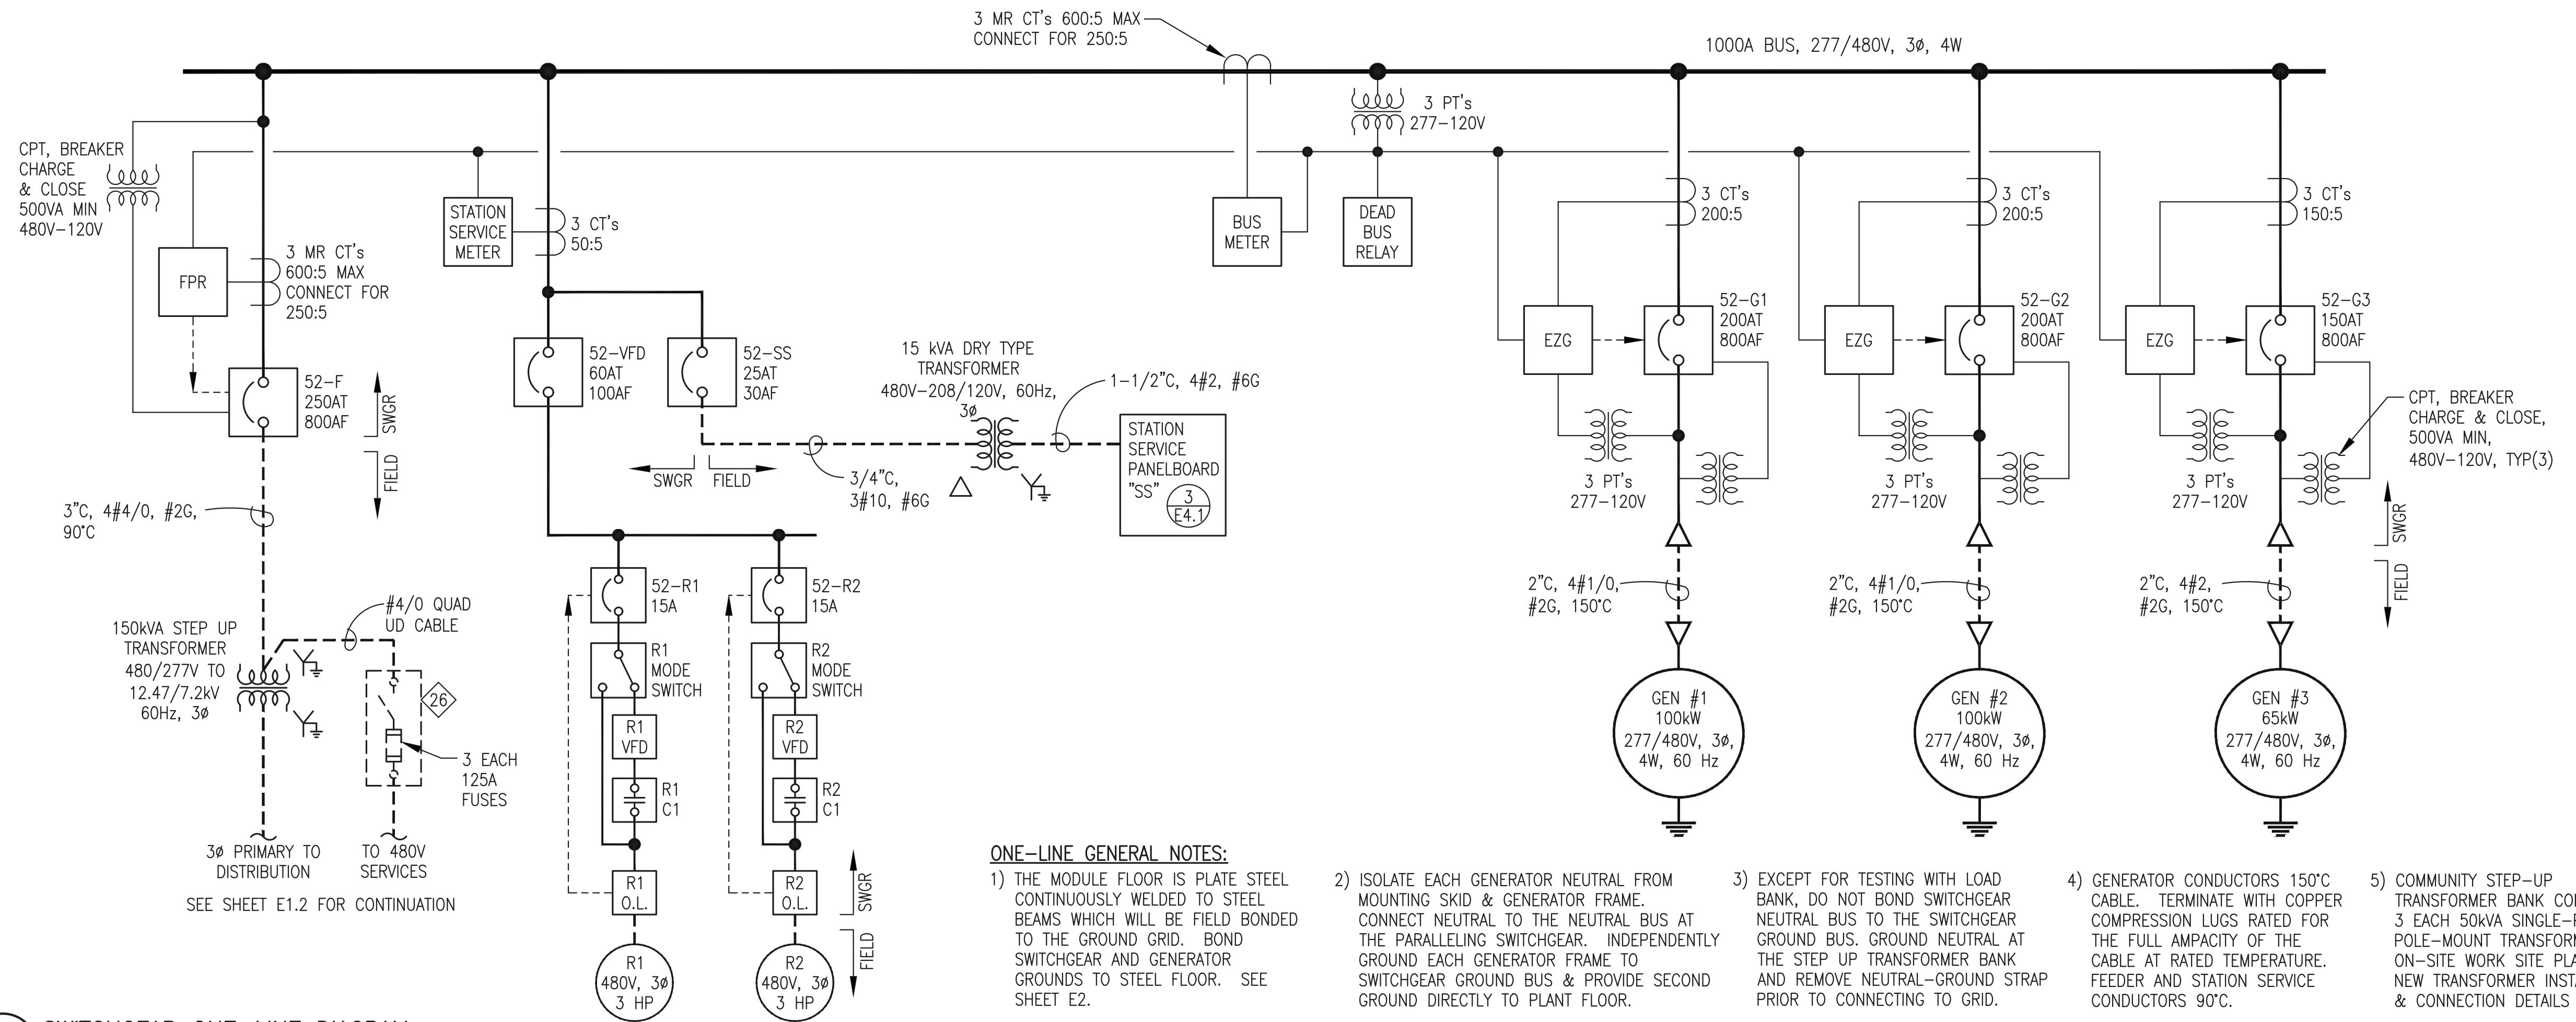

SWITCHGEAR SYMBOL LEGEND	
	TRANSFORMER PT=POTENTIAL XFRMR CPT=CONTROL POWER XFRMR
	CURRENT TRANSFORMER M.R. - INDICATES MULTIRATIO CT'S RATING FACTOR RF=2.0
	CIRCUIT BREAKER AT=AMP TRIP RATING AF=AMP FRAME RATING
	WOODWARD EASYPEN GENSET CONTROLLER
	FEEDER PROTECTION RELAY
	SHOP INSTALLED POWER WIRING/BUS
	FIELD INSTALLED POWER WIRING
	SHOP INSTALLED CONTROL WIRING


**ONE-LINE GENERAL NOTES:**

- 1) THE MODULE FLOOR IS PLATE STEEL CONTINUOUSLY WELDED TO STEEL BEAMS WHICH WILL BE FIELD BONDED TO THE GROUND GRID. BOND SWITCHGEAR AND GENERATOR GROUNDS TO STEEL FLOOR. SEE SHEET E2.
- 2) ISOLATE EACH GENERATOR NEUTRAL FROM MOUNTING SKID & GENERATOR FRAME. CONNECT NEUTRAL TO THE NEUTRAL BUS AT THE PARALLELING SWITCHGEAR. INDEPENDENTLY GROUND EACH GENERATOR FRAME TO SWITCHGEAR GROUND BUS & PROVIDE SECOND GROUND DIRECTLY TO PLANT FLOOR.
- 3) EXCEPT FOR TESTING WITH LOAD BANK, DO NOT BOND SWITCHGEAR NEUTRAL BUS TO THE SWITCHGEAR GROUND BUS. GROUND NEUTRAL AT THE STEP UP TRANSFORMER BANK AND REMOVE NEUTRAL-GROUND STRAP PRIOR TO CONNECTING TO GRID.
- 4) GENERATOR CONDUCTORS 150°C CABLE. TERMINATE WITH COPPER COMPRESSION LUGS RATED FOR THE FULL AMPACITY OF THE CABLE AT RATED TEMPERATURE. FEEDER AND STATION SERVICE CONDUCTORS 90°C.
- 5) COMMUNITY STEP-UP TRANSFORMER BANK CONSISTS OF 3 EACH 50KVA SINGLE-PHASE POLE-MOUNT TRANSFORMERS, SEE ON-SITE WORK SITE PLAN FOR NEW TRANSFORMER INSTALLATION & CONNECTION DETAILS

**1 SWITCHGEAR ONE-LINE DIAGRAM**  
E6.2 NO SCALE

- ARC FLASH NOTES:**
- 1) PERMANENTLY AFFIX ARC FLASH LABELS TO EACH SECTION WITH 480V POWER AS INDICATED.
  - 2) SCALED PDF IMAGES OF THESE LABELS WILL BE FURNISHED TO THE FABRICATOR UPON REQUEST.

**2 ARC FLASH LABELS**  
E6.2 NO SCALE

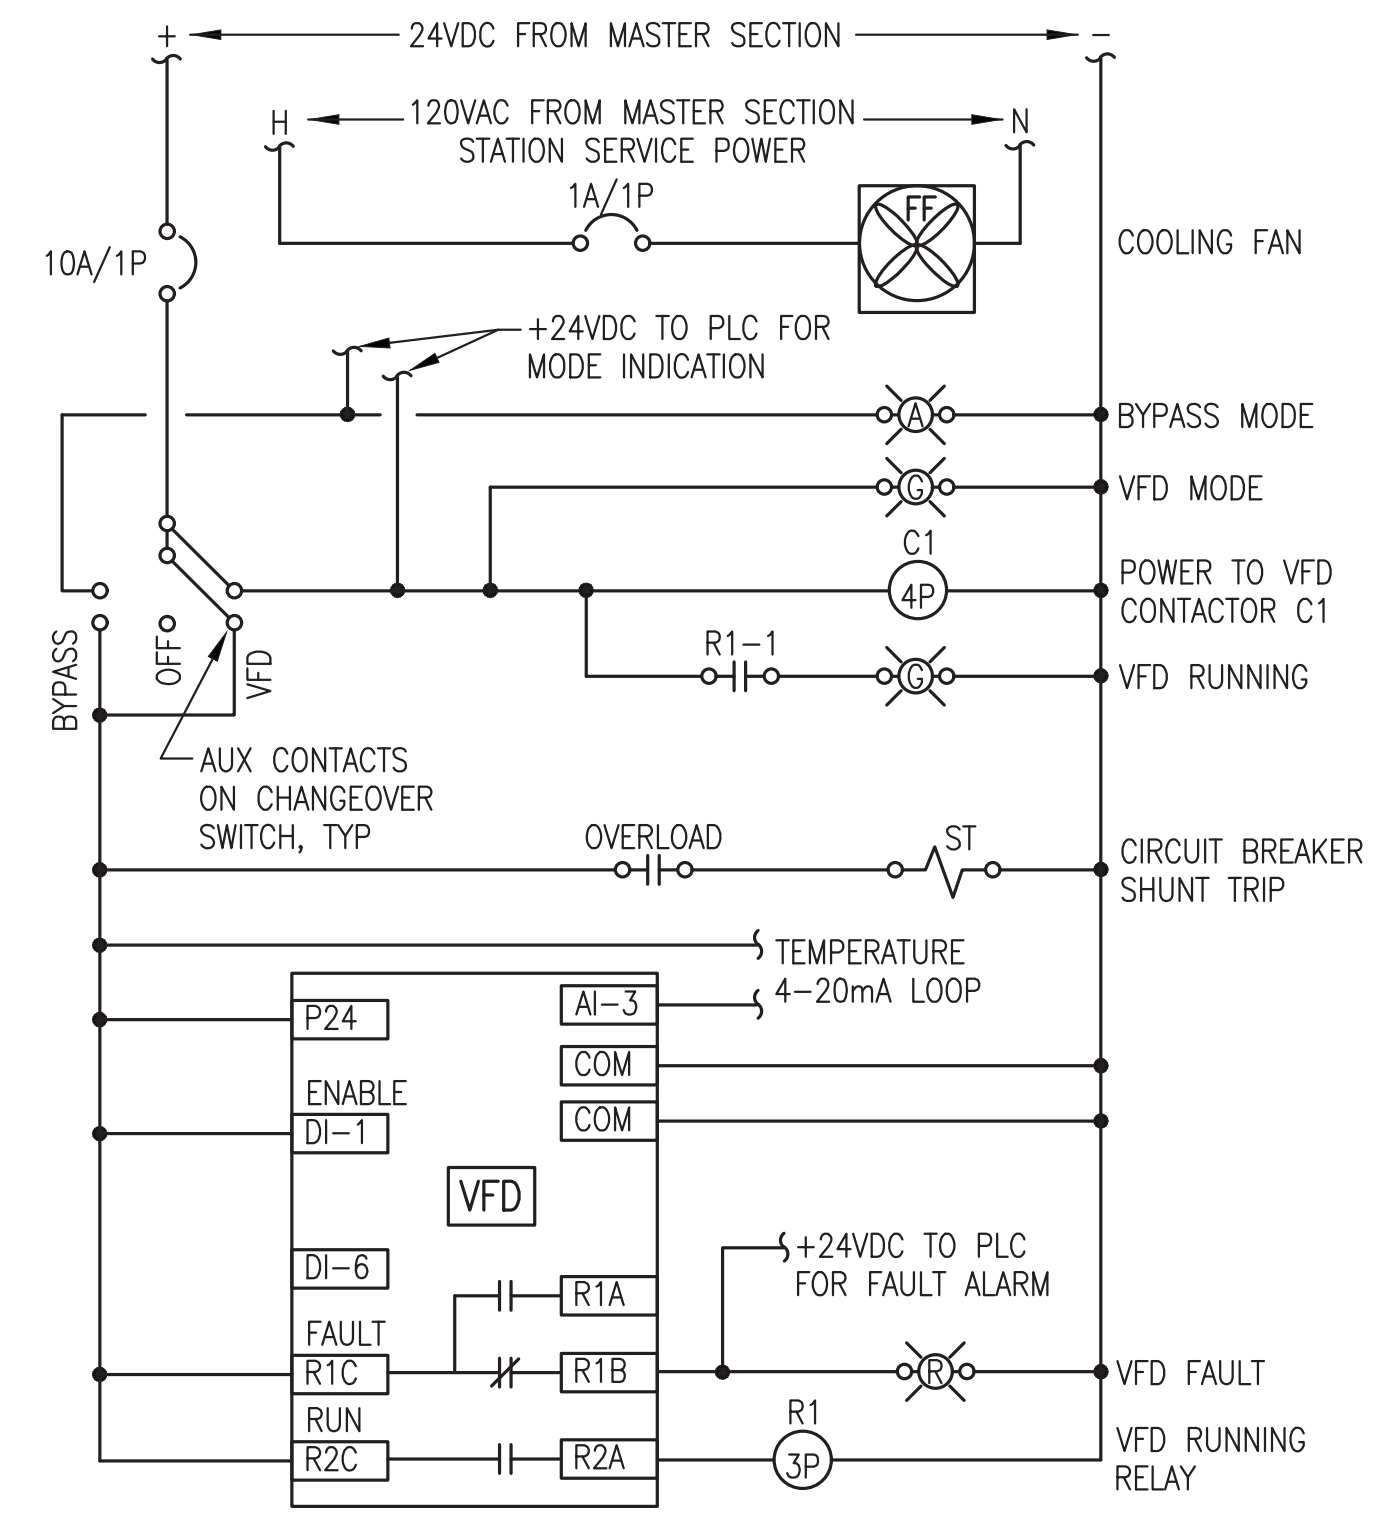


**3 TYPICAL RADIATOR VFD LOGIC DIAGRAM**  
E6.2 NO SCALE

ALL WORK ON THIS SHEET WAS PERFORMED AS PART OF THE PRIOR MODULE ASSEMBLY CONTRACT EXCEPT FOR THE FEEDER AND STEP UP TRANSFORMER WHICH ARE INCLUDED IN THE ON SITE WORK.


1	REVISE VFD TO MATCH SHOP AS BUILT (DELETE ENABLE TIMER)	11/13/23	BCG
REV.	DESCRIPTION	DATE	BY
 ALASKA ENERGY AUTHORITY			
PROJECT: NELSON LAGOON POWER SYSTEM UPGRADE			
TITLE: SWITCHGEAR ONE-LINE & SCHEMATICS			
DRAWN BY: JTD		SCALE: NO SCALE	
DESIGNED BY: CWV/BCG		DATE: 4/10/23	
FILE NAME: NELS_PP_E6		SHEET: E6.2	
PROJECT NUMBER:			

REV#1  
ISSUED FOR  
CONSTRUCTION  
NOV 2023


**Gray Stassel Engineering, Inc.**  
P.O. 111405, Anchorage, AK 99511 (907)349-0100

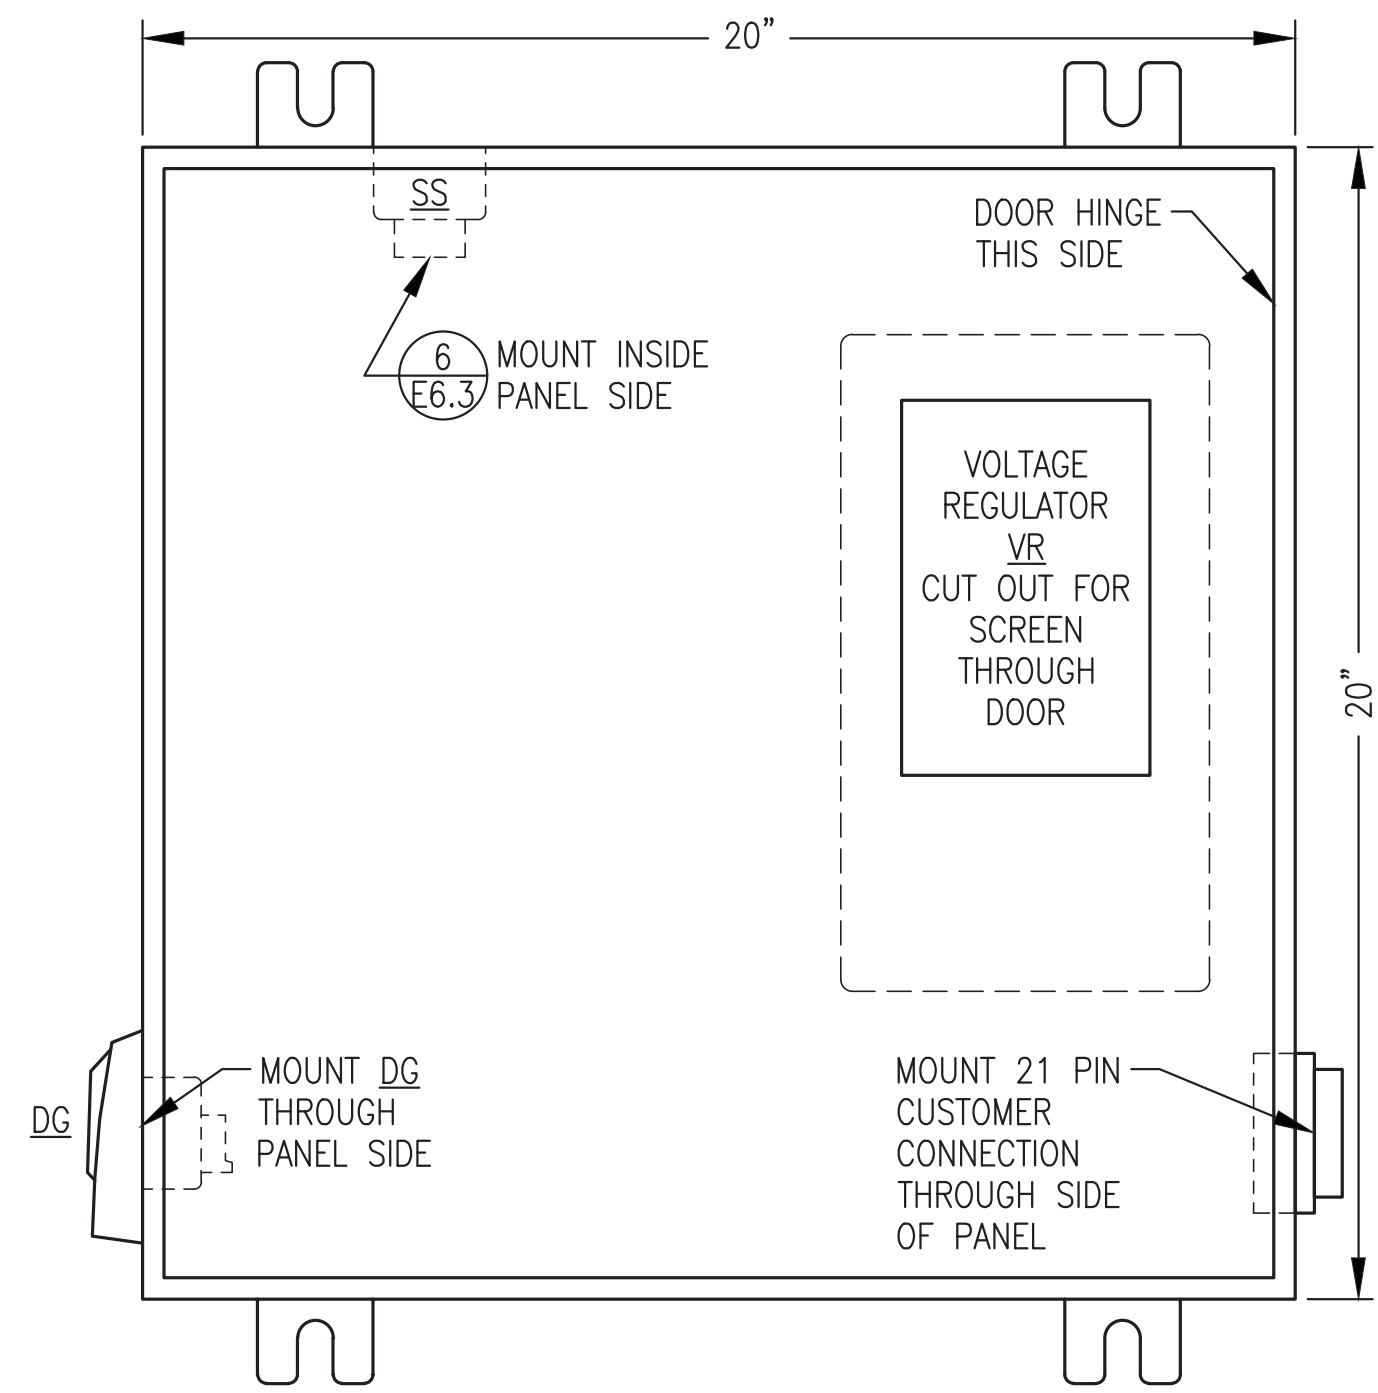


**1** JUNCTION BOX FRONT PANEL LAYOUT  
E6.3 NO SCALE

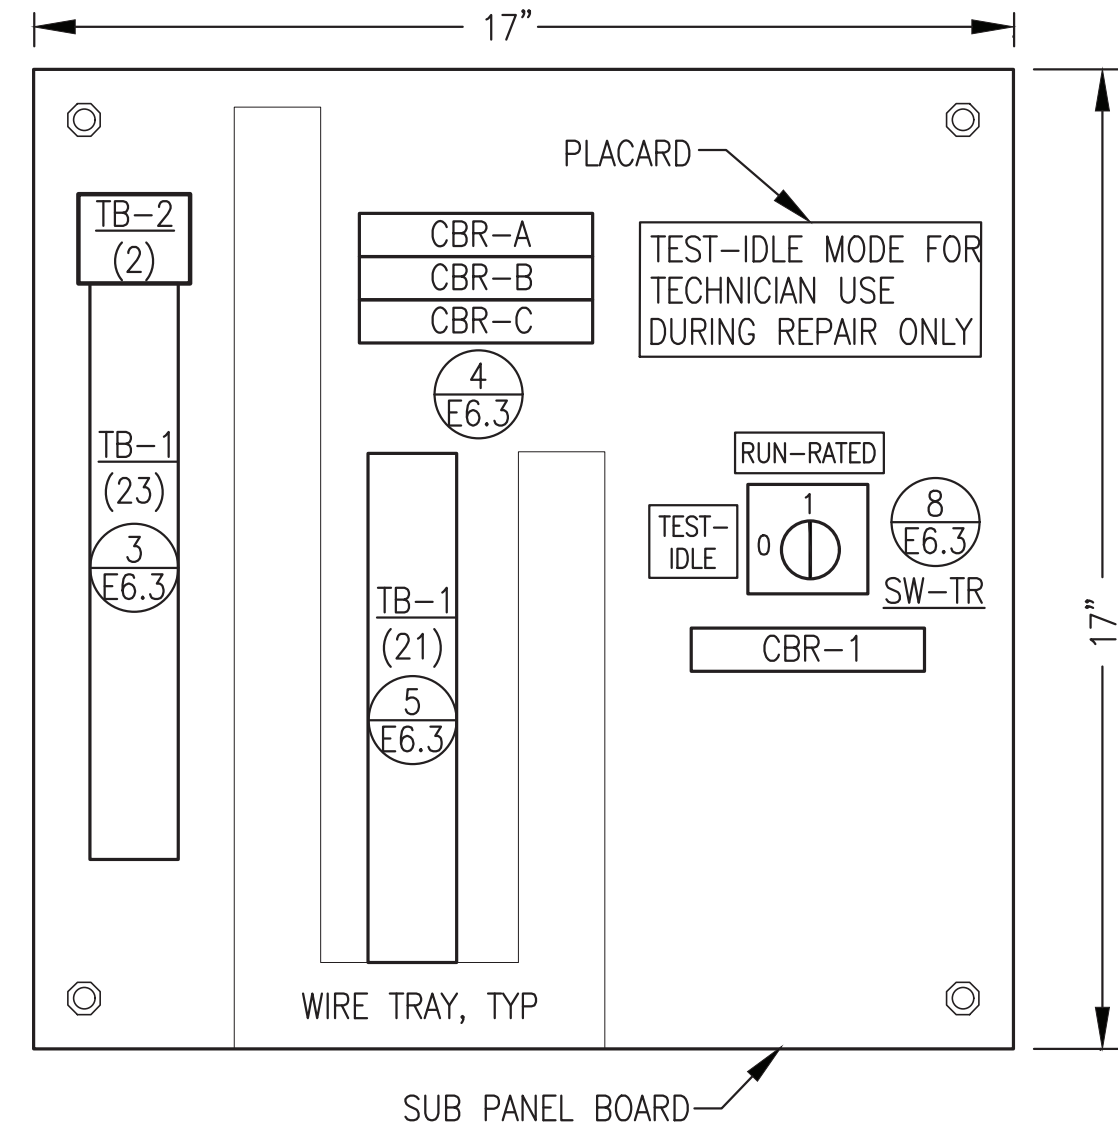


**2** JUNCTION BOX SUB PANEL LAYOUT  
E6.3 NO SCALE

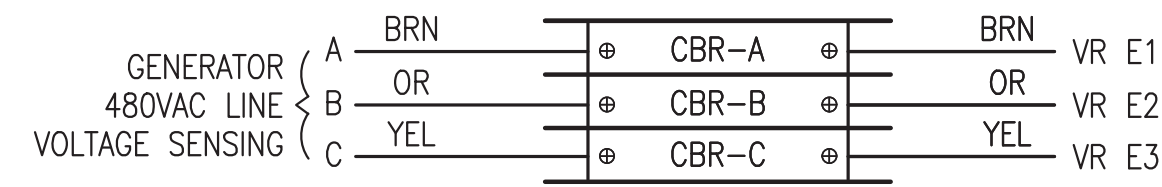

**4** CIRCUIT BREAKER CONNECTIONS  
E6.3 NO SCALE

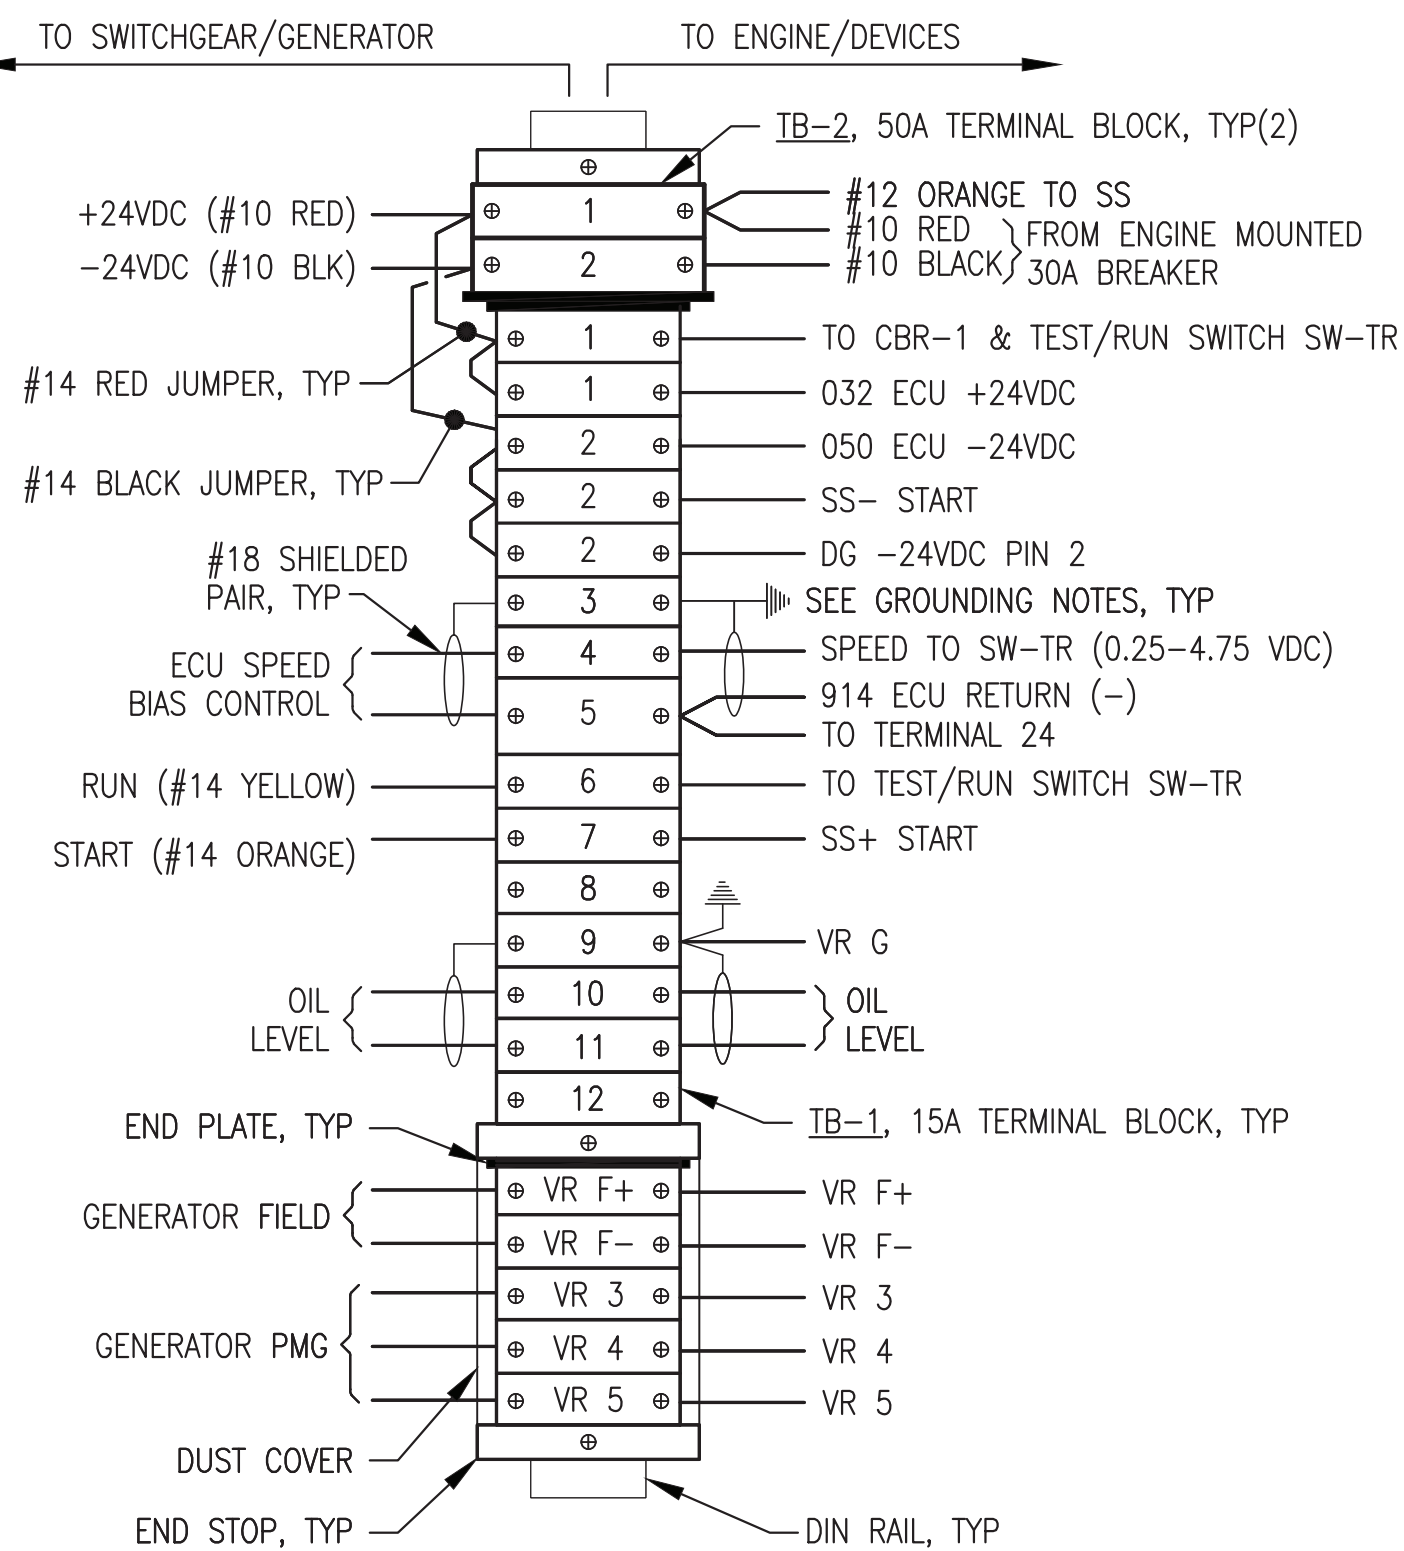

**3** TERMINAL STRIP CONNECTIONS  
E6.3 NO SCALE

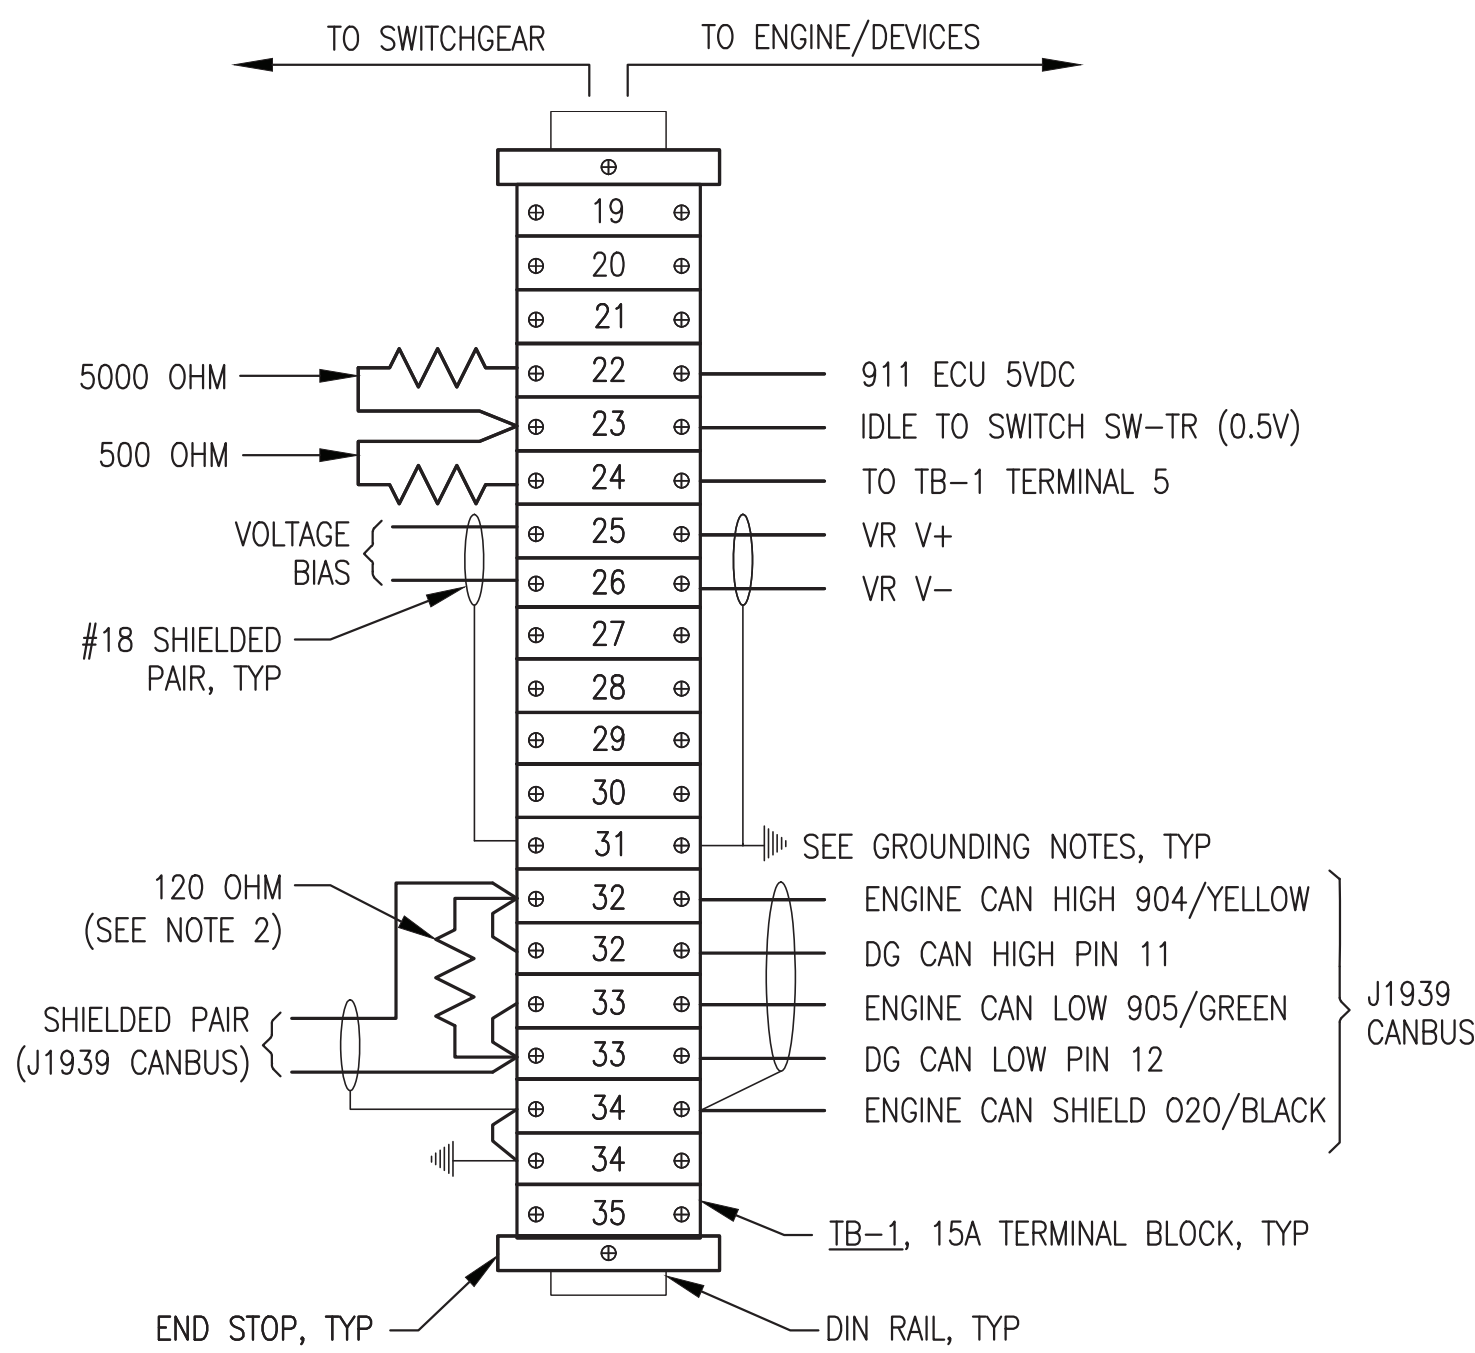

NOTES: 1) ALL RESISTORS 0.25W.  
2) REMOVE RESISTOR IF ENGINE WIRING HARNESS HAS 120 OHM END OF LINE RESISTOR.

**5** TERMINAL STRIP CONNECTIONS  
E6.3 NO SCALE

BILL OF MATERIALS			
TAG	MANUFACTURER	MODEL	DESCRIPTION
21 PIN	JOHN DEERE OR DEUTZ		21 PIN CUSTOMER CONNECTION ASSY
CBR-A/B/C	ALLEN-BRADLEY	1489-M1-C010	RAIL MOUNT CIRCUIT BREAKER, 1P, 1A
CBR-1	ALLEN-BRADLEY	1489-M1-C050	RAIL MOUNT CIRCUIT BREAKER, 1P, 5A
DG	JOHN DEERE	DG-14	DIAGNOSTIC GAUGE WITH HARNESS
			PROGRAMMED FOR MARINE TIER 3 WITH UNIQUE JOHN DEERE FAULT CODE
ENCL.	HOFFMAN	A20H20ALP	20x20x8" NEMA 12
	HOFFMAN	A20P20	BACK PANEL
SS	JOHN DEERE	AT145341	STARTER AUXILIARY SOLENOID, 24V
SW-TR	ALLEN-BRADLEY	194L-A12-225-2	CHANGEOVER SWITCH, 12A, 2P
	ALLEN-BRADLEY	194L-HE-4A-175	90 DEGREE I-O HANDLE
TB-1	IDEC	BNH15LW	15A DIN RAIL-MOUNT TERMINAL BLOCK
TB-2	IDEC	BNH50W	50A DIN RAIL-MOUNT TERMINAL BLOCK
VR	BASLER	DECS-150 5NS1V1N1S	DIGITAL VOLTAGE REGULATOR


BRAND SPECIFIC NOTE: SPECIFIC PARTS MANUFACTURER AND MODEL SELECTED NOT ONLY TO MEET PERFORMANCE FUNCTION BUT ALSO TO COORDINATE AND INTERFACE WITH OTHER DEVICES AND SYSTEMS. APPROVED EQUAL SUBSTITUTIONS WILL BE ALLOWED ONLY BY ENGINEER'S APPROVAL. TO OBTAIN APPROVAL, SUBMITTALS MUST CLEARLY DEMONSTRATE HOW SUBSTITUTE ITEM MEETS OR EXCEEDS SPECIFIED ITEM QUALITY AND PERFORMANCE CHARACTERISTICS AND ALSO COMPLIES WITH MECHANICAL AND/OR ELECTRICAL CONNECTIONS AND PHYSICAL LAYOUT REQUIREMENTS.

**SHOP FABRICATION NOTES:**


- 1) PROVIDE ASSEMBLY WITH ALL DEVICES AND WIRING INDICATED.
- 2) INSTALL IN A NEMA 12 ENCLOSURE WITH MOUNTING FLANGES AT BACK, A MIN 14 GAUGE INTERIOR BACK PANEL AND HINGED LOCKABLE DOOR. SIZE AS INDICATED.
- 3) PROVIDE DIN RAIL, TERMINAL END PLATES, TERMINAL END STOPS, TERMINAL DUST COVERS AND OTHER MISCELLANEOUS HARDWARE AS REQUIRED TO MATCH TERMINALS. LABEL ALL TERMINALS EXACTLY AS INDICATED ON THE DETAILS.
- 4) ALL WIRE #14AWG EXCEPT WHERE SPECIFICALLY INDICATED OTHERWISE. LABEL BOTH ENDS OF ALL JUMPERS WITH THE ENGINE PANEL TERMINAL NUMBER.
- 5) PROVIDE MECHANICAL GROUND LUGS FASTENED TO BACK PANEL AND GROUNDED TO ENGINE-GENERATOR. GROUND ALL SHIELD DRAIN WIRES TO LUGS AT BACK PANEL ONLY.
- 6) PROVIDE WIRING HARNESSES FOR CONNECTION TO GENERATOR AND TO ENGINE. INSTALL WIRES IN LIQUID TIGHT FLEX OR FLEXIBLE PLASTIC WIRE LOOM AND PROVIDE SERVICE LOOPS IN ACCORDANCE WITH SPECIFICATIONS.
- 7) SHOP TEST EACH NEW ENGINE-GENERATOR WITH ASSOCIATED JUNCTION BOX PERMANENTLY CONNECTED. UPON COMPLETION OF TESTING, COIL WIRING HARNESSES AND SECURE JUNCTION BOX TO GENERATOR FOR SHIPPING.

**FIELD INSTALLATION NOTES:**

- 1) PERFORM ALL FIELD WIRING IN ACCORDANCE WITH SPECIFICATIONS. LABEL BOTH ENDS OF ALL FIELD WIRING WITH THE ENGINE PANEL TERMINAL NUMBER.
- 2) ON SHIELDED CONDUCTORS GROUND ALL SHIELD DRAIN WIRES AT ENGINE J-BOX ONLY. CLIP DRAIN WIRES AT OPPOSITE ENDS.

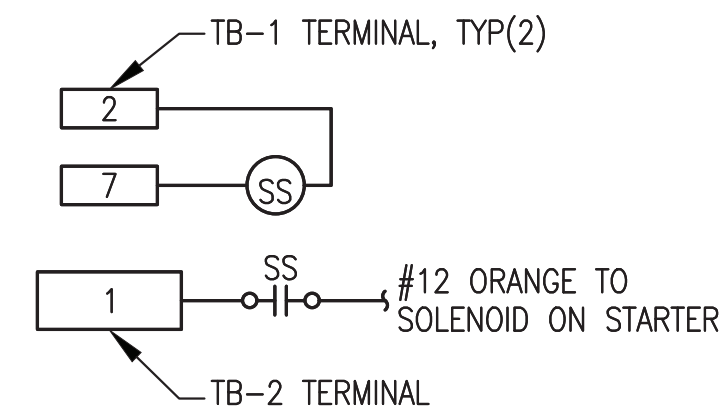

**6** STARTER AUX SOLENOID SS WIRING  
E6.3 NO SCALE

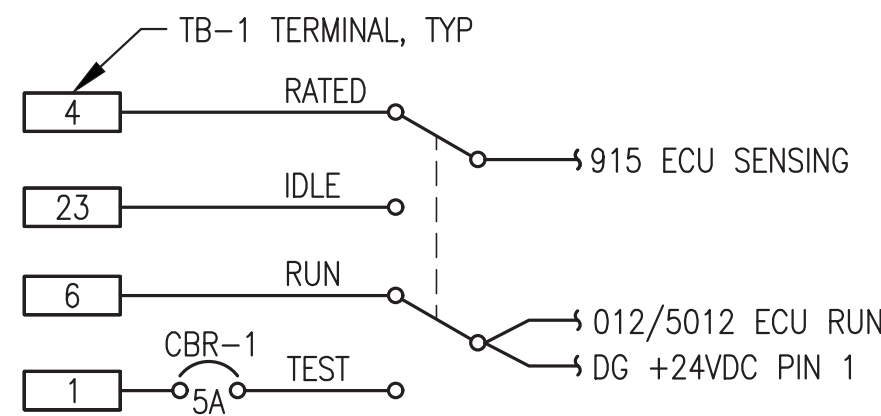

**7** EXHAUST RTD CONNECTOR  
E6.3 NO SCALE

**8** TEST-IDLE/RUN-RATED SWITCH SW-TR WIRING  
E6.3 NO SCALE


ALL WORK ON THIS SHEET WAS PERFORMED AS PART OF THE PRIOR MODULE ASSEMBLY CONTRACT AND IS SHOWN HERE FOR REFERENCE ONLY.

REV.	DESCRIPTION	DATE	BY
2	DELETED EXHAUST RTD & VACUUM SENSOR PER NEW J1939 ENGINE MONITORING	8/15/23	BCG
1	UPDATED TO ADD 21 PIN CUSTOMER CONNECTION	5/30/23	BCG




PROJECT: <b>NELSON LAGOON POWER SYSTEM UPGRADE</b>	
TITLE: <b>24VDC ENGINE WIRING JUNCTION BOX</b>	
	DRAWN BY: JTD DESIGNED BY: CWV/BCG FILE NAME: NELS_PP_E6 PROJECT NUMBER:
REV#1 ISSUED FOR CONSTRUCTION AUGUST 2023 	SCALE: NO SCALE DATE: 4/10/23 SHEET: <b>E6.3</b>

P.O. 111405, Anchorage, AK 99511 (907)349-0100

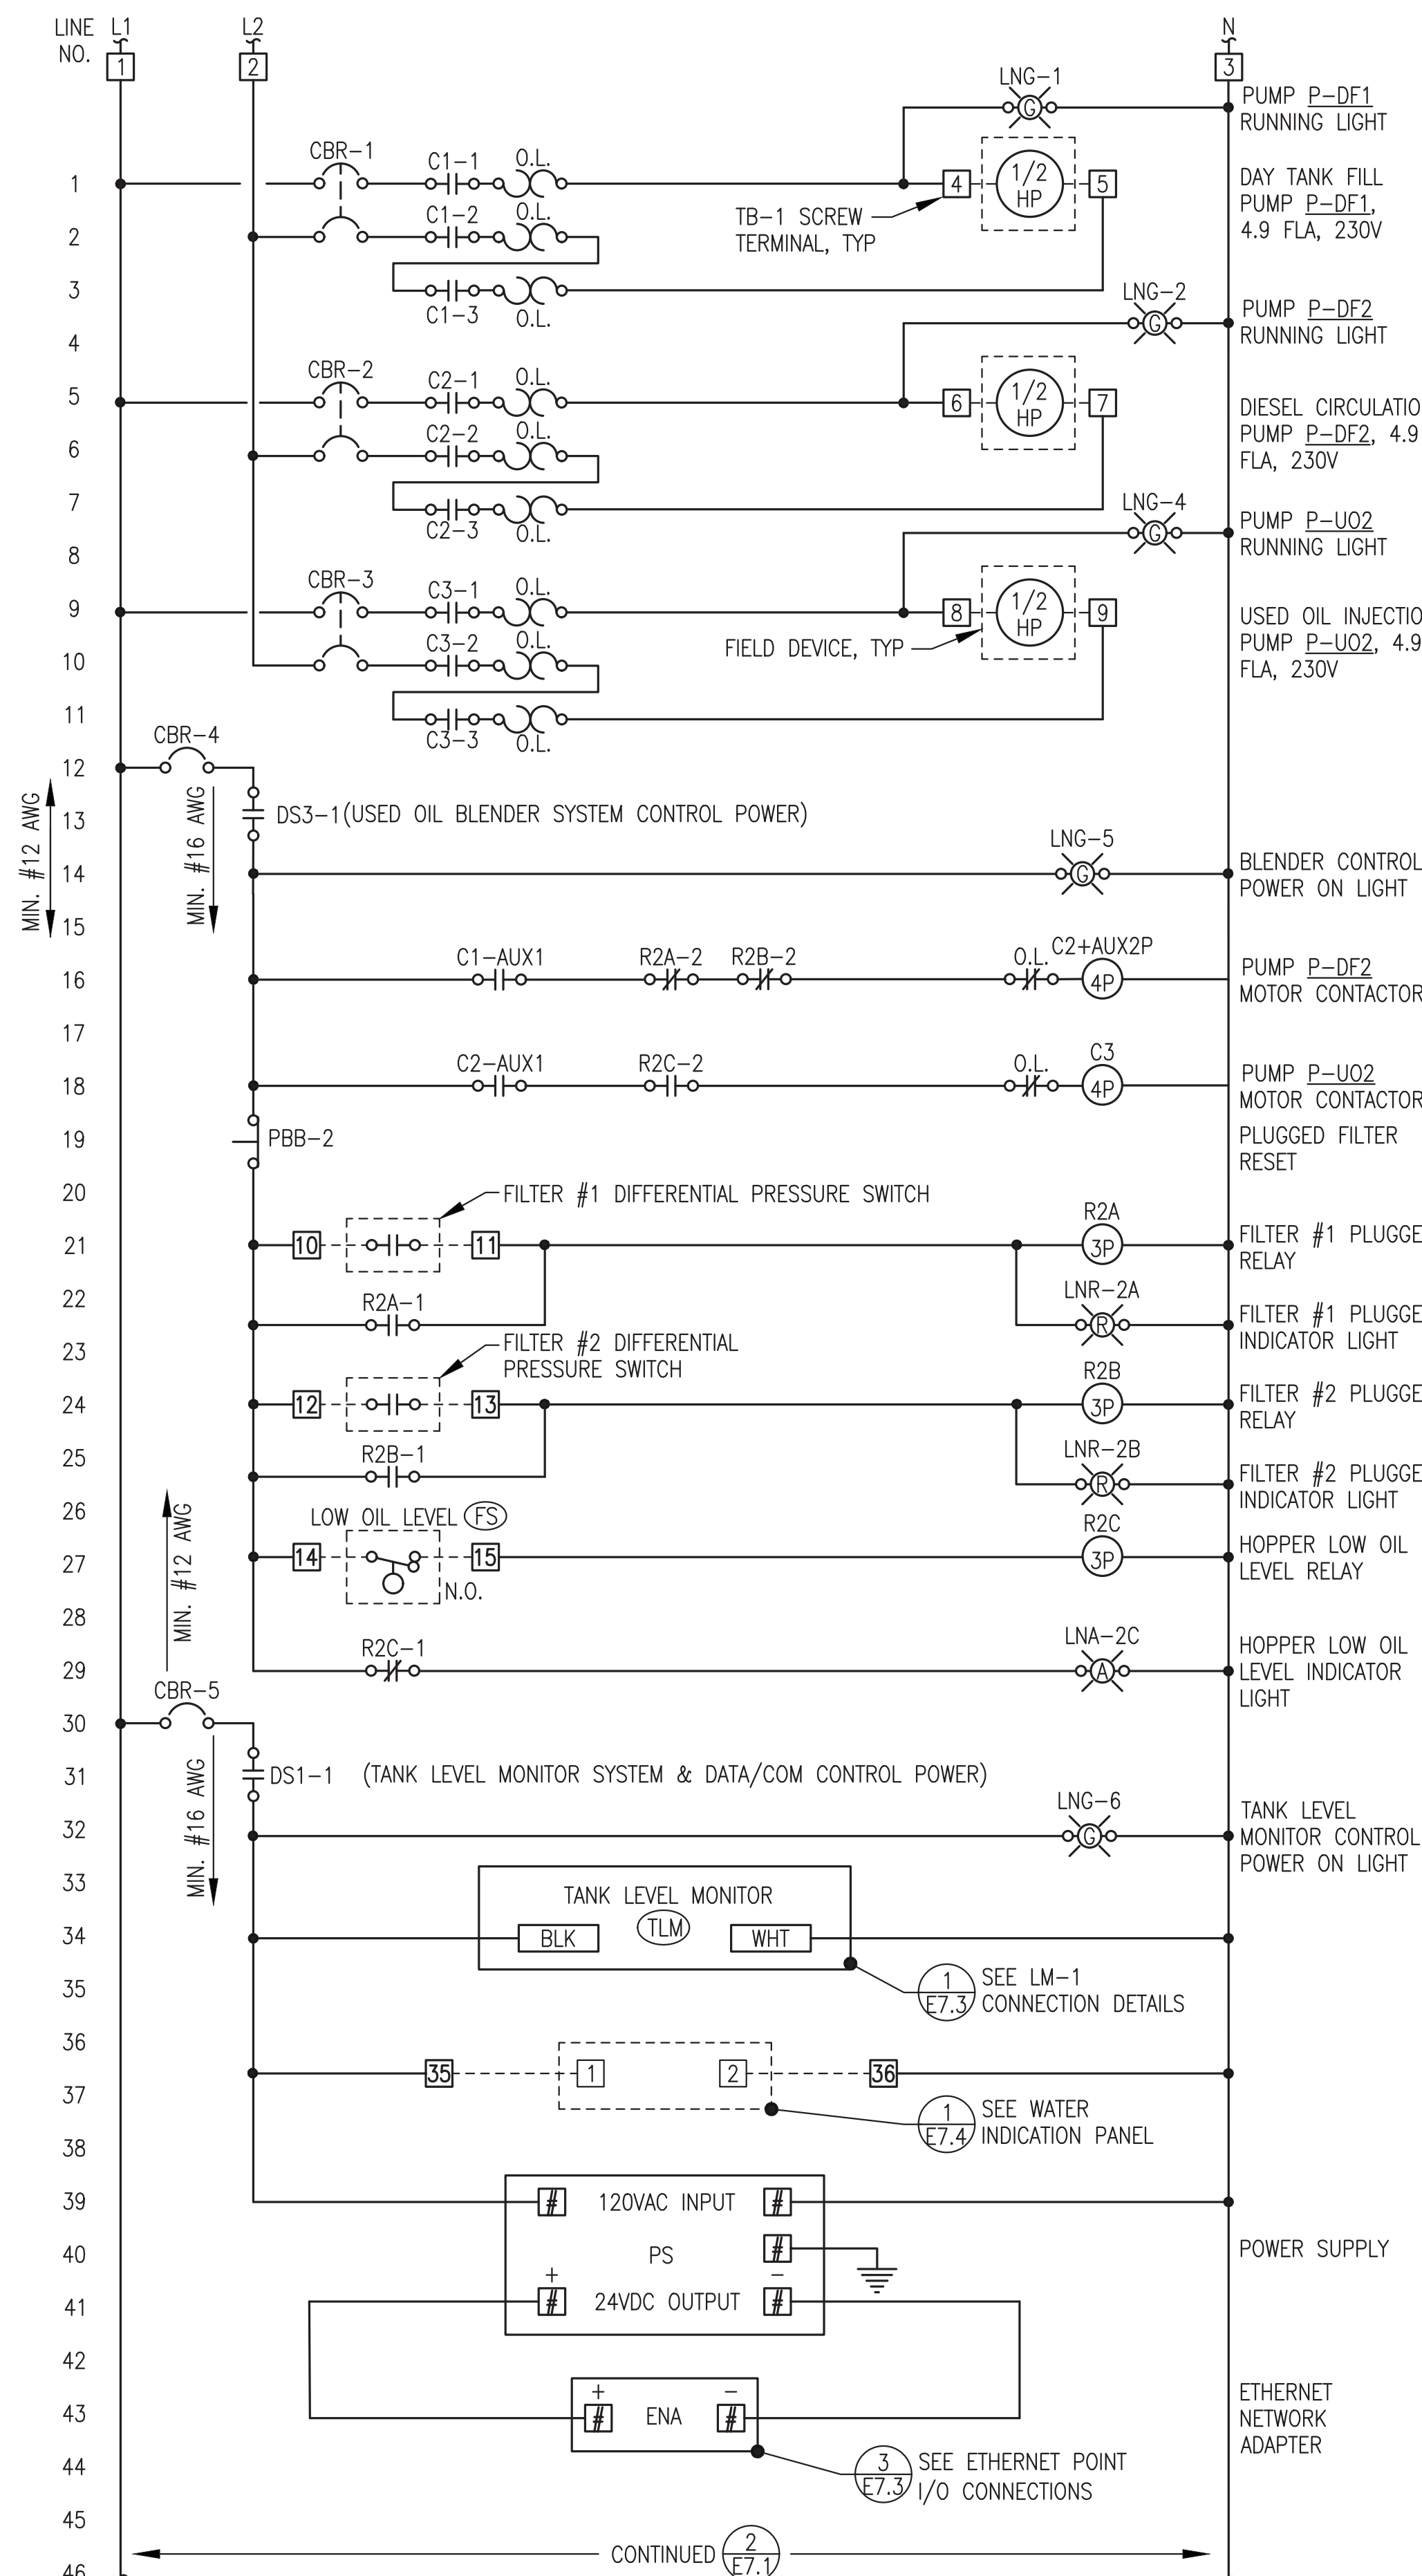

**1** USED OIL BLENDER SYSTEM LOGIC DIAGRAM  
E7.1 NO SCALE

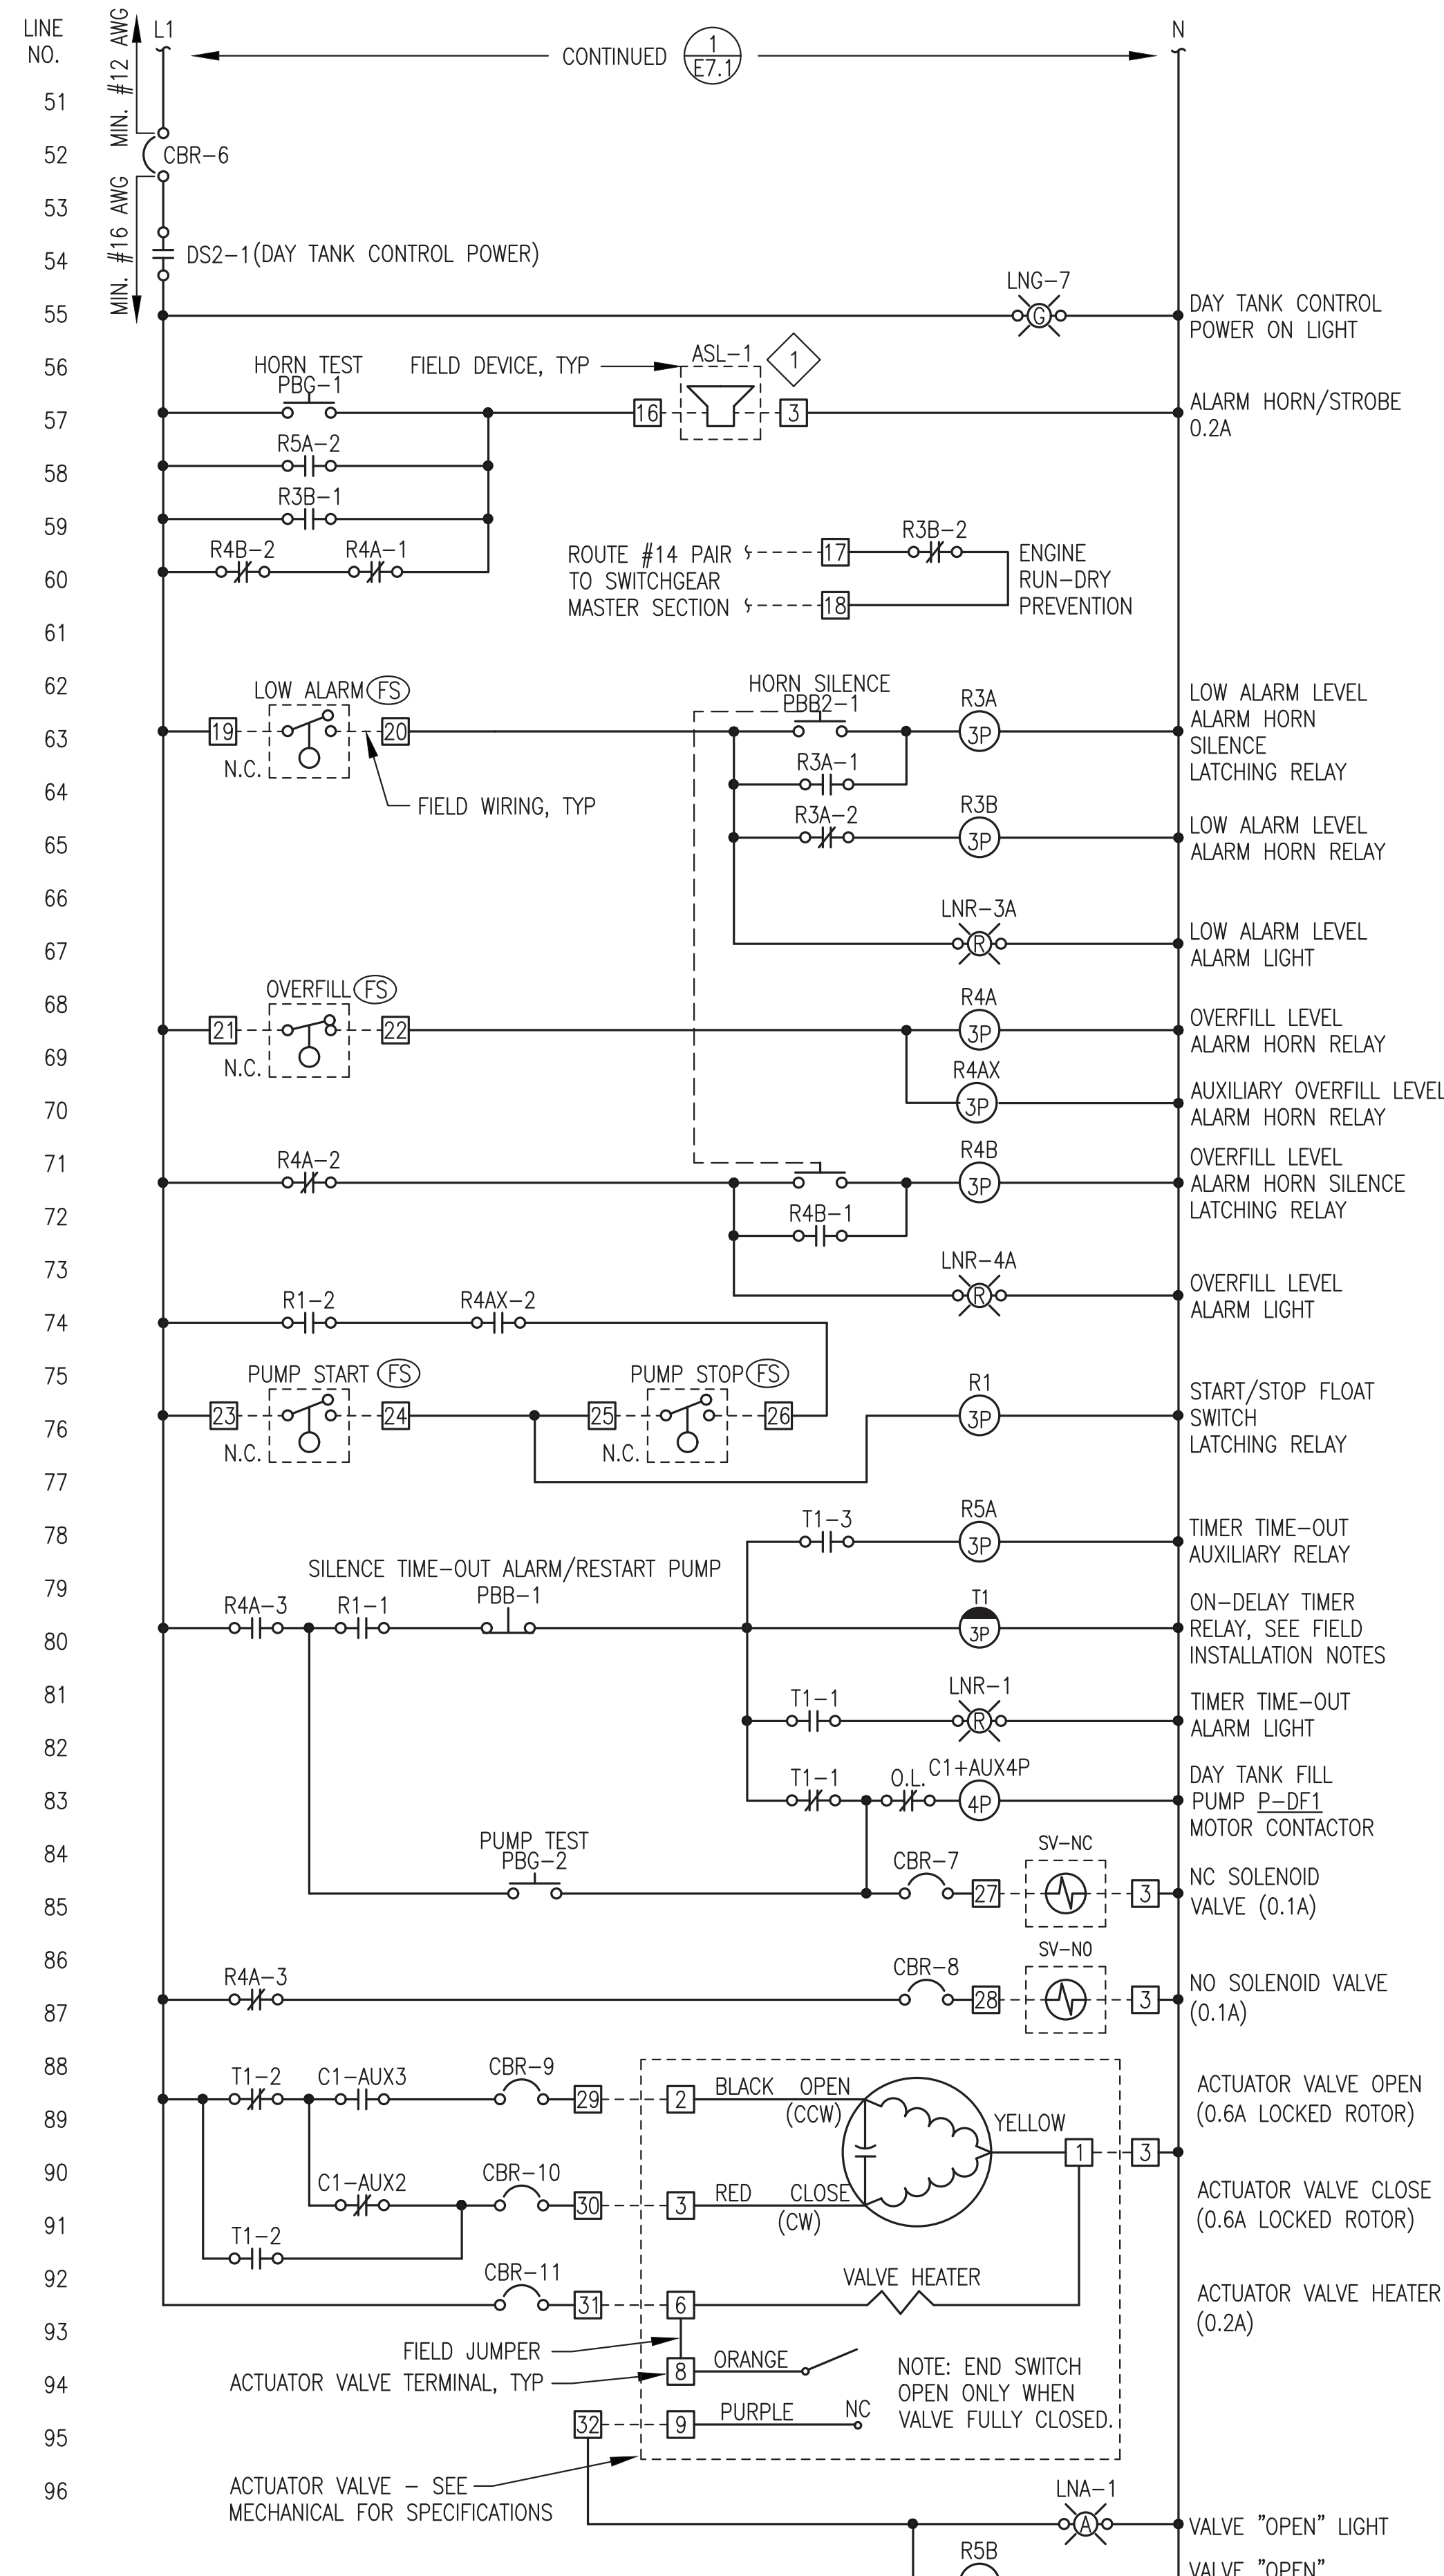

**2** DAY TANK LOGIC DIAGRAM  
E7.1 NO SCALE

**BILL OF MATERIALS**

NOTE: ON THIS SHEET AND THE PANEL DRAWINGS THAT FOLLOW SPECIFIC PARTS MANUFACTURER AND MODEL ARE SELECTED NOT ONLY TO MEET PERFORMANCE FUNCTION BUT ALSO TO COORDINATE AND INTERFACE WITH OTHER DEVICES AND SYSTEMS. APPROVED EQUAL SUBSTITUTIONS WILL BE ALLOWED ONLY BY ENGINEER'S APPROVAL. TO OBTAIN APPROVAL, SUBMITTALS MUST CLEARLY DEMONSTRATE HOW SUBSTITUTE ITEM MEETS OR EXCEEDS SPECIFIED ITEM QUALITY AND PERFORMANCE CHARACTERISTICS AND ALSO COMPLIES WITH MECHANICAL AND/OR ELECTRICAL CONNECTIONS AND PHYSICAL LAYOUT REQUIREMENTS.


TAG	MANUFACTURER	MODEL	DESCRIPTION
AUX2P	ALLEN-BRADLEY	100FA11	AUXILIARY CONTACT FOR CONTACTOR, 2 POLE, NO, NC
AUX4P	ALLEN-BRADLEY	100FA31	AUXILIARY CONTACT FOR CONTACTOR, 4 POLE, 3NO, 1NC
C	ALLEN-BRADLEY	100C09D10	CONTACTOR, 120V COIL, 9A, 4 POLE
CBR-1,2,3	ALLEN-BRADLEY	1489-M2-C150	RAIL-MOUNT CIRCUIT BREAKER, 2 POLE, 15A
CBR-4,5,6	ALLEN-BRADLEY	1489-M1-C050	RAIL-MOUNT CIRCUIT BREAKER, 1 POLE, 5A
CBR-7,8,9,10,11	ALLEN-BRADLEY	1489-M1-C010	RAIL-MOUNT CIRCUIT BREAKER, 1 POLE, 1A
DS	ALLEN-BRADLEY	194LE201753	DISCONNECT, 2 POSITION, 3 N.O., 20A, FACE MOUNT
ENA	ALLEN-BRADLEY	194LHC4E1751	KNOB ACTUATOR FOR LOAD SWITCH, ON/OFF, LOCKABLE
Di8	ALLAN-BRADLEY	1734-AENTR	I/O DUAL PORT ETHERNET NETWORK ADAPTER
LNG	ALLEN-BRADLEY	800HORH2G	DIGITAL INPUT MODULE, 24VDC, 8 POINT, SINKING
LNR	ALLEN-BRADLEY	800HORH2R	GREEN LED PILOT LIGHT, 12-130V, NEMA 4X
LNA	ALLEN-BRADLEY	800HORH2A	RED LED PILOT LIGHT, 12-130V, NEMA 4X
OL	ALLEN-BRADLEY	193-1EEDB	AMBER LED PILOT LIGHT, 12-130V, NEMA 4X
PBB	ALLEN-BRADLEY	800HAR2D2	OVERLOAD, 230V, 1Ø, ADJUSTABLE 3.2A-16.0A RANGE
PBB2	ALLEN-BRADLEY	800HAR2A2	MOMENTARY PUSH BUTTON, 1 NO, NEMA 4X, BLACK
PBG	ALLEN-BRADLEY	800HAR1D1	MOMENTARY PUSH BUTTON, 2 NO, NEMA 4X, BLACK
PP	PHOENIX CONTACTS	FLPPRJ45/RJ45	MOMENTARY PUSH BUTTON, 1 NO, NEMA 4X, GREEN
PS	ALLEN-BRADLEY	CP5.241-S1	ETHERNET PATCH PANEL, RJ45xRJ45, DIN RAIL MOUNT
R	ALLEN-BRADLEY	700HA33A1	5A, 120VAC/24VDC POWER SUPPLY
	ALLEN-BRADLEY	700HN101	3PDT RELAY
	ALLEN-BRADLEY	700HT3	11 PIN SOCKET BASE
T	ALLEN-BRADLEY	700HA33A1	SERIES B TIMING MODULE
	ALLEN-BRADLEY	700HN205	3PDT RELAY
	ALLEN-BRADLEY	1492CAM1L	11 PIN RELAY SOCKET BASE FOR TIMER
TB-1,2	ALLEN-BRADLEY	1492CAM1L	35A, 600V, LARGE-HEAD SCREW TERMINALS
(TLM)			TANK LEVEL MONITOR, SEE INSTRUMENTATION SCHEDULE ON SHEET M1.1

**LEGEND**

—	PANEL WIRING	----	FIELD WIRING	O.L.	OVERLOADS
R#	CONTROL RELAY	R#-#	NORMALLY OPEN CONTACT	PB-#	NORMALLY OPEN MOMENTARY PUSH BUTTON
T#	TIME DELAY RELAY	SS-#	2-POSITION SELECTOR SWITCH	PB-#	NORMALLY CLOSED MOMENTARY PUSH BUTTON
C#	CONTACTOR	R#-#	NORMALLY CLOSED CONTACT	SV#	SOLENOID VALVE
#	TERMINAL BLOCK	SW-#	NORMALLY OPEN FLOAT SWITCH	ASL-#	ALARM & STROBE LIGHT
CB-#	CIRCUIT BREAKER	SW-#	NORMALLY CLOSED FLOAT SWITCH		

ALL WORK ON THIS SHEET WAS PERFORMED AS PART OF THE PRIOR MODULE ASSEMBLY CONTRACT EXCEPT FOR TERMINATION AT THE PANEL OF EXTERIOR FIELD CONDUCTORS SHOWN ON SHEETS E1.3 AND E1.5 WHICH IS INCLUDED IN THE ON SITE WORK.

ISSUED FOR CONSTRUCTION  
MAY 2023

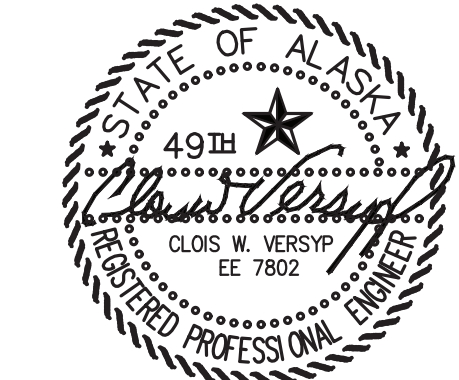




**ALASKA ENERGY AUTHORITY**

PROJECT: **NELSON LAGOON POWER SYSTEM UPGRADE**

TITLE: **DAY TANK CONTROL PANEL LOGIC DIAGRAM & BILL OF MATERIALS**

DRAWN BY: BCG/JTD	SCALE: AS NOTED
DESIGNED BY: CWV/BCG	DATE: 5/30/23
FILE NAME: NELS_PP_E7	SHEET: E7.1
PROJECT NUMBER:	

**Gray Stassel Engineering, Inc.**  
P.O. 111405, Anchorage, AK 99511 (907)349-0100

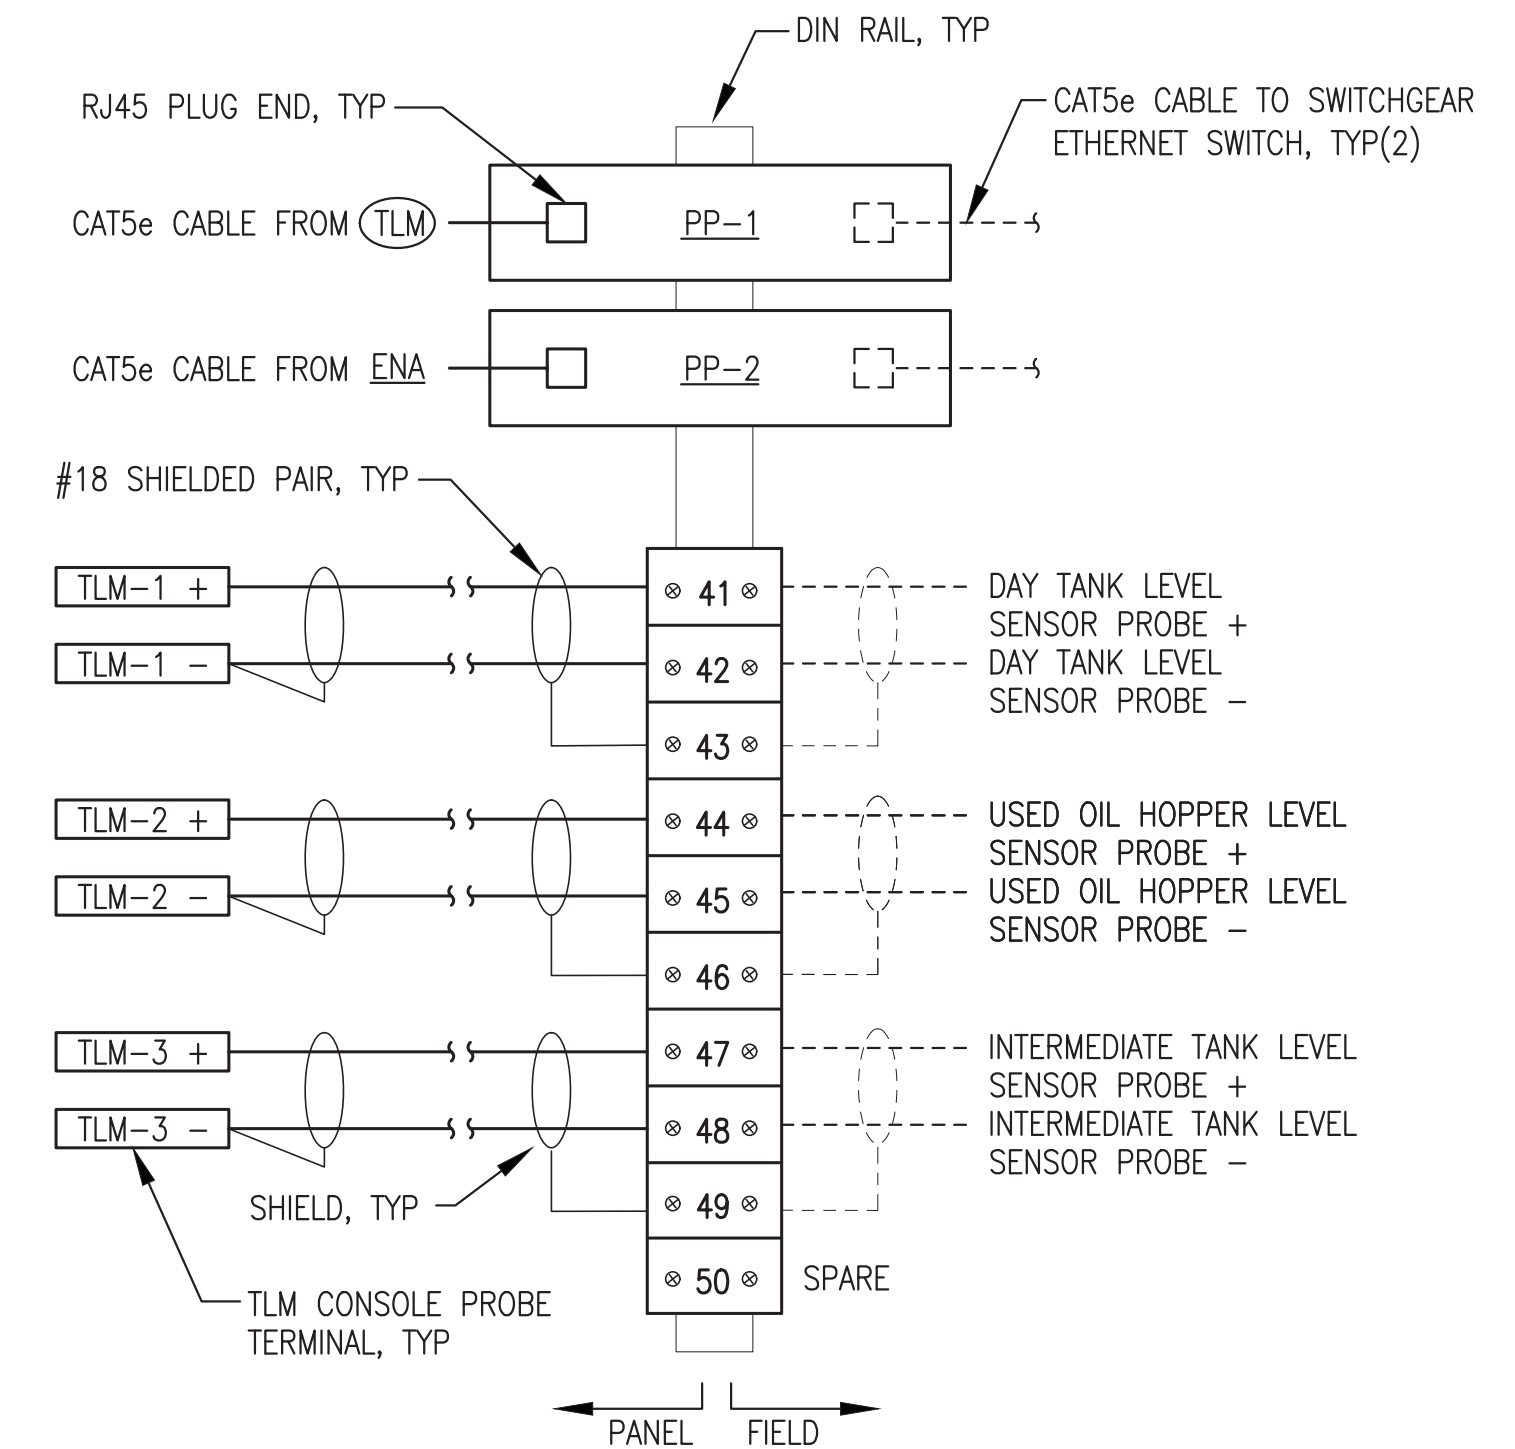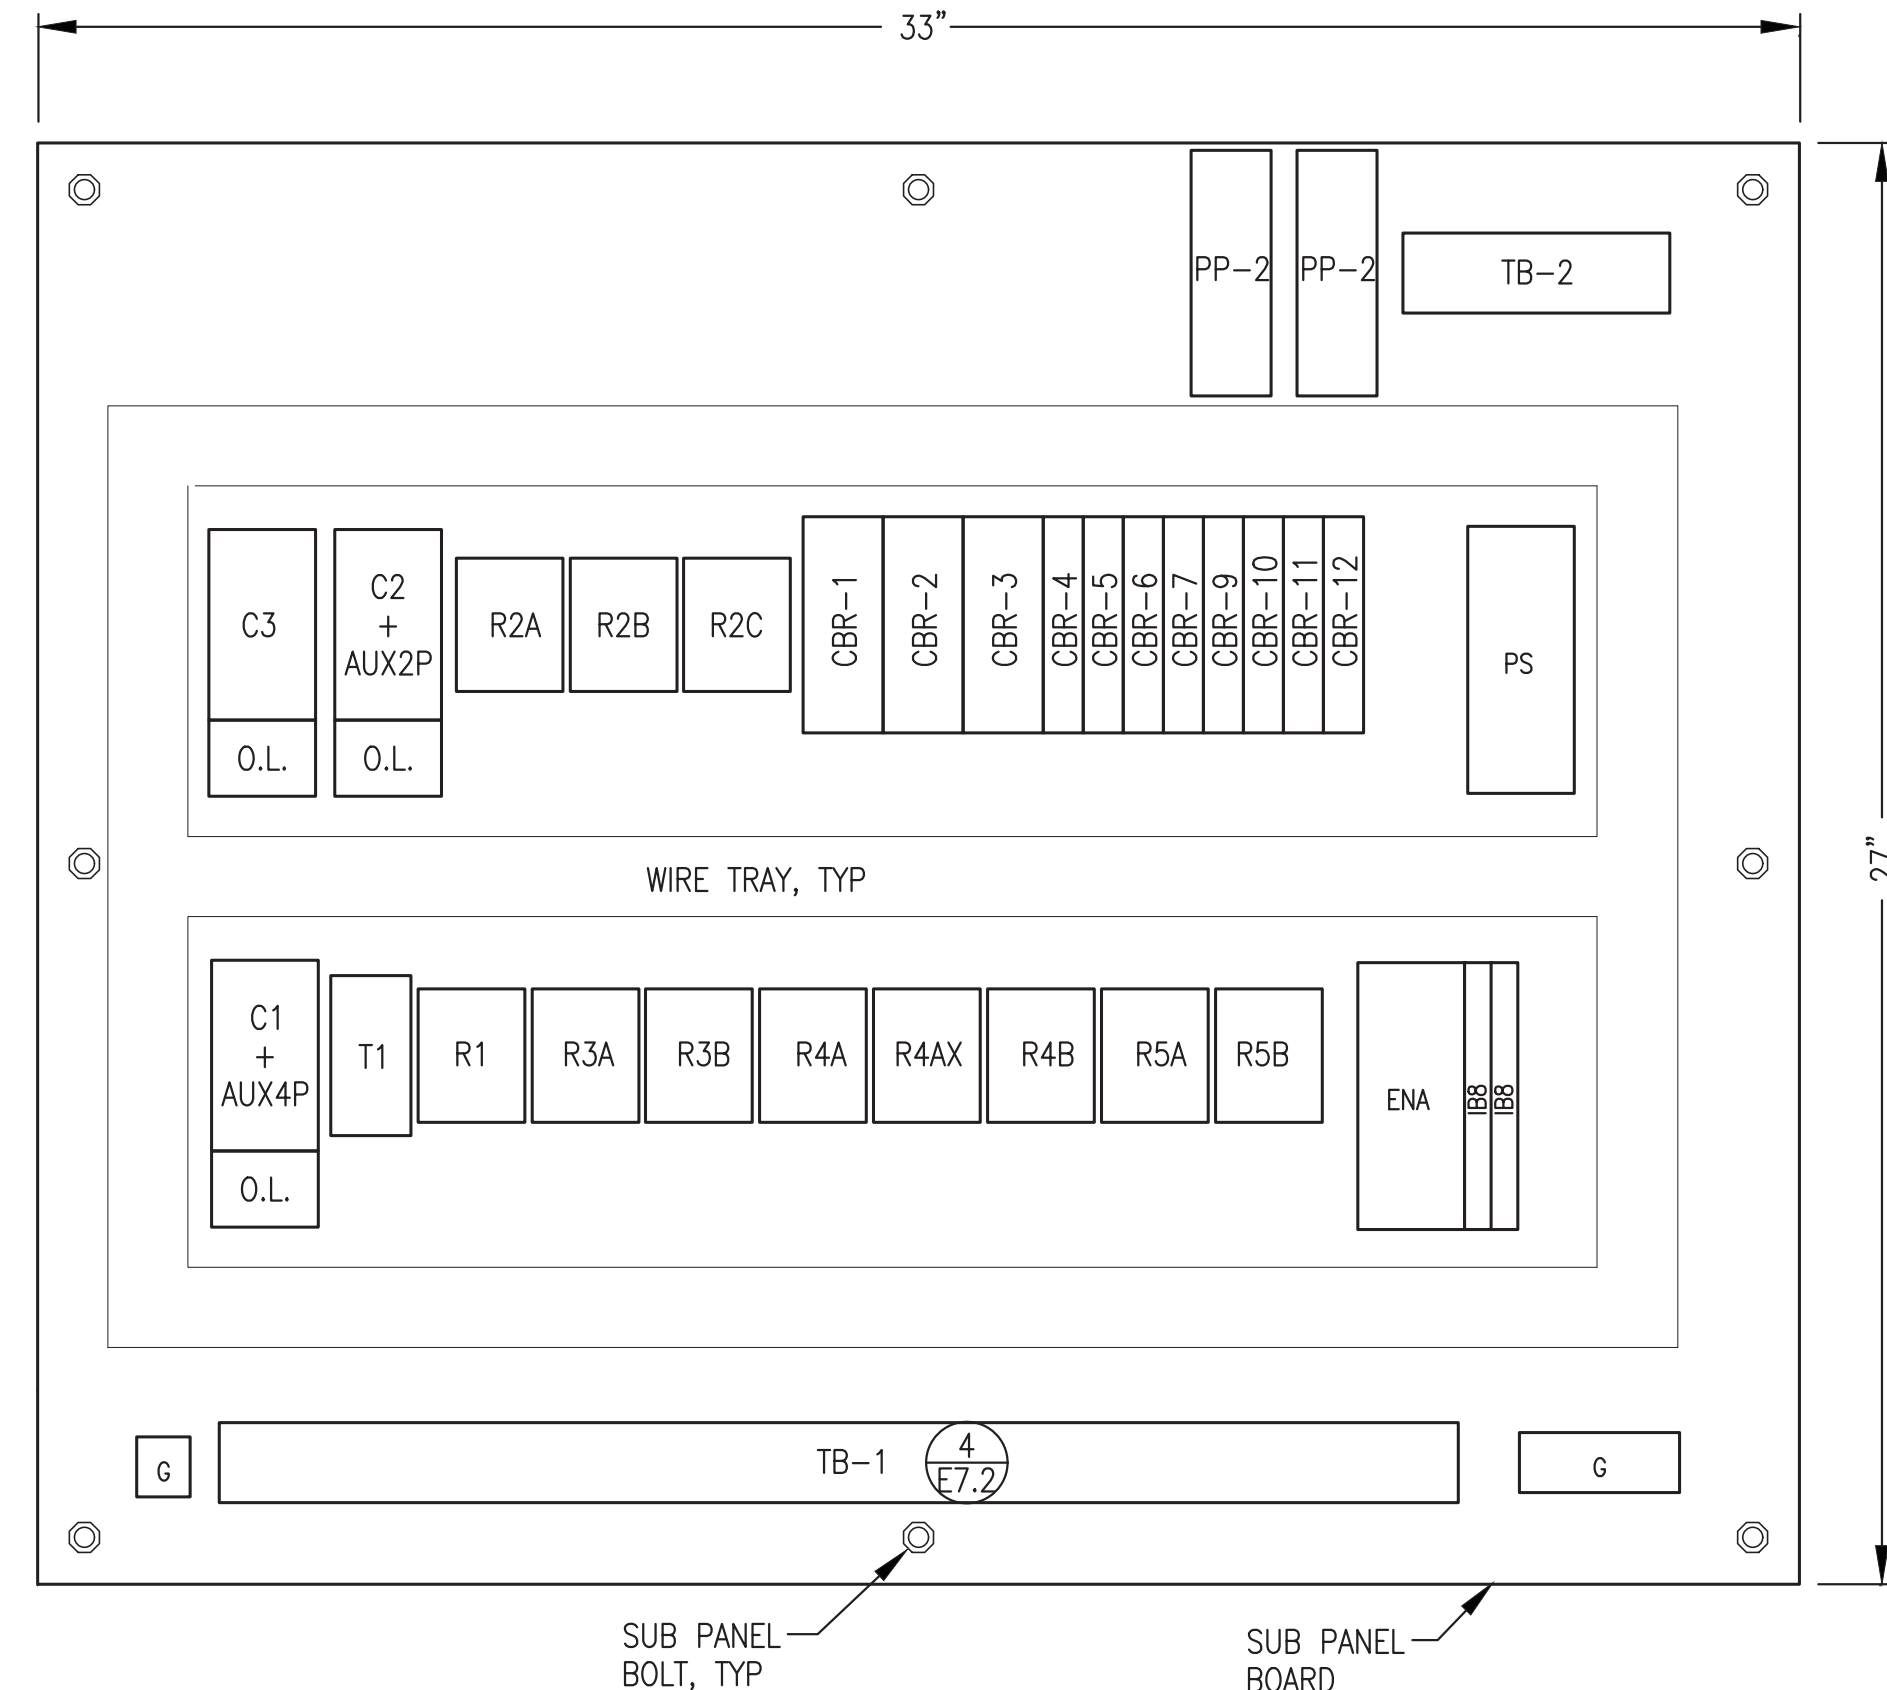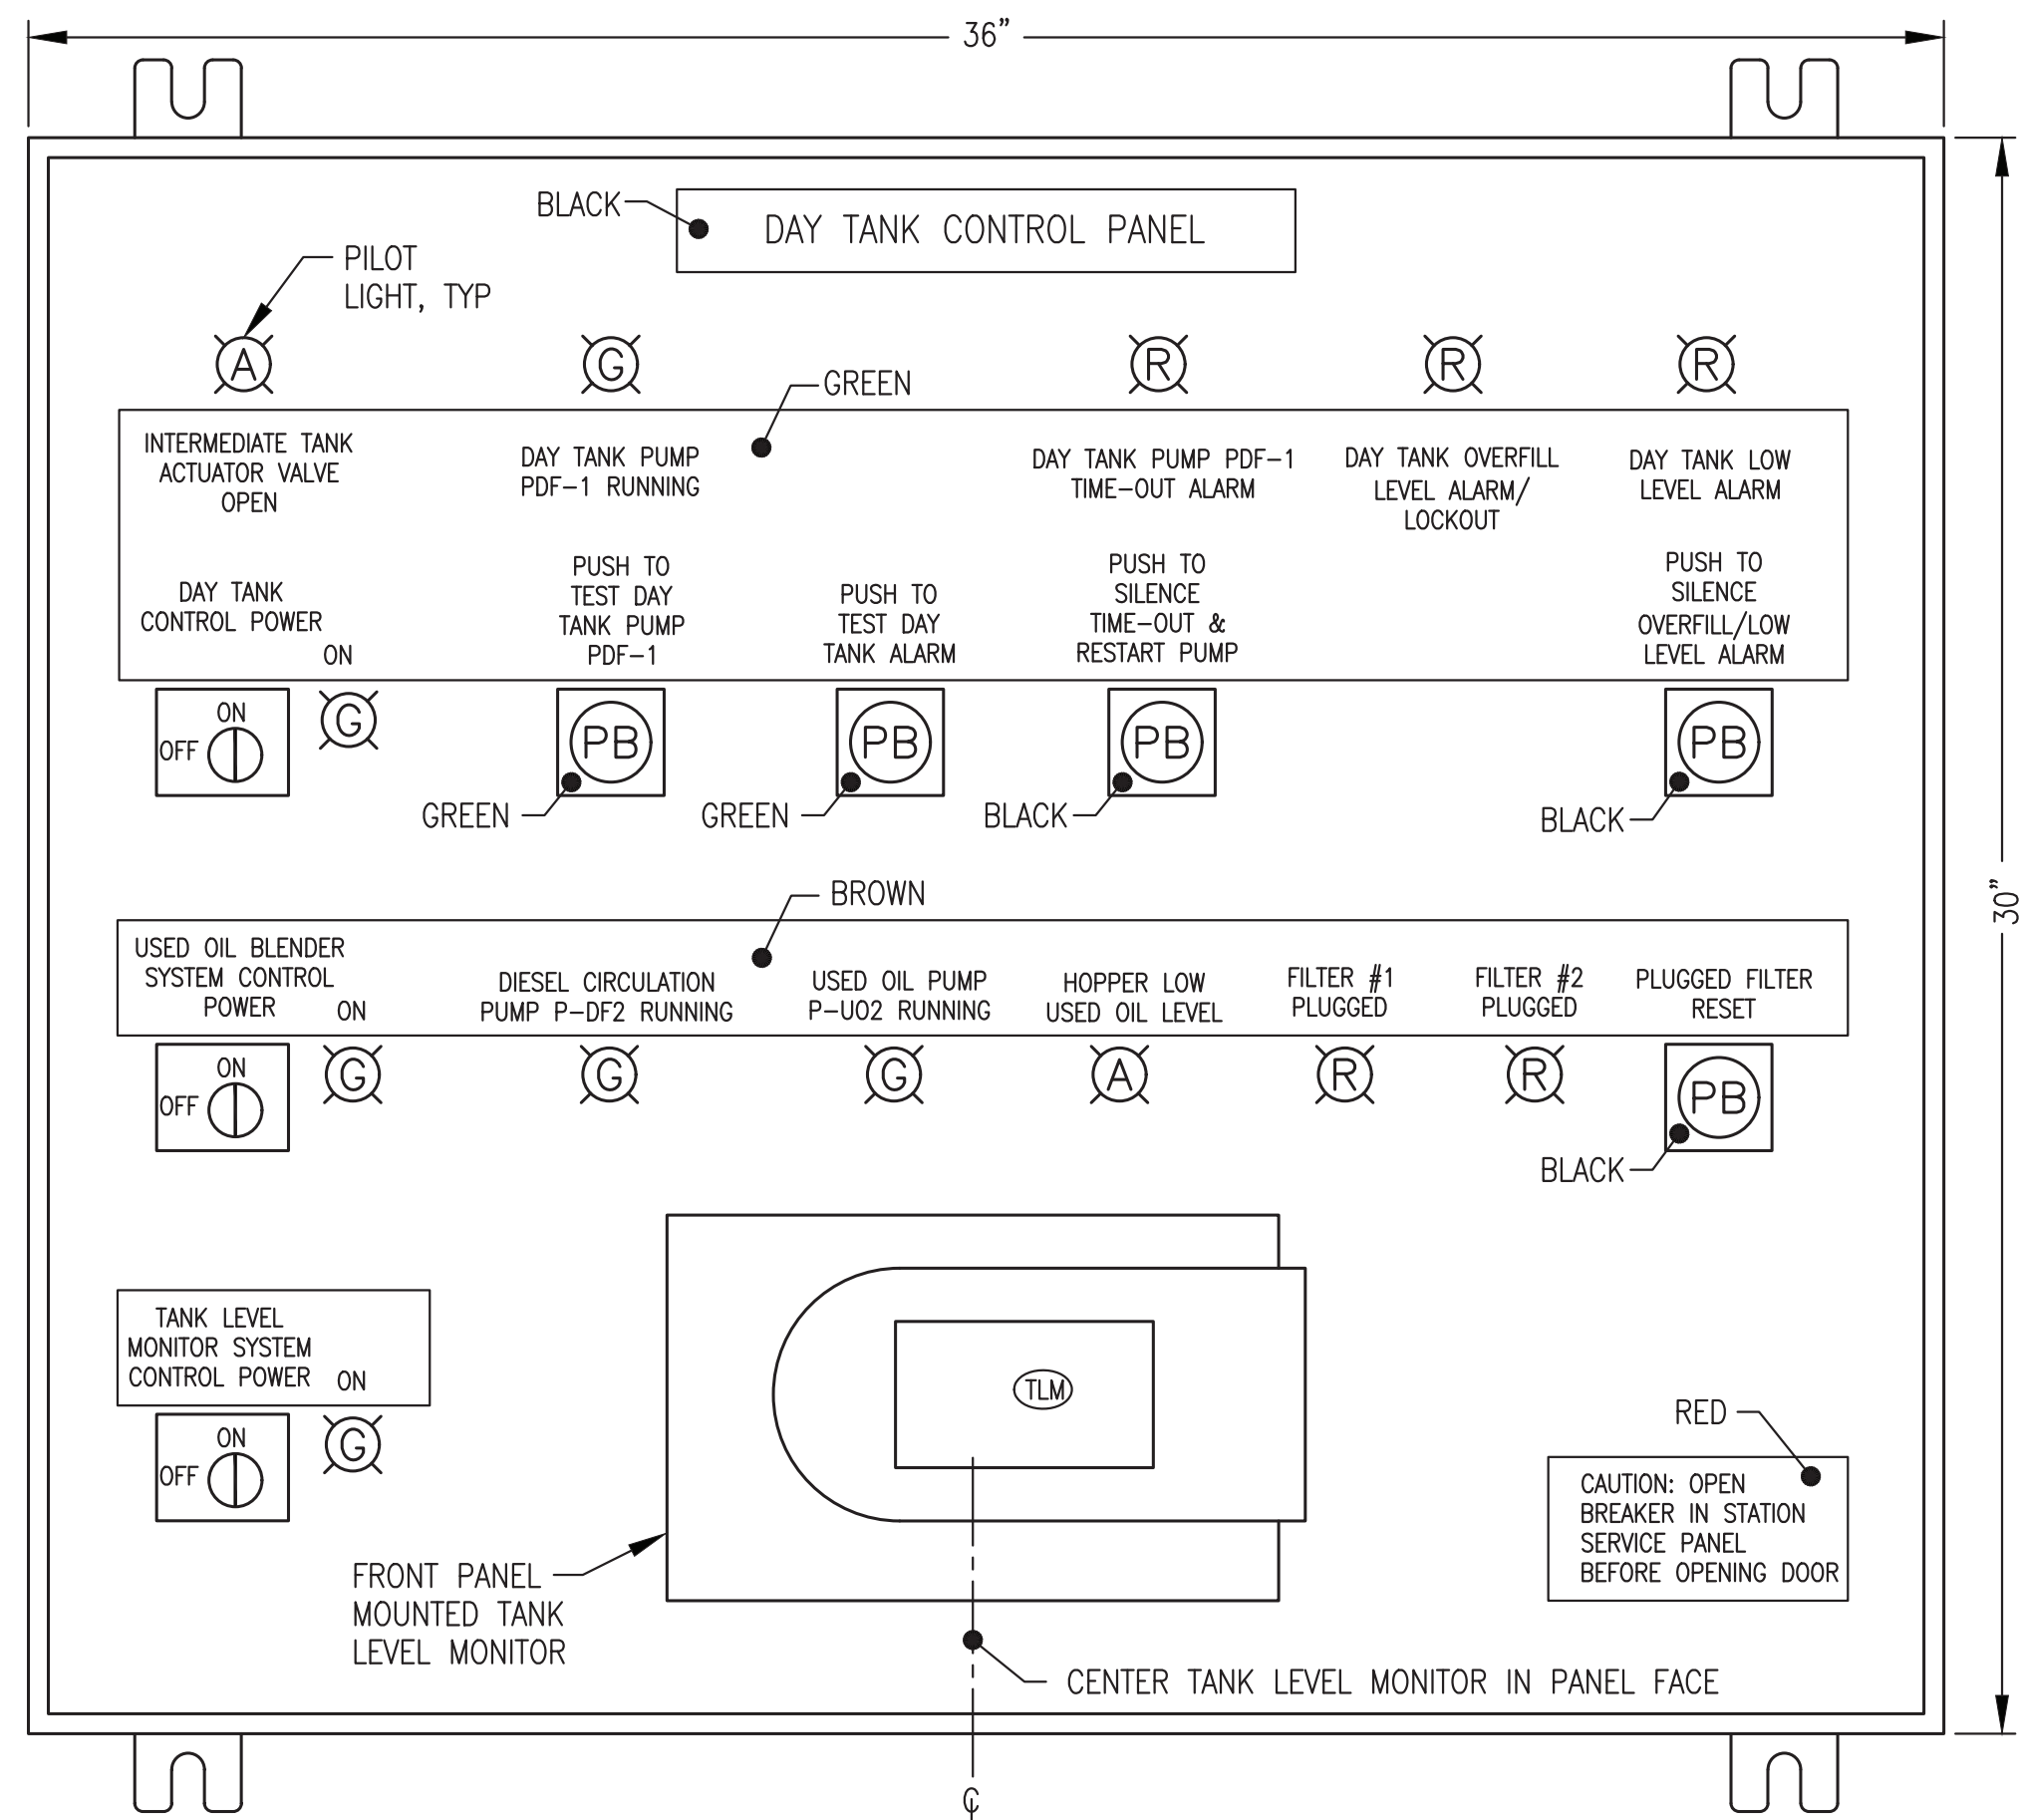


NOTES:

1. INSTALL TERMINAL STRIP TB-2 AND ETHERNET PATCH PANEL PP-1 ON VERTICAL DIN RAIL AS SHOWN. LOCATE TERMINAL STRIP IN THE UPPER RIGHT CORNER OF PANEL TO ACCOMMODATE CONDUCTOR ENTRY THROUGH RIGHT SIDE OF PANEL, SEE SUB-PANEL LAYOUT.

1 FRONT PANEL LAYOUT  
E7.2 NO SCALE

2 SUB PANEL LAYOUT  
E7.2 NO SCALE

3 TB-2 TERM STRIP LAYOUT  
E7.2 NO SCALE

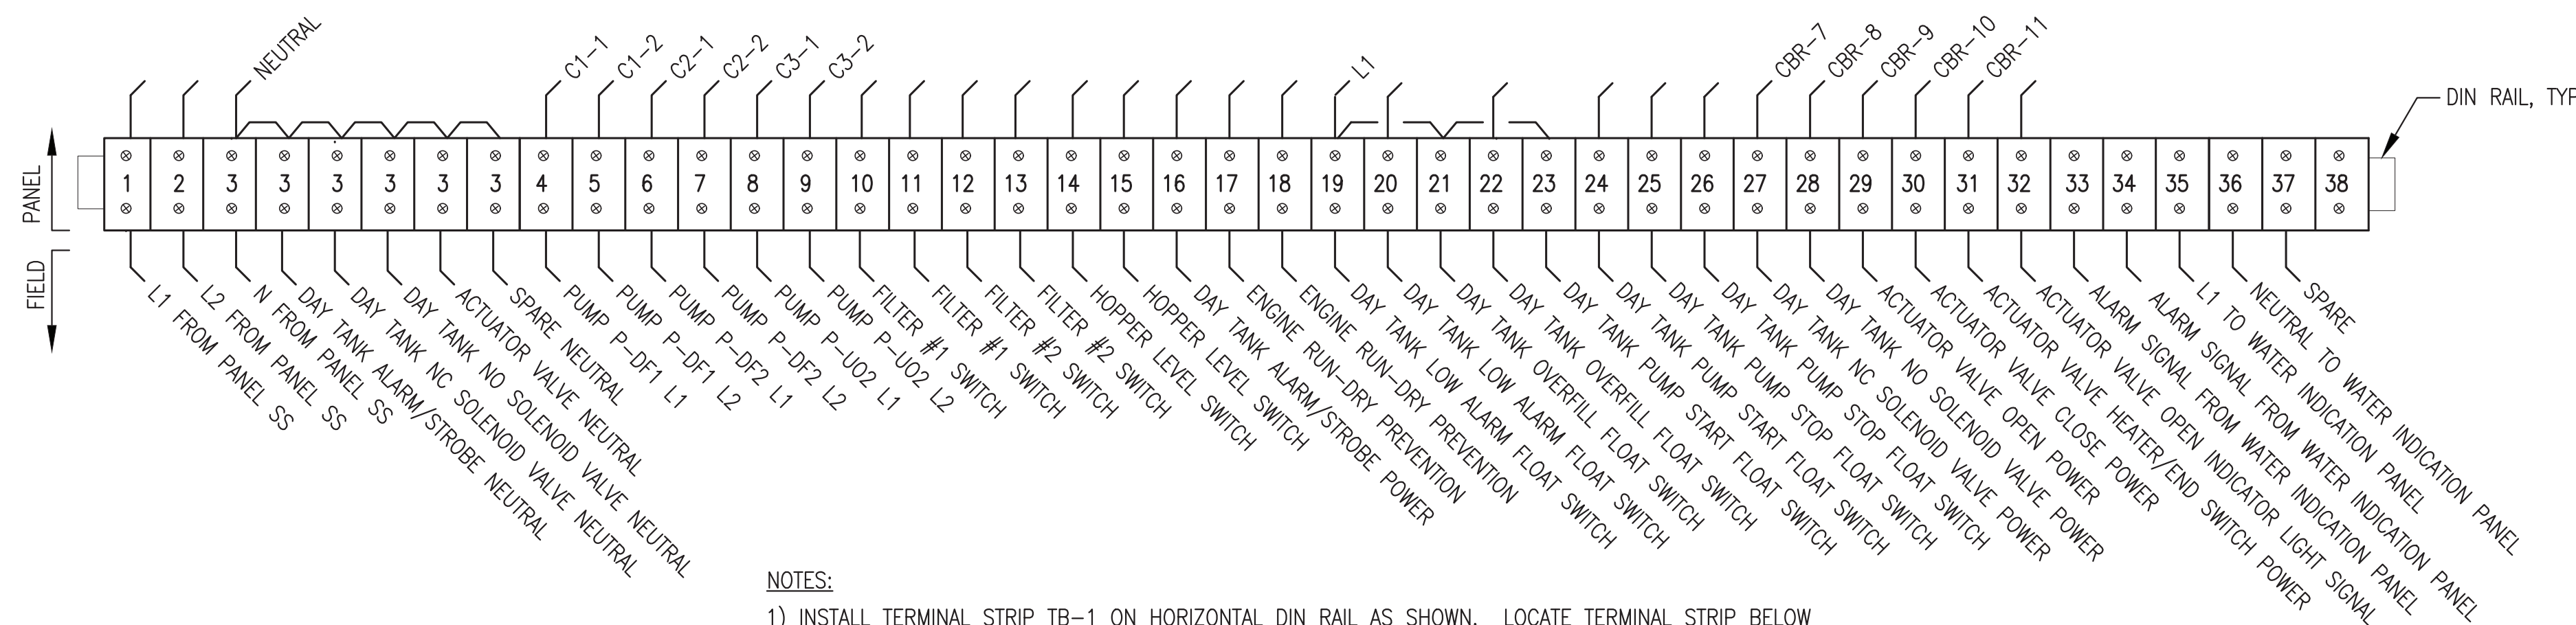


NOTES:

- 1) INSTALL TERMINAL STRIP TB-1 ON HORIZONTAL DIN RAIL AS SHOWN. LOCATE TERMINAL STRIP BELOW PANEL DEVICES TO ACCOMMODATE CONDUCTOR ROUTING FROM CONDUITS CONNECTING TO BOTTOM OF PANEL, SEE SUB-PANEL LAYOUT.
- 2) IN ADDITION TO THE TERMINAL STRIPS SHOWN, PROVIDE 6 EACH 35A SCREW TERMINAL GROUNDING BUS.

4 TB-1 TERMINAL STRIP LAYOUT  
E7.2 NO SCALE

ALL WORK ON THIS SHEET WAS PERFORMED AS PART OF THE PRIOR MODULE ASSEMBLY CONTRACT AND IS SHOWN HERE FOR REFERENCE EXCEPT FOR TERMINATION AT THE PANEL OF EXTERIOR INTERMEDIATE TANK FIELD CONDUCTORS WHICH IS INCLUDED IN THE ON SITE WORK.

ISSUED FOR CONSTRUCTION  
MAY 2023

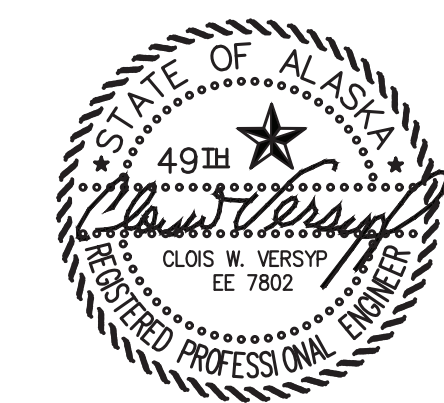

PROJECT: NELSON LAGOON POWER SYSTEM UPGRADE		
TITLE: DAY TANK CONTROL PANEL LAYOUT & TERMINAL STRIPS		
DRAWN BY: BCG/JTD	SCALE: AS NOTED	
DESIGNED BY: CWV/BCG	DATE: 5/30/23	
FILE NAME: NELS PP E7	SHEET:	E7.2
PROJECT NUMBER:		



**PANEL NOTES:**

- 1) PROVIDE COMPLETE LISTED PANEL ASSEMBLY WITH ALL DEVICES INDICATED IN LOGIC DIAGRAM EXCEPT FOR FIELD DEVICES. INSTALL IN A NEMA 12 ENCLOSURE WITH 4 EACH INTEGRAL MOUNTING LUGS AT BACK. SEE SHEET E7.2 FOR PANEL LAYOUT DETAILS.
- 2) USE MIN #12 WIRE FOR ALL CIRCUITS UP TO FIRST IN-LINE PANEL BREAKERS (FOR 20A FEED). USE MIN #16 AWG ON ALL 5 AMP CIRCUITS AND MIN #14 AWG WIRE ON ALL 15A CIRCUITS. TAG EACH END OF ALL JUMPERS WITH DEVICE OR TERMINATION DESIGNATOR OF LANDING OF OPPOSITE END OF JUMPER (REVERSE ADDRESS).
- 3) LABEL ALL PANEL DEVICES ON BASE OR BACK PANEL ADJACENT TO ITEM. LABEL REMOTE EQUIPMENT CONNECTIONS AT EACH TERMINAL BLOCK BY THE ITEM TITLE AS SHOWN ON THE FIELD SIDE OF THE TERMINAL STRIP DRAWING. PROVIDE BEVELED EDGE WHITE CORE NAMEPLATES AS SHOWN ON THE PANEL FACE LAYOUT AND SECURE TO PANEL FACE WITH A MINIMUM OF TWO STAINLESS STEEL MOUNTING SCREWS, COLOR AS INDICATED.
- 4) BENCH TEST COMPLETED UNIT. PROVIDE MIN 48 HOURS NOTICE TO ENGINEER TO SCHEDULE OBSERVATION OF BENCH TEST. PROVIDE SWITCHES AND LAMPS TO SIMULATE OPERATION OF ALL FIELD DEVICES.
- 5) DEVICES AND WIRING NOTED AS "FIELD" AND SHOWN WITH DASHED LINES WILL BE FIELD INSTALLED AND ARE NOT PART OF THE PANEL SHOP FABRICATION. FOR BENCH TEST, PROVIDE TEMPORARY DEVICES AND WIRING AS REQUIRED TO SIMULATE FIELD DEVICES.
- 6) POWER TO PANEL PROVIDED FROM DEDICATED 20A 2-POLE CIRCUIT BREAKER IN LISTED LOAD CENTER. SEE FIELD INSTALLATION NOTE #3.

**FIELD INSTALLATION NOTES:**


- 1) SEE MECHANICAL FOR DAY TANK INSTALLATION & PIPING. INSTALL CONTROL PANEL & FIELD DEVICES AS INDICATED TO PROVIDE REDUNDANT HIGH & LOW LIMIT CONTROLS & OVERFILL PROTECTION.
- 2) FIELD WIRING TO FLOAT SWITCHES, SOLENOID VALVES, ACTUATOR VALVE, & ALARM HORN #14 AWG. ALL OTHER FIELD WIRING #12 AWG. LABEL BOTH ENDS OF ALL CONDUCTORS WITH CONTROL PANEL TERMINAL BLOCK TERMINATION NUMBERS. WHEN NOT IN CONDUIT, MAKE JACKETED COM CABLE ENCLOSURE ENTRIES WITH CABLE GLAND CONNECTORS.
- 3) PERFORM ALL FIELD WIRING IN ACCORDANCE WITH ELECTRICAL SPECIFICATIONS ON SHEET E2. PROVIDE POWER TO DAY TANK PANEL FROM DEDICATED 20A 2-POLE CIRCUIT BREAKER IN STATION SERVICE PANELBOARD.
- 4) VERIFY THAT ALL DAY TANK FLOAT SWITCHES ARE ORIENTED FOR N.C. (OPEN ON RISE) OPERATION PRIOR TO INSTALLATION. ALL FLOATS SHOWN ON LOGIC DIAGRAM WITH TANK AT FULL (PUMP STOP) LEVEL. VERIFY THAT THE HOPPER FLOAT SWITCH IS ORIENTED FOR N.O. (CLOSE ON RISE) OPERATION.
- 5) FILL PUMP CAVITIES WITH LUBE OIL PRIOR TO INITIAL OPERATION. VERIFY PROPER ROTATION OF PUMPS. PRIME SYSTEM WITH HAND PRIMING PUMP PRIOR TO BEGINNING DAY TANK FILL.
- 6) FIELD TEST COMPLETED UNIT TO VERIFY ALL CONTROL AND ALARM FUNCTIONS. MANIPULATE FLOAT SWITCHES BY REACHING IN THROUGH ADJACENT 4" BUNG. TEMPORARILY SET TIMING RELAY TO 30 SECONDS TO VERIFY TIME-OUT AND RESET FUNCTIONS.
- 7) SET TIMING RELAY TIME DELAY TO 30 MINUTES (APPROX. 55 GALS. REQUIRED FROM PUMP START TO PUMP STOP LEVEL @ APPROX. 4 GPM). ON THE INITIAL TANK FILL, THE PUMP TEST/RESET BUTTON MAY HAVE TO BE MANUALLY RESET IN ORDER TO GET THE FUEL LEVEL TO WITHIN THE NORMAL OPERATING RANGE. SEE SEQUENCE OF OPERATIONS.

**DAY TANK FILL SEQUENCE OF OPERATIONS:**


- 1) WHEN THE DAY TANK CIRCUIT BREAKER AND CONTROL POWER SWITCH ARE CLOSED, THE POWER LIGHT IS ON AND POWER IS PROVIDED TO THE REMOTE ACTUATOR VALVE HEATER/OPEN LIGHT CIRCUIT.
- 2) WHEN THE DAY TANK IS NOT CALLING FOR FUEL, POWER IS PROVIDED TO THE REMOTE ACTUATOR VALVE CLOSE CIRCUIT. WHEN THE ACTUATOR IS IN THE FULLY CLOSED POSITION, THE CLOSING CIRCUIT IS BROKEN BY INTERNAL ACTUATOR LIMIT SWITCH #2 AND THE REMOTE ACTUATOR VALVE "OPEN" LIGHT IS OFF.
- 3) NORMAL FILL OPERATION - WHEN THE FUEL LEVEL DROPS TO THE "PUMP START" SWITCH, THE TIMER IS STARTED, THE N.C. DAY TANK SOLENOID VALVE OPENS, THE REMOTE ACTUATOR VALVE OPENS & THE VALVE "OPEN" LIGHT TURNS ON, THE DAY TANK PUMP IS ENERGIZED, THE PUMP "ON" LIGHT TURNS ON, AND THE USED OIL BLENDER RUN SIGNAL DRY CONTACT CLOSURES. WHEN THE ACTUATOR IS IN THE FULLY OPEN POSITION, THE OPENING CIRCUIT IS BROKEN BY INTERNAL ACTUATOR LIMIT SWITCH #7 AND THE REMOTE ACTUATOR VALVE "OPEN" LIGHT REMAINS ON. WHEN FUEL REACHES THE "PUMP STOP" FLOAT SWITCH BEFORE THE TIMER TIMES-OUT, THE TIMER IS RESET, THE N.C. DAY TANK SOLENOID VALVE AND REMOTE ACTUATOR VALVE CLOSE, THE REMOTE ACTUATOR VALVE "OPEN" LIGHT TURNS OFF, THE PUMP DE-ENERGIZES, THE PUMP "ON" LIGHT TURNS OFF, AND THE USED OIL BLENDER RUN SIGNAL DRY CONTACT OPENS.
- 4) TIMER OPERATION - IF THE TIMER TIMES-OUT THE N.C. DAY TANK SOLENOID VALVE AND REMOTE ACTUATOR VALVE CLOSE, THE REMOTE ACTUATOR VALVE "OPEN" LIGHT TURNS OFF, THE PUMP DE-ENERGIZES, THE PUMP "ON" LIGHT TURNS OFF, THE USED OIL BLENDER RUN SIGNAL DRY CONTACT OPENS, THE "TIME-OUT" ALARM LIGHT TURNS ON, AND THE TIME-OUT ALARM HORN SOUNDS. PRESSING THE "TIME-OUT ALARM SILENCE / PUMP RESTART" BUTTON RESETS THE TIMER, SILENCES THE ALARM HORN, AND STARTS THE NORMAL FILL OPERATION. SEE FIELD INSTALLATION NOTES FOR TIMER SETTING.
- 5) OVERFILL FUEL LEVEL - IF THE TANK OVERFILLS AND THE FUEL LEVEL REACHES THE "OVERFILL" FLOAT SWITCH, THE N.O. DAY TANK SOLENOID VALVE CLOSURES, THE "OVERFILL LEVEL" ALARM LIGHT TURNS ON, THE N.C. DAY TANK SOLENOID VALVE AND REMOTE ACTUATOR VALVE CLOSE, THE VALVE "OPEN" LIGHT TURNS OFF, THE PUMP DE-ENERGIZES, THE PUMP "ON" LIGHT TURNS OFF, THE USED OIL BLENDER RUN SIGNAL DRY CONTACT OPENS, THE "OVERFILL LEVEL" ALARM LIGHT TURNS ON, AND THE ALARM HORN SOUNDS. PRESSING THE LEVEL ALARM HORN "SILENCE" BUTTON SILENCES THE ALARM HORN WHILE LEAVING THE "OVERFILL LEVEL" ALARM LIGHT ON. WHEN THE FUEL LEVEL FALLS BELOW THE "OVERFILL" FLOAT SWITCH, THE "OVERFILL LEVEL" ALARM LIGHT TURNS OFF, THE N.O. DAY TANK SOLENOID VALVE OPENS AND THE ALARM HORN TURNS OFF (IF NOT PREVIOUSLY SILENCED). WHEN THE FUEL LEVEL REACHES THE "PUMP START" FLOAT SWITCH, THE NORMAL FILL OPERATION IS REPEATED.
- 6) LOW FUEL LEVEL - IF THE FUEL LEVEL FALLS BELOW THE "LOW ALARM" FLOAT SWITCH, THE "LOW FUEL LEVEL" ALARM LIGHT TURNS ON, THE ENGINE RUN-DRY PREVENTION DRY CONTACT OPENS, AND THE ALARM HORN SOUNDS. THE LEVEL ALARM HORN "SILENCE" BUTTON SILENCES THE ALARM HORN WHILE LEAVING THE "LOW FUEL LEVEL" ALARM LIGHT ON. WHEN THE FUEL LEVEL RISES ABOVE THE "LOW ALARM" FLOAT SWITCH THE "LOW FUEL LEVEL" ALARM LIGHT TURNS OFF, THE ENGINE RUN-DRY PREVENTION DRY CONTACT CLOSURES, AND THE ALARM HORN TURNS OFF (IF NOT PREVIOUSLY SILENCED).
- 7) PUMP & HORN TEST - MOMENTARY CONTACT BUTTONS ARE PROVIDED TO TEST FUNCTION OF THE DAY TANK PUMP AND ALARM HORN. PRESSING THE "PUSH TO TEST DAY TANK PUMP" BUTTON STARTS THE TIMER, MOMENTARILY OPENS THE N.C. DAY TANK SOLENOID VALVE & ACTUATED BALL VALVE, ENERGIZES THE DAY TANK PUMP, TURNS ON THE DAY TANK PUMP "RUNNING" LIGHT AND CLOSURES THE USED OIL BLENDER RUN SIGNAL DRY CONTACT. THE "PUSH TO TEST DAY TANK PUMP" BUTTON IS LOCKED OUT IF THE DAY TANK IS AT THE OVERFILL LEVEL. PRESSING THE "PUSH TO TEST DAY TANK ALARM" BUTTON MOMENTARILY ENERGIZES THE ALARM HORN/STROBE.

**USED OIL BLENDER SYSTEM SEQUENCE OF OPERATIONS:**


- 1) WHEN THE BLENDER CIRCUIT BREAKER AND CONTROL POWER SWITCH ARE CLOSED; THE GREEN POWER LIGHT IS ON AND POWER IS PROVIDED TO ALL CONTROL DEVICES.
- 2) NORMAL OPERATION - WHENEVER THE DAY TANK FILL SEQUENCE IS INITIATED, BOTH THE DIESEL CIRCULATING PUMP P-DF2 AND THE USED OIL INJECTION PUMP P-U02 RUN AND THE ASSOCIATED GREEN PUMP RUNNING LIGHTS ARE ON.
- 3) PLUGGED FILTER - IF THE DIFFERENTIAL PRESSURE ACROSS A FILTER REACHES THE ALARM SETPOINT, BOTH PUMPS STOP RUNNING AND THE RED FILTER PLUGGED LIGHT FOR THE ASSOCIATED FILTER TURNS ON. THE ALARM LATCHES AND THE SYSTEM WILL NOT OPERATE UNTIL THE PROBLEM IS CORRECTED. AFTER THE FILTER ELEMENT HAS BEEN CHANGED THE BLACK RESET BUTTON MUST BE PRESSED TO RESUME NORMAL OPERATION.
- 4) HOPPER LOW OIL LEVEL - WHEN THE OIL LEVEL FALLS BELOW THE LOW LEVEL FLOAT SWITCH, USED OIL INJECTION PUMP P-U02 STOPS RUNNING AND THE AMBER HOPPER LOW OIL LEVEL LIGHT TURNS ON. PUMP P-U02 WILL NOT OPERATE UNTIL THE USED OIL LEVEL IN THE HOPPER RISES ABOVE THE LOW LEVEL. RESET IS NOT REQUIRED.

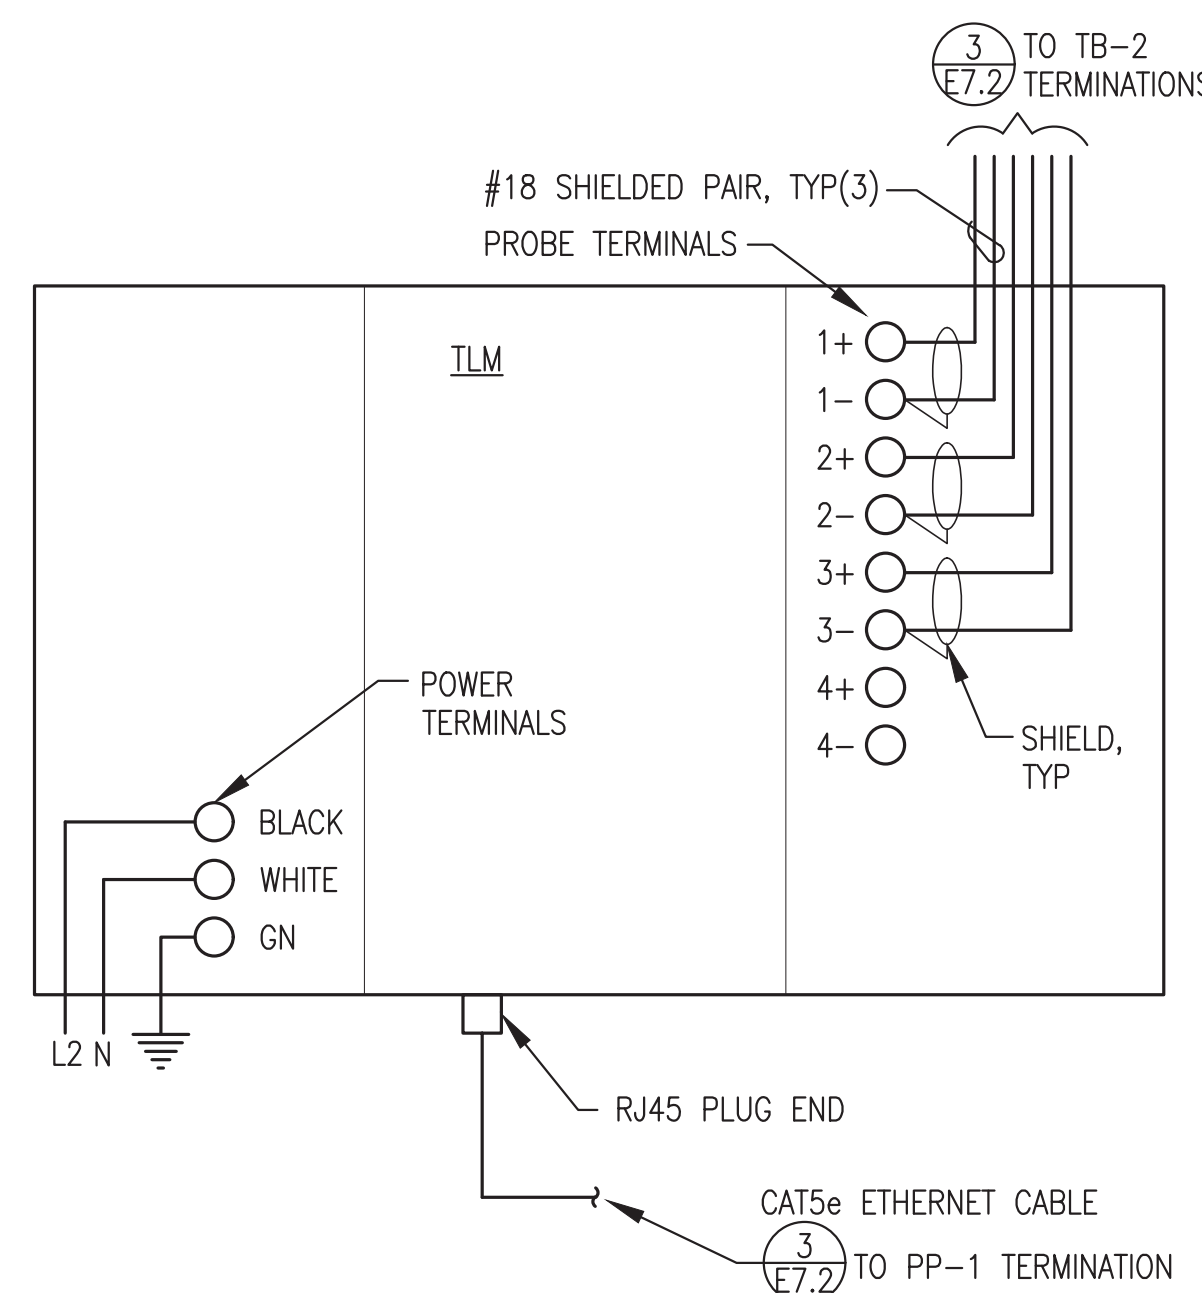

**1 TANK LEVEL MONITOR (TLM) CONSOLE CONNECTIONS**  
E7.3 NO SCALE

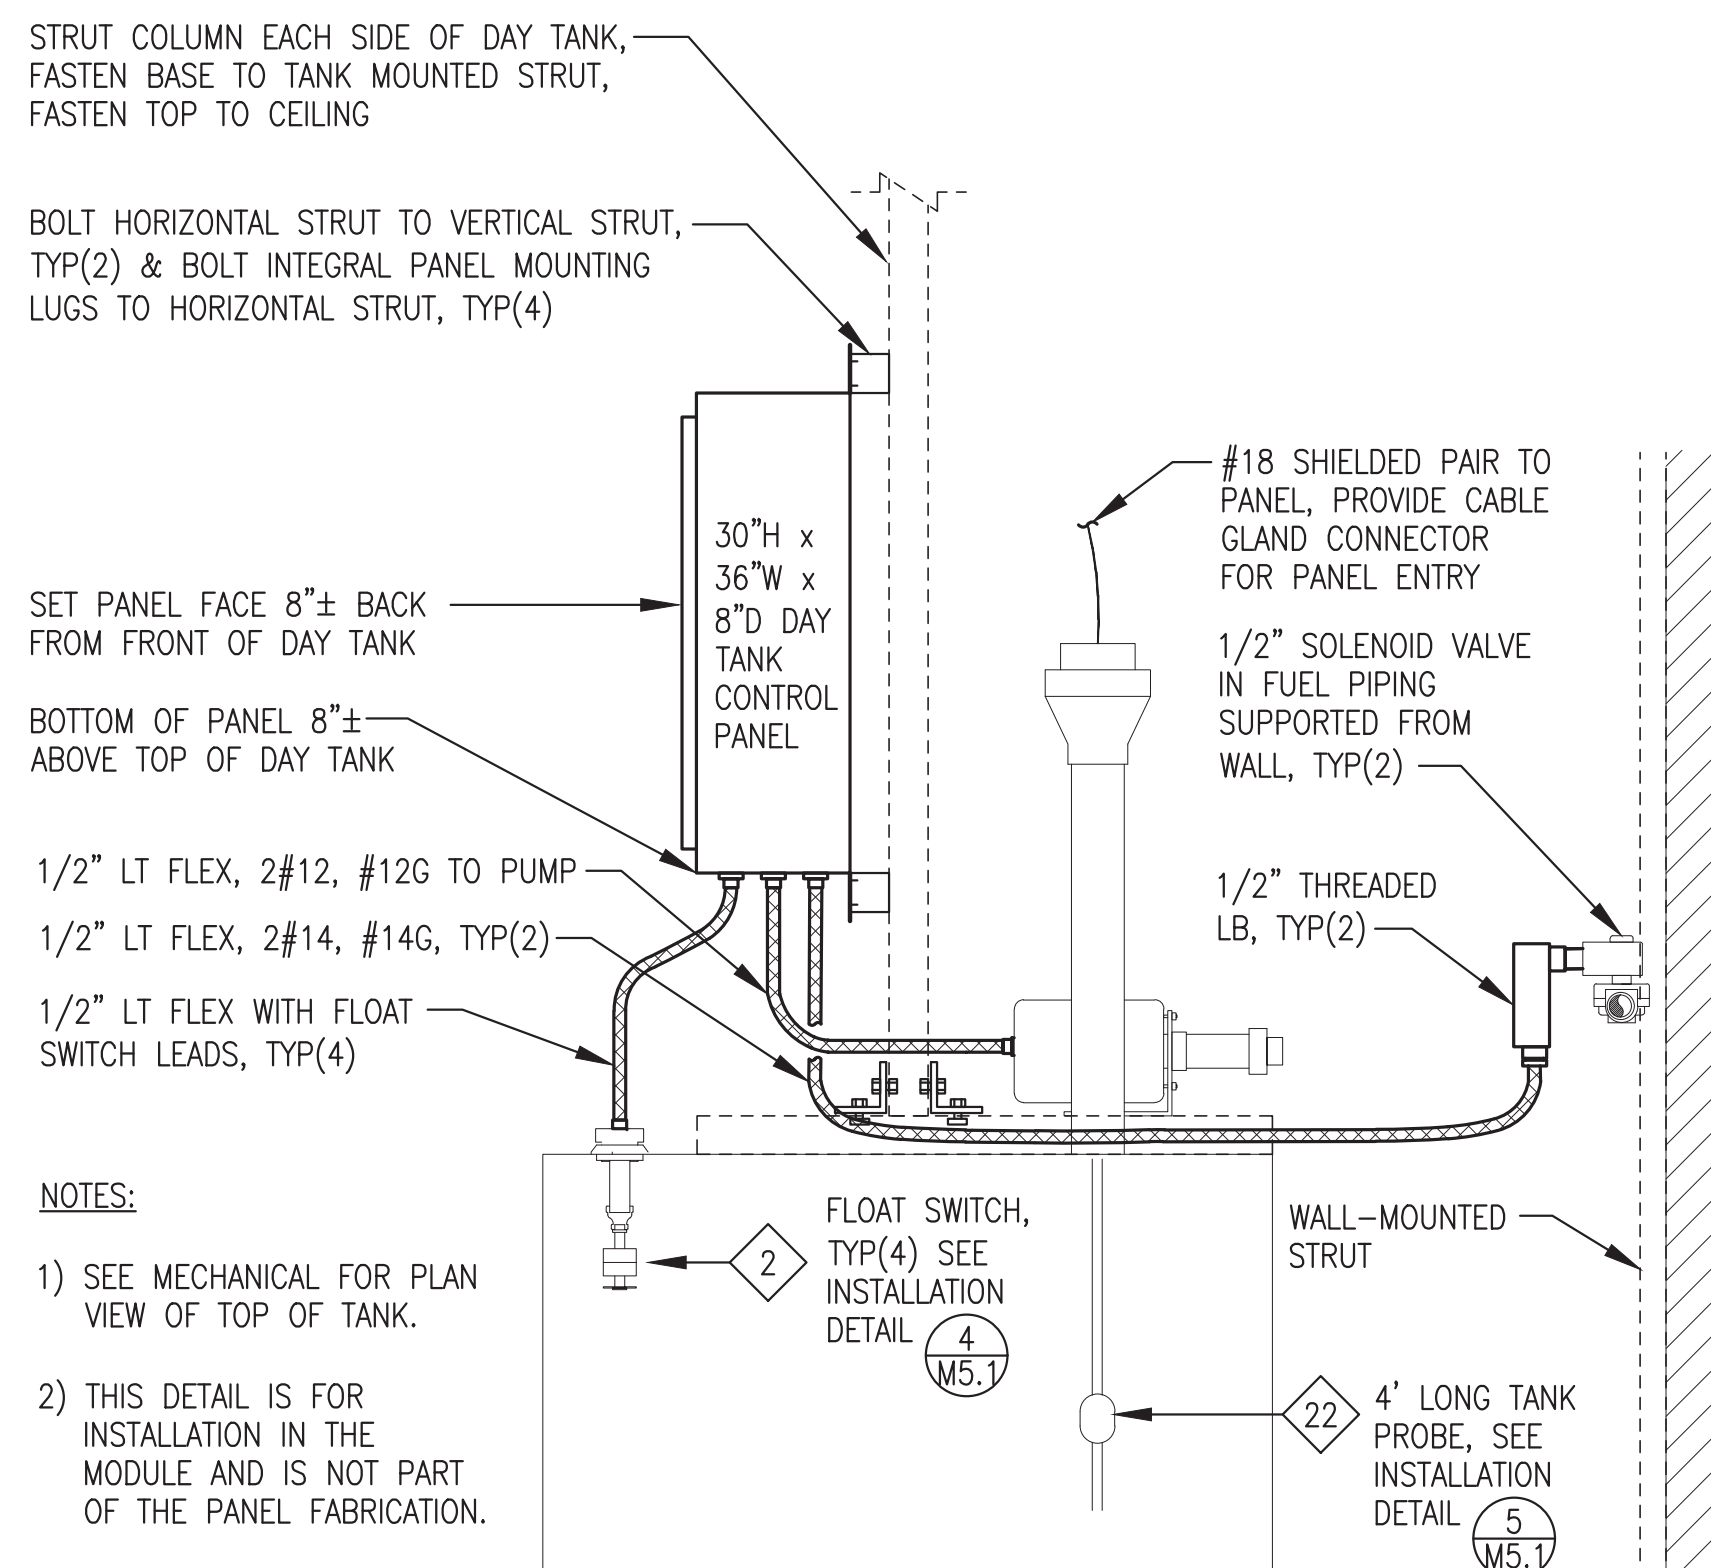

**2 DAY TANK CONTROL PANEL & DEVICE INSTALLATION**  
E7.3 NO SCALE

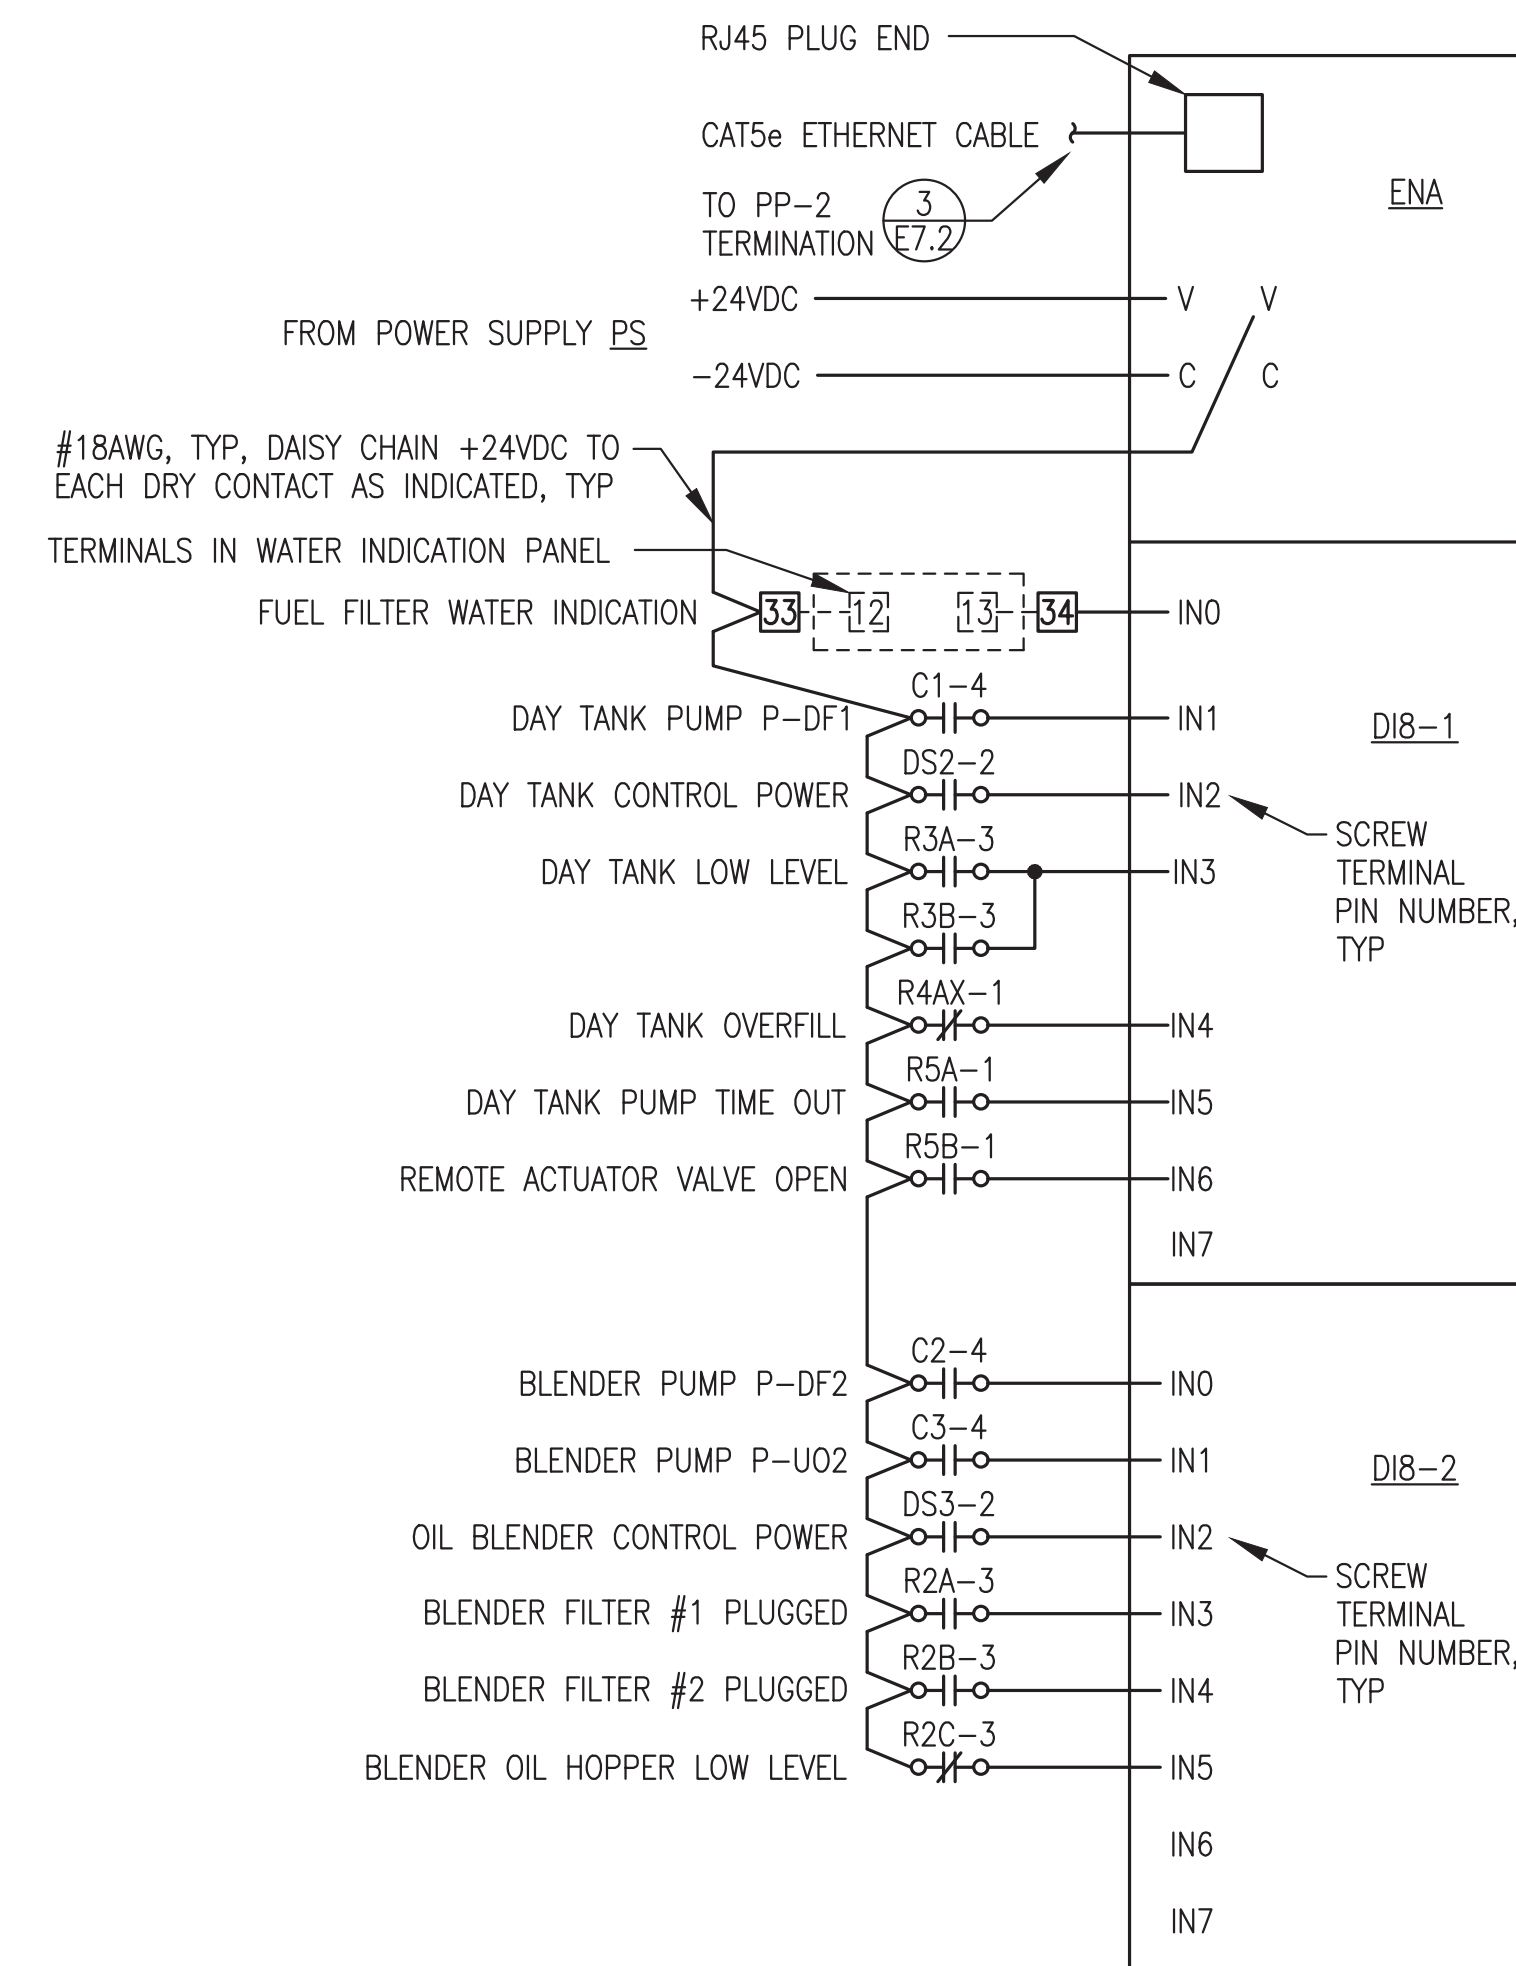

**3 ETHERNET POINT I/O CONNECTIONS**  
E7.3 NO SCALE


ALL WORK ON THIS SHEET WAS PERFORMED AS PART OF THE PRIOR MODULE ASSEMBLY CONTRACT AND IS SHOWN HERE FOR REFERENCE ONLY.

ISSUED FOR CONSTRUCTION MAY 2023




<p>ALASKA ENERGY AUTHORITY</p>	
PROJECT: NELSON LAGOON POWER SYSTEM UPGRADE	
TITLE: DAY TANK CONTROL PANEL NOTES, SEQUENCE OF OPERATIONS & INTERCONNECT DETAILS	
<p>Gray Stassel Engineering, Inc.</p>	DRAWN BY: BCG/JTD DESIGNED BY: CWV/BCG FILE NAME: NELS_PP_E7 PROJECT NUMBER:
SCALE: AS NOTED	DATE: 5/30/23
SHEET: <b>E7.3</b>	
P.O. 111405, Anchorage, AK 99511 (907)349-0100	




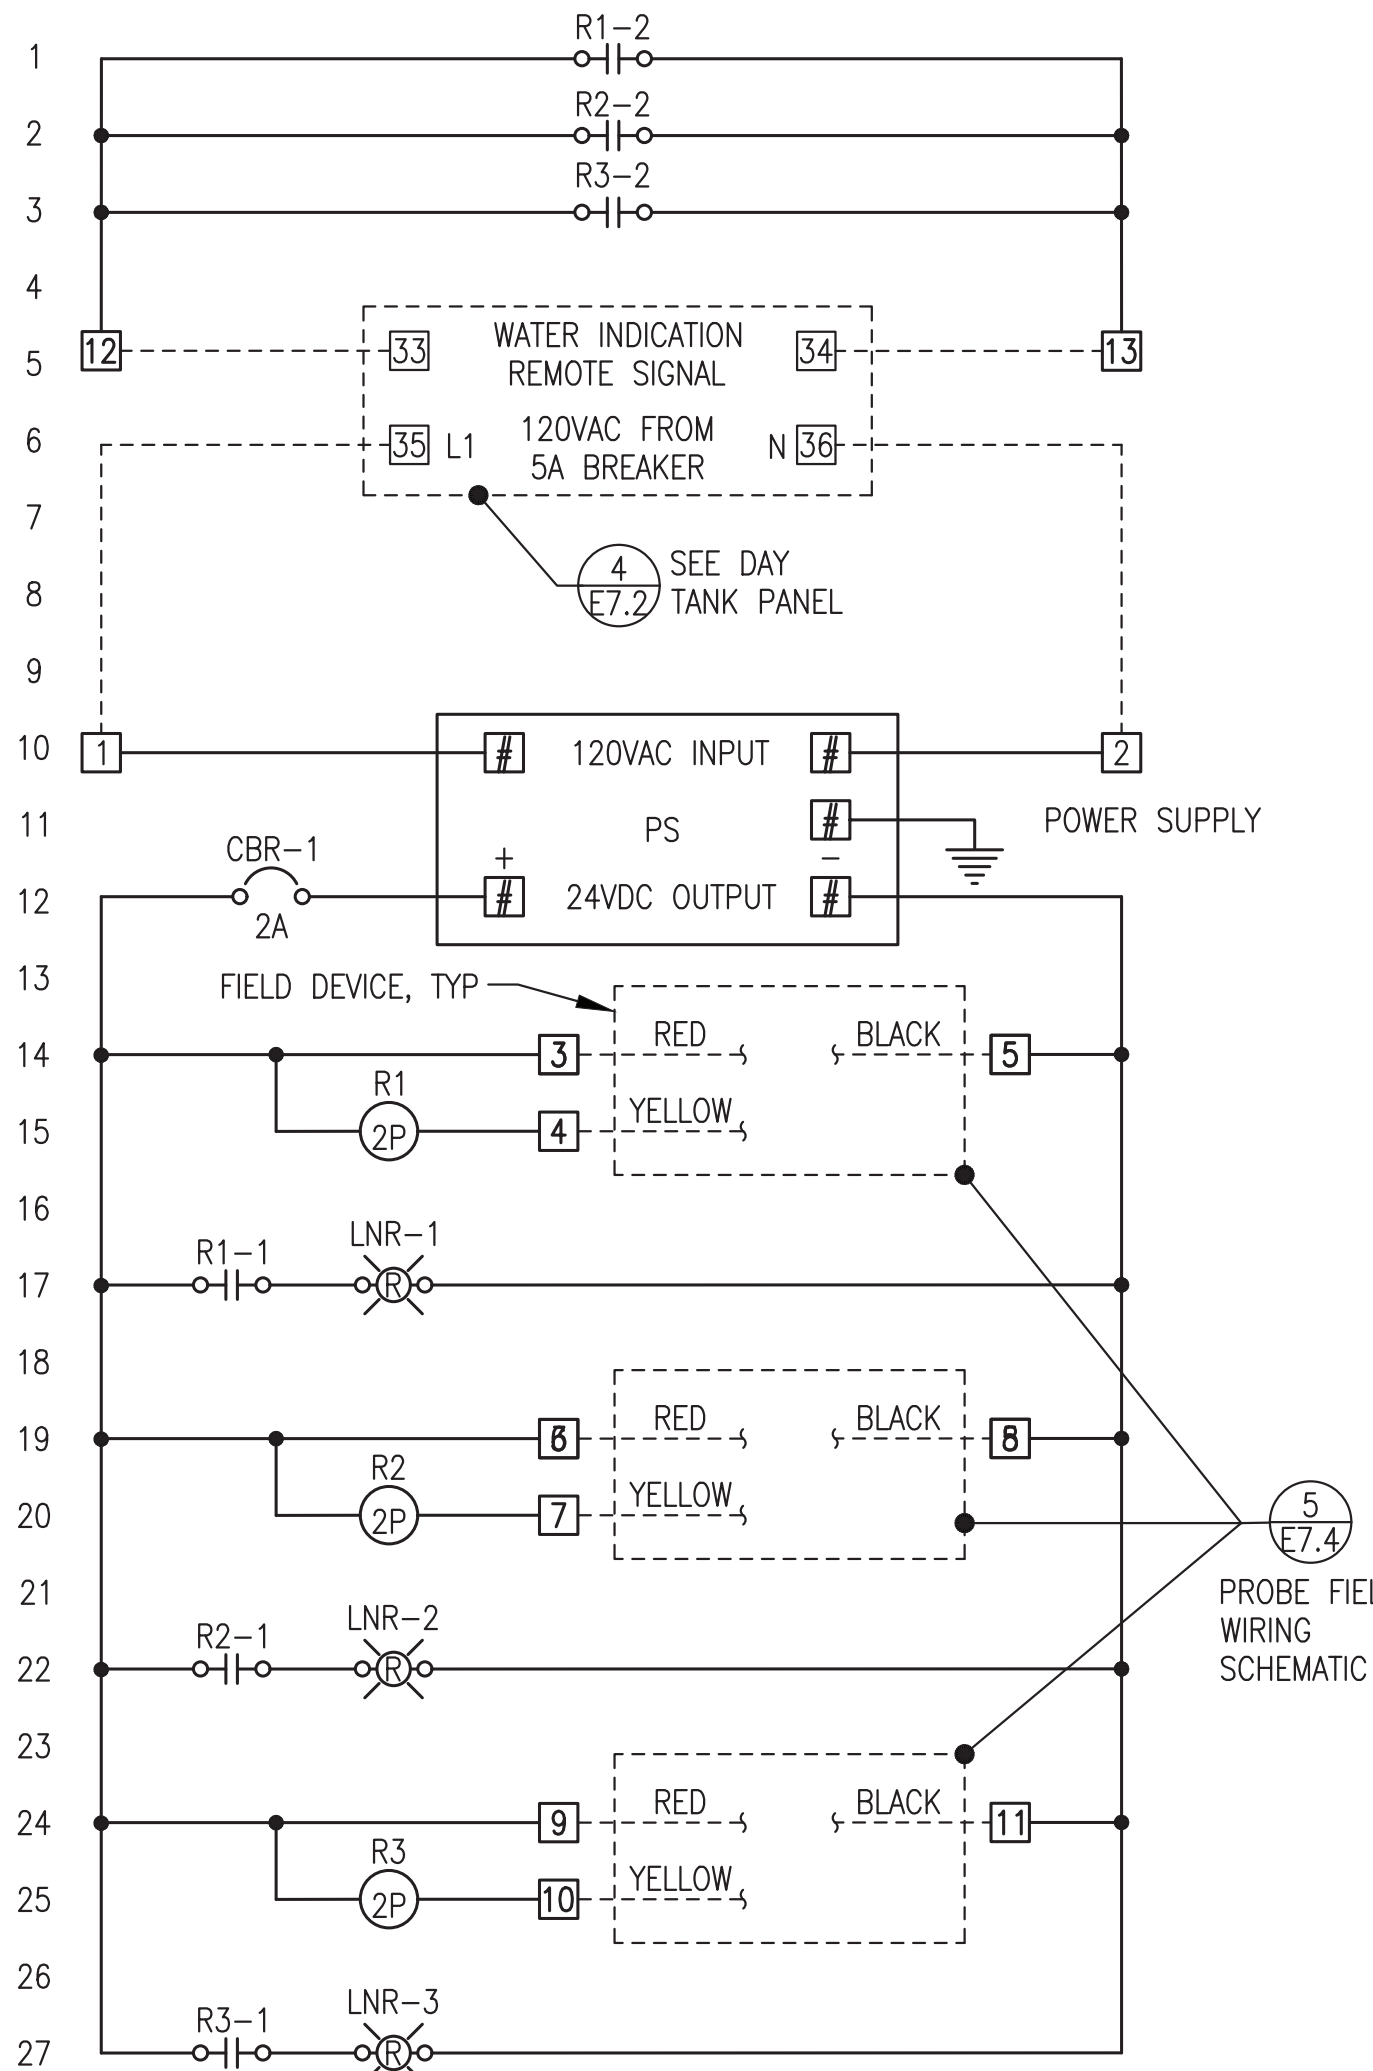

**1** PANEL WIRING DIAGRAM  
E7.4 NO SCALE

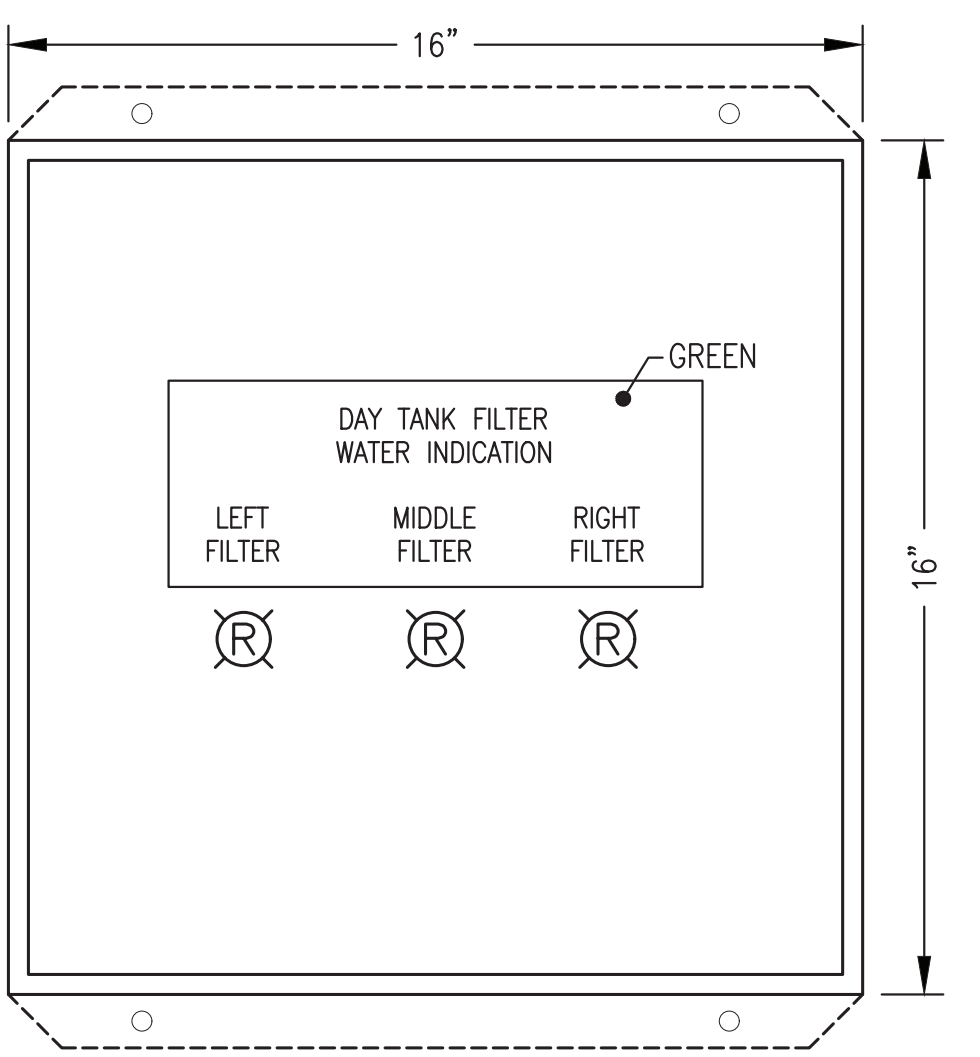

**2** FRONT PANEL LAYOUT  
E7.4 NO SCALE

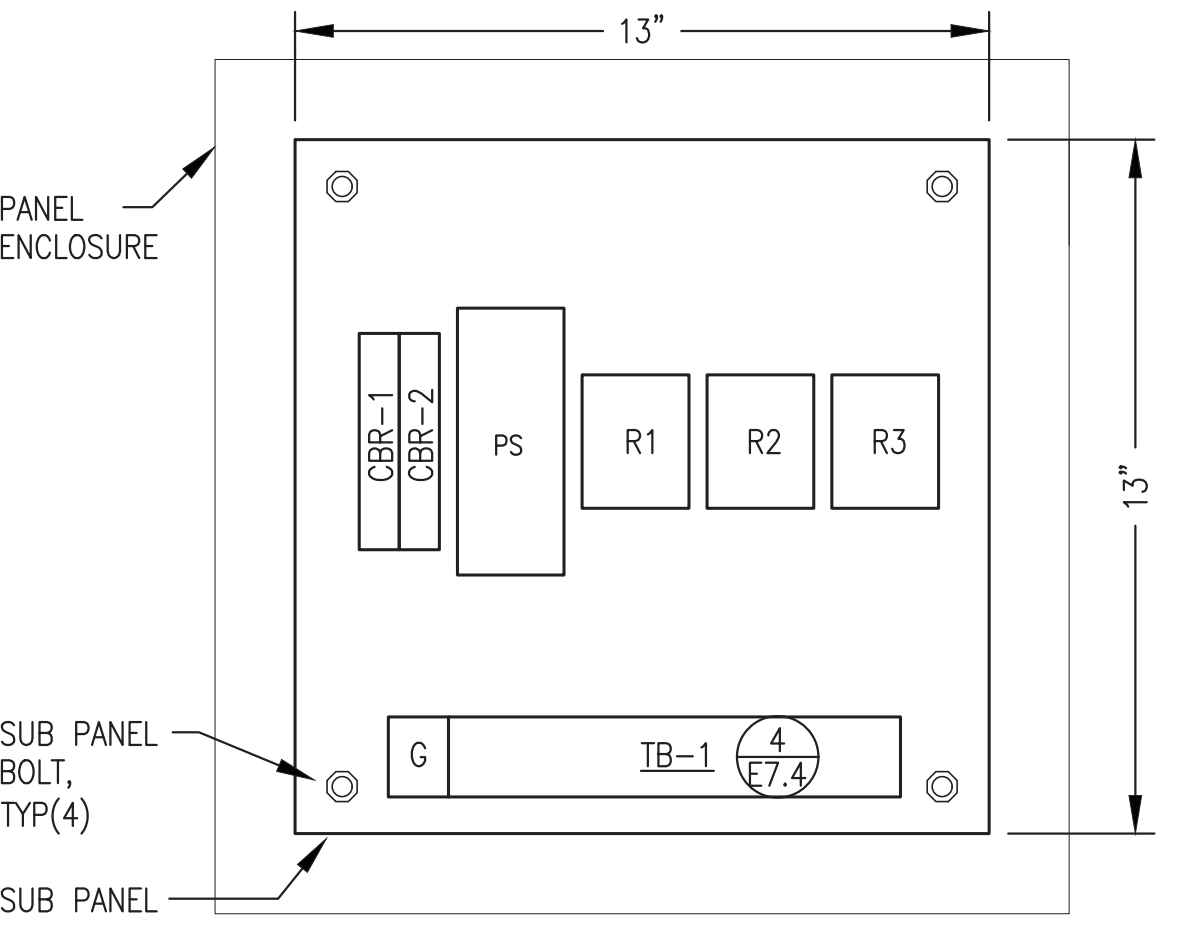


**3** SUB PANEL LAYOUT  
E7.4 NO SCALE

TAG	QTY	MANUFACTURER	MODEL	DESCRIPTION
CBR-1	1	ALLEN-BRADLEY	1489-M1-C020	RAIL-MOUNT CIRCUIT BREAKER, 1 POLE, 2A
LNR	3	ALLEN-BRADLEY	800HORH2R	RED LED PILOT LIGHT, 12-130V, NEMA 4X
PS	1	PULS	CP5.241-S1	5A, 120VAC/24VDC POWER SUPPLY
R	3	ALLEN-BRADLEY	700HA32A1	2PDT RELAY
	3	ALLEN-BRADLEY	700HN100	8 PIN SOCKET BASE
TB	15	ALLEN-BRADLEY	1492CAM1L	35A, 600V, LARGE-HEAD SCREW TERMINALS

**PANEL SHOP FABRICATION NOTES:**


- FURNISH COMPLETE PANEL ASSEMBLY WITH ALL DEVICES INDICATED IN WIRING DIAGRAM AND BILL OF MATERIALS ALONG WITH ALL PANEL DEVICE ACCESSORIES, DIN RAIL, & HARDWARE REQUIRED FOR COMPLETE INSTALLATION.
- INSTALL IN A 16"x16"x8" NEMA 12 STEEL ENCLOSURE WITH INTEGRAL MOUNTING FLANGES AT BACK, A MIN 16 GAUGE INTERIOR BACK PANEL, AND HINGED DOOR. ENCLOSURE COLOR ANSI 61 GRAY AND BACK PANEL COLOR WHITE.
- PROVIDE BEVELED EDGE WHITE CORE NAMEPLATES, FACE COLOR AS INDICATED. SECURE TO PANEL FACE WITH A MINIMUM OF TWO MOUNTING SCREWS.
- CONNECT DEVICES WITH MANUFACTURER PROVIDED CABLES IN ACCORDANCE WITH INSTALLATION INSTRUCTIONS.

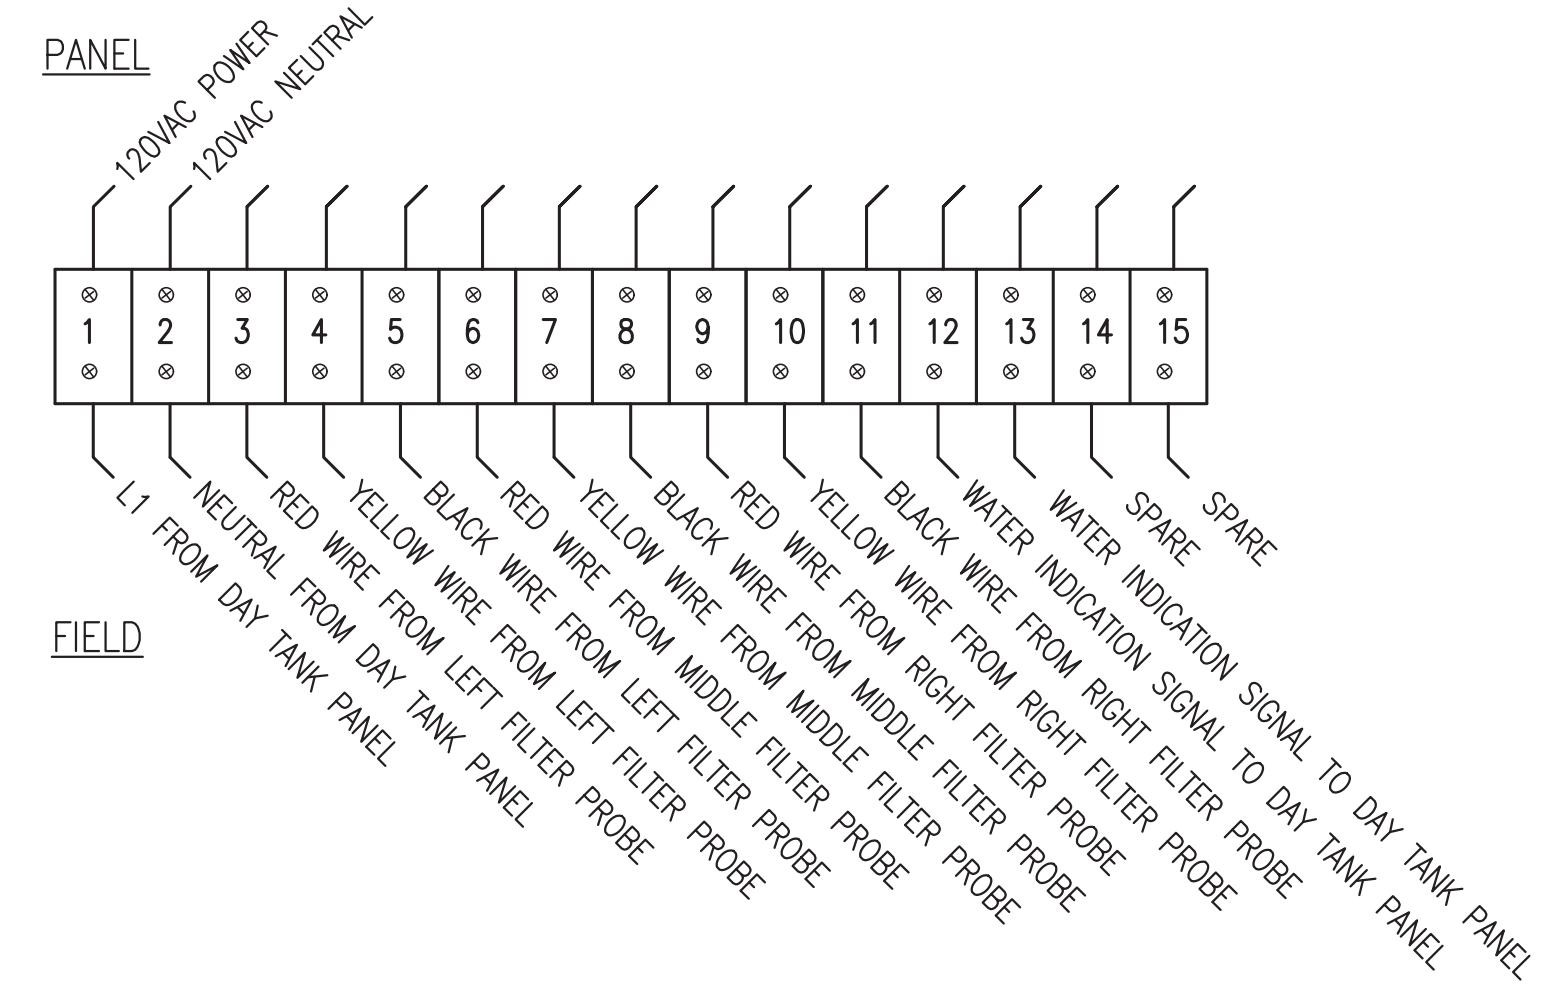

**NOTES:**

- INSTALL TERMINAL STRIP TB-1 HORIZONTALLY AS SHOWN. LOCATE TERMINAL STRIP BELOW WIRE TRAY TO ACCOMMODATE FIELD CONDUCTORS ENTERING BOTTOM OF PANEL, SEE SUB-PANEL LAYOUT.
- IN ADDITION TO THE TERMINAL STRIPS SHOWN, PROVIDE 2 EACH 60A SCREW TERMINAL GROUNDING BUS.

**4** TERMINAL STRIP TB-1 LAYOUT  
E7.4 NO SCALE

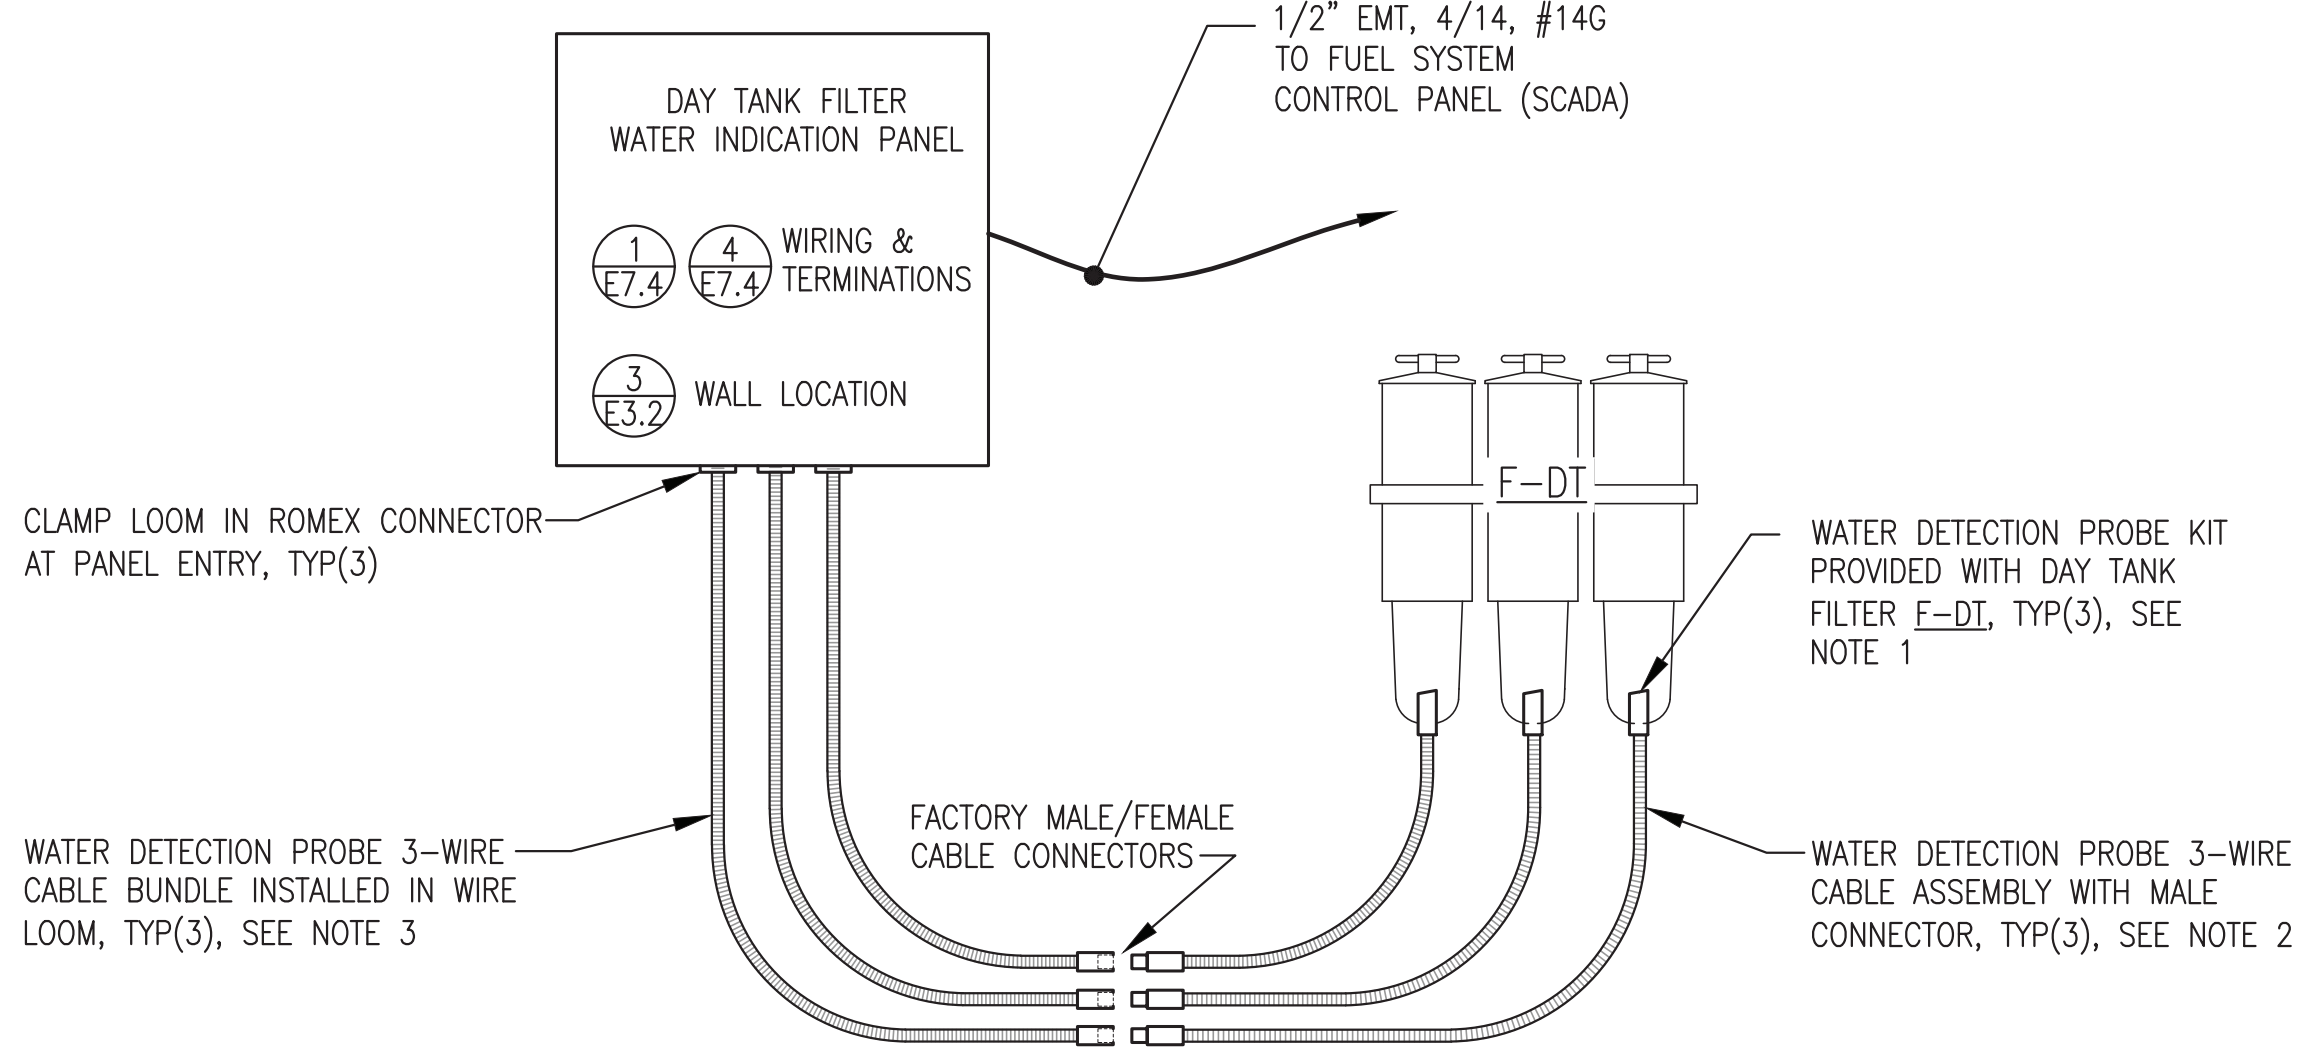


**5** FIELD WIRING SCHEMATIC  
E7.4 NO SCALE

**NOTES:**

- THREE EACH RACOR WATER DETECTION PROBE KITS, MODEL RK30880E, SHIPPED LOOSE WITH 3-FILTER BANK. NOT ALL KIT COMPONENTS USED THIS INSTALLATION. KEEP THREE EACH WATER DETECTION PROBE CABLES WITH MOLDED MALE CONNECTORS AND KEEP THREE EACH 3-WIRE CABLE BUNDLES WITH MOLDED FEMALE CONNECTORS. DISCARD THREE EACH PILOT LIGHTS AND DISCARD THREE EACH MOUNTING PANELS.
- PRIOR TO FLOODING SYSTEM WITH FUEL INSTALL WATER DETECTION PROBES IN EACH FILTER ACCORDING TO MANUFACTURER'S INSTRUCTIONS. ROUTE FACTORY LOOMED CABLES WITH MOLDED FEMALE CONNECTORS BACK TO WALL IN NEAT AND ORGANIZED FASHION FOR CONNECTION TO WIRE EXTENSION CONNECTORS. TYWRAP LOOM TO CONDUIT OR PIPING.
- FACTORY 3-WIRE CABLE BUNDLES FURNISHED WITH MOLDED MALE CONNECTORS. FIELD INSTALL IN 3/8" PLASTIC WIRE LOOM FROM CONNECTOR TO PANEL ENTRY AND ROUTE TO PANEL IN NEAT AND ORGANIZED FASHION. TYWRAP LOOM TO ADJACENT CONDUIT, PIPING, OR STRUT.

ALL WORK ON THIS SHEET WAS PERFORMED AS PART OF THE PRIOR MODULE ASSEMBLY CONTRACT AND IS SHOWN HERE FOR REFERENCE ONLY.




ISSUED FOR CONSTRUCTION  
MAY 2023

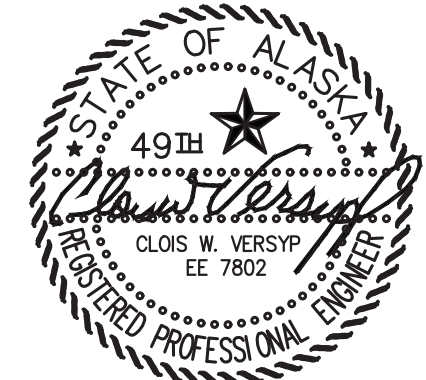

PROJECT: NELSON LAGOON POWER SYSTEM UPGRADE	
TITLE: DAY TANK FILTER WATER INDICATION PANEL	
DRAWN BY: BCG/JTD	SCALE: AS NOTED
DESIGNED BY: CWV/BCG	DATE: 5/30/23
FILE NAME: NELS_PP_E7	SHEET: <b>E7.4</b>
PROJECT NUMBER:	




P.O. 111405, Anchorage, AK 99511 (907)349-0100

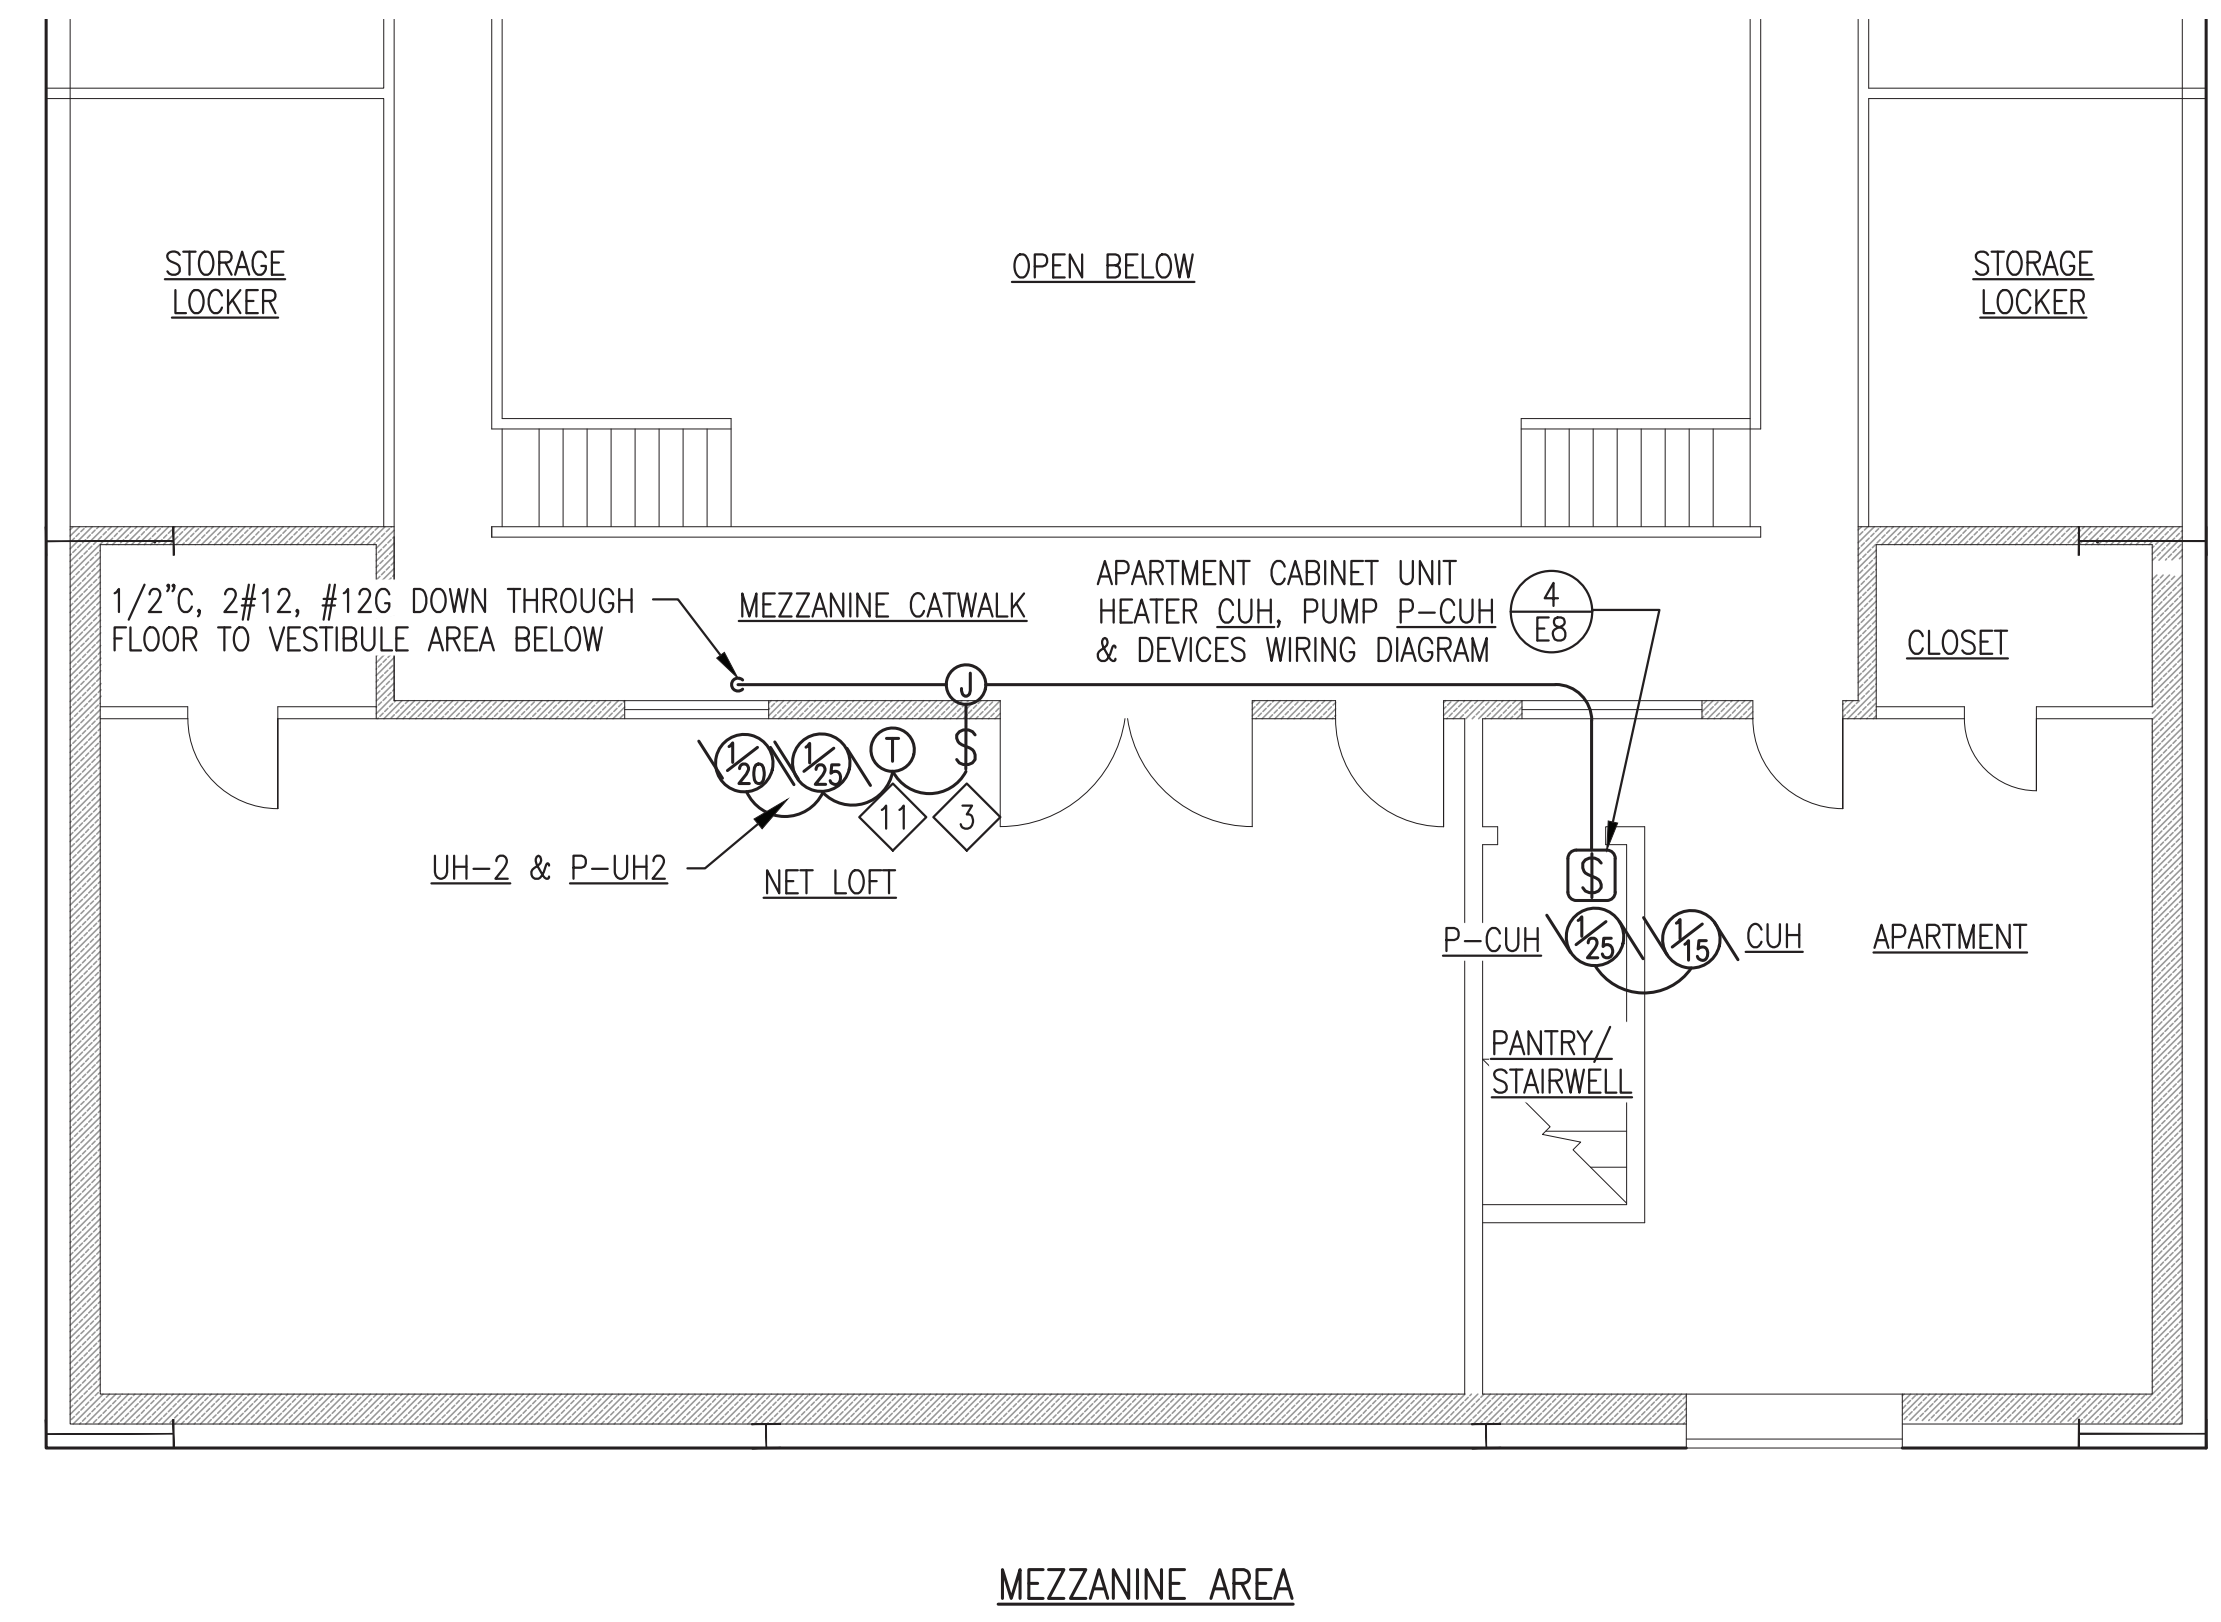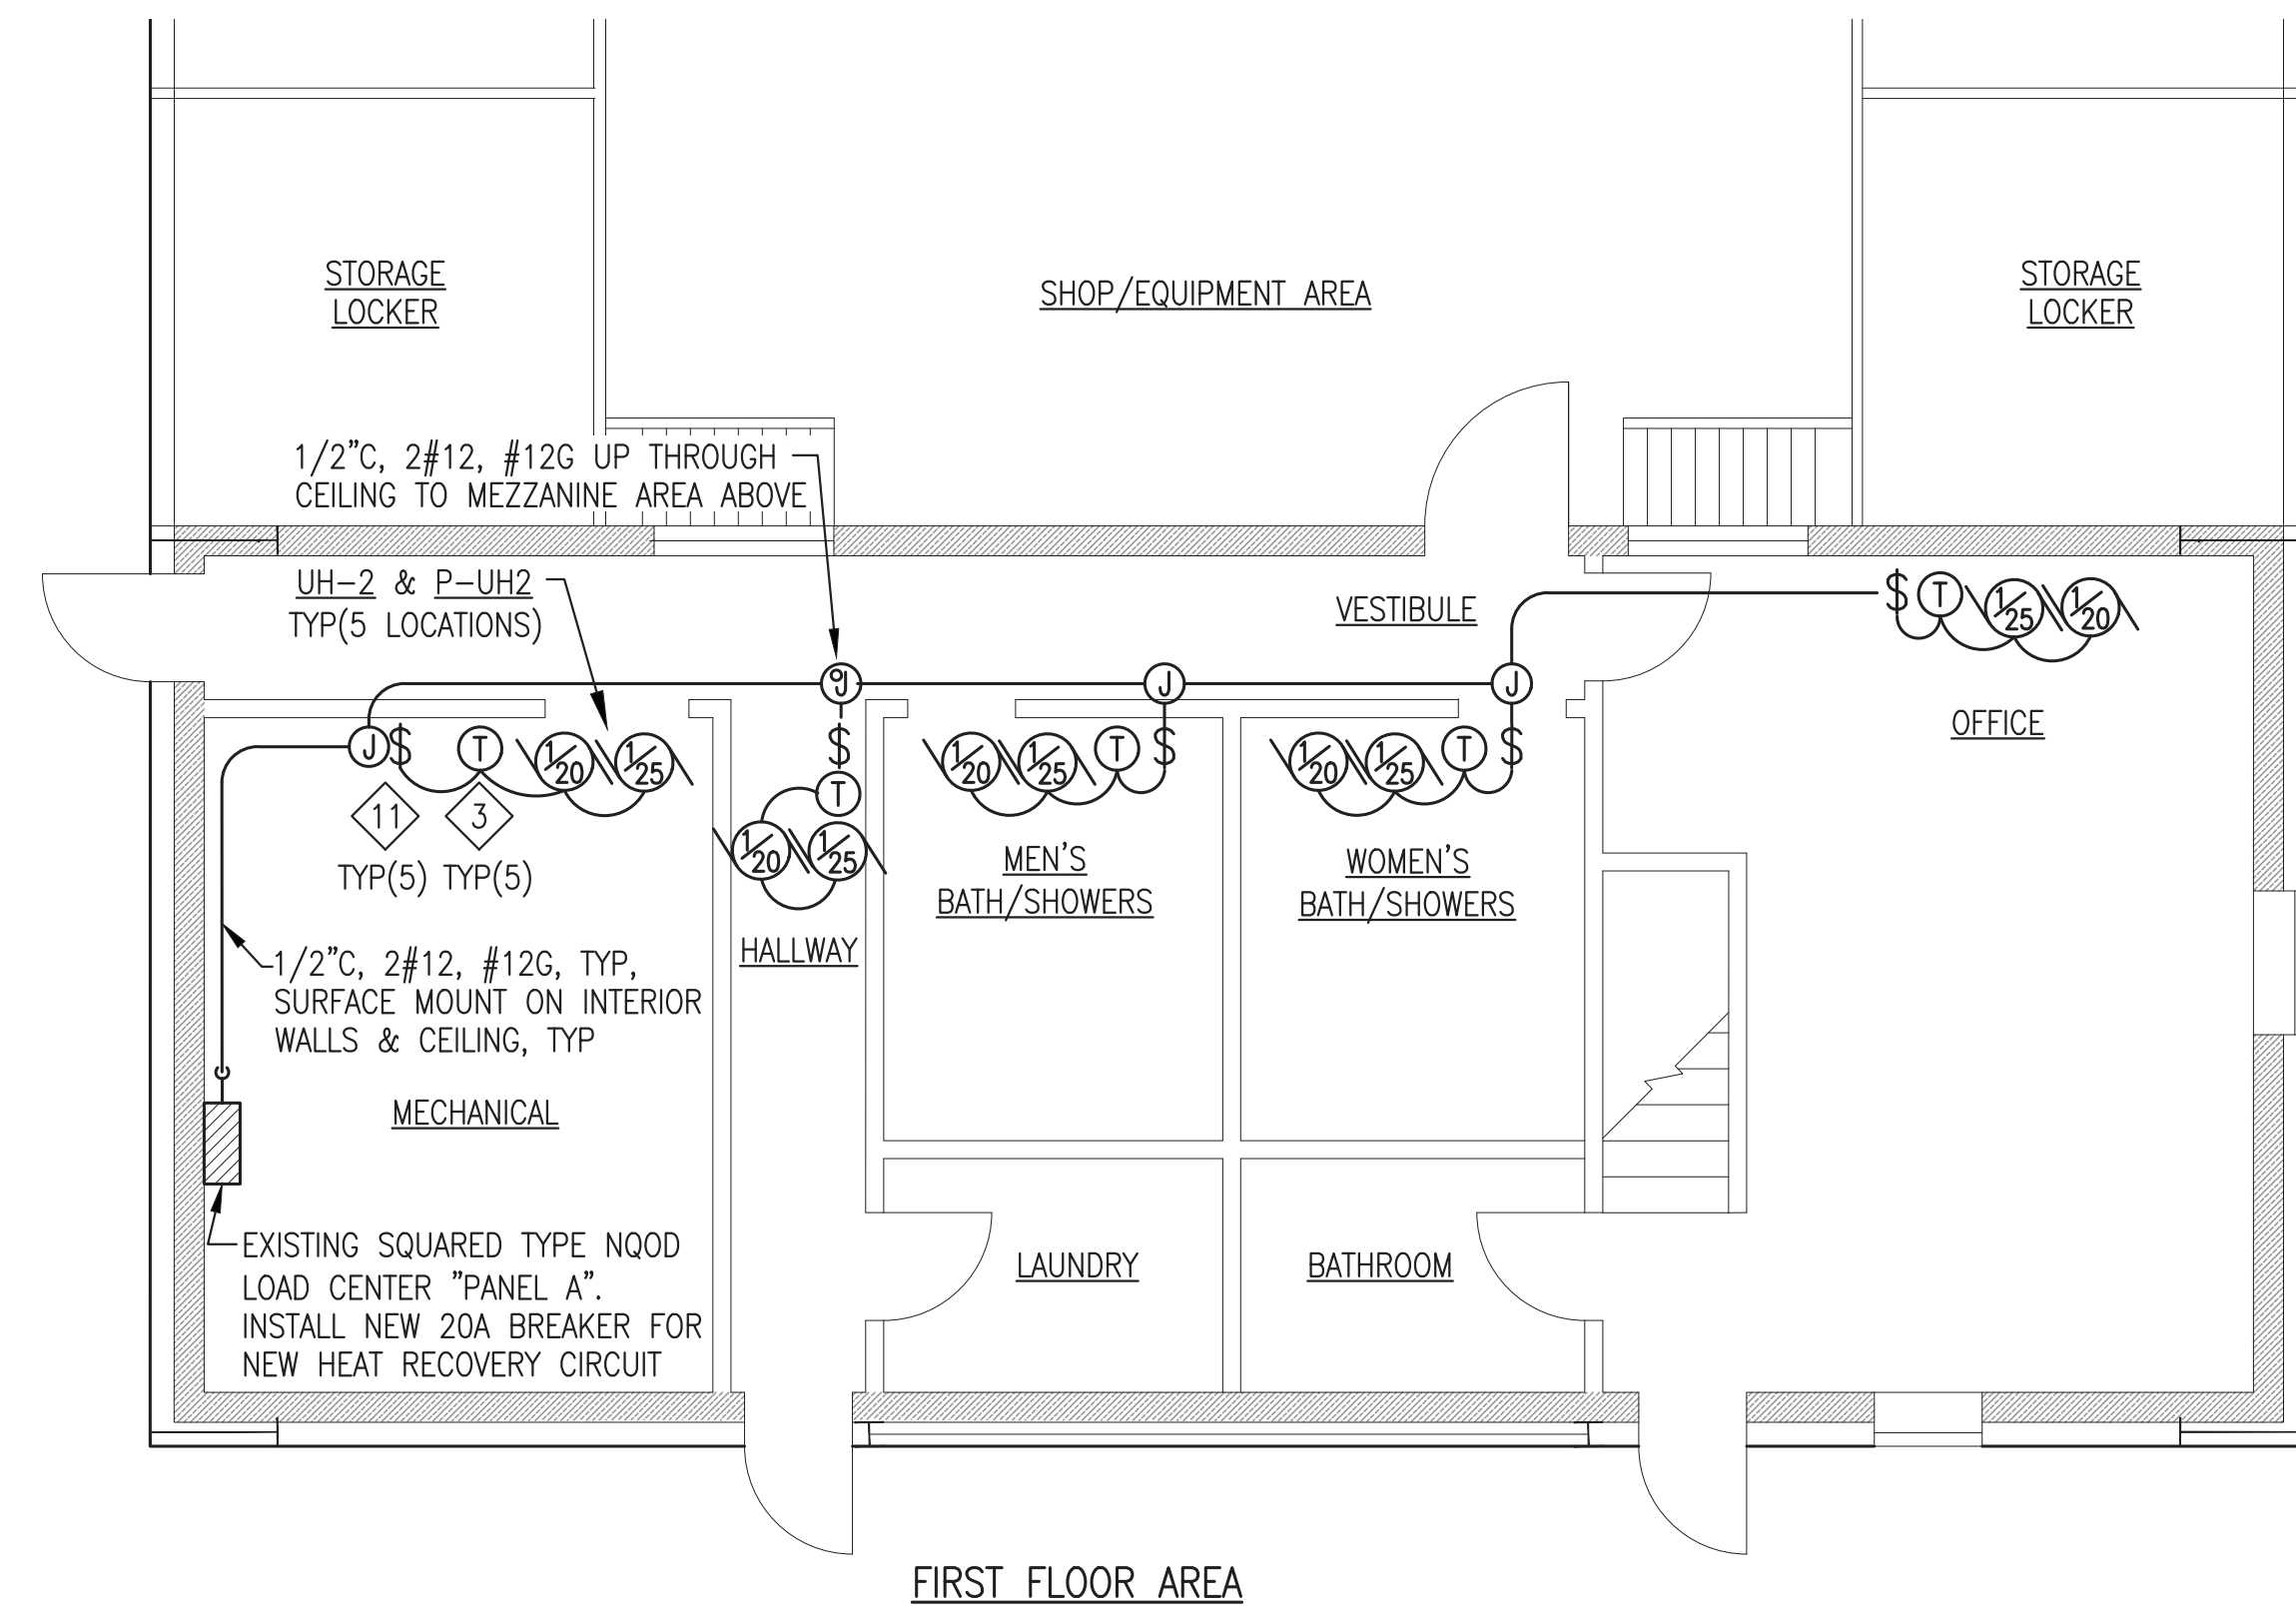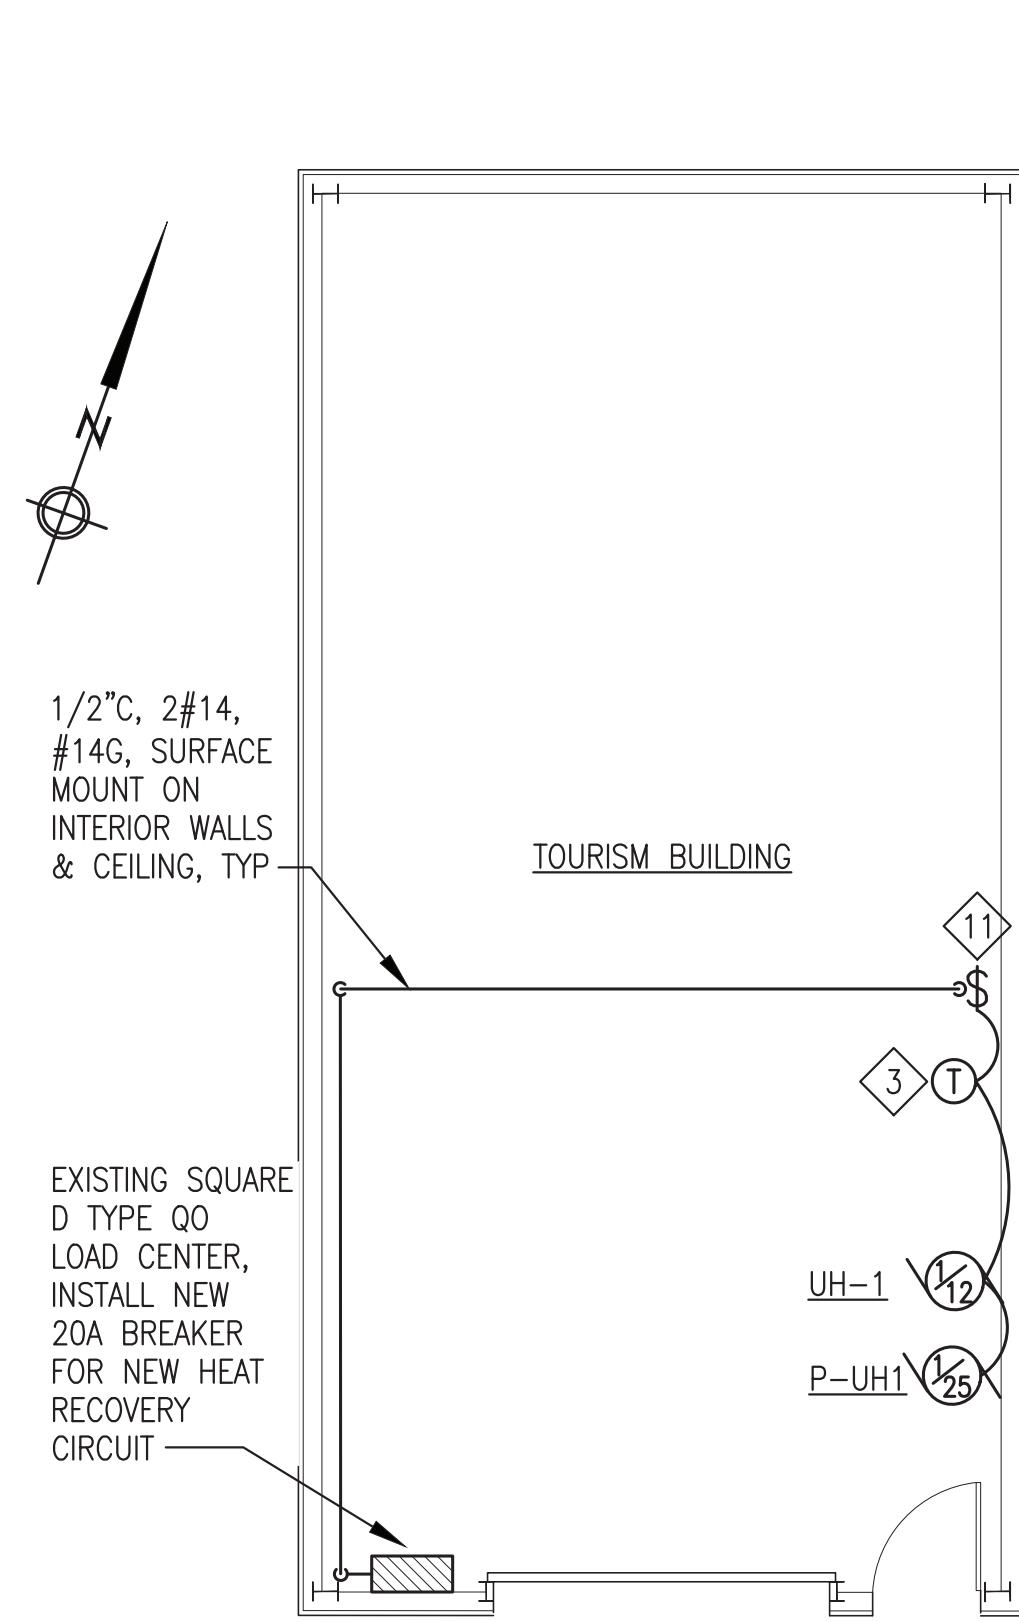


1 TOURISM BUILDING ELECTRICAL PLAN  
E8 1/2"=1'-0"

2 STORAGE COMPOUND ELECTRICAL PLAN  
E8 3/16"=1'-0"

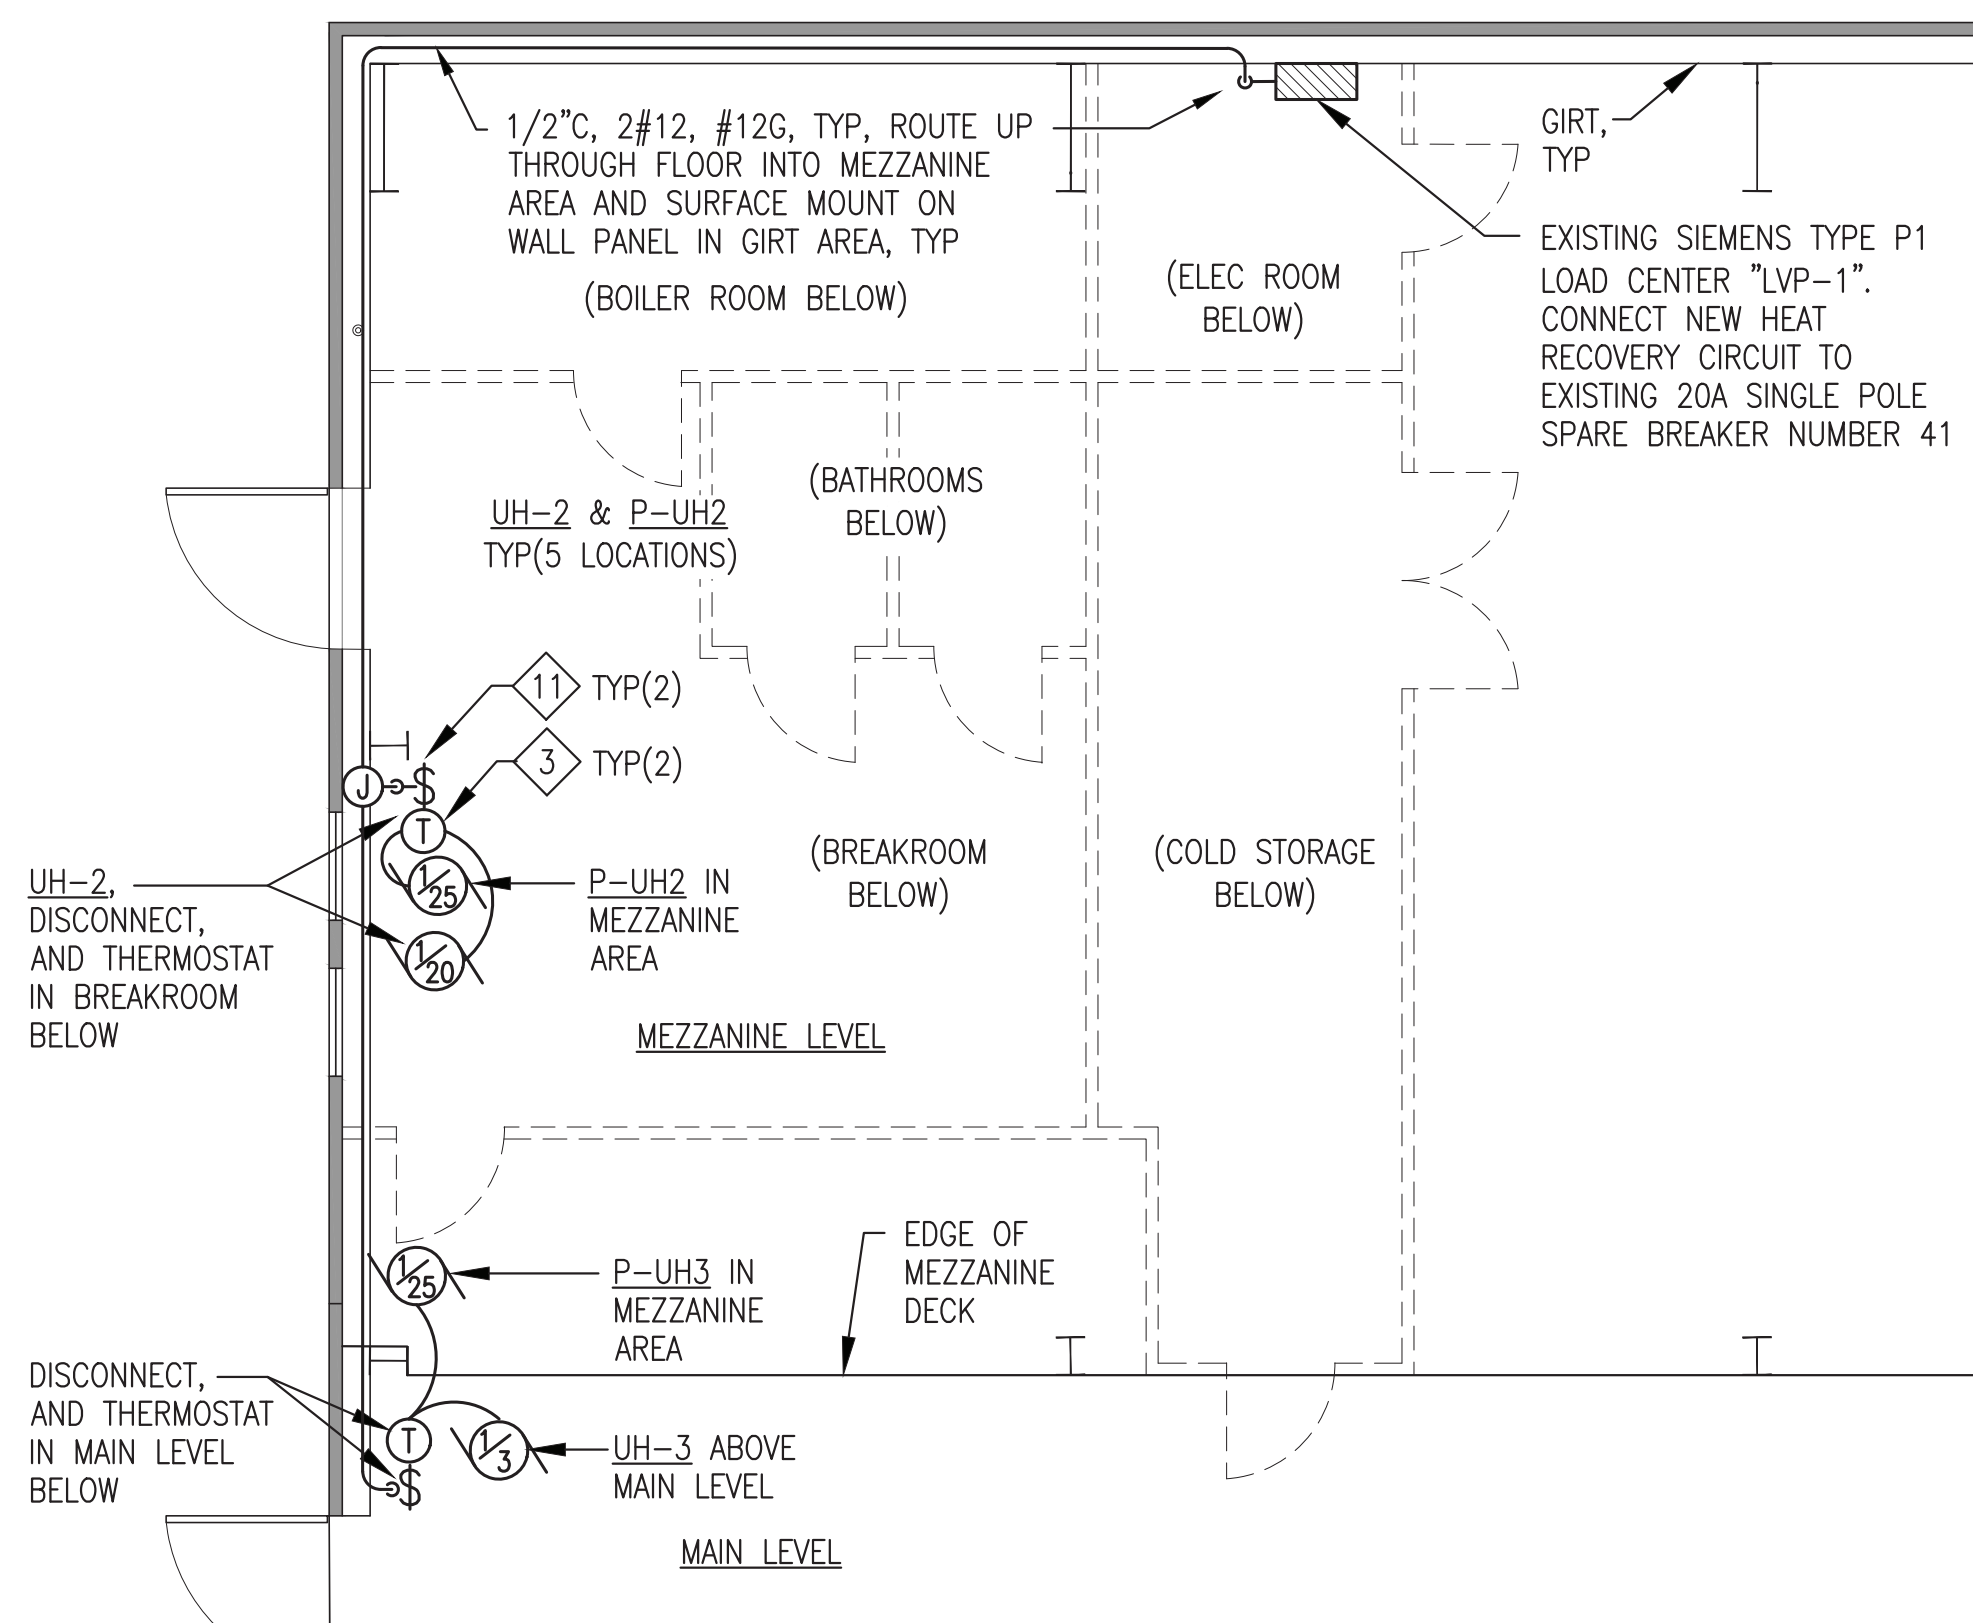

GENERAL NOTES:

- 1) SEE SHEET E1.2 FOR BUILDING LOCATIONS.
- 2) SEE MECHANICAL FOR EQUIPMENT INSTALLATION DETAILS IN EACH BUILDING.

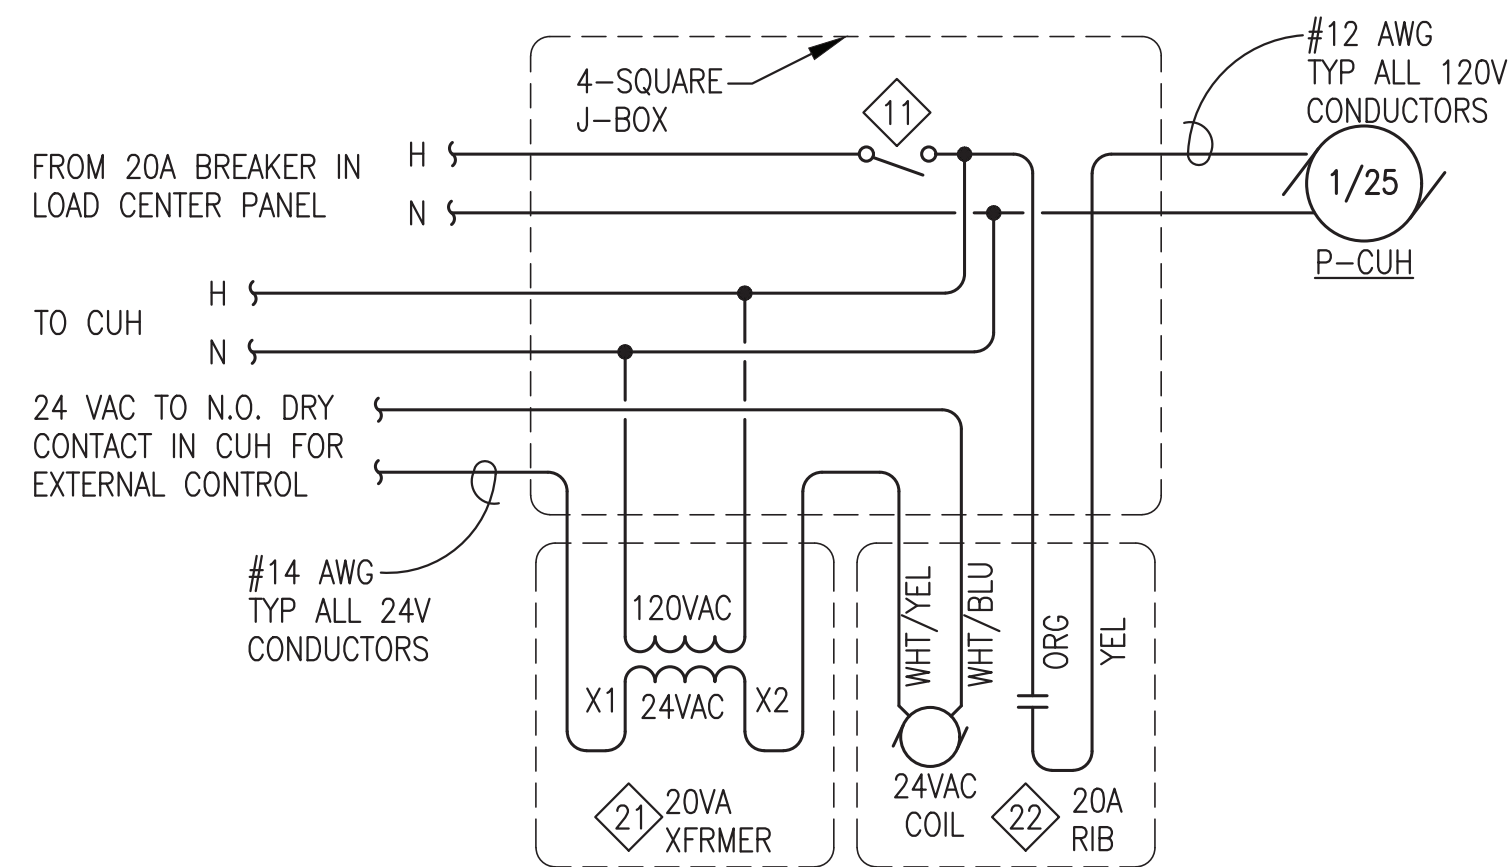

4 CUH WIRING DIAGRAM  
E8 NO SCALE

3 ICEHOUSE ELECTRICAL PLAN  
E8 3/16"=1'-0"

ALL WORK ON THIS SHEET IS INCLUDED IN THE ON SITE CONTRACT UNDER ADDITIVE ALTERNATE #1.



ISSUED FOR CONSTRUCTION  
MAY 2023





<p>ALASKA ENERGY AUTHORITY</p>	
PROJECT: NELSON LAGOON POWER SYSTEM UPGRADE	
TITLE: HEAT RECOVERY SYSTEM BUILDING A ELECTRICAL PLAN & DETAILS	
DESIGNED BY: BCG	SCALE: AS NOTED
DATE: 5/30/23	
FILE NAME: NELSS PP E8	SHEET: E8
P.O. 111405, Anchorage, AK 99511 (907)349-0100	PROJECT NUMBER:




G:\CE2 Data Files\AEA REG\Nelson Lagoon\TANK FARM BULK FUEL UPGRADES\As-Built Drawings\EA.dwg, 9/19/2022 11:01:20 AM, cmezr, AutoCAD PDF (General Documentation).pc3

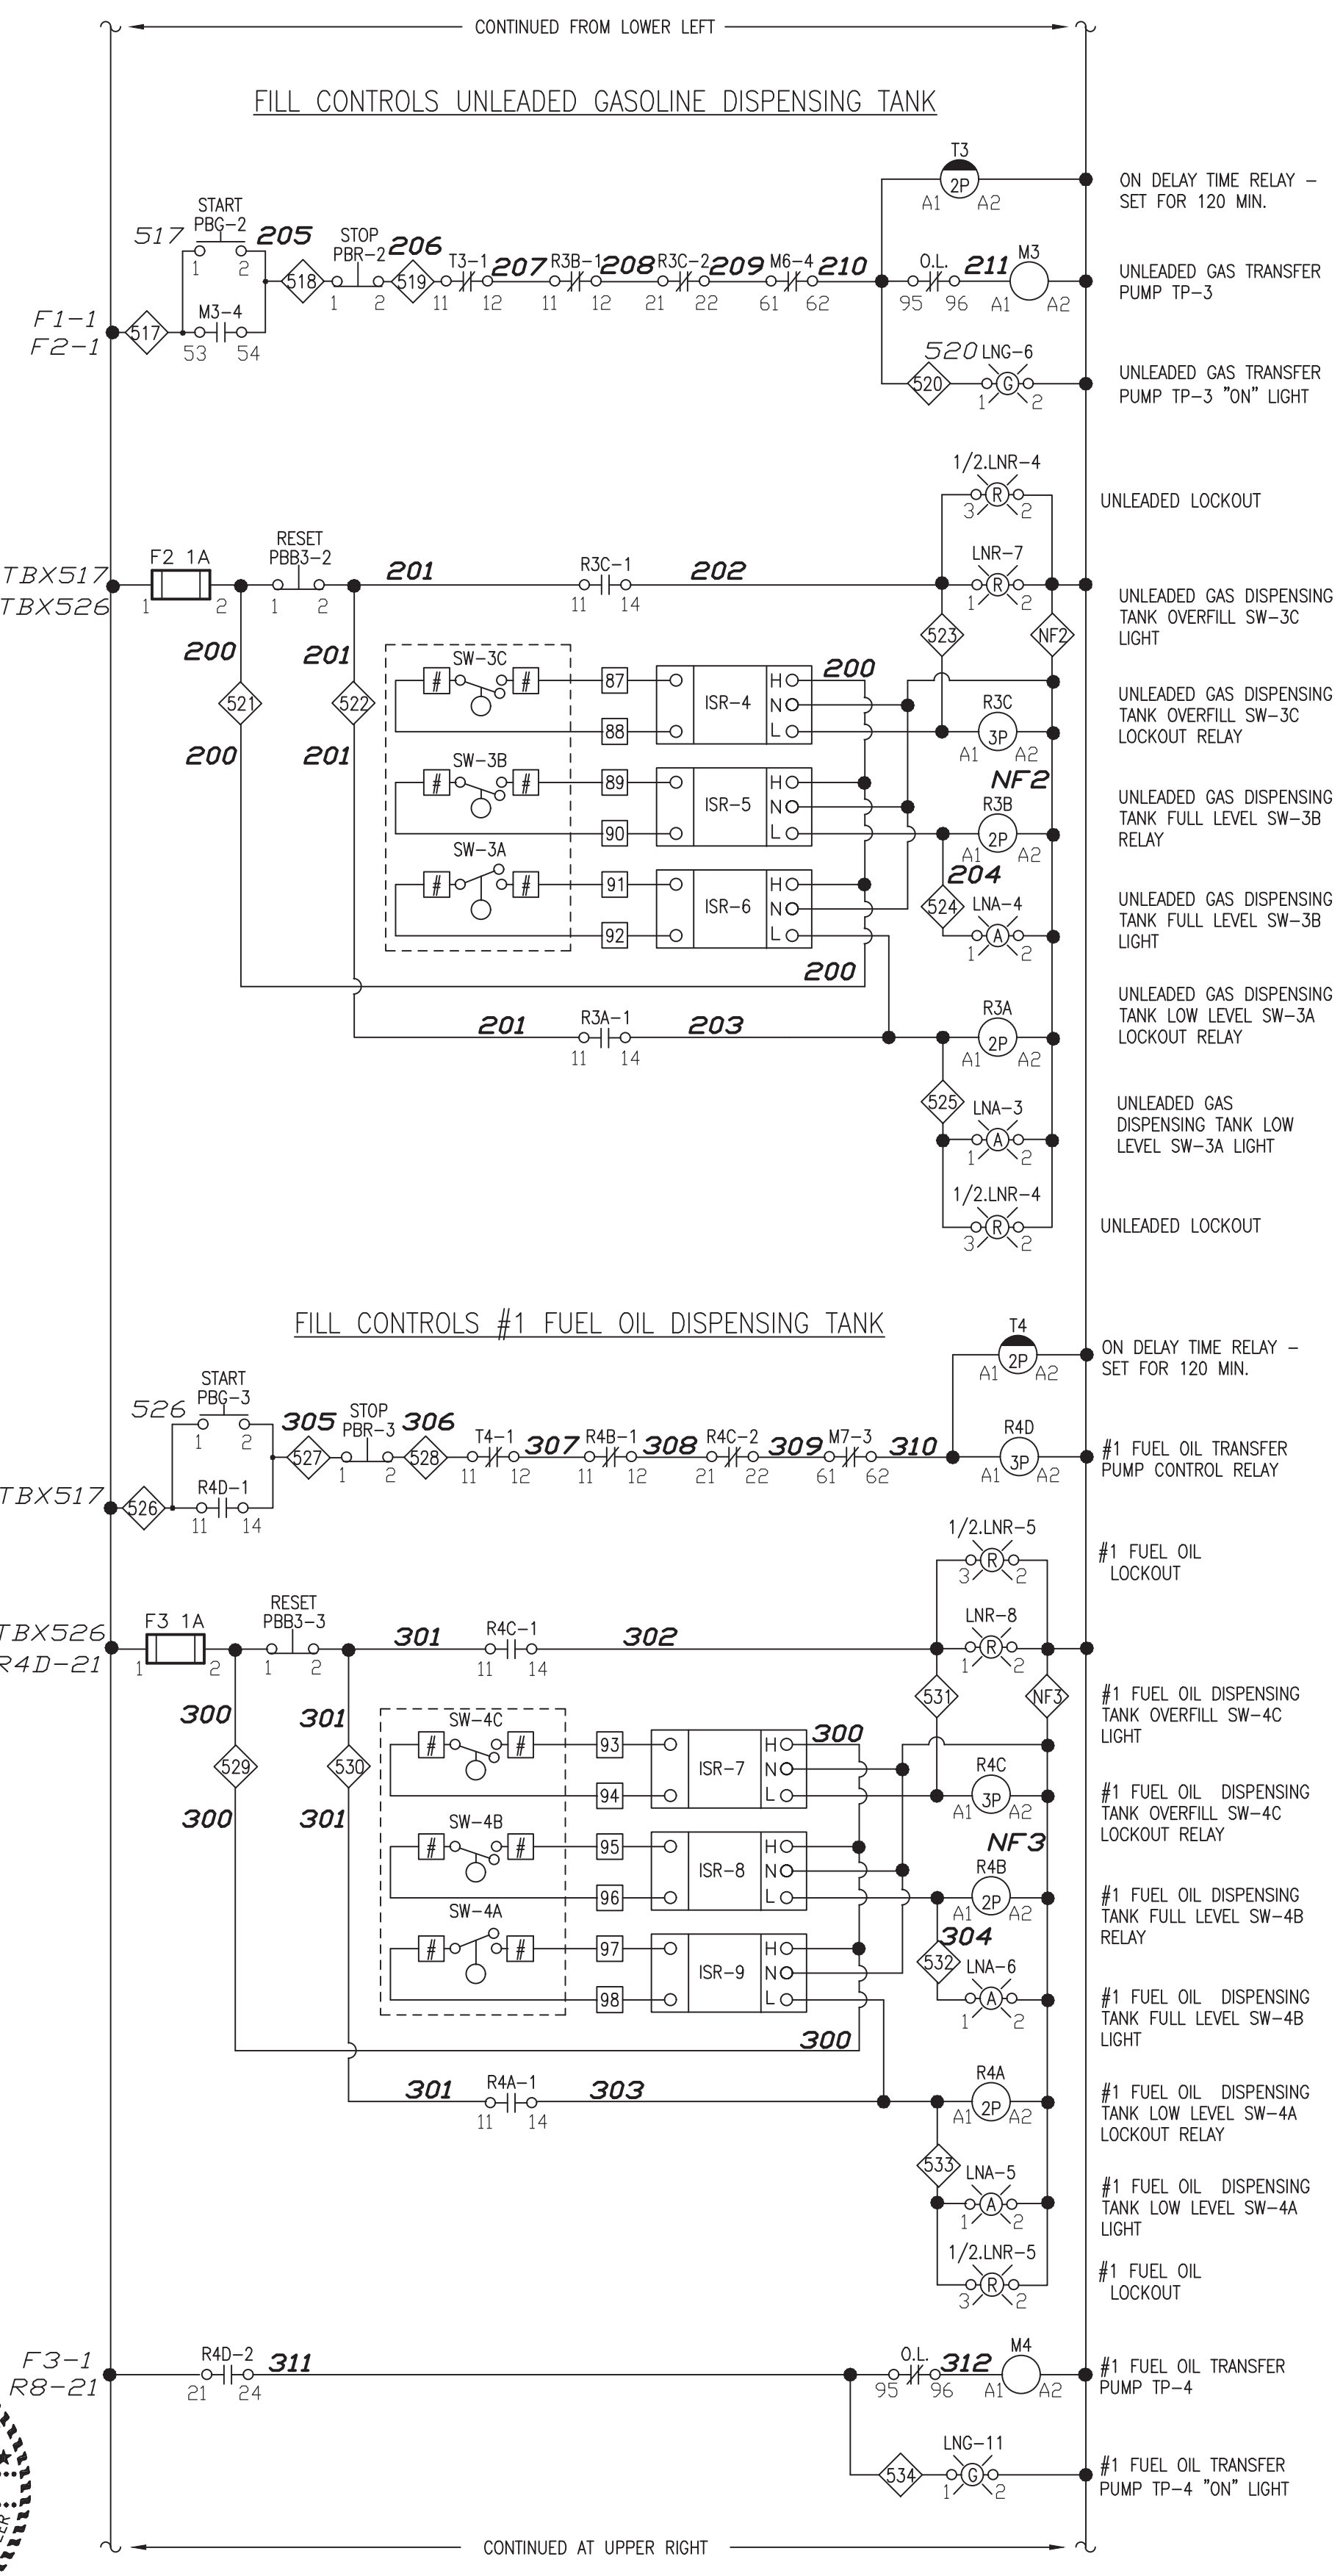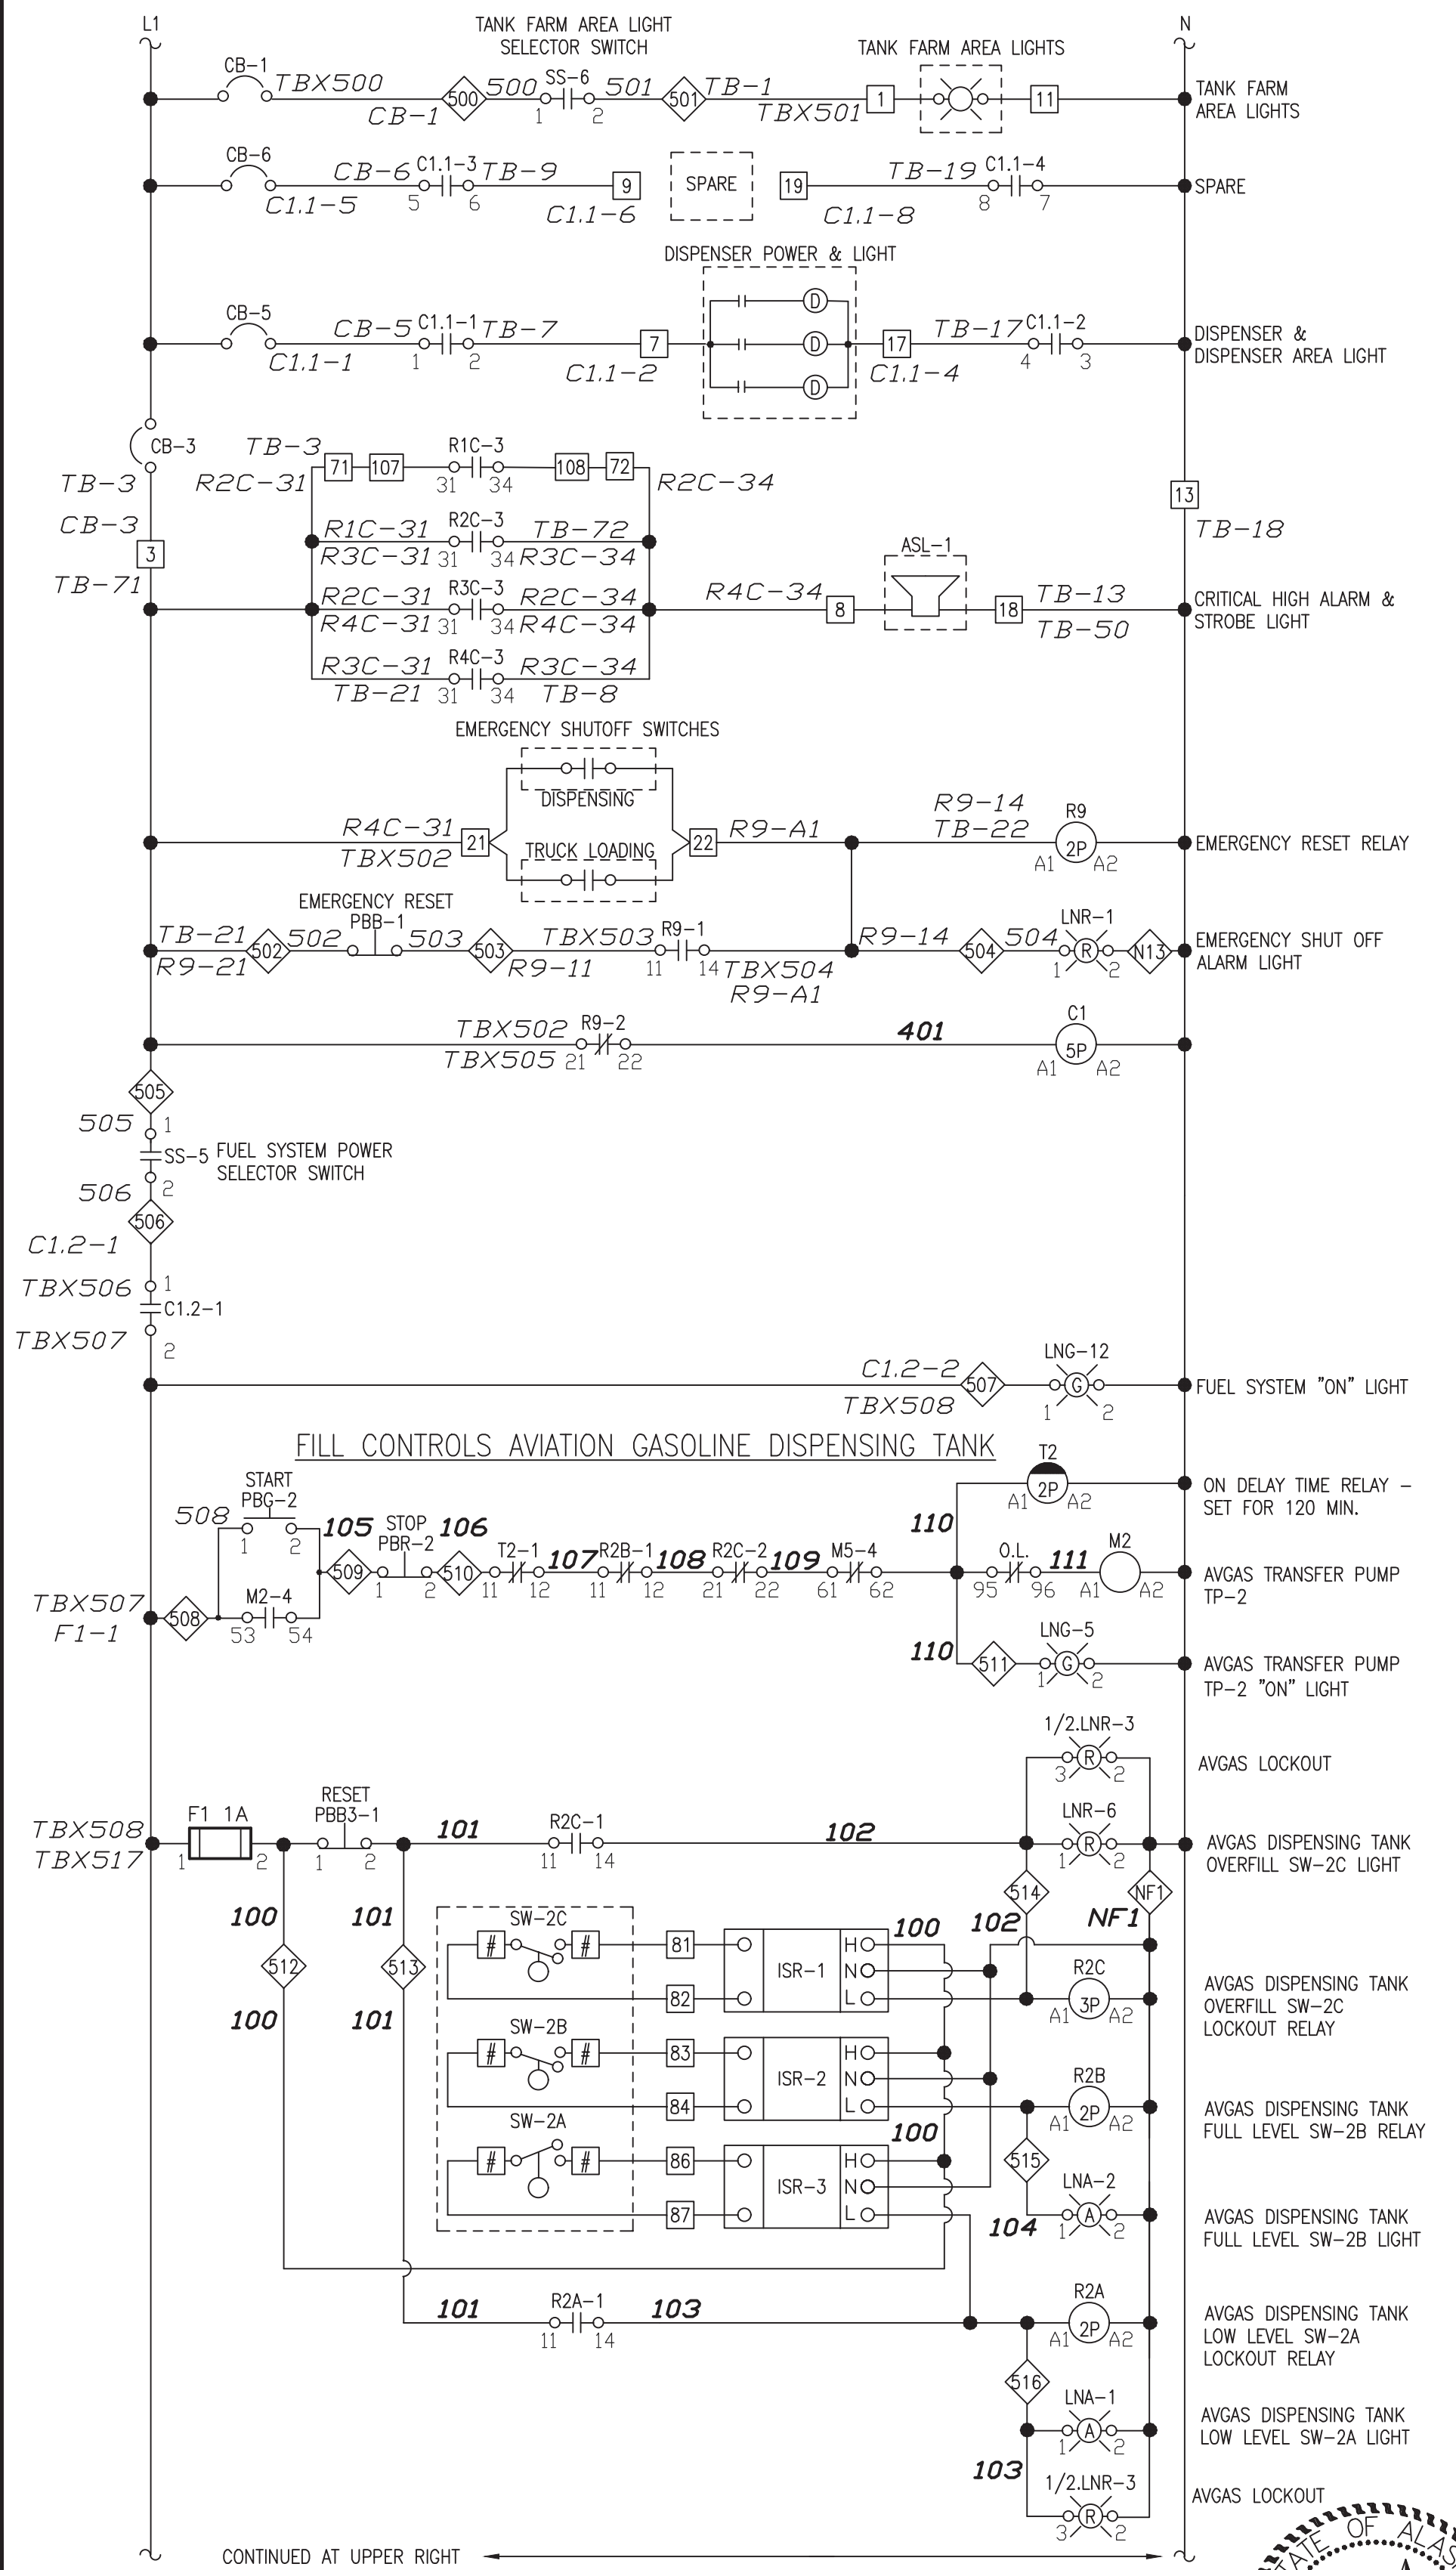

EXISTING TANK FARM PANEL DRAWING PROVIDED FOR REFERENCE DRAWING PREPARED BY OTHERS AND NOT FIELD VERIFIED

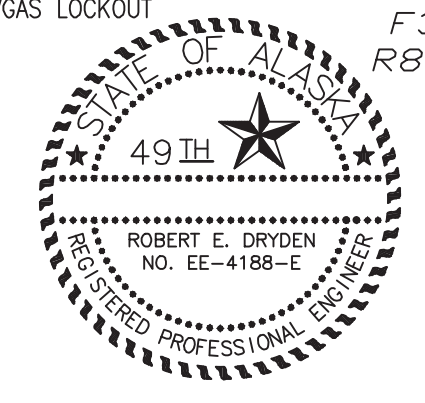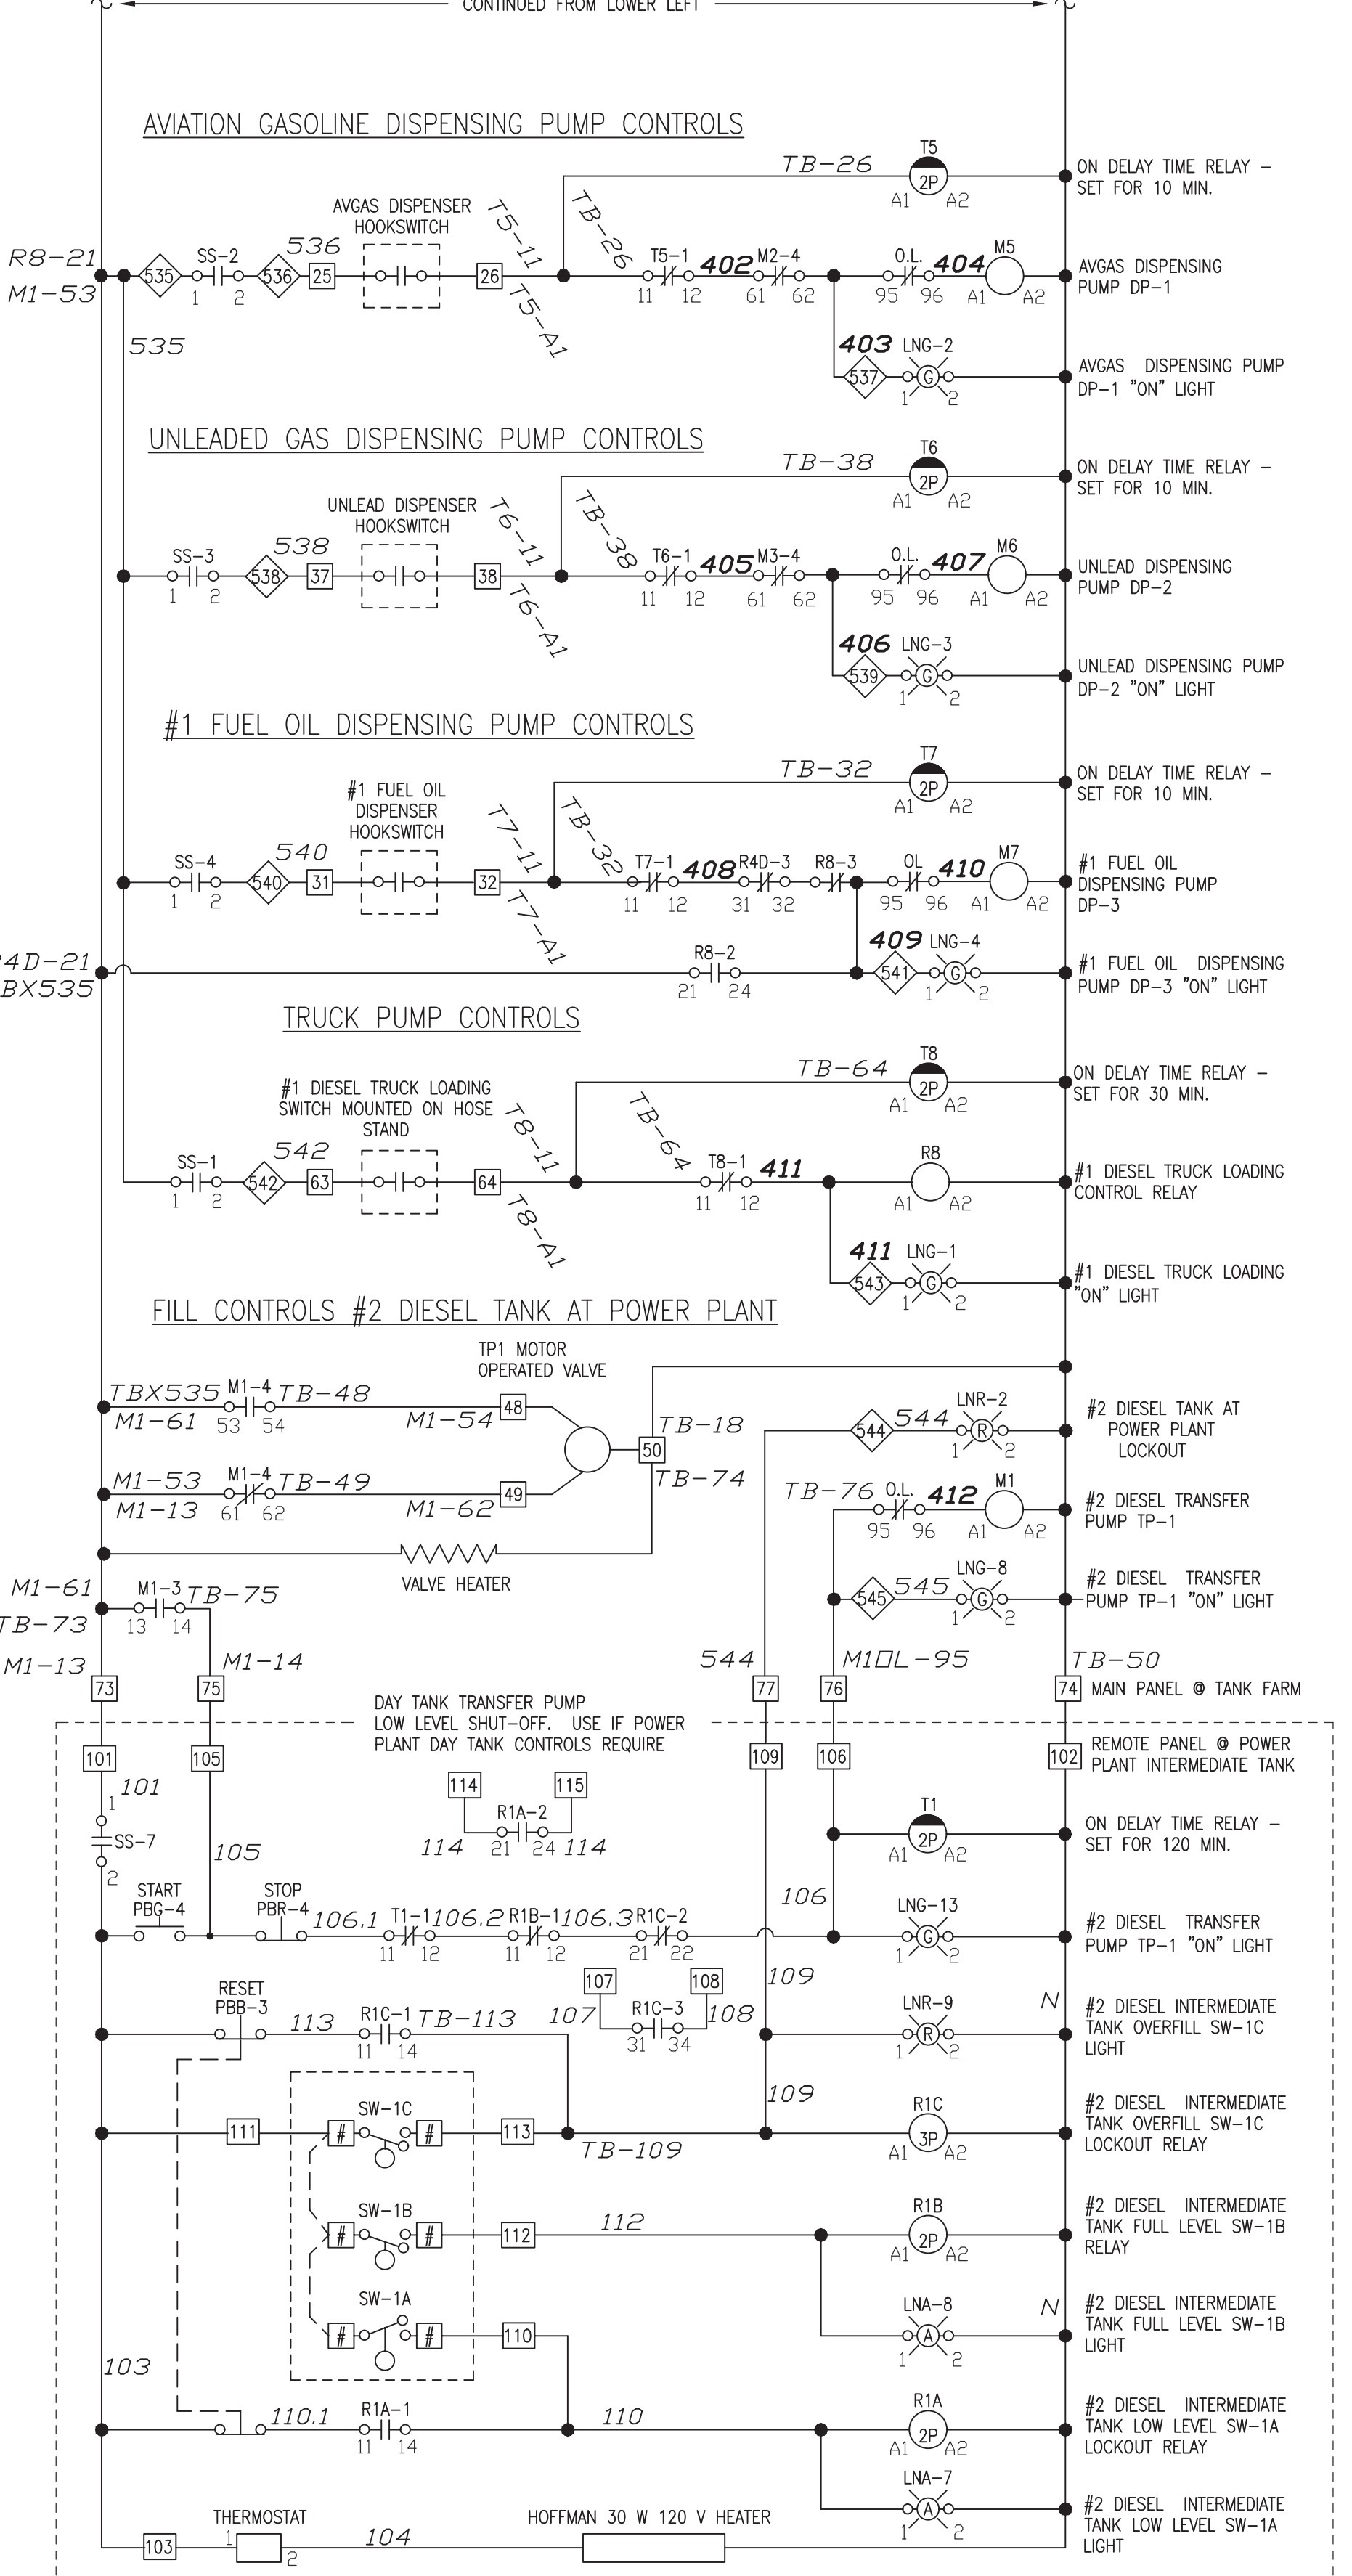

RECORD DRAWING

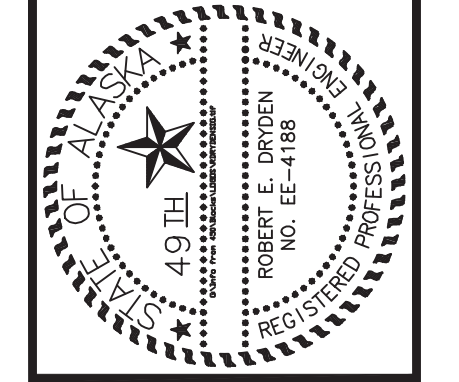


CE2 ENGINEERS, INC. ANCHORAGE, ALASKA

NELSON LAGOON, ALASKA COMMUNITY FUEL FACILITIES UPGRADE LADDER DIAGRAM - TANK FARM CONTROL

State of Alaska Department of Community and Economic Development AIDEA/AEA Rural Energy Group 813 West Northern Lights Blvd. Anchorage, Alaska 99503

CHECKED BY: BED DRAWN BY: LAW DATE: APRIL 2004 W.O. No.: REVISION: REV 1 06/04 BED

DRAWING NO. E-07

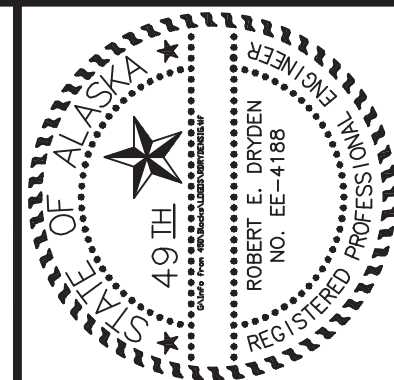


CE2 ENGINEERS, INC. ANCHORAGE, ALASKA

NELSON LAGOON, ALASKA  
COMMUNITY FUEL FACILITIES UPGRADE  
INTERCONNECT DIAGRAM AND NOTES


State of Alaska  
Department of Community and Economic Development  
AIDEA/AEA  
Rural Energy Group  
813 West Northern Lights Blvd.  
Anchorage, Alaska 99503

CHECKED BY: BED  
DRAWN BY: LAW  
DATE: APRIL 2004  
W.O. No.:  
REVISION:  
REV 1 06/04 BED  
DRAWING NO. E-08

EXISTING TANK FARM  
PANEL DRAWING  
PROVIDED FOR  
REFERENCE  
DRAWING PREPARED  
BY OTHERS AND NOT  
FIELD VERIFIED

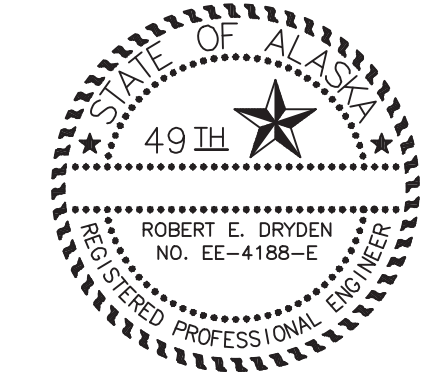



RECORD DRAWING

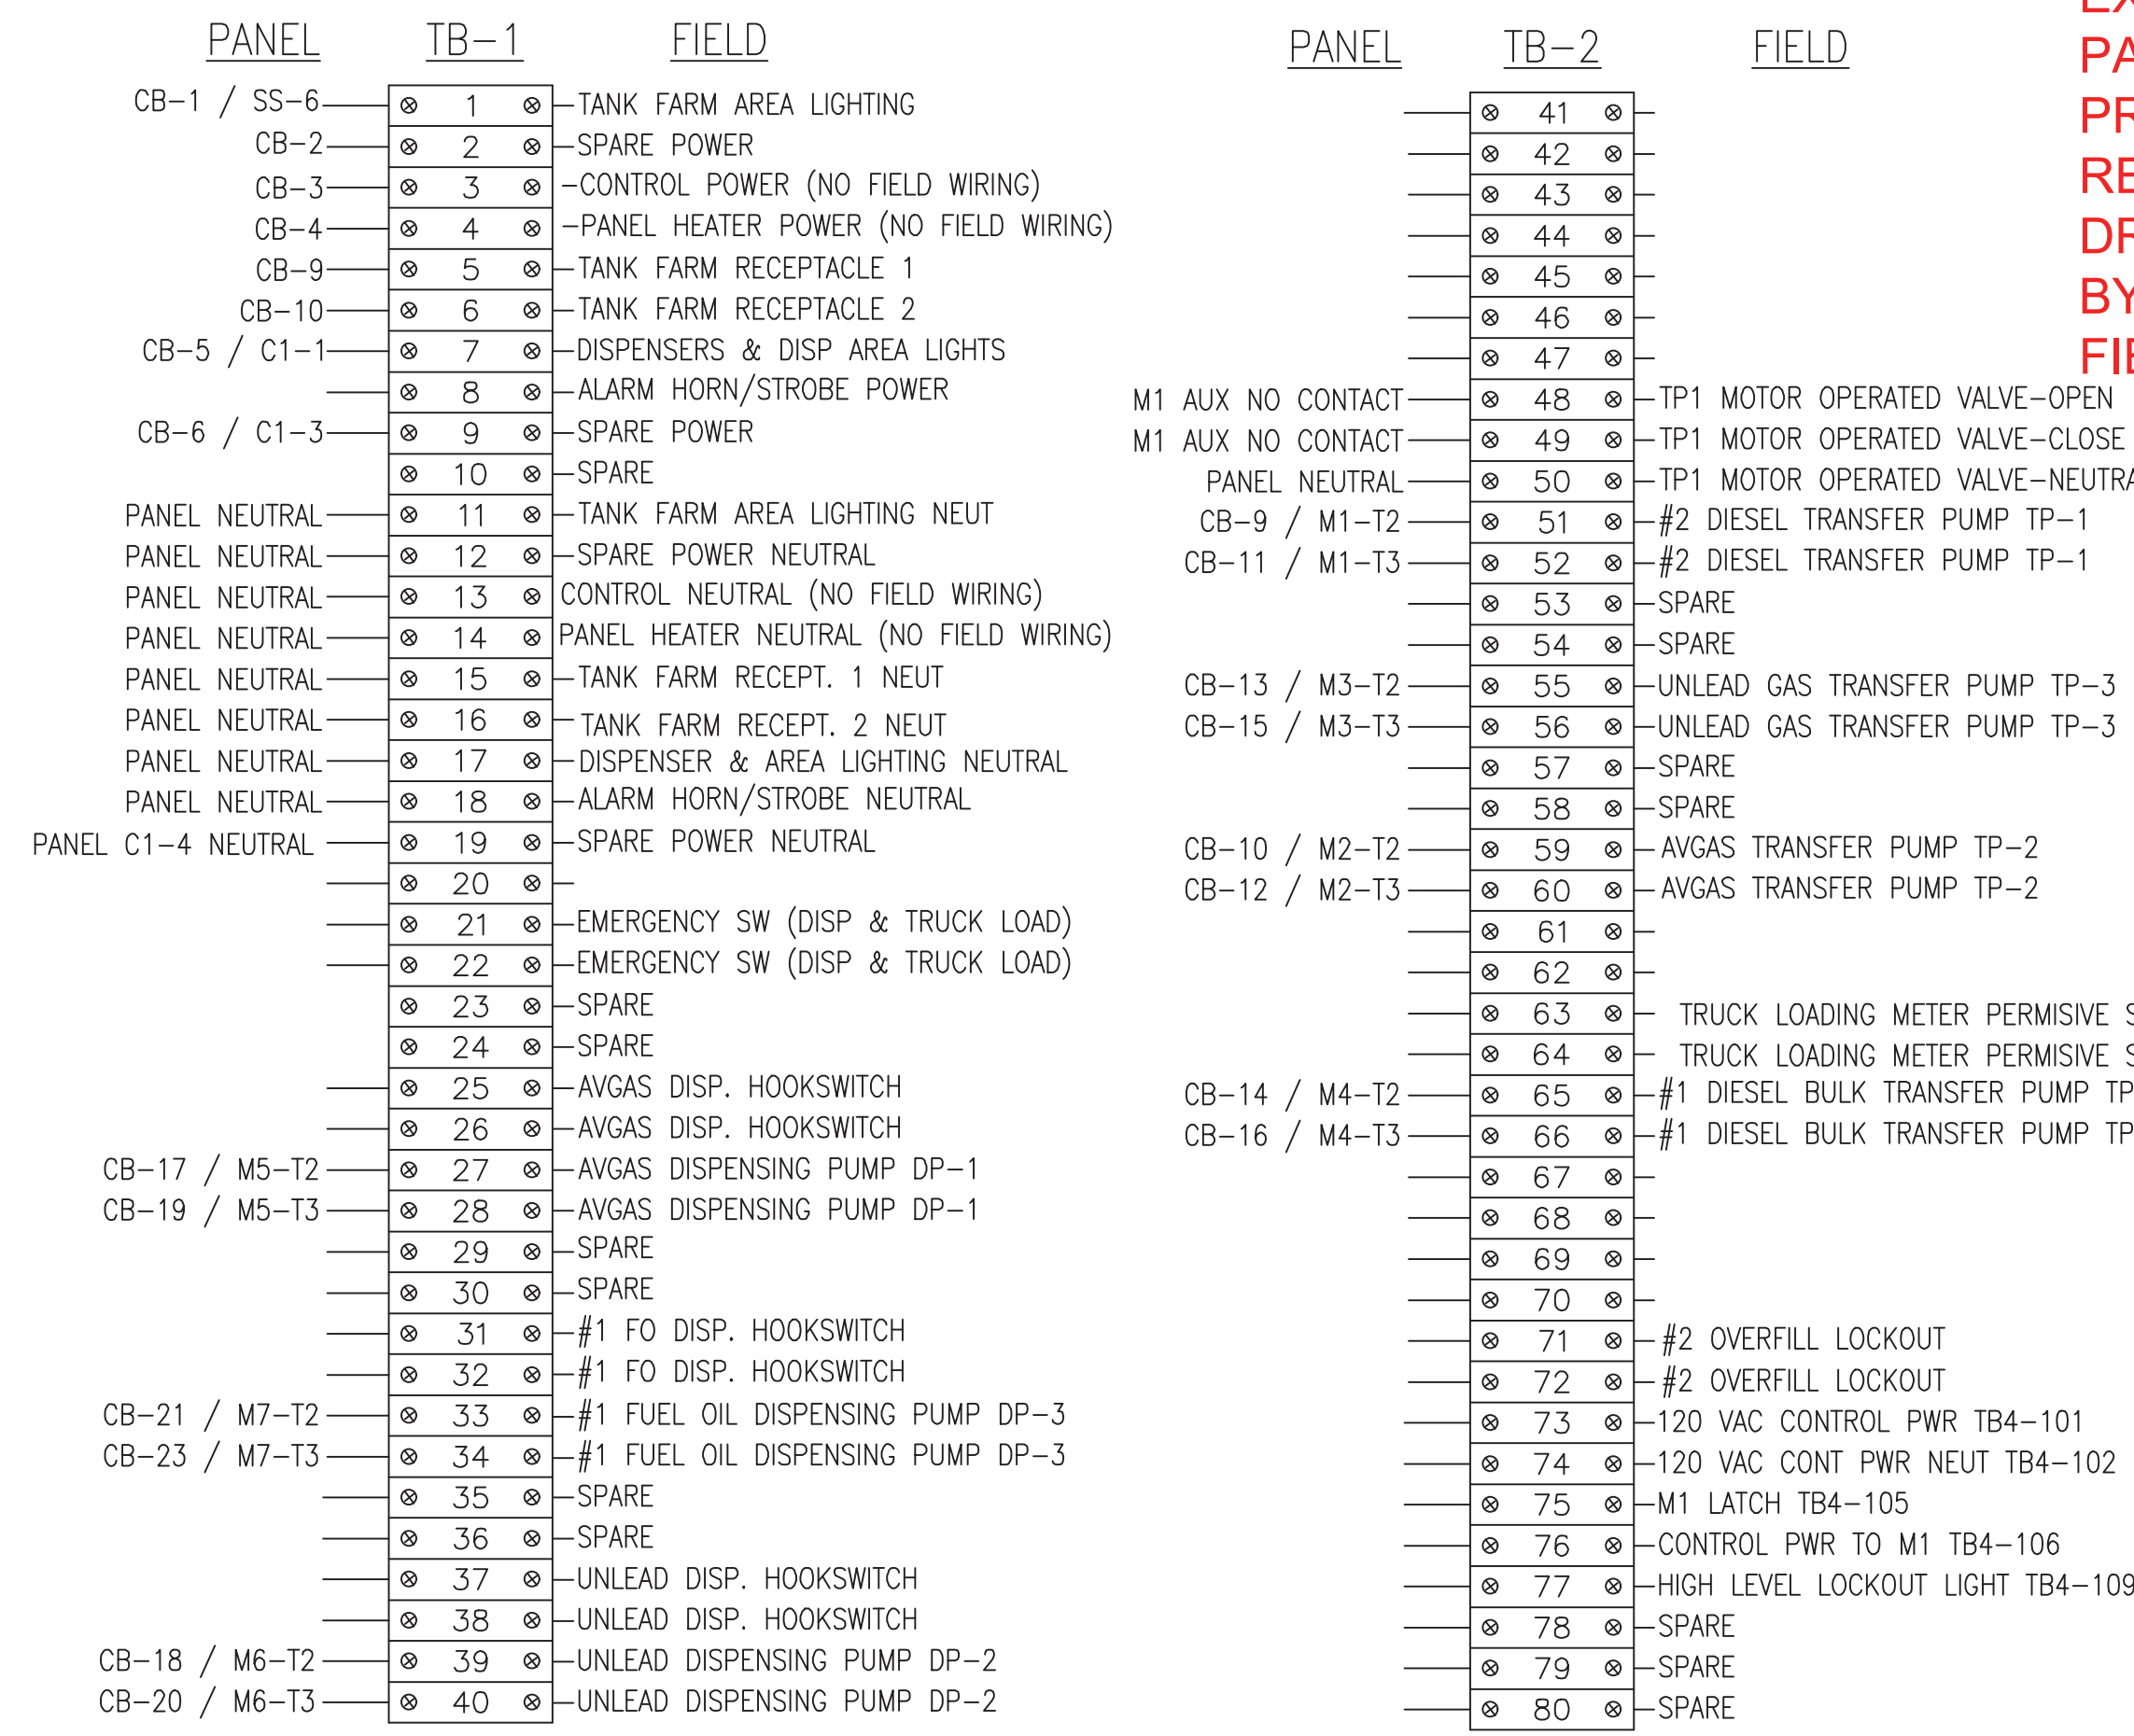

Terminal strip connection tables for TB-1, TB-2, TB-3, and TB-4, listing panel and field connections for various components like lighting, heaters, receptacles, and dispensing pumps.

PANEL BILL OF MATERIALS table listing components such as contactors, circuit breakers, switches, relays, and terminal blocks with their respective quantities and descriptions.

- PANEL NOTES: 1. PROVIDE COMPLETE UL LISTED PANEL ASSEMBLY... 2. INSTALL IN A 36"x48"x12" NEMA 4X ENCLOSURE... 3. SEE SHEET E7 FOR PANEL FACE LAYOUT... 4. LABEL ALL REMOTE EQUIPMENT CONNECTIONS... 5. PROVIDE SHOP DRAWING WITH ALL TERMINAL BLOCK TERMINATION NUMBERS... 6. BENCH TEST THE COMPLETED ASSEMBLY...
- FIELD INSTALLATION NOTES: 1. PRIOR TO PLACING IN THE TANK, VERIFY PROPER OPERATION OF EACH FLOAT SWITCH...

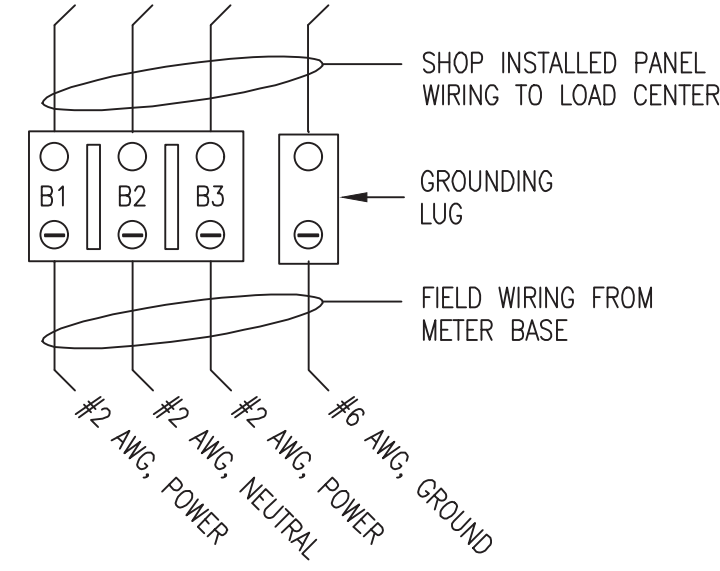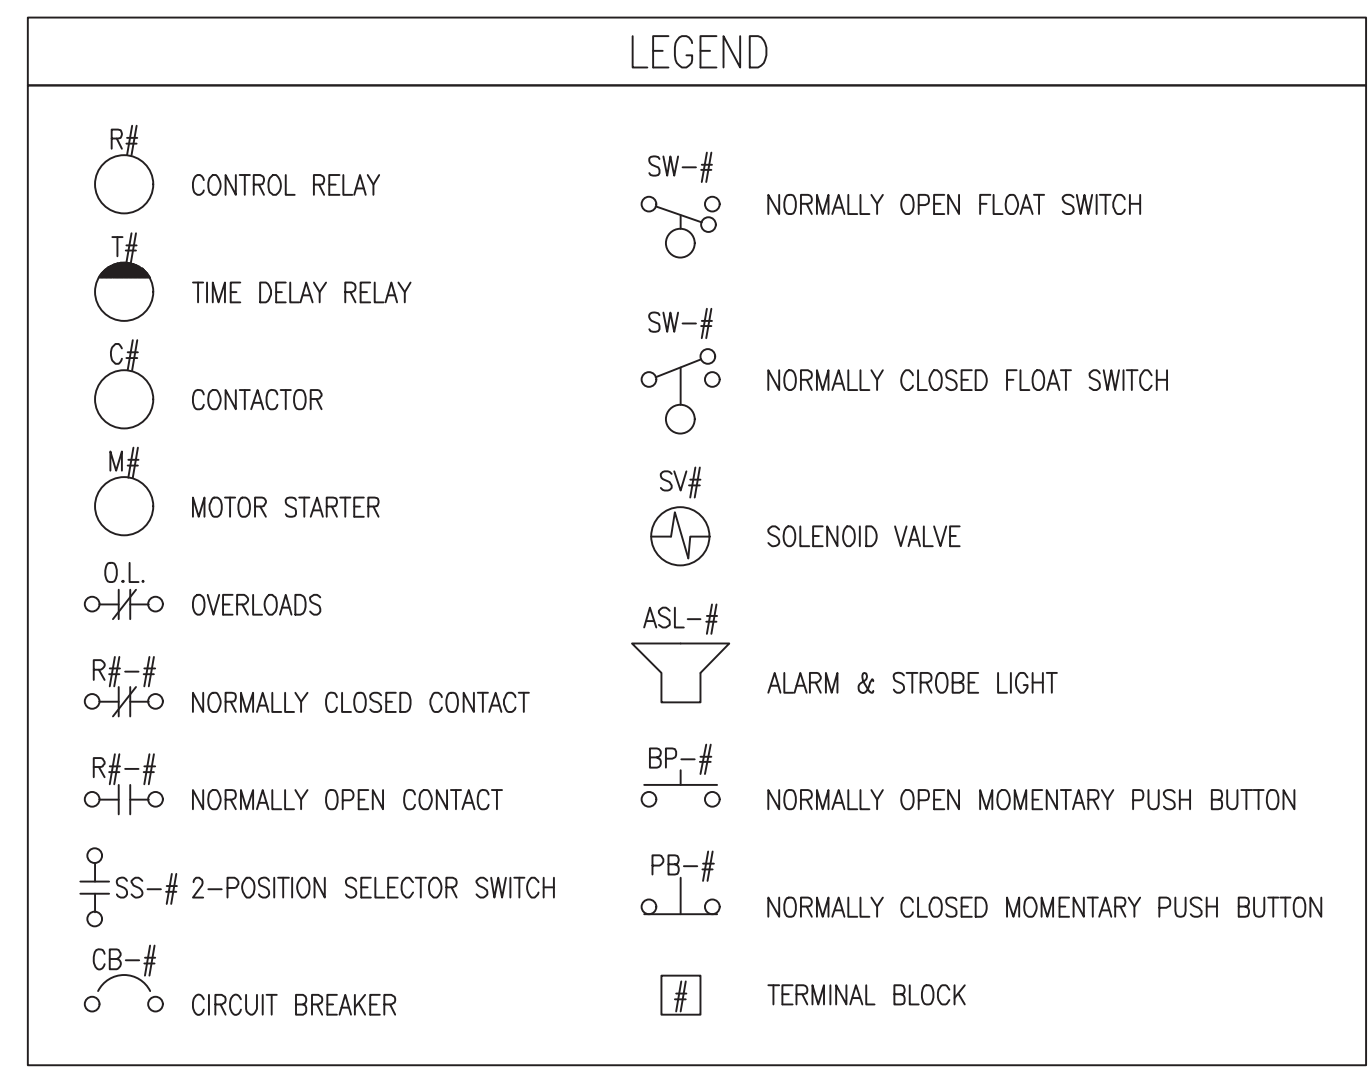


NOTE: INSTALL 100 AMP TERMINAL STRIP HORIZONTALLY AS SHOWN. LOCATE TERMINAL STRIP BELOW PANEL DEVICES TO ACCOMMODATE CONDUCTOR ROUTING FROM CONDUITS CONNECTING TO BOTTOM OF PANEL.

TERMINAL STRIP TB-B

G:\CE2 Data Files\AEA REG\Nelson Lagoon\TANK FARM BULK FUEL UPGRADES\As-Built Drawings\EB.dwg, 9/19/2022 11:07:38 AM, cmezr, AutoCAD PDF (General Documentation).pc3

G:\CE2 Data Files\AEA REG\Nelson Lagoon\TANK FARM BULK FUEL UPGRADES\As-Built Drawings\E9.dwg, 9/19/2022 11:08:30 AM, cmezr, AutoCAD PDF (General Documentation).pc3


**EXISTING TANK FARM PANEL DRAWING PROVIDED FOR REFERENCE  
DRAWING PREPARED BY OTHERS AND NOT FIELD VERIFIED**

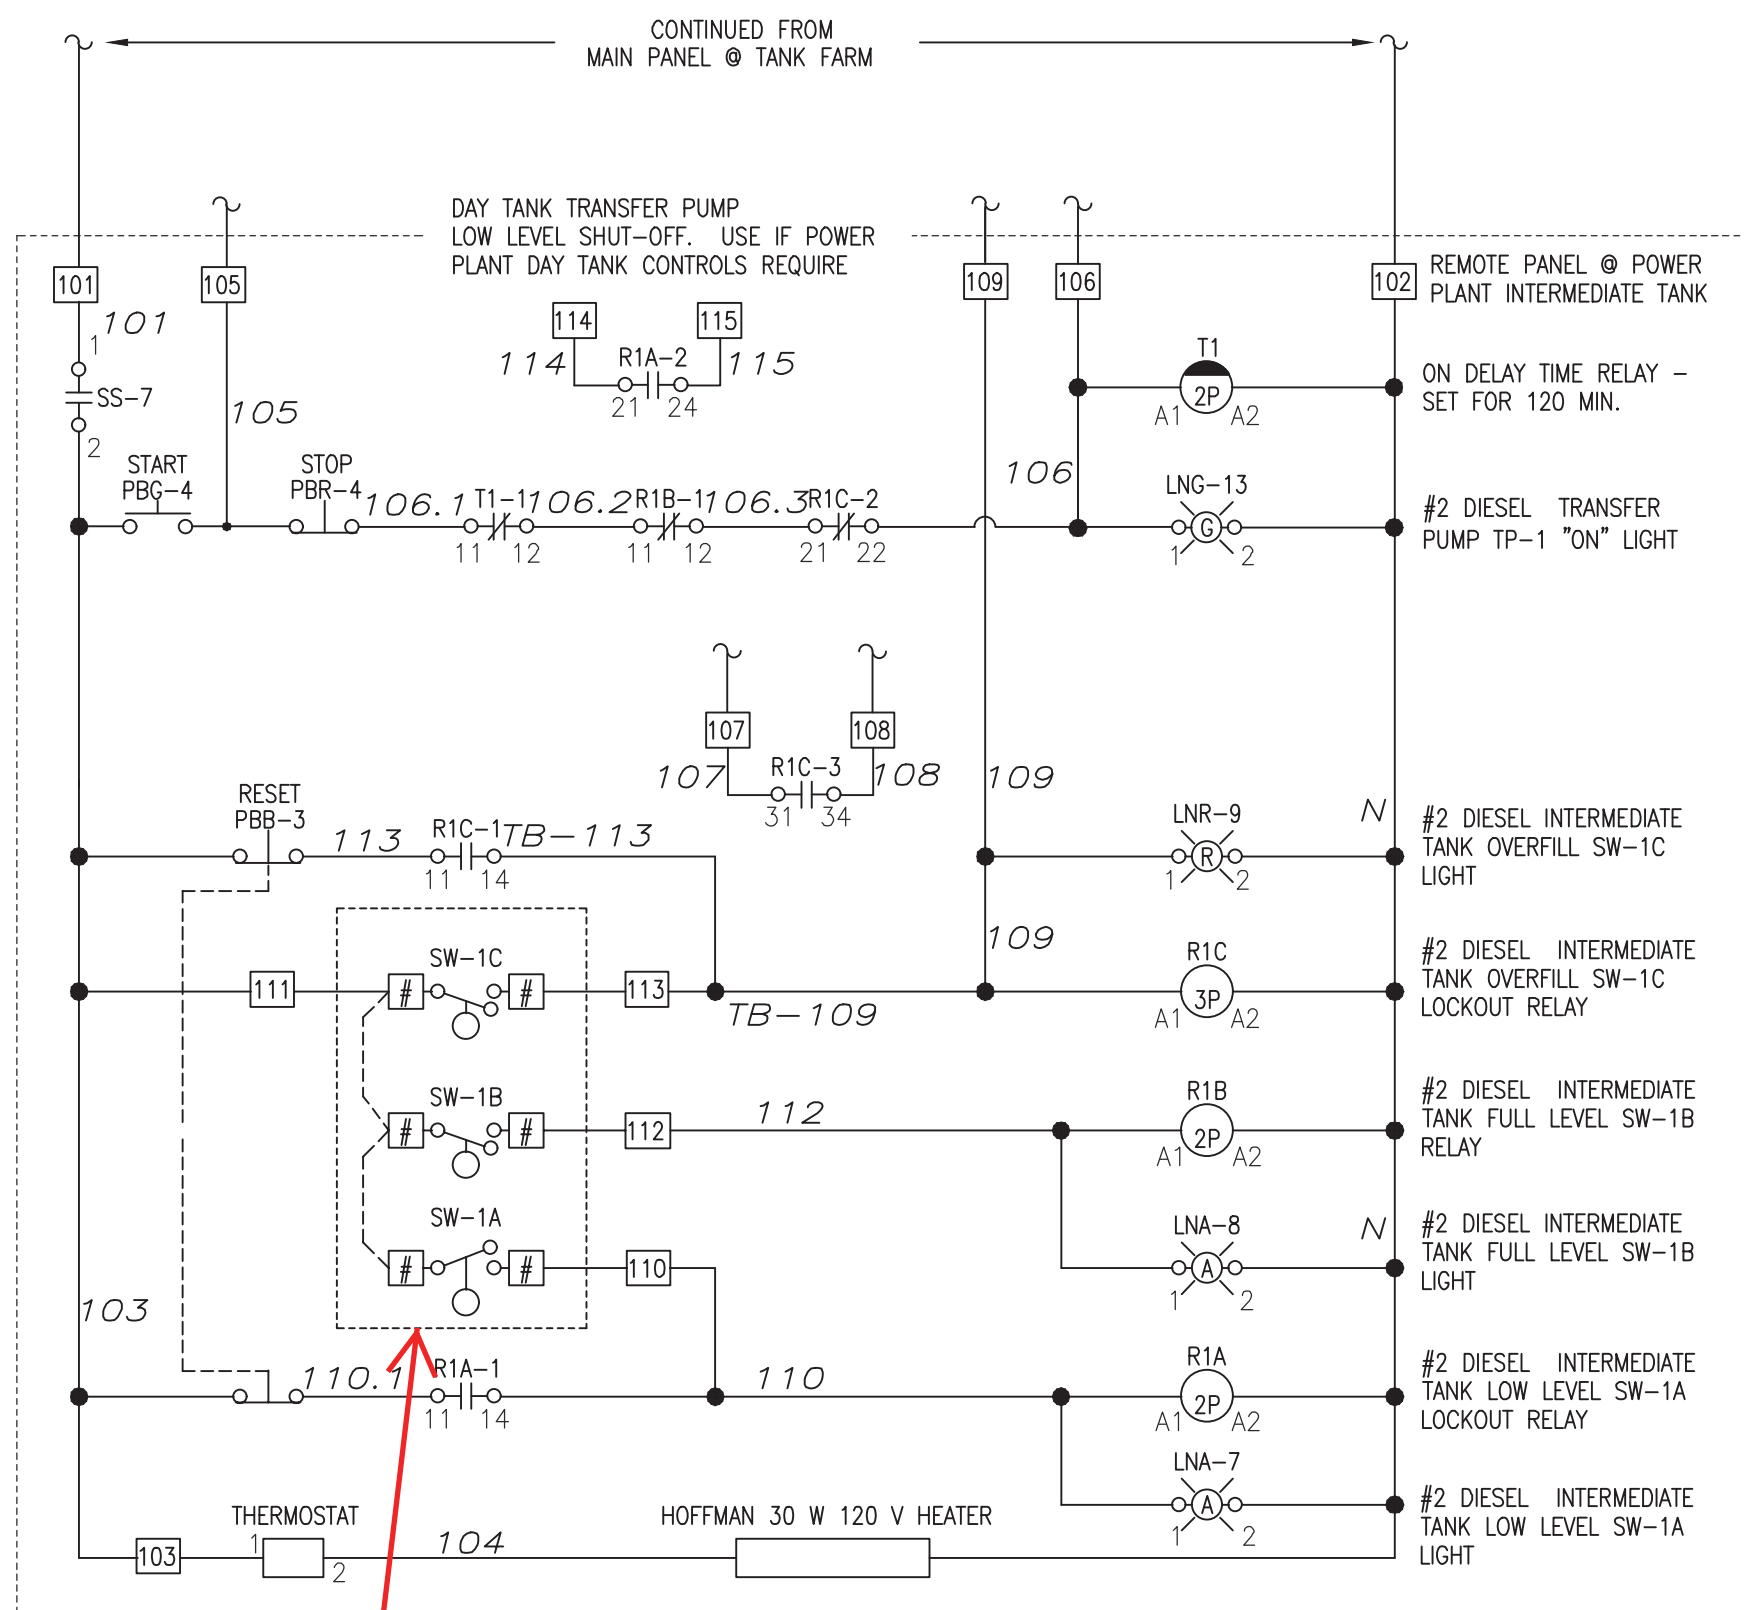

**CONNECT TO NEW** POWER PLANT INTERMEDIATE TANK CONTROL PANEL  
FLOAT SWITCH

POWER PLANT INTERMEDIATE TRANSFER CONTROL PANEL

**1 CONTROL PANEL LAYOUT**  
E-09 NOT TO SCALE

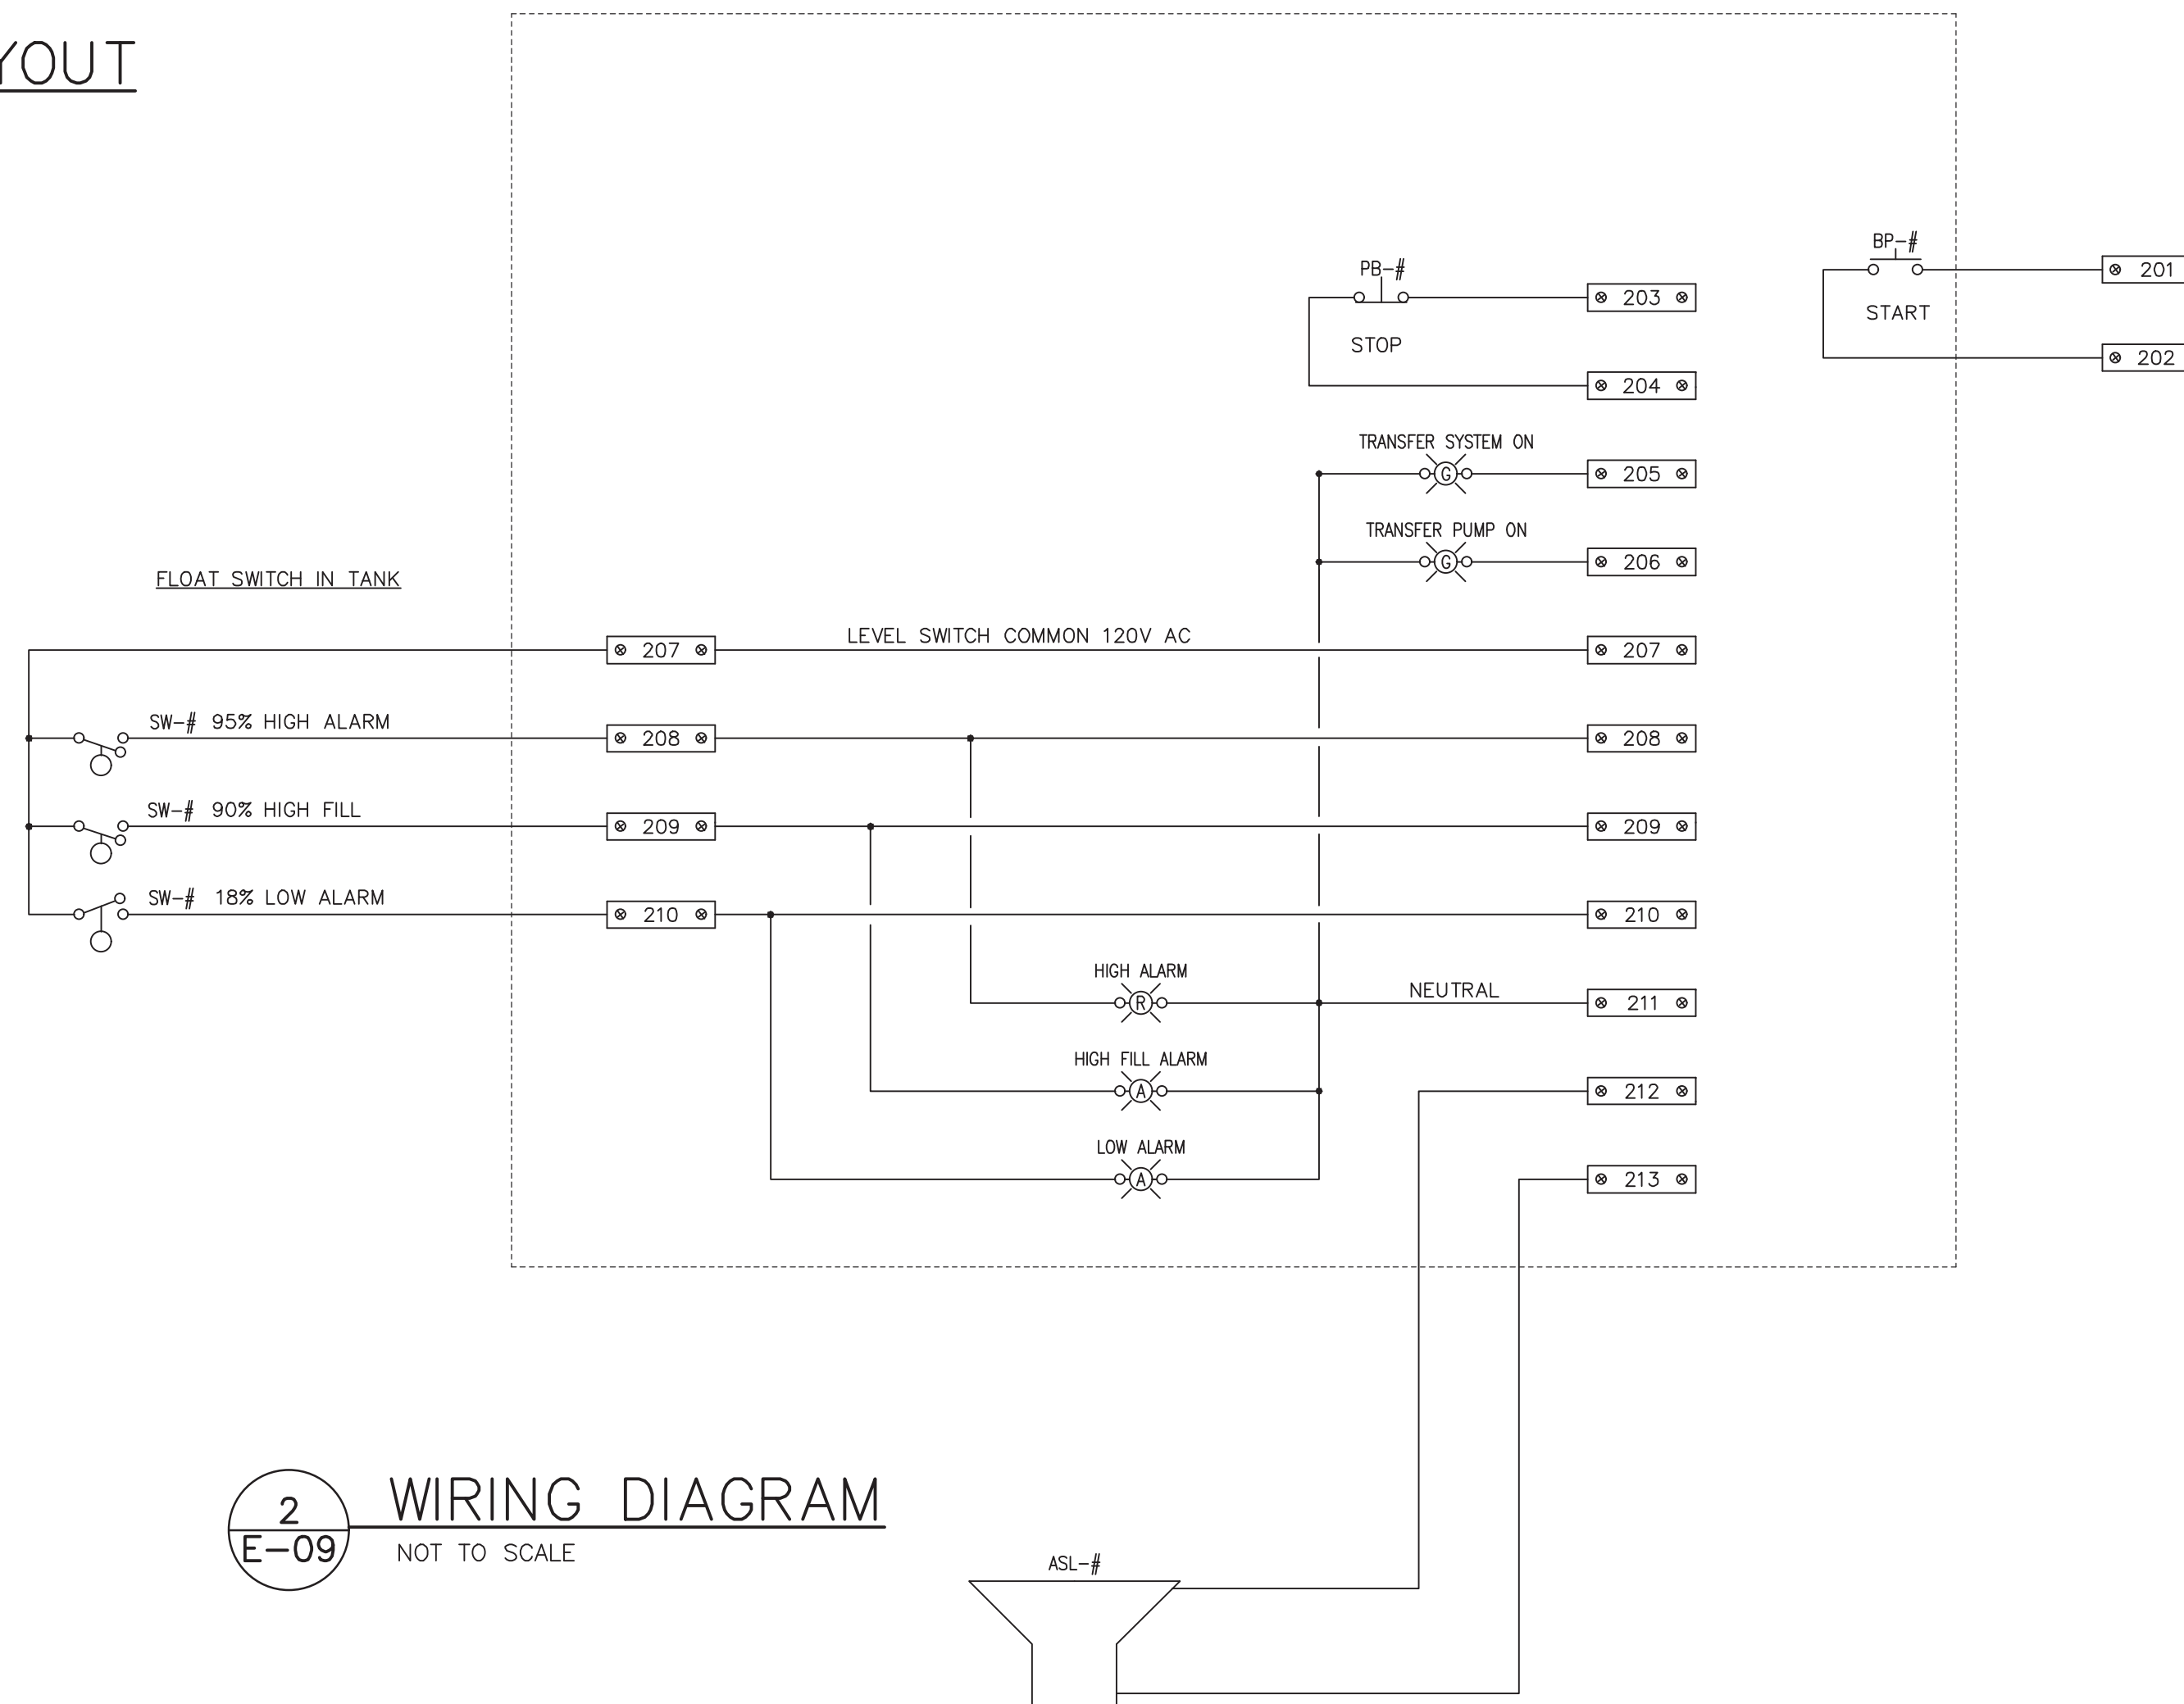

**2 WIRING DIAGRAM**  
E-09 NOT TO SCALE

**PANEL BILL OF MATERIALS:**

Tag Name	Tag Qty	Part Number	Description
LNA	2	800HQRL10A	Allen-Bradley-Amber LED pilot light, 120V, NEMA 4X
LNG	5	800HQRL10G	Allen-Bradley-Green LED pilot light, 120V, NEMA 4X
LNR	2	800HQRL10R	Allen-Bradley-Red LED pilot light, 120V, NEMA 4X
PBB	1	800HAR2D2 800HN101B	Allen-Bradley-Momentary push-button, 1 N.C. NEMA 4X black Allen-Bradley-Silicone boot push button
PBB2	1	800HAR2A4 800HN101B 800TXD2	Allen-Bradley-Momentary push-button, 2 N.C. NEMA 4X black Allen-Bradley-Silicone boot push button Allen-Bradley-Contact Block, 1 N.C.
PBG	1	800HAR1D1 800HN101G	Allen-Bradley-Momentary push-button, 1 N.O. NEMA 4X green Allen-Bradley-Silicone boot push button
PBR	1	800HAR6D2 800HN101R	Allen-Bradley-Momentary push-button, 1 N.C. NEMA 4X red Allen-Bradley-Silicone boot push button
TB-1	1	1492CAM1	Allen-Bradley-Screw terminals blocks, 35Amp, 600V
H1,2,3	3	D-AH301	Hoffman Panel Heater, 30W
TEM	1	A-TEMNC	Hoffman Panel Thermostat


**PANEL NOTES:**

- PROVIDE COMPLETE UL LISTED PANEL ASSEMBLY WITH ALL DEVICES INDICATED IN LOGIC DIAGRAM EXCEPT FOR FIELD DEVICES.
- INSTALL IN A NEMA 4X ENCLOSURE WITH 4 EACH INTEGRAL MOUNTING LUGS AT BACK. INSTALL WEATHERPROOF HINGED WINDOW AND DRIP SHIELD AS INDICATED ON PANEL FACE LAYOUT.
- LABEL ALL REMOTE EQUIPMENT CONNECTIONS AT THE TERMINAL BLOCK BY THE ITEM TITLE AS SHOWN ON THE DRAWING. TAG EACH END OF ALL JUMPERS WITH DEVICE OR TERMINATION DESIGNATOR OF LANDING OF OPPOSITE END OF JUMPER (REVERSE ADDRESS).
- PROVIDE SHOP DRAWING WITH ALL TERMINAL BLOCK TERMINATION NUMBERS AND DEVICE CONNECTION NUMBERS.
- BENCH TEST THE COMPLETED ASSEMBLY PRIOR TO SHIPPING. PROVIDE MIN 48 HOURS NOTICE TO ENGINEER TO SCHEDULE OBSERVATION OF BENCH TEST. PROVIDE SWITCHES AND LAMPS TO SIMULATE OPERATION OF ALL FIELD DEVICES.
- 


**FIELD INSTALLATION NOTES:**

- PRIOR TO PLACING IN THE TANK, VERIFY PROPER OPERATION OF EACH FLOAT SWITCH (ACTUATION LENGTH AND NO/NC FUNCTION). LABEL FLOAT SWITCH TERMINALS WITH THE NUMBER OF THE ASSOCIATED HOME RUN LANDING IN THE CONTROL PANEL.

LEGEND	
	NORMALLY OPEN FLOAT SWITCH
	NORMALLY CLOSED FLOAT SWITCH
	LIGHT (G=GREEN, A=AMBER, R=RED)
	ALARM & STROBE LIGHT
	NORMALLY OPEN MOMENTARY PUSH BUTTON
	NORMALLY CLOSED MOMENTARY PUSH BUTTON
	TERMINAL BLOCK

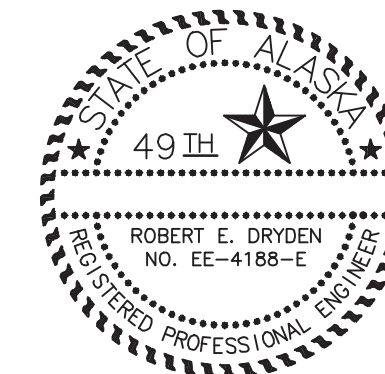

RECORD DRAWING

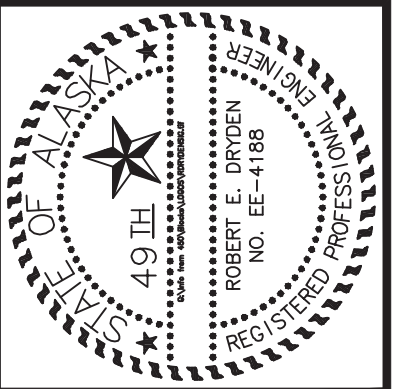

**CE2 ENGINEERS, INC.**  
ANCHORAGE, ALASKA

NELSON LAGOON, ALASKA  
COMMUNITY FUEL FACILITIES UPGRADE

POWER PLANT TANK -  
TRANSFER CONTROL PANEL

State of Alaska  
Department of Community  
and Economic Development  
**AIDEA/AEA**  
Rural Energy Group  
813 West Northern Lights Blvd.  
Anchorage, Alaska 99503

CHECKED BY: BED  
DRAWN BY: LAW  
DATE: APRIL 2004  
W.O. No:

REVISION:

DRAWING NO.  
**E-09**