

STRUCTURAL DRAWINGS

- S1 BUILDING DEMOLITION & MODIFICATION PLAN & ELEVATION
- S2 WEST WALL MODIFICATION ELEVATION & DETAILS

MECHANICAL DRAWINGS


- M1.1 MECHANICAL LEGENDS & SCHEDULES
- M1.2 WARNING SIGN & FIRE EXTINGUISHER PLAN, SIGN & VALVE TAG SCHEDULES
- M1.3 SYSTEM START UP & SEQUENCE OF OPERATIONS
- M1.4 OVERALL MECHANICAL AREA PLAN
- M2.1 MECHANICAL DEMOLITION PLAN
- M2.2 POWER PLANT BUILDING RENOVATION PLAN & DETAILS FOR MECHANICAL UPGRADES
- M2.3 POWER PLANT BUILDING RENOVATION ELEVATIONS & DETAILS FOR MECHANICAL UPGRADES
- M3.1 MECHANICAL EQUIPMENT LAYOUT & NEW WORK OVERVIEW
- M3.2 EQUIPMENT LAYOUT SECTIONS & ELEVATIONS
- M3.3 MECHANICAL SUPPORT PLAN & SECTIONS
- M3.4 MECHANICAL SUPPORT FABRICATION DETAILS
- M3.5 GENSET FABRICATION DETAILS
- M4.1 ENGINE COOLANT SYSTEM PIPING PLAN, ISOMETRIC & DETAILS
- M4.2 ENGINE COOLANT SYSTEM FABRICATION DETAILS
- M4.3 ENGINE COOLANT & HEAT RECOVERY PIPING DETAILS
- M4.4 HEAT RECOVERY SYSTEM PLAN, ISOMETRIC, & DETAILS
- M4.5 HEAT RECOVERY SYSTEM DETAILS
- M5.1 DIESEL FUEL & USED OIL PIPING PLAN, DIAGRAM, & DETAILS
- M5.2 DIESEL FUEL & USED OIL PIPING ELEVATIONS & DETAILS
- M5.3 EXISTING USED OIL HOPPER & BLENDER MODIFICATION DETAILS
- M5.4 200 GALLON DAY TANK FABRICATION
- M6.1 EXHAUST & CRANK VENT PLAN & DETAILS
- M6.2 CHARGE AIR SYSTEM PLAN & DETAILS
- M7.1 VENTILATION PLAN & DETAILS
- M7.2 SHEET METAL FABRICATION DETAILS
- M8.1 HEAT RECOVERY SYSTEM OVERALL AREA & POWER PLANT AREA PLANS
- M8.2 HEAT RECOVERY SYSTEM PUBLIC SAFETY BUILDING DETAILS
- M8.3 HEAT RECOVERY SYSTEM ARCTIC PIPE ELEVATIONS & DETAILS
- M8.4 HEAT RECOVERY SYSTEM CLINIC AREA ELEVATIONS & DETAILS
- M9.1 POWER PLANT AREA FUEL PIPING PLAN & DETAILS
- M9.2 INTERMEDIATE TANK MODIFICATION DETAILS

FIRE SUPPRESSION DRAWINGS

- FS1 FIRE DETECTION & ALARM SYSTEM RENOVATION
- FS2 FIRE SUPPRESSION SYSTEM RENOVATION

ELECTRICAL DRAWINGS

- E1.1 ELECTRICAL LEGENDS & SCHEDULES
- E1.2 OVERALL ELECTRICAL AREA PLAN
- E1.3 TEMPORARY POWER & STEP UP TRANSFORMER REPLACEMENT PLANS
- E2 ELECTRICAL DEMOLITION PLAN
- E3.1 ELECTRICAL EQUIPMENT LAYOUT & NEW WORK OVERVIEW
- E3.2 WIREWAY, CONDUIT, & EQUIPMENT LAYOUT PLAN & DETAILS
- E3.3 SECTIONS, DETAILS, & GENERATOR GROUNDING
- E3.4 BACK WALL ELEVATION & DETAILS
- E4.1 STATION SERVICE PANEL SS & LIGHTING/RECEPTACLE MODIFICATIONS
- E4.2 STATION SERVICE PLAN, DETAILS, & PANELBOARD
- E5 INSTRUMENTATION & DATA MODIFICATION PLAN & DETAILS
- E6.1 SWITCHGEAR ENCLOSURE LAYOUT, SETTING TABLE, & DETAILS
- E6.2 SWITCHGEAR ONE-LINE & DETAILS
- E6.3 24VDC ENGINE WIRING JUNCTION BOX
- E7.1 DAY TANK CONTROL PANEL LOGIC DIAGRAM & BILL OF MATERIALS
- E7.2 DAY TANK CONTROL PANEL LAYOUT & TERMINAL STRIPS
- E7.3 DAY TANK CONTROL PANEL NOTES, SEQUENCE OF OPERATIONS & INTERCONNECT DETAILS
- E7.4 INTERMEDIATE TANK CONTROL PANEL
- E8.1 HEAT RECOVERY SYSTEM HEAT RECOVERY PANEL HRP
- E8.2 HEAT RECOVERY SYSTEM END USER BUILDING WIRING PLANS
- E9 POWER PLANT AREA FUEL SYSTEM WIRING MODIFICATION PLAN & DETAILS

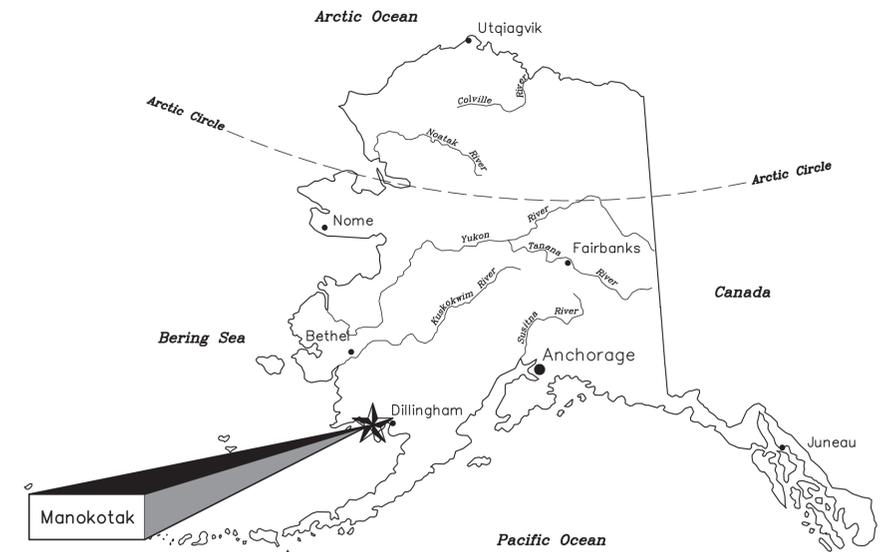

**MANOKOTAK POWER PLANT
UPGRADE PROJECT
REVISION #1 ISSUED FOR
CONSTRUCTION AUGUST 2025**

THIS DRAWING SET SHOWS WORK THAT IS UNDER THE
BASE BID AND ADDITIVE ALTERNATES. ALL WORK SHOWN
IS INCLUDED IN THE BASE BID UNLESS SPECIFICALLY
INDICATED AS ADDITIVE ALTERNATE.

1	UPDATED FOR 2025 AEA STANDARDS	8/15/25	BCG
REV.	DESCRIPTION	DATE	BY
 ALASKA ENERGY AUTHORITY			
PROJECT: MANOKOTAK POWER PLANT UPGRADE PROJECT			
TITLE: SCHEDULE OF DRAWINGS			
 Gray Stassel Engineering, Inc. <small>P.O. 111405, Anchorage, AK 99511 (907)349-0100</small>		DRAWN BY: BCG	SCALE: NO SCALE
		DESIGNED BY: BCG	DATE: 9/28/23
		FILE NAME: MANO PP G1	SHEET:
		PROJECT NUMBER:	G1

ELECTRICAL EQUIPMENT SCHEDULE

SYMBOL	SERVICE/FUNCTION	DESCRIPTION	MANUFACTURER/MODEL
1	DAY TANK ALARM HORN/STROBE	MULTI-TONE ALARM WITH STROBE, 115V, NEMA 3R, WEATHER RESISTANT SURFACE MOUNT BELL BOX	WHEELLOCK MT4-115-WH-VNS
2	DIGITAL THERMOSTAT	MULTIPLE OUTPUT MODULATING DIGITAL THERMOSTAT	HONEYWELL TB7980B
3	LINE VOLTAGE THERMOSTAT	HEATING/COOLING THERMOSTAT, 16 FLA @ 120V, SPDT, 50F TO 80F RANGE.	DAYTON 1UHH2
4	EXTERIOR LIGHT	AREA LIGHT, WIDE DISPERSION WALL PACK WITH PHOTO CONTROL. LED, 17.7W, 120-277V DRIVER	HUBBELL NRG-356L-5K-U-PC
5	EMERGENCY LIGHT	WHITE PLASTIC ENCLOSURE, 120-347V INPUT, DUAL 5.3W LED LAMPS, LITHIUM IRON PHOSPHATE BATTERY	LITHONIA EML6L UVOLT LTP SRDT
6	EMERGENCY/EXIT LIGHT COMBO	WHITE PLASTIC ENCLOSURE, RED EXIT SIGN, 277/120V INPUT, DUAL 1.5W 9.6V LED LAMPS. OPTIONAL HIGH OUTPUT NI-CAD BATTERY	LITHONIA LHQM LED R HO
7	EMERGENCY EXIT REMOTE LIGHT	REMOTE LAMP FIXTURE, DUAL HEAD, RATED FOR EXTERIOR INSTALLATION IN DAMP/WET LOCATIONS, 1.5W 9.6V LED LAMPS.	LITHONIA ELA T QWP L0309
8	INTERIOR LIGHT	SURFACE MOUNTED LED STRIPLIGHT FIXTURE, 48" LONG, 34W, 5000K WITH SNAP ON FROSTED DIFFUSER	LITHONIA L1N-L48-5000LM-FST
9	TIMER SWITCH	0-5 MINUTE , 120V, 20A, 1HP RATED, INSTALL IN 4"x4" PRESSED STEEL BOX WITH METAL COVER.	INTERMATIC FF5M
10	LIGHT SWITCH	SINGLE POLE SNAP SWITCH, 120V, 20A, METAL, 1-1/2HP RATED, INSTALL IN 4"x4" STEEL BOX WITH METAL COVER, IVORY.	HUBBELL 1221-I
11	1Ø SMALL MOTOR DISCONNECT	SINGLE POLE SNAP SWITCH WITH RED PILOT LIGHT, 120V, 20A, 1HP RATED, INSTALL IN 4"x4" STEEL BOX WITH METAL COVER	HUBBELL 1221-PL
12	NOT USED	NOT USED	
13	<i>STATION SERVICE TRANSFORMER</i>	<i>STATION SERVICE TRANSFORMER - ENERGY STAR COMPLIANT, ENCLOSURE TYPE 1, 45kVA, HV 480 DELTA, LV 208Y/120, 125 AMP</i>	<i>EGS ELECTRICAL GROUP CAT. NO. ET2H30</i>
14	<i>STATION SERVICE PANELBOARD</i>	<i>COPPER BUS, 3 PHASE, 4 WIRE, 120/208V, 125A MAIN BREAKER, 42 CIRCUITS, BOLT-IN BREAKERS, NEMA 1 ENCLOSURE, SURFACE MOUNT, NO KNOCKOUTS</i>	<i>SIEMENS TYPE P1</i>
15	STANDARD RECEPTACLE	SURFACE MOUNT 125V NEMA 5-20R RECEPTACLE. INSTALL IN 4"x4" STEEL BOX WITH METAL COVER	PASS & SEYMOUR 5362W
16	EXTERIOR GFCI RECEPTACLE	125V NEMA 5-20R GFCI RECEPTACLE. MOUNT IN CAST FDA BOX WITH WEATHERPROOF COVER	PASS & SEYMOUR 2095-W
17	BATTERY CHARGER	12/24-VOLT SOLID STATE 20-AMP AUTO-EQUALIZING BATTERY CHARGER FOR 120 VAC INPUT, WITH OPTIONAL HIGH/LOW VOLTAGE, AC POWER FAILURE, & REMOTE SUMMARY ALARM RELAYS	SENS NRG22-20-RCLS OR LEMARCHE ECSR-40/20-12/24V-AV1
18	NOT USED	NOT USED	NOT USED
19	NOT USED	NOT USED	NOT USED
20	RADIATOR/CAC MOTOR DISCONNECT	NON-FUSED LOCKABLE SAFETY SWITCH, NEMA 3R ENCLOSURE, 3PST, 600V, 30A, MIN 5HP RATED	SIEMENS HNF361R OR SQUARE D HU361R
21	NOT USED	NOT USED	NOT USED
22	NOT USED	NOT USED	NOT USED
23	SNAP SWITCH WITH THERMAL UNIT	600VAC, 1HP, 16A MANUAL MOTOR STARTER WITH TYPE S, TYPE A, MELTING ALLOY, CLASS 20 THERMAL UNIT	SQUARE D 2510F01 MOTOR STARTER WITH A14.8 THERMAL UNIT
24	ROUTER - HIGH SPEED INTERNET	4-PORT GIGABIT ROUTER, DUAL 2.4 AND 5 GHz WIFI WITH ADJUSTABLE ANTENNAS, 4 EACH 1 GBPS LAN, 1 GBPS WAN, MINIMUM 256 MB RAM, WITH DDNS AND PORT FORWARDING CAPABILITY, ASUS RT-AX1800S OR APPROVED EQUAL	ASUS RT-AX1800S
25	FOC-1 ENCLOSED CONTACTOR	NEMA 1 ENCLOSURE WITH IEC STYLE CONTACTOR, 5.4-27A ADJUSTABLE RANGE SOLID STATE OVERLOAD, HAND-OFF-AUTO CONTROL, NORMALLY OPEN AUXILIARY CONTACT, 16A, 208V 3-PHASE.	ALLEN-BRADLEY 109-C16AD-OLR ENCLOSED CONTACTOR, 193-EEEB OVERLOAD, 198-3SS HOA, 193-ERA OVERLOAD RESET & 150-CA10 1P, N.O. AUX CONTACT
26	FOC-1 TEMP CONTROLLER	NEMA 1 120/240 VAC PROGRAMMABLE TEMPERATURE CONTROLLER WITH PTC TEMPERATURE SENSOR AND 2m LONG JACKETED CABLE	PENN A421ABC-02C
27	PUMP P-DF3 DISCONNECT	LOCKABLE TUMBLER SWITCH, NEMA 7, FEED THROUGH WITH 3/4" HUBS, 20A, 2 POLE, 120/277V, COMPLETE ASSEMBLY	KILLARK XS-52C

EQUIPMENT NOTES:
 1) ALL EQUIPMENT SHOWN IN LIGHT ITALIC TEXT IS EXISTING TO REMAIN AND ARE SHOWN HERE FOR REFERENCE ONLY. SOME EXISTING ITEMS WILL BE DEMOLISHED AND/OR REPLACED WITH NEW AS INDICATED ON THE PAGES THAT FOLLOW.
 2) ALL EQUIPMENT SHOWN IN BOLD DARK TEXT IS NEW AND IS TO BE FURNISHED AND INSTALLED UNDER THIS PROJECT INCLUDING REPLACEMENTS FOR EXISTING.
 3) SPECIFIC PARTS MANUFACTURER AND MODEL SELECTED NOT ONLY TO MEET PERFORMANCE FUNCTION BUT ALSO TO COORDINATE AND INTERFACE WITH OTHER DEVICES AND SYSTEMS. APPROVED EQUAL SUBSTITUTIONS WILL BE ALLOWED ONLY BY ENGINEER'S APPROVAL. TO OBTAIN APPROVAL, SUBMITTALS MUST CLEARLY DEMONSTRATE HOW SUBSTITUTE ITEM MEETS OR EXCEEDS SPECIFIED ITEM QUALITY AND PERFORMANCE CHARACTERISTICS AND ALSO COMPLIES WITH MECHANICAL AND/OR ELECTRICAL CONNECTIONS AND PHYSICAL LAYOUT REQUIREMENTS.

ELECTRICAL CONDUCTOR SCHEDULE

SERVICE/FUNCTION	DESCRIPTION	MANUFACTURER/MODEL	NOTES:
GENERATOR LEADS (ENGINE STARTER CABLES SIMILAR)	HIGH TEMPERATURE, EXTRA FLEXIBLE CABLE, TIN COATED COPPER CONDUCTOR. THERMOSET EPDM INSULATION, UL 3340/3374, MINIMUM 600V, LISTED 150°C FOR NON-FLEXING	COBRA CABLE, BELDEN, OR OMINI	TERMINATE WITH COPPER COMPRESSION LUGS RATED FOR THE FULL AMPACITY OF THE CABLE AT 150°C.
GENERAL USE CONDUCTORS	CLASS B CONCENTRIC STRANDED, SOFT DRAWN COPPER. TYPE XHHW2 INSULATION, 600V AND 90C RATED.		
SHIELDED/TWISTED INSTRUMENT & CONTROL & CANBUS CONDUCTORS	#18 AWG STRANDED TINNED COPPER CONDUCTORS, 600V POLYETHYLENE INSULATION, 100% COVERAGE ALUMINUM FOIL-POLYESTER TAPE SHIELD WITH STRANDED TINNED COPPER DRAIN WIRE & PVC OUTER JACKET	BELDEN PART #'S SINGLE PAIR: #1120A FOUR PAIR: #1049A SINGLE TRIAD: #1121A	GROUND SHIELD DRAIN WIRE AT PANEL END ONLY.
EHTERNET (CAT5e) COMMUNICATION CONDUCTORS	SOLID BARE COPPER CONDUCTORS, 300V FEP INSULATION & JACKET, 100% COVERAGE ALUMINUM FOIL-POLYESTER TAPE SHIELD WITH STRANDED TINNED COPPER DRAIN WIRE	FOUR PAIR #24 BELDEN 1585LC	GROUND SHIELD DRAIN WIRE AT PANEL END ONLY. ROUTE ALL DEVICENET & CAT5e CABLES IN SEPARATE DEDICATED RACEWAY.
UNLESS INDICATED OTHERWISE ALL CONDUCTORS SHALL USE THE FOLLOWING COLOR CODE: 480-VOLT POWER (PHASE) CONDUCTORS PHASE A: BROWN PHASE B: ORANGE PHASE C: YELLOW 120/208-VOLT POWER (PHASE) CONDUCTORS PHASE A: BLACK PHASE B: RED PHASE C: BLUE NEUTRAL: WHITE, NO EXCEPTIONS GROUND: GREEN OR BARE, NO EXCEPTIONS 24 VOLT DC CONDUCTORS +24VDC: RED or RED W/GRAY STRIPE -24VDC: BLACK or BLACK W/GRAY STRIPE CONTROL AND INSTRUMENT CONDUCTORS MAY BE COLOR CODED PER MANUFACTURER'S STANDARD		NOTES: 1) COLOR CODING FOR NO. 6 AWG AND SMALLER CONDUCTORS SHALL BE BY USING CONDUCTORS WITH CONTINUOUS COLOR EMBEDDED IN THE INSULATION. 2) COLOR CODING FOR CONDUCTORS LARGER THAN NO. 6, SHALL BE BY: A) CONTINUOUS COLOR EMBEDDED IN THE INSULATION, OR B) BLACK CABLE WITH SCOTCH 35 OR APPROVED EQUAL MARKING (PHASE) TAPE. AT EVERY ACCESSIBLE LOCATION A MINIMUM 3" LONG SECTION OF CONDUCTOR SHALL BE SPIRAL WRAPPED. NOTE THAT PHASE TAPE MAY NOT BE USED ON COLORED CABLE, BLACK CABLE ONLY. 3) GROUNDING - PROVIDE A SEPARATE GREEN INSULATED EQUIPMENT GROUNDING CONDUCTOR IN EACH RACEWAY. DO NOT USE THE CONDUIT AS AN EQUIPMENT GROUNDING CONDUCTOR. EQUIPMENT GROUNDING CONDUCTORS SHALL BE OF THE SAME TYPE AS THE PHASE CONDUCTORS AND SHALL BE SIZED AS INDICATED ON THE DRAWINGS. CONDUCTORS NOT INDICATED SHALL BE SIZED IN ACCORDANCE WITH THE NATIONAL ELECTRICAL CODE.	

WIRING & DEVICE SYMBOL LEGEND

SYMBOL	DESCRIPTION	SYMBOL	DESCRIPTION
SS-##	HOME RUN TO PANEL & BREAKER(S) INDICATED. SHORT DASH INDICATES HOT CONDUCTOR, LONG DASH INDICATES NEUTRAL CONDUCTOR, CURVED DASH INDICATES GROUND CONDUCTOR. IF NOT SPECIFICALLY INDICATED, PROVIDE 2#12 AWG & 1#12 AWG GROUND.	⊖	125V, 20A, DUPLEX RECEPTACLE
⊖		⊖	LINE VOLTAGE THERMOSTAT
⊖		⊖	DIGITAL THERMOSTAT, MODULATING
#	ELECTRICAL ITEM - SEE EQUIPMENT SCHEDULE	\$	SNAP SWITCH / SMALL MOTOR DISCONNECT
1/4	MOTOR (HORESPower INDICATED)	T\$	TIMER SWITCH
MD	MOTORIZED DAMPER - SEE MECHANICAL	⊖	GROUND

INSTRUMENTATION LEGEND

NOTE: SEE SCHEDULES SHEET M1.1 FOR EQUIPMENT SPECIFICATIONS.

SYMBOL	SERVICE/FUNCTION	SYMBOL	SERVICE/FUNCTION
TT	TEMPERATURE TRANSMITTER	LCA	GLYCOL TANK LOW COOLANT ALARM
TTT	THERMOMETER/TEMP TRANSMITTER	FS	DAY TANK/HOPPER FLOAT SWITCH
PTC	COOLING SYSTEM PRESSURE TRANSMITTER	GLS	GLYCOL TANK LEVEL SENSOR PROBE
PTH	HEAT RECOVERY PRESSURE TRANSMITTER	LS	INTERMEDIATE TANK TWO POINT FLOAT TYPE LEVEL SWITCH
DP	DIFFERENTIAL PRESSURE GAUGE/SWITCH		

REVISION #1
 ISSUED FOR
 CONSTRUCTION
 AUGUST 2025



1	UPDATED FOR 2025 AEA STANDARDS	8/15/25	BCG
REV.	DESCRIPTION	DATE	BY
 ALASKA ENERGY AUTHORITY			
PROJECT: MANOKOTAK POWER PLANT UPGRADE PROJECT			
TITLE: ELECTRICAL LEGENDS & SCHEDULES			
DRAWN BY: JTD		SCALE: AS NOTED	
DESIGNED BY: CWV/BCG		DATE: 9/28/23	
FILE NAME: MANO PP E1-E2		SHEET: E1.1	
PROJECT NUMBER:			

P.O. 111405, Anchorage, AK 99511 (907)349-0100



PROJECT OVERVIEW:

- 1) THE EXISTING POWER PLANT EQUIPMENT HAS REACHED THE END OF ITS USEFUL LIFE AND THIS UPGRADE PROJECT INVOLVES A COMPLETE RENOVATION OF THE PLANT. THE PROJECT INCLUDES BASE BID AND ADDITIVE ALTERNATE TASKS. SEE SPECIFICATIONS SECTION 01 11 13 SUMMARY OF WORK FOR DELINEATION OF BASE BID AND ADDITIVE ALTERNATE TASKS.
- 2) ELECTRICAL UPGRADES INCLUDE BUT ARE NOT LIMITED TO NEW STEP UP TRANSFORMER, NEW DIESEL-ELECTRIC GENERATORS, NEW SWITCHGEAR, NEW POWER AND CONTROL WIRING, NEW CONTROL PANELS, AND MISCELLANEOUS UPGRADES TO THE PLANT STATION SERVICE ELECTRICAL SYSTEM.
- 3) THE PROJECT ALSO INCLUDES MAJOR RENOVATION OF THE MECHANICAL SYSTEMS AND MINOR RENOVATION OF THE BUILDING. SEE MECHANICAL AND STRUCTURAL.

TEMPORARY GENERATION NOTES:


- 1) THIS POWER PLANT PROVIDES PRIME POWER TO THE COMMUNITY OF MANOKOTAK. THE UPGRADE PROJECT REQUIRES SUBSTANTIAL MODIFICATIONS TO THE POWER PLANT WHICH WILL RENDER IT UNAVAILABLE FOR PROVIDING COMMUNITY POWER DURING A LARGE PORTION OF THE WORK.
- 2) AN EXISTING 450kW EMERGENCY STANDBY GENERATOR (E-GEN) HAS BEEN INSTALLED IN A CONNEX ADJACENT TO THE POWER PLANT. THE CONTRACTOR SHALL CONNECT THE E-GEN TO THE ELECTRICAL DISTRIBUTION SYSTEM AS INDICATED ON SHEET E1.3.
- 3) THE UTILITY WILL OPERATE THE STANDBY GENERATOR TO PROVIDE POWER TO THE COMMUNITY DURING MAJOR RENOVATION OF THE POWER PLANT. THE CONTRACTOR SHALL DEVELOP A SCHEDULE AND WORK PLAN TO LIMIT THE TIME NEEDED TO BE ON STANDBY POWER TO NO MORE THAN THREE CALENDAR MONTHS. THE SCHEDULE MUST BE APPROVED BY THE AUTHORITY AND THE UTILITY PRIOR TO BEGINNING WORK. WRITTEN NOTICE SHALL BE PROVIDED TO THE AUTHORITY AND THE UTILITY OF ANY EVENTS THAT MAY POTENTIALLY ALTER THE APPROVED SCHEDULE.

1 OVERALL ELECTRICAL AREA PLAN
E1.2

REVISION #1
ISSUED FOR
CONSTRUCTION
AUGUST 2025




1	UPDATED FOR 2025 AEA STANDARDS	8/15/25	BCG
REV.	DESCRIPTION	DATE	BY
 ALASKA ENERGY AUTHORITY			
PROJECT:		MANOKOTAK POWER PLANT UPGRADE PROJECT	
TITLE:		OVERALL ELECTRICAL AREA PLAN	
 Gray Stassel Engineering, Inc.		DRAWN BY: JTD DESIGNED BY: CWV/BCG FILE NAME: MANO PP E1-E2 PROJECT NUMBER:	SCALE: AS NOTED DATE: 9/28/23 SHEET: E1.2
P.O. 111405, Anchorage, AK 99511 (907)349-0100			

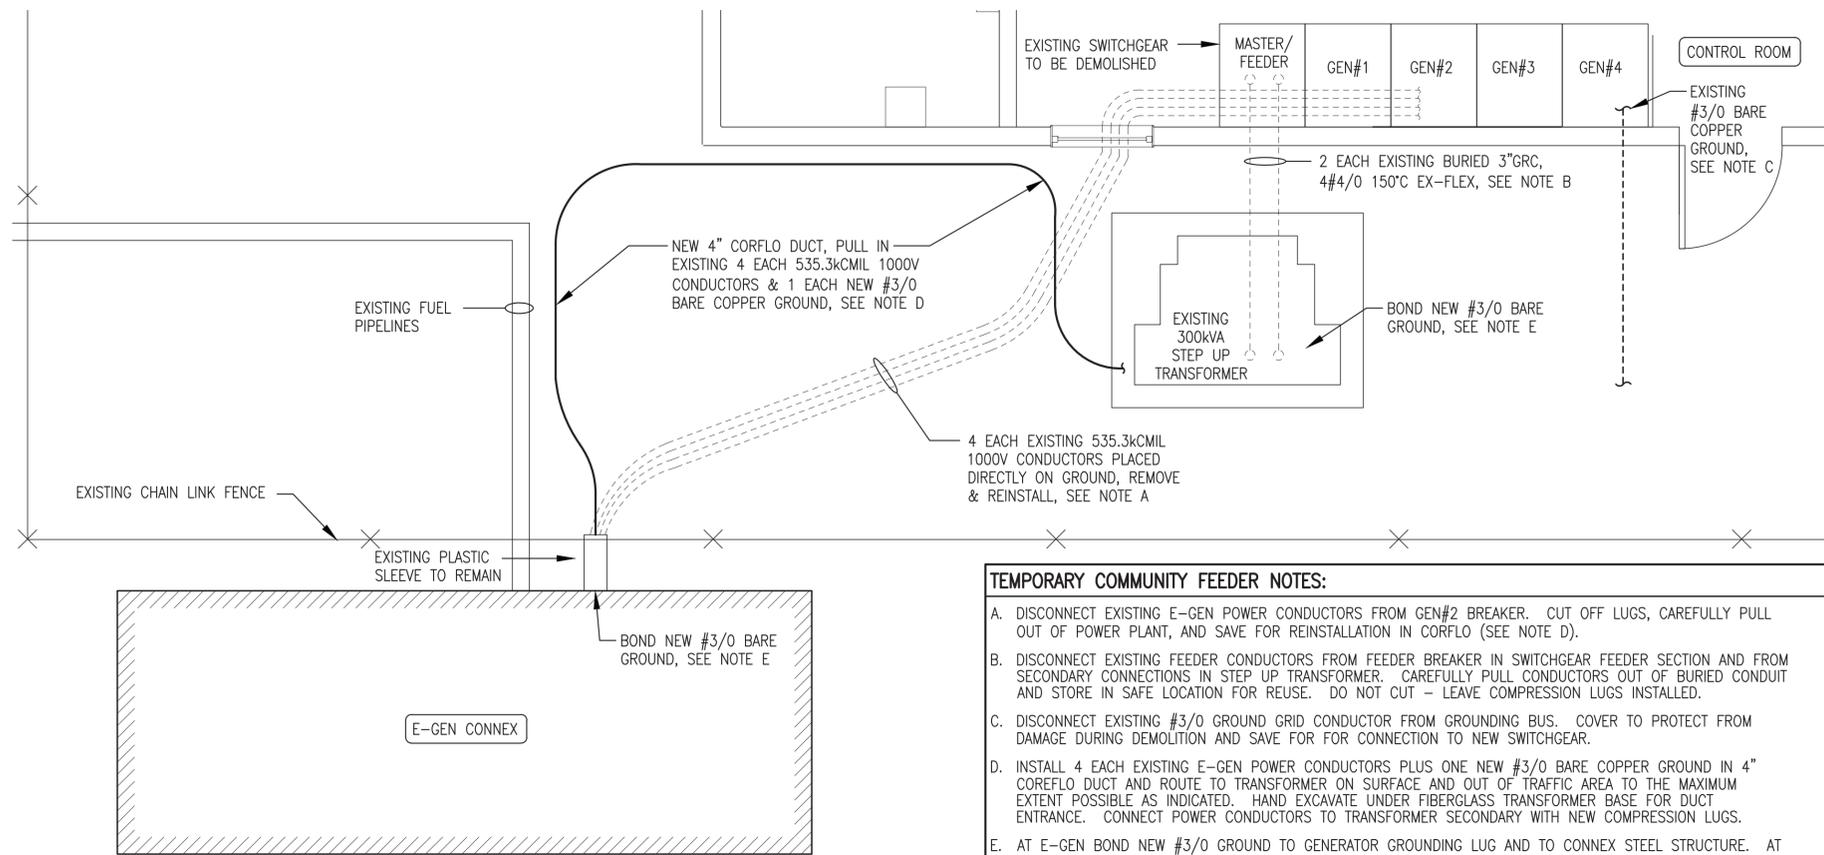


- TEMPORARY COMMUNITY FEEDER NOTES:**
- DISCONNECT EXISTING E-GEN POWER CONDUCTORS FROM GEN#2 BREAKER. CUT OFF LUGS, CAREFULLY PULL OUT OF POWER PLANT, AND SAVE FOR REINSTALLATION IN CORFLO (SEE NOTE D).
 - DISCONNECT EXISTING FEEDER CONDUCTORS FROM FEEDER BREAKER IN SWITCHGEAR FEEDER SECTION AND FROM SECONDARY CONNECTIONS IN STEP UP TRANSFORMER. CAREFULLY PULL CONDUCTORS OUT OF BURIED CONDUIT AND STORE IN SAFE LOCATION FOR REUSE. DO NOT CUT - LEAVE COMPRESSION LUGS INSTALLED.
 - DISCONNECT EXISTING #3/0 GROUND GRID CONDUCTOR FROM GROUNDING BUS. COVER TO PROTECT FROM DAMAGE DURING DEMOLITION AND SAVE FOR CONNECTION TO NEW SWITCHGEAR.
 - INSTALL 4 EACH EXISTING E-GEN POWER CONDUCTORS PLUS ONE NEW #3/0 BARE COPPER GROUND IN 4" COREFLO DUCT AND ROUTE TO TRANSFORMER ON SURFACE AND OUT OF TRAFFIC AREA TO THE MAXIMUM EXTENT POSSIBLE AS INDICATED. HAND EXCAVATE UNDER FIBERGLASS TRANSFORMER BASE FOR DUCT ENTRANCE. CONNECT POWER CONDUCTORS TO TRANSFORMER SECONDARY WITH NEW COMPRESSION LUGS.
 - AT E-GEN BOND NEW #3/0 GROUND TO GENERATOR GROUNDING LUG AND TO CONNEX STEEL STRUCTURE. AT TRANSFORMER BOND NEW #3/0 TO EXISTING GROUND.

1 TEMPORARY COMMUNITY FEEDER PLAN
E1.3 3/8"=1'-0"

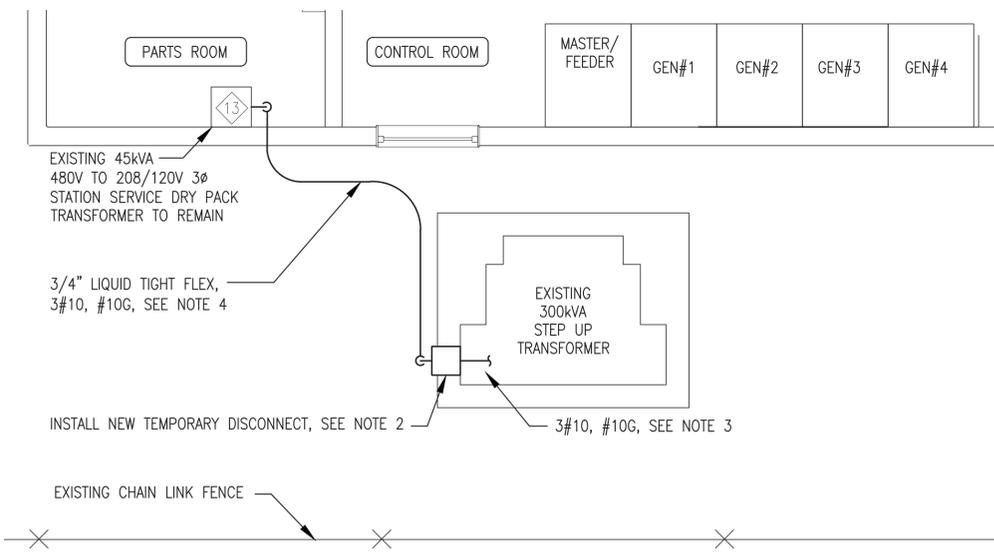

- TEMPORARY STATION SERVICE POWER NOTES:**
- THE PRIMARY PURPOSE OF THIS TEMPORARY POWER IS TO PROVIDE 3 PHASE POWER FOR TESTING ALL STATION SERVICE CIRCUITS AND EQUIPMENT IN THE RENOVATED POWER PLANT PRIOR TO STARTING NEW GENERATORS. CONTRACTOR MAY INSTALL AT THE BEGINNING OF THE PROJECT TO PROVIDE CONSTRUCTION POWER FOR TOOLS AND LIGHTS. THE STATION SERVICE MAY NOT BE USED FOR ELECTRIC HEAT.
 - INSTALL TEMPORARY NEMA 3R, 30A, 3P, 600V FUSED DISCONNECT OR ENCLOSED BREAKER ON EXTERIOR OF EXISTING (OLD) PAD-MOUNT TRANSFORMER CABINET.
 - ROUTE CONDUCTORS INTO TRANSFORMER THROUGH CHASE NIPPLE AND CONNECT TO 480V 3P SECONDARY.
 - ROUTE CONDUCTORS IN 3/4" LIQUID TIGHT FLEX FROM TEMPORARY DISCONNECT THROUGH BUILDING WALL TO PRIMARY ON EXISTING DRY PACK TRANSFORMER.
 - THE ENTIRE TEMPORARY POWER CIRCUIT, INCLUDING DISCONNECT, CONDUIT AND CONDUCTORS TO BE REMOVED ALONG WITH THE OLD PAD-MOUNT STEP UP TRANSFORMER IN PREPARATION FOR INSTALLATION OF THE NEW PAD-MOUNT STEP UP TRANSFORMER AND CONNECTION OF THE EXISTING STATION SERVICE DRY PACK TRANSFORMER TO THE NEW SWITCHGEAR STATION SERVICE BREAKER.
 - PLUG AND PATCH HOLES IN BUILDING EXTERIOR WALLS TO MATCH EXISTING AFTER REMOVING TEMPORARY POWER CONDUCTORS.

2 TEMPORARY STATION SERVICE POWER PLAN
E1.3 3/8"=1'-0"

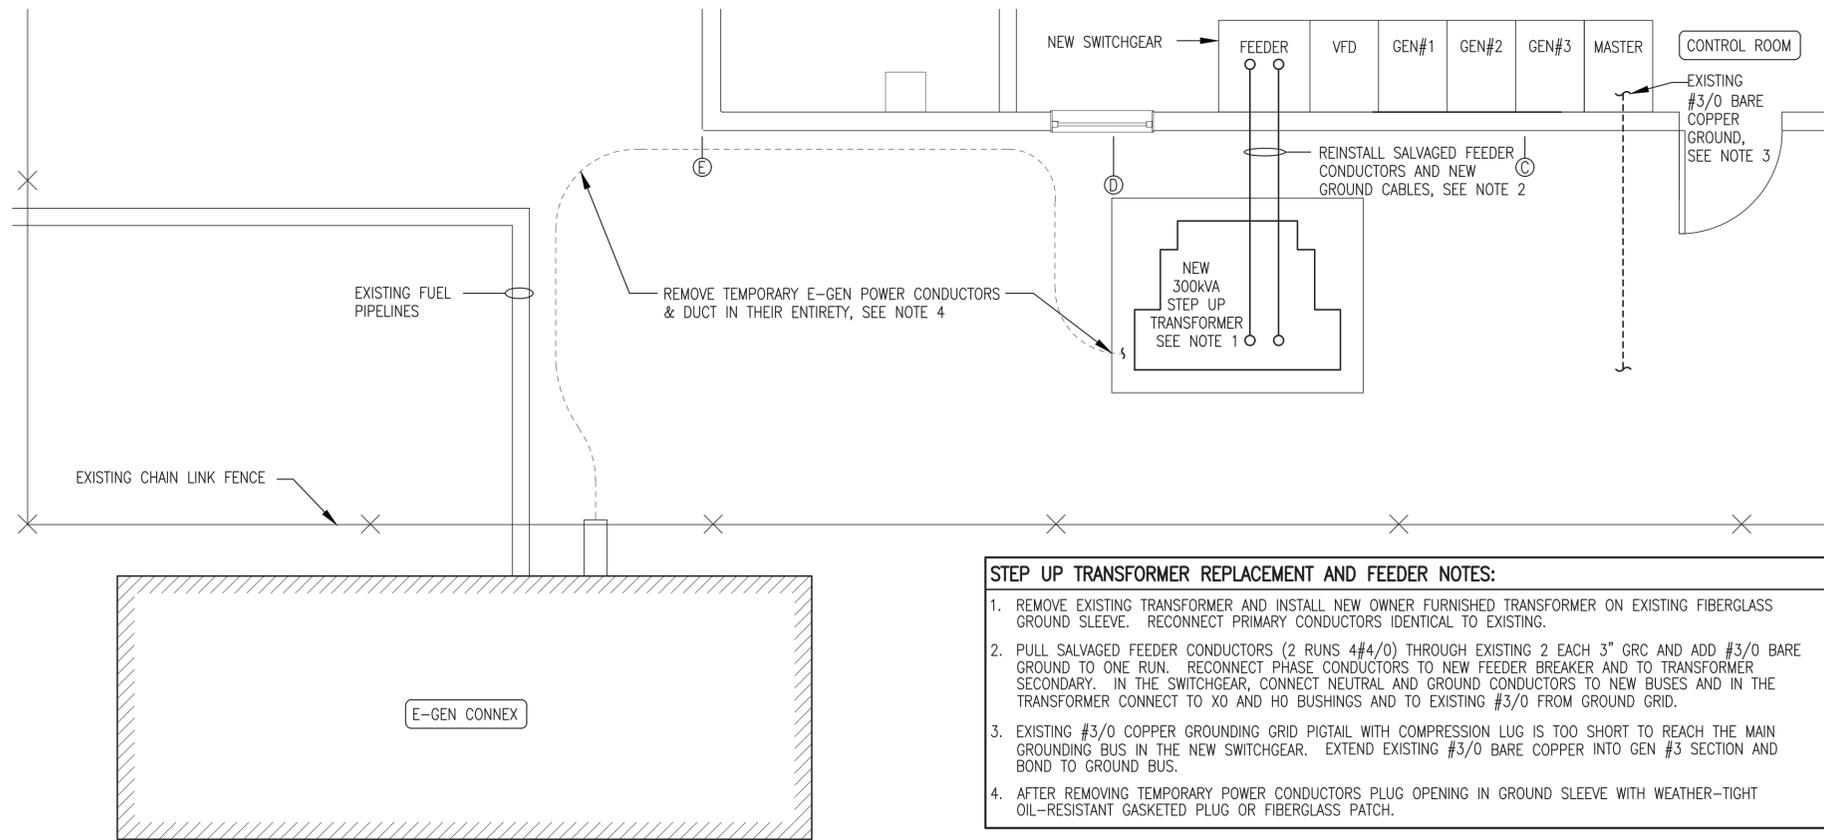


- STEP UP TRANSFORMER REPLACEMENT AND FEEDER NOTES:**
- REMOVE EXISTING TRANSFORMER AND INSTALL NEW OWNER FURNISHED TRANSFORMER ON EXISTING FIBERGLASS GROUND SLEEVE. RECONNECT PRIMARY CONDUCTORS IDENTICAL TO EXISTING.
 - PULL SALVAGED FEEDER CONDUCTORS (2 RUNS 4#4/0) THROUGH EXISTING 2 EACH 3" GRC AND ADD #3/0 BARE GROUND TO ONE RUN. RECONNECT PHASE CONDUCTORS TO NEW FEEDER BREAKER AND TO TRANSFORMER SECONDARY. IN THE SWITCHGEAR, CONNECT NEUTRAL AND GROUND CONDUCTORS TO NEW BUSES AND IN THE TRANSFORMER CONNECT TO XO AND HO BUSHINGS AND TO EXISTING #3/0 FROM GROUND GRID.
 - EXISTING #3/0 COPPER GROUNDING GRID PIGTAIL WITH COMPRESSION LUG IS TOO SHORT TO REACH THE MAIN GROUNDING BUS IN THE NEW SWITCHGEAR. EXTEND EXISTING #3/0 BARE COPPER INTO GEN #3 SECTION AND BOND TO GROUND BUS.
 - AFTER REMOVING TEMPORARY POWER CONDUCTORS PLUG OPENING IN GROUND SLEEVE WITH WEATHER-TIGHT OIL-RESISTANT GASKETED PLUG OR FIBERGLASS PATCH.

3 STEP UP TRANSFORMER REPLACEMENT AND FINAL POWER PLAN
E1.3 3/8"=1'-0"

REVISION #1
ISSUED FOR
CONSTRUCTION
AUGUST 2025


1	UPDATED FOR 2025 AEA STANDARDS	8/15/25	BCG
REV.	DESCRIPTION	DATE	BY
PROJECT: MANOKOTAK POWER PLANT UPGRADE PROJECT			
TITLE: TEMPORARY POWER & STEP UP TRANSFORMER REPLACEMENT PLANS			
DRAWN BY: JTD		SCALE: AS NOTED	
DESIGNED BY: CWV/BCG		DATE: 9/28/23	
FILE NAME: MANO PP E1-E2		SHEET: E1.3	
PROJECT NUMBER: P.O. 111405, Anchorage, AK 99511 (907)349-0100			

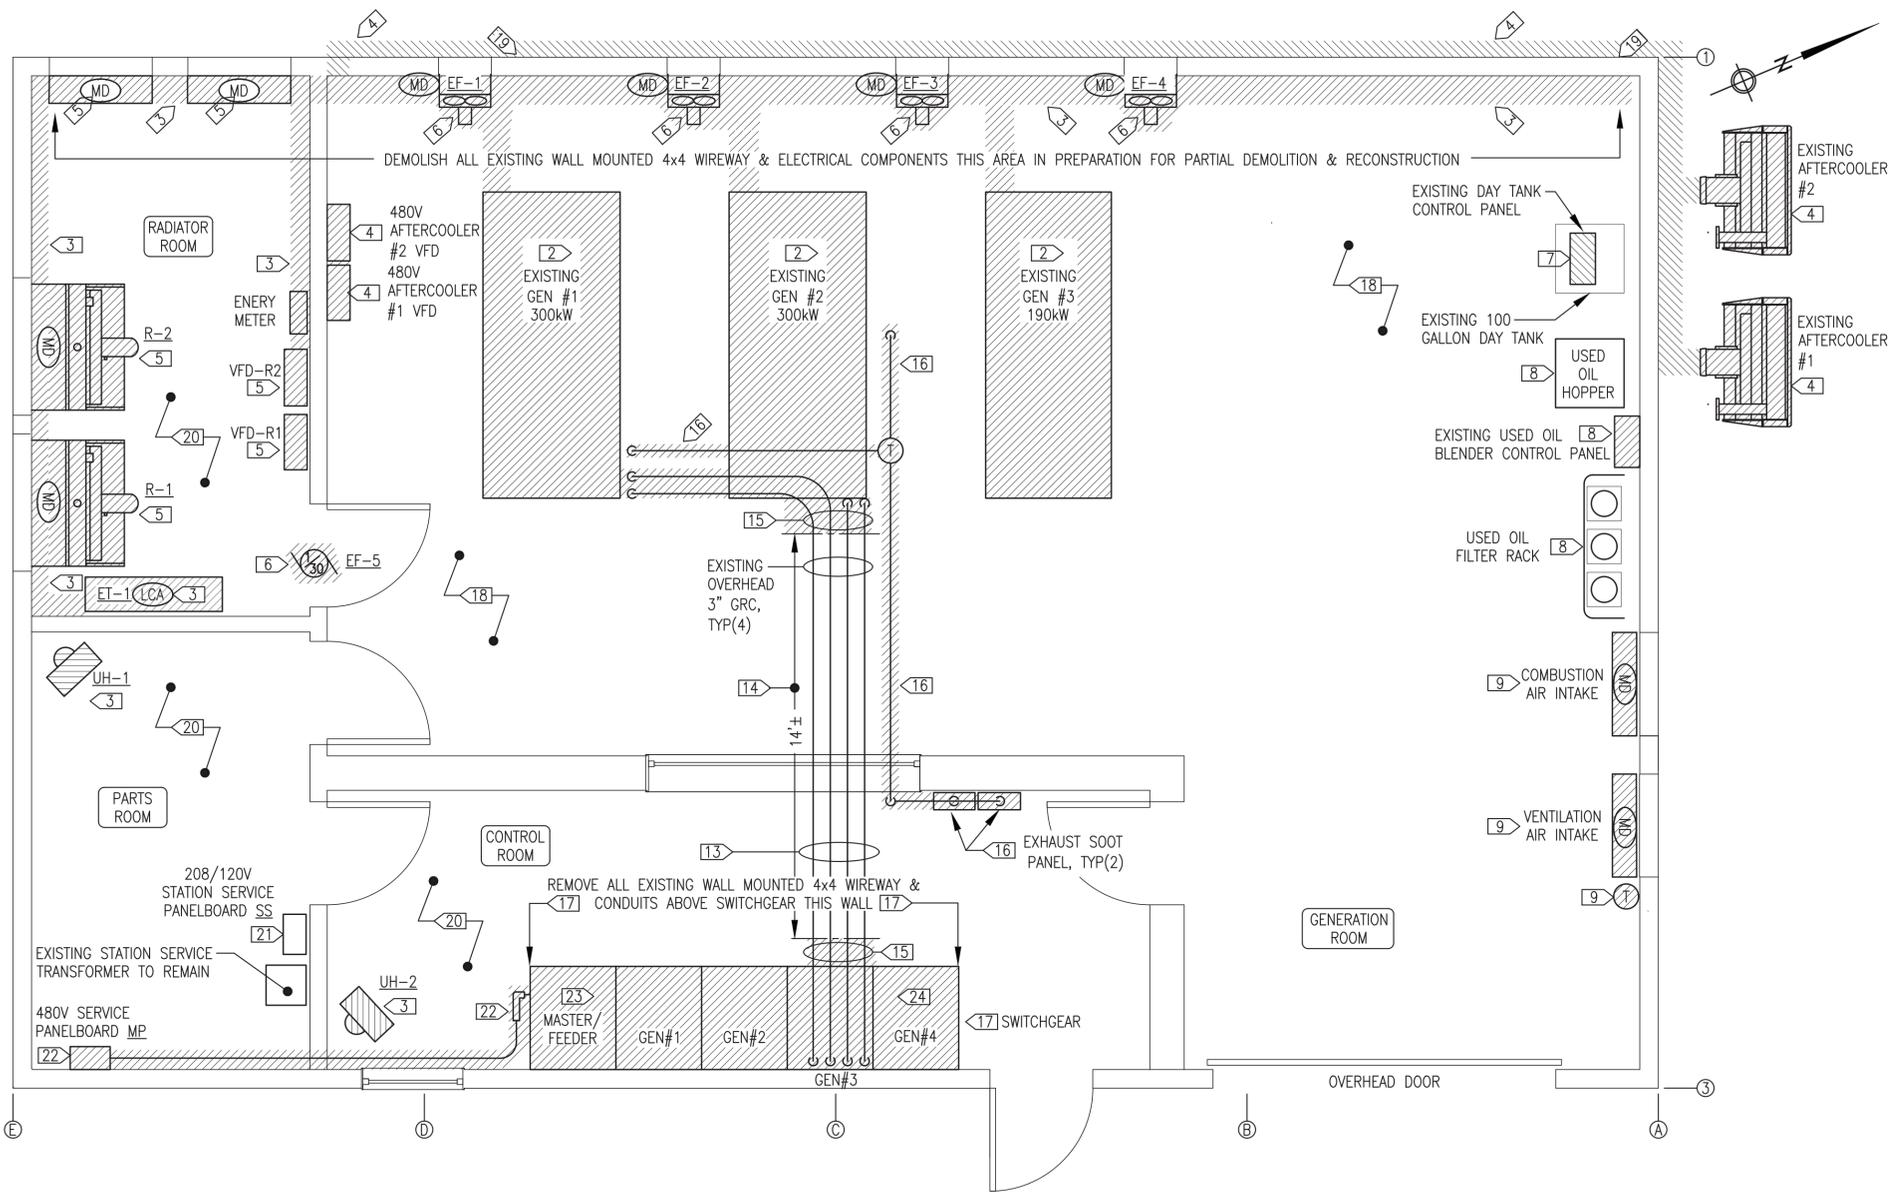

POWER PLANT ELECTRICAL DEMOLITION SPECIFIC NOTES:

- 1 SEE MECHANICAL DEMOLITION
- 2 DISCONNECT AND DEMOLISH ALL GENERATOR ELECTRICAL COMPONENTS IN THEIR ENTIRETY INCLUDING ALL ASSOCIATED 480V POWER, 24V CONTROL, AND 120/208V STATION SERVICE CONDUCTORS, CABLES, BATTERIES, CONTROLLERS, VOLTAGE REGULATORS, ENGINE "HOTSTART" PREHEATERS, CONDUIT, STRUT RACKS, ETC. REMOVE ALL CONDUCTORS BACK TO SOURCE.
- 3 DEMOLISH ALL ELECTRICAL EQUIPMENT AND DEVICES AS SPECIFICALLY INDICATED OR WITHIN HATCHED AREAS INCLUDING RECEPTACLES, SWITCHES, THERMOSTATS, BATTERY CHARGERS, THERMOSTATS, MOTOR CONNECTIONS, DAMPER ACTUATORS, CRANK CASE VENTILATION FAN, ETC., ALONG WITH ASSOCIATED CONDUCTORS BACK TO SOURCE UNLESS INDICATED OTHERWISE OR WHERE REQUIRED FOR NEW EQUIPMENT INSTALLATION. DEMOLISH 4x4 WIREWAY ON BACK WALL AS REQUIRED FOR WALL DEMOLITION AND RECONSTRUCTION. ALL OTHER WALL MOUNTED 4x4 WIREWAY TO REMAIN. REMOVE ALL BRANCH RACEWAY ASSOCIATED WITH DEMOLISHED ITEMS.
- 4 DEMOLISH WIRING AND DEVICES ASSOCIATED WITH EXISTING CHARGE AIR COOLERS INCLUDING VFD's, DISCONNECTS, CONDUITS, AND CONDUCTORS. REMOVE ALL CONDUCTORS BACK TO SOURCE.
- 5 DEMOLISH WIRING AND DEVICES ASSOCIATED WITH EXISTING RADIATORS INCLUDING VFD's, DISCONNECTS, CONDUITS, DAMPERS ACTUATORS, AND CONDUCTORS. REMOVE ALL CONDUCTORS BACK TO SOURCE.
- 6 DEMOLISH FANS (SEE MECHANICAL) AND ASSOCIATED THERMOSTATS AND WIRING.
- 7 DEMOLISH EXISTING DAY TANK CONTROL PANEL ALONG WITH ALL ASSOCIATED EQUIPMENT, INSTRUMENTATION, RACEWAY, AND DEVICES. COIL POWER CONDUCTORS IN A SAFE LOCATION AND TAPE ENDS FOR REUSE.
- 8 DEMOLISH EXISTING USED OIL BLENDER CONTROL PANEL ALONG WITH ALL ASSOCIATED EQUIPMENT, INSTRUMENTATION, RACEWAY, AND DEVICES.
- 9 TWO EACH EXISTING VENTILATION AIR INTAKE DAMPERS AND ONE EACH LINE VOLTAGE THERMOSTAT TO BE DEMOLISHED IN PREPARATION FOR REPLACEMENT (SEE MECHANICAL). CAREFULLY REMOVE EXISTING CONDUCTORS AND RE-ROUTE TO OLD RADIATOR ROOM FOR REUSE AT NEW VENTILATION LOCATION.
- 10 SEE MECHANICAL.
- 11 SEE MECHANICAL NEW WORK.
- 12 REMOVE EXISTING UNDER-SLAB GENERATOR POWER AND CONTROL CONDUCTORS IN THEIR ENTIRETY AND TURN OVER TO UTILITY. ABANDON ALL EMPTY UNDER-SLAB CONDUIT IN PLACE. CUT OFF CONDUIT SLAB PENETRATIONS FLUSH WITH SLAB BOTH ENDS AND GROUT FULL TO BLEND WITH FLOOR SURFACE. MINIMUM 22 PENETRATIONS TOTAL.
- 13 REMOVE EXISTING GEN#1 AND GEN#2 POWER CONDUCTORS FROM EXISTING 3" OVERHEAD CONDUIT IN THEIR ENTIRETY AND TURN OVER TO UTILITY.
- 14 4 EACH STRAIGHT SECTIONS OF EMPTY 3" OVERHEAD GRC TO REMAIN.
- 15 DEMOLISH 3" GRC FROM LAST THREADED JOINT ON OVERHEAD STRAIGHT SECTIONS DOWN TO CONNECTIONS TO EXISTING GEN#1 AND GEN#2 ONE END AND DOWN TO ASSOCIATED SWITCHGEAR SECTION OTHER END.
- 16 DEMOLISH 2 EACH ENGINE EXHAUST SYSTEM SOOT CONTROL PANELS WITH ASSOCIATED OVERHEAD CONDUIT AND CONDUCTORS TO GEN#1 AND GEN#2 PARTICULATE FILTERS. REMOVE PANEL POWER CONDUCTORS BACK TO SOURCE.
- 17 DEMOLISH EXISTING SWITCHGEAR. REMOVE 4x4 WIREWAY AND CONDUITS ABOVE SWITCHGEAR IN PREPARATION FOR INSTALLATION OF NEW 10x10 WIREWAY AND NEW SWITCHGEAR.
- 18 REMOVE ALL EXISTING FLUORESCENT LIGHT FIXTURES, CEILING FANS, CAMERAS, AND MISCELLANEOUS DEVICES FROM GENERATION ROOM CEILING IN PREPARATION FOR DEGREASING AND CLEANING. ALL FAN CIRCUITS, INCLUDING CONDUIT, CONDUCTORS AND DISCONNECTS, TO BE DEMOLISHED. LIGHTING CIRCUITS, INCLUDING CONDUIT, CONDUCTOR AND DISCONNECTS, TO REMAIN UNLESS REQUIRED TO BE RELOCATED FOR MODIFICATIONS. COVER AND SEAL ALL CEILING AND WALL MOUNTED ELECTRICAL AND FIRE DETECTION DEVICES TO REMAIN IN PLACE PRIOR TO PRESSURE WASHING. SEE MECHANICAL DEMOLITION.
- 19 SEE STRUCTURAL AND SHEET M2.2 FOR BACK WALL RENOVATION.
- 20 REMOVE ALL EXISTING FLUORESCENT LIGHT FIXTURES, CEILING FANS, CAMERAS, AND MISCELLANEOUS DEVICES FROM CONTROL ROOM AND PARTS ROOMS CEILINGS.
- 21 EXISTING 208/120V 3-PHASE STATION SERVICE PANEL SS TO REMAIN. DISCONNECT AND REMOVE BREAKERS AND CONDUCTORS FOR DEMOLISHED/ABANDONED CIRCUITS.
- 22 DEMOLISH 480V PANELBOARD MP ALONG WITH ALL ASSOCIATED CONDUCTORS AND CONDUIT INCLUDING TO STATION SERVICE TRANSFORMER, AND TO FEEDER BREAKER IN SWITCHGEAR.
- 23 2 EACH EXISTING UNDERGROUND 3" GRC FEEDER CONDUITS TO REMAIN. CAREFULLY REMOVE EXISTING 2 EACH 4#3/0 FEEDER CONDUCTORS FOR PROTECTION. TAPE ENDS, COIL, AND STORE IN SAFE LOCATION TO PROTECT FOR REINSTALLATION IN NEW SWITCHGEAR AND NEW STEP UP TRANSFORMER.
- 24 DISCONNECT EXISTING #3/0 GROUND GRID CONDUCTOR FROM GROUNDING BUS. COVER TO PROTECT FROM DAMAGE DURING DEMOLITION AND SAVE FOR CONNECTION TO NEW SWITCHGEAR
- 25 SEE MECHANICAL.
- 26 SEE MECHANICAL.

1 ABOVE GRADE ELECTRICAL DEMOLITION PLAN
E2 3/8"=1'

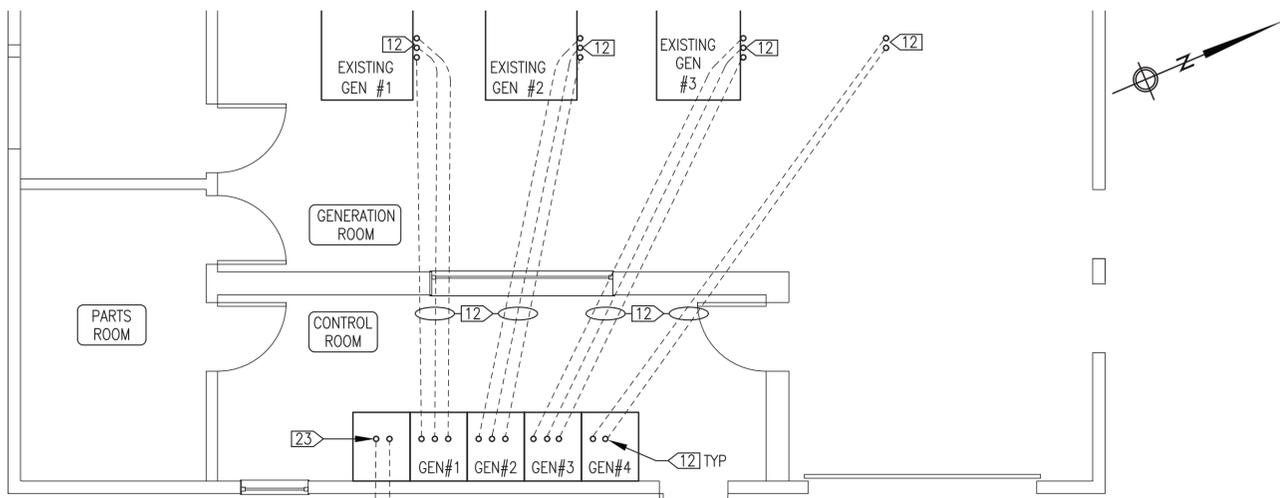

POWER PLANT ELECTRICAL DEMOLITION GENERAL NOTES:


1. THIS PLANT PROVIDES PRIME POWER TO THE COMMUNITY OF MANOKOTAK. KEEP UNPLANNED OUTAGES TO A MINIMUM AND COORDINATE ALL REQUIRED OUTAGES WITH THE UTILITY. SEE TEMPORARY POWER GENERATION PLAN SHEET E1.3.
2. THE BACK (WEST) WALL WILL BE SUBSTANTIALLY MODIFIED IN ORDER TO ACCOMMODATE RELOCATED MECHANICAL OPENINGS AND SUPPORTS. THE INTENT IS TO REMOVE ALL EXISTING INTERIOR AND EXTERIOR EQUIPMENT, RACEWAYS AND DEVICES FROM THE WALL PRIOR TO MODIFYING THE STRUCTURE UNLESS SPECIFICALLY INDICATED OTHERWISE. SEE SPECIFIC NOTE 19.
3. ALL ITEMS TO REMAIN UNLESS SPECIFICALLY INDICATED FOR REMOVAL. AREAS CONTAINING EXISTING EQUIPMENT TO BE REMOVED INDICATED BY HATCHING.
4. ONLY MAJOR DEMOLITION ITEMS AND AREAS SHOWN THIS SHEET. REMOVAL OF SMALL ELECTRICAL COMPONENTS AS REQUIRED FOR MISCELLANEOUS UPGRADES SHOWN WITH NEW WORK PLANS OR ON DETAILS.
5. ENSURE ALL EQUIPMENT AND CIRCUITS TO BE REMOVED ARE DE-ENERGIZED PRIOR TO BEGINNING DEMOLITION. LOCK AND TAG OUT ALL AFFECTED CIRCUIT BREAKERS AND DISCONNECTS.
6. TAKE ALL PRECAUTIONS TO MINIMIZE DAMAGE TO ELECTRICAL EQUIPMENT AND CONDUCTORS BEING SALVAGED FOR REUSE. TURN ALL REMOVED MATERIALS AND EQUIPMENT OVER TO THE UTILITY FOR FINAL DISPOSITION IF NOT REUSED.

2 UNDER-SLAB ELECTRICAL DEMOLITION PLAN
E2 1/4"=1'

REVISION #1
ISSUED FOR
CONSTRUCTION
AUGUST 2025



1	UPDATED FOR 2025 AEA STANDARDS	8/15/25	BCG
REV.	DESCRIPTION	DATE	BY
<p>ALASKA ENERGY AUTHORITY</p>			
PROJECT: MANOKOTAK POWER PLANT UPGRADE PROJECT			
TITLE: ELECTRICAL DEMOLITION PLAN			
DRAWN BY: JTD		SCALE: AS NOTED	
DESIGNED BY: CWV/BCG		DATE: 9/28/23	
FILE NAME: MANO PP E1-2		SHEET: E2	
P.O. 111405, Anchorage, AK 99511 (907)349-0100			

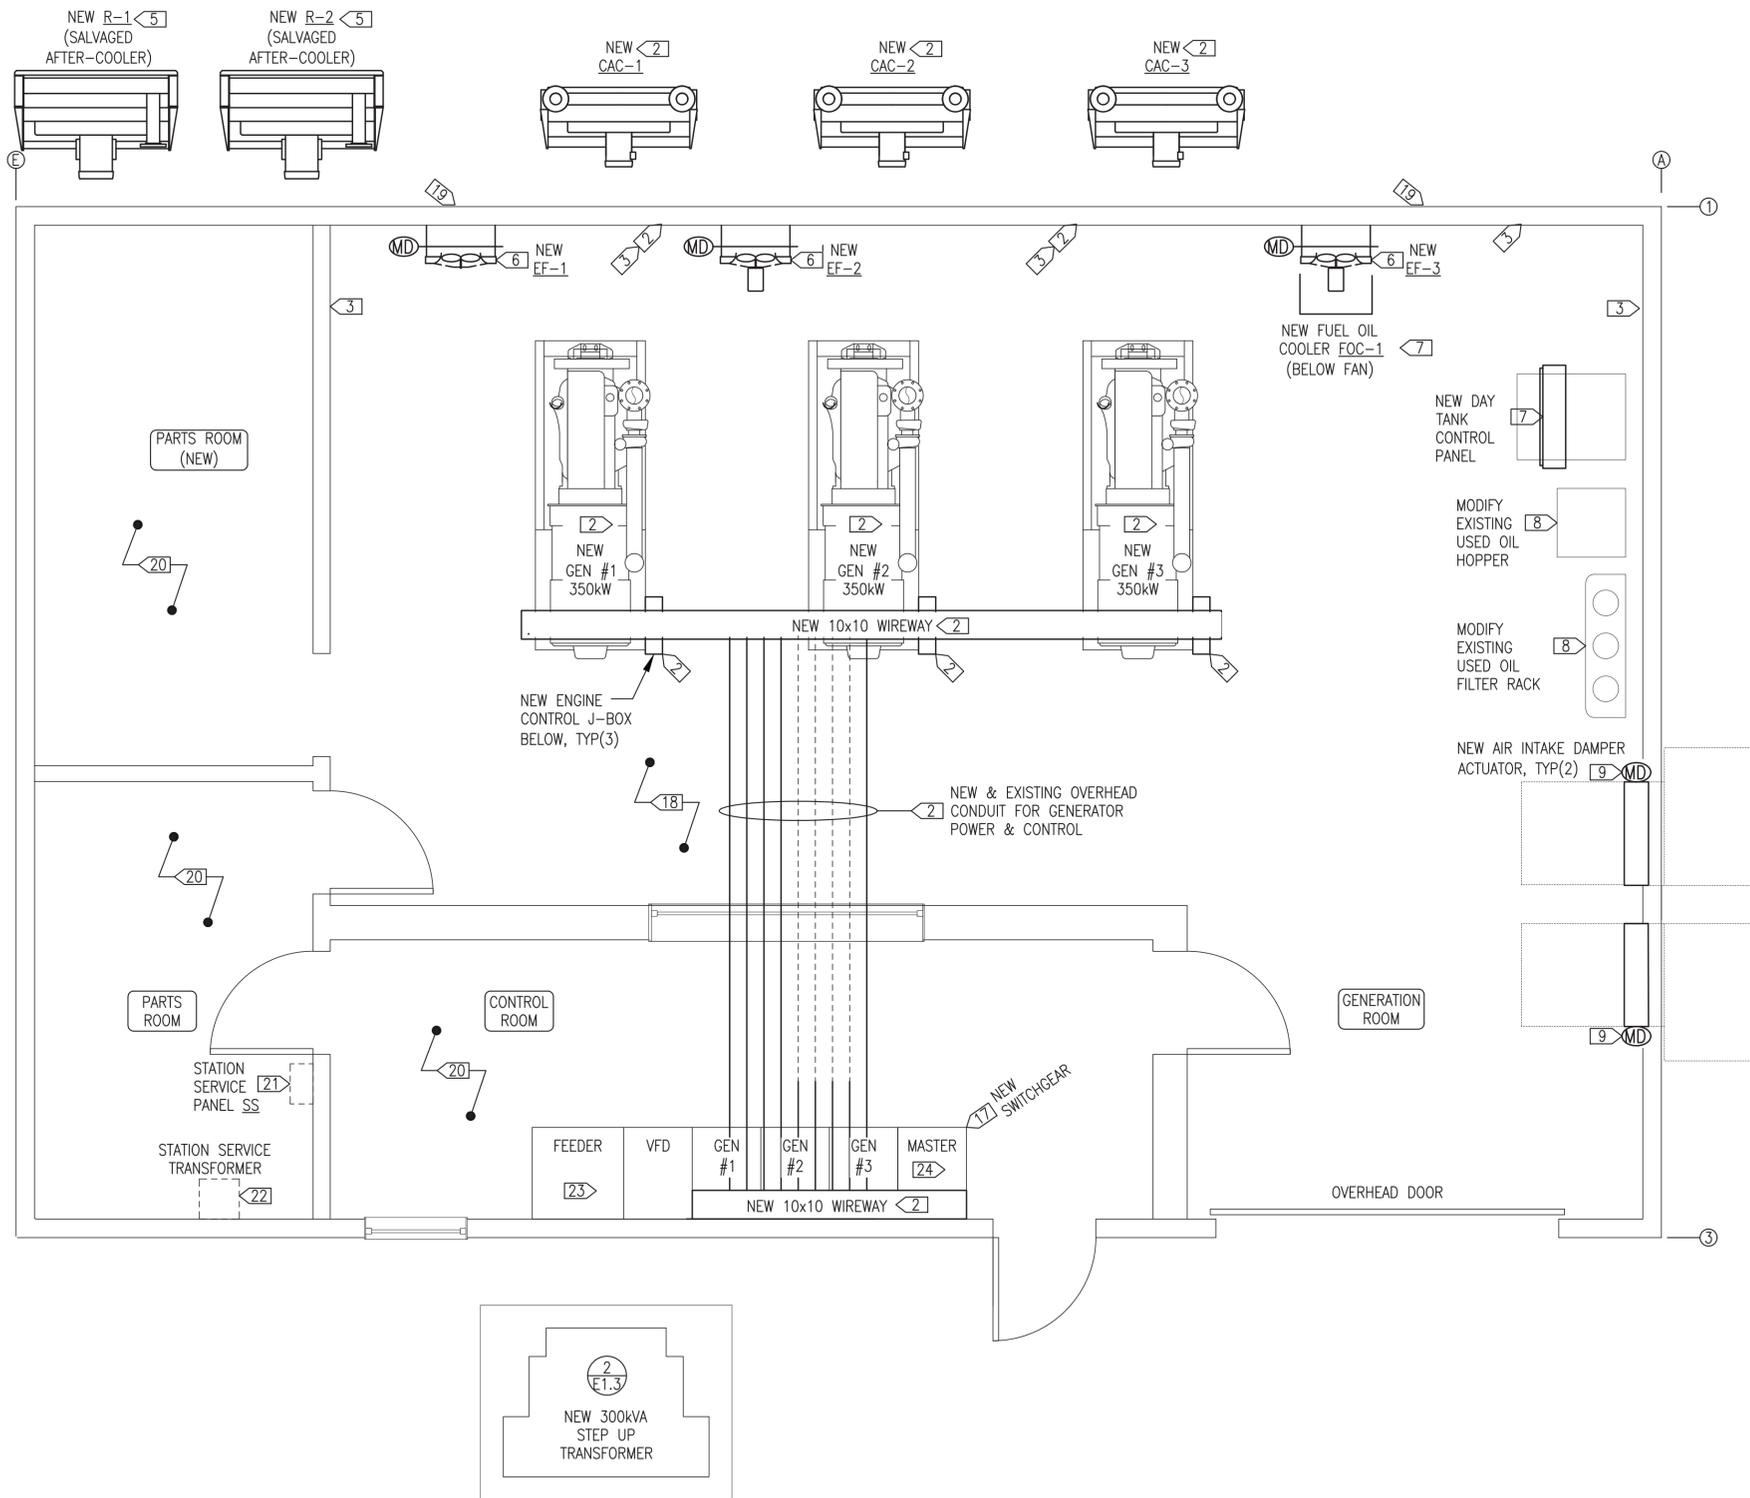

- POWER PLANT ELECTRICAL NEW WORK GENERAL NOTES:**
- EXISTING EQUIPMENT AND RACEWAYS TO REMAIN IN SERVICE SHOWN WITH LIGHT DASHED LINES.
 - NEW EQUIPMENT AND RACEWAYS SHOWN WITH DARK SOLID LINES.
 - NOT ALL EXISTING EQUIPMENT AND RACEWAYS SHOWN. SEE ATTACHED RECORD DRAWINGS OF ORIGINAL POWER PLANT CONSTRUCTION FOR ADDITIONAL DETAIL ON SYSTEMS NOT BEING MODIFIED.
 - ONLY MAJOR NEW WORK ITEMS SHOWN THIS SHEET. SEE NEW WORK PLANS AND DETAILS FOR ADDITIONAL DETAIL.
 - SEE SHEETS E3.1-3.4 FOR WIREWAY & GENERAL EQUIPMENT LAYOUT, ELEVATIONS, AND DETAILS.
 - SEE SHEETS E4.1-4.2 FOR STATION SERVICE AND LIGHTING MODIFICATION PLANS.
 - SEE SHEET E5 FOR DATA/CONTROL MODIFICATION PLANS.
 - SEE SHEETS E6.1-E6.3 FOR SWITCHGEAR MODIFICATIONS AND NEW GENERATOR J-BOXES.
 - SEE SHEETS E7.1-E7.4 FOR DAY TANK AND INTERMEDIATE TANK CONTROL PANELS.
 - SEE SHEET FS1 FOR FIRE SUPPRESSION SYSTEM DEMOLITION AND NEW WORK.
- POWER PLANT ELECTRICAL NEW WORK SPECIFIC NOTES:**
- SEE MECHANICAL DEMOLITION
 - INSTALL NEW POWER, CONTROL, AND SENSING CONDUCTORS AND RACEWAYS AS REQUIRED FOR NEW GENERATORS, CHARGE AIR COOLERS, AND RADIATORS. COORDINATE WITH MECHANICAL.
 - INSTALL NEW RACEWAYS, EQUIPMENT, DEVICES AND CIRCUITS THIS AREA. RECONNECT TO EXISTING WHERE SHOWN ON PLANS AND DETAILS.
 - SEE MECHANICAL AND ELECTRICAL DEMOLITION.
 - INSTALL NEW POWER AND SENSING CIRCUITS FOR SALVAGED RADIATORS FROM NEW VFD'S IN SWITCHGEAR.
 - SEE MECHANICAL
 - INSTALL NEW DAY TANK CONTROL PANEL AND ALL ASSOCIATED POWER AND CONTROL CIRCUITS FOR DAY TANK AND USED OIL BLENDER.
 - CONNECT TO NEW INSTRUMENTATION ON REFURBISHED EXISTING USED OIL FILTER BANK.
 - CONNECT NEW AIR INTAKE DAMPER ACTUATORS TO NEW AND/OR EXISTING CIRCUITS.
 - SEE MECHANICAL DEMOLITION.
 - SEE MECHANICAL NEW WORK.
 - SEE ELECTRICAL DEMOLITION.
 - INSTALL NEW SWITCHGEAR. SEE SHEETS E6.1 AND E6.2.
 - INSTALL NEW LED LIGHTS IN GENERATION ROOM AFTER PRESSURE WASHING CEILING. CONNECT TO NEW AND/OR EXISTING WIRING AS SHOWN ON PLANS.
 - SEE STRUCTURAL AND SHEET M2.2 FOR BACK WALL RENOVATION.
 - INSTALL NEW LED LIGHTS IN CONTROL ROOM AND PARTS ROOMS. CONNECT TO EXISTING WIRING AS SHOWN ON PLANS.
 - REVISE PANELBOARD WIRING AND RE-LABEL CIRCUIT SCHEDULE.
 - CONNECT EXISTING 480V DRY PACK TRANSFORMER TO STATION SERVICE BREAKER IN SWITCHGEAR.
 - PULL SALVAGED FEEDER CONDUCTORS (2 RUNS 4#4/0) THROUGH EXISTING 2 EACH 3" GRC AND ADD #3/0 BARE GROUND TO ONE RUN. RECONNECT PHASE CONDUCTORS TO NEW FEEDER BREAKER AND TO TRANSFORMER. IN THE SWITCHGEAR CONNECT NEUTRAL AND GROUND CONDUCTORS TO NEW BUSES AND IN THE TRANSFORMER CONNECT TO X0 AND HO BUSHINGS AND TO EXISTING #3/0 FROM GROUND GRID.
 - EXTEND EXISTING #3/0 FROM GROUND GRID UNDER NEW MASTER SECTION, ROUTE INTO GEN #3 SECTION, AND BOND TO GROUND BUS.
 - SEE MECHANICAL.
 - SEE MECHANICAL.


1 ELECTRICAL NEW WORK PLAN
E3.1 3/8"=1'

REVISION #1
ISSUED FOR
CONSTRUCTION
AUGUST 2025




1	UPDATED FOR 2025 AEA STANDARDS	8/15/25	BCG
REV.	DESCRIPTION	DATE	BY
 ALASKA ENERGY AUTHORITY			
PROJECT: MANOKOTAK POWER PLANT UPGRADE PROJECT			
TITLE: ELECTRICAL EQUIPMENT LAYOUT & NEW WORK OVERVIEW			
DRAWN BY: JTD		SCALE: AS NOTED	
DESIGNED BY: CWV/BCG		DATE: 9/28/23	
FILE NAME: MANO PP E3-5		SHEET:	
PROJECT NUMBER:		E3.1	
P.O. 111405, Anchorage, AK 99511 (907)349-0100			




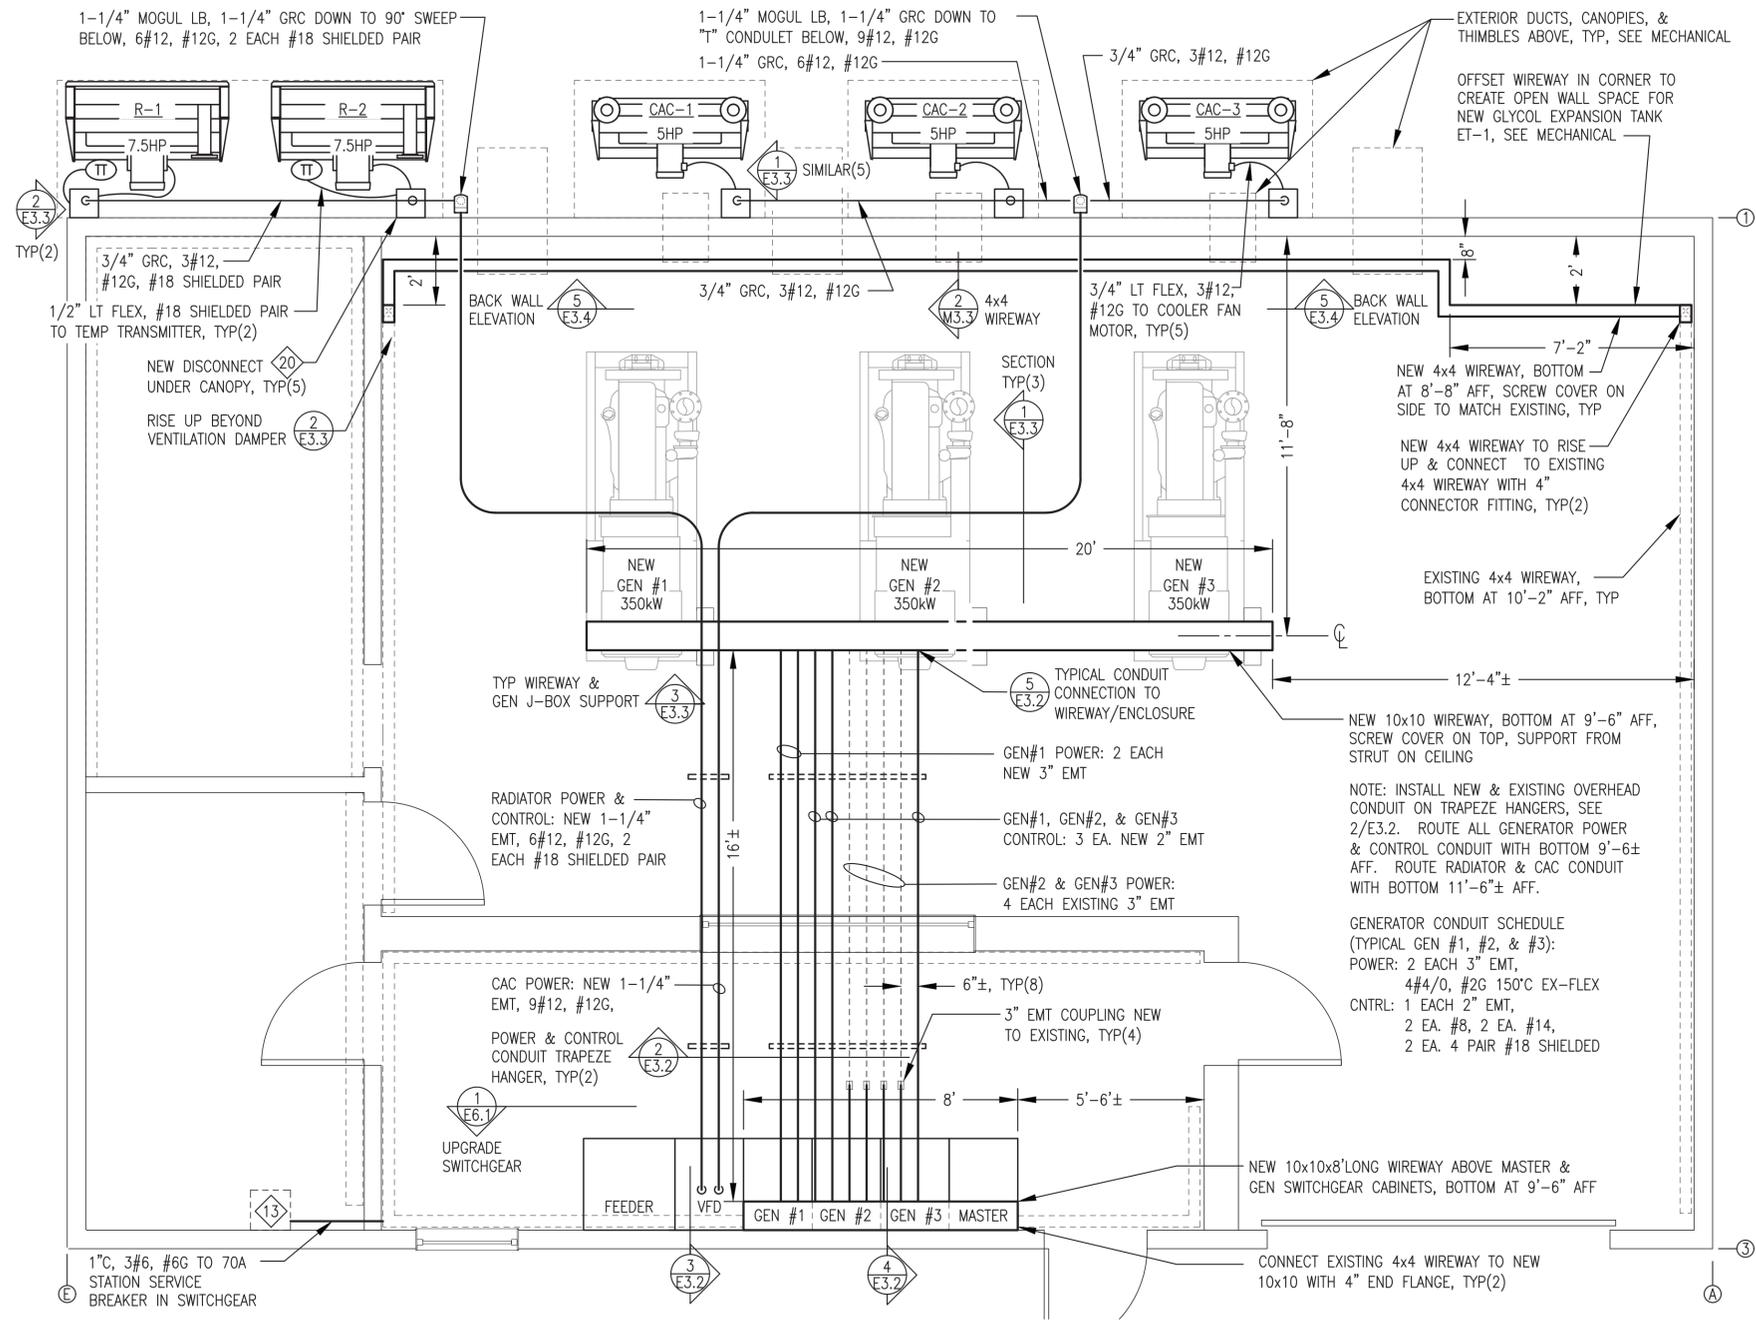


1 WIREWAY, CONDUIT, & EQUIPMENT LAYOUT PLAN
E3.2 3/8"=1'

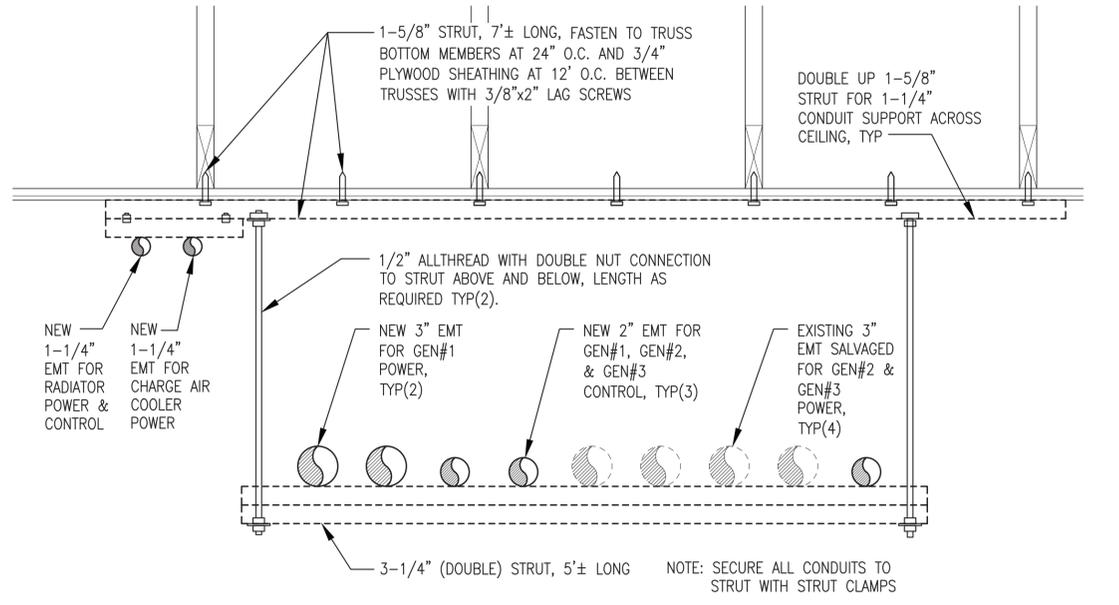


2 NEW POWER & CONTROL CONDUIT TRAPEZE HANGER
E3.2 NO SCALE

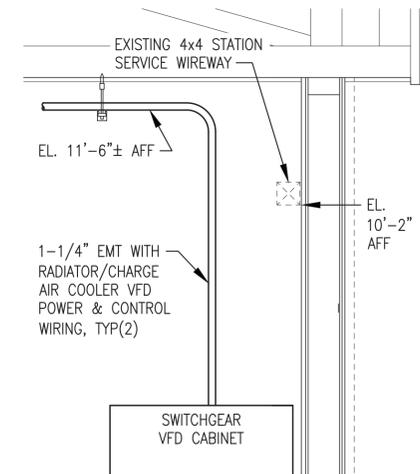

3 TYPICAL SECTION AT VFD
E3.2 3/8"=1'

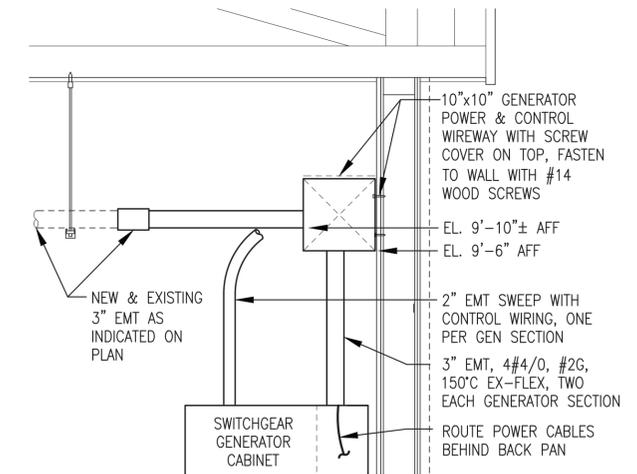

4 TYPICAL SECTION AT GEN SECTION
E3.2 3/8"=1'

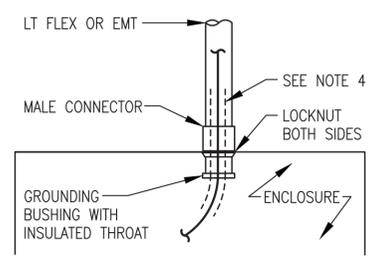


5 TYP ENCLASURE CONNECTION
E3.2 NO SCALE

- NOTES:**
- 1) THIS DETAIL APPLIES TO CONNECTIONS TO WIREWAY, GENERATOR ENCLOSURES, SWITCHGEAR, AND PANELS.
 - 2) AT A MINIMUM INSTALL GROUNDING BUSHING ON ALL GENERATOR POWER CONDUIT, COMMUNITY FEEDER CONDUIT, STATION SERVICE FEEDERS, AND WHERE OTHERWISE INDICATED OR REQUIRED. BOND GROUNDING BUSHING TO EQUIPMENT GROUNDING CONDUCTOR.
 - 3) INSTALL PLASTIC BUSHING WHERE GROUNDING BUSHING IS NOT REQUIRED.
 - 4) ON GENERATOR ENCLOSURES PROTECT CABLES FROM WEAR BY INSTALLING 1 EACH 12" LONG LAYER OF HEAVY WALL HEAT SHRINK CENTERED IN CONNECTOR.


REVISION #1
ISSUED FOR
CONSTRUCTION
AUGUST 2025




1	UPDATED FOR 2025 AEA STANDARDS	8/15/25	BCG
REV.	DESCRIPTION	DATE	BY
PROJECT: MANOKOTAK POWER PLANT UPGRADE PROJECT			
TITLE: WIREWAY, CONDUIT, & EQUIPMENT LAYOUT PLAN & DETAILS			
	DRAWN BY: JTD	SCALE: AS NOTED	
	DESIGNED BY: CWV/BCG	DATE: 9/28/23	
	FILE NAME: MANO PP E3-5	SHEET:	
	PROJECT NUMBER:		E3.2

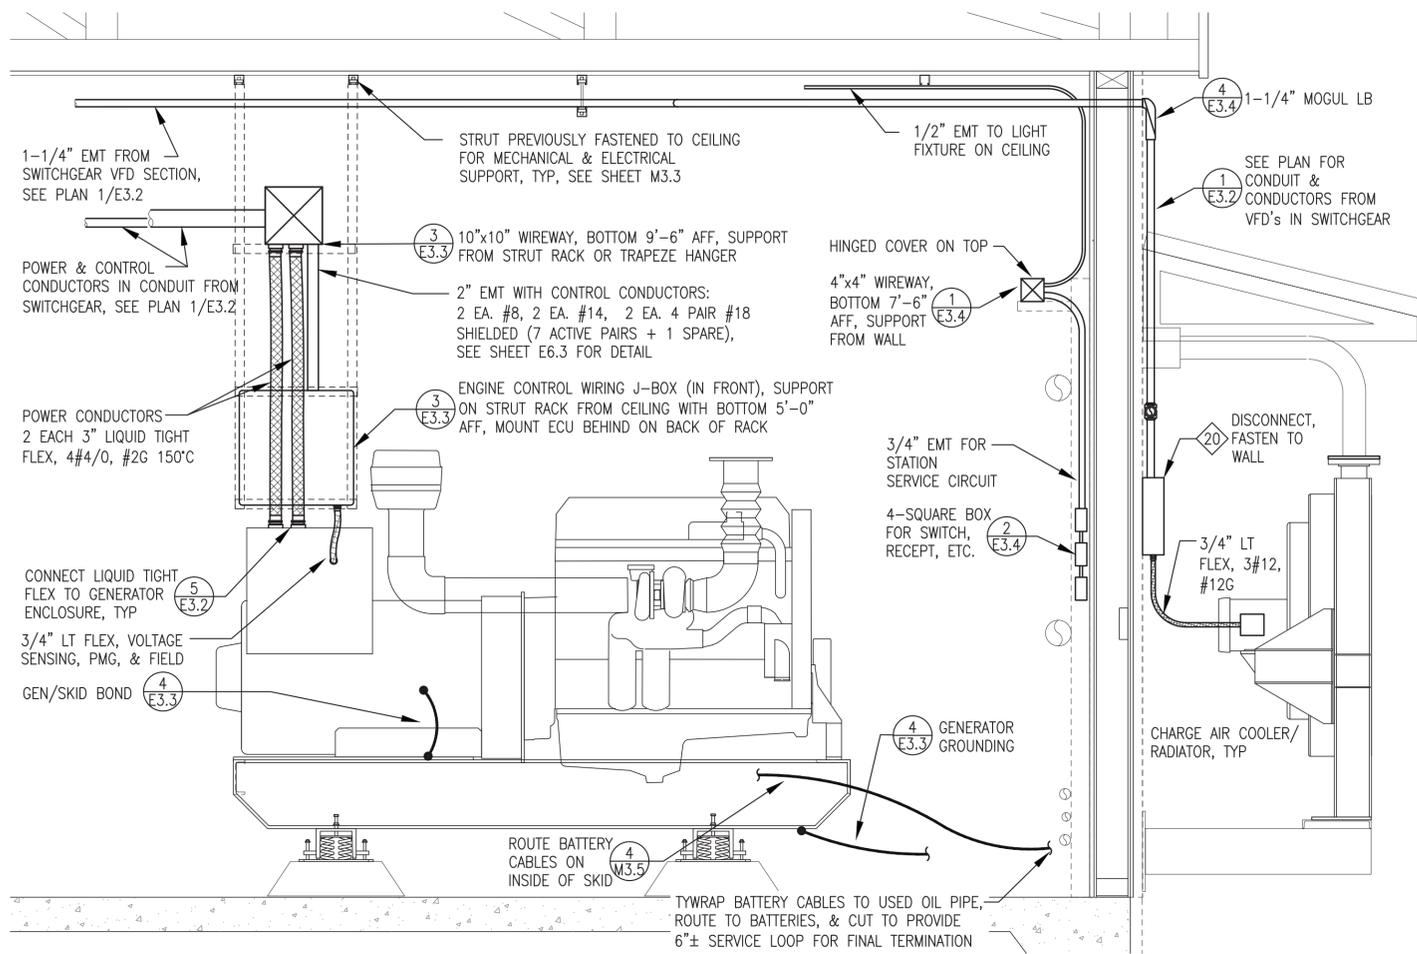


1 TYPICAL BUILDING SECTION AT GENERATOR (CAC SHOWN, RADIATOR SIMILAR)
E3.3 3/4"=1"

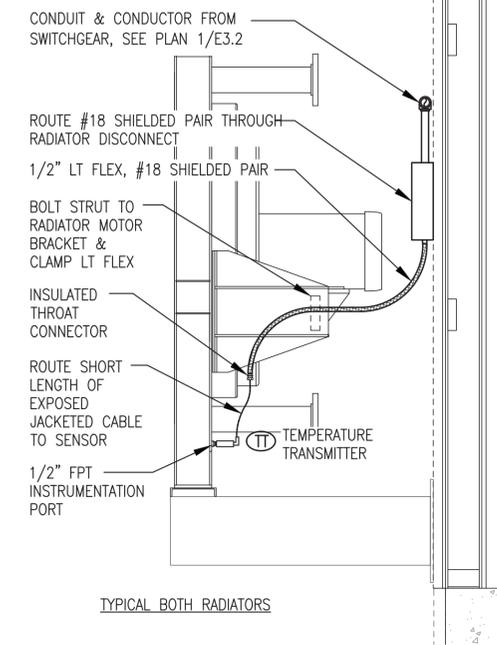


2 RADIATOR TEMP TRANSMITTER
E3.3 3/4"=1"

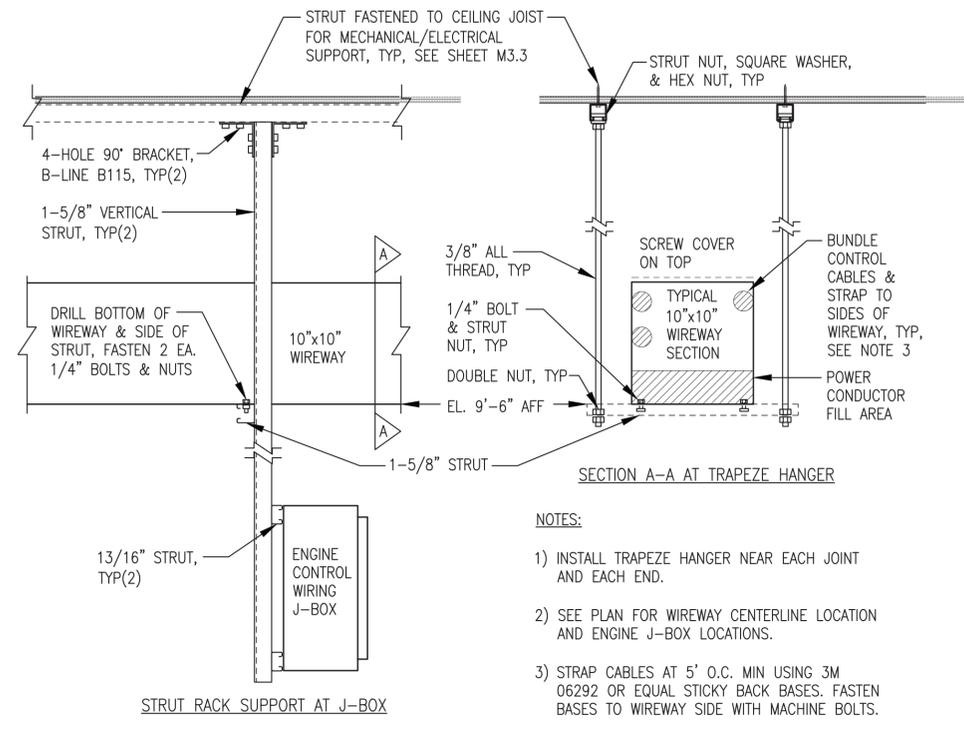

3 10x10 WIREWAY AND GENERATOR J-BOX INSTALLATION
E3.3 NO SCALE

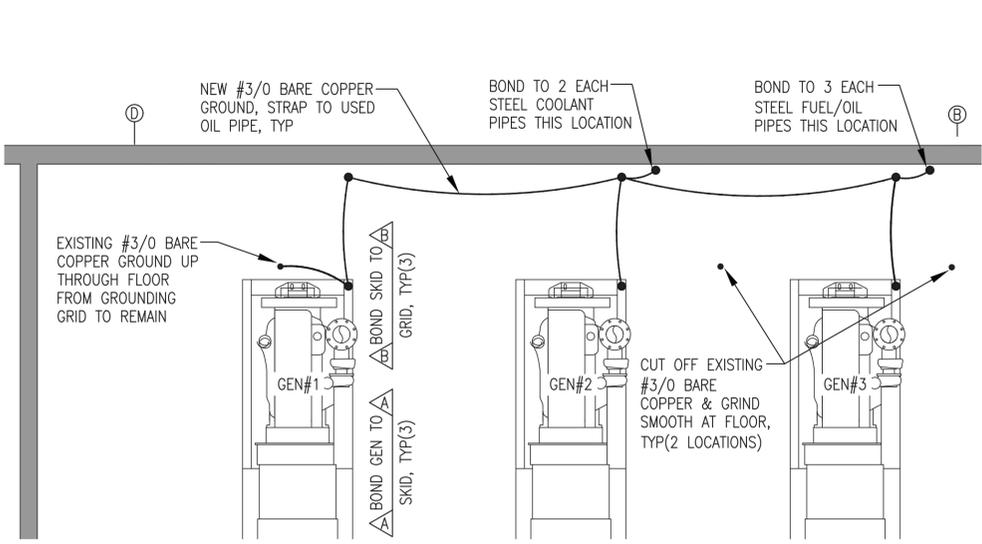

4 GENERATOR GROUNDING PLAN
E3.3 NO SCALE

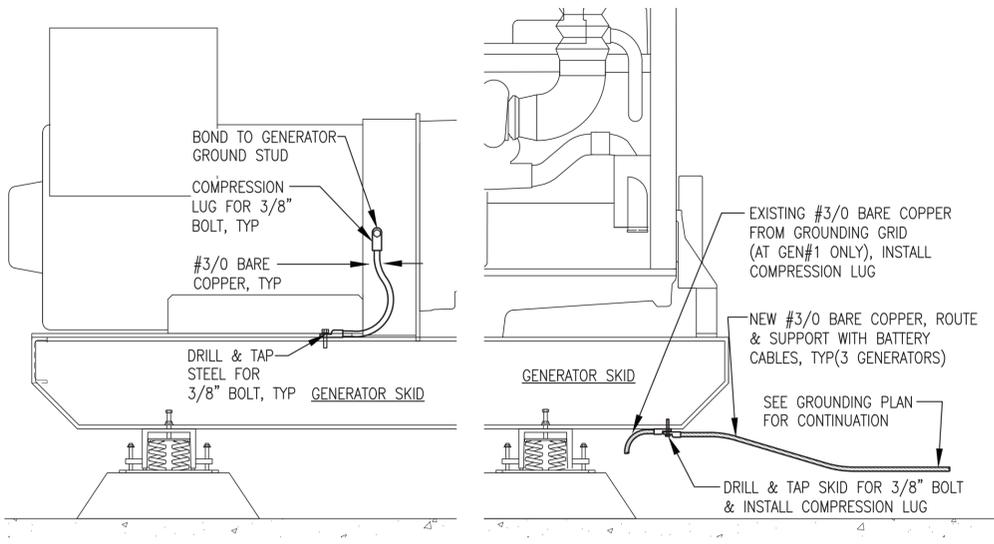


SECTION A-A SECTION B-B


REVISION #1
ISSUED FOR
CONSTRUCTION
AUGUST 2025



1	UPDATED FOR 2025 AEA STANDARDS	8/15/25	BCG
REV.	DESCRIPTION	DATE	BY
 ALASKA ENERGY AUTHORITY			
PROJECT: MANOKOTAK POWER PLANT UPGRADE PROJECT			
TITLE: SECTIONS, DETAILS, & GENERATOR GROUNDING			
DRAWN BY: JTD		SCALE: AS NOTED	
DESIGNED BY: CWV/BCG		DATE: 9/28/23	
FILE NAME: MANO PP E3-E5		SHEET: E3.3	
PROJECT NUMBER: P.O. 111405, Anchorage, AK 99511 (907)349-0100			

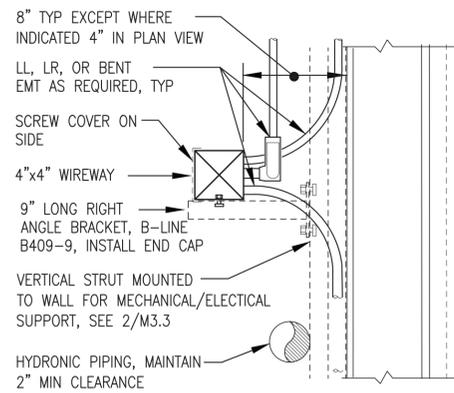


1 4" WIREWAY ARRANGEMENT AT BACK WALL
E3.4 NO SCALE

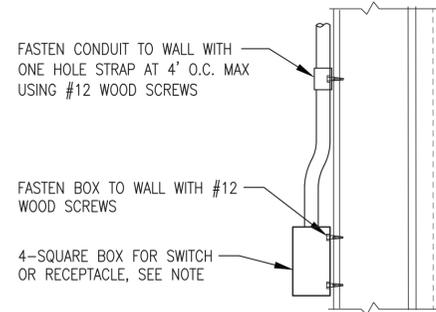

NOTE: INSTALL THERMOSTATS & TIMER SWITCHES IN DEEP SINGLE GANG BELL BOX INSTEAD OF 4-SQUARE BOX.

2 TYPICAL INTERIOR DEVICE MOUNTING
E3.4 NO SCALE


NOTE: FOR CONDUIT WALL PENETRATIONS WITHOUT BELL BOX, INSTALL CONDUIT BODY & SEAL ALL AROUND CONDUIT WITH POLYURETHANE CAULK.

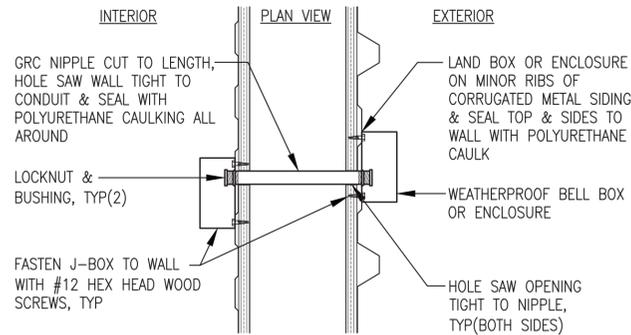


3 TYP EXTERIOR WALL-MOUNT DEVICE
E3.4 NO SCALE

NOTES:

- UPON COMPLETION OF CIRCUIT TESTING PACK GRC NIPPLE THROUGH WALL WITH DUCT SEAL.
- THIS DETAIL FOR TYPICAL SMALL CONDUIT WALL PENETRATIONS LESS THAN 2" DIAMETER. SEE PLANS & DETAILS FOR CONDUIT WALL PENETRATIONS OF 2" AND LARGER SIZE.

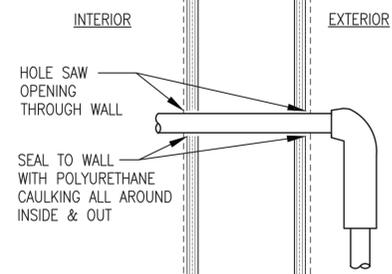

4 TYP CONDUIT WALL PENETRATION
E3.4 NO SCALE

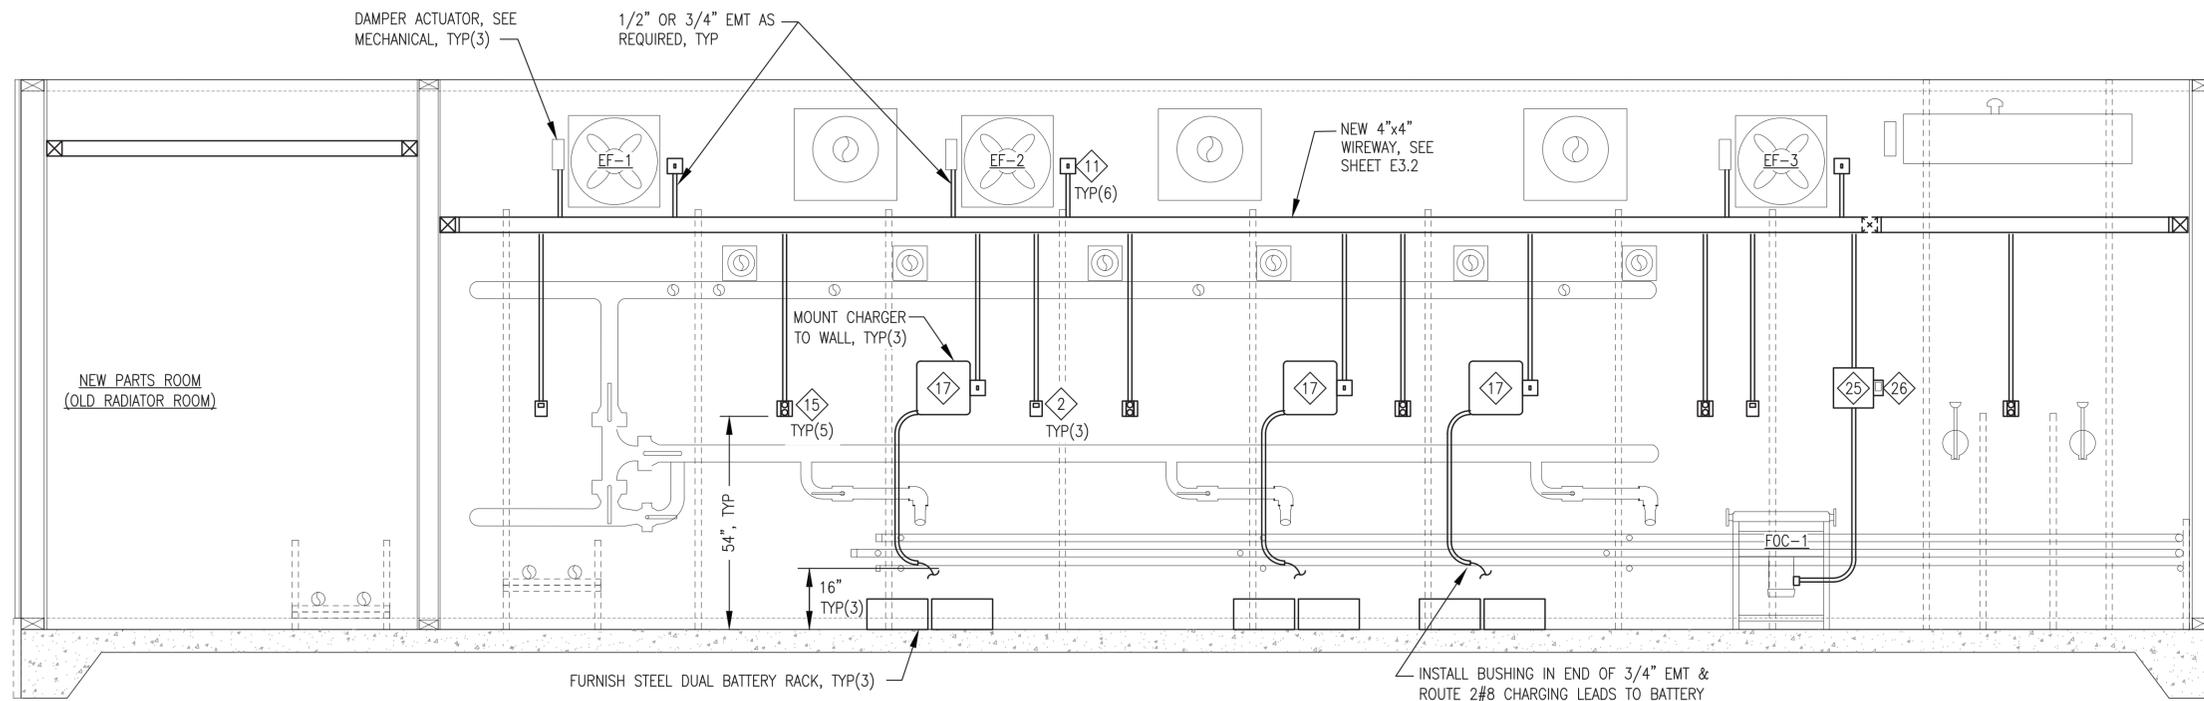


5 BACK WALL ELEVATION
E3.4 NO SCALE

REVISION #1
ISSUED FOR
CONSTRUCTION
AUGUST 2025




1	UPDATED FOR 2025 AEA STANDARDS	8/15/25	BCG
REV.	DESCRIPTION	DATE	BY
 ALASKA ENERGY AUTHORITY			
PROJECT: MANOKOTAK POWER PLANT UPGRADE PROJECT			
TITLE: BACK WALL ELEVATION & DETAILS			
DRAWN BY: JTD		SCALE: AS NOTED	
DESIGNED BY: CWV/BCG		DATE: 9/28/23	
FILE NAME: MANO PP E3-E5		SHEET:	
PROJECT NUMBER:		E3.4	
P.O. 111405, Anchorage, AK 99511 (907)349-0100			

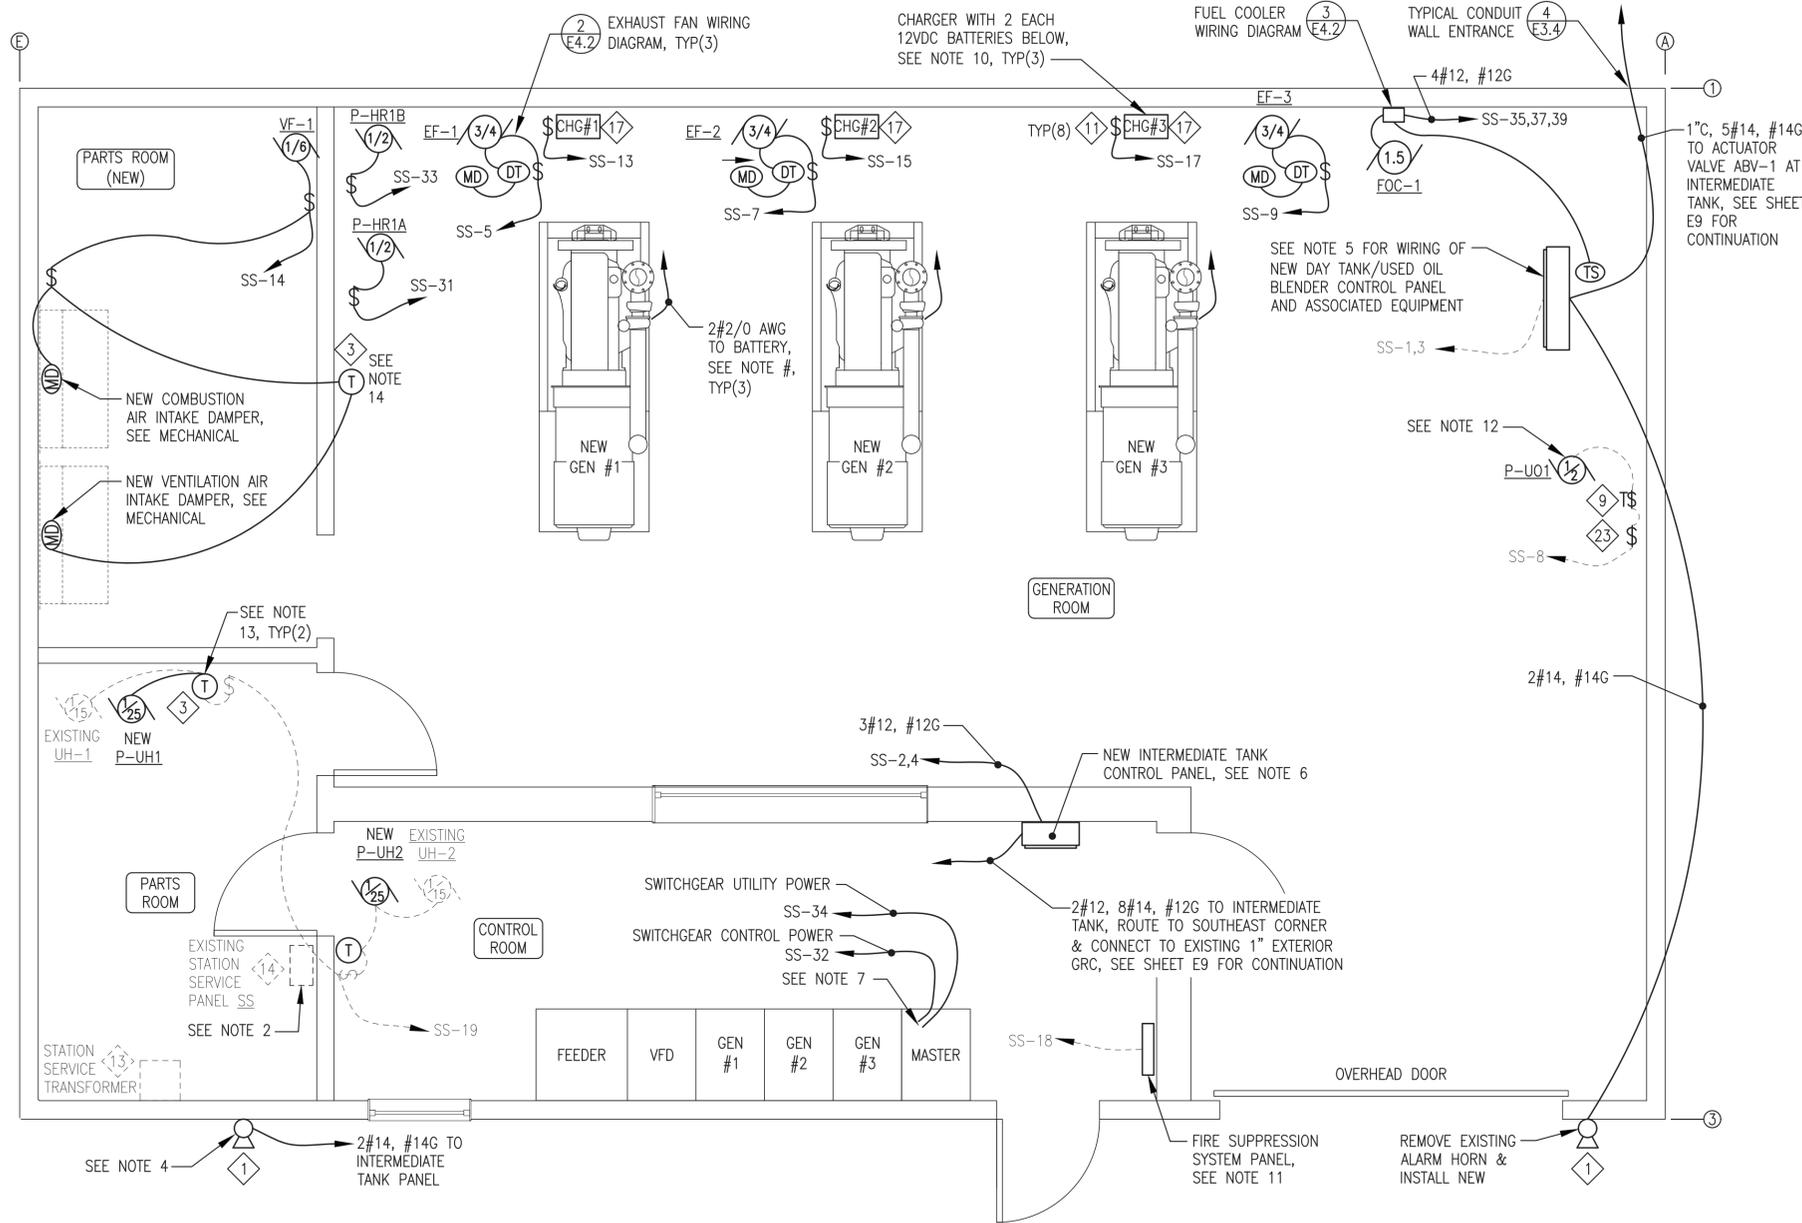

STATION SERVICE MODIFICATION NOTES:


- NEW OR MODIFIED POWER PLANT STATION SERVICE CIRCUITS SHOWN ONLY FOR CLARITY. ALL STATION SERVICE CIRCUITS TO REMAIN UNALTERED UNLESS SPECIFICALLY INDICATED OTHERWISE ON DEMOLITION AND MODIFICATION PLANS.
- EXISTING STATION SERVICE PANEL SS TO REMAIN. MODIFY EXISTING CIRCUITS AND INSTALL NEW CIRCUITS AND CIRCUIT BREAKERS AS INDICATED ON PANEL LAYOUT DETAIL 1/E4.1.
- ALL WIRING RUNS 2#12, #12G UNLESS SPECIFICALLY NOTED OTHERWISE.
- MOUNT NEW ALARM HORN AT 11'± AFF TO MATCH EXISTING HORN AT OTHER END OF BUILDING. SEE DETAIL 3/E3.4.
- SEE SHEETS E7.1-E7.3 FOR DAY TANK AND USED OIL BLENDER CONTROL PANEL DESIGN AND WIRING TERMINATIONS. ALL ASSOCIATED EQUIPMENT NOT SHOWN ON PLANS. SEE LOGIC DIAGRAMS FOR ADDITIONAL DETAIL.
- SEE SHEET E7.4 FOR INTERMEDIATE TANK CONTROL PANEL DESIGN AND WIRING TERMINATIONS. ALL ACCESSORIES NOT SHOWN ON PLANS. SEE LOGIC DIAGRAMS FOR ADDITIONAL DETAILS.
- SEE SWITCHGEAR SHOP DRAWINGS FOR TERMINATION OF ALL POWER AND CONTROL WIRING.
- NOT USED.
- ROUTE BATTERY CABLES TO FRONT OF SKID SUPPORTED WITH CUSHIONED CLAMPS, SEE SHEET M3.5. ROUTE FROM SKID DIRECTLY UNDER FUEL HOSES TO WALL AND TYWRAP CABLES TO USED OIL PIPE ALONG WALL, SEE SECTION 1/E3.3. CUT TO PROVIDE 6"± LOOP FOR FINAL TERMINATION ON BATTERIES.
- MOUNT BATTERY CHARGER TO WALL ON SHALLOW STRUT AND INSTALL BATTERIES IN RACK ON FLOOR BELOW, SEE ELEVATION 5/E3.4.
- EXISTING FIRE SUPPRESSION PANEL ENCLOSURE TO REMAIN. SEE FIRE SUPPRESSION SYSTEM MODIFICATION DRAWING SHEET FS1 FOR ALL FIRE SYSTEM WORK THIS PROJECT.
- NEW PUMP UO2, TIMER AND DISCONNECT WITH OVERLOAD INSTALLED THIS PROJECT ON EXISTING CIRCUIT. REUSE EXISTING CONDUCTORS AND RACEWAY TO THE MAXIMUM EXTENT POSSIBLE.
- REPLACE EXISTING THERMOSTAT WITH NEW AND SET TO HEATING MODE, 70F.
- REPLACE EXISTING THERMOSTAT WITH NEW AND SET TO COOLING MODE, 70F.

1 STATION SERVICE MODIFICATION PLAN
3/8"=1'-0"

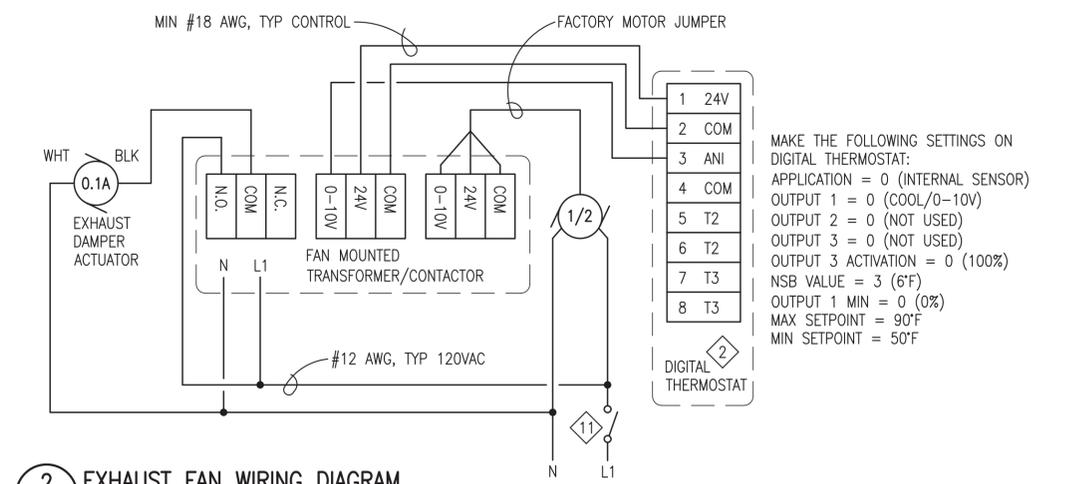


2 EXHAUST FAN WIRING DIAGRAM
NO SCALE

- NOTES:**
- ALL WIRING #12AWG EXCEPT AS NOTED.
 - PLACE TEMPERATURE CONTROLLER IN COOLING/CUT-IN MODE. SETPOINT = 120°F, DIFFERENTIAL = 10°F
 - MOUNT TEMP CONTROLLER TO WALL ABOVE FOC-1 ADJACENT TO CONTACTOR.

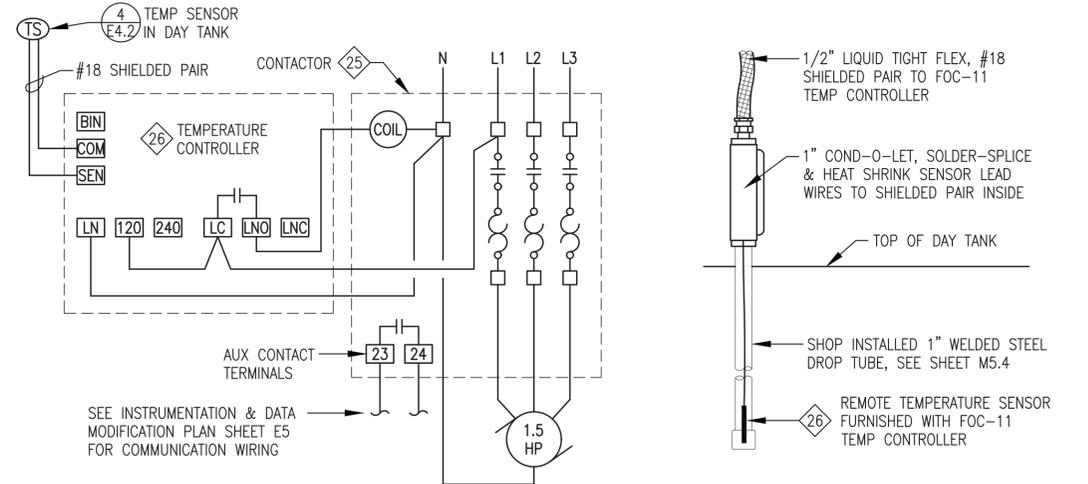

3 FOC-1 WIRING DIAGRAM
NO SCALE


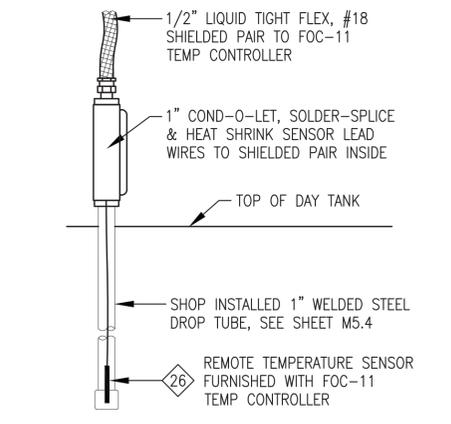


4 TANK TEMP SENSOR INSTALLATION
NO SCALE


REVISION #1
ISSUED FOR
CONSTRUCTION
AUGUST 2025



1	UPDATED FOR 2025 AEA STANDARDS	8/15/25	BCG
REV.	DESCRIPTION	DATE	BY
PROJECT: MANOKOTAK POWER PLANT UPGRADE PROJECT			
TITLE: STATION SERVICE MODIFICATION PLAN & DETAILS			
DRAWN BY: JTD		SCALE: AS NOTED	
DESIGNED BY: CWV/BCG		DATE: 9/28/23	
FILE NAME: MANO PP E3-E5		SHEET: E4.2	
PROJECT NUMBER: P.O. 111405, Anchorage, AK 99511 (907)349-0100			

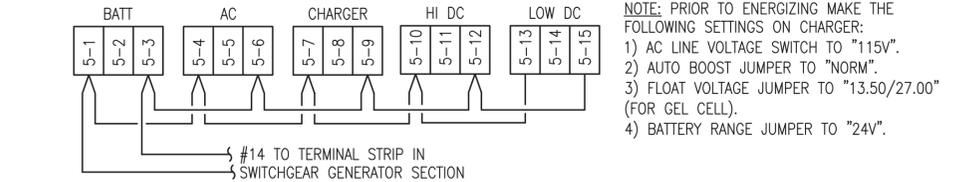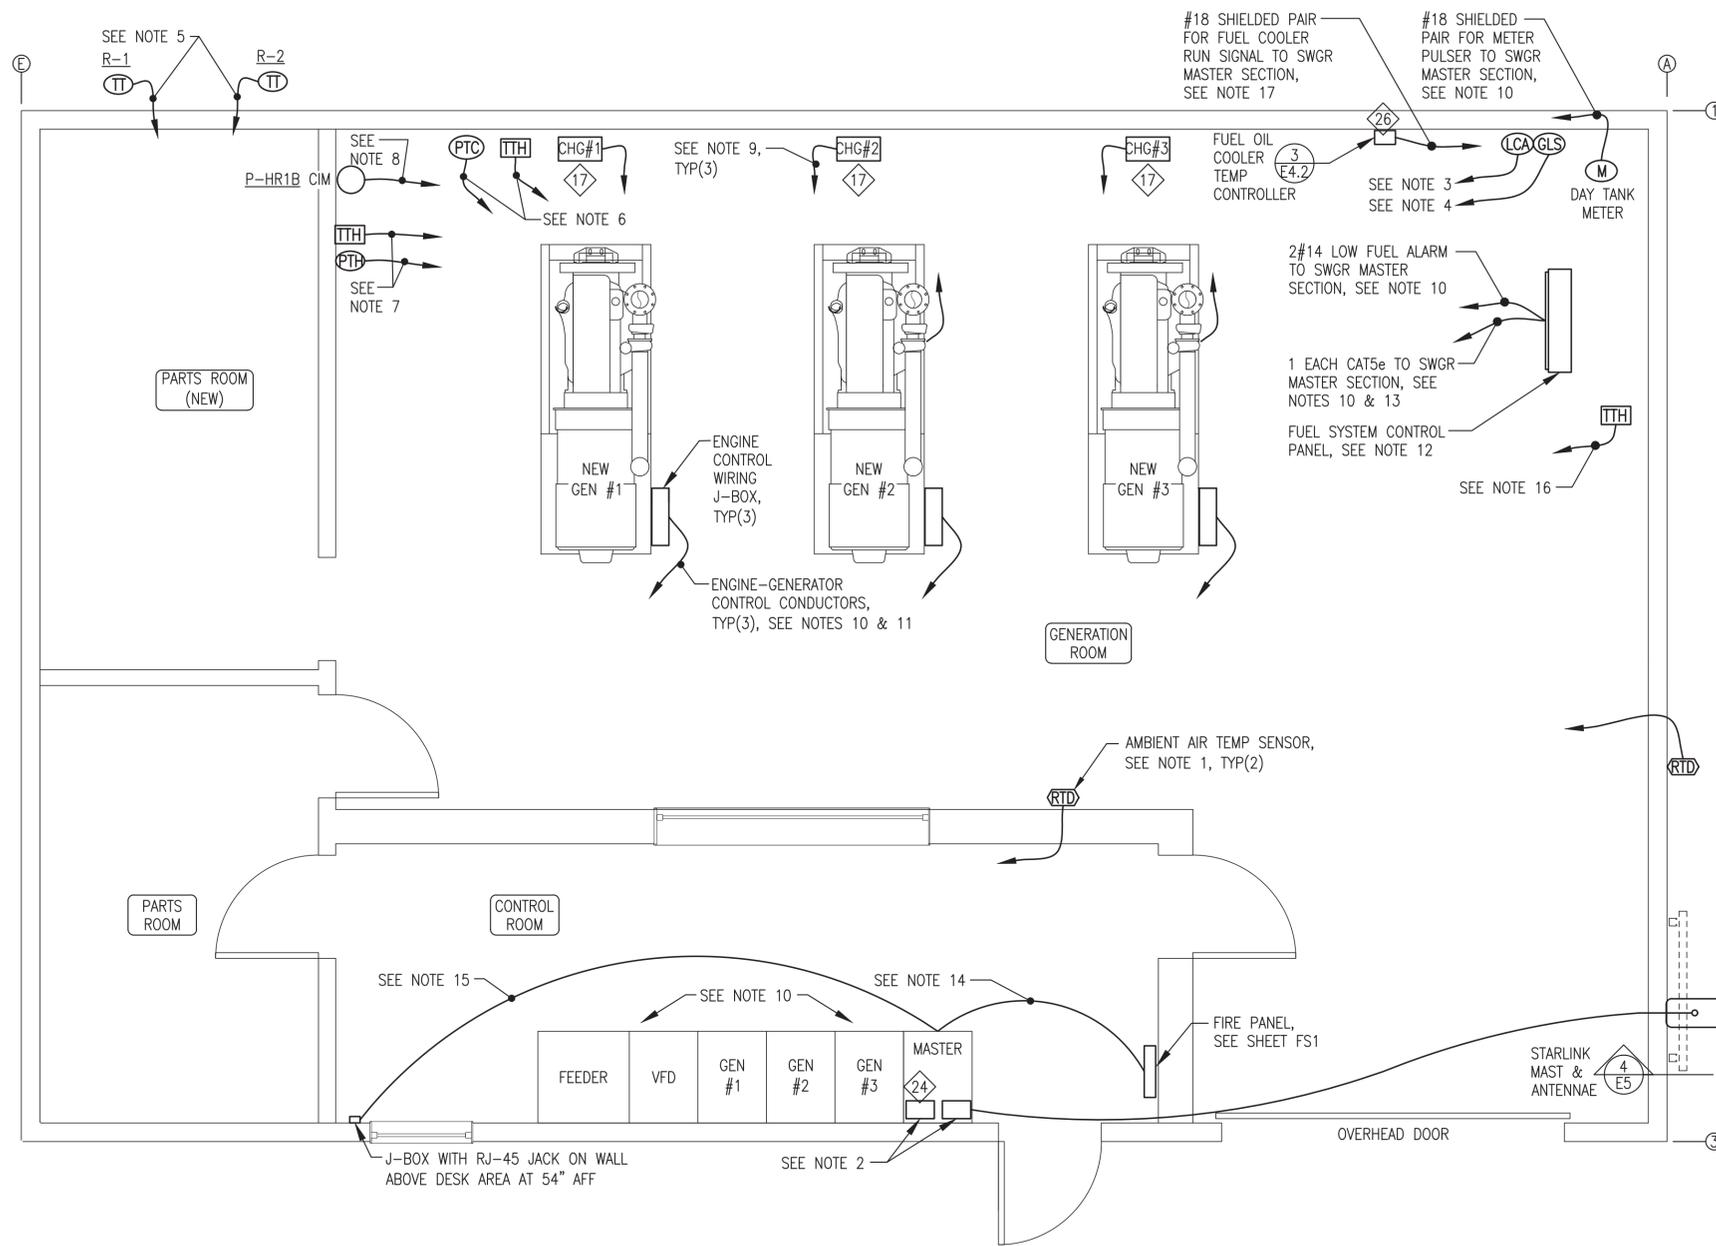


2 BATTERY CHARGER ALARM WIRING DIAGRAM
E5 NO SCALE

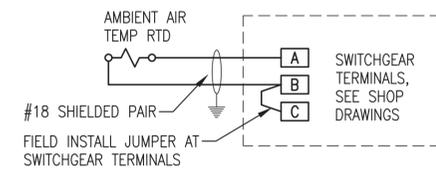

3 AMBIENT AIR TEMP RTD TERMINATION
E5 NO SCALE

INTERNET SERVICE GENERAL NOTES:

- FURNISH AND INSTALL COMPLETE SYSTEM WITH ANTENNA, MOUNTING HARDWARE, MODEM, JACKS, CABLES, CONNECTORS, AND ACCESSORIES REQUIRED TO PROVIDE INTERNET SERVICE TO THE NEW POWER PLANT.
- THE INTERNET SERVICE SHALL HAVE THE FOLLOWING PERFORMANCE CHARACTERISTICS: 40 MBPS DOWNLOAD, 10 MBPS UPLOAD, 50 GB PRIORITY MONTHLY DATA LIMIT. STARLINK STANDARD GEN3 KIT WITH BUSINESS LOCAL PRIORITY 50 GB PLAN, NO SUBSTITUTES. CONFIGURE STARLINK ACCOUNT IP POLICY TO "PUBLIC IP" AND ENABLE "BYPASS" MODE.
- UPON COMPLETION OF INSTALLATION THE INTERNET SYSTEM SHALL BE COMMISSIONED IN ACCORDANCE WITH THE SERVICE PROVIDER'S REQUIREMENTS.
- IN ADDITION TO FURNISHING AND INSTALLING SYSTEMS, THE CONTRACTOR SHALL PRE-PAY FOR A 1 YEAR INTERNET SERVICE CONTRACT.
- ROUTER CONFIGURATION: SET SSID TO "MANOKOTAK PP" AND FORWARD INCOMING TRAFFIC ON PORT 8088 TO 192.168.1.142:8088

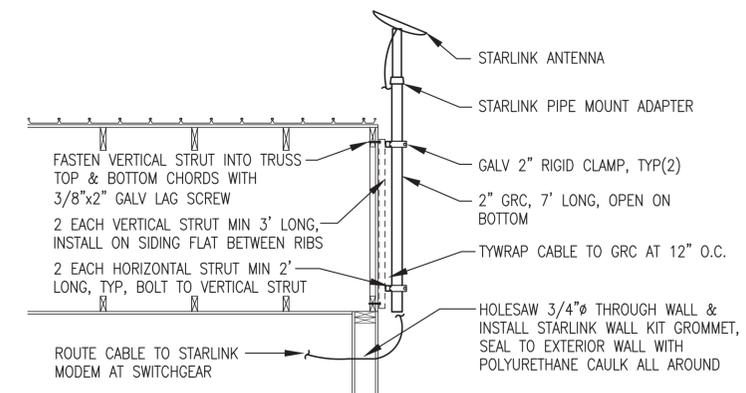

4 STARLINK ANTENNA & MAST INSTALLATION
E5 1/2"=1'-0"

INSTRUMENTATION & DATA PLAN NOTES:

- RTD TEMPERATURE SENSOR PROVIDED WITH SWITCHGEAR. ROUTE #18 SHIELDED PAIR TO SWITCHGEAR MASTER SECTION. SEE DETAIL 3/E5 AND NOTE 10.
- INSTALL STARLINK MODEM AND INTERNET ROUTER IN BOTTOM OF MASTER SECTION. CONNECT MODEM TO ROUTER AND CONNECT ROUTER TO ETHERNET SWITCH INSIDE MASTER SECTION. CONNECT BOTH TO 120VAC UPS, SEE NOTE 10.
- LOW COOLANT LEVEL ALARM SWITCH INSTALLED AT EXPANSION TANK, SEE MECHANICAL. CONNECT TO N.C. SWITCH (WHITE & RED) AND ROUTE 2#14 TO SWITCHGEAR MASTER SECTION. SEE NOTE 10.
- GLYCOL LEVEL SENSOR WITH 4-20mA SIGNAL CONDITIONER IN EXPANSION TANK, SEE MECHANICAL. ROUTE #18 SHIELDED PAIR TO SWITCHGEAR. SEE NOTE 10
- INSTALL TEMP TRANSMITTER IN EACH RADIATOR, SEE DETAIL 2/E3.3. ROUTE #18 SHIELDED PAIR FROM EACH TO SWITCHGEAR VFD SECTION, SEE NOTE 10.
- INSTALL COOLANT RETURN TEMP AND COOLING SYSTEM PRESSURE TRANSMITTERS IN PIPING MAIN WHERE SHOWN ON COOLING PIPING ISOMETRIC 1/M4.1. ROUTE #18 SHIELDED PAIRS FROM EACH TRANSMITTER TO SWITCHGEAR MASTER SECTION. LAND TEMP TRANSMITTER PAIR ON TERMINALS 624 AND 104090. LAND PRESSURE TRANSMITTER PAIR ON TERMINALS 624 AND 104091.
- INSTALL ONE TEMP TRANSMITTER (SUPPLY) AND ONE PRESSURE TRANSMITTER FOR
- PUMP P-HR1B HAS INTERNAL MONITORING FOR FLOW RATE AND TEMPERATURE. CONNECT PUMP CIM CARD WITH CAT5e AND ROUTE TO ETHERNET SWITCH IN MASTER SECTION. INSTALL IN SEPARATE DEDICATED RACEWAY OR WITH OTHER INSTRUMENT CABLES. DO NOT ROUTE WITH STATION SERVICE OR POWER CONDUCTORS.
- ROUTE 2#14 FROM BATTERY CHARGER ALARM CONTACTS TO ASSOCIATED SWITCHGEAR GENERATOR SECTION, SEE NOTE 10 AND WIRING DIAGRAM 2/E5.
- SEE SWITCHGEAR SHOP DRAWINGS FOR TERMINATION OF ALL INSTRUMENTATION AND DATA WIRING INCLUDING CONTROL POWER.
- ROUTE ENGINE-GENERATOR CONTROL CONDUCTORS TO SWITCHGEAR IN 10x10 WIREWAY WITH POWER CONDUCTORS AND IN 2" EMT. SEE PLAN 1/E3.2, DETAIL 3/E3.3, SHEET E6.3, AND NOTE 10.
- SEE SHEETS E7.1-E7.3 FOR DAY TANK CONTROL PANEL DESIGN AND WIRING
- HEAT RECOVERY MONITORING WHERE SHOWN ON HEAT RECOVERY PIPING ISOMETRIC 1/M4.4. ROUTE #18 SHIELDED PAIR FROM EACH TO SWITCHGEAR MASTER SECTION. SEE NOTE 10.
- ROUTE CAT5e CONDUCTOR FROM DAY TANK PANEL REMOTE I/O TO ETHERNET SWITCH IN SWITCHGEAR MASTER SECTION. INSTALL IN SEPARATE DEDICATED RACEWAY. DO NOT ROUTE WITH STATION SERVICE OR POWER CONDUCTORS.
- ROUTE CAT5e FOR DATA AND 2#14 FOR GENERATOR SHUT DOWN FROM FIRE PANEL TO SWITCHGEAR MASTER SECTION, SEE SHEET FS1 AND NOTE 10. INSTALL IN SEPARATE DEDICATED RACEWAY, COLOR RED. DO NOT ROUTE WITH STATION SERVICE OR POWER CONDUCTORS.
- ROUTE CAT5e FROM RJ-45 JACK IN DESK AREA TO ETHERNET SWITCH IN MASTER SECTION. INSTALL IN SEPARATE DEDICATED RACEWAY. DO NOT ROUTE WITH STATION SERVICE OR POWER CONDUCTORS.
- INSTALL FUEL RETURN TEMP TRANSMITTER IN PIPING MAIN WHERE SHOWN ON COOLING PIPING ISOMETRIC 4/M5.1. ROUTE #18 SHIELDED PAIR TO SWITCHGEAR MASTER SECTION TERMINALS 624 AND 104110A.
- ROUTE #18 SHIELDED PAIR FROM CONTACT TO SWITCHGEAR MASTER SECTION TERMINALS 624 AND 104022 FOR SCADA FUEL COOLER RUN INDICATION.

1 INSTRUMENTATION & DATA MODIFICATION PLAN & DETAILS
E5 3/8"=1'

REVISION #1
ISSUED FOR
CONSTRUCTION
AUGUST 2025

1	UPDATED FOR 2025 AEA STANDARDS	8/15/25	BCG
REV.	DESCRIPTION	DATE	BY
PROJECT: MANOKOTAK POWER PLANT UPGRADE PROJECT			
TITLE: INSTRUMENTATION & DATA MODIFICATION PLAN & DETAILS			
DRAWN BY: JTD		SCALE: AS NOTED	
DESIGNED BY: CWV/BCG		DATE: 9/28/23	
FILE NAME: MANO PP E3-E5		SHEET: E5	
PROJECT NUMBER:			
P.O. 111405, Anchorage, AK 99511 (907)349-0100			

Final (Permanent) Demand Control Table (PLC)				
Demand Control	Generator(s) On Line	On-line kW (Overload)	Level Increase	Level Decrease
Level 1	One Gen	350	310	---
Level 2	Two Gens	700	620	280
Level 3	All	1050	---	560

Note: All generators are equal capacity. Manually select priority for each.

Temporary Demand Control for Load Test with 300kW Load Bank

Demand Control	Generator(s) On Line	On-line kW (Overload)	Level Increase	Level Decrease
Level 1	One Gen	150	135	---
Level 2	Two Gens	300	270	120
Level 3	All	450	---	240

Note: Temporarily set to reduced values in order to test all demand levels.

Engine-Generator Alarm Settings (EZGN Genset Controller)

Function	Normal Range	Alarm	Shut Down
Overspeed	1795-1805	----	1900 RPM
Oil Pressure	30-50 PSI	14.5 PSI	10 PSI
Air Filter Vacuum	1-10" H2O	15" H2O	20" H2O
Coolant Temp.	180-200°F	210°F	215°F
Exhaust Temp.	500-850°F	900°F	-----
Charge Air Temp.	100-120°F	140°F	150°F
Under Frequency	59.5-60.5 Hz	----	58.2 Hz
Over Frequency	59.5-60.5 Hz	----	61.8 Hz
Under Voltage	470-490 V	----	432 V
Over Voltage	470-490 V	----	528 V
Reverse Power	0	----	10%

Generator Breaker Settings (EZGN Genset Controller)

Function	Setting
Gen Breaker Trip Setpoint (EZGN Rated Current)	600 A
Gen Breaker Level 1 (100%) Time Over Current	3 sec.
Gen Breaker Level 2 (120%) Time Over Current	1 sec.
Gen Breaker Level 3 (250%) Time Over Current	0.4 sec.

Feeder Breaker Settings (Feeder Protection Relay - FPR)


Function (Note: Element 1 is the only active element)	Setting
T.O.C. Trip Pickup (amps) Note: 5A = 100% of CT rating	5.0
T.O.C. Curve Selection	U4
T.O.C. Time Dial	5.00
E.M Reset delay (Y/N)	N
Constant Time Adder (seconds)	0.00
Minimum Response Time (seconds)	0.00
Maximum Phase T.O.C. Torque Control	1

Radiator VFD Settings


Function	Setting
Min PID Feedback	20
Max PID Feedback	240
rSL (Wake UP Threshold)	1
PID Reference Temperature	175°F
Proportional Gain	0.93
Integral Gain	0.3
Derivative	0
Minimum Speed	10 Hz.
Low Speed Timeout	10 sec.
Loss of Phase	Ignore

Charge Air Cooler VFD Settings


Function	Setting
Min PID Feedback	20
Max PID Feedback	240
rSL (Wake UP Threshold)	Not Used
PID Reference Temperature	100°F
Proportional Gain	0.2
Integral Gain	0.1
Derivative	0

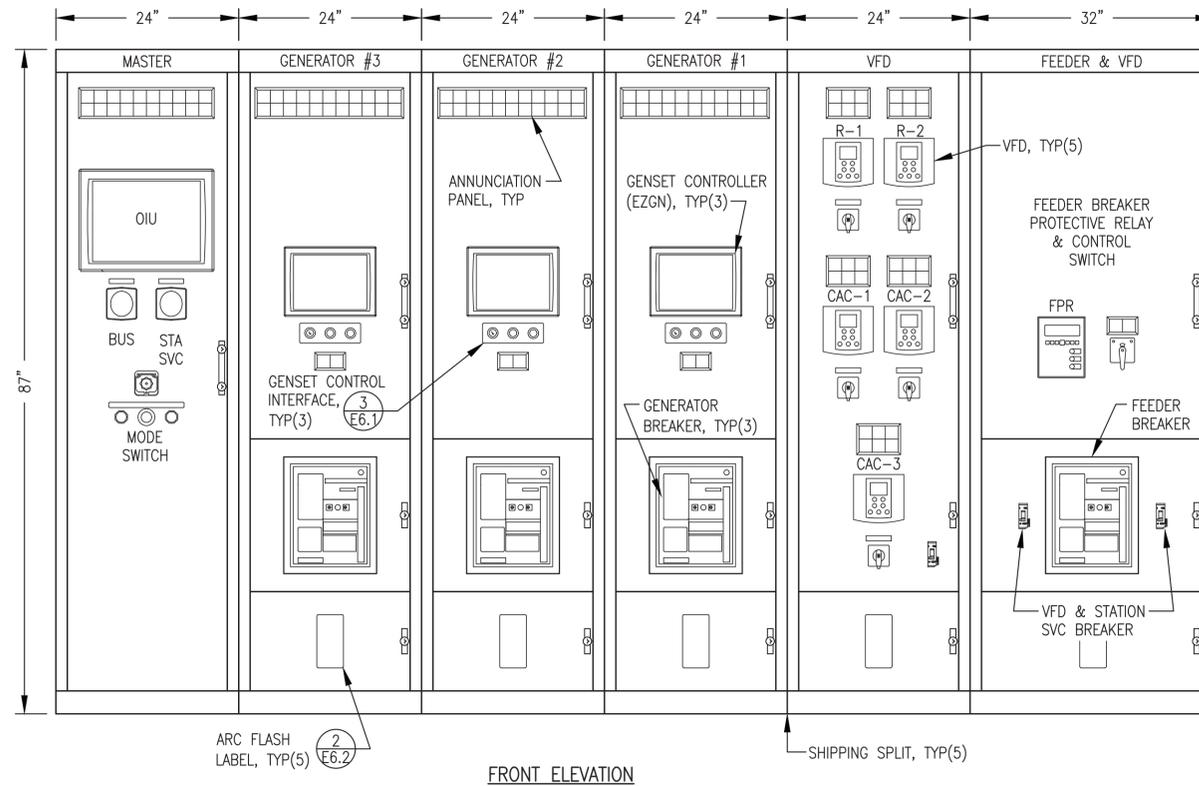


1 SWITCHGEAR ENCLOSURE LAYOUT
E6.1 NO SCALE

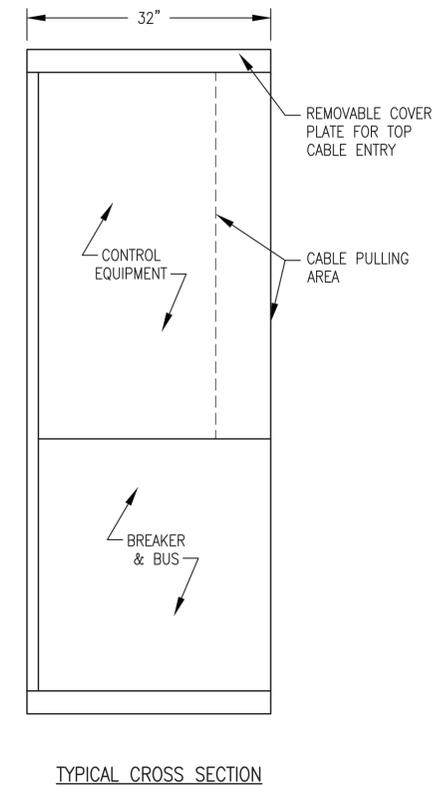

TYPICAL CROSS SECTION

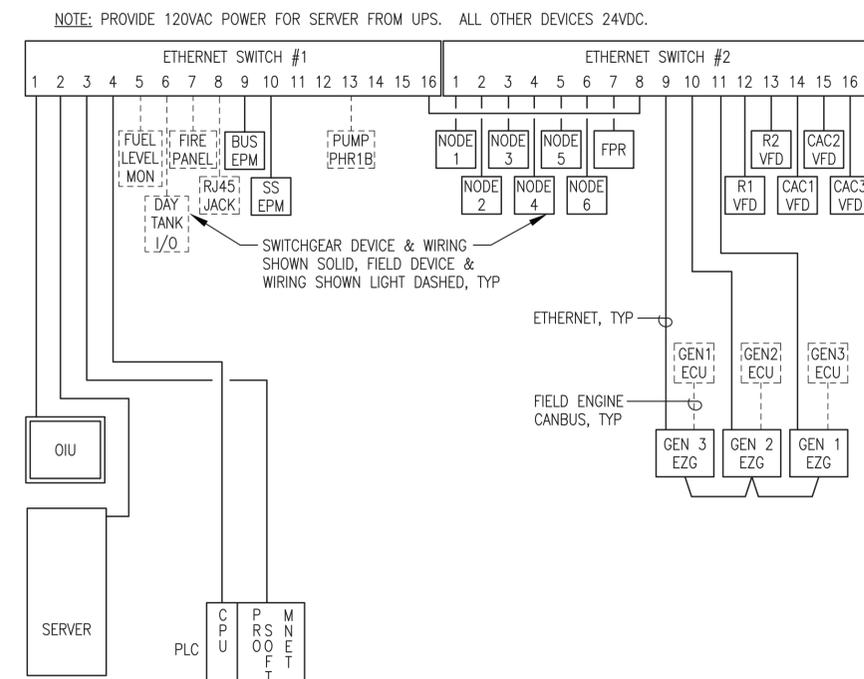

2 COMMUNICATION SCHEMATIC
E6.1 NO SCALE

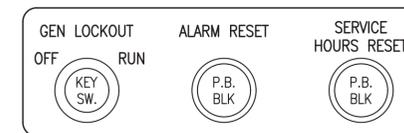

INTERFACE CONTROLS LEGEND:
P.B. PUSH BUTTON
KEY SW. KEY OPERATED LOCKABLE SWITCH


3 GENSET CONTROL (EZGN) INTERFACE CONTROLS
E6.1 NO SCALE

REVISION #1
ISSUED FOR
CONSTRUCTION
AUGUST 2025



1	UPDATED FOR 2025 AEA STANDARDS	8/15/25	BCG
REV.	DESCRIPTION	DATE	BY
 ALASKA ENERGY AUTHORITY			
PROJECT: MANOKOTAK POWER SYSTEM UPGRADE			
TITLE: SWITCHGEAR ENCLOSURE LAYOUT, SETTING TABLE, & DETAILS			
DRAWN BY: JTD		SCALE: NO SCALE	
DESIGNED BY: CWV/BCG		DATE: 9/28/23	
FILE NAME: MANO PP E6		SHEET:	
PROJECT NUMBER:		E6.1	
P.O. 111405, Anchorage, AK 99511 (907)349-0100			




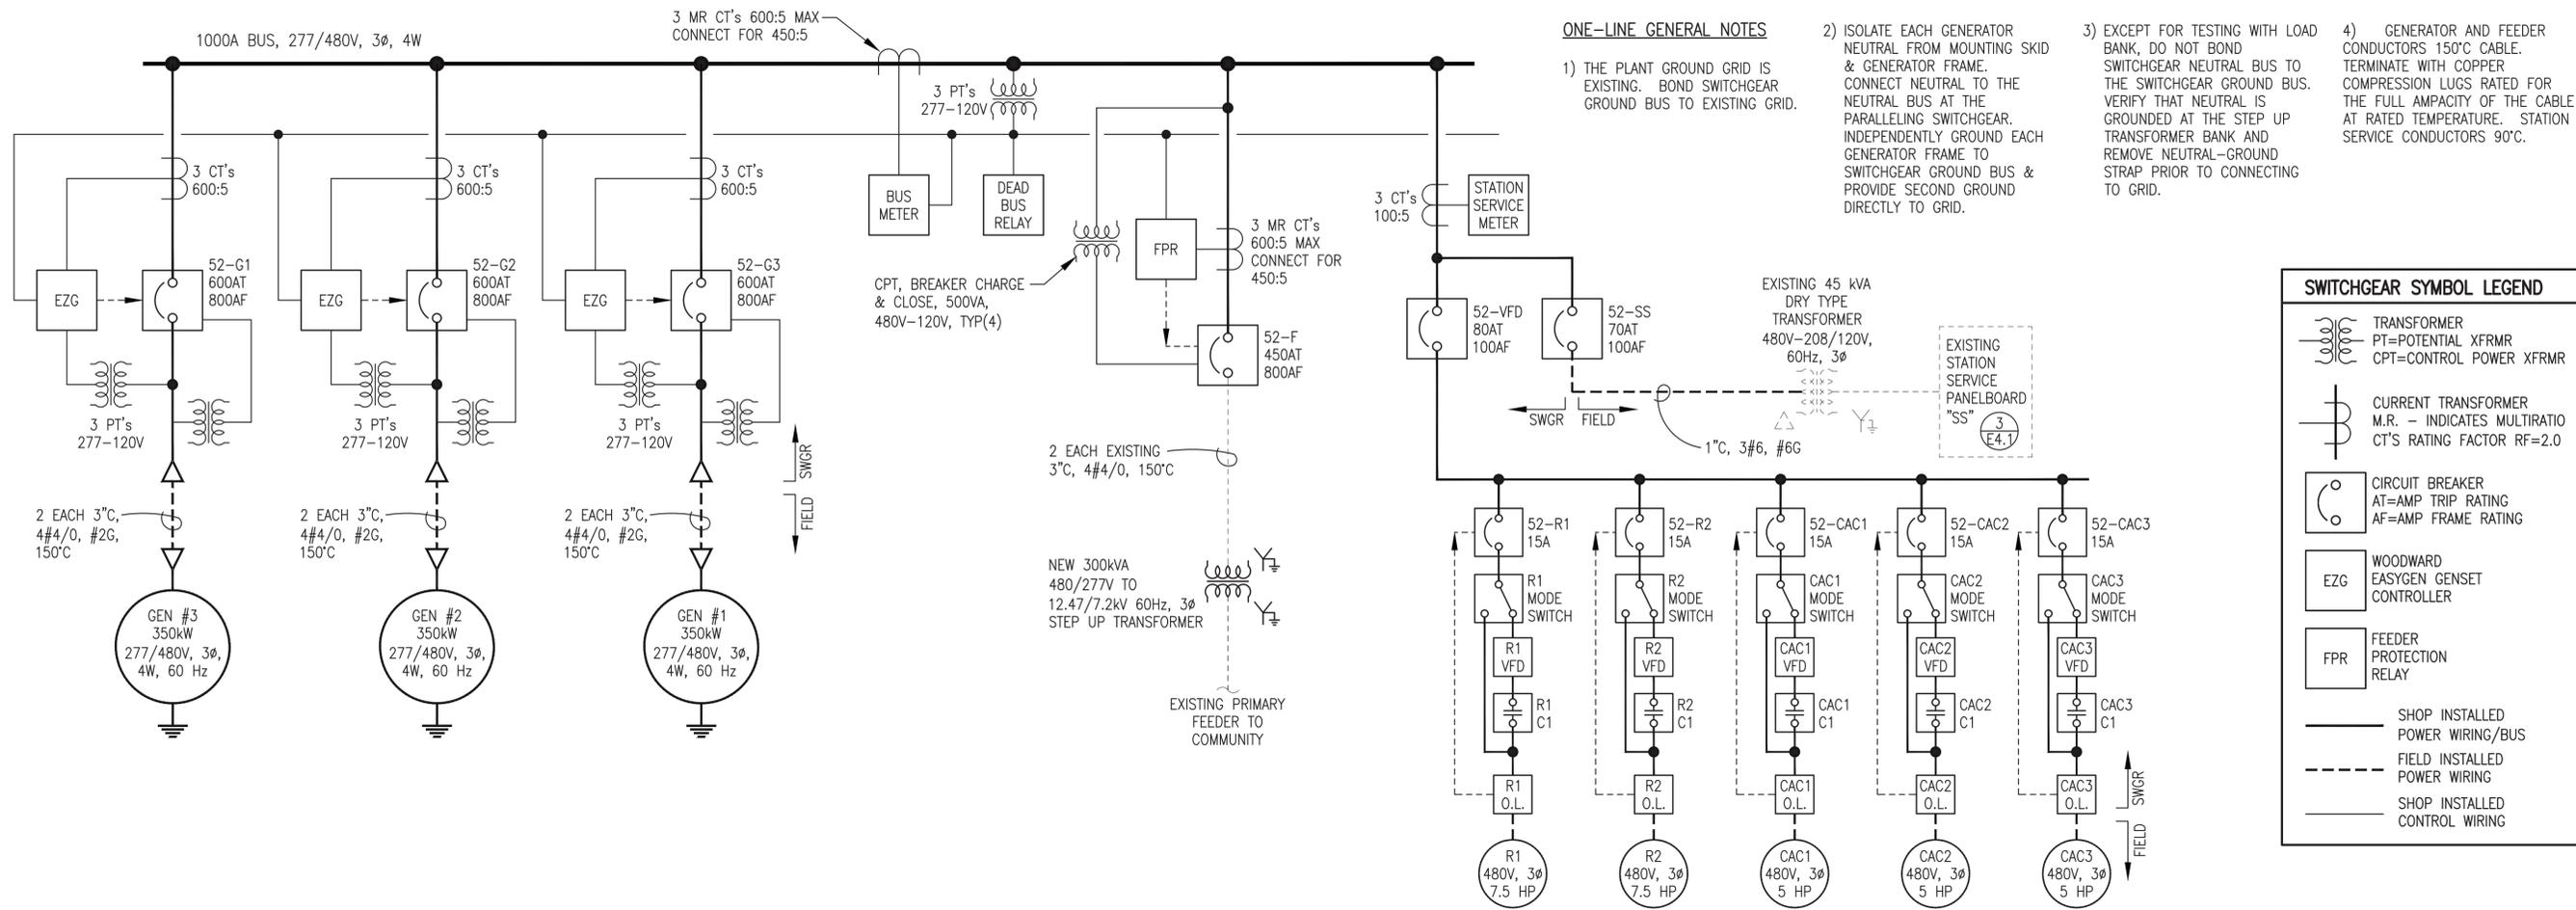

ONE-LINE GENERAL NOTES

- 1) THE PLANT GROUND GRID IS EXISTING. BOND SWITCHGEAR GROUND BUS TO EXISTING GRID.
- 2) ISOLATE EACH GENERATOR NEUTRAL FROM MOUNTING SKID & GENERATOR FRAME. CONNECT NEUTRAL TO THE NEUTRAL BUS AT THE PARALLELING SWITCHGEAR. INDEPENDENTLY GROUND EACH GENERATOR FRAME TO SWITCHGEAR GROUND BUS & PROVIDE SECOND GROUND DIRECTLY TO GRID.
- 3) EXCEPT FOR TESTING WITH LOAD BANK, DO NOT BOND SWITCHGEAR NEUTRAL BUS TO THE SWITCHGEAR GROUND BUS. VERIFY THAT NEUTRAL IS GROUNDED AT THE STEP UP TRANSFORMER BANK AND REMOVE NEUTRAL-GROUND STRAP PRIOR TO CONNECTING TO GRID.
- 4) GENERATOR AND FEEDER CONDUCTORS 150°C CABLE. TERMINATE WITH COPPER COMPRESSION LUGS RATED FOR THE FULL AMPACITY OF THE CABLE AT RATED TEMPERATURE. STATION SERVICE CONDUCTORS 90°C.

SWITCHGEAR SYMBOL LEGEND

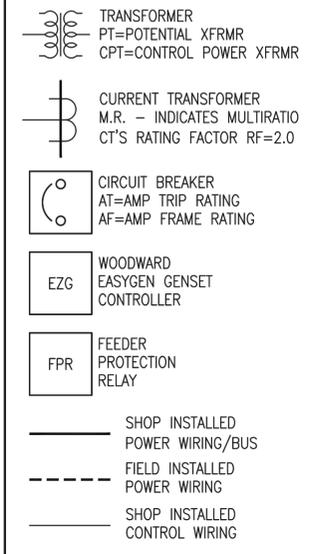


1 SWITCHGEAR ONE-LINE DIAGRAM
E6.2 NO SCALE

ARC FLASH NOTES:
 1) PERMANENTLY AFFIX ARC FLASH LABELS TO EACH SECTION WITH 480V POWER AS INDICATED.
 2) SCALED PDF IMAGES OF THESE LABELS WILL BE FURNISHED TO THE FABRICATOR UPON REQUEST.


GENERATOR

FEEDER

2 ARC FLASH LABELS
E6.2 NO SCALE

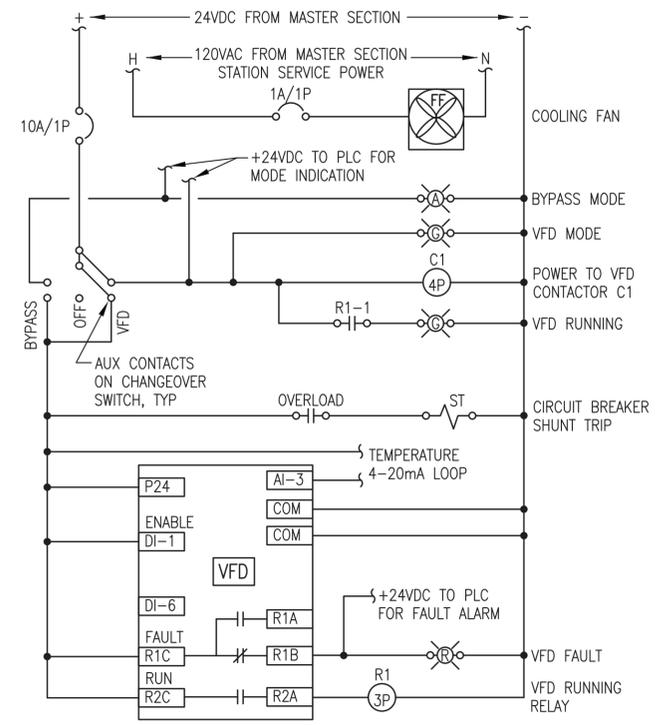

3 TYPICAL RADIATOR VFD LOGIC DIAGRAM
E6.2 NO SCALE


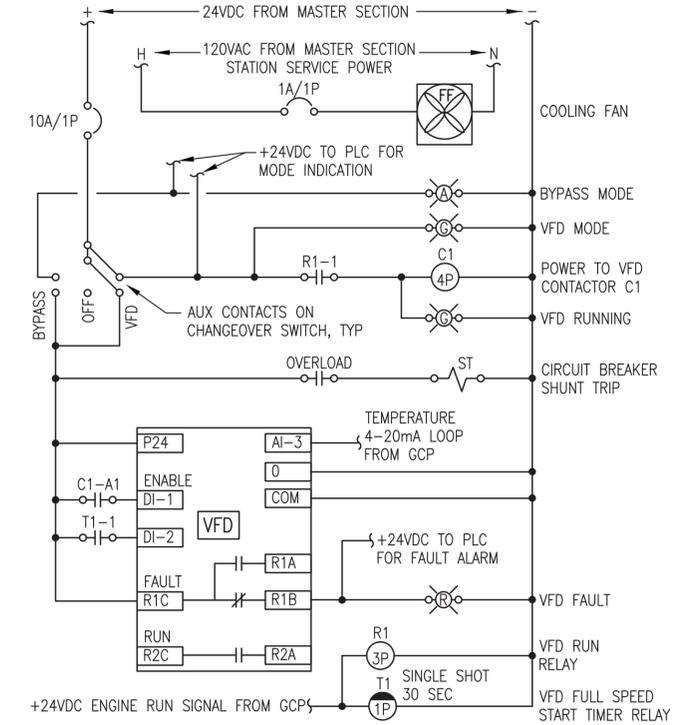


4 TYPICAL CHARGE AIR COOLER VFD LOGIC DIAGRAM
E6.2 NO SCALE

REVISION #1
ISSUED FOR
CONSTRUCTION
AUGUST 2025



1	UPDATED FOR 2025 AEA STANDARDS	8/15/25	BCG
REV.	DESCRIPTION	DATE	BY
<p>ALASKA ENERGY AUTHORITY</p>			
PROJECT: MANOKOTAK POWER SYSTEM UPGRADE			
TITLE: SWITCHGEAR ONE-LINE & DETAILS			
<p>Gray Stassel Engineering, Inc. P.O. 111405, Anchorage, AK 99511 (907)349-0100</p>	DRAWN BY: JTD	SCALE: NO SCALE	
	DESIGNED BY: CWV/BCG	DATE: 9/28/23	
	FILE NAME: MANO PP E6	SHEET: E6.2	
PROJECT NUMBER:			

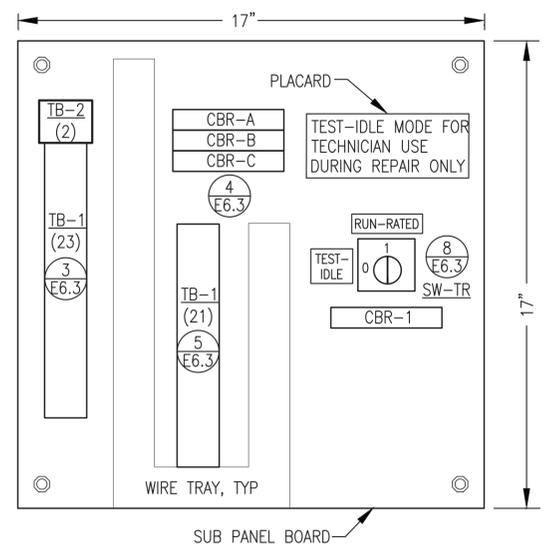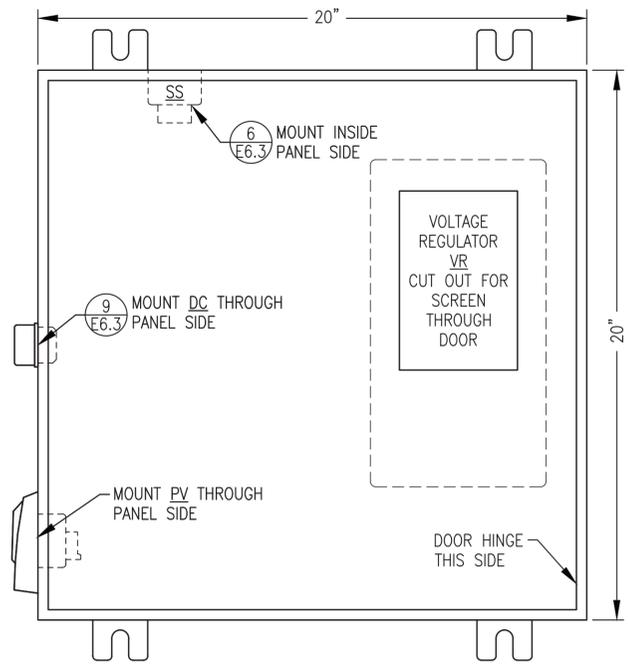

1 JUNCTION BOX FRONT PANEL LAYOUT
E6.3 NO SCALE

2 JUNCTION BOX SUB PANEL LAYOUT
E6.3 NO SCALE

TAG	MANUFACTURER	MODEL	DESCRIPTION
CBR-A/B/C	ALLEN-BRADLEY	1489-M1-C010	RAIL MOUNT CIRCUIT BREAKER, 1P, 1A
CBR-1	ALLEN-BRADLEY	1489-M1-C050	RAIL MOUNT CIRCUIT BREAKER, 1P, 5A
DC	DEUTSCH	HD10-9-1939P	DIAGNOSTIC CONNECTOR, 9-PIN, CAN-BUS
	DEUTSCH	HD18-009	CONNECTOR STRAIN RELIEF
	DEUTSCH	HDC16-9	CONNECTOR PROTECTIVE DUST CAP
	DEUTSCH	HD10-9-GKT	CONNECTOR GASKET
	DEUTSCH	JDL062397	CONNECTOR LANYARD
ENCL.	HOFFMAN	A20H20ALP	20x20x8" NEMA 12
	HOFFMAN	A20P20	BACK PANEL
PV	MURPHY	PV380-R3	POWER VIEW (NON-TIER 4) WITH HARNESS
SS	JOHN DEERE	AT145341	STARTER AUXILIARY SOLENOID, 24V
SW-TR	ALLEN-BRADLEY	194L-A12-225-2	CHANGEOVER SWITCH, 12A, 2P
	ALLEN-BRADLEY	194L-HE-4A-175	90 DEGREE I-O HANDLE
TB-1	IDEC	BNH15LW	15A DIN RAIL-MOUNT TERMINAL BLOCK
TB-2	IDEC	BNH50W	50A DIN RAIL-MOUNT TERMINAL BLOCK
VR	BASLER	DECS-100-A05	DIGITAL VOLTAGE REGULATOR


BRAND SPECIFIC NOTE: SPECIFIC PARTS MANUFACTURER AND MODEL SELECTED NOT ONLY TO MEET PERFORMANCE FUNCTION BUT ALSO TO COORDINATE AND INTERFACE WITH OTHER DEVICES AND SYSTEMS. APPROVED EQUAL SUBSTITUTIONS WILL BE ALLOWED ONLY BY ENGINEER'S APPROVAL. TO OBTAIN APPROVAL, SUBMITTALS MUST CLEARLY DEMONSTRATE HOW SUBSTITUTE ITEM MEETS OR EXCEEDS SPECIFIED ITEM QUALITY AND PERFORMANCE CHARACTERISTICS AND ALSO COMPLIES WITH MECHANICAL AND/OR ELECTRICAL CONNECTIONS AND PHYSICAL LAYOUT REQUIREMENTS.

SHOP FABRICATION NOTES:


- 1) PROVIDE ASSEMBLY WITH ALL DEVICES AND WIRING INDICATED.
- 2) INSTALL IN A NEMA 12 ENCLOSURE WITH MOUNTING FLANGES AT BACK, A MIN 14 GAUGE INTERIOR BACK PANEL AND HINGED LOCKABLE DOOR. SIZE AS INDICATED.
- 3) PROVIDE DIN RAIL, TERMINAL END PLATES, TERMINAL END STOPS, TERMINAL DUST COVERS AND OTHER MISCELLANEOUS HARDWARE AS REQUIRED TO MATCH TERMINALS. LABEL ALL TERMINALS EXACTLY AS INDICATED ON THE DETAILS.
- 4) ALL WIRE #14AWG EXCEPT WHERE SPECIFICALLY INDICATED OTHERWISE. LABEL BOTH ENDS OF ALL JUMPERS WITH THE ENGINE PANEL TERMINAL NUMBER.
- 5) PROVIDE MECHANICAL GROUND LUGS FASTENED TO BACK PANEL AND GROUNDED TO ENGINE-GENERATOR. GROUND ALL SHIELD DRAIN WIRES TO LUGS AT BACK PANEL ONLY.
- 6) PROVIDE WIRING HARNESSSES FOR CONNECTION TO GENERATOR AND TO ENGINE. INSTALL WIRES IN LIQUID TIGHT FLEX OR FLEXIBLE PLASTIC WIRE LOOM AND PROVIDE SERVICE LOOPS IN ACCORDANCE WITH SPECIFICATIONS.
- 7) SHOP TEST EACH NEW ENGINE-GENERATOR WITH ASSOCIATED JUNCTION BOX PERMANENTLY CONNECTED. UPON COMPLETION OF TESTING, COIL WIRING HARNESSSES AND SECURE JUNCTION BOX TO GENERATOR FOR SHIPPING.

FIELD INSTALLATION NOTES:


- 1) PERFORM ALL FIELD WIRING IN ACCORDANCE WITH SPECIFICATIONS. LABEL BOTH ENDS OF ALL FIELD WIRING WITH THE ENGINE PANEL TERMINAL NUMBER.
- 2) ON SHIELDED CONDUCTORS GROUND ALL SHIELD DRAIN WIRES AT ENGINE J-BOX ONLY. CLIP DRAIN WIRES AT OPPOSITE ENDS.

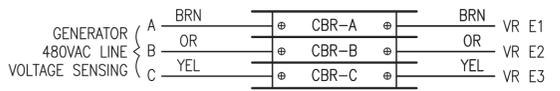


4 CIRCUIT BREAKER CONNECTIONS
E6.3 NO SCALE

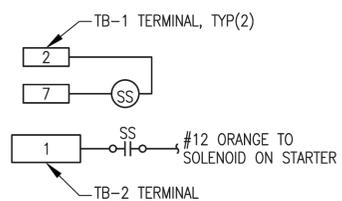


6 STARTER AUX SOLENOID SS WIRING
E6.3 NO SCALE

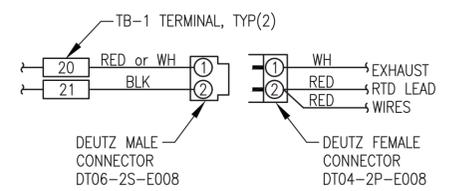


7 EXHAUST RTD CONNECTOR
E6.3 NO SCALE

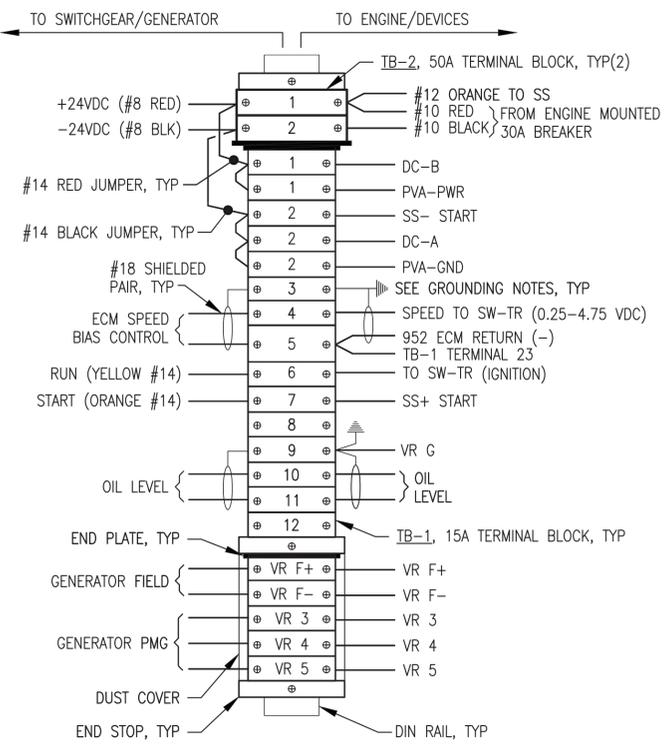


3 TERMINAL STRIP CONNECTIONS
E6.3 NO SCALE

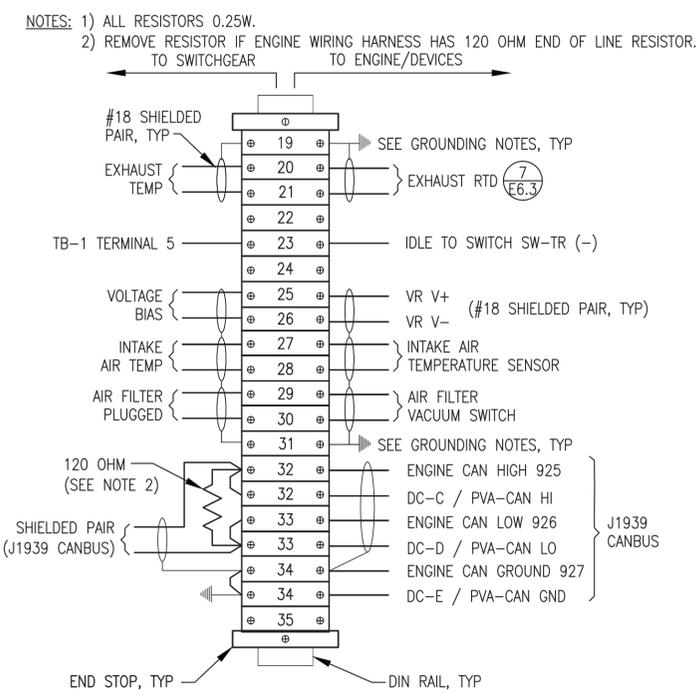

5 TERMINAL STRIP CONNECTIONS
E6.3 NO SCALE

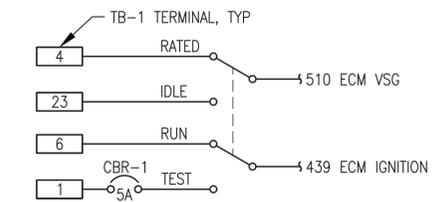

8 TEST-IDLE/RUN-RATED SWITCH SW-TR WIRING
E6.3 NO SCALE

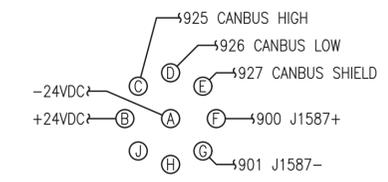


9 DIAGNOSTIC CONNECTOR WIRING
E6.3 NO SCALE

REVISION #1
ISSUED FOR
CONSTRUCTION
AUGUST 2025




1	UPDATED FOR 2025 AEA STANDARDS	8/15/25	BCG
REV.	DESCRIPTION	DATE	BY
PROJECT: MANOKOTAK POWER SYSTEM UPGRADE			
TITLE: 24VDC ENGINE WIRING JUNCTION BOX			
DRAWN BY: JTD		SCALE: NO SCALE	
DESIGNED BY: CWV/BCG		DATE: 9/28/23	
FILE NAME: MANO_PP_E6		SHEET: E6.3	
PROJECT NUMBER:			



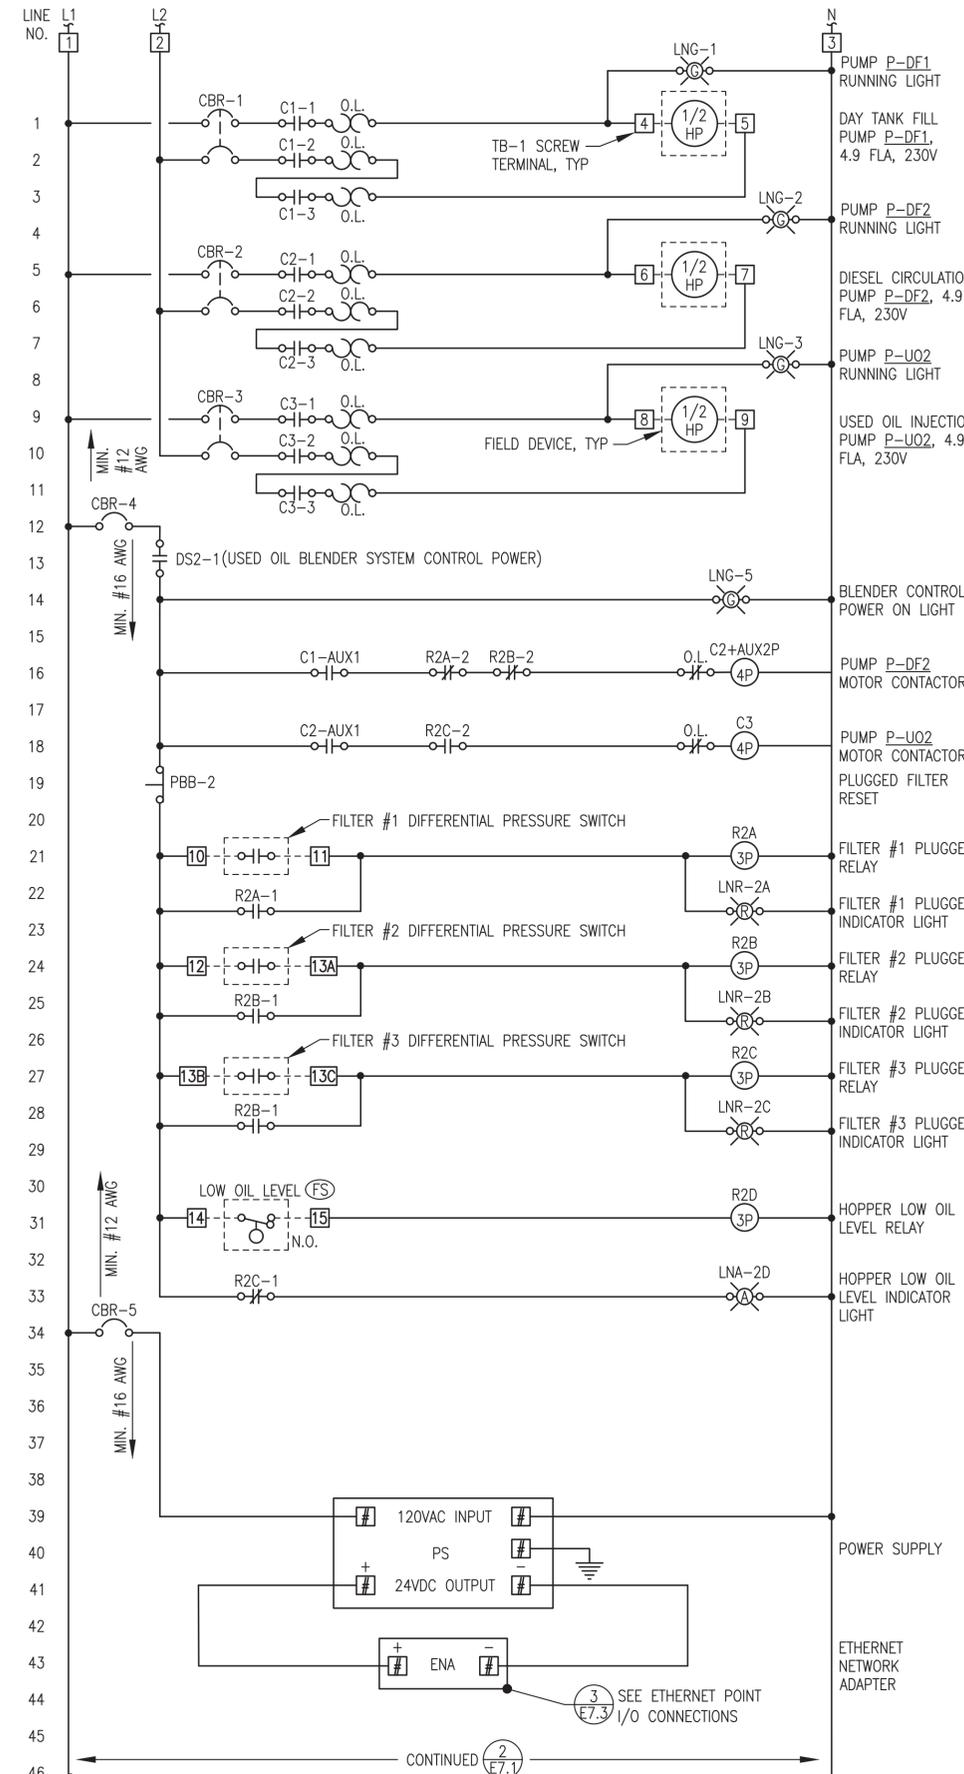

1 USED OIL BLENDER SYSTEM LOGIC DIAGRAM
E7.1 NO SCALE

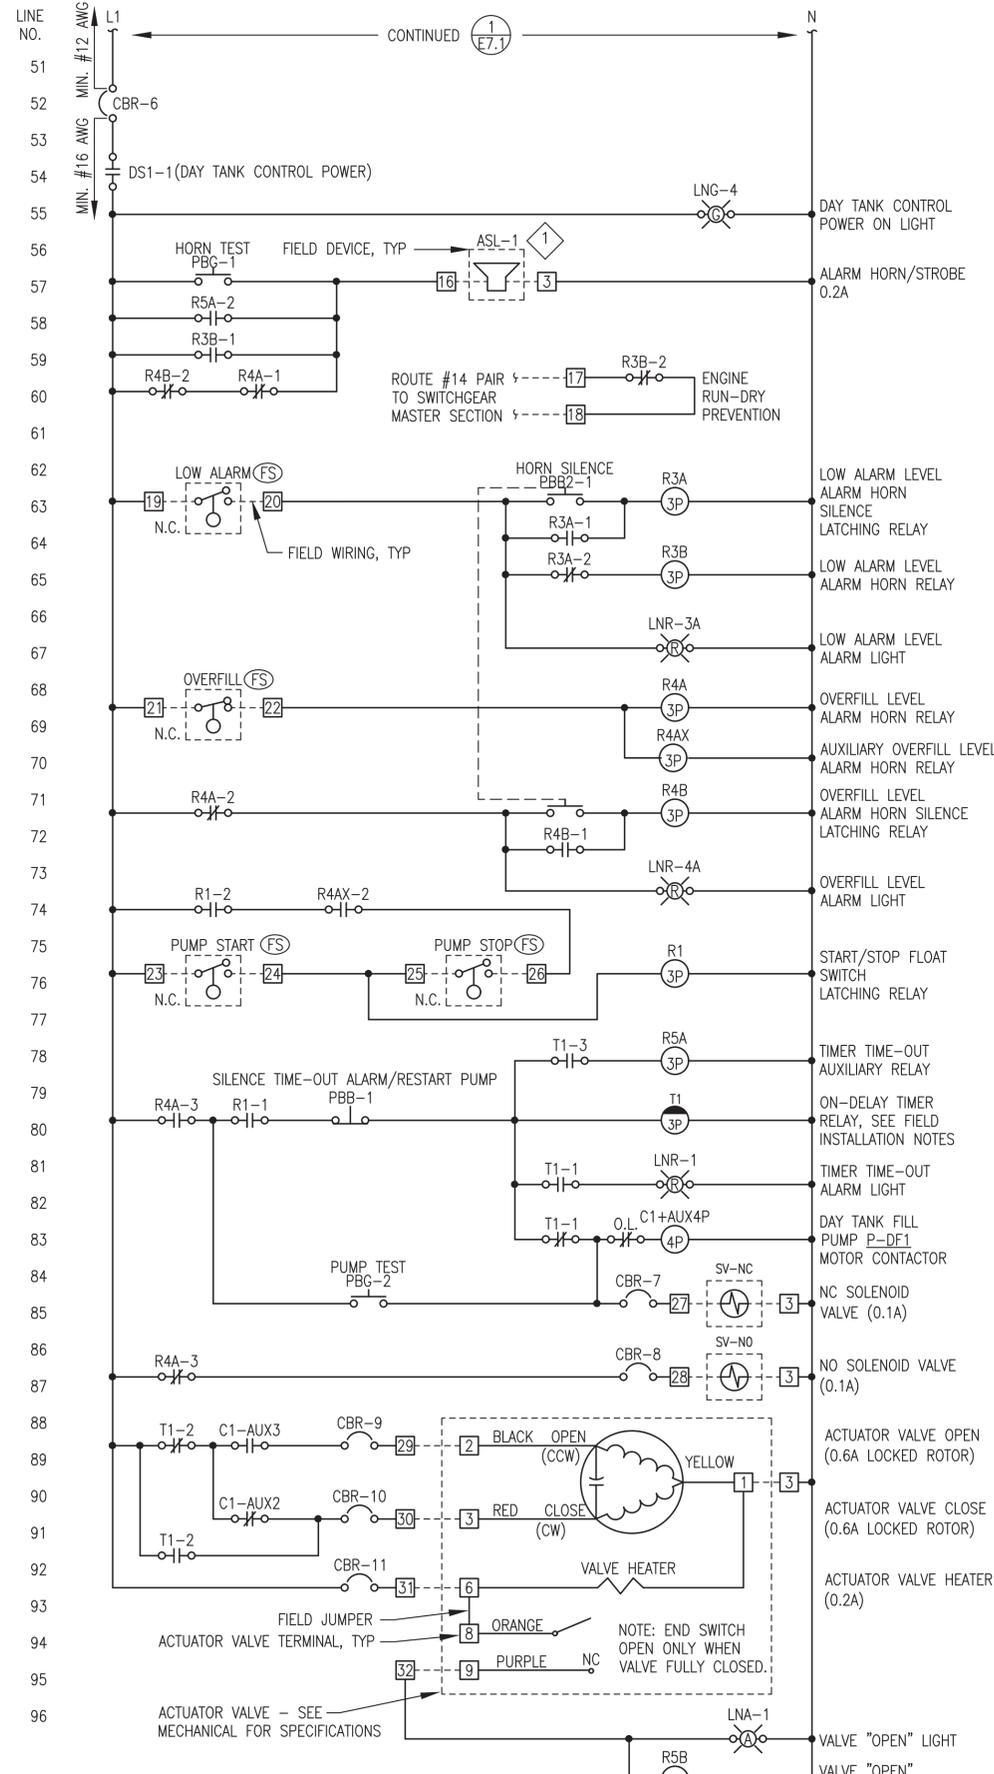

2 DAY TANK LOGIC DIAGRAM
E7.1 NO SCALE

BILL OF MATERIALS			
NOTE: ON THIS SHEET AND THE PANEL DRAWINGS THAT FOLLOW SPECIFIC PARTS MANUFACTURER AND MODEL ARE SELECTED NOT ONLY TO MEET PERFORMANCE FUNCTION BUT ALSO TO COORDINATE AND INTERFACE WITH OTHER DEVICES AND SYSTEMS. APPROVED EQUAL SUBSTITUTIONS WILL BE ALLOWED ONLY BY ENGINEER'S APPROVAL. TO OBTAIN APPROVAL, SUBMITTALS MUST CLEARLY DEMONSTRATE HOW SUBSTITUTE ITEM MEETS OR EXCEEDS SPECIFIED ITEM QUALITY AND PERFORMANCE CHARACTERISTICS AND ALSO COMPLIES WITH MECHANICAL AND/OR ELECTRICAL CONNECTIONS AND PHYSICAL LAYOUT REQUIREMENTS.			
TAG	MANUFACTURER	MODEL	DESCRIPTION
AUX2P	ALLEN-BRADLEY	100FA11	AUXILIARY CONTACT FOR CONTACTOR, 2 POLE, NO, NC
AUX4P	ALLEN-BRADLEY	100FA31	AUXILIARY CONTACT FOR CONTACTOR, 4 POLE, 3NO, 1NC
C	ALLEN-BRADLEY	100C09D10	CONTACTOR, 120V COIL, 9A, 4 POLE
CBR-1,2,3	ALLEN-BRADLEY	1489-M2-C150	RAIL-MOUNT CIRCUIT BREAKER, 2 POLE, 15A
CBR-4,5,6	ALLEN-BRADLEY	1489-M1-C050	RAIL-MOUNT CIRCUIT BREAKER, 1 POLE, 5A
CBR-7,8,9,10,11	ALLEN-BRADLEY	1489-M1-C010	RAIL-MOUNT CIRCUIT BREAKER, 1 POLE, 1A
DS	ALLEN-BRADLEY	194LE201753	DISCONNECT, 2 POSITION, 3 N.O., 20A, FACE MOUNT
ENA	ALLEN-BRADLEY	194LHC4E1751	KNOB ACTUATOR FOR LOAD SWITCH, ON/OFF, LOCKABLE
DI8	ALLEN-BRADLEY	1734-AENTR	I/O DUAL PORT ETHERNET NETWORK ADAPTER
LNG	ALLEN-BRADLEY	800HORH2G	GREEN LED PILOT LIGHT, 12-130V, NEMA 4X
LNR	ALLEN-BRADLEY	800HORH2R	RED LED PILOT LIGHT, 12-130V, NEMA 4X
LNA	ALLEN-BRADLEY	800HORH2A	AMBER LED PILOT LIGHT, 12-130V, NEMA 4X
OL	ALLEN-BRADLEY	193-1EEDB	OVERLOAD, 230V, 1Ø, ADJUSTABLE 3.2A-16.0A RANGE
PBB	ALLEN-BRADLEY	800HAR2D2	MOMENTARY PUSH BUTTON, 1 NO, NEMA 4X, BLACK
PBB2	ALLEN-BRADLEY	800HAR2A2	MOMENTARY PUSH BUTTON, 2 NO, NEMA 4X, BLACK
PBG	ALLEN-BRADLEY	800HAR1D1	MOMENTARY PUSH BUTTON, 1 NO, NEMA 4X, GREEN
PP	PHOENIX CONTACTS	FLPPRJ45/RJ45	ETHERNET PATCH PANEL, RJ45xRJ45, DIN RAIL MOUNT
PS	ALLEN-BRADLEY	CP5.241-S1	5A, 120VAC/24VDC POWER SUPPLY
R	ALLEN-BRADLEY	700HA33A1	3PDT RELAY
	ALLEN-BRADLEY	700HN101	11 PIN SOCKET BASE
T	ALLEN-BRADLEY	700HT3	SERIES B TIMING MODULE
	ALLEN-BRADLEY	700HA33A1	3PDT RELAY
	ALLEN-BRADLEY	700HN205	11 PIN RELAY SOCKET BASE FOR TIMER
TB-1,2	ALLEN-BRADLEY	1492CAM1L	35A, 600V, LARGE-HEAD SCREW TERMINALS

LEGEND			
—	PANEL WIRING	----	FIELD WIRING
R#	CONTROL RELAY	R#-#	NORMALLY OPEN CONTACT
T#	TIME DELAY RELAY	SS-#	2-POSITION SELECTOR SWITCH
C#	CONTACTOR	R#-#	NORMALLY CLOSED CONTACT
#	TERMINAL BLOCK	SW-#	NORMALLY OPEN FLOAT SWITCH
CB-#	CIRCUIT BREAKER	SW-#	NORMALLY CLOSED FLOAT SWITCH
O.L.	OVERLOADS	PB-#	NORMALLY OPEN MOMENTARY PUSH BUTTON
			NORMALLY CLOSED MOMENTARY PUSH BUTTON
		SV#	SOLENOID VALVE
		ASL-#	ALARM & STROBE LIGHT




REVISION #1
ISSUED FOR
CONSTRUCTION
AUGUST 2025



1	UPDATED FOR 2025 AEA STANDARDS	8/15/25	BCG
REV.	DESCRIPTION	DATE	BY
PROJECT: MANOKOTAK POWER PLANT UPGRADE PROJECT			
TITLE: DAY TANK CONTROL PANEL LOGIC DIAGRAM & BILL OF MATERIALS			
DRAWN BY: JTD		SCALE: AS NOTED	
DESIGNED BY: CWV/BCG		DATE: 9/28/23	
FILE NAME: MANO PP E7		SHEET: E7.1	
PROJECT NUMBER: MANO			



P.O. 111405, Anchorage, AK 99511 (907)349-0100

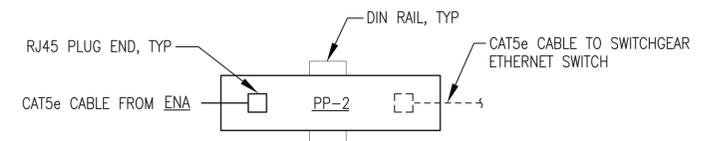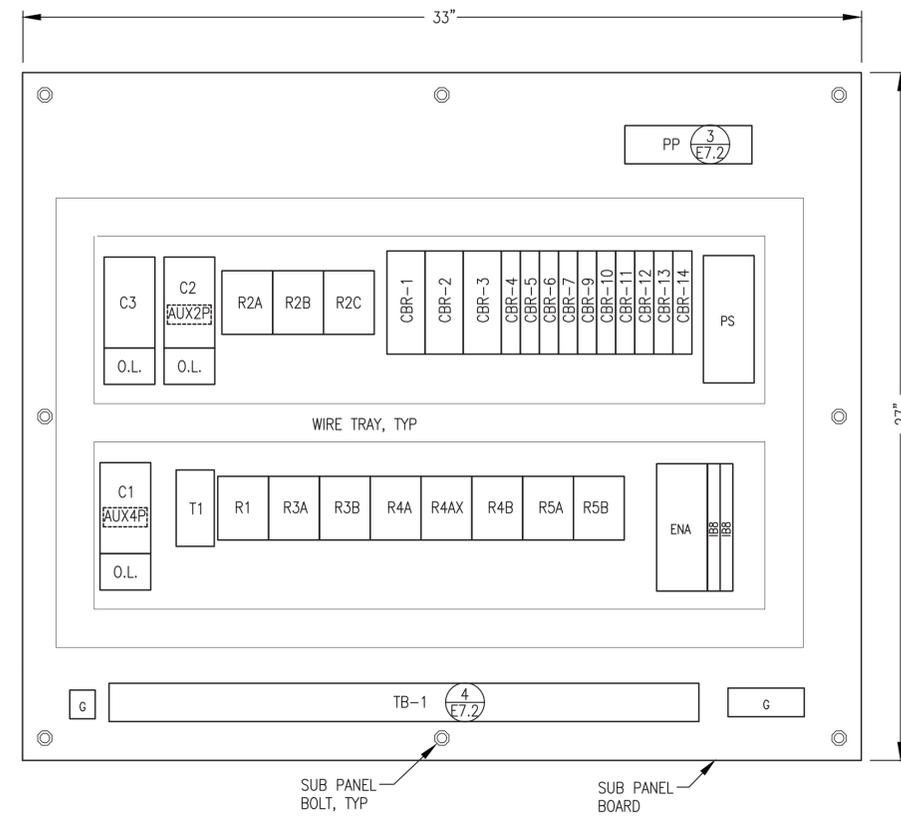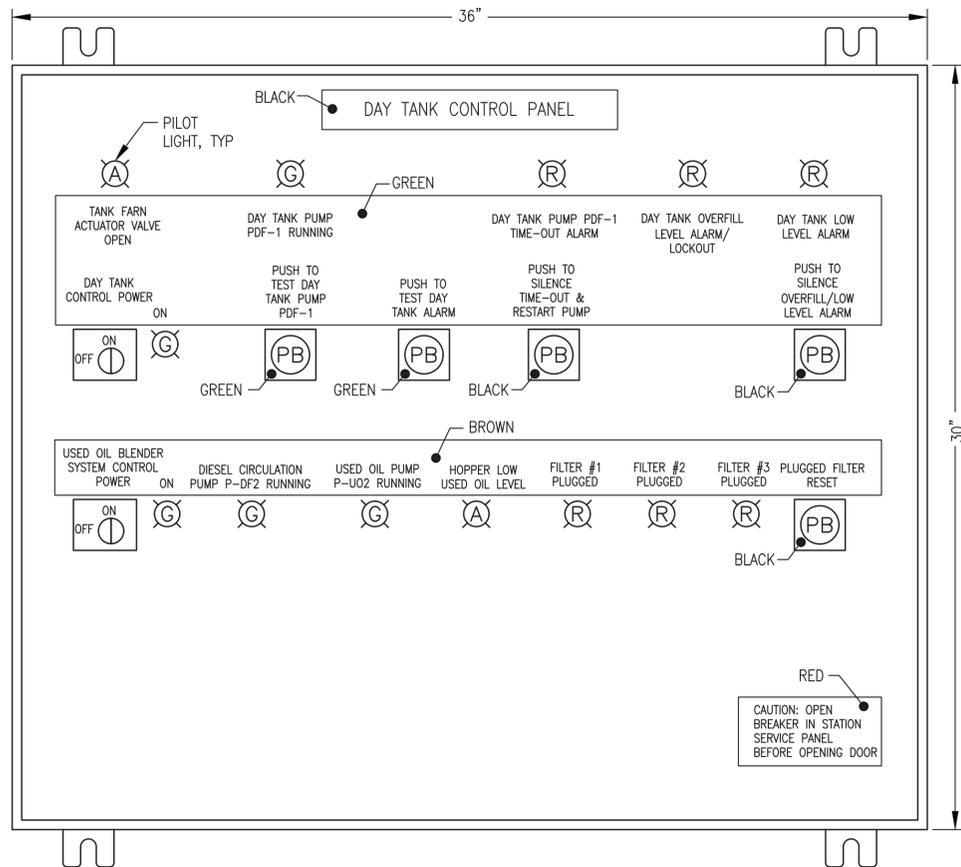


NOTE: INSTALL ETHERNET PATCH PANEL PP ON DIN RAIL AS SHOWN. LOCATE TERMINAL STRIP IN THE UPPER RIGHT CORNER OF PANEL TO ACCOMMODATE CONDUCTOR ENTRY THROUGH RIGHT SIDE OF PANEL, SEE SUB-PANEL LAYOUT.

1 FRONT PANEL LAYOUT
E7.2 NO SCALE

2 SUB PANEL LAYOUT
E7.2 NO SCALE

3 PATCH PANEL PP INSTALLATION
E7.2 NO SCALE

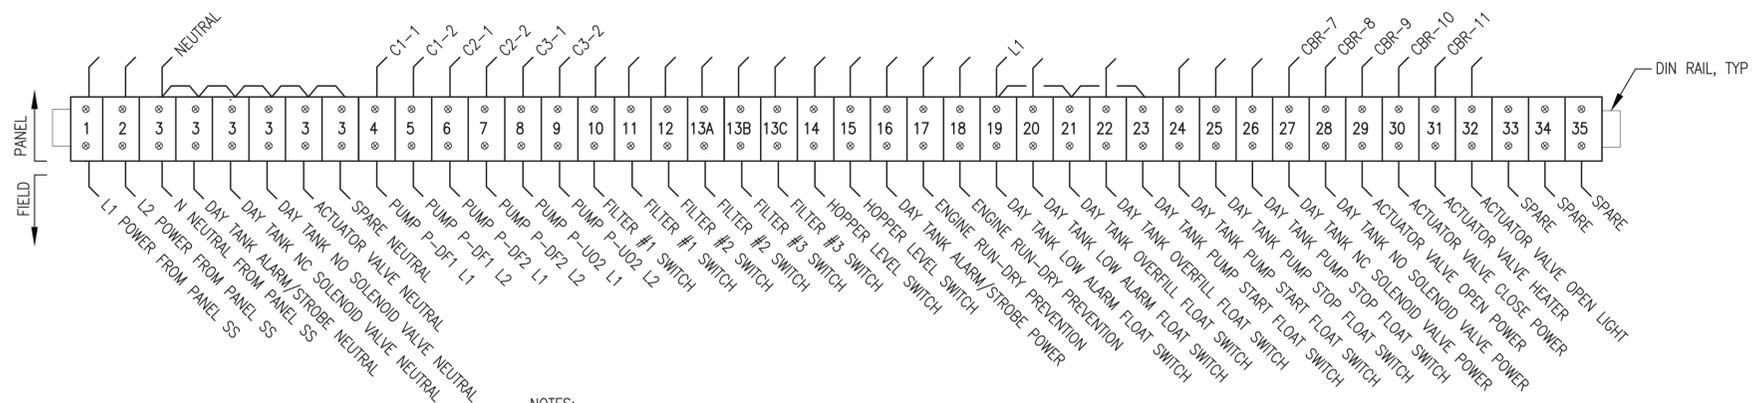

NOTES:
1) INSTALL TERMINAL STRIP TB-1 ON HORIZONTAL DIN RAIL AS SHOWN. LOCATE TERMINAL STRIP BELOW PANEL DEVICES TO ACCOMMODATE CONDUCTOR ROUTING FROM CONDUITS CONNECTING TO BOTTOM OF PANEL, SEE SUB-PANEL LAYOUT.
2) IN ADDITION TO THE TERMINAL STRIPS SHOWN, PROVIDE 6 EACH 35A SCREW TERMINAL GROUNDING BUS.

4 TB-1 TERMINAL STRIP LAYOUT
E7.2 NO SCALE

REVISION #1
ISSUED FOR
CONSTRUCTION
AUGUST 2025



1	UPDATED FOR 2025 AEA STANDARDS	8/15/25	BCG
REV.	DESCRIPTION	DATE	BY
 ALASKA ENERGY AUTHORITY			
PROJECT: MANOKOTAK POWER PLANT UPGRADE PROJECT			
TITLE: DAY TANK CONTROL PANEL LAYOUT & TERMINAL STRIPS			
DRAWN BY: JTD		SCALE: AS NOTED	
DESIGNED BY: CWV/BCG		DATE: 9/28/23	
FILE NAME: MANO PP E7		SHEET: E7.2	
PROJECT NUMBER: P.O. 111405, Anchorage, AK 99511 (907)349-0100			

PANEL NOTES:

- 1) PROVIDE COMPLETE LISTED PANEL ASSEMBLY WITH ALL DEVICES INDICATED IN LOGIC DIAGRAM EXCEPT FOR FIELD DEVICES. INSTALL IN A NEMA 12 ENCLOSURE WITH 4 EACH INTEGRAL MOUNTING LUGS AT BACK. SEE SHEET E7.2 FOR PANEL LAYOUT DETAILS.
- 2) USE MIN #12 WIRE FOR ALL CIRCUITS UP TO FIRST IN-LINE PANEL BREAKERS (FOR 20A FEED). USE MIN #16 AWG ON ALL 5 AMP CIRCUITS AND MIN #14 AWG WIRE ON ALL 15A CIRCUITS. TAG EACH END OF ALL JUMPERS WITH DEVICE OR TERMINATION DESIGNATOR OF LANDING OF OPPOSITE END OF JUMPER (REVERSE ADDRESS).
- 3) LABEL ALL PANEL DEVICES ON BASE OR BACK PANEL ADJACENT TO ITEM. LABEL REMOTE EQUIPMENT CONNECTIONS AT EACH TERMINAL BLOCK BY THE ITEM TITLE AS SHOWN ON THE FIELD SIDE OF THE TERMINAL STRIP DRAWING. PROVIDE BEVELED EDGE WHITE CORE NAMEPLATES AS SHOWN ON THE PANEL FACE LAYOUT AND SECURE TO PANEL FACE WITH A MINIMUM OF TWO STAINLESS STEEL MOUNTING SCREWS, COLOR AS INDICATED.
- 4) BENCH TEST COMPLETED UNIT. PROVIDE MIN 48 HOURS NOTICE TO ENGINEER TO SCHEDULE OBSERVATION OF BENCH TEST. PROVIDE SWITCHES AND LAMPS TO SIMULATE OPERATION OF ALL FIELD DEVICES.
- 5) DEVICES AND WIRING NOTED AS "FIELD" AND SHOWN WITH DASHED LINES WILL BE FIELD INSTALLED AND ARE NOT PART OF THE PANEL SHOP FABRICATION. FOR BENCH TEST, PROVIDE TEMPORARY DEVICES AND WIRING AS REQUIRED TO SIMULATE FIELD DEVICES.
- 6) POWER TO PANEL PROVIDED FROM DEDICATED 20A 2-POLE CIRCUIT BREAKER IN LISTED LOAD CENTER. SEE FIELD INSTALLATION NOTE #3.

FIELD INSTALLATION NOTES:


- 1) SEE MECHANICAL FOR DAY TANK INSTALLATION & PIPING. INSTALL CONTROL PANEL & FIELD DEVICES AS INDICATED TO PROVIDE REDUNDANT HIGH & LOW LIMIT CONTROLS & OVERFILL PROTECTION.
- 2) FIELD WIRING TO FLOAT SWITCHES, SOLENOID VALVES, ACTUATOR VALVE, & ALARM HORN #14 AWG. ALL OTHER FIELD WIRING #12 AWG. LABEL BOTH ENDS OF ALL CONDUCTORS WITH CONTROL PANEL TERMINAL BLOCK TERMINATION NUMBERS. WHEN NOT IN CONDUIT, MAKE JACKETED COM CABLE ENCLOSURE ENTRIES WITH CABLE GLAND CONNECTORS.
- 3) PERFORM ALL FIELD WIRING IN ACCORDANCE WITH ELECTRICAL SPECIFICATIONS. PROVIDE POWER TO DAY TANK PANEL FROM DEDICATED 20A 2-POLE CIRCUIT BREAKER IN STATION SERVICE PANELBOARD.
- 4) VERIFY THAT ALL DAY TANK FLOAT SWITCHES ARE ORIENTED FOR N.C. (OPEN ON RISE) OPERATION PRIOR TO INSTALLATION. ALL FLOATS SHOWN ON LOGIC DIAGRAM WITH TANK AT FULL (PUMP STOP) LEVEL. VERIFY THAT THE HOPPER FLOAT SWITCH IS ORIENTED FOR N.O. (CLOSE ON RISE) OPERATION.
- 5) FILL PUMP CAVITIES WITH LUBE OIL PRIOR TO INITIAL OPERATION. VERIFY PROPER ROTATION OF PUMPS. PRIME SYSTEM WITH HAND PRIMING PUMP PRIOR TO BEGINNING DAY TANK FILL.
- 6) FIELD TEST COMPLETED UNIT TO VERIFY ALL CONTROL AND ALARM FUNCTIONS. MANIPULATE FLOAT SWITCHES BY REACHING IN THROUGH ADJACENT 4" BUNG. TEMPORARILY SET TIMING RELAY TO 30 SECONDS TO VERIFY TIME-OUT AND RESET FUNCTIONS.
- 7) SET TIMING RELAY TIME DELAY TO 30 MINUTES (APPROX. 55 GALS. REQUIRED FROM PUMP START TO PUMP STOP LEVEL @ APPROX. 4 GPM). ON THE INITIAL TANK FILL, THE PUMP TEST/RESET BUTTON MAY HAVE TO BE MANUALLY RESET IN ORDER TO GET THE FUEL LEVEL TO WITHIN THE NORMAL OPERATING RANGE. SEE SEQUENCE OF OPERATIONS.

DAY TANK FILL SEQUENCE OF OPERATIONS:


- 1) WHEN THE DAY TANK CIRCUIT BREAKER AND CONTROL POWER SWITCH ARE CLOSED, THE POWER LIGHT IS ON AND POWER IS PROVIDED TO THE REMOTE ACTUATOR VALVE HEATER/OPEN LIGHT CIRCUIT.
- 2) WHEN THE DAY TANK IS NOT CALLING FOR FUEL, POWER IS PROVIDED TO THE REMOTE ACTUATOR VALVE CLOSE CIRCUIT. WHEN THE ACTUATOR IS IN THE FULLY CLOSED POSITION, THE CLOSING CIRCUIT IS BROKEN BY INTERNAL ACTUATOR LIMIT SWITCH #2 AND THE REMOTE ACTUATOR VALVE "OPEN" LIGHT IS OFF.
- 3) NORMAL FILL OPERATION – WHEN THE FUEL LEVEL DROPS TO THE "PUMP START" SWITCH, THE TIMER IS STARTED, THE N.C. DAY TANK SOLENOID VALVE OPENS, THE REMOTE ACTUATOR VALVE OPENS & THE VALVE "OPEN" LIGHT TURNS ON, THE DAY TANK PUMP IS ENERGIZED, THE PUMP "ON" LIGHT TURNS ON, AND THE USED OIL BLENDER RUN SIGNAL DRY CONTACT CLOSURES. WHEN THE ACTUATOR IS IN THE FULLY OPEN POSITION, THE OPENING CIRCUIT IS BROKEN BY INTERNAL ACTUATOR LIMIT SWITCH #7 AND THE REMOTE ACTUATOR VALVE "OPEN" LIGHT REMAINS ON. WHEN FUEL REACHES THE "PUMP STOP" FLOAT SWITCH BEFORE THE TIMER TIMES-OUT, THE TIMER IS RESET, THE N.C. DAY TANK SOLENOID VALVE AND REMOTE ACTUATOR VALVE CLOSE, THE REMOTE ACTUATOR VALVE "OPEN" LIGHT TURNS OFF, THE PUMP DE-ENERGIZES, THE PUMP "ON" LIGHT TURNS OFF, AND THE USED OIL BLENDER RUN SIGNAL DRY CONTACT OPENS.
- 4) TIMER OPERATION – IF THE TIMER TIMES-OUT THE N.C. DAY TANK SOLENOID VALVE AND REMOTE ACTUATOR VALVE CLOSE, THE REMOTE ACTUATOR VALVE "OPEN" LIGHT TURNS OFF, THE PUMP DE-ENERGIZES, THE PUMP "ON" LIGHT TURNS OFF, THE USED OIL BLENDER RUN SIGNAL DRY CONTACT OPENS, THE "TIME-OUT" ALARM LIGHT TURNS ON, AND THE TIME-OUT ALARM HORN SOUNDS. PRESSING THE "TIME-OUT ALARM SILENCE / PUMP RESTART" BUTTON RESETS THE TIMER, SILENCES THE ALARM HORN, AND STARTS THE NORMAL FILL OPERATION. SEE FIELD INSTALLATION NOTES FOR TIMER SETTING.
- 5) OVERFILL FUEL LEVEL – IF THE TANK OVERFILLS AND THE FUEL LEVEL REACHES THE "OVERFILL" FLOAT SWITCH, THE N.O. DAY TANK SOLENOID VALVE CLOSURES, THE "OVERFILL LEVEL" ALARM LIGHT TURNS ON, THE N.C. DAY TANK SOLENOID VALVE AND REMOTE ACTUATOR VALVE CLOSE, THE VALVE "OPEN" LIGHT TURNS OFF, THE PUMP DE-ENERGIZES, THE PUMP "ON" LIGHT TURNS OFF, THE USED OIL BLENDER RUN SIGNAL DRY CONTACT OPENS, THE "OVERFILL LEVEL" ALARM LIGHT TURNS ON, AND THE ALARM HORN SOUNDS. PRESSING THE LEVEL ALARM HORN "SILENCE" BUTTON SILENCES THE ALARM HORN WHILE LEAVING THE "OVERFILL LEVEL" ALARM LIGHT ON. WHEN THE FUEL LEVEL FALLS BELOW THE "OVERFILL" FLOAT SWITCH, THE "OVERFILL LEVEL" ALARM LIGHT TURNS OFF, THE N.O. DAY TANK SOLENOID VALVE OPENS AND THE ALARM HORN TURNS OFF (IF NOT PREVIOUSLY SILENCED). WHEN THE FUEL LEVEL REACHES THE "PUMP START" FLOAT SWITCH, THE NORMAL FILL OPERATION IS REPEATED.
- 6) LOW FUEL LEVEL – IF THE FUEL LEVEL FALLS BELOW THE "LOW ALARM" FLOAT SWITCH, THE "LOW FUEL LEVEL" ALARM LIGHT TURNS ON, THE ENGINE RUN-DRY PREVENTION DRY CONTACT OPENS, AND THE ALARM HORN SOUNDS. THE LEVEL ALARM HORN "SILENCE" BUTTON SILENCES THE ALARM HORN WHILE LEAVING THE "LOW FUEL LEVEL" ALARM LIGHT ON. WHEN THE FUEL LEVEL RISES ABOVE THE "LOW ALARM" FLOAT SWITCH THE "LOW FUEL LEVEL" ALARM LIGHT TURNS OFF, THE ENGINE RUN-DRY PREVENTION DRY CONTACT CLOSURES, AND THE ALARM HORN TURNS OFF (IF NOT PREVIOUSLY SILENCED).
- 7) PUMP & HORN TEST – MOMENTARY CONTACT BUTTONS ARE PROVIDED TO TEST FUNCTION OF THE DAY TANK PUMP AND ALARM HORN. PRESSING THE "PUSH TO TEST DAY TANK PUMP" BUTTON STARTS THE TIMER, MOMENTARILY OPENS THE N.C. DAY TANK SOLENOID VALVE & ACTUATED BALL VALVE, ENERGIZES THE DAY TANK PUMP, TURNS ON THE DAY TANK PUMP "RUNNING" LIGHT AND CLOSURES THE USED OIL BLENDER RUN SIGNAL DRY CONTACT. THE "PUSH TO TEST DAY TANK PUMP" BUTTON IS LOCKED OUT IF THE DAY TANK IS AT THE OVERFILL LEVEL. PRESSING THE "PUSH TO TEST DAY TANK ALARM" BUTTON MOMENTARILY ENERGIZES THE ALARM HORN/STROBE.

USED OIL BLENDER SYSTEM SEQUENCE OF OPERATIONS:

- 1) WHEN THE BLENDER CIRCUIT BREAKER AND CONTROL POWER SWITCH ARE CLOSED; THE GREEN POWER LIGHT IS ON AND POWER IS PROVIDED TO ALL CONTROL DEVICES.
- 2) NORMAL OPERATION – WHENEVER THE DAY TANK FILL SEQUENCE IS INITIATED, BOTH THE DIESEL CIRCULATING PUMP P-DF2 AND THE USED OIL INJECTION PUMP P-U02 RUN AND THE ASSOCIATED GREEN PUMP RUNNING LIGHTS ARE ON.
- 3) PLUGGED FILTER – IF THE DIFFERENTIAL PRESSURE ACROSS A FILTER REACHES THE ALARM SETPOINT, BOTH PUMPS STOP RUNNING AND THE RED FILTER PLUGGED LIGHT FOR THE ASSOCIATED FILTER TURNS ON. THE ALARM LATCHES AND THE SYSTEM WILL NOT OPERATE UNTIL THE PROBLEM IS CORRECTED. AFTER THE FILTER ELEMENT HAS BEEN CHANGED THE BLACK RESET BUTTON MUST BE PRESSED TO RESUME NORMAL OPERATION.
- 4) HOPPER LOW OIL LEVEL – WHEN THE OIL LEVEL FALLS BELOW THE LOW LEVEL FLOAT SWITCH, USED OIL INJECTION PUMP P-U02 STOPS RUNNING AND THE AMBER HOPPER LOW OIL LEVEL LIGHT TURNS ON. PUMP P-U02 WILL NOT OPERATE UNTIL THE USED OIL LEVEL IN THE HOPPER RISES ABOVE THE LOW LEVEL. RESET IS NOT REQUIRED.

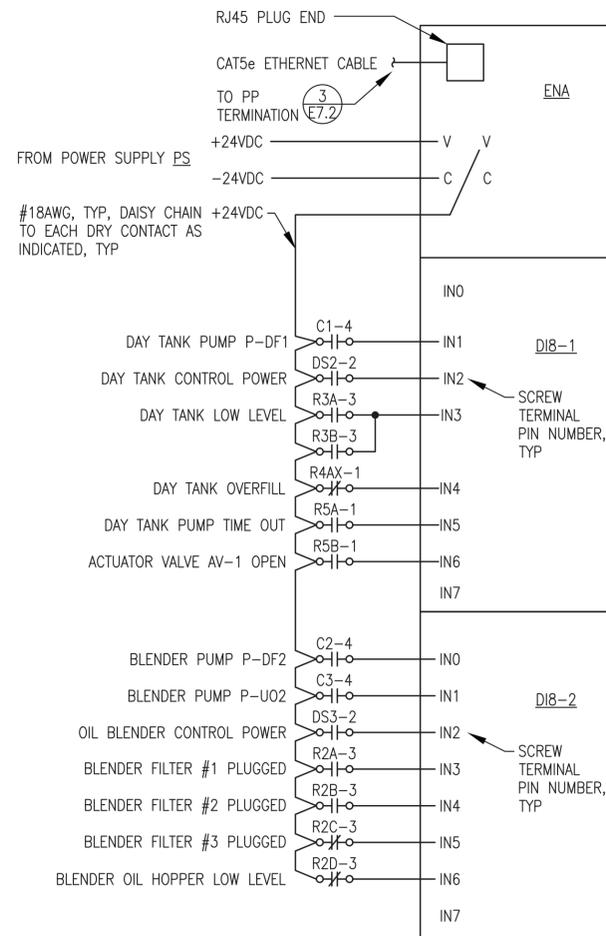

1 **E7.3** ETHERNET POINT I/O CONNECTIONS
NO SCALE

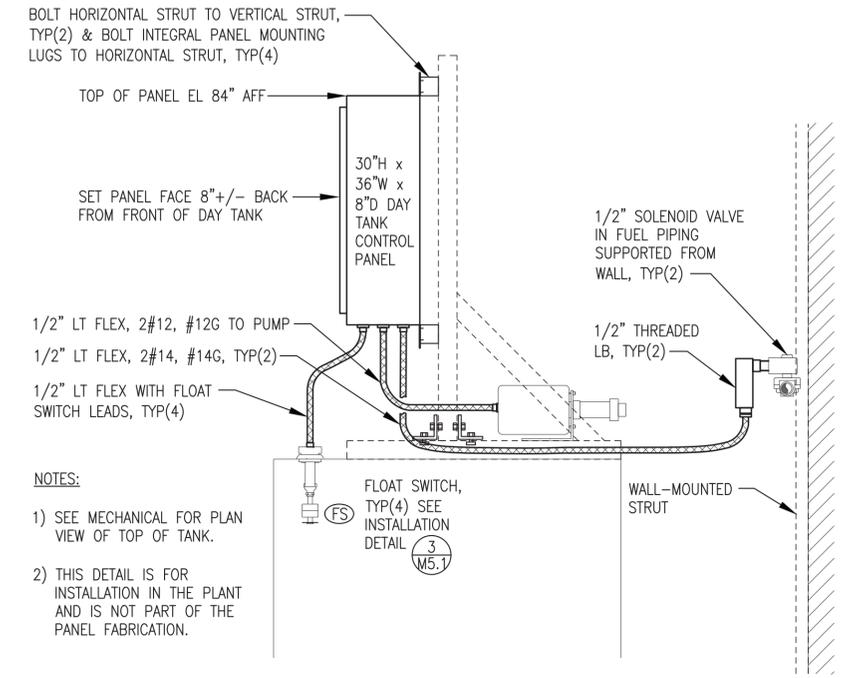


2 **E7.3** DAY TANK CONTROL PANEL & DEVICE INSTALLATION
NO SCALE


REVISION #1
ISSUED FOR
CONSTRUCTION
AUGUST 2025




1	UPDATED FOR 2025 AEA STANDARDS	8/15/25	BCG
REV.	DESCRIPTION	DATE	BY
 ALASKA ENERGY AUTHORITY			
PROJECT: MANOKOTAK POWER PLANT UPGRADE PROJECT			
TITLE: DAY TANK CONTROL PANEL NOTES, SEQUENCE OF OPERATIONS & INTERCONNECT DETAILS			
DRAWN BY: JTD		SCALE: AS NOTED	
DESIGNED BY: CWV/BCG		DATE: 9/28/23	
FILE NAME: MANO PP E7		SHEET: E7.3	
P.O. 111405, Anchorage, AK 99511 (907)349-0100			

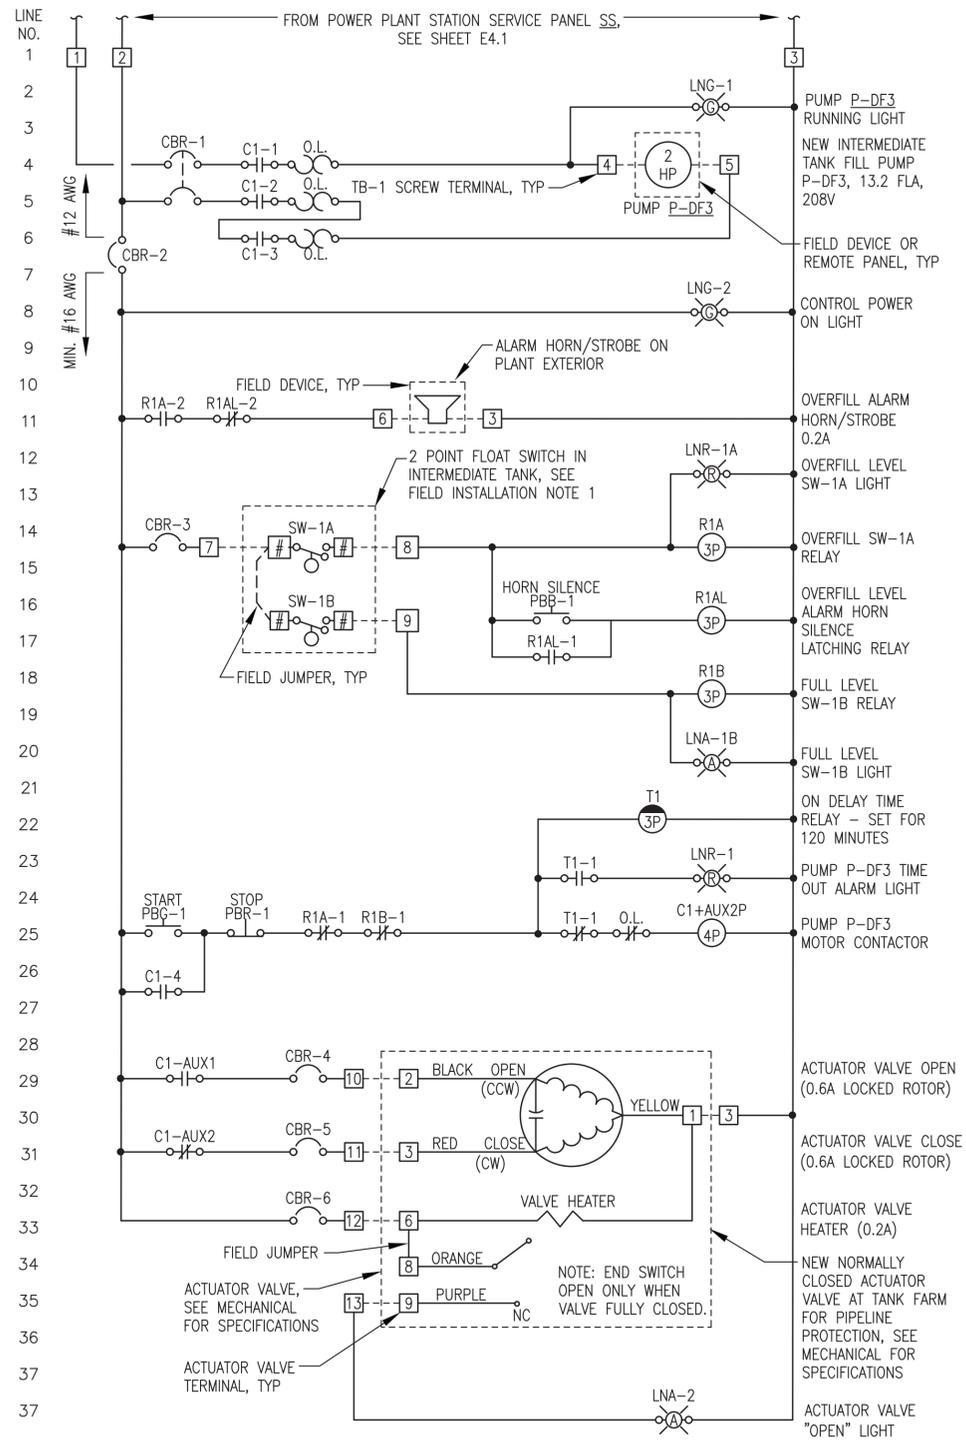


1 LOGIC DIAGRAM
E7.4 NO SCALE

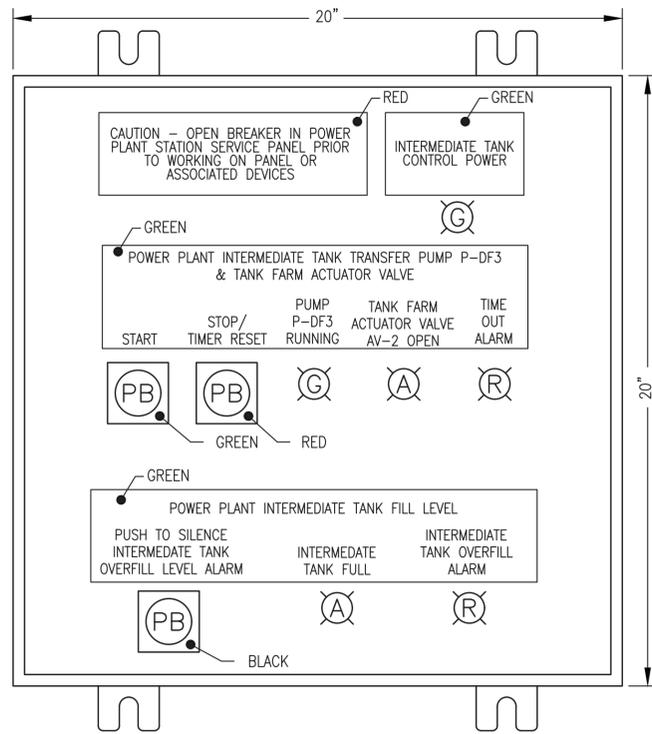

2 FRONT PANEL LAYOUT
E7.4 NO SCALE

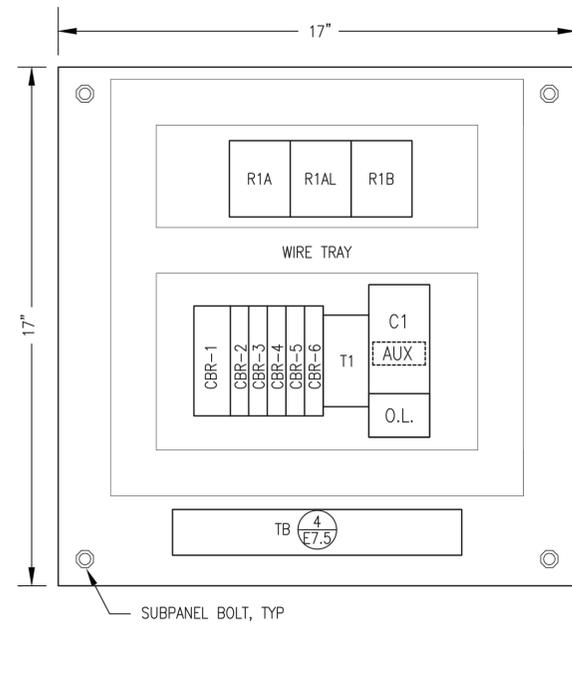

3 SUBPANEL LAYOUT
E7.4 NO SCALE

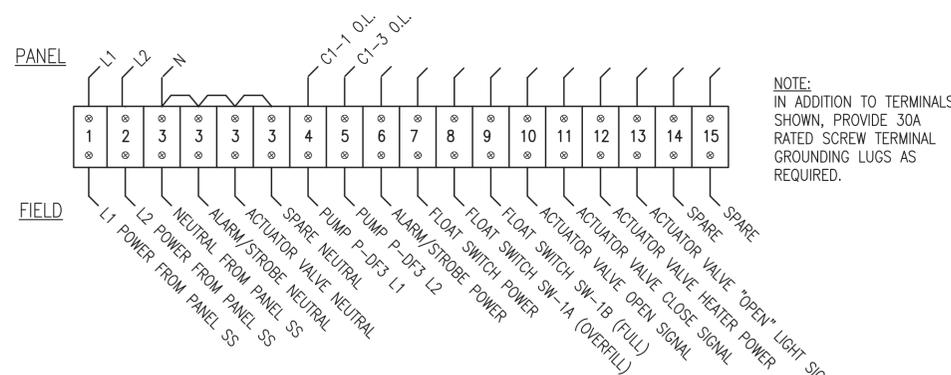

4 TERMINAL STRIP TB
E7.4 NO SCALE

SEQUENCE OF OPERATIONS:

- 1) WHEN THE CIRCUIT BREAKER IN THE STATION SERVICE PANELBOARD IS CLOSED: POWER IS PROVIDED TO THE CONTROL PANEL. IN NORMAL INACTIVE STATUS POWER IS PROVIDED TO THE ACTUATOR VALVE CLOSE CIRCUIT. WHEN THE ACTUATOR IS IN THE FULLY CLOSED POSITION: THE ACTUATOR CLOSE CIRCUIT IS BROKEN BY AN INTERNAL LIMIT SWITCH IN THE ACTUATOR AND THE ACTUATOR VALVE "OPEN" LIGHT IS OFF.
- 2) **NORMAL FILL OPERATION** - WHEN THE "START" BUTTON IS PRESSED: THE TIMING RELAY IS STARTED, THE PUMP STARTS, THE PUMP "ON" LIGHT TURNS ON, THE ACTUATOR VALVE BEGINS TO OPEN, AND THE "ACTUATOR VALVE OPEN" LIGHT IS ENERGIZED. WHEN THE ACTUATOR VALVE REACHES THE FULLY OPEN POSITION: THE ACTUATOR OPEN CIRCUIT IS BROKEN BY AN INTERNAL LIMIT SWITCH AND THE "ACTUATOR VALVE OPEN" LIGHT REMAINS ON. WHEN THE FUEL LEVEL REACHES THE FULL FLOAT SWITCH: THE "TANK FULL" LIGHT TURNS ON, THE TIMING RELAY IS RESET, THE PUMP STOPS, THE PUMP "ON" LIGHT TURNS OFF, THE ACTUATOR VALVE CLOSES, AND THE REMOTE ACTUATOR VALVE "OPEN" LIGHT TURNS OFF. PRESSING THE "STOP" BUTTON AT ANY TIME DURING A NORMAL FILL CYCLE WILL PERFORM THE SAME FUNCTION AS THE FUEL LEVEL REACHING THE FULL FLOAT SWITCH EXCEPT THE "TANK FULL" LIGHT WILL NOT BE TURNED ON.
- 3) **TIMER OPERATION** - IF THE TIMING RELAY TIMES OUT BEFORE THE FILL CYCLE IS STOPPED THE SEQUENCE IS IDENTICAL TO THE NORMAL PUMP STOP SEQUENCE EXCEPT: THE "TIME OUT" ALARM LIGHT ON THE FACE OF THE PANEL IS TURNED ON. THE "TIME OUT" ALARM LIGHT REMAINS ON AND PUMP P-DF3 CANNOT BE STARTED UNTIL THE TIMER IS RESET BY PRESSING THE STOP BUTTON.
- 4) **OVERFILL ALARM** - IF THE INTERMEDIATE TANK OVERFILLS AND THE FUEL LEVEL REACHES THE OVERFILL FLOAT SWITCH: THE "OVERFILL ALARM" LIGHT TURNS ON, THE ALARM HORN SOUNDS, THE TIMING RELAY IS RESET, AND AFTER APPROXIMATELY 10 SECONDS THE "ACTUATOR VALVE OPEN" LIGHT TURNS OFF. PRESSING THE "SILENCE OVERFILL ALARM" BUTTON SILENCES THE ALARM HORN BUT THE "OVERFILL ALARM" LIGHT WILL STAY ON UNTIL THE FUEL LEVEL FALLS BELOW THE OVERFILL FLOAT SWITCH. A NEW FILL CYCLE CANNOT BE STARTED UNTIL THE FUEL LEVEL DROPS BELOW THE FULL LEVEL.

PANEL FABRICATION NOTES:

- 1) PROVIDE COMPLETE LISTED PANEL ASSEMBLY WITH ALL DEVICES INDICATED IN LOGIC DIAGRAM EXCEPT FOR FIELD DEVICES. FIELD DEVICES ARE INDICATED BY DASHED OUTLINES. FIELD WIRING AND FIELD INSTALLED DEVICES PROVIDED BY OTHERS ARE SHOWN FOR INFORMATIONAL PURPOSES ONLY AND ARE NOT PART OF THE PANEL SCOPE.
- 2) INSTALL IN A 20"x20"x8" NEMA 12 STEEL ENCLOSURE WITH 4 EACH INTEGRAL MOUNTING LUGS AT BACK, A MIN 14 GAUGE INTERIOR BACK PANEL, AND HINGED LOCKABLE DOOR.
- 3) USE MINIMUM #16AWG FOR ALL WIRING UNLESS SPECIFICALLY NOTED OTHERWISE. TAG EACH END OF ALL JUMPERS WITH DEVICE OR TERMINATION DESIGNATOR OF LANDING OF OPPOSITE END OF JUMPER (REVERSE ADDRESS).
- 4) LABEL ALL PANEL DEVICES ON BASE OR BACK PANEL ADJACENT TO ITEM. LABEL REMOTE EQUIPMENT CONNECTIONS AT EACH TERMINAL BLOCK BY THE ITEM TITLE AS SHOWN ON THE FIELD SIDE OF THE TERMINAL STRIP DRAWING.
- 5) PROVIDE DIN RAIL, END PLATES, HARDWARE AND ACCESSORIES AS REQUIRED FOR MOUNTING ALL DIN RAIL DEVICES AND TERMINAL BLOCKS.
- 6) PROVIDE BEVELED EDGE WHITE CORE NAMEPLATES, FACE COLOR AS INDICATED, AND SECURE TO PANEL FACE WITH A MINIMUM OF TWO STAINLESS STEEL MOUNTING SCREWS.
- 7) BENCH TEST THE COMPLETED ASSEMBLY PRIOR TO SHIPPING. PROVIDE MIN 48 HOURS NOTICE TO ENGINEER TO SCHEDULE OBSERVATION OF BENCH TEST. PROVIDE SWITCHES AND LAMPS TO SIMULATE OPERATION OF ALL FIELD DEVICES. TEST IN CONJUNCTION WITH TANK FARM AUXILIARY PANEL TO VERIFY FUNCTION.

FIELD INSTALLATION NOTES:

- 1) SEE SHEETS E4.2 AND E9 FOR FIELD INSTALLATION.
- 2) PRIOR TO PLACING IN THE TANK, VERIFY THAT BOTH FLOAT SWITCHES ARE ORIENTED NO (CLOSE ON RISE). LABEL FLOAT SWITCH TERMINALS WITH THE NUMBER OF THE ASSOCIATED HOME RUN LANDING ON TB-1 IN THE CONTROL PANEL.
- 3) PERFORM ALL FIELD WIRING IN ACCORDANCE WITH SPECIFICATIONS. LABEL BOTH ENDS OF ALL FIELD WIRING WITH THE NUMBER OF THE ASSOCIATED HOME RUN LANDING ON TB-1 IN THE CONTROL PANEL. INSTALL JUMPERS ON FIELD DEVICES AS SHOWN. USE MIN #14AWG FOR CONNECTION TO ALL FIELD DEVICES EXCEPT #12 TO PUMP.
- 4) TEST ALL CONTROL AND ALARM FUNCTIONS UPON COMPLETION AND PRIOR TO PLACING INTO SERVICE. SET TIMERS TO 10 SECONDS TO VERIFY TIME OUT FUNCTION, THEN RE-SET TO VALUES SHOWN.

BILL OF MATERIALS

NOTE: ON THIS SHEET AND THE PANEL DRAWINGS THAT FOLLOW SPECIFIC PARTS MANUFACTURER AND MODEL ARE SELECTED NOT ONLY TO MEET PERFORMANCE FUNCTION BUT ALSO TO COORDINATE AND INTERFACE WITH OTHER DEVICES AND SYSTEMS. APPROVED EQUAL SUBSTITUTIONS WILL BE ALLOWED ONLY BY ENGINEER'S APPROVAL. TO OBTAIN APPROVAL, SUBMITTALS MUST CLEARLY DEMONSTRATE HOW SUBSTITUTE ITEM MEETS OR EXCEEDS SPECIFIED ITEM QUALITY AND PERFORMANCE CHARACTERISTICS AND ALSO COMPLIES WITH MECHANICAL AND/OR ELECTRICAL CONNECTIONS AND PHYSICAL LAYOUT REQUIREMENTS.

TAG	MANUFACTURER	MODEL	DESCRIPTION
AUX2P	ALLEN-BRADLEY	100-FA11	AUX. CONTACT FOR CONTACTOR, 2 POLE NO, NC
C	ALLEN-BRADLEY	100C23D10	CONTACTOR, 120V COIL, 23A, 4 POLE
CBR-1	ALLEN-BRADLEY	1489-M2-C150	RAIL-MOUNT CIRCUIT BREAKER, 2 POLE, 15A
CBR-2,3	ALLEN-BRADLEY	1489-M1-C050	RAIL-MOUNT CIRCUIT BREAKER, 1 POLE, 5A
CBR-4,5,6	ALLEN-BRADLEY	1489-M1-C010	RAIL-MOUNT CIRCUIT BREAKER, 1 POLE, 1A
LNA	ALLEN-BRADLEY	800HQH2A	AMBER LED PILOT LIGHT, 12-120V, NEMA 4X
LNG	ALLEN-BRADLEY	800HQH2G	GREEN LED PILOT LIGHT, 12-120V, NEMA 4X
LNR	ALLEN-BRADLEY	800HQH2R	RED LED PILOT LIGHT, 12-120V, NEMA 4X
OL	ALLEN-BRADLEY	193-1EEDB	OVERLOAD, 230V, 1Ø, ADJUSTABLE 3.2-16.0A RANGE
PBB	ALLEN-BRADLEY	800HAR2	MOMENTARY PUSH BUTTON, 1NO, NEMA 4X, BLACK
PBG	ALLEN-BRADLEY	800HAR1	MOMENTARY PUSH BUTTON, 1NO, NEMA 4X, GREEN
PBR	ALLEN-BRADLEY	800HAR6D2	MOMENTARY PUSH BUTTON, 1NC, NEMA 4X, RED
R	ALLEN-BRADLEY	700HA33A1	3PDT RELAY
	ALLEN-BRADLEY	700HN101	11 PIN SOCKET BASE
T	ALLEN-BRADLEY	700HA33A1	3PDT RELAY
	ALLEN-BRADLEY	700HN205	11 PIN RELAY SOCKET BASE FOR TIMER
	ALLEN-BRADLEY	700HT3	SERIES B TIMING MODULE
TB	ALLEN-BRADLEY	1492CAM1L	LARGE-HEAD SCREW TERMINALS, 35A, 600V

REVISION #1
ISSUED FOR
CONSTRUCTION
AUGUST 2025




1	UPDATED FOR 2025 AEA STANDARDS	8/15/25	BCG
REV.	DESCRIPTION	DATE	BY


PROJECT: MANOKOTAK POWER PLANT UPGRADE PROJECT

TITLE: INTERMEDIATE TANK CONTROL PANEL

DRAWN BY: JTD	SCALE: AS NOTED
DESIGNED BY: CWV/BCG	DATE: 9/28/23
FILE NAME: MANO PP E7	SHEET: E7.4
PROJECT NUMBER:	

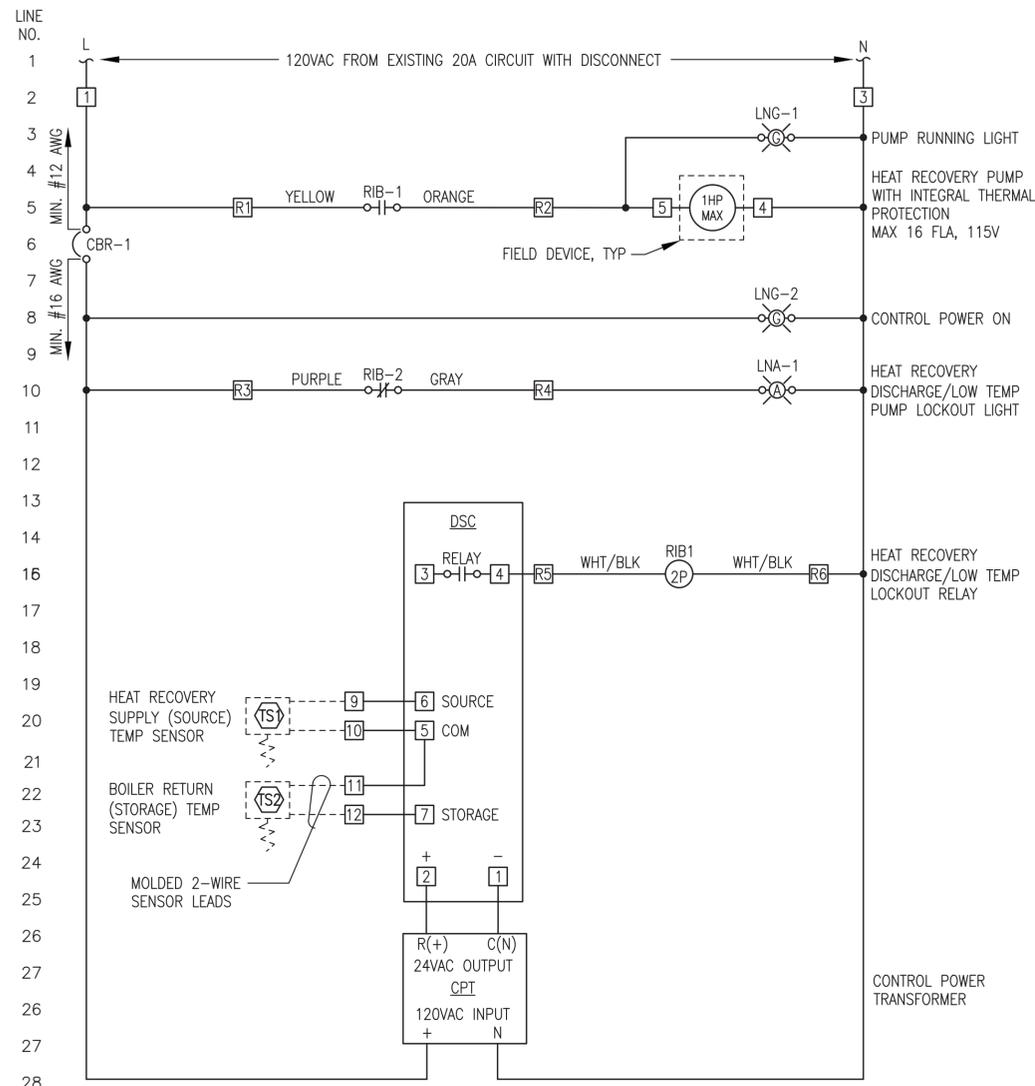


1 HEAT RECOVERY PANEL LOGIC DIAGRAM
E8.1 NO SCALE

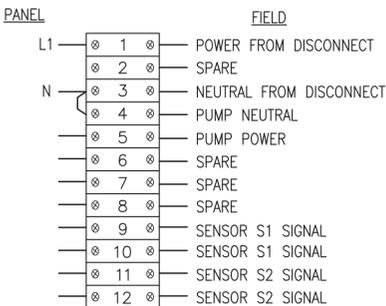


4 TERMINAL STRIP TB-1
E8.1 NO SCALE

5 RIB TERMINAL STRIP
E8.1 NO SCALE

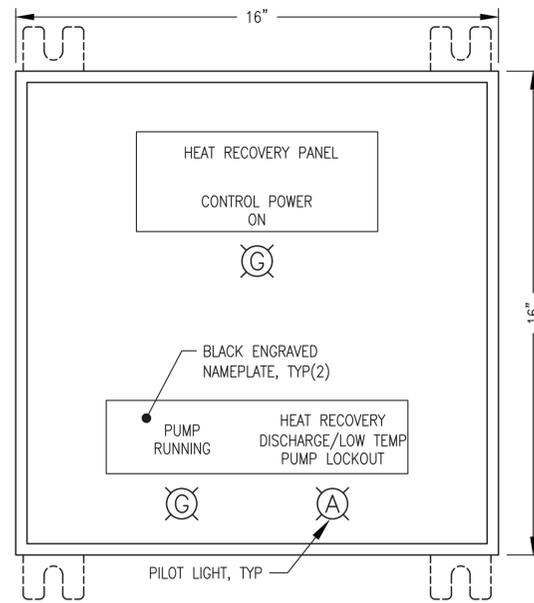

2 FRONT PANEL LAYOUT
E8.1 NO SCALE

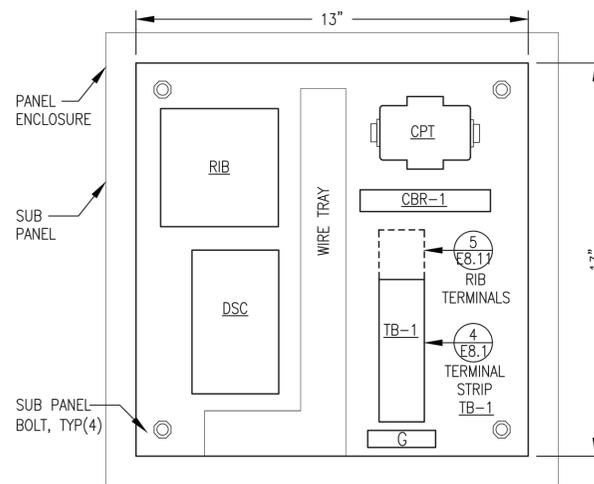


3 SUB PANEL LAYOUT
E8.1 NO SCALE

FIELD NOTE:
IF MOLDED LEAD CANNOT REACH PANEL SOLDER SPLICE AND HEAT SHRINK TO #18 SHIELDED PAIR AS REQUIRED. SUPPORT LEADS FROM PIPING AND/OR CONDUIT WITH WIRE TIES. USE CABLE GLANDS OR ROMEX CLAMPS FOR CABLE ENTRIES INTO JUNCTION BOX OR PANEL.

2#12, #12G FROM DISCONNECT, SEE PLAN

6 TYPICAL HEAT RECOVERY PANEL HRP FIELD TERMINAL CONNECTIONS
E8.1 NO SCALE

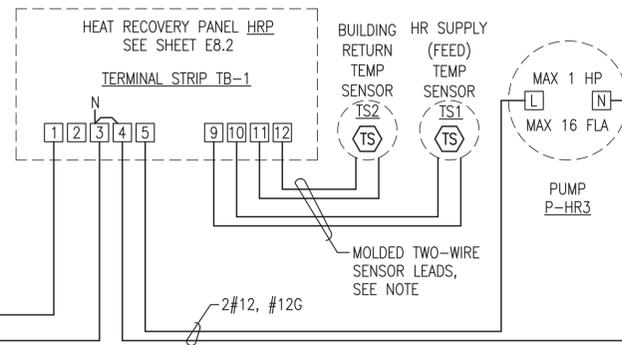

LEGEND			
R#	CONTROL RELAY	R#-#	NORMALLY OPEN CONTACT
#	TERMINAL BLOCK	R#-#	NORMALLY CLOSED CONTACT
CB-#	CIRCUIT BREAKER	---	FIELD WIRING
		---	PANEL WIRING

BILL OF MATERIALS

TAG	QTY	MANUFACTURER	MODEL	DESCRIPTION
CBR	1	ALLEN-BRADLEY	1489-M1-C050	RAIL-MOUNT CIRCUIT BREAKER, 1 POLE, 5A
CPT	1	FUNCTIONAL DEVICES	TR40VA002	40VA, 24VAC CONTROL POWER TRANSFORMER
DSC	1	TEKMAR	MODEL 156	DIFFERENCE SETPOINT CONTROLLER WITH MINIMUM AND MAXIMUM TEMPERATURE FUNCTIONS, 24VAC, 1 EACH N.O. RELAY RATED 240V, 10A, 1/3HP
LNG	2	ALLEN-BRADLEY	800HQRH10G	GREEN LED PILOT LIGHT, 120V, NEMA 4X
LNA	1	ALLEN-BRADLEY	800HQRH10A	AMBER LED PILOT LIGHT, 120V, NEMA 4X
RIB	1	FUNCTIONAL DEVICES	RIB01P	DPDT RELAY, 120VAC COIL, 20A, 1HP N.C. RATED
TS1,2	2	TEKMAR	MODEL 085	SOLAR SENSOR, 10K THERMISTOR, 6mm DIA x 45mm LONG, 5' LEAD WIRE
TB		ALLEN-BRADLEY	1492CAM1L	35A, 600V, LARGE-HEAD SCREW TERMINALS

HEAT RECOVERY PANEL SEQUENCE OF OPERATION:

CONTROL POWER: WHEN THE CIRCUIT BREAKER IN THE LOAD CENTER IS CLOSED, THE WALL-MOUNT DISCONNECT IS CLOSED, AND THE INTERNAL CIRCUIT BREAKER CBR-1 IS CLOSED, POWER IS PROVIDED TO CONTROL DEVICES AND THE "CONTROL POWER ON" LIGHT IS ON.

NORMAL OPERATION: WHEN THE DIFFERENCE BETWEEN SENSOR S1 (HEAT RECOVERY SUPPLY TEMPERATURE OR "SOURCE") AND SENSOR S2 (BOILER RETURN TEMPERATURE OR "STORAGE") IS GREATER THAN THE DELTA-T SETPOINT (7 DEG F) AND THE HEAT RECOVERY SUPPLY SENSOR S1 TEMPERATURE IS GREATER THAN THE MINIMUM SOURCE SETPOINT (160 DEG F): THE PUMP WILL RUN AND THE "PUMP RUNNING" LIGHT WILL BE ON.

DISCHARGE LOCKOUT OPERATION: WHEN THE DIFFERENCE BETWEEN SENSOR S1 AND SENSOR S2 BECOMES LESS THAN THE DELTA-T SETPOINT (7 DEG F) MINUS THE DELTA-T DIFFERENTIAL (5 DEG F): THE DSC RELAY WILL OPEN, THE RIB1 COIL WILL BE DE-ENERGIZED, THE AMBER "LOCKOUT" LIGHT WILL TURN ON, AND THE PUMP WILL STOP. WHEN THE DIFFERENCE BETWEEN S1 AND S2 BECOMES GREATER THAN THE DELTA-T SETPOINT: THE DSC RELAY WILL CLOSE, THE RIB1 COIL WILL BE ENERGIZED, THE AMBER "LOCKOUT" LIGHT WILL TURN OFF, AND THE PUMP WILL RUN.

DISTRICT HEAT LOW TEMPERATURE LOCKOUT OPERATION: IF THE HEAT RECOVERY SUPPLY TEMPERATURE (SENSOR S1 "SOURCE") FALLS TO LESS THAN THE MINIMUM SOURCE SETPOINT (160 DEG F): THE DSC RELAY WILL OPEN, THE RIB2 COIL WILL BE DE-ENERGIZED, THE AMBER "LOCKOUT" LIGHT WILL TURN ON AND THE PUMP WILL STOP. WHEN THE HEAT RECOVERY SUPPLY TEMPERATURE (S1) RECOVERS AND BECOMES EQUAL TO THE MINIMUM SOURCE SETPOINT (160 DEG F) PLUS THE MINIMUM SOURCE DIFFERENTIAL (5 DEG F): THE DSC RELAY WILL CLOSE, THE RIB2 COIL WILL BE ENERGIZED, THE AMBER "LOCKOUT" LIGHT WILL TURN OFF, AND THE PUMP WILL RUN.

SHOP FABRICATION NOTES:

- FURNISH COMPLETE PANEL ASSEMBLY WITH ALL DEVICES INDICATED IN LOGIC DIAGRAM AND BILL OF MATERIALS ALONG WITH ALL PANEL DEVICE ACCESSORIES REQUIRED FOR COMPLETE INSTALLATION. FURNISH TEMPERATURE SENSORS LOOSE SHIP WITH PANEL FOR FIELD INSTALLATION.
- INSTALL IN A NEMA 12 ENCLOSURE, MIN 14 GAUGE STEEL CONSTRUCTION WITH 4 EACH INTEGRAL MOUNTING LUGS AT BACK, A MIN 14 GAUGE INTERIOR BACK PANEL, AND HINGED LOCKABLE DOOR. PAINT ENCLOSURE ANSI 61 GRAY AND PAINT BACK PANEL WHITE.
- TAG EACH END OF ALL JUMPERS WITH DEVICE OR TERMINATION DESIGNATOR OF LANDING OF OPPOSITE END OF JUMPER (REVERSE ADDRESS).
- LABEL ALL PANEL DEVICES ON BASE OR BACK PANEL ADJACENT TO ITEM. LABEL REMOTE EQUIPMENT CONNECTIONS AT EACH TERMINAL BLOCK BY THE ITEM TITLE AS SHOWN ON THE FIELD SIDE OF THE TERMINAL STRIP DRAWING.
- PROVIDE BEVELED EDGE WHITE CORE NAMEPLATES, FACE COLOR AS INDICATED. SECURE TO PANEL FACE WITH A MINIMUM OF TWO MOUNTING SCREWS.
- PROGRAM THE DIFFERENTIAL SETPOINT CONTROLLER (DSC) WITH THE FOLLOWING SETTINGS:
SET THE DRAINDOWN/DRAINBACK DIP SWITCH TO DRAINDOWN.
 ΔT SETPOINT=7; ΔT DIFFERENTIAL=5; MINIMUM SOURCE SETPOINT=160; MINIMUM SOURCE DIFFERENTIAL=5;
MAXIMUM STORAGE SETPOINT=200; MAXIMUM STORAGE DIFFERENTIAL=10. SET DISPLAY TO 'F'.
- BENCH TEST COMPLETED UNIT. PROVIDE MIN 48 HOURS NOTICE TO ENGINEER TO SCHEDULE OBSERVATION OF BENCH TEST. PROVIDE SWITCHES AND LAMPS TO SIMULATE OPERATION OF ALL FIELD DEVICES.


FIELD INSTALLATION NOTES:

- SEE FIELD WIRING DIAGRAM 6/E8.1. PERFORM ALL FIELD WIRING IN ACCORDANCE WITH ELECTRICAL SPECIFICATIONS. FIELD WIRING TO MOTORS MIN #12 AWG. LABEL BOTH ENDS OF ALL CONDUCTORS WITH PANEL TERMINAL BLOCK TERMINATION NUMBERS.


REVISION #1
ISSUED FOR
CONSTRUCTION
AUGUST 2025



1	UPDATED FOR 2025 AEA STANDARDS	8/15/25	BCG
REV.	DESCRIPTION	DATE	BY
 ALASKA ENERGY AUTHORITY			
PROJECT: MANOKOTAK POWER PLANT UPGRADE PROJECT			
TITLE: HEAT RECOVERY SYSTEM HEAT RECOVERY PANEL HRP			
DRAWN BY: JTD		SCALE: AS NOTED	
DESIGNED BY: CWV/BCG		DATE: 9/28/23	
FILE NAME: MANO PP E8		SHEET:	
PROJECT NUMBER:		E8.1	
P.O. 111405, Anchorage, AK 99511 (907)349-0100			

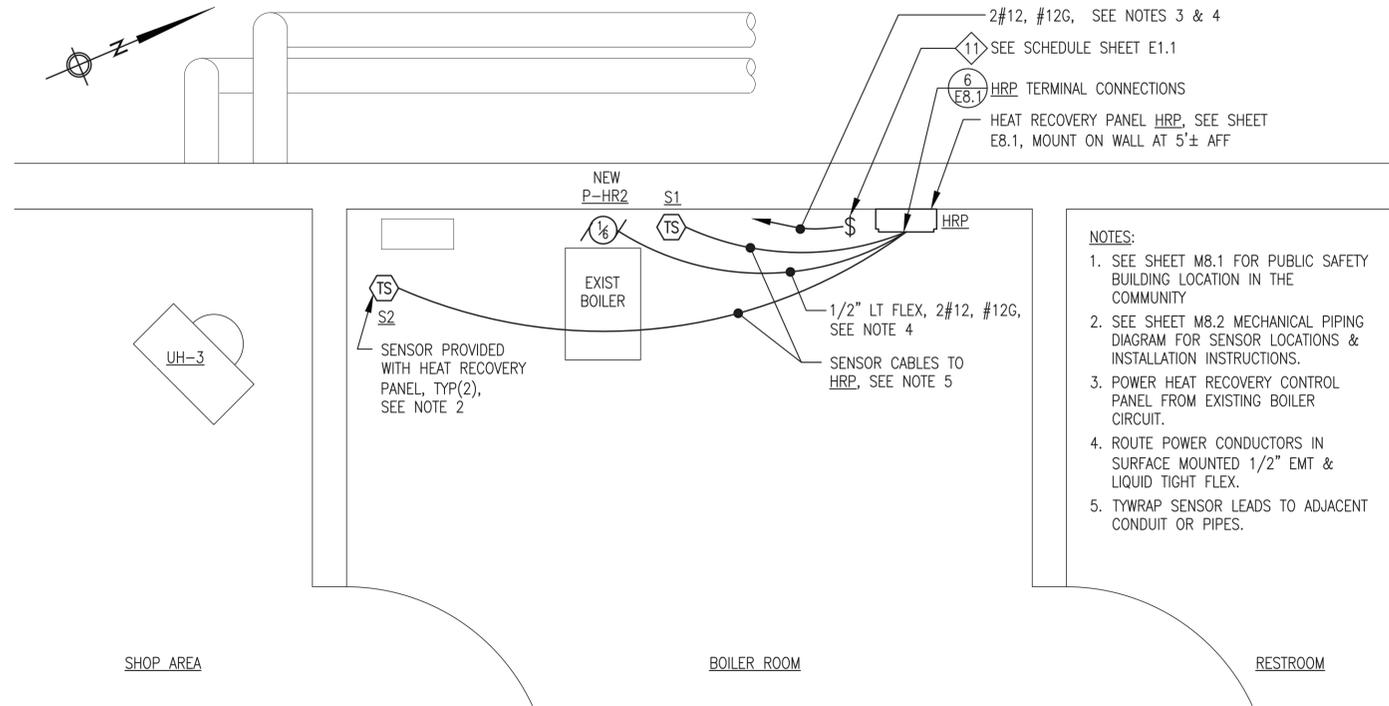

1 PUBLIC SAFETY BUILDING HEAT RECOVERY WIRING PLAN
 E8.2 3/4"=1'-0"


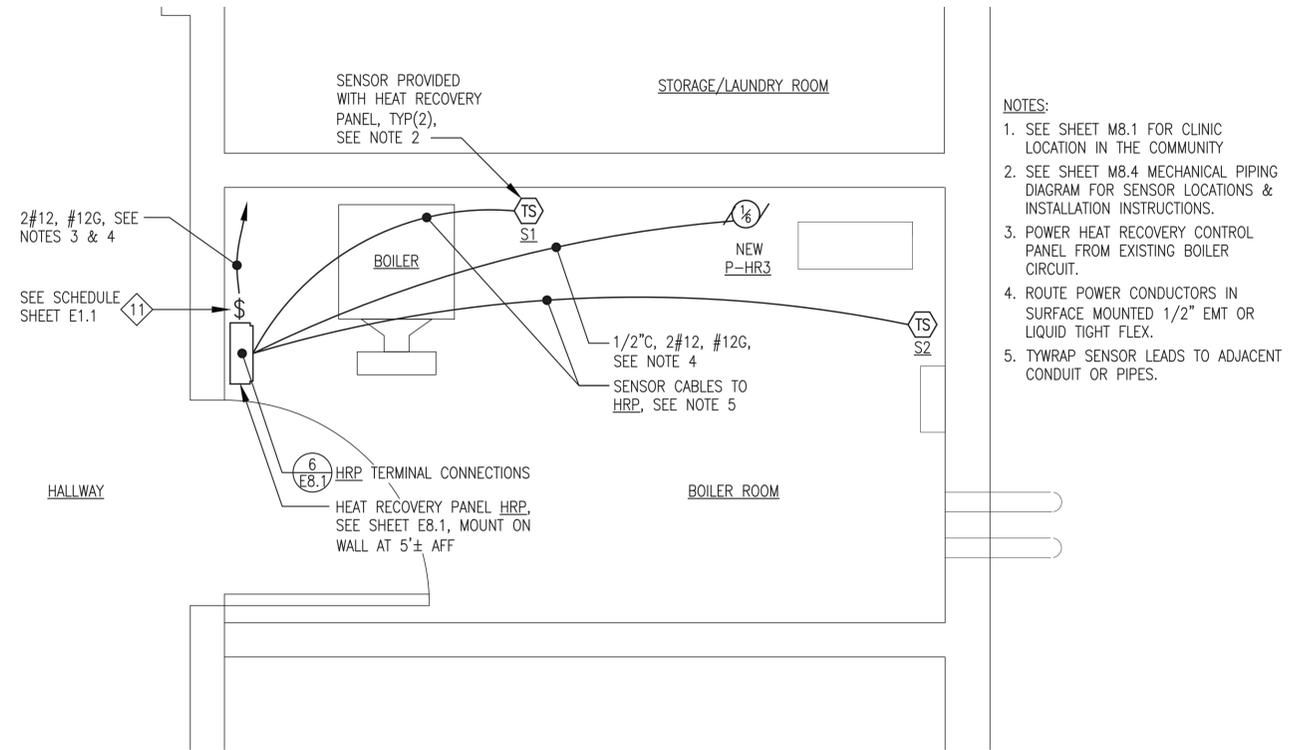


2 CLINIC HEAT RECOVERY WIRING PLAN
 E8.2 3/4"=1'-0"


1	UPDATED FOR 2025 AEA STANDARDS	8/15/25	BCG
REV.	DESCRIPTION	DATE	BY
 ALASKA ENERGY AUTHORITY			
PROJECT: MANOKOTAK POWER PLANT UPGRADE PROJECT			
TITLE: HEAT RECOVERY SYSTEM END USER BUILDING WIRING PLANS			
DRAWN BY: JTD		SCALE: AS NOTED	
DESIGNED BY: CWV/BCG		DATE: 9/28/23	
FILE NAME: MANO PP E8		SHEET: E8.2	
P.O. 111405, Anchorage, AK 99511 (907)349-0100			

REVISION #1
 ISSUED FOR
 CONSTRUCTION
 AUGUST 2025



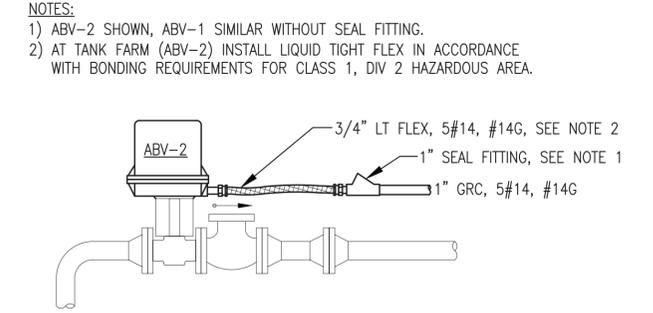
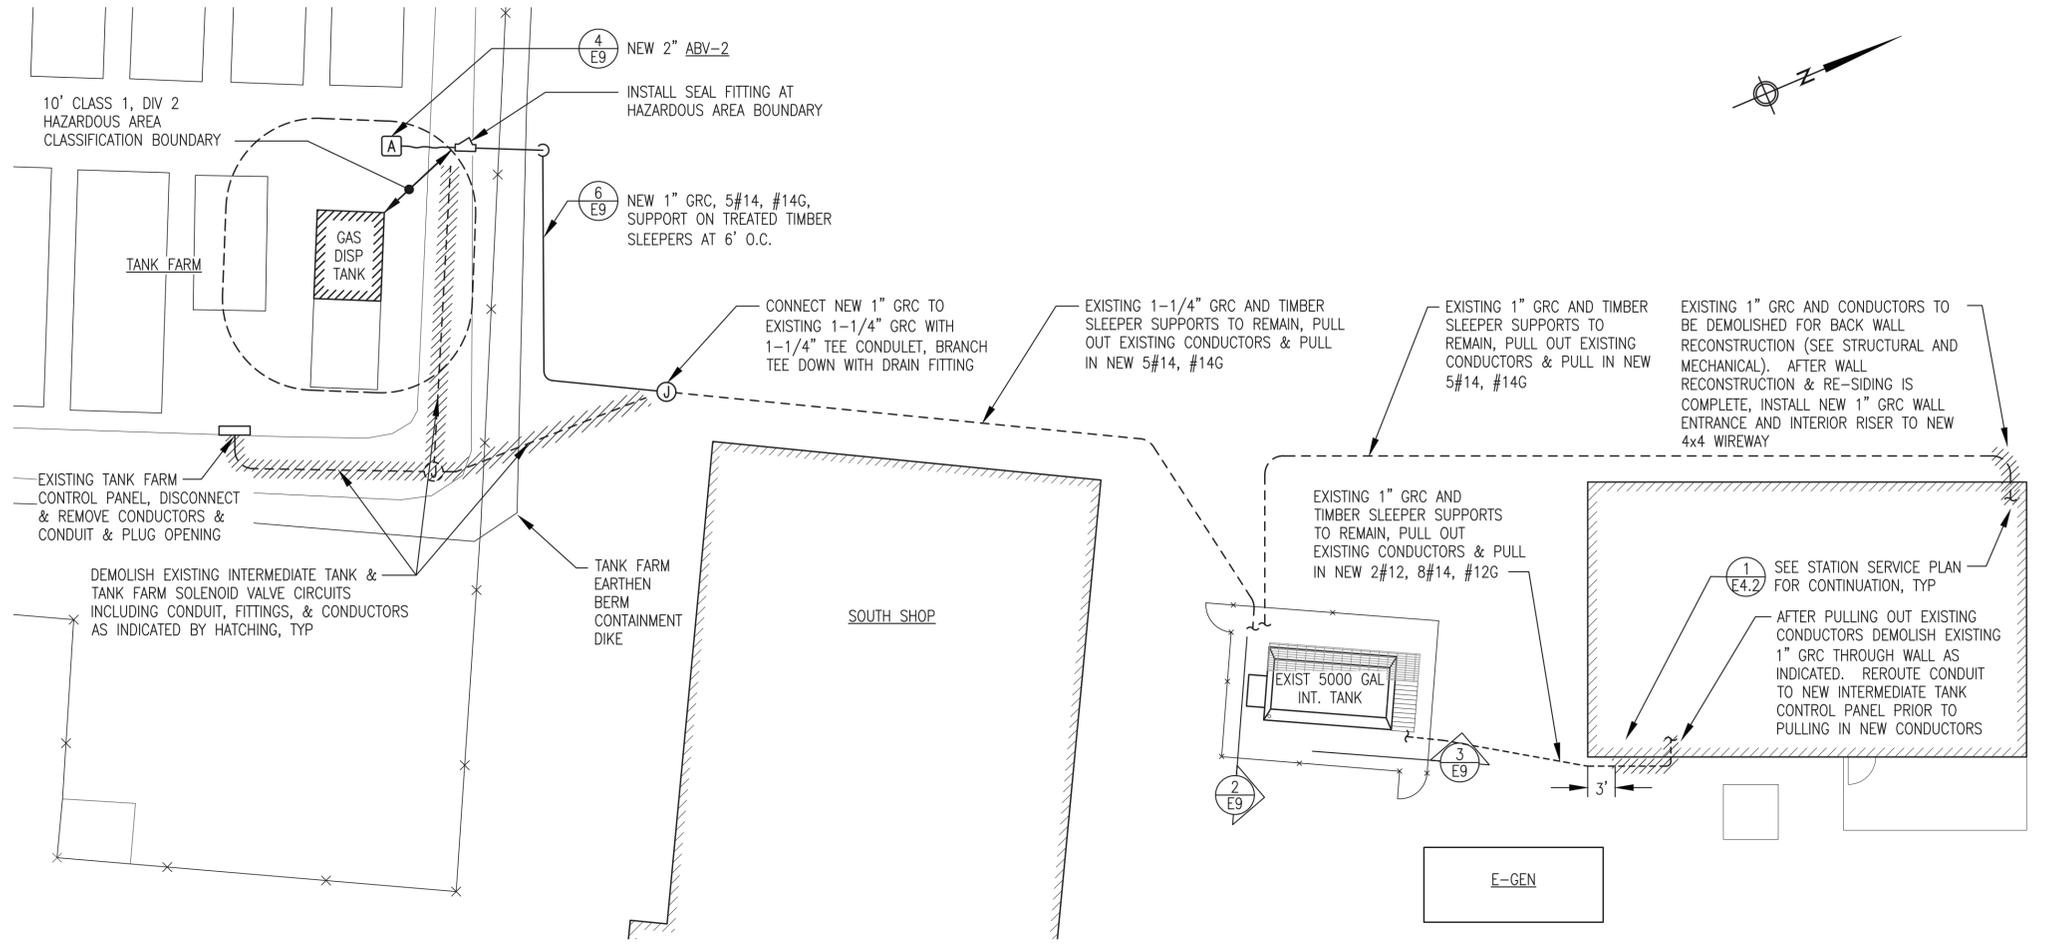


4 ACTUATOR VALVE CONNECTION
NO SCALE

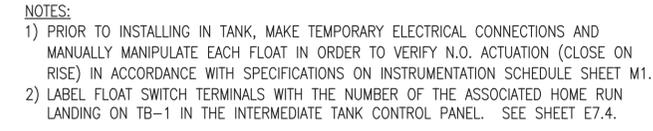

5 NEW INTERMEDIATE TANK FLOAT SWITCH INSTALLATION
NO SCALE

1 POWER PLANT AREA FUEL SYSTEM WIRING MODIFICATION PLAN
1"=10"

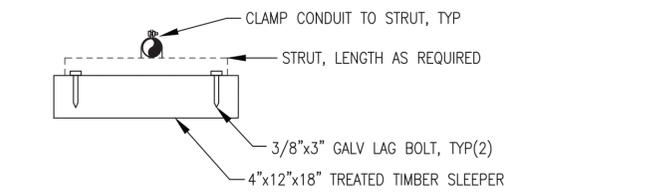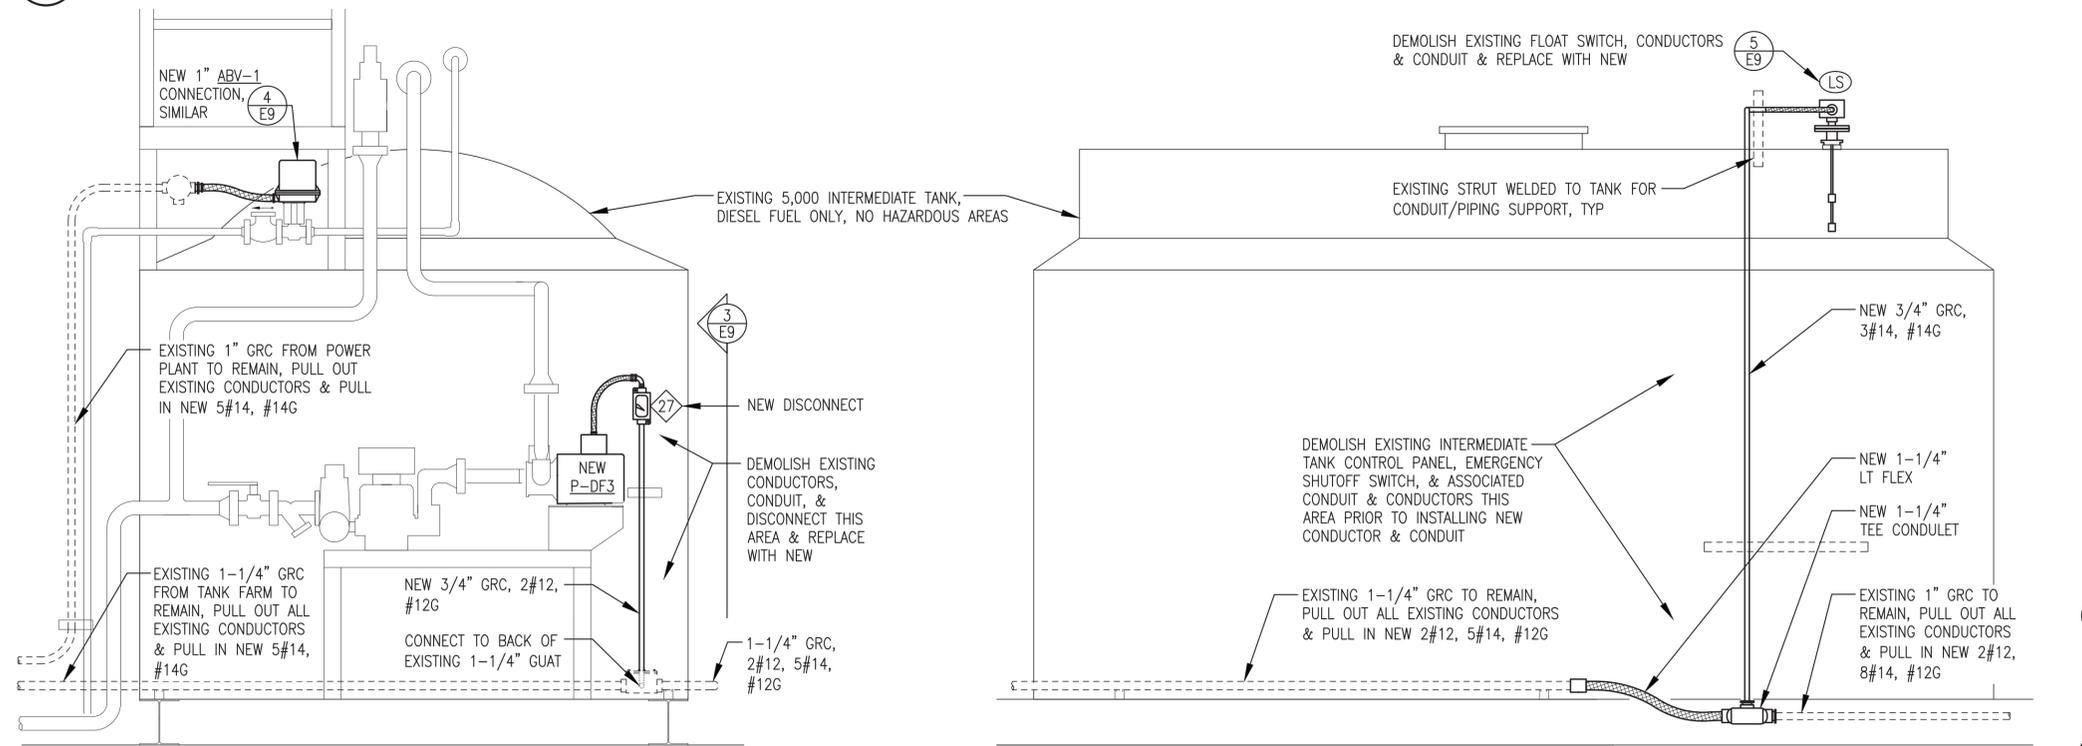

6 CONDUIT SLEEPER SUPPORT
NO SCALE

2 INTERMEDIATE TANK END ELEVATION
3/4"=1'-0"

3 INTERMEDIATE TANK SIDE ELEVATION
3/4"=1'-0"

REVISION #1
ISSUED FOR
CONSTRUCTION
AUGUST 2025



1	UPDATED FOR 2025 AEA STANDARDS	8/15/25	BCG
REV.	DESCRIPTION	DATE	BY
 ALASKA ENERGY AUTHORITY			
PROJECT: MANOKOTAK POWER PLANT UPGRADE PROJECT			
TITLE: POWER PLANT AREA FUEL SYSTEM WIRING MODIFICATION PLAN & DETAILS			
DRAWN BY: JTD		SCALE: AS NOTED	
DESIGNED BY: CWV/BCG		DATE: 9/28/23	
FILE NAME: MANO PP E9		SHEET: E9	
PROJECT NUMBER: MANO			





RURAL ENERGY GROUP
 813 W. NORTHERN LIGHTS BLVD.
 ANCHORAGE, ALASKA 99503
[HTTP://WWW.AIDEA.ORG](http://WWW.AIDEA.ORG)



ENGINEERED & MANUFACTURED BY
Controlled Power, Inc.
 BOTHELL, WASHINGTON USA
 (425)-485-1778 www.controlledpowerinc.com

**MANOKOTAK POWER SYSTEM UPGRADE
 PURCHASE ORDER NUMBER: PO010800
 CONTROLLED POWER, INC. JOB No. 9332SG**

<u>DRAWING No.</u>	<u>DRAWING TITLE</u>	<u>DRAWING No.</u>	<u>DRAWING TITLE</u>
9332SG-2101-D	COVER SHEET	9332SG-5314-D	FEEDER/VFD DC CONTROL, SCHEMATIC DIAGRAM
9332SG-3101-D	SCHEMATIC LEGEND & NOTES	9332SG-5315-D	FEEDER/VFD DC CONTROL, SCHEMATIC DIAGRAM
9332SG-4101-D	GENERATOR SWITCHGEAR ELEVATION VIEW, OUTLINE DIAGRAM	9332SG-5316-D	VFD DC CONTROL, SCHEMATIC DIAGRAM
9332SG-5101-D	GENERATOR SWITCHGEAR SINGLE LINE, SCHEMATIC DIAGRAM	9332SG-5317-D	R1 & R2 VFD DC CONTROL, SCHEMATIC DIAGRAM
9332SG-5201-D	GENERATOR 1 AC THREE LINE, SCHEMATIC DIAGRAM	9332SG-5318-D	CAC1 & CAC2 VFD DC CONTROL, SCHEMATIC DIAGRAM
9332SG-5202-D	GENERATOR 2 AC THREE LINE, SCHEMATIC DIAGRAM	9332SG-5319-D	CAC3 VFD DC CONTROL, SCHEMATIC DIAGRAM
9332SG-5203-D	GENERATOR 3 AC THREE LINE, SCHEMATIC DIAGRAM	9332SG-5401-D	GEN 1 & GEN 2 CIRCUIT BREAKER CONTROL, SCHEMATIC DIAGRAM
9332SG-5204-D	MASTER AC THREE LINE, SCHEMATIC DIAGRAM	9332SG-5402-D	GEN 3 & FEEDER CIRCUIT BREAKER CONTROL, SCHEMATIC DIAGRAM
9332SG-5205-D	VFD AC THREE LINE, SCHEMATIC DIAGRAM	9332SG-5501-D	POINT I/O COMMUNICATION NETWORK, SCHEMATIC DIAGRAM
9332SG-5301-D	GENERATOR 1 DC CONTROL, SCHEMATIC DIAGRAM	9332SG-5601-D	COMMUNICATION NETWORK, SCHEMATIC DIAGRAM
9332SG-5302-D	GENERATOR 1 DC CONTROL, SCHEMATIC DIAGRAM	9332SG-5602-D	COMMUNICATION NETWORK, SCHEMATIC DIAGRAM
9332SG-5303-D	GENERATOR 1 DC CONTROL, SCHEMATIC DIAGRAM	9332SG-5603-D	COMMUNICATION NETWORK, SCHEMATIC DIAGRAM
9332SG-5304-D	GENERATOR 2 DC CONTROL, SCHEMATIC DIAGRAM	9332SG-5701-D	AC CONTROL, SCHEMATIC DIAGRAM
9332SG-5305-D	GENERATOR 2 DC CONTROL, SCHEMATIC DIAGRAM	9332SG-5702-D	AC CONTROL, SCHEMATIC DIAGRAM
9332SG-5306-D	GENERATOR 2 DC CONTROL, SCHEMATIC DIAGRAM	9332SG-6101-D	CONTROL SWITCH TARGET DIAGRAM
9332SG-5307-D	GENERATOR 3 DC CONTROL, SCHEMATIC DIAGRAM	9332SG-6201-D	NAMEPLATE ENGRAVING SCHEDULE, FABRICATION DIAGRAM
9332SG-5308-D	GENERATOR 3 DC CONTROL, SCHEMATIC DIAGRAM	9332SG-6202-D	ANNUNCIATOR WINDOWS, FABRICATION DIAGRAM
9332SG-5309-D	GENERATOR 3 DC CONTROL, SCHEMATIC DIAGRAM	9332SG-7101-D	INTERCONNECTION DIAGRAM
9332SG-5310-D	MASTER DC CONTROL, SCHEMATIC DIAGRAM	9332SG-7102-D	INTERCONNECTION DIAGRAM
9332SG-5311-D	MASTER DC CONTROL, SCHEMATIC DIAGRAM	9332SG-7103-D	ETHERNET SHIPPING SPLIT, INTERCONNECTION DIAGRAM
9332SG-5312-D	MASTER DC CONTROL, SCHEMATIC DIAGRAM		
9332SG-5313-D	MASTER DC CONTROL, SCHEMATIC DIAGRAM		

WARNING

07-13-2022

**Arc Flash and Shock Hazard
Appropriate PPE Required**

Arc Flash Boundary 1.6 ft
Incident Energy (cal/cm²) 1.3
Working Distance 18.0 in

Arc-rated long-sleeve shirt and arc-rated pants or arc-rated overall and/or arc flash suit, Arc-rated face shield, Arc-rated jacket, Hard hat, Arc-rated hard hat liner, Safety glasses, Hearing protection, Leather gloves and Leather work shoes.

Shock Hazard Exposure: 480 V
Shock Hazard when covers removed

Limited Approach 3.5 ft Class 00
Restricted Approach 1.0 ft Insulating Gloves
V-rating 500 VAC

GENERATOR

GENERATOR ARC FLASH LABEL

WARNING

07-13-2022

**Arc Flash and Shock Hazard
Appropriate PPE Required**

Arc Flash Boundary 1.6 ft
Incident Energy (cal/cm²) 1.3
Working Distance 18.0 in




Arc-rated long-sleeve shirt and arc-rated pants or arc-rated overall and/or arc flash suit, Arc-rated face shield, Arc-rated jacket, Hard hat, Arc-rated hard hat liner, Safety glasses, Hearing protection, Leather gloves and Leather work shoes.

Shock Hazard Exposure: 480 V
Shock Hazard when covers removed

Limited Approach 3.5 ft Class 00
Restricted Approach 1.0 ft Insulating Gloves
V-rating 500 VAC

FEEDER

FEEDER ARC FLASH LABEL

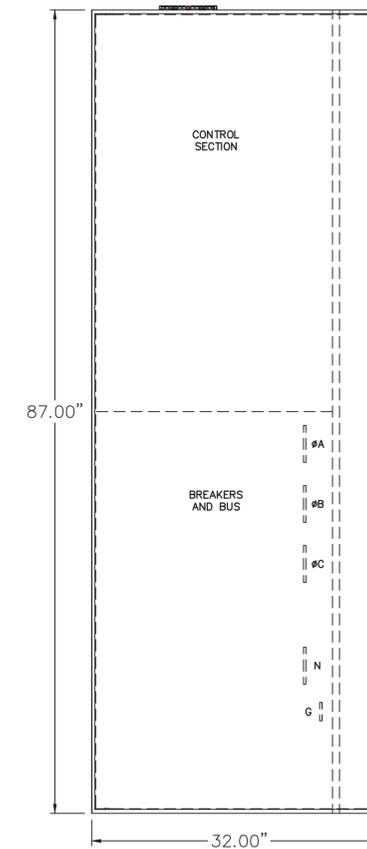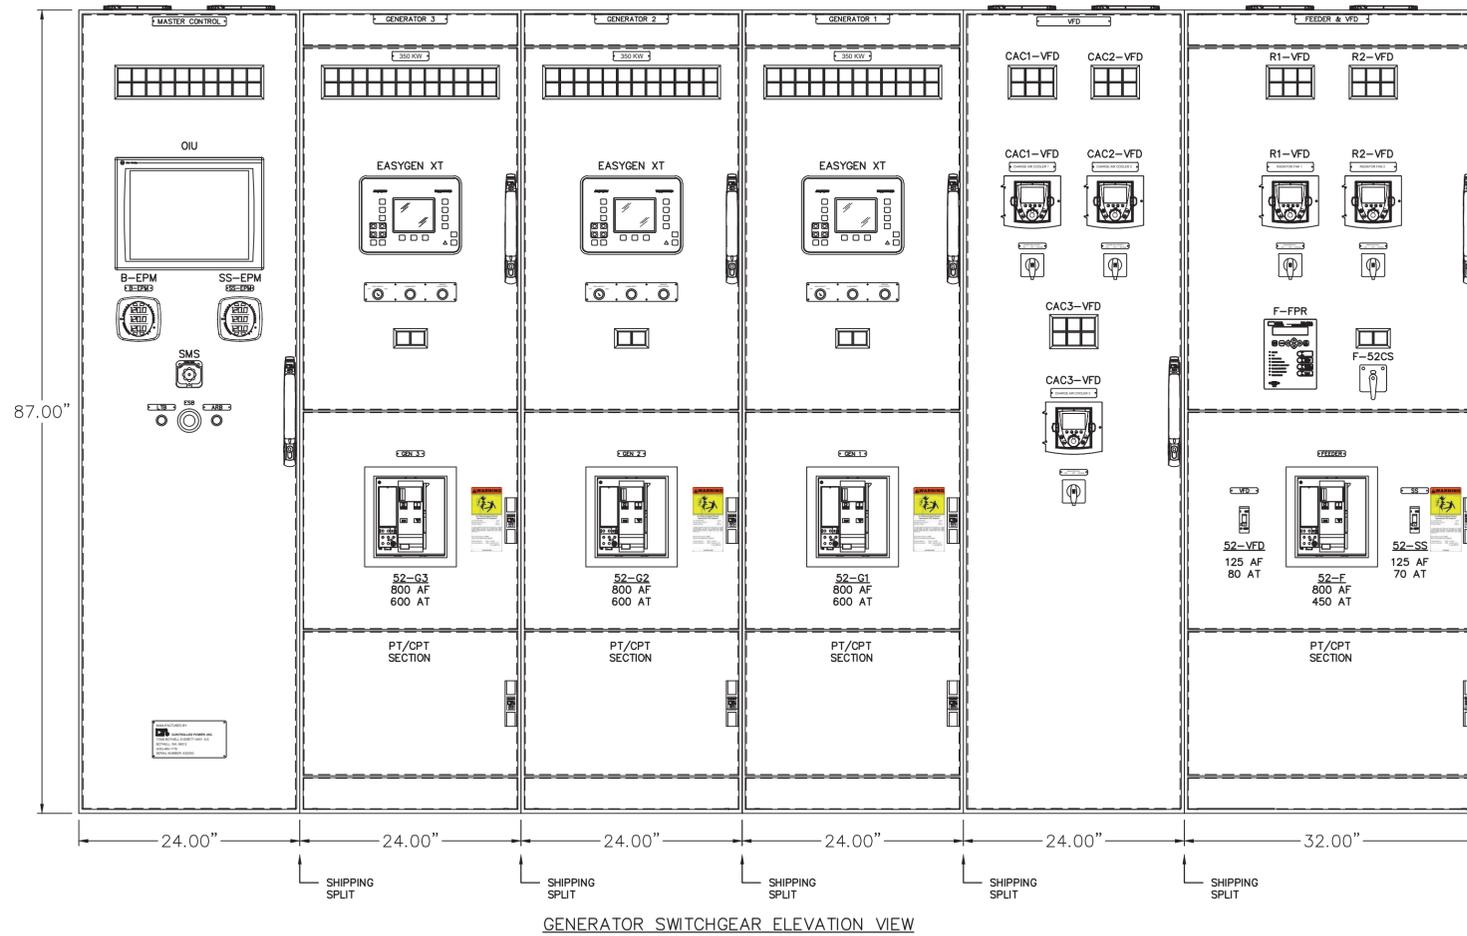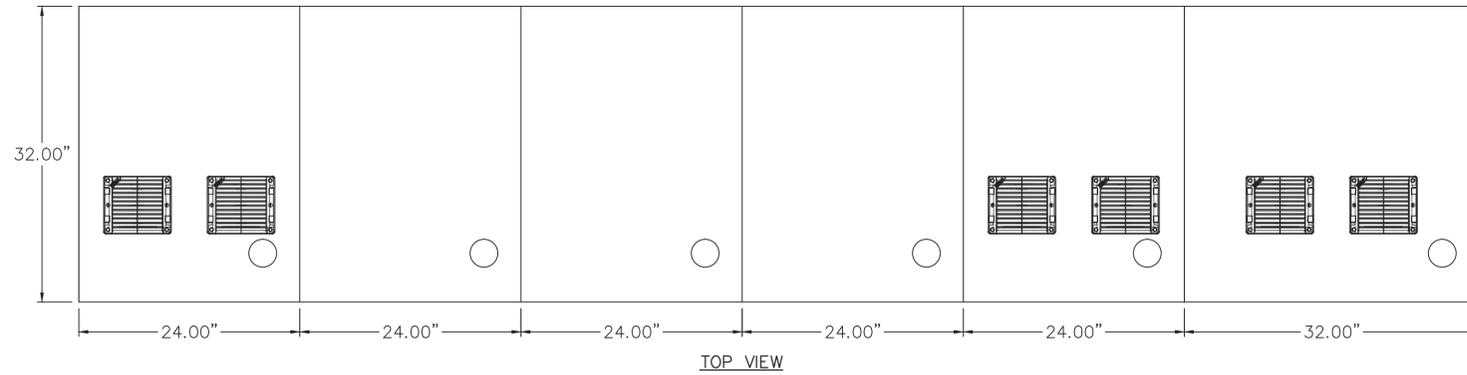


D	09-18-24	SHOP AS BUILT	GJG
REV.	DATE	DESCRIPTION	BY
AEA PURCHASE ORDER No. P0010800		CONTROLLED POWER JOB No. 9332SG	
TITLE: GENERATOR SWITCHGEAR ELEVATION VIEW, OUTLINE DIAGRAM			
SCALE: NONE	DATE: 11-29-23	DWN. BY: GPN	
DWG. No: 9332SG-4101-D	SHEET: 1 OF 1	CKD. BY: JMD	
JOB: MANOKOTAK POWER SYSTEM UPGRADE			

ALASKA ENERGY AUTHORITY

RURAL ENERGY GROUP
813 W. NORTHERN LIGHTS BLVD.
ANCHORAGE, ALASKA 99503
HTTP://WWW.AIDEA.ORG

ENGINEERED & MANUFACTURED BY
Controlled Power, Inc.
BOTHELL, WASHINGTON USA
(425)-485-1778 www.controlleddpowerinc.com

NOTICE
THE DRAWINGS, INFORMATION AND SUBJECT MATTER HEREOF ARE THE CONFIDENTIAL, SOLE AND EXCLUSIVE PROPERTY OF CONTROLLED POWER, INC., AND ARE NOT TO BE COPIED, REPRODUCED OR USED IN ANY MANNER FOR ANY PURPOSE WHATSOEVER WITHOUT WRITTEN CONSENT OR DIRECTION.

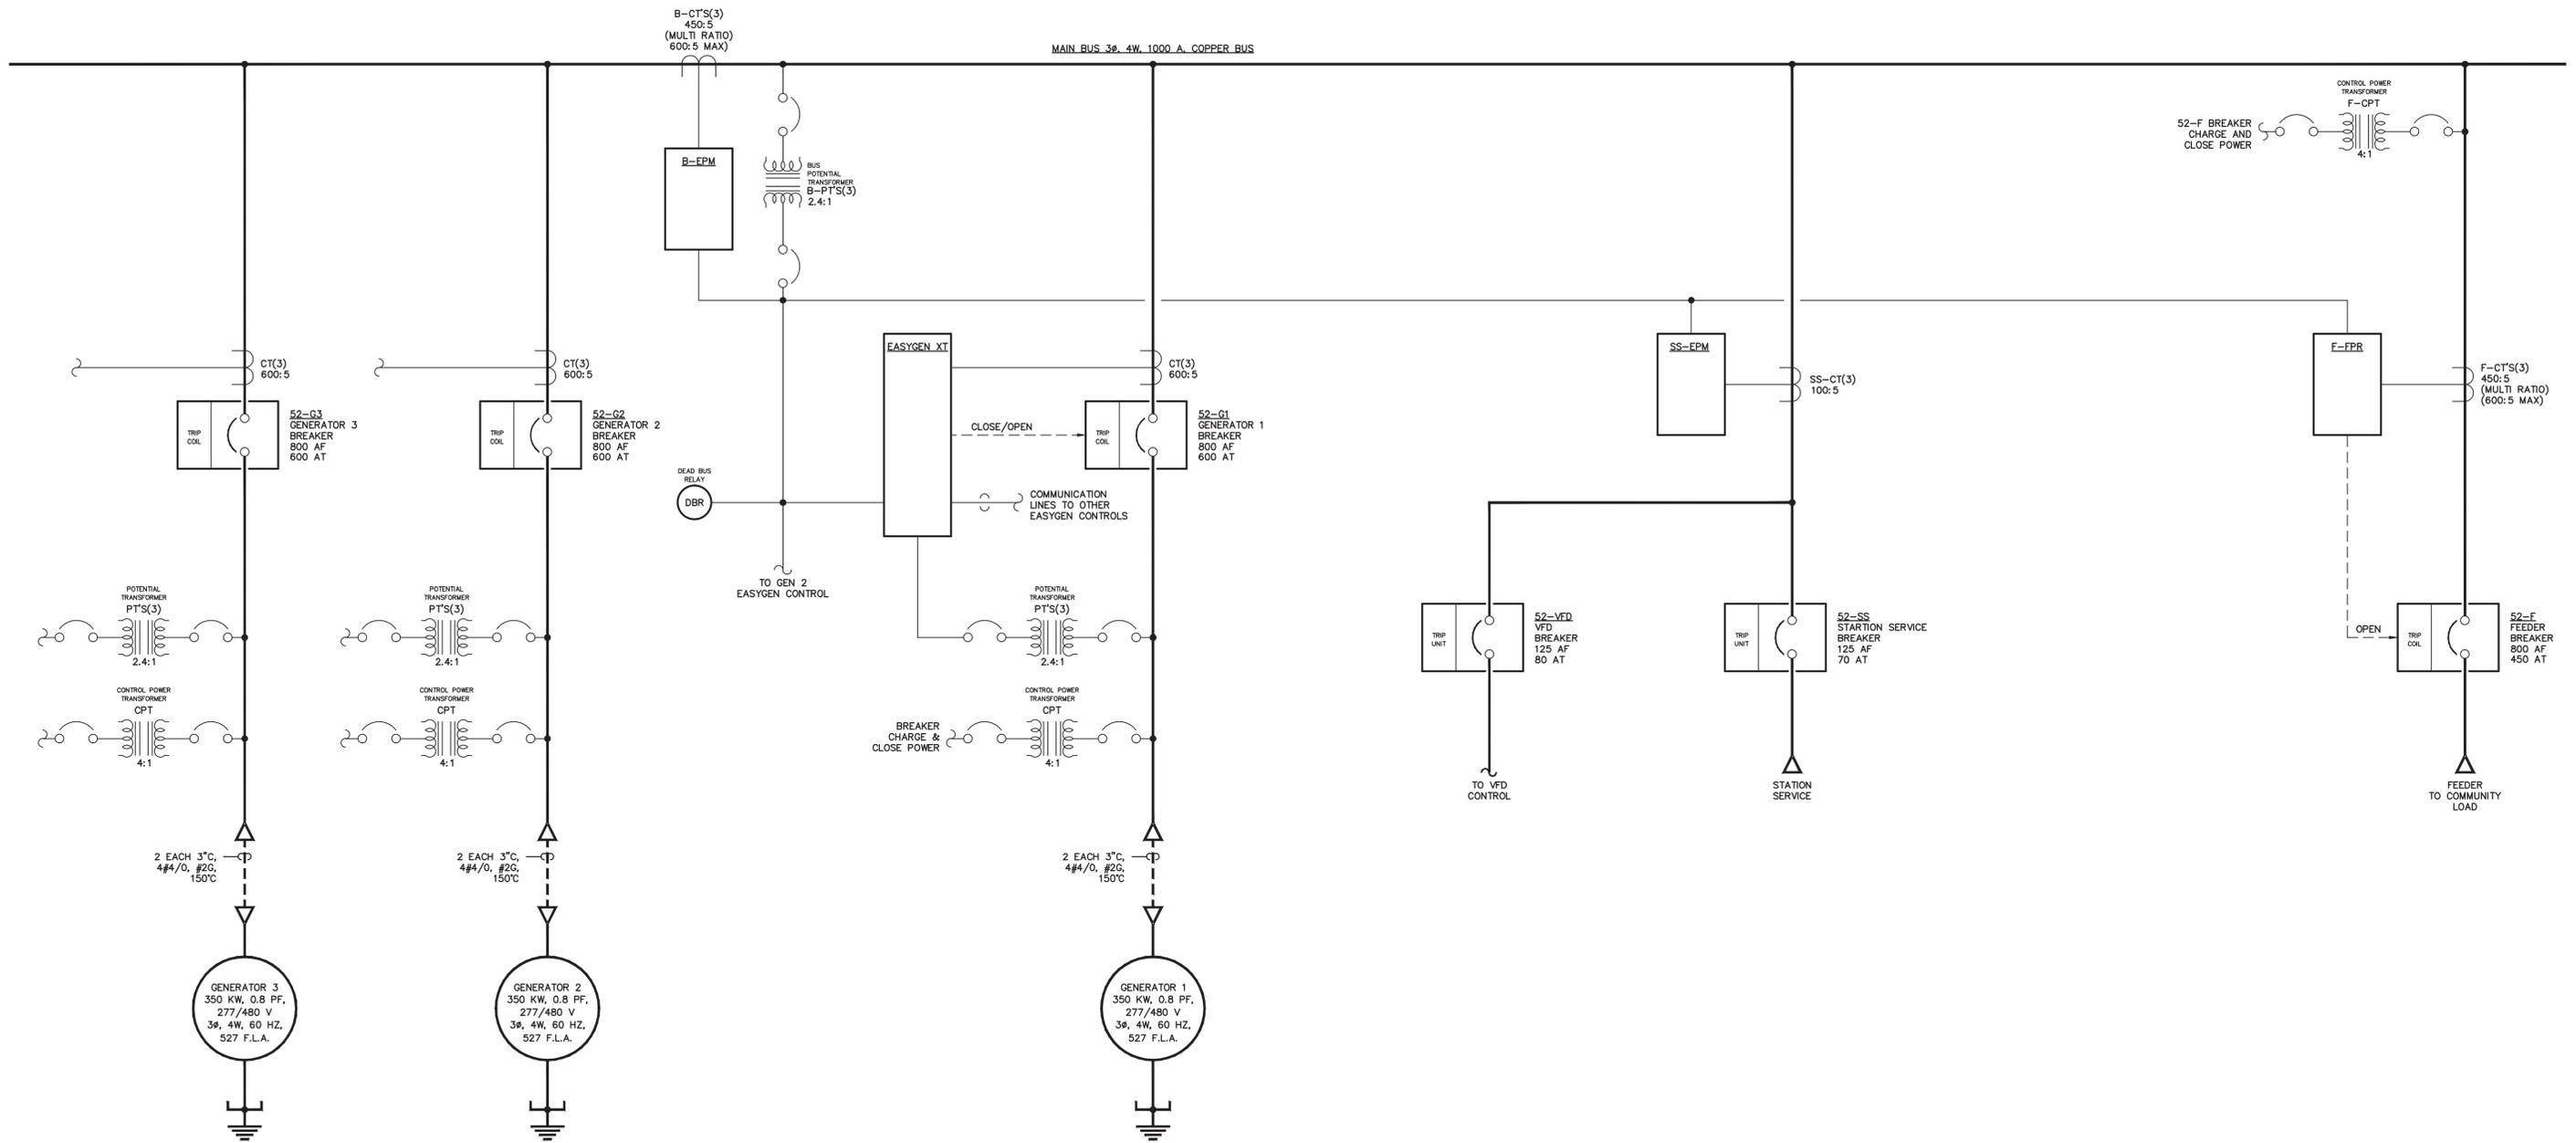

- NOTES:**
- GENERATORS 2 & 3 SIMILAR TO GENERATOR 1.

NOTE:

- FOR GENERAL WIRING & CONSTRUCTION NOTES, SEE DRAWING No. 9332SG-3101-D.

REV.	DATE	DESCRIPTION	BY
D	09-18-24	SHOP AS BUILT	GJG

AEA PURCHASE ORDER No. P0010800 CONTROLLED POWER JOB No. 9332SG

TITLE: GENERATOR SWITCHGEAR SINGLE LINE, SCHEMATIC DIAGRAM

SCALE: NONE DATE: 11-29-23 DWN. BY: GPN

DWG. No: 9332SG-5101-D SHEET: 1 OF 1 CKD. BY: JMD


JOB: MANOKOTAK POWER SYSTEM UPGRADE

ALASKA ENERGY AUTHORITY
 RURAL ENERGY GROUP
 813 W. NORTHERN LIGHTS BLVD.
 ANCHORAGE, ALASKA 99503
 HTTP://WWW.AIDEA.ORG

NOTICE
 THE DRAWINGS, INFORMATION AND SUBJECT MATTER HEREOF ARE THE CONFIDENTIAL, SOLE AND EXCLUSIVE PROPERTY OF CONTROLLED POWER, INC., AND ARE NOT TO BE COPIED, REPRODUCED OR USED IN ANY MANNER FOR ANY PURPOSE WHATSOEVER WITHOUT WRITTEN CONSENT OR DIRECTION.

Controlled Power, Inc.
 ENGINEERED & MANUFACTURED BY
 BOTHELL, WASHINGTON USA
 (425)-485-1778 www.controlledpowerinc.com

LINE No.
1
2
3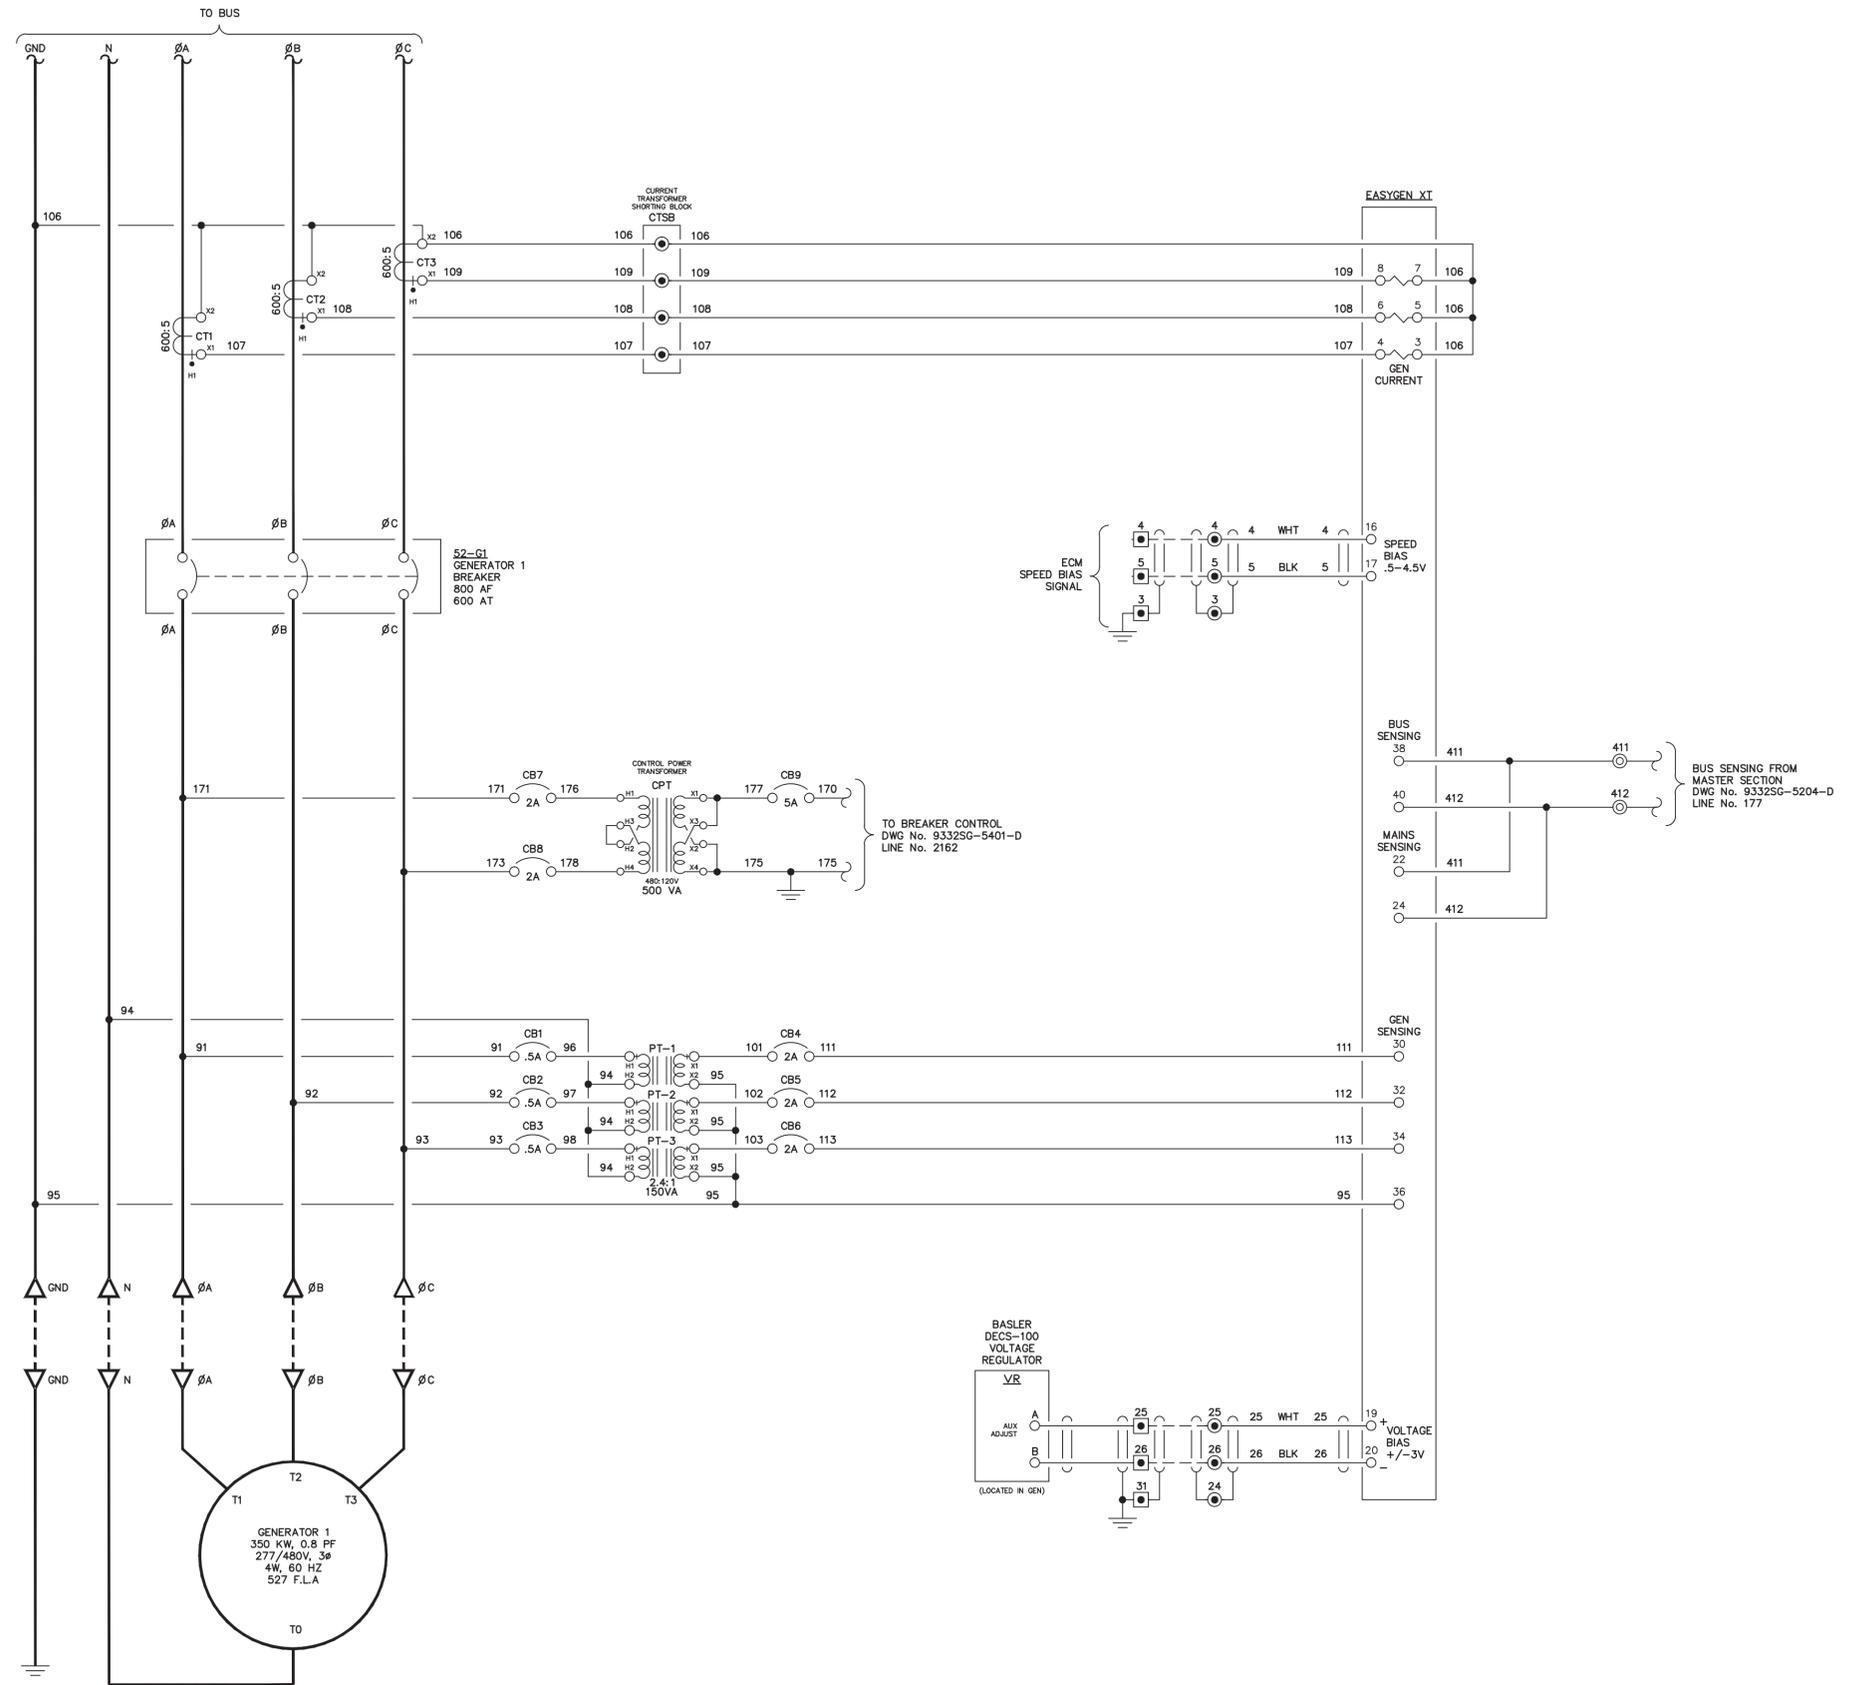
NOTE:
1. FOR GENERAL WIRING & CONSTRUCTION NOTES, SEE DRAWING No. 9332SG-3101-D.


D	09-18-24	SHOP AS BUILT	GJG
REV.	DATE	DESCRIPTION	BY
AEA PURCHASE ORDER No. P0010800		CONTROLLED POWER JOB No. 9332SG	
TITLE: GENERATOR 1 AC THREE LINE, SCHEMATIC DIAGRAM			
SCALE: NONE	DATE: 11-29-23	DWN. BY: GPN	
DWG. No: 9332SG-5201-D	SHEET: 1 OF 1	CKD. BY: JMD	
JOB: MANOKOTAK POWER SYSTEM UPGRADE			

ALASKA ENERGY AUTHORITY
RURAL ENERGY GROUP
813 W. NORTHERN LIGHTS BLVD.
ANCHORAGE, ALASKA 99503
HTTP://WWW.AIDEA.ORG

NOTICE
THE DRAWINGS, INFORMATION AND SUBJECT MATTER HEREOF ARE THE CONFIDENTIAL, SOLE AND EXCLUSIVE PROPERTY OF CONTROLLED POWER, INC., AND ARE NOT TO BE COPIED, REPRODUCED OR USED IN ANY MANNER FOR ANY PURPOSE WHATSOEVER WITHOUT WRITTEN CONSENT OR DIRECTION.

ENGINEERED & MANUFACTURED BY
Controlled Power, Inc.
BOTHELL, WASHINGTON USA
(425)-485-1778 www.controlledpowerinc.com

LINE No.
51
52
53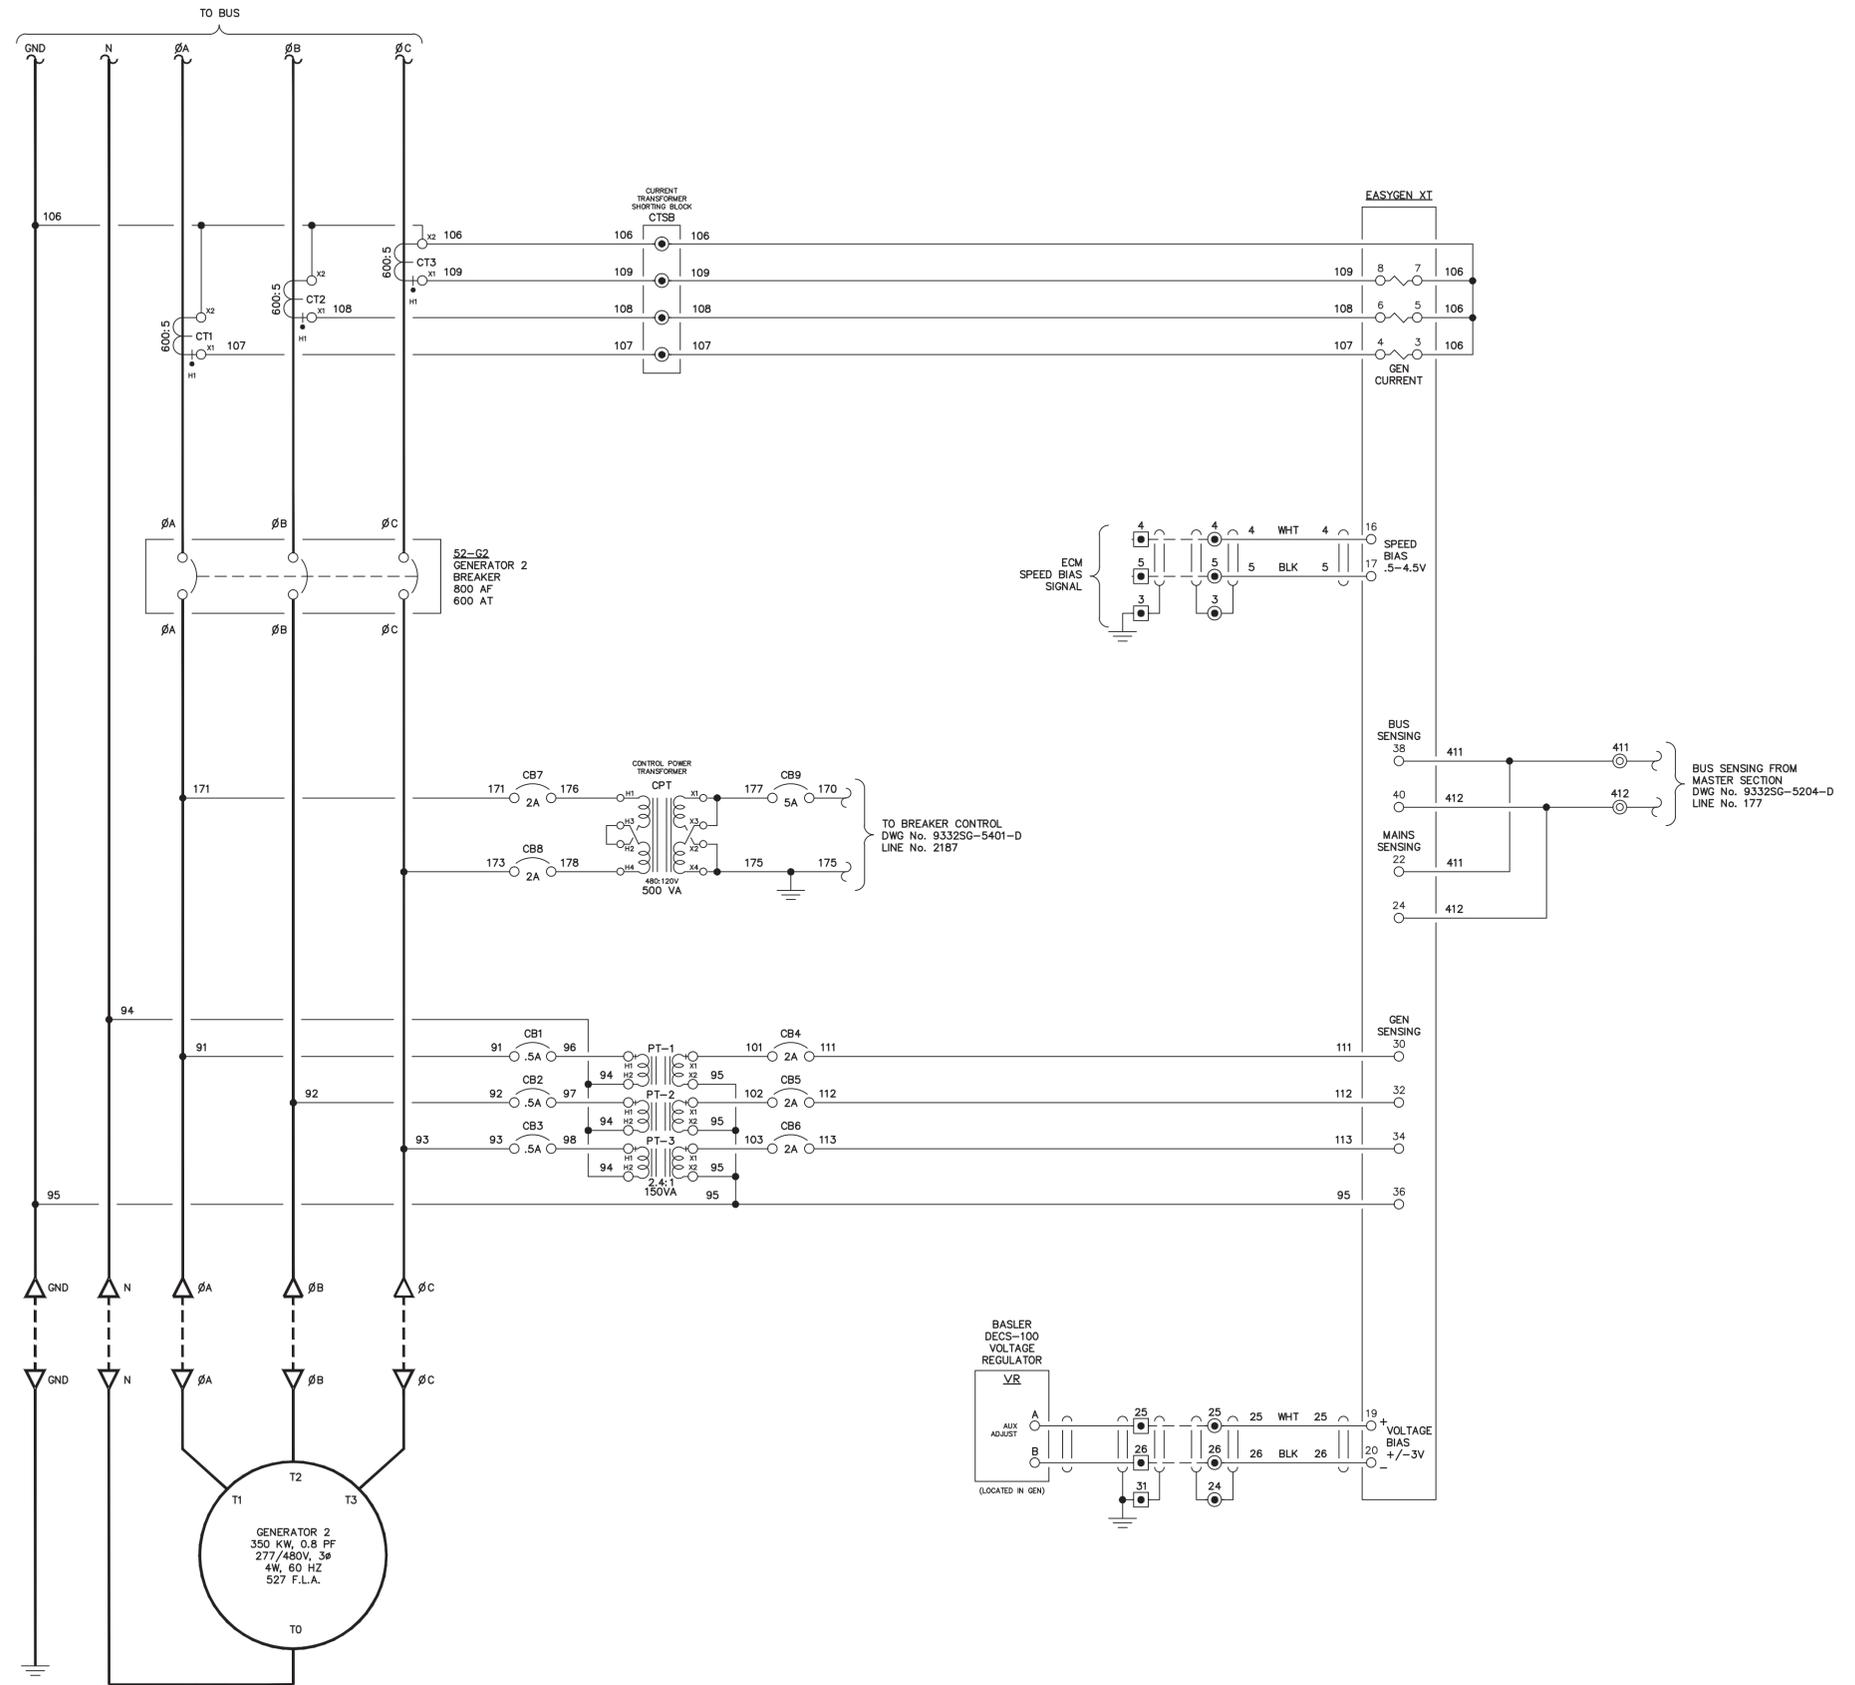
NOTE:
1. FOR GENERAL WIRING & CONSTRUCTION NOTES, SEE DRAWING No. 9332SG-3101-D.

D	09-18-24	SHOP AS BUILT	GJG
REV.	DATE	DESCRIPTION	BY
AEA PURCHASE ORDER No. P0010800		CONTROLLED POWER JOB No. 9332SG	
TITLE: GENERATOR 2 AC THREE LINE, SCHEMATIC DIAGRAM			
SCALE: NONE	DATE: 11-29-23	DWN. BY: GPN	
DWG. No: 9332SG-5202-D	SHEET: 1 OF 1	CKD. BY: JMD	
JOB: MANOKOTAK POWER SYSTEM UPGRADE			
ALASKA ENERGY AUTHORITY		RURAL ENERGY GROUP 813 W. NORTHERN LIGHTS BLVD. ANCHORAGE, ALASKA 99503 HTTP://WWW.AIDEA.ORG	

NOTICE
THE DRAWINGS, INFORMATION AND SUBJECT MATTER HEREOF ARE THE CONFIDENTIAL, SOLE AND EXCLUSIVE PROPERTY OF CONTROLLED POWER, INC., AND ARE NOT TO BE COPIED, REPRODUCED OR USED IN ANY MANNER FOR ANY PURPOSE WHATSOEVER WITHOUT WRITTEN CONSENT OR DIRECTION.

ENGINEERED & MANUFACTURED BY
Controlled Power, Inc.
BOTHELL, WASHINGTON USA
(425)-485-1778 www.controlledpowerinc.com

LINE No.
101
102
103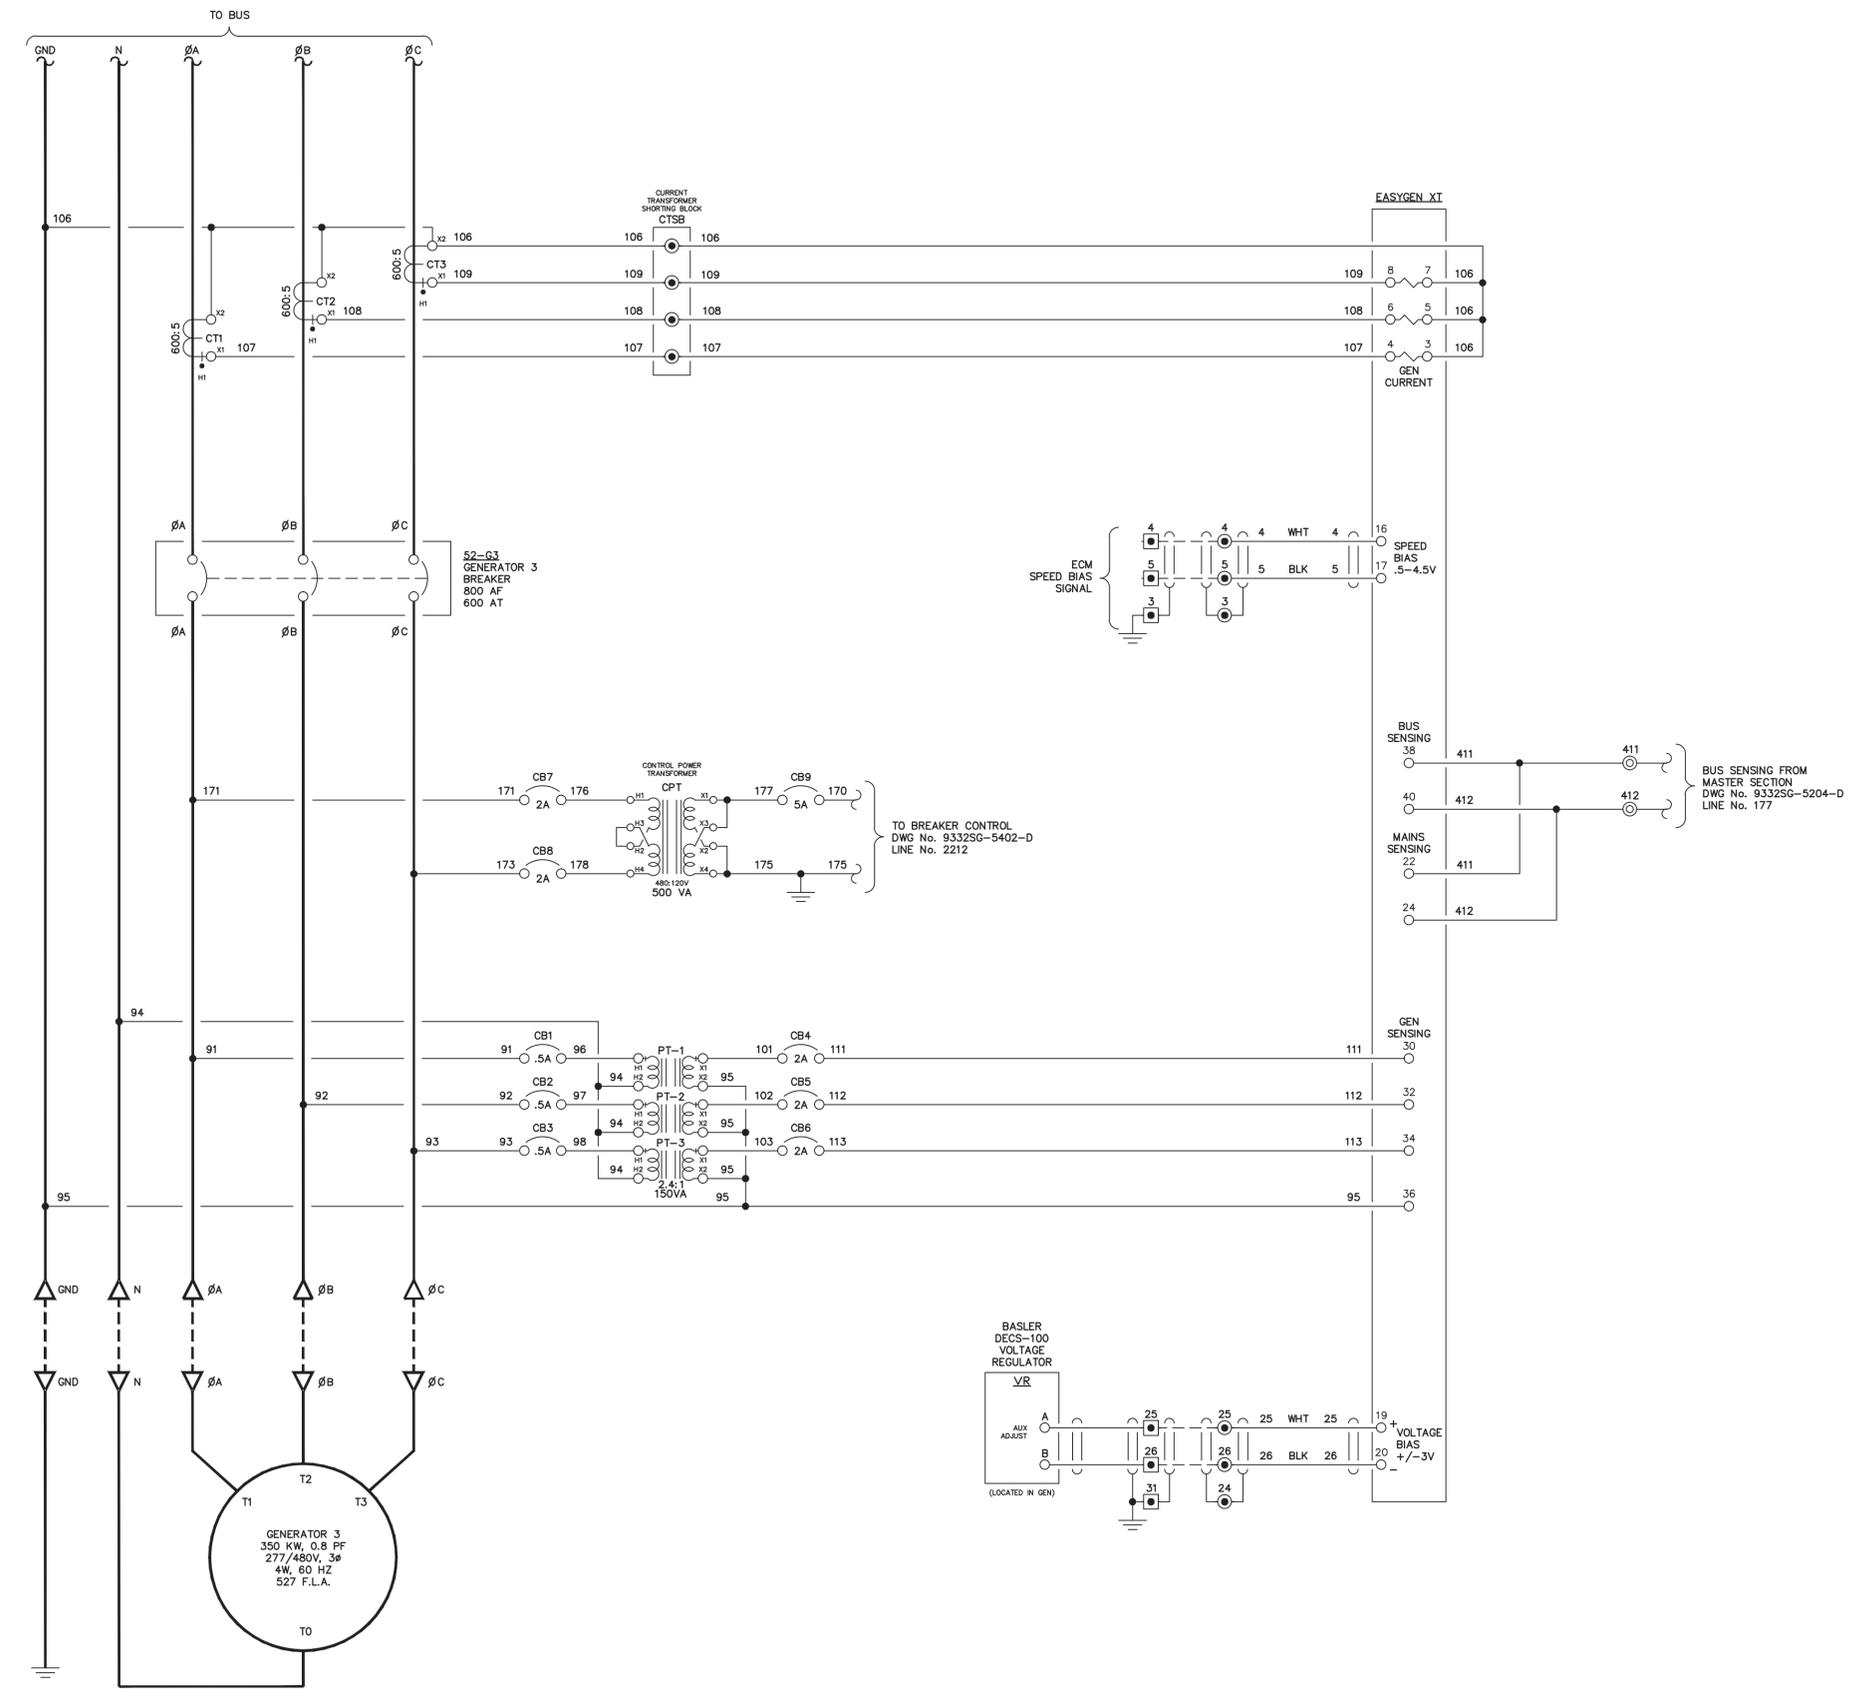
NOTE:
1. FOR GENERAL WIRING & CONSTRUCTION NOTES, SEE DRAWING No. 9332SG-3101-D.

D	09-18-24	SHOP AS BUILT	GJG
REV.	DATE	DESCRIPTION	BY
AEA PURCHASE ORDER No. P0010800		CONTROLLED POWER JOB No. 9332SG	
TITLE: GENERATOR 3 AC THREE LINE, SCHEMATIC DIAGRAM			
SCALE: NONE	DATE: 11-29-23	DWN. BY: GPN	
DWG. No: 9332SG-5203-D	SHEET: 1 OF 1	CKD. BY: JMD	
JOB: MANOKOTAK POWER SYSTEM UPGRADE			

ALASKA ENERGY AUTHORITY
RURAL ENERGY GROUP
813 W. NORTHERN LIGHTS BLVD.
ANCHORAGE, ALASKA 99503
HTTP://WWW.AIDEA.ORG

NOTICE
THE DRAWINGS, INFORMATION AND SUBJECT MATTER HEREOF ARE THE CONFIDENTIAL, SOLE AND EXCLUSIVE PROPERTY OF CONTROLLED POWER, INC., AND ARE NOT TO BE COPIED, REPRODUCED OR USED IN ANY MANNER FOR ANY PURPOSE WHATSOEVER WITHOUT WRITTEN CONSENT OR DIRECTION.

ENGINEERED & MANUFACTURED BY
Controlled Power, Inc.
BOTHELL, WASHINGTON USA
(425)-485-1778 www.controlledpowerinc.com

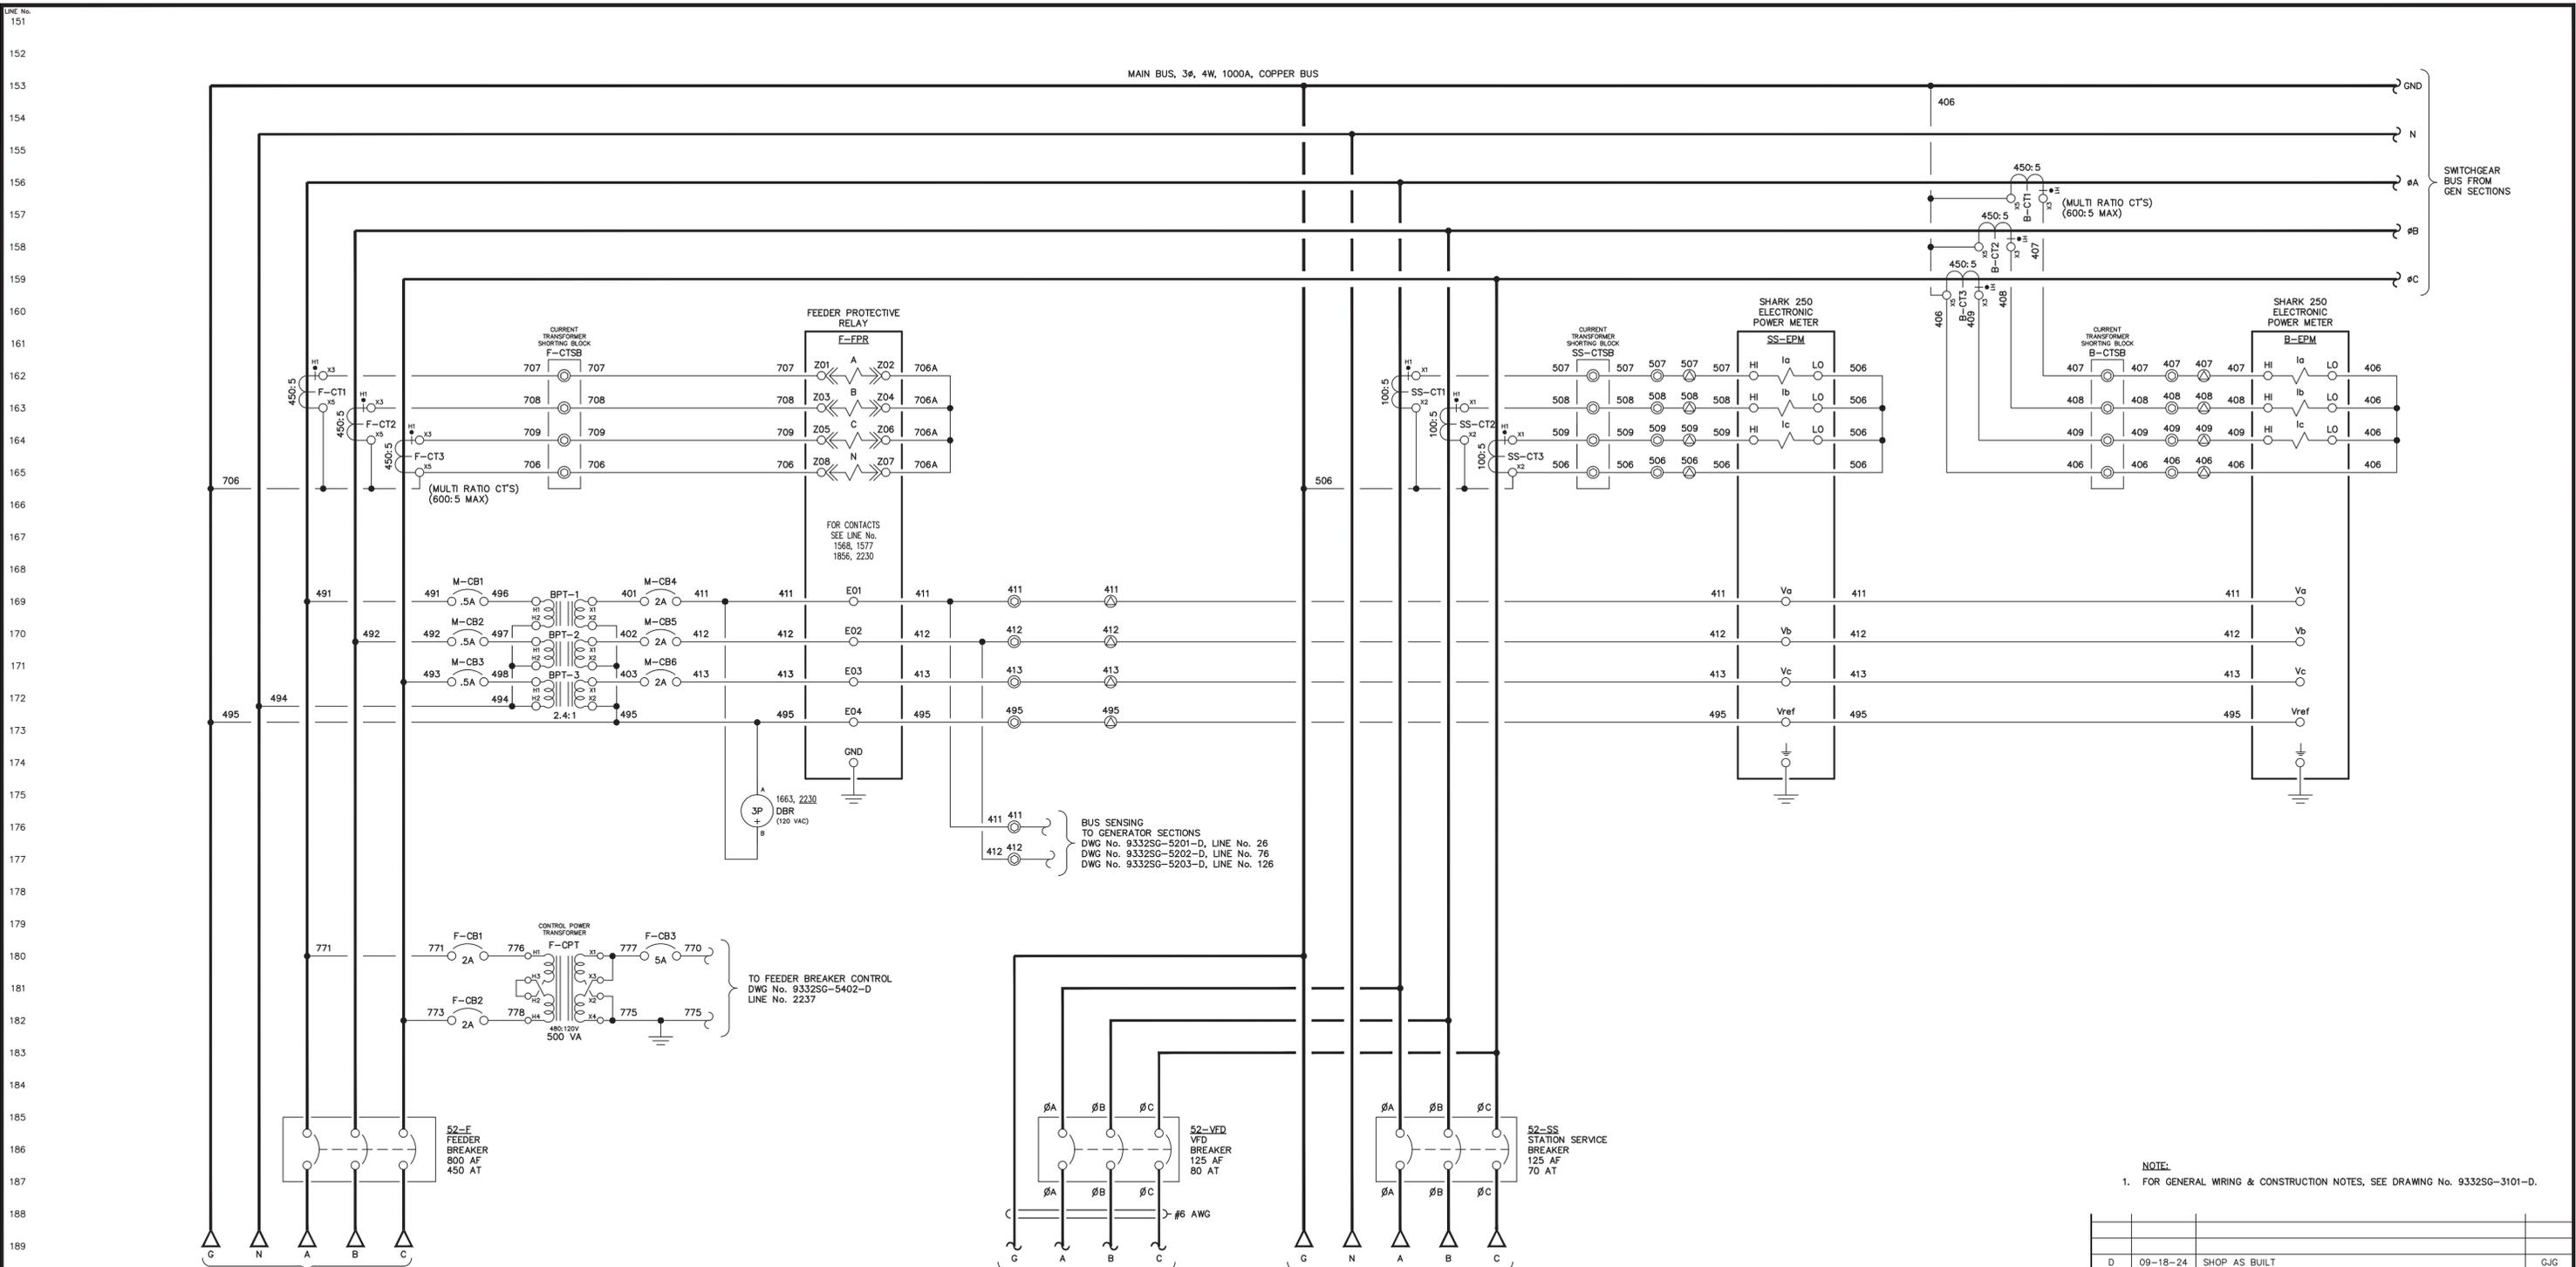

NOTE:
1. FOR GENERAL WIRING & CONSTRUCTION NOTES, SEE DRAWING No. 9332SG-3101-D.


D	09-18-24	SHOP AS BUILT	GJG
REV.	DATE	DESCRIPTION	BY
AEA PURCHASE ORDER No. P0010800		CONTROLLED POWER JOB No. 9332SG	
TITLE: MASTER AC THREE LINE, SCHEMATIC DIAGRAM			
SCALE: NONE	DATE: 11-29-23	DWN. BY: GPN	
DWG. No: 9332SG-5204-D	SHEET: 1 OF 1	CKD. BY: JMD	
JOB: MANOKOTAK POWER SYSTEM UPGRADE			

ALASKA ENERGY AUTHORITY
RURAL ENERGY GROUP
813 W. NORTHERN LIGHTS BLVD.
ANCHORAGE, ALASKA 99503
HTTP://WWW.AIDEA.ORG

ENGINEERED & MANUFACTURED BY
Controlled Power, Inc.
BOTHELL, WASHINGTON USA
(425)-485-1778 www.controlleddpowerinc.com

NOTICE
THE DRAWINGS, INFORMATION AND SUBJECT MATTER HEREOF ARE THE CONFIDENTIAL, SOLE AND EXCLUSIVE PROPERTY OF CONTROLLED POWER, INC., AND ARE NOT TO BE COPIED, REPRODUCED OR USED IN ANY MANNER FOR ANY PURPOSE WHATSOEVER WITHOUT WRITTEN CONSENT OR DIRECTION.

LINE No.
151
152
153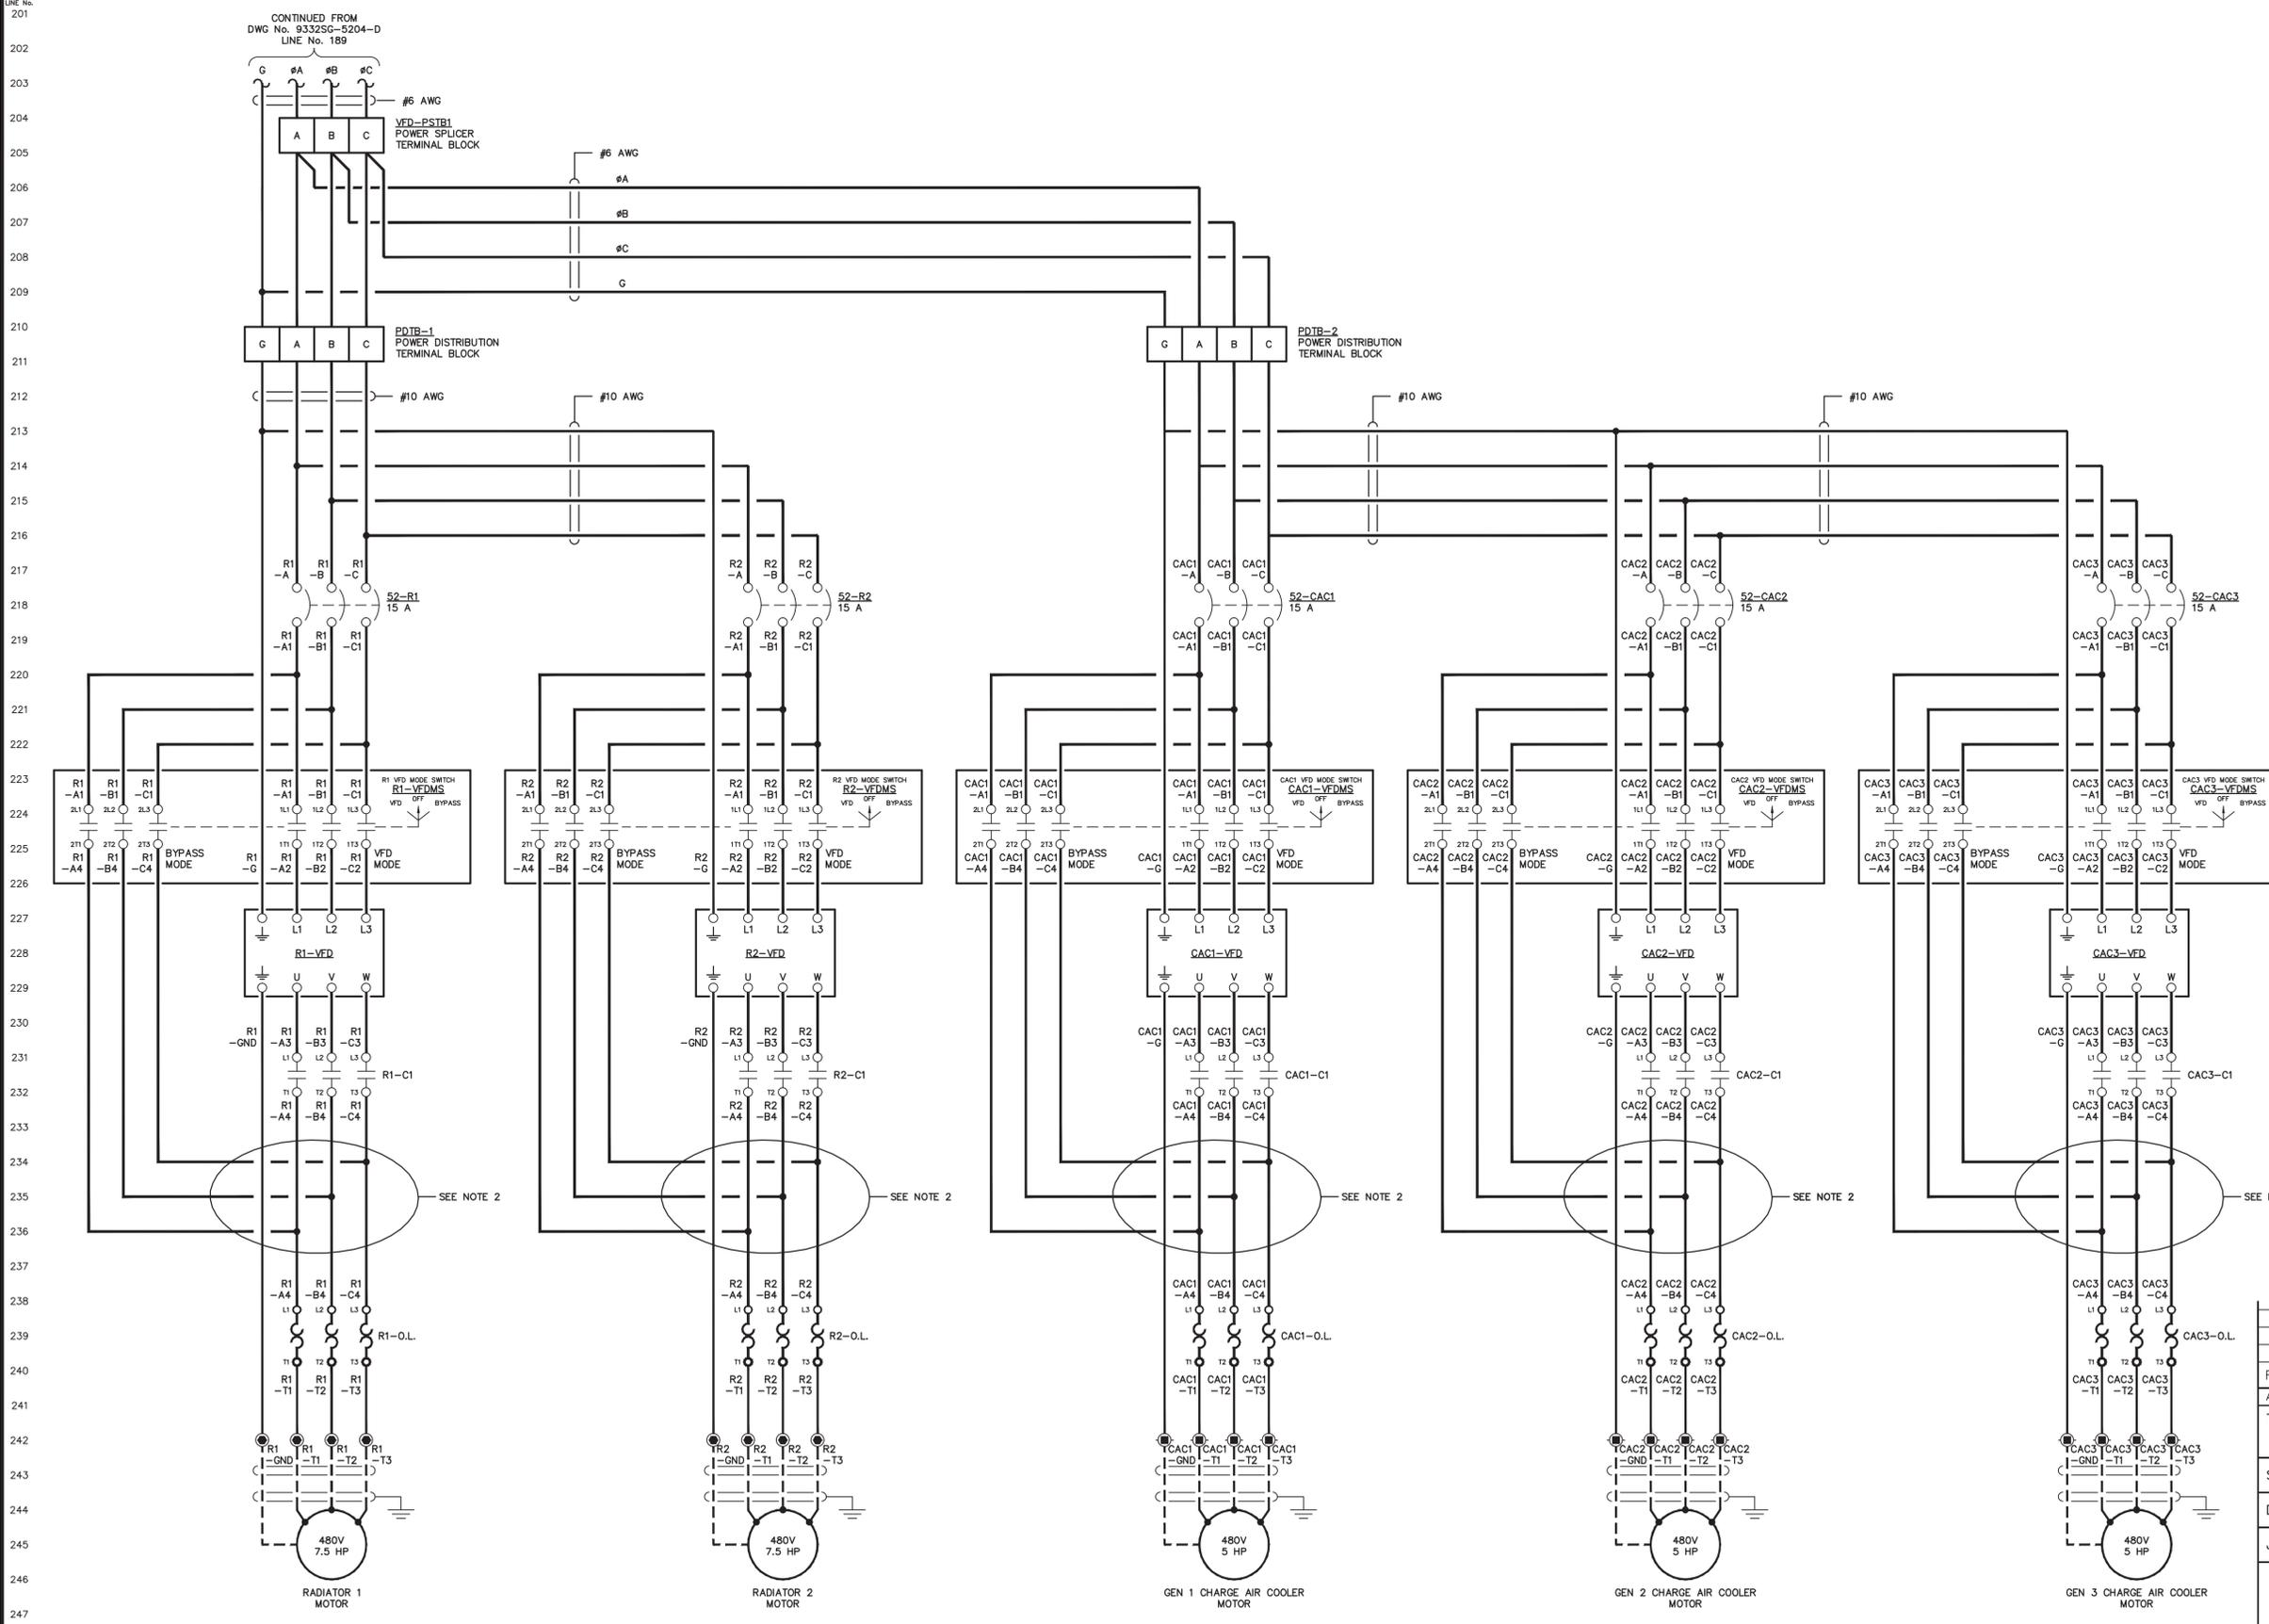
- NOTE:
- FOR GENERAL WIRING & CONSTRUCTION NOTES, SEE DRAWING No. 93325G-3101-D.
 - VFD LOAD WIRES SHALL BE ROUTED SEPARATE FROM ALL OTHER WIRING OR SHIELDED TO AVOID RF INTERFERENCE.

D	09-18-24	SHOP AS BUILT	GJG
REV.	DATE	DESCRIPTION	BY
AEA PURCHASE ORDER No. P0010800		CONTROLLED POWER JOB No. 93325G	
TITLE: VFD AC THREE LINE, SCHEMATIC DIAGRAM			
SCALE: NONE	DATE: 11-29-23	DWN. BY: GPN	
DWG. No: 93325G-5205-D	SHEET: 1 OF 1	CKD. BY: JMD	
JOB: MANOKOTAK POWER SYSTEM UPGRADE			

ALASKA ENERGY AUTHORITY
 RURAL ENERGY GROUP
 813 W. NORTHERN LIGHTS BLVD.
 ANCHORAGE, ALASKA 99503
[HTTP://WWW.AIEA.ORG](http://www.aiea.org)

ENGINEERED & MANUFACTURED BY
Controlled Power, Inc.
 BOTHELL, WASHINGTON USA
 (425)-485-1778 www.controlleddpowerinc.com

NOTICE
 THE DRAWINGS, INFORMATION AND SUBJECT MATTER HEREOF ARE THE CONFIDENTIAL, SOLE AND EXCLUSIVE PROPERTY OF CONTROLLED POWER, INC., AND ARE NOT TO BE COPIED, REPRODUCED OR USED IN ANY MANNER FOR ANY PURPOSE WHATSOEVER WITHOUT WRITTEN CONSENT OR DIRECTION.

LINE No. 201
202
203
204
CONTINUED FROM
 DWG No. 93325G-5204-D
 LINE No. 189

PDTB-1
 POWER DISTRIBUTION
 TERMINAL BLOCK

PDTB-2
 POWER DISTRIBUTION
 TERMINAL BLOCK



RADIATOR 1
 MOTOR

RADIATOR 2
 MOTOR

GEN 1 CHARGE AIR COOLER
 MOTOR

GEN 2 CHARGE AIR COOLER
 MOTOR

GEN 3 CHARGE AIR COOLER
 MOTOR

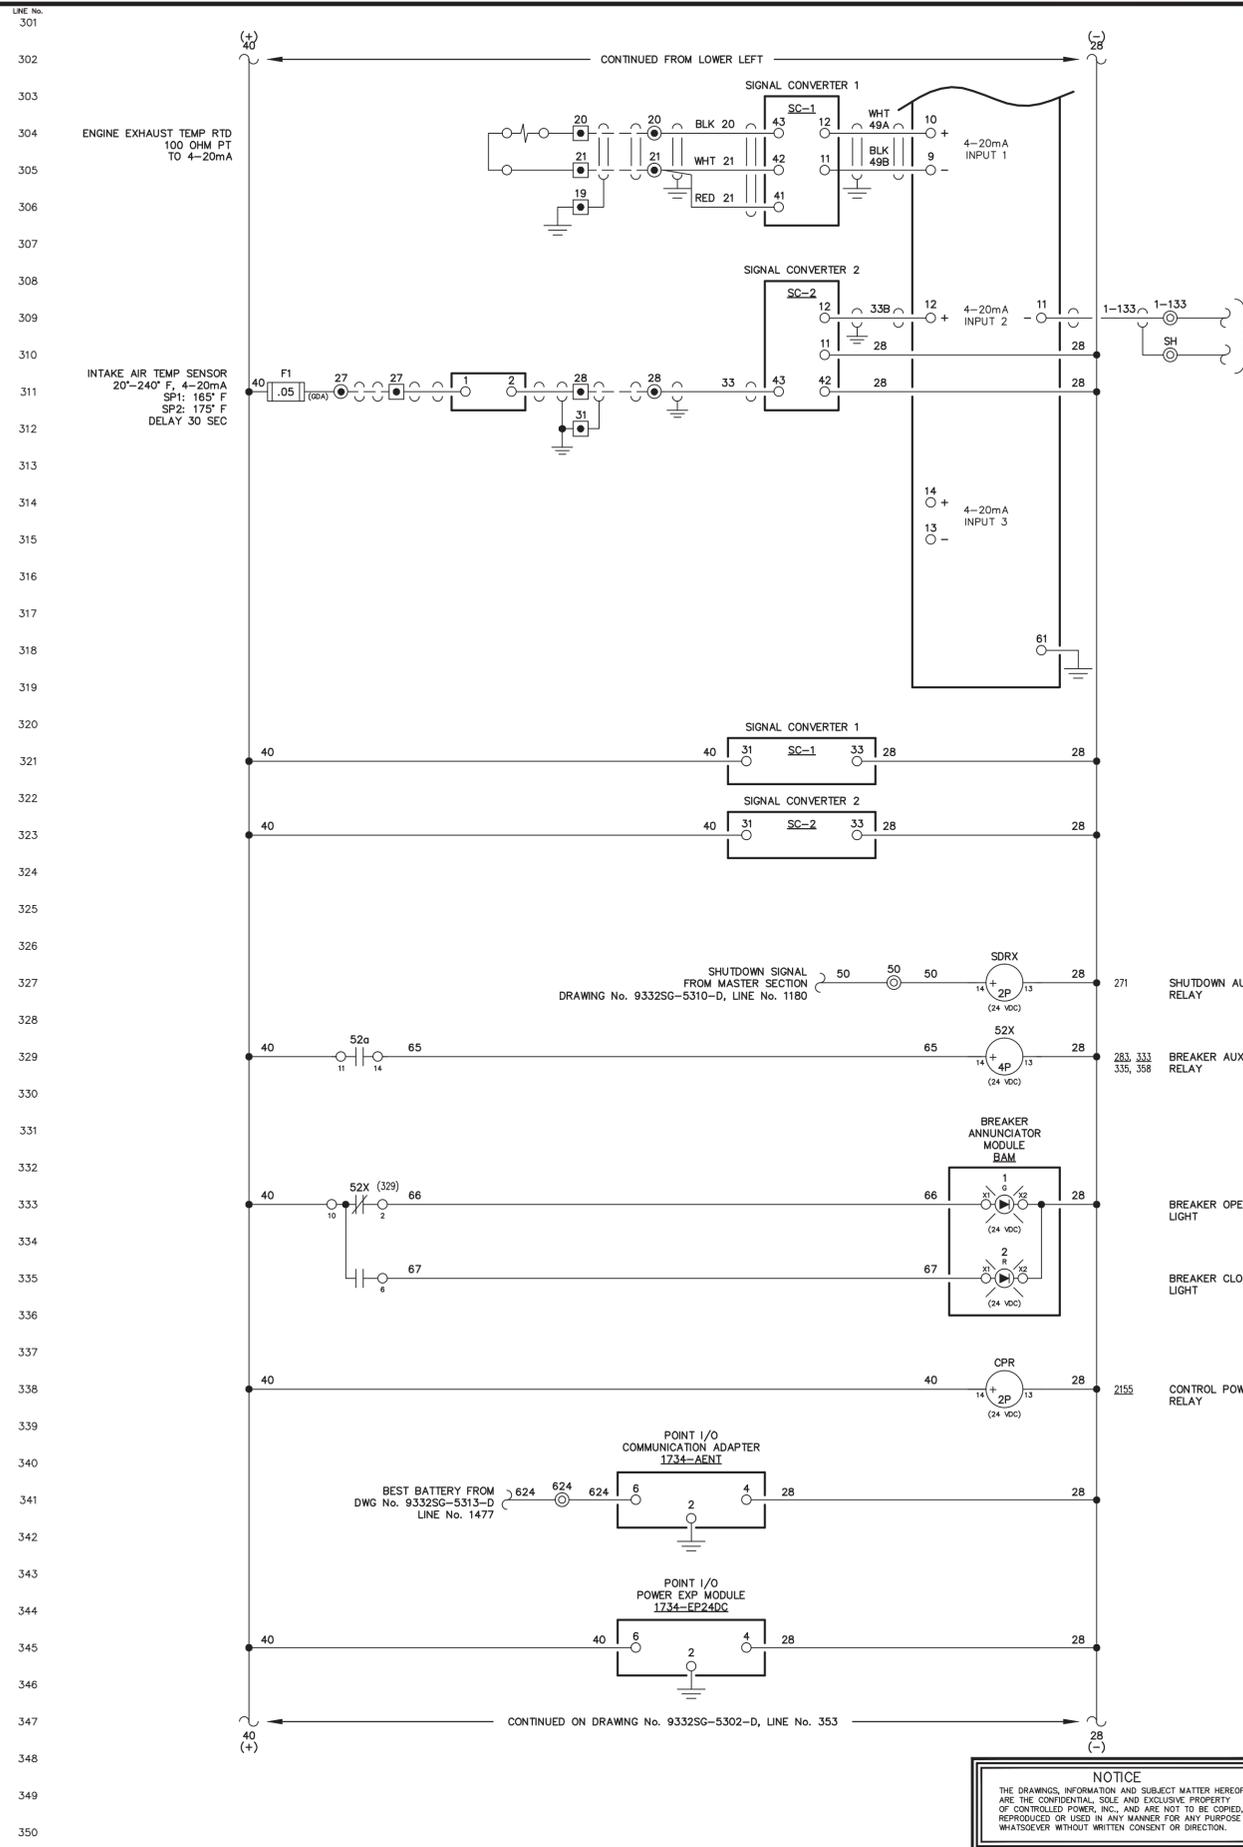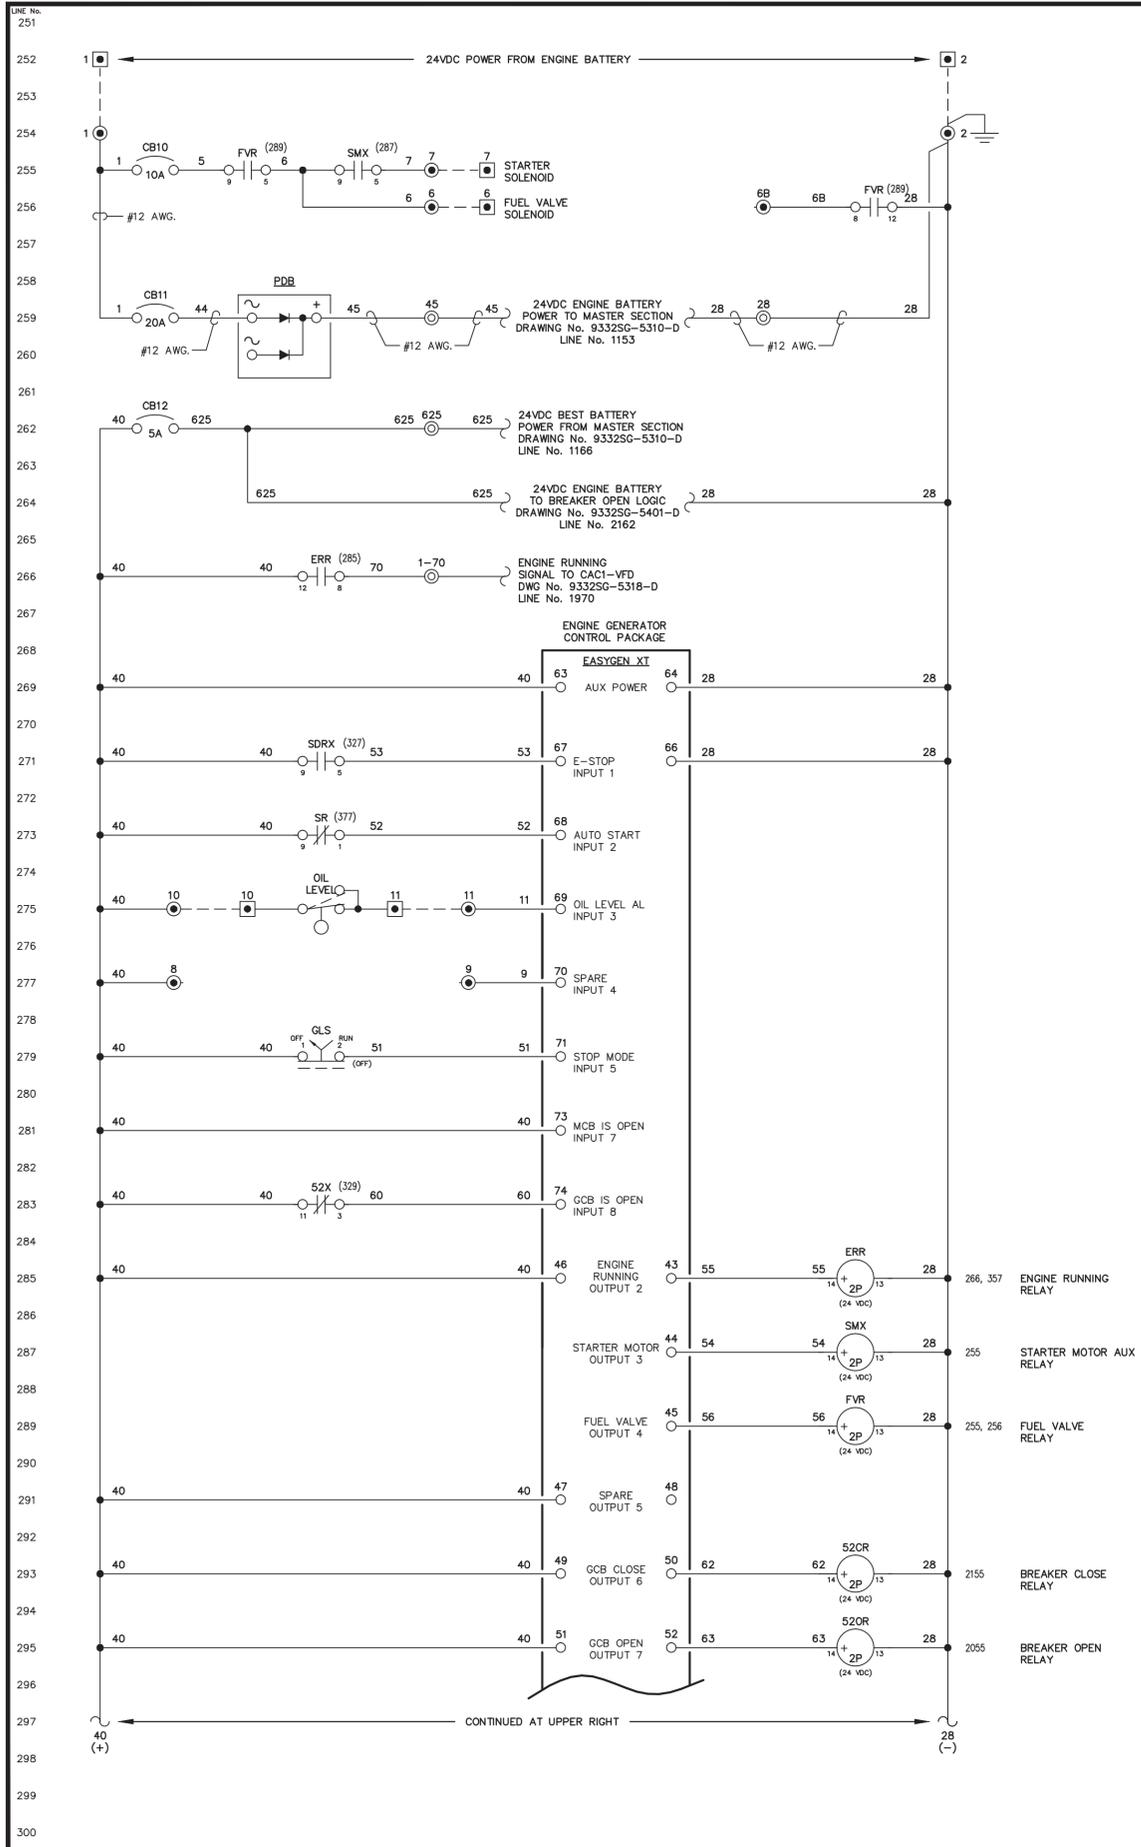

TO CAC1-VFD DRAWING No. 9332SG-5318-D Line No. 1976





NOTE:
1. FOR GENERAL WIRING & CONSTRUCTION NOTES, SEE DRAWING No. 9332SG-3101-D.

D	09-18-24	SHOP AS BUILT	GJG
REV.	DATE	DESCRIPTION	BY
AEA PURCHASE ORDER No. P0010800		CONTROLLED POWER JOB No. 9332SG	
TITLE: GENERATOR 1 DC CONTROL, SCHEMATIC DIAGRAM			
SCALE: NONE	DATE: 11-29-23	DWN. BY: GPN	
DWG. No: 9332SG-5301-D	SHEET: 1 OF 1	CKD. BY: JMD	
JOB: MANOKOTAK POWER SYSTEM UPGRADE			

ALASKA ENERGY AUTHORITY
RURAL ENERGY GROUP
813 W. NORTHERN LIGHTS BLVD.
ANCHORAGE, ALASKA 99503
HTTP://WWW.AIDEA.ORG

ENGINEERED & MANUFACTURED BY
Controlled Power, Inc.
BOTHELL, WASHINGTON USA
(425)-485-1778 www.controlledpowerinc.com

NOTICE
THE DRAWINGS, INFORMATION AND SUBJECT MATTER HEREOF ARE THE CONFIDENTIAL, SOLE AND EXCLUSIVE PROPERTY OF CONTROLLED POWER, INC., AND ARE NOT TO BE COPIED, REPRODUCED OR USED IN ANY MANNER FOR ANY PURPOSE WHATSOEVER WITHOUT WRITTEN CONSENT OR DIRECTION.

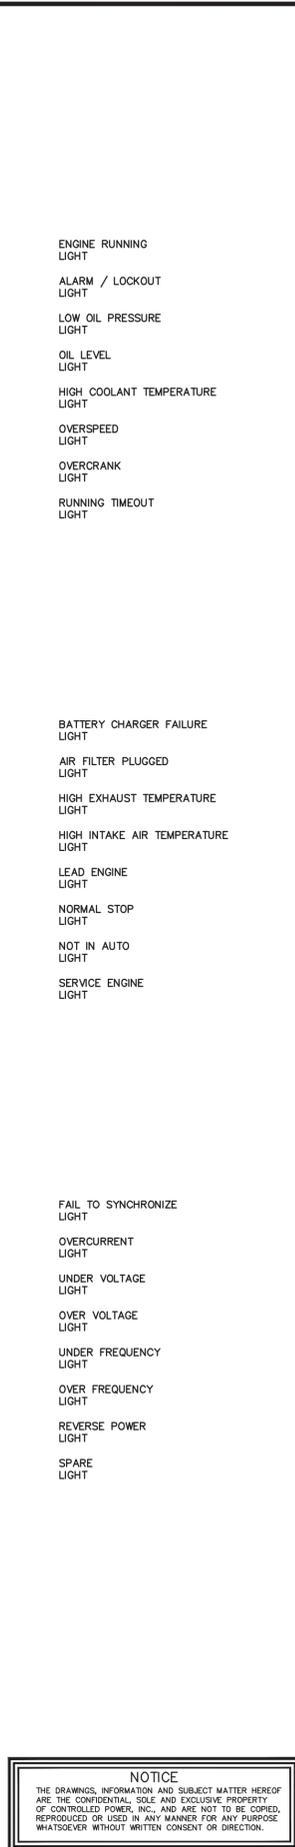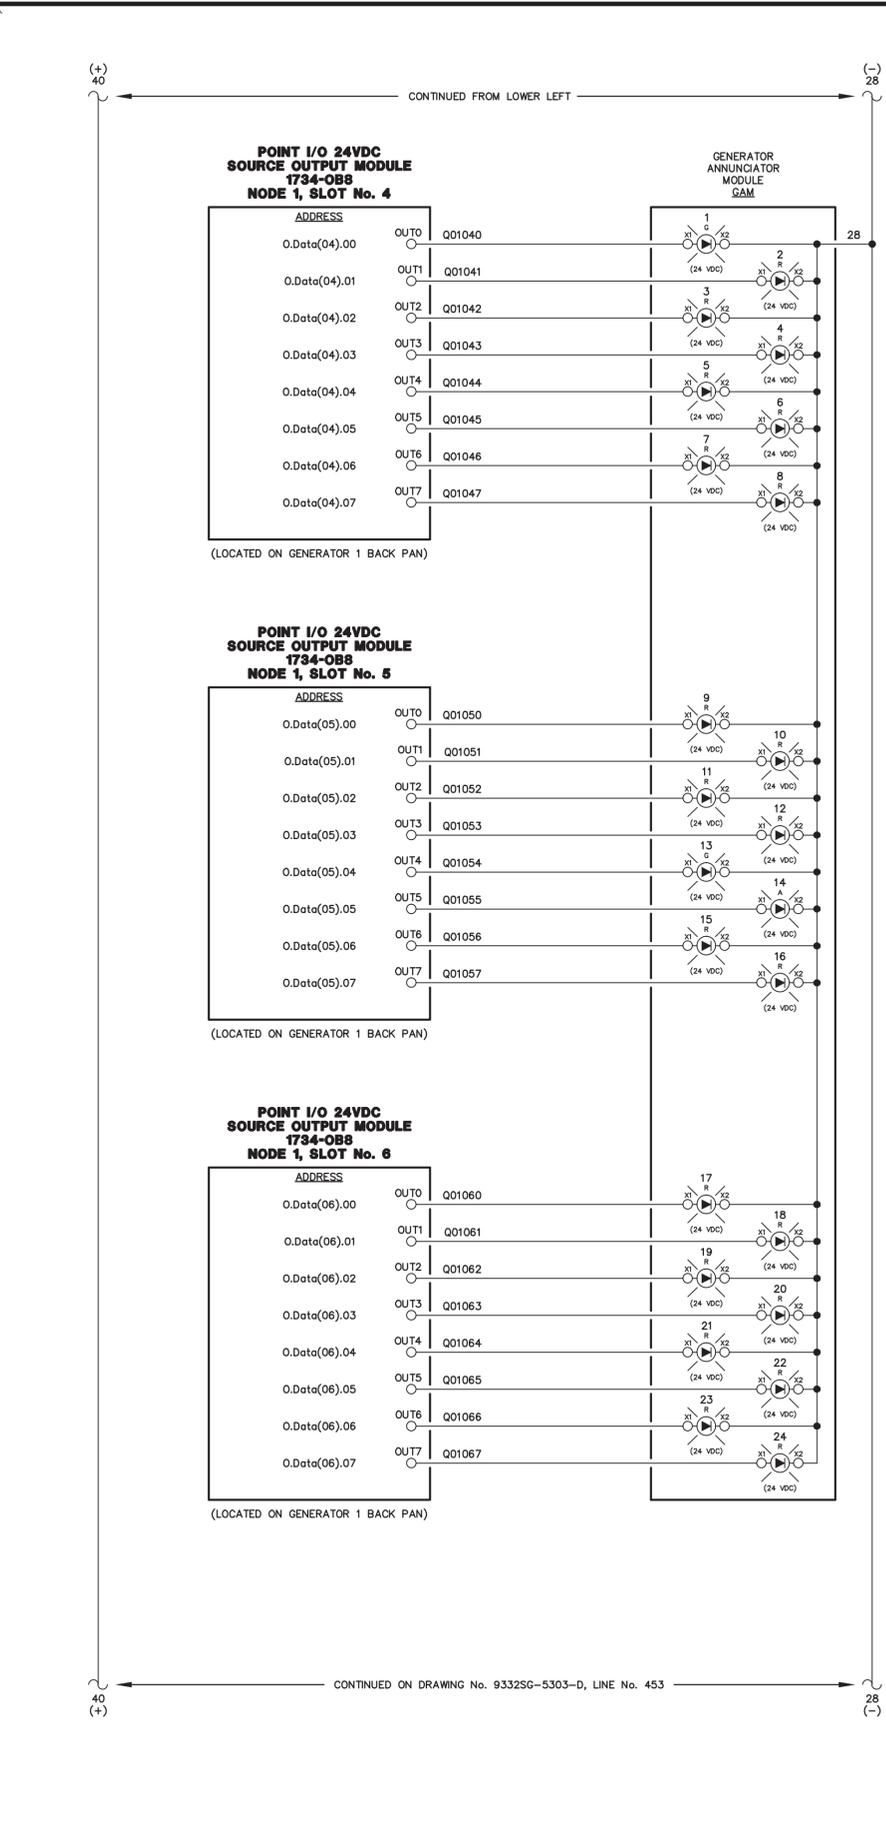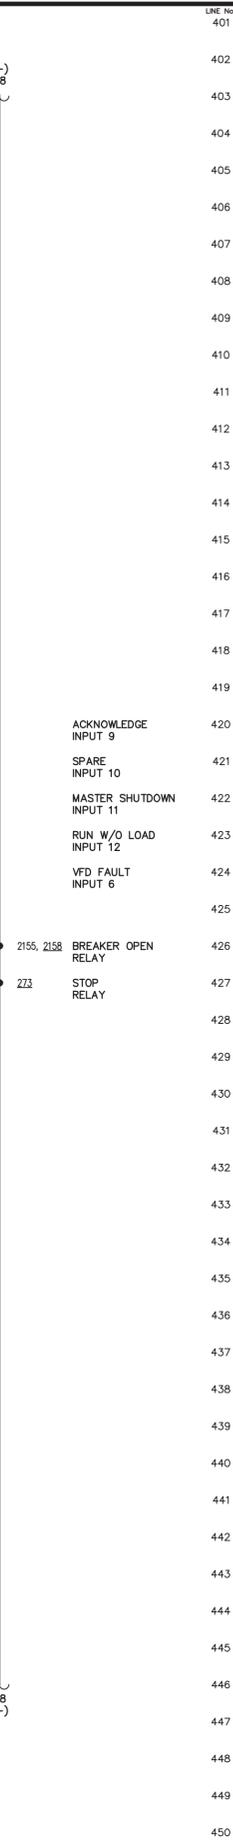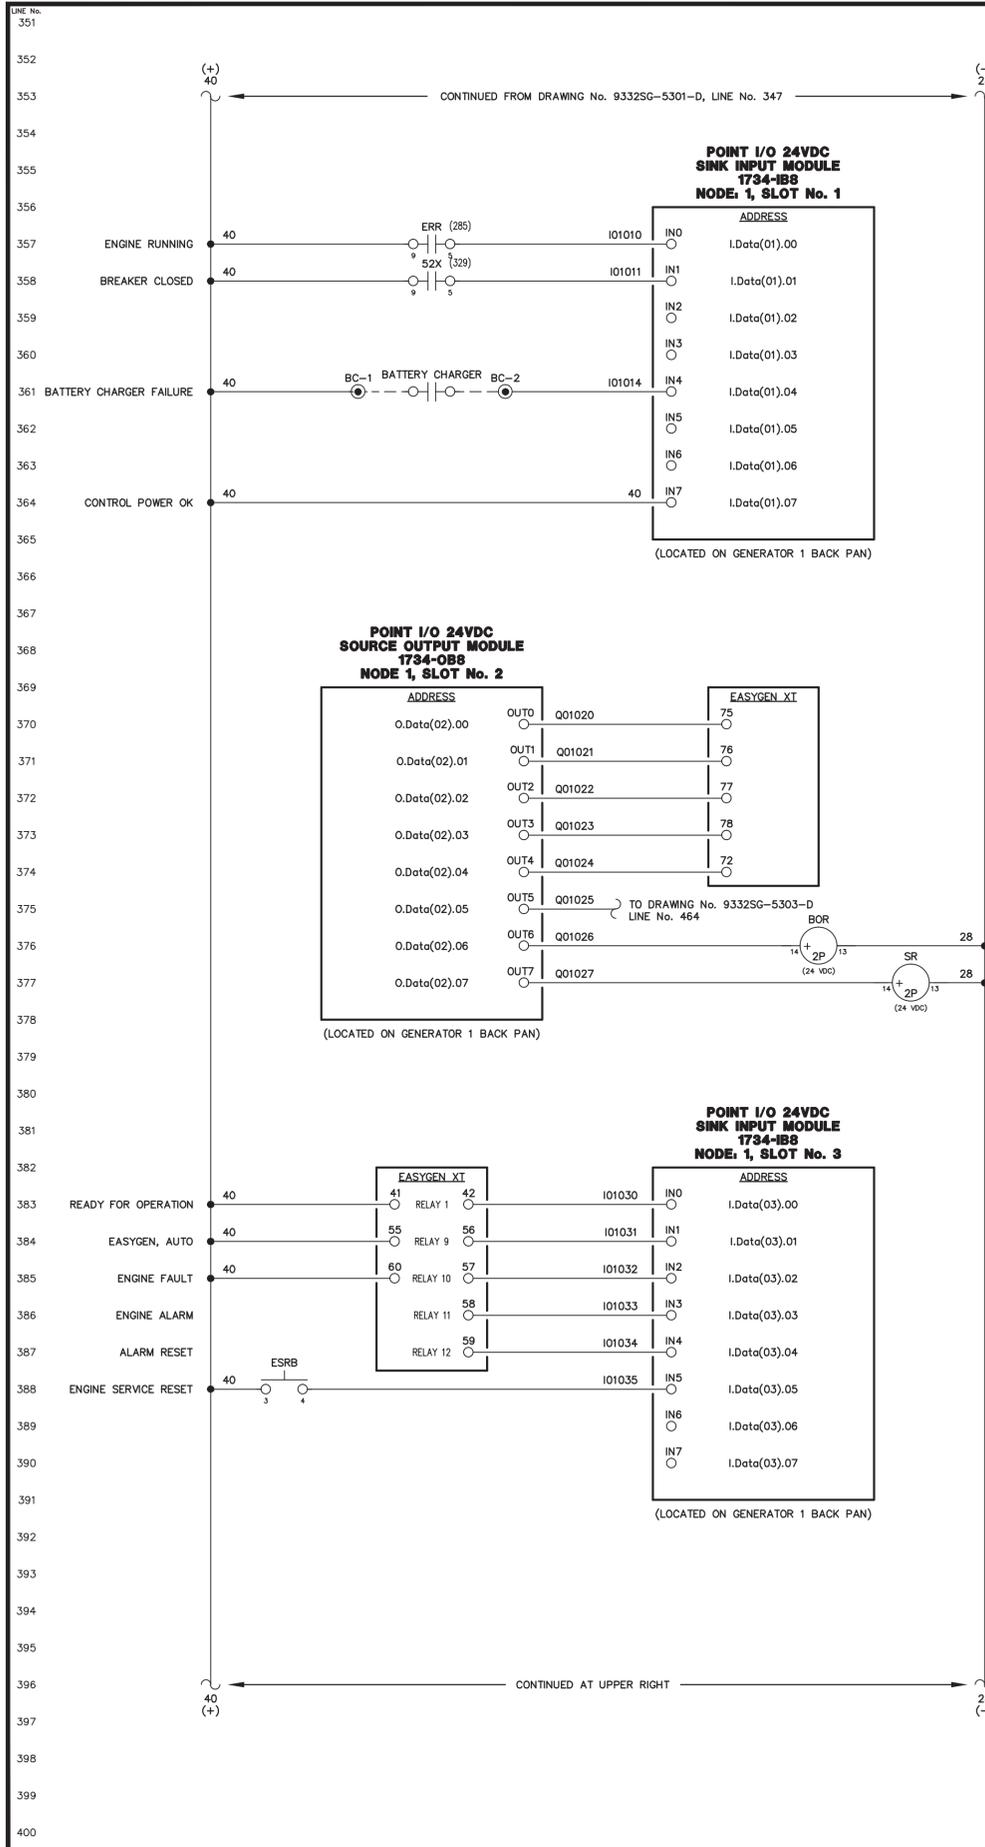

NOTE:
1. FOR GENERAL WIRING & CONSTRUCTION NOTES, SEE DRAWING No. 9332SG-3101-D.

D	09-18-24	SHOP AS BUILT	GJG
REV.	DATE	DESCRIPTION	BY
AEA PURCHASE ORDER No. P0010800		CONTROLLED POWER JOB No. 9332SG	
TITLE: GENERATOR 1 DC CONTROL, SCHEMATIC DIAGRAM			
SCALE: NONE	DATE: 11-29-23	DWN. BY: GPN	
DWG. No: 9332SG-5302-D	SHEET: 1 OF 1	CKD. BY: JMD	
JOB: MANOKOTAK POWER SYSTEM UPGRADE			


ALASKA ENERGY AUTHORITY
RURAL ENERGY GROUP
813 W. NORTHERN LIGHTS BLVD.
ANCHORAGE, ALASKA 99503
HTTP://WWW.AIDEA.ORG

ENGINEERED & MANUFACTURED BY
Controlled Power, Inc.
BOTHELL, WASHINGTON USA
(425)-485-1778 www.controlleddpowerinc.com

NOTICE
THE DRAWINGS, INFORMATION AND SUBJECT MATTER HEREOF ARE THE CONFIDENTIAL, SOLE AND EXCLUSIVE PROPERTY OF CONTROLLED POWER, INC., AND ARE NOT TO BE COPIED, REPRODUCED OR USED IN ANY MANNER FOR ANY PURPOSE WHATSOEVER WITHOUT WRITTEN CONSENT OR DIRECTION.

LINE No.
451
452
453
LINE No.
501
502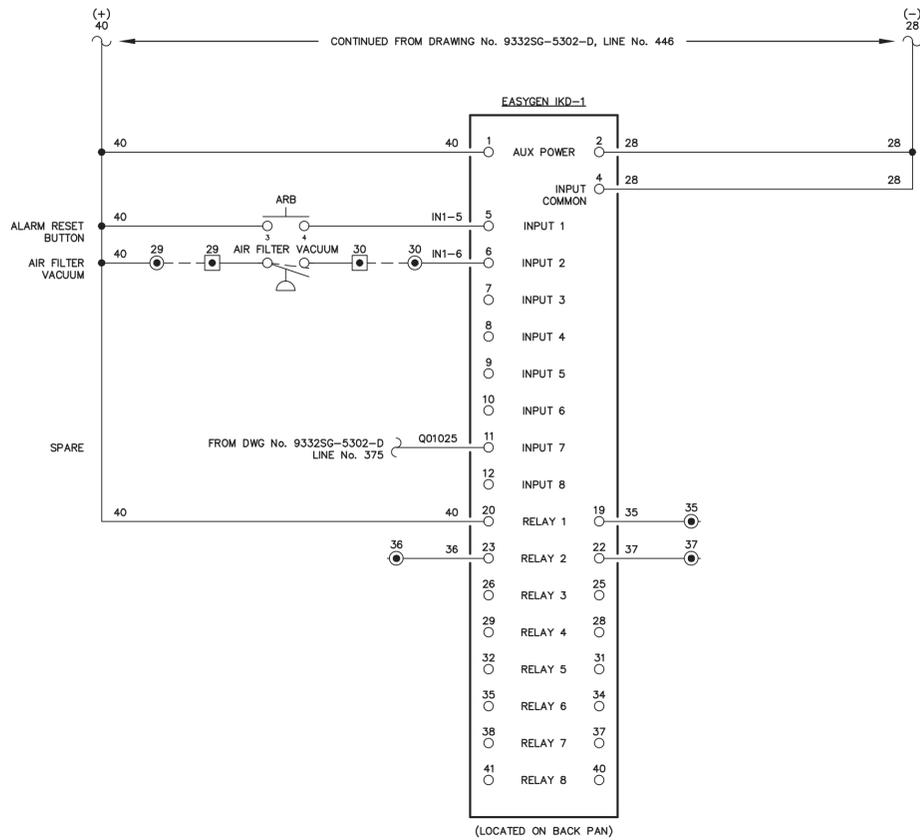
NOTE:
1. FOR GENERAL WIRING & CONSTRUCTION NOTES, SEE DRAWING No. 9332SG-3101-D.

D	09-18-24	SHOP AS BUILT	GJG
REV.	DATE	DESCRIPTION	BY
AEA PURCHASE ORDER No. P0010800		CONTROLLED POWER JOB No. 9332SG	
TITLE: GENERATOR 1 DC CONTROL, SCHEMATIC DIAGRAM			
SCALE: NONE	DATE: 11-29-23	DWN. BY: GPN	
DWG. No: 9332SG-5303-D	SHEET: 1 OF 1	CKD. BY: JMD	
JOB: MANOKOTAK POWER SYSTEM UPGRADE			
		RURAL ENERGY GROUP 813 W. NORTHERN LIGHTS BLVD. ANCHORAGE, ALASKA 99503 HTTP://WWW.AIDEA.ORG	

NOTICE
THE DRAWINGS, INFORMATION AND SUBJECT MATTER HEREOF ARE THE CONFIDENTIAL, SOLE AND EXCLUSIVE PROPERTY OF CONTROLLED POWER, INC. AND ARE NOT TO BE COPIED, REPRODUCED OR USED IN ANY MANNER FOR ANY PURPOSE WHATSOEVER WITHOUT WRITTEN CONSENT OR DIRECTION.

ENGINEERED & MANUFACTURED BY
Controlled Power, Inc.
 BOTHELL, WASHINGTON USA
 (425)-485-1778 www.controlleddpowerinc.com

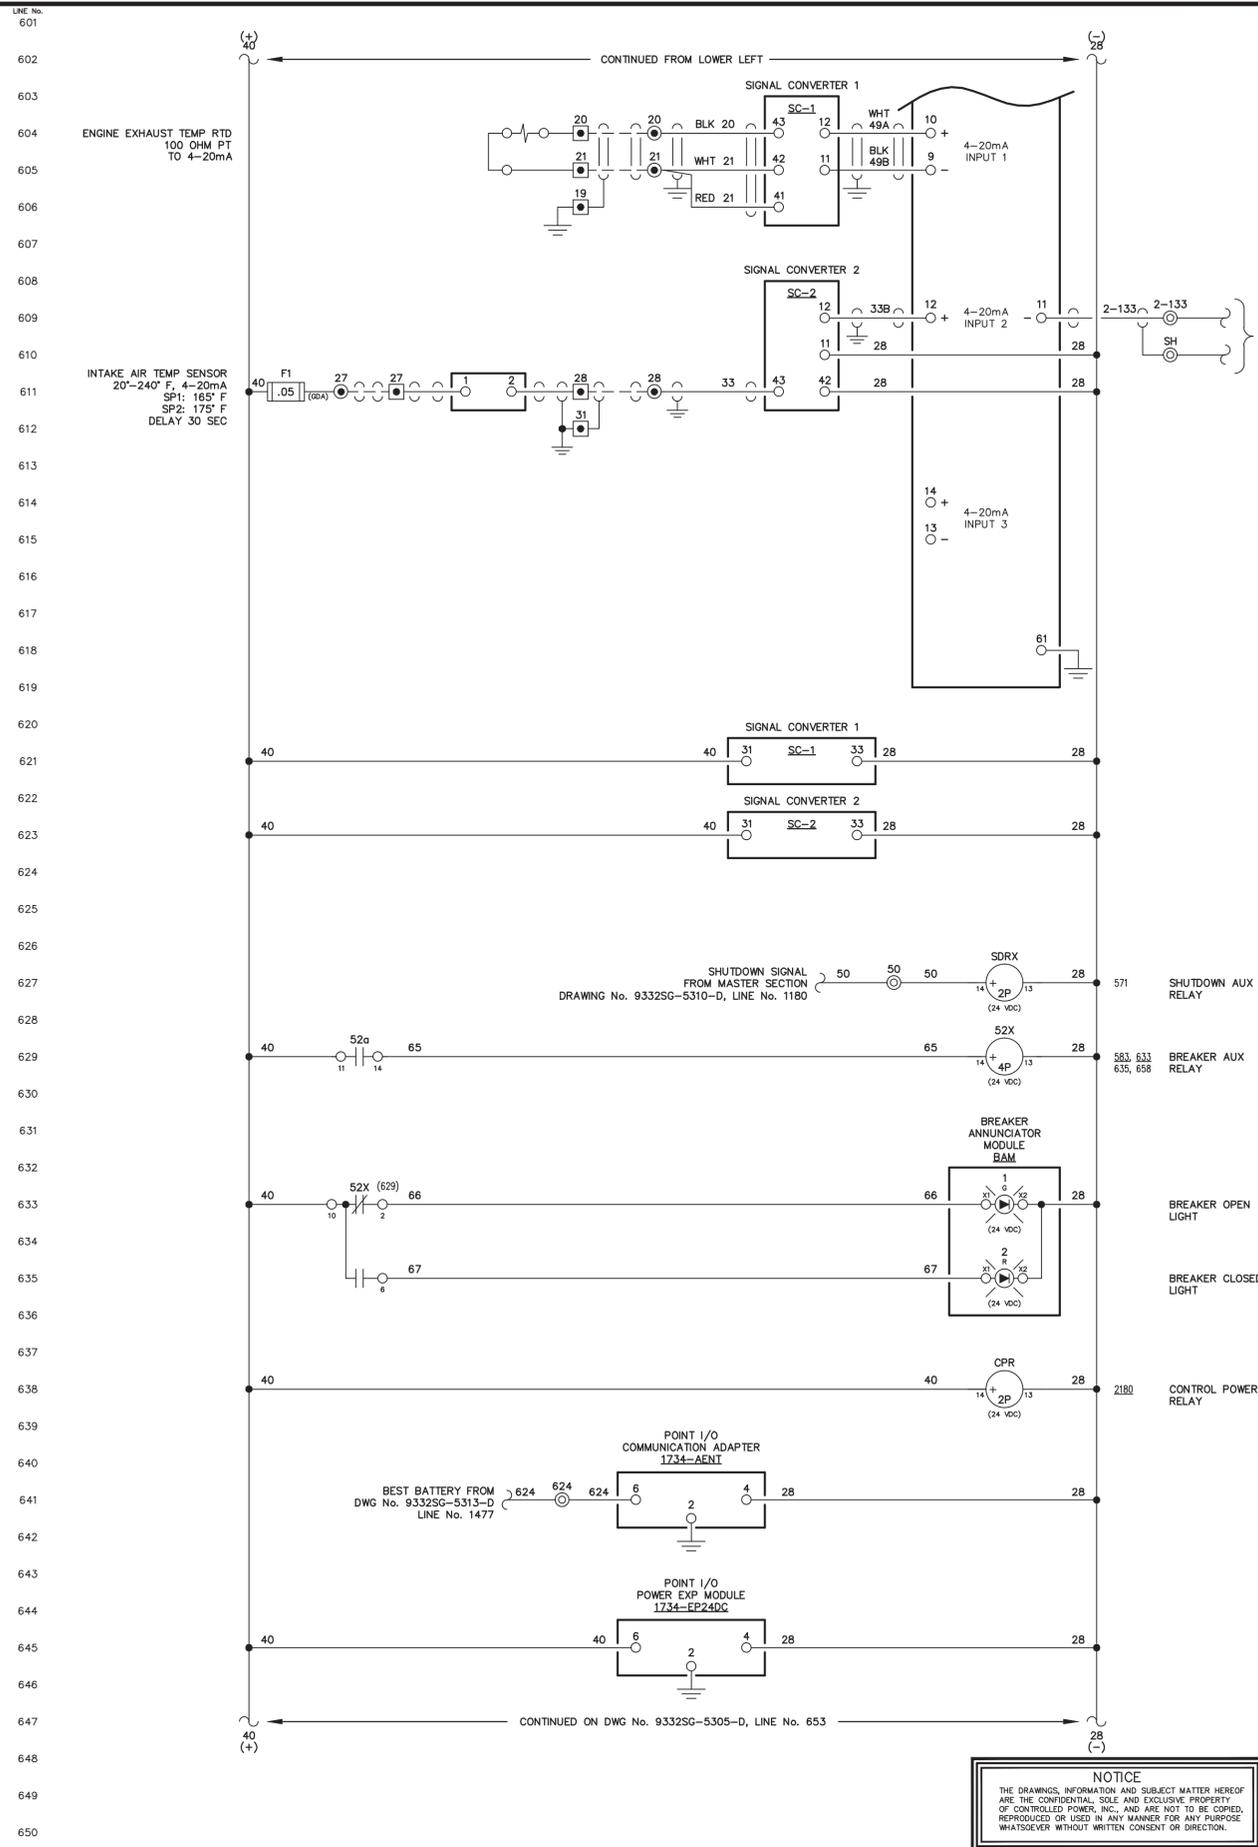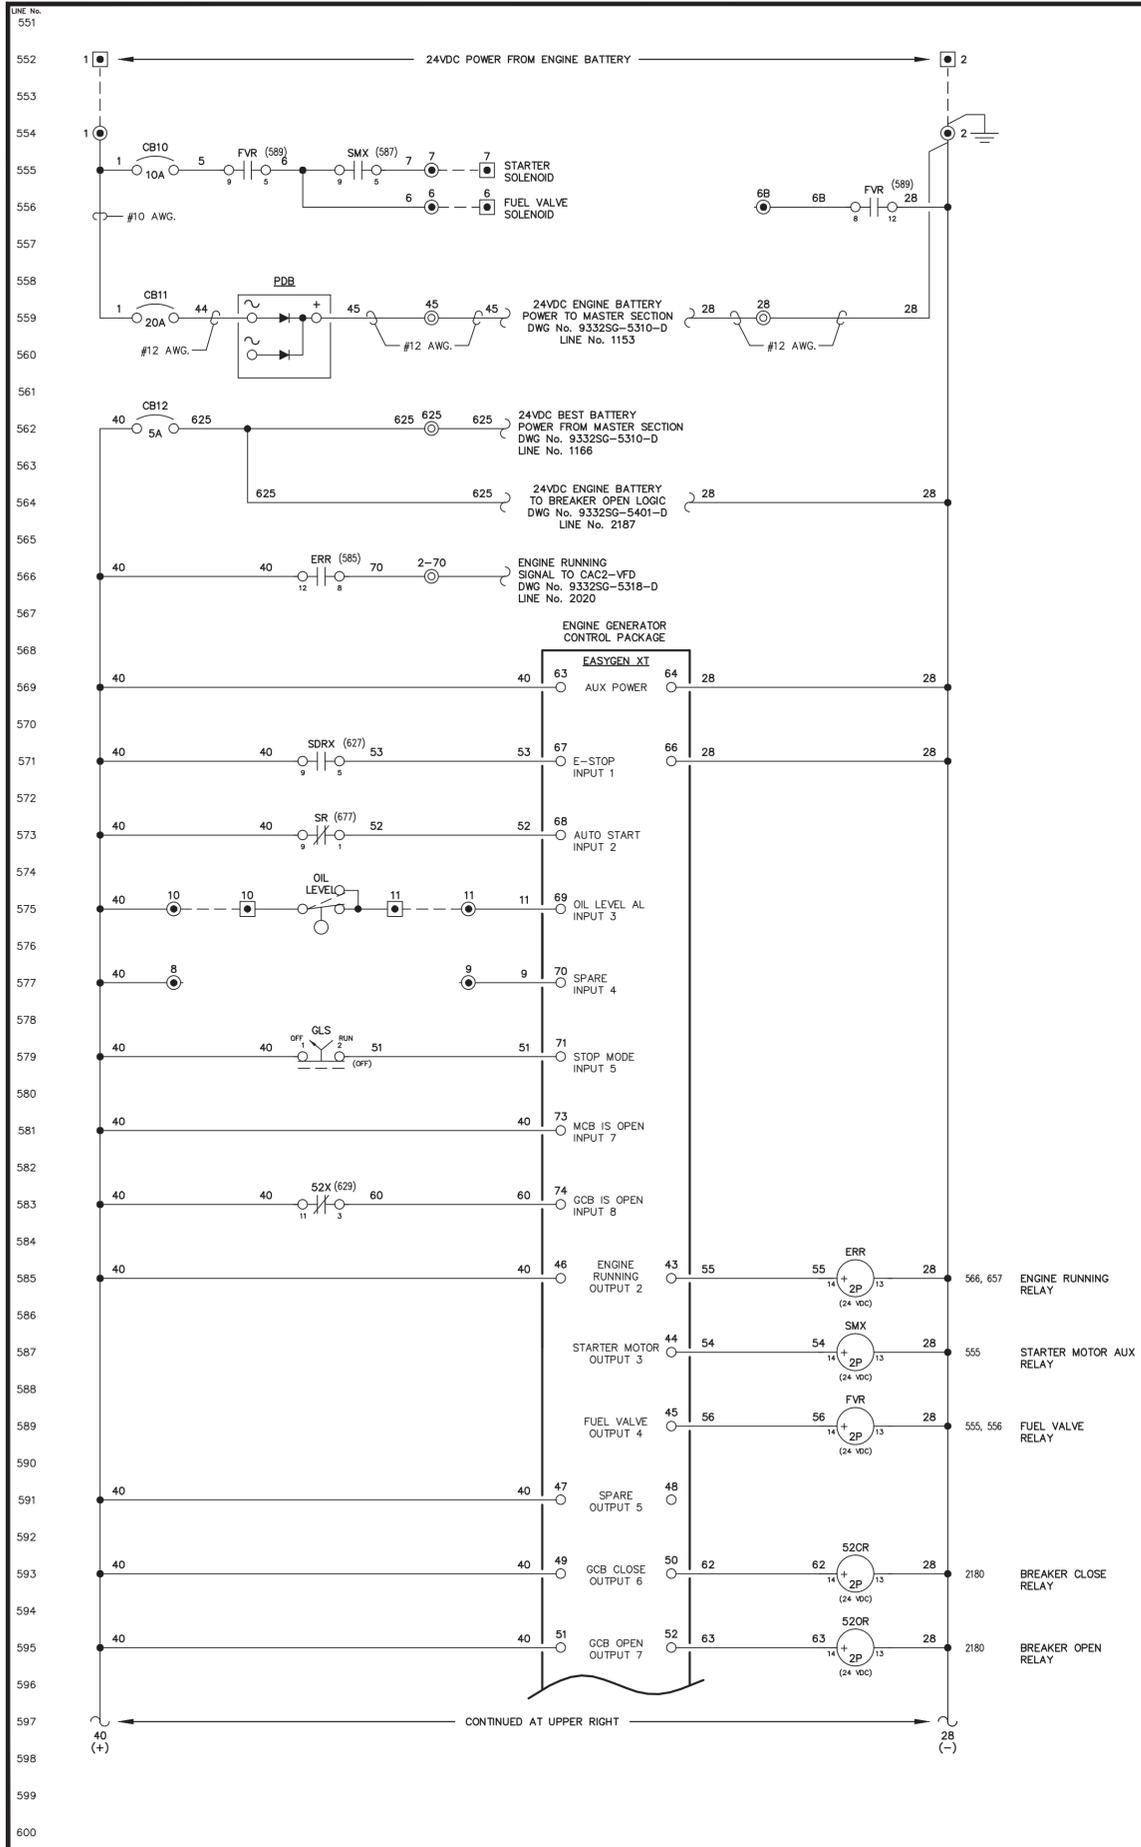

TO CAC2-VFD
DRAWING No. 9332SG-5318-D
Line No. 2026



NOTE:
1. FOR GENERAL WIRING & CONSTRUCTION NOTES, SEE DRAWING No. 9332SG-3101-D.

D	09-18-24	SHOP AS BUILT	GJG
REV.	DATE	DESCRIPTION	BY
AEA PURCHASE ORDER No. P0010800		CONTROLLED POWER JOB No. 9332SG	
TITLE: GENERATOR 2 DC CONTROL, SCHEMATIC DIAGRAM			
SCALE: NONE	DATE: 11-29-23	DWN. BY: GPN	
DWG. No: 9332SG-5304-D	SHEET: 1 OF 1	CKD. BY: JMD	
JOB: MANOKOTAK POWER SYSTEM UPGRADE			

ALASKA ENERGY AUTHORITY
RURAL ENERGY GROUP
813 W. NORTHERN LIGHTS BLVD.
ANCHORAGE, ALASKA 99503
HTTP://WWW.AIDEA.ORG

ENGINEERED & MANUFACTURED BY
Controlled Power, Inc.
BOTHELL, WASHINGTON USA
(425)-485-1778 www.controlledpowerinc.com

NOTICE
THE DRAWINGS, INFORMATION AND SUBJECT MATTER HEREOF ARE THE CONFIDENTIAL, SOLE AND EXCLUSIVE PROPERTY OF CONTROLLED POWER, INC., AND ARE NOT TO BE COPIED, REPRODUCED OR USED IN ANY MANNER FOR ANY PURPOSE WHATSOEVER WITHOUT WRITTEN CONSENT OR DIRECTION.

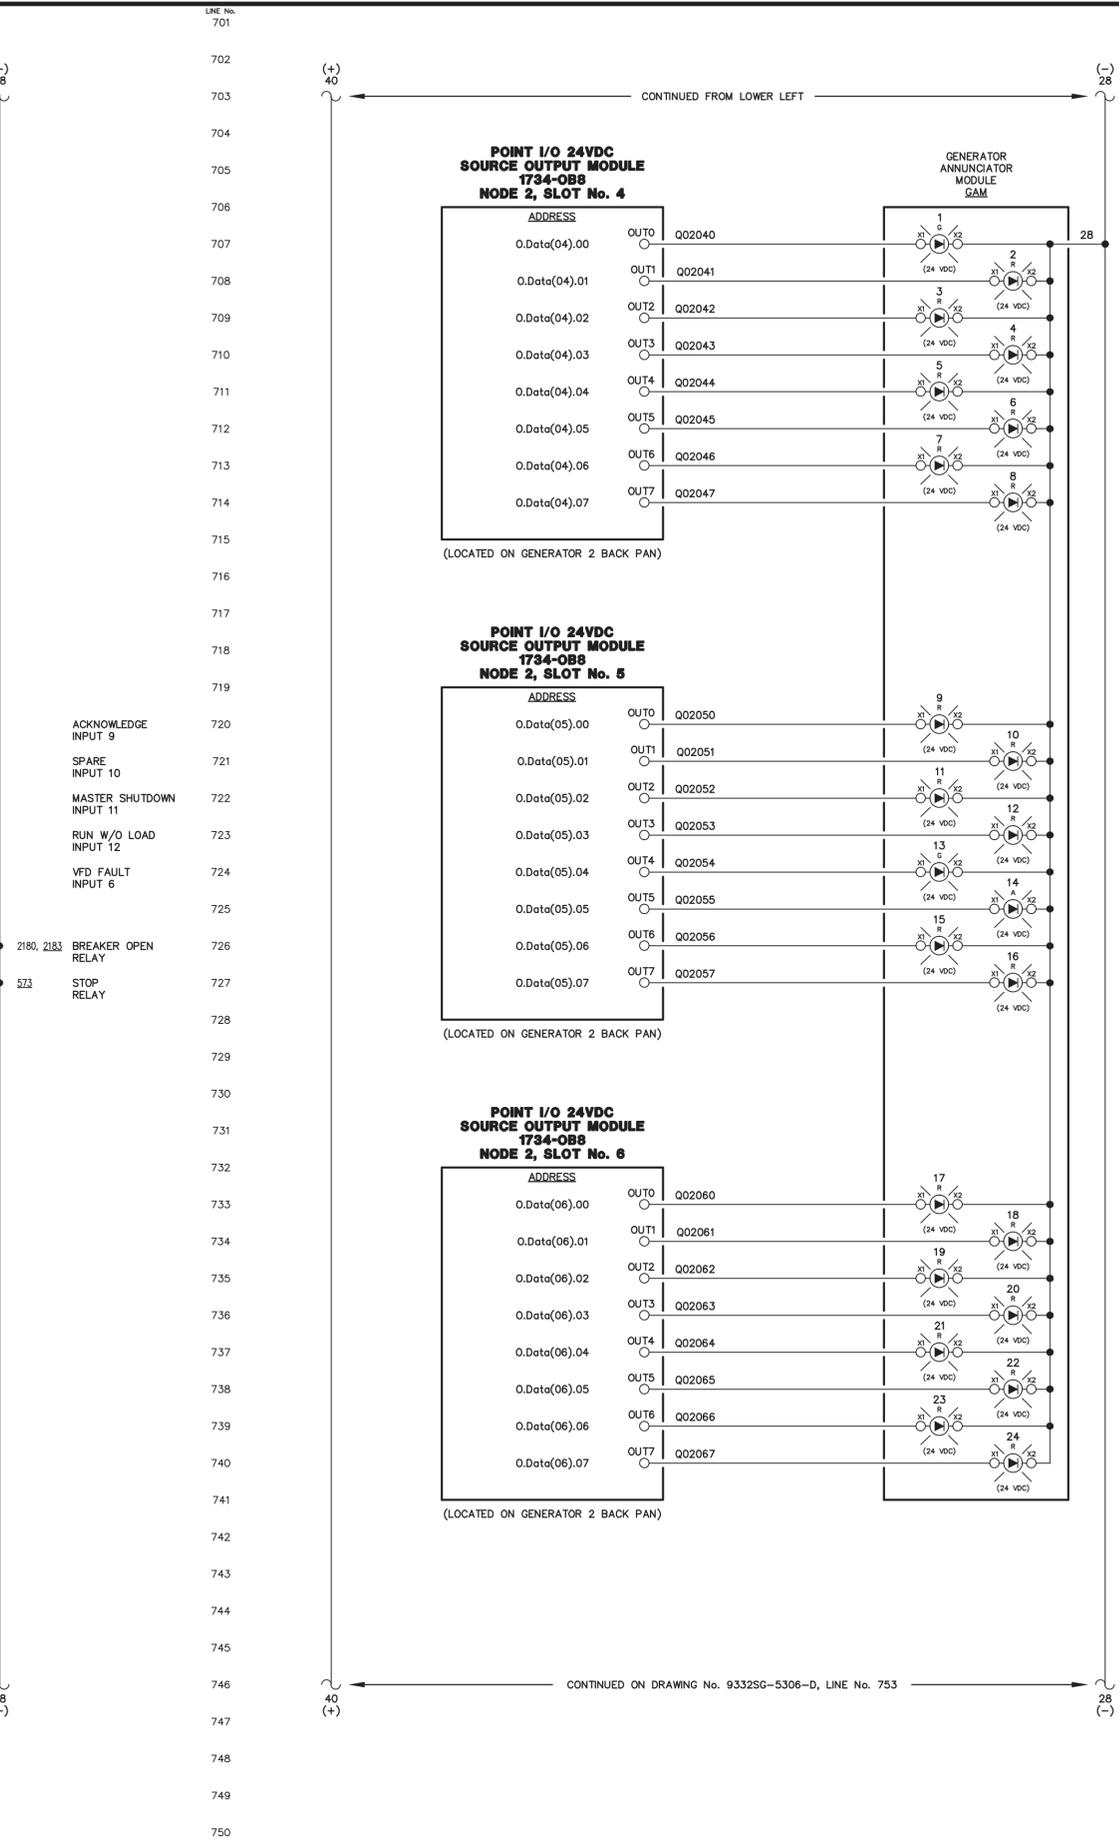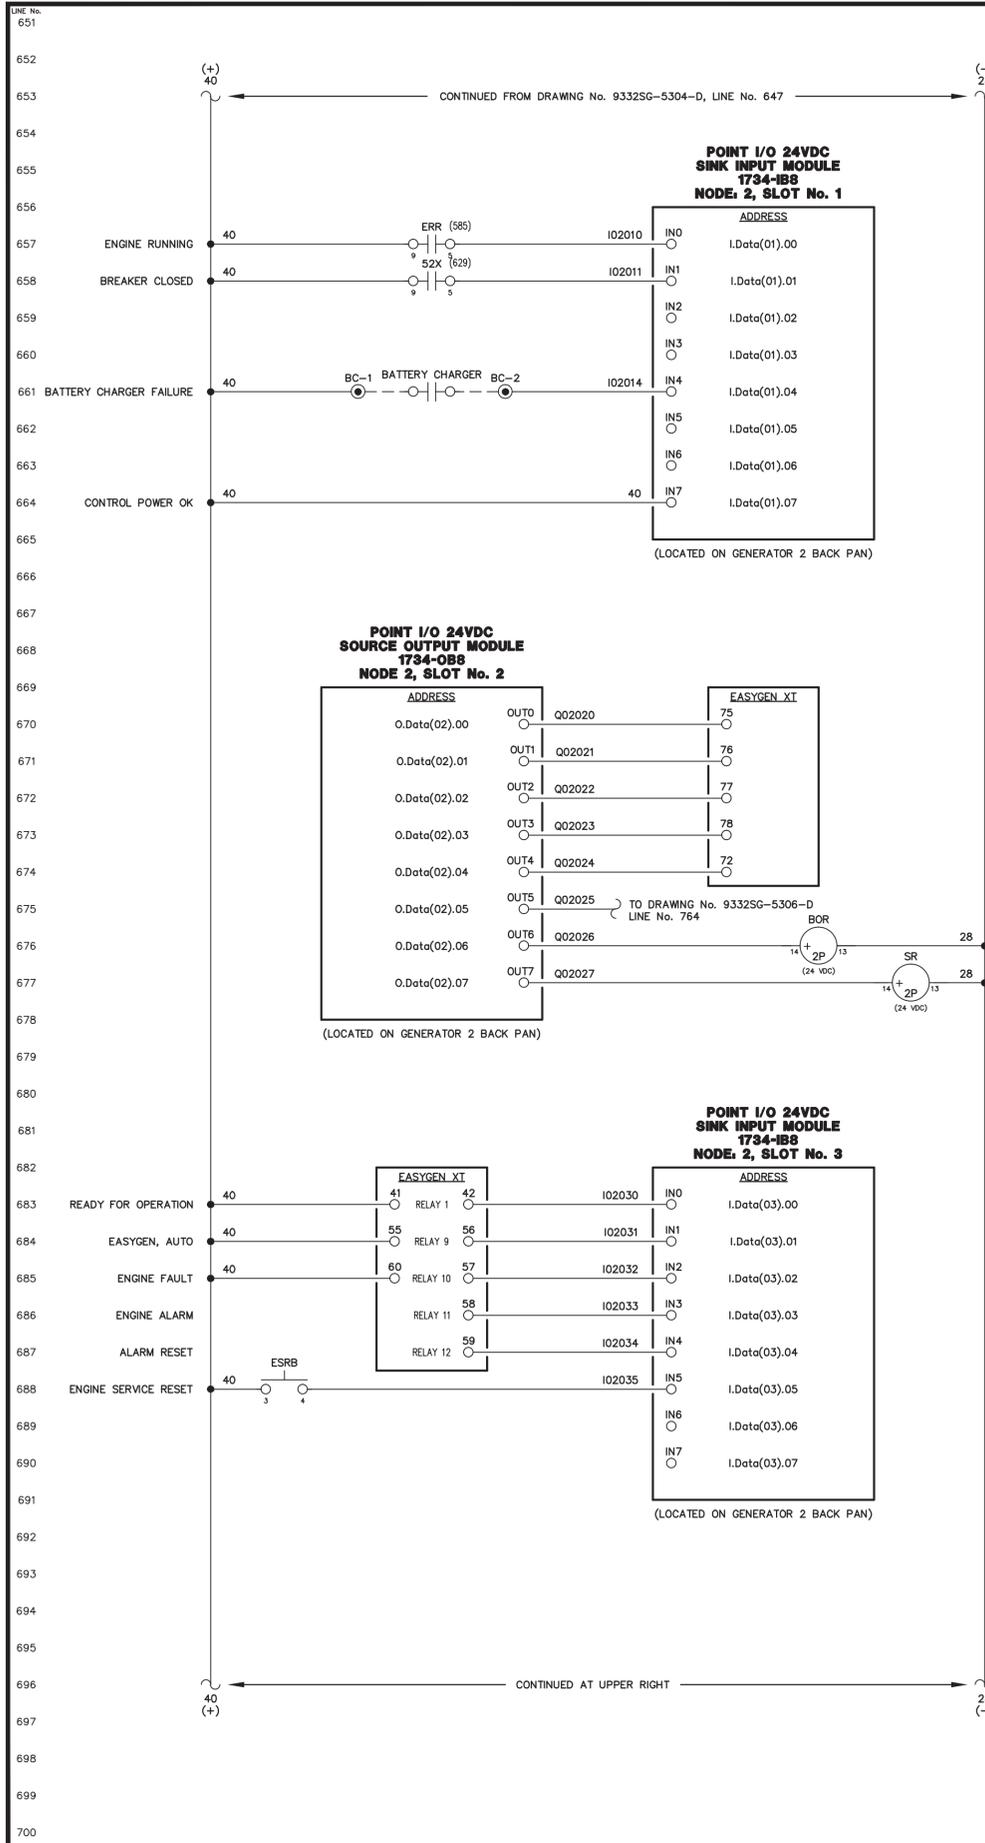

CONTINUED FROM LOWER LEFT

CONTINUED AT UPPER RIGHT

CONTINUED ON DRAWING No. 9332SG-5306-D, LINE No. 753

NOTE:
1. FOR GENERAL WIRING & CONSTRUCTION NOTES, SEE DRAWING No. 9332SG-3101-D.

REV.	DATE	DESCRIPTION	BY
D	09-18-24	SHOP AS BUILT	GJG

AEA PURCHASE ORDER No. P0010800 CONTROLLED POWER JOB No. 9332SG

TITLE: GENERATOR 2 DC CONTROL, SCHEMATIC DIAGRAM

SCALE: NONE	DATE: 11-29-23	DWN. BY: GPN
DWG. No: 9332SG-5305-D	SHEET: 1 OF 1	CKD. BY: JMD

JOB: MANOKOTAK POWER SYSTEM UPGRADE


ALASKA ENERGY AUTHORITY
RURAL ENERGY GROUP
813 W. NORTHERN LIGHTS BLVD.
ANCHORAGE, ALASKA 99503
HTTP://WWW.AIDEA.ORG

Controlled Power, Inc.
BOTHELL, WASHINGTON USA
(425)-485-1778 www.controlleddpowerinc.com

NOTICE
THE DRAWINGS, INFORMATION AND SUBJECT MATTER HEREOF ARE THE CONFIDENTIAL, SOLE AND EXCLUSIVE PROPERTY OF CONTROLLED POWER, INC., AND ARE NOT TO BE COPIED, REPRODUCED OR USED IN ANY MANNER FOR ANY PURPOSE WHATSOEVER WITHOUT WRITTEN CONSENT OR DIRECTION.

751
752
753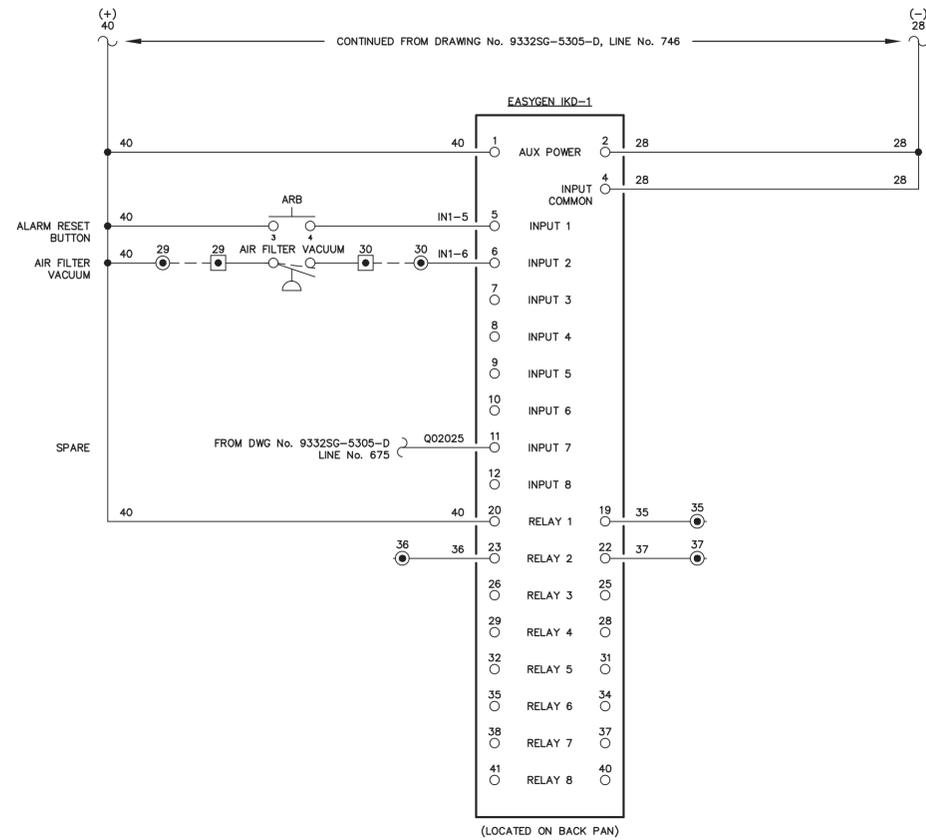
- NOTE:**
1. FOR GENERAL WIRING & CONSTRUCTION NOTES, SEE DRAWING No. 9332SG-3101-D.

REV.	DATE	DESCRIPTION	BY
D	09-18-24	SHOP AS BUILT	GJG

AEA PURCHASE ORDER No. P0010800 CONTROLLED POWER JOB No. 9332SG

TITLE: GENERATOR 2 DC CONTROL, SCHEMATIC DIAGRAM



SCALE: NONE	DATE: 11-29-23	DWN. BY: GPN
DWG. No: 9332SG-5306-D	SHEET: 1 OF 1	CKD. BY: JMD

JOB: MANOKOTAK POWER SYSTEM UPGRADE

ALASKA ENERGY AUTHORITY
RURAL ENERGY GROUP
813 W. NORTHERN LIGHTS BLVD.
ANCHORAGE, ALASKA 99503
HTTP://WWW.AIDEA.ORG

NOTICE
THE DRAWINGS, INFORMATION AND SUBJECT MATTER HEREOF ARE THE CONFIDENTIAL, SOLE AND EXCLUSIVE PROPERTY OF CONTROLLED POWER, INC. AND ARE NOT TO BE COPIED, REPRODUCED OR USED IN ANY MANNER FOR ANY PURPOSE WHATSOEVER WITHOUT WRITTEN CONSENT OR DIRECTION.



Controlled Power, Inc.
ENGINEERED & MANUFACTURED BY
BOTHHELL, WASHINGTON USA
(425)-485-1778 www.controlleddpowerinc.com

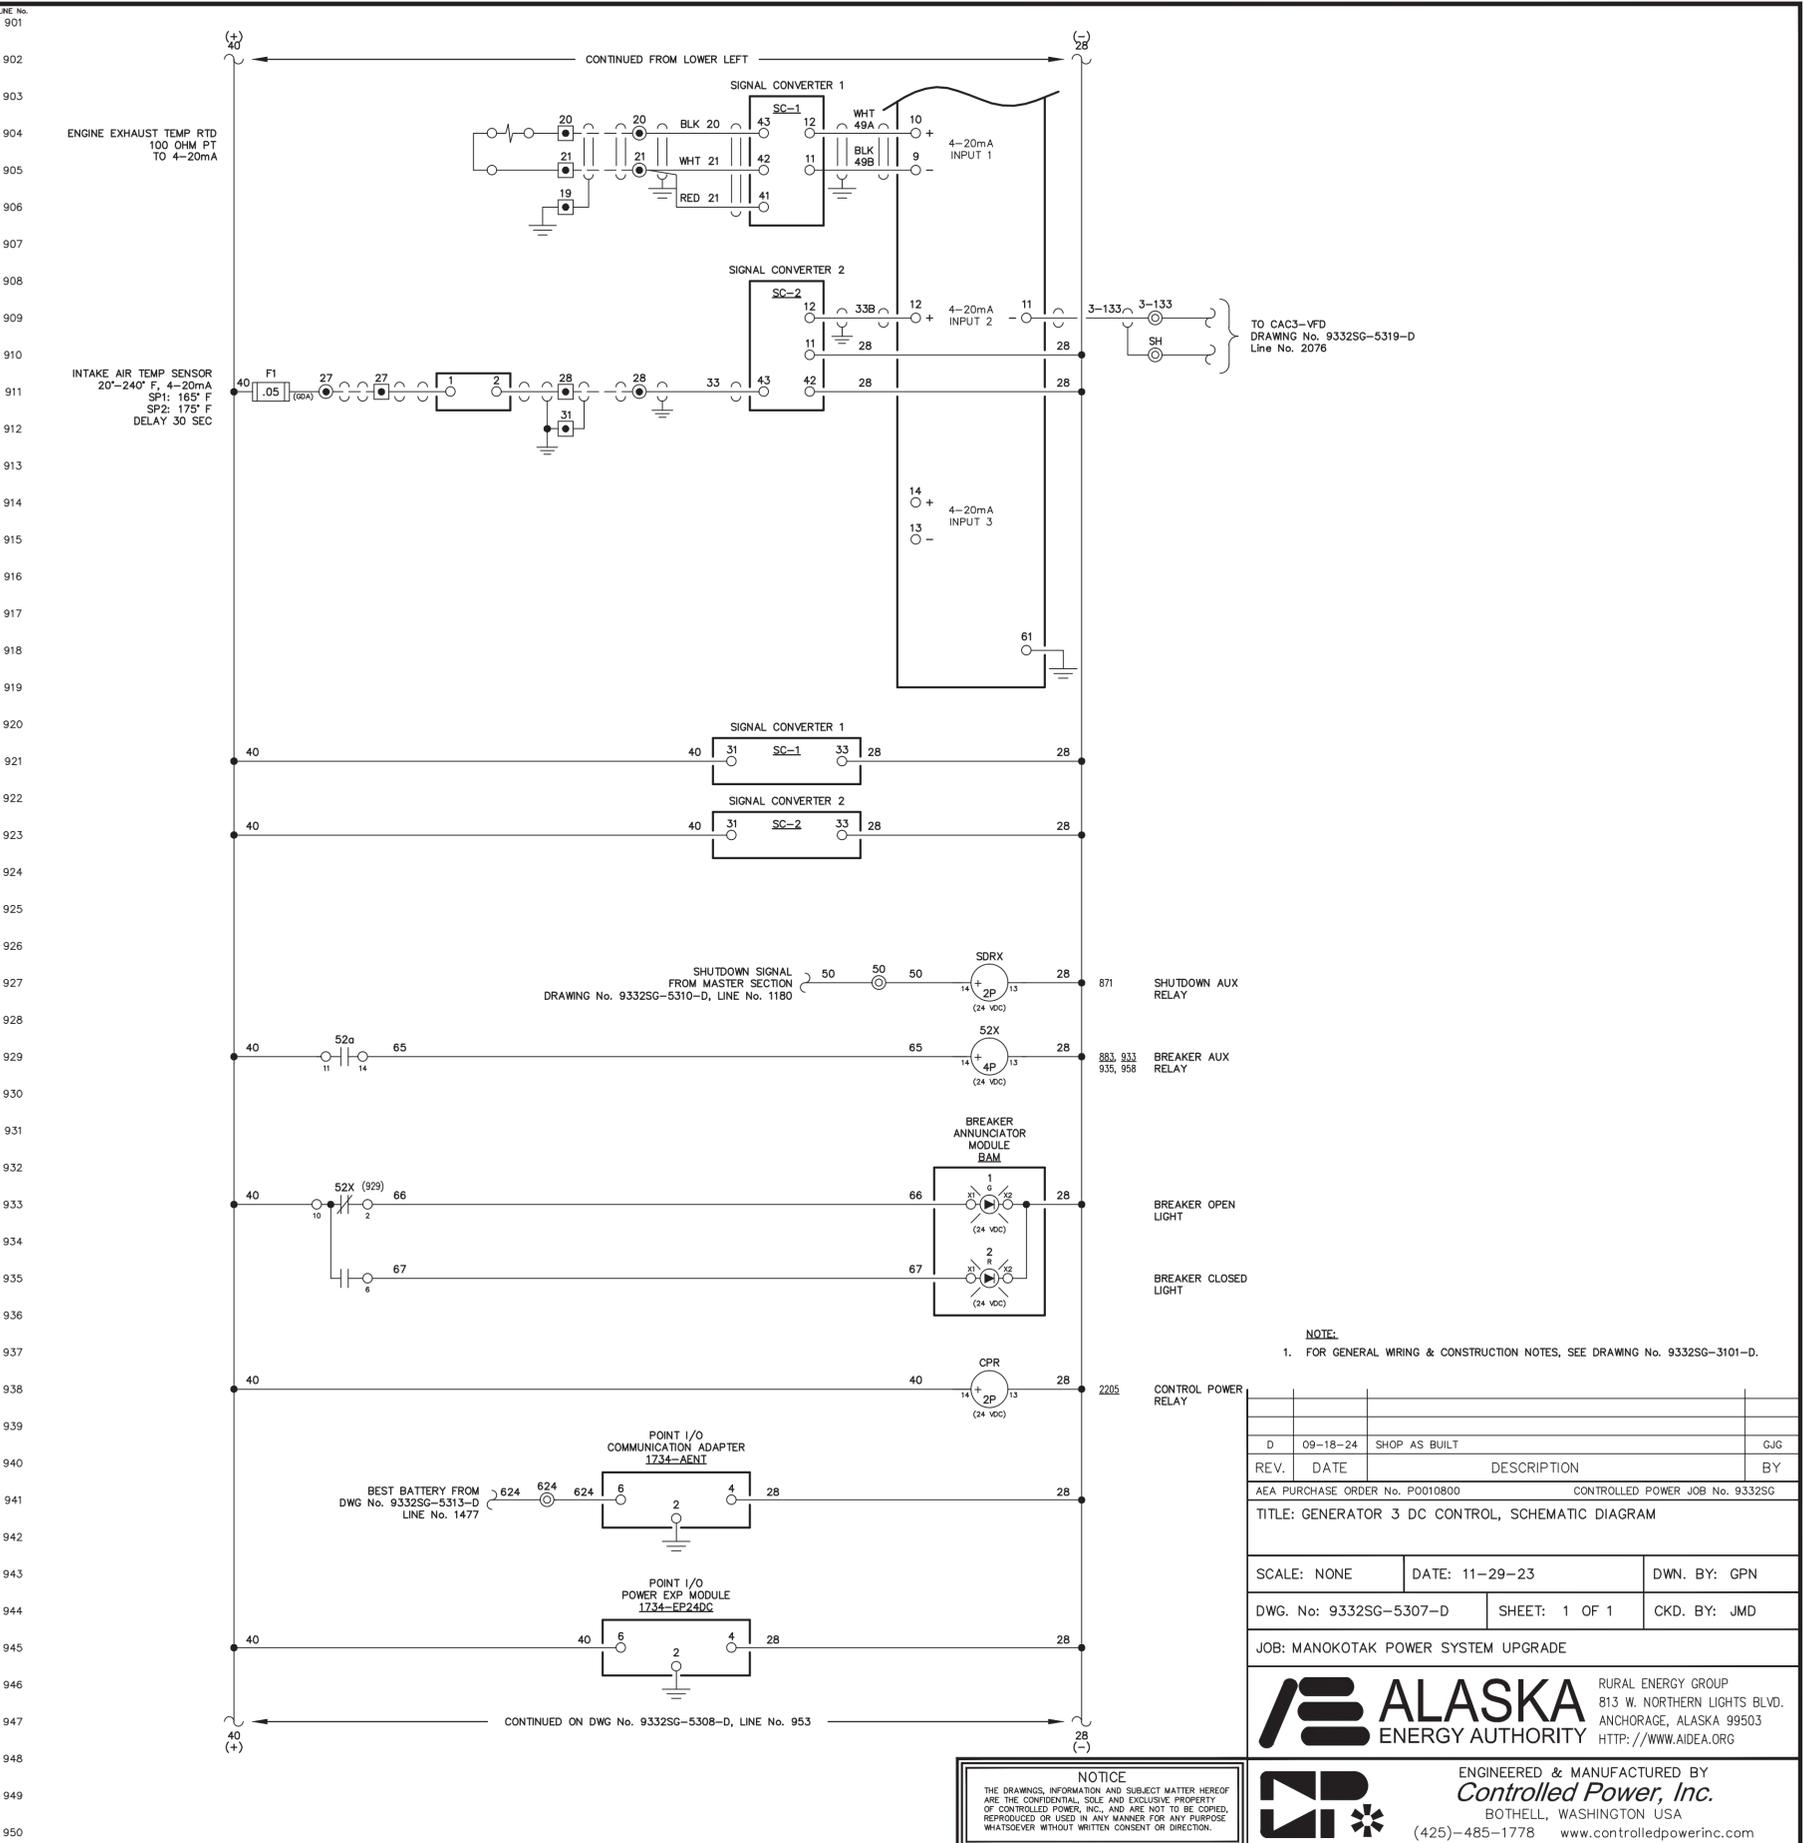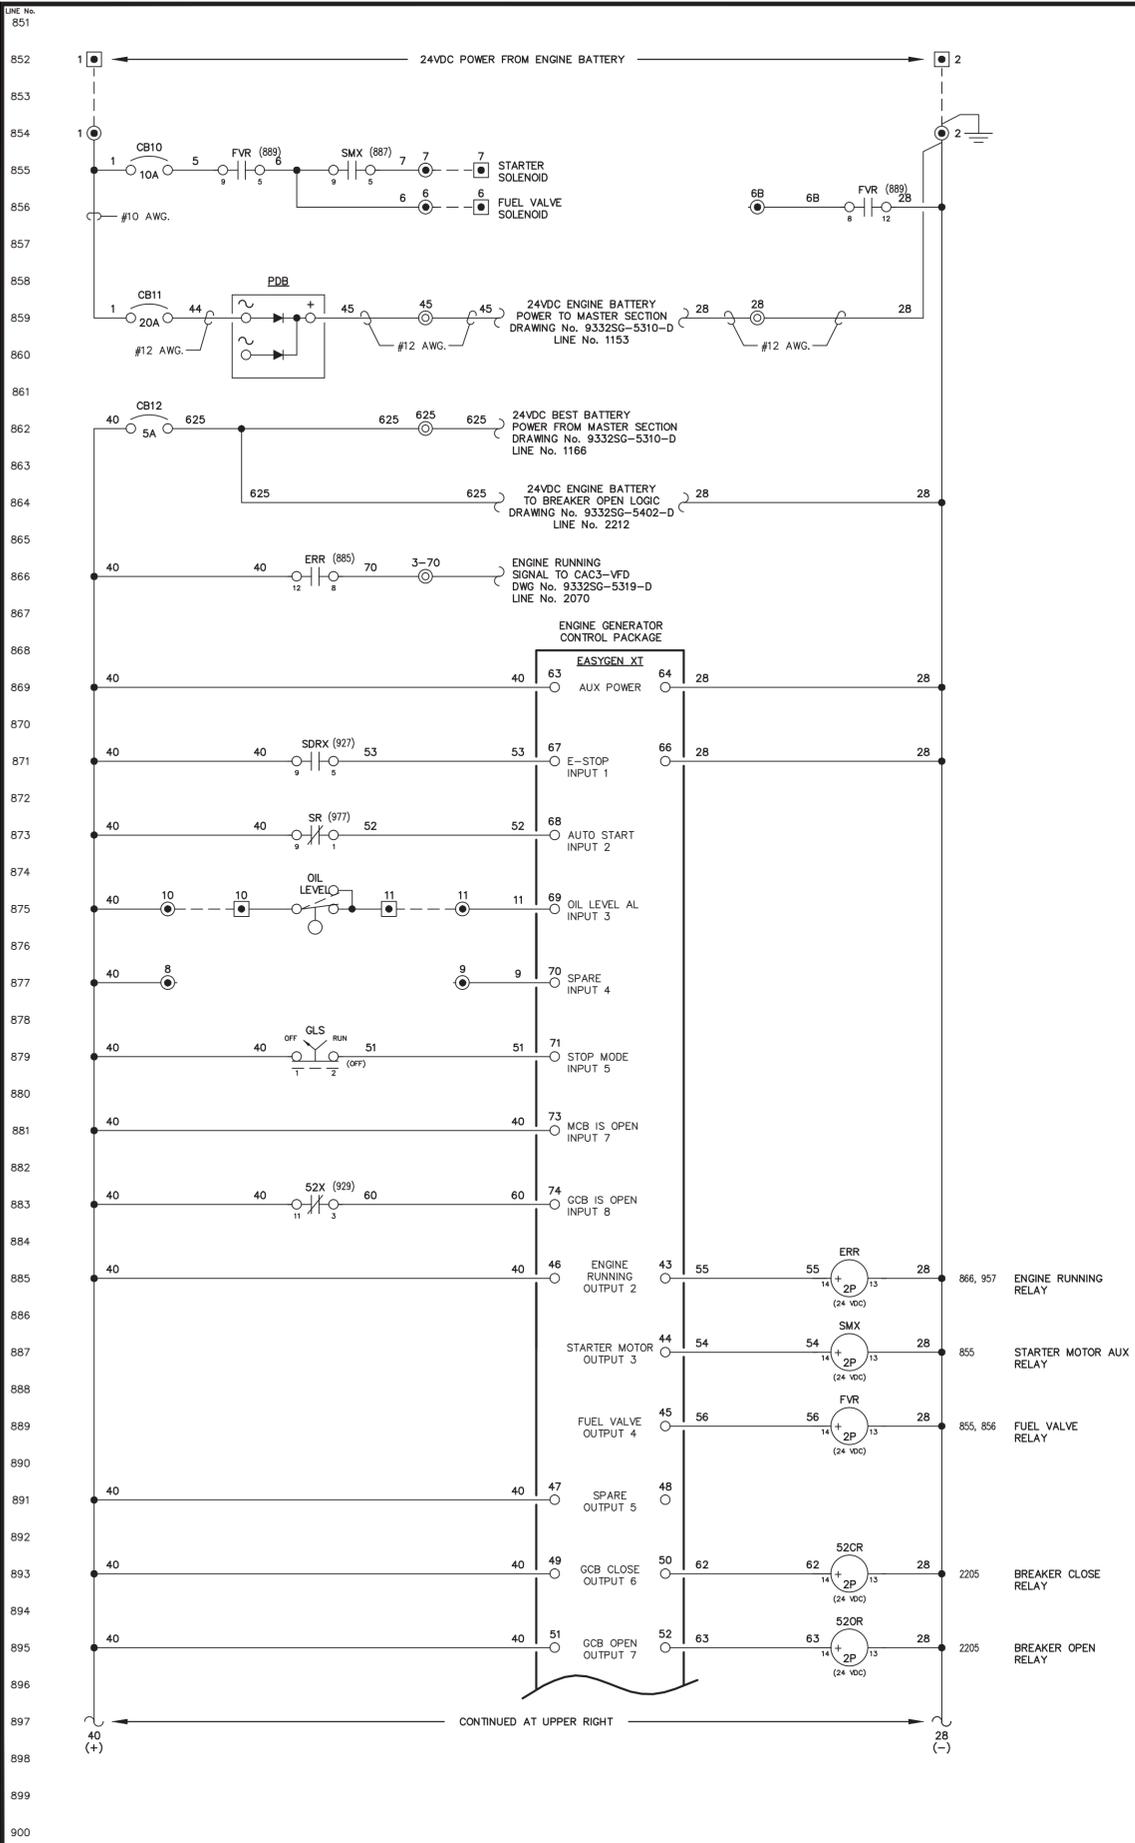

NOTICE
THE DRAWINGS, INFORMATION AND SUBJECT MATTER HEREOF ARE THE CONFIDENTIAL, SOLE AND EXCLUSIVE PROPERTY OF CONTROLLED POWER, INC., AND ARE NOT TO BE COPIED, REPRODUCED OR USED IN ANY MANNER FOR ANY PURPOSE WHATSOEVER WITHOUT WRITTEN CONSENT OR DIRECTION.

NOTE:
1. FOR GENERAL WIRING & CONSTRUCTION NOTES, SEE DRAWING No. 9332SG-3101-D.

D	09-18-24	SHOP AS BUILT	GJG
REV.	DATE	DESCRIPTION	BY
AEA PURCHASE ORDER No. P0010800		CONTROLLED POWER JOB No. 9332SG	
TITLE: GENERATOR 3 DC CONTROL, SCHEMATIC DIAGRAM			
SCALE: NONE	DATE: 11-29-23	DWN. BY: GPN	
DWG. No: 9332SG-5307-D	SHEET: 1 OF 1	CKD. BY: JMD	
JOB: MANOKOTAK POWER SYSTEM UPGRADE			
		RURAL ENERGY GROUP 813 W. NORTHERN LIGHTS BLVD. ANCHORAGE, ALASKA 99503 HTTP://WWW.AIDEA.ORG	
		ENGINEERED & MANUFACTURED BY Controlled Power, Inc. BOTHELL, WASHINGTON USA (425)-485-1778 www.controlledpowerinc.com	

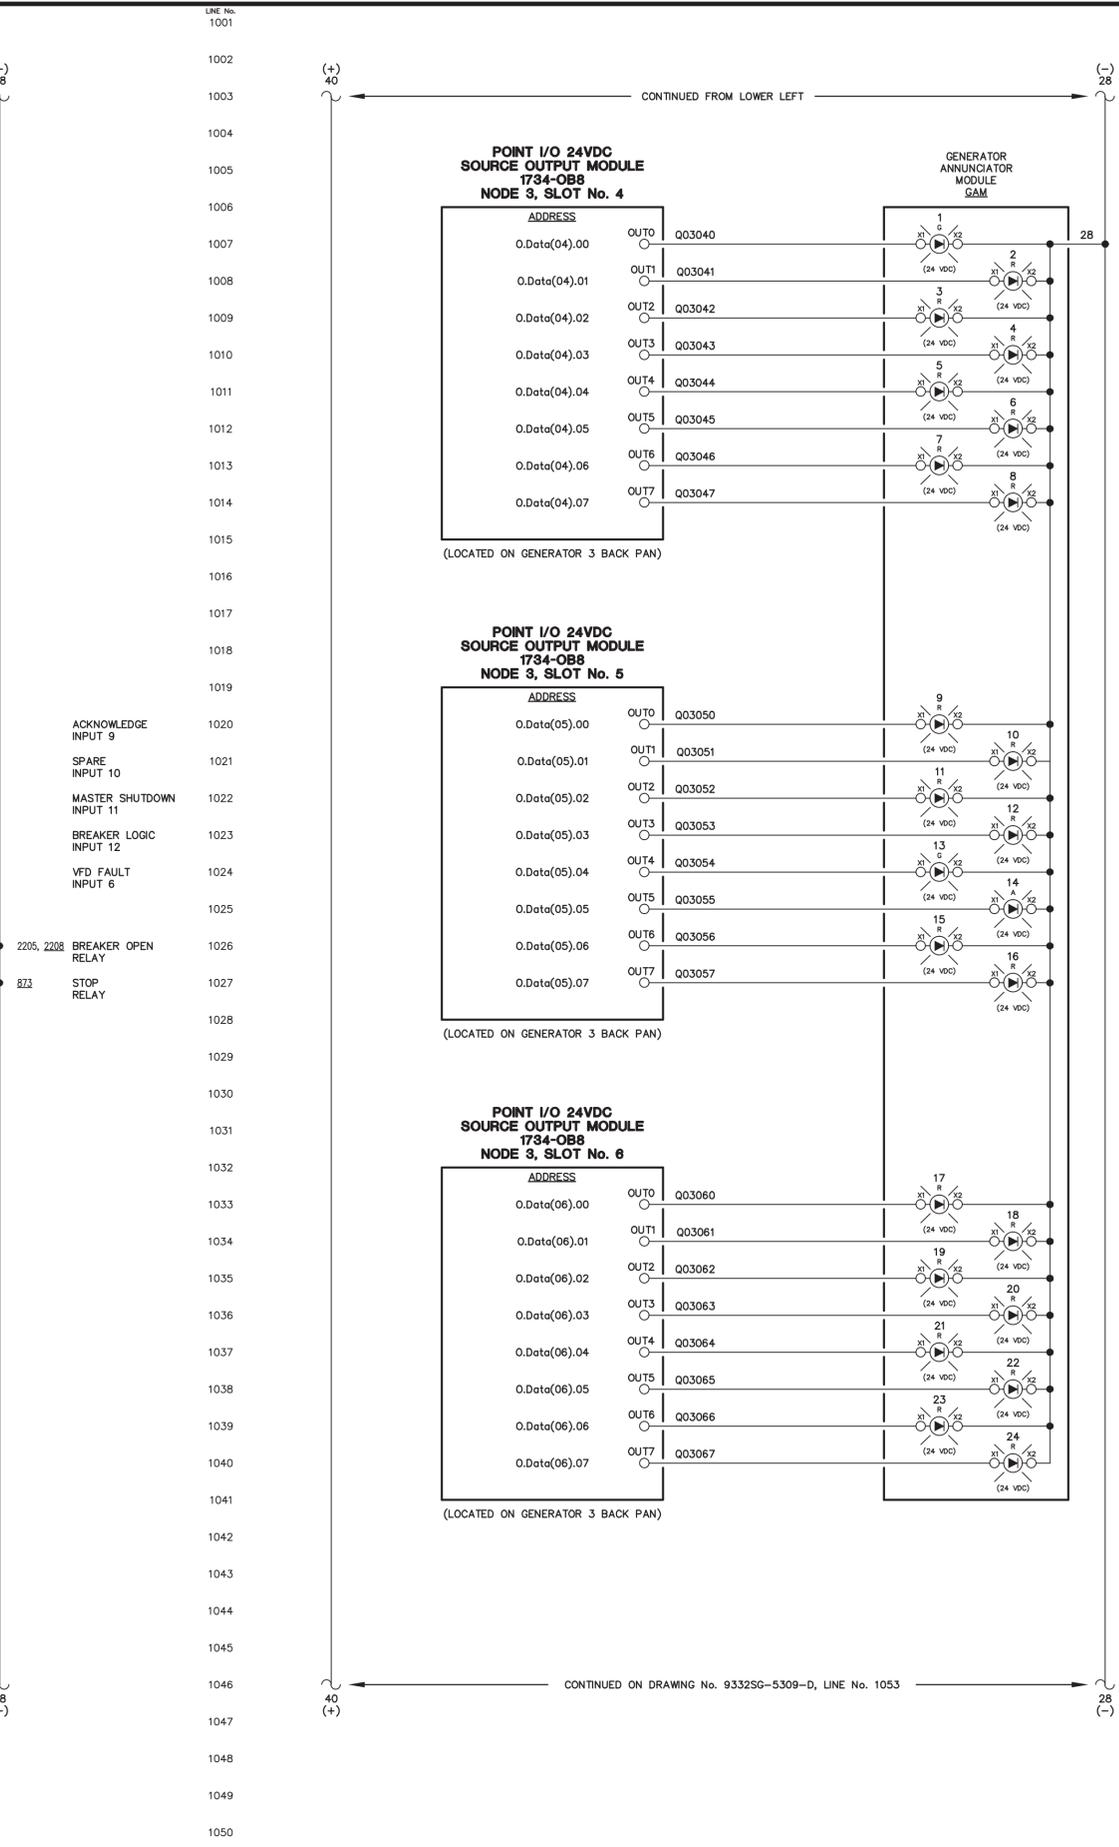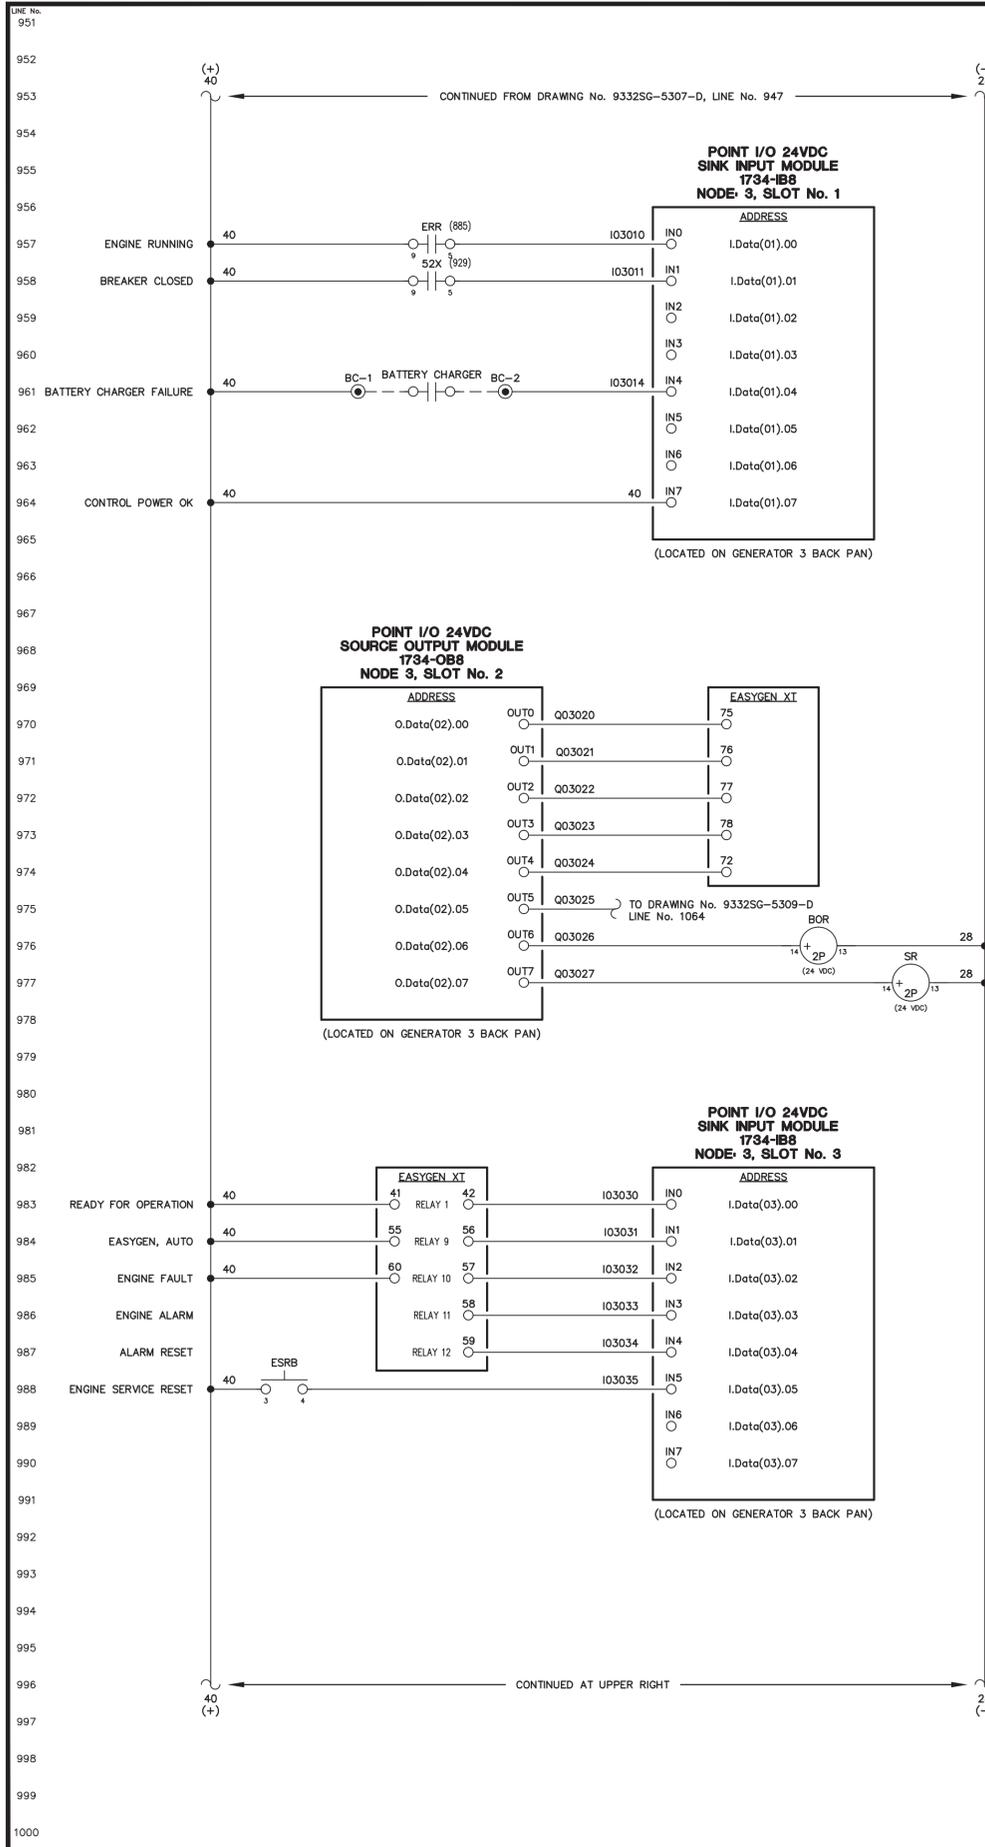

CONTINUED FROM LOWER LEFT

CONTINUED ON DRAWING No. 9332SG-5308-D, LINE No. 1053

CONTINUED AT UPPER RIGHT

CONTINUED FROM DRAWING No. 9332SG-5307-D, LINE No. 947

NOTE:
1. FOR GENERAL WIRING & CONSTRUCTION NOTES, SEE DRAWING No. 9332SG-3101-D.

REV.	DATE	DESCRIPTION	BY
D	09-18-24	SHOP AS BUILT	G/JG

AEA PURCHASE ORDER No. P0010800 CONTROLLED POWER JOB No. 9332SG

TITLE: GENERATOR 3 DC CONTROL, SCHEMATIC DIAGRAM

SCALE: NONE DATE: 11-29-23 DWN. BY: GPN

DWG. No: 9332SG-5308-D SHEET: 1 OF 1 CKD. BY: JMD

JOB: MANOKOTAK POWER SYSTEM UPGRADE


ALASKA ENERGY AUTHORITY
RURAL ENERGY GROUP
813 W. NORTHERN LIGHTS BLVD.
ANCHORAGE, ALASKA 99503
HTTP://WWW.AIDEA.ORG

ENGINEERED & MANUFACTURED BY
Controlled Power, Inc.
BOTHELL, WASHINGTON USA
(425)-485-1778 www.controlleddpowerinc.com

NOTICE
THE DRAWINGS, INFORMATION AND SUBJECT MATTER HEREOF ARE THE CONFIDENTIAL, SOLE AND EXCLUSIVE PROPERTY OF CONTROLLED POWER, INC., AND ARE NOT TO BE COPIED, REPRODUCED OR USED IN ANY MANNER FOR ANY PURPOSE WHATSOEVER WITHOUT WRITTEN CONSENT OR DIRECTION.

LINE No.
1051
1052
1053
LINE No.
1101
1102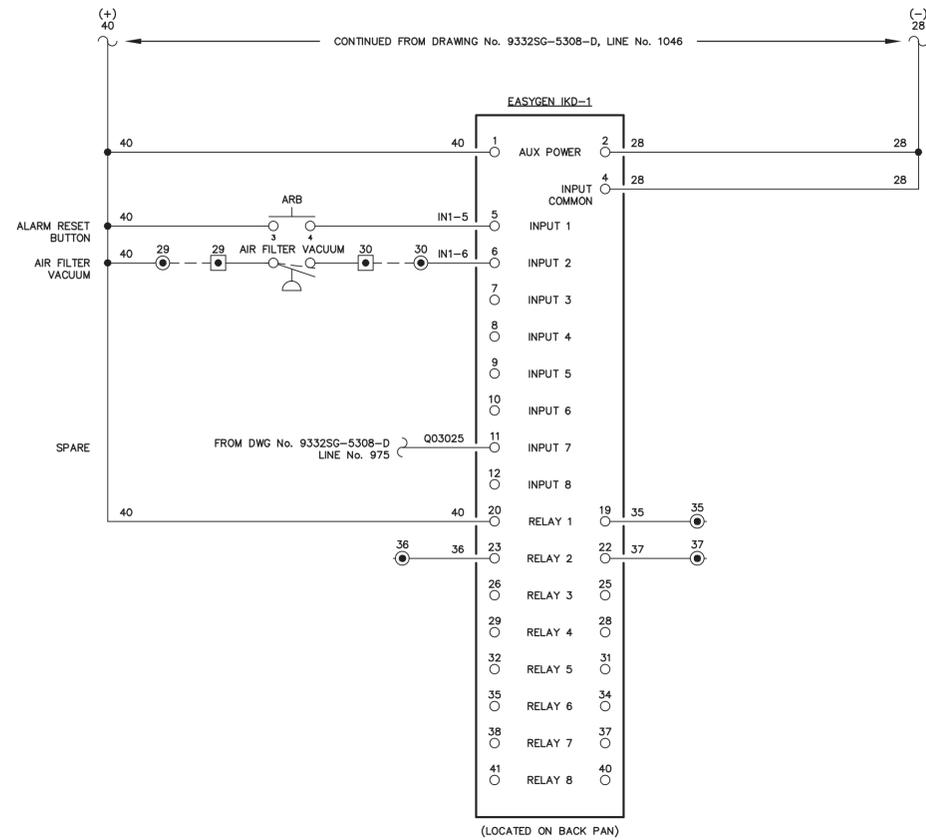
- NOTE:**
1. FOR GENERAL WIRING & CONSTRUCTION NOTES, SEE DRAWING No. 9332SG-3101-D.

D	09-18-24	SHOP AS BUILT	GJG
REV.	DATE	DESCRIPTION	BY
AEA PURCHASE ORDER No. P0010800		CONTROLLED POWER JOB No. 9332SG	
TITLE: GENERATOR 3 DC CONTROL, SCHEMATIC DIAGRAM			
SCALE: NONE	DATE: 11-29-23	DWN. BY: GPN	
DWG. No: 9332SG-5309-D	SHEET: 1 OF 1	CKD. BY: JMD	
JOB: MANOKOTAK POWER SYSTEM UPGRADE			

ALASKA ENERGY AUTHORITY
RURAL ENERGY GROUP
813 W. NORTHERN LIGHTS BLVD.
ANCHORAGE, ALASKA 99503
HTTP://WWW.AIDEA.ORG

NOTICE
THE DRAWINGS, INFORMATION AND SUBJECT MATTER HEREOF ARE THE CONFIDENTIAL, SOLE AND EXCLUSIVE PROPERTY OF CONTROLLED POWER, INC. AND ARE NOT TO BE COPIED, REPRODUCED OR USED IN ANY MANNER FOR ANY PURPOSE WHATSOEVER WITHOUT WRITTEN CONSENT OR DIRECTION.

Controlled Power, Inc.
ENGINEERED & MANUFACTURED BY
BOTHHELL, WASHINGTON USA
(425)-485-1778 www.controlledpowerinc.com

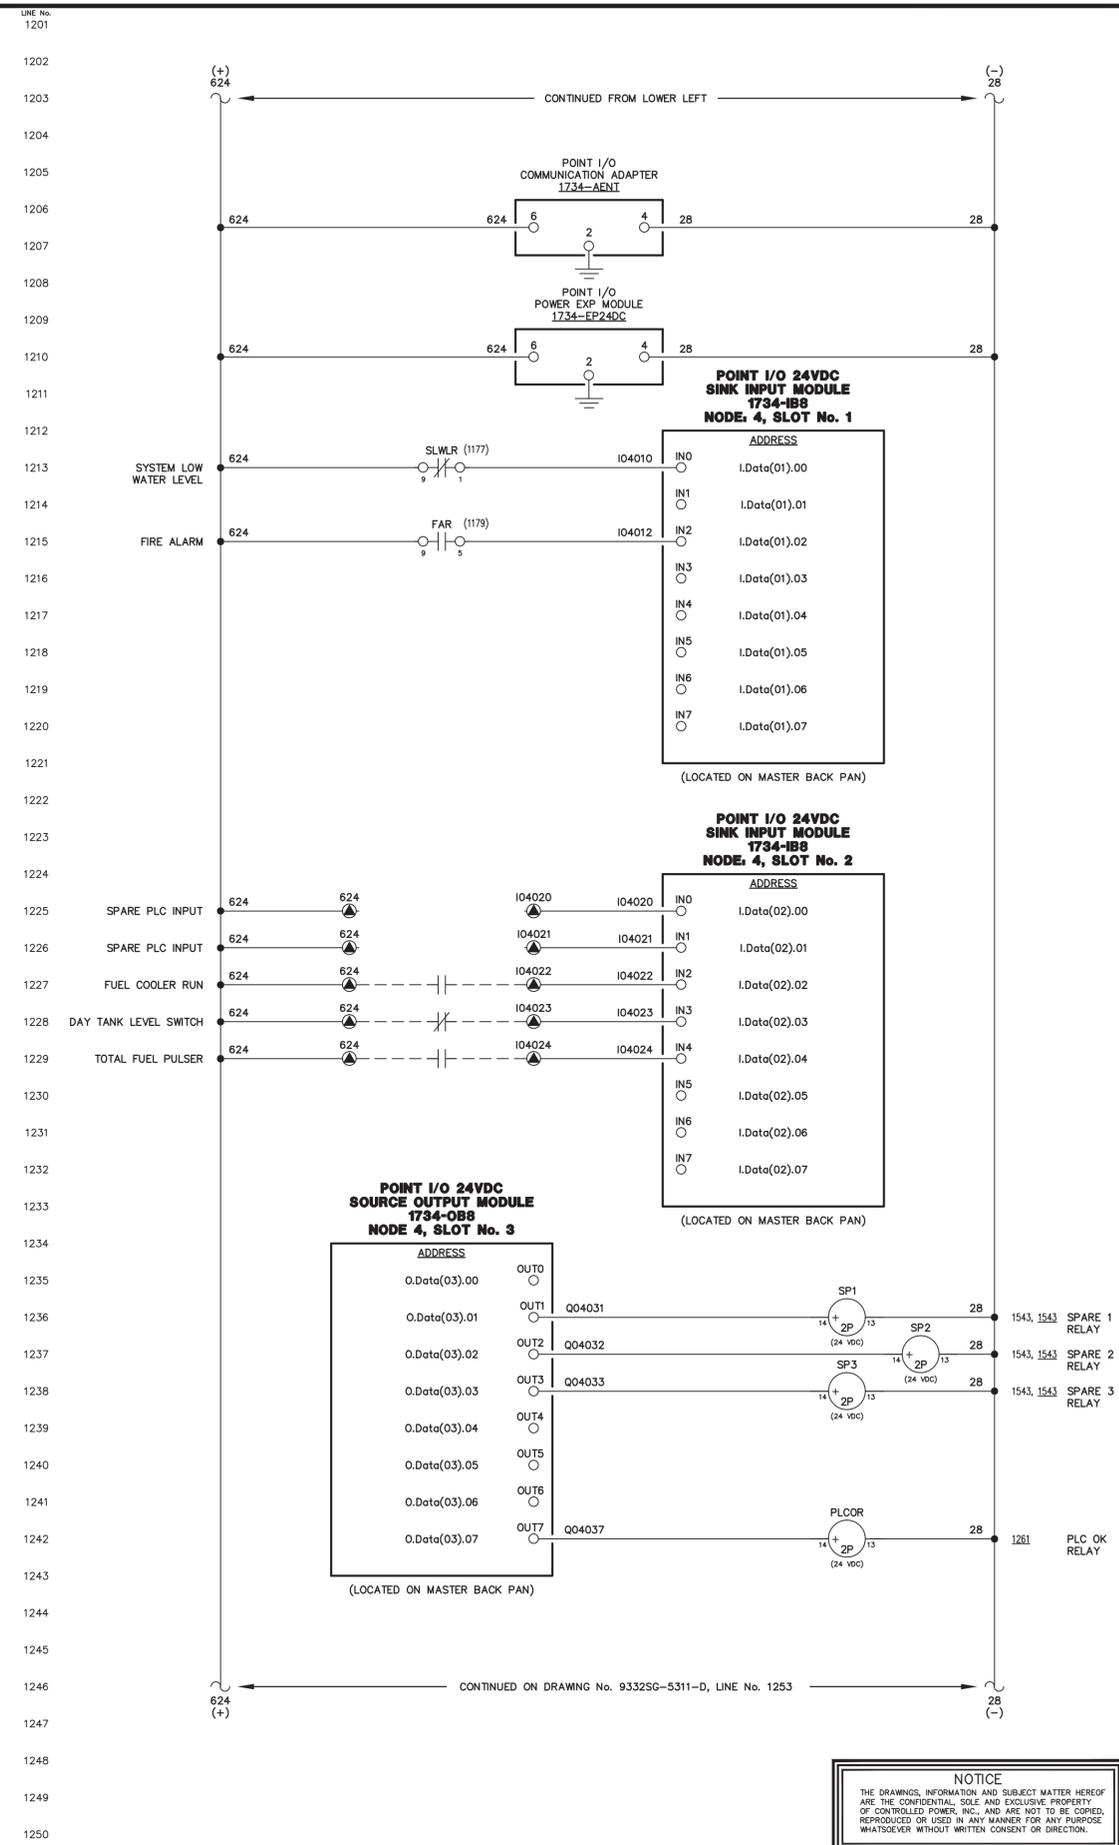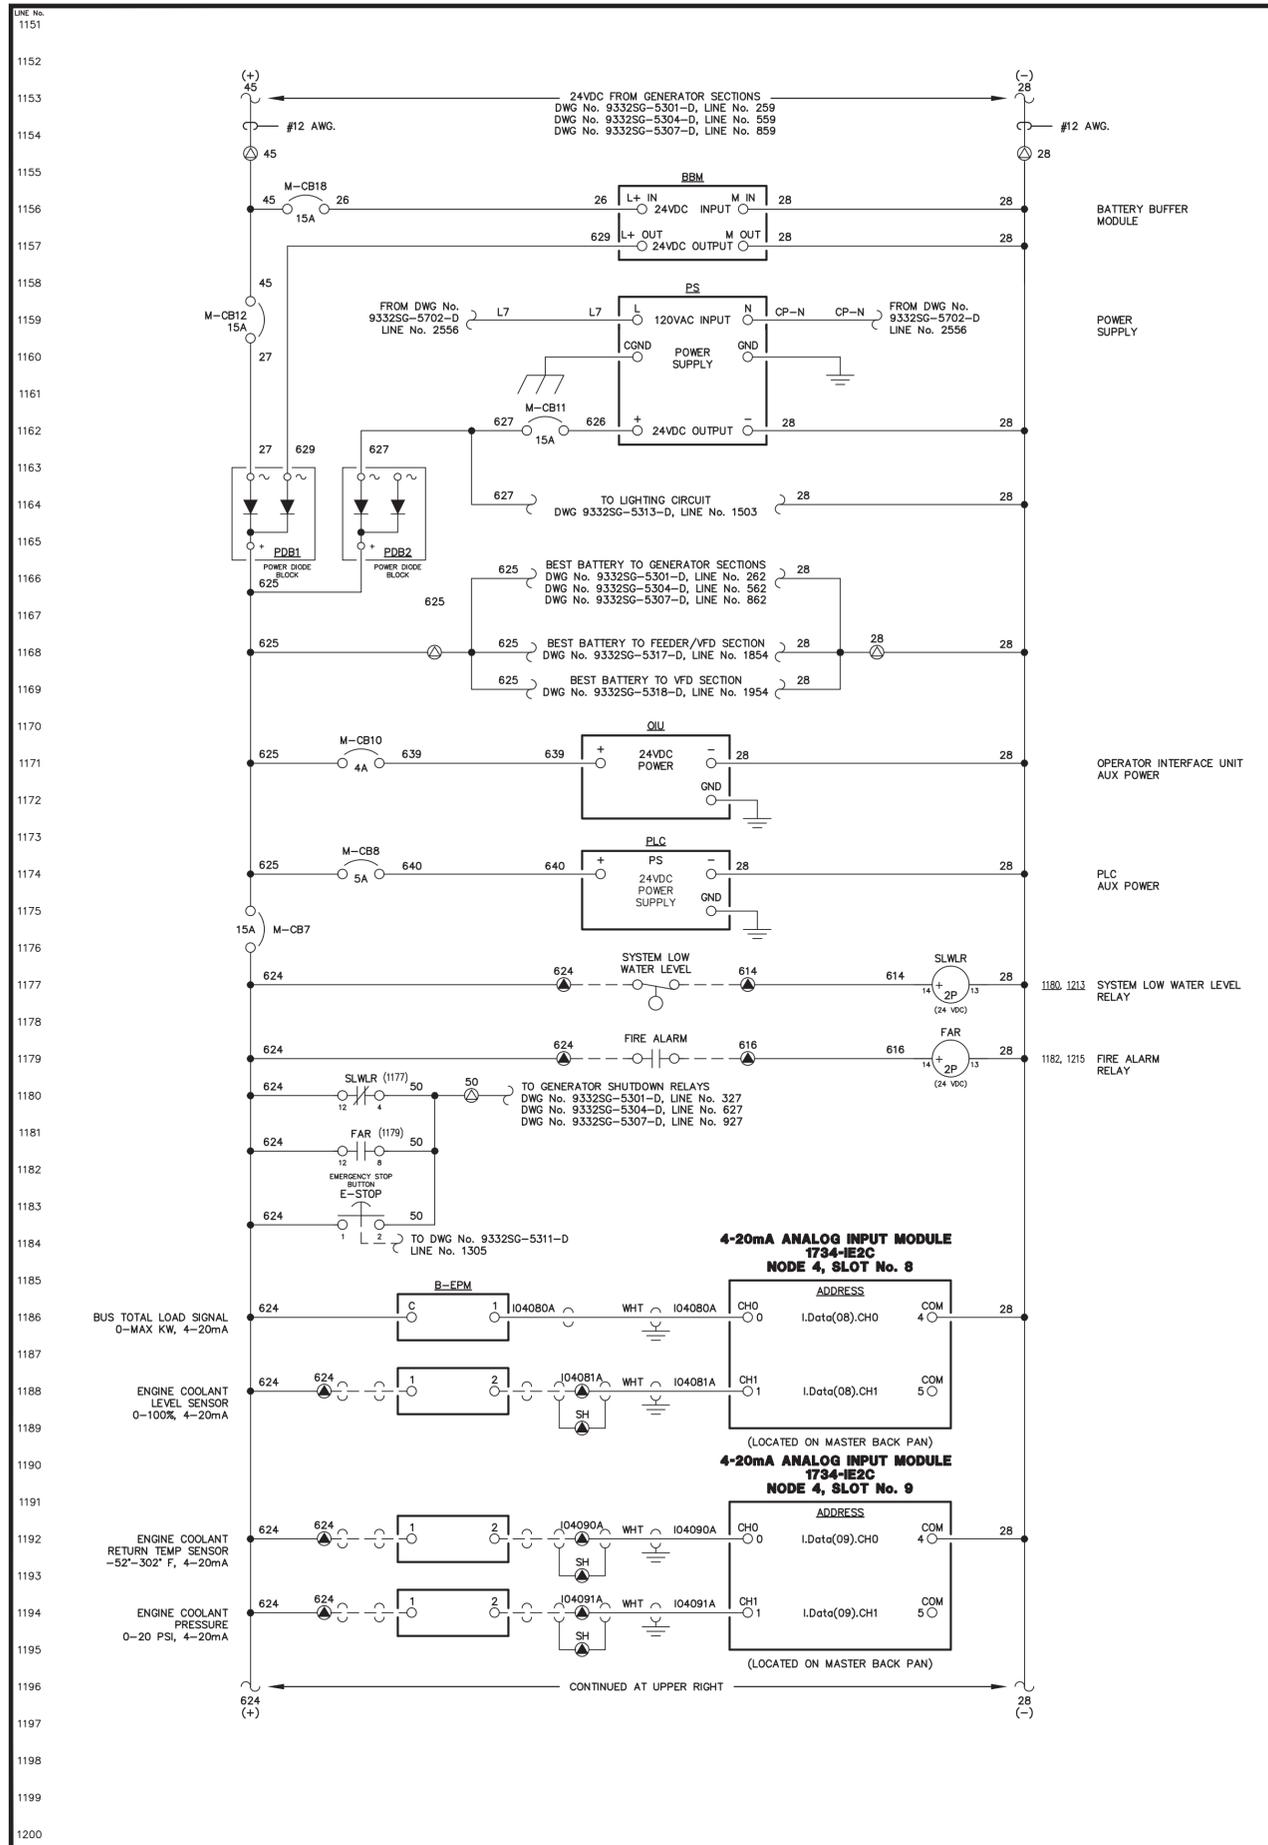




NOTE:
 1. FOR GENERAL WIRING & CONSTRUCTION NOTES, SEE DRAWING No. 9332SG-3101-D.

D	09-18-24	SHOP AS BUILT	GJG
REV.	DATE	DESCRIPTION	BY
AEA PURCHASE ORDER No. P0010800		CONTROLLED POWER JOB No. 9332SG	
TITLE: MASTER DC CONTROL, SCHEMATIC DIAGRAM			
SCALE: NONE	DATE: 11-29-23	DWN. BY: GPN	
DWG. No: 9332SG-5310-D	SHEET: 1 OF 1	CKD. BY: JMD	
JOB: MANOKOTAK POWER SYSTEM UPGRADE			

ALASKA ENERGY AUTHORITY
 RURAL ENERGY GROUP
 813 W. NORTHERN LIGHTS BLVD.
 ANCHORAGE, ALASKA 99503
 HTTP://WWW.AIDEA.ORG

ENGINEERED & MANUFACTURED BY
Controlled Power, Inc.
 BOTHELL, WASHINGTON USA
 (425)-485-1778 www.controlleddpowerinc.com

NOTICE
 THE DRAWINGS, INFORMATION AND SUBJECT MATTER HEREOF ARE THE CONFIDENTIAL, SOLE AND EXCLUSIVE PROPERTY OF CONTROLLED POWER, INC., AND ARE NOT TO BE COPIED, REPRODUCED OR USED IN ANY MANNER FOR ANY PURPOSE WHATSOEVER WITHOUT WRITTEN CONSENT OR DIRECTION.

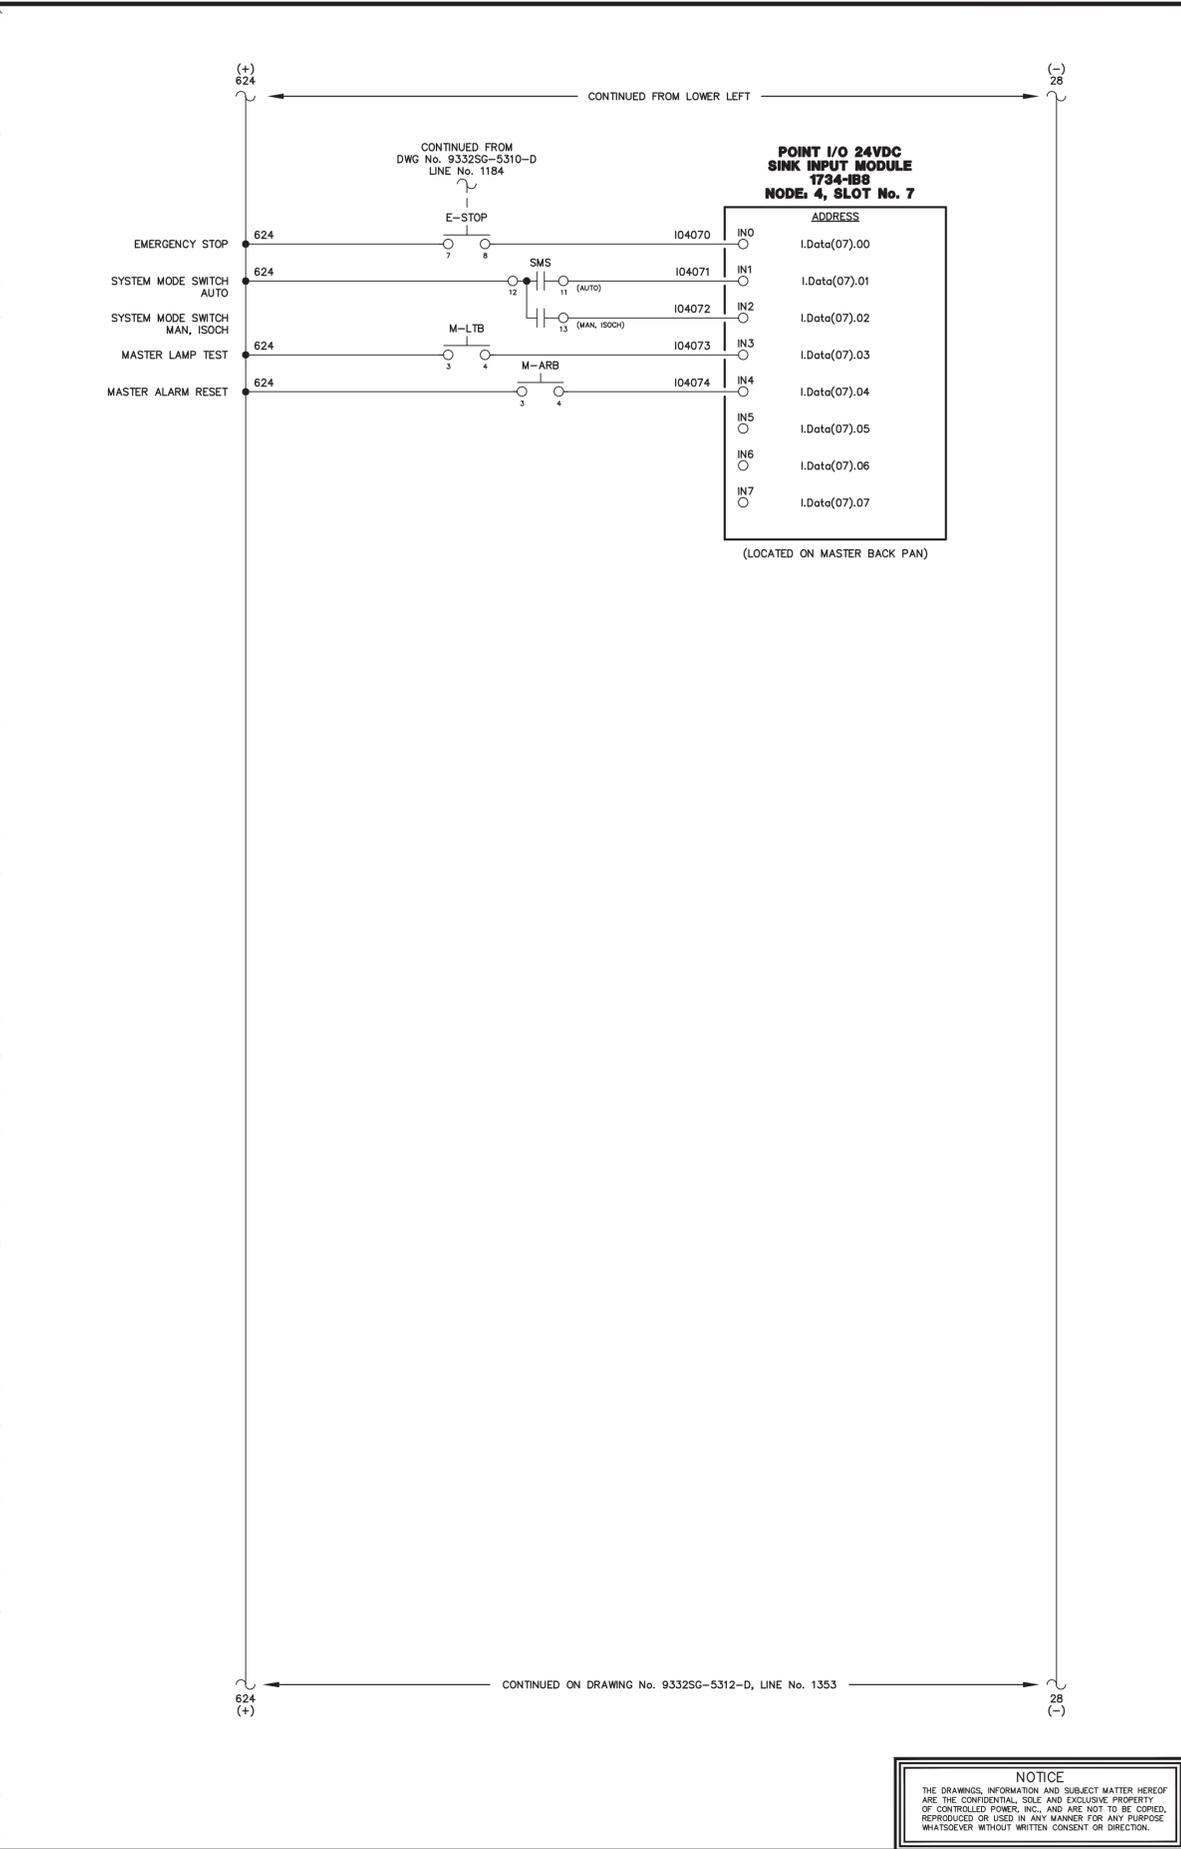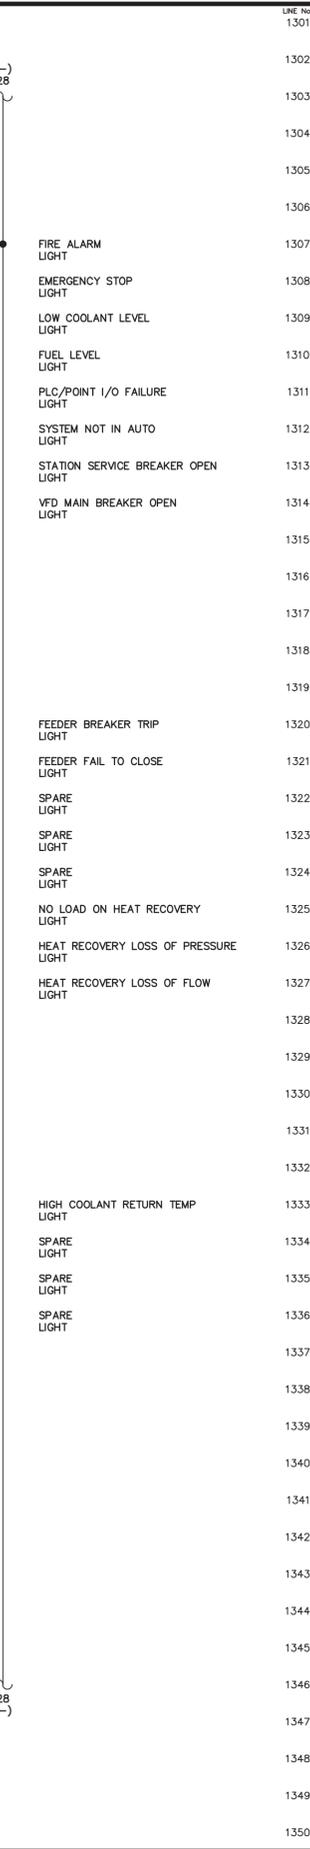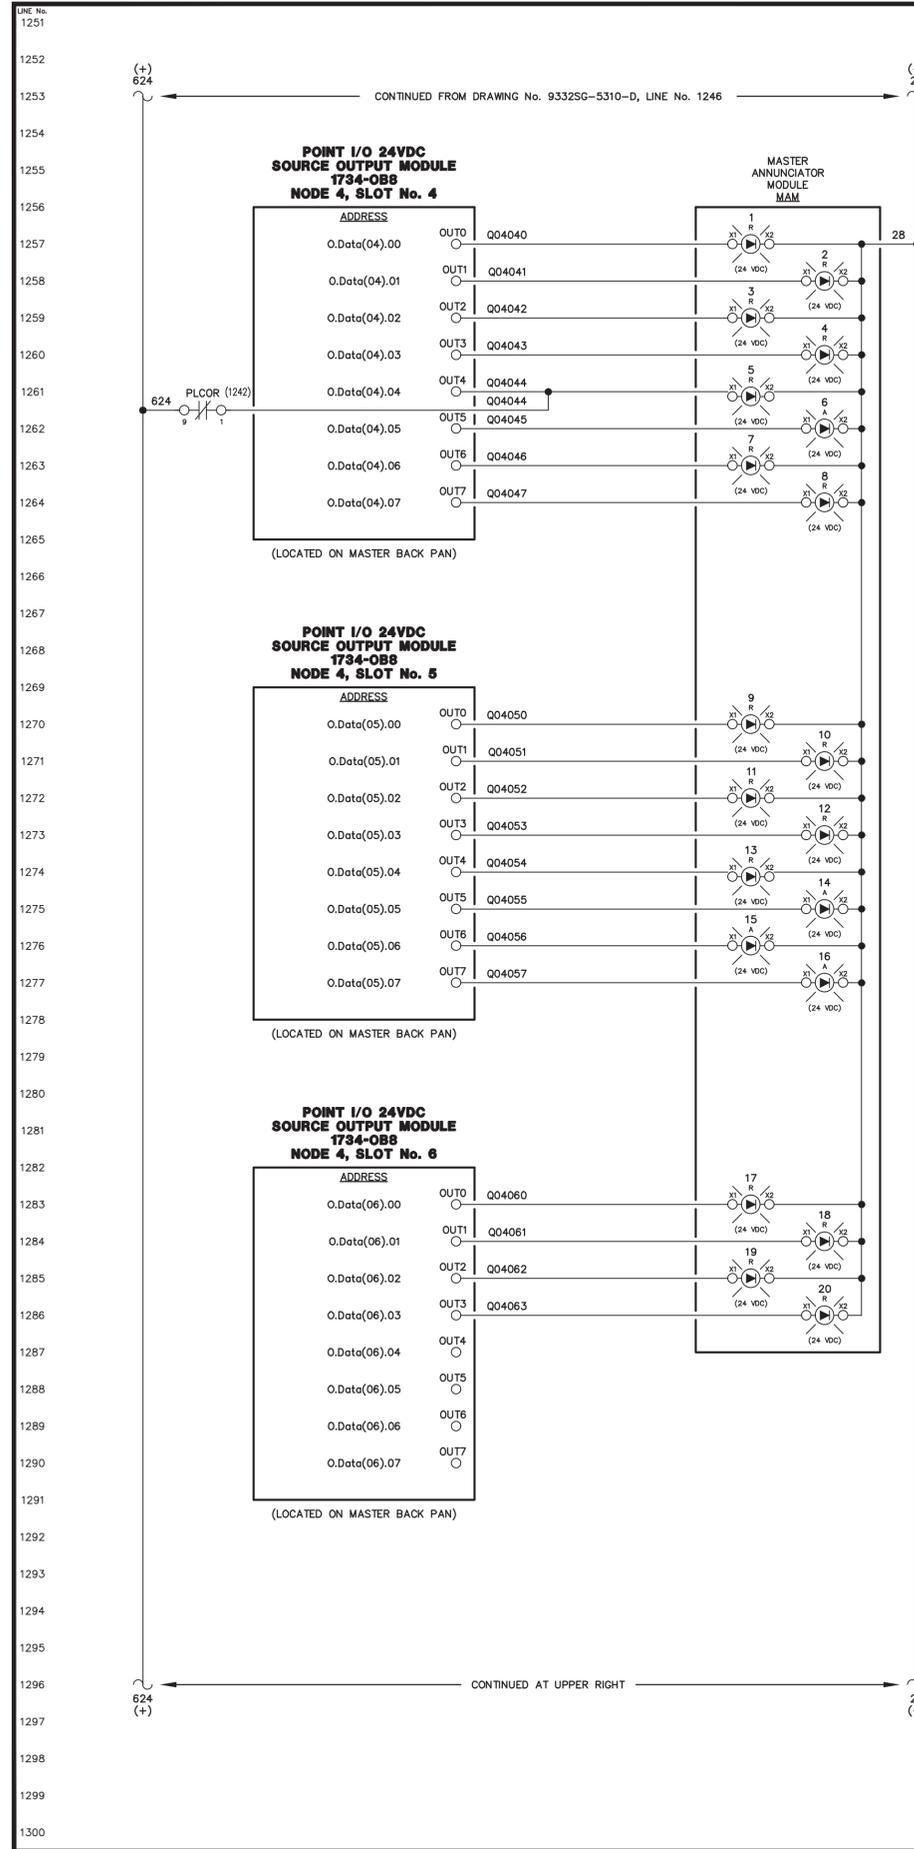



NOTE:
1. FOR GENERAL WIRING & CONSTRUCTION NOTES, SEE DRAWING No. 9332SG-3101-D.

D	09-18-24	SHOP AS BUILT	GJG
REV.	DATE	DESCRIPTION	BY
AEA PURCHASE ORDER No. P0010800		CONTROLLED POWER JOB No. 9332SG	
TITLE: MASTER DC CONTROL, SCHEMATIC DIAGRAM			
SCALE: NONE	DATE: 11-29-23	DWN. BY: GPN	
DWG. No: 9332SG-5311-D	SHEET: 1 OF 1	CKD. BY: JMD	
JOB: MANOKOTAK POWER SYSTEM UPGRADE			

ALASKA ENERGY AUTHORITY
RURAL ENERGY GROUP
813 W. NORTHERN LIGHTS BLVD.
ANCHORAGE, ALASKA 99503
HTTP://WWW.AIDEA.ORG

ENGINEERED & MANUFACTURED BY
Controlled Power, Inc.
BOTHELL, WASHINGTON USA
(425)-485-1778 www.controlleddpowerinc.com

NOTICE
THE DRAWINGS, INFORMATION AND SUBJECT MATTER HEREOF ARE THE CONFIDENTIAL, SOLE AND EXCLUSIVE PROPERTY OF CONTROLLED POWER, INC., AND ARE NOT TO BE COPIED, REPRODUCED OR USED IN ANY MANNER FOR ANY PURPOSE WHATSOEVER WITHOUT WRITTEN CONSENT OR DIRECTION.

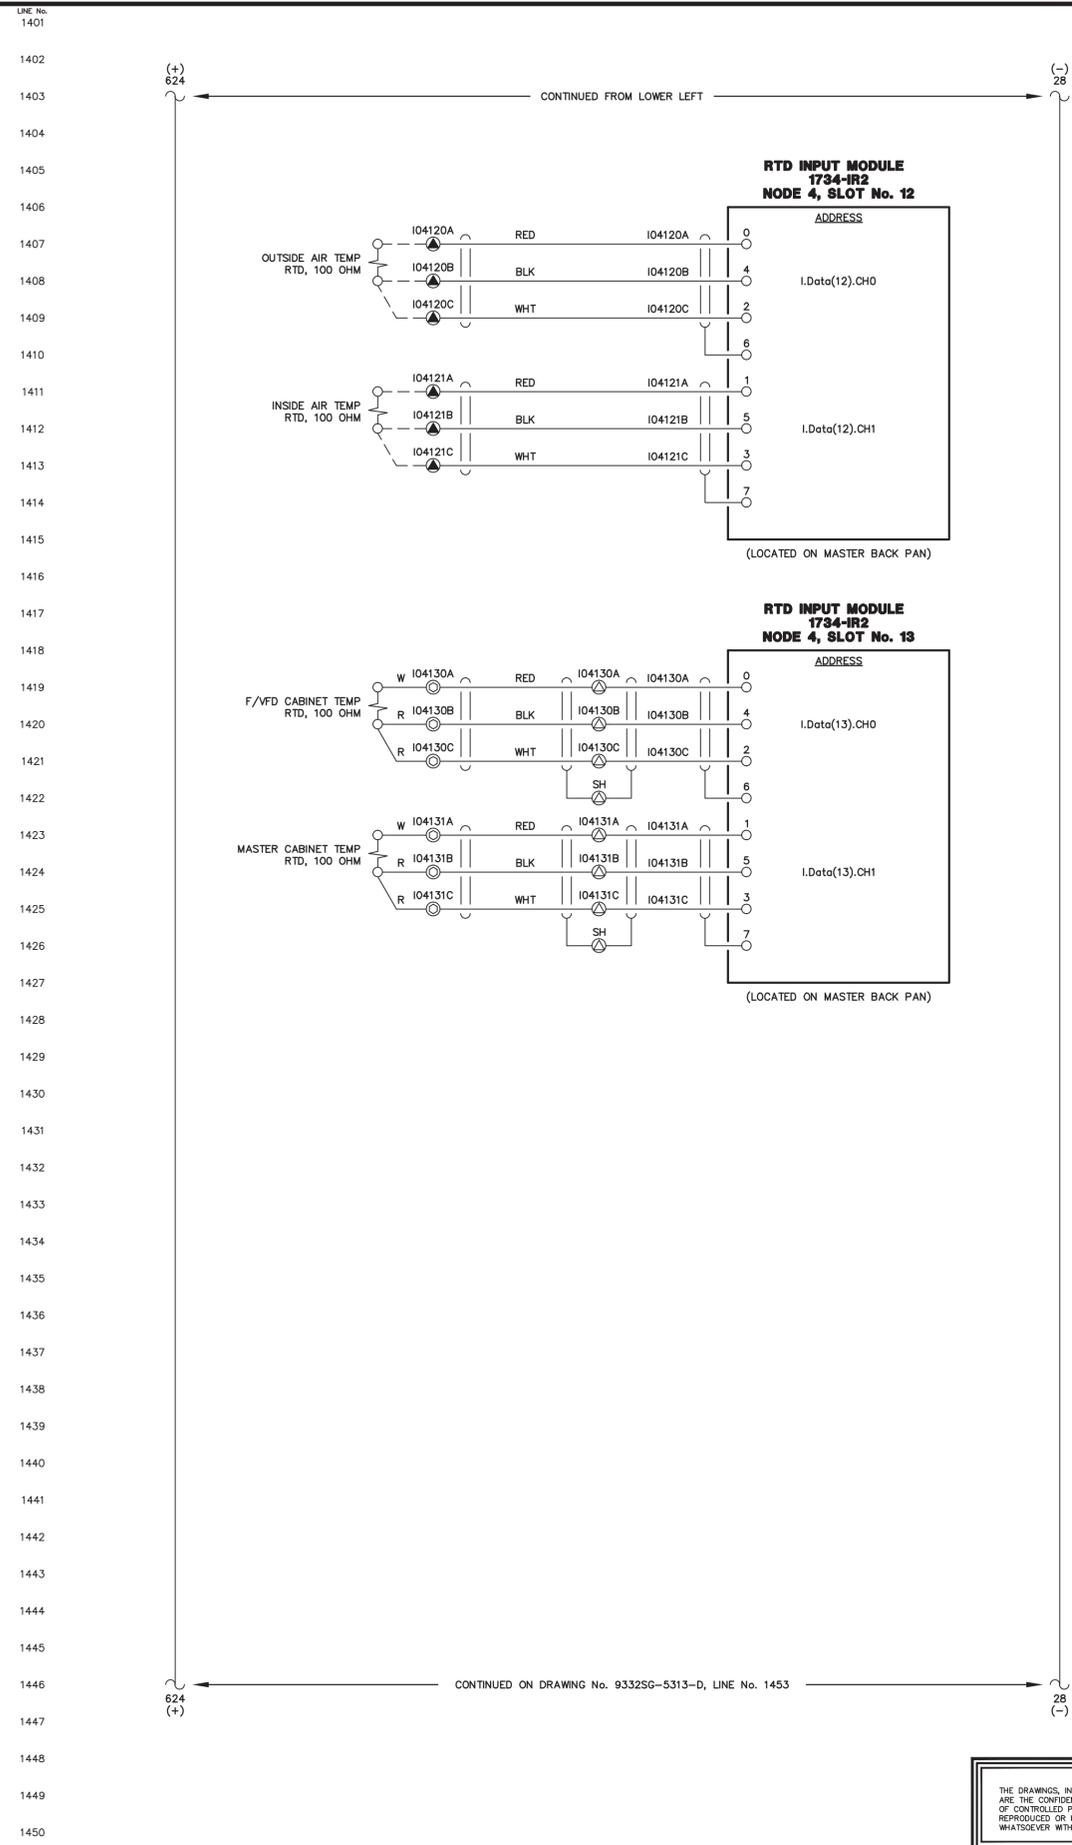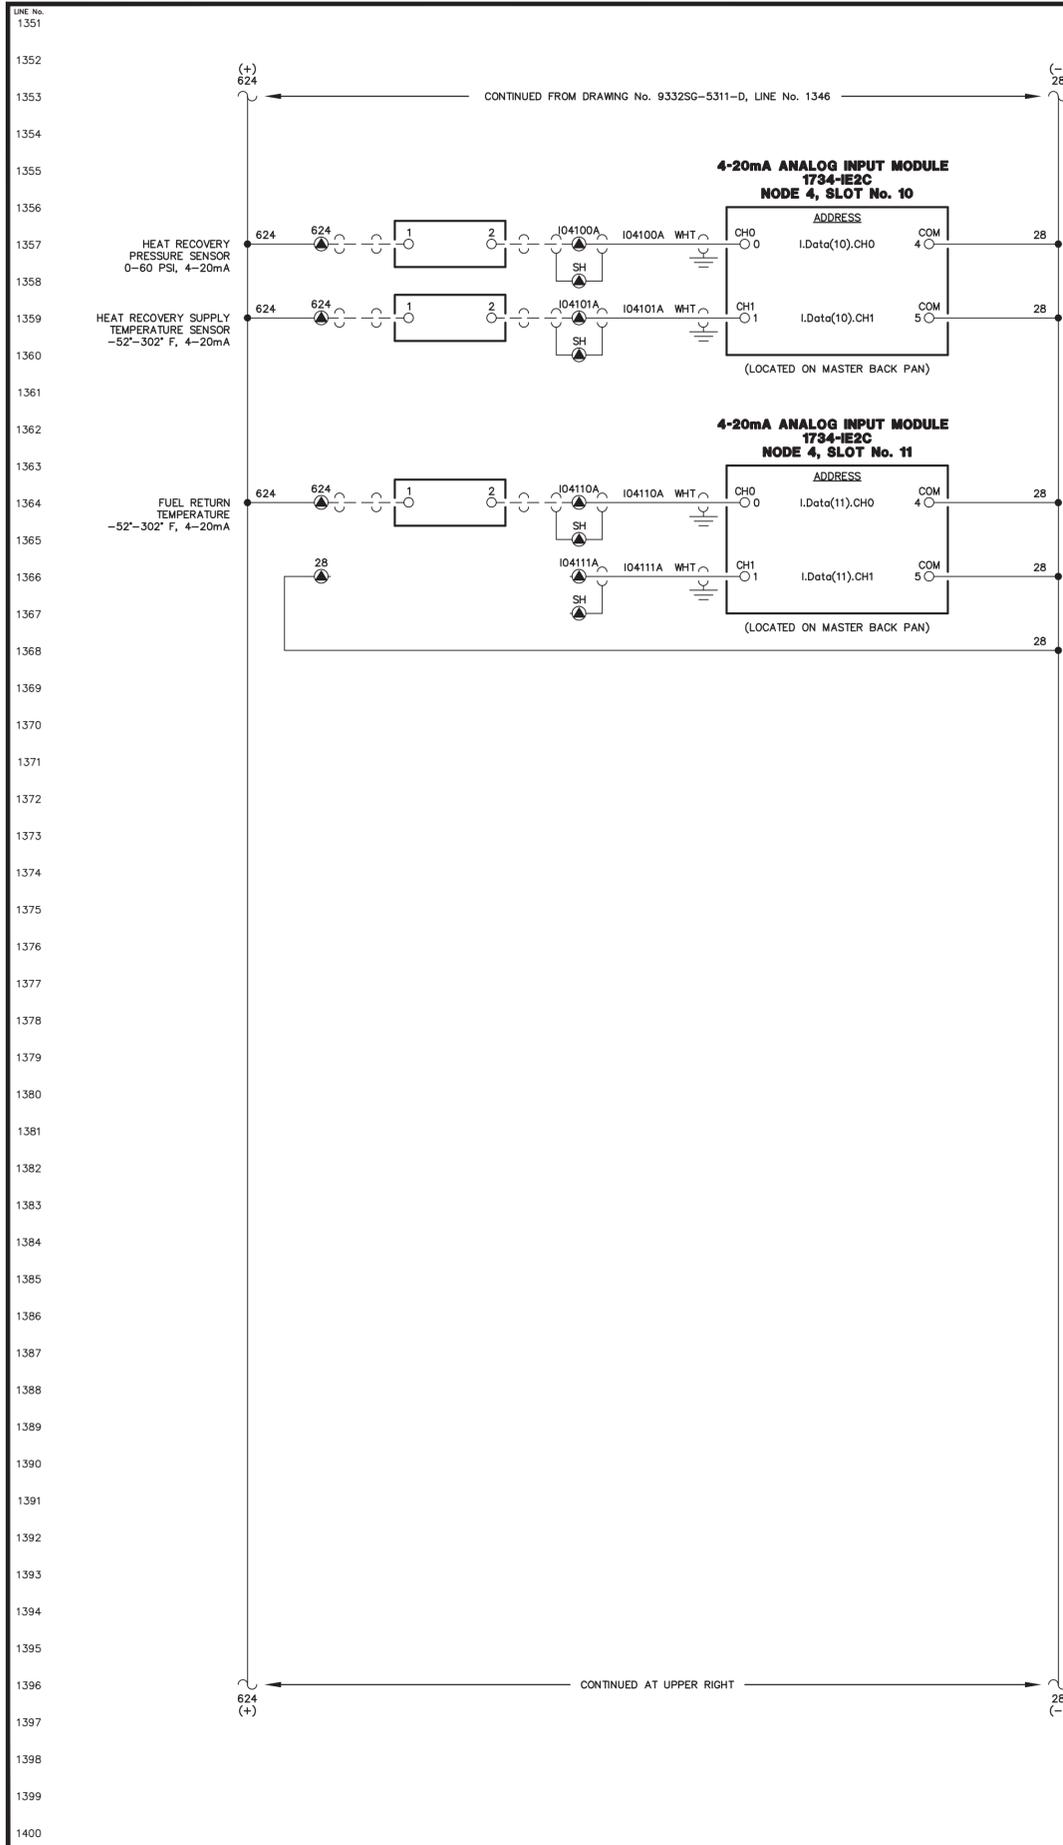



NOTE:
1. FOR GENERAL WIRING & CONSTRUCTION NOTES, SEE DRAWING No. 9332SG-3101-D.

REV.	DATE	DESCRIPTION	BY
D	09-18-24	SHOP AS BUILT	GJG
AEA PURCHASE ORDER No. P0010800		CONTROLLED POWER JOB No. 9332SG	
TITLE: MASTER DC CONTROL, SCHEMATIC DIAGRAM			
SCALE: NONE	DATE: 11-29-23	DWN. BY: GPN	
DWG. No: 9332SG-5312-D	SHEET: 1 OF 1	CKD. BY: JMD	
JOB: MANOKOTAK POWER SYSTEM UPGRADE			

ALASKA ENERGY AUTHORITY
RURAL ENERGY GROUP
813 W. NORTHERN LIGHTS BLVD.
ANCHORAGE, ALASKA 99503
HTTP://WWW.AIDEA.ORG

ENGINEERED & MANUFACTURED BY
Controlled Power, Inc.
BOTHELL, WASHINGTON USA
(425)-485-1778 www.controlleddpowerinc.com

NOTICE
THE DRAWINGS, INFORMATION AND SUBJECT MATTER HEREOF ARE THE CONFIDENTIAL, SOLE AND EXCLUSIVE PROPERTY OF CONTROLLED POWER, INC., AND ARE NOT TO BE COPIED, REPRODUCED OR USED IN ANY MANNER FOR ANY PURPOSE WHATSOEVER WITHOUT WRITTEN CONSENT OR DIRECTION.

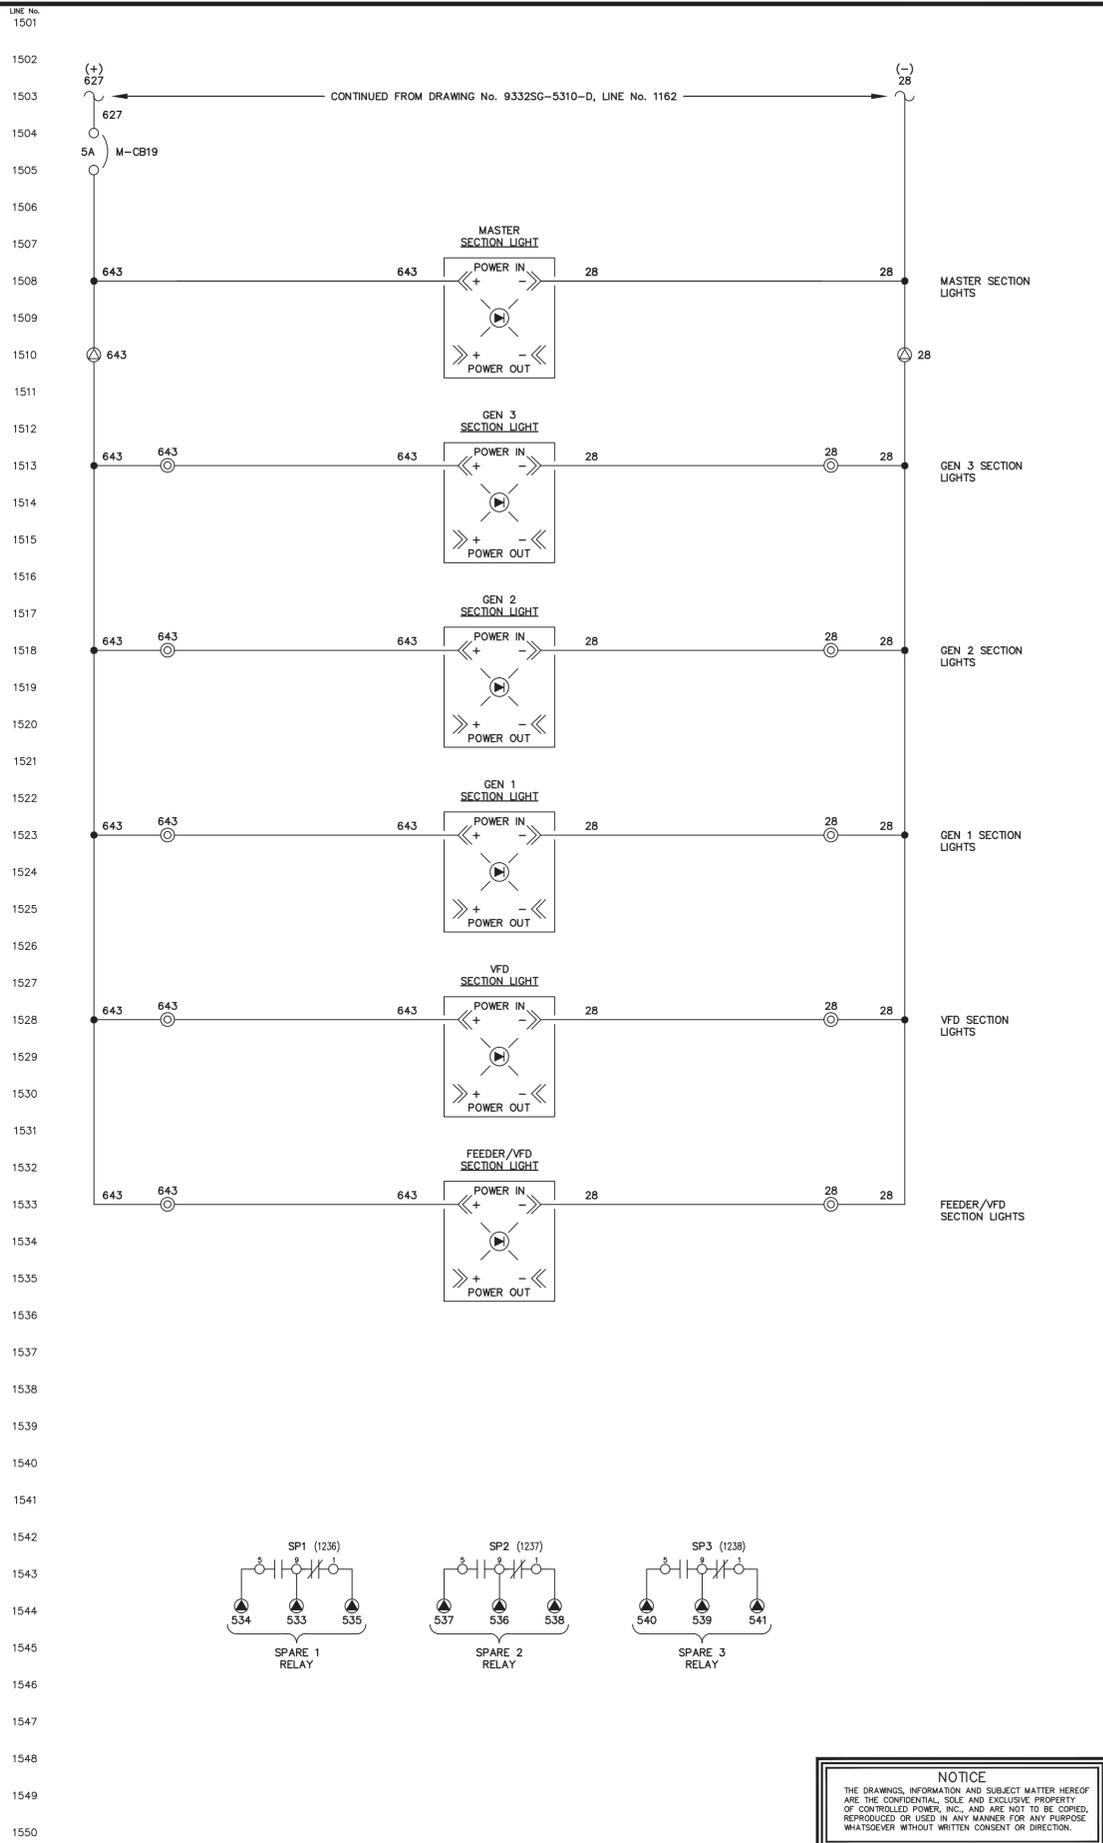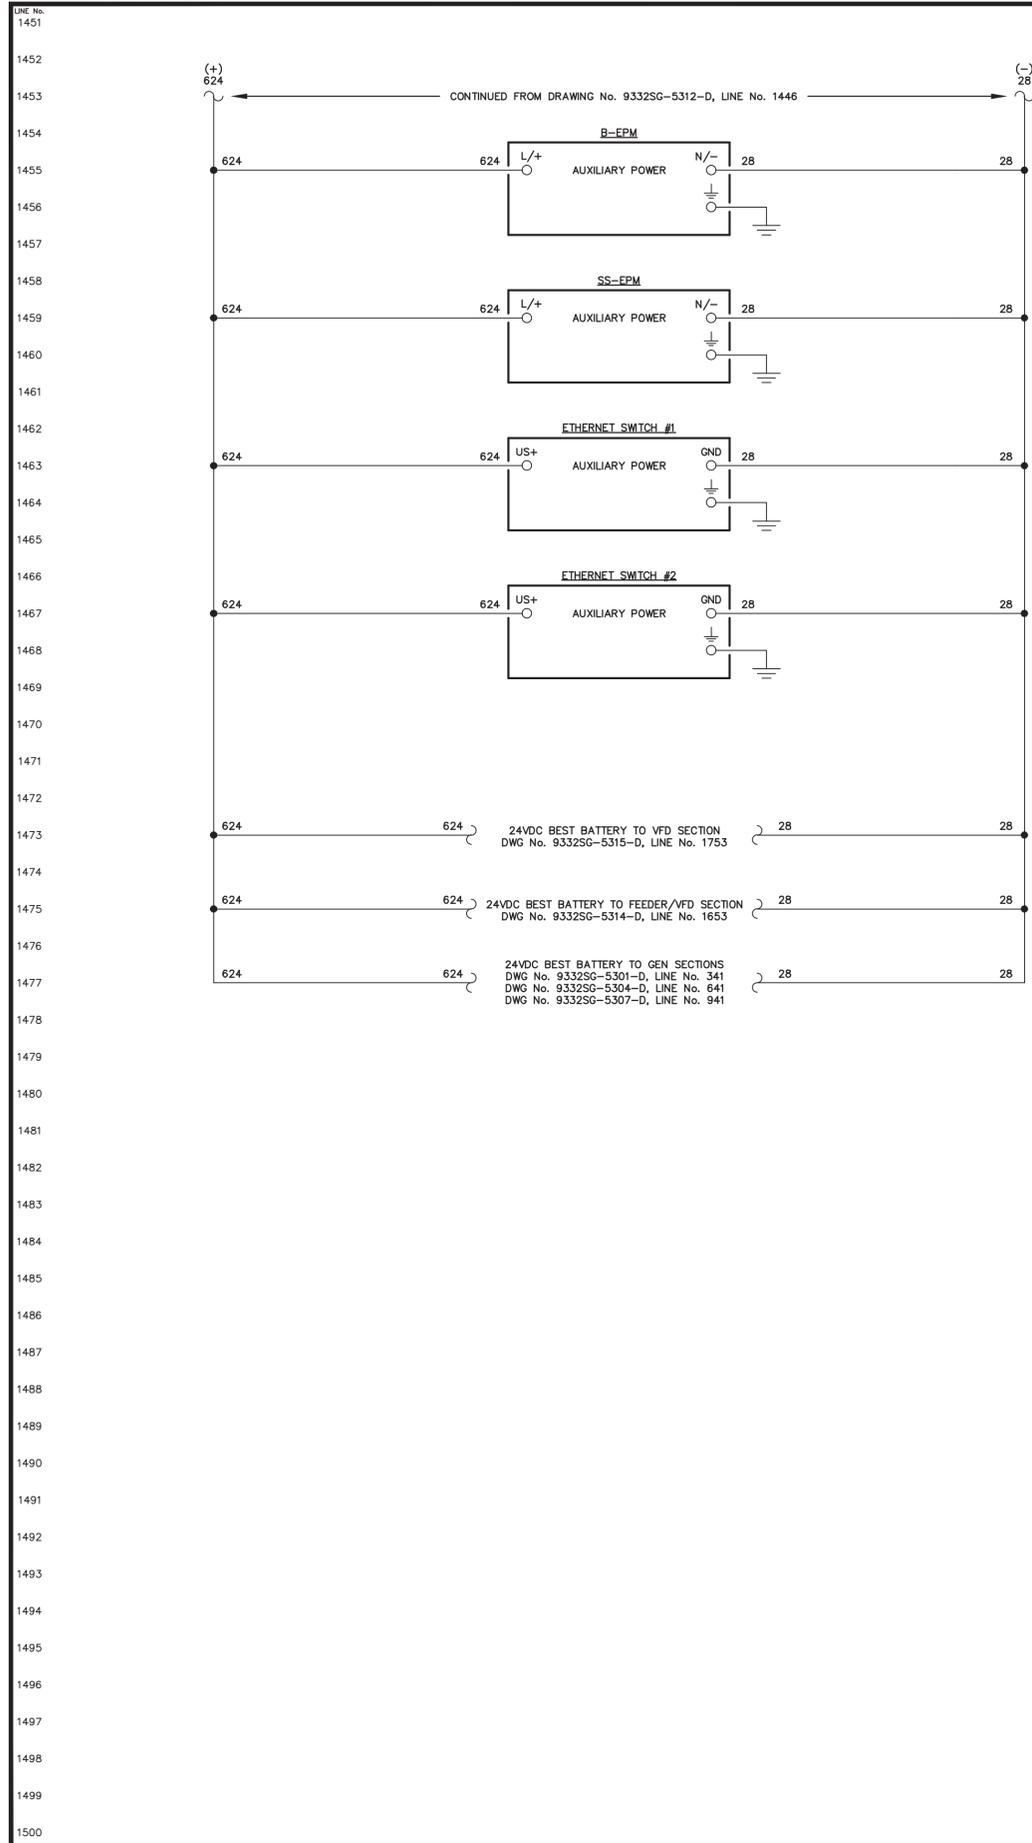



NOTE:
1. FOR GENERAL WIRING & CONSTRUCTION NOTES, SEE DRAWING No. 9332SG-3101-D.

D	09-18-24	SHOP AS BUILT	GJG
REV.	DATE	DESCRIPTION	BY
AEA PURCHASE ORDER No. P0010800		CONTROLLED POWER JOB No. 9332SG	
TITLE: MASTER DC CONTROL, SCHEMATIC DIAGRAM			
SCALE: NONE	DATE: 11-29-23	DWN. BY: GPN	
DWG. No: 9332SG-5313-D	SHEET: 1 OF 1	CKD. BY: JMD	
JOB: MANOKOTAK POWER SYSTEM UPGRADE			

ALASKA ENERGY AUTHORITY
RURAL ENERGY GROUP
813 W. NORTHERN LIGHTS BLVD.
ANCHORAGE, ALASKA 99503
HTTP://WWW.AIDEA.ORG

ENGINEERED & MANUFACTURED BY
Controlled Power, Inc.
BOTHELL, WASHINGTON USA
(425)-485-1778 www.controlledpowerinc.com

NOTICE
THE DRAWINGS, INFORMATION AND SUBJECT MATTER HEREOF ARE THE CONFIDENTIAL, SOLE AND EXCLUSIVE PROPERTY OF CONTROLLED POWER, INC., AND ARE NOT TO BE COPIED, REPRODUCED OR USED IN ANY MANNER FOR ANY PURPOSE WHATSOEVER WITHOUT WRITTEN CONSENT OR DIRECTION.

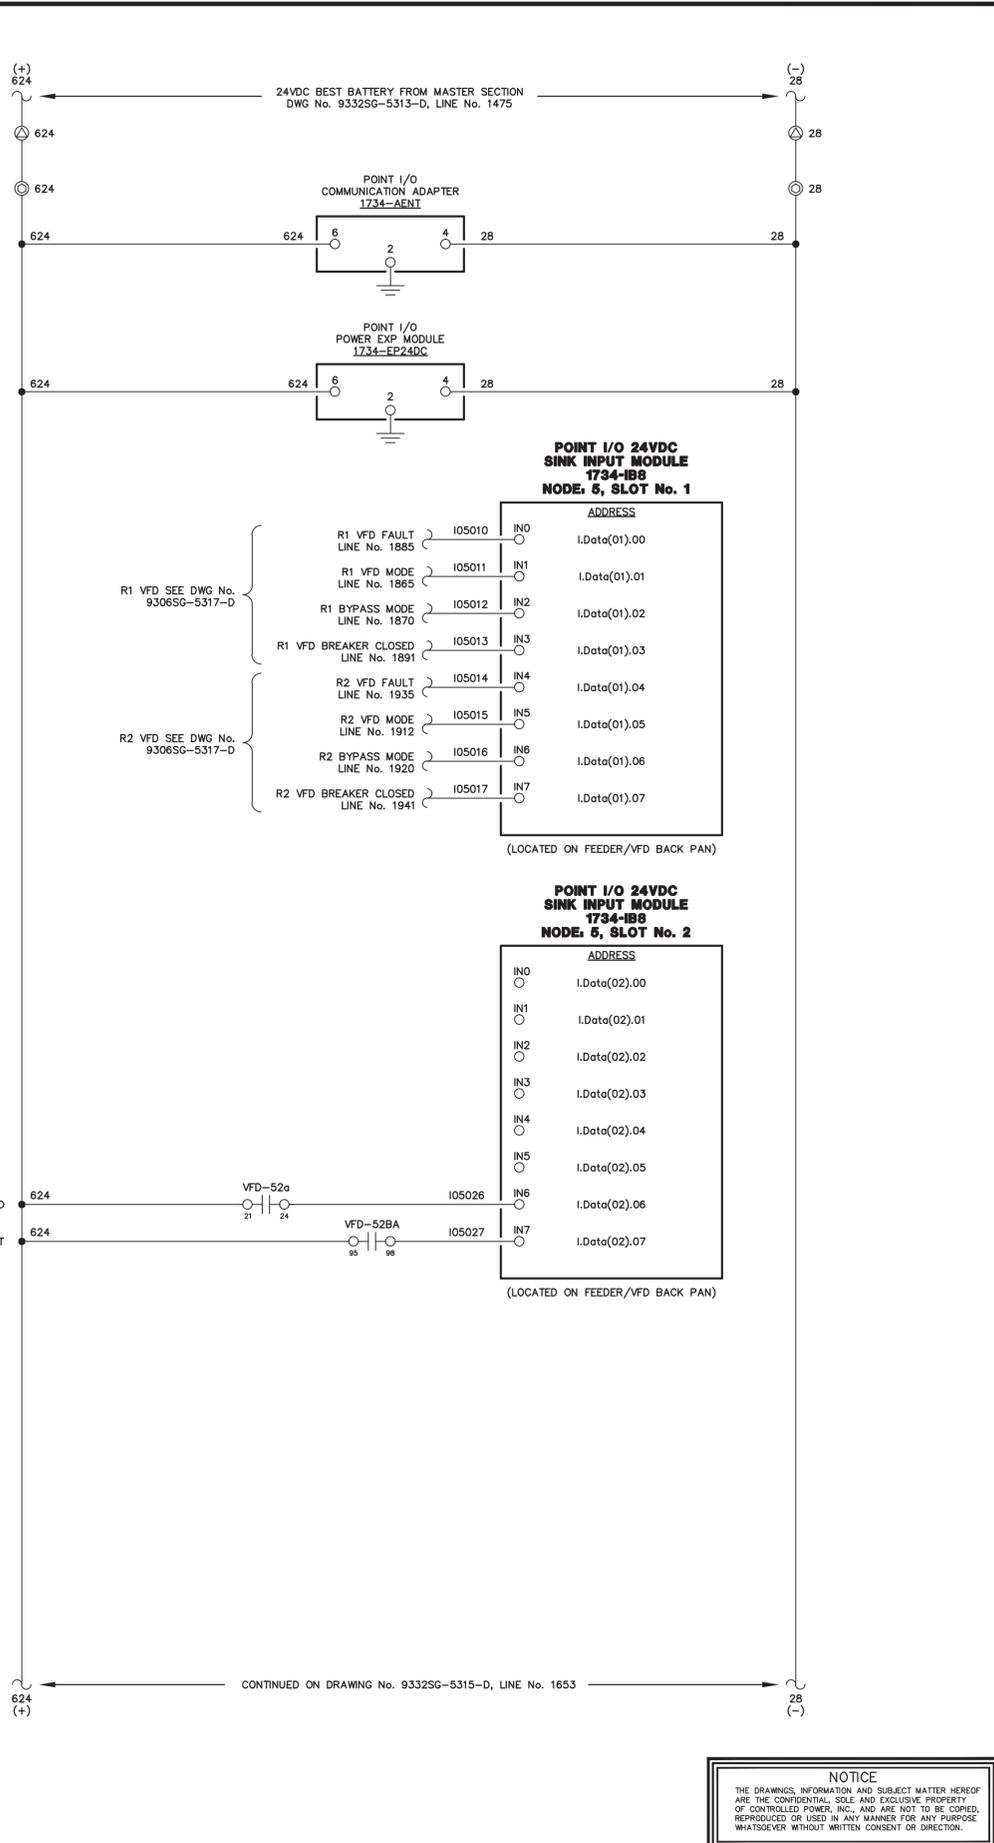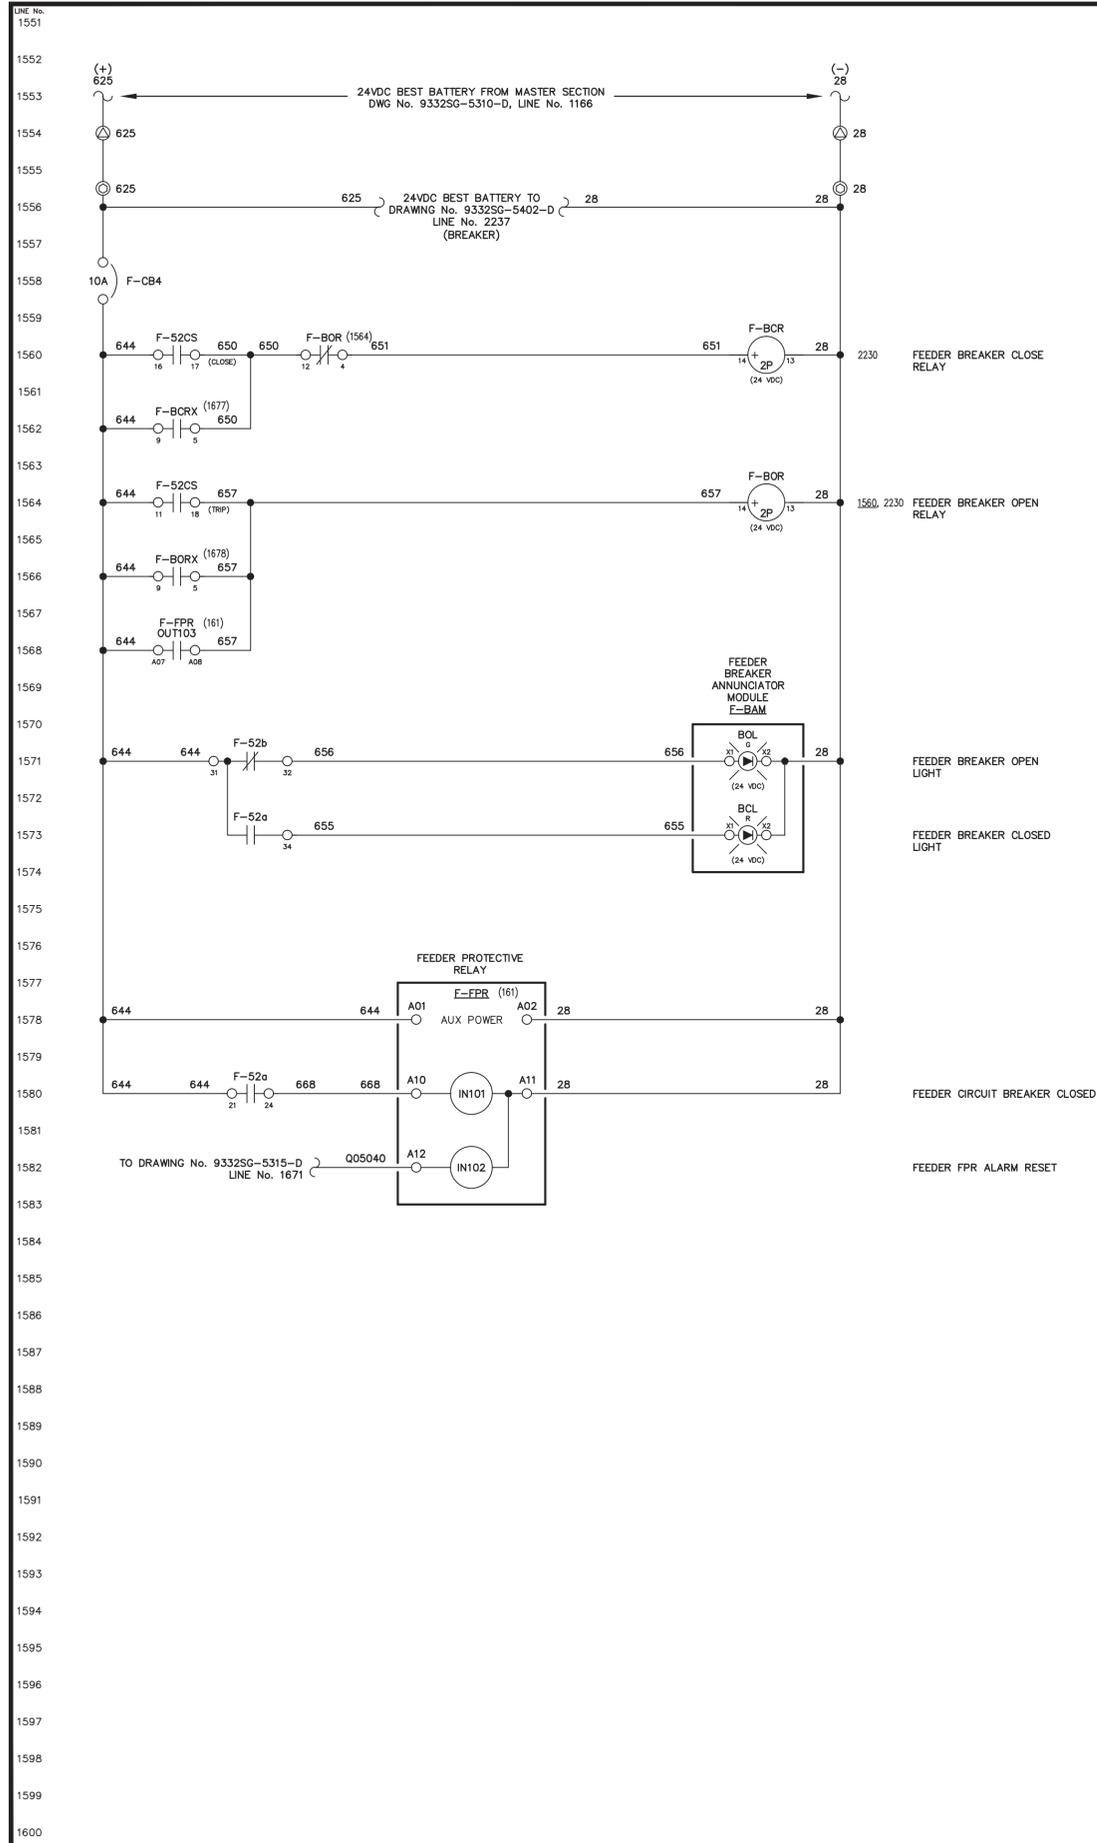


LINE No.
1651
1652
1653
LINE No.
1701
1702
(+) 624 ← CONTINUED FROM DRAWING No. 9332SG-5314-D, LINE No. 1646 → (-) 28

**POINT I/O 24VDC
SINK INPUT MODULE
1734-IB8
NODE 5, SLOT No. 3**

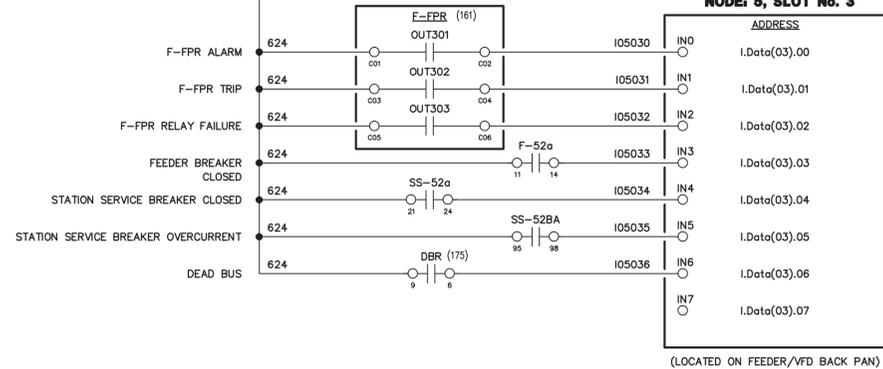

(LOCATED ON FEEDER/VFD BACK PAN)

**POINT I/O 24VDC
SOURCE OUTPUT MODULE
1734-OB8
NODE 5, SLOT No. 4**

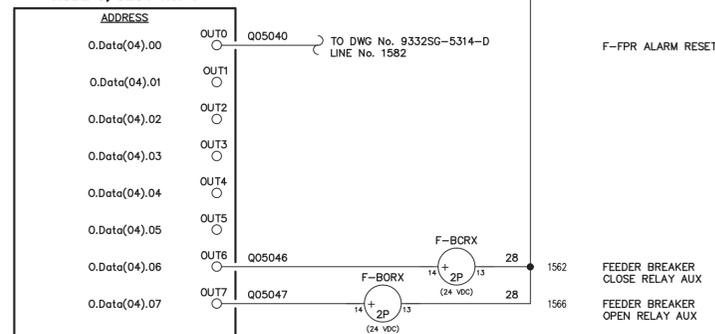

(LOCATED ON FEEDER/VFD BACK PAN)

NOTE:


- FOR GENERAL WIRING & CONSTRUCTION NOTES, SEE DRAWING No. 9332SG-3101-D.

D	09-18-24	SHOP AS BUILT	GJG
REV.	DATE	DESCRIPTION	BY
AEA PURCHASE ORDER No. P0010800		CONTROLLED POWER JOB No. 9332SG	
TITLE: FEEDER/VFD DC CONTROL, SCHEMATIC DIAGRAM			
SCALE: NONE	DATE: 11-29-23	DWN. BY: GPN	
DWG. No: 9332SG-5315-D	SHEET: 1 OF 1	CKD. BY: JMD	
JOB: MANOKOTAK POWER SYSTEM UPGRADE			


ALASKA ENERGY AUTHORITY
RURAL ENERGY GROUP
813 W. NORTHERN LIGHTS BLVD.
ANCHORAGE, ALASKA 99503
HTTP://WWW.AIDEA.ORG

NOTICE
THE DRAWINGS, INFORMATION AND SUBJECT MATTER HEREOF ARE THE CONFIDENTIAL, SOLE AND EXCLUSIVE PROPERTY OF CONTROLLED POWER, INC., AND ARE NOT TO BE COPIED, REPRODUCED OR USED IN ANY MANNER FOR ANY PURPOSE WHATSOEVER WITHOUT WRITTEN CONSENT OR DIRECTION.


Controlled Power, Inc.
ENGINEERED & MANUFACTURED BY
BOTHHELL, WASHINGTON USA
(425)-485-1778 www.controlleddpowerinc.com

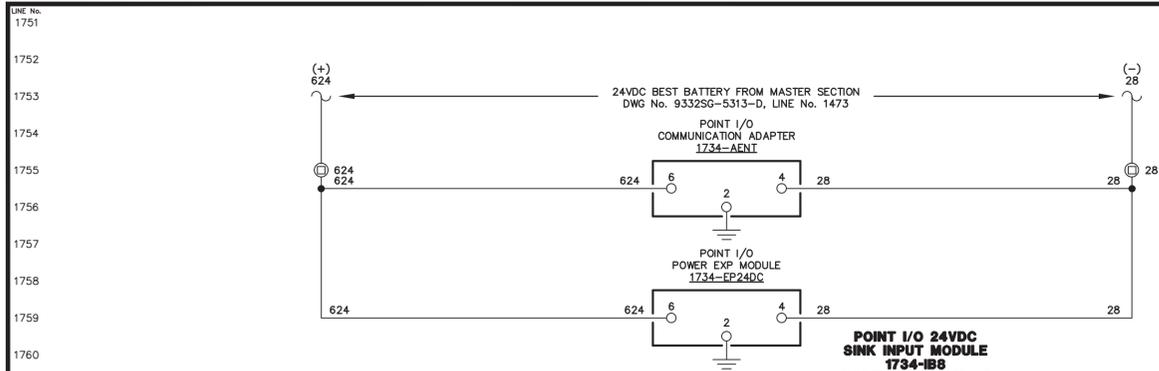

POINT I/O 24VDC SINK INPUT MODULE 1734-IB8 NODE 6, SLOT No. 1

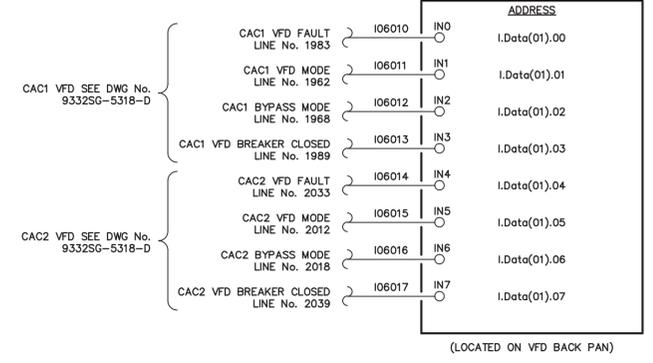

POINT I/O 24VDC SINK INPUT MODULE 1734-IB8 NODE 6, SLOT No. 2

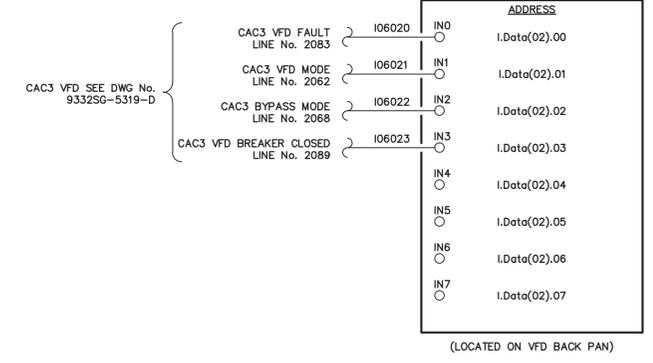



NOTE:
1. FOR GENERAL WIRING & CONSTRUCTION NOTES, SEE DRAWING No. 9332SG-3101-D.

D	09-18-24	SHOP AS BUILT	GJG
REV.	DATE	DESCRIPTION	BY
AEA PURCHASE ORDER No. P0010800 CONTROLLED POWER JOB No. 9332SG			
TITLE: VFD DC CONTROL, SCHEMATIC DIAGRAM			
SCALE: NONE	DATE: 11-29-23	DWN. BY: GPN	
DWG. No: 9332SG-5316-D	SHEET: 1 OF 1	CKD. BY: JMD	
JOB: MANOKOTAK POWER SYSTEM UPGRADE			

ALASKA ENERGY AUTHORITY
RURAL ENERGY GROUP
813 W. NORTHERN LIGHTS BLVD.
ANCHORAGE, ALASKA 99503
HTTP://WWW.AIDEA.ORG

NOTICE
THE DRAWINGS, INFORMATION AND SUBJECT MATTER HEREOF ARE THE CONFIDENTIAL, SOLE AND EXCLUSIVE PROPERTY OF CONTROLLED POWER, INC., AND ARE NOT TO BE COPIED, REPRODUCED OR USED IN ANY MANNER FOR ANY PURPOSE WHATSOEVER WITHOUT WRITTEN CONSENT OR DIRECTION.



Controlled Power, Inc.
ENGINEERED & MANUFACTURED BY
BOTHHELL, WASHINGTON USA
(425)-485-1778 www.controlledpowerinc.com

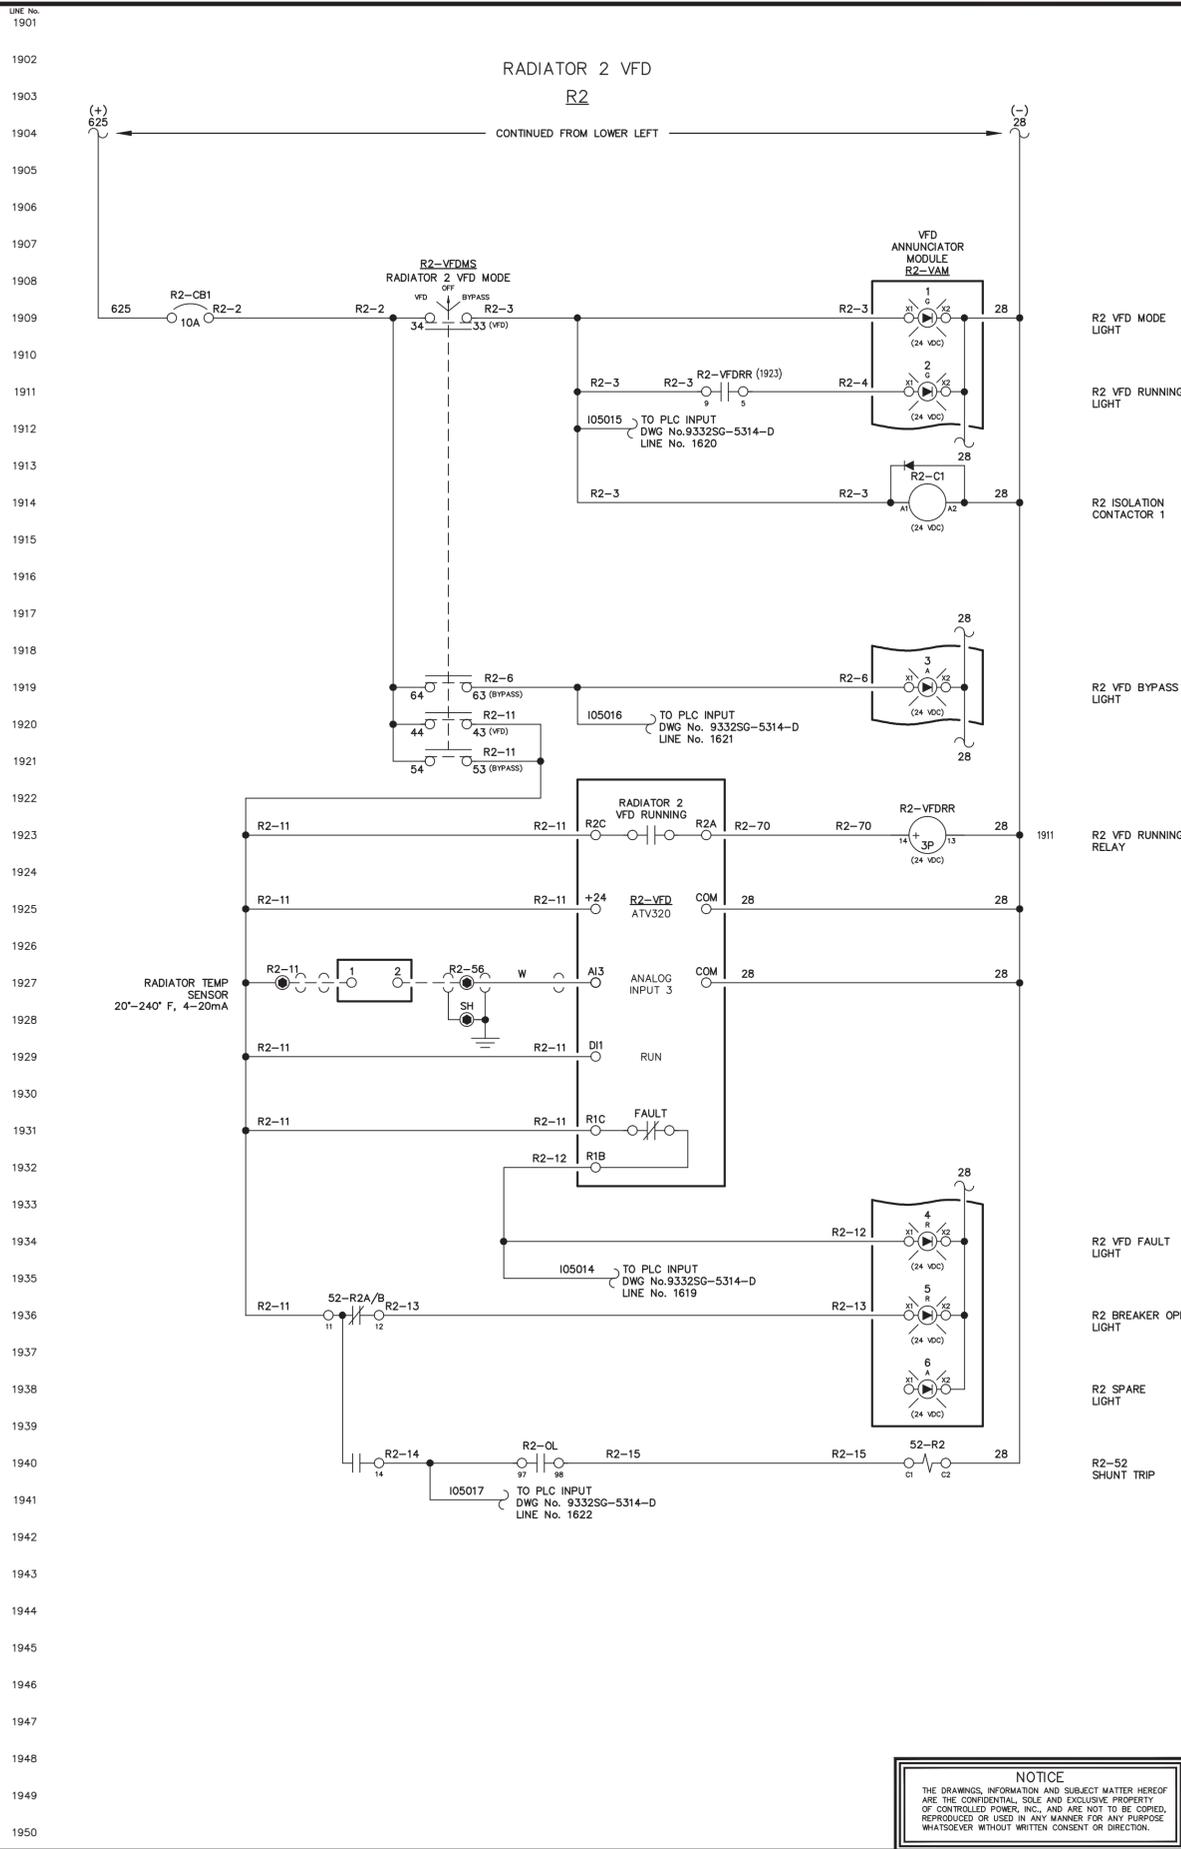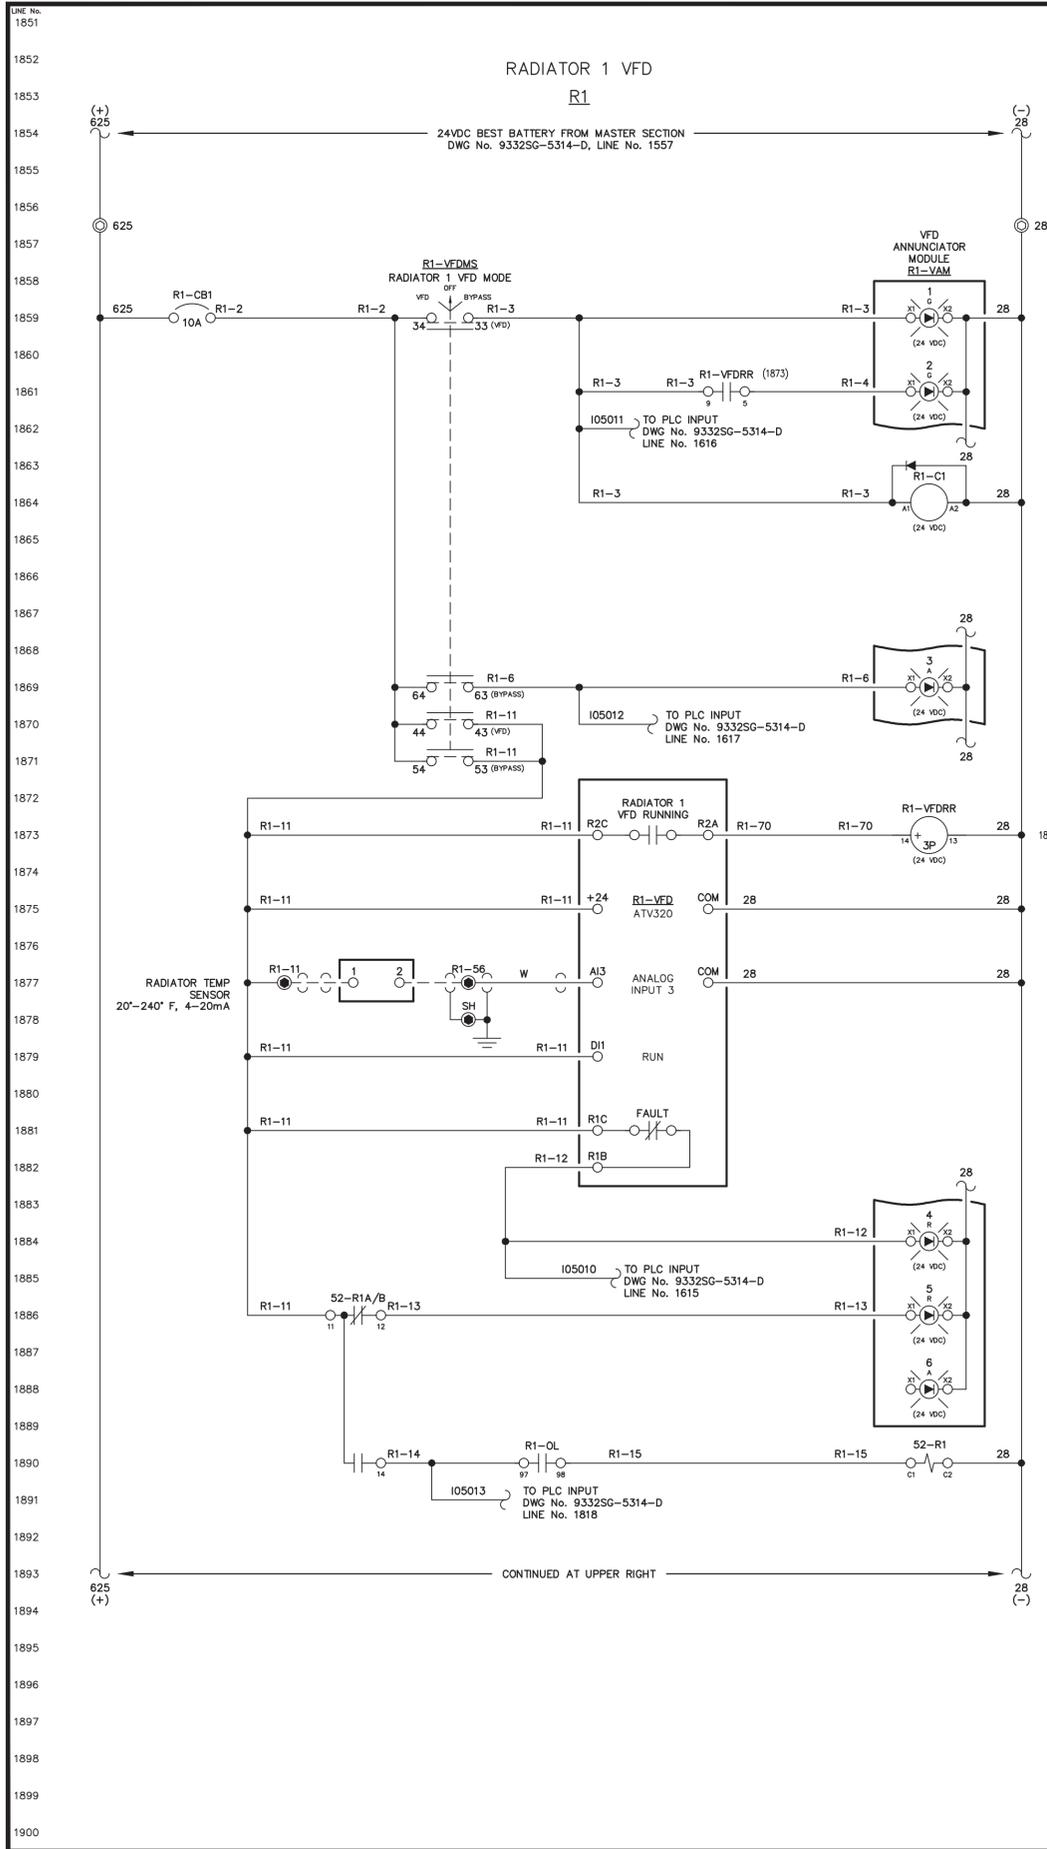

NOTE:
1. FOR GENERAL WIRING & CONSTRUCTION NOTES, SEE DRAWING No. 9332SG-3101-D.

D	09-18-24	SHOP AS BUILT	GJG
REV.	DATE	DESCRIPTION	BY
AEA PURCHASE ORDER No. P0010800 CONTROLLED POWER JOB No. 9332SG			
TITLE: R1 & R2 VFD DC CONTROL, SCHEMATIC DIAGRAM			
SCALE: NONE	DATE: 11-29-23	DWN. BY: GPN	
DWG. No: 9332SG-5317-D	SHEET: 1 OF 1	CKD. BY: JMD	
JOB: MANOKOTAK POWER SYSTEM UPGRADE			
		RURAL ENERGY GROUP 813 W. NORTHERN LIGHTS BLVD. ANCHORAGE, ALASKA 99503 HTTP://WWW.AIDEA.ORG	
		ENGINEERED & MANUFACTURED BY Controlled Power, Inc. BOTHELL, WASHINGTON USA (425)-485-1778 www.controlledpowerinc.com	

NOTICE
THE DRAWINGS, INFORMATION AND SUBJECT MATTER HEREOF ARE THE CONFIDENTIAL, SOLE AND EXCLUSIVE PROPERTY OF CONTROLLED POWER, INC., AND ARE NOT TO BE COPIED, REPRODUCED OR USED IN ANY MANNER FOR ANY PURPOSE WHATSOEVER WITHOUT WRITTEN CONSENT OR DIRECTION.

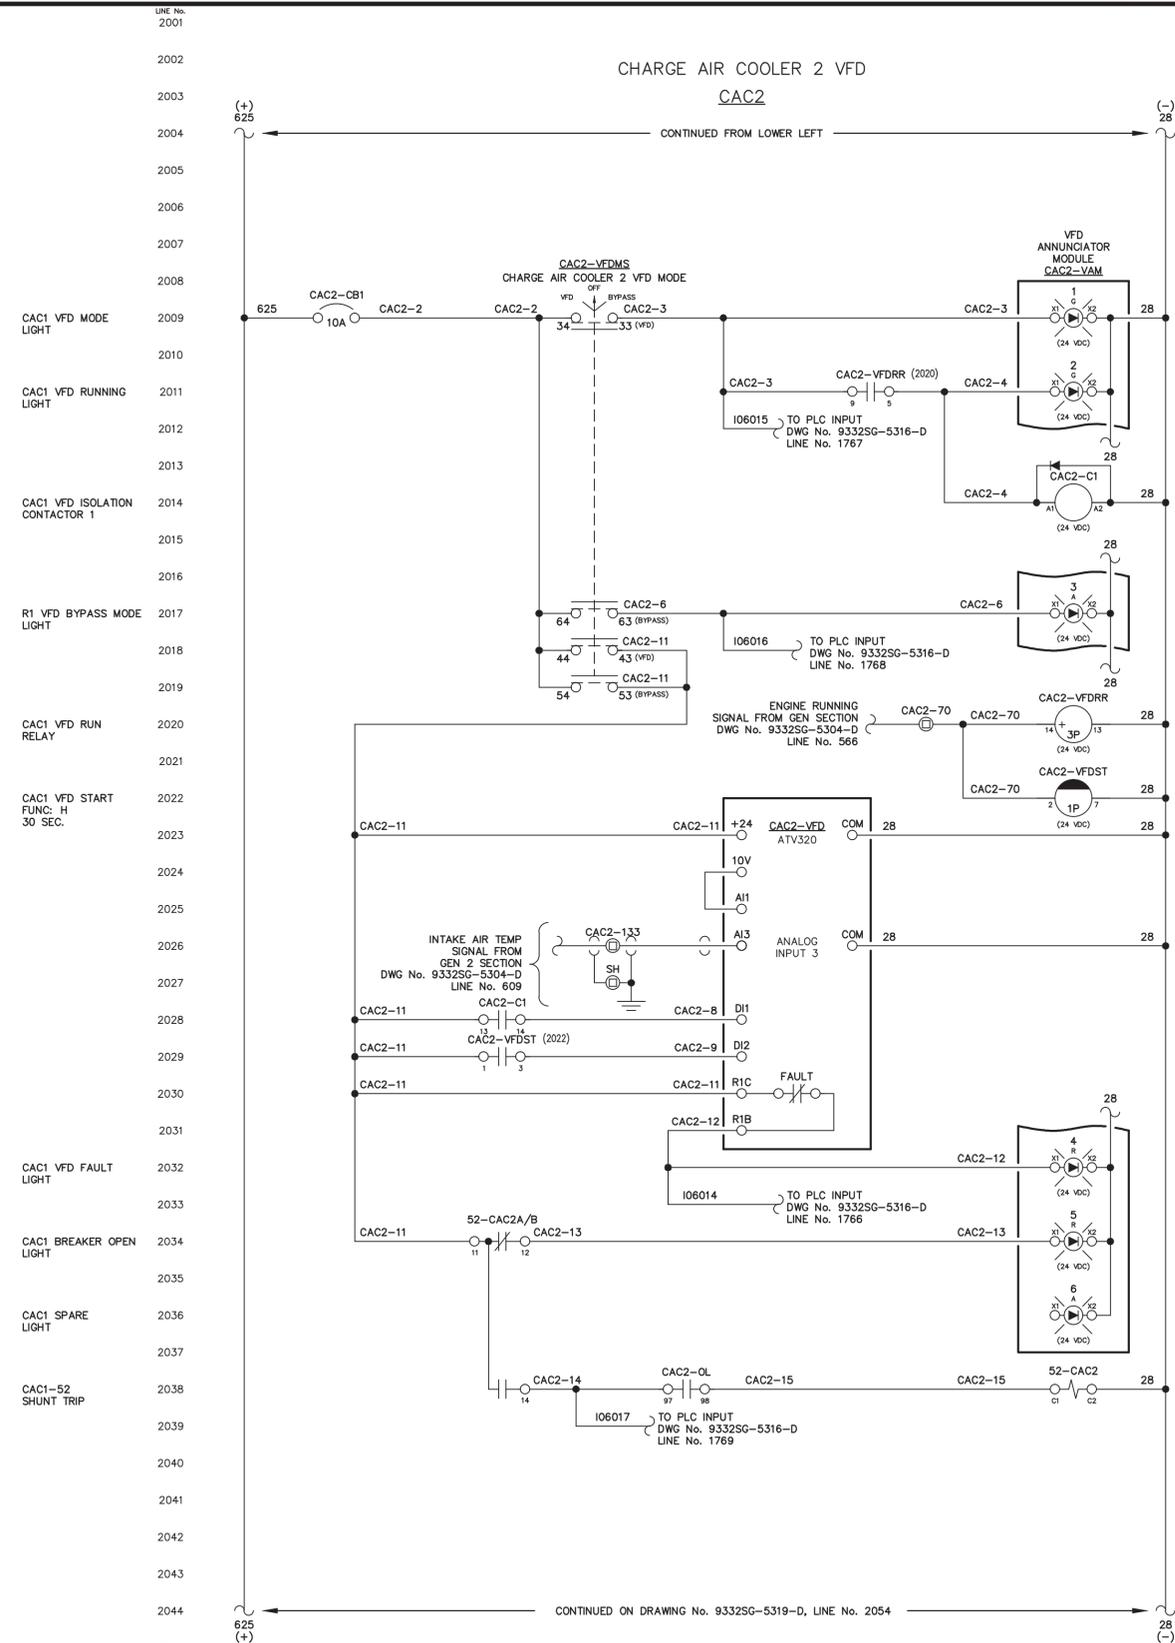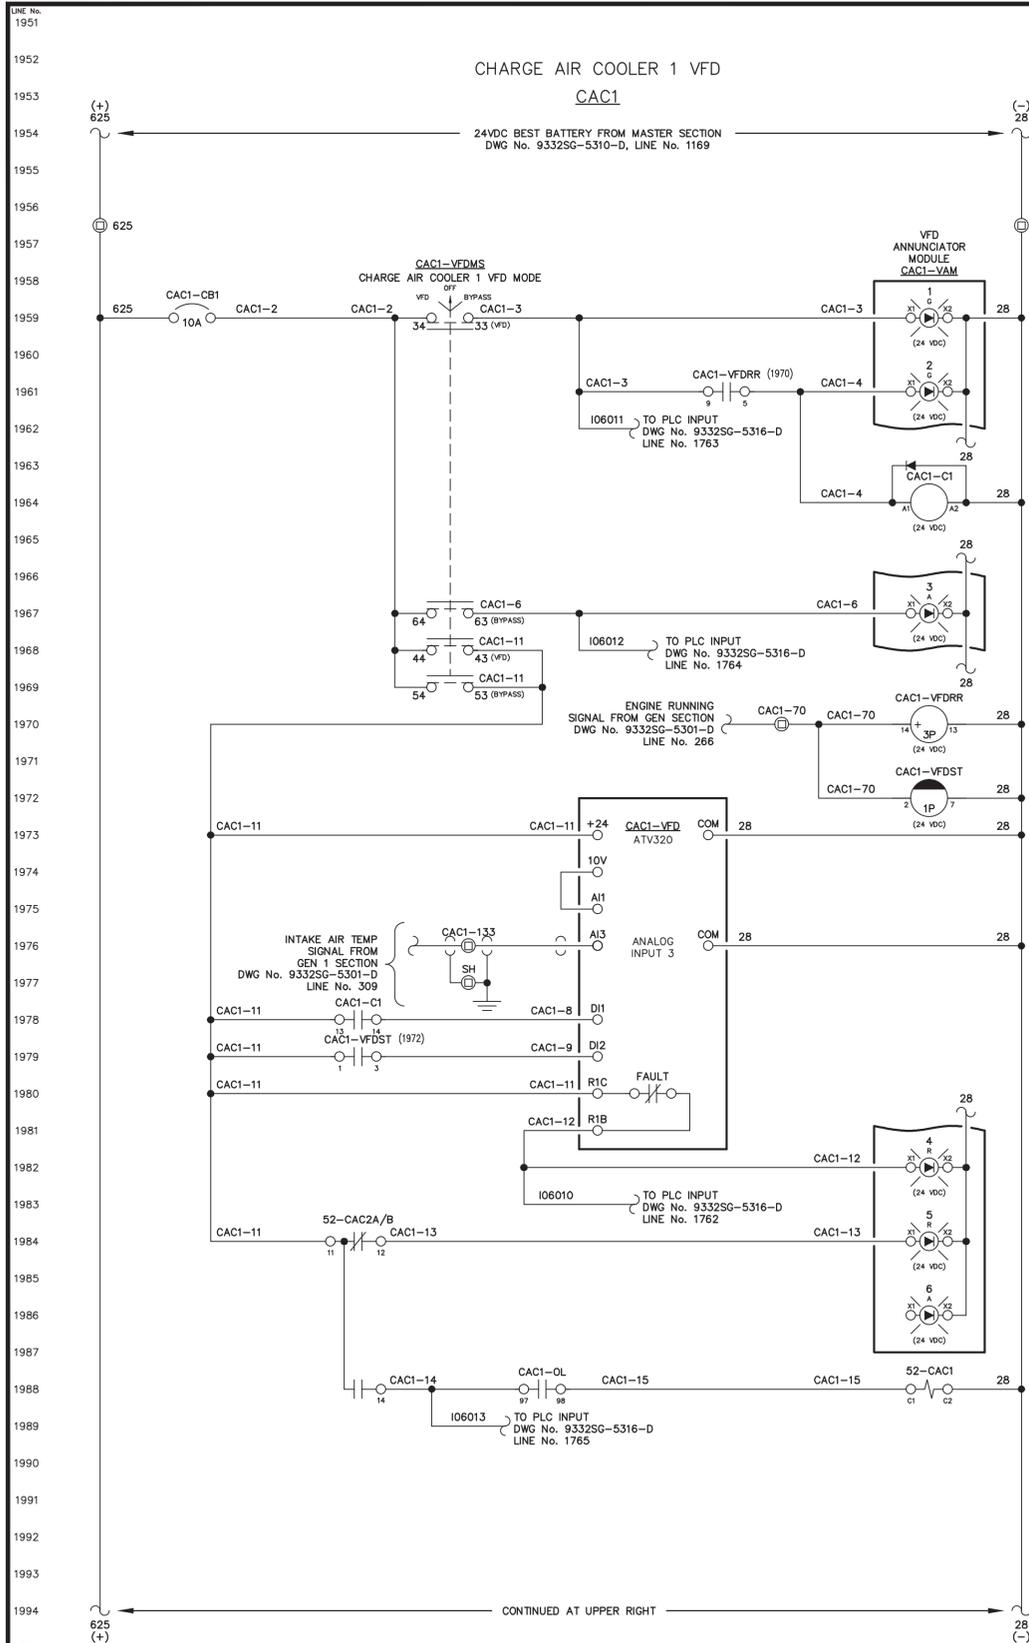

CAC1 VFD MODE LIGHT

CAC1 VFD RUNNING LIGHT

CAC1 VFD ISOLATION CONTACTOR 1

R1 VFD BYPASS MODE LIGHT

CAC1 VFD RUN RELAY

CAC1 VFD START FUNC: H 30 SEC.

CAC1 VFD FAULT LIGHT

CAC1 BREAKER OPEN LIGHT

CAC1 SPARE LIGHT

CAC1-52 SHUNT TRIP

CAC2 VFD MODE LIGHT

CAC2 VFD RUNNING LIGHT

CAC2 VFD ISOLATION CONTACTOR 1

R1 VFD BYPASS MODE LIGHT

CAC2 VFD RUN RELAY

CAC2 VFD START FUNC: H 30 SEC.

CAC2 VFD FAULT LIGHT

CAC2 BREAKER OPEN LIGHT

CAC2 SPARE LIGHT

CAC2-52 SHUNT TRIP



NOTE:
1. FOR GENERAL WIRING & CONSTRUCTION NOTES, SEE DRAWING No. 9332SG-3101-D.


D	09-18-24	SHOP AS BUILT	GJG
REV.	DATE	DESCRIPTION	BY
AEA PURCHASE ORDER No. P0010800 CONTROLLED POWER JOB No. 9332SG			
TITLE: CAC1 & CAC2 VFD DC CONTROL, SCHEMATIC DIAGRAM			
SCALE: NONE	DATE: 11-29-23	DWN. BY: GPN	
DWG. No: 9332SG-5318-D	SHEET: 1 OF 1	CKD. BY: JMD	
JOB: MANOKOTAK POWER SYSTEM UPGRADE			

ALASKA ENERGY AUTHORITY
RURAL ENERGY GROUP
813 W. NORTHERN LIGHTS BLVD.
ANCHORAGE, ALASKA 99503
HTTP://WWW.AIDEA.ORG


ENGINEERED & MANUFACTURED BY
Controlled Power, Inc.
BOTHELL, WASHINGTON USA
(425)-485-1778 www.controlleddpowerinc.com

NOTICE
THE DRAWINGS, INFORMATION AND SUBJECT MATTER HEREOF ARE THE CONFIDENTIAL, SOLE AND EXCLUSIVE PROPERTY OF CONTROLLED POWER, INC., AND ARE NOT TO BE COPIED, REPRODUCED OR USED IN ANY MANNER FOR ANY PURPOSE WHATSOEVER WITHOUT WRITTEN CONSENT OR DIRECTION.

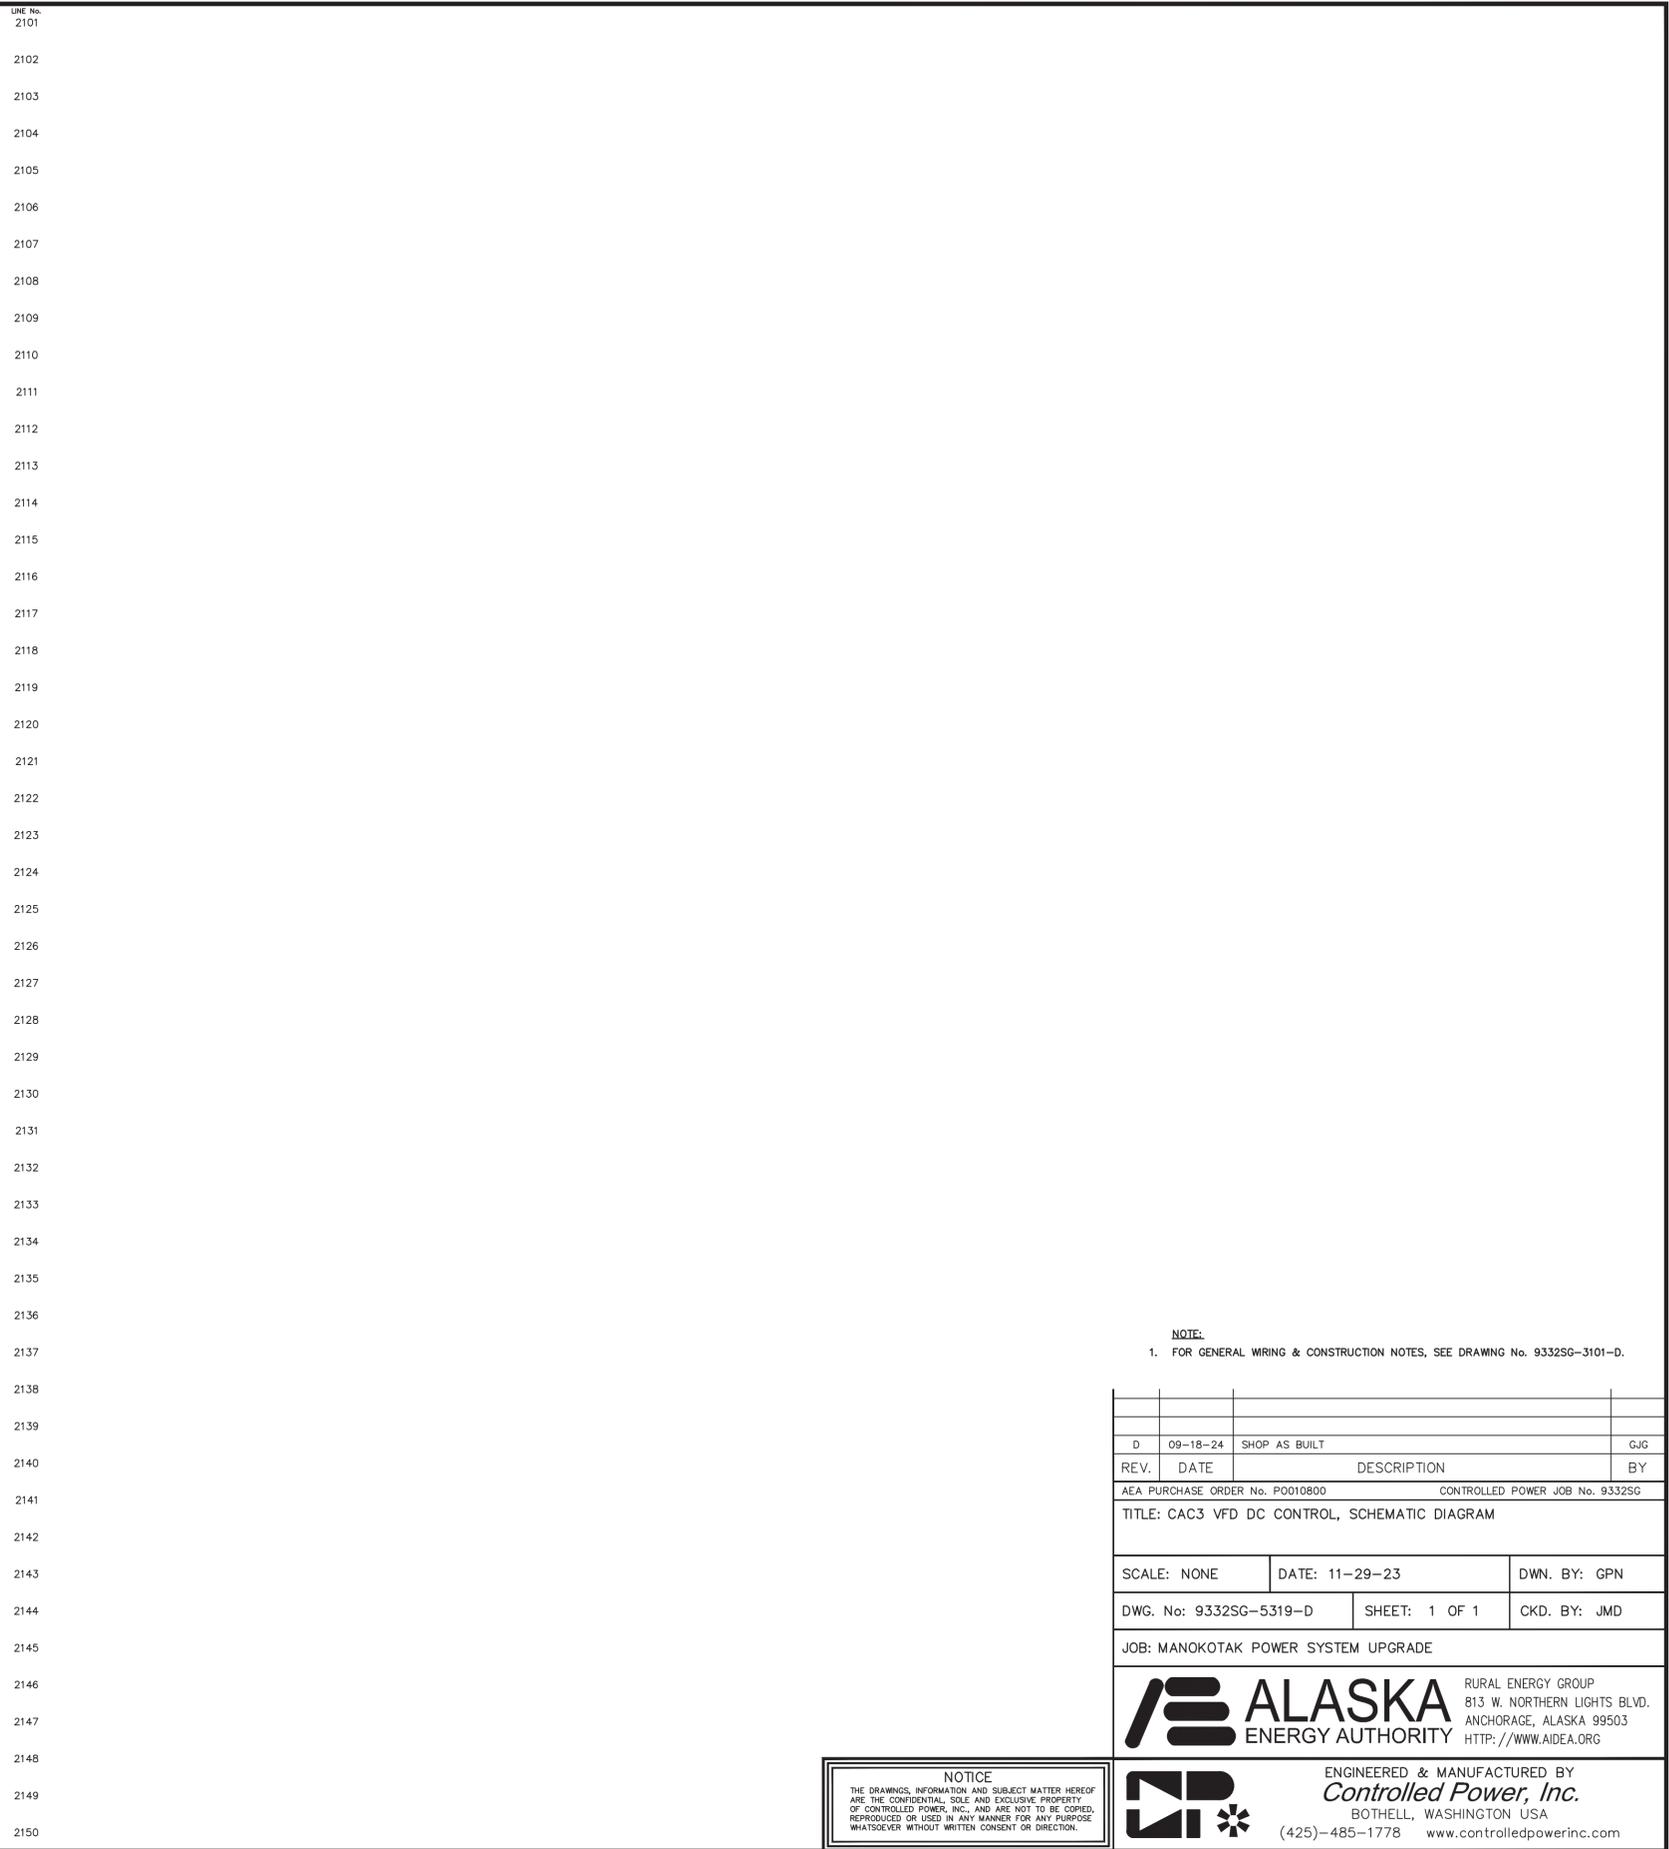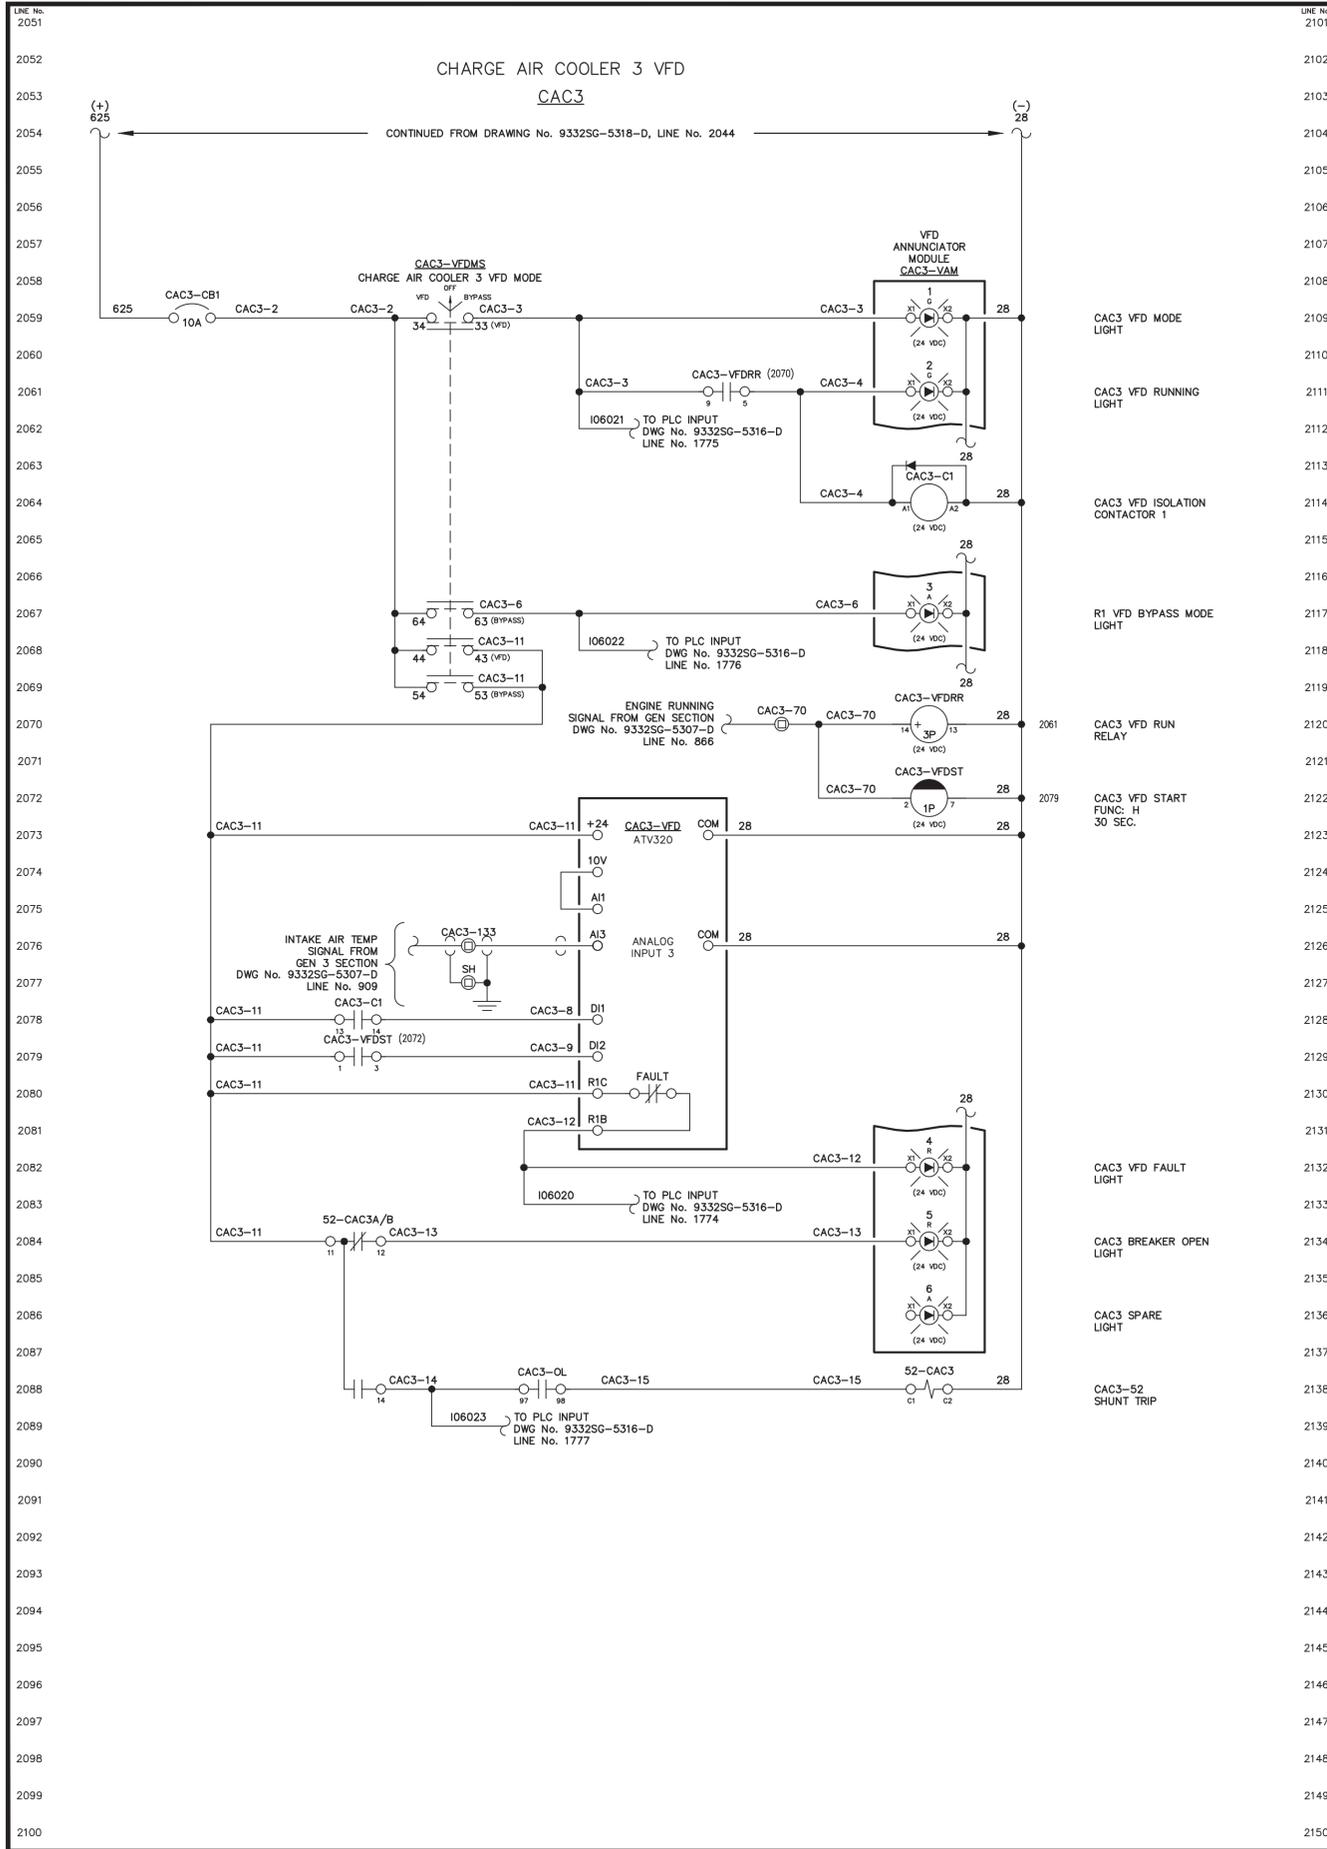

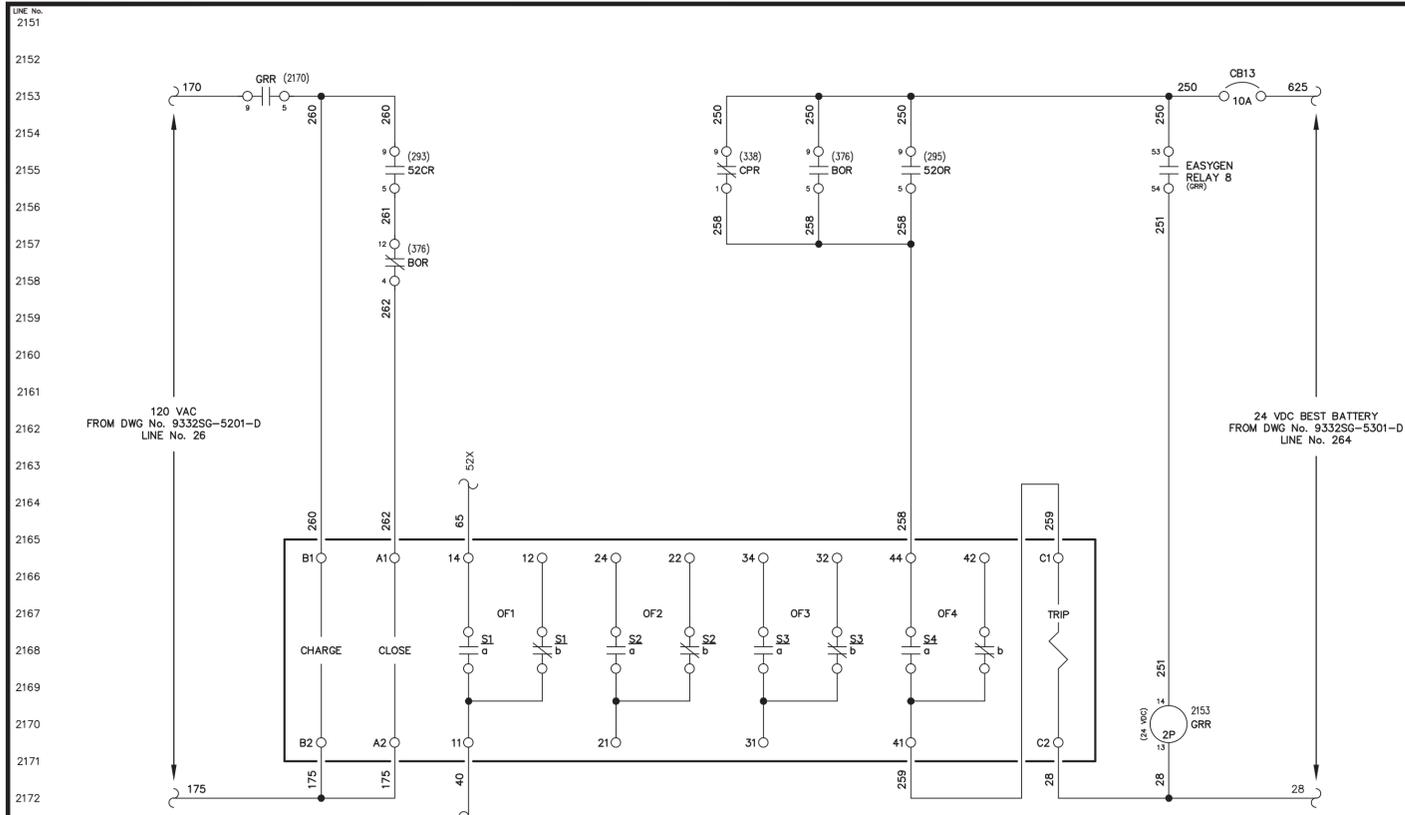

GENERATOR 1 BREAKER
SQUARE D MASTERPACT NT

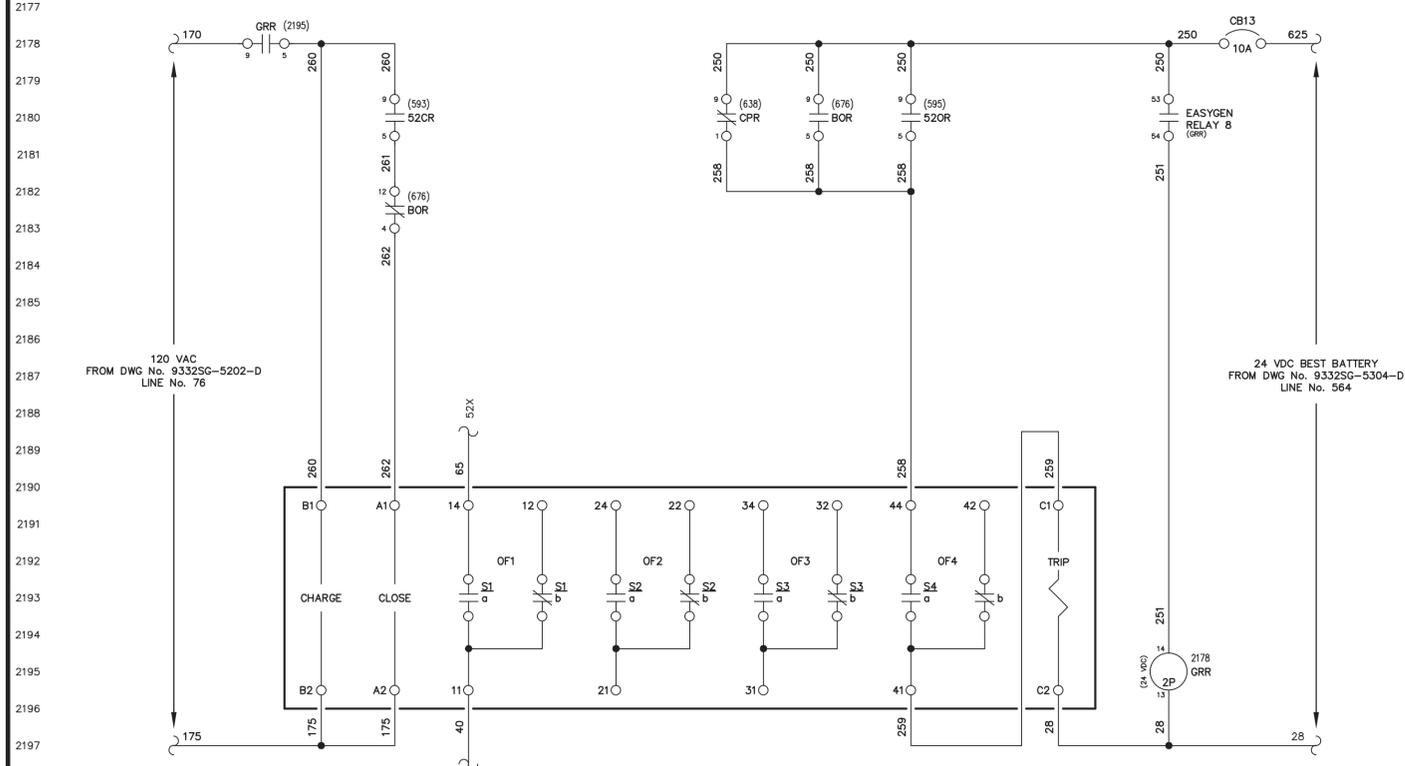

GENERATOR 2 BREAKER
SQUARE D MASTERPACT NT


NOTE:
1. FOR GENERAL WIRING & CONSTRUCTION NOTES, SEE DRAWING No. 9332SG-3101-D.

D	09-18-24	SHOP AS BUILT	GJG
REV.	DATE	DESCRIPTION	BY
AEA PURCHASE ORDER No. P0010800		CONTROLLED POWER JOB No. 9332SG	
TITLE: GEN 1 & GEN 2 CIRCUIT BREAKER CONTROL, SCHEMATIC DIAGRAM			
SCALE: NONE	DATE: 11-29-23	DWN. BY: GPN	
DWG. No: 9332SG-5401-D	SHEET: 1 OF 1	CKD. BY: JMD	
JOB: MANOKOTAK POWER SYSTEM UPGRADE			


ALASKA ENERGY AUTHORITY
RURAL ENERGY GROUP
813 W. NORTHERN LIGHTS BLVD.
ANCHORAGE, ALASKA 99503
HTTP://WWW.AIDEA.ORG

NOTICE
THE DRAWINGS, INFORMATION AND SUBJECT MATTER HEREOF ARE THE CONFIDENTIAL, SOLE AND EXCLUSIVE PROPERTY OF CONTROLLED POWER, INC., AND ARE NOT TO BE COPIED, REPRODUCED OR USED IN ANY MANNER FOR ANY PURPOSE WHATSOEVER WITHOUT WRITTEN CONSENT OR DIRECTION.

ENGINEERED & MANUFACTURED BY
Controlled Power, Inc.
BOTHHELL, WASHINGTON USA
(425)-485-1778 www.controlleddpowerinc.com

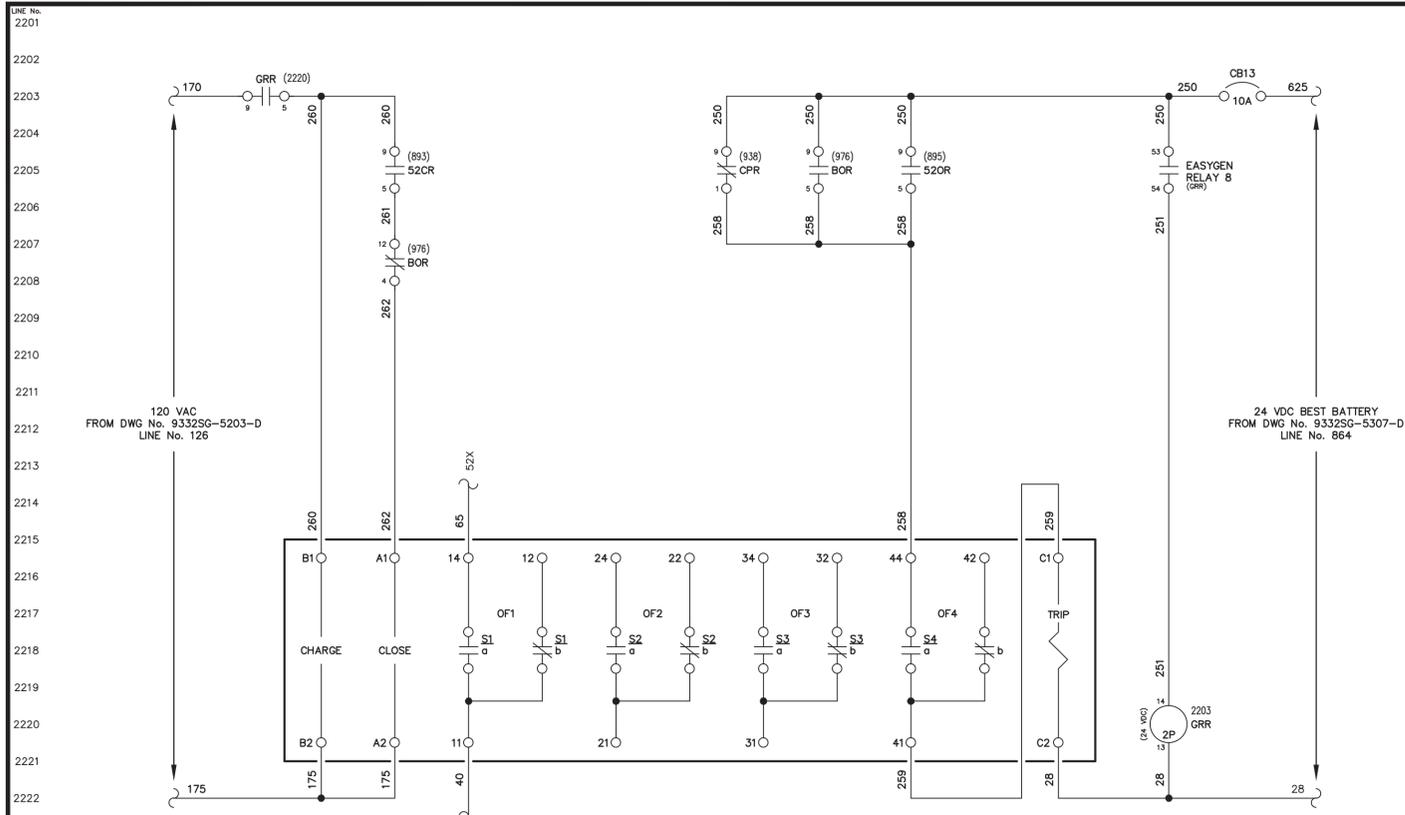

GENERATOR 3 BREAKER
SQUARE D MASTERPACT NT

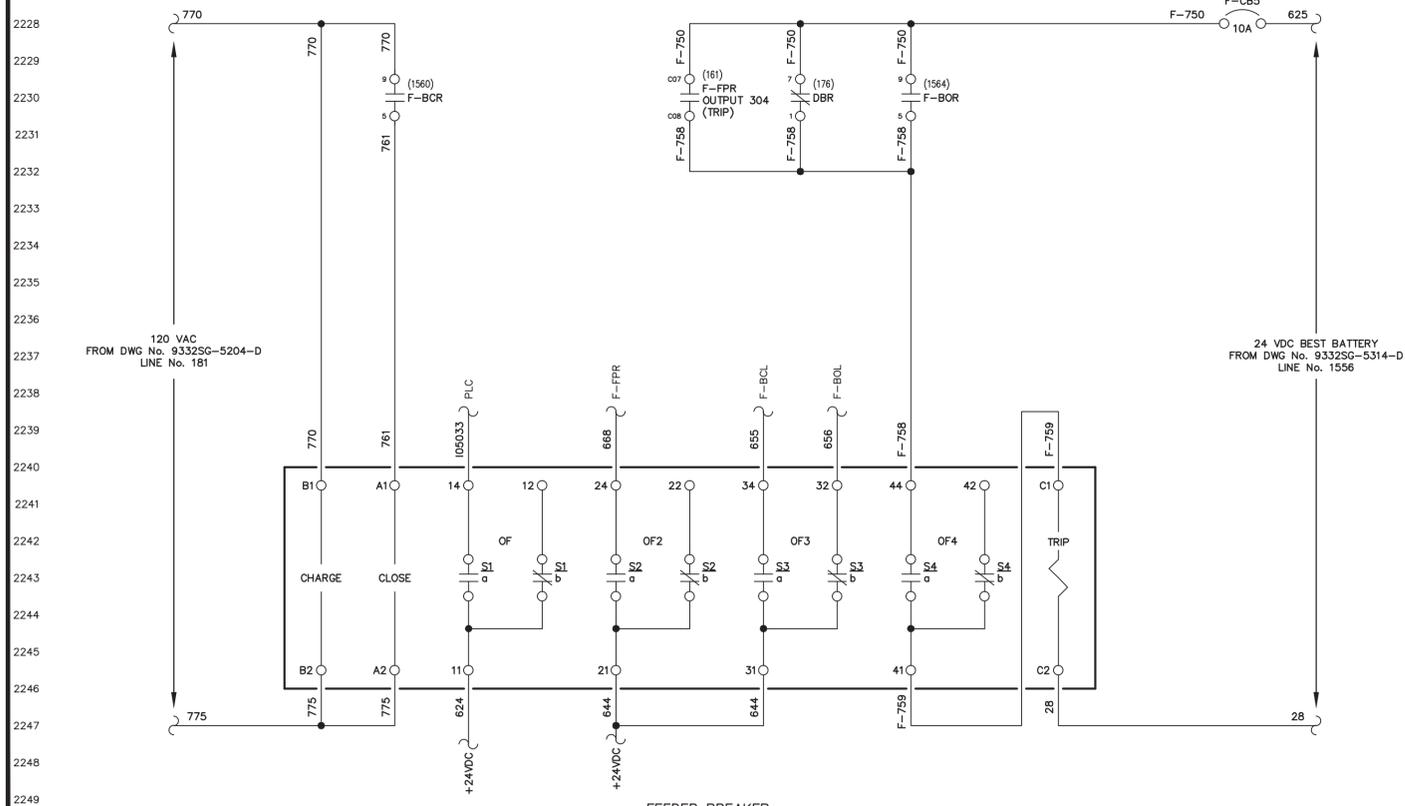

FEEDER BREAKER
SQUARE D MASTERPACT NT

NOTE:
1. FOR GENERAL WIRING & CONSTRUCTION NOTES, SEE DRAWING No. 9332SG-3101-D.


D	09-18-24	SHOP AS BUILT	GJG
REV.	DATE	DESCRIPTION	BY
AEA PURCHASE ORDER No. P0010800		CONTROLLED POWER JOB No. 9332SG	
TITLE: GEN 3 & FEEDER CIRCUIT BREAKER CONTROL, SCHEMATIC DIAGRAM			
SCALE: NONE	DATE: 11-29-23	DWN. BY: GPN	
DWG. No: 9332SG-5402-D	SHEET: 1 OF 1	CKD. BY: JMD	
JOB: MANOKOTAK POWER SYSTEM UPGRADE			

ALASKA ENERGY AUTHORITY
RURAL ENERGY GROUP
813 W. NORTHERN LIGHTS BLVD.
ANCHORAGE, ALASKA 99503
HTTP://WWW.AIDEA.ORG

NOTICE
THE DRAWINGS, INFORMATION AND SUBJECT MATTER HEREOF ARE THE CONFIDENTIAL, SOLE AND EXCLUSIVE PROPERTY OF CONTROLLED POWER, INC., AND ARE NOT TO BE COPIED, REPRODUCED OR USED IN ANY MANNER FOR ANY PURPOSE WHATSOEVER WITHOUT WRITTEN CONSENT OR DIRECTION.

ENGINEERED & MANUFACTURED BY
Controlled Power, Inc.
BOTHELL, WASHINGTON USA
(425)-485-1778 www.controlledpowerinc.com

LINE No.
2301
2302
2303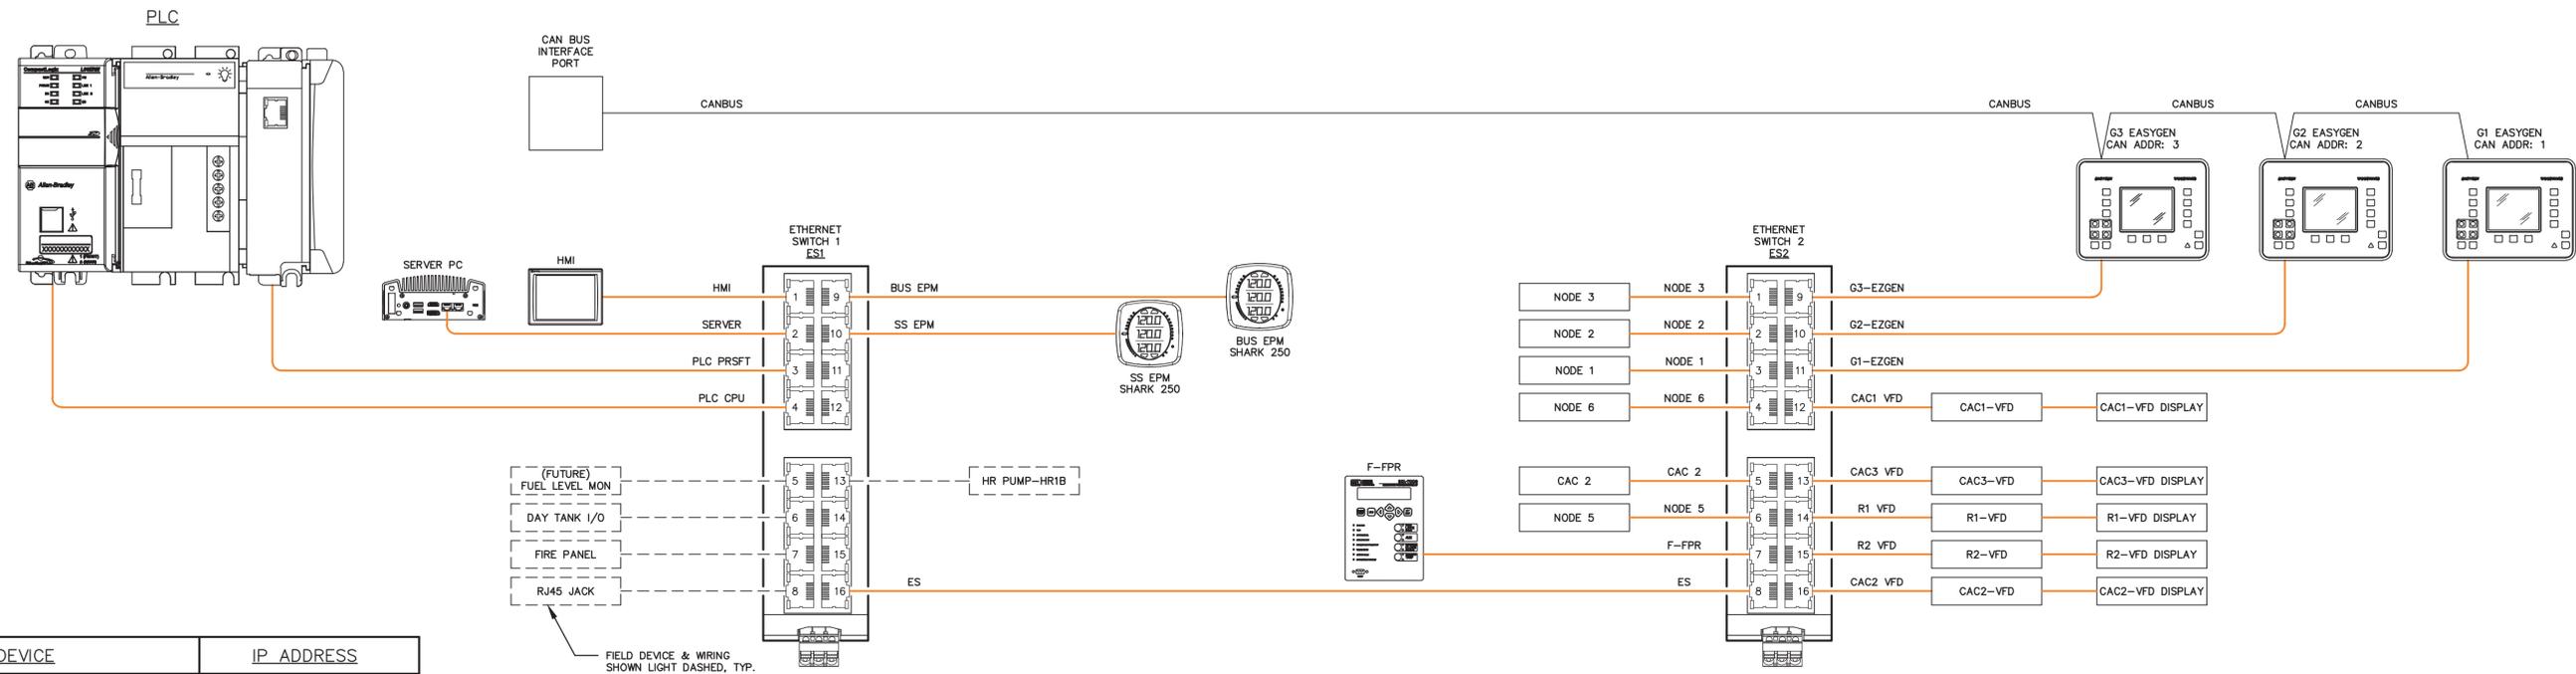
DEVICE	IP ADDRESS
SERVER	192.168.1.142
F-FPR	192.168.1.155
R1 VFD	192.168.1.171
R2 VFD	192.168.1.172
CAC1 VFD	192.168.1.174
CAC2 VFD	192.168.1.175
CAC3 VFD	192.168.1.176
HR PUMP-HR1B	192.168.1.178
HMI	192.168.1.182
PLC CPU	192.168.1.183
PLC PROSOFT	192.168.1.187
BUS EPM	192.168.1.190
SS EPM	192.168.1.191
G1 EASYGEN	192.168.1.161
G2 EASYGEN	192.168.1.162
G3 EASYGEN	192.168.1.163
NODE 1	192.168.1.121
NODE 2	192.168.1.122
NODE 3	192.168.1.123
NODE 4	192.168.1.126
NODE 5	192.168.1.125
NODE 6	192.168.1.128
DAY TANK I/O	192.168.1.127
TANK LEVEL MONITOR	192.168.1.198

(FUTURE)
FUEL LEVEL MON
DAY TANK I/O
FIRE PANEL
RJ45 JACK
FIELD DEVICE & WIRING SHOWN LIGHT DASHED, TYP.

NOTE:
1. FOR GENERAL WIRING & CONSTRUCTION NOTES, SEE DRAWING No. 9332SG-3101-D.


D	09-18-24	SHOP AS BUILT	GJG
REV.	DATE	DESCRIPTION	BY
AEA PURCHASE ORDER No. P0010800		CONTROLLED POWER JOB No. 9332SG	
TITLE: COMMUNICATION NETWORK, SCHEMATIC DIAGRAM			
SCALE: NONE	DATE: 11-29-23	DWN. BY: GPN	
DWG. No: 9332SG-5601-D	SHEET: 1 OF 1	CKD. BY: JMD	
JOB: MANOKOTAK POWER SYSTEM UPGRADE			

ALASKA ENERGY AUTHORITY
RURAL ENERGY GROUP
813 W. NORTHERN LIGHTS BLVD.
ANCHORAGE, ALASKA 99503
HTTP://WWW.AIDEA.ORG

NOTICE
THE DRAWINGS, INFORMATION AND SUBJECT MATTER HEREOF ARE THE CONFIDENTIAL, SOLE AND EXCLUSIVE PROPERTY OF CONTROLLED POWER, INC., AND ARE NOT TO BE COPIED, REPRODUCED OR USED IN ANY MANNER FOR ANY PURPOSE WHATSOEVER WITHOUT WRITTEN CONSENT OR DIRECTION.

ENGINEERED & MANUFACTURED BY
Controlled Power, Inc.
BOTHELL, WASHINGTON USA
(425)-485-1778 www.controlledpowerinc.com

2351
2352
2353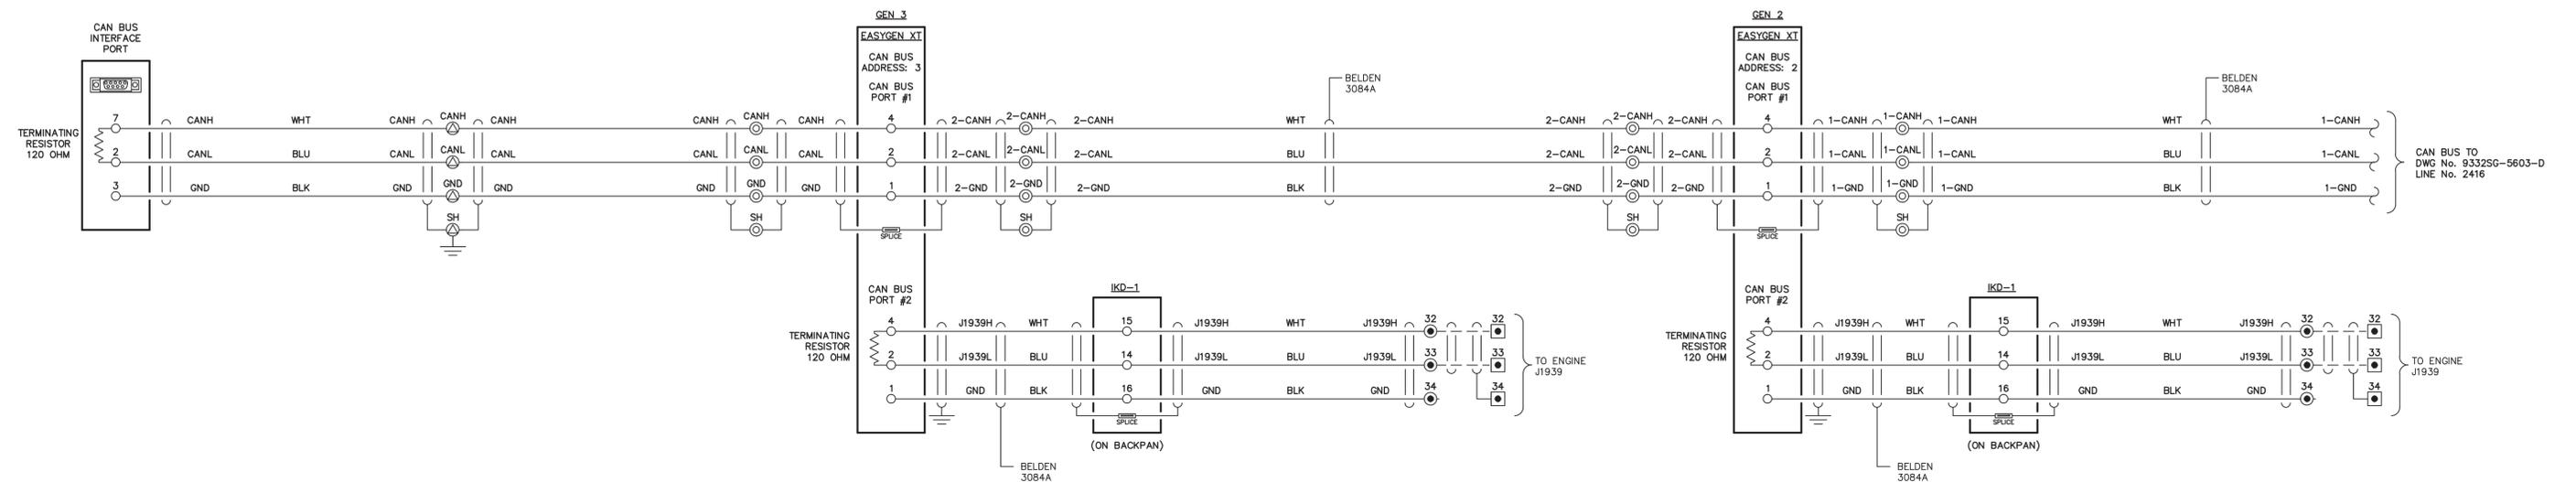
NOTE:
1. FOR GENERAL WIRING & CONSTRUCTION NOTES, SEE DRAWING No. 9332SG-3101-D.


D	09-18-24	SHOP AS BUILT	GJG
REV.	DATE	DESCRIPTION	BY
AEA PURCHASE ORDER No. P0010800		CONTROLLED POWER JOB No. 9332SG	
TITLE: COMMUNICATION NETWORK, SCHEMATIC DIAGRAM			
SCALE: NONE	DATE: 11-29-23	DWN. BY: GPN	
DWG. No: 9332SG-5602-D	SHEET: 1 OF 1	CKD. BY: JMD	
JOB: MANOKOTAK POWER SYSTEM UPGRADE			

ALASKA ENERGY AUTHORITY
RURAL ENERGY GROUP
813 W. NORTHERN LIGHTS BLVD.
ANCHORAGE, ALASKA 99503
HTTP://WWW.AIDEA.ORG

Controlled Power, Inc.
ENGINEERED & MANUFACTURED BY
BOTHELL, WASHINGTON USA
(425)-485-1778 www.controlleddpowerinc.com

NOTICE
THE DRAWINGS, INFORMATION AND SUBJECT MATTER HEREOF ARE THE CONFIDENTIAL, SOLE AND EXCLUSIVE PROPERTY OF CONTROLLED POWER, INC., AND ARE NOT TO BE COPIED, REPRODUCED OR USED IN ANY MANNER FOR ANY PURPOSE WHATSOEVER WITHOUT WRITTEN CONSENT OR DIRECTION.

2401
2402
2403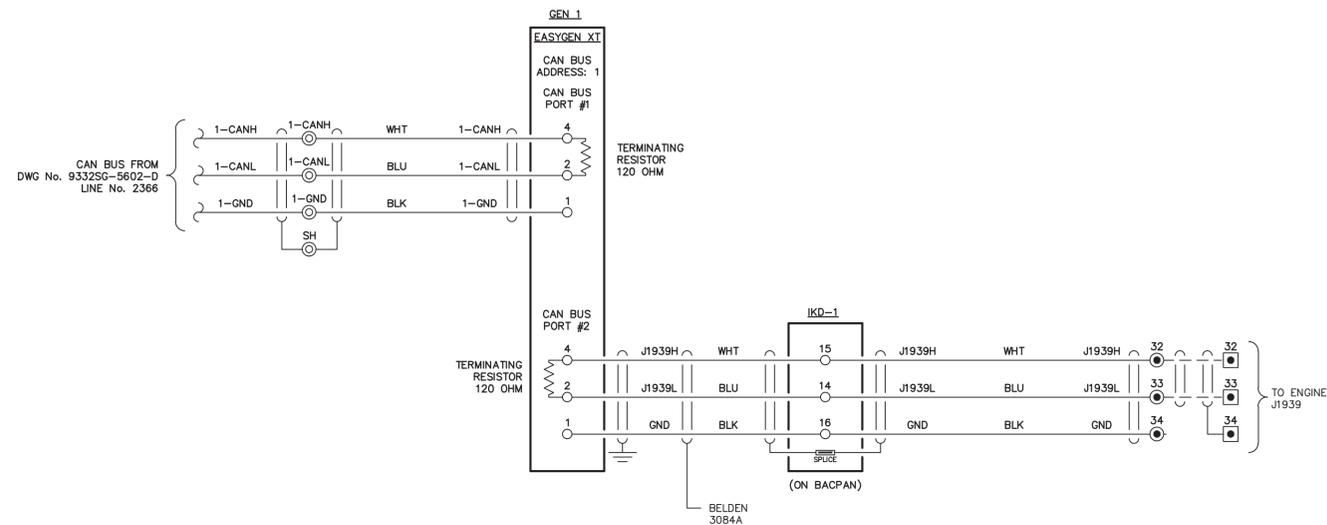
NOTE:
1. FOR GENERAL WIRING & CONSTRUCTION NOTES, SEE DRAWING No. 9332SG-3101-D.

REV.	DATE	DESCRIPTION	BY
D	09-18-24	SHOP AS BUILT	GJG
AEA PURCHASE ORDER No. P0010800		CONTROLLED POWER JOB No. 9332SG	
TITLE: COMMUNICATION NETWORK, SCHEMATIC DIAGRAM			
SCALE: NONE	DATE: 11-29-23	DWN. BY: GPN	
DWG. No: 9332SG-5603-D	SHEET: 1 OF 1	CKD. BY: JMD	
JOB: MANOKOTAK POWER SYSTEM UPGRADE			

ALASKA ENERGY AUTHORITY
RURAL ENERGY GROUP
813 W. NORTHERN LIGHTS BLVD.
ANCHORAGE, ALASKA 99503
HTTP://WWW.AIDEA.ORG

NOTICE
THE DRAWINGS, INFORMATION AND SUBJECT MATTER HEREOF ARE THE CONFIDENTIAL, SOLE AND EXCLUSIVE PROPERTY OF CONTROLLED POWER, INC. AND ARE NOT TO BE COPIED, REPRODUCED OR USED IN ANY MANNER FOR ANY PURPOSE WHATSOEVER WITHOUT WRITTEN CONSENT OR DIRECTION.

ENGINEERED & MANUFACTURED BY
Controlled Power, Inc.
BOTHELL, WASHINGTON USA
(425)-485-1778 www.controlledpowerinc.com

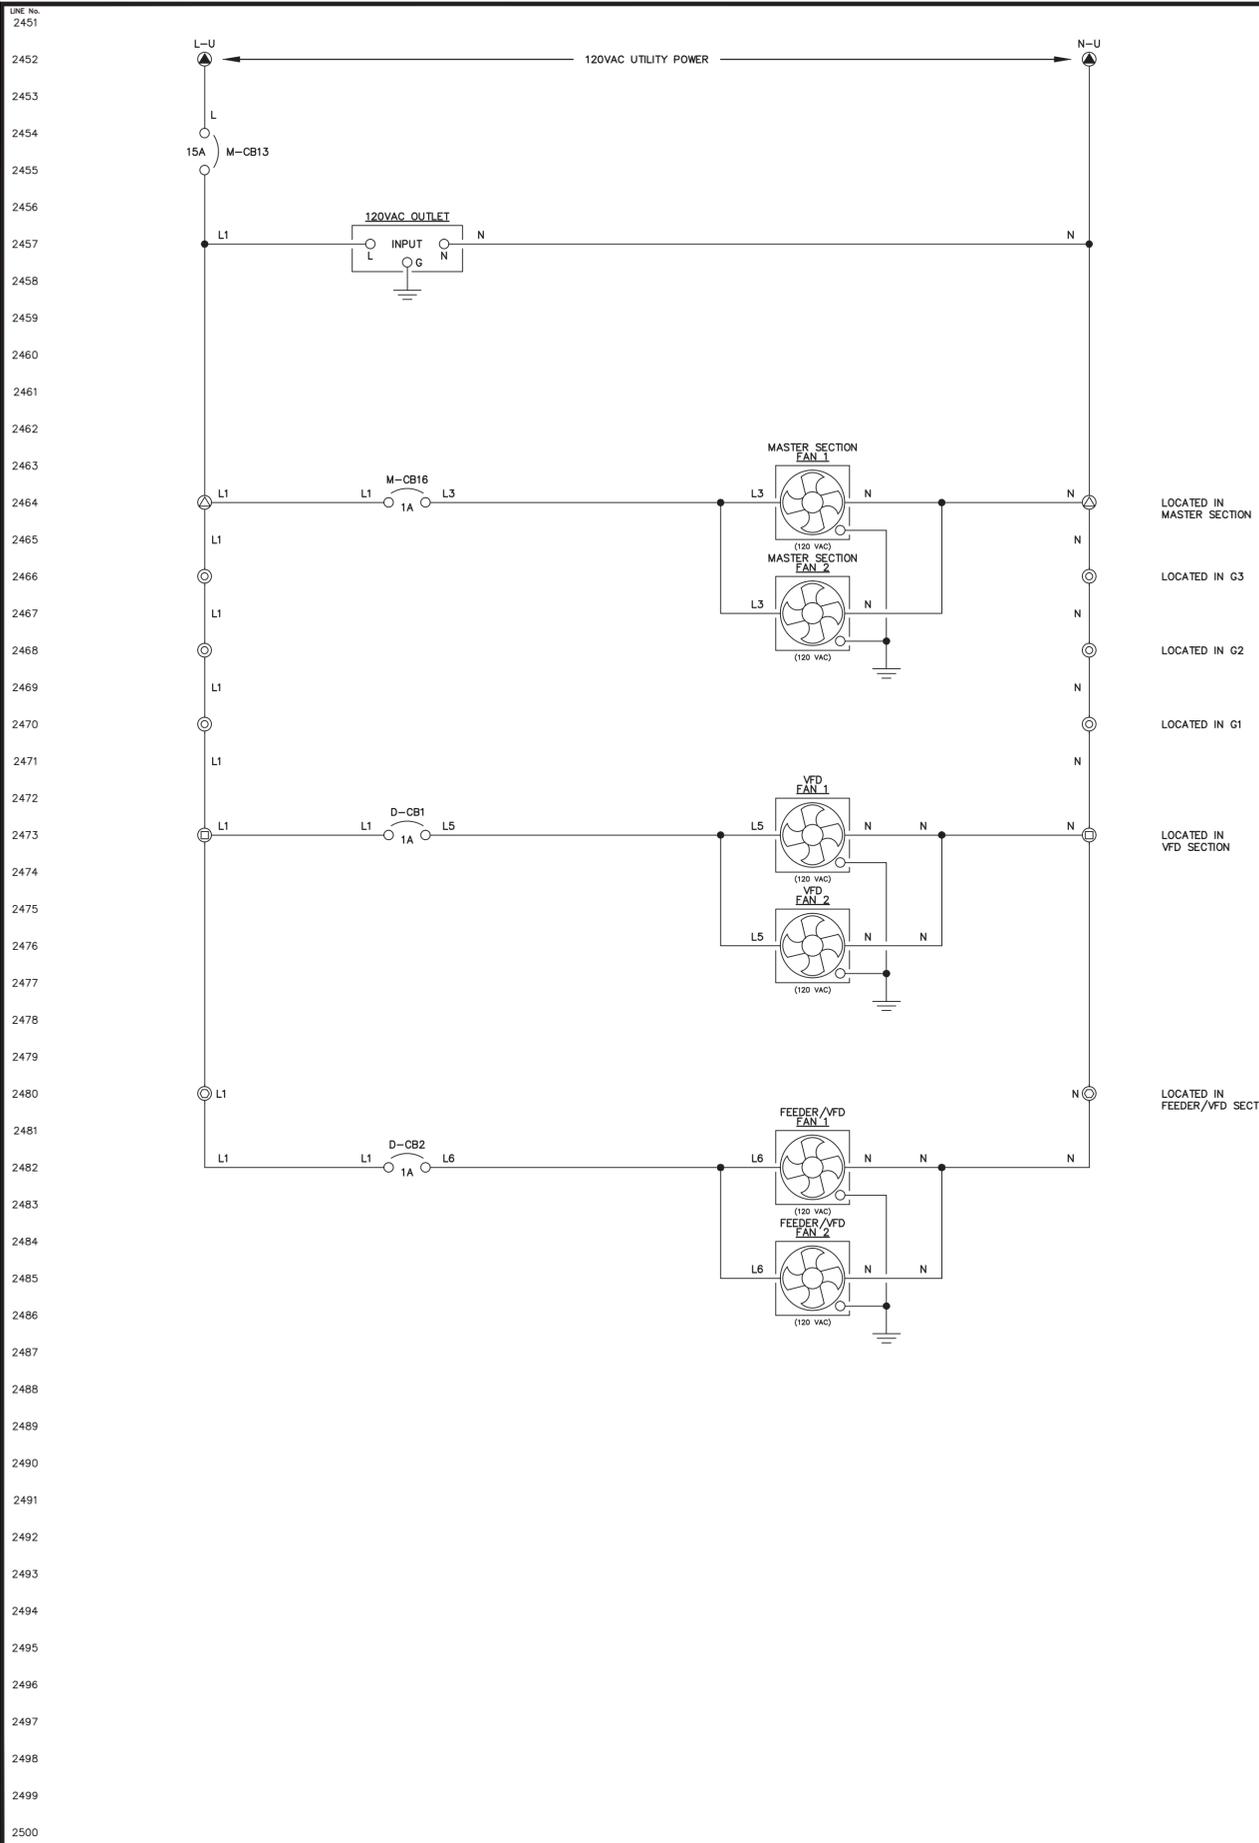

2501		2501
2502		2502
2503		2503
2504		2504
2505		2505
2506		2506
2507		2507
2508		2508
2509		2509
2510		2510
2511		2511
2512		2512
2513		2513
2514	LOCATED IN MASTER SECTION	2514
2515		2515
2516	LOCATED IN G3	2516
2517		2517
2518	LOCATED IN G2	2518
2519		2519
2520	LOCATED IN G1	2520
2521		2521
2522		2522
2523	LOCATED IN VFD SECTION	2523
2524		2524
2525		2525
2526		2526
2527		2527
2528		2528
2529		2529
2530	LOCATED IN FEEDER/VFD SECTION	2530
2531		2531
2532		2532
2533		2533
2534		2534
2535		2535
2536		2536
2537		2537
2538		2538
2539		2539
2540		2540
2541		2541
2542		2542
2543		2543
2544		2544
2545		2545
2546		2546
2547		2547
2548		2548
2549		2549
2550		2550

NOTE:
1. FOR GENERAL WIRING & CONSTRUCTION NOTES, SEE DRAWING No. 9332SG-3101-D.


D	09-18-24	SHOP AS BUILT	GJG
REV.	DATE	DESCRIPTION	BY
AEA PURCHASE ORDER No. P0010800 CONTROLLED POWER JOB No. 9332SG			
TITLE: AC CONTROL, SCHEMATIC DIAGRAM			
SCALE: NONE	DATE: 11-29-23	DWN. BY: GPN	
DWG. No: 9332SG-5701-D	SHEET: 1 OF 1	CKD. BY: JMD	
JOB: MANOKOTAK POWER SYSTEM UPGRADE			

ALASKA ENERGY AUTHORITY
RURAL ENERGY GROUP
813 W. NORTHERN LIGHTS BLVD.
ANCHORAGE, ALASKA 99503
HTTP://WWW.AIDEA.ORG

NOTICE
THE DRAWINGS, INFORMATION AND SUBJECT MATTER HEREOF ARE THE CONFIDENTIAL, SOLE AND EXCLUSIVE PROPERTY OF CONTROLLED POWER, INC., AND ARE NOT TO BE COPIED, REPRODUCED OR USED IN ANY MANNER FOR ANY PURPOSE WHATSOEVER WITHOUT WRITTEN CONSENT OR DIRECTION.

ENGINEERED & MANUFACTURED BY
Controlled Power, Inc.
BOTHELL, WASHINGTON USA
(425)-485-1778 www.controlledpowerinc.com

2551
2552
2553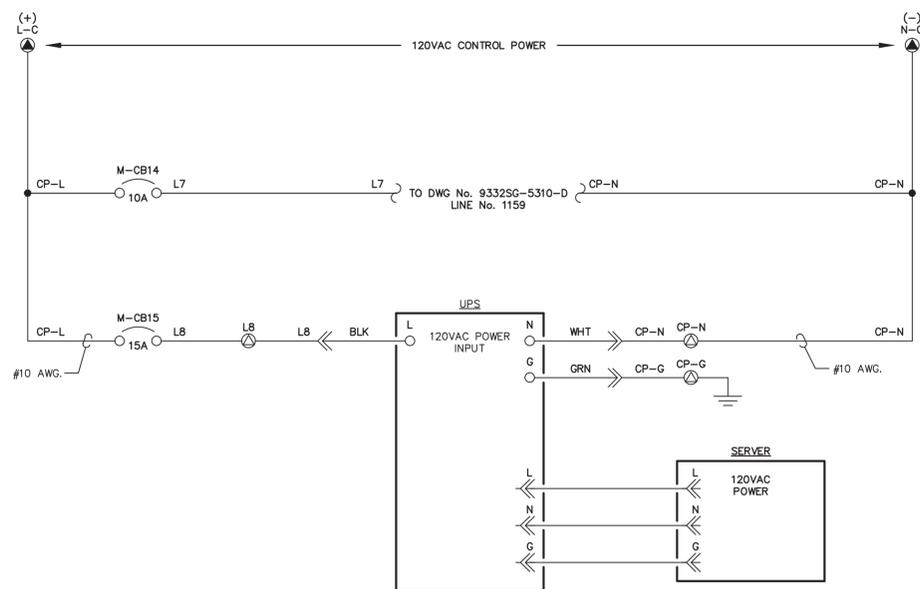
NOTE:
1. FOR GENERAL WIRING & CONSTRUCTION NOTES, SEE DRAWING No. 9332SG-3101-D.


REV.	DATE	DESCRIPTION	BY
D	09-18-24	SHOP AS BUILT	GJG
AEA PURCHASE ORDER No. P0010800 CONTROLLED POWER JOB No. 9332SG			
TITLE: AC CONTROL, SCHEMATIC DIAGRAM			
SCALE: NONE	DATE: 11-29-23	DWN. BY: GPN	
DWG. No: 9332SG-5702-D	SHEET: 1 OF 1	CKD. BY: JMD	
JOB: MANOKOTAK POWER SYSTEM UPGRADE			

ALASKA ENERGY AUTHORITY
RURAL ENERGY GROUP
813 W. NORTHERN LIGHTS BLVD.
ANCHORAGE, ALASKA 99503
HTTP://WWW.AIDEA.ORG

NOTICE
THE DRAWINGS, INFORMATION AND SUBJECT MATTER HEREOF ARE THE CONFIDENTIAL, SOLE AND EXCLUSIVE PROPERTY OF CONTROLLED POWER, INC., AND ARE NOT TO BE COPIED, REPRODUCED OR USED IN ANY MANNER FOR ANY PURPOSE WHATSOEVER WITHOUT WRITTEN CONSENT OR DIRECTION.

ENGINEERED & MANUFACTURED BY
Controlled Power, Inc.
BOTHHELL, WASHINGTON USA
(425)-485-1778 www.controlledpowerinc.com


SYSTEM MODE SWITCH – SMS

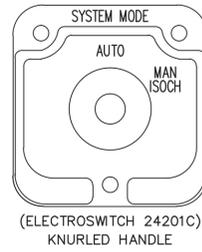

DECK	CONTACTS		POS.	
	AUTO	MAN ISOCH	AUTO	MAN ISOCH
1	12	11	X	X
	13	13	X	X
1	16	15	X	X
	17	17	X	X
1	11	18	X	X
	12	12	X	X
1	15	14	X	X
	16	16	X	X

(ELECTROSWITCH 24201C)
KNURLED HANDLE

BREAKER CONTROL SWITCH – 52CS

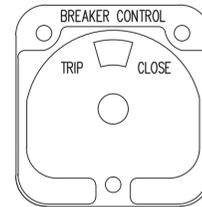


DECK	CONTACTS		POS.	
	TRIP	NORM. CLOSE	TRIP	NORM. CLOSE
1	11	18	X	X
	16	17	X	X

(ELECTROSWITCH 2438D)
PISTOL GRIP HANDLE
SPRING RETURN TO CENTER

GENERATOR LOCKOUT SWITCH – GLS

OFF GEN LOCKOUT RUN

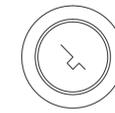


POS	
OFF	RUN
X	
	X



KEY OPERATED
2 POS MAINTAINED

VARIABLE FREQUENCY DRIVE MODE SWITCH – VFDMS

VFD OFF BYPASS

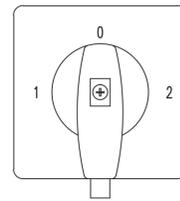

71322		44	34	1L1	1L2	1L3	2L1	2L2	2L3	53	63
POSITION	43	33	1T1	1T2	1T3	2T1	2T2	2T3	54	64	POSITION
	SMD	1	MD	71300						ME	2

3 POS MAINTAINED

NOTE:

- FOR GENERAL WIRING & CONSTRUCTION NOTES, SEE DRAWING No. 9332SG-3101-D.

REV.	DATE	DESCRIPTION	BY
D	09-18-24	SHOP AS BUILT	GJG

AEA PURCHASE ORDER No. P0010800 CONTROLLED POWER JOB No. 9332SG

TITLE: CONTROL SWITCH TARGET DIAGRAM

SCALE: NONE DATE: 11-29-23 DWN. BY: GPN









DWG. No: 9332SG-6101-D SHEET: 1 OF 1 CKD. BY: JMD

JOB: MANOKOTAK POWER SYSTEM UPGRADE

ALASKA ENERGY AUTHORITY
RURAL ENERGY GROUP
813 W. NORTHERN LIGHTS BLVD.
ANCHORAGE, ALASKA 99503
HTTP://WWW.AIDEA.ORG

NOTICE
THE DRAWINGS, INFORMATION AND SUBJECT MATTER HEREOF ARE THE CONFIDENTIAL, SOLE AND EXCLUSIVE PROPERTY OF CONTROLLED POWER, INC., AND ARE NOT TO BE COPIED, REPRODUCED OR USED IN ANY MANNER FOR ANY PURPOSE WHATSOEVER WITHOUT WRITTEN CONSENT OR DIRECTION.


ENGINEERED & MANUFACTURED BY
Controlled Power, Inc.
BOTHELL, WASHINGTON USA
(425)-485-1778 www.controlledpowerinc.com

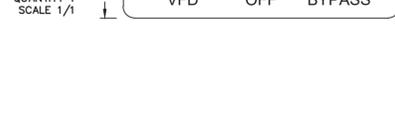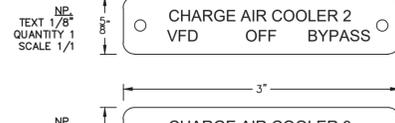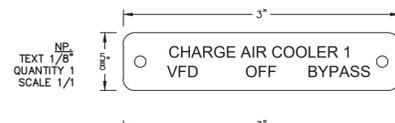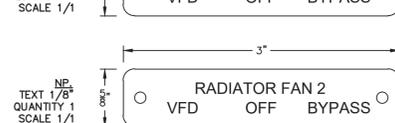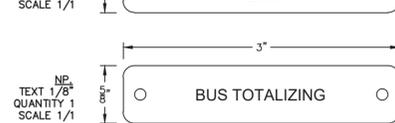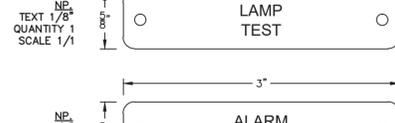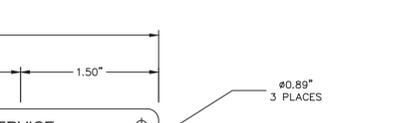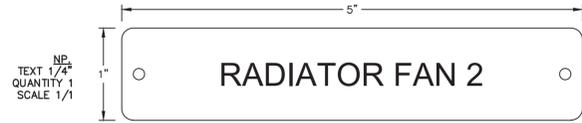

- NOTES:**
- ALL NAMEPLATES SHALL BE BLACK FACE WITH WHITE LETTERS EXCEPT AS NOTED.
 - ALL NAMEPLATES SHALL HAVE PRESSURE SENSITIVE ADHESIVE ON BACK, 100 % COVERAGE.
 - ALL NAMEPLATES SHALL HAVE MOUNTING HOLES DRILLED AS INDICATED.
- ▲ INDICATES THAT NAMEPLATE SHALL BE BRUSHED ALUMINUM WITH BLACK ENGRAVED LETTERS.

NOTE:

- FOR GENERAL WIRING & CONSTRUCTION NOTES, SEE DRAWING No. 9332SG-3101-D.

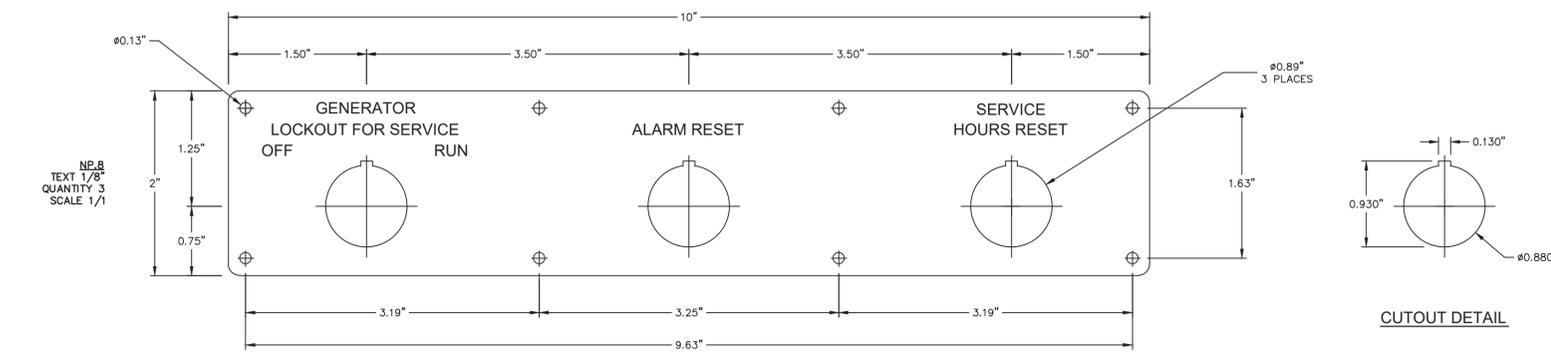


NOTICE
THE DRAWINGS, INFORMATION AND SUBJECT MATTER HEREOF ARE THE CONFIDENTIAL, SOLE AND EXCLUSIVE PROPERTY OF CONTROLLED POWER, INC., AND ARE NOT TO BE COPIED, REPRODUCED OR USED IN ANY MANNER FOR ANY PURPOSE WHATSOEVER WITHOUT WRITTEN CONSENT OR DIRECTION.


D	09-18-24	SHOP AS BUILT	GJG
REV.	DATE	DESCRIPTION	BY
AEA PURCHASE ORDER No. P0010800		CONTROLLED POWER JOB No. 9332SG	
TITLE: NAMEPLATE ENGRAVING SCHEDULE, FABRICATION DIAGRAM			
SCALE: NONE	DATE: 11-29-23	DWN. BY: GPN	
DWG. No: 9332SG-6201-D	SHEET: 1 OF 1	CKD. BY: JMD	
JOB: MANOKOTAK POWER SYSTEM UPGRADE			

ALASKA ENERGY AUTHORITY
RURAL ENERGY GROUP
813 W. NORTHERN LIGHTS BLVD.
ANCHORAGE, ALASKA 99503
HTTP://WWW.AIDEA.ORG


Controlled Power, Inc.
ENGINEERED & MANUFACTURED BY
BOTHELL, WASHINGTON USA
(425)-485-1778 www.controlledpowerinc.com

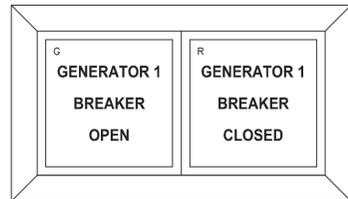


GEN 1 BREAKER ANNUNCIATOR
QTY 1

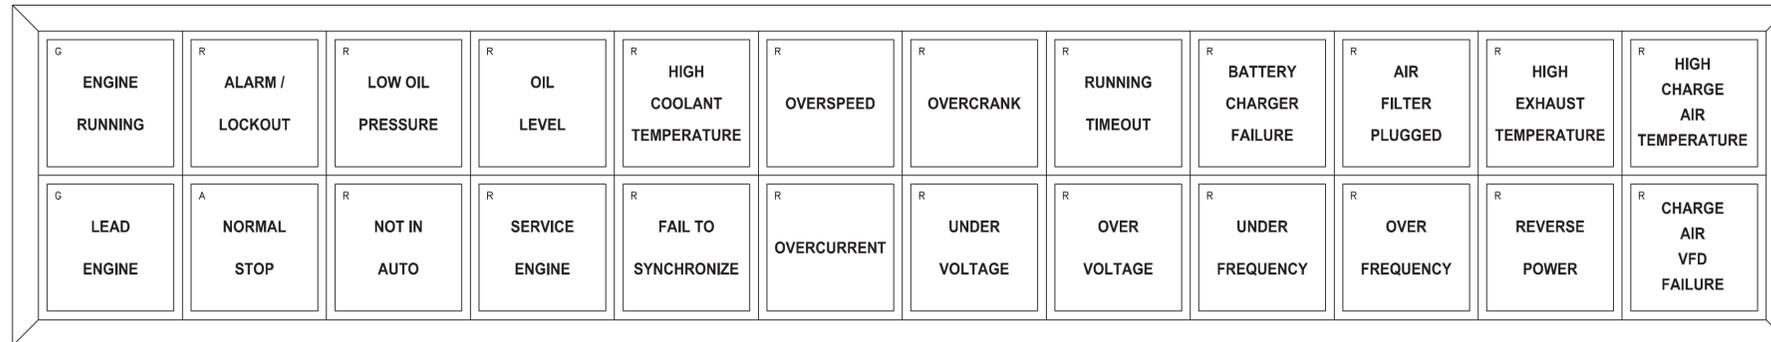


GENERATOR ANNUNCIATOR
QTY 3

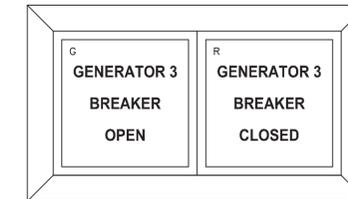


GEN 3 BREAKER ANNUNCIATOR
QTY 1

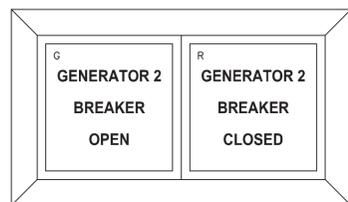


GEN 2 BREAKER ANNUNCIATOR
QTY 1

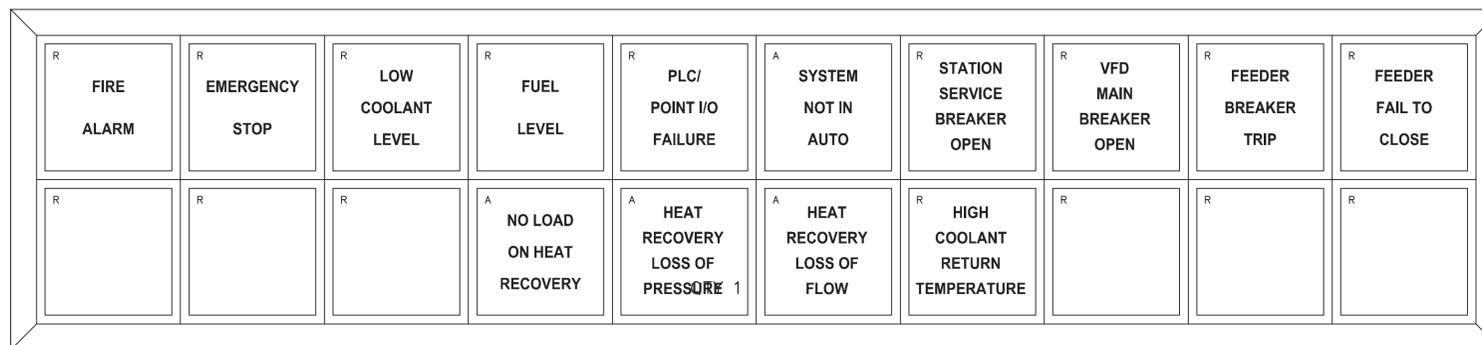

MASTER ANNUNCIATOR
QTY 1

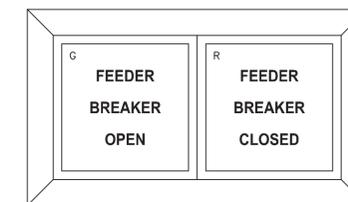

FEEDER F1 BREAKER ANNUNCIATOR
QTY 1

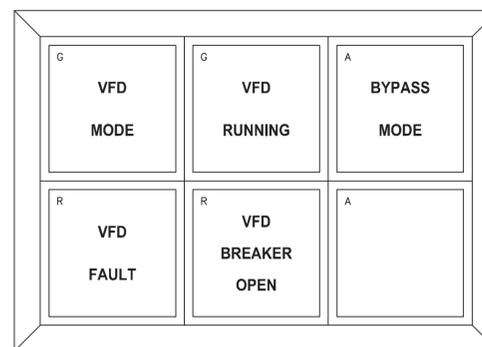

VFD ANNUNCIATOR
QTY 5

REV.	DATE	DESCRIPTION	BY
D	09-18-24	SHOP AS BUILT	GJG

AEA PURCHASE ORDER No. P0010800 CONTROLLED POWER JOB No. 9332SG

TITLE: ANNUNCIATOR WINDOWS, FABRICATION DIAGRAM

SCALE: NONE DATE: 11-29-23 DWN. BY: GPN

DWG. No: 9332SG-6202-D SHEET: 1 OF 1 CKD. BY: JMD




JOB: MANOKOTAK POWER SYSTEM UPGRADE

ALASKA ENERGY AUTHORITY
RURAL ENERGY GROUP
813 W. NORTHERN LIGHTS BLVD.
ANCHORAGE, ALASKA 99503
HTTP://WWW.AIDEA.ORG



ENGINEERED & MANUFACTURED BY
Controlled Power, Inc.
BOTHELL, WASHINGTON USA
(425)-485-1778 www.controlledpowerinc.com

NOTICE
THE DRAWINGS, INFORMATION AND SUBJECT MATTER HEREOF ARE THE CONFIDENTIAL, SOLE AND EXCLUSIVE PROPERTY OF CONTROLLED POWER, INC., AND ARE NOT TO BE COPIED, REPRODUCED OR USED IN ANY MANNER FOR ANY PURPOSE WHATSOEVER WITHOUT WRITTEN CONSENT OR DIRECTION.

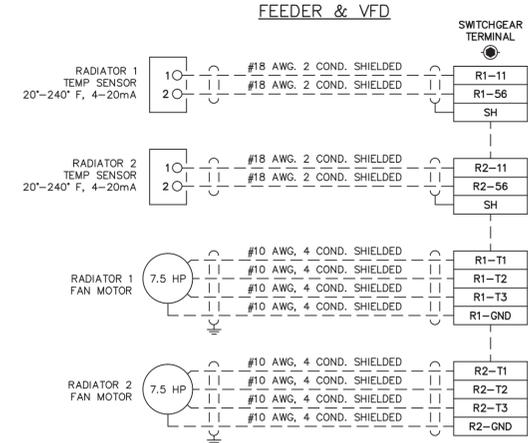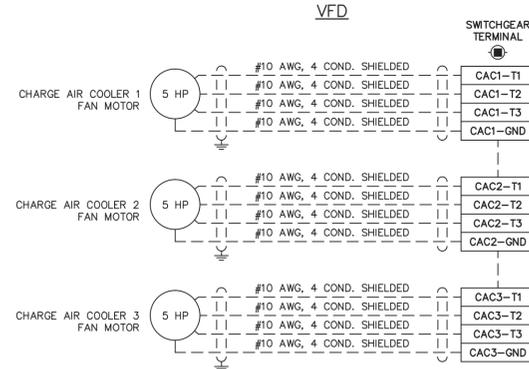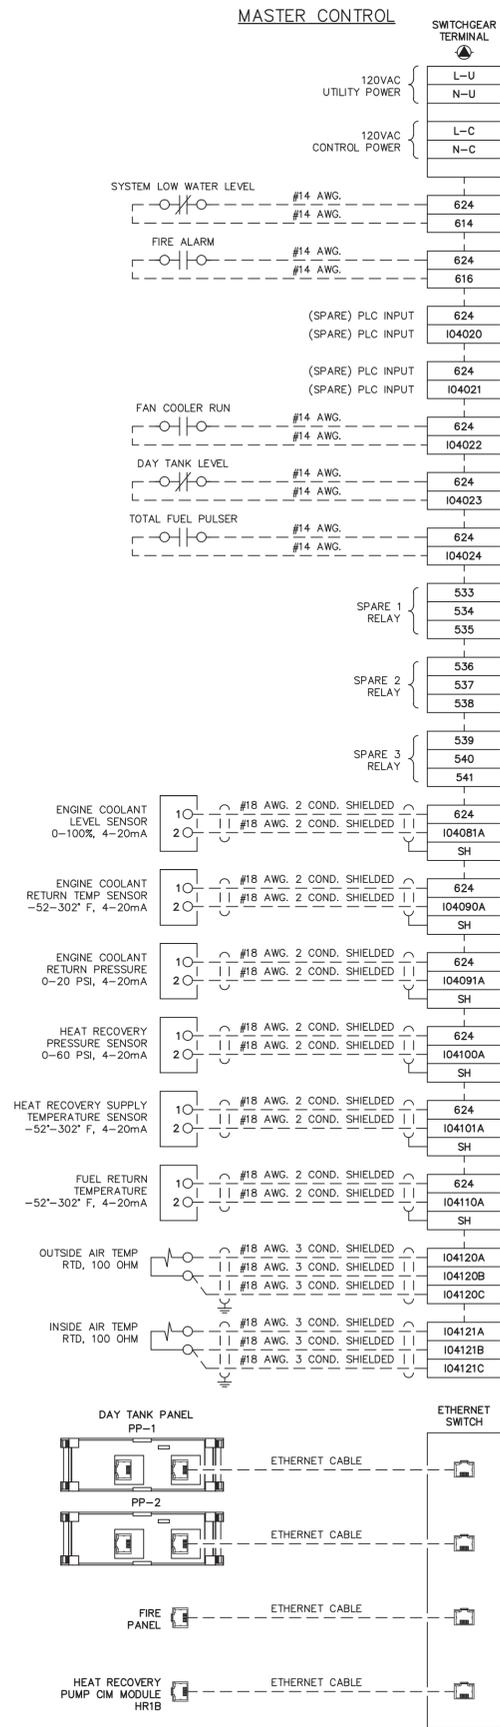

NOTE:
1. FOR GENERAL WIRING & CONSTRUCTION NOTES, SEE DRAWING No. 9332SG-3101-D.

REV.	DATE	DESCRIPTION	BY
D	09-18-24	SHOP AS BUILT	GJG

AEA PURCHASE ORDER No. P0010800 CONTROLLED POWER JOB No. 9332SG

TITLE: INTERCONNECTION DIAGRAM

SCALE: NONE DATE: 11-29-23 DWN. BY: GPN




DWG. No: 9332SG-7101-D SHEET: 1 OF 1 CKD. BY: JMD

JOB: MANOKOTAK POWER SYSTEM UPGRADE

ALASKA ENERGY AUTHORITY
RURAL ENERGY GROUP
813 W. NORTHERN LIGHTS BLVD.
ANCHORAGE, ALASKA 99503
HTTP://WWW.AIDEA.ORG

NOTICE
THE DRAWINGS, INFORMATION AND SUBJECT MATTER HEREOF ARE THE CONFIDENTIAL, SOLE AND EXCLUSIVE PROPERTY OF CONTROLLED POWER, INC., AND ARE NOT TO BE COPIED, REPRODUCED OR USED IN ANY MANNER FOR ANY PURPOSE WHATSOEVER WITHOUT WRITTEN CONSENT OR DIRECTION.

ENGINEERED & MANUFACTURED BY
Controlled Power, Inc.
BOTHELL, WASHINGTON USA
(425)-485-1778 www.controlledpowerinc.com

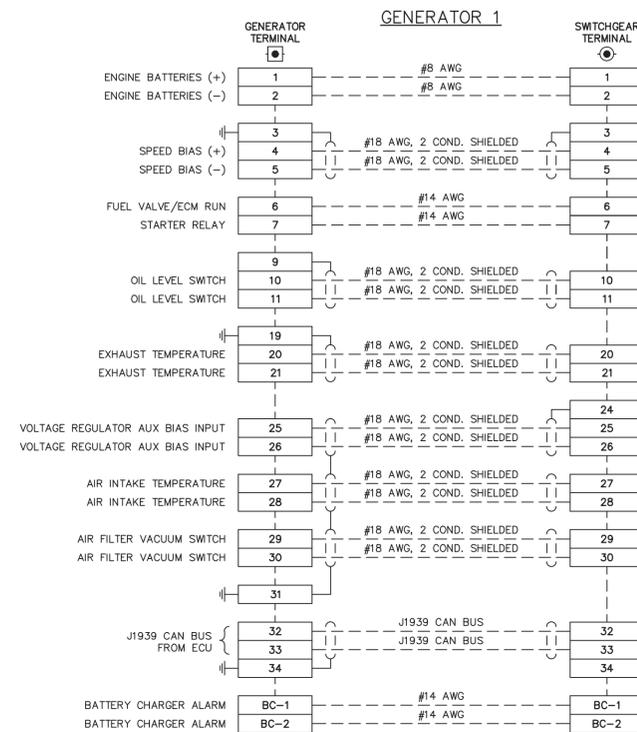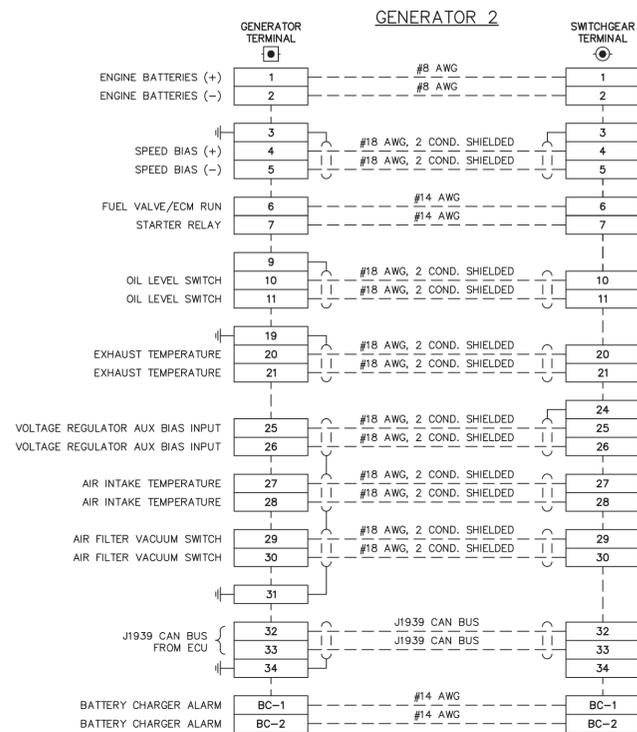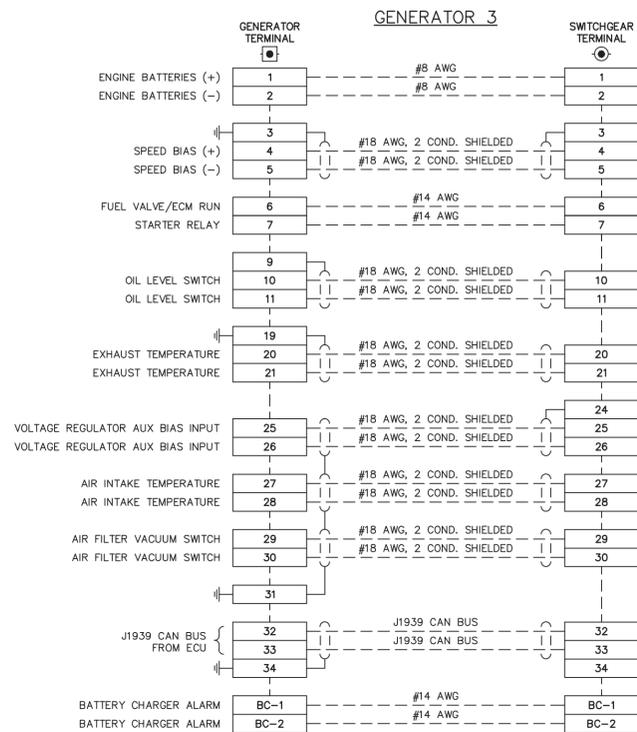

NOTE:
1. FOR GENERAL WIRING & CONSTRUCTION NOTES, SEE DRAWING No. 9332SG-3101-D.

D	09-18-24	SHOP AS BUILT	GJG
REV.	DATE	DESCRIPTION	BY
AEA PURCHASE ORDER No. P0010800		CONTROLLED POWER JOB No. 9332SG	
TITLE: INTERCONNECTION DIAGRAM			
SCALE: NONE	DATE: 11-29-23	DWN. BY: GPN	
DWG. No: 9332SG-7102-D	SHEET: 1 OF 1	CKD. BY: JMD	
JOB: MANOKOTAK POWER SYSTEM UPGRADE			

ALASKA ENERGY AUTHORITY
RURAL ENERGY GROUP
813 W. NORTHERN LIGHTS BLVD.
ANCHORAGE, ALASKA 99503
HTTP://WWW.AIDEA.ORG

NOTICE
THE DRAWINGS, INFORMATION AND SUBJECT MATTER HEREOF ARE THE CONFIDENTIAL, SOLE AND EXCLUSIVE PROPERTY OF CONTROLLED POWER, INC., AND ARE NOT TO BE COPIED, REPRODUCED OR USED IN ANY MANNER FOR ANY PURPOSE WHATSOEVER WITHOUT WRITTEN CONSENT OR DIRECTION.

ENGINEERED & MANUFACTURED BY
Controlled Power, Inc.
BOTHELL, WASHINGTON USA
(425)-485-1778 www.controlleddpowerinc.com

MASTER SECTION


GEN 3 SECTION

GEN 2 SECTION

GEN 1 SECTION

VFD SECTION

FEEDER SECTION

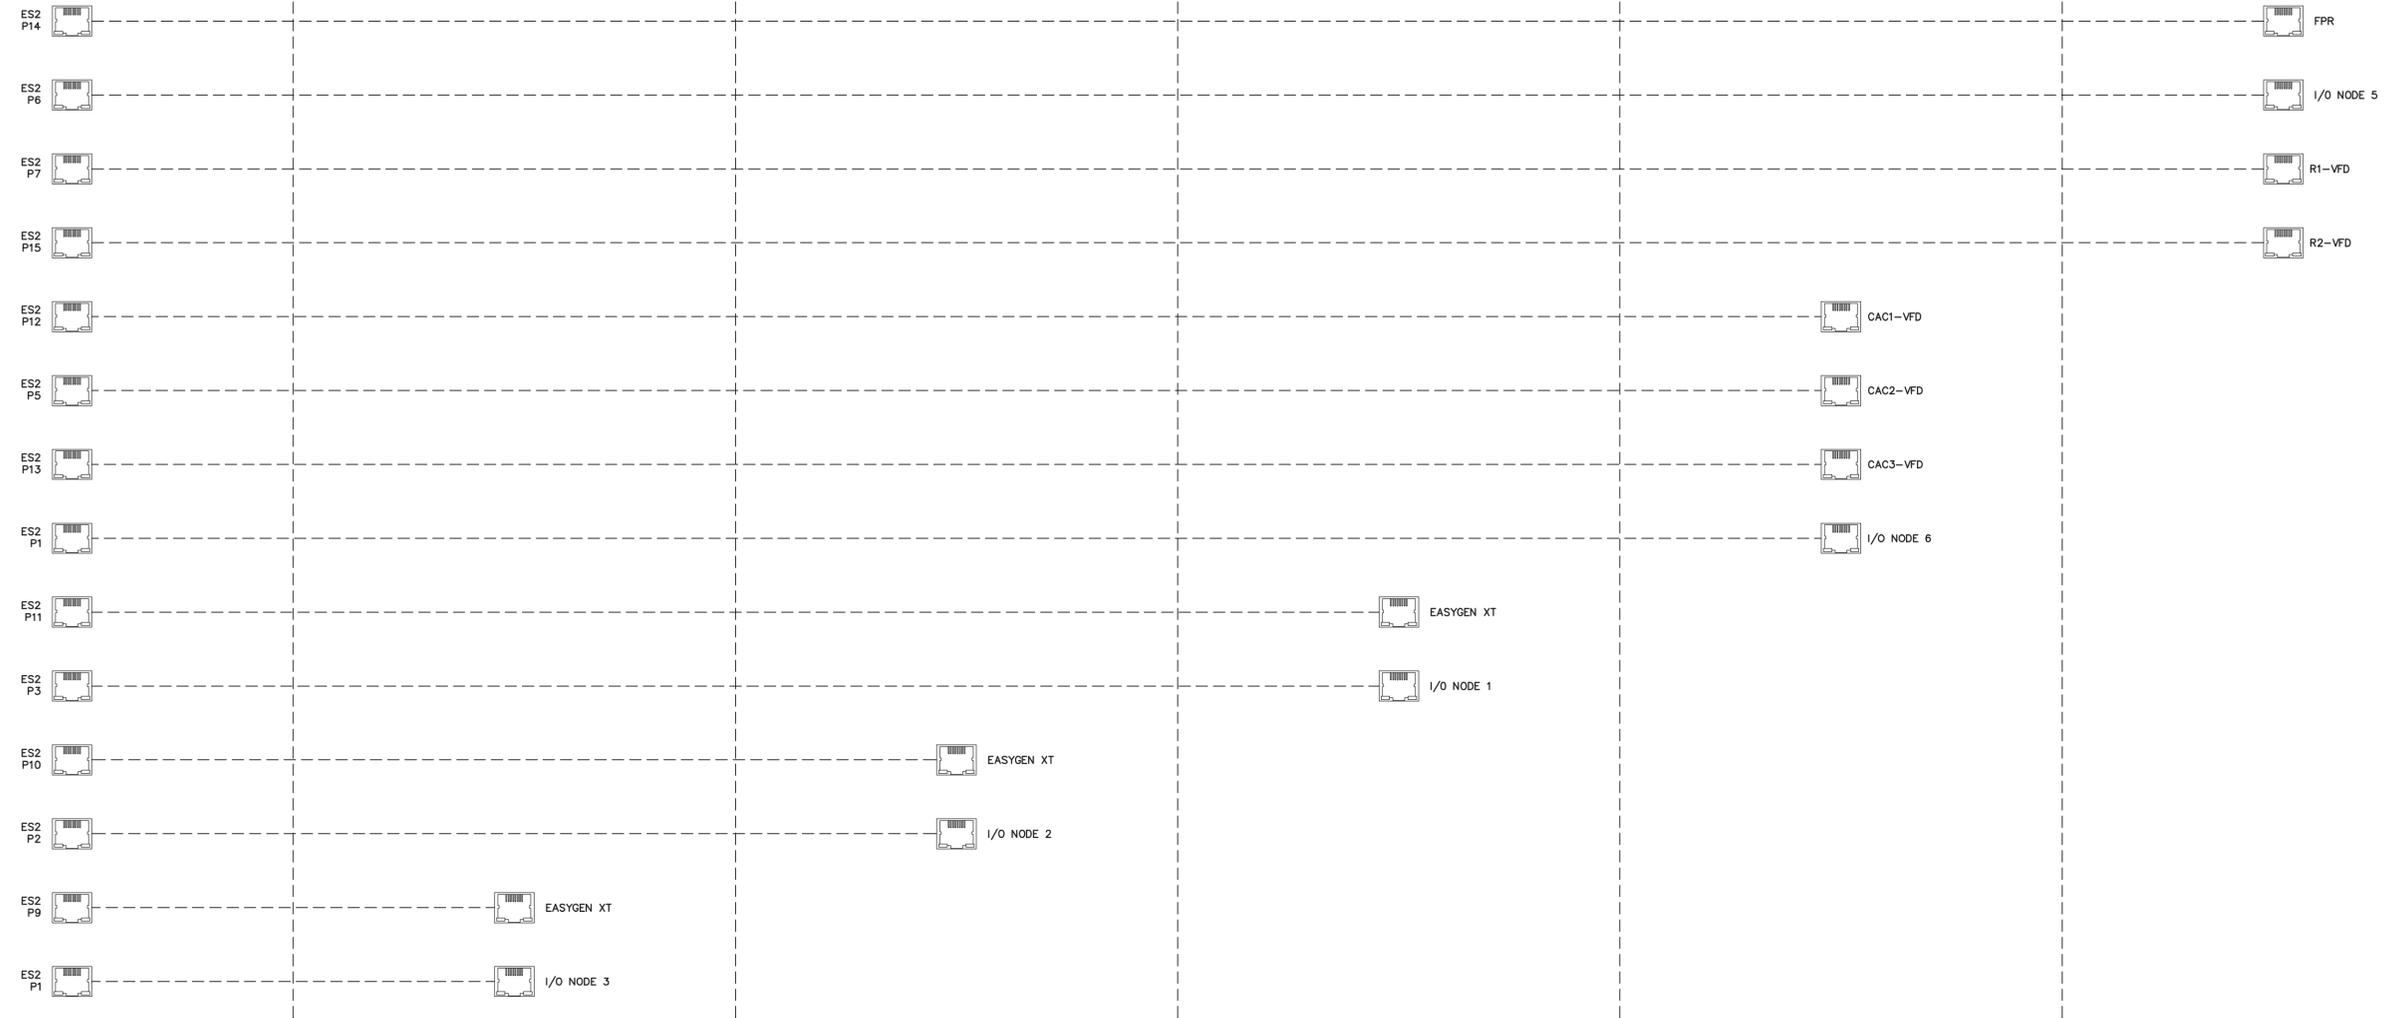

NOTE:

- FOR GENERAL WIRING & CONSTRUCTION NOTES, SEE DRAWING No. 9332SG-3101-D.

REV.	DATE	DESCRIPTION	BY
D	09-18-24	SHOP AS BUILT	GJG

AEA PURCHASE ORDER No. P0010800 CONTROLLED POWER JOB No. 9332SG

TITLE: ETHERNET SHIPPING SPLIT, INTERCONNECTION DIAGRAM

SCALE: NONE DATE: 11-29-23 DWN. BY: GPN

DWG. No: 9332SG-7103-D SHEET: 1 OF 1 CKD. BY: JMD

JOB: MANOKOTAK POWER SYSTEM UPGRADE

ALASKA ENERGY AUTHORITY
 RURAL ENERGY GROUP
 813 W. NORTHERN LIGHTS BLVD.
 ANCHORAGE, ALASKA 99503
 HTTP://WWW.AIDEA.ORG

Controlled Power, Inc.
 ENGINEERED & MANUFACTURED BY
 BOTHELL, WASHINGTON USA
 (425)-485-1778 www.controlleddpowerinc.com

NOTICE
 THE DRAWINGS, INFORMATION AND SUBJECT MATTER HEREOF ARE THE CONFIDENTIAL, SOLE AND EXCLUSIVE PROPERTY OF CONTROLLED POWER, INC., AND ARE NOT TO BE COPIED, REPRODUCED OR USED IN ANY MANNER FOR ANY PURPOSE WHATSOEVER WITHOUT WRITTEN CONSENT OR DIRECTION.