

CLARK'S POINT & PORT HEIDEN RURAL POWER SYSTEM UPGRADE PROJECTS

ITB 19041 - MODULAR POWER PLANT ASSEMBLY

CLARK'S POINT MODULAR POWER PLANT ASSEMBLY DESIGN DRAWINGS

M1.1 MECHANICAL LEGEND, SCHEDULES, & SEQUENCE OF OPERATIONS
M1.2 WARNING SIGN & FIRE EXTINGUISHER PLAN, SIGN & VALVE TAG SCHEDULES
M2.1 MECHANICAL PENETRATIONS PLAN, ELEVATION, & DETAILS
M2.2 MECHANICAL SUPPORT PLANS & DETAILS
M2.3 RADIATOR SUPPORT PLAN & DETAILS
M2.4 MECHANICAL SUPPORT HORIZONTAL WALL STRUT INSTALLATION
M2.5 MECHANICAL SUPPORT VERTICAL WALL STRUT INSTALLATION
M3.1 EQUIPMENT LAYOUT PLAN, SECTIONS, & DETAILS
M3.2 WALL ELEVATIONS & PIPING DETAILS
M3.3 GENERATOR FABRICATION DETAILS
M3.4 GLYCOL STORAGE & EXPANSION TANK FABRICATION
M4.1 COOLANT & HEAT RECOVERY PIPING PLAN & DETAILS
M4.2 COOLANT & HEAT RECOVERY ISOMETRICS & DETAILS
M5.1 DIESEL FUEL & USED OIL PIPING PLAN, DIAGRAM, & DETAILS
M5.2 DIESEL FUEL & USED OIL PIPING ELEVATIONS & DETAILS
M5.3 200 GALLON DAY TANK FABRICATION
M5.4 USED OIL BLENDER FILTER BANK LAYOUT & CONFIGURATION
M5.5 USED OIL BLENDER TYPICAL FILTER HOUSING DETAILS
M5.6 USED OIL BLENDER 25 GALLON HOPPER FABRICATION
M6 EXHAUST & CRANK VENT PLAN & DETAILS
M7.1 VENTILATION PLAN & DETAILS
M7.2 SHEET METAL FABRICATION DETAILS
FS1 FIRE SUPPRESSION SYSTEM PLAN, SECTION, LEGEND, & NOTES
E1.1 ELECTRICAL LEGENDS & SCHEDULES
E3.1 WIREWAY PLAN, MODULE SECTION, & DETAILS
E3.2 ELEVATIONS & DETAILS
E3.3 ELEVATIONS & DETAILS
E4.1 RECEPTACLE & LIGHTING PLANS & STATION SERVICE PANEL
E4.2 STATION SERVICE PLAN, DETAILS, & PANEL
E5 INSTRUMENTATION & DATA PLANS & DETAILS
E6.1 SWITCHGEAR ENCLOSURE LAYOUT
E6.2 SWITCHGEAR ONE-LINE & SCHEMATICS
E6.3 24VDC ENGINE WIRING JUNCTION BOX
E6.4 BOILER SCR PANEL 3-LINE & SCHEMATICS
E7.1 FUEL SYSTEM CONTROL PANEL LOGIC DIAGRAM & BILL OF MATERIALS
E7.2 FUEL SYSTEM CONTROL PANEL LAYOUT & TERMINAL STRIPS
E7.3 FUEL SYSTEM CONTROL PANEL SEQUENCE OF OPERATION & DETAILS
A1 FLOOR PLAN, REFLECTED CEILING PLAN, CODE ANALYSIS, & GENERAL NOTES
A2 INTERIOR ELEVATIONS & DOOR/WINDOW DETAILS

PORT HEIDEN MODULAR POWER PLANT ASSEMBLY DESIGN DRAWINGS

M1.1 MECHANICAL LEGEND, SCHEDULES, & SEQUENCE OF OPERATIONS
M1.2 WARNING SIGN & FIRE EXTINGUISHER PLAN, SIGN & VALVE TAG SCHEDULES
M2.1 MECHANICAL PENETRATIONS PLAN, ELEVATION, & DETAILS
M2.2 MECHANICAL SUPPORT PLANS & DETAILS
M2.3 RADIATOR SUPPORT PLAN & DETAILS
M2.4 MECHANICAL SUPPORT HORIZONTAL WALL STRUT INSTALLATION
M2.5 MECHANICAL SUPPORT VERTICAL WALL STRUT INSTALLATION
M3.1 EQUIPMENT LAYOUT PLAN, SECTIONS, & DETAILS
M3.2 WALL ELEVATIONS & PIPING DETAILS
M3.3 GENERATOR FABRICATION DETAILS
M3.4 GLYCOL STORAGE & EXPANSION TANK FABRICATION
M4.1 COOLANT & HEAT RECOVERY PIPING PLAN & DETAILS
M4.2 COOLANT & HEAT RECOVERY ISOMETRICS & DETAILS
M5.1 DIESEL FUEL & USED OIL PIPING PLAN, DIAGRAM, & DETAILS
M5.2 DIESEL FUEL & USED OIL PIPING ELEVATIONS & DETAILS
M5.3 200 GALLON DAY TANK FABRICATION
M6 EXHAUST & CRANK VENT PLAN & DETAILS
M7.1 VENTILATION PLAN & DETAILS
M7.2 SHEET METAL FABRICATION DETAILS
FS1 FIRE SUPPRESSION SYSTEM PLAN, SECTION, LEGEND, & NOTES
E1.1 ELECTRICAL LEGENDS & SCHEDULES
E3.1 WIREWAY PLAN, MODULE SECTION, & DETAILS
E3.2 ELEVATIONS & DETAILS
E3.3 ELEVATIONS & DETAILS
E4.1 RECEPTACLE & LIGHTING PLANS & STATION SERVICE PANEL
E4.2 STATION SERVICE PLAN, DETAILS, & PANEL
E5 INSTRUMENTATION & DATA PLANS & DETAILS
E6.1 SWITCHGEAR ENCLOSURE LAYOUT
E6.2 SWITCHGEAR ONE-LINE & SCHEMATICS
E6.3 24VDC ENGINE WIRING JUNCTION BOX
E7.1 DAY TANK CONTROL PANEL LOGIC DIAGRAM & BILL OF MATERIALS
E7.2 DAY TANK CONTROL PANEL LAYOUT & TERMINAL STRIPS
E7.3 DAY TANK CONTROL PANEL SEQUENCE OF OPERATION & DETAILS
A1 FLOOR PLAN, REFLECTED CEILING PLAN, CODE ANALYSIS, & GENERAL NOTES
A2 INTERIOR ELEVATIONS & DOOR/WINDOW DETAILS

OWNER FURNISHED MODULE STRUCTURE APPROVED SHOP DRAWINGS

E1 BASE FRAMING PLAN
E2 CEILING FRAMING PLAN
E3 EXTERIOR ELEVATIONS
E4 FLOOR PLAN
E5 DECK & CEILING PLATES
E6 RADIATOR SUPPORTS & STAIR FRAMING PLANS
D1 BASE BEAM DETAILS
D2 WALL FRAMING DETAILS
D3 CEILING TUBE DETAILS
D4 MISCELLANEOUS DETAILS
D5 STAIR ASSEMBLY DETAILS

NOTE: ONE SET OF SHOP DRAWINGS PROVIDED. THE TWO MODULE STRUCTURES ARE IDENTICAL EXCEPT AS NOTED ON SHEET E4.



ALASKA ENERGY AUTHORITY

PROJECT: CLARK'S POINT & PORT HEIDEN
RURAL POWER SYSTEM UPGRADE PROJECTS

TITLE: MODULAR POWER PLANT ASSEMBLY
SCHEDULE OF DRAWINGS

 P.O. 111405, Anchorage, AK 99511 (907)349-0100	DRAWN BY: BCG	SCALE: NO SCALE
	DESIGNED BY: BCG	DATE: 1-14-19
	FILE NAME: CKPT&PTH G1	SHEET: G1 OF 1
	PROJECT NUMBER:	

LEGEND

- DIRECTION OF FLOW
- CHANGE OF PIPE SIZE
- PIPING CONNECTION (TEE)
- ELBOW TURNED DOWN
- ELBOW TURNED UP
- FLANGED JOINT
- UNION
- FLEXIBLE CONNECTOR
- BUTTERFLY VALVE
- BALL VALVE
- CHECK VALVE
- HOSE END DRAIN VALVE
- GAUGE COCK
- AUTOMATIC AIR VENT
- THERMOMETER
- PRESSURE GAUGE
- TEMPERATURE TRANSMITTER
- PRESSURE TRANSMITTER
- FLOW METER
- FLOAT SWITCH
- LOW COOLANT ALARM
- TANK LEVEL MONITOR
- LEVEL SENSOR PROBE
- GLYCOL LEVEL SENSOR

ABBREVIATIONS

- ∅ DIAMETER (PHASE)
- A AMPS
- AFF ABOVE FINISHED FLOOR
- BTU BRITISH THERMAL UNIT
- DFR DIESEL FUEL RETURN
- DFS DIESEL FUEL SUPPLY
- EWT ENTERING WATER TEMPERATURE
- EXIST EXISTING
- ECR ENGINE COOLANT RETURN
- ECS ENGINE COOLANT SUPPLY
- FPT FEMALE PIPE THREAD
- GA GAUGE
- GALV GALVANIZED
- GPM GALLONS PER MINUTE
- GRC GALVANIZED RIGID CONDUIT
- HP HORSEPOWER
- HRR HEAT RECOVERY RETURN
- HRS HEAT RECOVERY SUPPLY
- ID INSIDE DIAMETER
- KW KILOWATT
- LT LIQUID TIGHT
- LWT LEAVING WATER TEMPERATURE
- MAX MAXIMUM
- MBH THOUSAND BTU PER HOUR
- MIN MINIMUM
- MPT MALE PIPE THREAD
- NC NORMALLY CLOSED
- NO NORMALLY OPEN
- OC ON CENTER
- OD OUTSIDE DIAMETER
- PRV PRESSURE RELIEF VALVE
- PSI POUNDS/PER SQUARE INCH
- PSID PSI DIFFERENTIAL
- PSIG PSI GAUGE
- SCH SCHEDULE
- TDH TOTAL DEVELOPED HEAD
- Typ TYPICAL
- UOR USED OIL RETURN
- V VOLTS
- W WATTS
- WG WATER GAUGE
- WPD WATER PRESSURE DROP

EQUIPMENT REQUIREMENTS FOR APPROVED EQUALS (APPLIES TO ALL SCHEDULES):
SPECIFIC PARTS MANUFACTURER AND MODEL SELECTED NOT ONLY TO MEET PERFORMANCE FUNCTION BUT ALSO TO COORDINATE AND INTERFACE WITH OTHER DEVICES AND SYSTEMS. APPROVED EQUAL SUBSTITUTIONS WILL BE ALLOWED ONLY BY ENGINEER'S APPROVAL. TO OBTAIN APPROVAL, SUBMITTALS MUST CLEARLY DEMONSTRATE HOW SUBSTITUTE ITEM MEETS OR EXCEEDS SPECIFIED ITEM QUALITY AND PERFORMANCE CHARACTERISTICS AND ALSO COMPLIES WITH MECHANICAL AND/OR ELECTRICAL CONNECTIONS AND PHYSICAL LAYOUT REQUIREMENTS.

ENGINE COOLING SYSTEM EQUIPMENT SCHEDULE

SYMBOL	SERVICE/FUNCTION	DESCRIPTION	MANUFACTURER/MODEL
R-1 R-2	GLYCOL RADIATOR	SINGLE PASS, 4 ROW, VERTICAL CORE, 3" FLANGED CONNECTIONS, GALVANIZED COATING, EXPANDED METAL GUARD. 6,000 BTU/MIN AT 77°F AMBIENT, 50 GPM 50% ETHYLENE GLYCOL AT 192F IN, 0.22 PSI MAX GLYCOL PRESSURE DROP. 3 HP, 460 V, 3 PH, MOTOR SUITABLE FOR VFD OPERATION AT 10:1 TURNDOWN RATIO.	DIESEL RADIATOR PART NO. DR3490
TV-1	COOLANT THERMOSTATIC VALVE	3" ANSI 125# FLAT FACED FLANGES, CAST IRON BODY, FACTORY SET NON-ADJUSTABLE FIELD REPLACEABLE THERMOSTATIC ELEMENTS - 185F NOMINAL TEMPERATURE	FPE PART NO. A3010-185
TV-2	HEAT RECOV. THERMOSTATIC VALVE	2-1/2" ANSI 125# FLAT FACED FLANGES, CAST IRON BODY, FACTORY SET NON-ADJUSTABLE FIELD REPLACEABLE THERMOSTATIC ELEMENTS, 185F NOMINAL TEMPERATURE,	FPE PART NO. A2510-185
ET-1	GEN COOLANT EXPANSION TANK	24 GALLON CAPACITY TANK, 12.75" O.D x 48" LONG FABRICATED STEEL TANK, SEE FABRICATION DETAIL	CUSTOM FABRICATION
HP-EC	ENGINE COOLANT FILL HAND PUMP	DOUBLE ACTION PISTON HAND PUMP, ALUM HOUSING, SS PISTON SHAFT & LINER, BUNA-N SEALS, ANTI-SIPHONING VALVE.	GPI MODEL HP-100
G-EC	ENGINE COOLANT GLYCOL TANK LEVEL GAUGE	MAGNETIC OPERATED SPIRAL GAUGE FOR #1 DIESEL, 25 PSIG MAX OPERATING PRESSURE, 35" LIQUID COLUMN PLUS 4" RISER.	ROCHESTER MODEL 8660

HEAT RECOVERY & PLANT HEATING EQUIPMENT SCHEDULE:

HX-1	POWER PLANT HEAT EXCHANGER	316 SS PLATES, BRAZED CONST. 2.5" NPT, 150 MBH MIN CAPACITY. PRIMARY: 35 GPM 195F EWT (50% ETHYLENE) 1.2 PSI MAX WPD, SECONDARY: 35 GPM 185F LWT (50% PROPYLENE) 1.2 PSI MAX WPD	AMERIDEX SL-140-50
P-HR1	CONTROL ROOM HEAT	1 GPM AT 18' TDH, 1/25HP, 115V, 1∅. PROVIDE WITH 3/4" SOLDER COMPANION SHUT OFF FLANGES, GASKETS, & BOLTS.	GRUNDFOS UPS 15-58FC, SPEED 3
P-HR2A	HEAT RECOV. PRIMARY	35 GPM AT 7' TDH, 1/6HP, 115V, 1∅. PROVIDE WITH 2" NPT COMPANION FLANGES, GASKETS, & BOLTS.	GRUNDFOS UPS 50-75F
P-HR2B	HEAT RECOV. SECONDARY	35 GPM AT 17' TDH, 1/2HP, 115V, 1∅. PROVIDE WITH 1-1/4" SOLDER COMPANION FLANGES, GASKETS, & BOLTS.	GRUNDFOS UPS 32-80/2 SPEED 3
CUH-1	CONTROL ROOM HEAT	FLOOR MOUNTED HOT WATER CABINET UNIT HEATER, 18 MBH AT 1 GPM 180F EWT & 60F EAT.	TOYOTOMI HC-20
ET-2	HEAT RECOV. EXP. TANK	BLADDER TYPE EXPANSION TANK, 44 GALLON TANK, 22 GALLON ACCEPTANCE VOL, 125 PSIG WORKING PRESSURE, 12 PSIG PRE-CHARGE.	AMTROL AX-80
P-EB1	ELECTRIC BOILER CIRC.	11 GPM AT 8' TDH, 1/25HP, 115V, 1∅. PROVIDE WITH 1-1/4" SOLDER COMPANION SHUT OFF FLANGES, GASKETS, & BOLTS.	GRUNDFOS UPS 15-58F SPEED 3
EB-1	ELECTRIC BOILER	CLEAN WATER CIRCULATION HEATER. 5" FLANGED PIPE BODY, 2" MPT PIPING CONNECTIONS, 24KW CAPACITY, 6 ELEMENTS, 4 KW EACH, 480V DELTA WITH GENERAL PURPOSE TERMINAL ENCLOSURE.	CHROMALOX NWH-06-024P-E1

VENTILATION EQUIPMENT SCHEDULE:

EF-1 EF-2	GENERATION ROOM EXHAUST FANS	DIRECT DRIVE 14"∅ PROPELLER SIDEWALL EXHAUST FAN, 2,100 CFM AT 0.375" SP, 1,750 RPM. FURNISH WITH SPECIAL 1/2 HP, 115 V, 1 PH VARIGREEN MOTOR WITH OPTIONAL 0-10V LEADS	GREENHECK SE1-14-436-VG (1/2 HP)
EF-1 EF-2 COMB.	FAN & INTAKE DAMPERS	OPPOSED BLADE LOW-LEAKAGE CONTROL DAMPER, GALVANIZED STEEL CONSTRUCTION, 304 STAINLESS STEEL BEARINGS AND JAMB SEALS, EPDM BLADE SEALS.	GREENHECK VCD-23
MD	MOTORIZED DAMPER ACTUATOR	120V SPRING RETURN ACTUATOR	BELIMO AF-BUP

FUEL SYSTEM EQUIPMENT SCHEDULE

SYMBOL	SERVICE/FUNCTION	DESCRIPTION	MANUFACTURER/MODEL
P-DF1	DAY TANK FILL PUMP	ROTARY GEAR PUMP, 1/2" FPT INLET AND OUTLET, DUCTILE IRON CONSTRUCTION WITH STAINLESS STEEL SHAFT, BUNA-N LIP SEAL, CARBON BEARINGS, DIRECT FLEX COUPLED TO 1725 RPM ODP THERMALLY PROTECTED, AUTO RESET MOTOR, 1/3 HP, 115 V, 1 PH, 60 HZ, 4.0 GPM @ 20 PSID.	OBERDORFER C992M3E5QF50
P-DF2 P-UO1	DIESEL CIRC. & USED OIL DRAIN PUMPS	ROTARY GEAR PUMP, 1/2" FPT INLET AND OUTLET, BRONZE CONSTRUCTION WITH SS SHAFTS, BUNA-N SEAL, CARBON BEARINGS, DIRECT FLEX COUPLED TO 1150 RPM ODP THERMALLY PROTECTED, AUTO RESET MOTOR, 1/2 HP, 115 V, 1 PH, 60 HZ, 6.6 GPM @ 20 PSID. PROVIDE WITH 40 PSID INTERNAL PRV.	OBERDORFER N994RH-J46
P-UO2	USED OIL INJECTION PUMP	ROTARY GEAR PUMP GEAR PUMP - 1.2 GPH @ 15 PSID, 1/8" FPT INLET AND OUTLET, PEEK GEARS, PTFE SEALS, MAGNETICALLY COUPLED TO 1725 RPM TFC THERMALLY PROTECTED AUTO RESET MOTOR, 1/4 HP, 115 V, 1 PH, 60 HZ. FURNISH WITH BASE MOUNT S56C FRAME INDUSTRIAL MOTOR.	MICROPUMP GA-V21J8FS.A PUMP WITH #81518 ADAPTER & BALDOR CDFL3504M MOTOR
HP-DI	DAY TANK FILL HAND PUMP	DOUBLE ACTION PISTON HAND PUMP, ALUM HOUSING, SS PISTON SHAFT & LINER, BUNA-N SEALS, ANTI-SIPHONING VALVE.	GPI MODEL HP-100
G-DI	DAY TANK LEVEL GAUGE	MAGNETIC OPERATED SPIRAL GAUGE FOR #1 DIESEL, 25 PSIG MAX OPERATING PRESSURE, 35" LIQUID COLUMN PLUS 4" RISER.	ROCHESTER MODEL 8660
M-DI	DAY TANK METER	STEEL BODY, 1" ANSI 300# FLANGED ENDS, 20-800 GPH FLOW RANGE, 0-RINGS AND SEALS COMPATIBLE WITH #1 DIESEL, DIRECT READ 6-DIGIT REGISTER TO 0.1 GAL, DRY CONTACT PULSER.	ISTEC CONTOIL 9226-F
F-DI	DAY TANK FILTER	10 MICRON FILTER FOR DIESEL FUEL, CLEAR BOWL WITH BOTTOM DRAIN VALVE, 150 PSIG MAXIMUM OPERATING PRESSURE, 25 GPM MAXIMUM FLOW. REPLACE FPT HEAD ASSEMBLY WITH CUSTOM FABRICATED STEEL HEAD WITH ANSI 150# FLANGED ENDS. FURNISH COMPLETE WITH WRENCH AND 5 SPARE FILTER ELEMENTS.	SUPERIOR MACHINE & WELDING HEAD WITH GOLDEN ROD NO. 495-4 BOWL, 491 WRENCH, 470-5 ELEMENTS
F-UOB	USED OIL BLENDER FILTER	CUSTOM FABRICATED FILTER BANK. FURNISH WITH TWO STAGE ELEMENTS: 10 MICRON HYDROSORB II FILTER 2 MICRON PARTICULATE FILTER PROVIDE 3 OF EACH ELEMENT TYPE	CIM-TEK #300342 CIM-TEK #30066

PIPE/TUBING STRUT CLAMP SCHEDULE

PIPE/TUBE	CLAMP #	PIPE/TUBE	CLAMP #	NOTES:
1/2" COPPER	BVT062	1/2" STEEL	B2008	1) ALL CLAMP NUMBERS ARE B-LINE. EQUIVALENT EQUALS ACCEPTABLE. 2) ALL COPPER TUBE CLAMPS TO BE CUSHIONED, VIBRA-CLAMP. 3) ALL STEEL PIPE CLAMPS NOT CUSHIONED. USE FOR ALL STEEL PIPE AND RIGID CONDUIT. 4) SEE PLANS, ELEVATIONS, ISOMETRICS, AND DETAILS FOR ACTUAL PIPE SIZES.
3/4" COPPER	BVT087	3/4" STEEL	B2009	
1" COPPER	BVT112	1" STEEL	B2010	
1-1/4" COPPER	BVT125	1-1/4" STEEL	B2011	
1-1/2" COPPER	BVT162	1-1/2" STEEL	B2012	
2" COPPER	BVT212	2" STEEL	B2013	
2-1/2" COPPER	BVT262	2-1/2" STEEL	B2014	
3" COPPER	BVT312	3" STEEL	B2015	
4" COPPER	BVT412	4" STEEL	B2017	

INSTRUMENTATION: SEE ELECTRICAL INSTRUMENTATION SCHEDULE ON SHEET E1.1 FOR INSTRUMENTATION DEVICES SHOWN ON THE MECHANICAL DRAWINGS.

SEQUENCE OF OPERATIONS

DAY TANK WILL HAVE AUTOMATIC FILL CONTROLS WITH REDUNDANT HIGH AND LOW LEVEL ALARMS AND TIMERS. USED OIL/DIESEL FUEL BLENDER WILL RUN ANY TIME DAY TANK FILL PUMP RUNS. SEE FUEL SYSTEM CONTROL PANEL DRAWINGS FOR DETAILED SEQUENCE.

ALL DAMPER MOTORS WILL BE NORMALLY CLOSED SPRING RETURN AND WILL CLOSE ON LOSS OF POWER (FIRE ALARM) IN LESS THAN 30 SECONDS. VENTILATION AIR INTAKE AND EXHAUST MOTORIZED DAMPERS WILL OPEN ANY TIME ASSOCIATED EXHAUST FAN OPERATES. THE COMBUSTION AIR INTAKE MOTORIZED DAMPER WILL BE OPEN ANY TIME PLANT OPERATES (STATION SERVICE POWER ON).

EXHAUST FANS EF-1 AND EF-2 WILL OPERATE ON A CALL FOR COOLING THROUGH A 24VAC DIGITAL MODULATING THERMOSTAT. THE THERMOSTAT WILL PROVIDE A 0-10V SIGNAL TO MODULATE THE FAN SPEED AS REQUIRED TO MAINTAIN GENERATING ROOM TEMPERATURE, 75F, ADJUSTABLE.

CABINET UNIT HEATER CUH-1 AND CIRCULATING PUMP P-HR1 WILL OPERATE ON A CALL FOR HEATING THROUGH THE INTERNAL CUH CONTROLS TO MAINTAIN CONTROL ROOM TEMPERATURE, 65F, ADJUSTABLE.

RADIATOR FAN MOTORS WILL OPERATE UNDER VARIABLE FREQUENCY DRIVE (VFD) CONTROL. WHEN THE COOLANT RETURN TEMP REACHES THE WAKE UP SETPOINT THE MOTOR WILL START AT MINIMUM SPEED AND RAMP UP TO THE REQUIRED SPEED. USING PID CONTROL, THE VFD WILL MODULATE THE FAN SPEED AS REQUIRED TO MAINTAIN COOLANT RETURN TEMP AT THE PID REFERENCE SETPOINT. AS THE COOLANT RETURN TEMP RISES, THE VFD WILL INCREASE THE SPEED OF THE FAN MOTOR UP TO 100%. ONCE THE FAN REACHES THE MINIMUM SPEED, THE VFD WILL MAINTAIN THAT SPEED UNTIL THE LOW SPEED TIME OUT EXPIRES. WHEN THE LOW SPEED TIME OUT EXPIRES THE MOTOR WILL STOP. THE MOTOR WILL REMAIN OFF UNTIL THE COOLANT RETURN TEMP RISES TO THE WAKE UP SETPOINT. THE INITIAL OPERATING SETTINGS SHALL BE SET TO THE FOLLOWING VALUES AND SHALL BE ADJUSTABLE:
 170F = PID REFERENCE TEMPERATURE 160F = WAKE UP TEMPERATURE
 0.93 = PROPORTIONAL GAIN 0.3 = INTEGRAL GAIN 0 = DERIVATIVE
 6 HZ = MINIMUM SPEED 60 SEC = LOW SPEED TIME OUT

HEAT RECOVERY PUMPS P-HR2A AND P-HR2B WILL OPERATE CONTINUOUSLY UNDER MANUAL CONTROL.

WHEN THE SYSTEM PRESSURE IN THE HEAT RECOVERY PIPING DROPS BELOW 15 PSIG FOR 15 MINUTES, A RED LAMP "HEAT RECOVERY LOSS OF PRESSURE" LOCATED IN THE SWITCHGEAR MASTER SECTION WILL ILLUMINATE.

WHEN THE HEAT RECOVERY RETURN TEMP. IS EQUAL TO OR GREATER THAN THE HEAT RECOVERY SUPPLY TEMP. FOR 60 MINUTES, AN AMBER LAMP "NO LOAD ON HEAT RECOVERY" LOCATED IN THE SWITCHGEAR MASTER SECTION WILL ILLUMINATE. WHEN THE HEAT RECOVERY SUPPLY TEMP. IS A MIN. OF 1°F GREATER THAN THE HEAT RECOVERY RETURN TEMP. THE LAMP WILL TURN OFF.

WHEN THE FLOW RATE IN THE HEAT RECOVERY PIPING FALLS BELOW 10 GPM FOR 15 MINUTES, A RED LAMP "HEAT RECOVERY LOSS OF FLOW" LOCATED IN THE SWITCHGEAR MASTER SECTION WILL ILLUMINATE.

ELECTRIC BOILER PUMP P-EB1 WILL OPERATE CONTINUOUSLY UNDER MANUAL CONTROL. PUMP SHALL RUN ANYTIME THE REMOTE ELECTRIC WIND POWER GENERATORS ARE AVAILABLE TO RUN.




STATE OF ALASKA, AIDEA/AEA RURAL POWER SYSTEM UPGRADE

CLARKS POINT POWER PLANT
CLARKS POINT, ALASKA

CONSTRUCTION DOCUMENTS	REVISIONS	DESCRIPTION
	REV DATE	

VERIFY SCALES
0 1" THIS BAR REPRESENTS ONE INCH ON ORIGINAL DRAWING

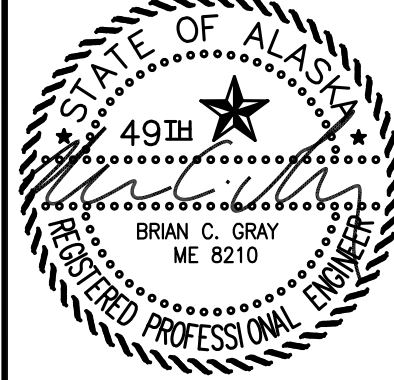

DATE: 1/14/19
DRAWN BY: JTD
CHECKED BY: BCG
JOB NUMBER:


DRAWING TITLE:
MECHANICAL LEGENDS, SCHEDULES & SEQUENCE OF OPERATIONS

M1.1
SHEET OF 7

ISSUED FOR CONSTRUCTION JANUARY 2019

REVISIONS	DESCRIPTION
REV DATE	

ISSUED FOR CONSTRUCTION JANUARY 2019

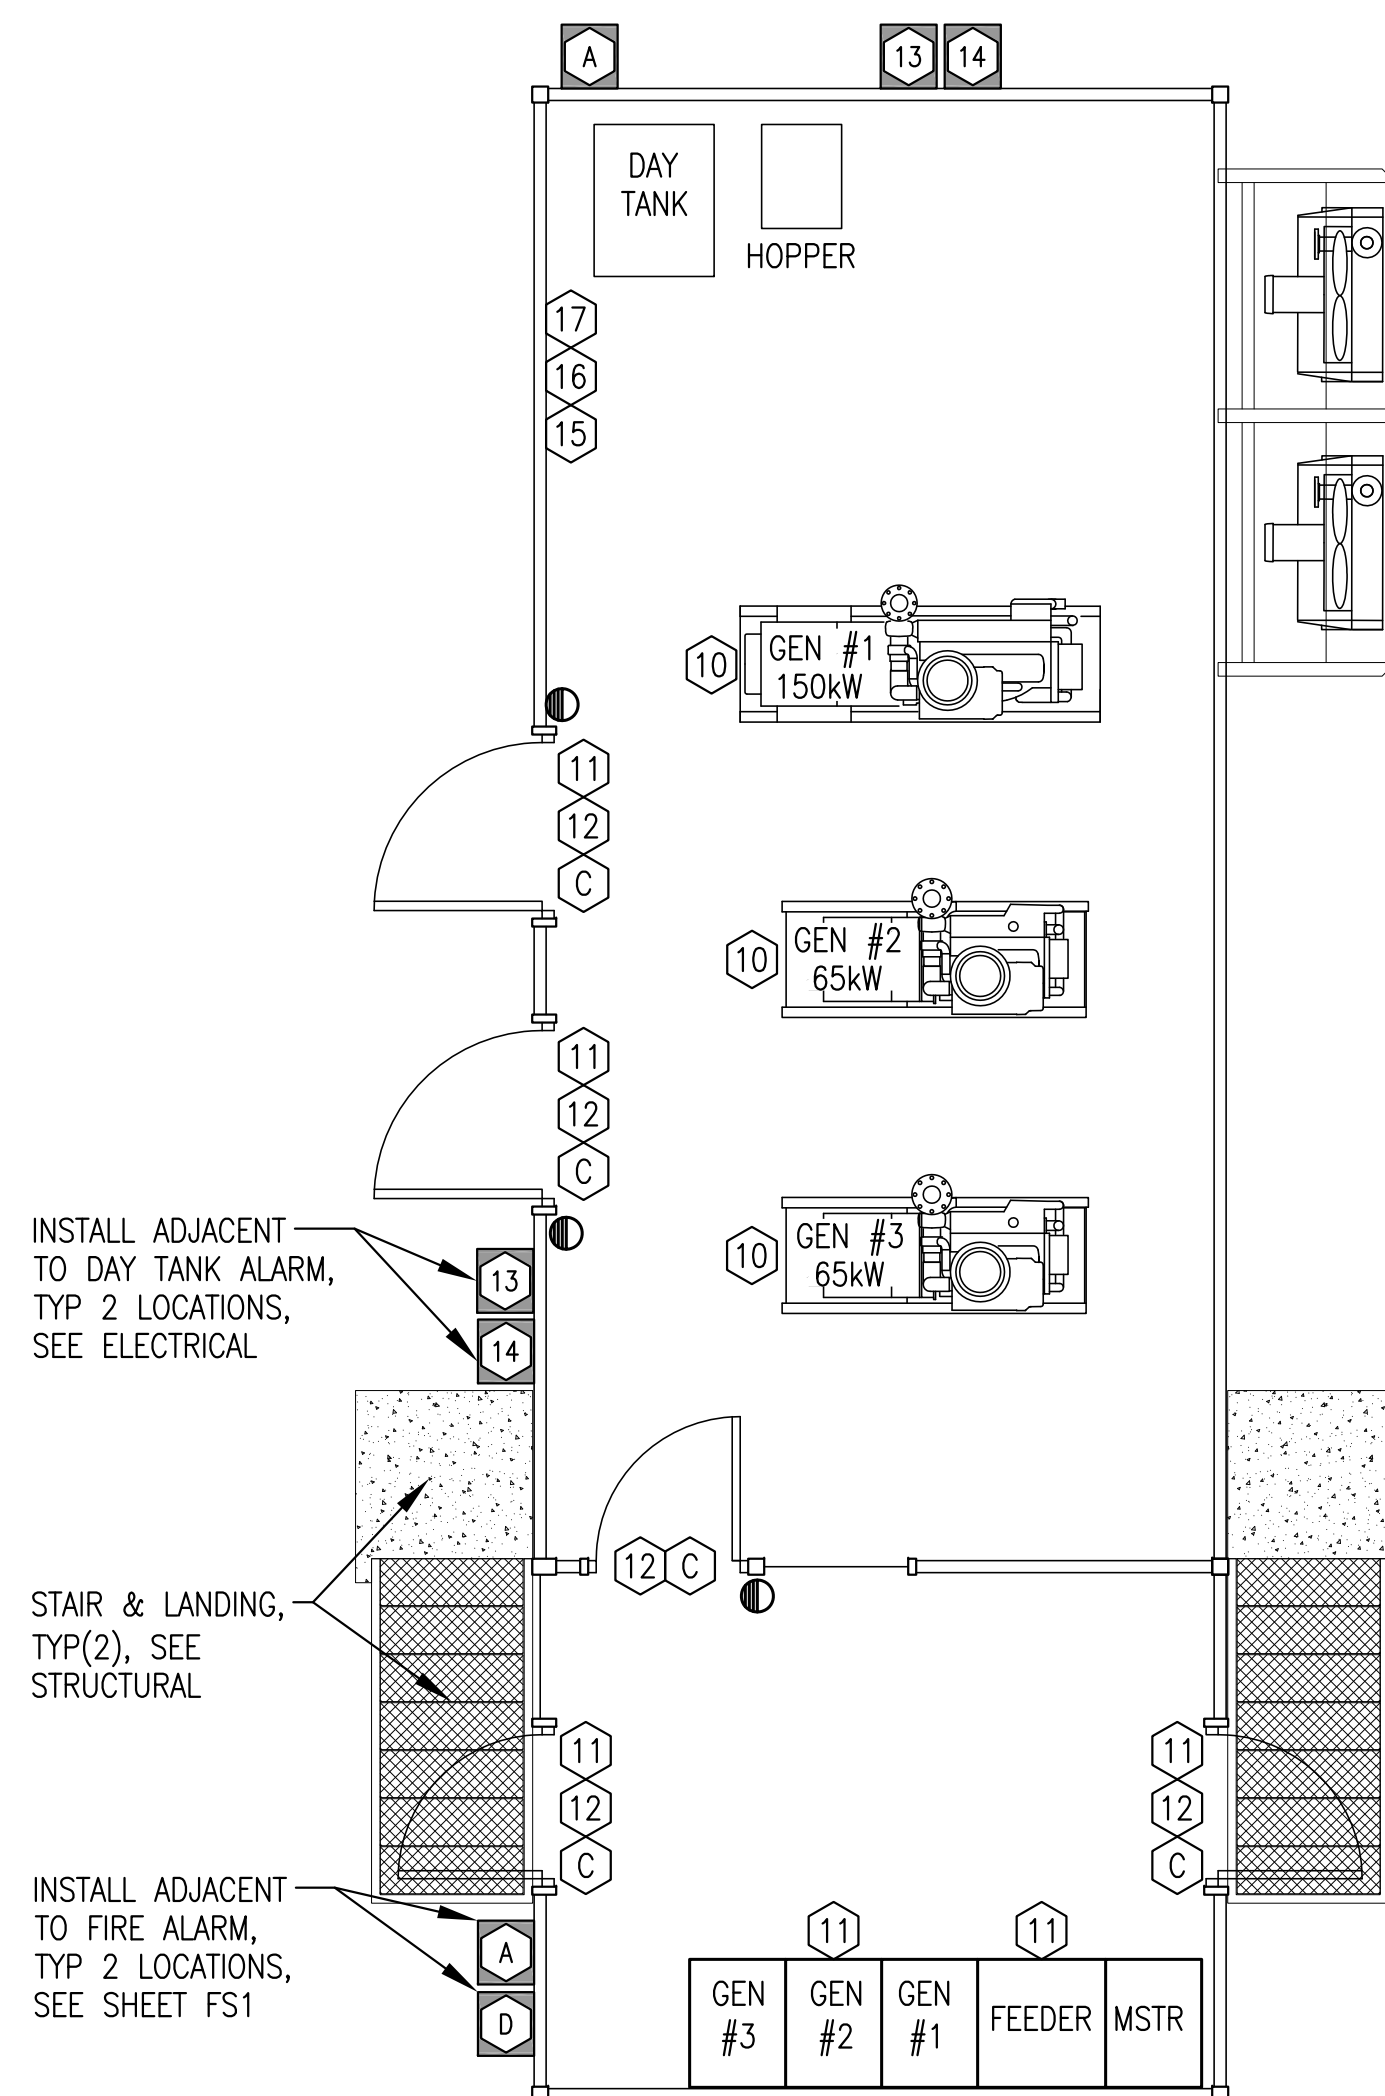

WARNING SIGN & INFORMATIONAL PLACARD SCHEDULE:

WARNING SIGNS & INFORMATIONAL PLACARDS - PROVIDE DECALS AND SIGN BOARDS AS INDICATED IN THE SCHEDULE BELOW, QUANTITY & LOCATION WHERE SHOWN ON THE WARNING SIGN/PLACARD PLAN THIS SHEET.

DECALS
DECALS TO BE WHITE NON-REFLECTIVE VINYL BACKGROUND, 3M 3650-10, WITH 3M SERIES 225 HIGH PERFORMANCE VINYL LETTERS, ONE SIDE ONLY, SELF ADHESIVE BACK. NOMINAL 10"x14" SIZE UNLESS INDICATED OTHERWISE OR REQUIRED TO BE LARGER FOR SPECIFIED LETTER SIZE. WARNING LITES OR EQUAL. INSTALL ON FACE OF DOORS OR ELECTRICAL ENCLOSURES WHERE INDICATED. CLEAN SURFACES AND APPLY IN ACCORDANCE WITH MANUFACTURER'S INSTRUCTIONS.

BOARDS
SIGN BOARDS TO BE EQUAL TO DECALS EXCEPT MOUNTED ON 0.08" ALUMINUM PLATE. PROVIDE 3/16" HOLES IN ALL FOUR CORNERS. ATTACH TO CHAIN LINK FENCING WITH HOG RINGS OR STAINLESS STEEL TIES. ATTACH TO WALLS OR STRUCTURES WITH STAINLESS STEEL SCREWS OR BOLTS.

WARNING SIGNS - RED LETTERING ON WHITE BACKGROUND.

- A** "FIRE ALARM"
- C** "CAUTION, ROOM PROTECTED BY WATER MIST FIRE PROTECTION SYSTEM, IN CASE OF FIRE KEEP DOOR CLOSED AND DO NOT ENTER"
- D** "FLASHING LIGHT MEANS FIRE SUPPRESSION AGENT HAS DISCHARGED"
- 10** "CAUTION: THIS UNIT STARTS AUTOMATICALLY, LOCK & TAG OUT PRIOR TO SERVICE"
- 11** "DANGER HIGH VOLTAGE, AUTHORIZED PERSONNEL ONLY"
- 12** "CAUTION HEARING & EYE PROTECTION REQUIRED"
- 13** "FUEL OIL DAY TANK ALARM"
- 14** "IN CASE OF SPILL CALL DEC 1-800-478-9300"

INFORMATIONAL PLACARDS - BLACK LETTERING ON WHITE BACKGROUND.

- 15** "CHECK INTERMEDIATE TANK LEVEL DAILY, FILL WHEN BELOW 4'-0"
- 16** "TO MANUALLY FILL DAY TANK IN CASE OF EMERGENCY:
1) TURN OFF POWER TO THE DAY TANK CONTROL PANEL
2) MANUALLY OPEN ACTUATOR VALVE AT INTERMEDIATE TANK USING A WRENCH
3) OPEN NORMALLY CLOSED VALVE BY HAND PUMP
4) OPERATE HAND PUMP WHILE MONITORING LEVEL GAUGE"
- 17** "TO CHANGE ENGINE OIL:
1) LOCK & TAG GENERATOR OUT OF SERVICE
2) OPEN NORMALLY CLOSED DRAIN VALVE AT GEN
3) TURN ON PUMP TIMER & PUMP OUT ENGINE OIL
4) CHANGE FILTER & PLACE OLD ONE IN HOPPER
5) CLOSE DRAIN VALVE & REFILL ENGINE
6) RUN ENGINE, SHUT OFF, & CHECK DIPSTICK
7) TOP OFF & PLACE ENGINE BACK IN SERVICE"

VALVE TAG SCHEDULE:

VALVE TAGS - 3"x5"x.08" ALUMINUM, 3/16" HOLES IN ALL FOUR CORNERS, BLACK GERBER THERMAL TRANSFER FILM PRINTED LETTERS ON GERBER 220 HIGH PERFORMANCE VINYL BACKGROUND, COLOR AS INDICATED, ONE SIDE ONLY. WARNING LITES OR APPROVED EQUAL.
NOTE: PROVIDE TAGS NOTED AS DECALS WITHOUT ALUMINUM BACKING PLATE.

GREEN (DIESEL FUEL)

- 21** "NORMALLY OPEN, CLOSE ONLY FOR EMERGENCIES & TEMPORARY MAINTENANCE OF DAY TANK & DEVICES"
- 22** "NORMALLY CLOSED, OPEN ONLY FOR HAND PRIMING DAY TANK"
- 23** "NORMALLY OPEN, CLOSE ONLY FOR TEMPORARY MAINTENANCE OF BLENDER"
- 24** "NORMALLY OPEN, CLOSE ONLY FOR TEMPORARY MAINTENANCE OF ENGINE"

BROWN (USED OIL)

- 41** "NORMALLY CLOSED, OPEN ONLY FOR ENGINE OIL CHANGE"
- 42** "BLENDER FILTER #1, 10 MICRON HYDROSORB" (DECAL)
- 43** "BLENDER FILTER #2, 2 MICRON PARTICULATE" (DECAL)

PINK (COOLING/ETHYLENE GLYCOL)

- 51** "NORMALLY CLOSED, OPEN ONLY FOR ADDING COOLANT - ETHYLENE GLYCOL ONLY"
- 52** "NORMALLY CLOSED, OPEN ONLY ON HIGH COOLANT TEMPERATURE ALARM"
- 53** "NORMALLY OPEN, CLOSE ONLY ON HIGH COOLANT TEMPERATURE ALARM"
- 54** "NORMALLY OPEN, HEAT RECOVERY SUPPLY"
- 55** "NORMALLY OPEN, HEAT RECOVERY RETURN"

ORANGE (HEAT RECOVERY/PROPYLENE GLYCOL)

- 61** "NORMALLY CLOSED, OPEN ONLY FOR ADDING FLUID - PROPYLENE GLYCOL ONLY"
- 62** "NORMALLY OPEN, HEAT RECOVERY SUPPLY"
- 63** "NORMALLY OPEN, HEAT RECOVERY RETURN"
- 64** "NORMALLY OPEN, CLOSE ONLY FOR TEMPORARY MAINTENANCE OF SYSTEM"

INSTALLATION - SECURE EACH TAG TIGHT TO VALVE, PIPE, OR DEVICE WITH STAINLESS STEEL CABLE TIES OR SAFETY WIRE THROUGH ALL FOUR CORNERS OR FASTEN TO ADJACENT WALL OR SECTION OF STRUT WITH SCREWS.

NOTES:

- 1) SEE DRAWINGS THAT FOLLOW FOR LOCATIONS OF ALL SPECIFIC FUNCTION TAGS.
- 2) FOR ALL VALVES NOT INDICATED WITH A SPECIFIC FUNCTION TAG PROVIDE 1-1/2" BRASS TAG LABELED "N.O." FOR NORMALLY OPEN VALVES AND 1" BRASS TAG LABELED "N.C." FOR NORMALLY CLOSED VALVES. SECURE TAGS TO VALVE OR ADJACENT PIPE WITH BEADED BRASS CHAIN.


MODULE SHOP/ON-SITE NOTES:

- 1) FURNISH AND INSTALL ALL DECALS, SIGN BOARDS, AND FIRE EXTINGUISHERS AS PART OF THE MODULE SHOP FABRICATION WORK.
- 2) FURNISH AND INSTALL ALL VALVE TAGS AS PART OF THE MODULE SHOP FABRICATION WORK.

1 POWER PLANT WARNING SIGN/PLACARD & FIRE EXTINGUISHER PLAN
M1.2 1/4"=1'-0"

CONSTRUCTION DOCUMENTS	
REVISIONS	DESCRIPTION
REV. DATE	


VERIFY SCALES
0 1"
THIS BAR REPRESENTS ONE INCH ON ORIGINAL DRAWING

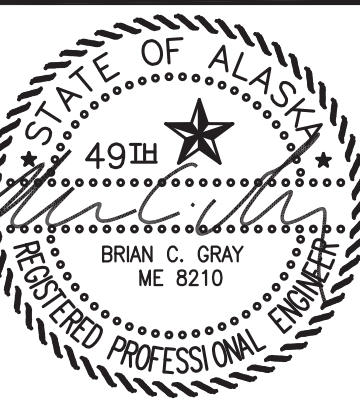


DATE: 1/14/19
DRAWN BY: JTD
CHECKED BY: BCG
JOB NUMBER:

DRAWING TITLE:
MECHANICAL PENETRATIONS PLAN, ELEVATION, & DETAILS

4 MODULE BACK WALL MECHANICAL PENETRATION LAYOUT

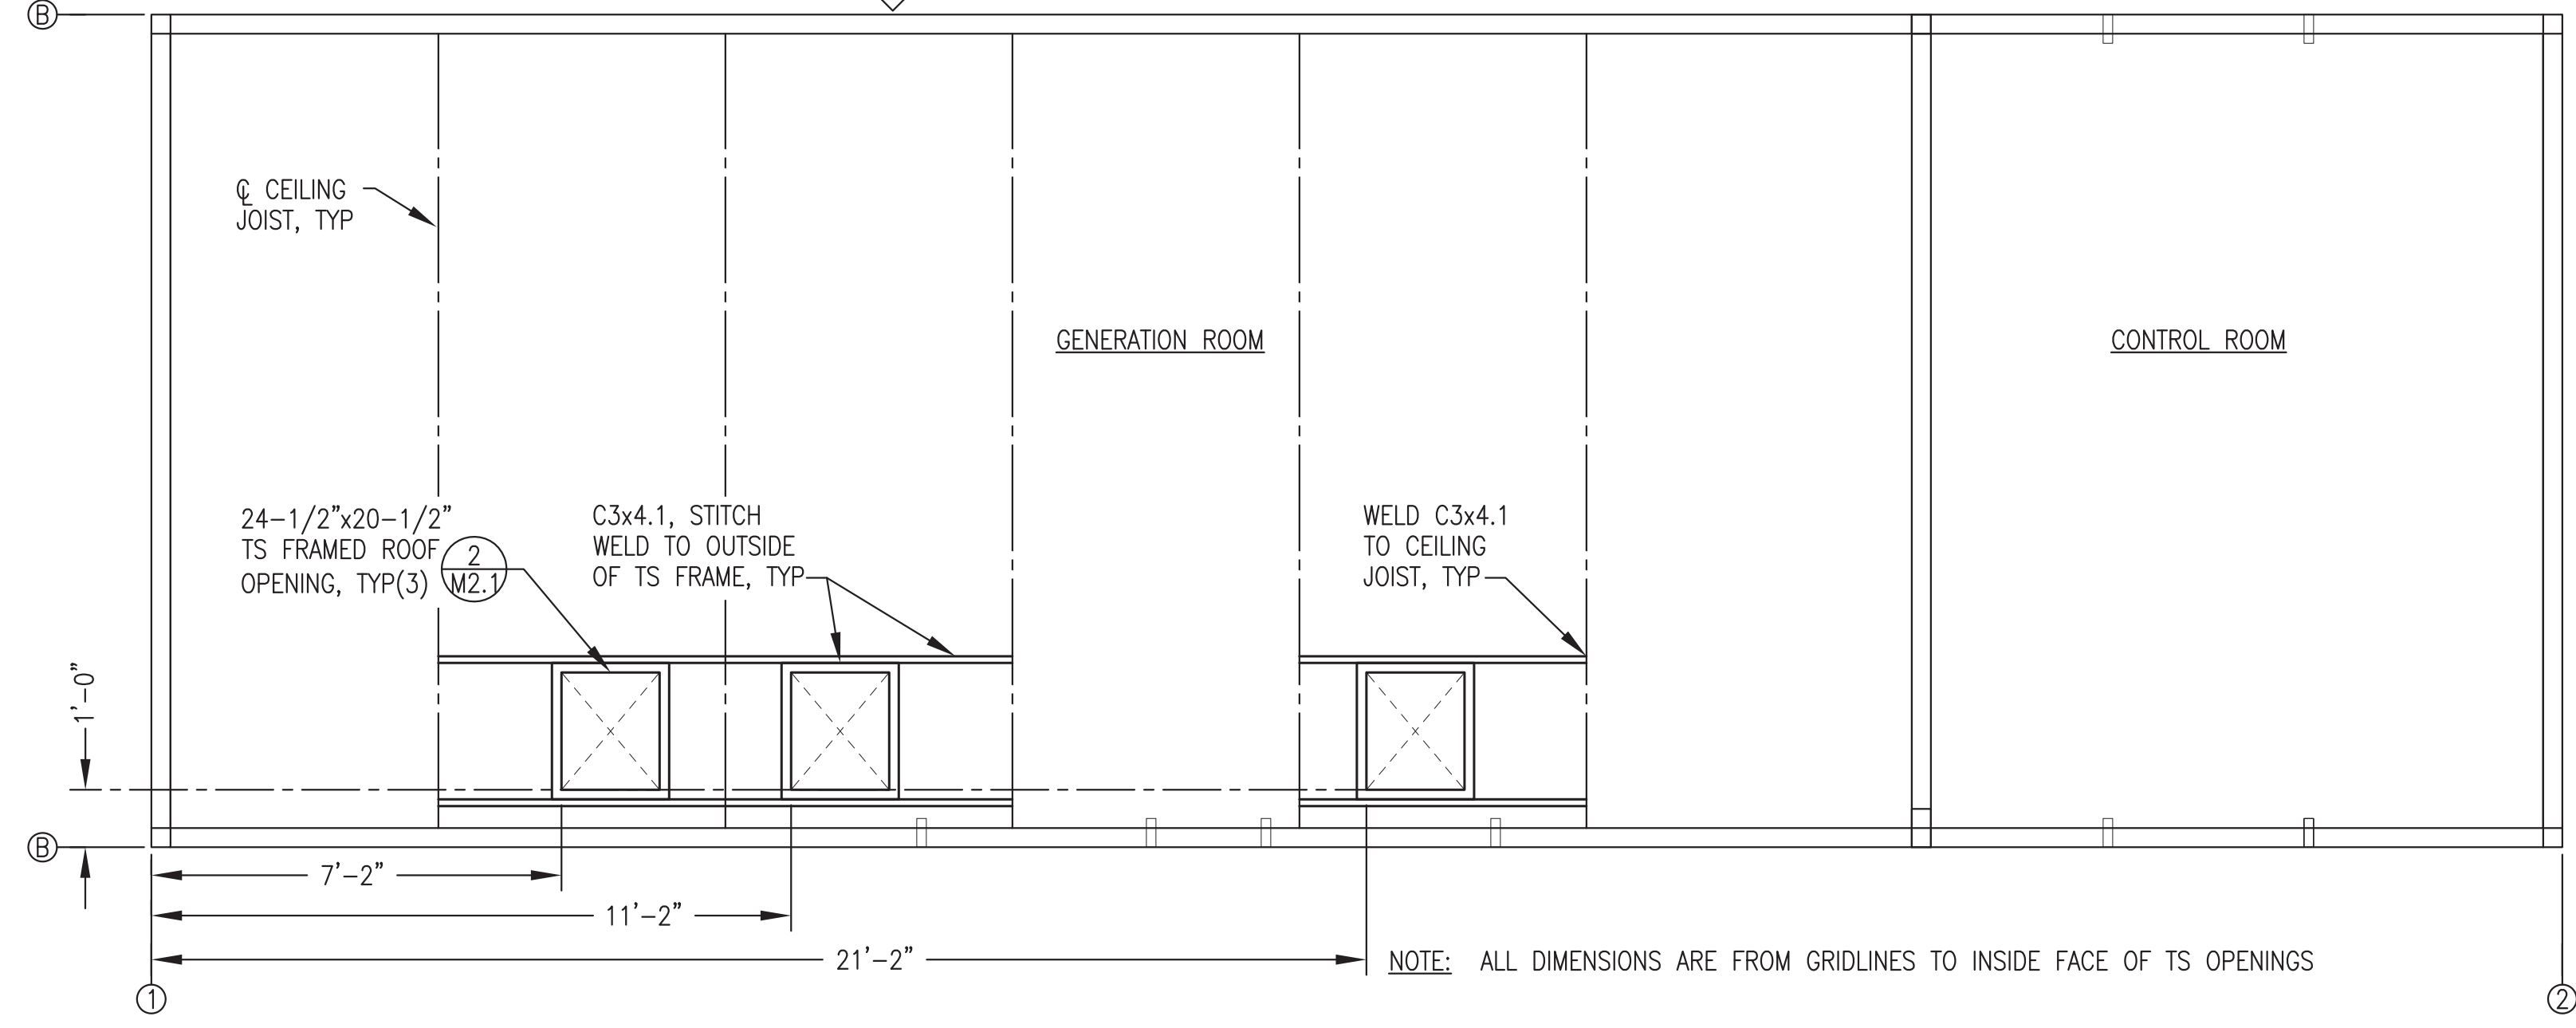


1 MODULE MECHANICAL ROOF PENETRATION PLAN
3/8"=1'-0"

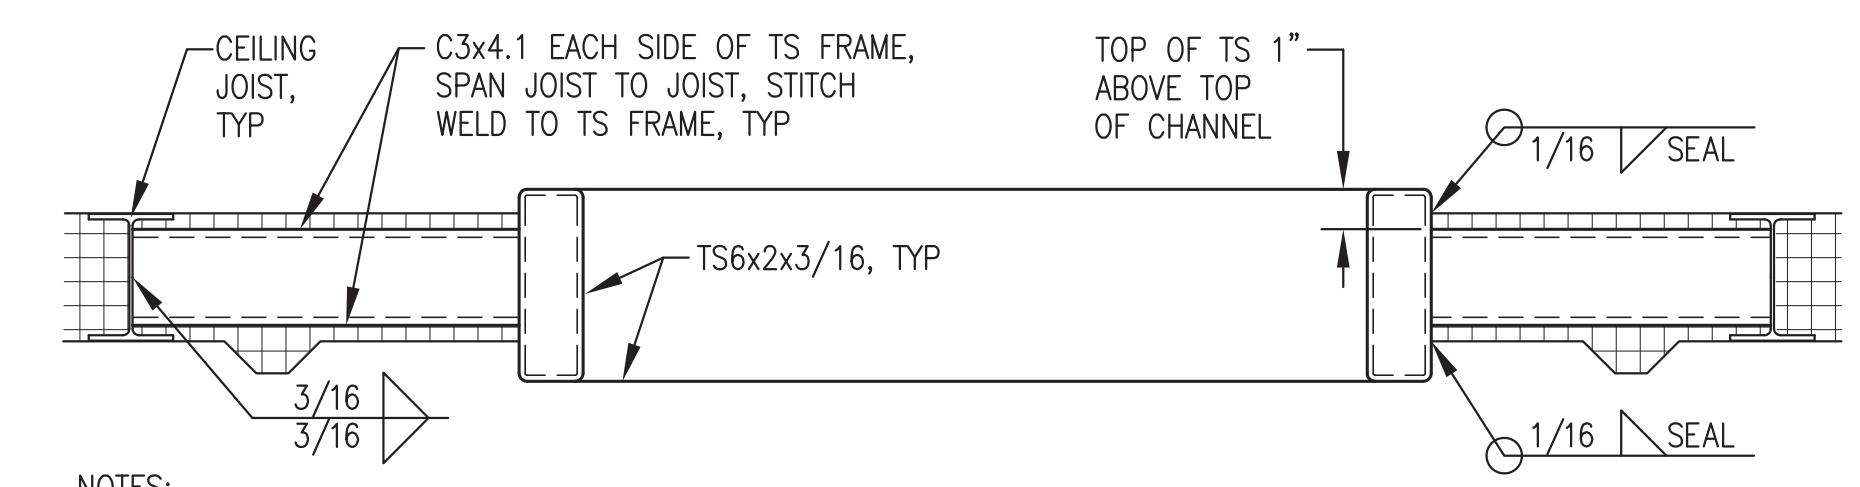


- NOTES:
- 1) FABRICATE FRAMED OPENING WITH MITERED CORNERS AND FULL PENETRATION GROOVE WELDS.
 - 2) FABRICATE TO FINISHED INSIDE (CLEAR) DIMENSIONS INDICATED ON PLANS.
 - 3) GRIND OUT INSIDE OF MITERED CORNERS TO PROVIDE FULL CLEAR OPENING.

2 TYPICAL ROOF OPENING DETAIL
2"=1'-0"

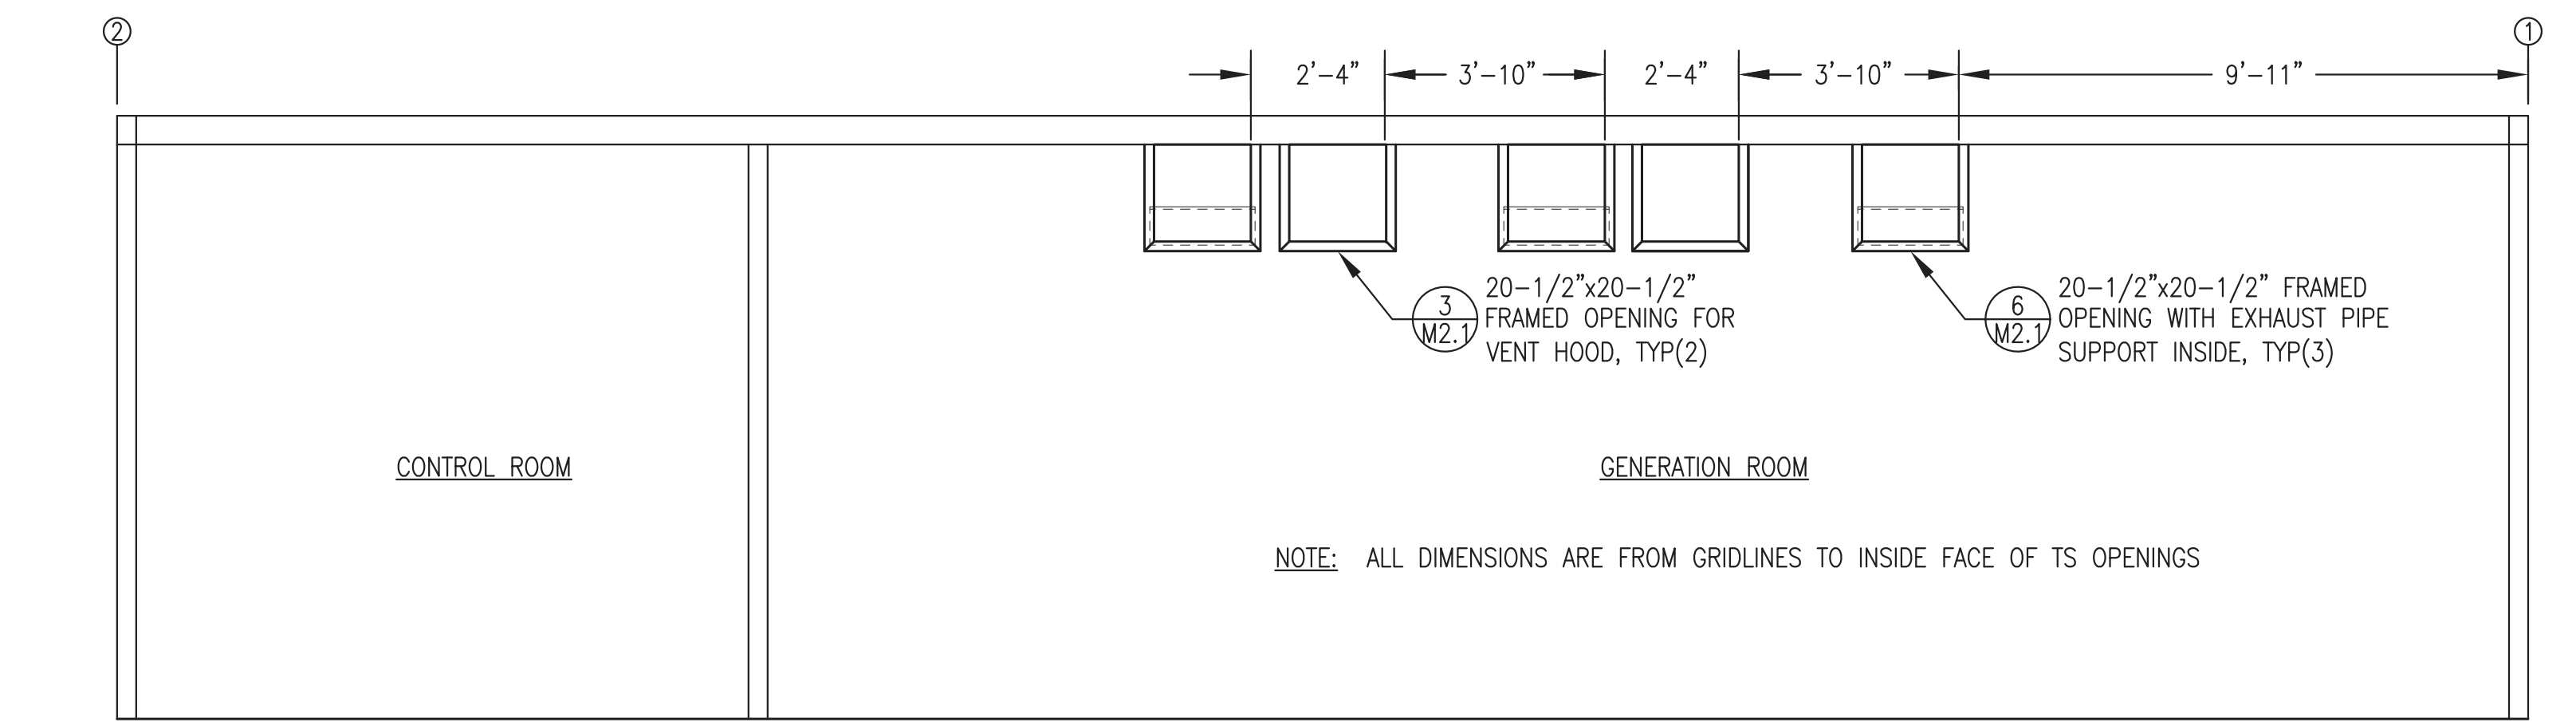


4 MODULE MECHANICAL WALL PENETRATIONS AT GRID A - EXTERIOR ELEVATION
1/2"=1'-0"

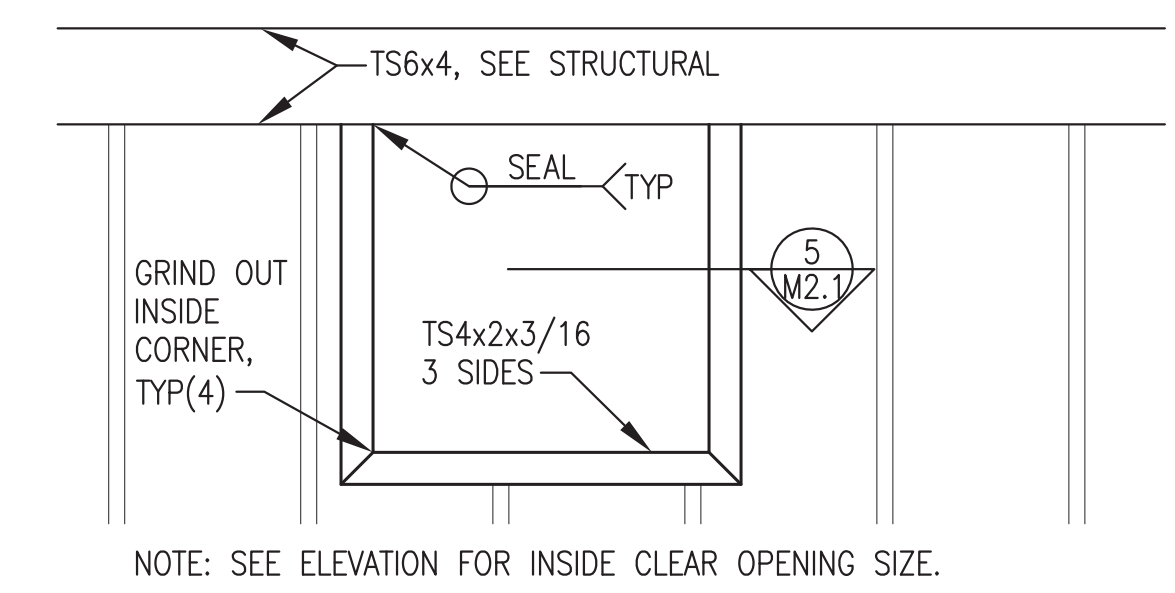


3 TYPICAL WALL OPENING - ELEVATION
1"=1'-0"

- NOTES:
- 1) FABRICATE FRAMED OPENING WITH MITERED CORNERS AND FULL PENETRATION GROOVE WELDS.
 - 2) FABRICATE TO FINISHED INSIDE (CLEAR) DIMENSIONS INDICATED ON ELEVATIONS.
 - 3) GRIND OUT INSIDE OF MITERED CORNERS TO PROVIDE FULL CLEAR OPENING.

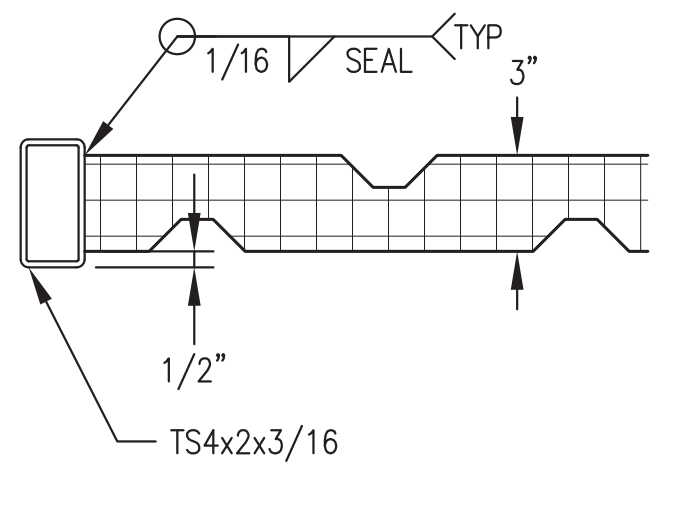

5 TYPICAL SECTION THROUGH WALL OPENING
2"=1'-0"

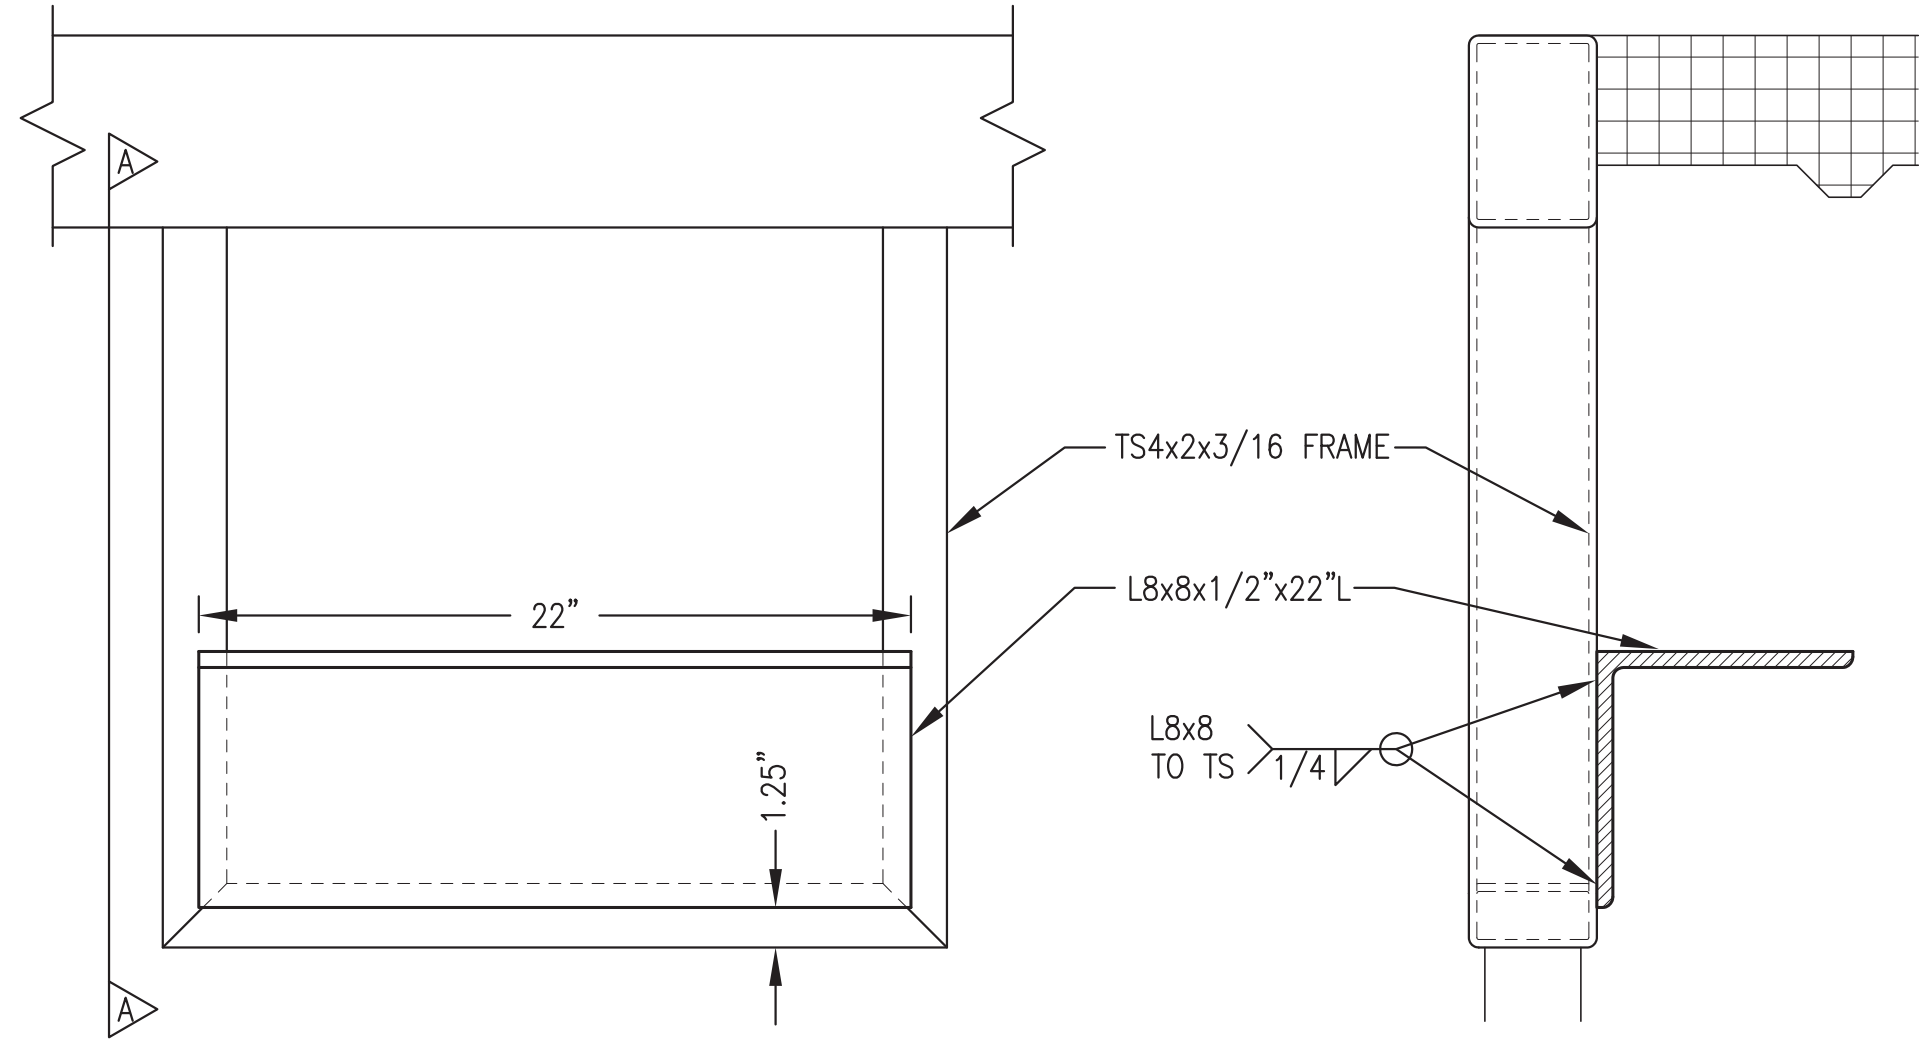


6 EXHAUST PIPE SUPPORT AT FRAMED OPENING
2"=1'-0"

NOTE: THIS DRAWING SHOWS WORK THAT WAS PERFORMED BY OTHERS AS PART OF THE FABRICATION OF THE OWNER FURNISHED MODULE STRUCTURE AND IS PROVIDED FOR REFERENCE ONLY. SEE OWNER FURNISHED MODULE SHOP DRAWINGS FOR ADDITIONAL DETAIL.


ISSUED FOR CONSTRUCTION JANUARY 2019

NOTE: ALL DIMENSIONS FROM GRIDLINE (OUTSIDE OF DECK)

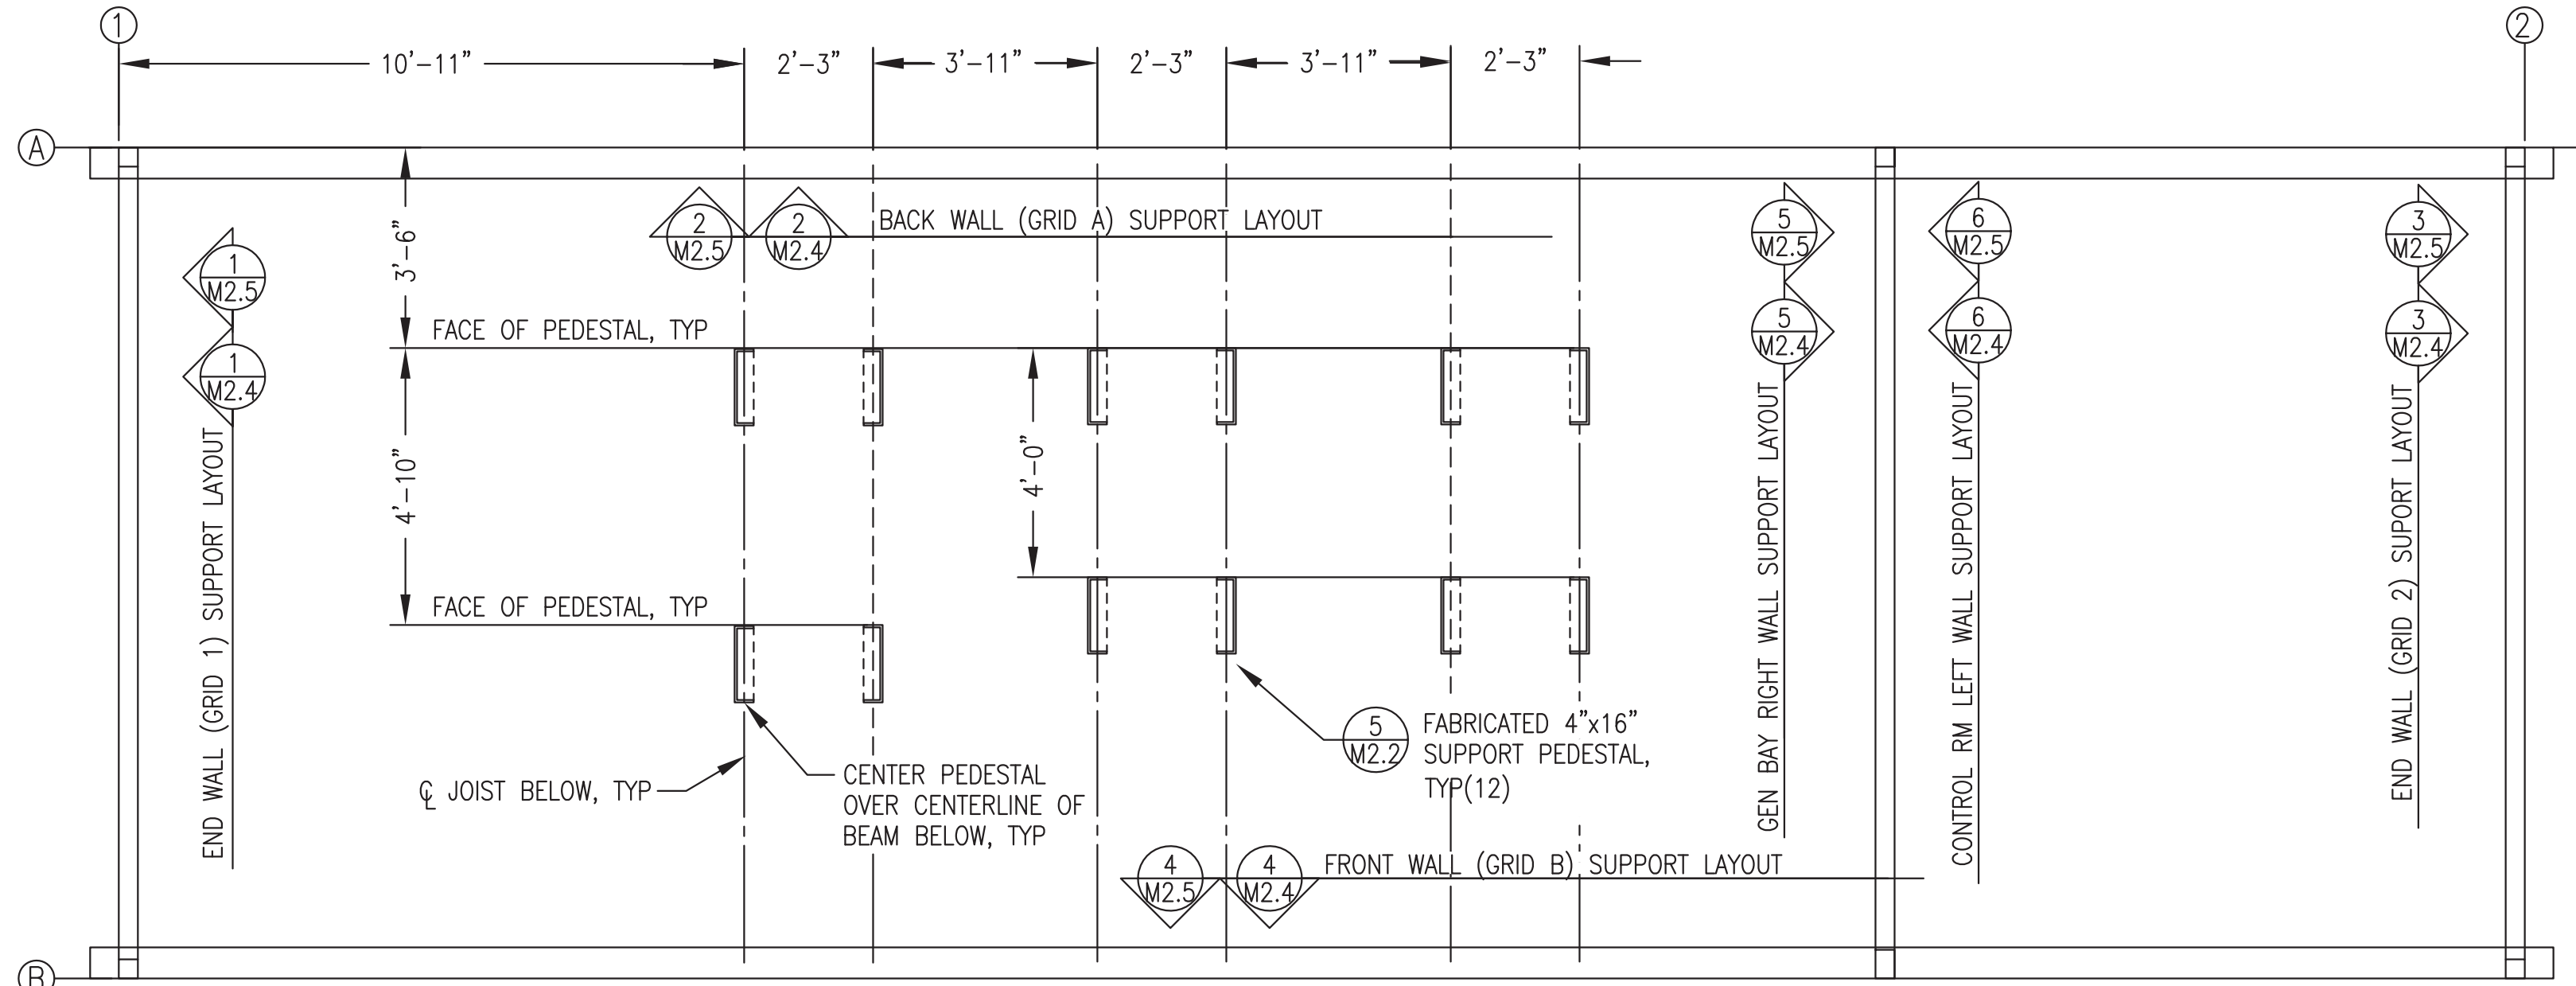


1 MODULE MECHANICAL SUPPORT PLAN
M2.2 3/8"=1'-0"

NOTE: THIS DRAWING SHOWS WORK THAT WAS PERFORMED BY OTHERS AS PART OF THE FABRICATION OF THE OWNER FURNISHED MODULE STRUCTURE AND IS PROVIDED FOR REFERENCE ONLY. SEE OWNER FURNISHED MODULE SHOP DRAWINGS FOR ADDITIONAL DETAIL.

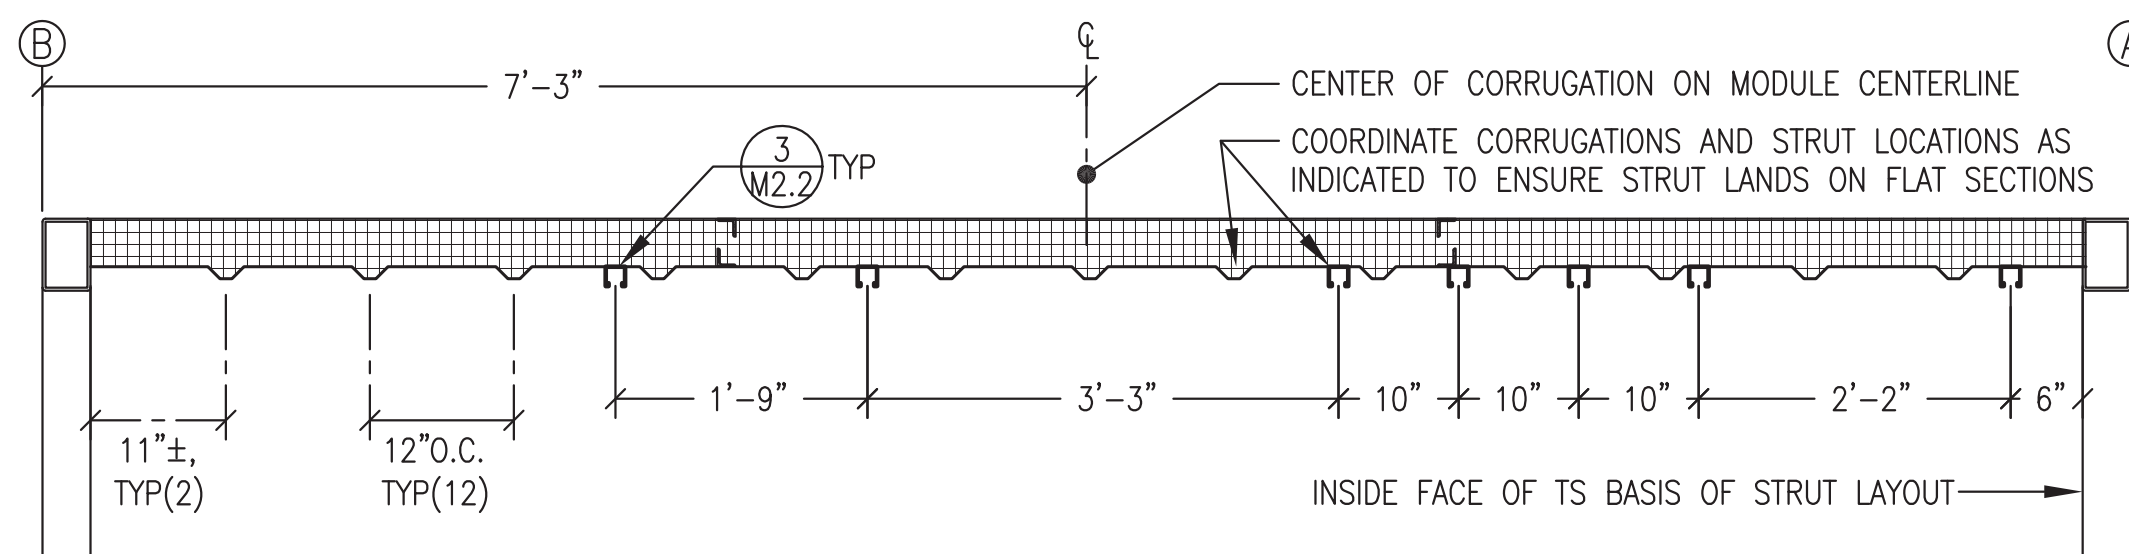


2 SECTION THROUGH CEILING - CORRUGATION & STRUT LAYOUT
M2.2 3/4"=1'-0"

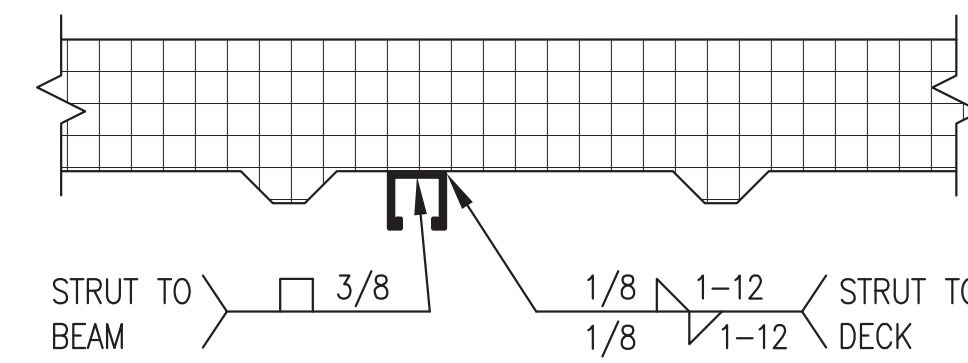


3 STRUT ATTACHMENT TO CEILING
M2.2 NO SCALE

GENERAL NOTES:

- 1) FABRICATE PEDESTALS FROM ASTM A36 ANGLE AND PLATES AS SHOWN.
- 2) ALL STRUT 12 GAUGE 1-5/8"x1-5/8" SOLID BACK PLAIN (UNFINISHED). B-LINE B22-PLN OR EQUAL. PURCHASE IN 20' LENGTHS TO MINIMIZE SPLICES.
- 3) INSTALL ALL SUPPORTS INDICATED AND GRIND SMOOTH PRIOR TO SANDBLASTING MODULE. SANDBLAST AND PAINT ALL SUPPORTS THIS SHEET EQUIVALENT TO MODULE INTERIOR. SEE SHEET A1 FOR PAINTING SPECIFICATIONS.

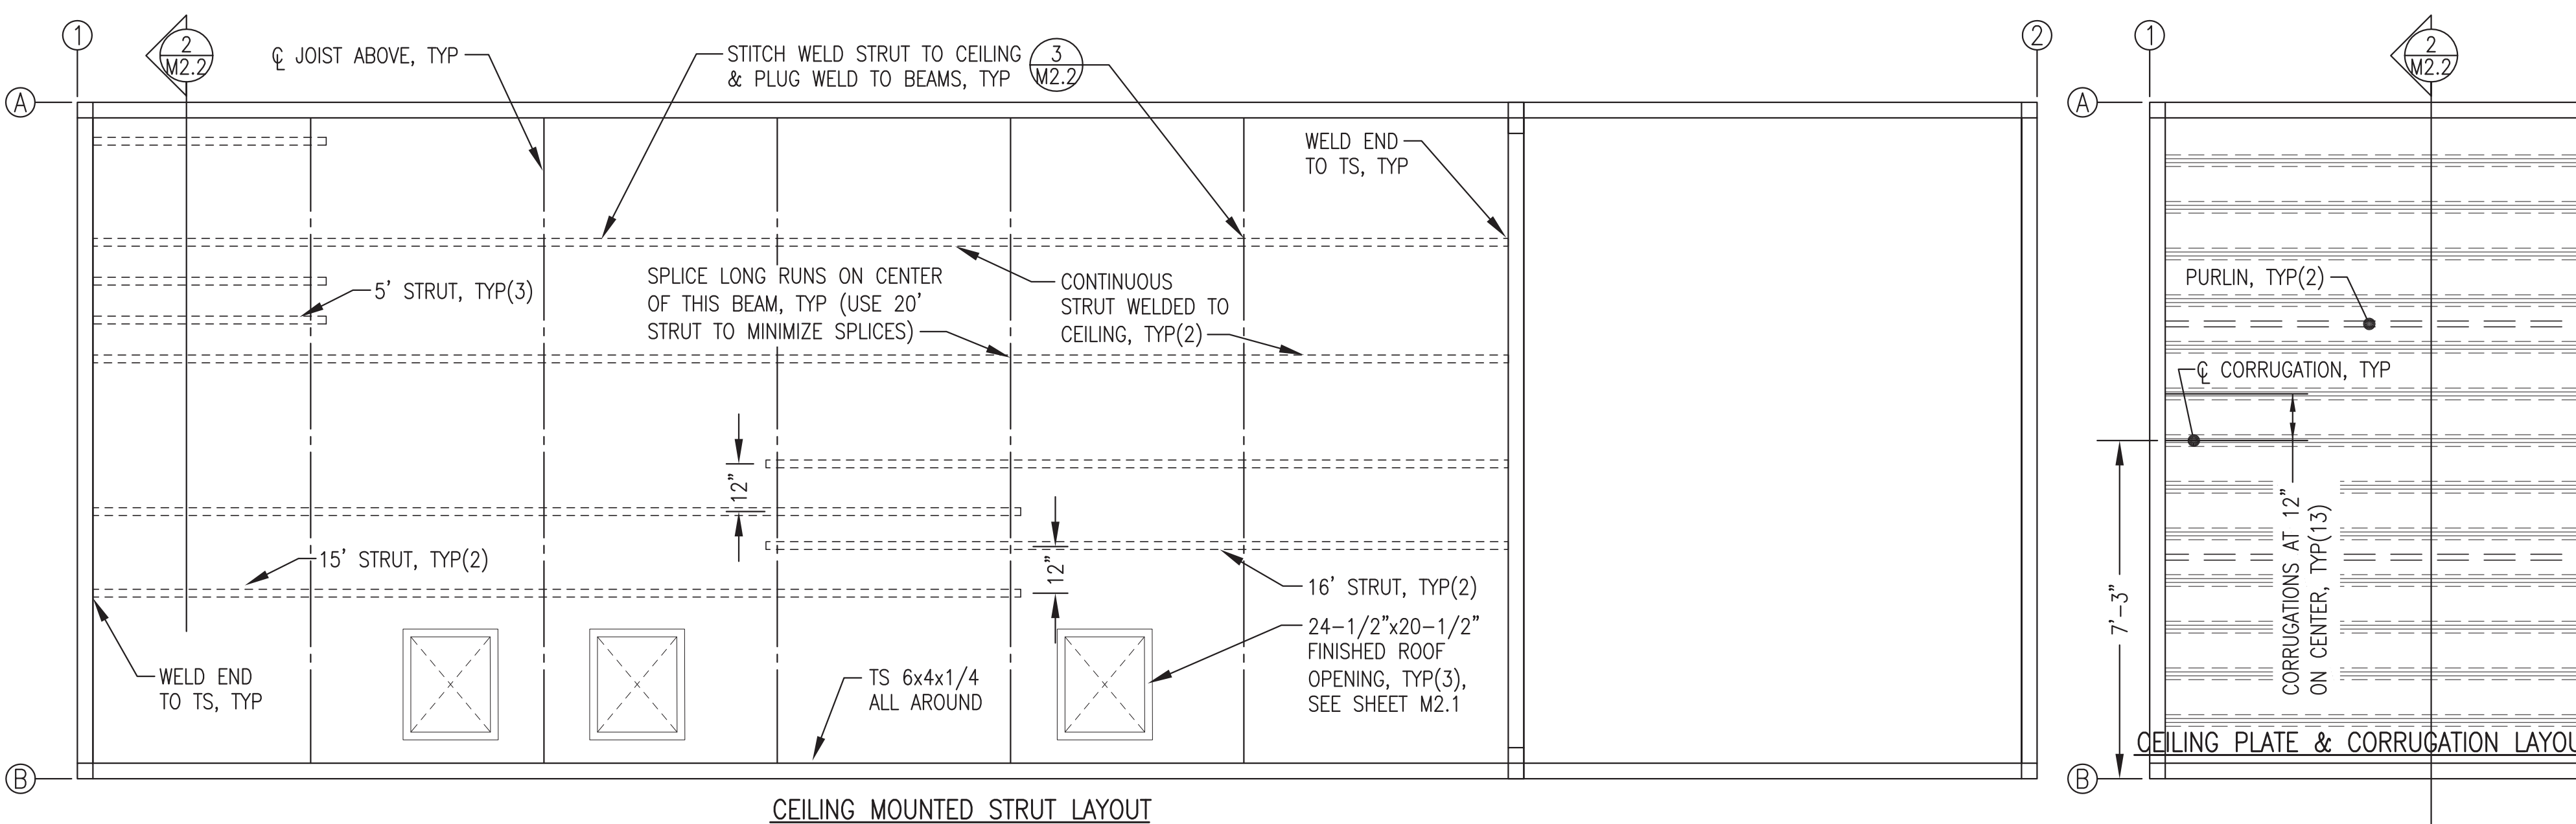

4 CEILING STRUT SUPPORT LAYOUT PLAN
M2.2 3/8"=1'-0"

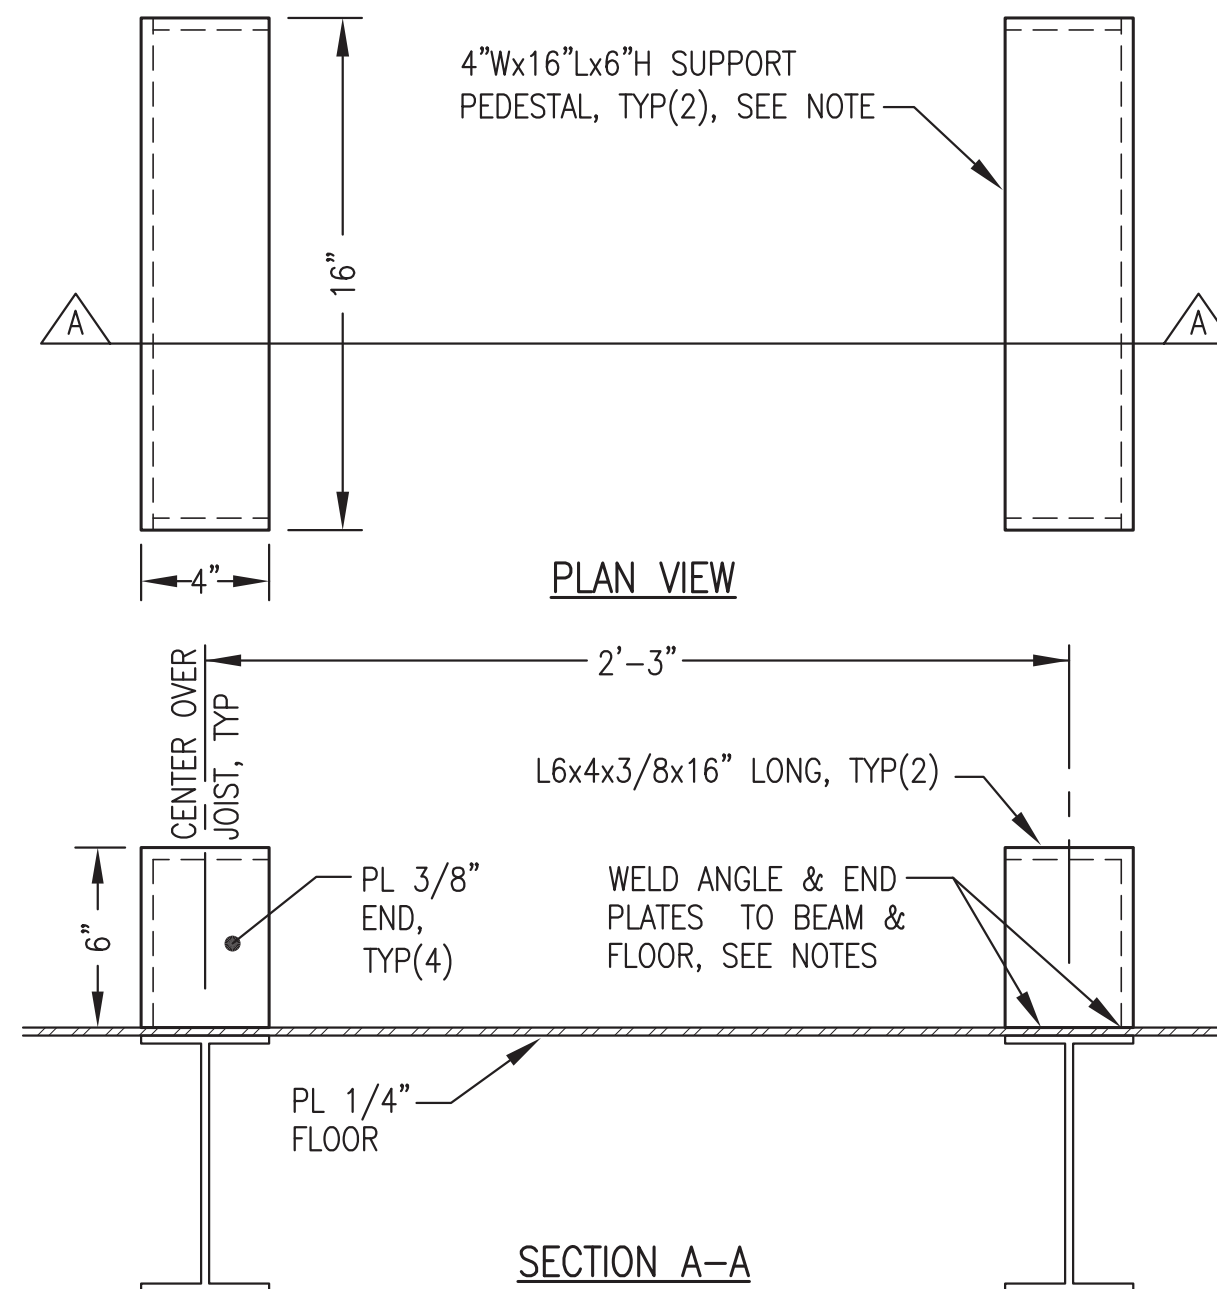

5 SUPPORT PEDESTAL FABRICATION
M2.2 2"=1'-0"




Gray Stassel Engineering, Inc.
P.O. 111405
Anchorage, AK 99511
(907)949-0100

STATE OF ALASKA, AIDEA/AEA RURAL POWER SYSTEM UPGRADE
CLARKS POINT POWER PLANT
CLARKS POINT, ALASKA

REVISIONS	DESCRIPTION

VERIFY SCALES
0 1"
THIS BAR REPRESENTS ONE INCH ON ORIGINAL DRAWING

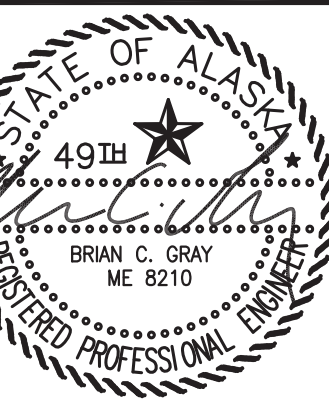

DATE: 1/14/19
DRAWN BY: JTD
CHECKED BY: BCG
JOB NUMBER:


DRAWING TITLE:
MECHANICAL SUPPORT PLANS & DETAILS

M2.2
SHEET OF 7

ISSUED FOR CONSTRUCTION JANUARY 2019

CONSTRUCTION DOCUMENTS	
REV. DATE	DESCRIPTION


VERIFY SCALES
0 1"
THIS BAR REPRESENTS ONE INCH ON ORIGINAL DRAWING

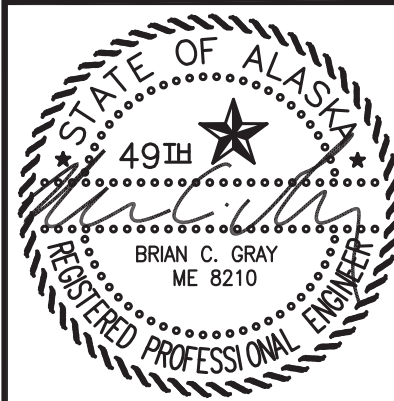


DATE: 1/14/19
DRAWN BY: JTD
CHECKED BY: BCG
JOB NUMBER:

DRAWING TITLE:
RADIATOR SUPPORT
PLAN & DETAILS

M2.3
SHEET OF 7

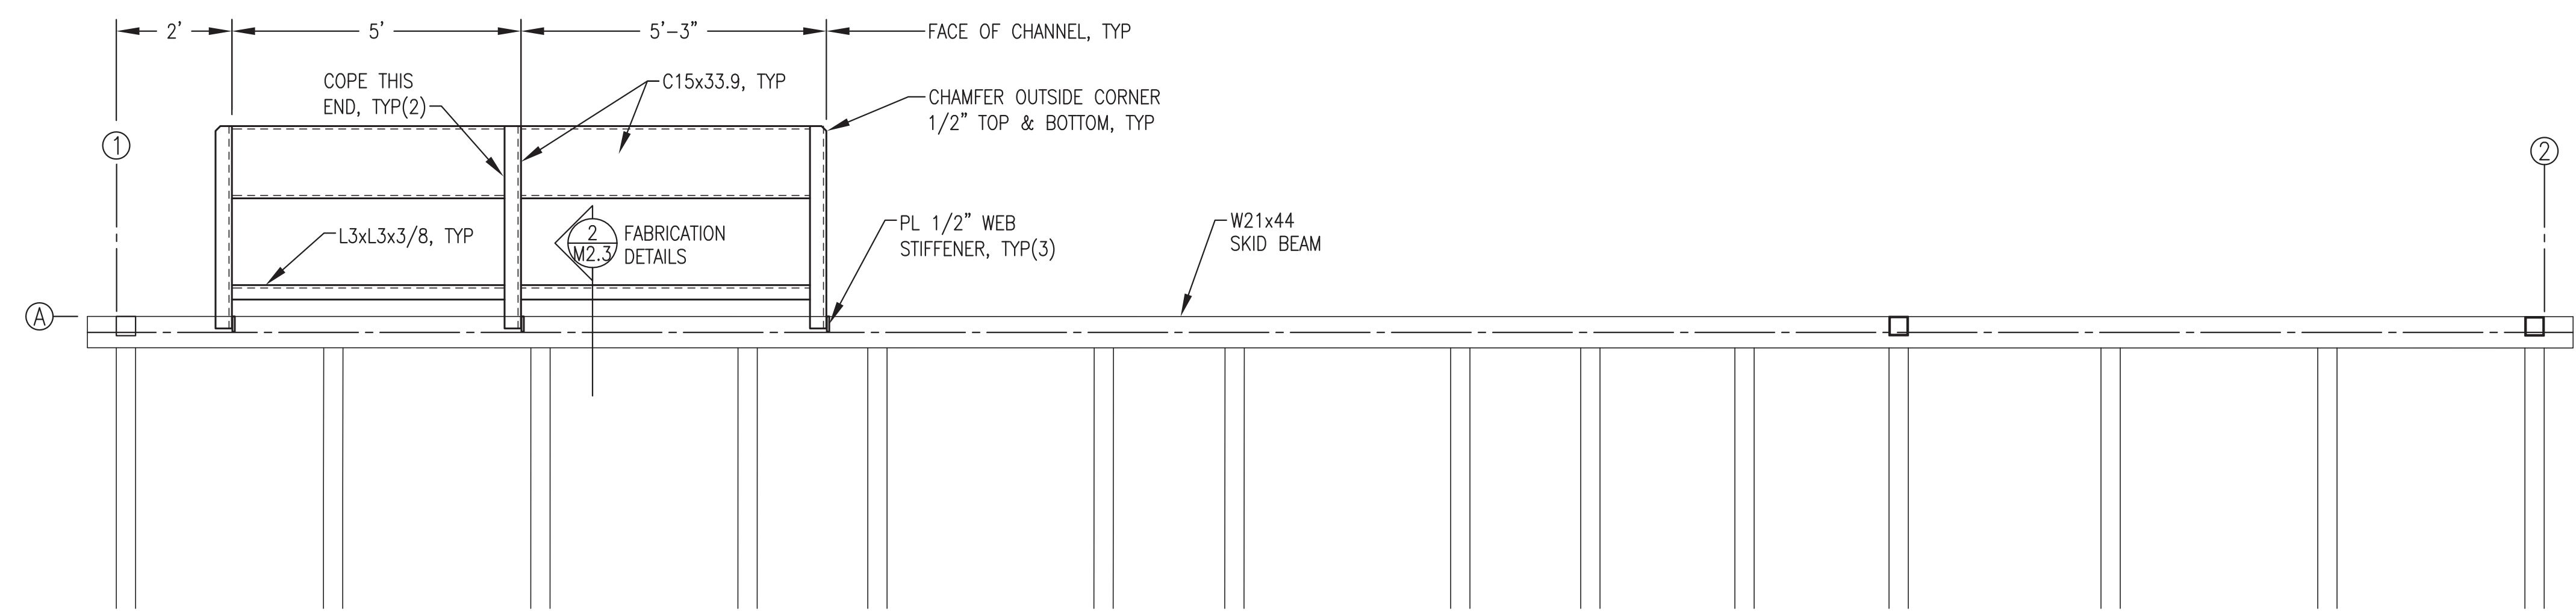

1 RADIATOR SUPPORT PLAN
M2.3 1/2"=1'-0"

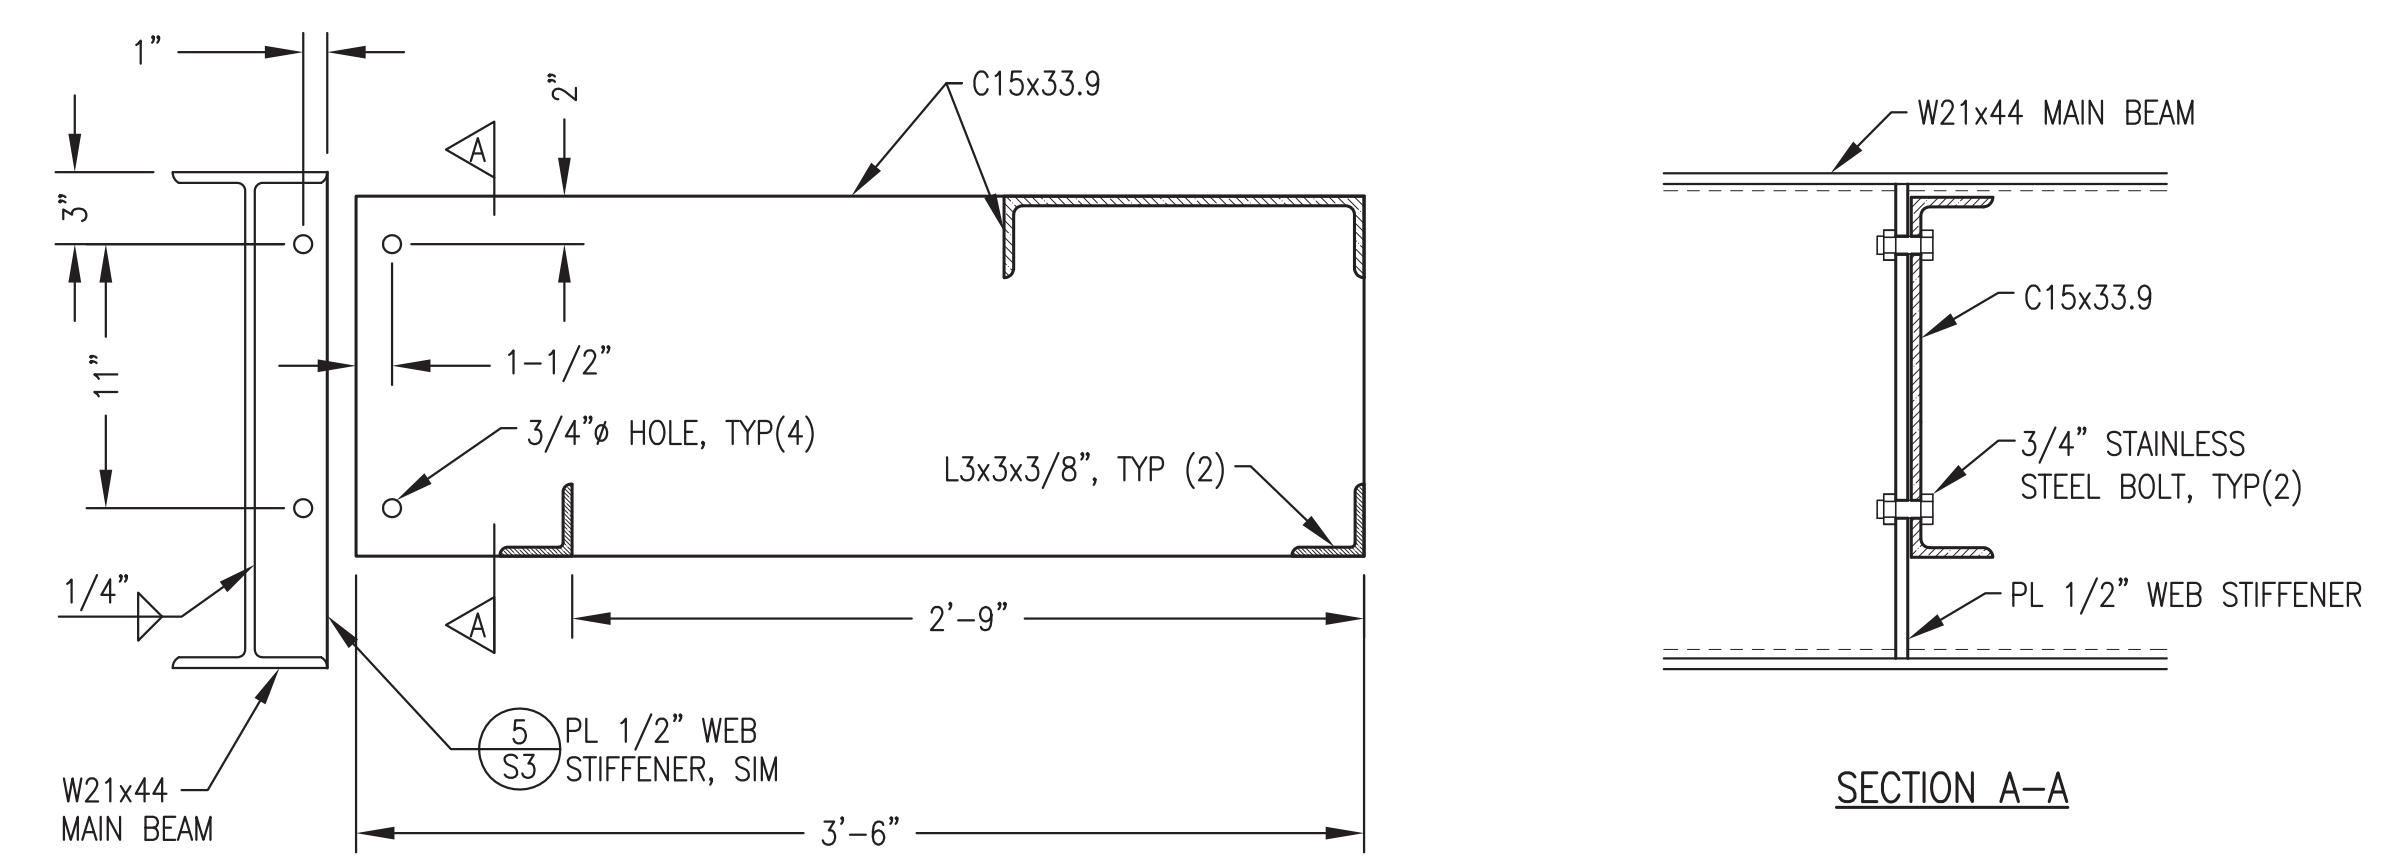

- SUPPORT FABRICATION NOTES:**
- 1) FABRICATE SUPPORT FROM ASTM A36 ANGLE & CHANNEL AS SHOWN.
 - 2) RACK ALL SUPPORT BRACKETS LEVEL & PERPENDICULAR TO SKID WITH CONNECTIONS BOLTED TIGHT PRIOR TO WELDING.
 - 3) UPON COMPLETION OF WELDING ROUND CORNERS AND GRIND EDGES SMOOTH.
 - 4) PRIOR TO SANDBLASTING MODULE REMOVE SUPPORTS THEN SANDBLAST AND PAINT EQUIVALENT TO MODULE EXTERIOR WALLS. SEE SHEET A1 FOR PAINTING SPECIFICATIONS.


NOTE: THIS DRAWING SHOWS WORK THAT WAS PERFORMED BY OTHERS AS PART OF THE FABRICATION OF THE OWNER FURNISHED MODULE STRUCTURE AND IS PROVIDED FOR REFERENCE ONLY. SEE OWNER FURNISHED MODULE SHOP DRAWINGS FOR ADDITIONAL DETAIL.

2 RADIATOR SUPPORT FABRICATION
M2.3 1-1/2"=1'-0"

ISSUED FOR CONSTRUCTION JANUARY 2019

REVISIONS	DESCRIPTION
REV DATE	


VERIFY SCALES
0 1" = 1" THIS BAR REPRESENTS ONE INCH ON ORIGINAL DRAWING

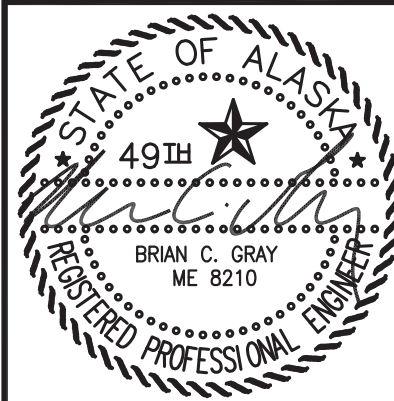


DATE: 1/14/19
DRAWN BY: JTD
CHECKED BY: BCG
JOB NUMBER:

DRAWING TITLE:
MECHANICAL SUPPORT
HORIZONTAL WALL STRUT
INSTALLATION


M2.4
SHEET OF 7

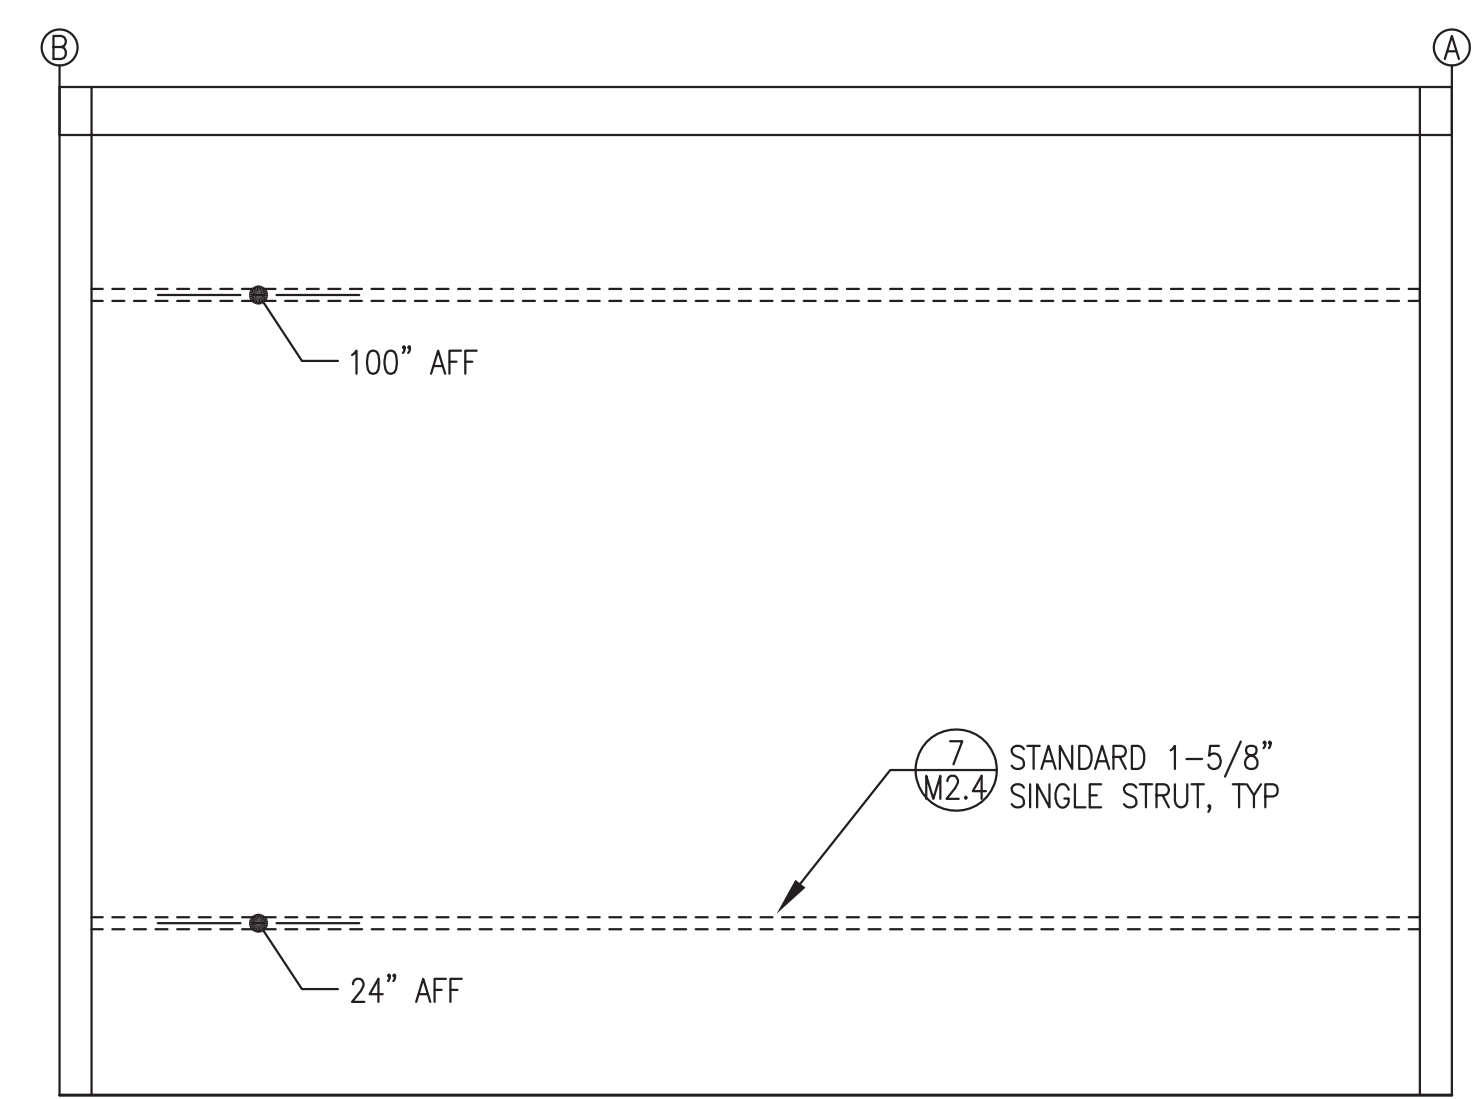


1 END WALL (GRID 1) HORIZONTAL WALL STRUT LAYOUT
M2.4 1/2"=1'-0"

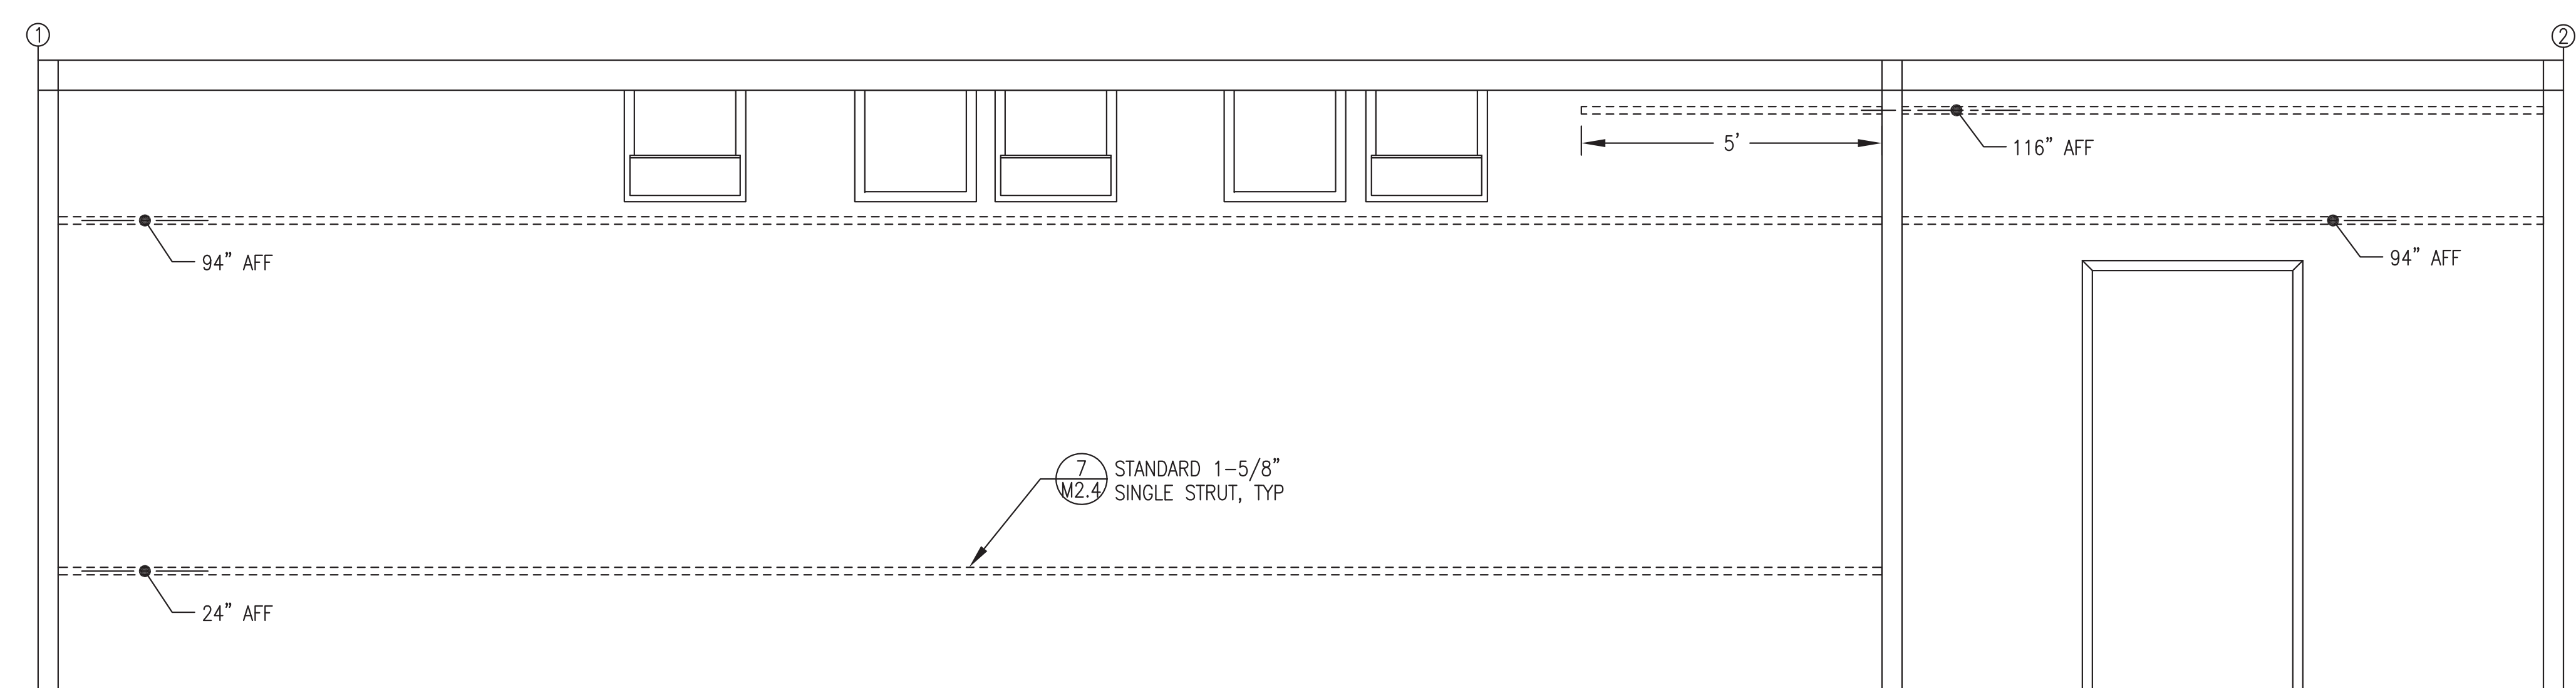


2 BACK WALL (GRID A) HORIZONTAL WALL STRUT LAYOUT
M2.4 1/2"=1'-0"

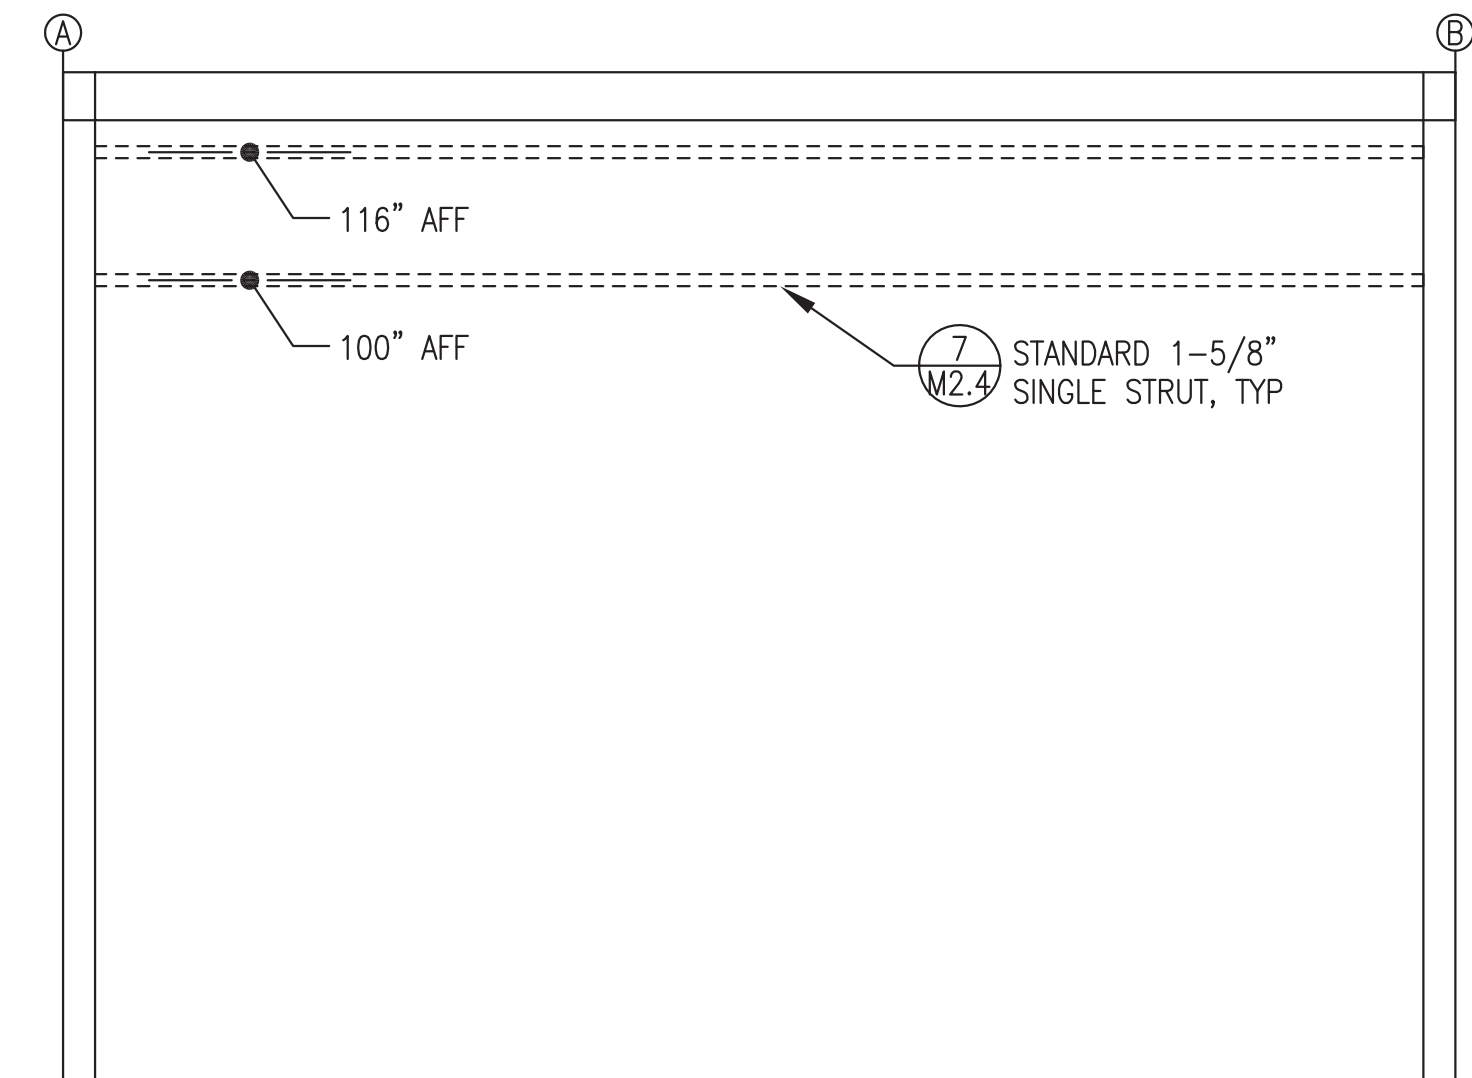


3 END WALL (GRID 2) HORIZONTAL WALL STRUT LAYOUT
M2.4 1/2"=1'-0"

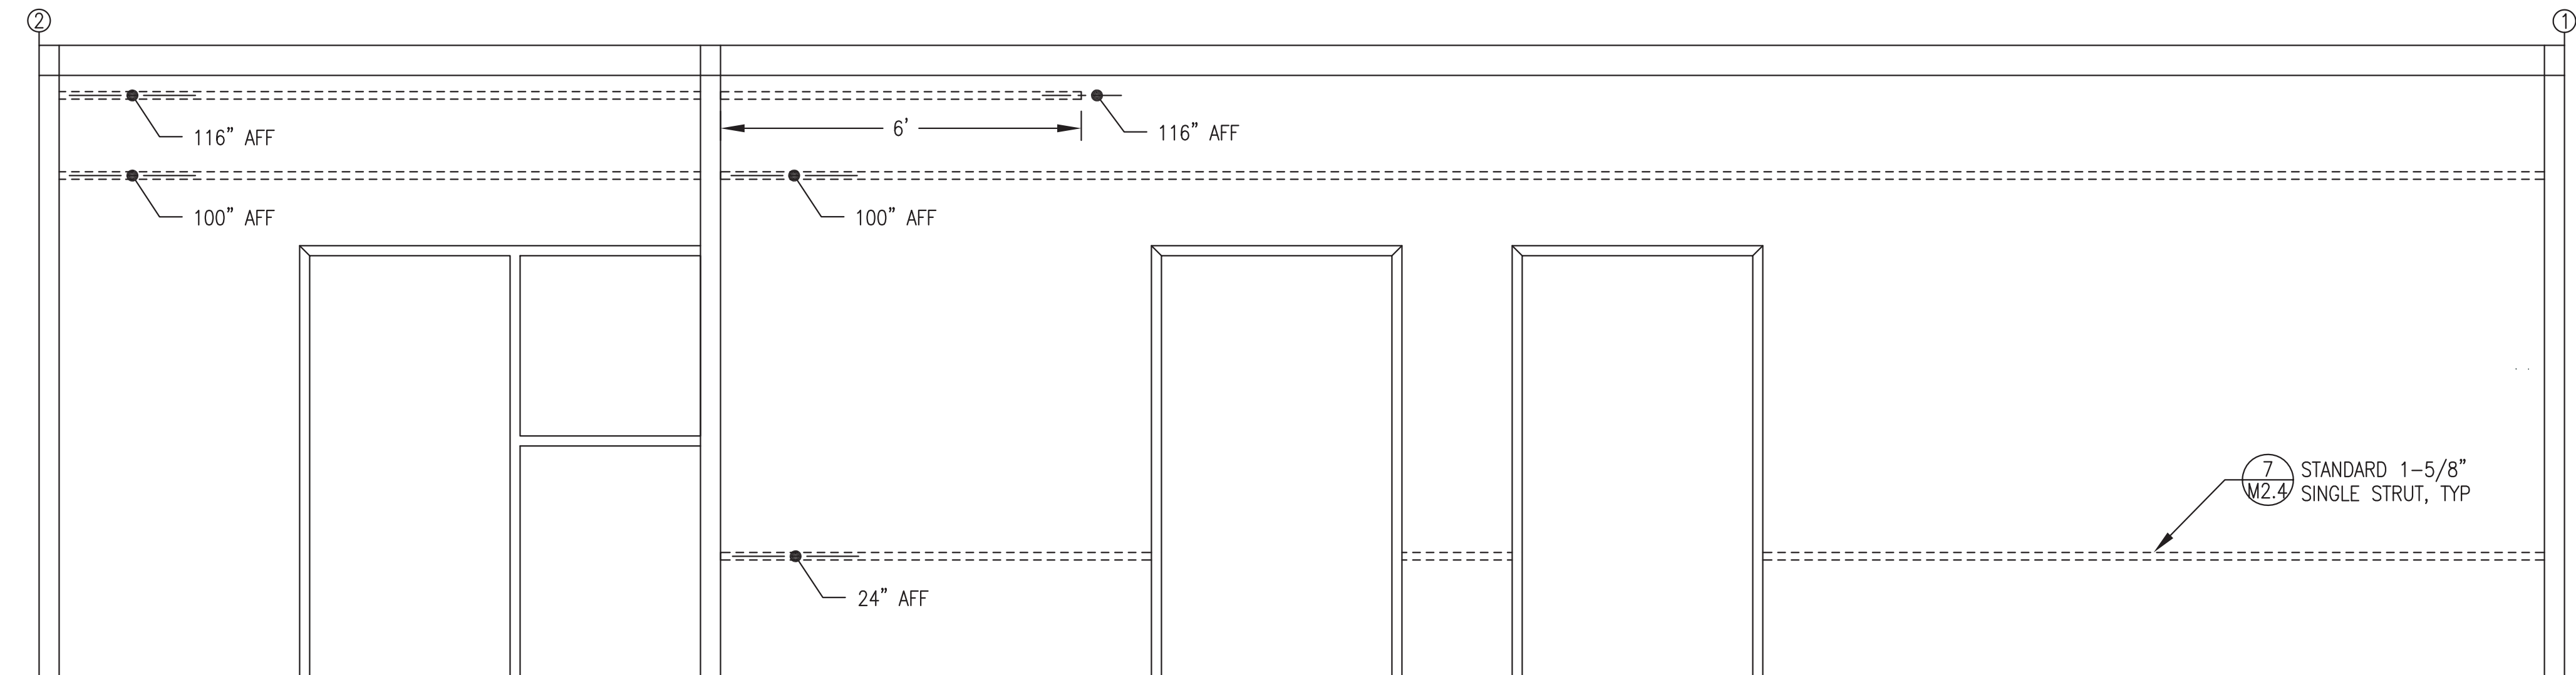

4 FRONT WALL (GRID B) HORIZONTAL WALL STRUT LAYOUT
M2.4 1/2"=1'-0"

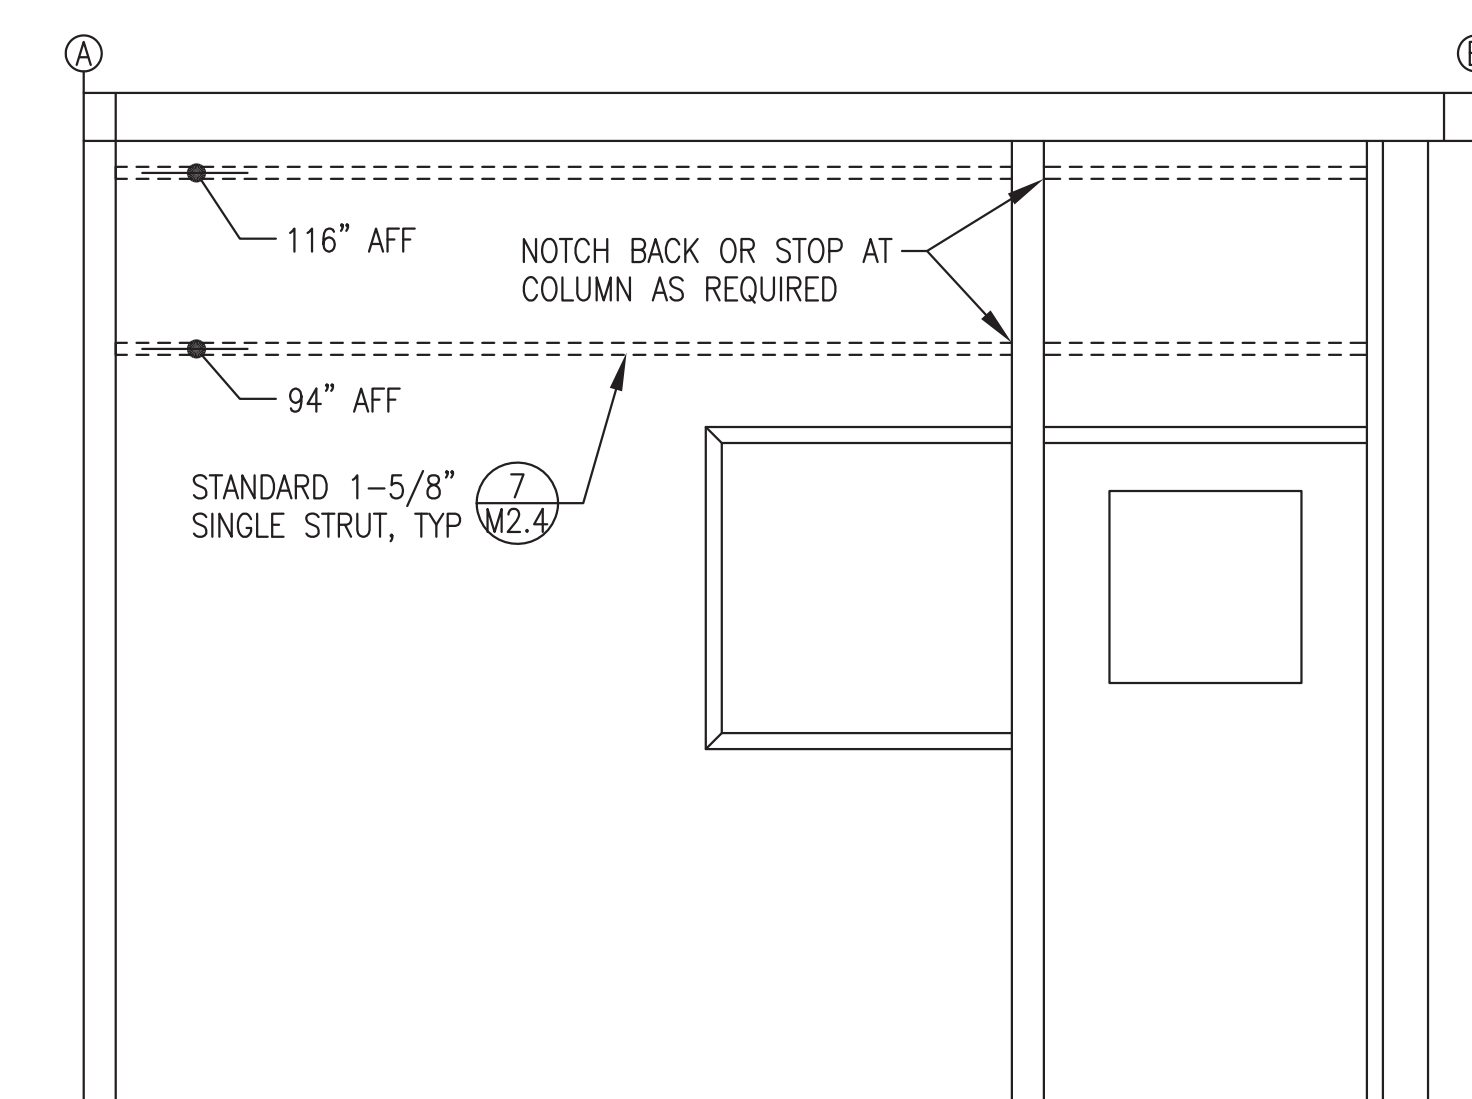


5 GEN BAY RIGHT WALL HORIZONTAL WALL STRUT LAYOUT
M2.4 1/2"=1'-0"

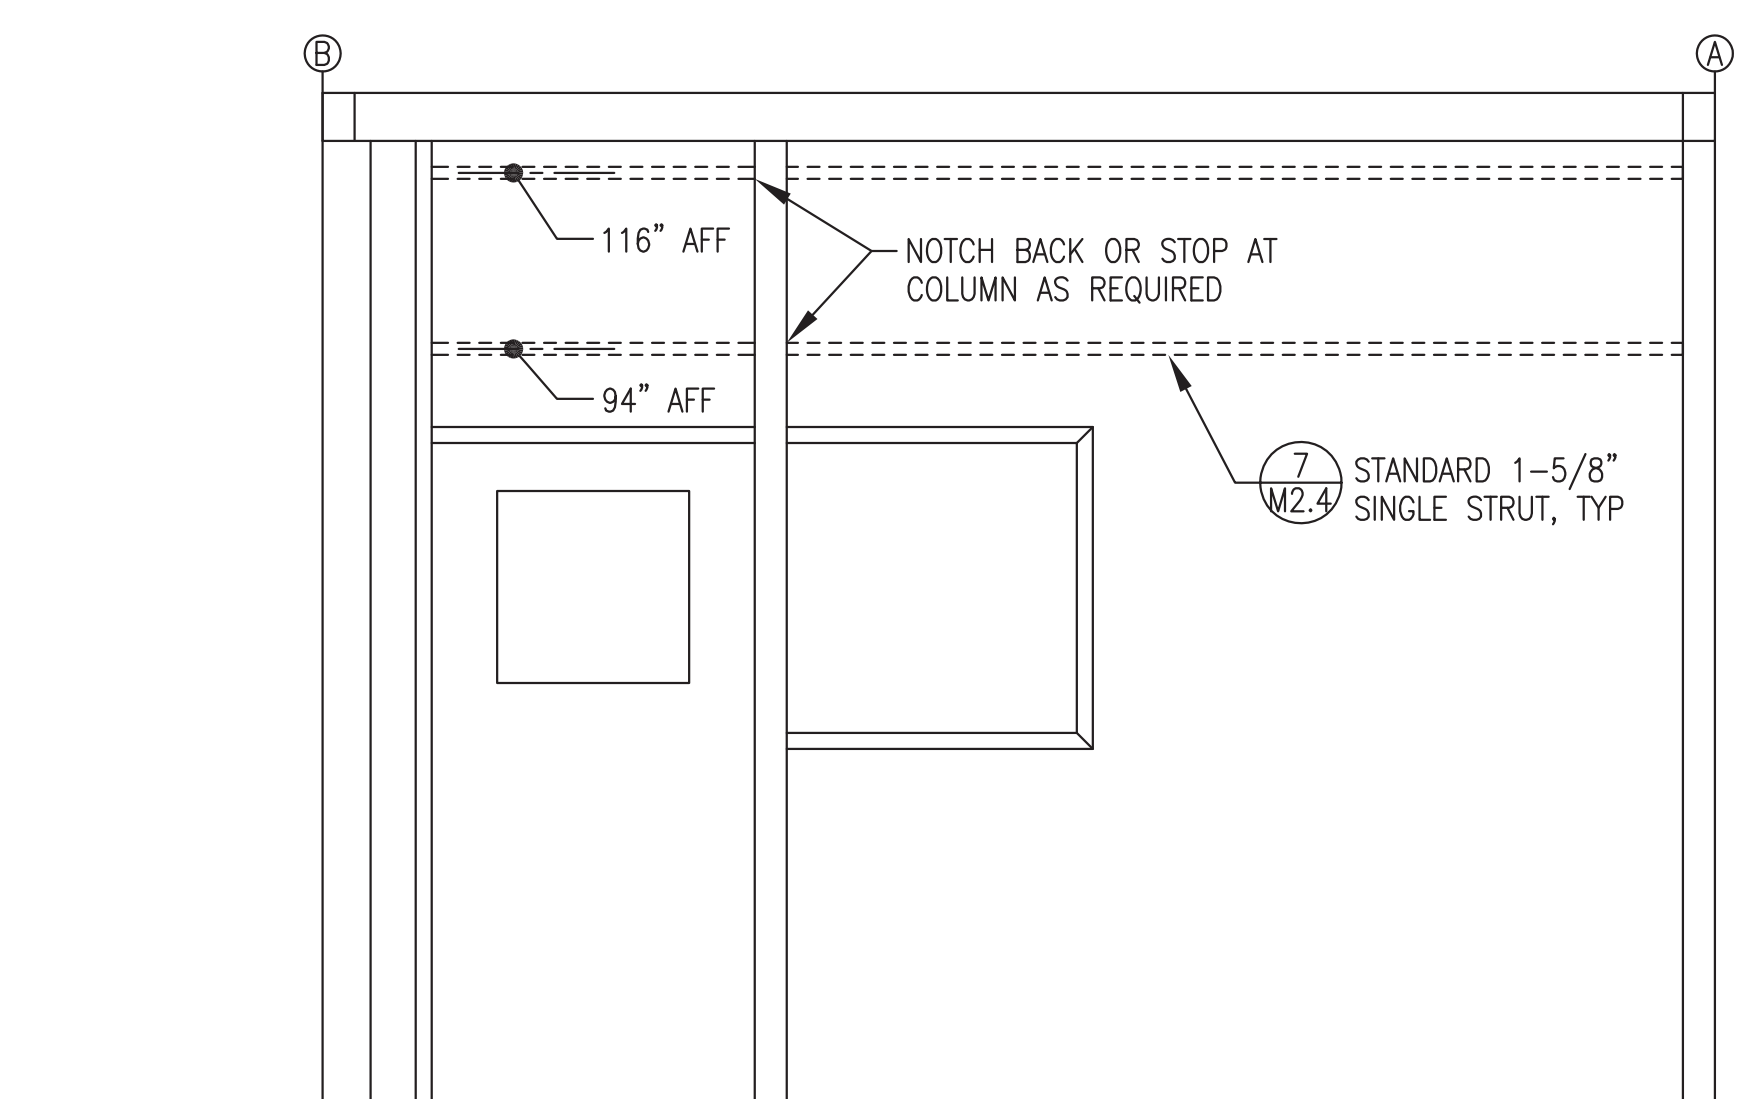

6 CONTROL ROOM LEFT WALL HORIZONTAL WALL STRUT LAYOUT
M2.4 1/2"=1'-0"

HORIZONTAL WALL STRUT INSTALLATION NOTES:


- 1) ALL LOCATIONS ARE CENTERLINE OF STRUT ABOVE FINISHED FLOOR (AFF).
- 2) ALL STRUT SHALL BE 12 GAUGE, 1-5/8" x 1-5/8", PLAIN (UN-FINISHED BLACK) WITH SOLID BACK, B-LINE B22-PLN OR EQUAL.
- 3) PRIOR TO PAINTING MODULE, WELD ALL HORIZONTAL STRUT SECTIONS TO WALLS AS SHOWN. SANDBLAST AND PAINT STRUT WITH MODULE INTERIOR WALLS. SEE SHEET A1 FOR PAINTING SPECIFICATIONS.

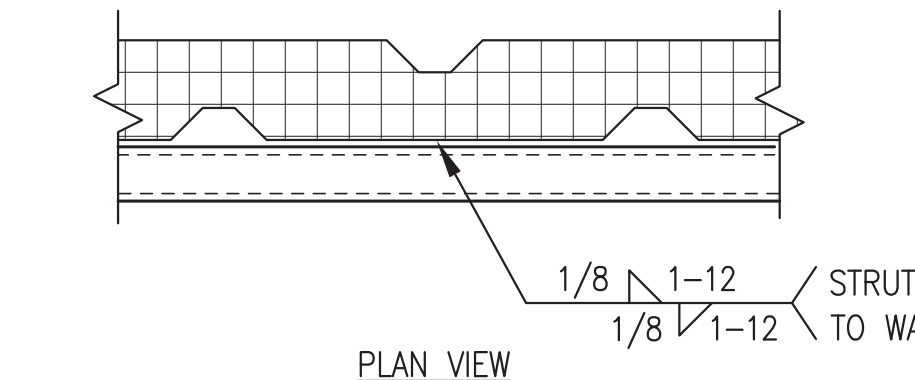


7 HORIZONTAL WALL STRUT ATTACHMENT
M2.4 NO SCALE

NOTE: THIS DRAWING SHOWS WORK THAT WAS PERFORMED BY OTHERS AS PART OF THE FABRICATION OF THE OWNER FURNISHED MODULE STRUCTURE AND IS PROVIDED FOR REFERENCE ONLY. SEE OWNER FURNISHED MODULE SHOP DRAWINGS FOR ADDITIONAL DETAIL.


ISSUED FOR CONSTRUCTION JANUARY 2019

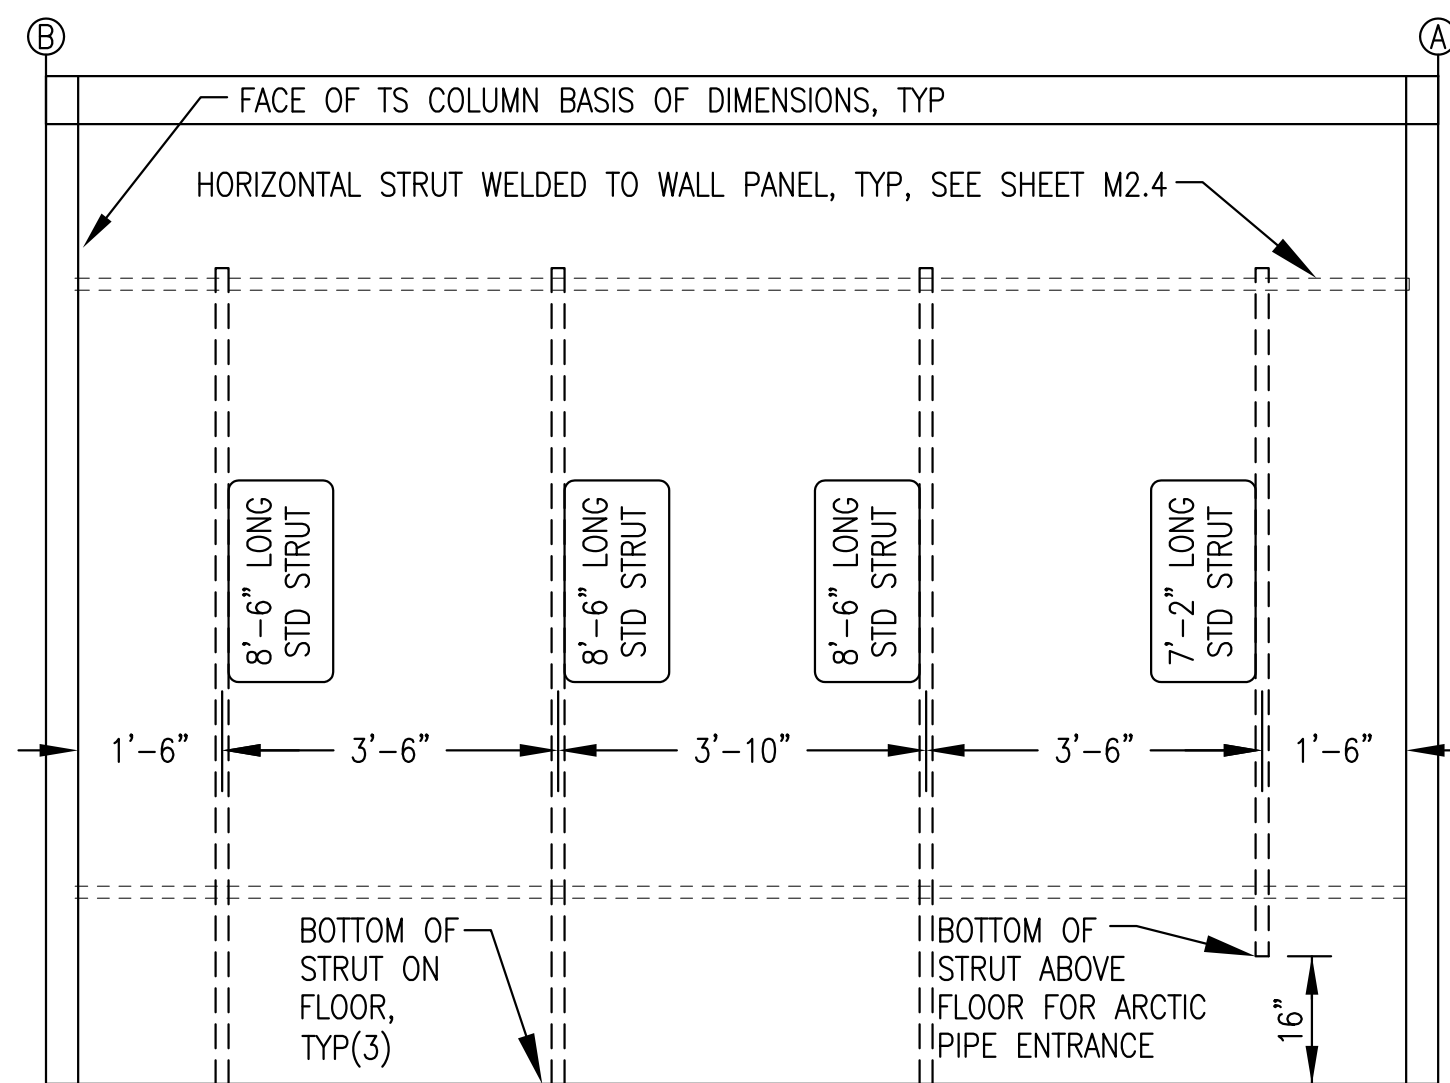


1 END WALL (GRID 1) VERTICAL WALL STRUT LAYOUT
M2.5 1/2"=1'-0"

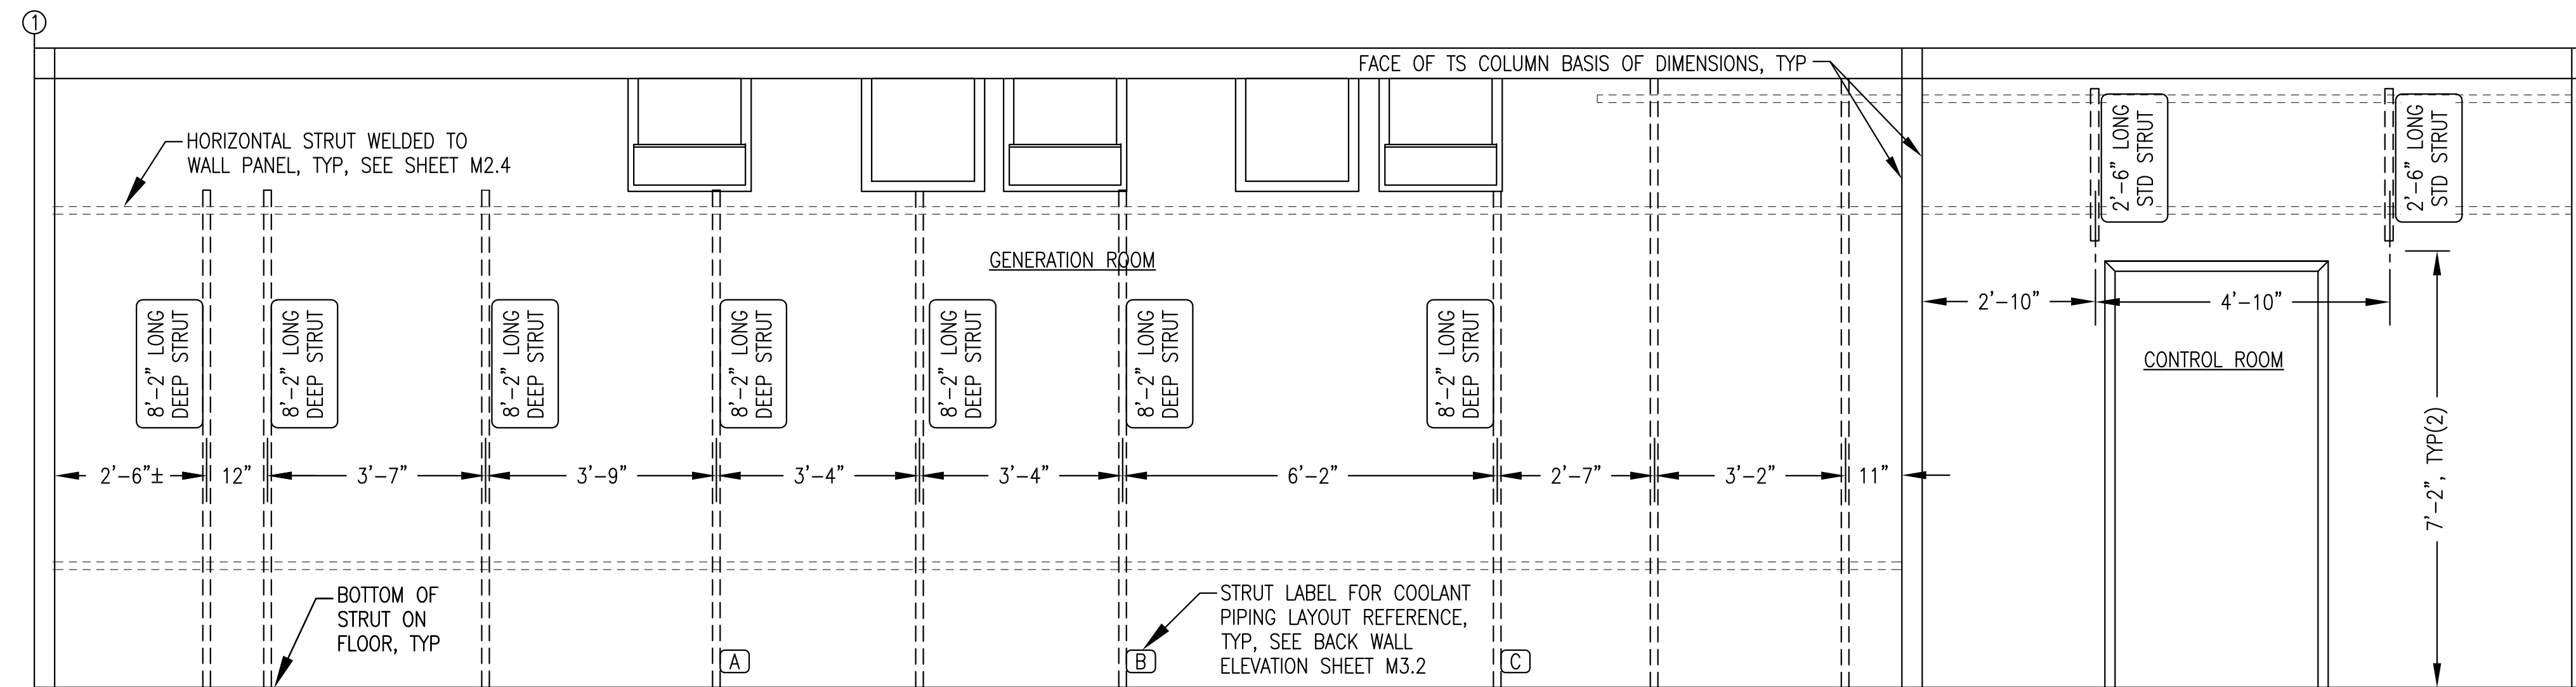


2 BACK WALL (GRID A) VERTICAL WALL STRUT LAYOUT
M2.5 1/2"=1'-0"

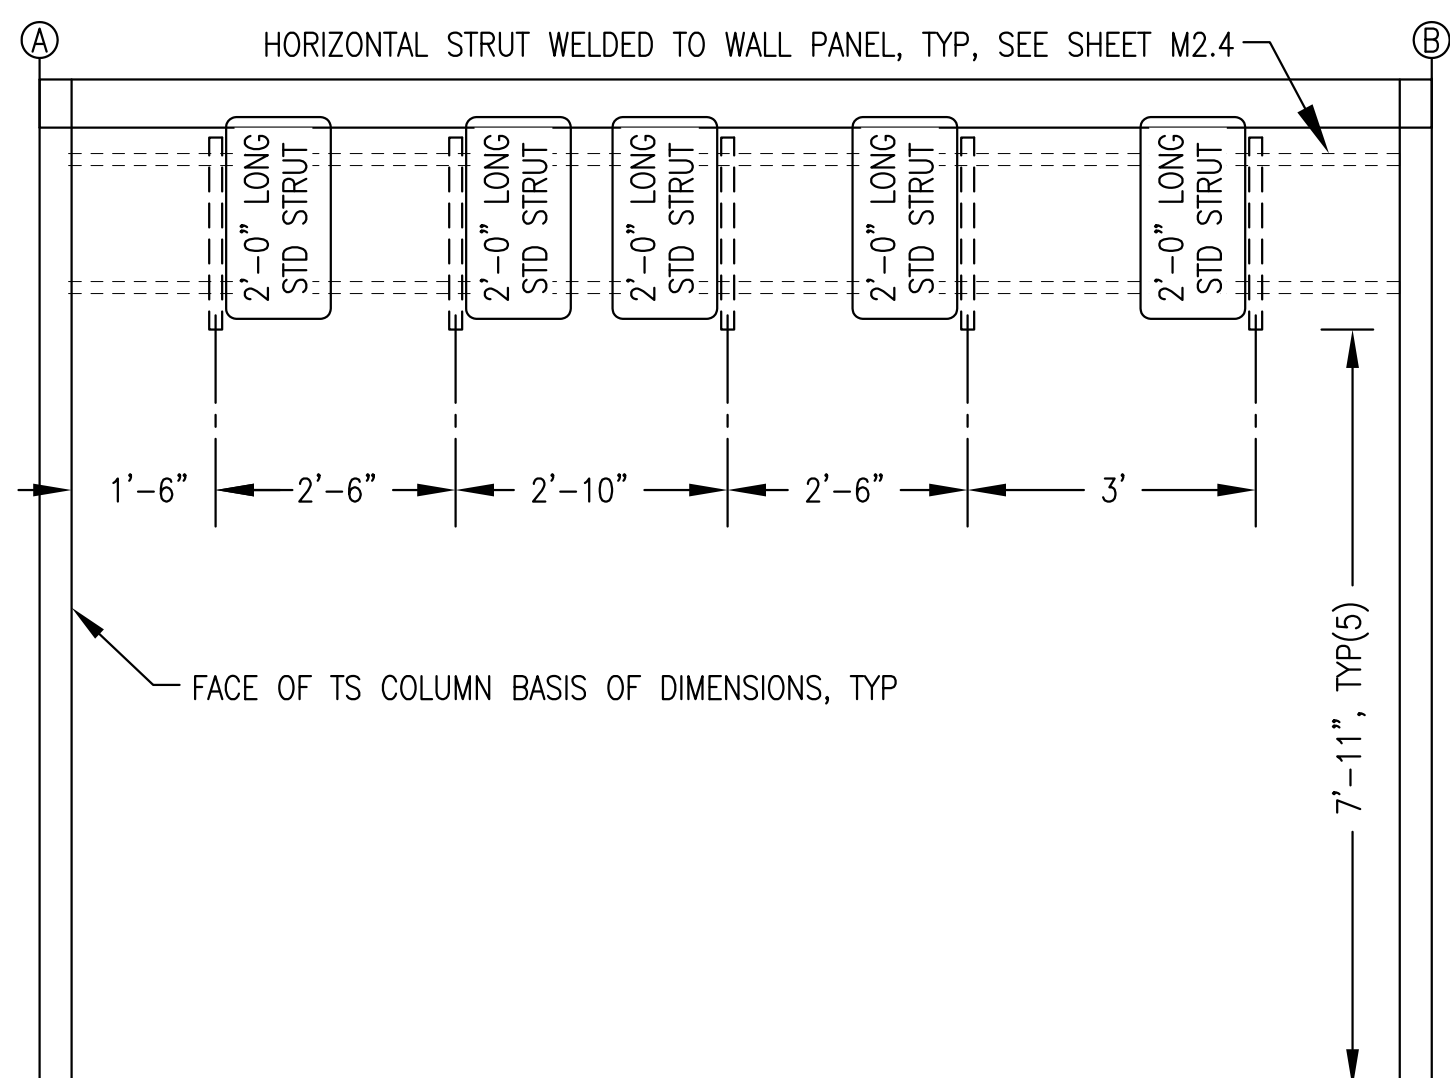


3 END WALL (GRID 2) VERTICAL WALL STRUT LAYOUT
M2.5 1/2"=1'-0"

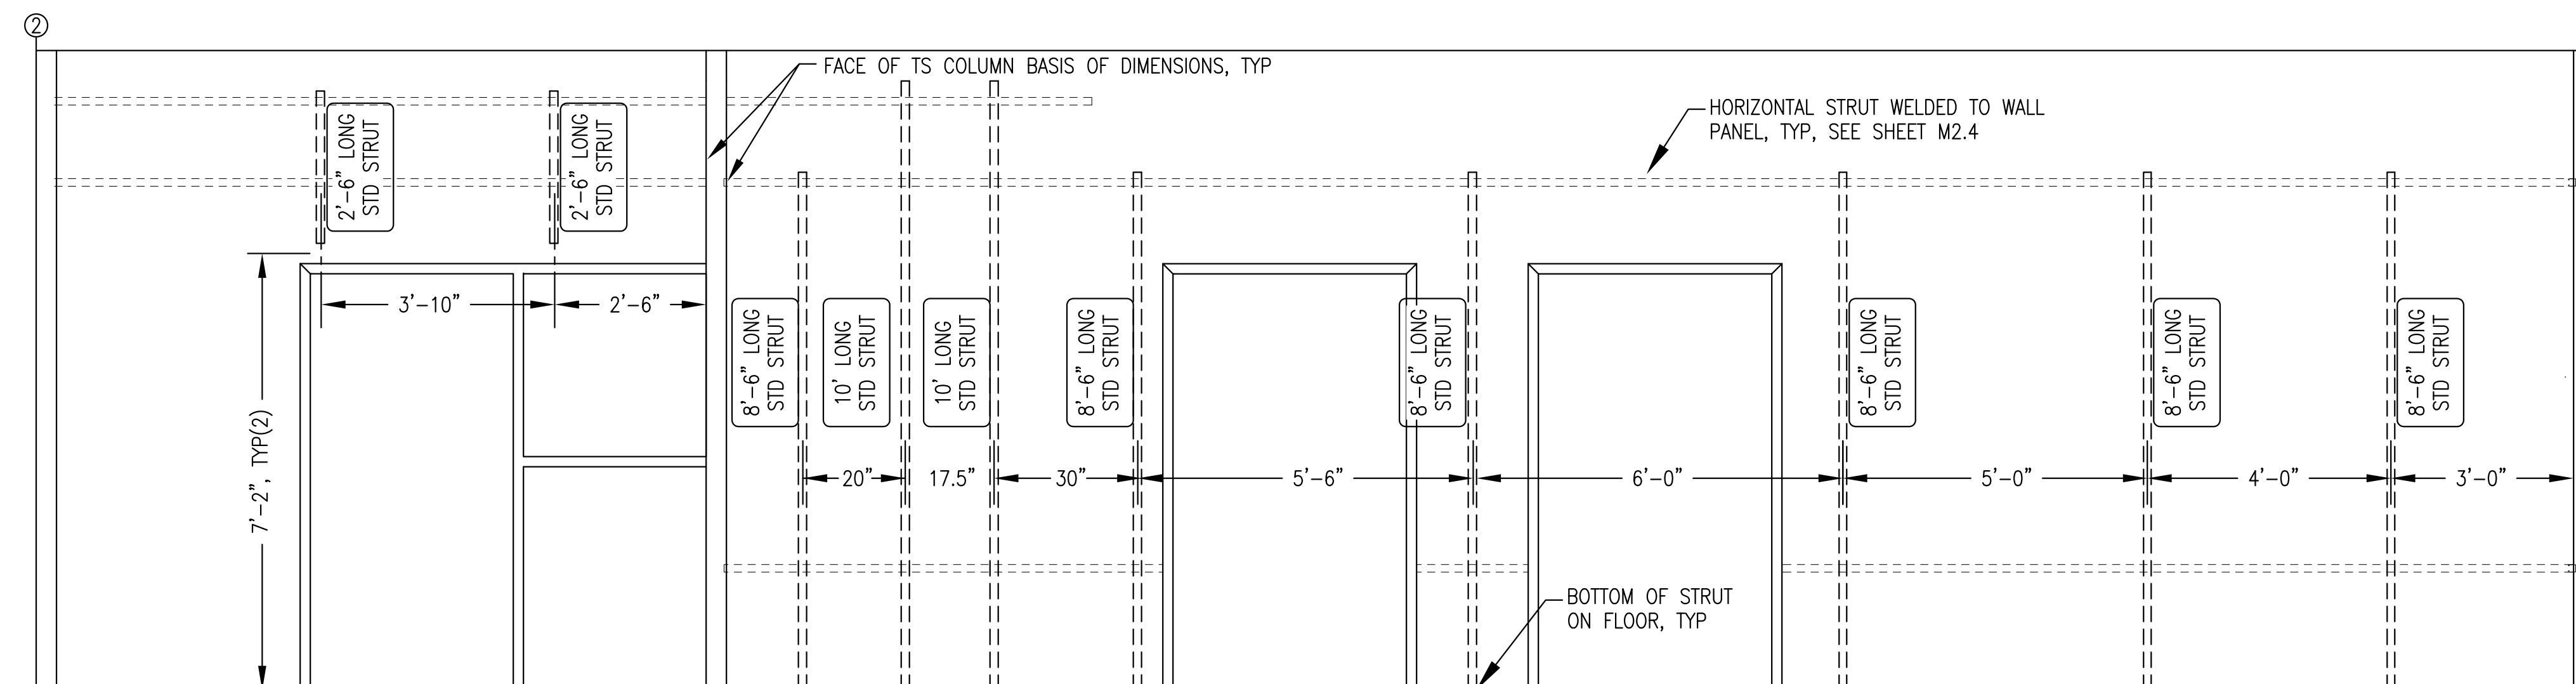

4 FRONT WALL (GRID B) VERTICAL WALL STRUT LAYOUT
M2.5 1/2"=1'-0"

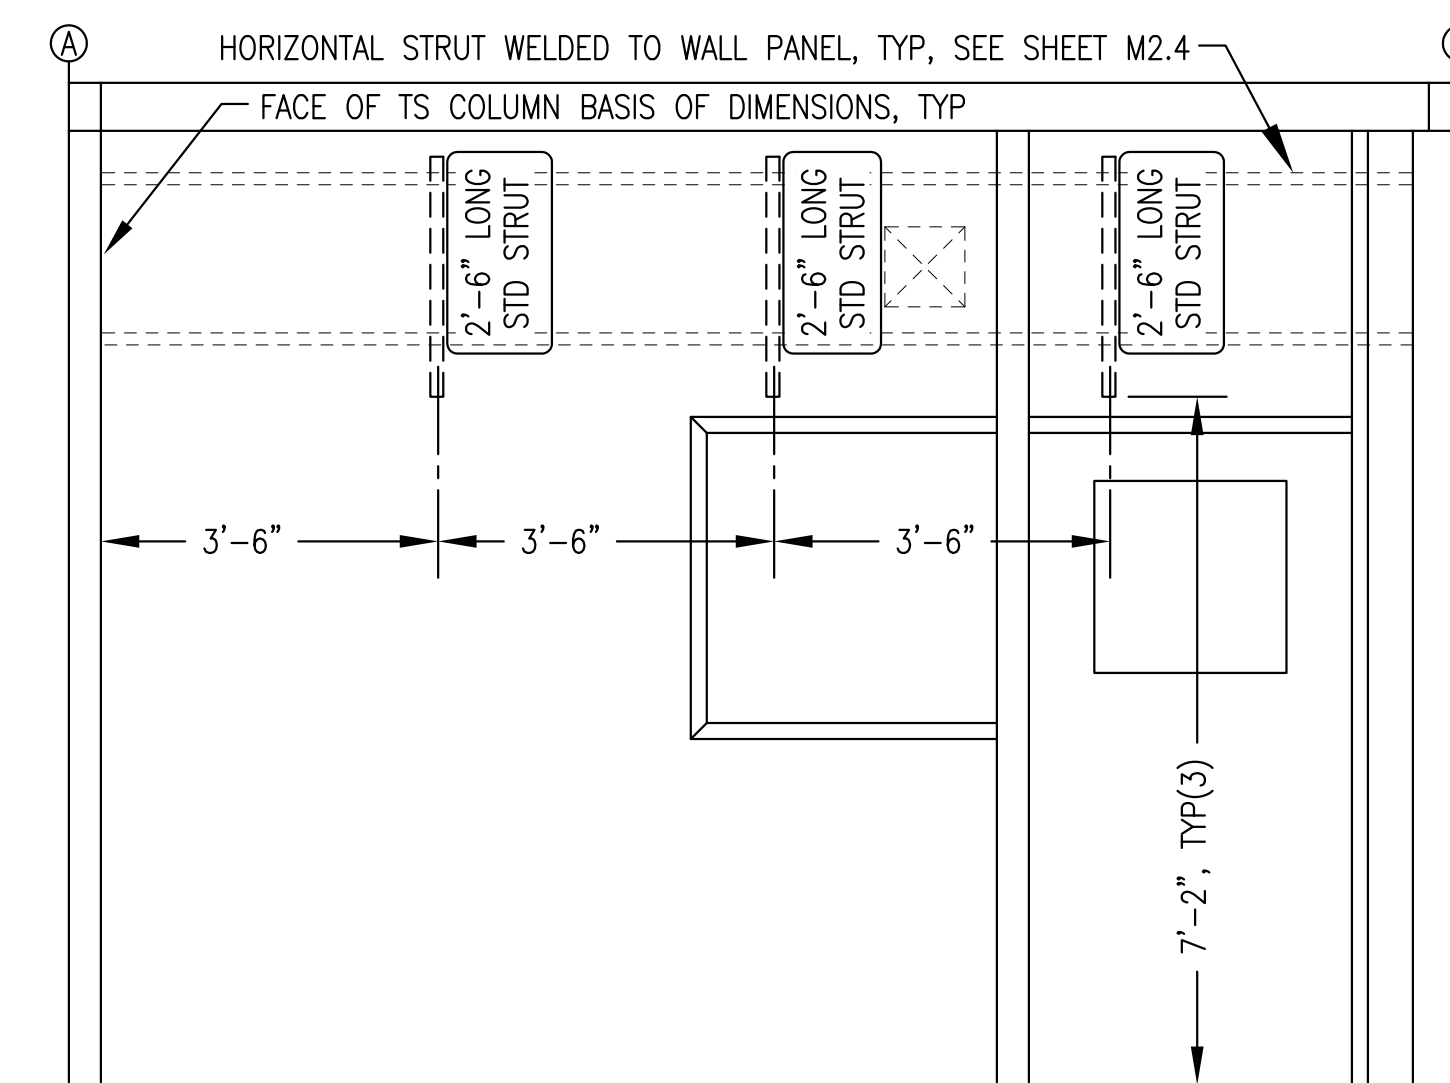

5 GEN BAY RIGHT WALL VERTICAL WALL STRUT LAYOUT
M2.5 1/2"=1'-0"

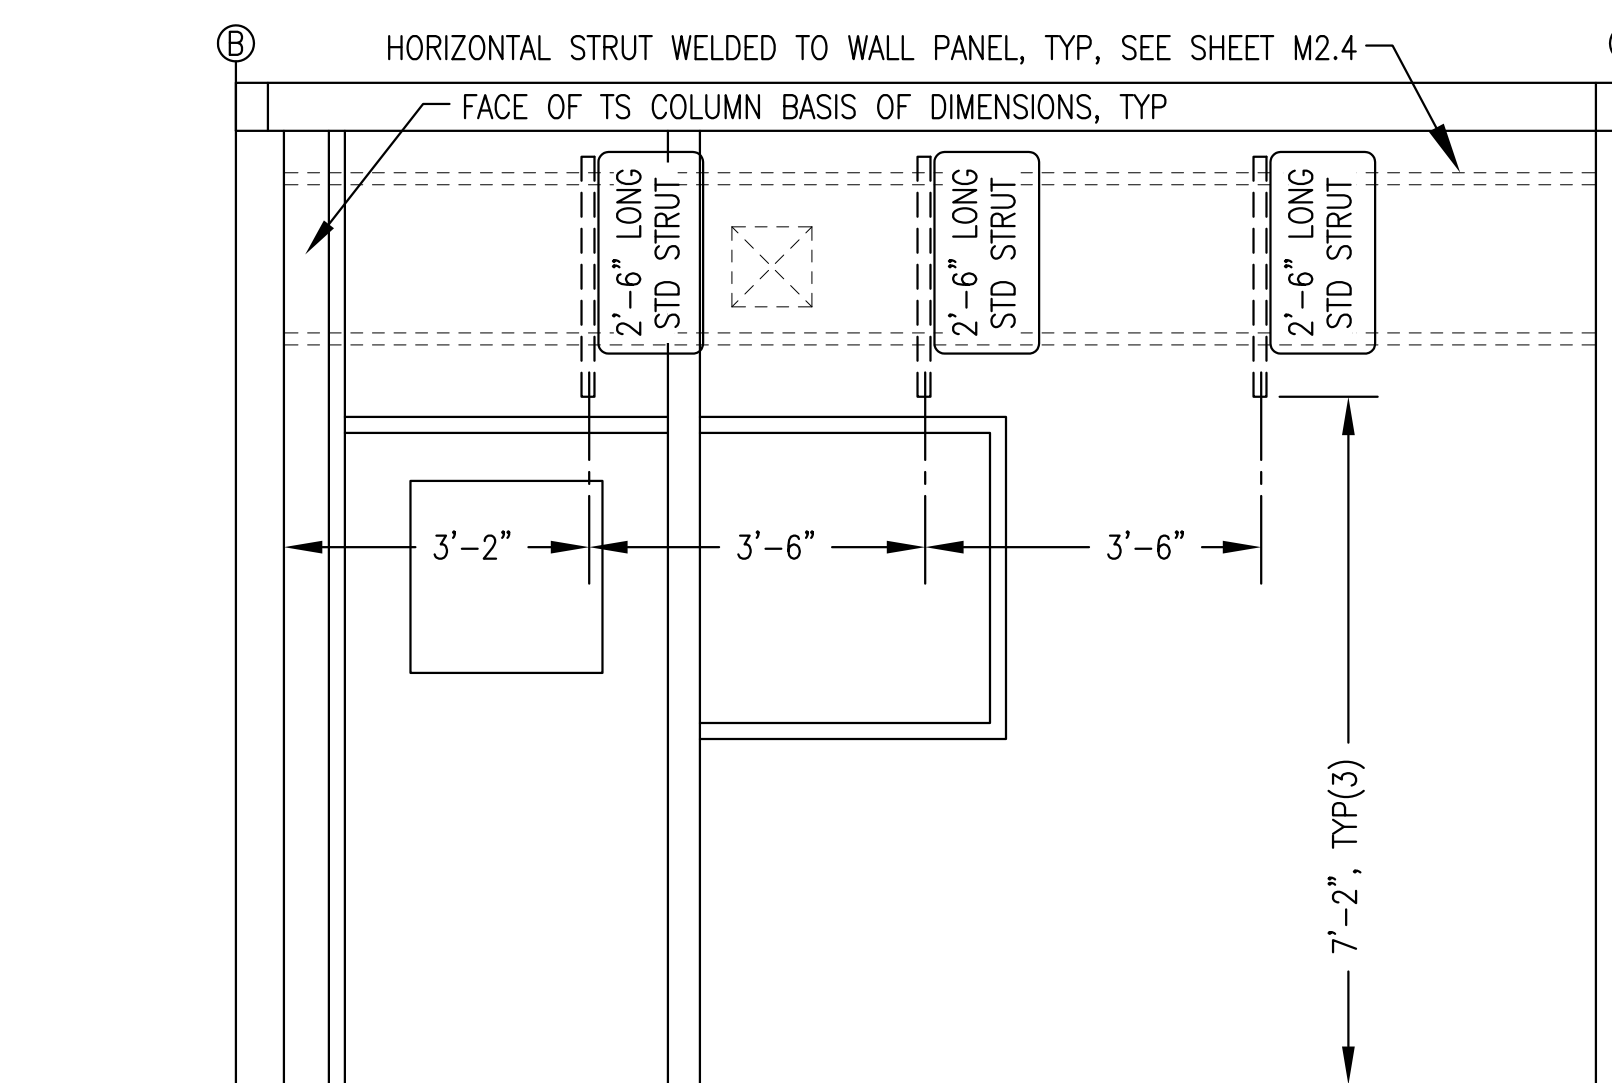

6 CONTROL ROOM LEFT WALL VERTICAL WALL STRUT LAYOUT
M2.5 1/2"=1'-0"

VERTICAL WALL STRUT INSTALLATION NOTES:

- 1) ALL HORIZONTAL LOCATIONS ARE CENTERLINE OF STRUT FROM FACE OF TS COLUMNS. ALL VERTICAL LOCATIONS ARE END OF STRUT ABOVE FINISHED FLOOR.
- 2) ALL STRUT SHALL BE 12 GAUGE, PRE-GALVANIZED FINISH WITH SLOTTED BACK.
"STD" DESIGNATES STANDARD 1-5/8" x 1-5/8" SINGLE STRUT, B-LINE B22-SH-GALV OR EQUAL.
"DEEP" DESIGNATES 3-1/4" x 1-5/8" SINGLE STRUT, B-LINE B11-SH-GALV OR EQUAL.
- 3) FASTEN ALL VERTICAL STRUT SECTIONS TO HORIZONTAL STRUT WITH 1/2"x1" ALLEN HEAD CAP SCREWS & STRUT NUTS.
- 4) ONLY MAJOR WALL MOUNTED EQUIPMENT SUPPORT STRUT SHOWN THIS SHEET. SEE MECHANICAL AND ELECTRICAL DRAWINGS FOR OTHER EQUIPMENT, PIPING, AND WIREWAY STRUT SUPPORT DETAILS.




Gray Stassel Engineering, Inc.
P.O. 111405
Anchorage, AK 99511
(907)949-0100

STATE OF ALASKA, AIDEA/AEA RURAL POWER SYSTEM UPGRADE
CLARKS POINT POWER PLANT
CLARKS POINT, ALASKA

CONSTRUCTION DOCUMENTS	
REVISIONS	DESCRIPTION
REV DATE	

VERIFY SCALES
0 1"
THIS BAR REPRESENTS ONE INCH ON ORIGINAL DRAWING

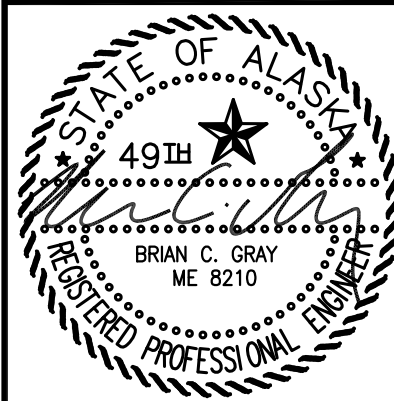


DATE: 1/14/19
DRAWN BY: JTD
CHECKED BY: BCG
JOB NUMBER:


DRAWING TITLE:
MECHANICAL SUPPORT VERTICAL WALL STRUT INSTALLATION

M2.5
SHEET OF 7


ISSUED FOR CONSTRUCTION JANUARY 2019

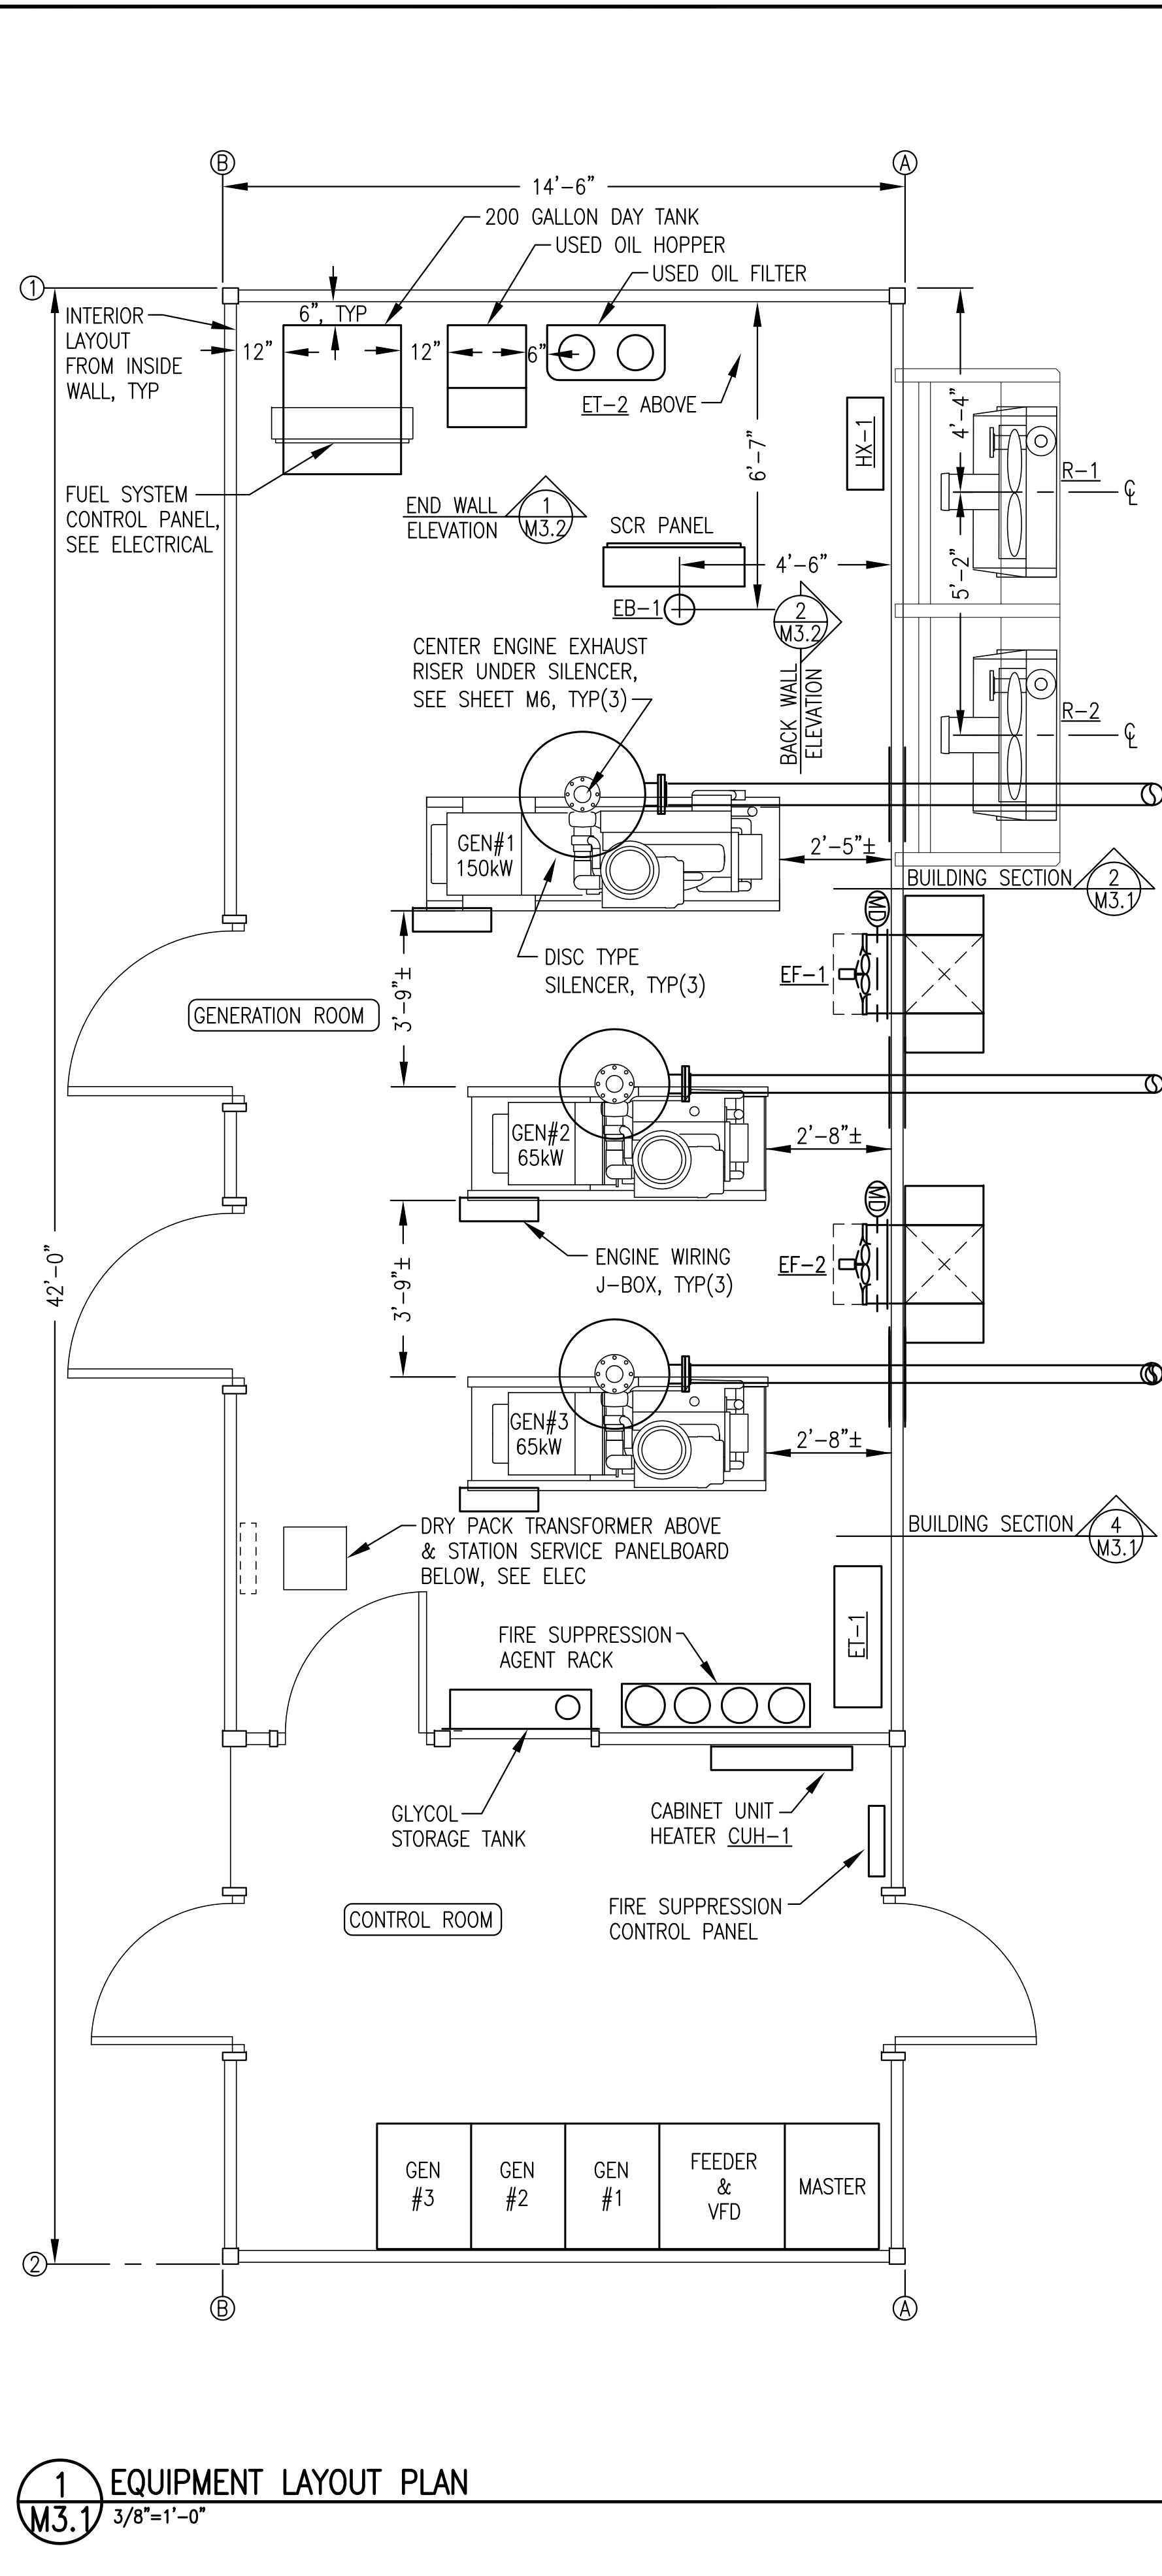


1 EQUIPMENT LAYOUT PLAN
M3.1 3/8"=1'-0"

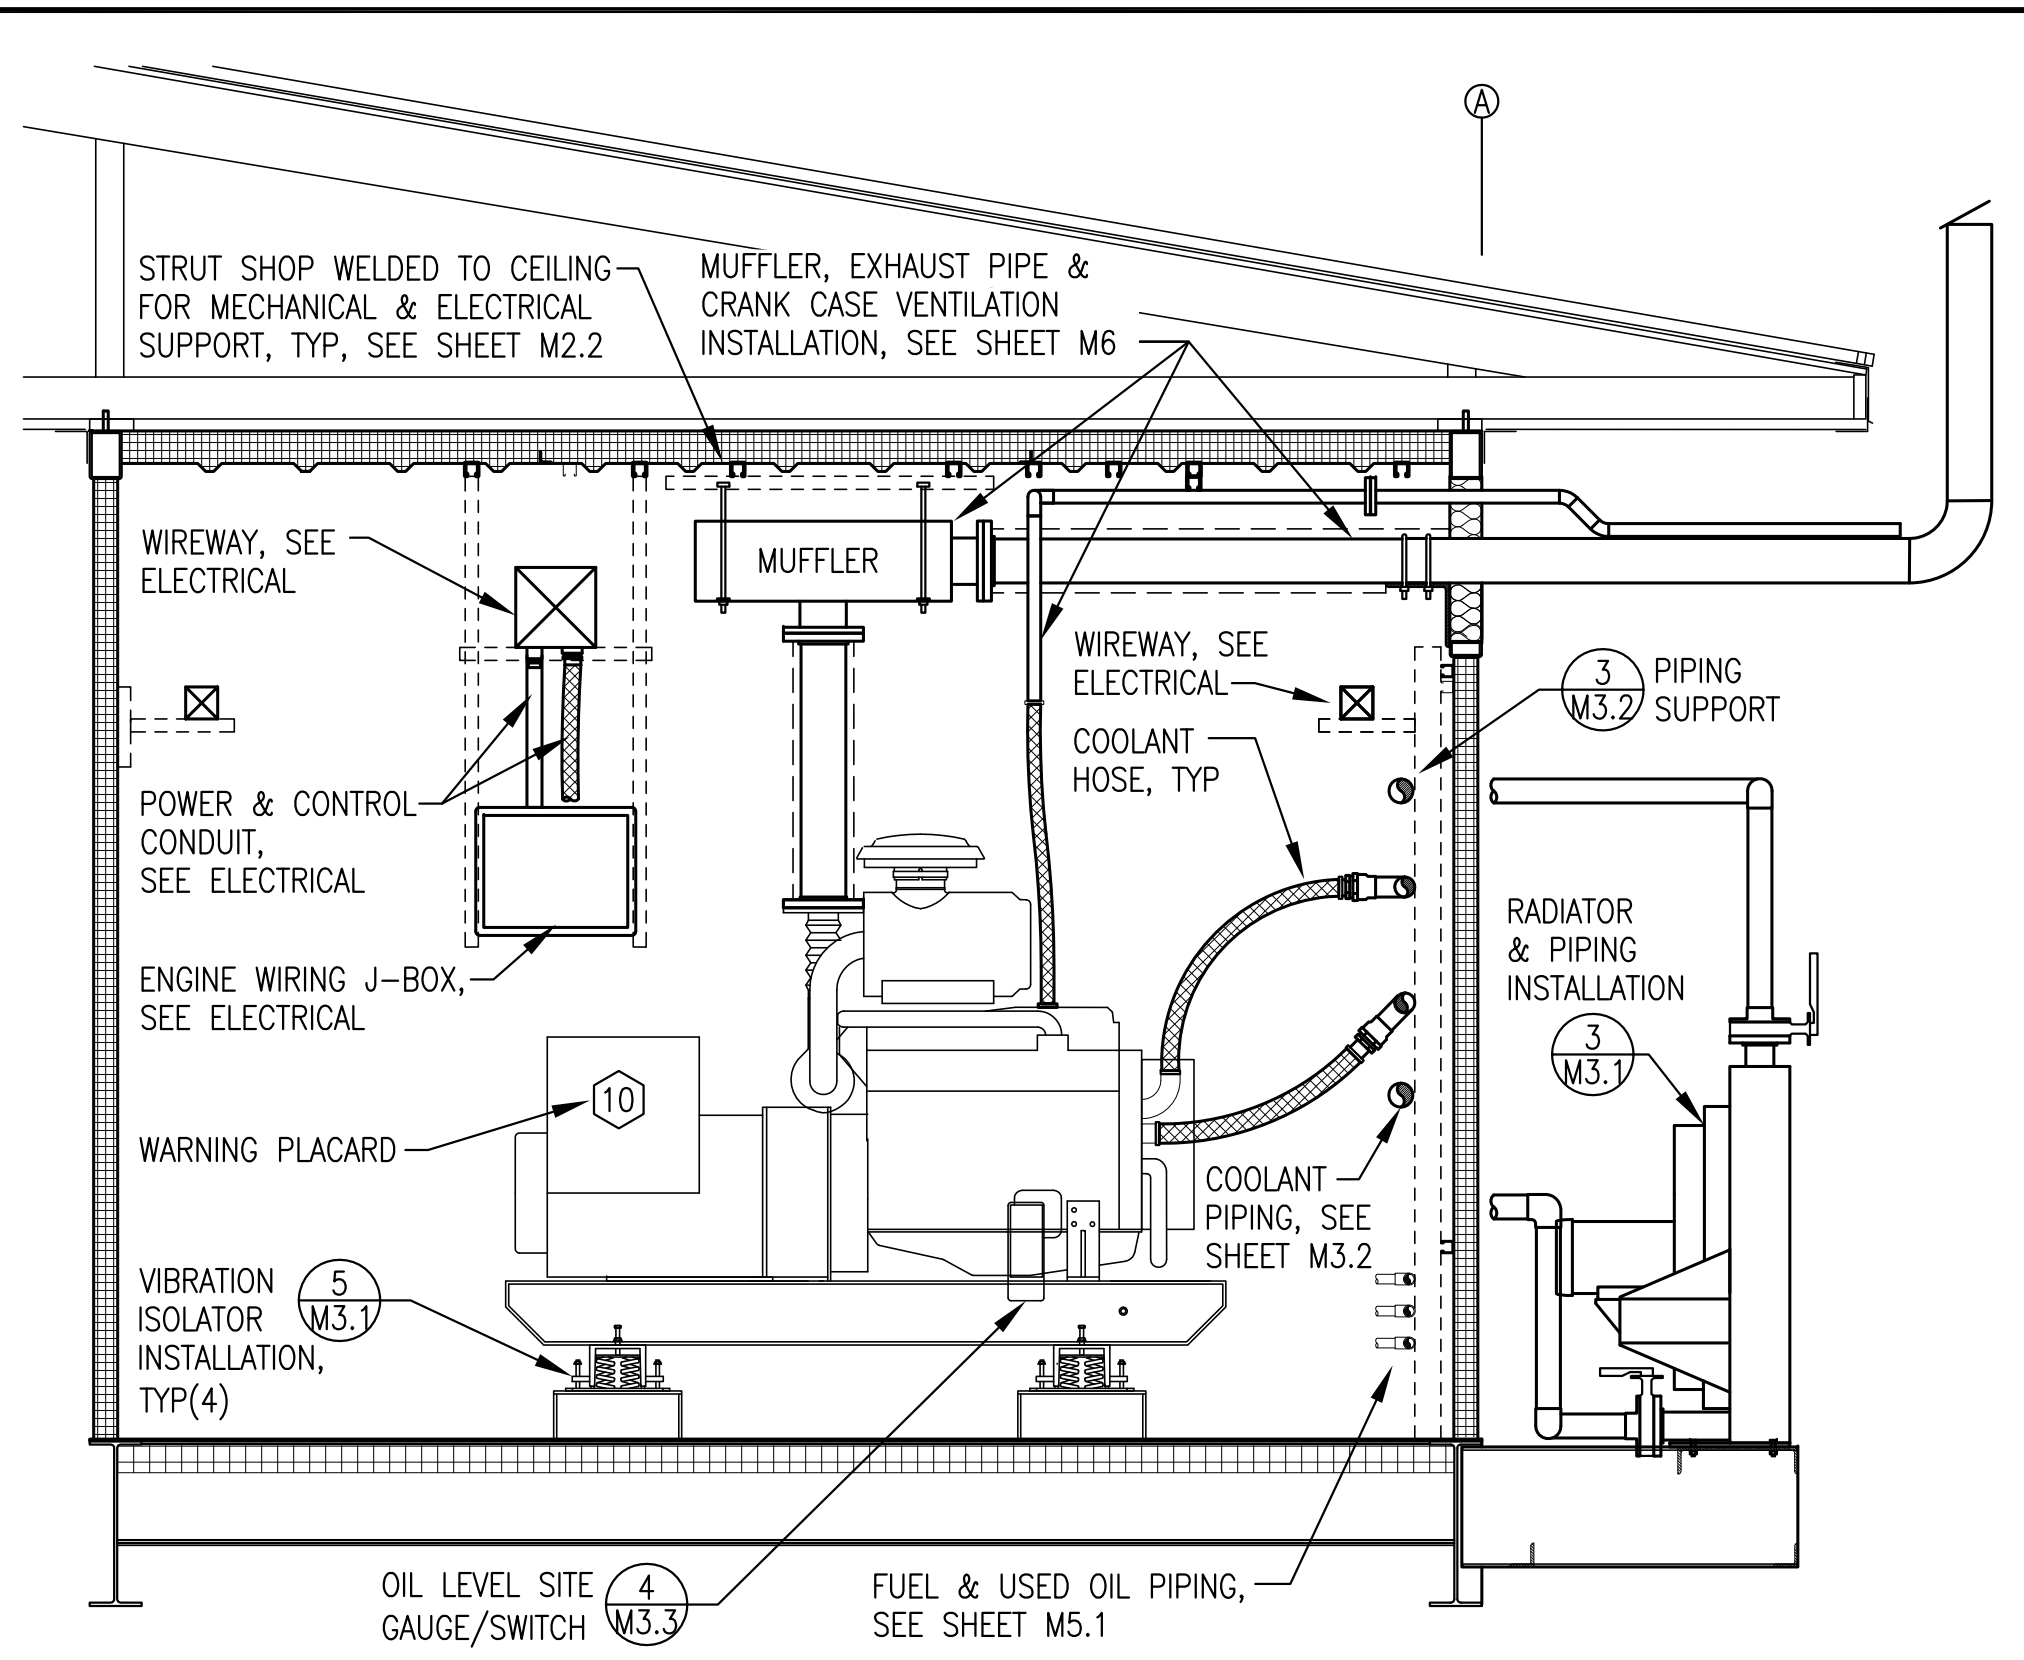


2 BUILDING SECTION/GENERATOR #1/#2 INSTALLATION
M3.1 1/2"=1'-0"

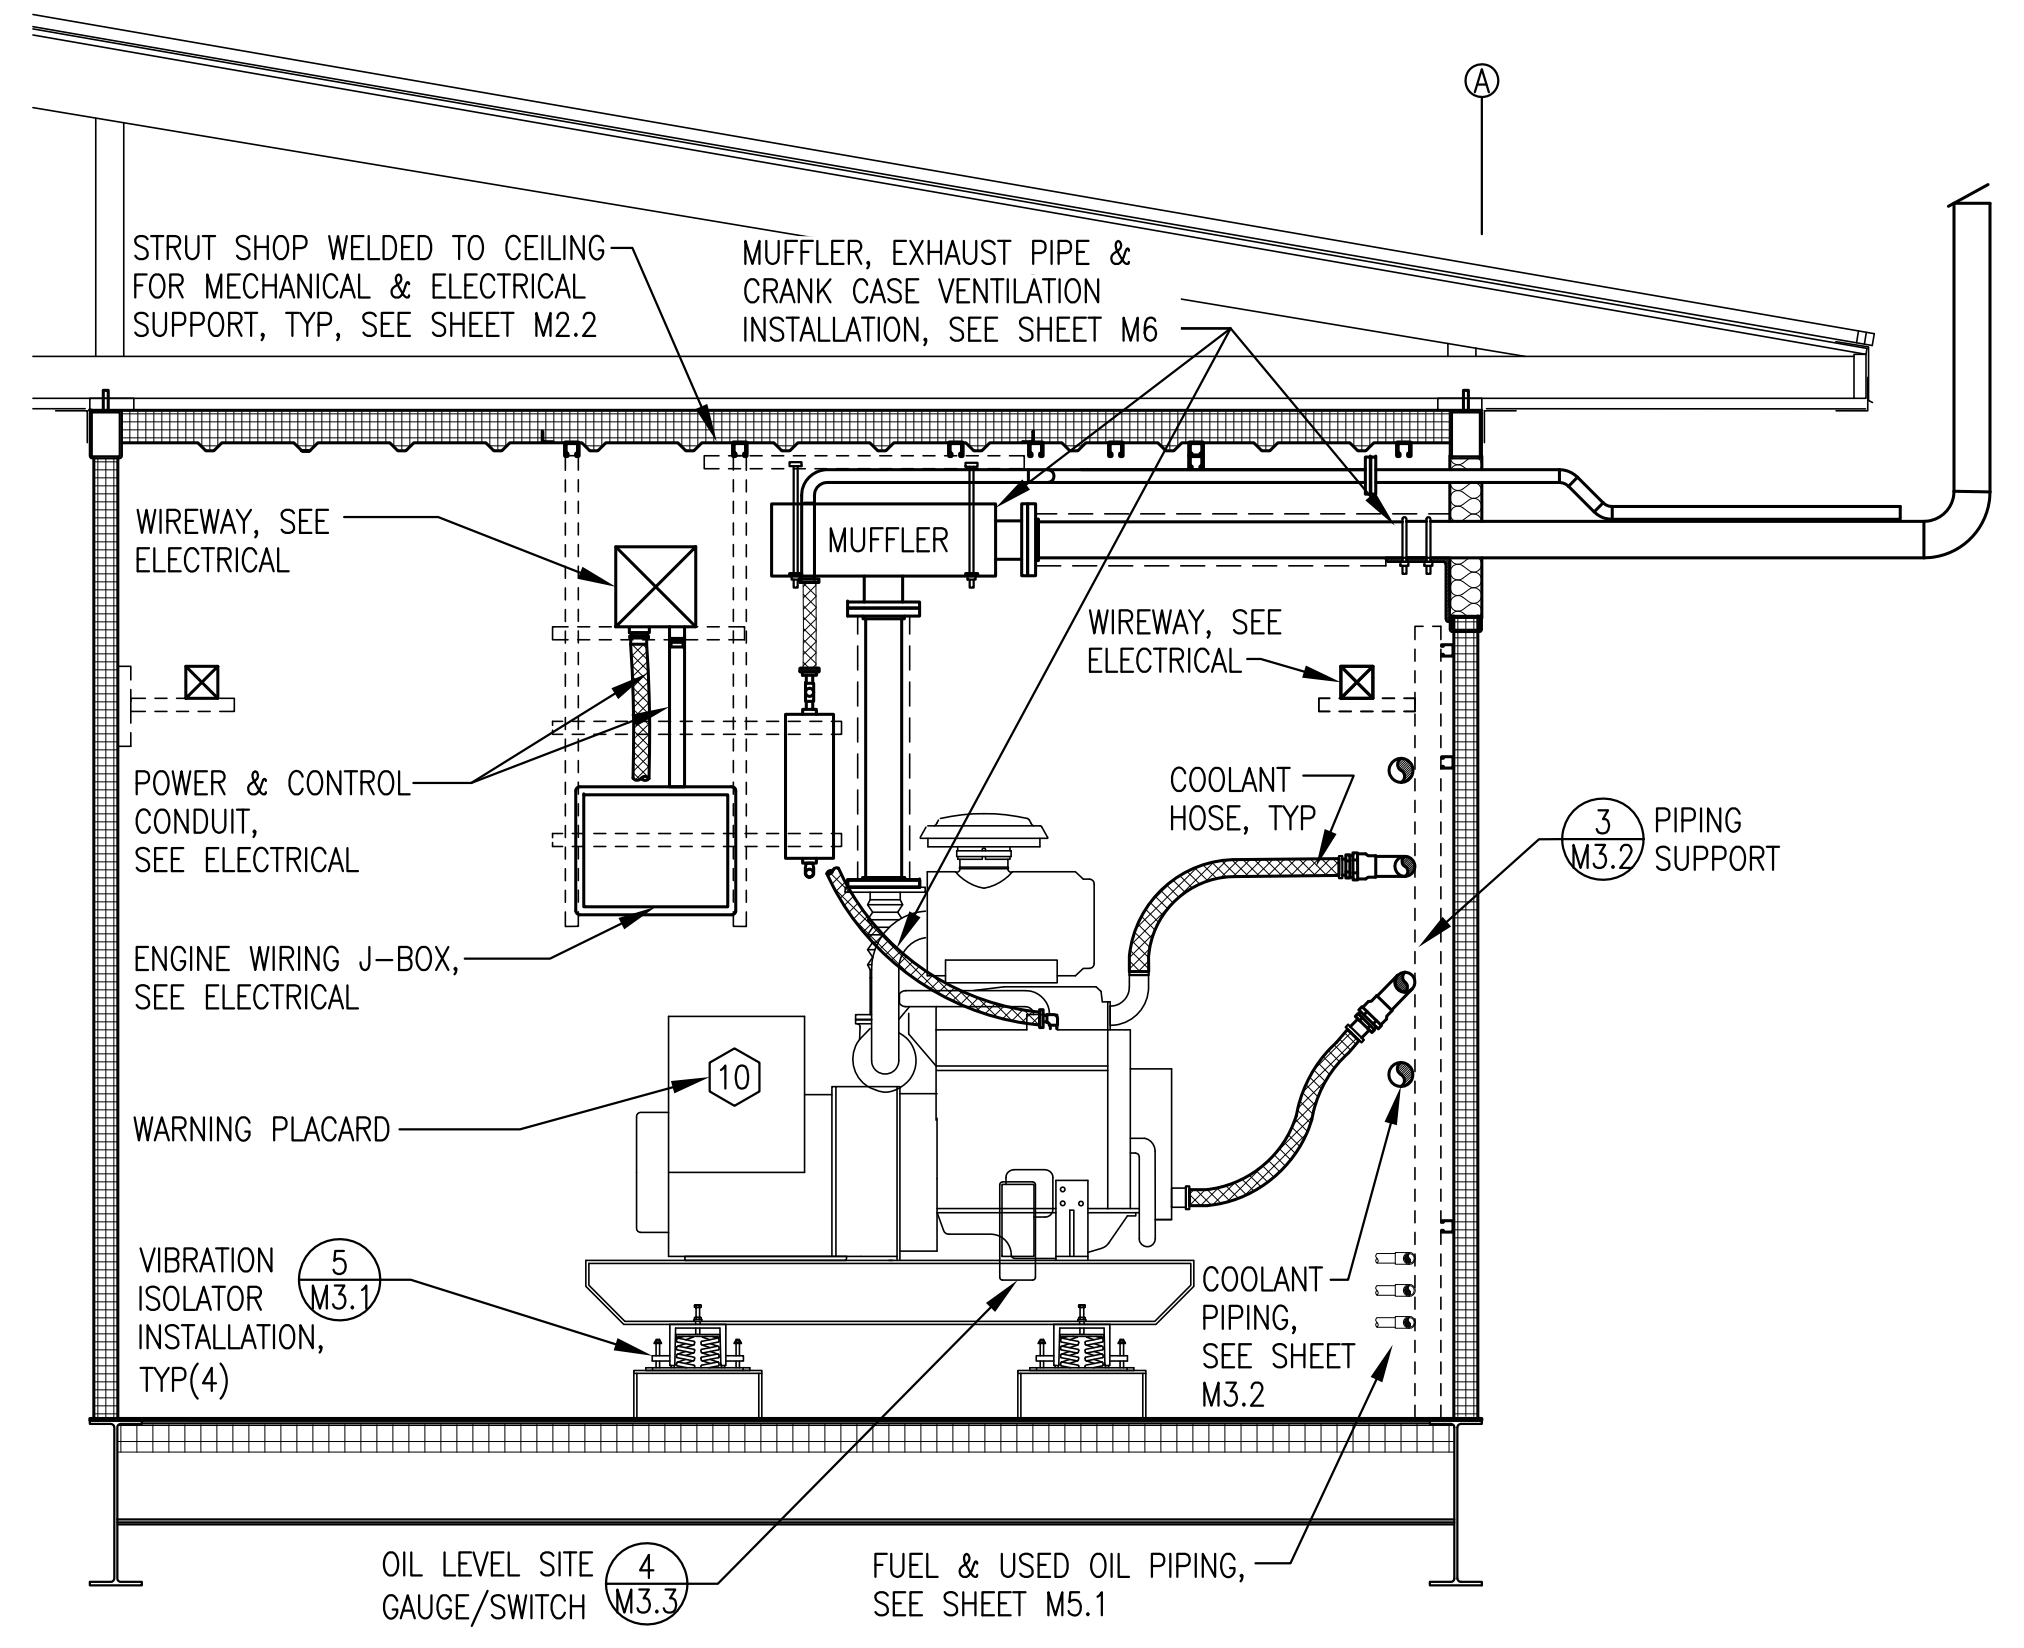

4 BUILDING SECTION/GENERATOR #3 INSTALLATION
M3.1 1/2"=1'-0"

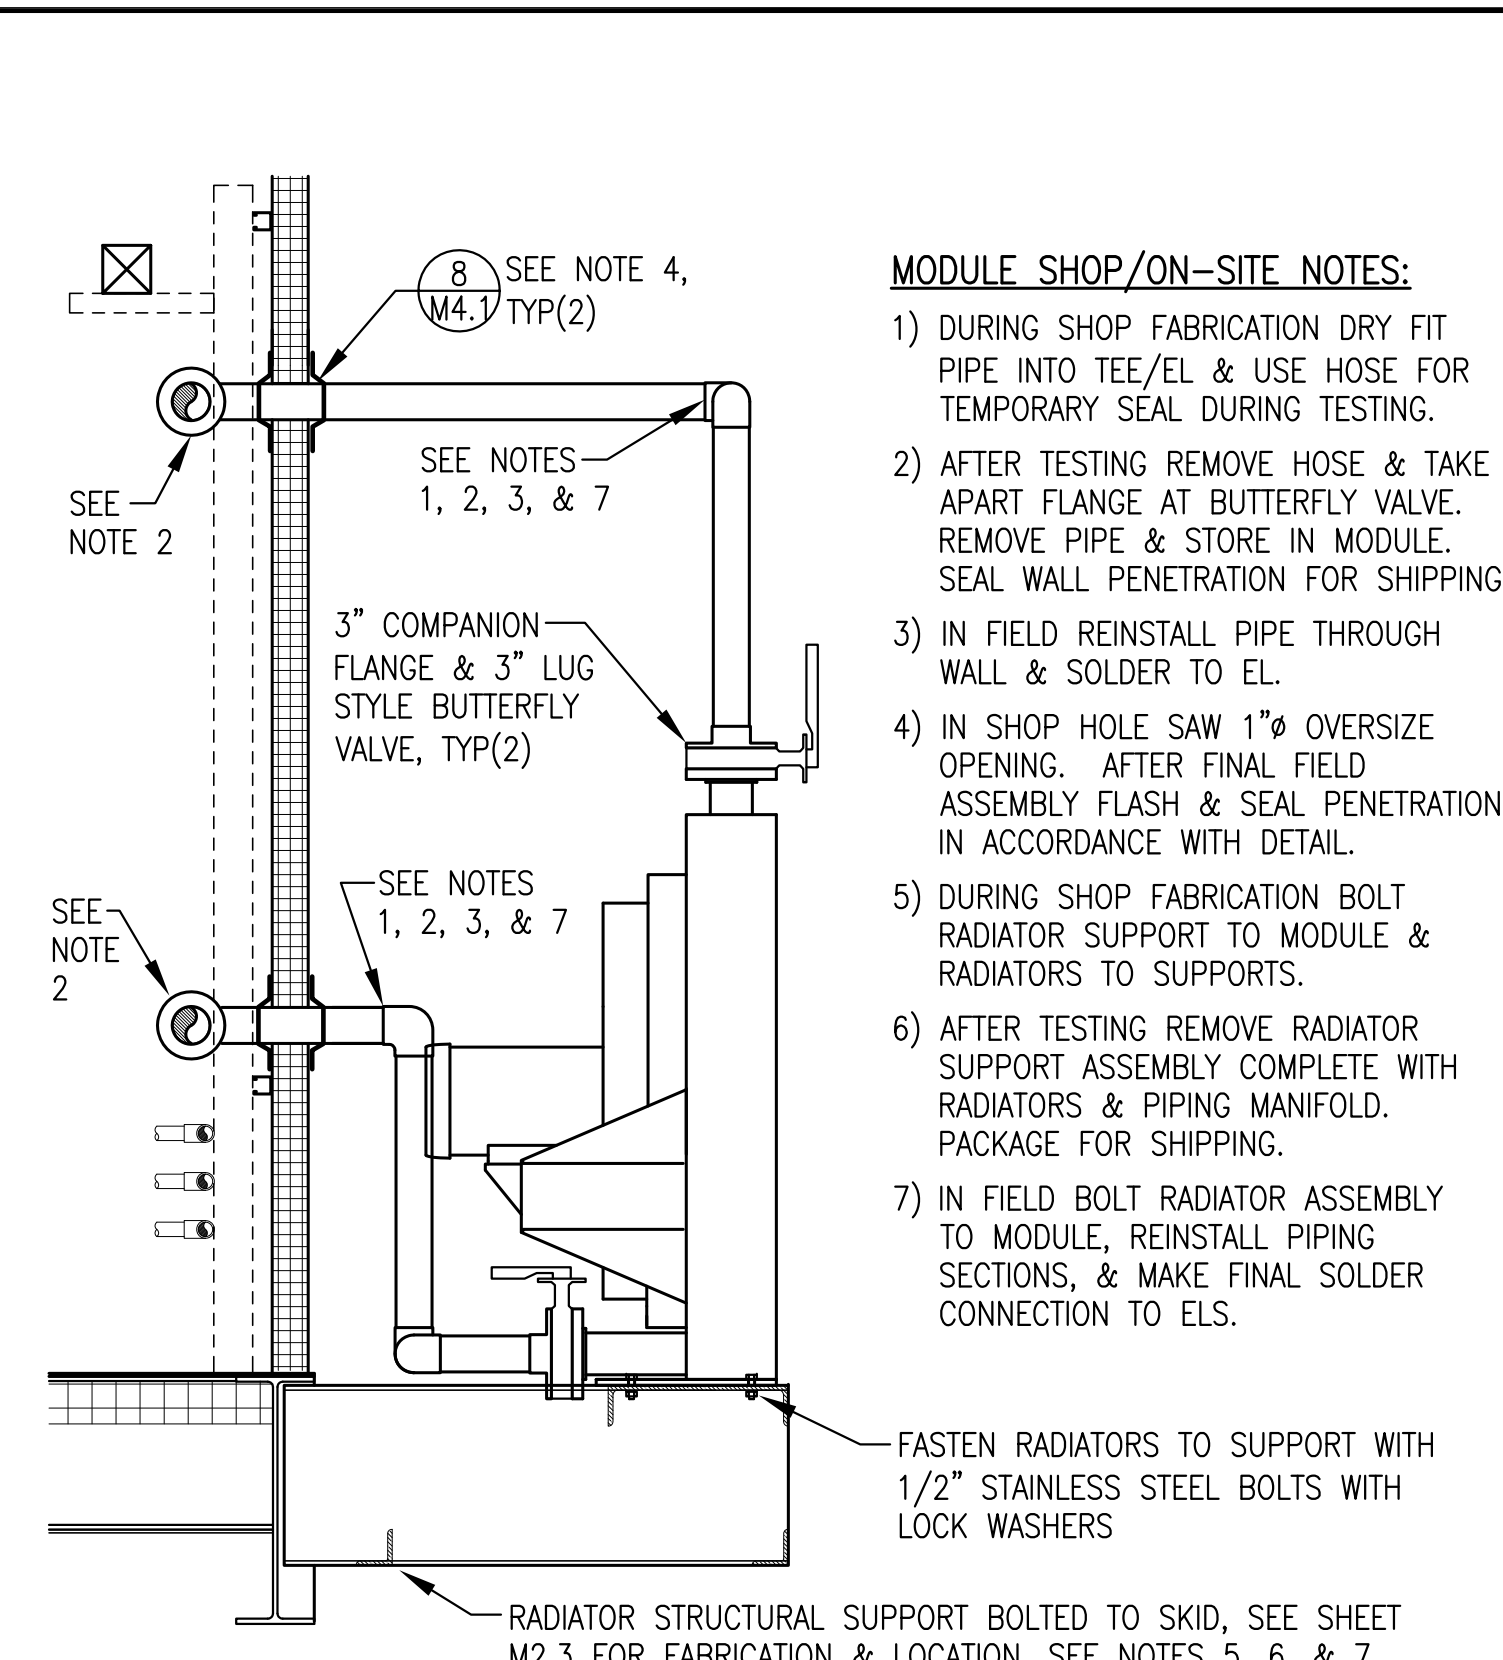

3 RADIATOR & PIPING INSTALLATION
M3.1 3/4"=1'-0"

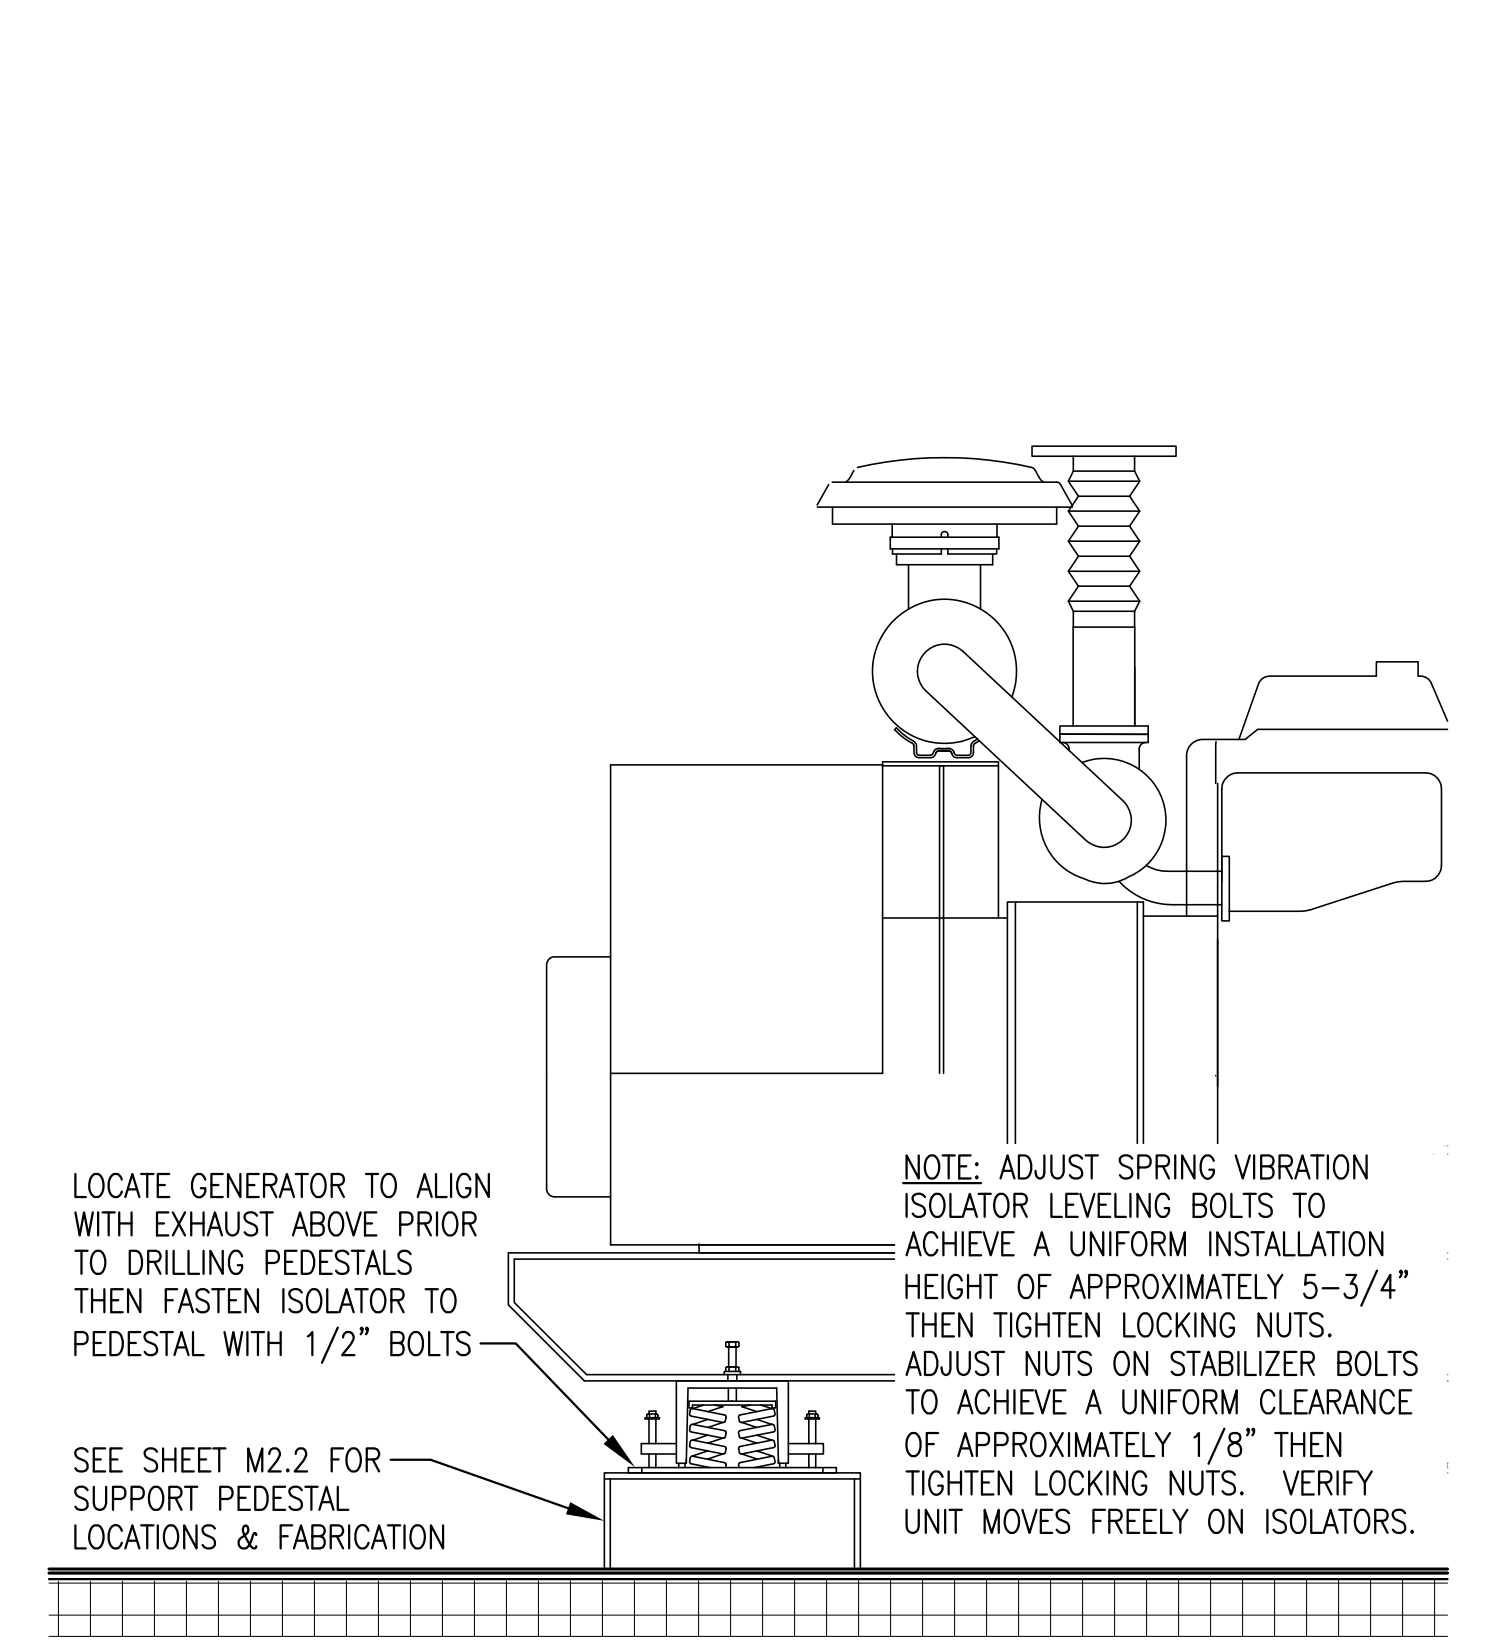

5 VIBRATION ISOATOR INSTALLATION
M3.1 1"=1'-0"

- MODULE SHOP/ON-SITE NOTES:**
- 1) DURING SHOP FABRICATION DRY FIT PIPE INTO TEE/EL & USE HOSE FOR TEMPORARY SEAL DURING TESTING.
 - 2) AFTER TESTING REMOVE HOSE & TAKE APART FLANGE AT BUTTERFLY VALVE. REMOVE PIPE & STORE IN MODULE. SEAL WALL PENETRATION FOR SHIPPING.
 - 3) IN FIELD REINSTALL PIPE THROUGH WALL & SOLDER TO EL.
 - 4) IN SHOP HOLE SAW 1" OVERSIZE OPENING. AFTER FINAL FIELD ASSEMBLY FLASH & SEAL PENETRATION IN ACCORDANCE WITH DETAIL.
 - 5) DURING SHOP FABRICATION BOLT RADIATOR SUPPORT TO MODULE & RADIATORS TO SUPPORTS.
 - 6) AFTER TESTING REMOVE RADIATOR SUPPORT ASSEMBLY COMPLETE WITH RADIATORS & PIPING MANIFOLD. PACKAGE FOR SHIPPING.
 - 7) IN FIELD BOLT RADIATOR ASSEMBLY TO MODULE, REINSTALL PIPING SECTIONS, & MAKE FINAL SOLDER CONNECTION TO ELS.




Gray Stassel Engineering, Inc.
P.O. 111405
Anchorage, AK 99511
(907)949-0100

STATE OF ALASKA, AIDEA/AEA RURAL POWER SYSTEM UPGRADE
CLARKS POINT POWER PLANT
CLARKS POINT, ALASKA

CONSTRUCTION DOCUMENTS	
REVISIONS	DESCRIPTION
REV DATE	

VERIFY SCALES
0 1"
THIS BAR REPRESENTS ONE INCH ON ORIGINAL DRAWING

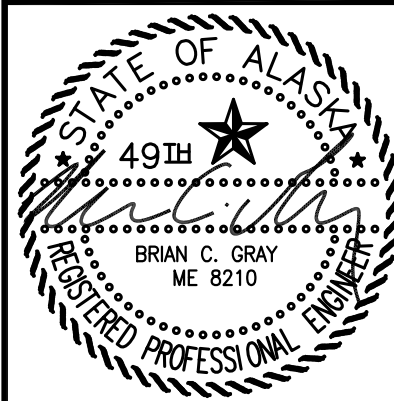


DATE: 1/14/19
DRAWN BY: JTD
CHECKED BY: BCG
JOB NUMBER:

DRAWING TITLE:
EQUIPMENT LAYOUT PLAN, SECTIONS, & DETAILS



M3.1
SHEET OF 7

ISSUED FOR CONSTRUCTION JANUARY 2019

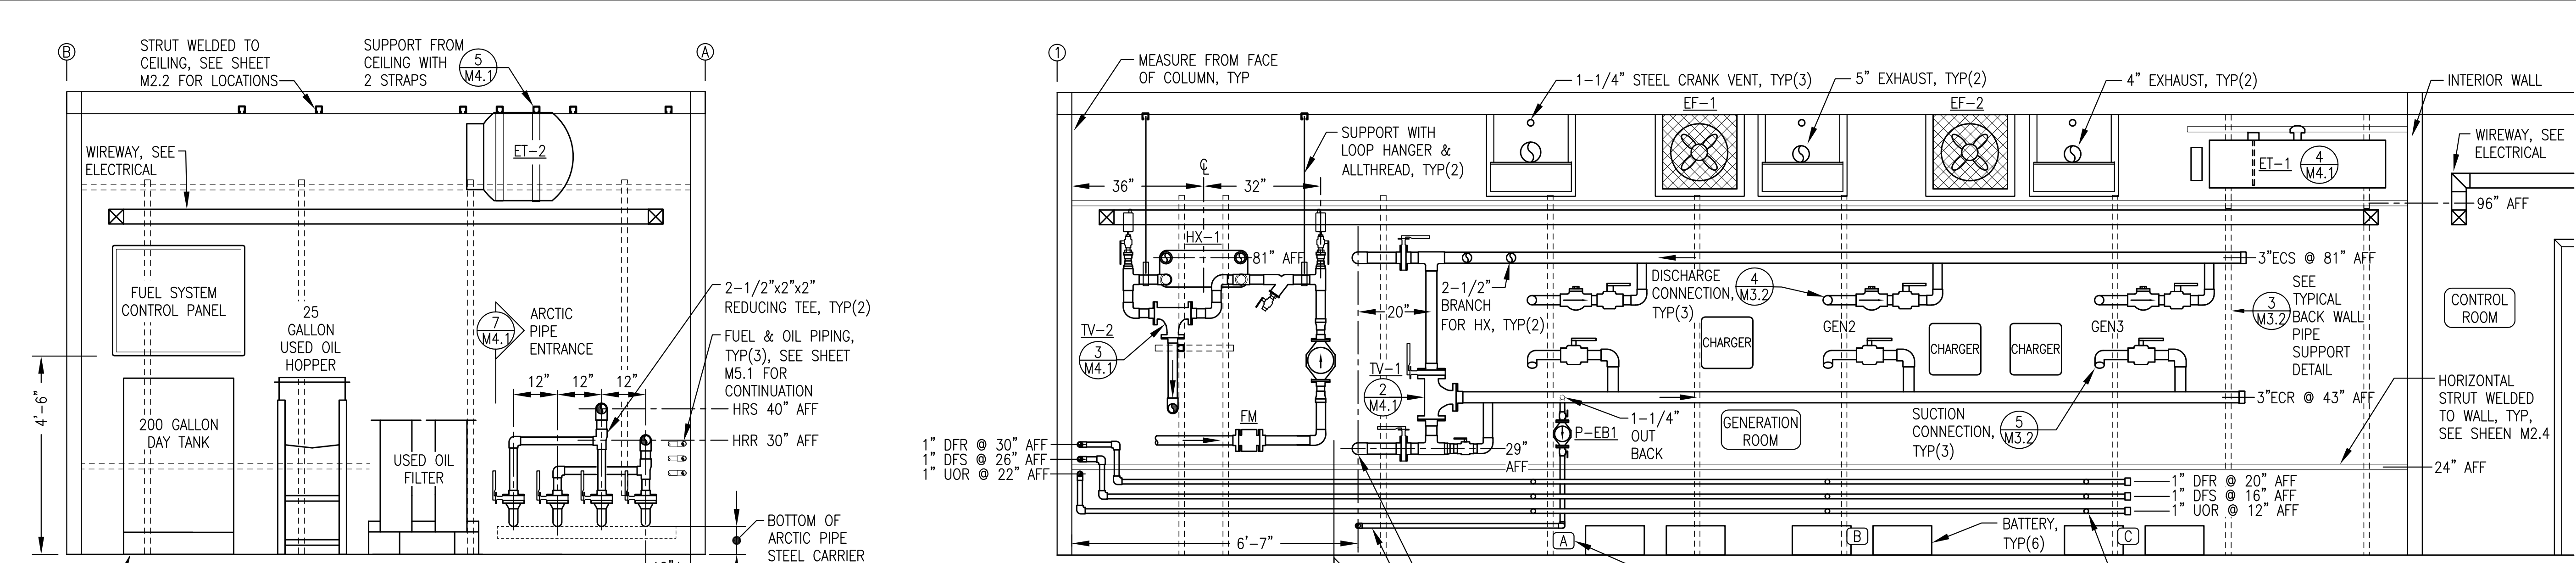

NOTES:
 1) SEE HEAT RECOVERY PIPING ISOMETRIC 2/M4.2 FOR ADDITIONAL DETAILS.
 2) SEE FUEL SYSTEM PLAN & ELEVATIONS SHEET M5.1 FOR ADDITIONAL DETAILS.

NOTES:
 1) SEE COOLING SYSTEM PIPING ISOMETRIC 1/M4.2 AND HEAT RECOVERY PIPING ISOMETRIC 2/M4.2 FOR ADDITIONAL DETAILS.

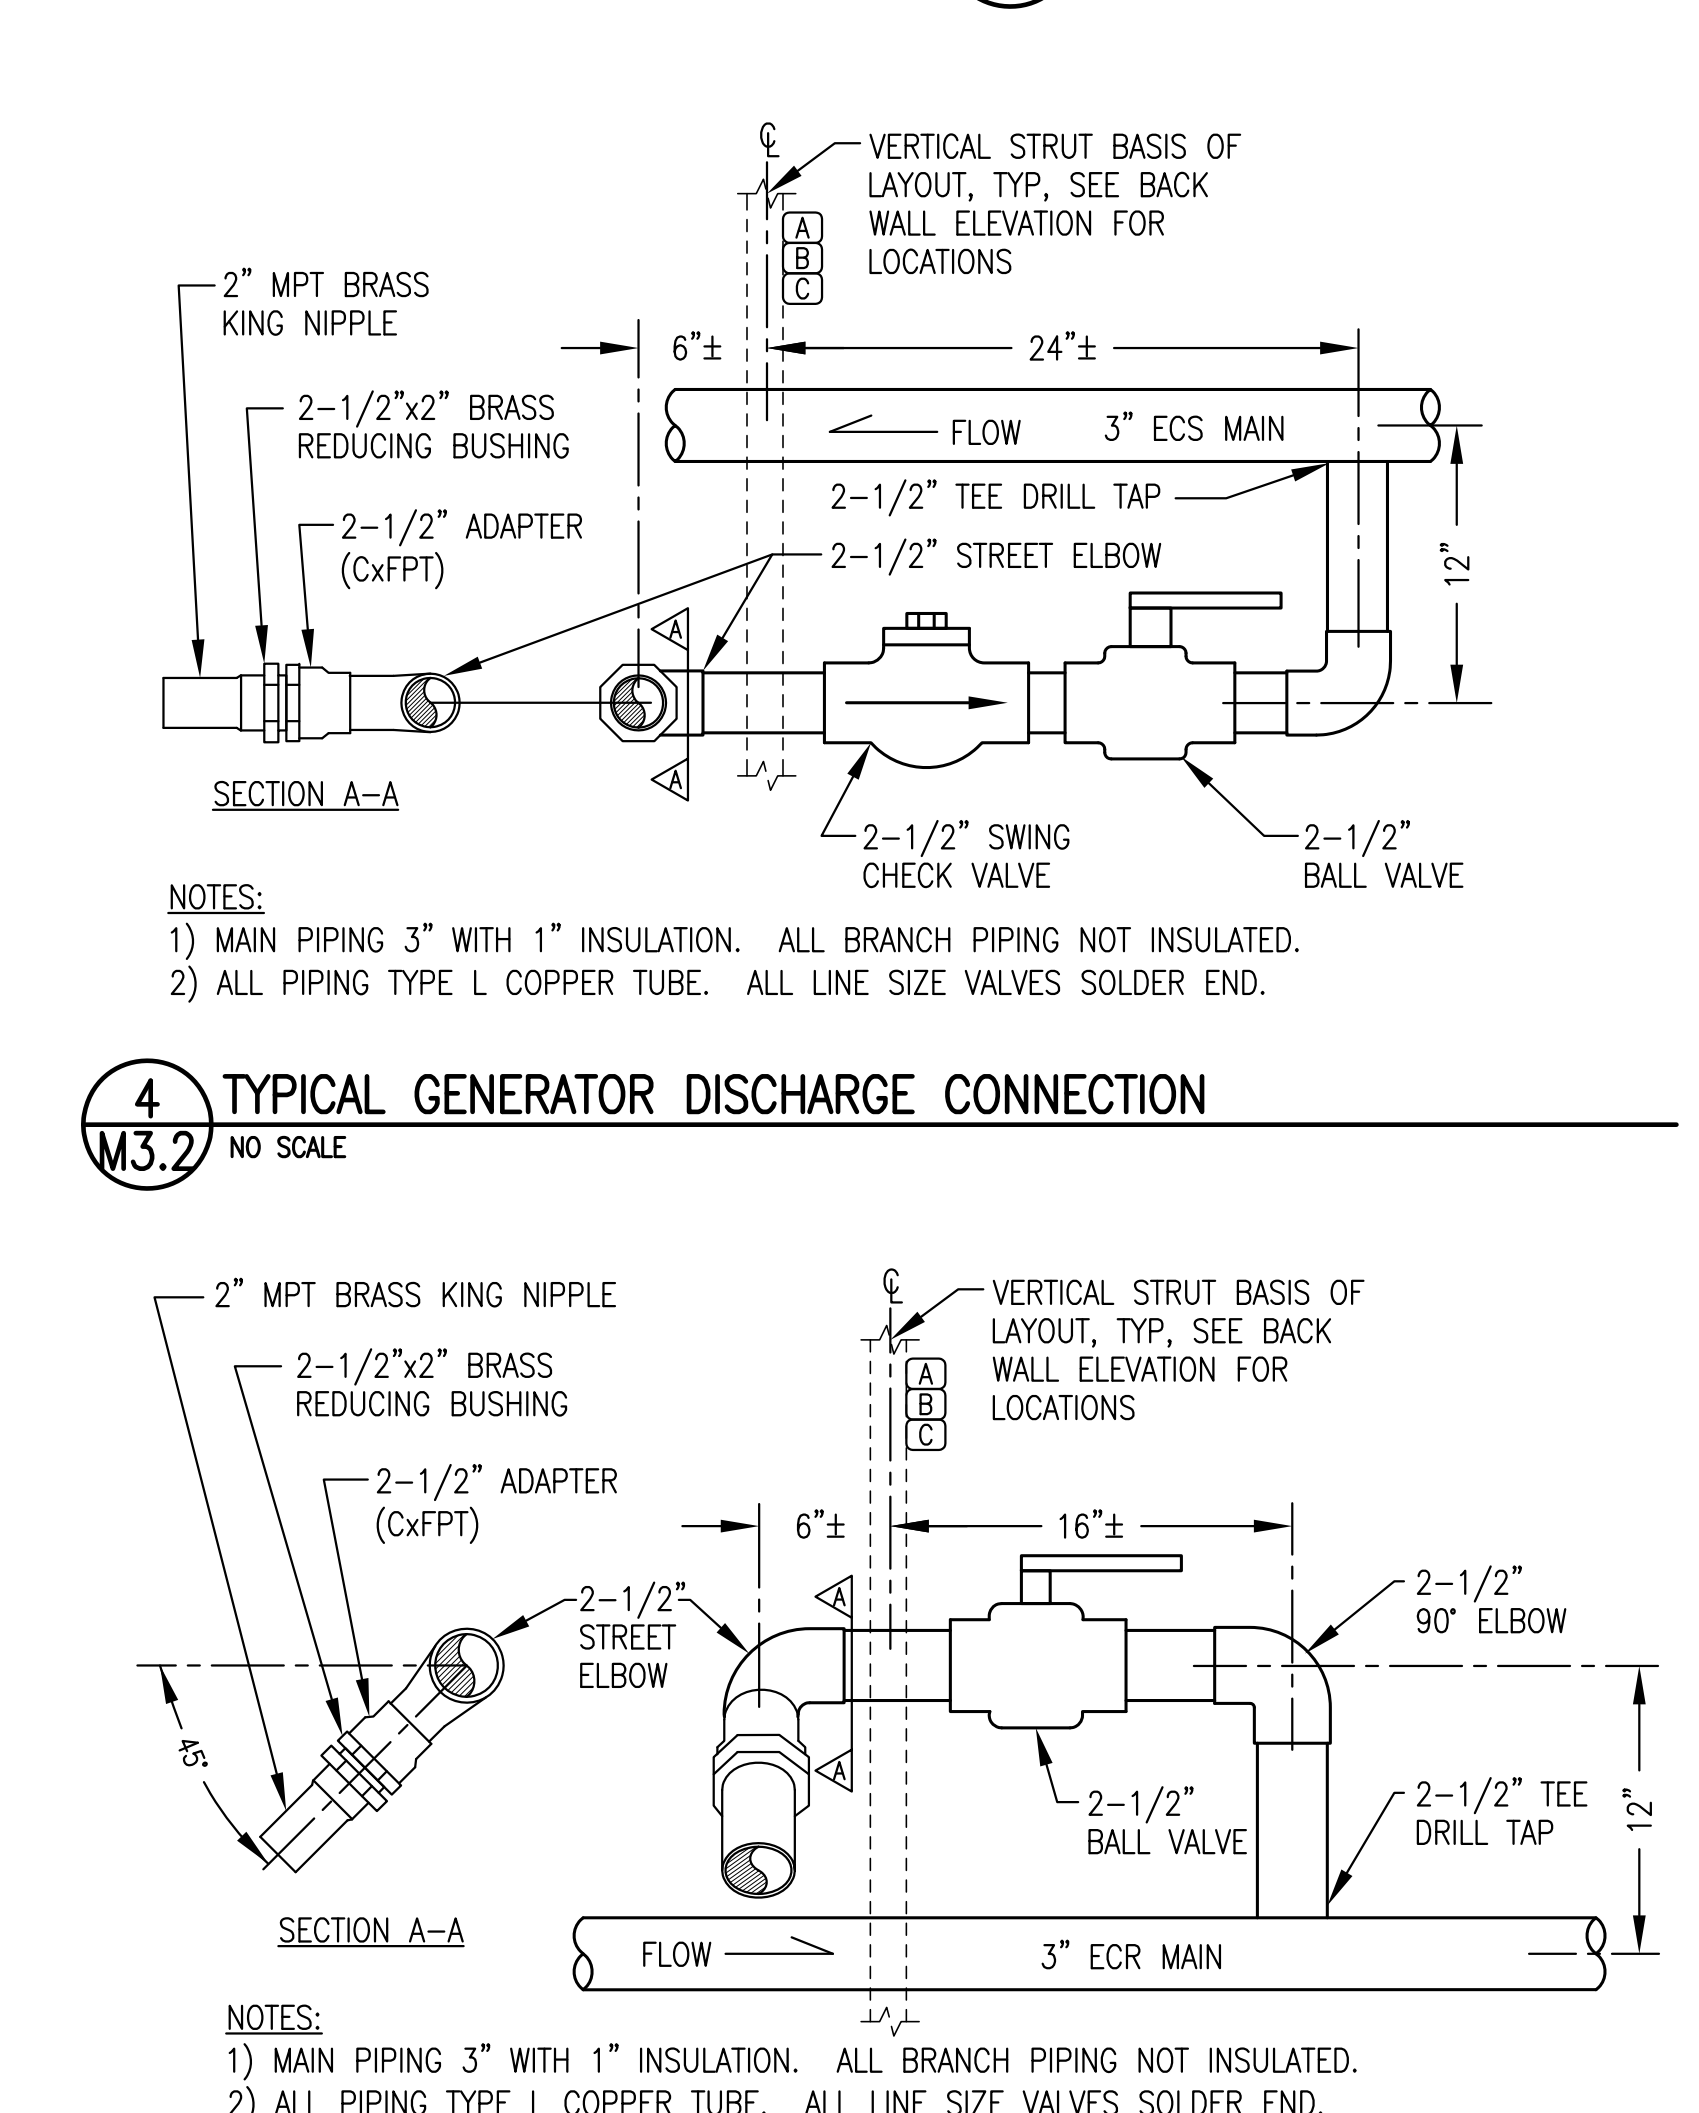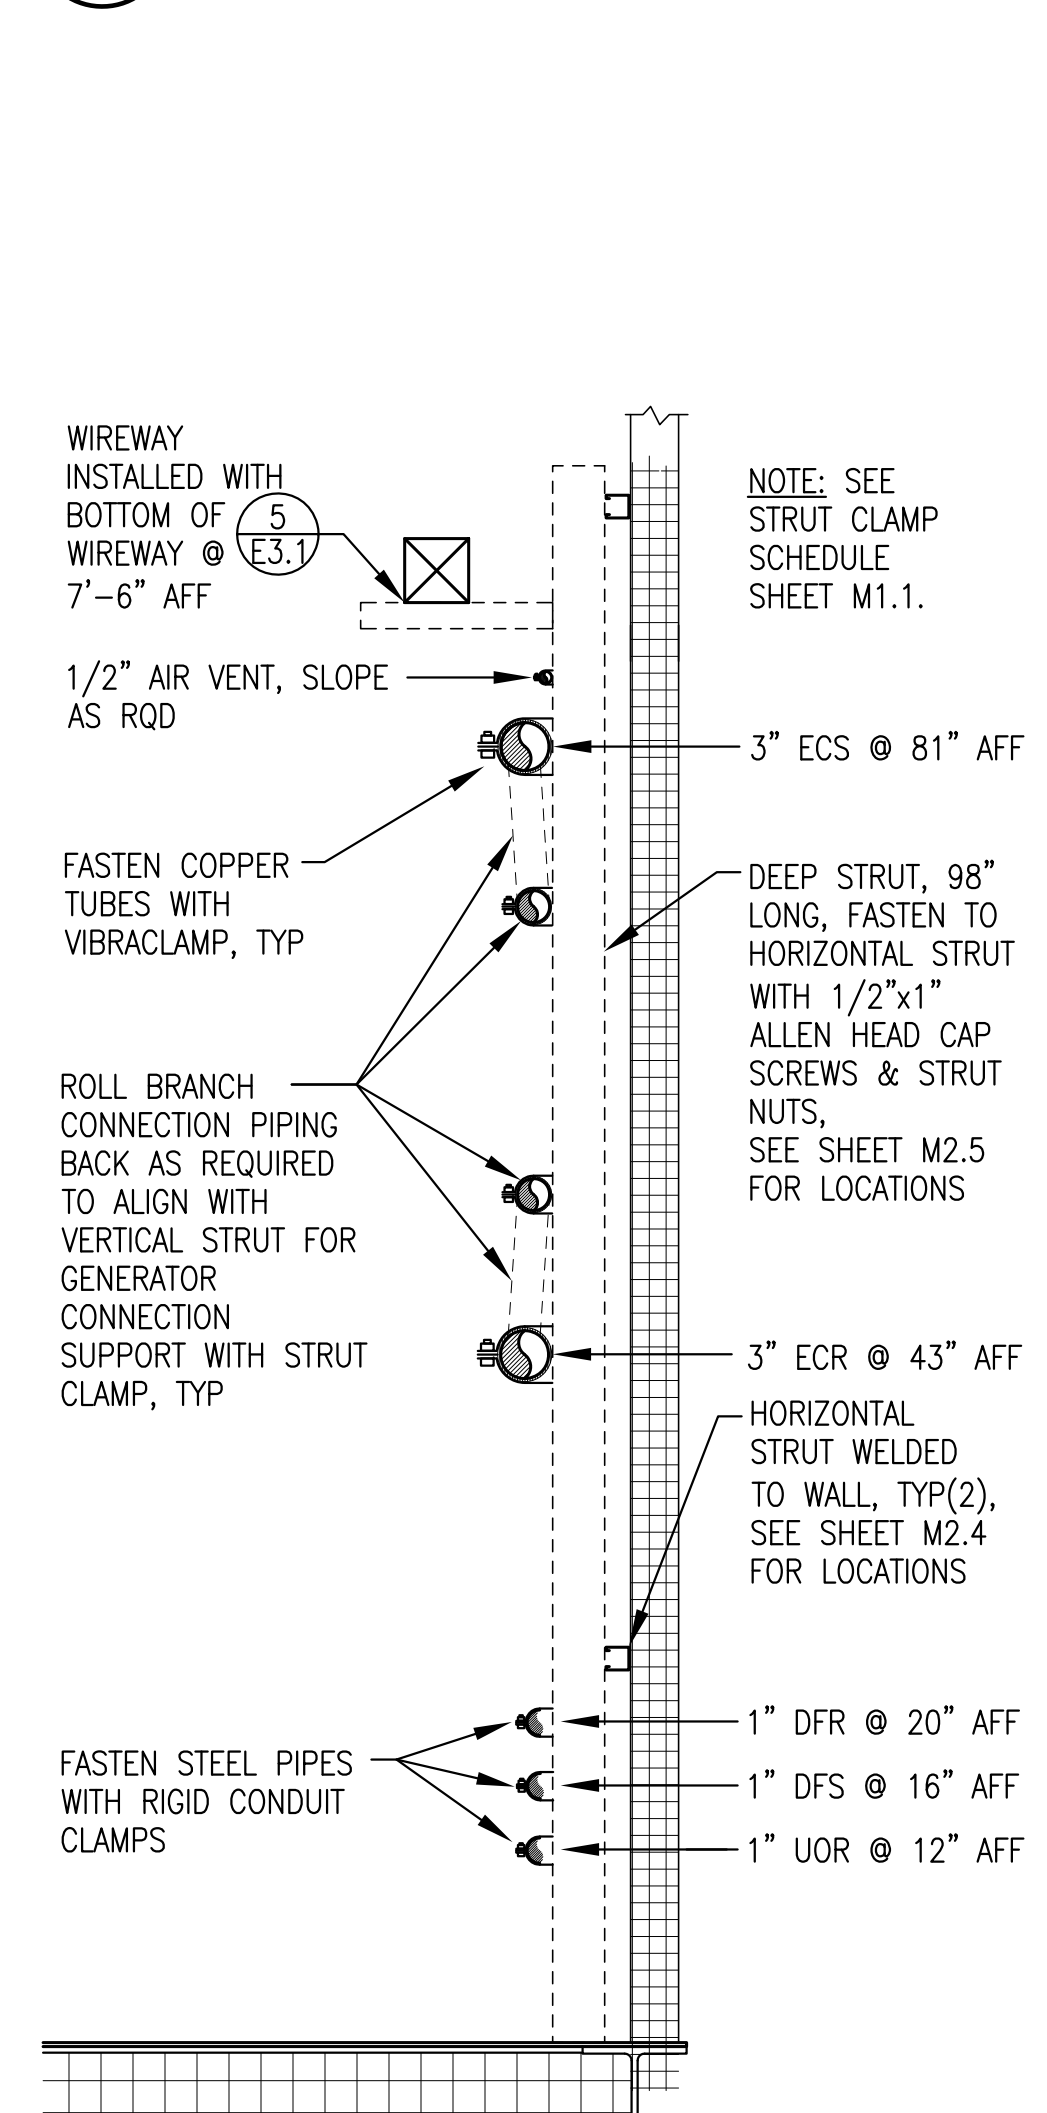

NOTES:
 1) MAIN PIPING 3" WITH 1" INSULATION. ALL BRANCH PIPING NOT INSULATED.
 2) ALL PIPING TYPE L COPPER TUBE. ALL LINE SIZE VALVES SOLDER END.

NOTES:
 1) MAIN PIPING 3" WITH 1" INSULATION. ALL BRANCH PIPING NOT INSULATED.
 2) ALL PIPING TYPE L COPPER TUBE. ALL LINE SIZE VALVES SOLDER END.

U M I A Q
6700 Arctic Spur Road
Anchorage, AK 99518
(907) 877-8220

Gray Stassel Engineering, Inc.
P.O. 111405
Anchorage, AK 99511
(907) 949-0100

STATE OF ALASKA, AIDEA/AEA RURAL POWER SYSTEM UPGRADE

CLARKS POINT POWER PLANT
CLARKS POINT, ALASKA

REVISIONS	REV DATE	DESCRIPTION

VERIFY SCALES
0 1"
THIS BAR REPRESENTS ONE INCH ON ORIGINAL DRAWING

STATE OF ALASKA
49th
BRAND C. GRAY
REGISTERED PROFESSIONAL ENGINEER
ME 8210


DATE: 1/14/19
DRAWN BY: JTD
CHECKED BY: BCG
JOB NUMBER:

DRAWING TITLE:
WALL ELEVATIONS & PIPING DETAILS


M3.2

SHEET OF 7

ISSUED FOR CONSTRUCTION JANUARY 2019

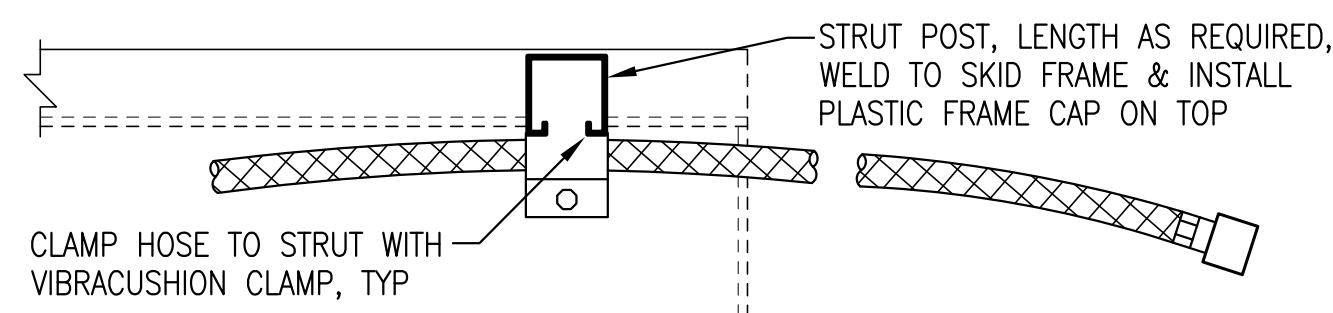

LEFT SKID PLAN (TOP) VIEW

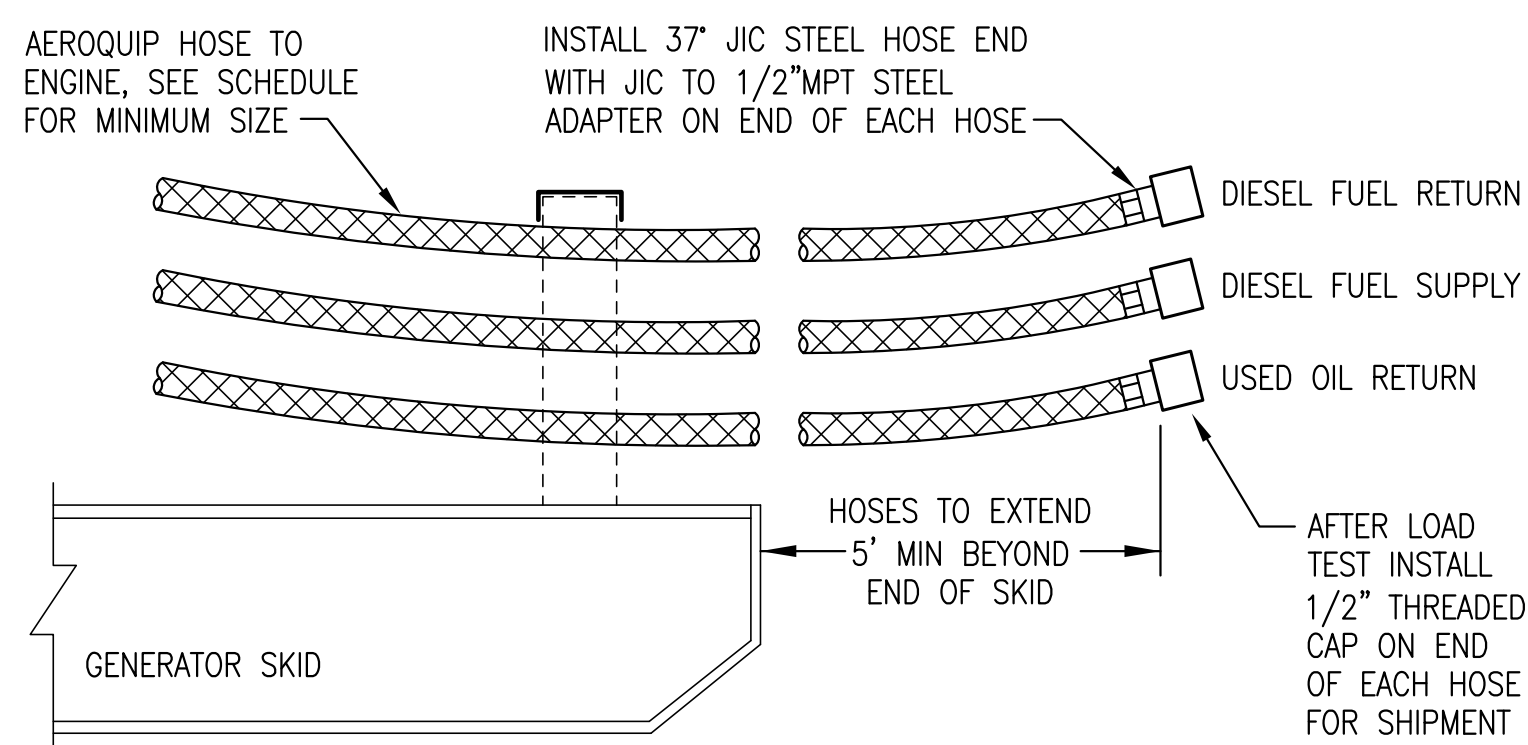


ELEVATION (SIDE) VIEW

MINIMUM HOSE SIZE SCHEDULE

FUEL SUPPLY	FUEL RETURN	USED OIL
#8	#8	#10

NOTE:
ON 4045 GROUP HOSES ON LEFT SKID AND ON 6081 GROUP HOSES ON RIGHT SKID AS SHOWN TO COORDINATE WITH COOLANT HOSES.


1 FUEL & OIL HOSE TERMINATIONS
M3.3 NO SCALE

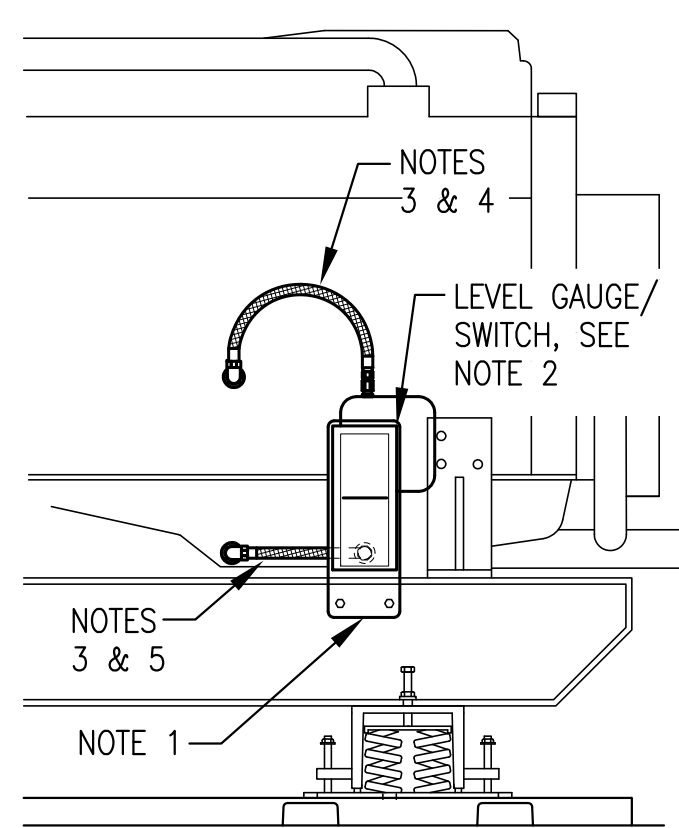


NOTES:

- 1) 1/4" STEEL SUPPORT PLATE PRE-DRILLED TO MATCH GAUGE/SWITCH MOUNTS, CHANNEL SKID HOLES AND BOTTOM HOSE ENTRANCE. BOLT TO INSIDE (BACK) OF CHANNEL SKID AT HEIGHT AS REQUIRED TO CENTER GAUGE AT NORMAL FULL OIL LEVEL. ADJUST SWITCH CONTACTS 1/2" ABOVE & BELOW.
- 2) MOUNT OIL LEVEL GAUGE/SWITCH TO STEEL SUPPORT PLATE WITH RUBBER SHOCK MOUNTS.
- 3) #8 HOSE WITH 1/2" OR 3/8" NPT JIC SWIVEL ENDS AS REQUIRED.
- 4) CONNECT TOP (VENT) PORT TO ENGINE CRANK CASE WITH HOSE. ROUTE UPPER HOSE TO AVOID LOW POINT TRAPS.
- 5) CONNECT BOTTOM PORT TO ENGINE OIL PAN WITH HOSE. DO NOT TEE INTO OIL DRAIN LINE. ROUTE LOWER HOSE BACK THROUGH PRE-DRILLED HOLE IN STEEL PLATE.


4 TYPICAL OIL LEVEL GAUGE/SWITCH INSTALLATION
M3.3 NO SCALE

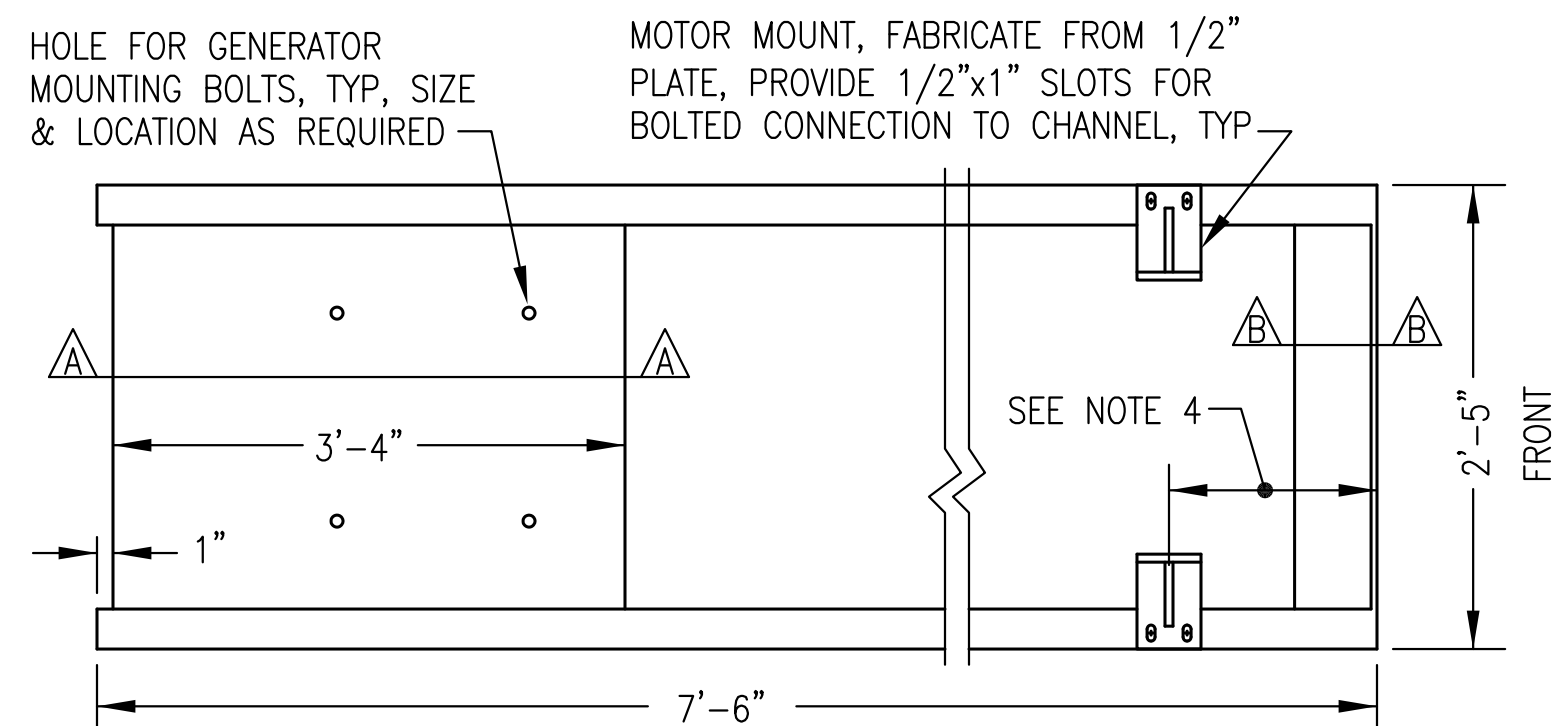


PLAN (TOP) VIEW

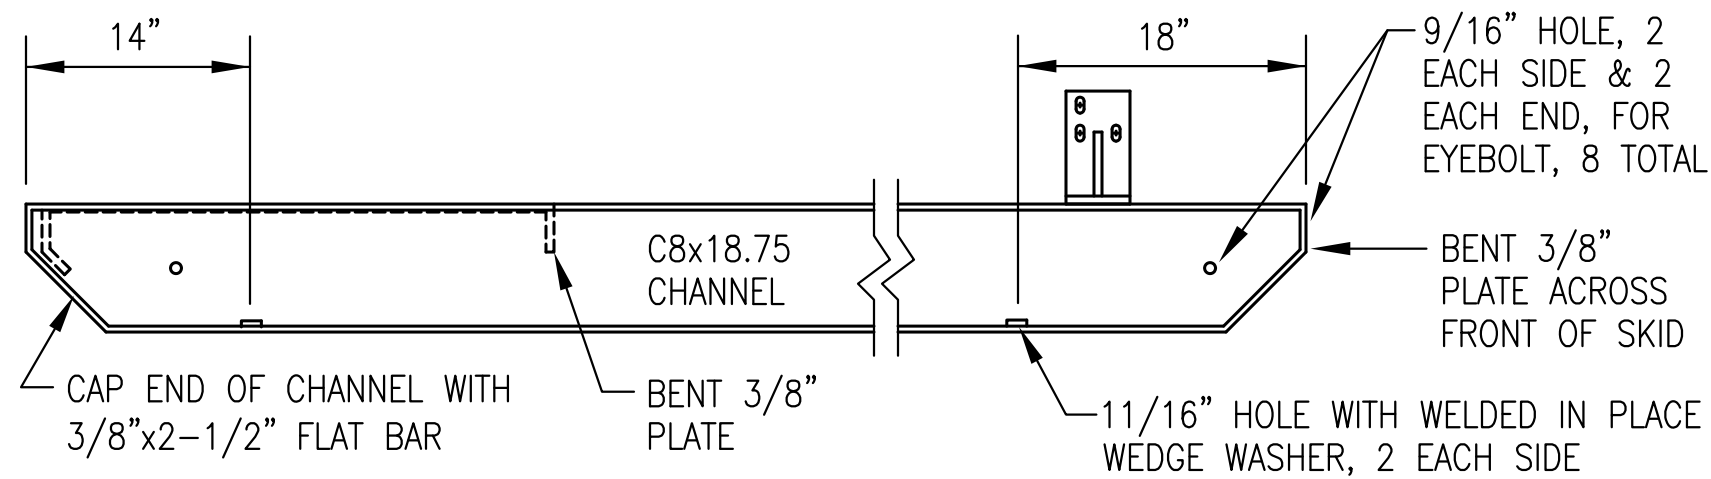

ELEVATION (SIDE) VIEW

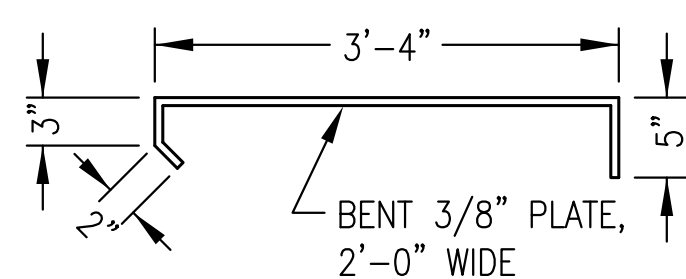

SECTION A-A

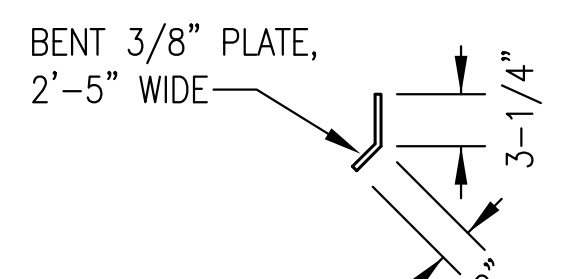


SECTION B-B


NOTES:

- 1) FABRICATE FROM ASTM A-36 STEEL. BEND PLATES & CUT ENDS OF CHANNELS AT 90° & 45° AS SHOWN.
- 2) EXCEPT WHERE INDICATED AS BOLTED MAKE ALL CONNECTIONS WITH CONTINUOUS WELDS (FILLET OR FULL-PENETRATION GROOVE AS REQUIRED) IN ACCORDANCE WITH CURRENT AWS STANDARD CODE.
- 3) ROUND ALL CORNERS & GRIND WELDS SMOOTH AFTER FABRICATION. PAINT TO MATCH ENGINE-GENERATOR.
- 4) PLACE UNIT ON SKID SO THAT THE EXHAUST RISER CENTERLINE IS 4'-2" FROM THE FRONT OF THE SKID.


2 GENERATOR #1 (JOHN DEERE 6068AFM85) SKID DESIGN
M3.3 NO SCALE

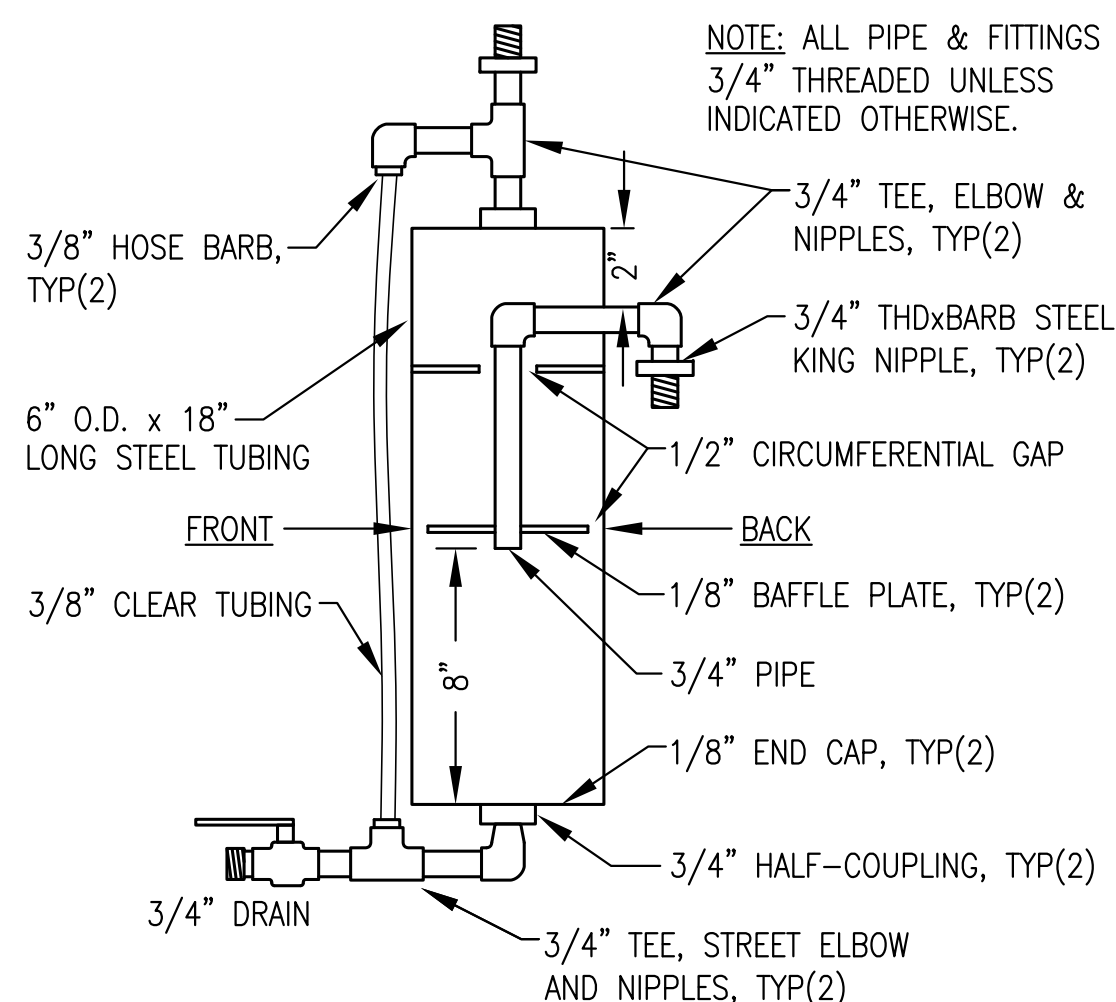


5 CONDENSATE TRAP FABRICATION
M3.3 NO SCALE

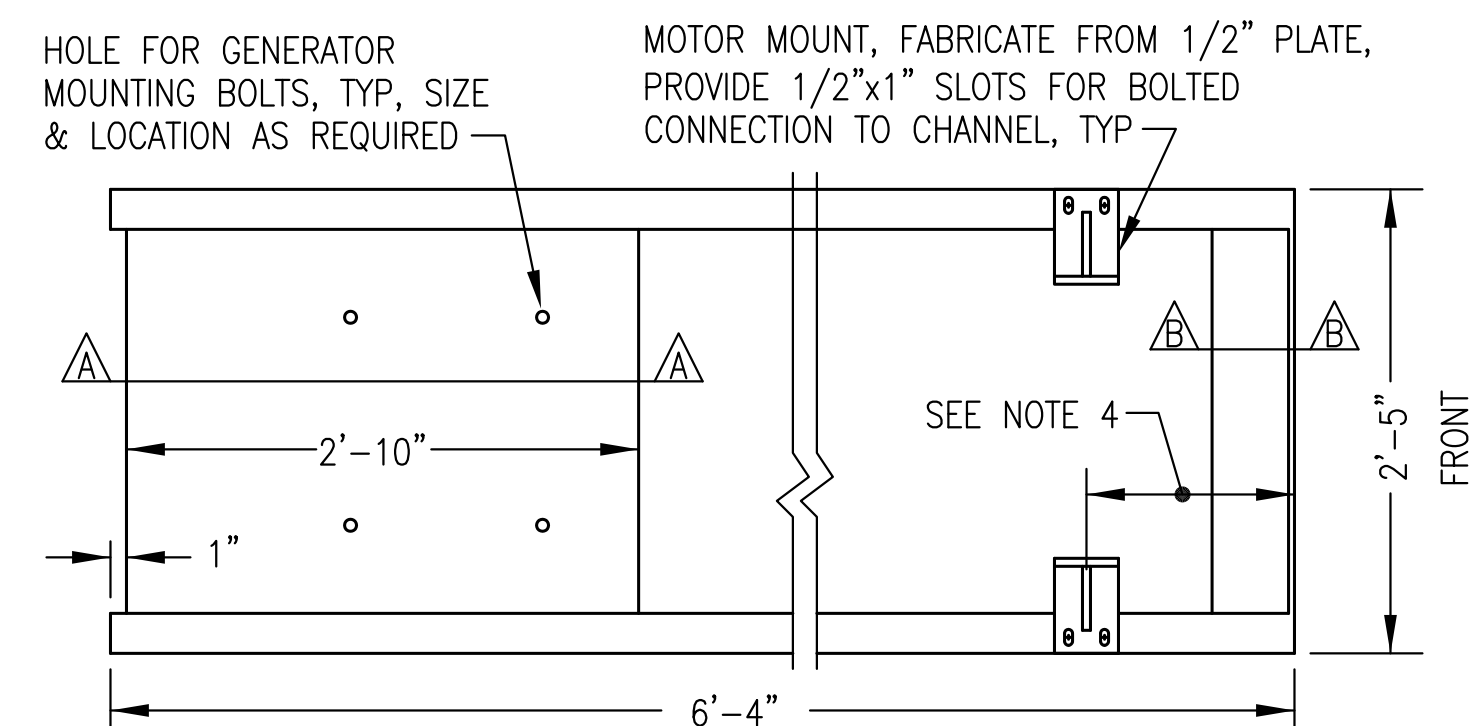


PLAN (TOP) VIEW

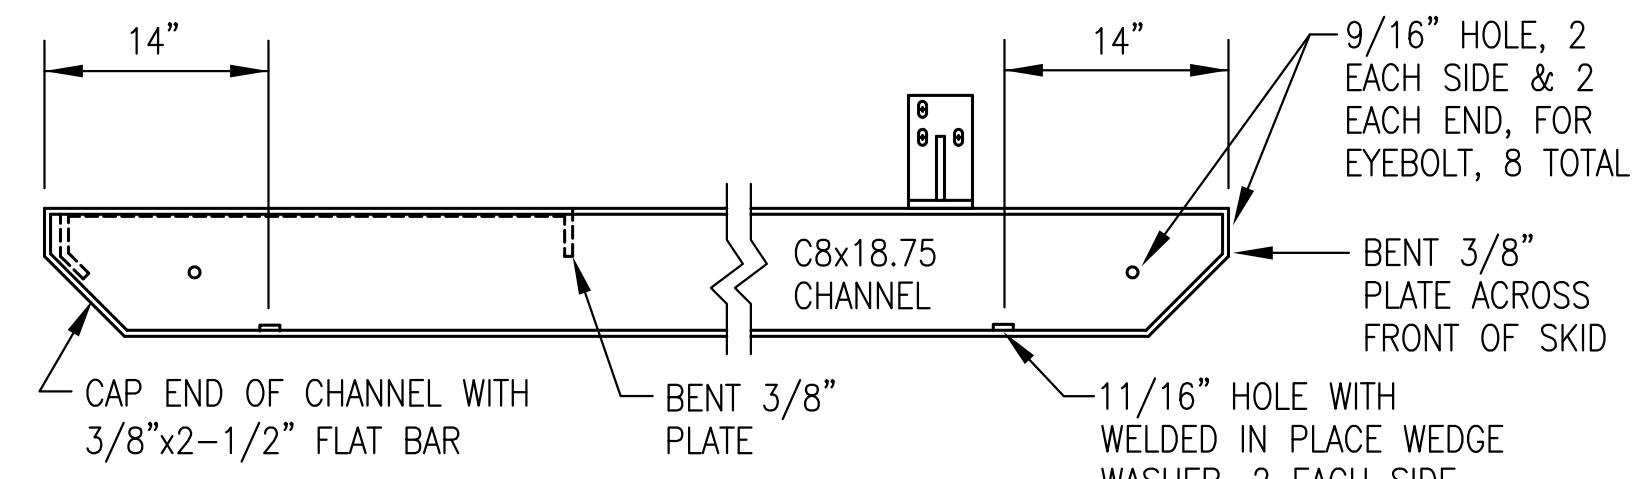

ELEVATION (SIDE) VIEW

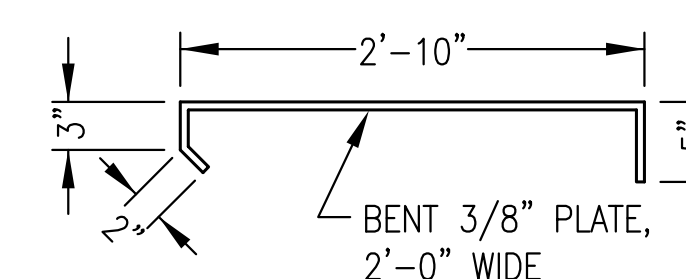

SECTION A-A

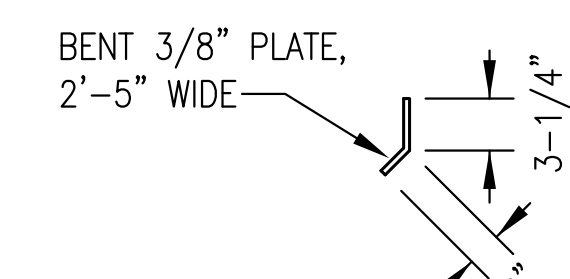


SECTION B-B

NOTES:

- 1) FABRICATE FROM ASTM A-36 STEEL. BEND PLATES & CUT ENDS OF CHANNELS AT 90° & 45° AS SHOWN.
- 2) EXCEPT WHERE INDICATED AS BOLTED MAKE ALL CONNECTIONS WITH CONTINUOUS WELDS (FILLET OR FULL-PENETRATION GROOVE AS REQUIRED) IN ACCORDANCE WITH CURRENT AWS STANDARD CODE.
- 3) ROUND ALL CORNERS & GRIND WELDS SMOOTH AFTER FABRICATION. PAINT TO MATCH ENGINE-GENERATOR.
- 4) PLACE UNIT ON SKID SO THAT THE EXHAUST RISER CENTERLINE IS 3'-2" FROM THE FRONT OF THE SKID.

3 GENERATOR #2 & #3 (JOHN DEERE 4045FM75) SKID DESIGN
M3.3

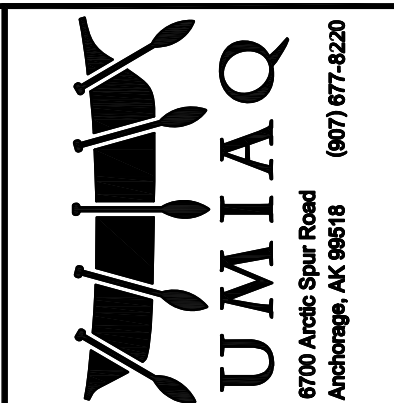


STATE OF ALASKA, AIDEA/AEA
RURAL POWER SYSTEM UPGRADE

CLARKS POINT POWER PLANT
CLARKS POINT, ALASKA

CONSTRUCTION DOCUMENTS

REVISIONS	DESCRIPTION
REV DATE	

VERIFY SCALES
0 1"
THIS BAR REPRESENTS ONE INCH ON ORIGINAL DRAWING

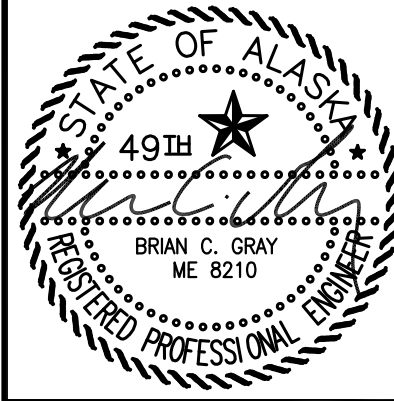

DATE: 1/14/19
DRAWN BY: JTD
CHECKED BY: BCG
JOB NUMBER:

DRAWING TITLE:
GENERATOR FABRICATION DETAILS

M3.3

SHEET OF 7

ISSUED FOR CONSTRUCTION JANUARY 2019

GLYCOL TANK SPECIFIC NOTES:


- 1) 1-1/2" FPT - INSTALL DAY TANK GAUGE G-DT.
- 2) 2" FPT - INSTALL 2" SCREENED VENT CAP ON 2"x6" NIPPLE.
- 3) 1" SCHEDULE 80 PIPE WITH THREADED TOP CONNECTION (WITHDRAWAL)
- 4) 1" SOCKETWELD 90° ELBOW
- 5) 1" THREADED HAND PUMP ADAPTER FLANGE, TOP OF FLANGE FLUSH WITH TOP OF TANK. INSTALL DAY TANK HAND PUMP HP-DT.
- 6) 2x1/4" FLAT BAR CONTINUOUS THREE SIDES
- 7) 3/8" HOLE AT 8" O.C. ALL AROUND
- 8) L2x2x1/4"x6' LONG. SET FACE TO BOLT TO HAND PUMP.

GLYCOL TANK GENERAL NOTES:


- 1. FABRICATE SINGLE WALL 60 GALLON NOMINAL CAPACITY GLYCOL TANK.
- 2. FABRICATE FROM ASTM A-36 STEEL PLATE, 10 GAUGE MINIMUM EXCEPT FOR TOP 3/16" MINIMUM. ALL TANK SEAM JOINTS TO BE FULL CONTINUOUS WELDS.
- 3. PROVIDE WITH ALL OPENINGS AND ATTACHMENTS INDICATED. SEAL WELD ALL TANK ATTACHMENTS.
- 4. ALL FPT OPENINGS TO BE FORGED STEEL HALF COUPLINGS.
- 5. UPON COMPLETION OF FABRICATION, ROUND ALL CORNERS AND SHARP EDGES. SANDBLAST TANK EXTERIOR AND ALL ATTACHMENTS IN ACCORDANCE WITH SSPC-SP-6. PAINT WITH TWO COATS OF SHERWIN WILLIAMS MACROPOXY 646 OR APPROVED EQUAL, COLOR STRUCTURAL GRAY 4031.
- 6. UPON COMPLETION FLUSH INTERIOR OF TANK TO REMOVE ALL DIRT AND DEBRIS AND AIR DRY INTERIOR. INSTALL VENT CAP, GAUGE, AND HAND PUMP.

EXPANSION TANK GENERAL NOTES:

- 1) FABRICATE SINGLE WALL 24 GALLON NOMINAL CAPACITY GLYCOL EXPANSION TANK.
- 2) FABRICATE SHELL FROM MINIMUM 10 GAUGE ASTM A-36 PLATE STEEL ROLLED AND WELDED OR SCHEDULE 5 LIGHTWALL ASTM A53 STEEL PIPE. FABRICATE HEADS FROM 3/16" THICK ASTM A-36 PLATE STEEL. MAKE ALL JOINTS WITH CONTINUOUS FULL-PENETRATION WELDS.
- 3) PROVIDE WITH ALL OPENINGS INDICATED USING MINIMUM 3000# FORGED STEEL PIPE HALF COUPLINGS IN ACCORDANCE WITH U.L 142 FIGURE 7.1 #2.
- 4) PRESSURE TEST COMPLETED ASSEMBLY TO 15 PSIG MINIMUM.
- 5) UPON COMPLETION OF FABRICATION, ROUND ALL CORNERS AND SHARP EDGES. SANDBLAST TANK EXTERIOR AND ALL ATTACHMENTS IN ACCORDANCE WITH SSPC-SP-6. PAINT WITH TWO COATS OF SHERWIN WILLIAMS MACROPOXY 646 OR APPROVED EQUAL, COLOR STRUCTURAL GRAY 4031.
- 6) UPON COMPLETION FLUSH INTERIOR OF TANK TO REMOVE ALL DIRT AND DEBRIS, AIR DRY INTERIOR, AND SEAL ALL TANK OPENINGS WITH PLASTIC PLUGS.

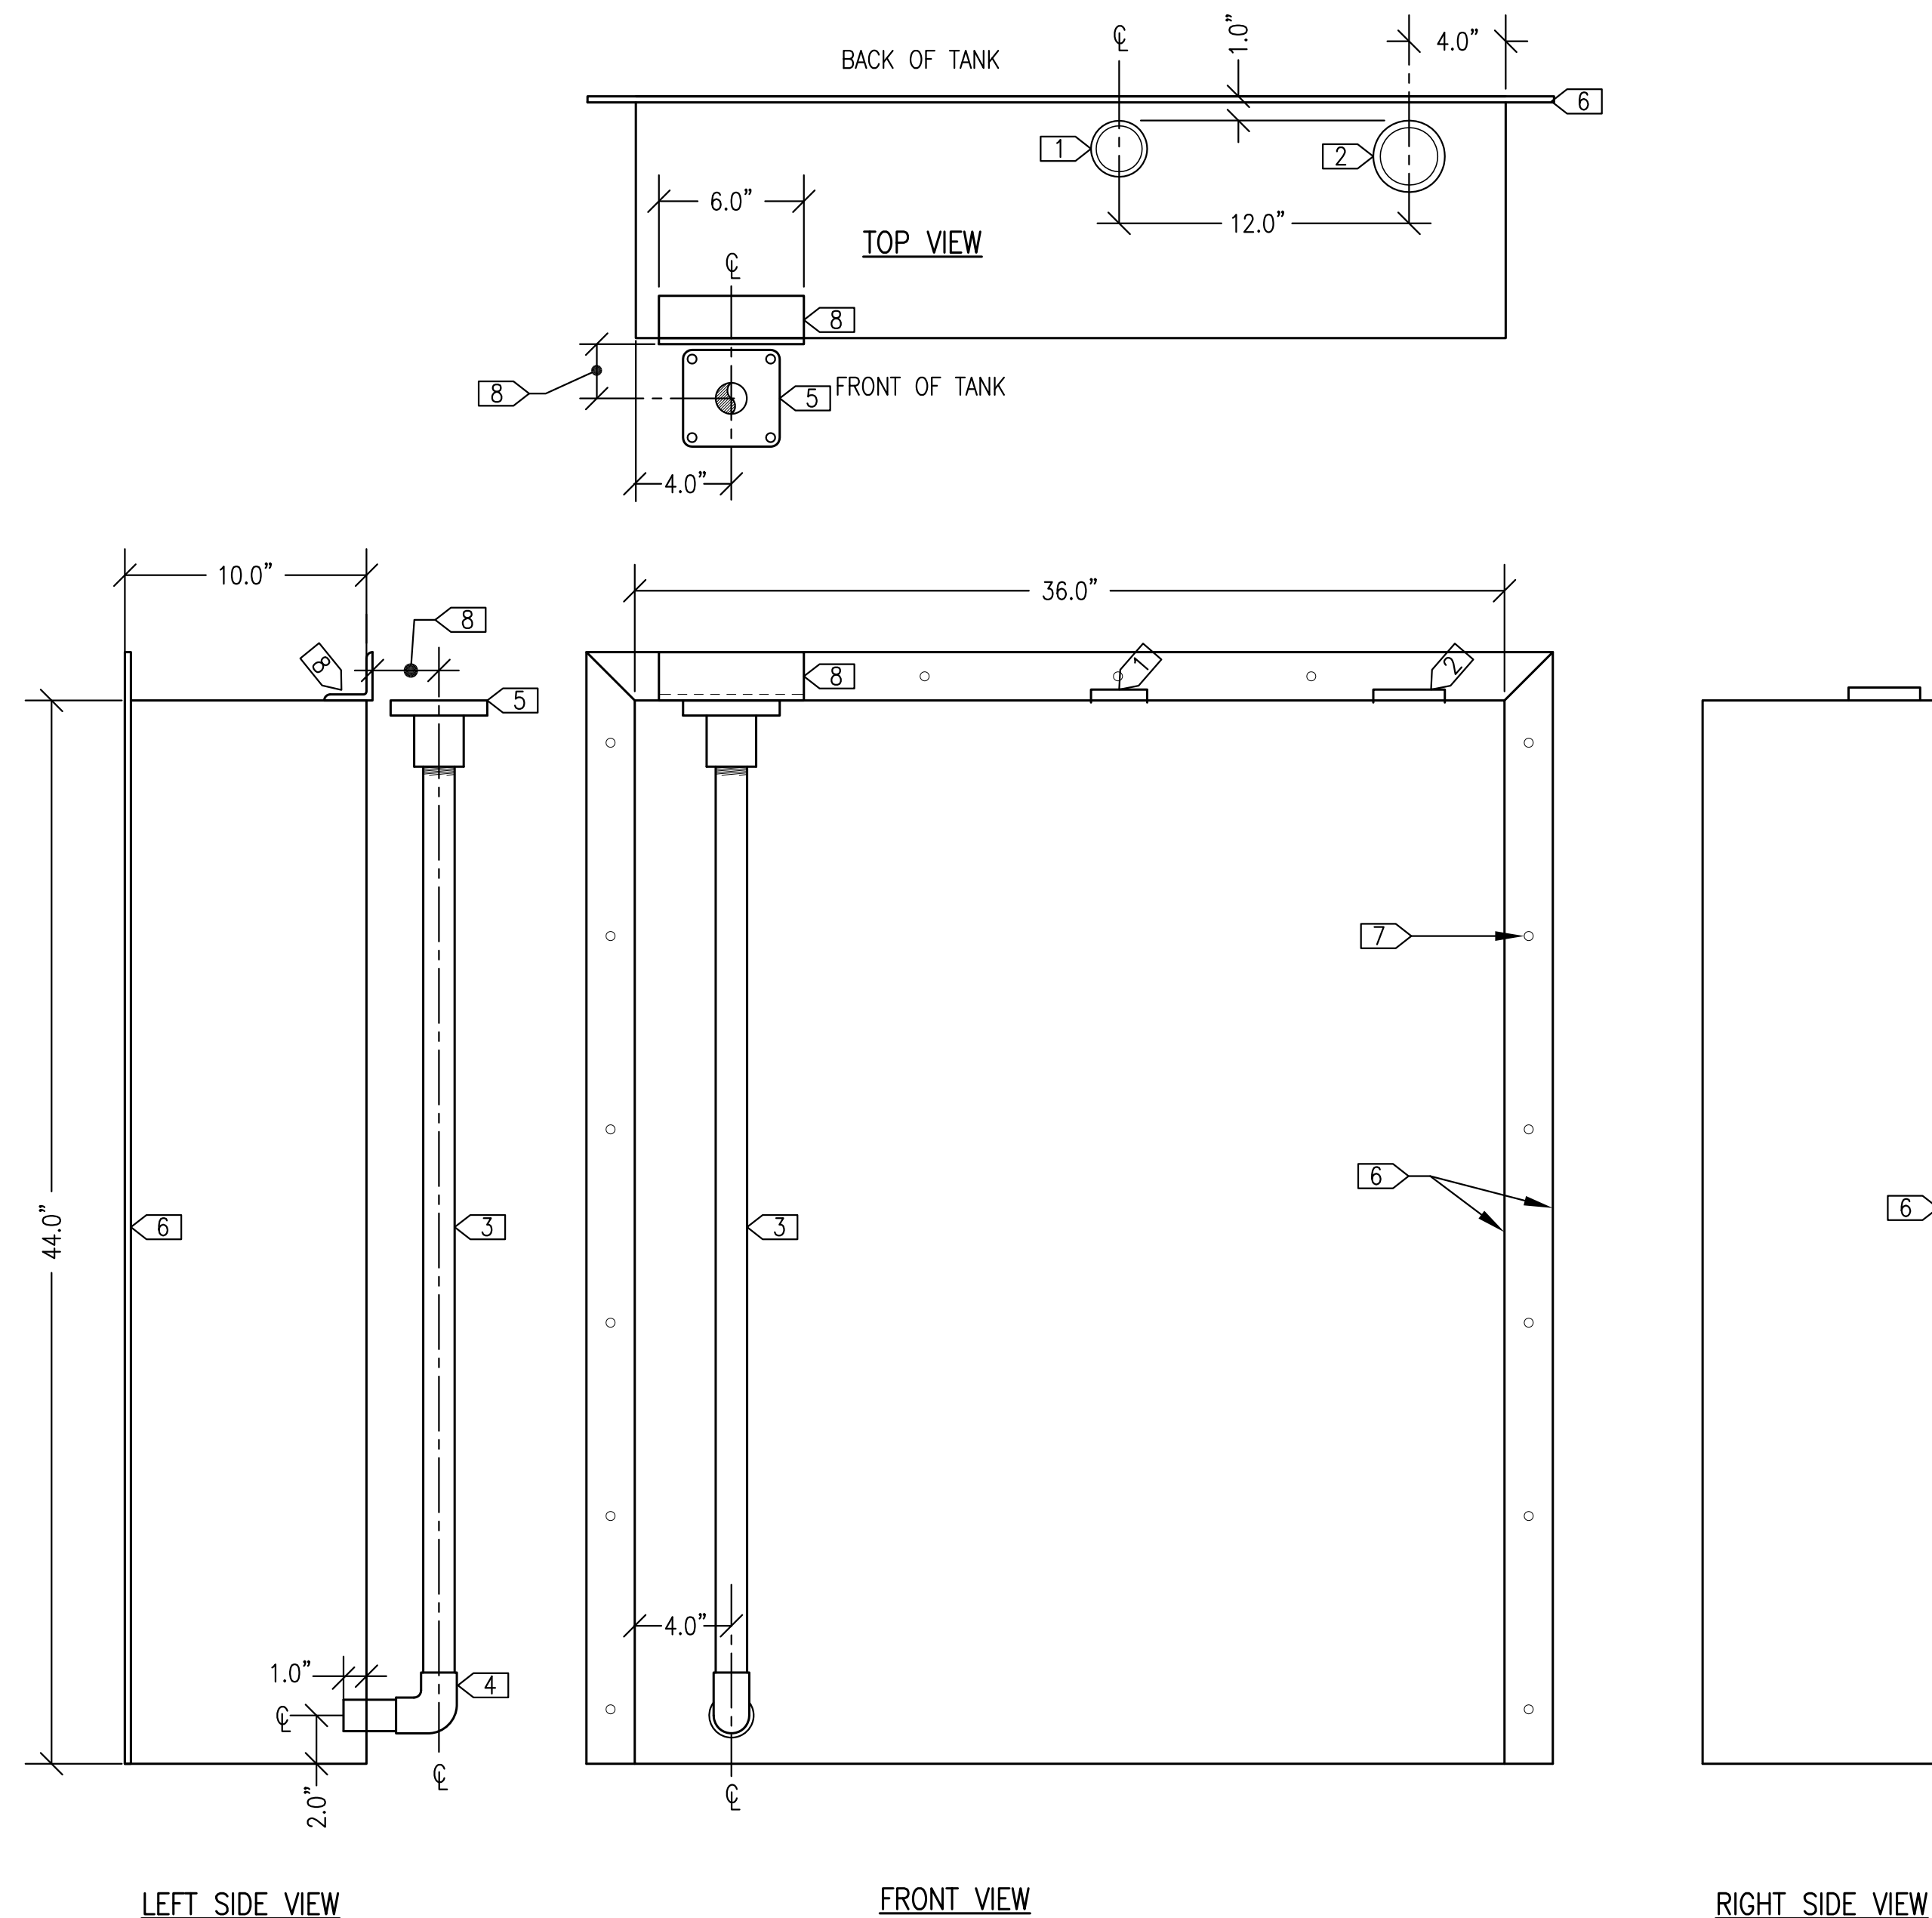

1 60 GALLON GLYCOL STORAGE TANK
M3.4 1"=6"

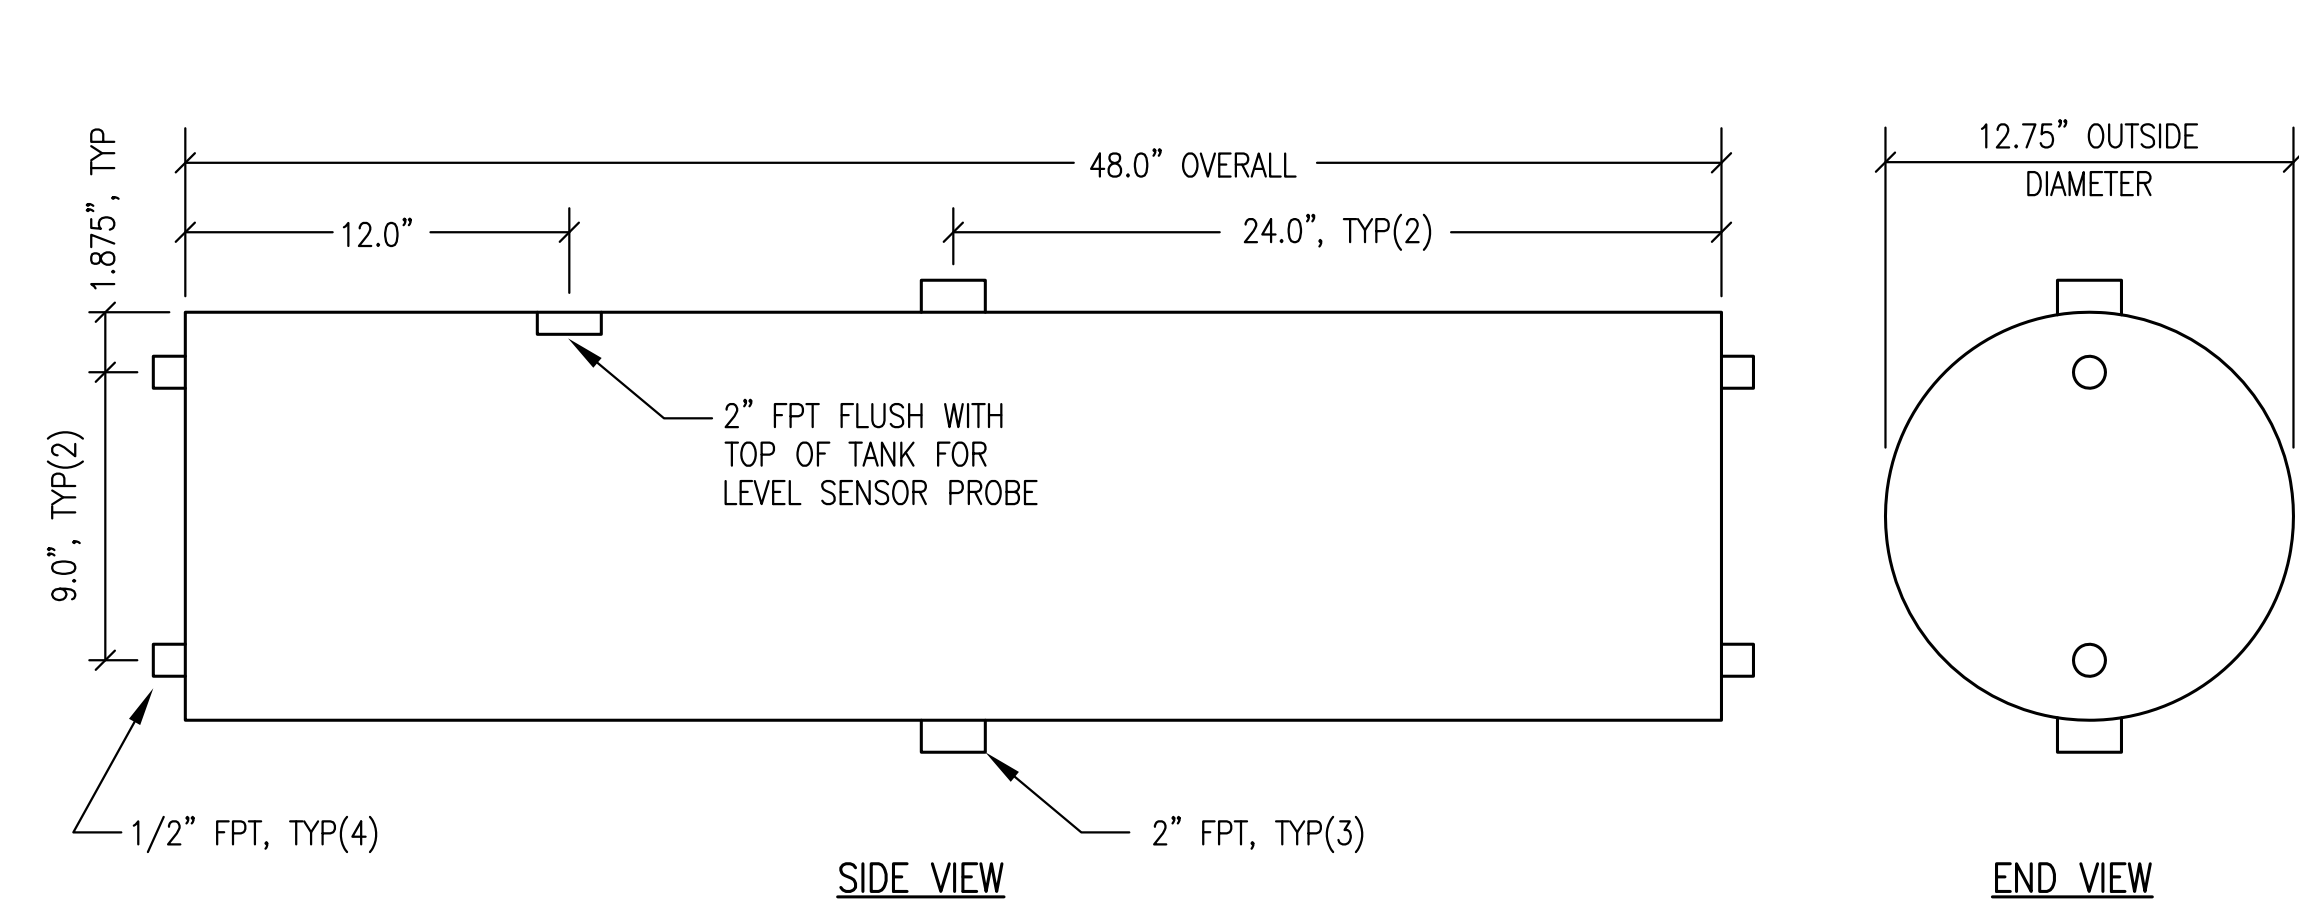


2 24 GALLON GLYCOL EXPANSION TANK
M3.4 1"=6"



**STATE OF ALASKA, AIDEA/AEA
RURAL POWER SYSTEM UPGRADE**
CLARKS POINT POWER PLANT
CLARKS POINT, ALASKA

CONSTRUCTION DOCUMENTS	
REVISIONS	DESCRIPTION
REV	DATE

VERIFY SCALES
0 1" = 1"
THIS BAR REPRESENTS ONE INCH ON ORIGINAL DRAWING

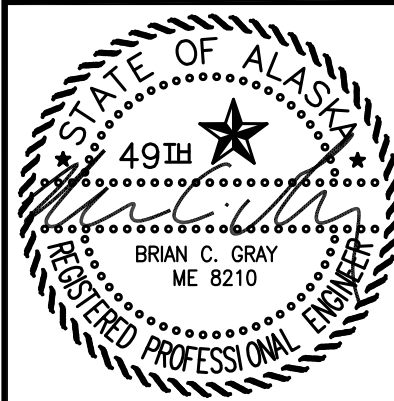


DATE: 1/14/19
DRAWN BY: JTD
CHECKED BY: BCG
JOB NUMBER:


DRAWING TITLE:
GLYCOL STORAGE & EXPANSION TANK FABRICATION

M3.4
SHEET OF 7


ISSUED FOR CONSTRUCTION JANUARY 2019

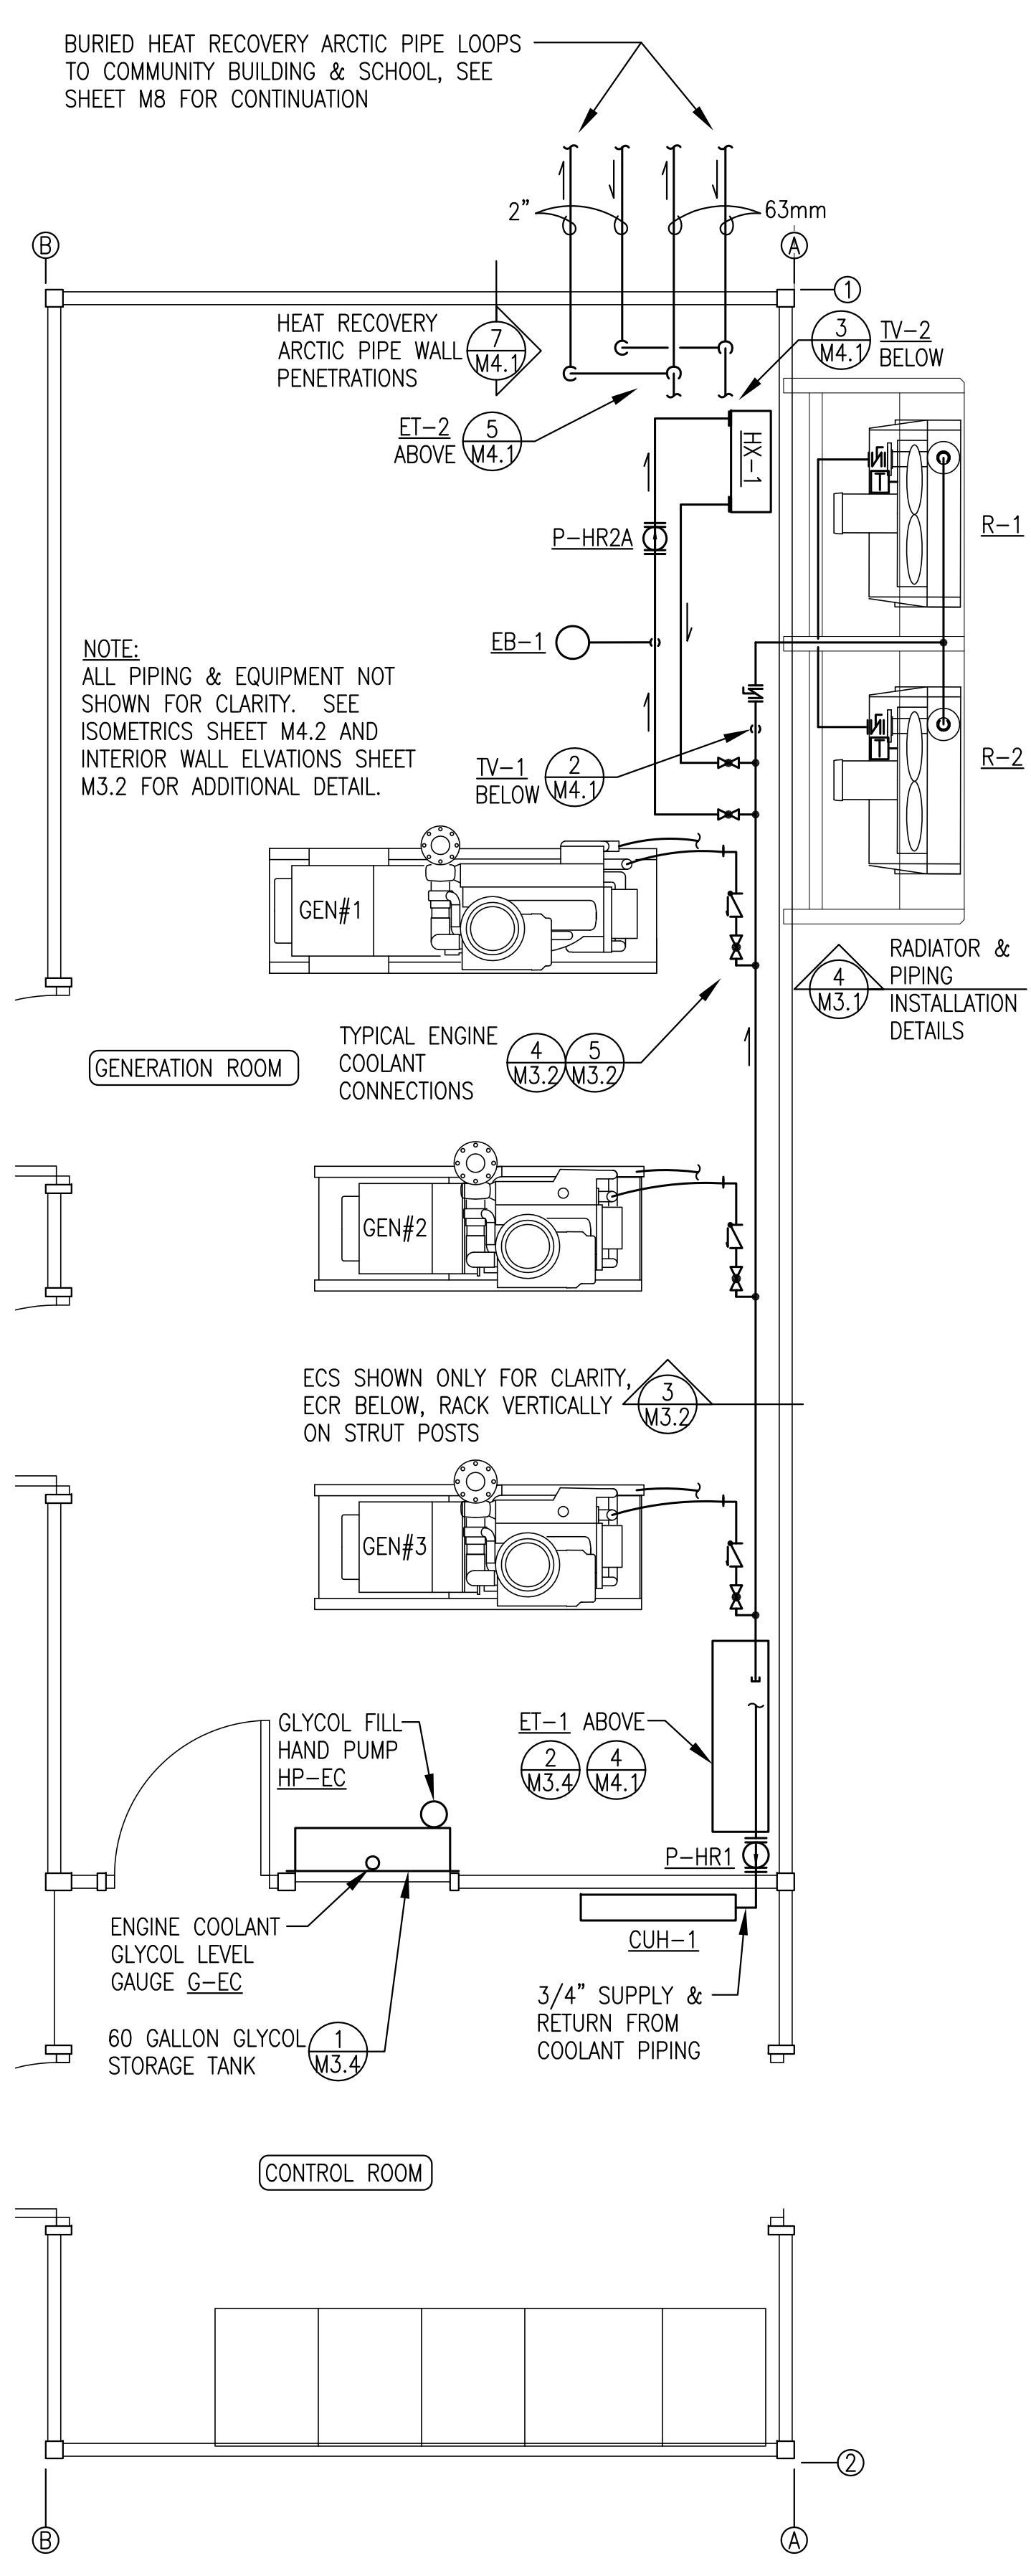


1 COOLANT AND HEAT RECOVERY PIPING PLAN
M4.1 3/8"=1'-0"

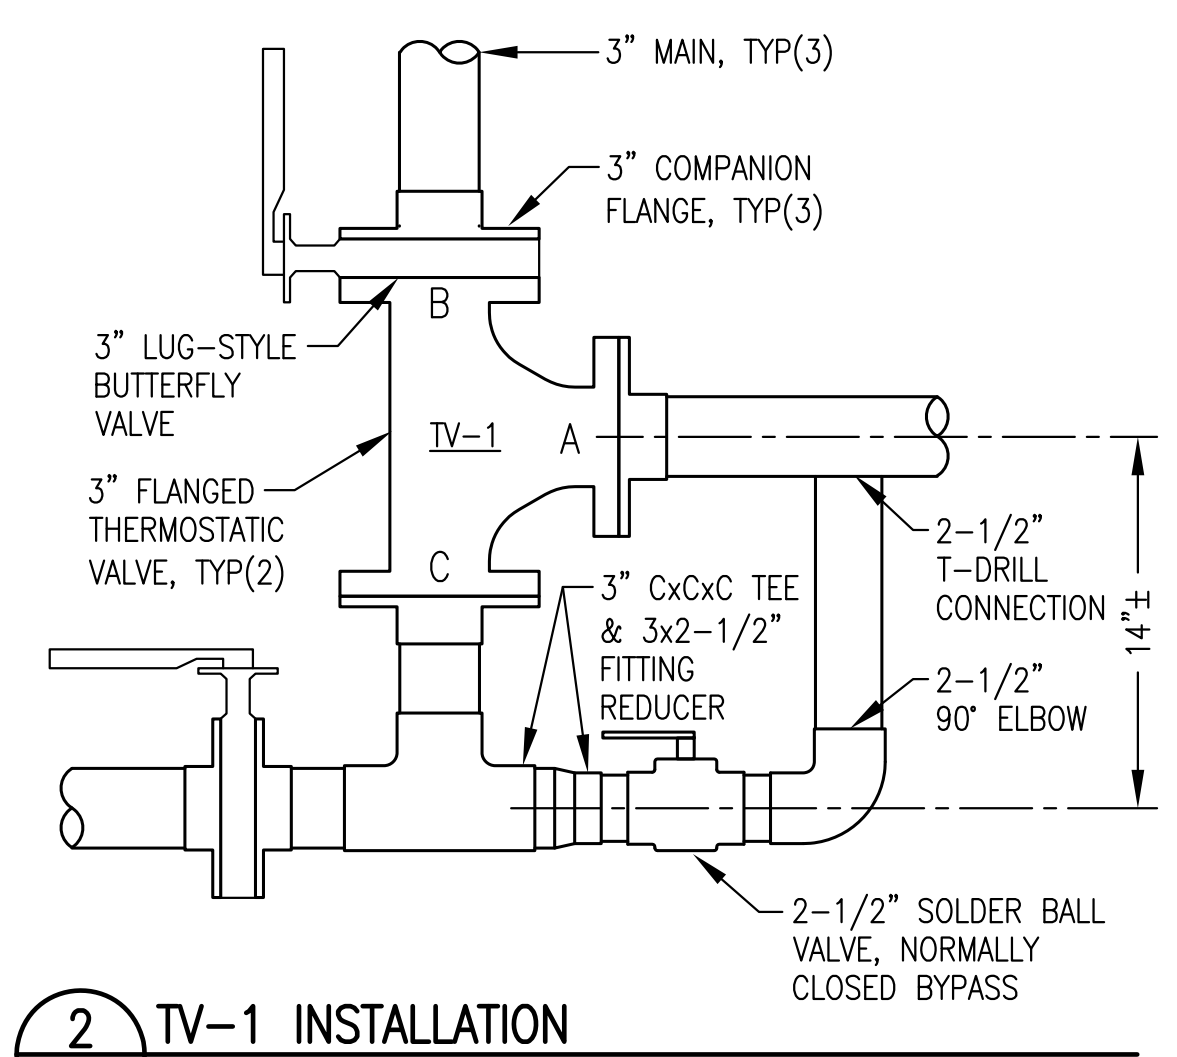


2 TV-1 INSTALLATION
M4.1 NO SCALE

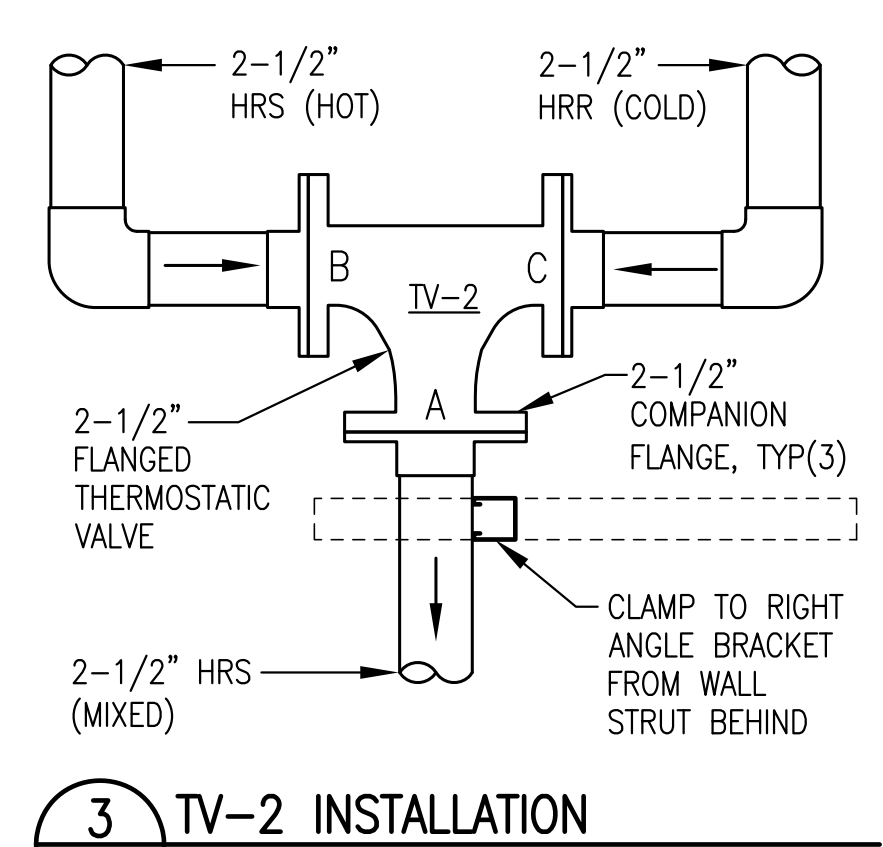



3 TV-2 INSTALLATION
M4.1 NO SCALE

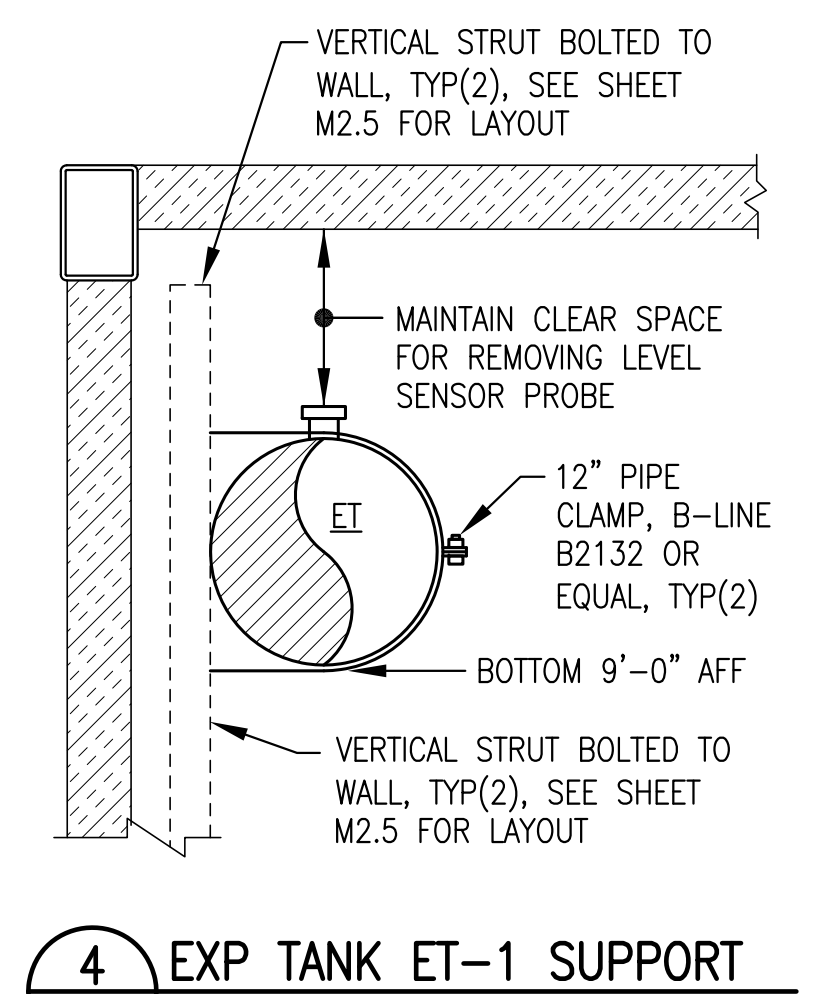


4 EXP TANK ET-1 SUPPORT
M4.1 NO SCALE

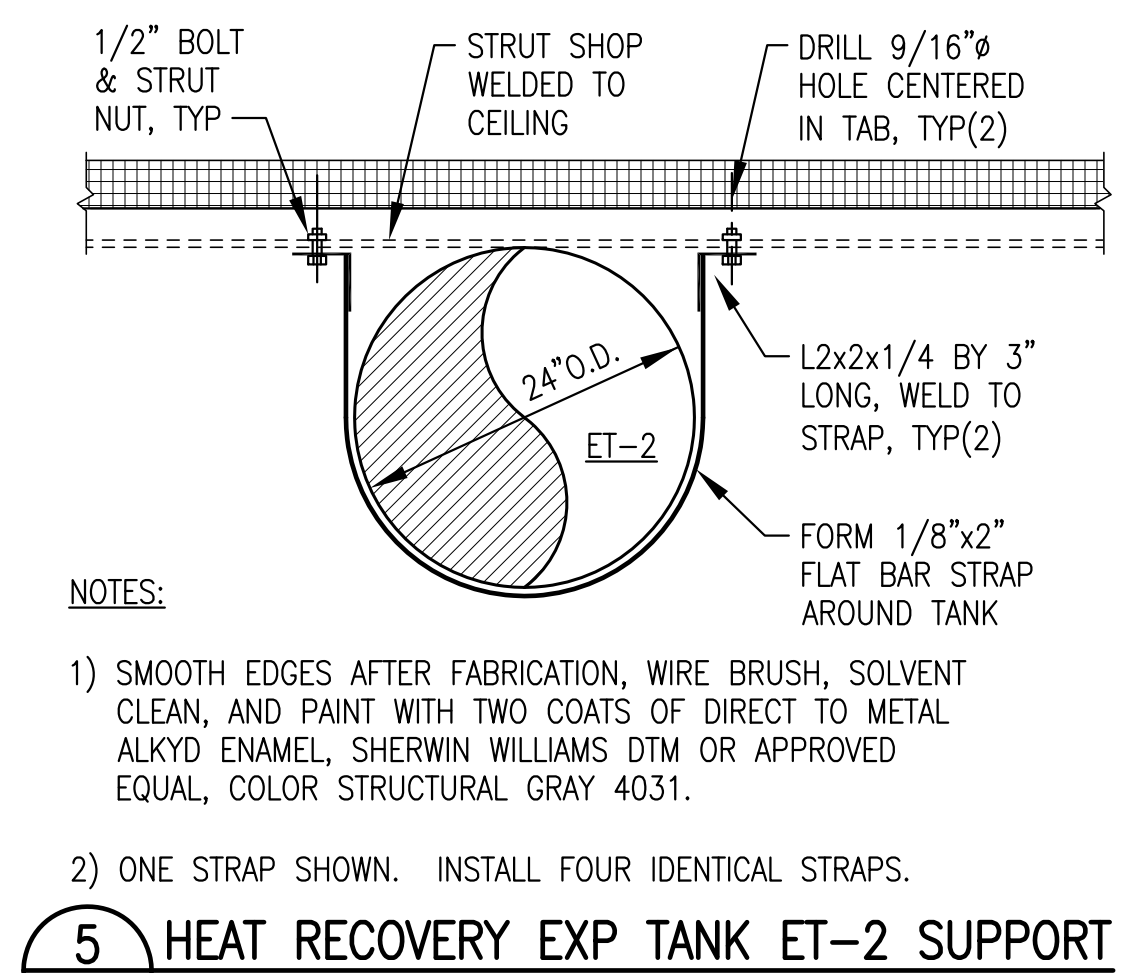


5 HEAT RECOVERY EXP TANK ET-2 SUPPORT
M4.1 NO SCALE

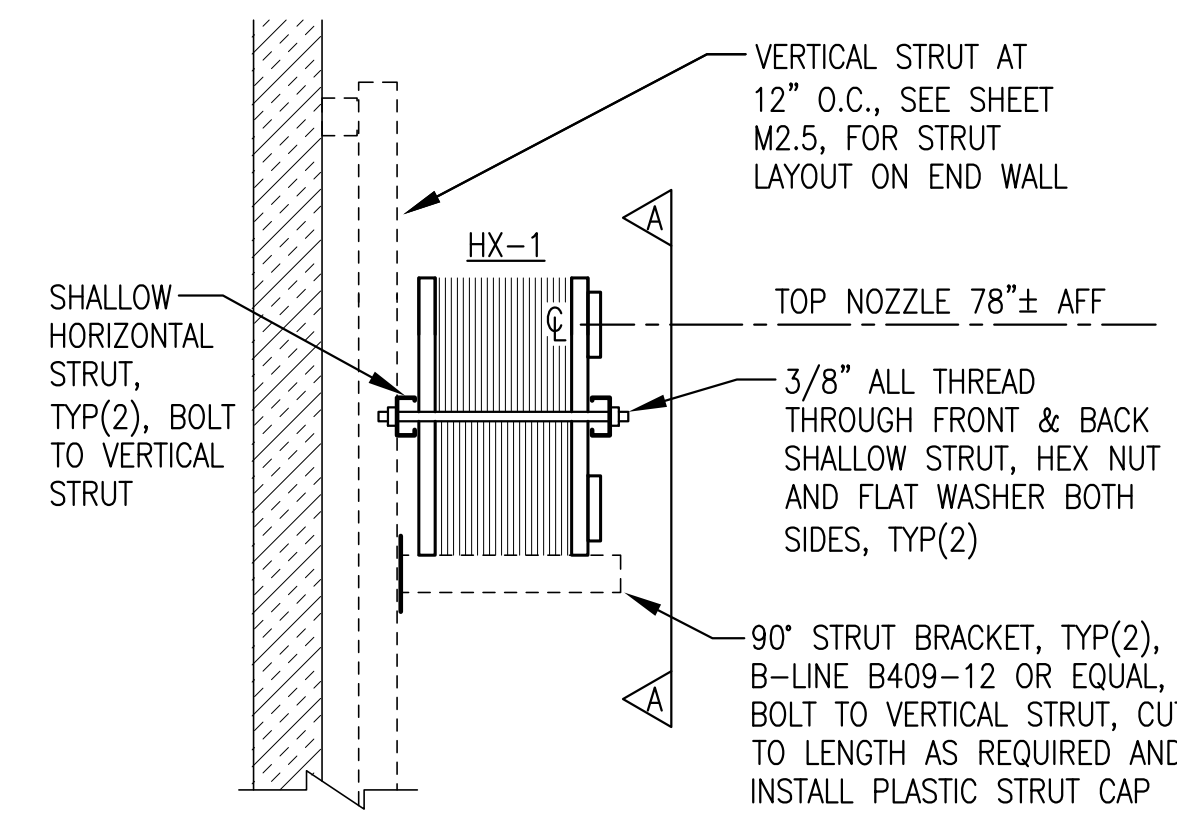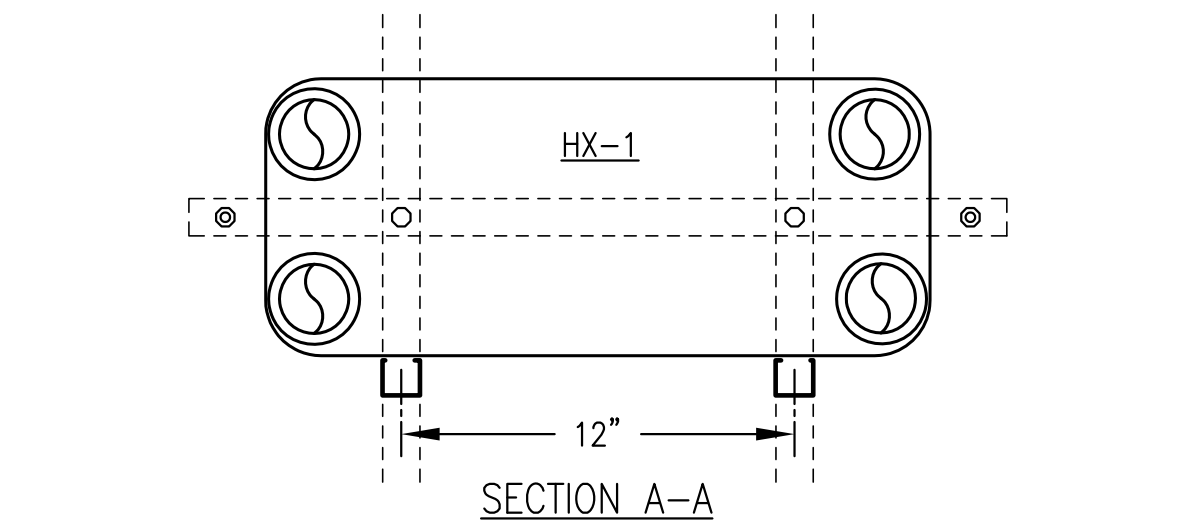


6 HEAT EXCHANGER SUPPORT FROM WALL
M4.1 NO SCALE

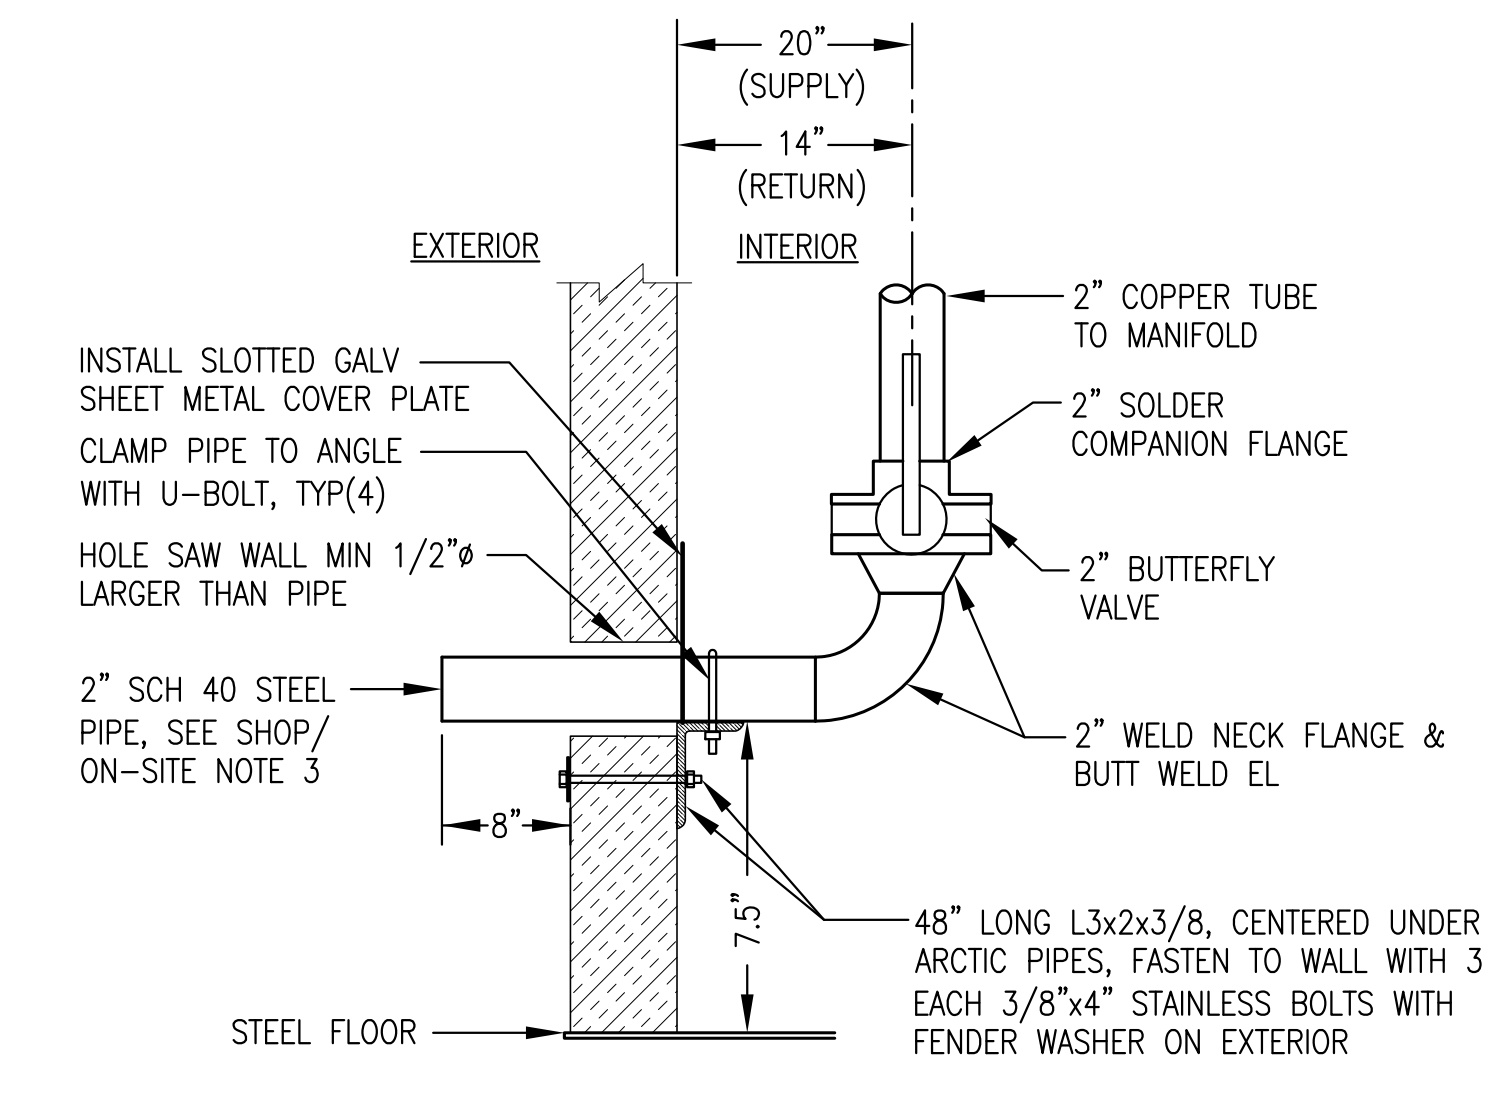


7 HEAT RECOVERY ARCTIC PIPE WALL PENETRATIONS
M4.1 NO SCALE

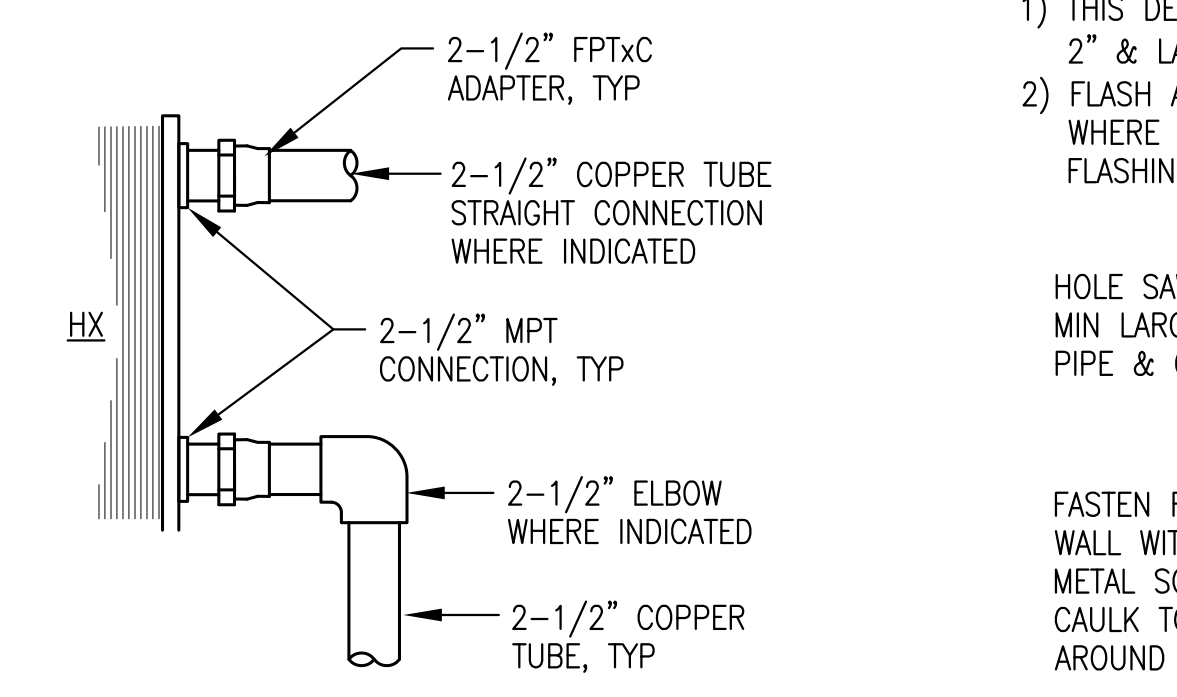

8 HX PIPING CONNECTION
M4.1 NO SCALE

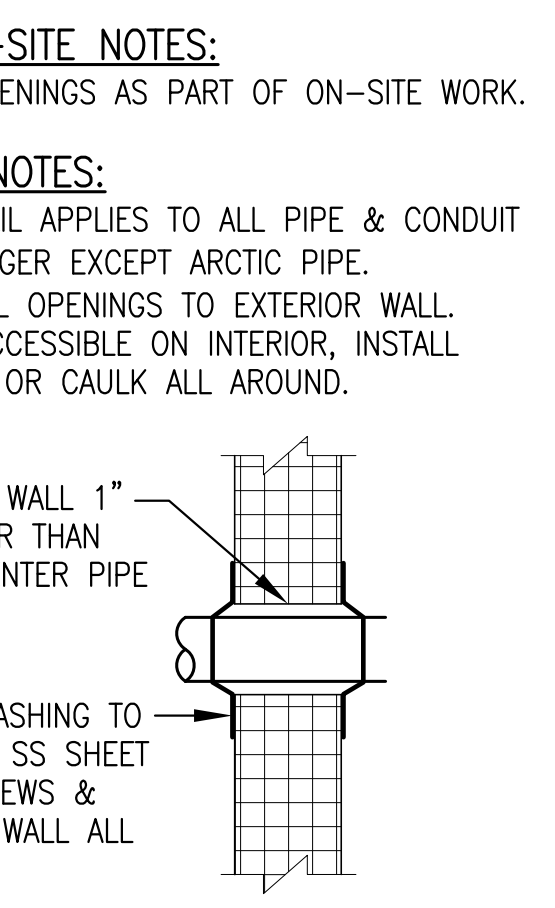

9 TYP WALL PENETRATION
M4.1 NO SCALE

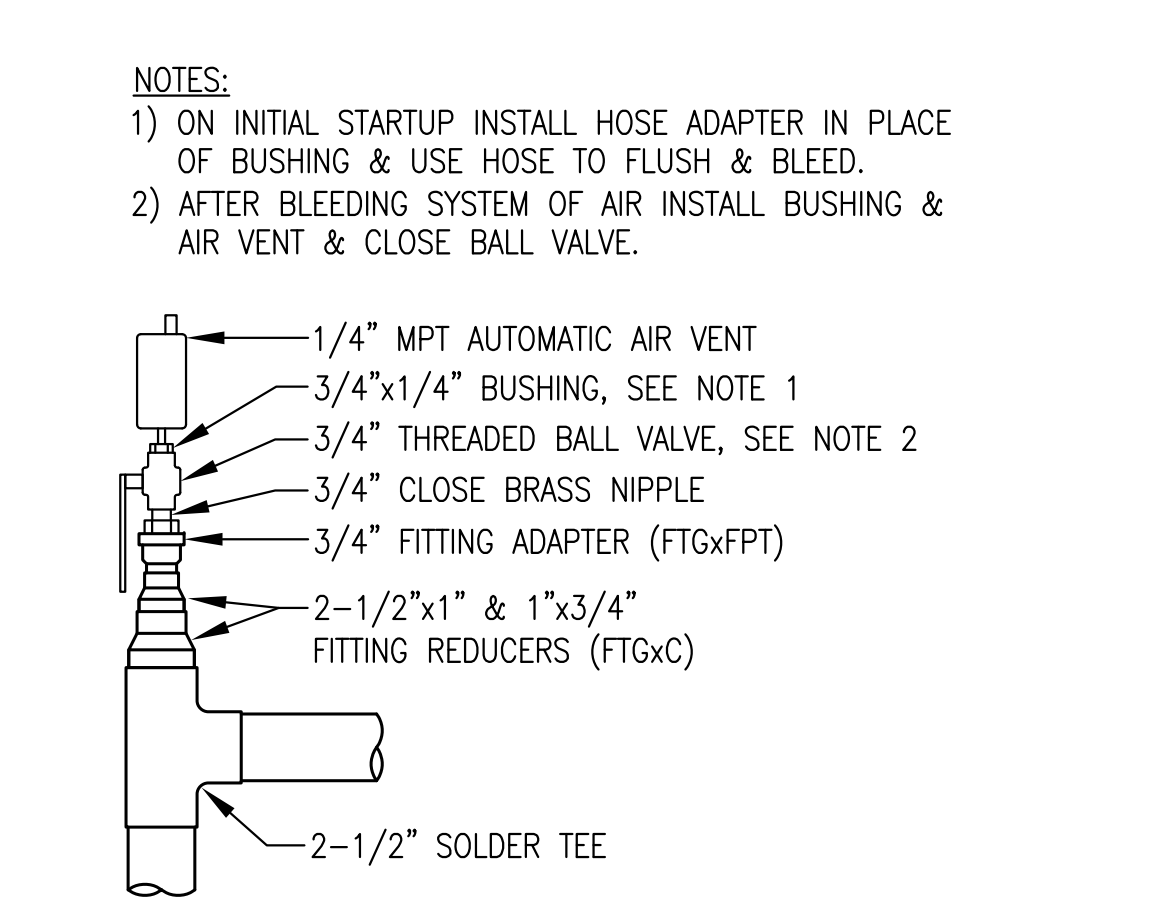

10 TYPICAL AIR VENT INSTALLATION
M4.1 NO SCALE

- ARCTIC PIPE GENERAL NOTES:**
- SEE ELEVATION 3/M3.2 FOR PENETRATION LOCATIONS.
 - ONE PIPE FOR EACH SIZE SHOWN. PROVIDE TWO IDENTICAL FOR EACH SIZE.
- ARCTIC PIPE SHOP/ON-SITE NOTES:**
- SHOP INSTALLATION SHOWN. STUB PIPE 8" MIN BEYOND WALL & TEMPORARILY CONNECT SUPPLY TO RETURN FOR TESTING.
 - AFTER TESTING REMOVE TEMPORARY CONNECTION, BREAK FLANGE JOINT, AND STORE PIPE IN MODULE. PLUG WALL PENETRATION FOR SHIPPING.
 - AS PART OF ON-SITE INSTALLATION REINSTALL PIPE THROUGH WALL AND CONNECT TO ARCTIC PIPE, SEE SHEET M8.

- SHOP/ON-SITE NOTES:**
- FLASH OPENINGS AS PART OF ON-SITE WORK.
- GENERAL NOTES:**
- THIS DETAIL APPLIES TO ALL PIPE & CONDUIT 2" & LARGER EXCEPT ARCTIC PIPE.
 - FLASH ALL OPENINGS TO EXTERIOR WALL. WHERE ACCESSIBLE ON INTERIOR, INSTALL FLASHING OR CAULK ALL AROUND.

- NOTES:**
- ON INITIAL STARTUP INSTALL HOSE ADAPTER IN PLACE OF BUSHING & USE HOSE TO FLUSH & BLEED.
 - AFTER BLEEDING SYSTEM OF AIR INSTALL BUSHING & AIR VENT & CLOSE BALL VALVE.




Gray Stassel Engineering, Inc.
P.O. 111405
Anchorage, AK 99511
(907)949-0100

STATE OF ALASKA, AIDEA/AEA RURAL POWER SYSTEM UPGRADE
CLARKS POINT POWER PLANT
CLARKS POINT, ALASKA

CONSTRUCTION DOCUMENTS	
REVISIONS	DESCRIPTION

VERIFY SCALES
0 1" THIS BAR REPRESENTS ONE INCH ON ORIGINAL DRAWING

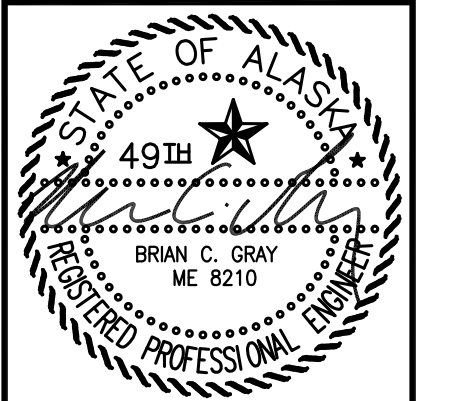

DATE: 1/14/19
DRAWN BY: JTD
CHECKED BY: BCG
JOB NUMBER:


DRAWING TITLE:
COOLANT & HEAT RECOVERY PIPING PLAN & DETAILS

M4.1
SHEET OF 7

ISSUED FOR CONSTRUCTION JANUARY 2019

NOTES:


- 1) ALL PIPING SHOWN THIS ISOMETRIC TYPE "L" COPPER WITH SOLDER JOINTS, 3"Ø EXCEPT WHERE SPECIFICALLY INDICATED OTHERWISE. ALL FLANGES ANSI 150# PATTERN BRONZE COMPANION WITH SOLDER ENDS.
- 2) MAKE ALL CONNECTIONS FOR INSTRUMENTATION WITH T-DRILL TAP, SEE DETAIL 3/M4.2. MAKE ALL OTHER REDUCING BRANCH CONNECTIONS WITH T-DRILL TAP OR TEE AS REQUIRED.
- 3) ALL COOLANT PRESSURE GAUGES 0-15 PSIG. ALL THERMOMETERS FAHRENHEIT RANGE.
- 4) SEE ELECTRICAL INSTRUMENTATION SCHEDULE FOR TEMPERATURE TRANSMITTERS AND OTHER INSTRUMENTATION.
- 5) UPON COMPLETION OF FABRICATION VALVE OFF CABINET UNIT HEATER AND FLUSH PIPING TO REMOVE ALL DEBRIS, SEE SPECIFICATIONS.
- 6) INSULATE COOLANT PIPING MAINS FROM GENERATOR VALVES TO RADIATORS. ALL OTHER PIPING NOT INSULATED.
- 7) INSTALL 9" LONG COOLANT SITE GAUGE ON 1/2" TEES, INSTALL 1/2" THREADED BALL VALVE WITH PLUG FOR DRAIN.
- 8) LOW COOLANT ALARM SWITCH, MOUNT WITH SWITCH POINT LEVEL WITHIN 12" OF TANK BOTTOM. CONNECT TO HOSE WITH NPTx5/8" BARB, 1/2" ON BOTTOM, 1/4" ON TOP.
- 9) 3/4" THREADED BALL VALVE, 3/4" MPTx5/8" BARB BRASS KING NIPPLE, & 1/2" HOSE FOR ENGINE VENT & PRE-HEAT.
- 10) SET P-HR1 & P-EB1 TO OPERATE ON SPEED 3.

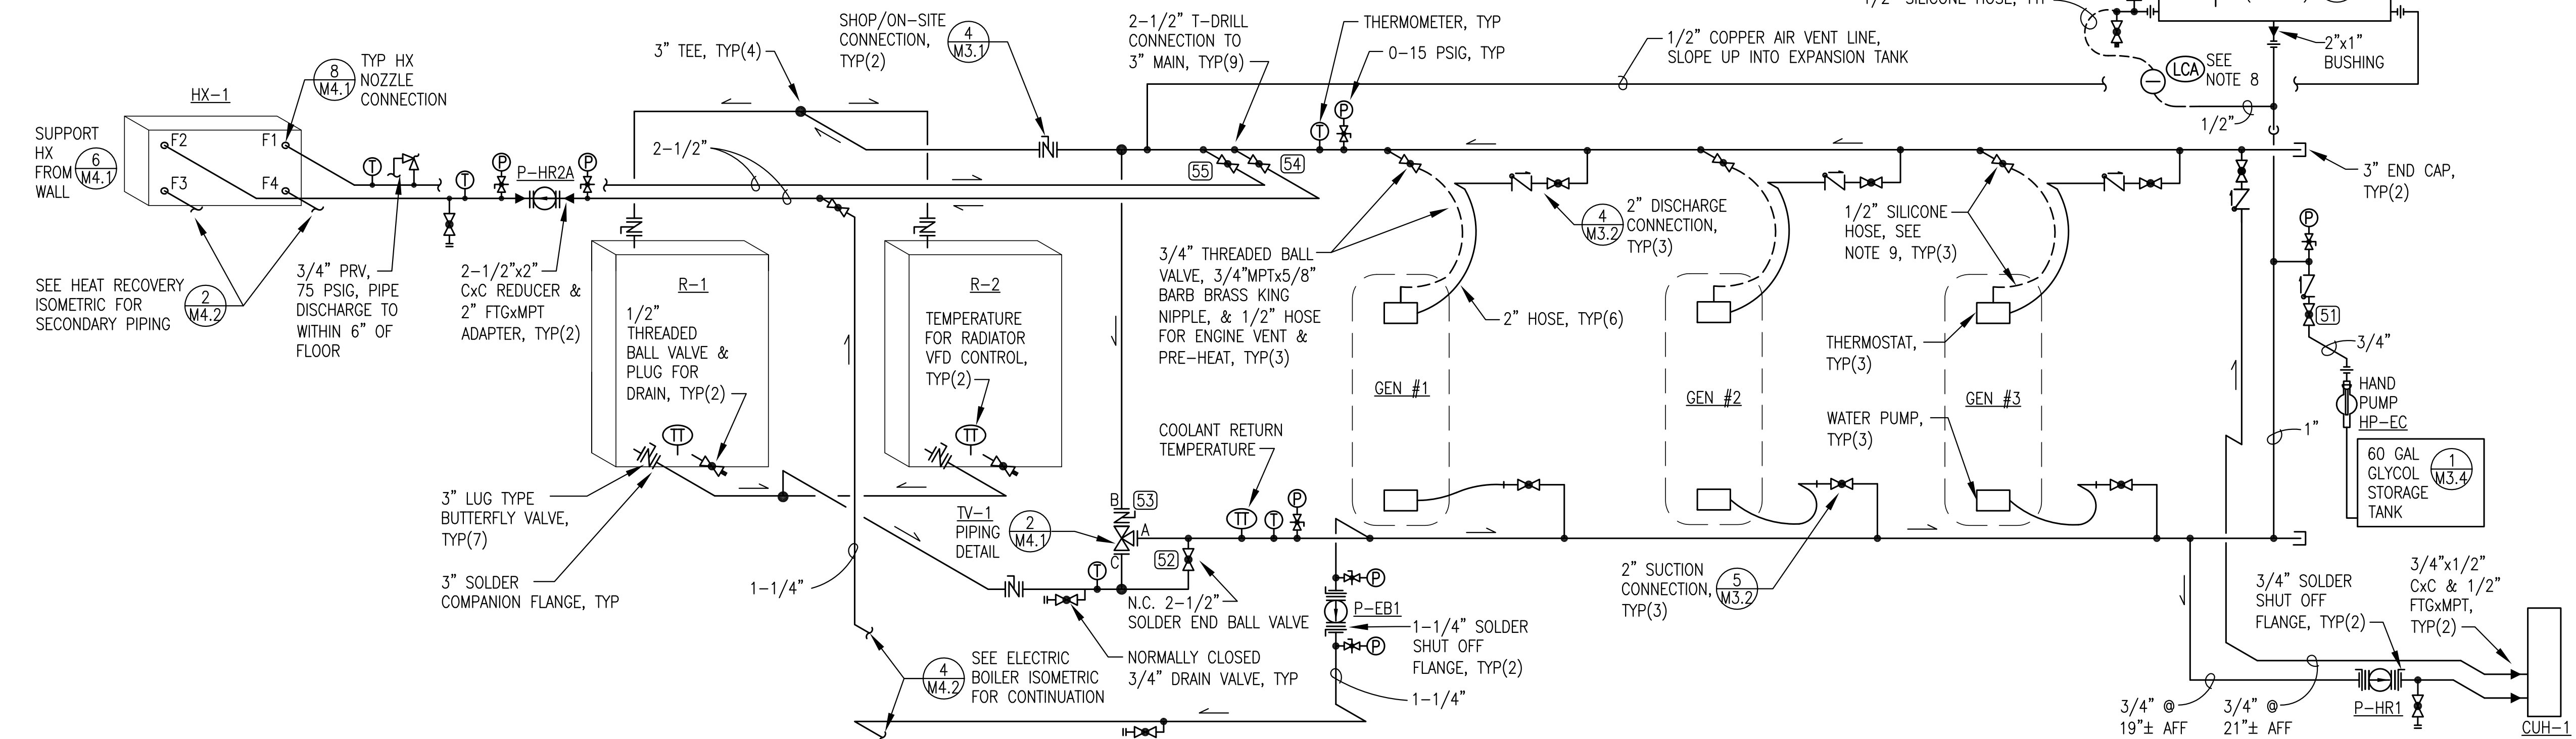

1 COOLING SYSTEM PIPING ISOMETRIC
M4.2 NO SCALE

NOTES:

- 1) ALL PIPING SHOWN THIS ISOMETRIC 2-1/2" TYPE L HARD DRAWN COPPER UNLESS SPECIFICALLY INDICATED OTHERWISE. ALL FLANGES ANSI 150# PATTERN BRONZE COMPANION WITH SOLDER ENDS.
- 2) UNLESS SPECIFIED OTHERWISE MAKE ALL CONNECTIONS FOR INSTRUMENTATION WITH T-DRILL TAP, SEE DETAIL 3/M4.2. MAKE ALL OTHER REDUCING BRANCH CONNECTIONS WITH T-DRILL TAP AS REQUIRED UNLESS INDICATED OTHERWISE.
- 3) ALL HEAT RECOVERY PRESSURE GAUGES 0-100 PSIG. ALL THERMOMETERS FAHRENHEIT RANGE.
- 4) SEE ELECTRICAL INSTRUMENTATION SCHEDULE FOR TEMPERATURE AND PRESSURE TRANSMITTERS AND FLOW METER.
- 5) UPON COMPLETION OF FABRICATION FLUSH PIPING TO REMOVE ALL DEBRIS, SEE SPECIFICATIONS.
- 6) INSULATE HEAT RECOVERY PIPING MAINS.
- 7) SET P-HR2B TO OPERATE ON SPEED 3.

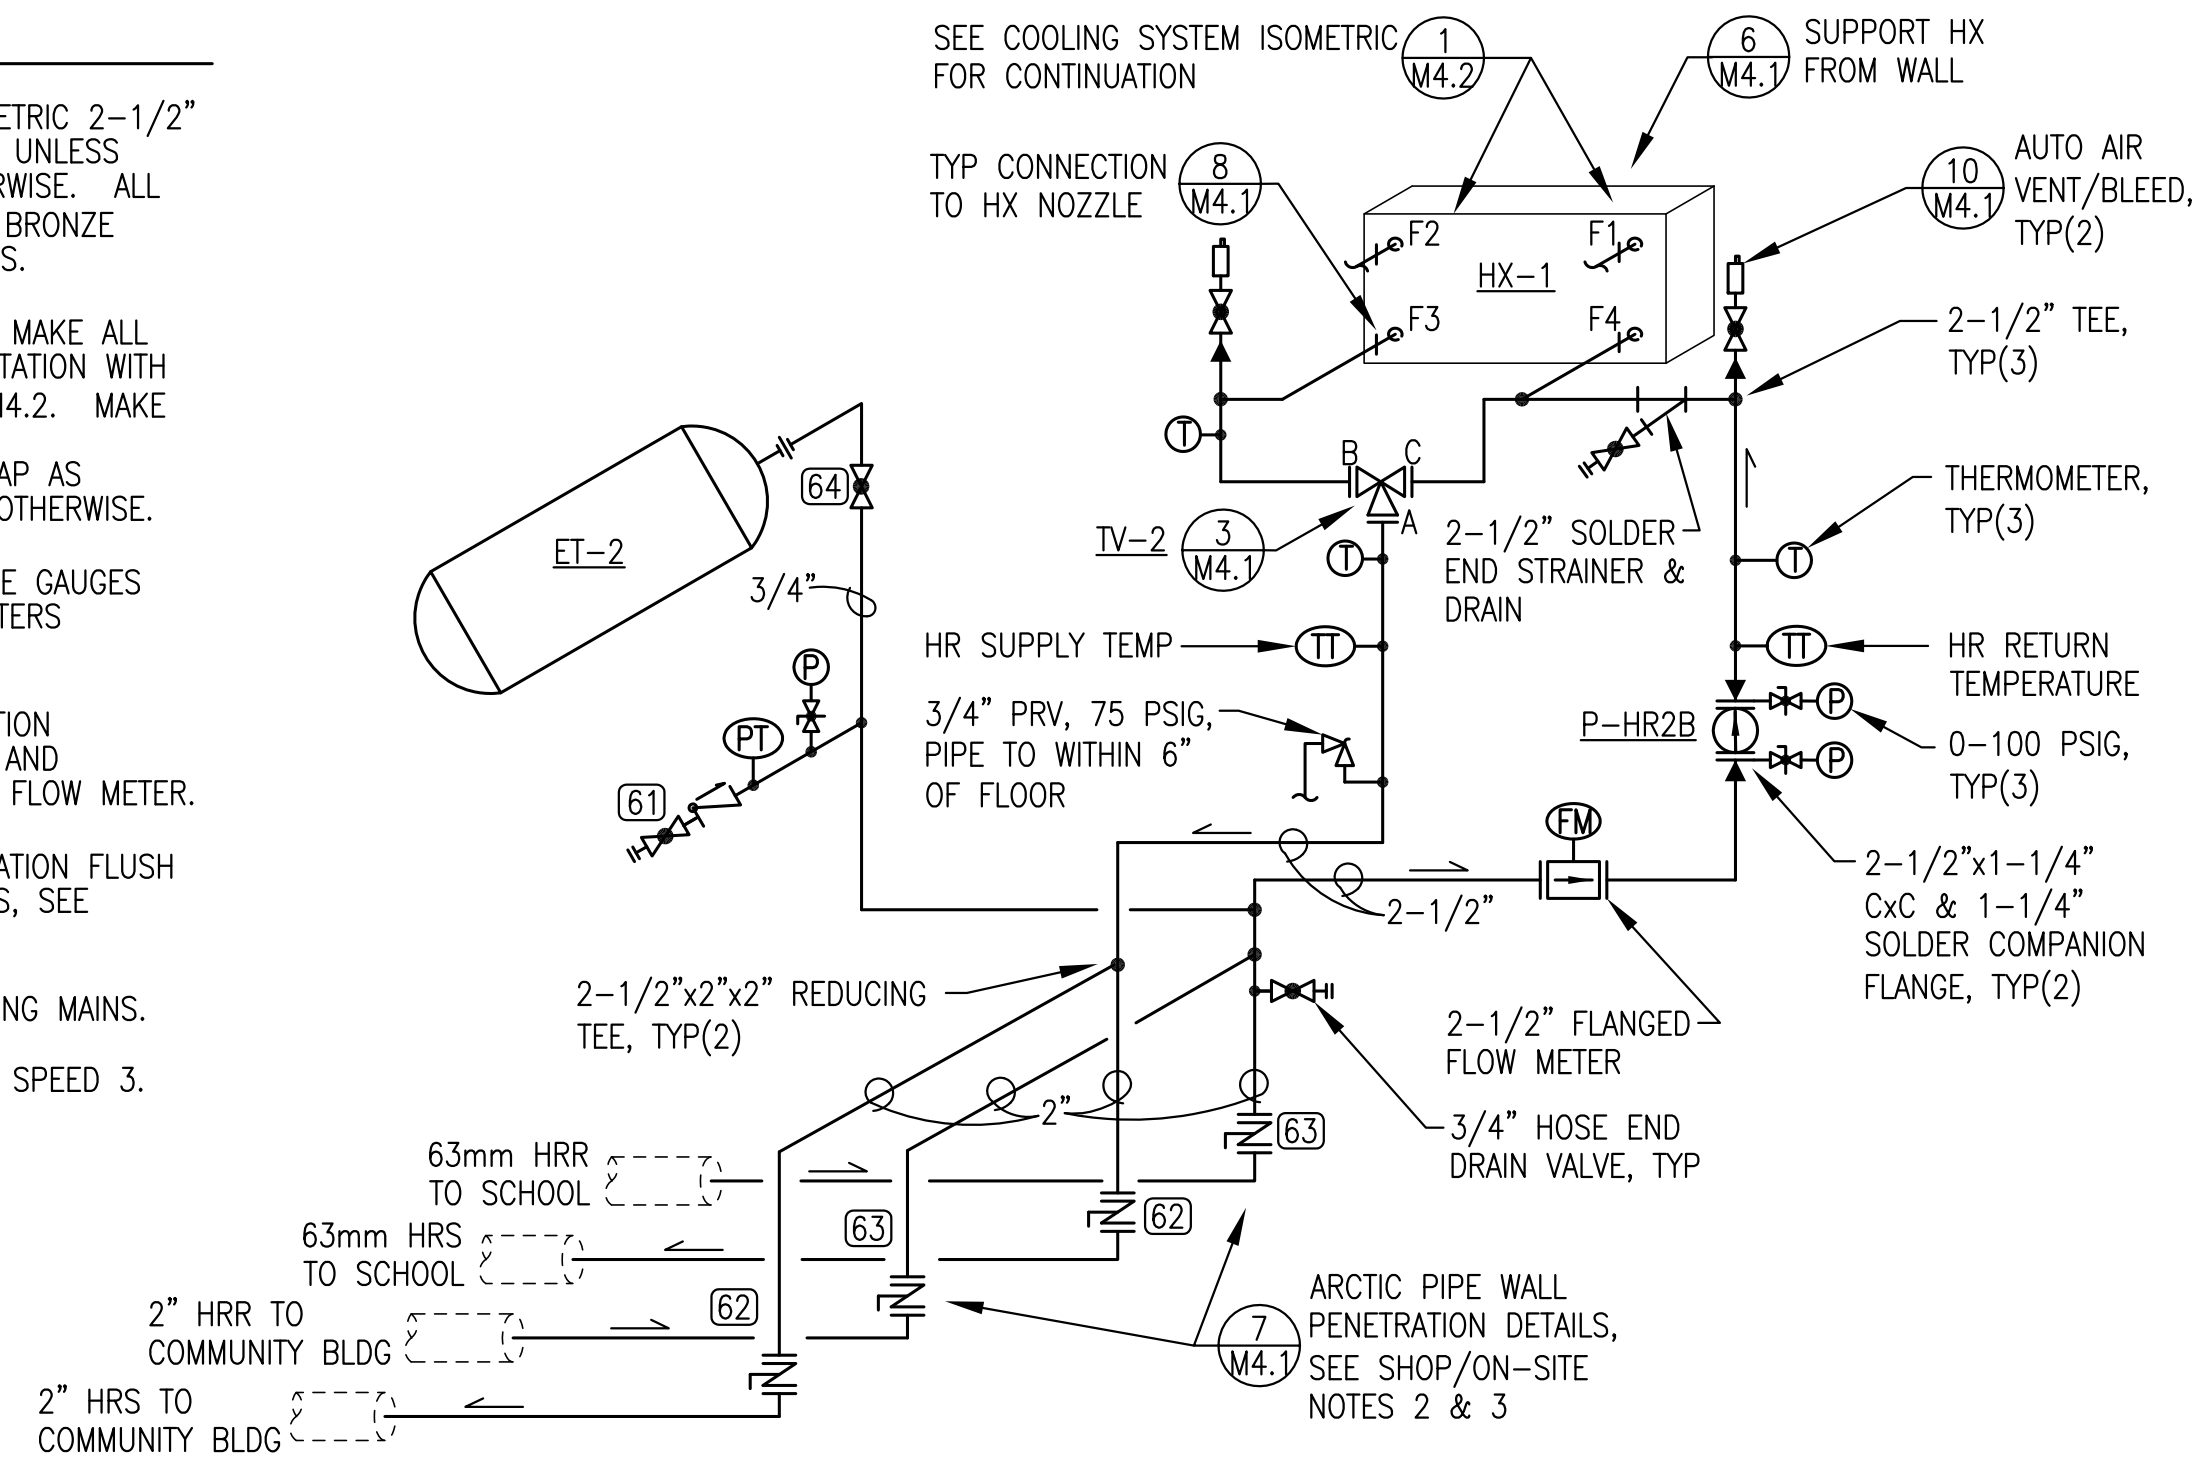

2 HEAT RECOVERY SYSTEM PIPING ISOMETRIC
M4.2 NO SCALE



NOTES:

- 1) USE T-DRILL TAPS AS SHOWN FOR INSTALLATIONS IN 1-1/4" AND LARGER COPPER MAINS. USE LINE SIZE TEE FITTINGS FOR INSTALLING INSTRUMENTATION IN 1" AND SMALLER MAINS. ADJUST ADAPTER AND BUSHING SIZES TO MATCH TEES.
- 2) TEMPERATURE TRANSMITTER INSTALLATION SIMILAR TO THERMOMETER EXCEPT USE 3/4"x1/2" BUSHING.
- 3) FOR MAINS SMALLER THAN 2" USE COPPER TUBE RISER AS SHOWN, LENGTH AS REQUIRED FOR 1" TO 2" WELL INSERTION INTO MAIN. FOR LARGER PIPES OMIT RISER AND INSERT 3/4" FTGXPT ADAPTER INTO T-DRILL TAP.


3 TYPICAL INSTRUMENT INSTALLATION
M4.2 NO SCALE

HYDRONIC PIPING SHOP/ON-SITE NOTES:

- 1) SEE SPECIFICATION 23 11 13 FOR COOLING AND HEAT RECOVERY PIPING TESTING, FLUSHING, DRAINING, AND FILLING REQUIREMENTS.
- 2) SEE DETAILS 4/M3.1 AND 7/M4.1 FOR SPECIFIC REQUIREMENTS FOR PIPING THROUGH THE EXTERIOR WALLS.
- 3) ARCTIC PIPE TO BE INSTALLED AS PART OF THE ON-SITE WORK.

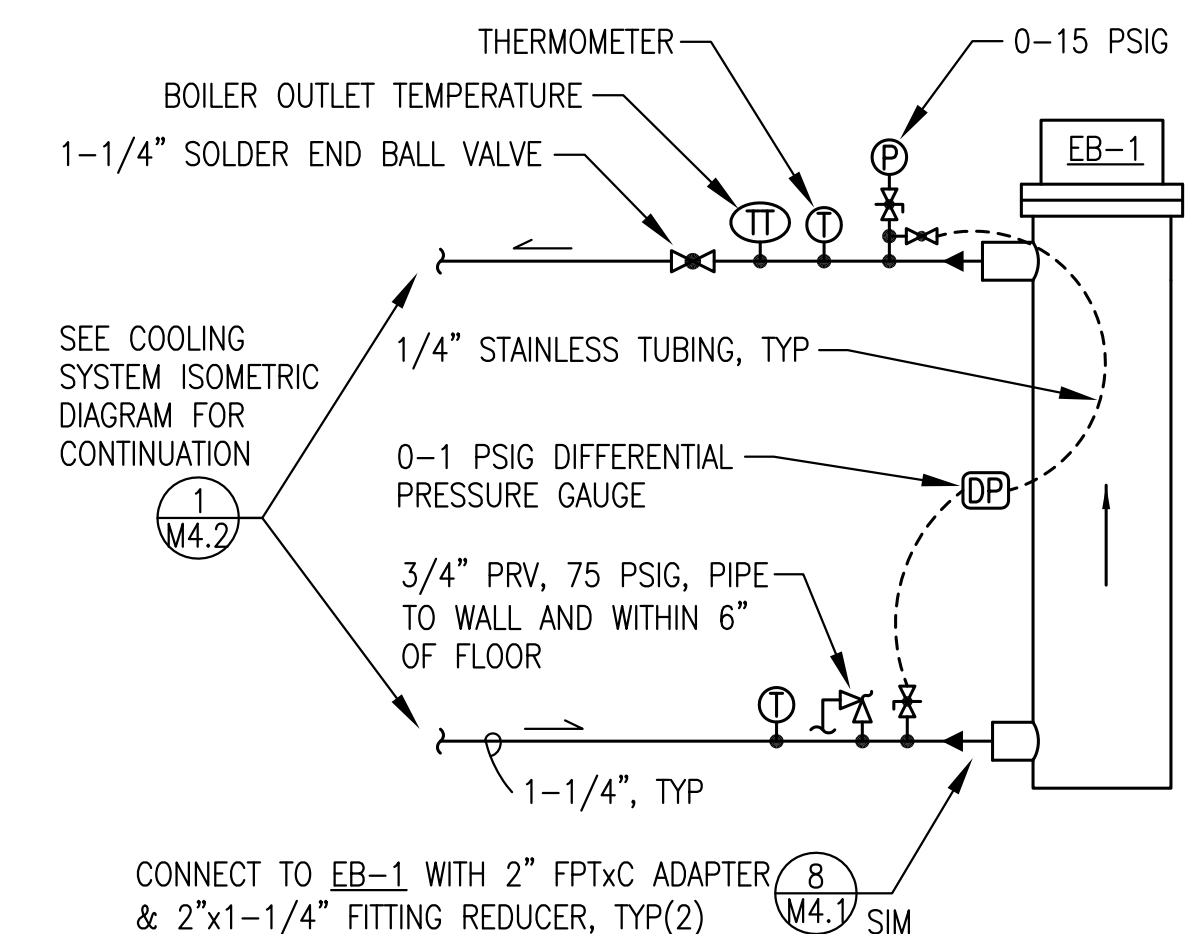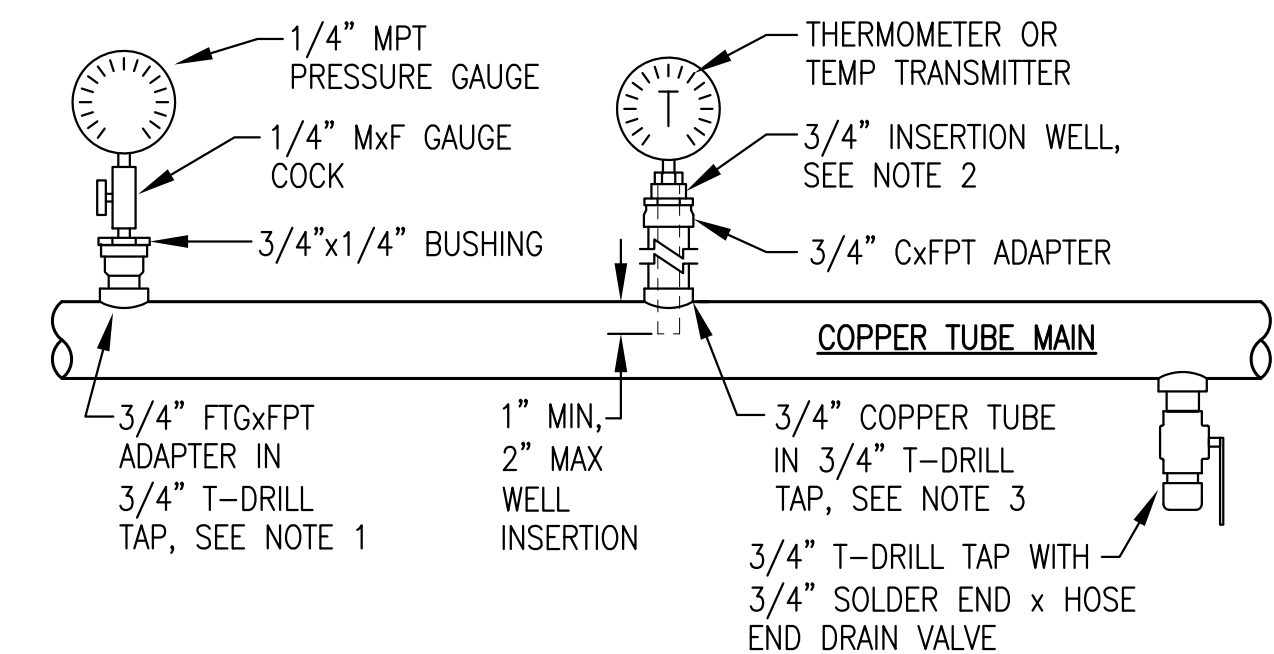

4 ELECTRIC BOILER EB-1 PIPING ISOMETRIC
M4.2 NO SCALE

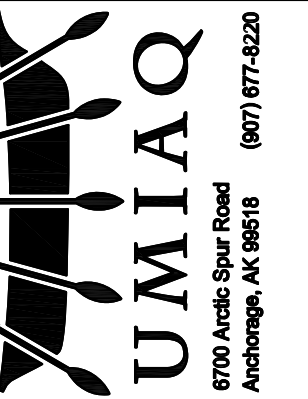


STATE OF ALASKA, AIDEA/AEA
RURAL POWER SYSTEM UPGRADE
CLARKS POINT POWER PLANT
CLARKS POINT, ALASKA

CONSTRUCTION DOCUMENTS

REVISIONS	REV DATE	DESCRIPTION

VERIFY SCALES
0 1"
THIS BAR REPRESENTS ONE INCH ON ORIGINAL DRAWING

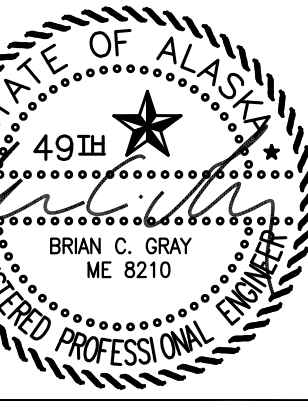


DATE: 1/14/19
DRAWN BY: JTD
CHECKED BY: BCG
JOB NUMBER:

DRAWING TITLE:
COOLANT & HEAT RECOVERY ISOMETRICS & DETAILS

M4.2

SHEET OF 7

ISSUED FOR CONSTRUCTION JANUARY 2019

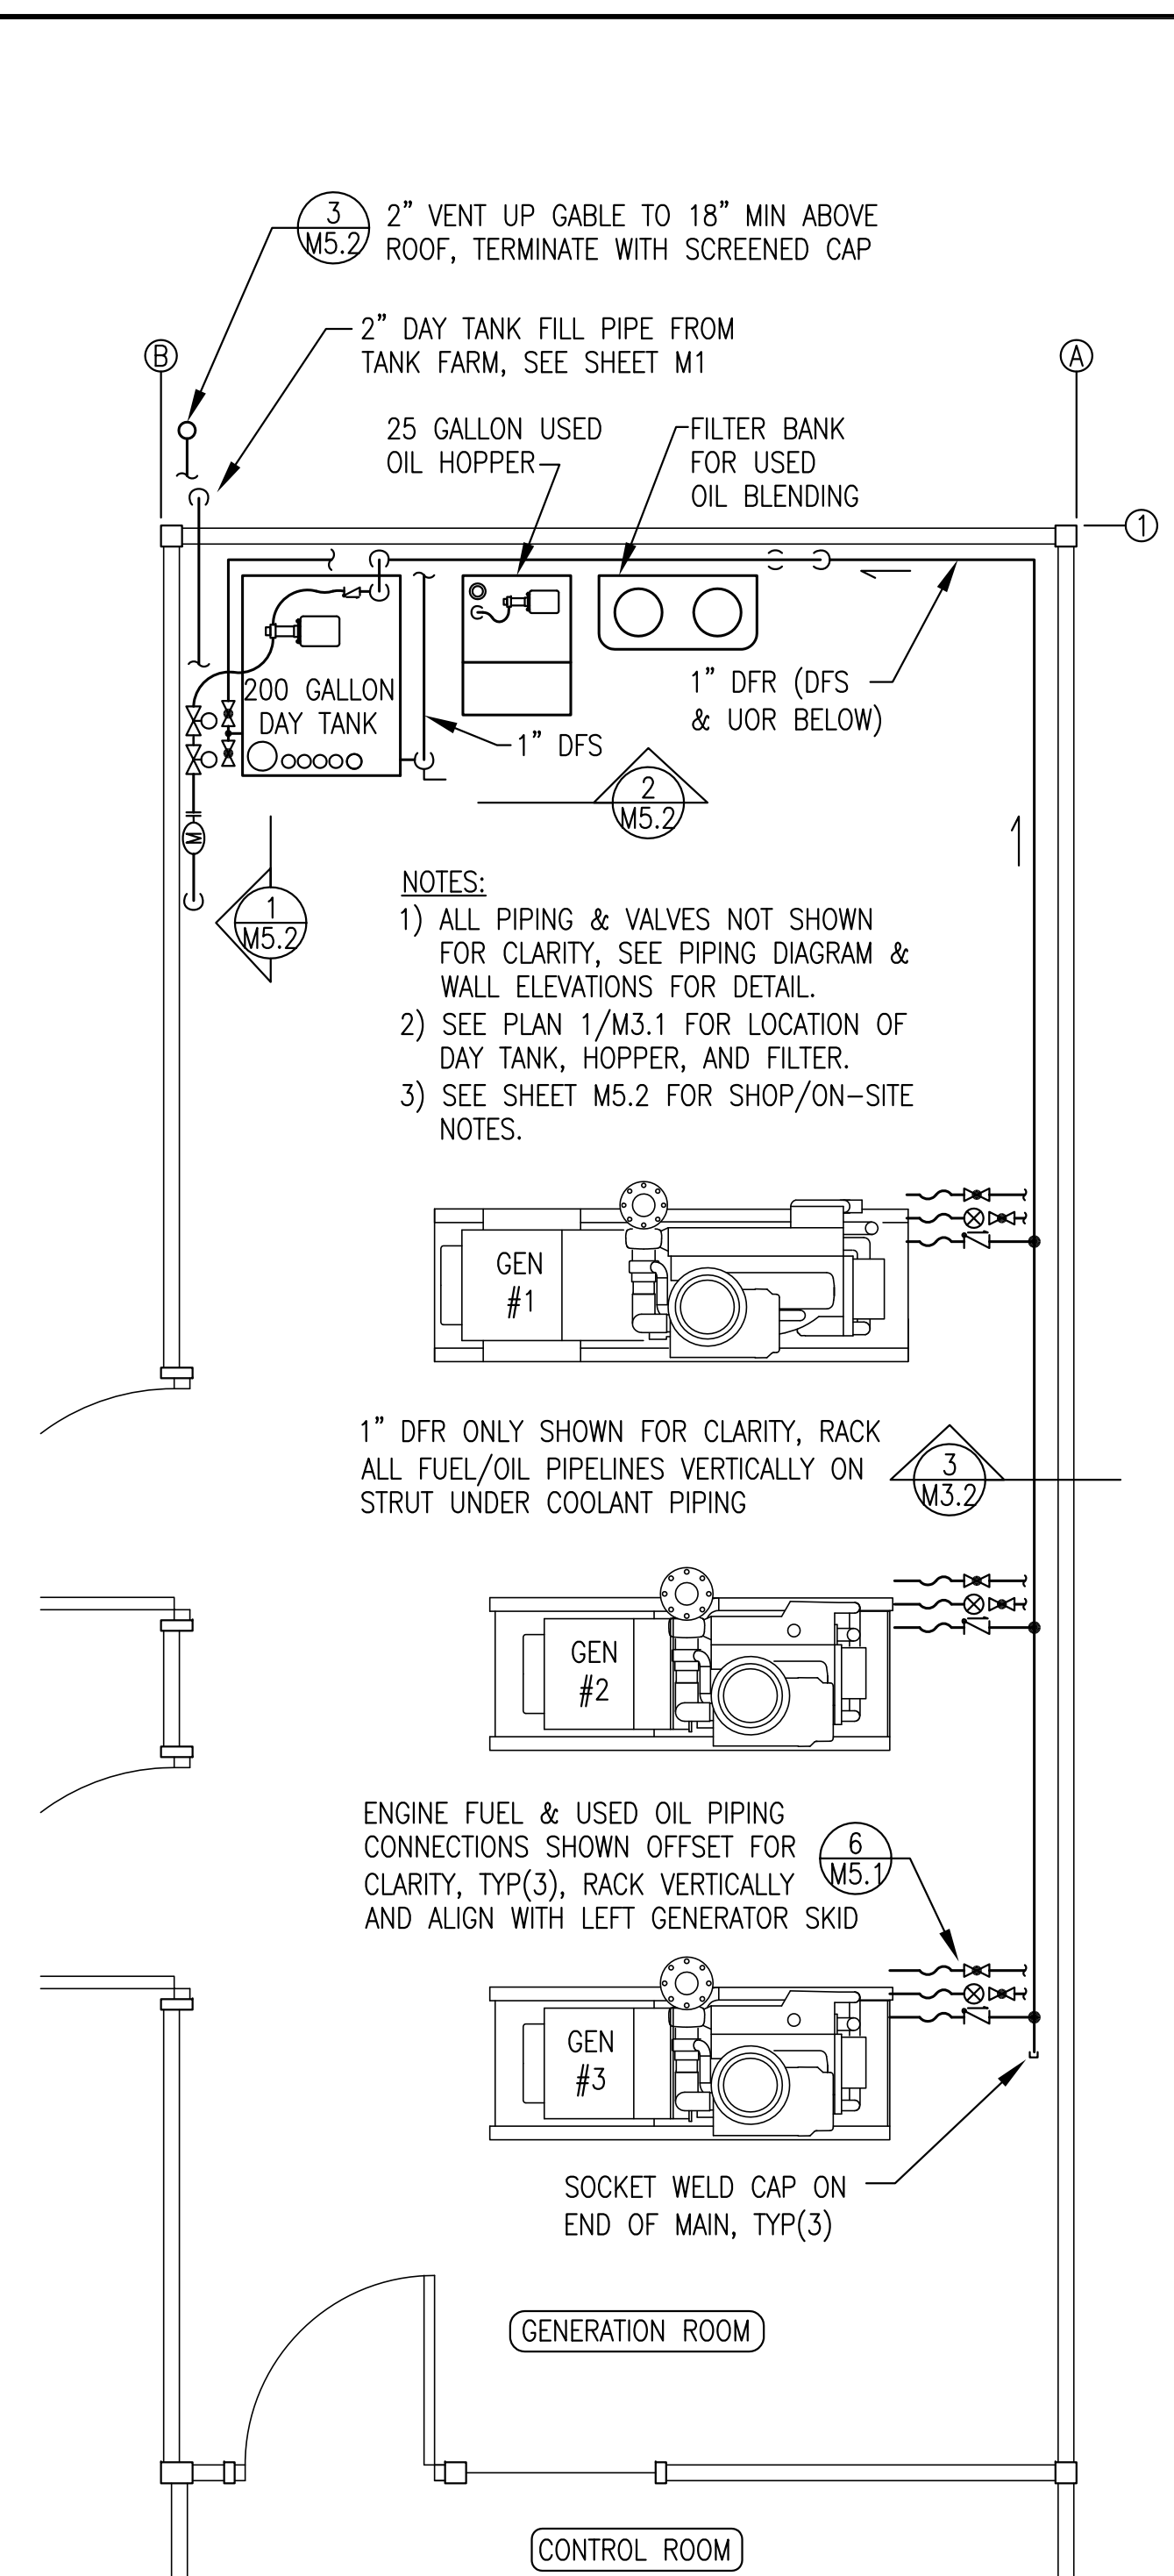


NOTES:
 1) ALL PIPING & VALVES NOT SHOWN FOR CLARITY, SEE PIPING DIAGRAM & WALL ELEVATIONS FOR DETAIL.
 2) SEE PLAN 1/M3.1 FOR LOCATION OF DAY TANK, HOPPER, AND FILTER.
 3) SEE SHEET M5.2 FOR SHOP/ON-SITE NOTES.

1" DFR ONLY SHOWN FOR CLARITY, RACK ALL FUEL/OIL PIPELINES VERTICALLY ON STRUT UNDER COOLANT PIPING

ENGINE FUEL & USED OIL PIPING CONNECTIONS SHOWN OFFSET FOR CLARITY, TYP(3), RACK VERTICALLY AND ALIGN WITH LEFT GENERATOR SKID


SOCKET WELD CAP ON END OF MAIN, TYP(3)

1 DIESEL FUEL SYSTEM & USED OIL PIPING PLAN
 M5.1 3/8"=1"

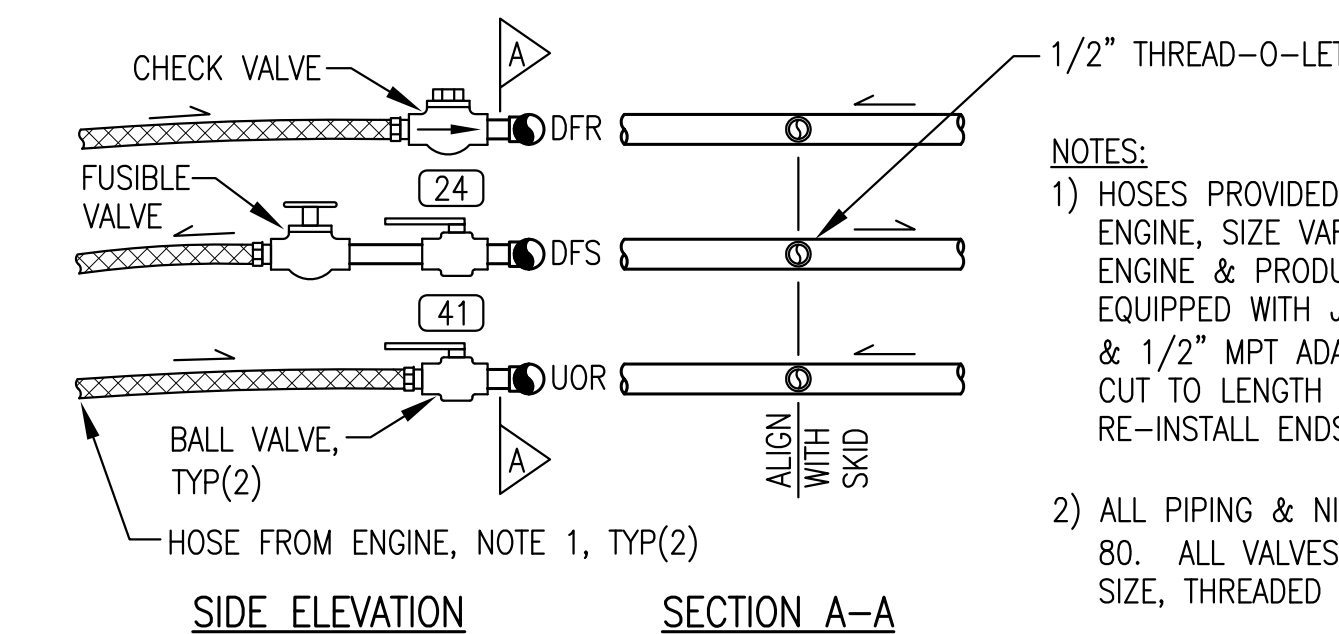

NOTES:
 1) HOSES PROVIDED WITH ENGINE, SIZE VARIES PER ENGINE & PRODUCT. ALL EQUIPPED WITH JIC SWIVELS & 1/2" MPT ADAPTERS. CUT TO LENGTH & RE-INSTALL ENDS.
 2) ALL PIPING & NIPPLES SCH 80. ALL VALVES 1/2" SIZE, THREADED BODY.

6 ENGINE FUEL PIPING CONNECTION
 M5.1 NO SCALE

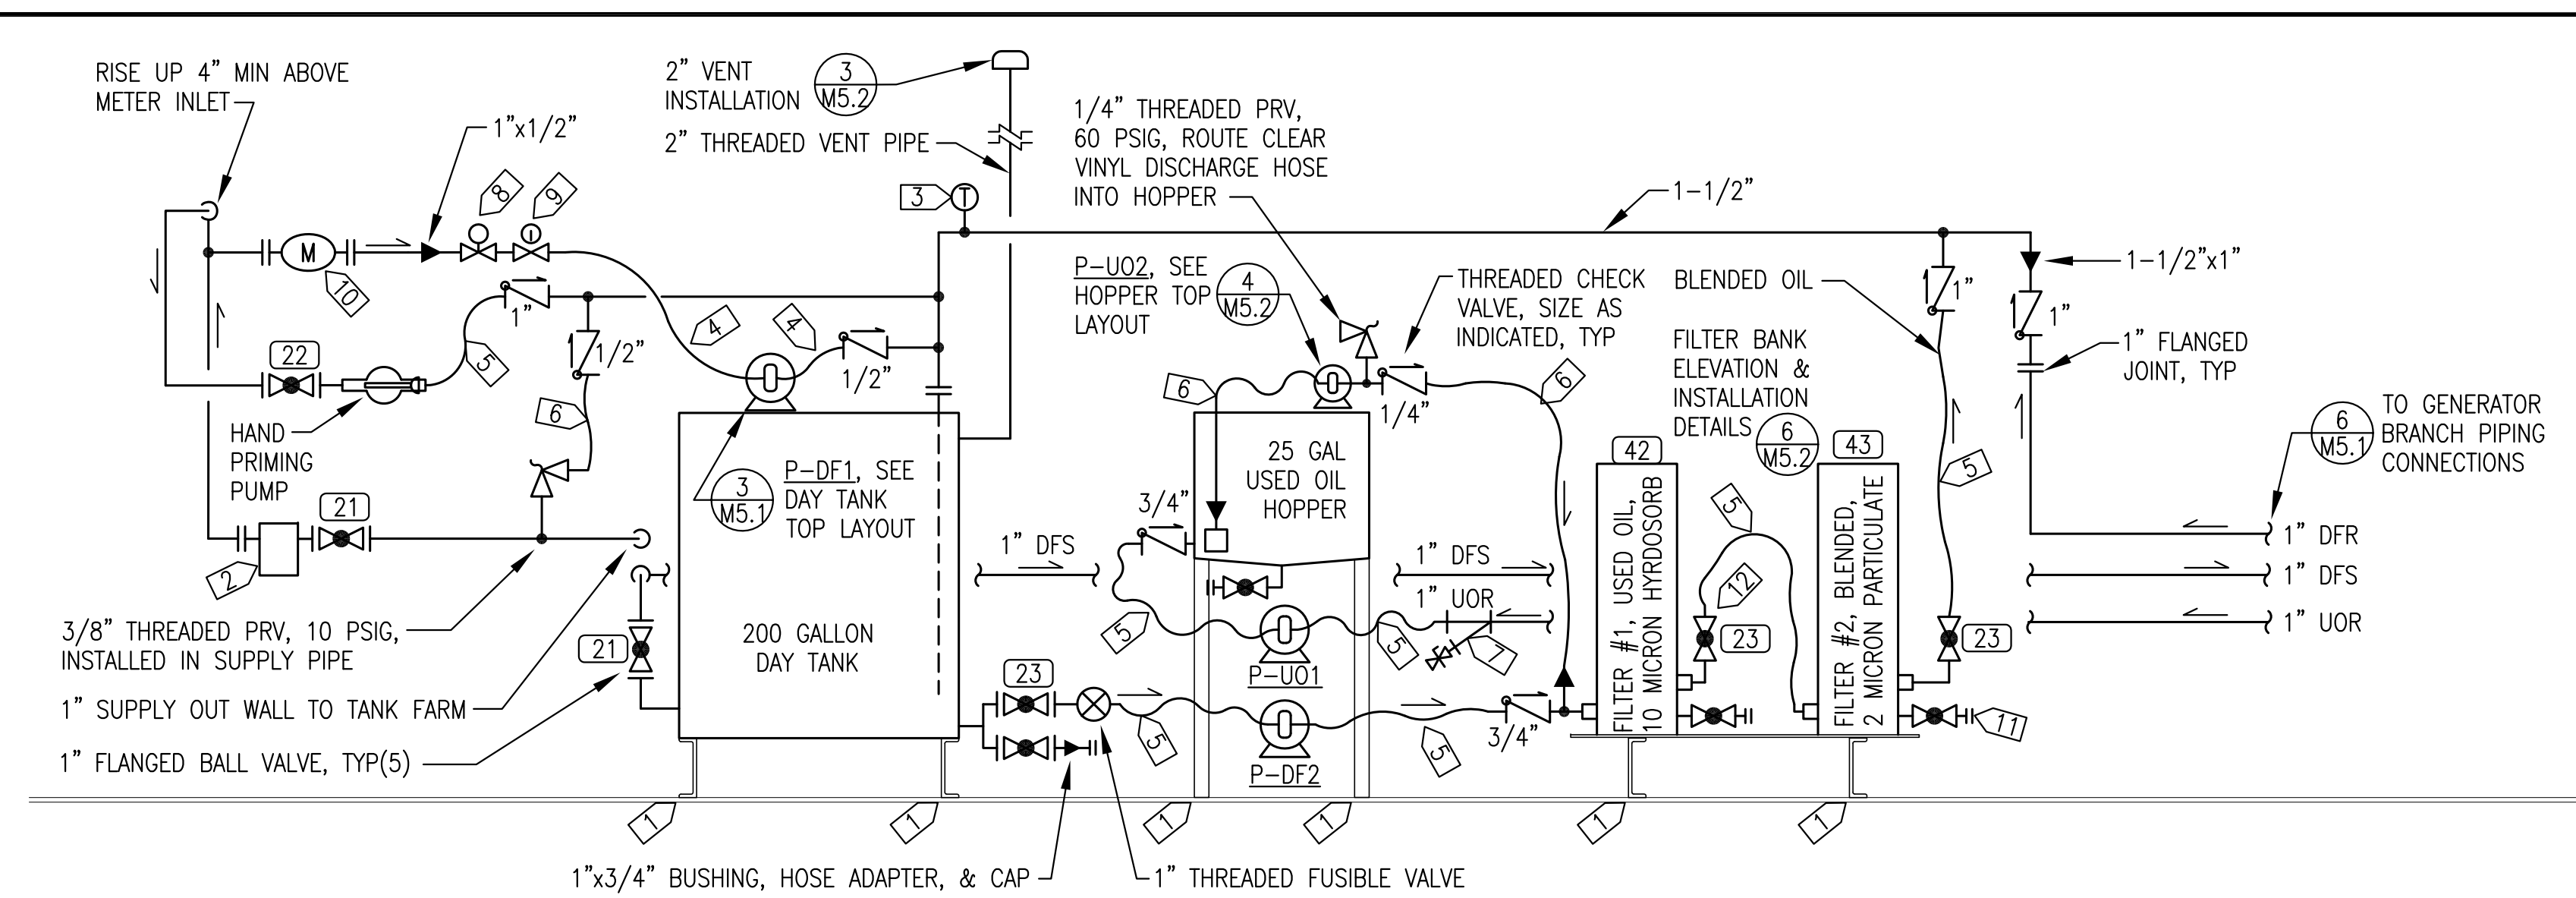


PIPING DIAGRAM SPECIFIC NOTES:

- 1 FASTEN DEVICE TO FLOOR WITH MIN 1"x3/16" FILLET WELD ALL 4 CORNERS, WIRE BRUSH AND RE-PAINT WELD AREA TO MATCH EXISTING.
- 2 1" ANSI 150# FLANGED FILTER F-DI, REMOVE DRAIN VALVE & INSTALL 1/8" MxF DRAIN COCK.
- 3 THERMOMETER, INSTALL WELL IN 3/4" THREAD-O-LET.
- 4 #10 HOSE WITH 1/2" OR 3/4" NPT ENDS.
- 5 #12 HOSE WITH 1/2", 3/4", OR 1" NPT ENDS.
- 6 #6 HOSE WITH 1/8", 1/4", OR 3/8" NPT ENDS.
- 7 1" THREADED STRAINER IN 1" UOR WITH GAUGE COCK BLOW DOWN.
- 8 1/2" NO SOLENOID VALVE.
- 9 1/2" NC SOLENOID VALVE.
- 10 METER M-DI EQUIPPED WITH 300# FLANGED ENDS, PROVIDE 1" ANSI 300# FLANGES & GASKETS, SOCKET WELD ON INLET & THREADED ON OUTLET.
- 11 3/4" THREADED BALL VALVE WITH HOSE ADAPTER & CAP, TYP(3).
- 12 3/4" THREADED BALL VALVE, TYP(2).


PIPING DIAGRAM GENERAL NOTES:

- 1) FABRICATE DAY TANK, FILTER BANK, & HOPPER IN ACCORDANCE WITH FABRICATION PLANS AND DETAILS.
- 2) ALL DAY TANK SUPPLY & RETURN PIPING 1" SCH 80 EXCEPT WHERE INDICATED AS 1-1/2". ALL VENT PIPING 2" SCH 40.
- 3) ALL PIPING JOINTS SOCKET OR BUTT WELD EXCEPT FOR THREADED VENT & CONNECTIONS TO EQUIPMENT & VALVES.
- 4) ON ALL HOSES INSTALL JIC/NPT SWIVEL ENDS, SIZE REQUIRED TO MATCH PIPING OR PUMPS


2 DIESEL FUEL & USED OIL PIPING DIAGRAM
 M5.1 NO SCALE

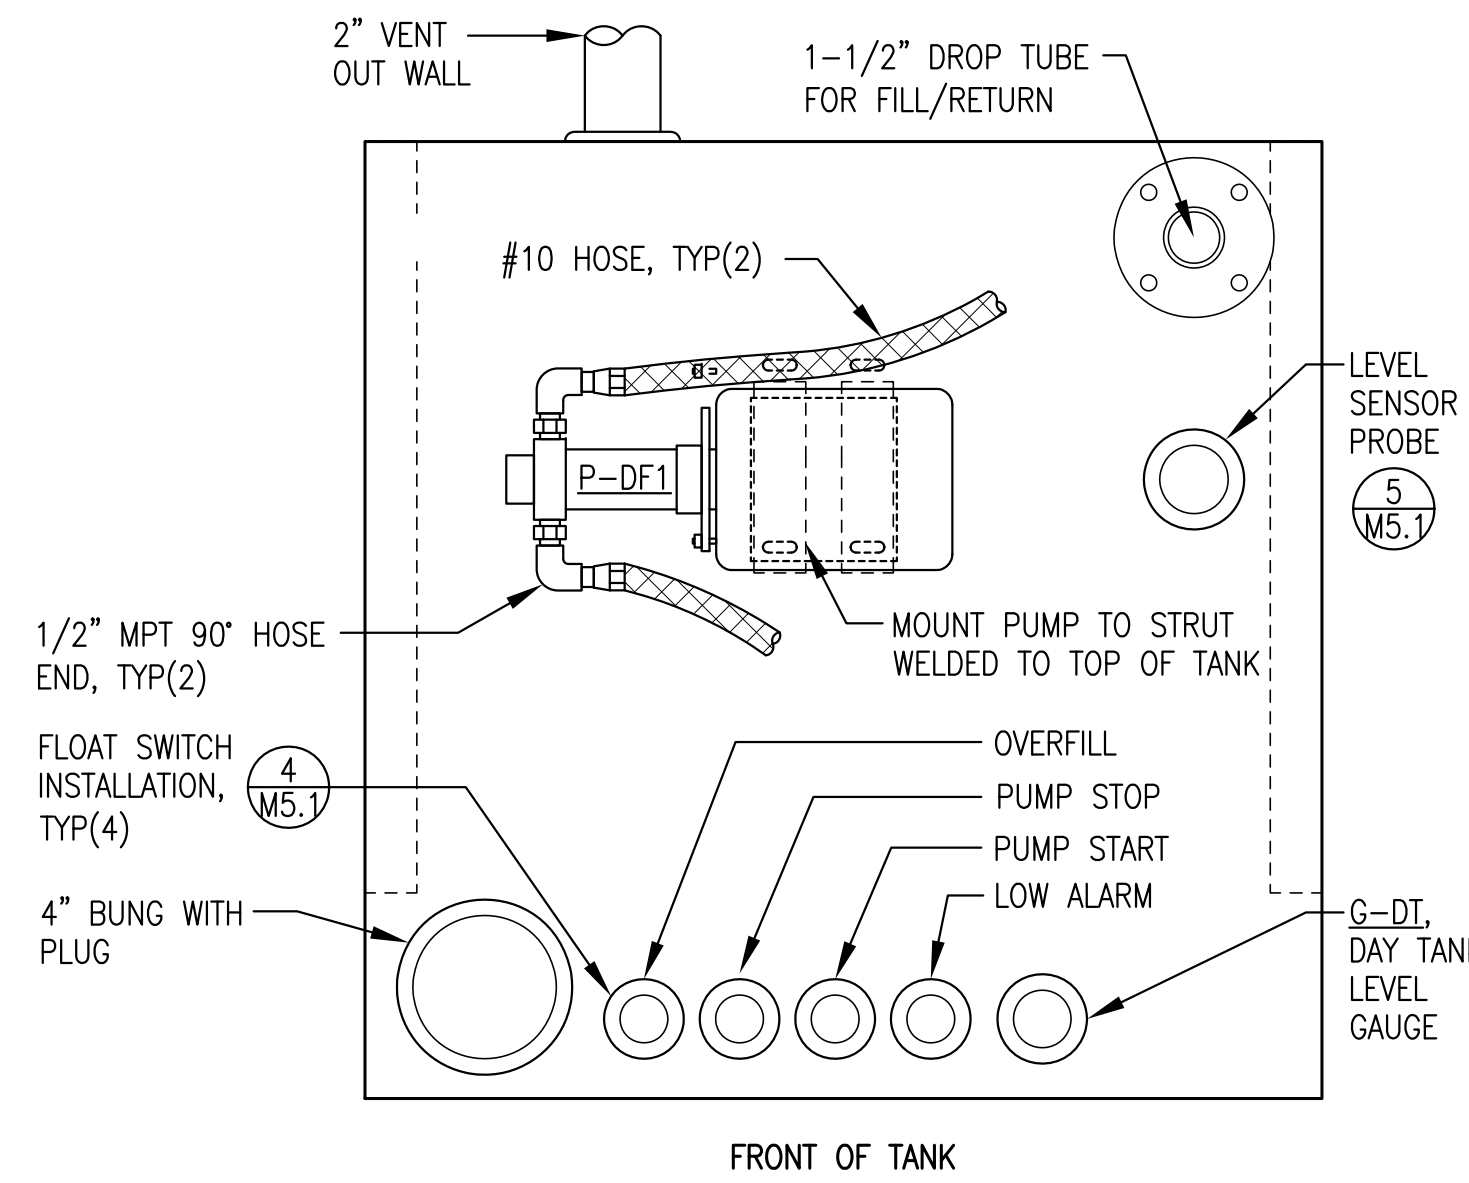

3 TOP OF DAY TANK - PLAN VIEW
 M5.1 NO SCALE

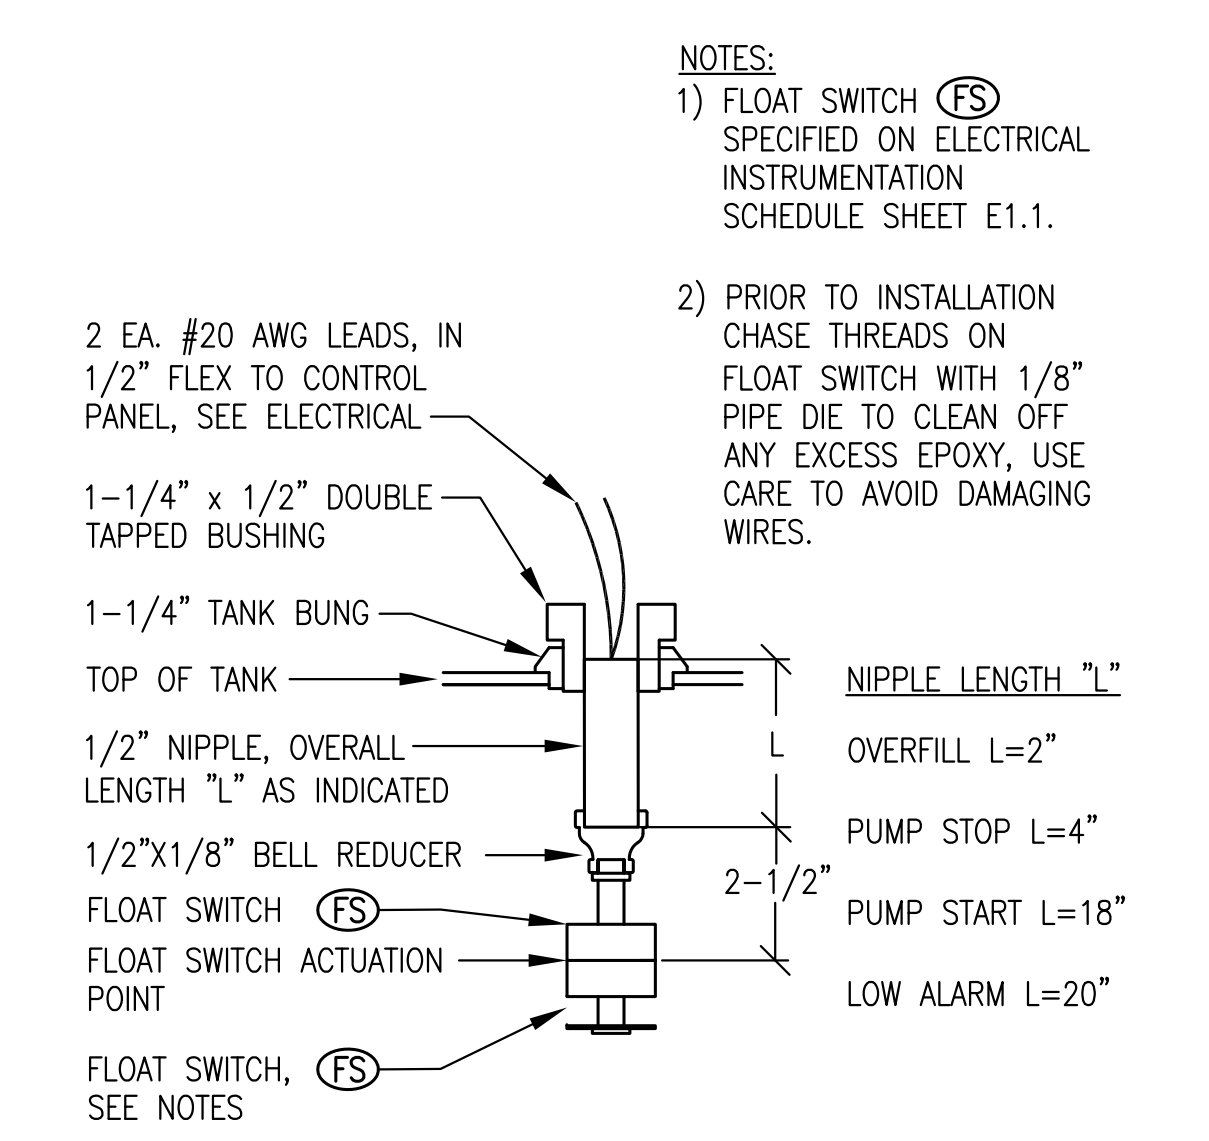

4 DAY TANK FLOAT SWITCH INSTALLATION
 M5.1 NO SCALE

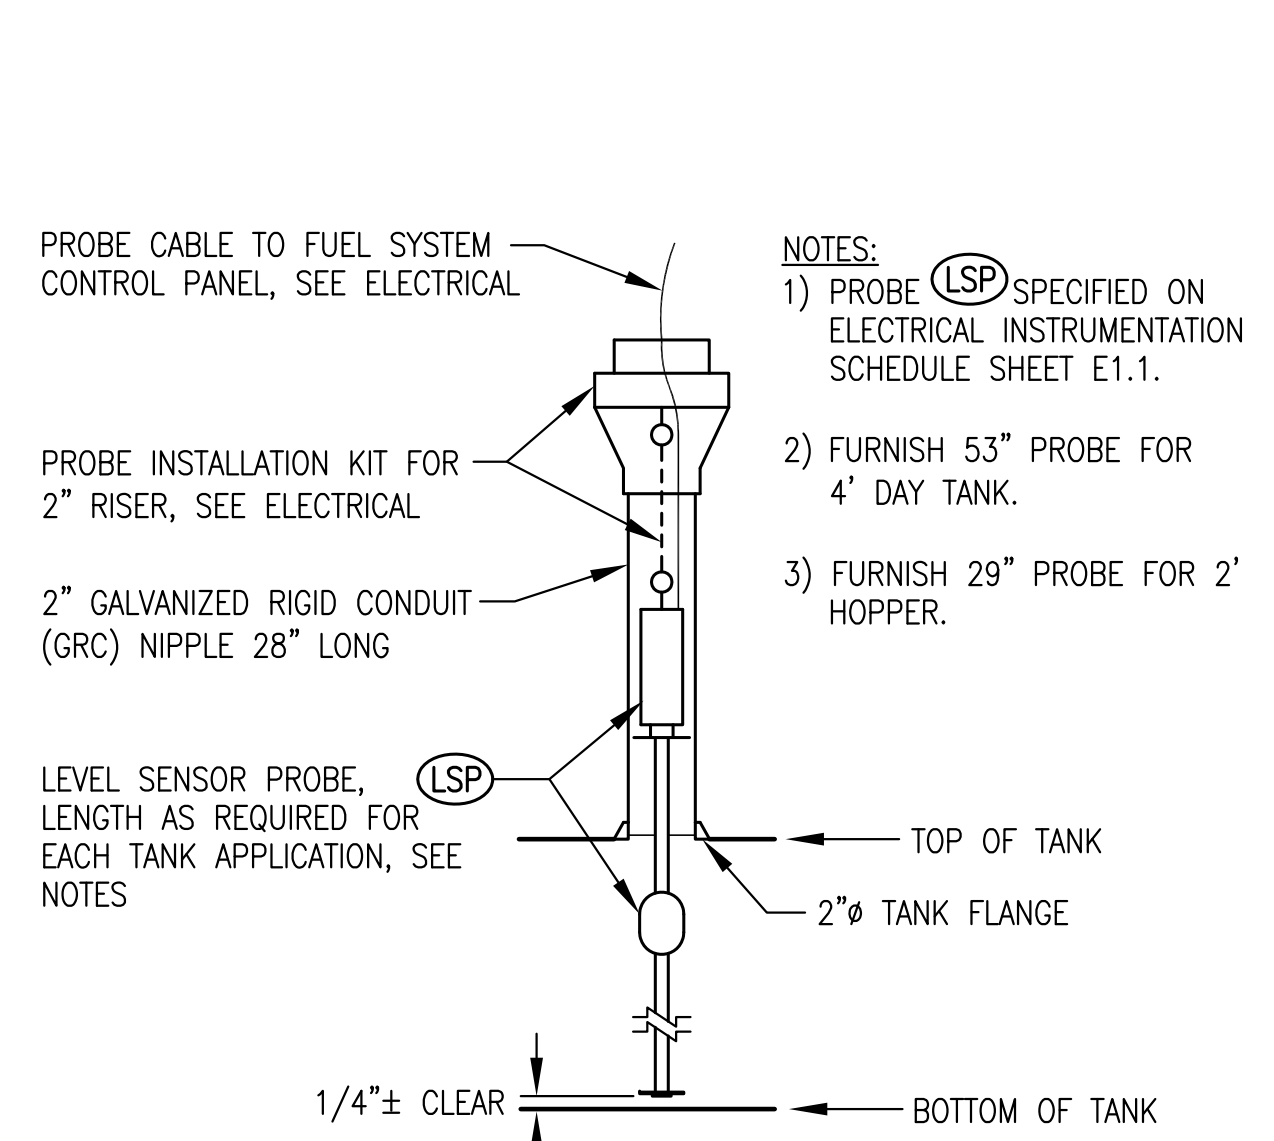

5 TYPICAL LEVEL SENSOR PROBE INSTALLATION
 M5.1 NO SCALE

UMIAQ
 6700 Arctic Spur Road
 Anchorage, AK 99518
 (907) 977-8220


Gray Stassel Engineering, Inc.
 P.O. 111405
 Anchorage, AK 99511
 (907) 949-0100

STATE OF ALASKA, AIDEA/AEA RURAL POWER SYSTEM UPGRADE

CLARKS POINT POWER PLANT
 CLARKS POINT, ALASKA

REVISIONS	DESCRIPTION


VERIFY SCALES
 0 1" THIS BAR REPRESENTS ONE INCH ON ORIGINAL DRAWING

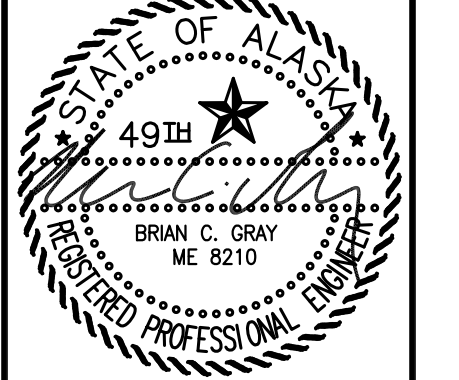

DATE: 1/14/19
 DRAWN BY: JTD
 CHECKED BY: BCG
 JOB NUMBER:

DRAWING TITLE:
 DIESEL FUEL & USED OIL PIPING PLAN, DIAGRAM & DETAILS


ISSUED FOR CONSTRUCTION JANUARY 2019

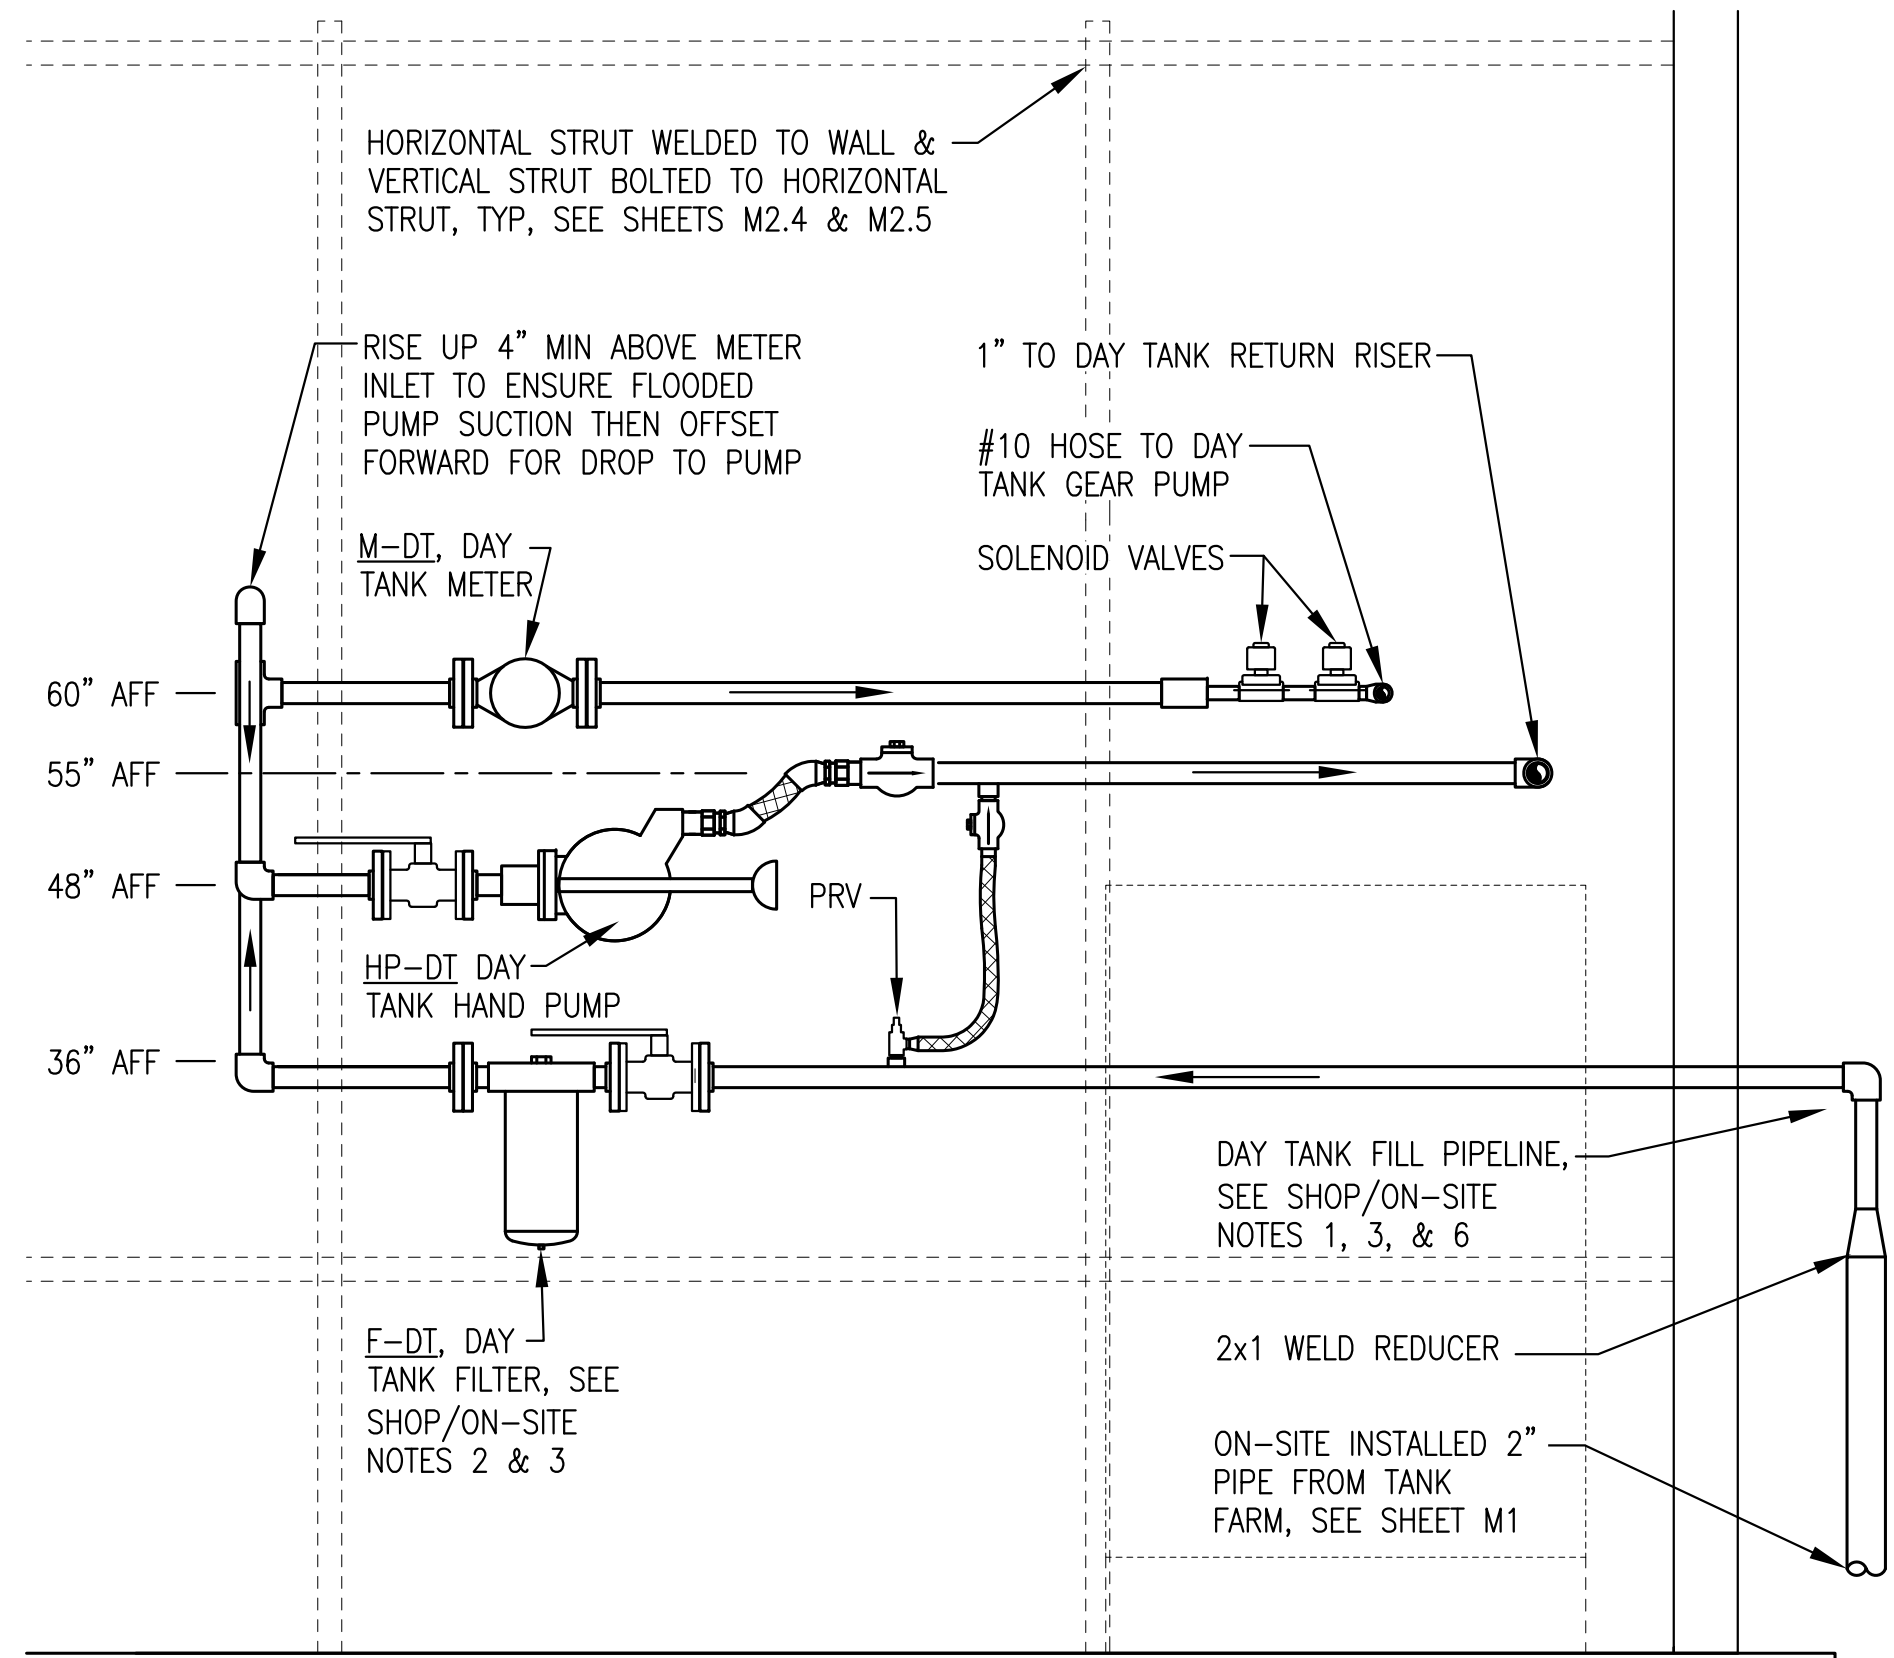


1 DIESEL FUEL FRONT WALL ELEVATION
M5.1 1"=1"

MODULE SHOP/ON-SITE NOTES:


1. DURING SHOP FABRICATION STUB DAY TANK FILL PIPE 8" MIN BEYOND WALL & TERMINATE WITH 1" MALE THREAD FOR TESTING.
2. UPON COMPLETION OF TESTING, DRAIN & REMOVE FILTER & STORE IN MODULE. SLIDE PIPE OVER & SECURE FOR SHIPPING.
3. AS PART OF ON-SITE INSTALLATION REINSTALL FILTER THEN CUT THREADS OFF END OF EXTERIOR PIPE & INSTALL SOCKET WELD ELBOW.
4. DURING SHOP FABRICATION INSTALL TEMPORARY VENT PIPE OUT WALL. REMOVE TEMP PIPE FOR SHIPPING.
5. AS PART OF ON-SITE INSTALLATION INSTALL 2" GALVANIZED THREADED VENT PIPE OUT WALL & UP TO VENT, SEE DETAIL 3/M5.2.
6. DURING SHOP FABRICATION HOLE SAW 1/2" OVERSIZE OPENING THEN SEAL FOR SHIPPING AFTER REMOVING PIPE. UPON FINAL ON-SITE ASSEMBLY SEAL 1" PIPE TO EXTERIOR WALL WITH POLYURETHANE CAULKING & INSTALL FLASHING ON 2" VENT, SEE DETAIL 9/M4.1.

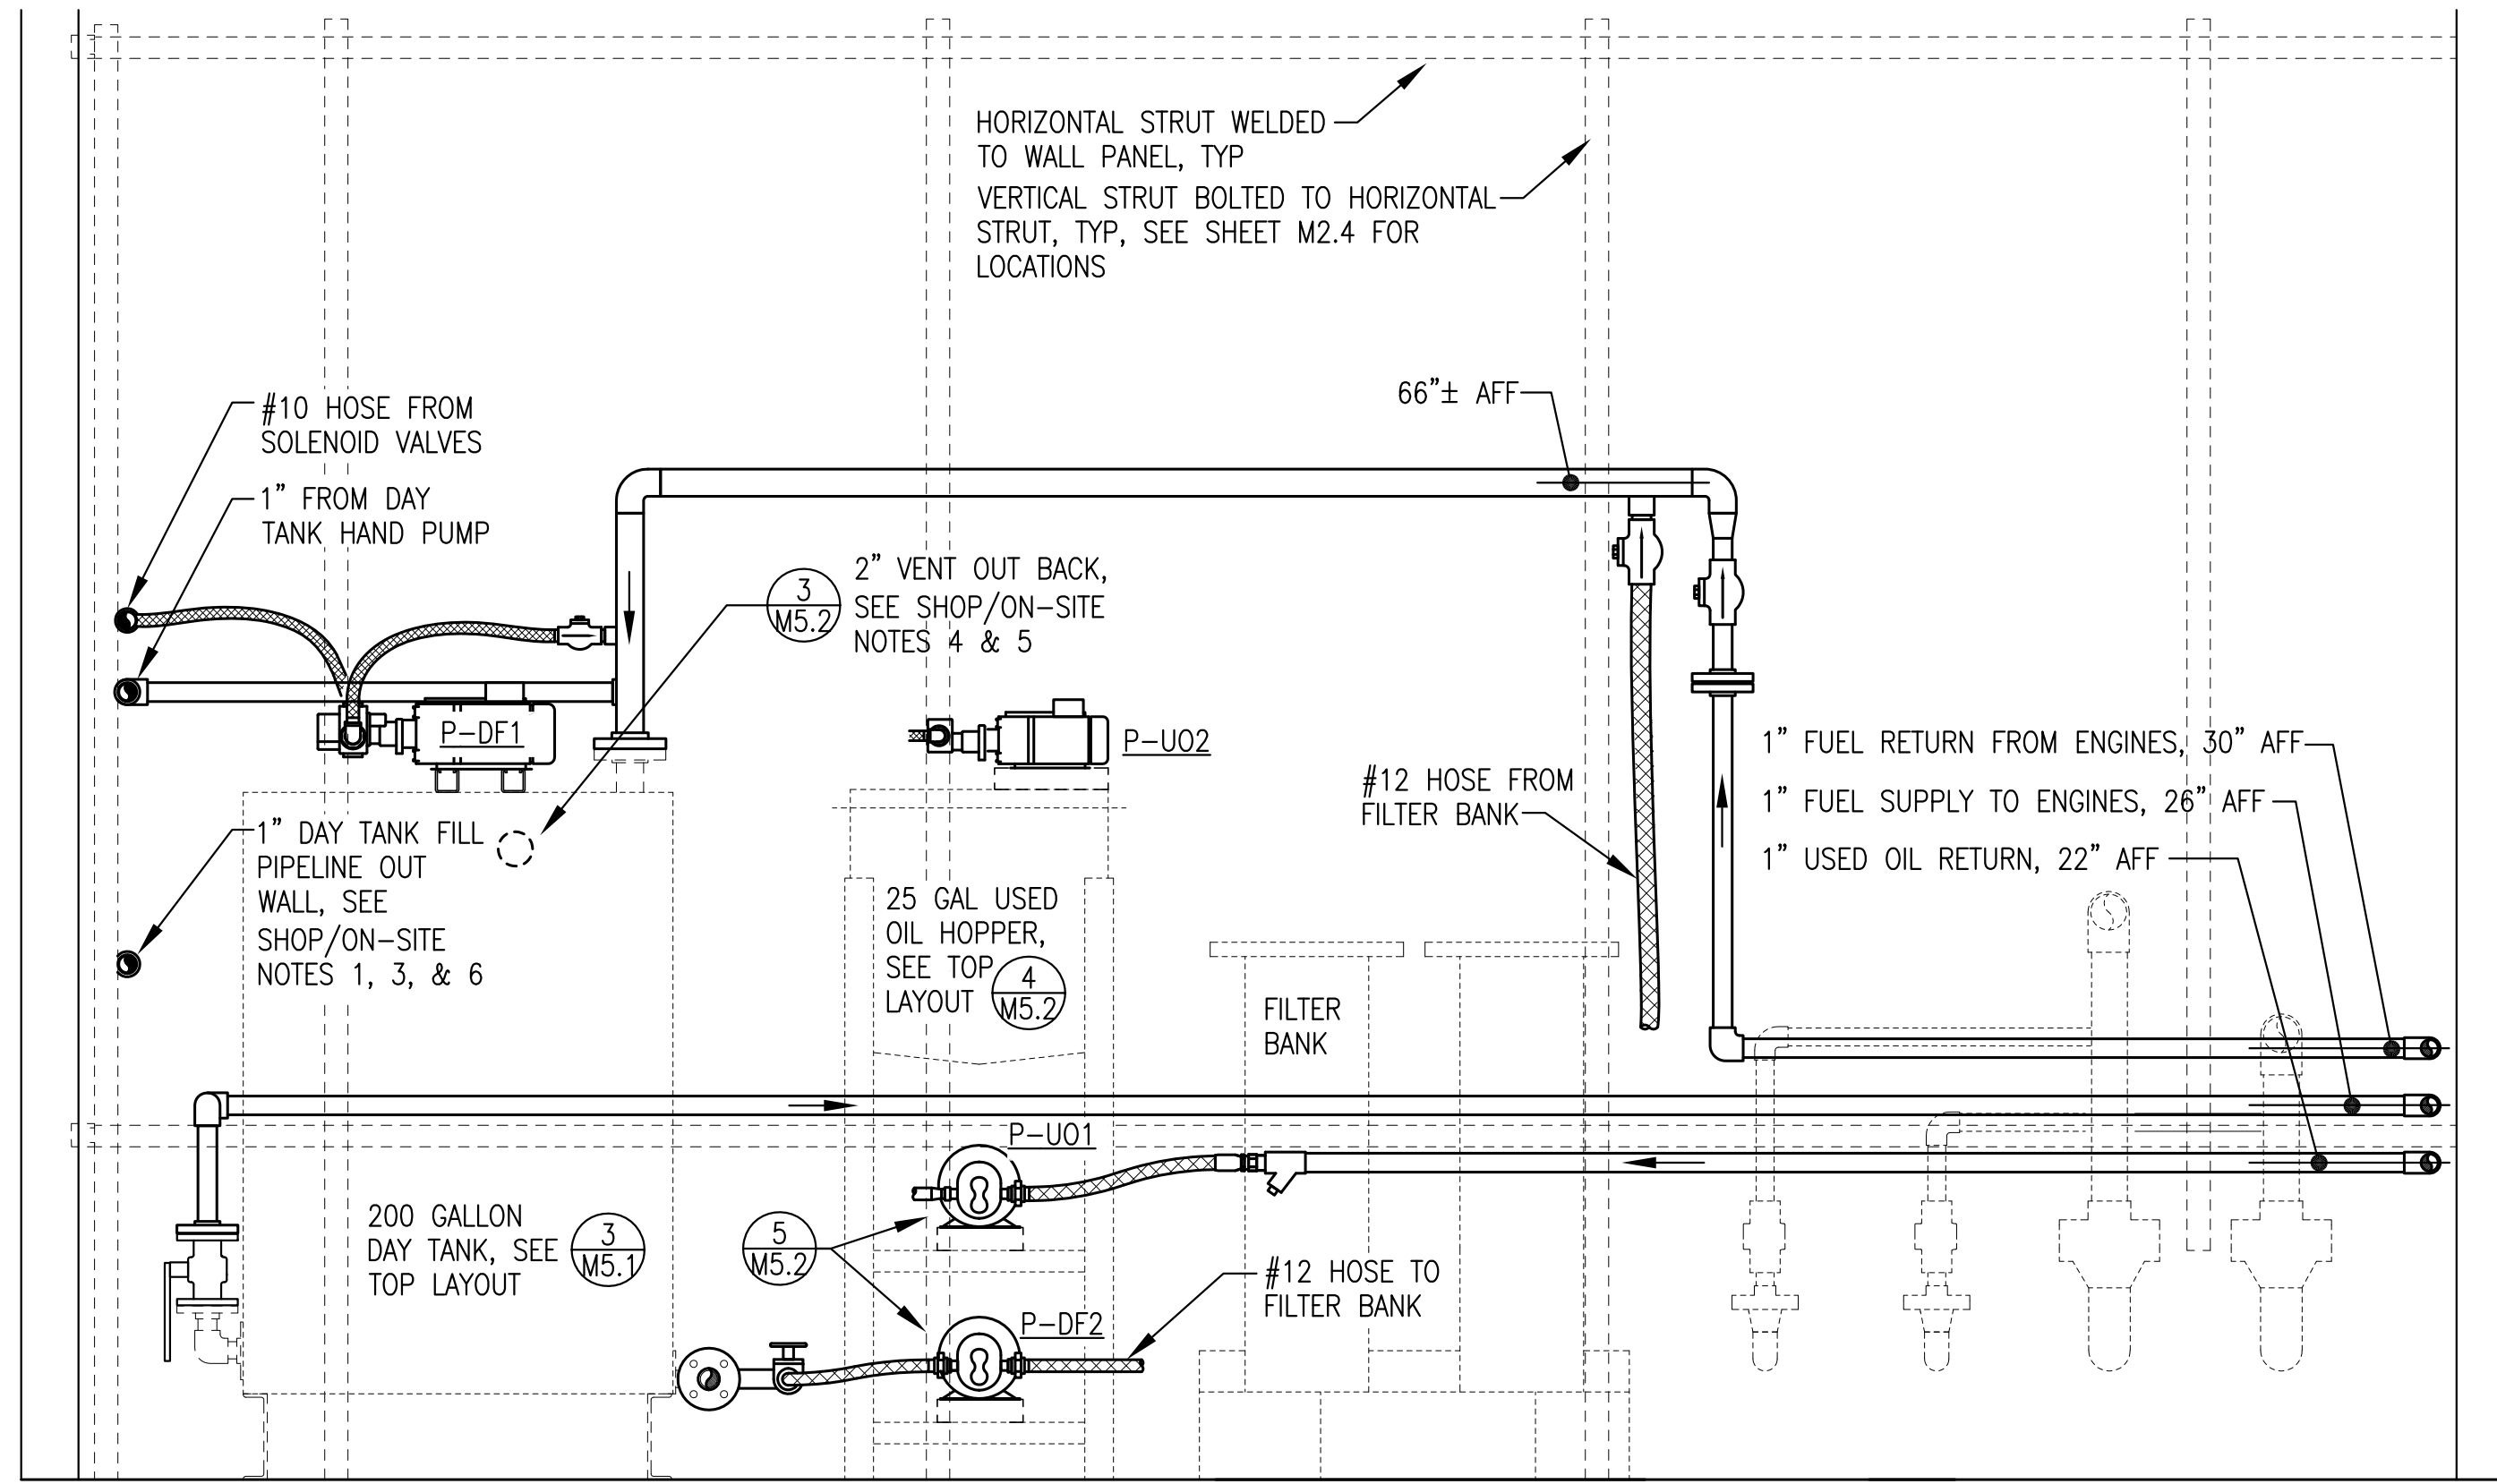


2 DIESEL FUEL & USED OIL END WALL ELEVATION
M5.2 1"=1"

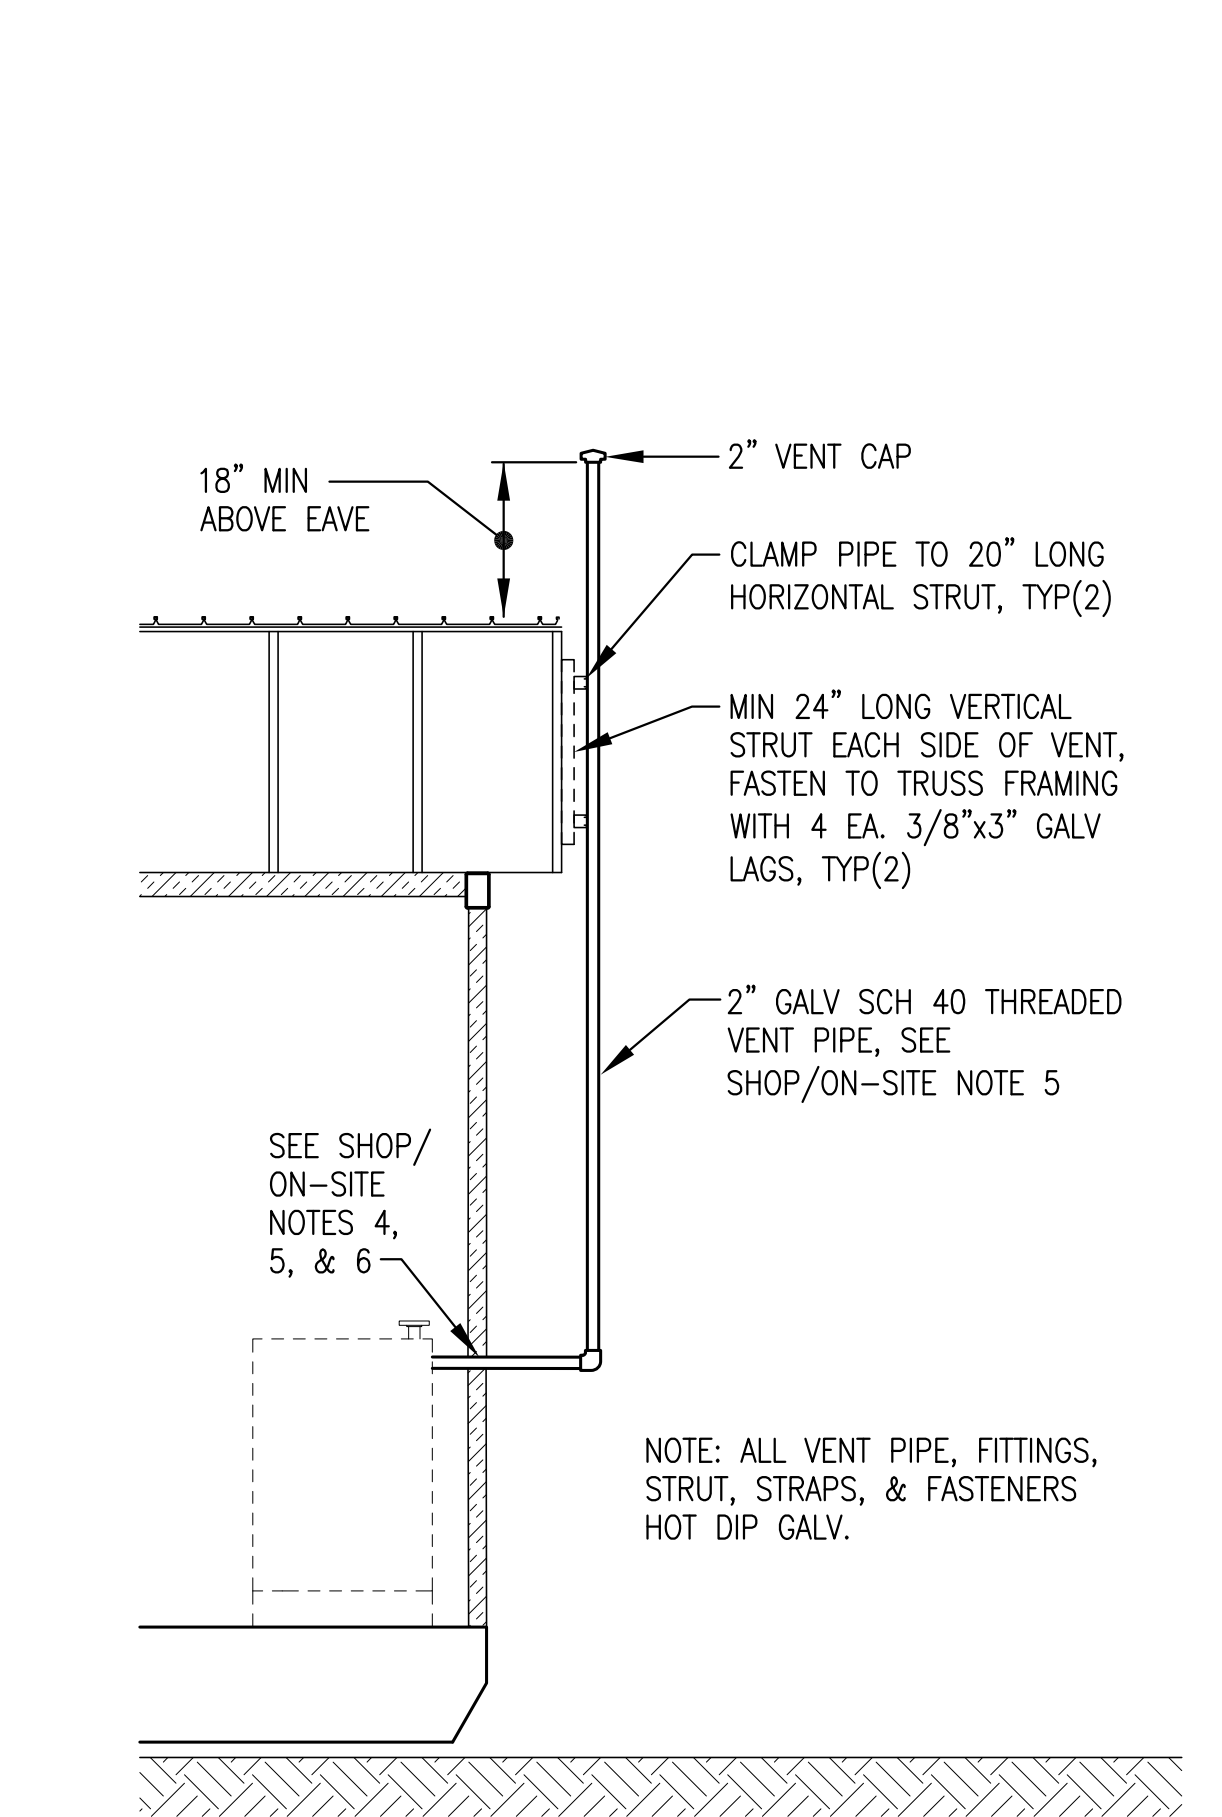


3 DAY TANK VENT INSTALLATION
M5.2 3/8"=1'-0"

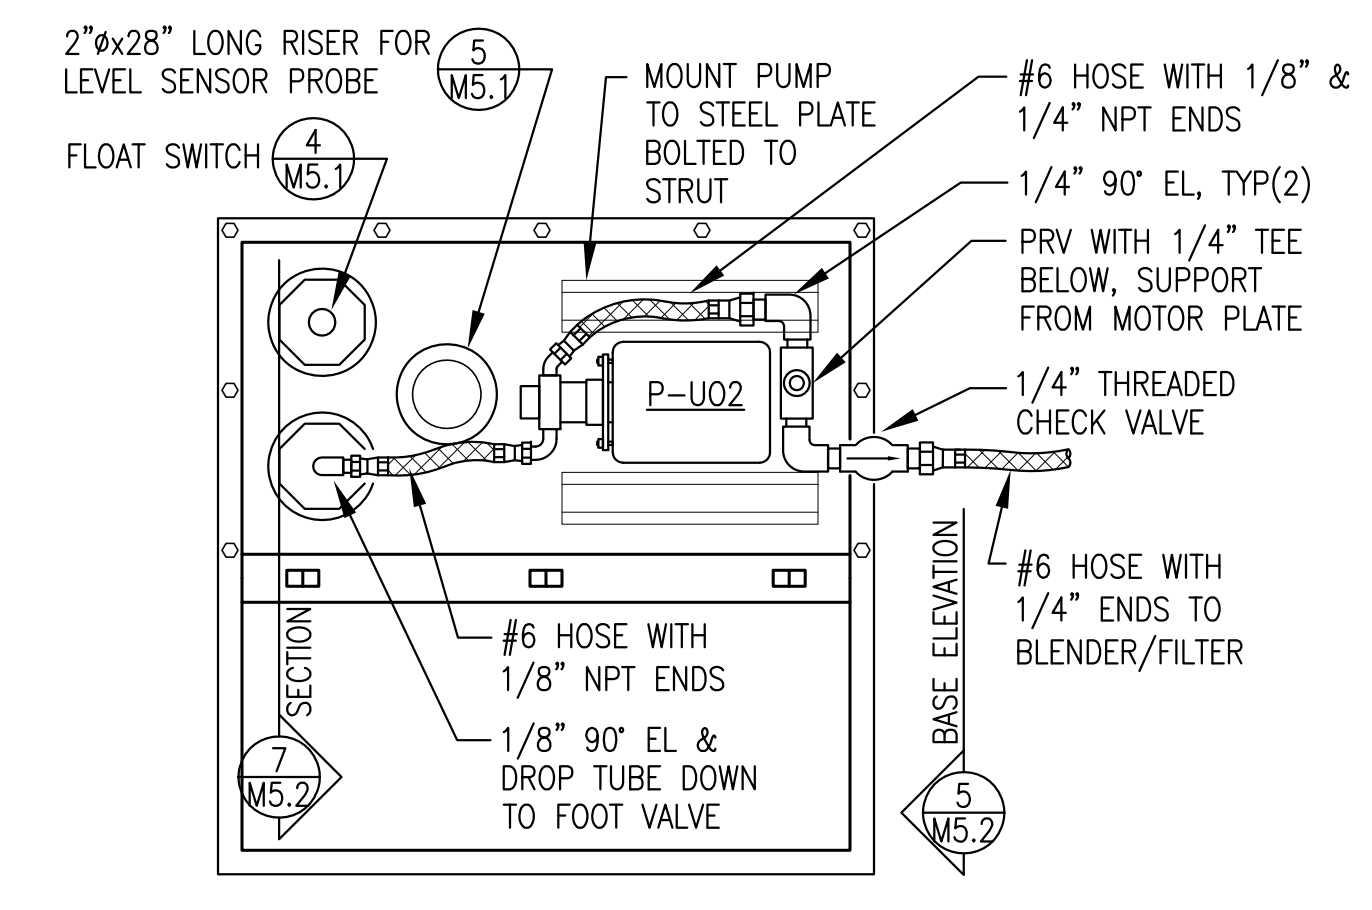


4 TOP OF HOPPER - PLAN VIEW
M5.2 NO SCALE

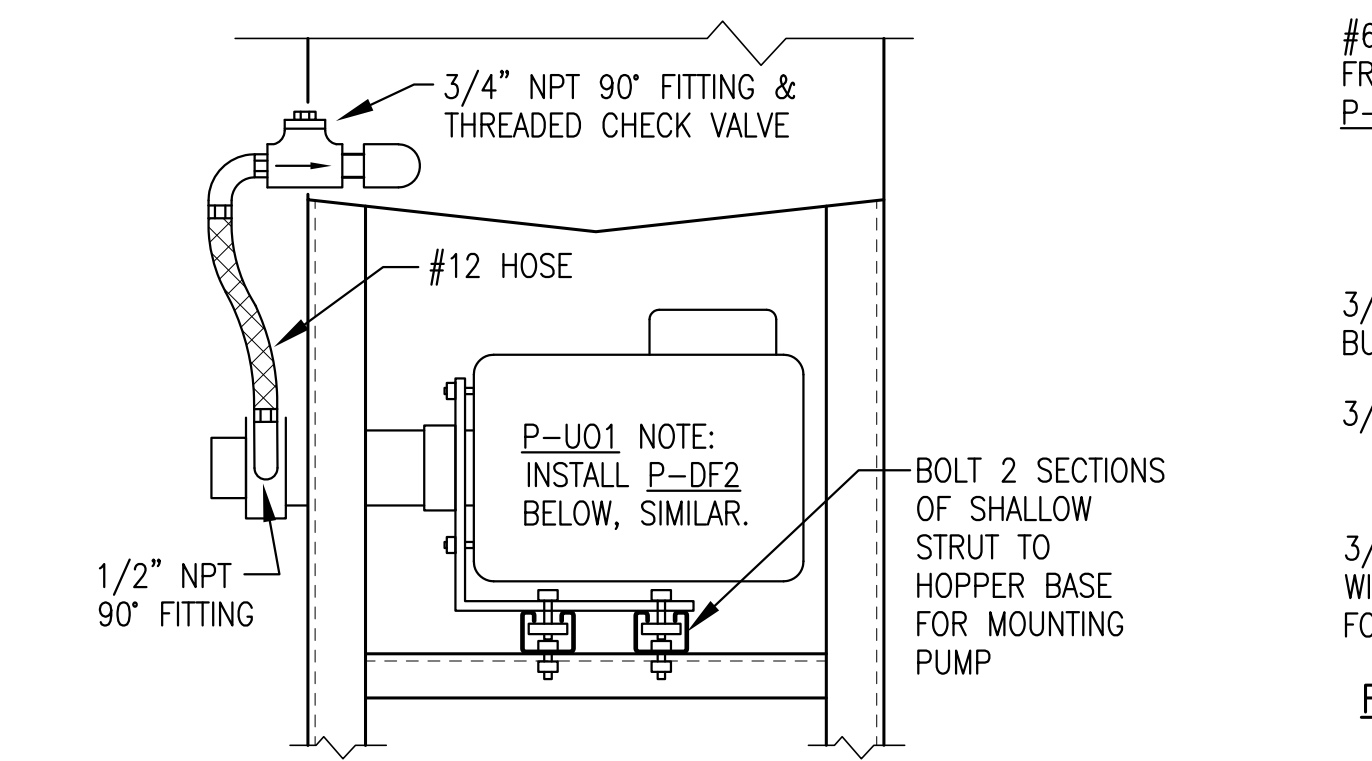

5 HOPPER BASE ELEVATION
M5.2 NO SCALE

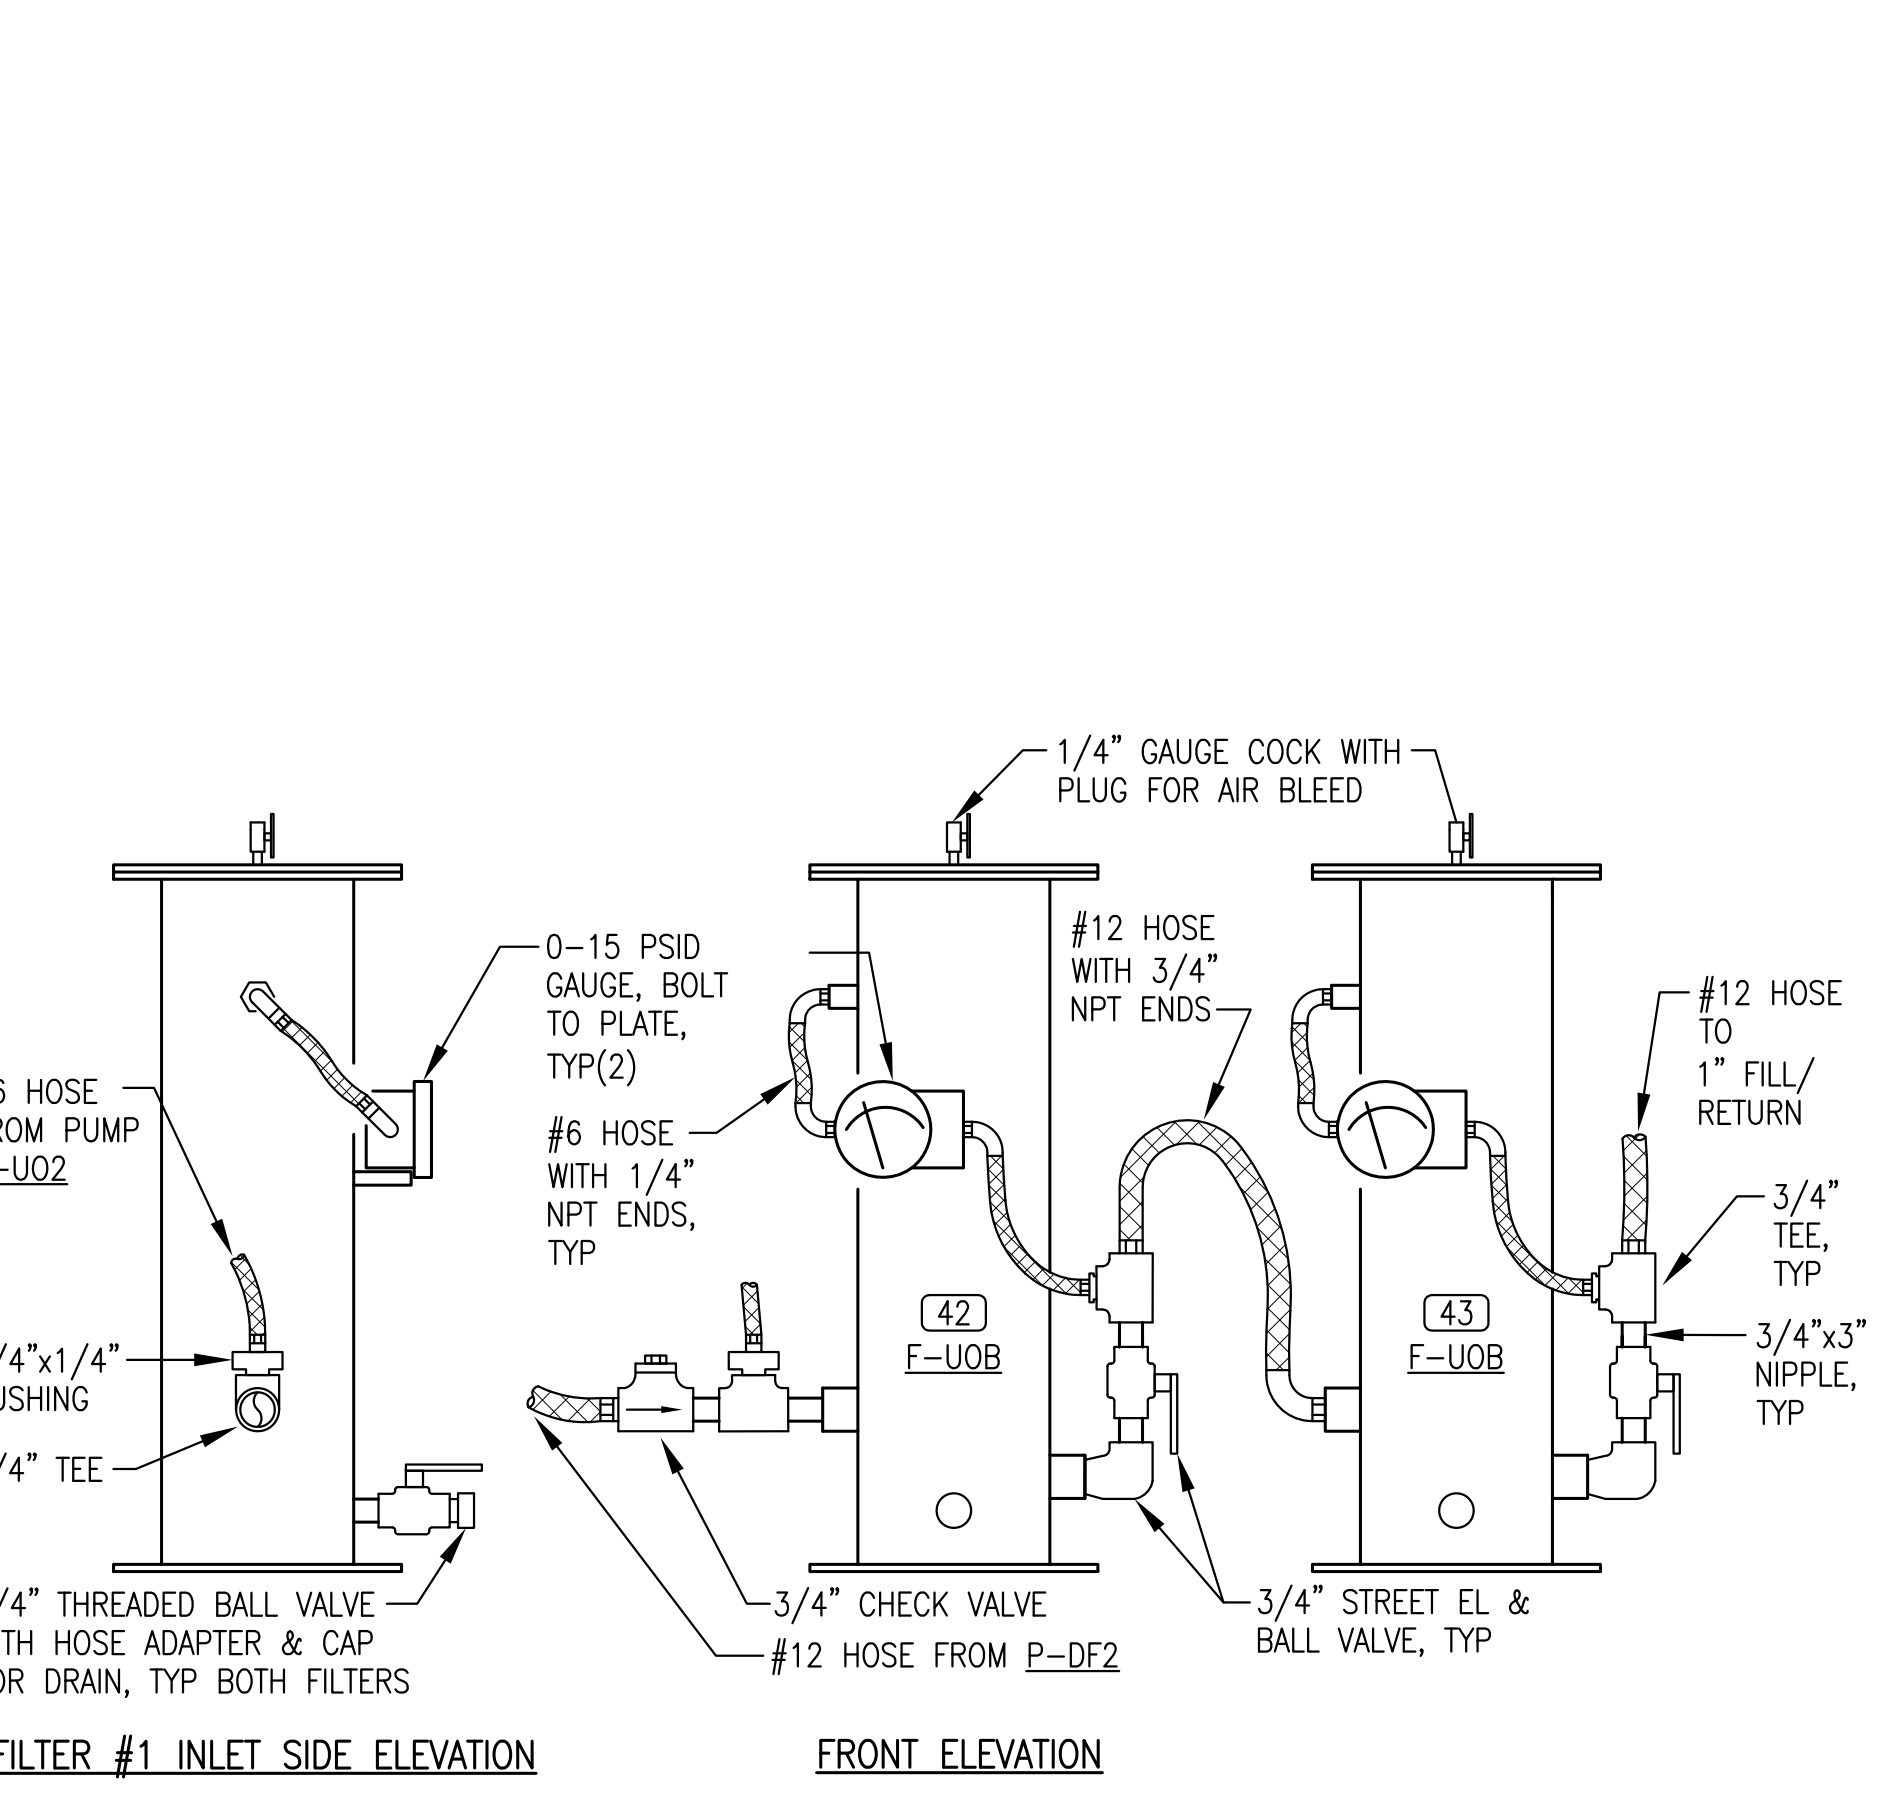

6 FILTER BANK ELEVATIONS & INSTALLATION DETAILS
M5.2 NO SCALE

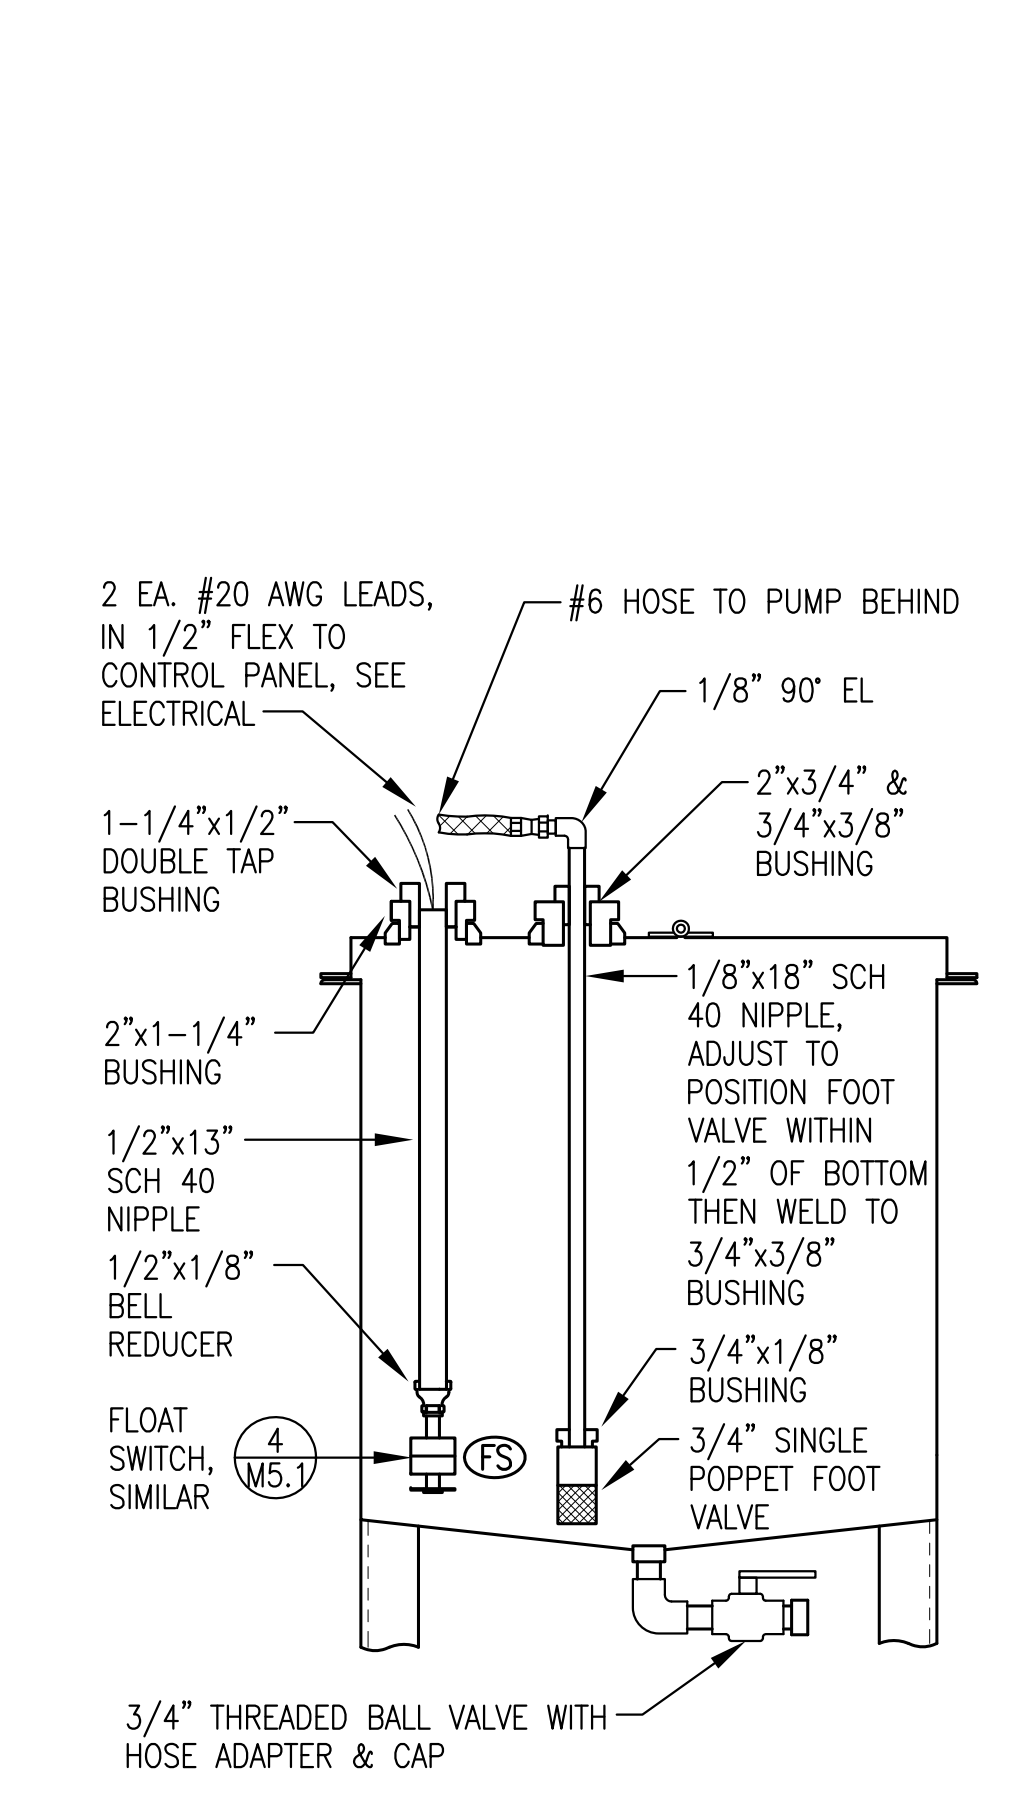

7 SECTION THROUGH HOPPER
M5.2 NO SCALE

U M I A Q
6700 Arctic Spur Road
Anchorage, AK 99518
(907) 677-8220

Ray Stassel Engineering, Inc.
P.O. 111405
Anchorage, AK 99511
(907) 949-0100

**STATE OF ALASKA, AIDEA/AEA
RURAL POWER SYSTEM UPGRADE**

CLARKS POINT POWER PLANT
CLARKS POINT, ALASKA

CONSTRUCTION DOCUMENTS

REVISIONS	DESCRIPTION

ISSUED FOR CONSTRUCTION JANUARY 2019

VERIFY SCALES
0 1" THIS BAR REPRESENTS ONE INCH ON ORIGINAL DRAWING

STATE OF ALASKA
49th
BRAND C. GRAY
REGISTERED PROFESSIONAL ENGINEER
ME 8210

DATE: 1/14/19
DRAWN BY: JTD
CHECKED BY: BCG
JOB NUMBER:

DRAWING TITLE:
DIESEL FUEL & USED OIL PIPING ELEVATIONS & DETAILS

M5.2


SHEET OF 7

DAY TANK SPECIFICATIONS:


- 1) FABRICATE SINGLE WALL 200 GALLON NOMINAL CAPACITY DAY TANK. FABRICATE IN ACCORDANCE WITH UL 142.
- 2) FABRICATE FROM ASTM A-36 STEEL PLATE, 10 GAUGE MINIMUM EXCEPT FOR TOP 3/16" MINIMUM. ALL TANK SEAM JOINTS TO BE FULL CONTINUOUS WELDS IN ACCORDANCE WITH UL 142 FIGURE 6.5 - #1, #6, #7, OR #8.
- 3) PROVIDE WITH ALL OPENINGS AND ATTACHMENTS INDICATED. ALL STRUT TO BE 1-5/8"x1-5/8"x12 GA SOLID BACK PLAIN (BLACK), B-LINE B22 PLN OR EQUAL. SEAL WELD ALL TANK ATTACHMENTS.
- 4) INSTALL ALL FPT OPENINGS IN ACCORDANCE WITH UL 142 FIGURE 7.1 - #4 UNLESS INDICATED OTHERWISE. ALL DROP TUBES SCH 40 ASTM A53 STEEL PIPE WITH MPT OR FLANGED END AS INDICATED.
- 5) UPON COMPLETION OF FABRICATION, ROUND ALL CORNERS AND SHARP EDGES. SANDBLAST TANK EXTERIOR AND ALL ATTACHMENTS IN ACCORDANCE WITH SSPC-SP-6. PAINT WITH TWO COATS OF SHERWIN WILLIAMS MACROPOXY 646 OR APPROVED EQUAL, COLOR STRUCTURAL GRAY 4031.
- 6) LABEL ALL OPENINGS WITH 1/4" BLACK LETTERS INDICATING FUNCTION AS LISTED IN PARENTHESES IN SPECIFIC NOTES.
- 7) UPON COMPLETION FLUSH INTERIOR OF TANK TO REMOVE ALL DIRT AND DEBRIS AND AIR DRY INTERIOR. SEAL ALL MPT OPENINGS WITH THREADED STEEL CAPS. SEAL FPT TANK OPENINGS WITH THREADED STEEL PIPE PLUGS WHERE INDICATED. INSTALL 1-1/4" VENT CAP WHERE INDICATED. SEAL ALL OTHER FPT OPENINGS WITH PLASTIC OR STEEL PLUGS.

DAY TANK SPECIFIC NOTES:


- 1) PROVIDE 2" HIGH LETTERING: "DIESEL FUEL 200 GALLONS"
- 2) 4" FPT (MANUAL FILL) - INSTALL THREADED STEEL PLUG
- 3) 1-1/4" FPT (OVERFILL) - INSTALL VENT CAP FOR SHIPPING
- 4) 1-1/4" FPT (PUMP STOP)
- 5) 1-1/4" FPT (PUMP START)
- 6) 1-1/4" FPT (LOW ALARM)
- 7) 1-1/2" FPT (TANK GAUGE)
- 8) 30"L STRUT, END FLUSH WITH BACK OF TANK
- 9) 6"L STRUT
- 10) NOT USED
- 11) NOT USED
- 12) NOT USED
- 13) 1-1/2" SCH 40 DROP TUBE (FILL) WITH 150# FLANGE
- 14) 1" FPT (SPARE) - INSTALL THREADED STEEL PLUG
- 15) 2" FPT (VENT)
- 16) 3" FPT (EMERGENCY VENT) - INSTALL THREADED STEEL PLUG
- 17) 1" FLANGE (SUPPLY) - SEE DETAIL 2/M5.3
- 18) NOT USED
- 19) 1" FLANGE (DRAIN) - SEE DETAIL 3/M5.3
- 20) C6x8.2, 38" LONG
- 21) 2" FPT (TANK LEVEL PROBE)

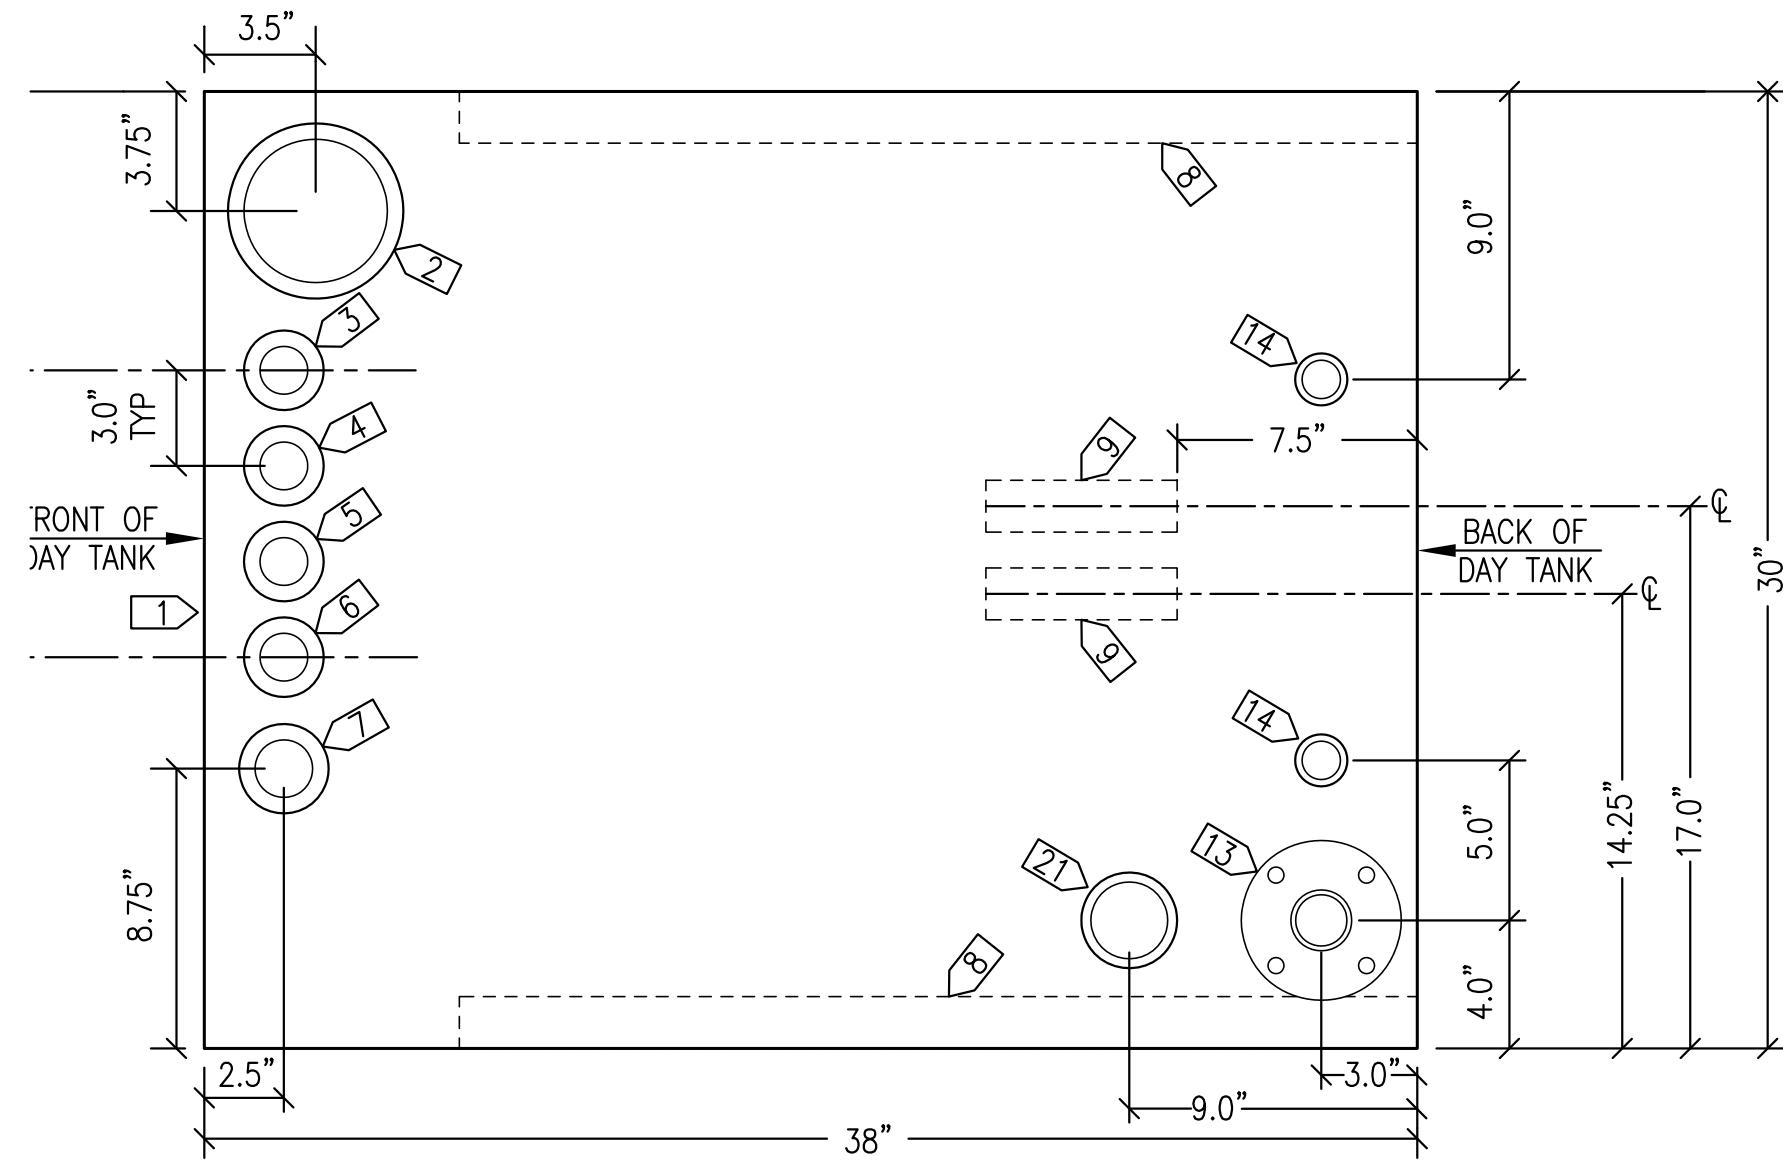


TOP VIEW

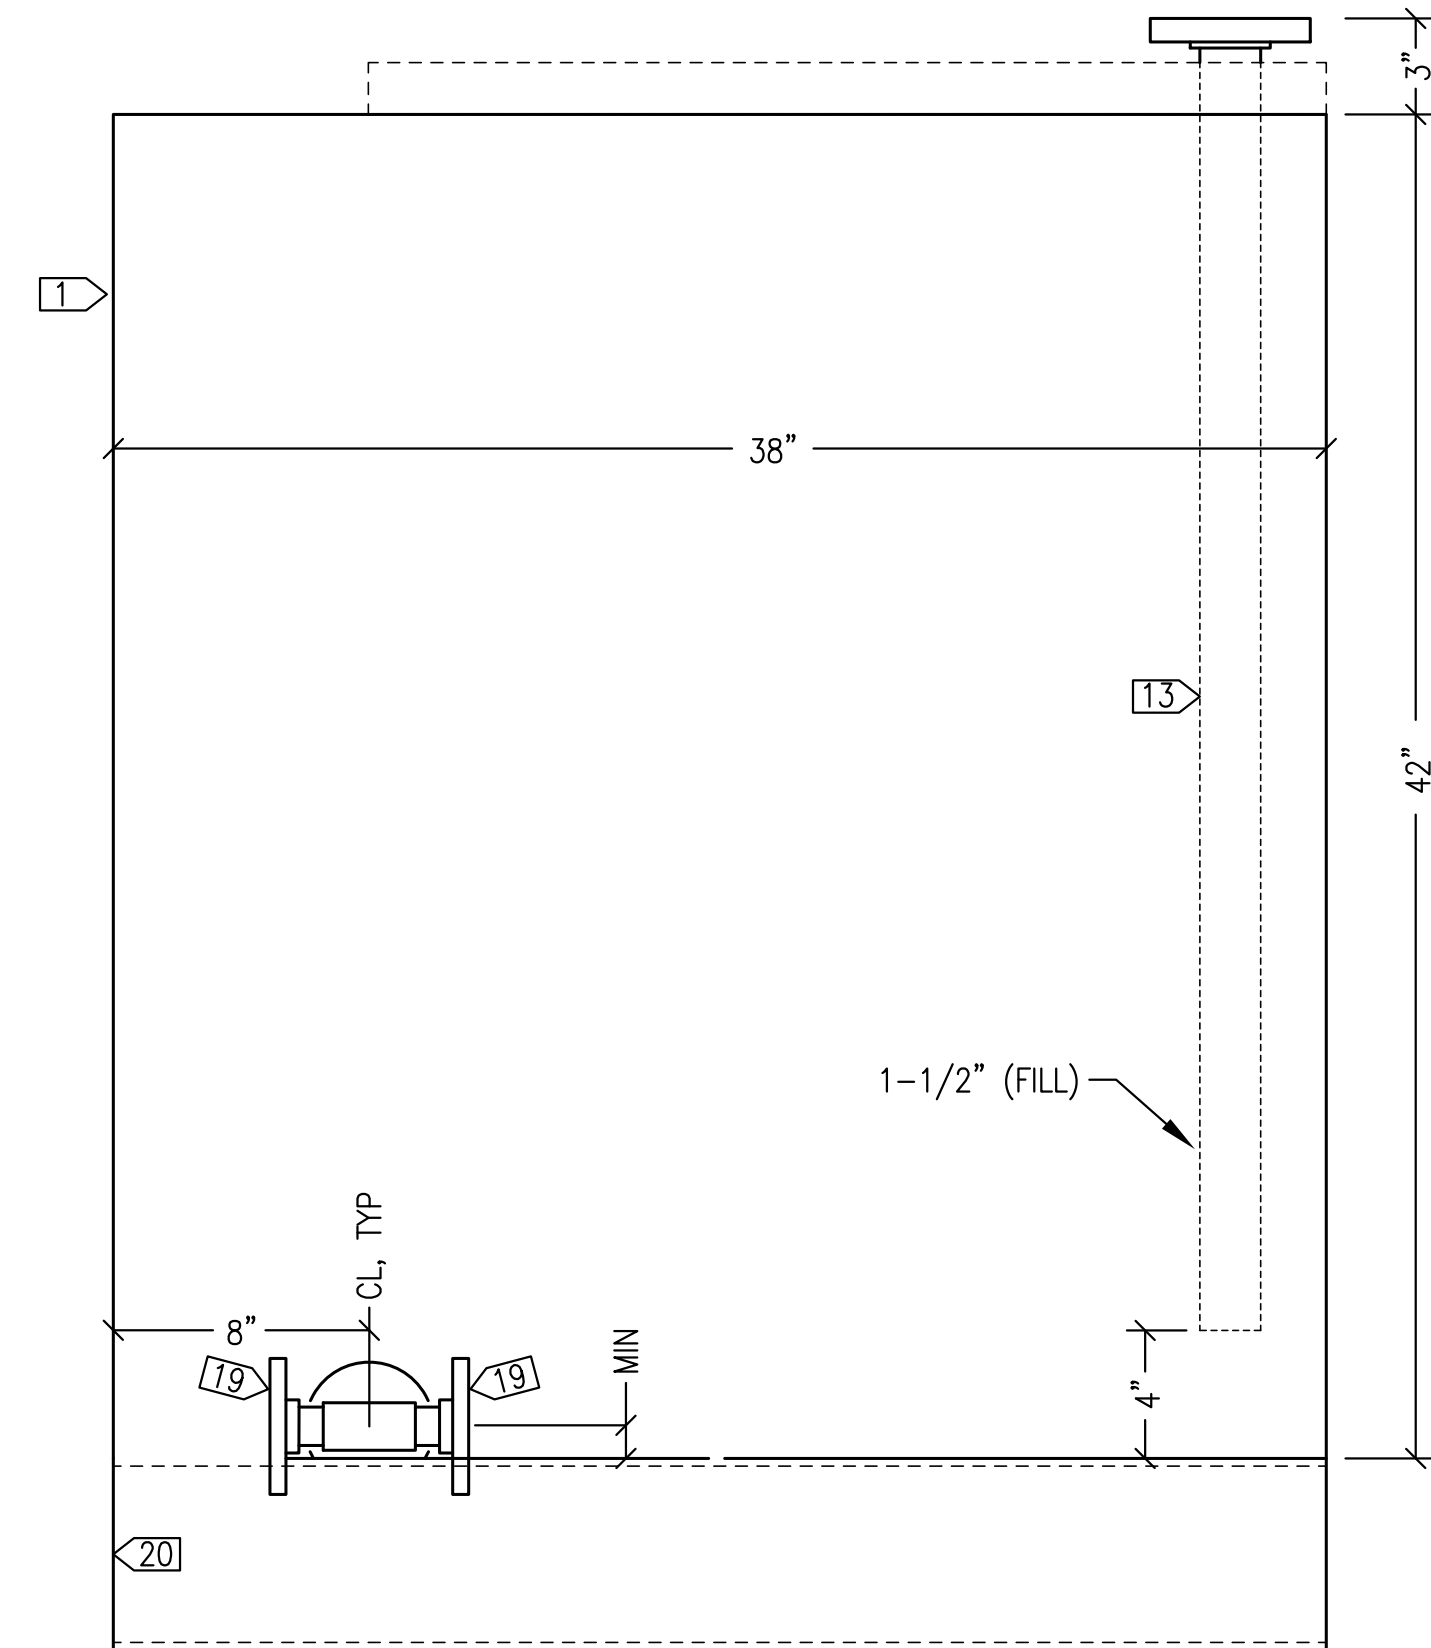

RIGHT SIDE VIEW

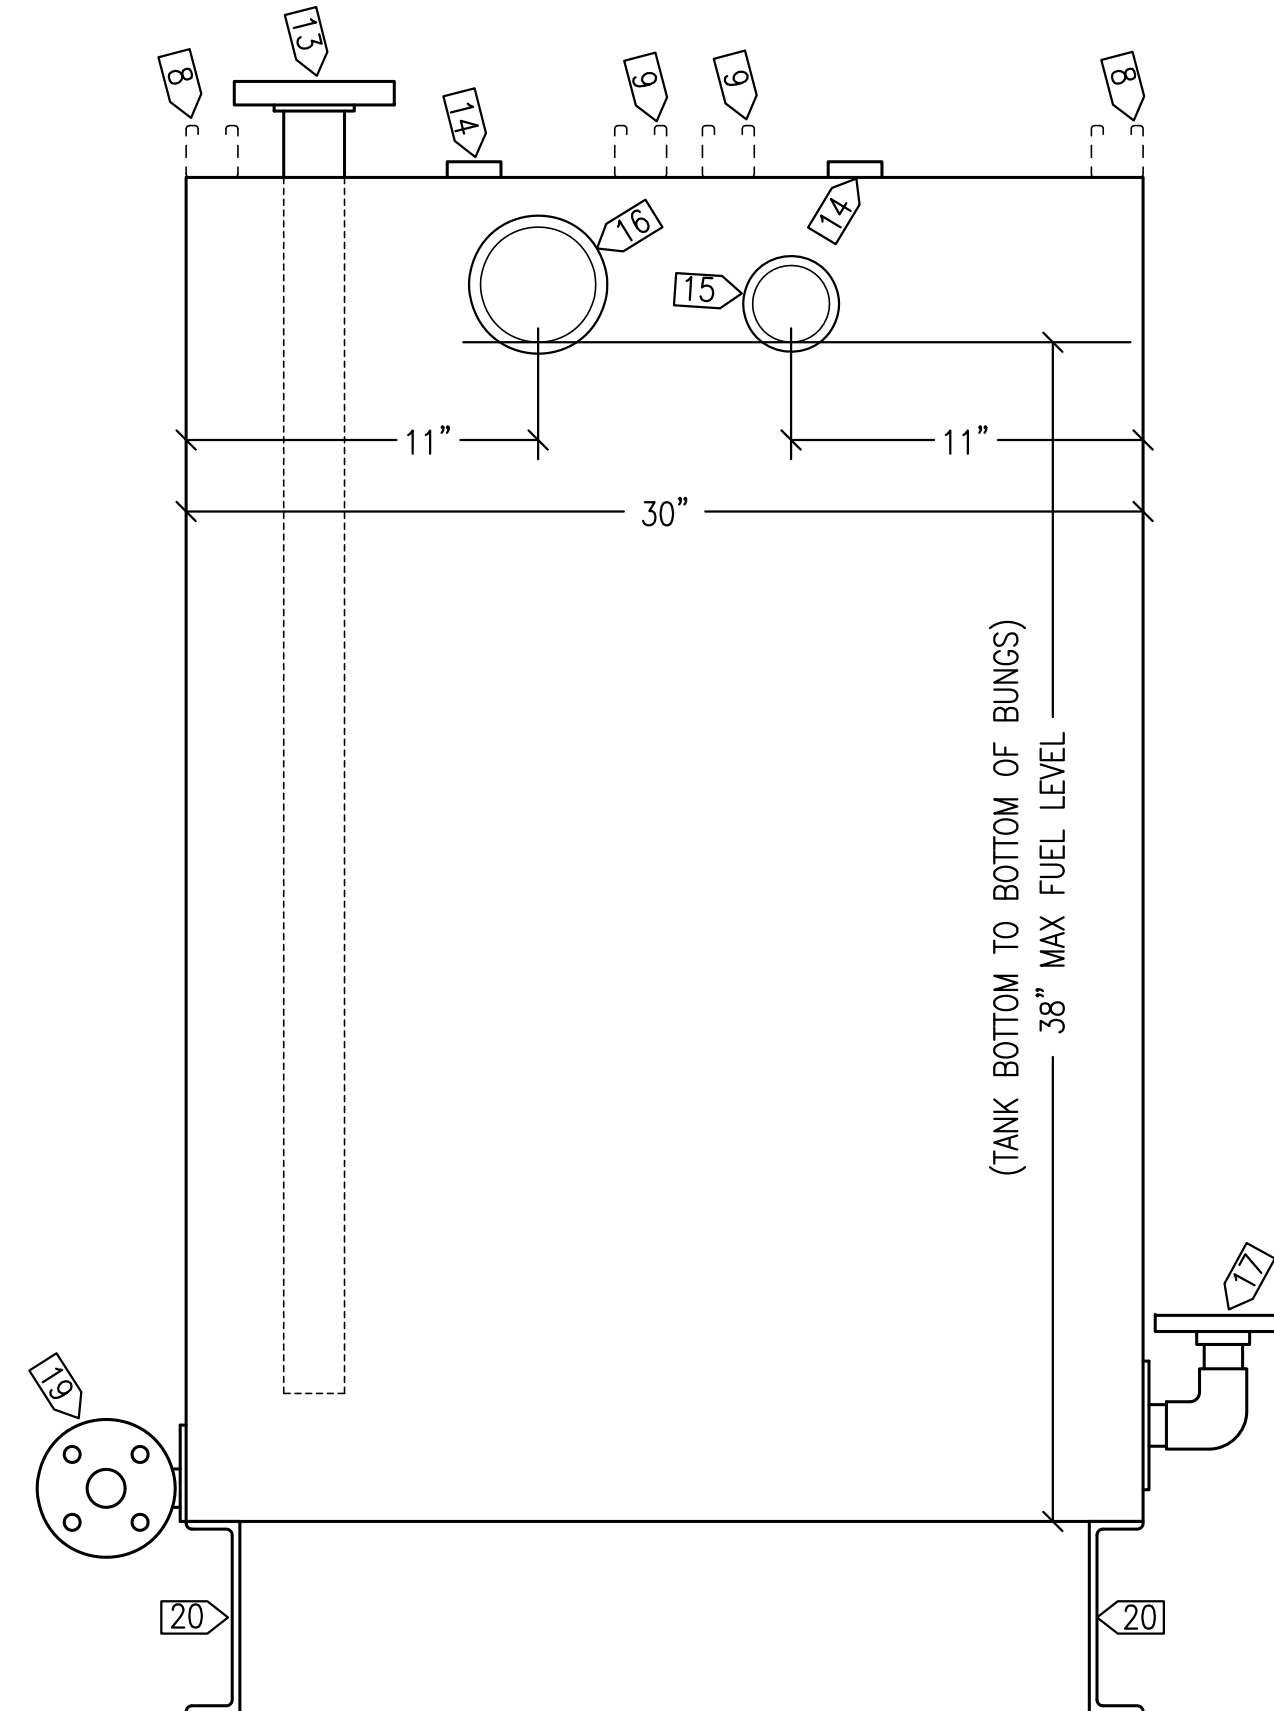


BACK VIEW

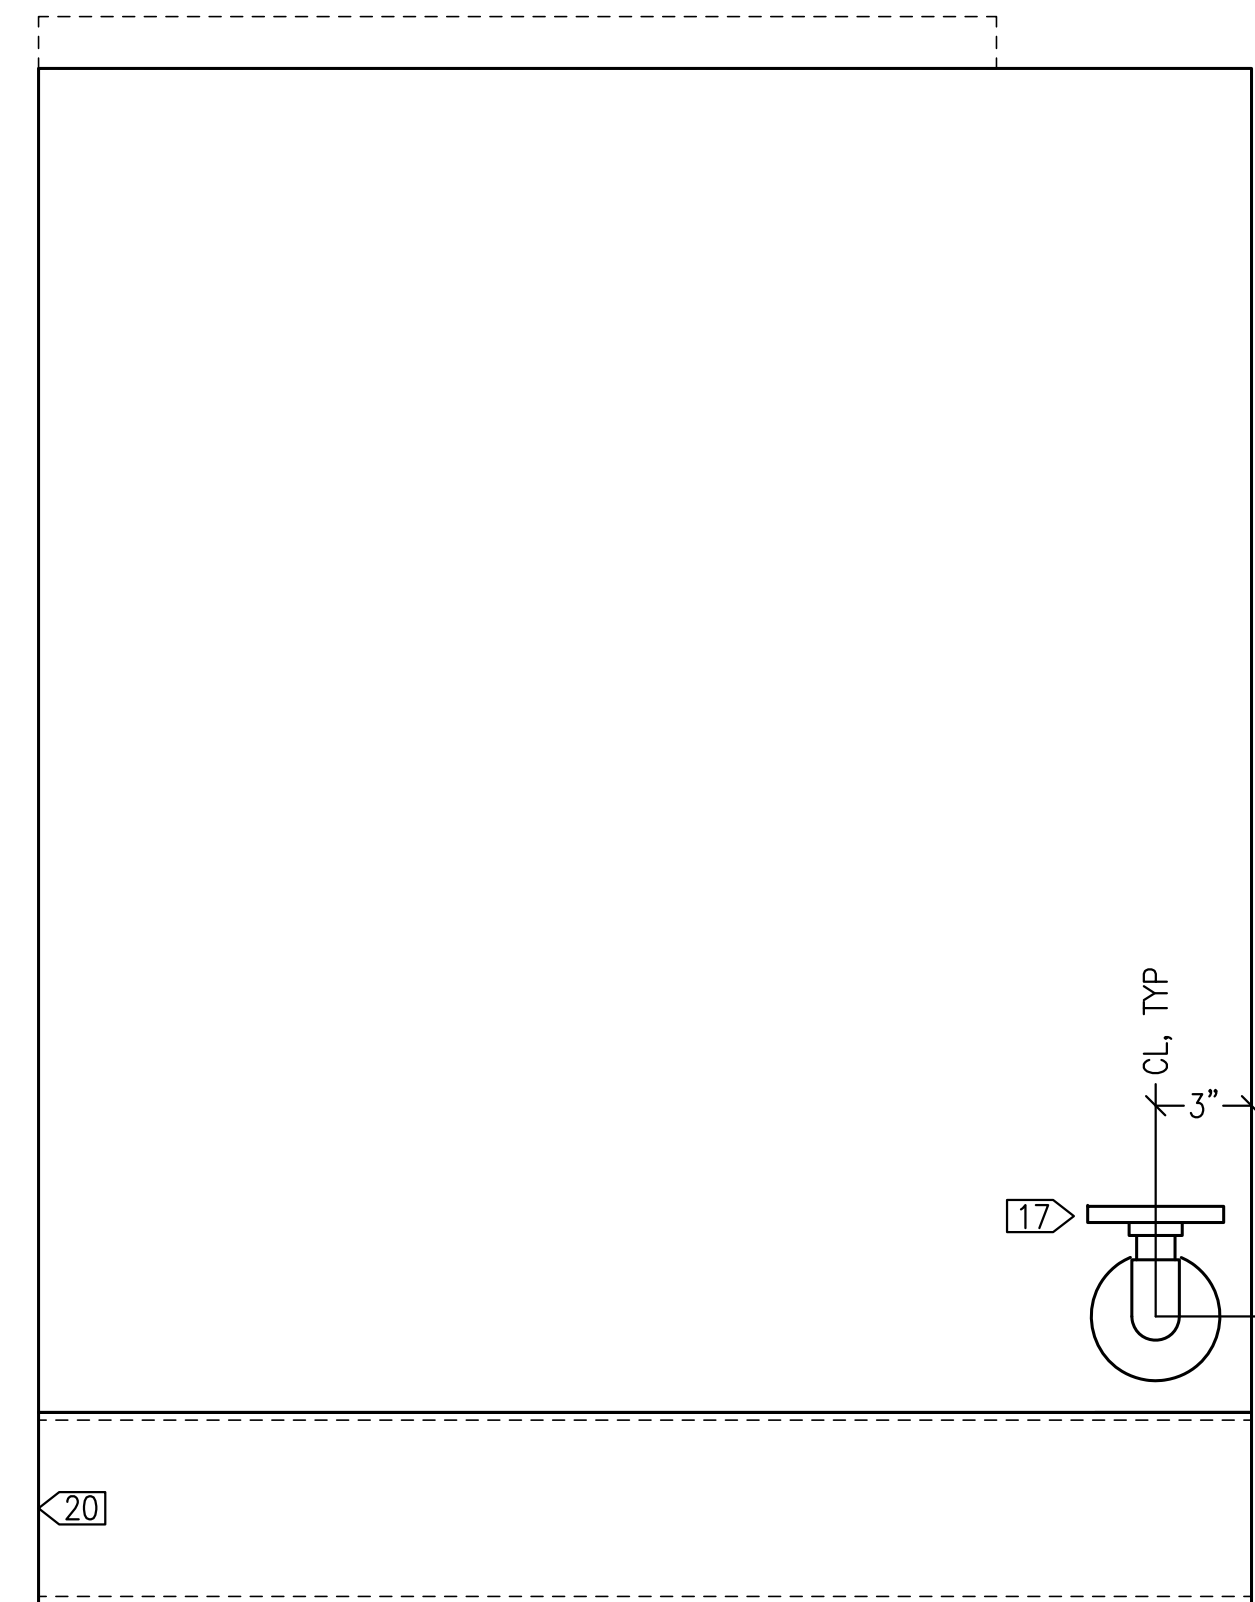


LEFT SIDE VIEW

1 200 GALLON SINGLE WALL DAY TANK
M5.3 1"=6"

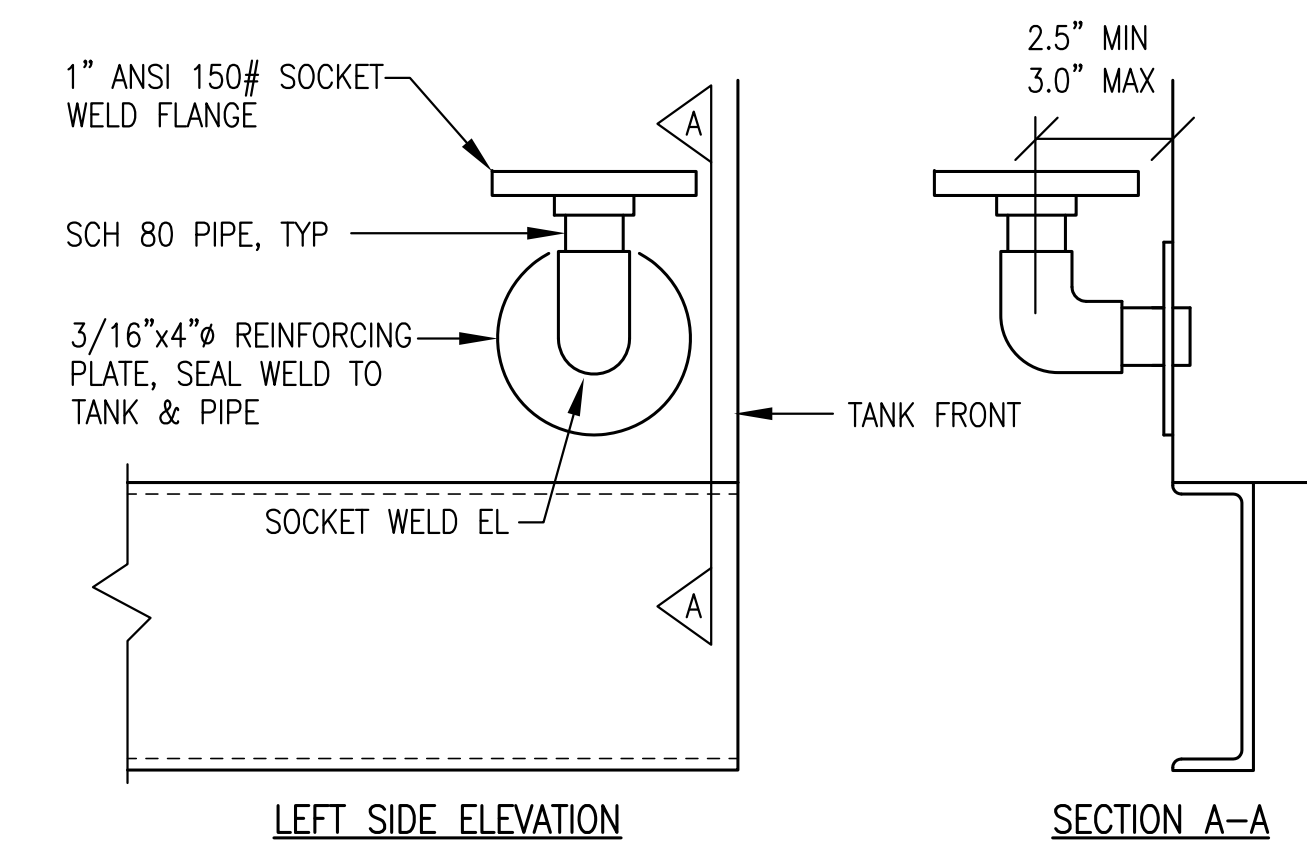

2 1" FLANGED SUPPLY CONNECTION
M5.3 NO SCALE

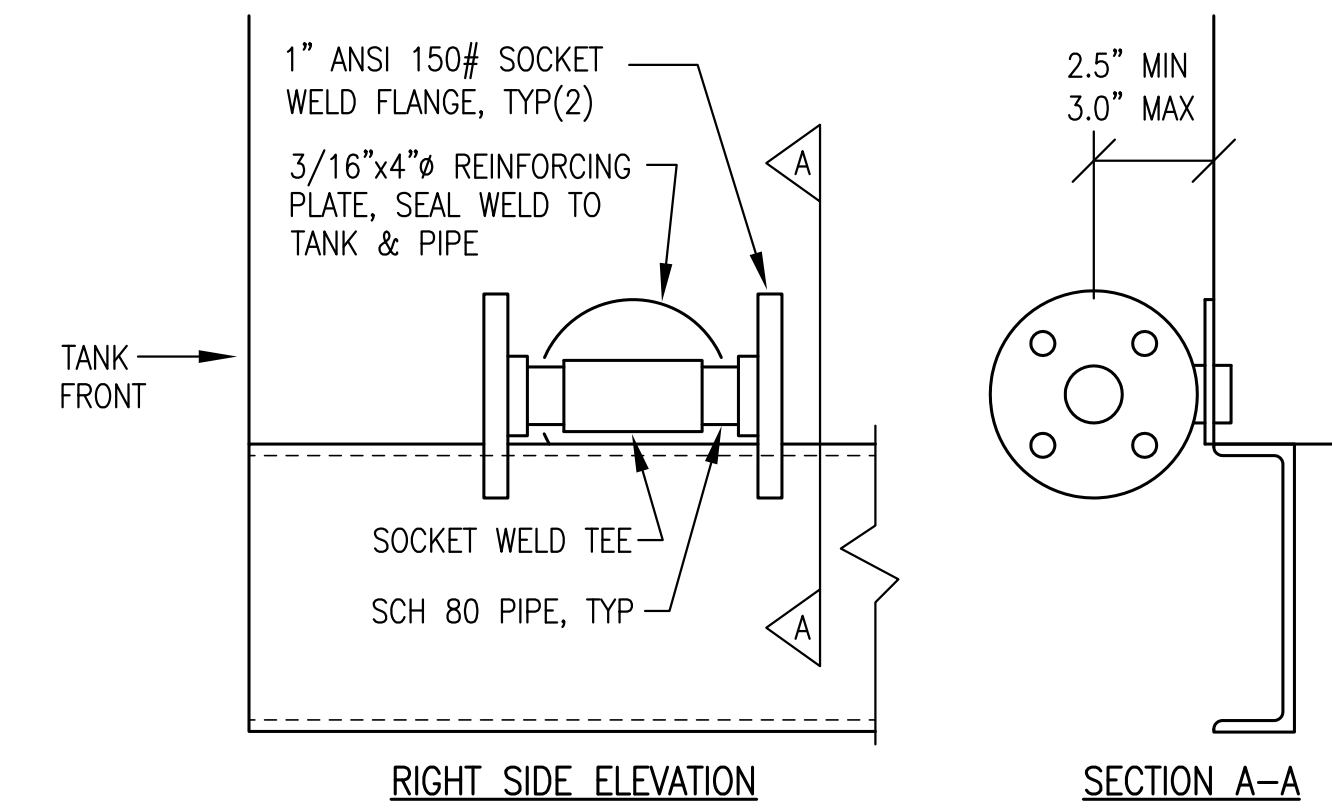

3 1" FLANGED DRAIN CONNECTION
M5.3 NO SCALE




Gray Stassel
Engineering, Inc.
P.O. 111405
Anchorage, AK 99511
(907)949-0100

STATE OF ALASKA, AIDEA/AEA
RURAL POWER SYSTEM UPGRADE
CLARKS POINT POWER PLANT
CLARKS POINT, ALASKA

CONSTRUCTION DOCUMENTS	
REVISIONS	DESCRIPTION
REV DATE	

VERIFY SCALES
0 1"
THIS BAR REPRESENTS ONE INCH ON ORIGINAL DRAWING

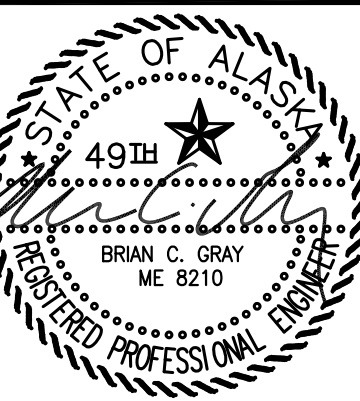



DATE: 1/14/19
DRAWN BY: JTD
CHECKED BY: BCG
JOB NUMBER:

DRAWING TITLE:
200 GALLON DAY TANK FABRICATION

M5.3

SHEET OF 7


ISSUED FOR CONSTRUCTION JANUARY 2019

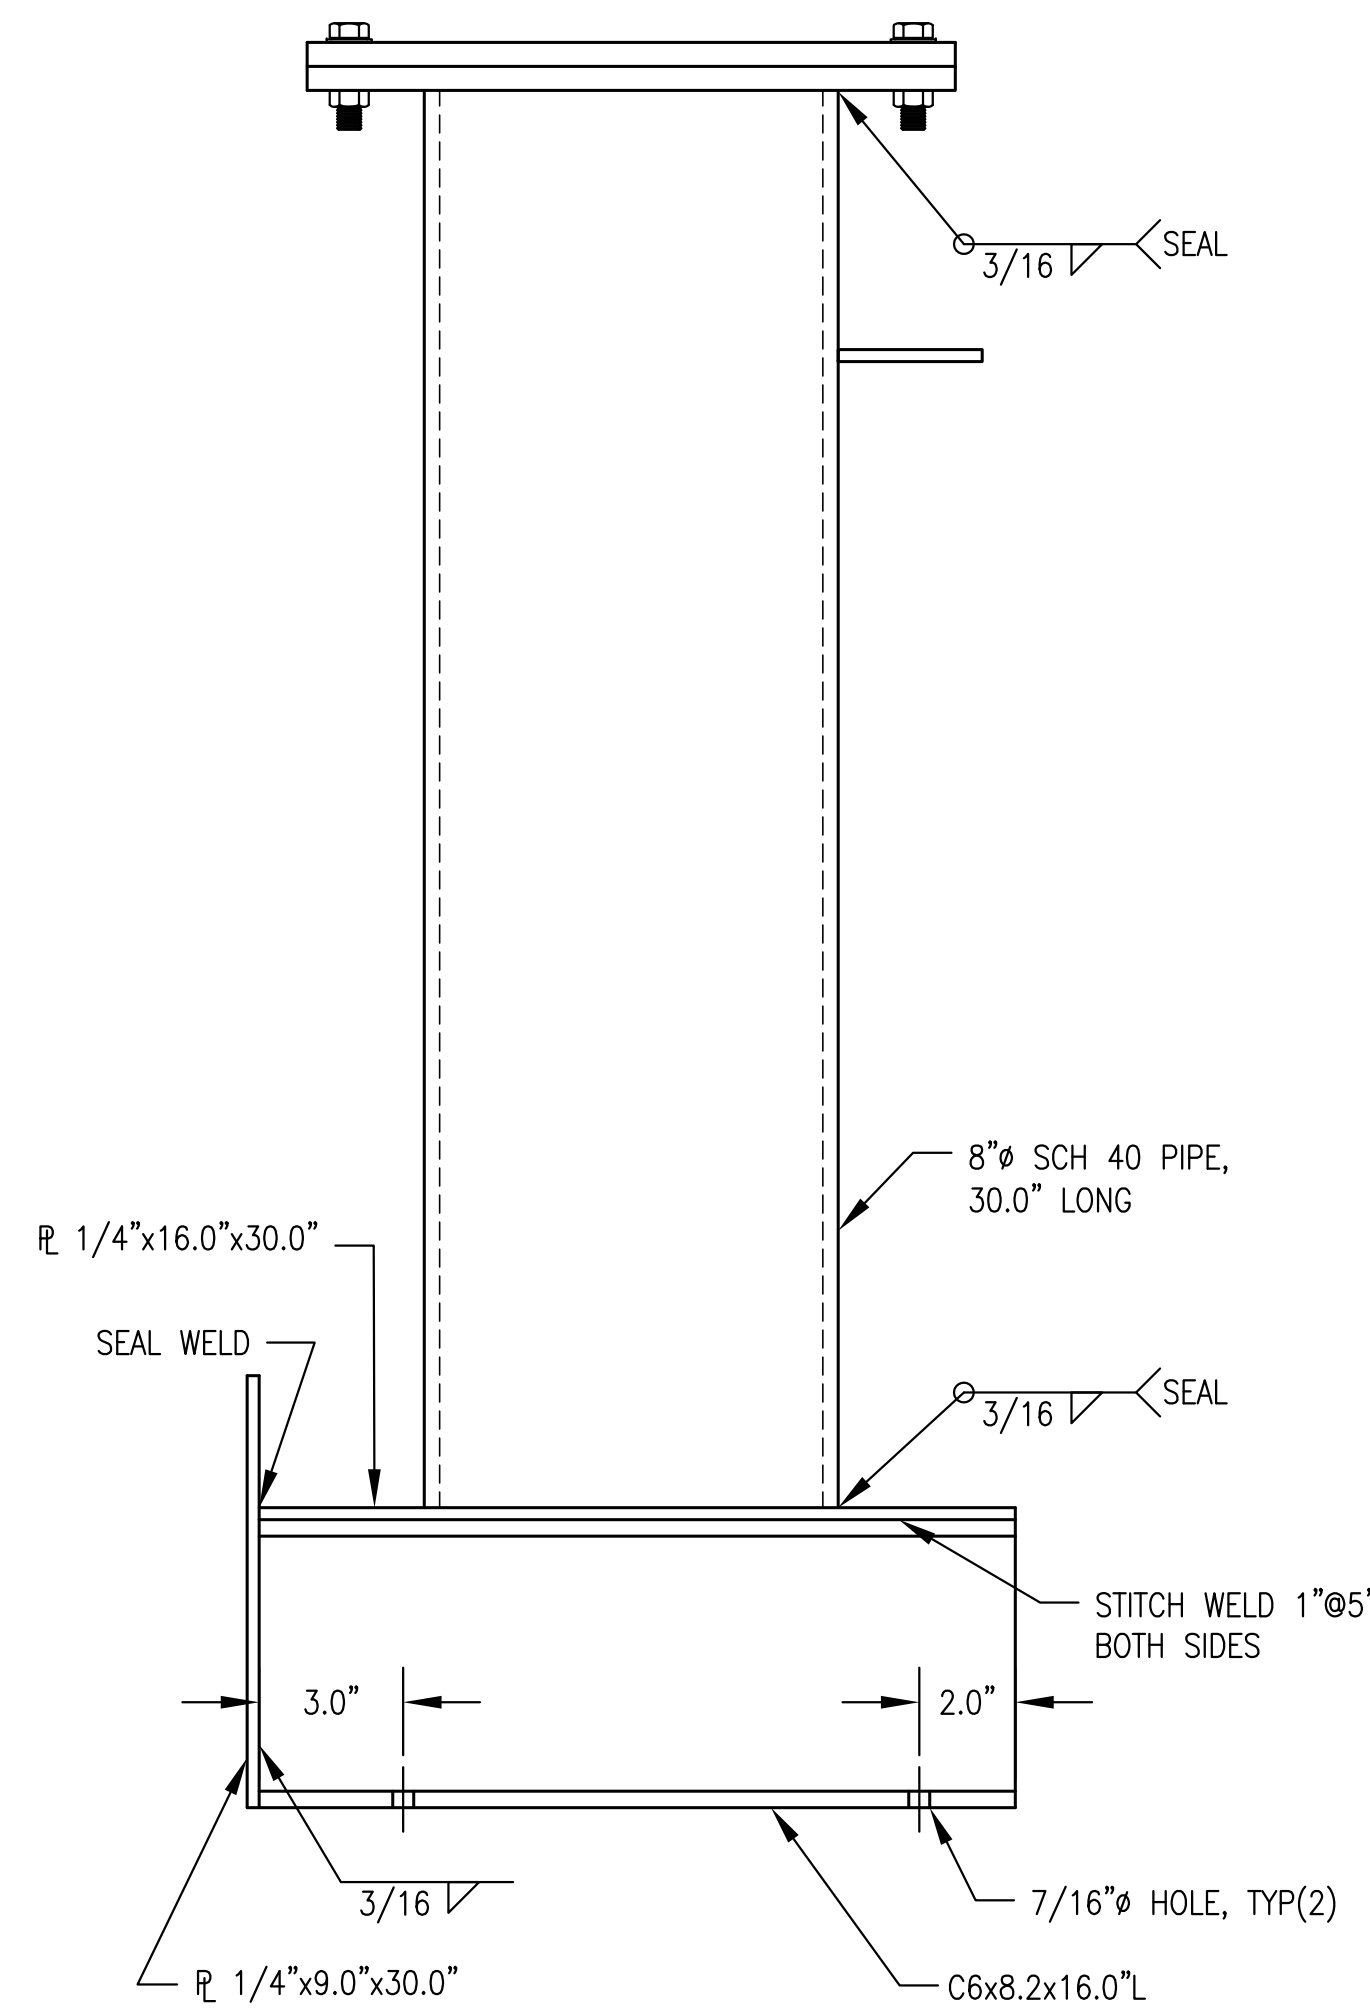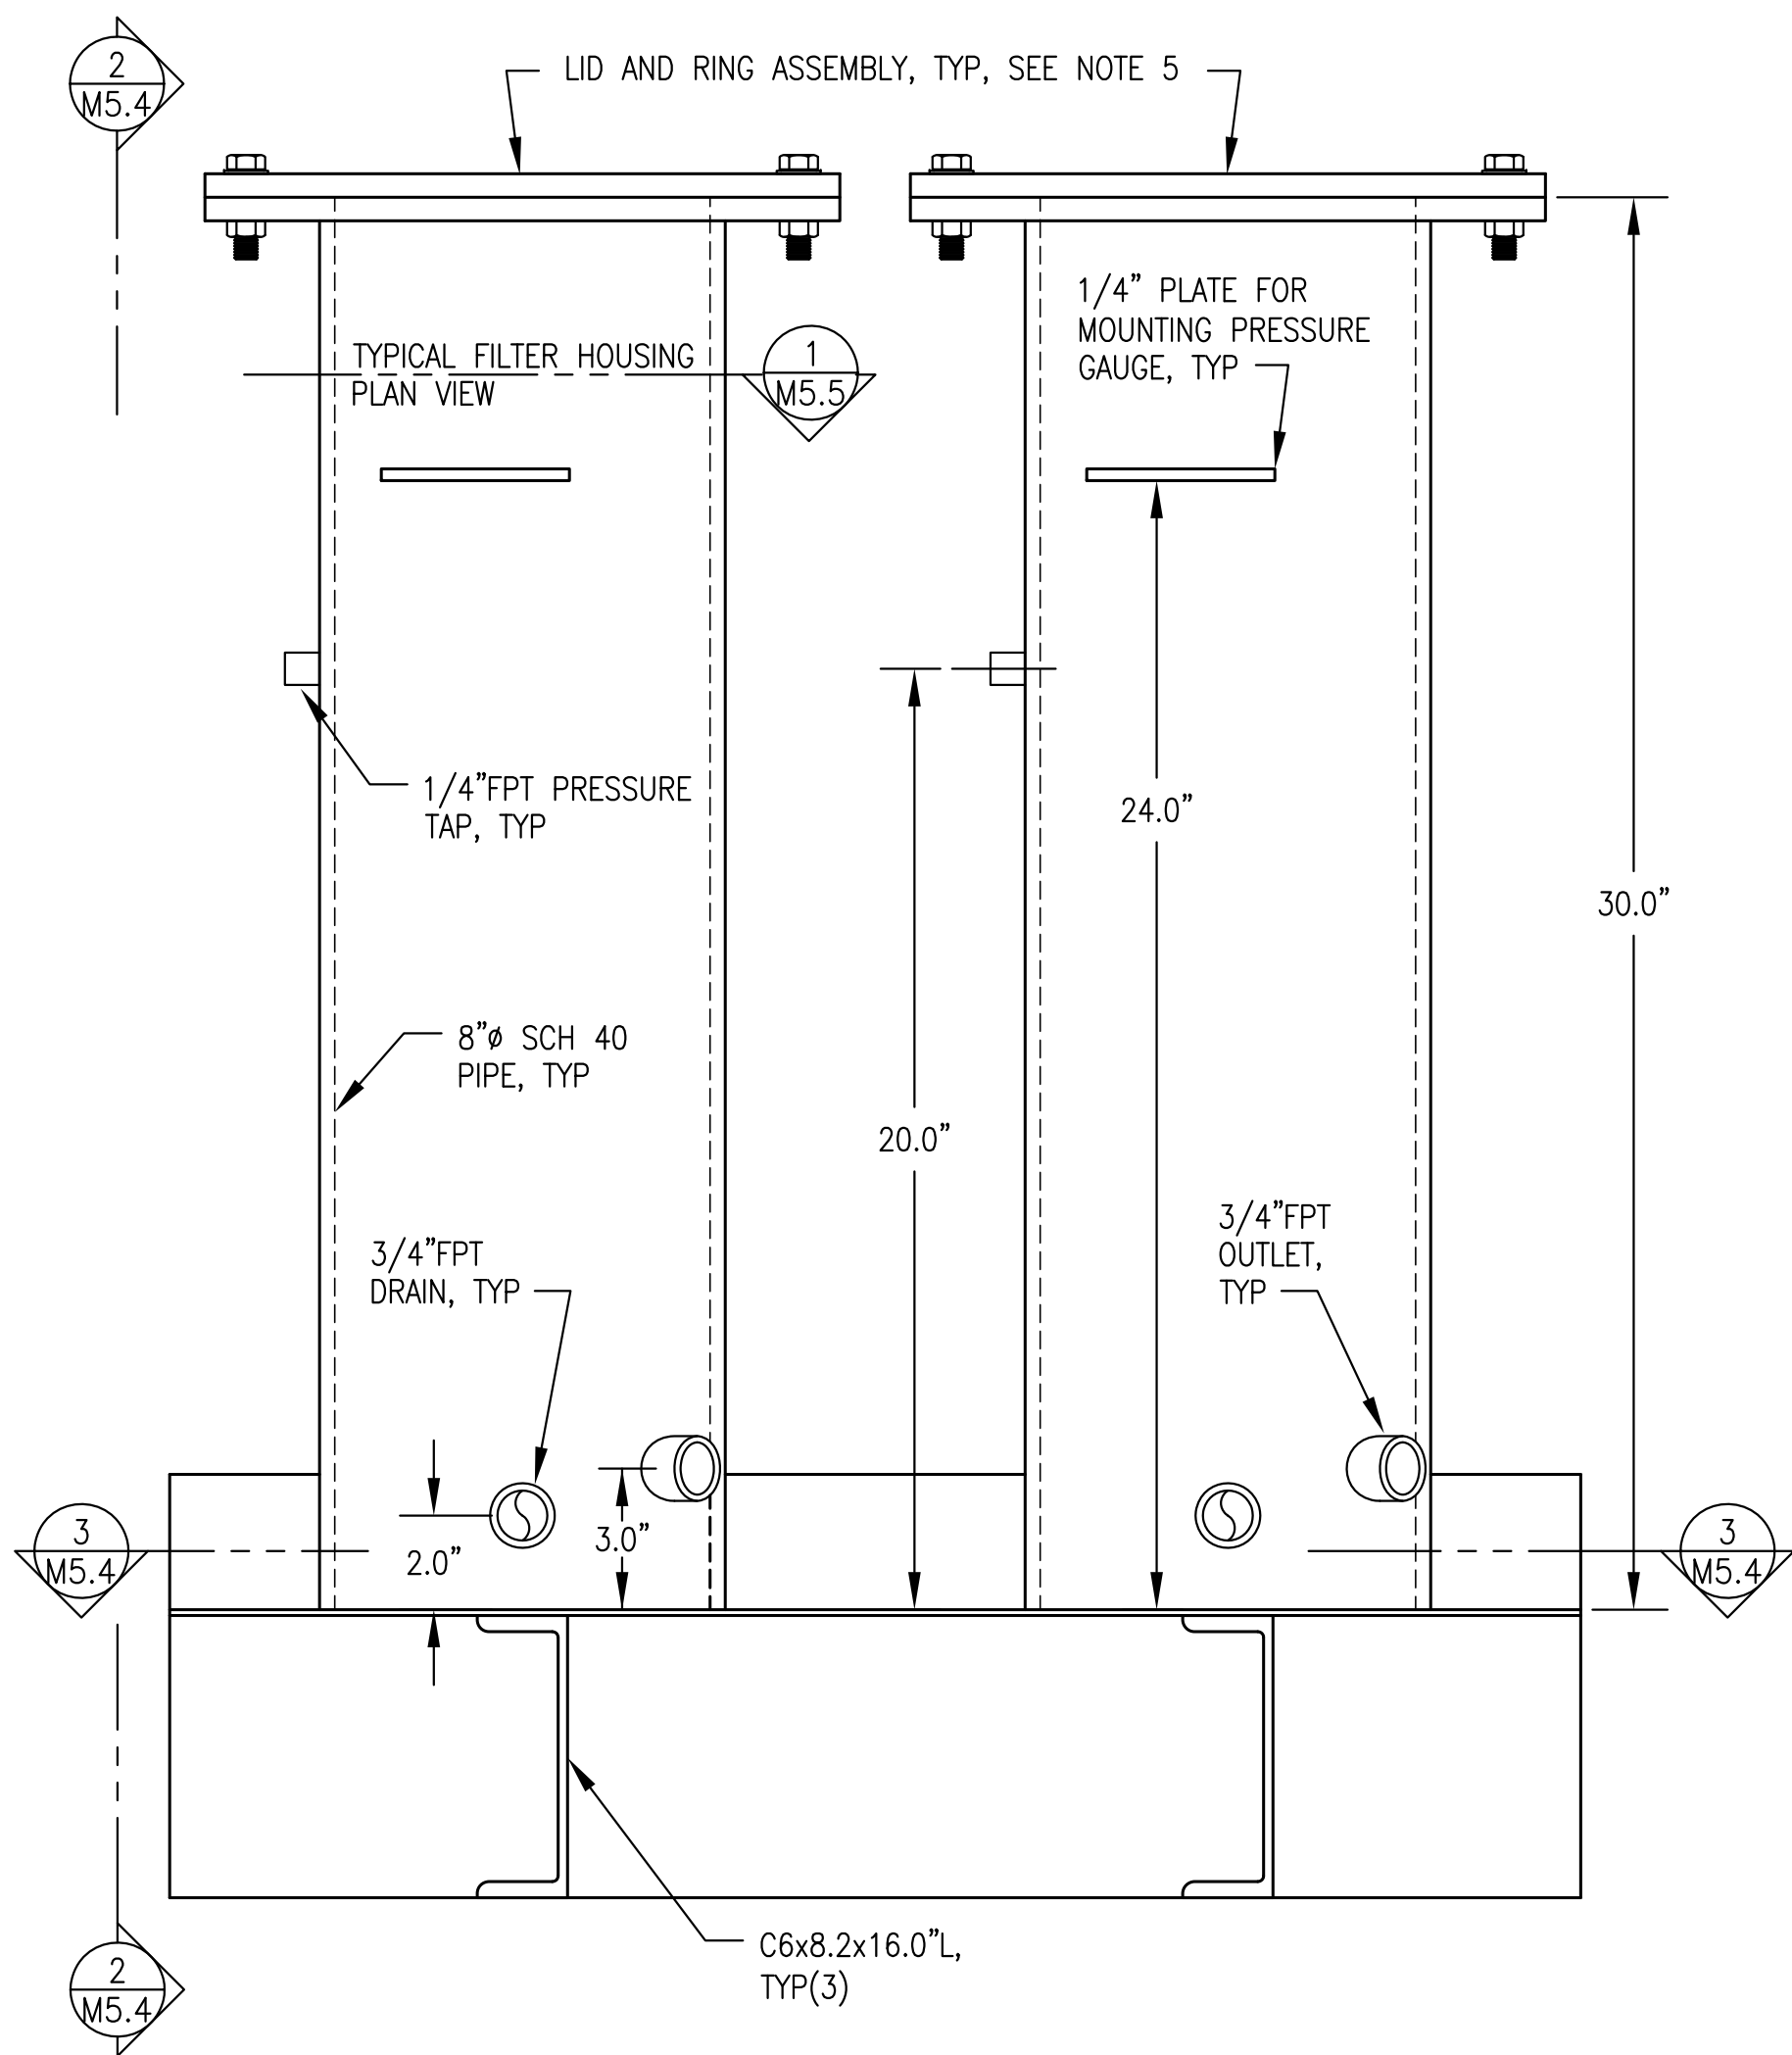

- FILTER BANK GENERAL NOTES:**
1. FABRICATE TWO CHAMBER FILTER BANK AS INDICATED. SEE SHEET M5.5 FOR INTERNAL DETAILS.
 2. FABRICATE FROM ASTM A-36 STEEL PLATE AND SHAPES AND ASTM A-53 PIPE. ALL JOINTS TO BE FULL CONTINUOUS SEAL WELDS EXCEPT WHERE SPECIFICALLY INDICATED OTHERWISE.
 3. PROVIDE WITH ALL OPENINGS AND ATTACHMENTS INDICATED. INSTALL MINIMUM 3,000# FORGED STEEL HALF COUPLINGS FOR ALL FPT OPENINGS IN ACCORDANCE WITH UL 142 FIGURE 7.1 - #2.
 4. UPON COMPLETION OF FABRICATION, ROUND ALL CORNERS AND SHARP EDGES. SANDBLAST TANK EXTERIOR AND ALL ATTACHMENTS IN ACCORDANCE WITH SSPC-SP-6. PAINT WITH TWO COATS OF SHERWIN WILLIAMS MACROPOXY 646 OR APPROVED EQUAL, COLOR STRUCTURAL GRAY 4031.
 5. AFTER PAINTING REMOVE LID, WIRE BRUSH MATING SURFACES OF LID AND RING TO REMOVE ALL PAINT AND POLISH SURFACES SMOOTH. APPLY A LIGHT COAT OF GREASE OR ANTI-SIEZE PASTE TO BOTH FACES PRIOR TO INSTALLING GASKET. INSTALL 13.5" O.D. FULL-FACED 1/4" BUNA-N RUBBER GASKET (ALASKA RUBBER OR EQUAL) ON FILTER LIDS.
 6. FURNISH FASTENERS AS INDICATED AND COAT WITH ANTI-SIEZE.
 7. PRESSURE TEST EACH FILTER HOUSING ASSEMBLY TO 50 PSIG MINIMUM.
 8. UPON COMPLETION FLUSH INTERIOR OF TANK TO REMOVE ALL DIRT AND DEBRIS, AIR DRY INTERIOR, AND SEAL ALL TANK OPENINGS WITH PLASTIC PLUGS.

1 OIL FILTER BANK FRONT ELEVATION
M5.4 1/4" = 1"

2 SECTION THROUGH FILTER & BASE
M5.4 1/4" = 1"

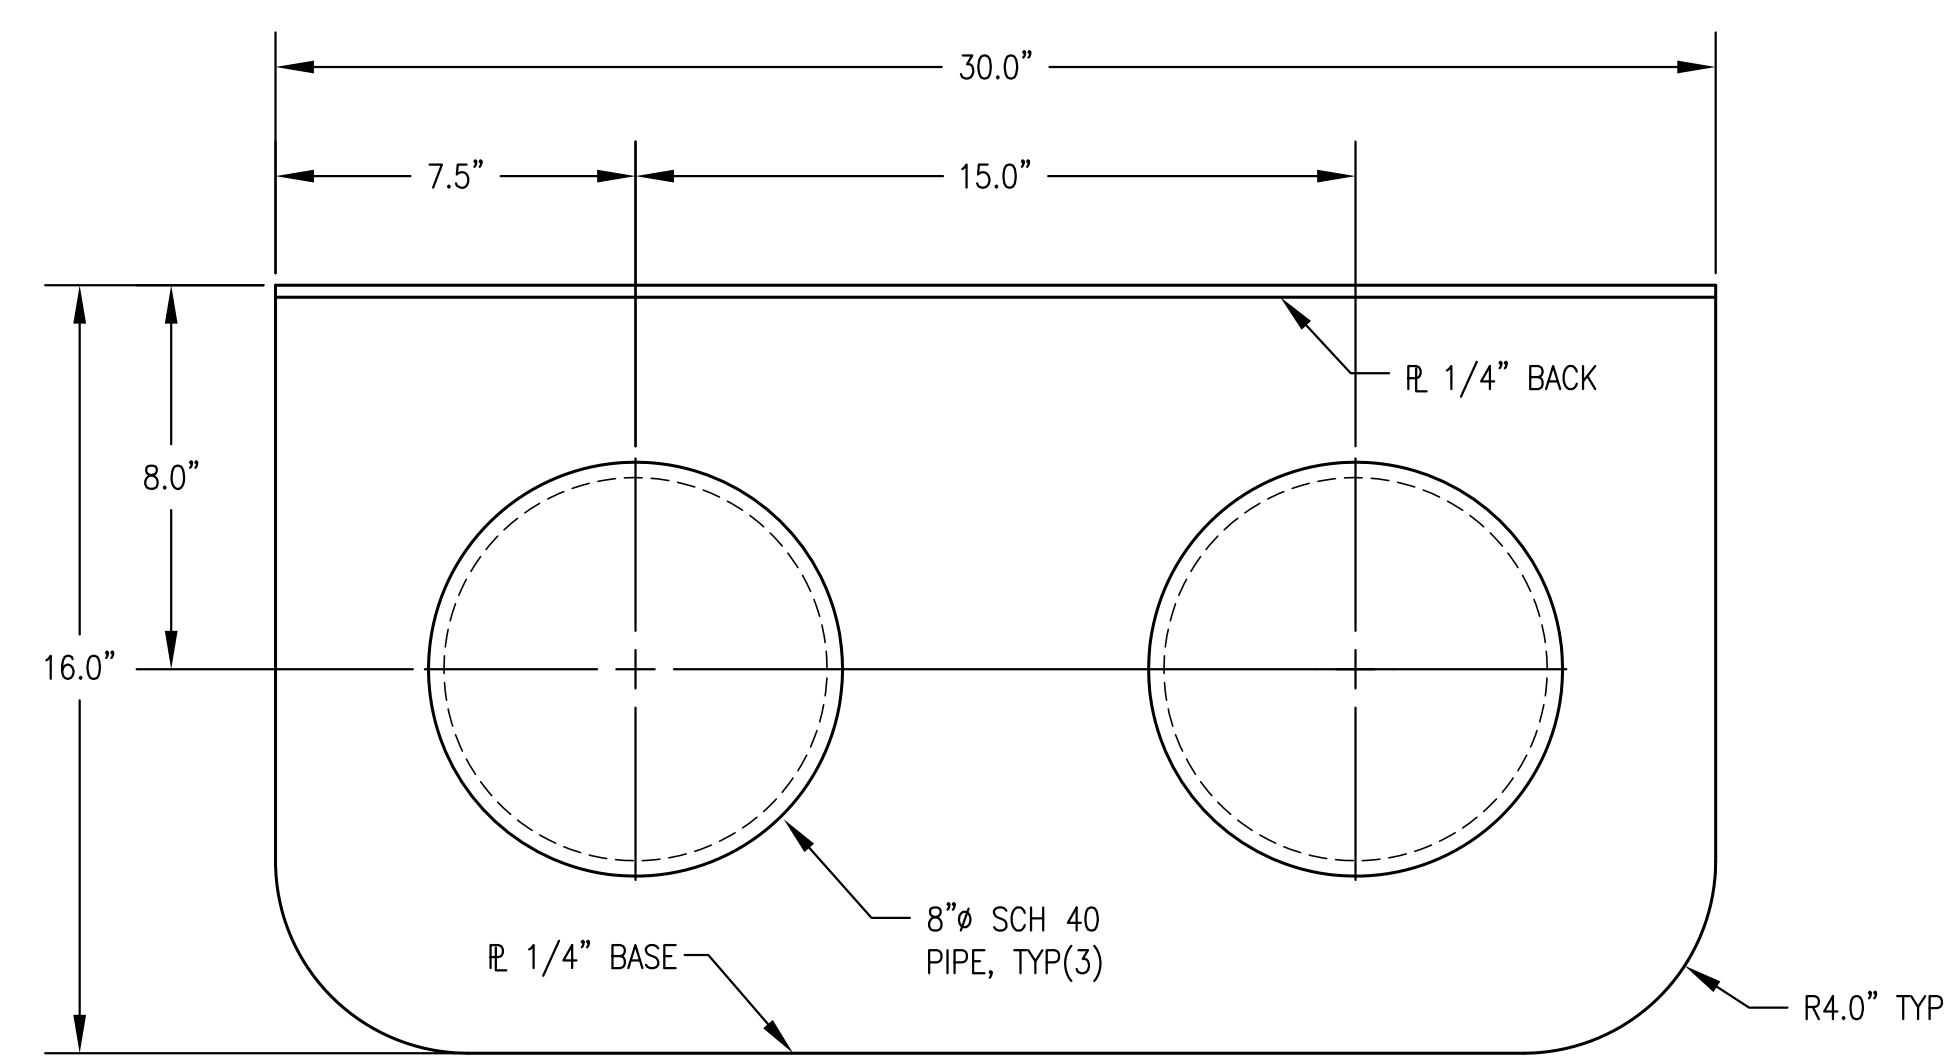

3 OIL FILTER BANK BASE PLAN
M5.4 1/4" = 1"




**STATE OF ALASKA, AIDEA/AEA
RURAL POWER SYSTEM UPGRADE**

CLARKS POINT POWER PLANT
CLARKS POINT, ALASKA

CONSTRUCTION DOCUMENTS	
REVISIONS	DESCRIPTION
REV	DATE

VERIFY SCALES
0 1"
THIS BAR REPRESENTS ONE INCH ON ORIGINAL DRAWING

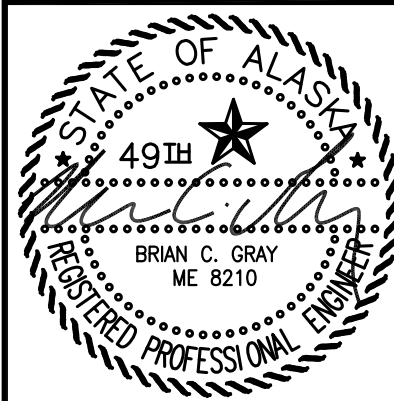


DATE: 1/14/19
DRAWN BY: JTD
CHECKED BY: BCG
JOB NUMBER:


DRAWING TITLE:
USED OIL BLENDER
FILTER BANK LAYOUT &
CONFIGURATION

M5.4
SHEET OF 7



ISSUED FOR CONSTRUCTION JANUARY 2019

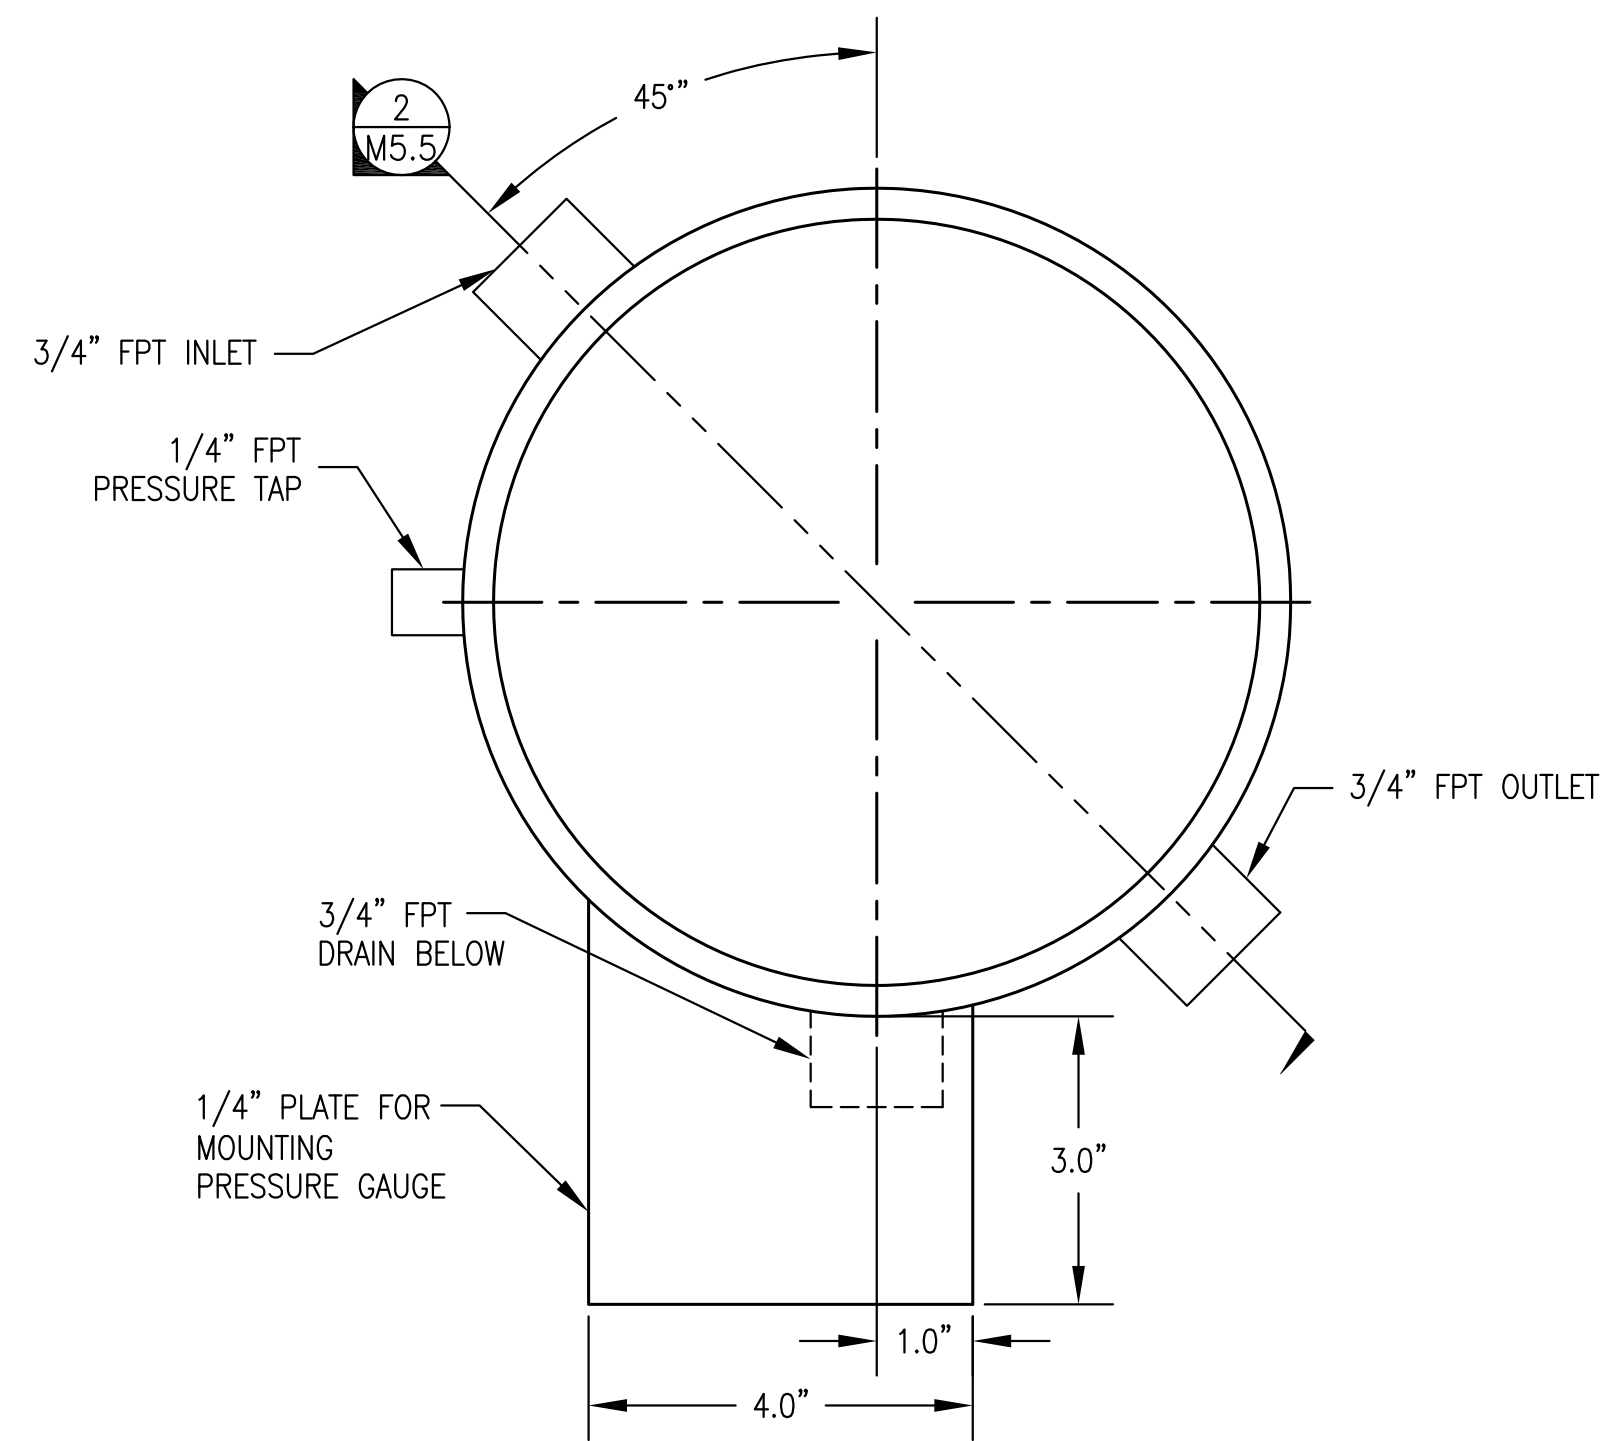


1 TYPICAL FILTER HOUSING - PLAN VIEW
 M5.5 1/2" = 1"

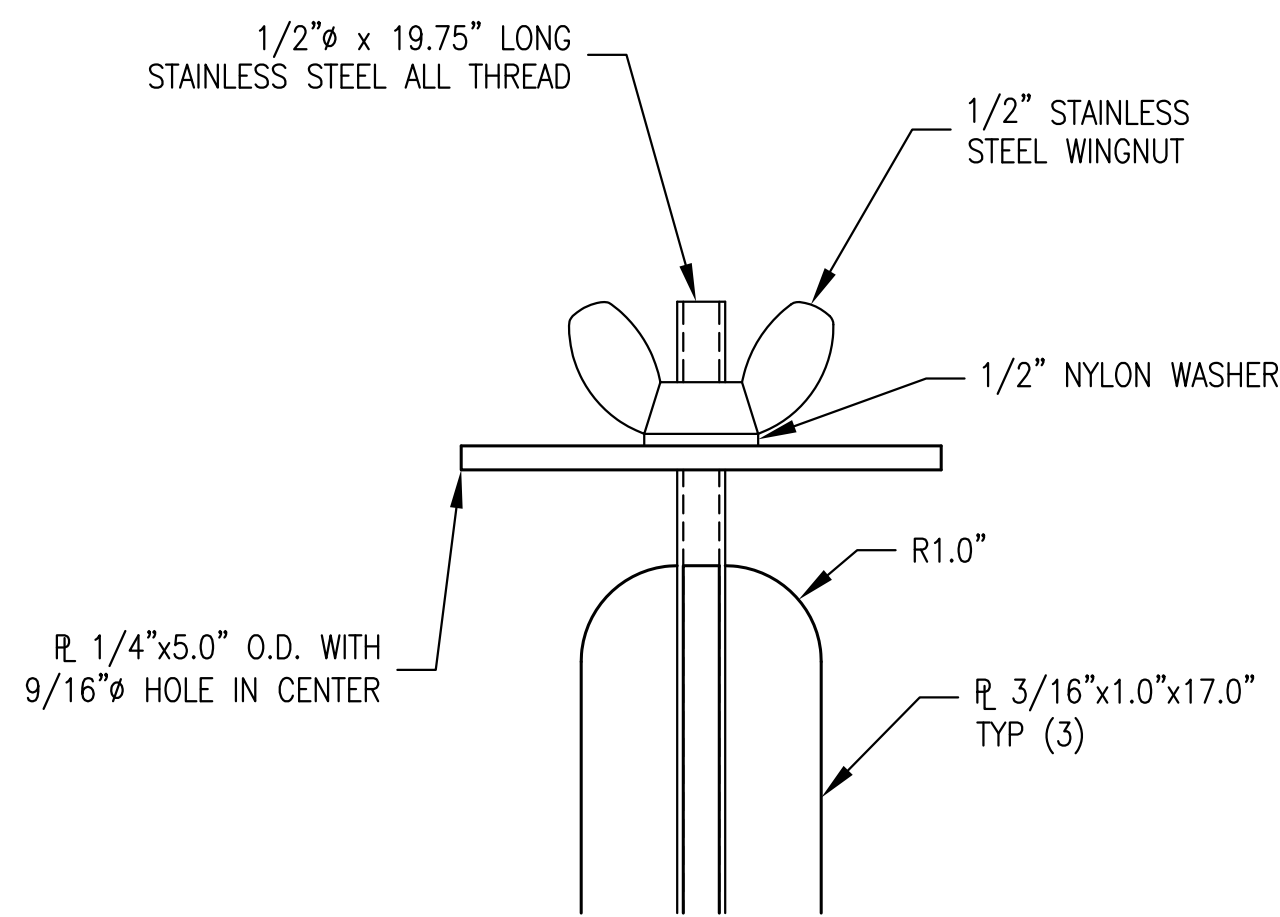


3 ELEMENT RETAINER CAP
 M5.5 1/2" = 1"

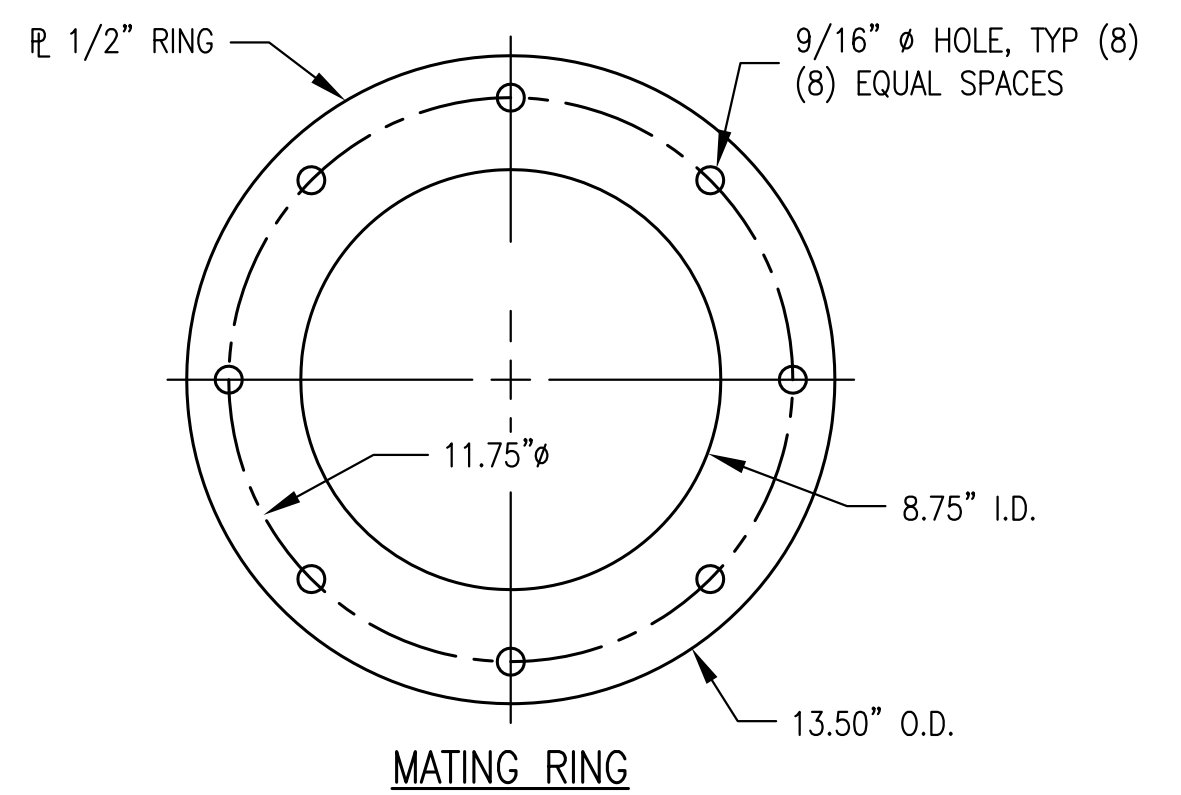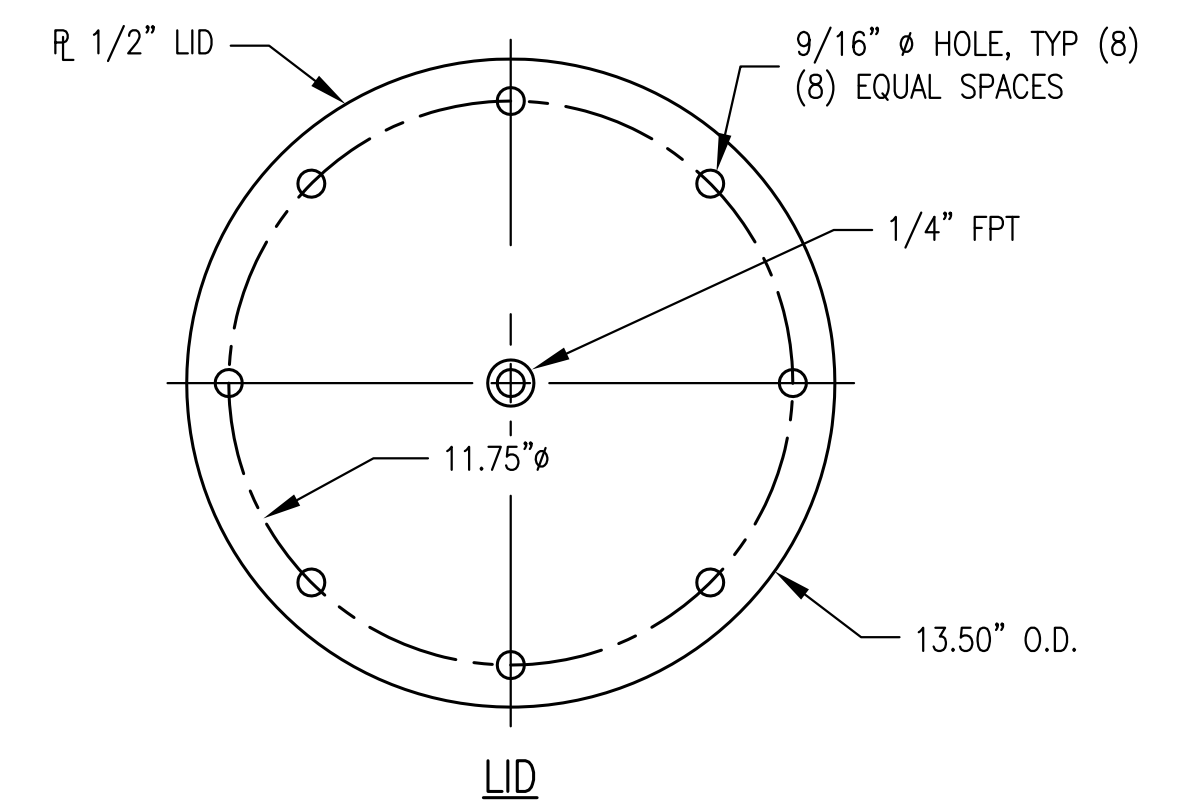


6 LID & MATING RING - PLAN VIEW
 M5.5 1/4" = 1"

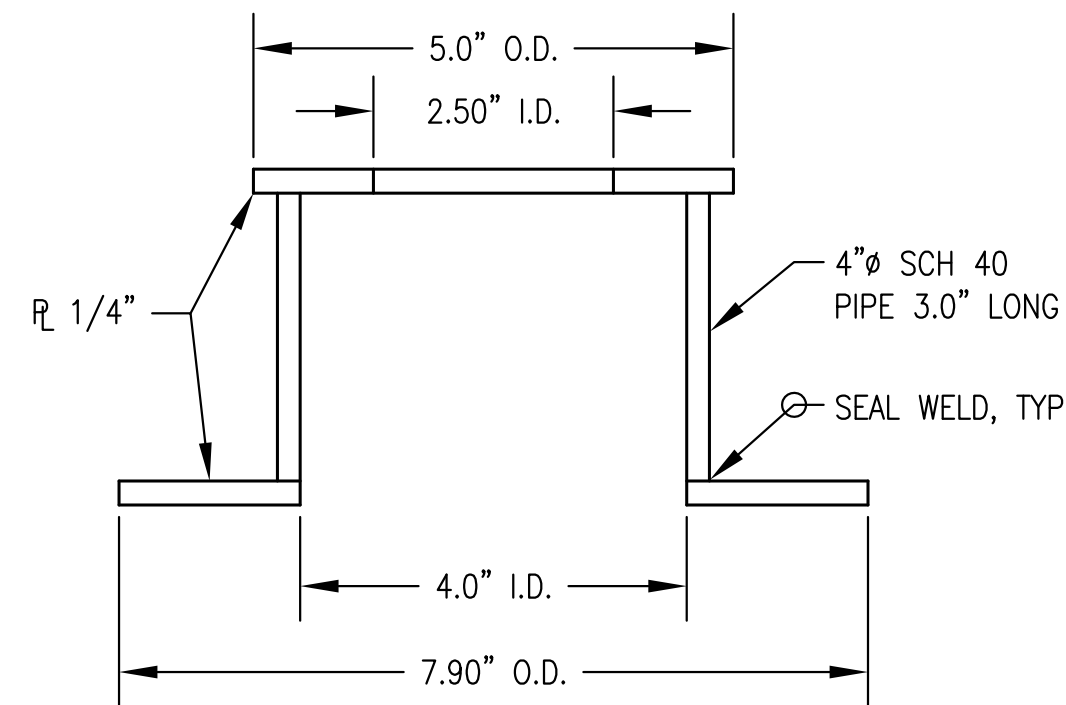

4 ELEMENT BASE STAND
 M5.5 1/2" = 1"

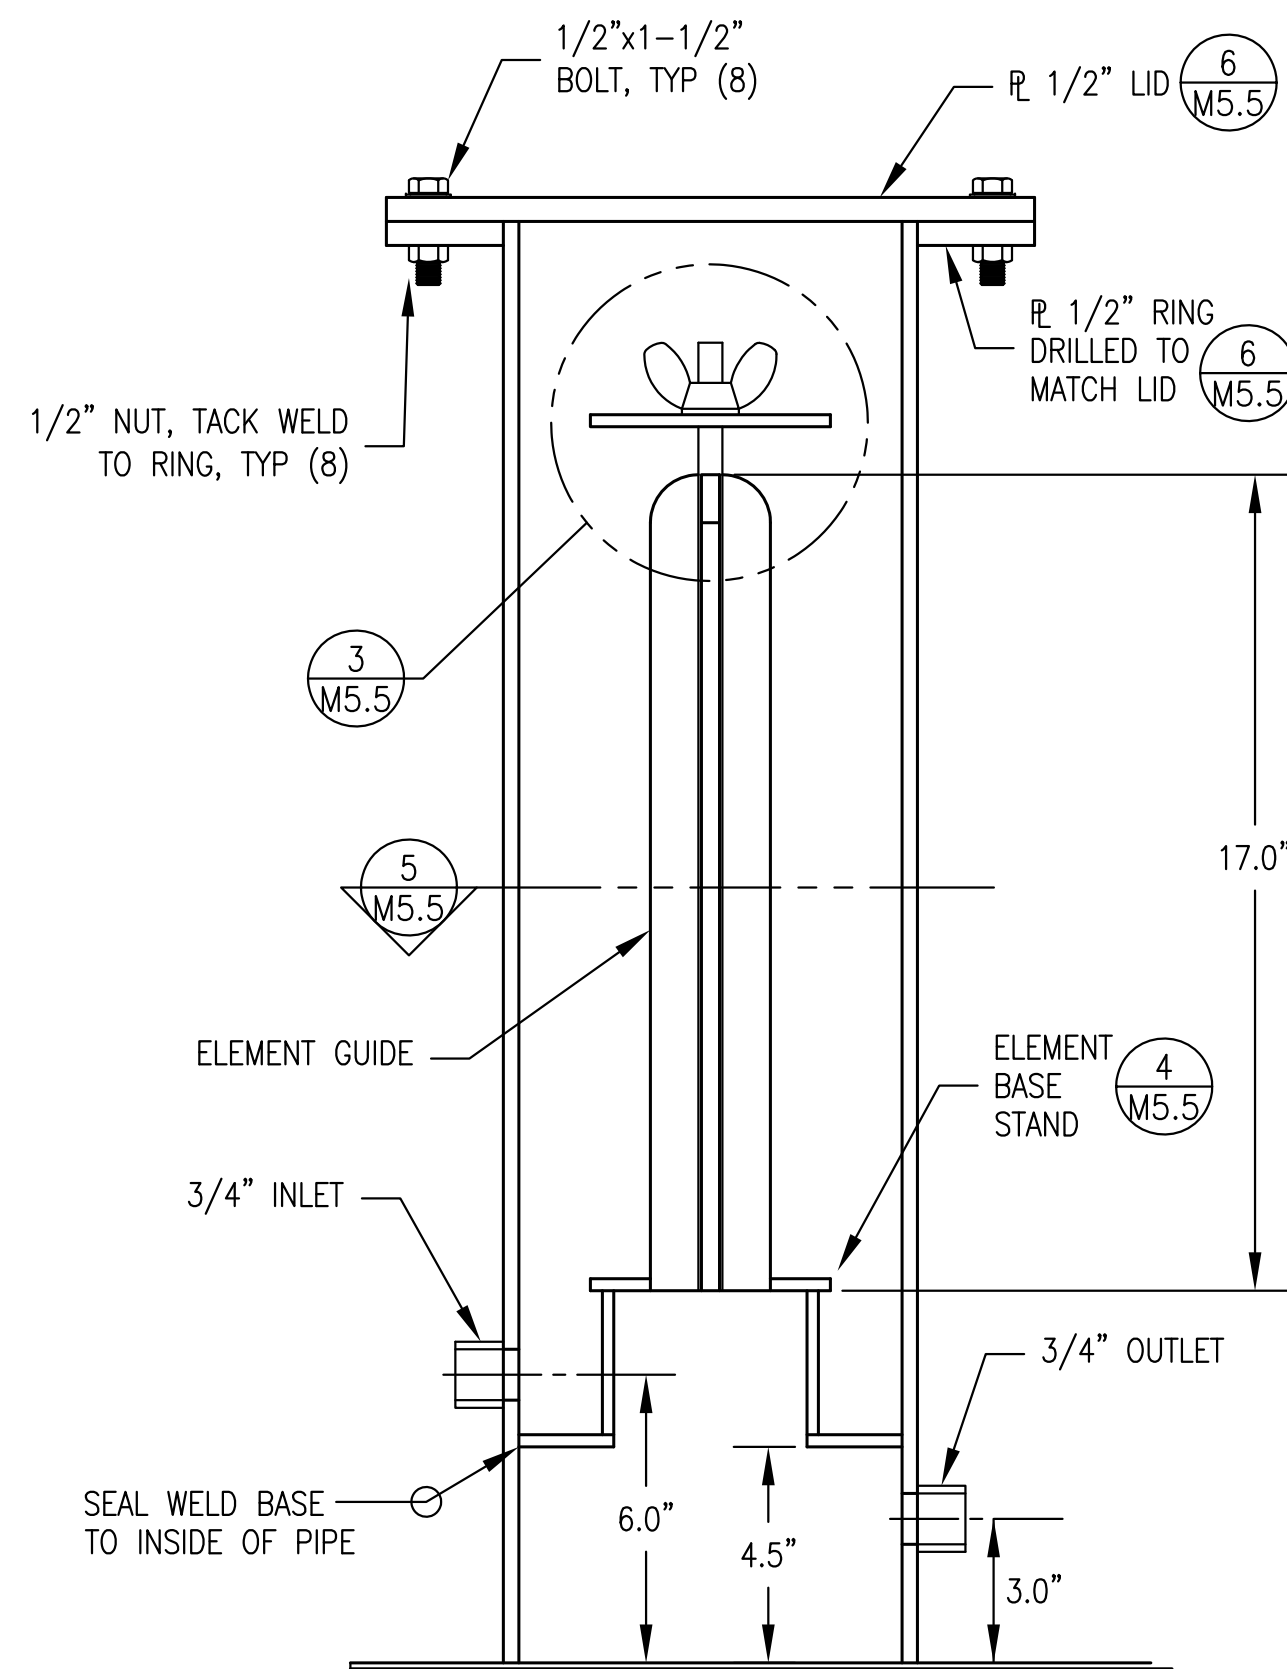

2 TYPICAL SECTION THROUGH FILTER HOUSING
 M5.5 1/4" = 1"

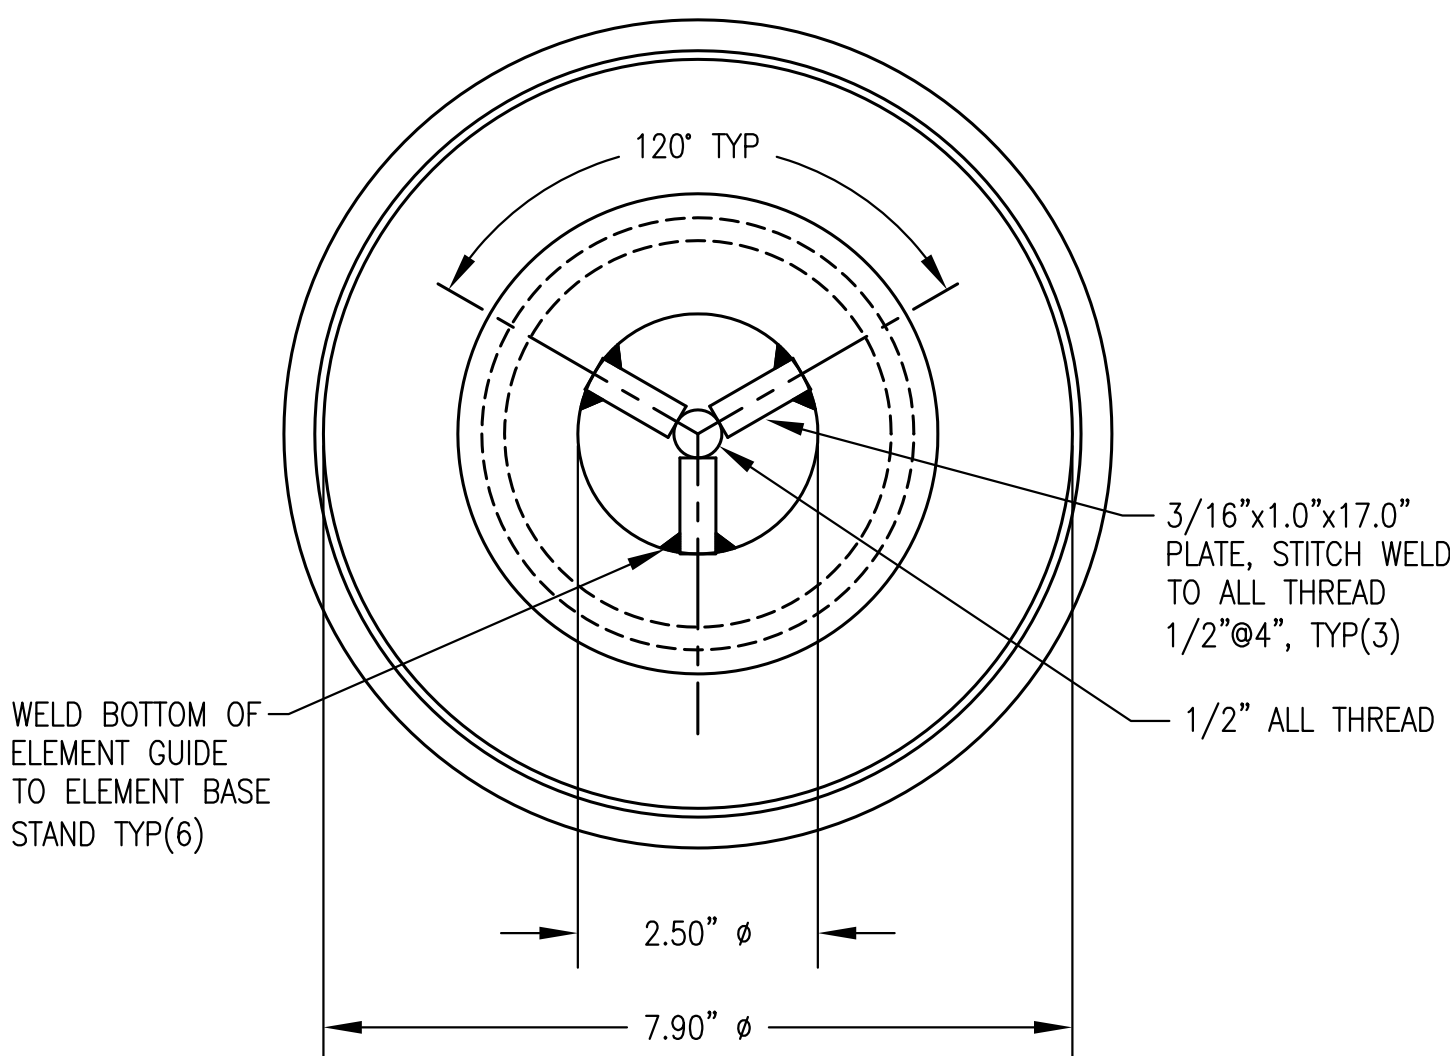

5 SECTION THROUGH ELEMENT GUIDE
 M5.5 1/2" = 1"

REVISIONS	DESCRIPTION
REV/ DATE	


VERIFY SCALES
 0 1"
 THIS BAR REPRESENTS
 ONE INCH ON ORIGINAL
 DRAWING




DATE: 1/14/19
 DRAWN BY: JTD
 CHECKED BY: BCG
 JOB NUMBER:

DRAWING TITLE:
 USED OIL BLENDER
 TYPICAL FILTER
 HOUSING DETAILS


ISSUED FOR CONSTRUCTION JANUARY 2019

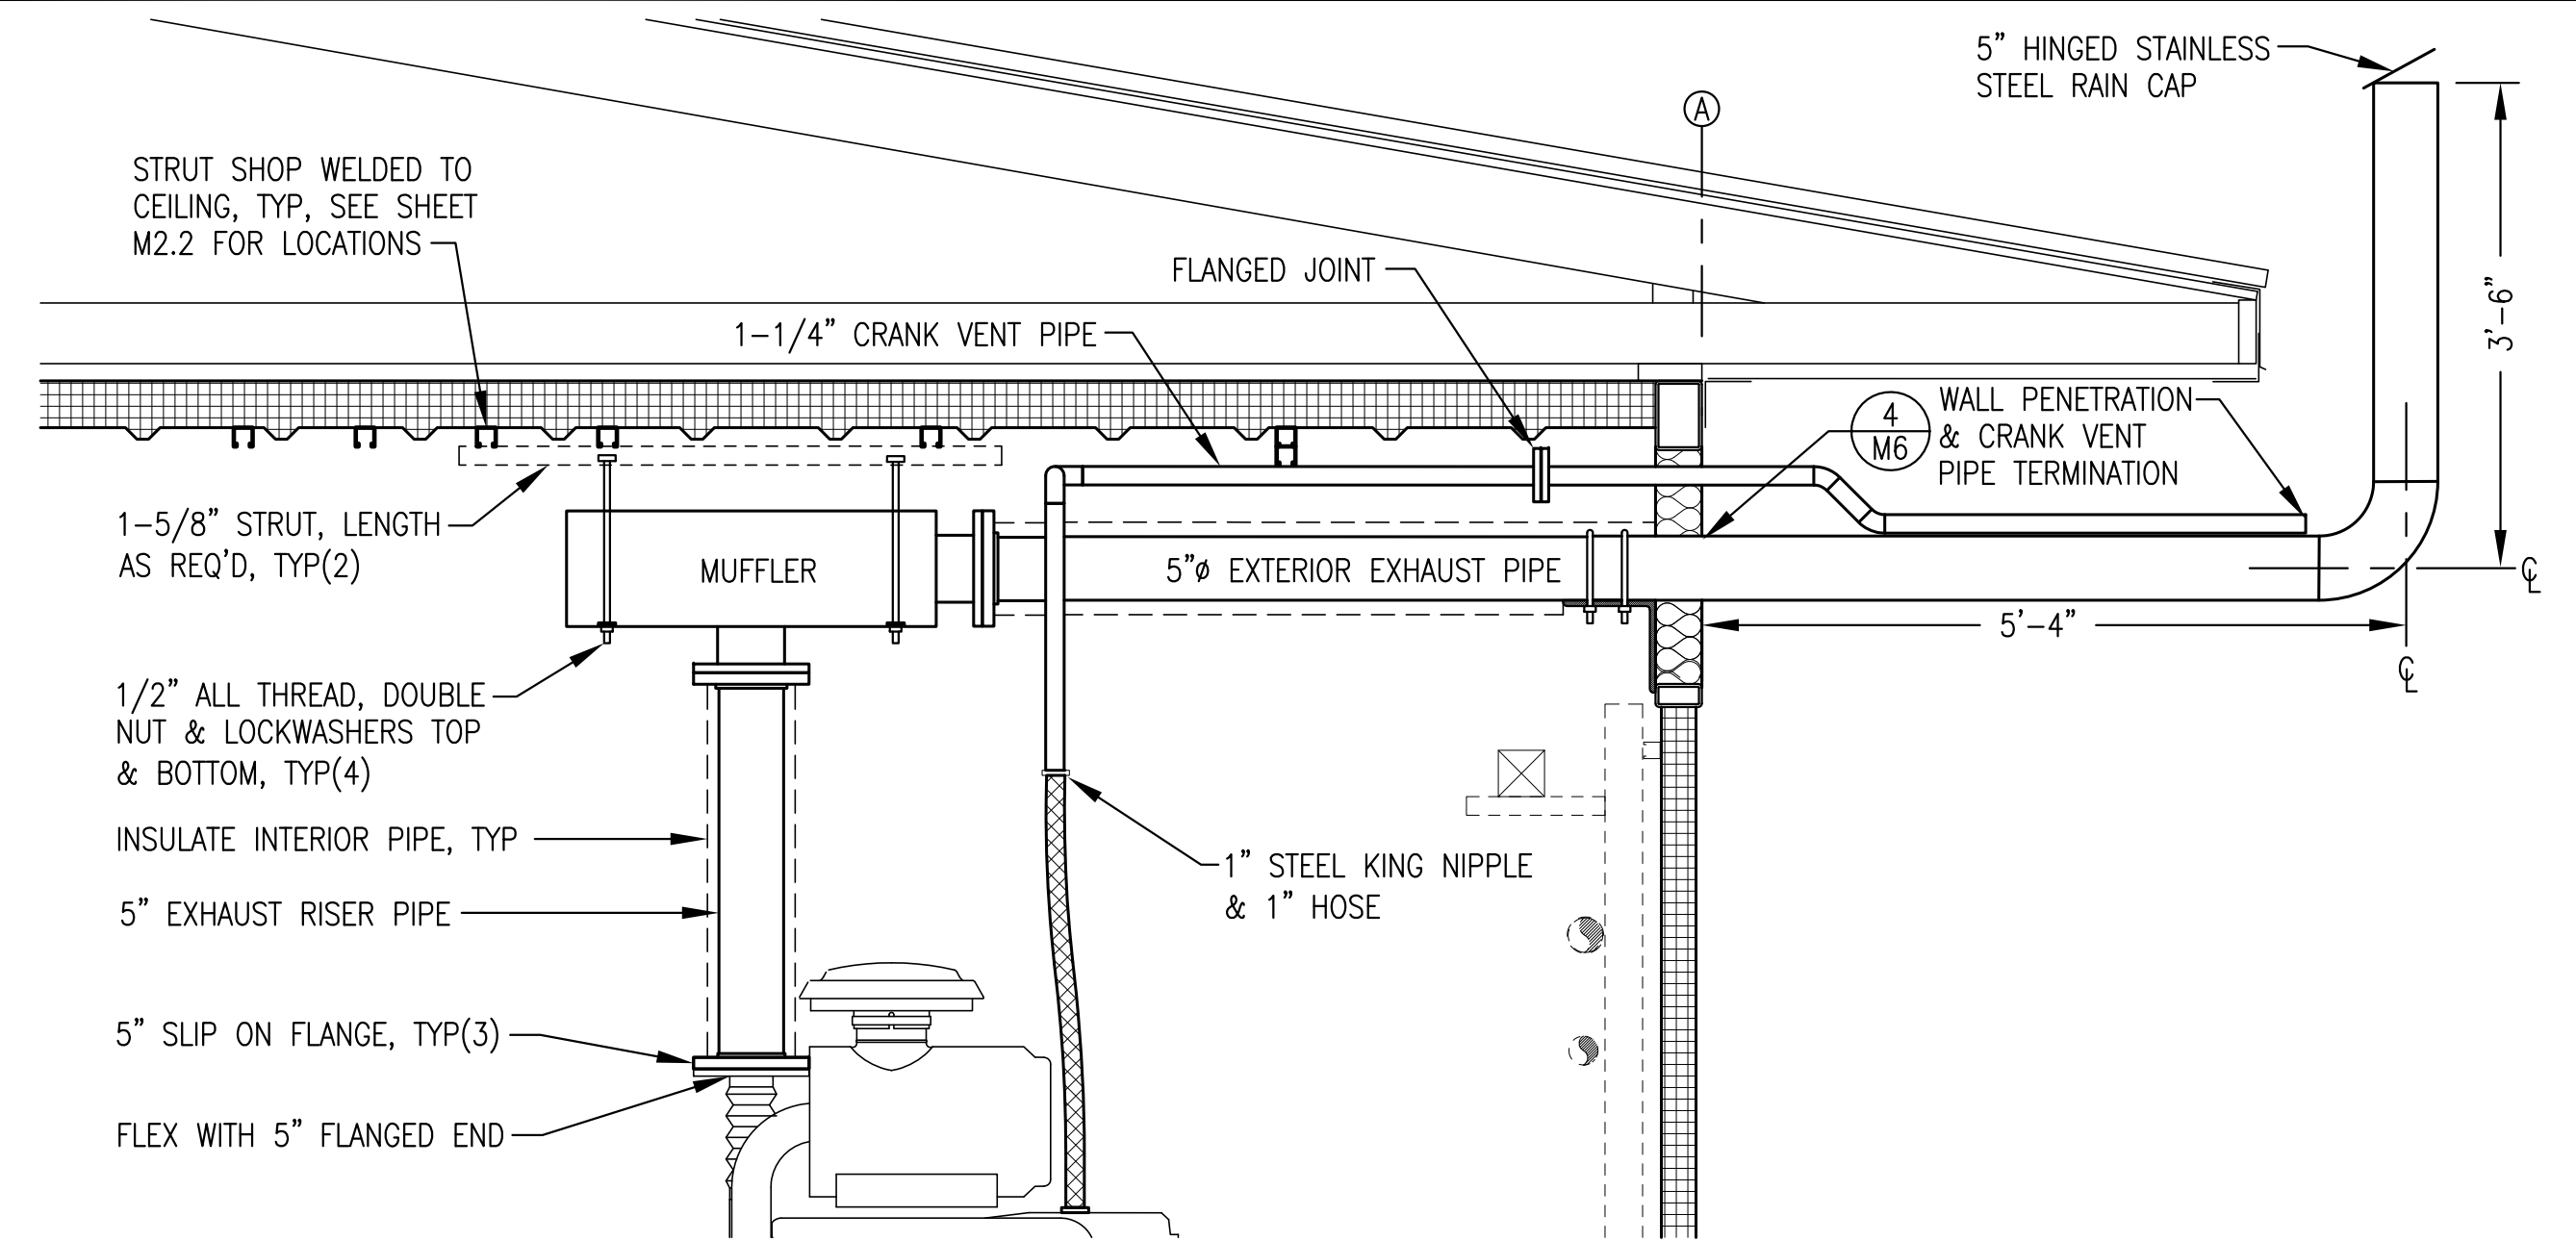


1 GEN #1 MUFLER, EXHAUST & CRANK VENT PIPE INSTALLATION
 3/4"=1'-0"

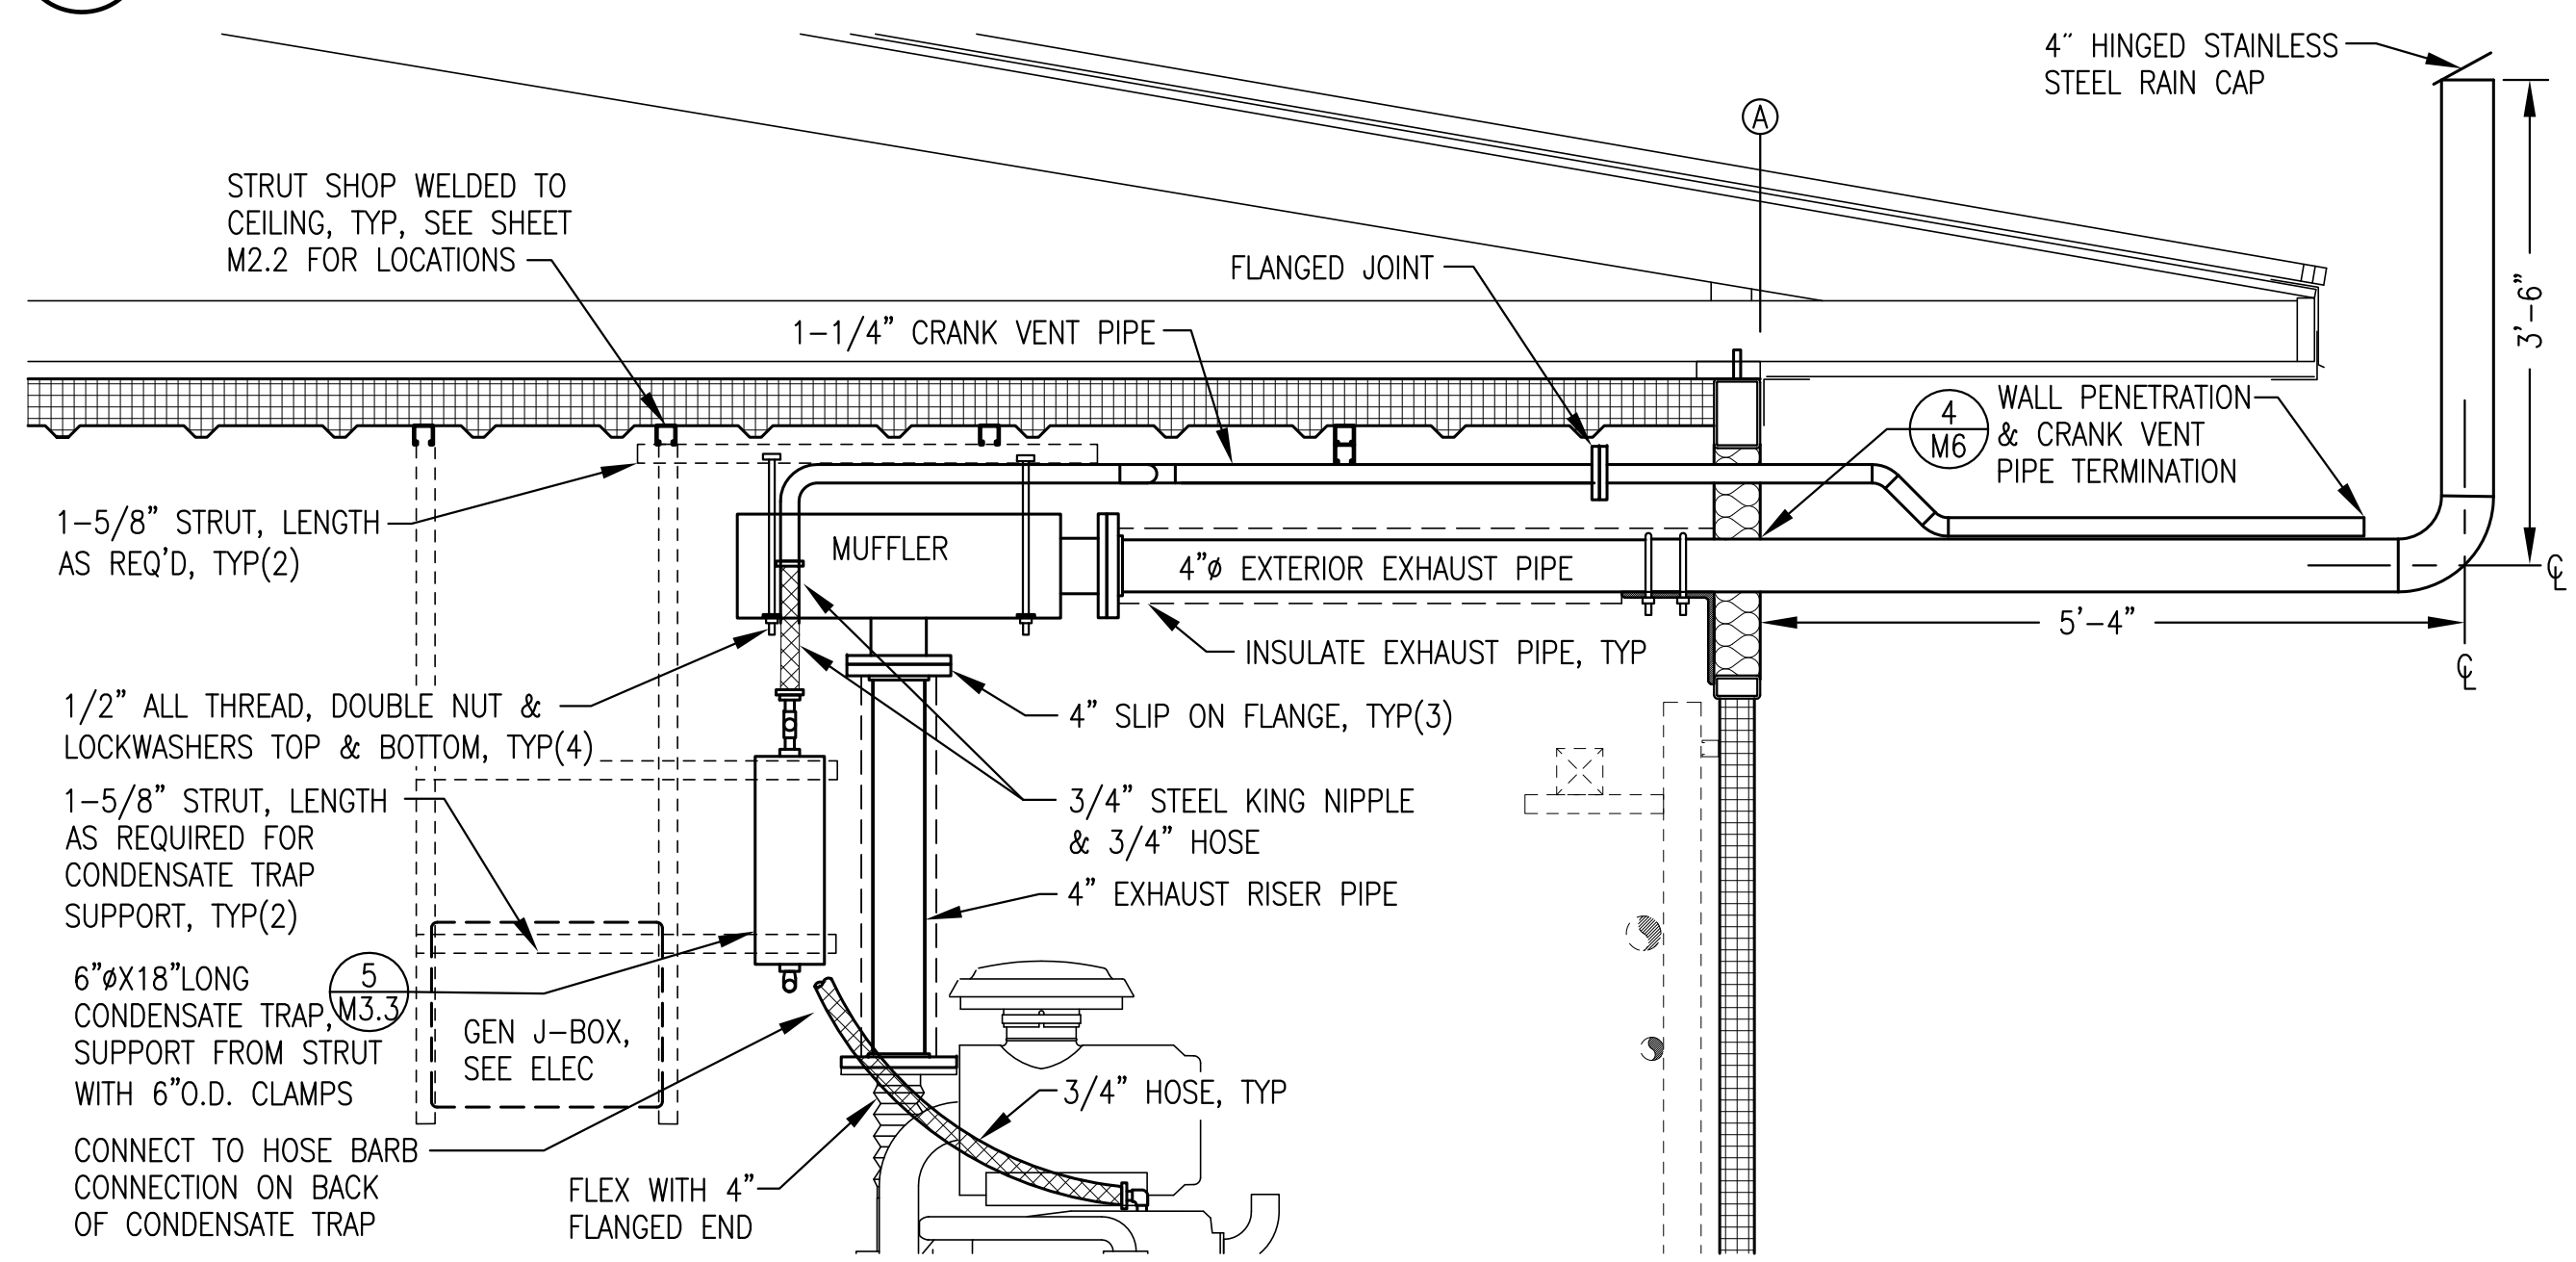

2 GEN #2/#3 MUFLER, EXHAUST, CONDENSATE TRAP & CRANK VENT PIPE INSTALLATION
 3/4"=1'-0"

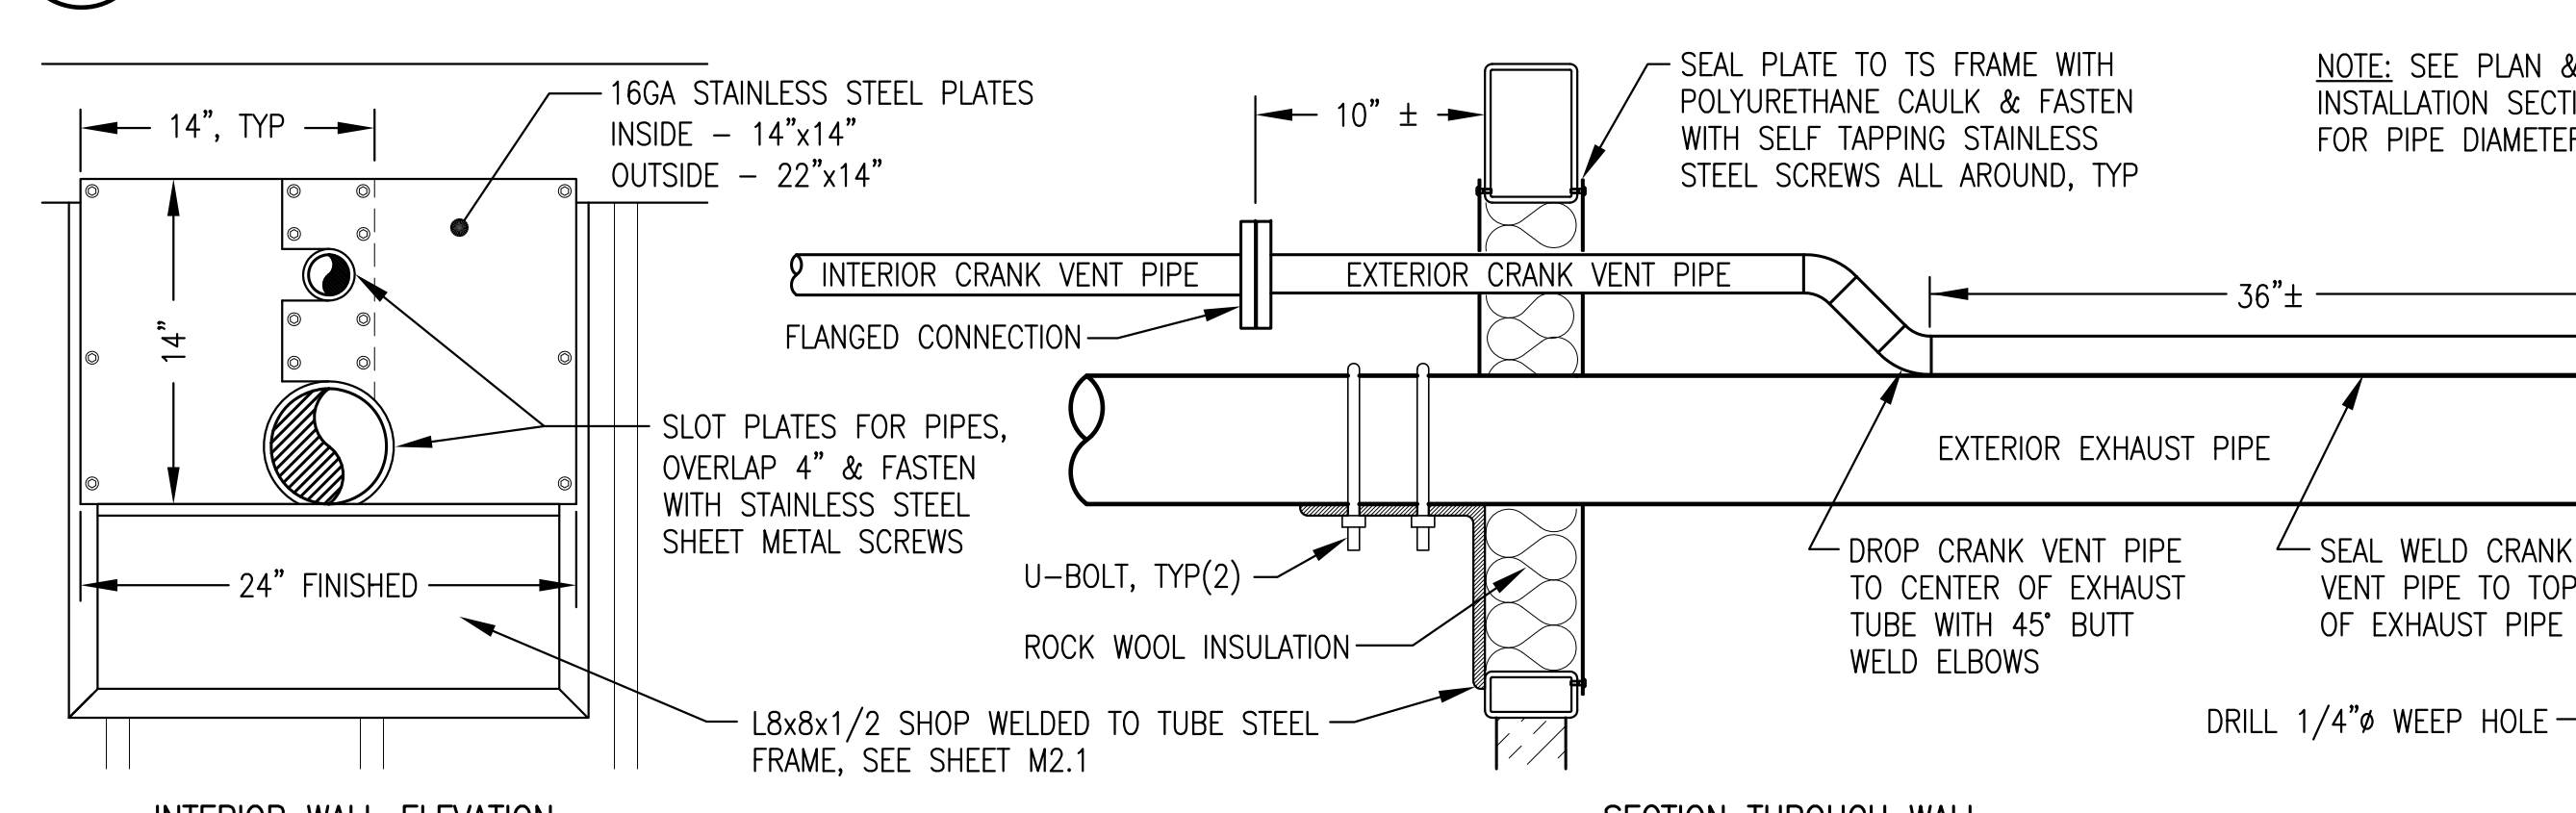

4 WALL PENETRATION & CRANK VENT PIPE TERMINATION
 NO SCALE

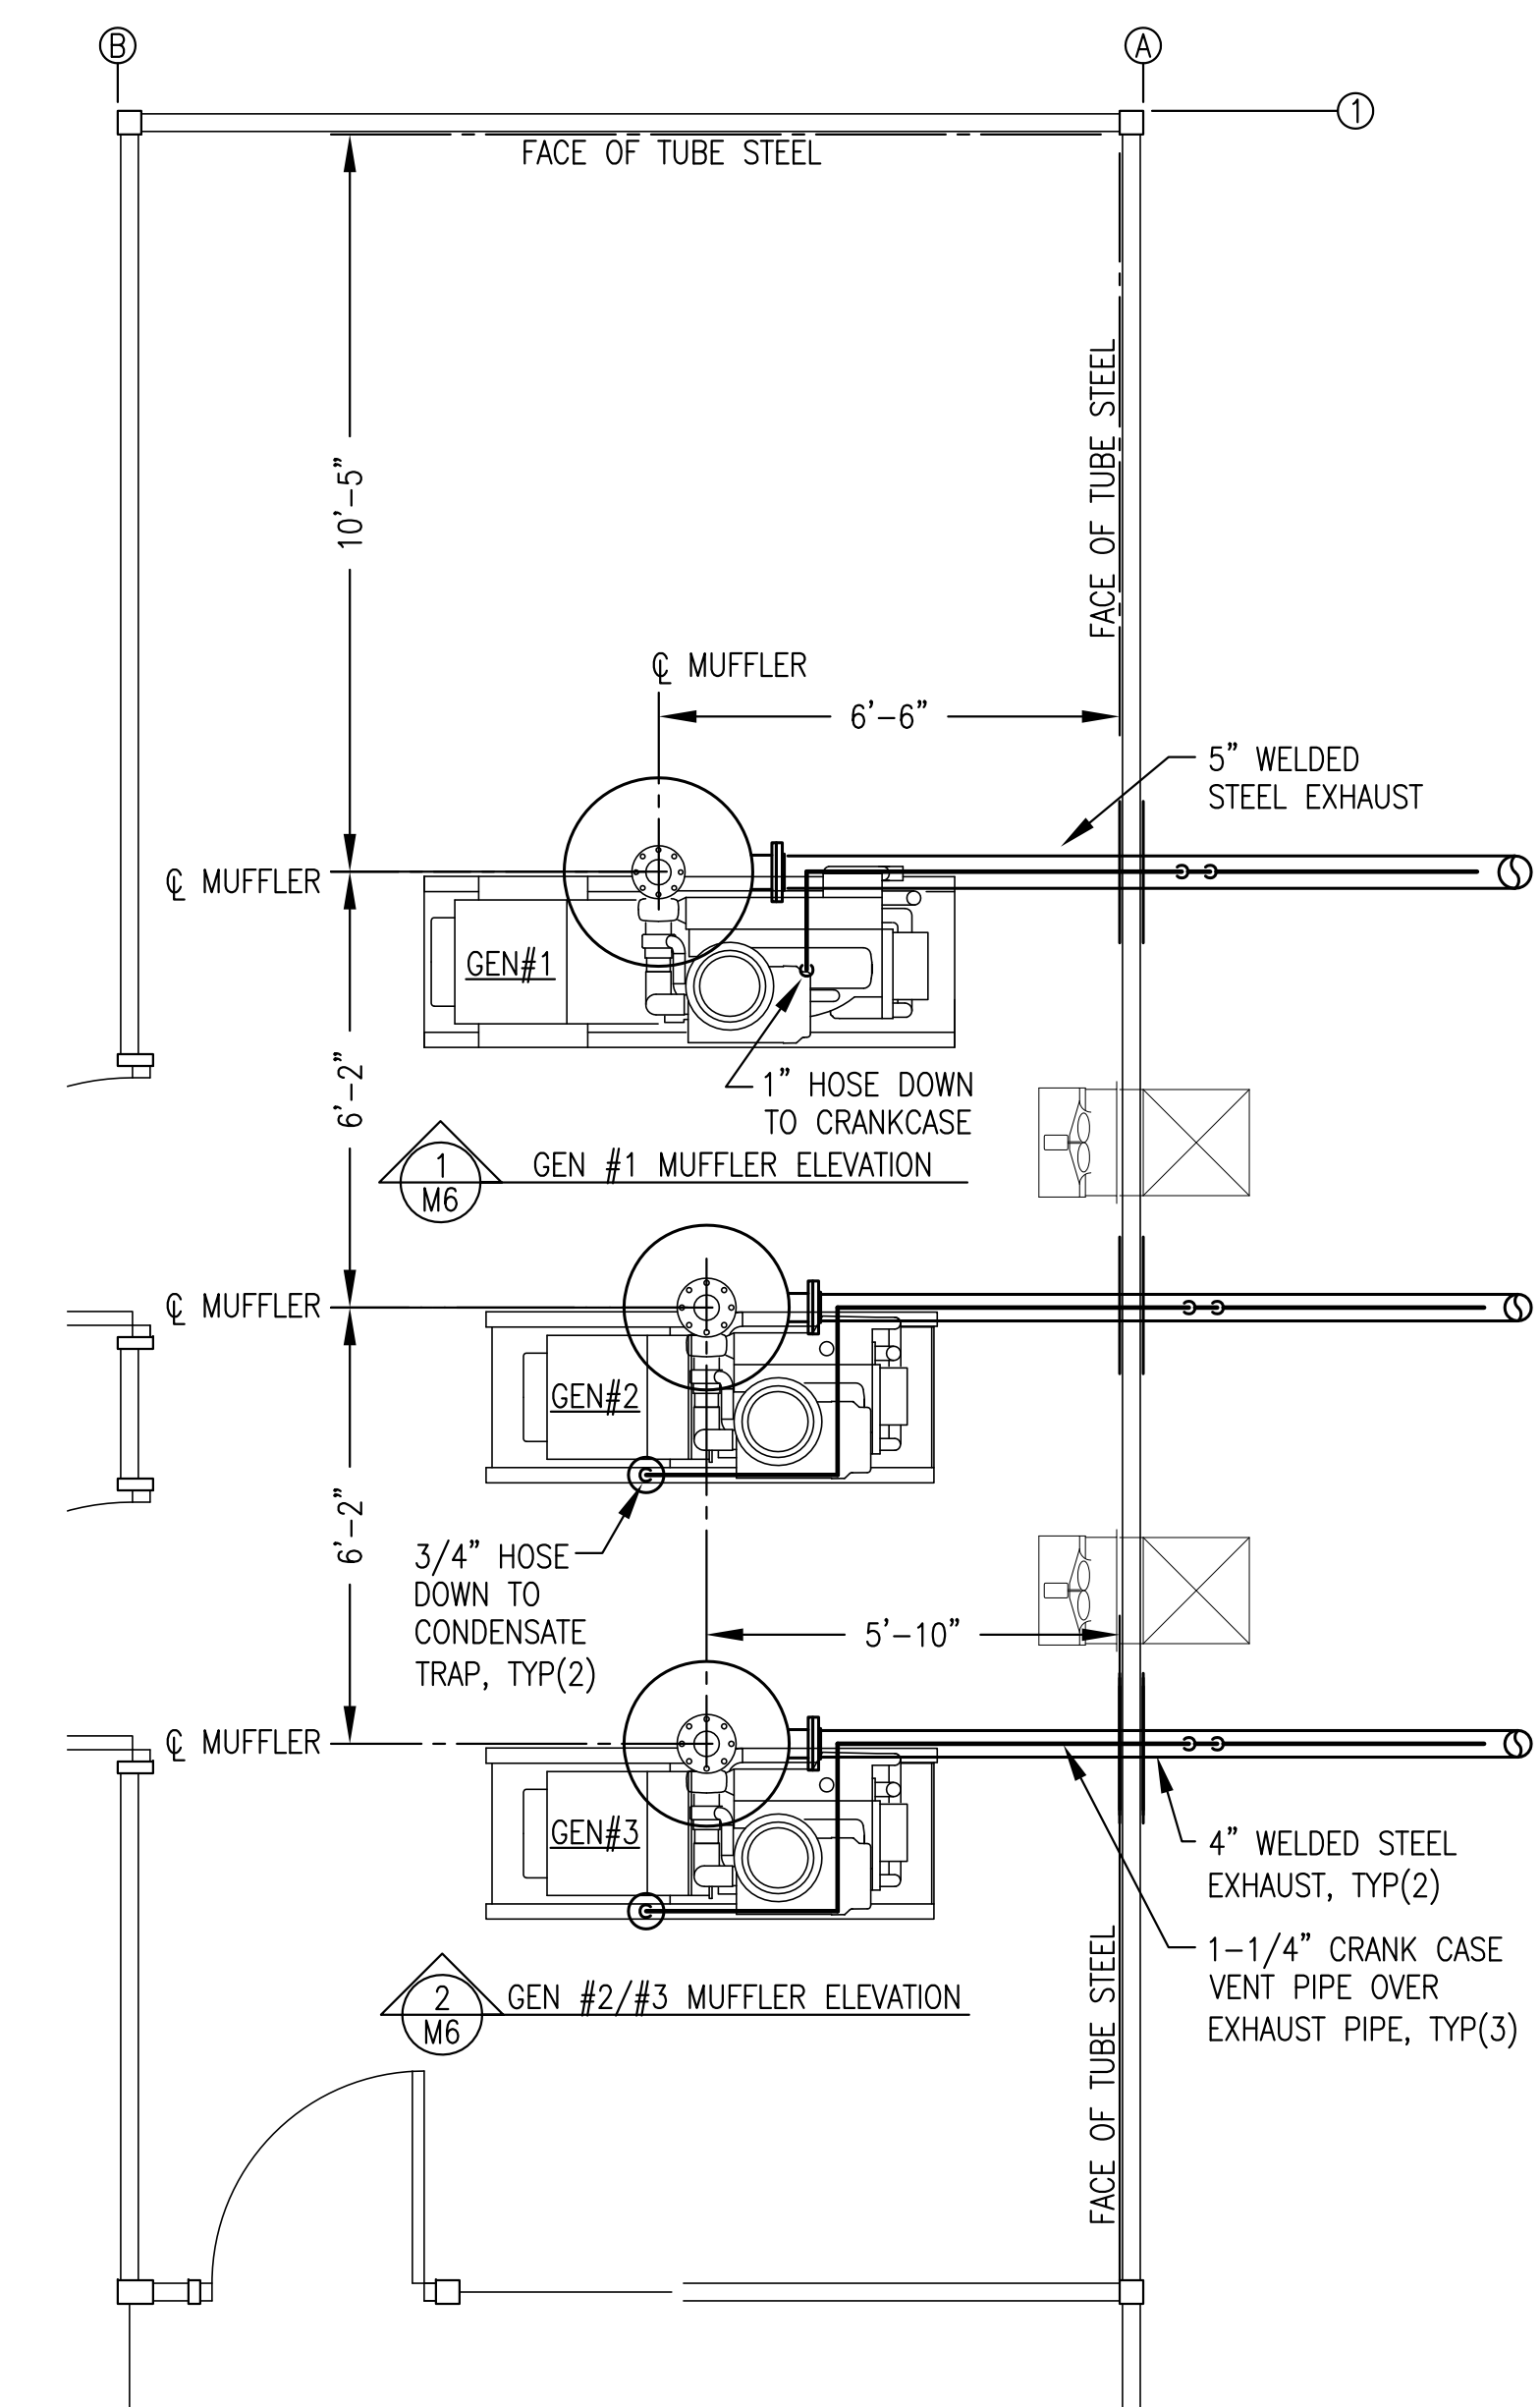

3 MUFLER, EXHAUST & CRANK VENT PIPE PLAN
 3/8"=1'-0"

EXHAUST & CRANK VENT GENERAL NOTES:

- 1) ALL EXTERIOR EXHAUST PIPE AND FITTINGS (FROM MUFLER TO RAIN CAP) TYPE 304L STAINLESS STEEL WITH BUTT WELD FITTINGS. INTERIOR EXHAUST PIPE RISER (FROM FLEX TO MUFLER) CARBON STEEL OR MAY BE STAINLESS AT CONTRACTORS OPTION. ALL FLANGES ANSI 150# FLAT FACED SLIP ON.
- 2) ALL EXTERIOR CRANK VENT PIPE AND FITTINGS TYPE 304L STAINLESS STEEL WITH BUTT WELD FITTINGS. ALL INTERIOR CRANK VENT PIPE AND FITTINGS CARBON STEEL WITH SOCKET WELD FITTINGS OR MAY BE STAINLESS AT CONTRACTORS OPTION. ALL FLANGES ANSI 150# FLAT FACED SOCKET WELD.
- 3) ALL EXHAUST FLANGE BOLTS BLACK OR STAINLESS STEEL. COAT WITH HIGH TEMPERATURE ANTI-SIEZE.

EXHAUST & CRANK VENT SHOP/ON-SITE NOTES:

- 1) SHOP FABRICATE COMPLETE EXHAUST AND CRANK VENT PIPING SYSTEM AS INDICATED.
- 2) SHOP INSTALL INSULATION FROM FLEX TO MUFLER. SHOP FIT INSULATION FROM MUFLER TO WALL, LABEL FOR THE ASSOCIATED GENERATOR AND STORE INSIDE MODULE.
- 3) SHOP FABRICATE STAINLESS STEEL COVER PLATES BUT DO NOT INSTALL. LABEL COVER PLATES FOR THE ASSOCIATED GENERATOR AND STORE INSIDE MODULE.
- 4) UPON COMPLETION OF TESTING BREAK EXHAUST FLANGE JOINT ON MUFLER OUTLET AND CRANK VENT FLANGE JOINT AND REMOVE U-BOLTS. REMOVE PIPING FOR SHIPPING AND TEMPORARILY SEAL WALL PENETRATION.
- 5) IN FIELD REINSTALL PIPING WITH NEW FLANGE GASKETS. RE-INSTALL PIPING INSULATION. INSULATE WALL PENETRATION, INSTALL COVER PLATES, AND SEAL TO WALL.

U M I A Q
 6700 Arctic Spur Road
 Anchorage, AK 99518
 (907) 677-8220

Stassel Engineering, Inc.
 P.O. 111405
 Anchorage, AK 99511
 (907) 949-0100


**STATE OF ALASKA, AIDEA/AEA
 RURAL POWER SYSTEM UPGRADE**

**CLARKS POINT POWER PLANT
 CLARKS POINT, ALASKA**

CONSTRUCTION DOCUMENTS

REVISIONS	DESCRIPTION

VERIFY SCALES
 0 1"
 THIS BAR REPRESENTS ONE INCH ON ORIGINAL DRAWING

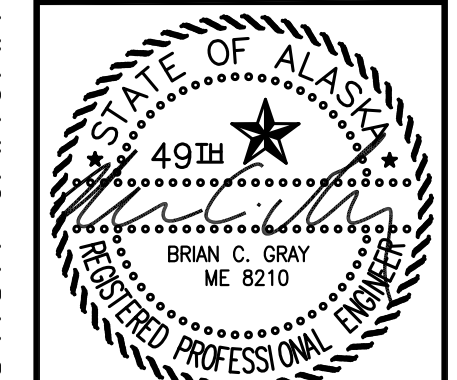


DATE: 1/14/19
 DRAWN BY: JTD
 CHECKED BY: BCG
 JOB NUMBER:


DRAWING TITLE:
 EXHAUST & CRANK VENT
 PLAN & DETAILS

M6
 SHEET OF 7


ISSUED FOR CONSTRUCTION JANUARY 2019

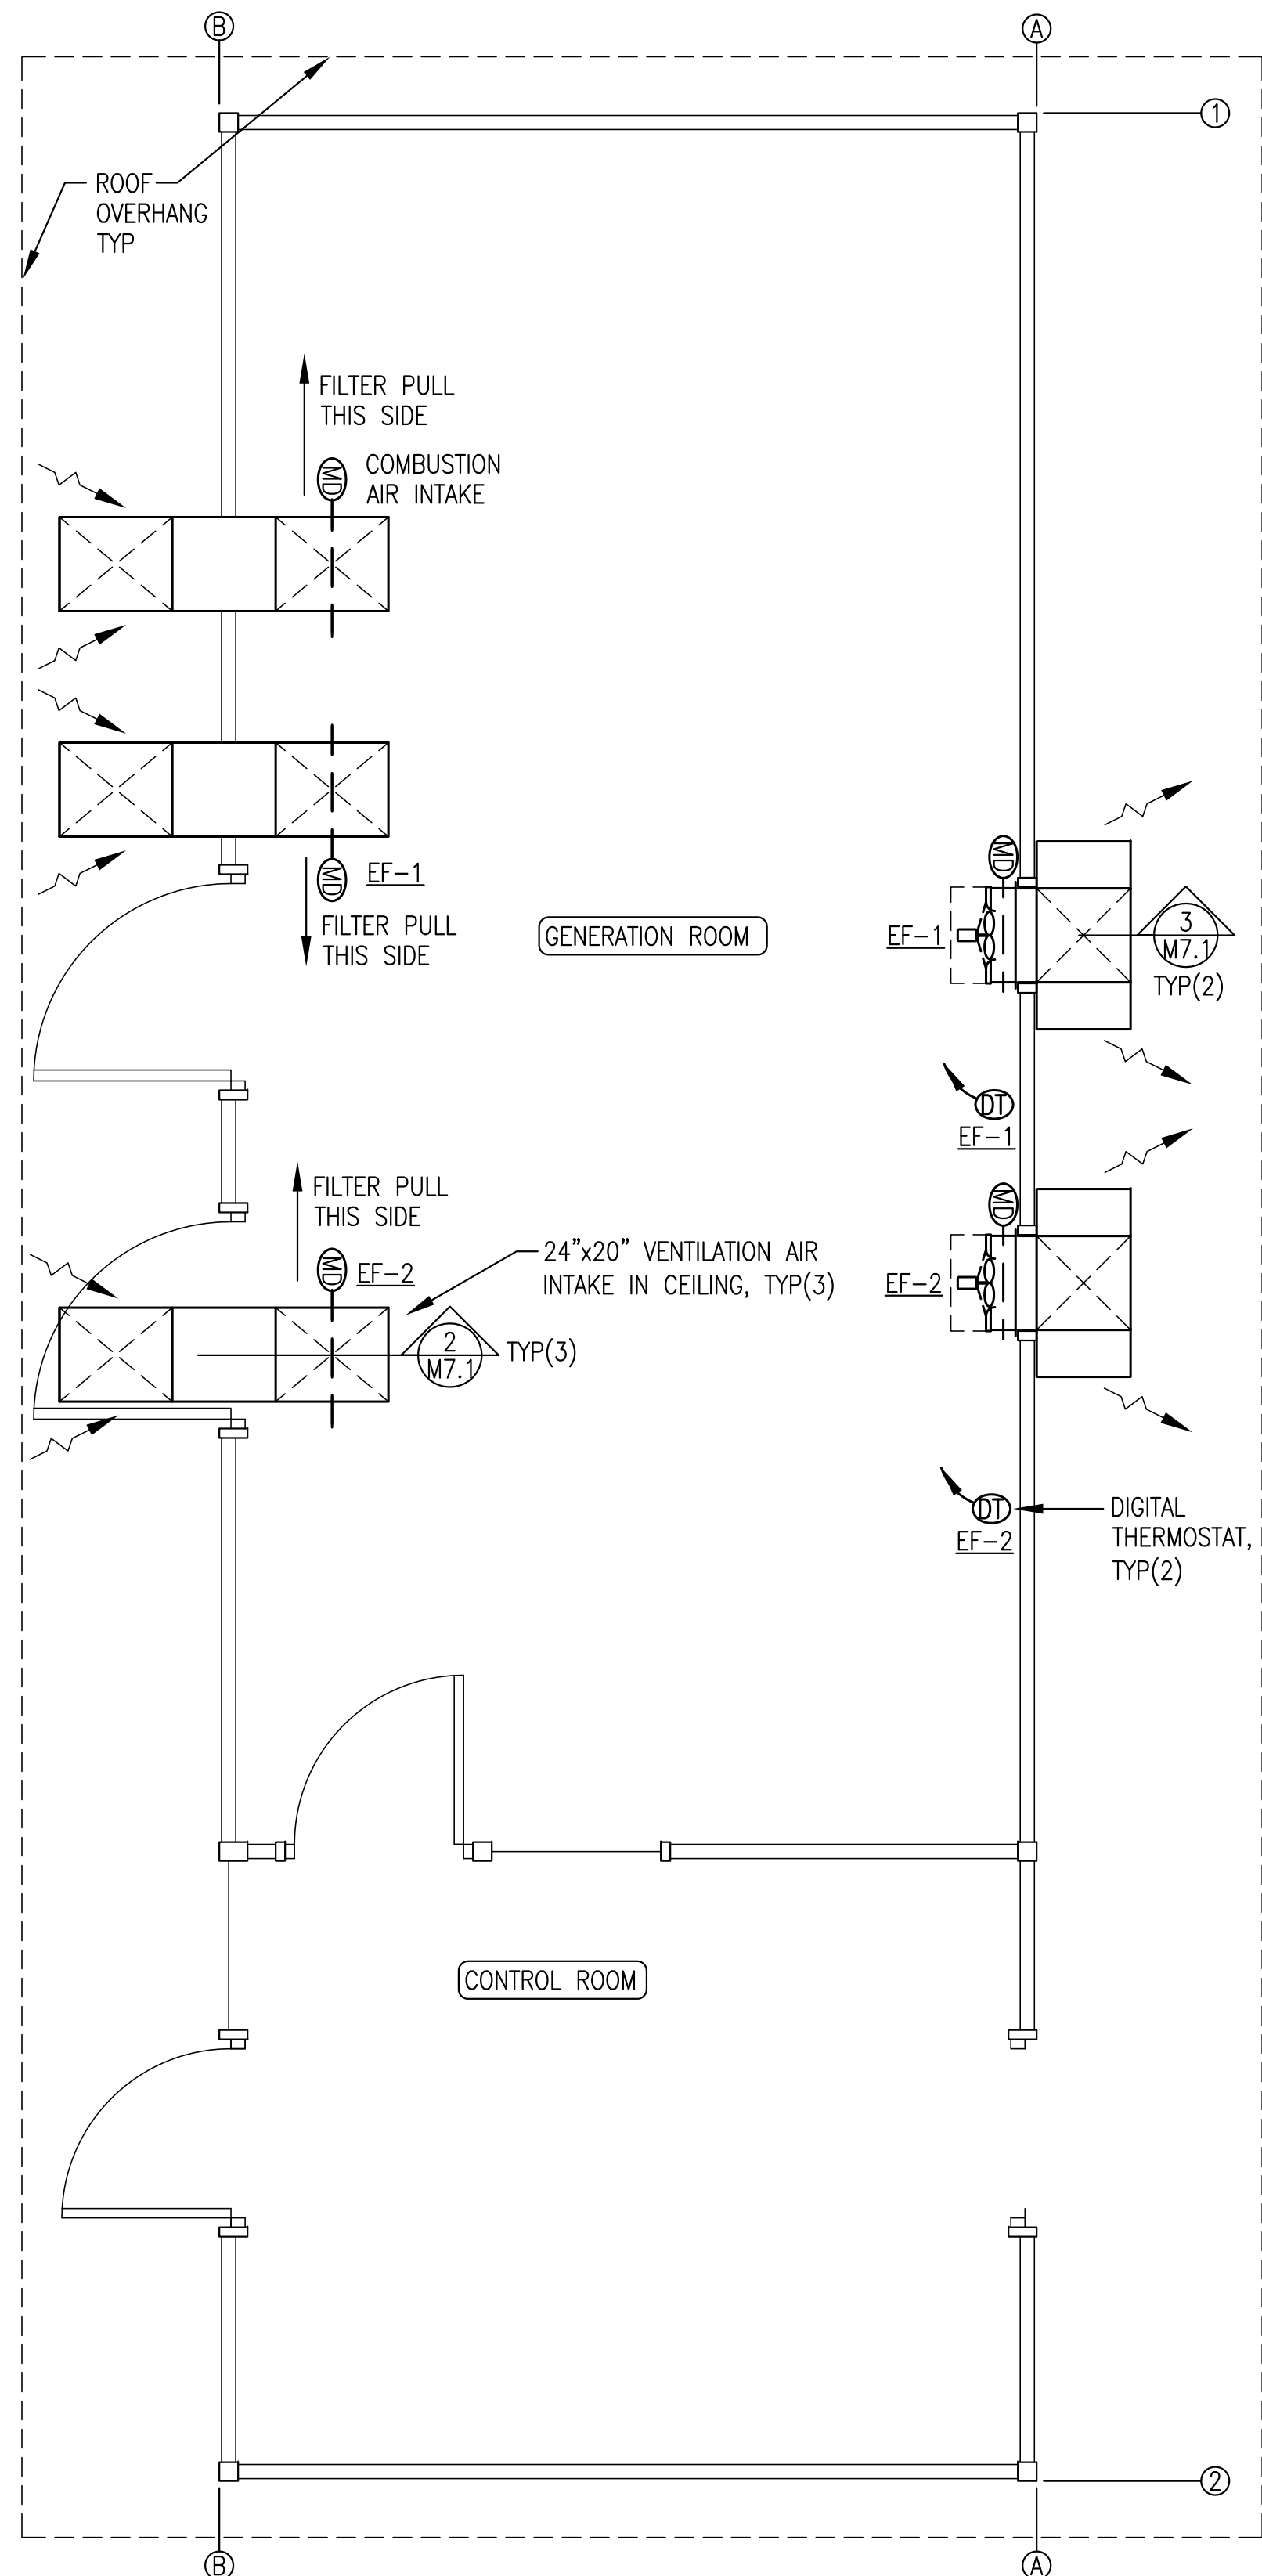

1 VENTILATION PLAN
M7.1 3/8"=1'-0"

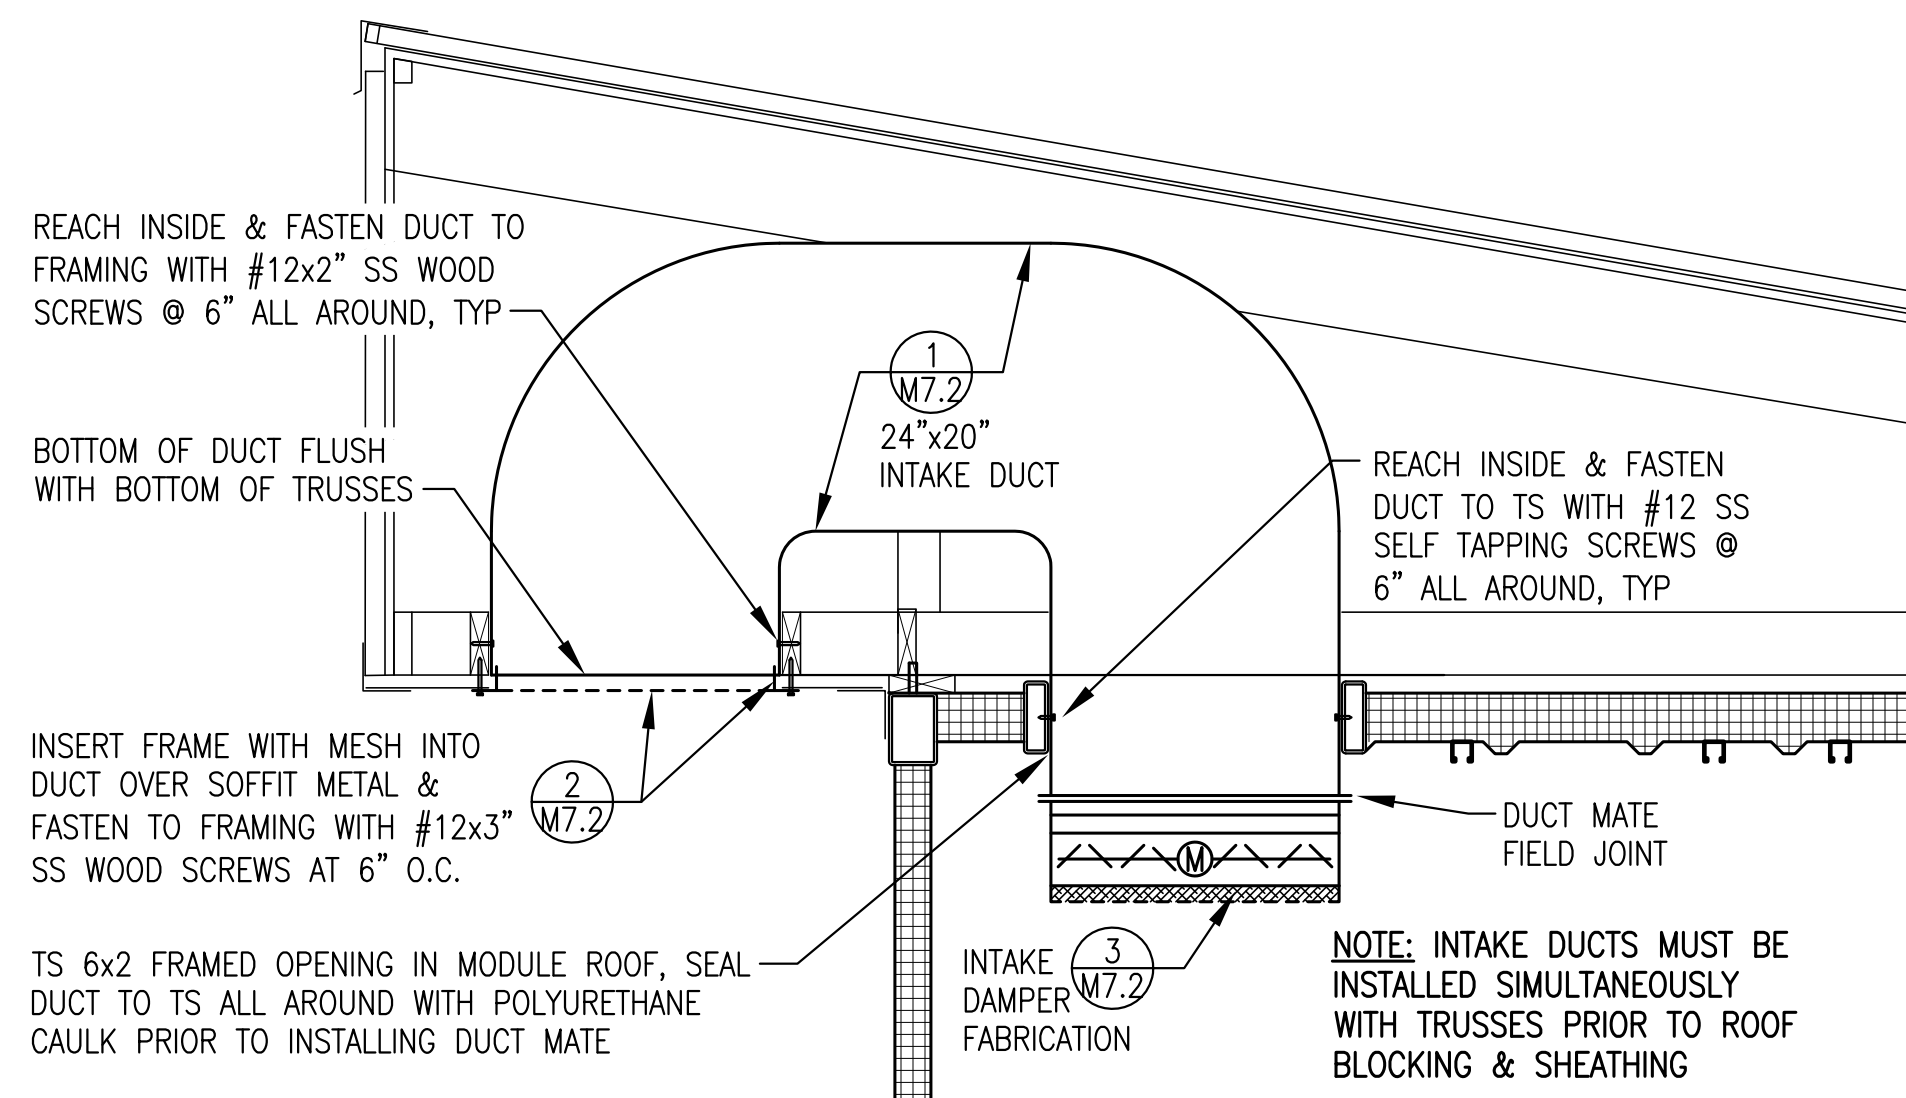


2 INTAKE DUCT INSTALLATION
M7.1 3/4"=1'-0"

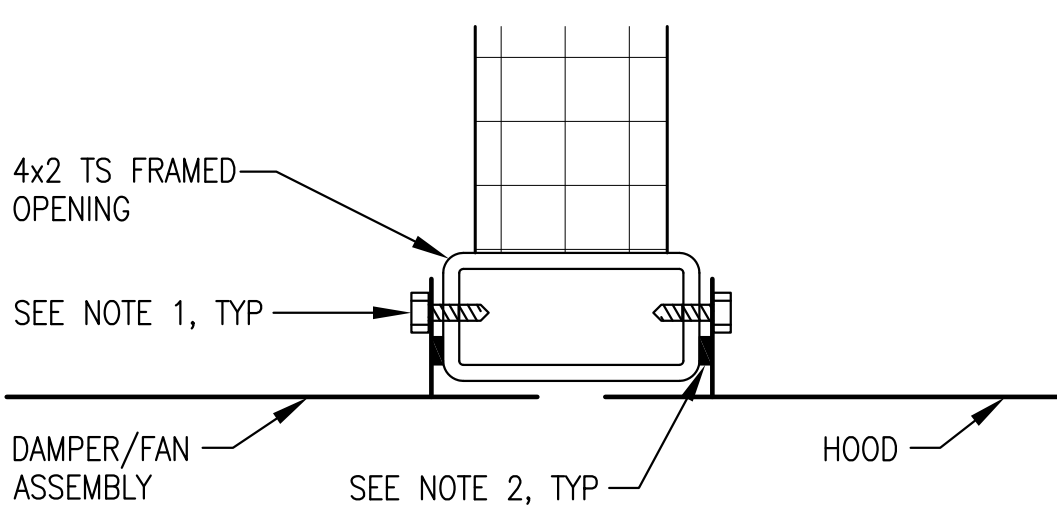

4 TYPICAL WALL PENETRATION
M7.1 4"=1'-0"


- NOTES:
- 1) FASTEN MOUNTING FLANGE TO TS WITH #12 STAINLESS STEEL SELF TAPPING SCREWS. ON HOODS FASTEN ON TOP AND SIDES ONLY. ON EXHAUST FANS FASTEN ON SIDES ONLY.
 - 2) SEAL MOUNTING FLANGE TO TS WITH CONTINUOUS BEAD OF POLYURETHANE CAULKING ALL AROUND.

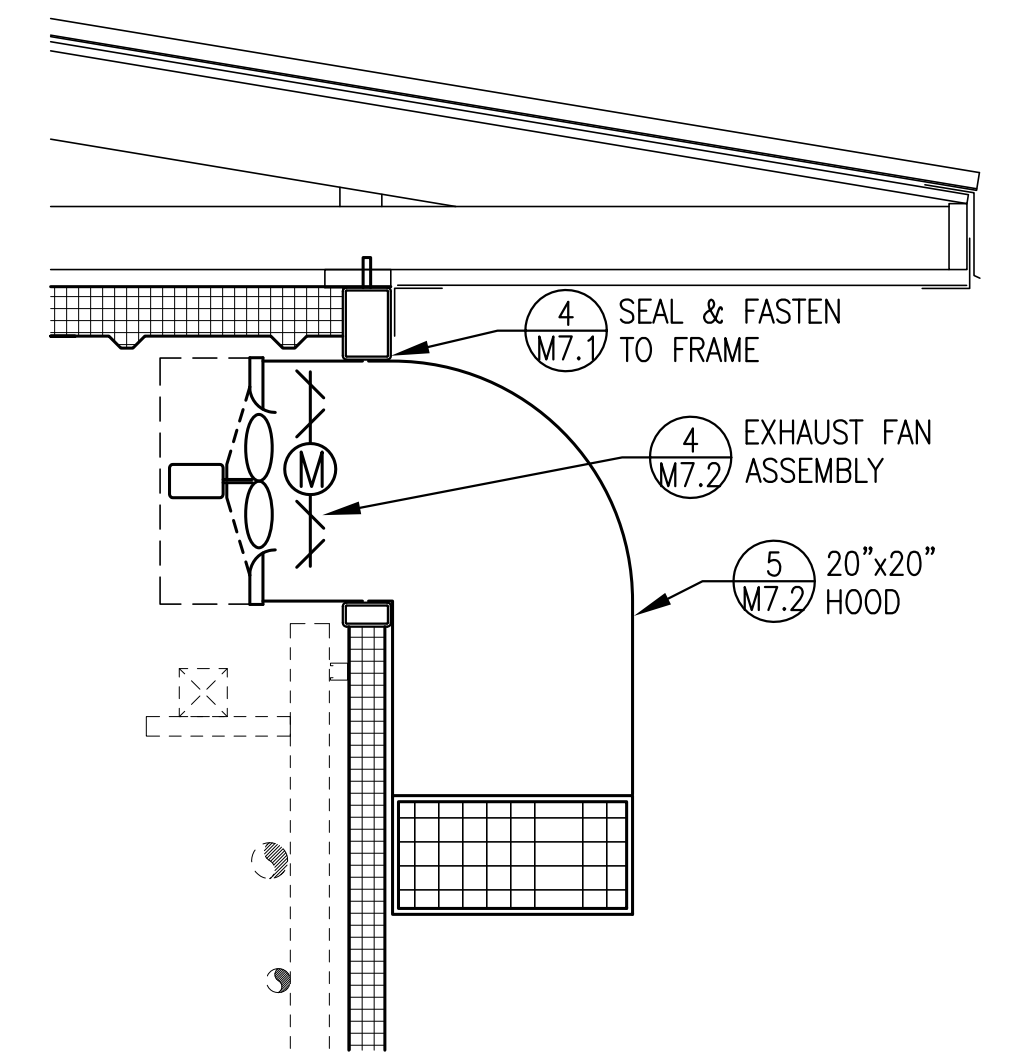

3 EXHAUST FAN INSTALLATION
M7.1 3/4"=1'-0"

CONSTRUCTION DOCUMENTS	
REVISIONS	DESCRIPTION
REV DATE	


VERIFY SCALES
0 1"
THIS BAR REPRESENTS ONE INCH ON ORIGINAL DRAWING

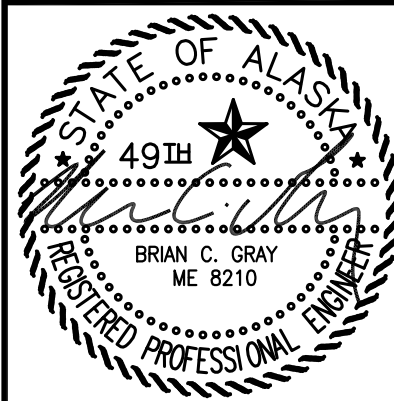


DATE: 1/14/19
DRAWN BY: JTD
CHECKED BY: BCG
JOB NUMBER:

DRAWING TITLE:
VENTILATION
PLAN & DETAILS


ISSUED FOR CONSTRUCTION JANUARY 2019

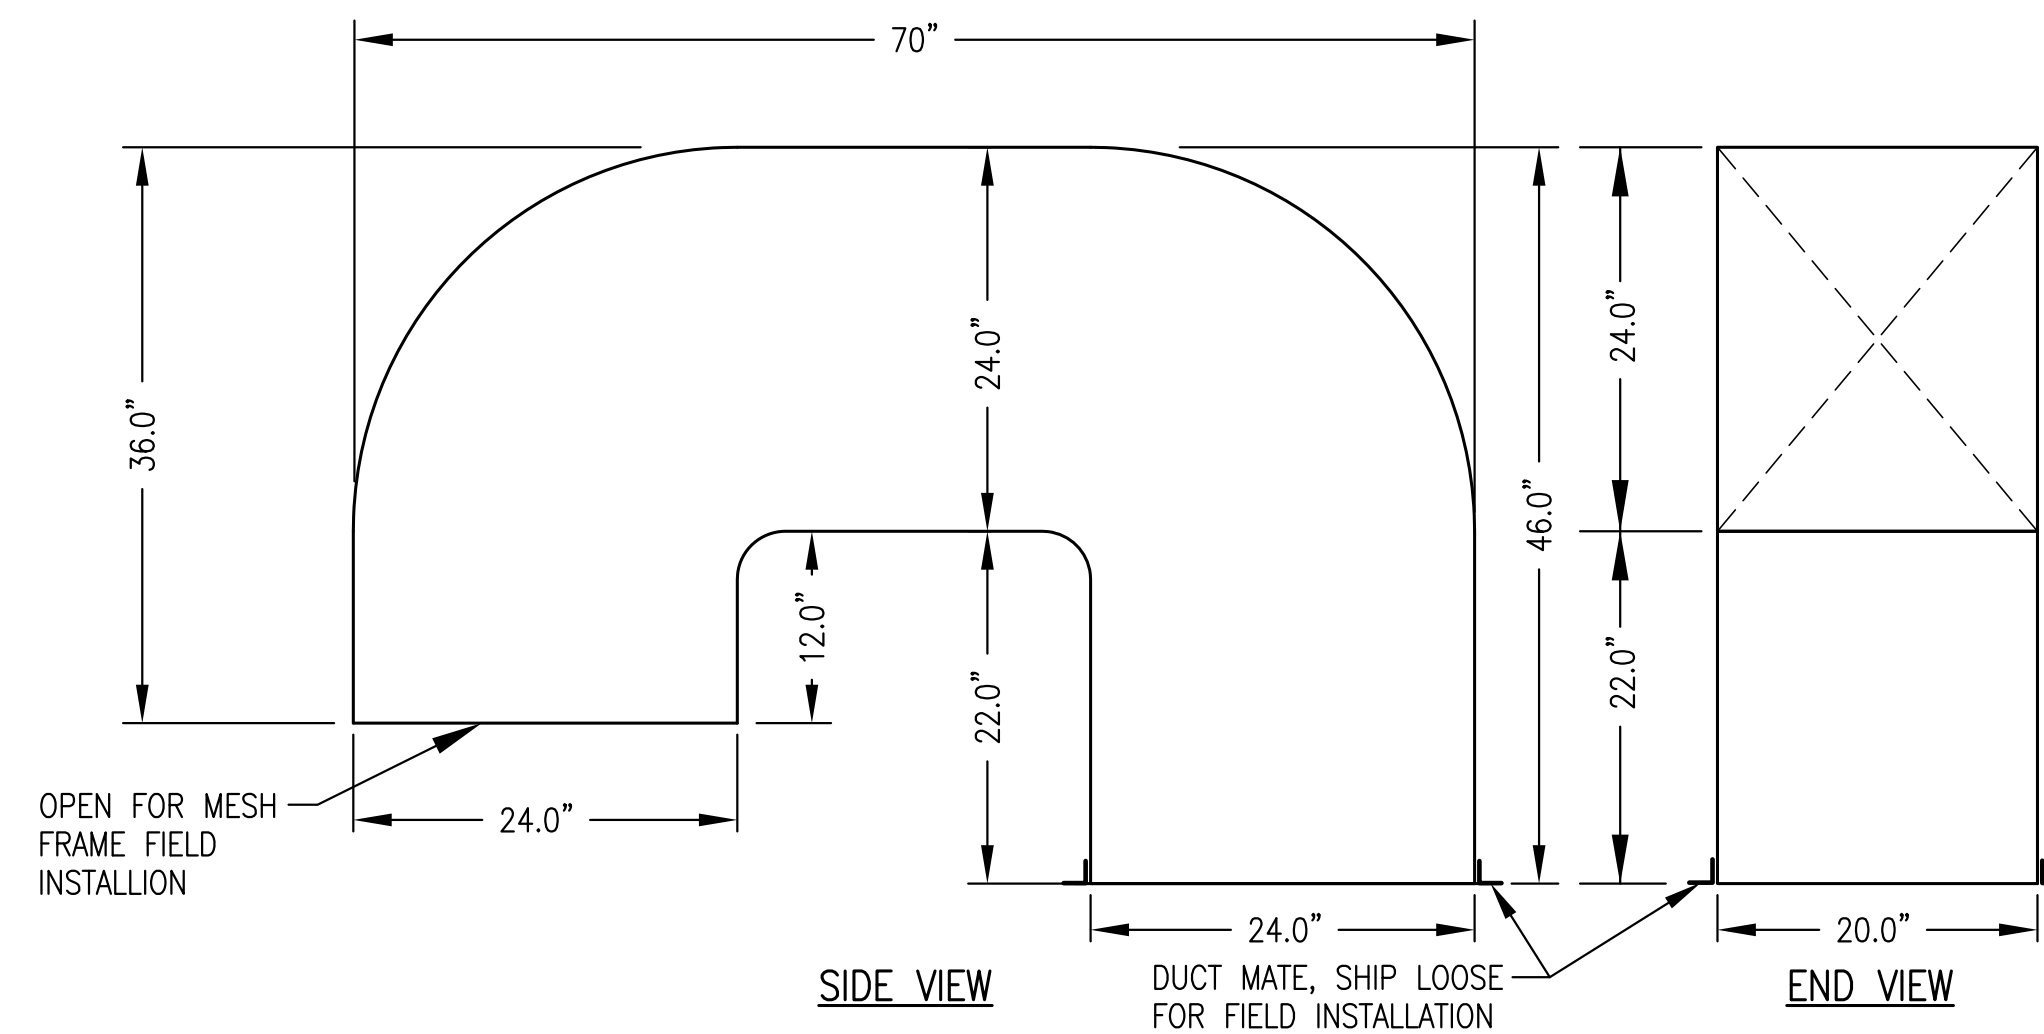

NOTE: FABRICATE 3 IDENTICAL DUCTS FROM MIN 18 GAUGE GALV SHEET METAL WITH SEALED MECHANICAL JOINTS OR AT CONTRACTORS OPTION 0.090" THICK TYPE 5052 ALUMINUM WITH ALL WELDED SEAMS.

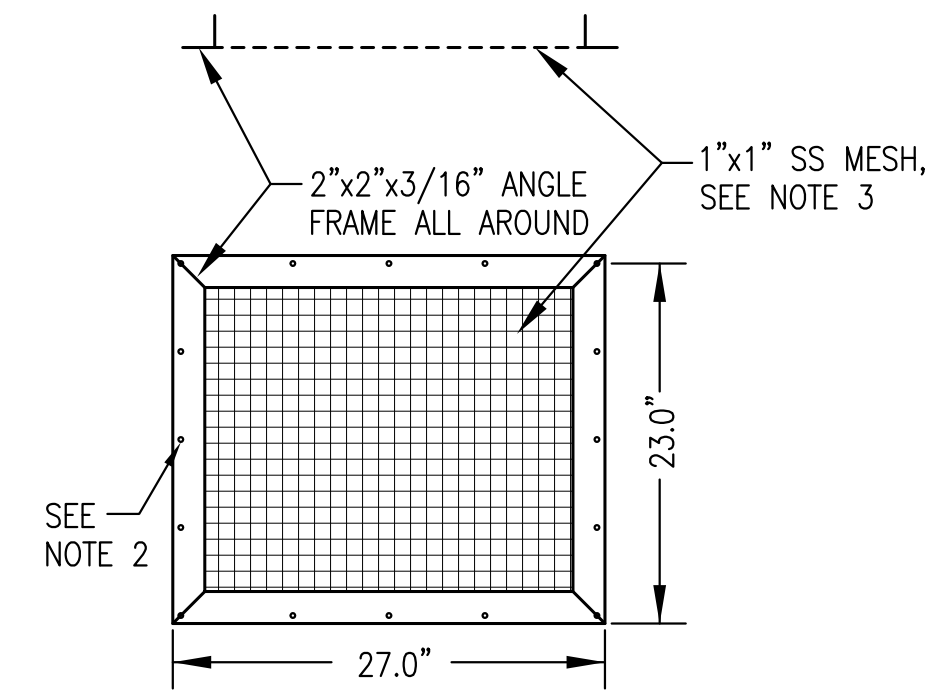

- NOTES:
- FABRICATE 3 IDENTICAL AIR INTAKE MESH FRAMES.
 - FABRICATE FRAME FROM 2"x2"x3/16" ALUMINUM ANGLE WITH MITERED AND WELDED CORNERS AND 1/4" HOLES AT 6" O.C. ALL AROUND, 1/2" FROM OUTSIDE EDGE OF FRAME.
 - INSTALL 1"x1" STAINLESS STEEL WIRE MESH IN HEMMED STAINLESS STEEL FRAME AND FASTEN TO ANGLE FRAME WITH STAINLESS STEEL SCREWS ALL AROUND.

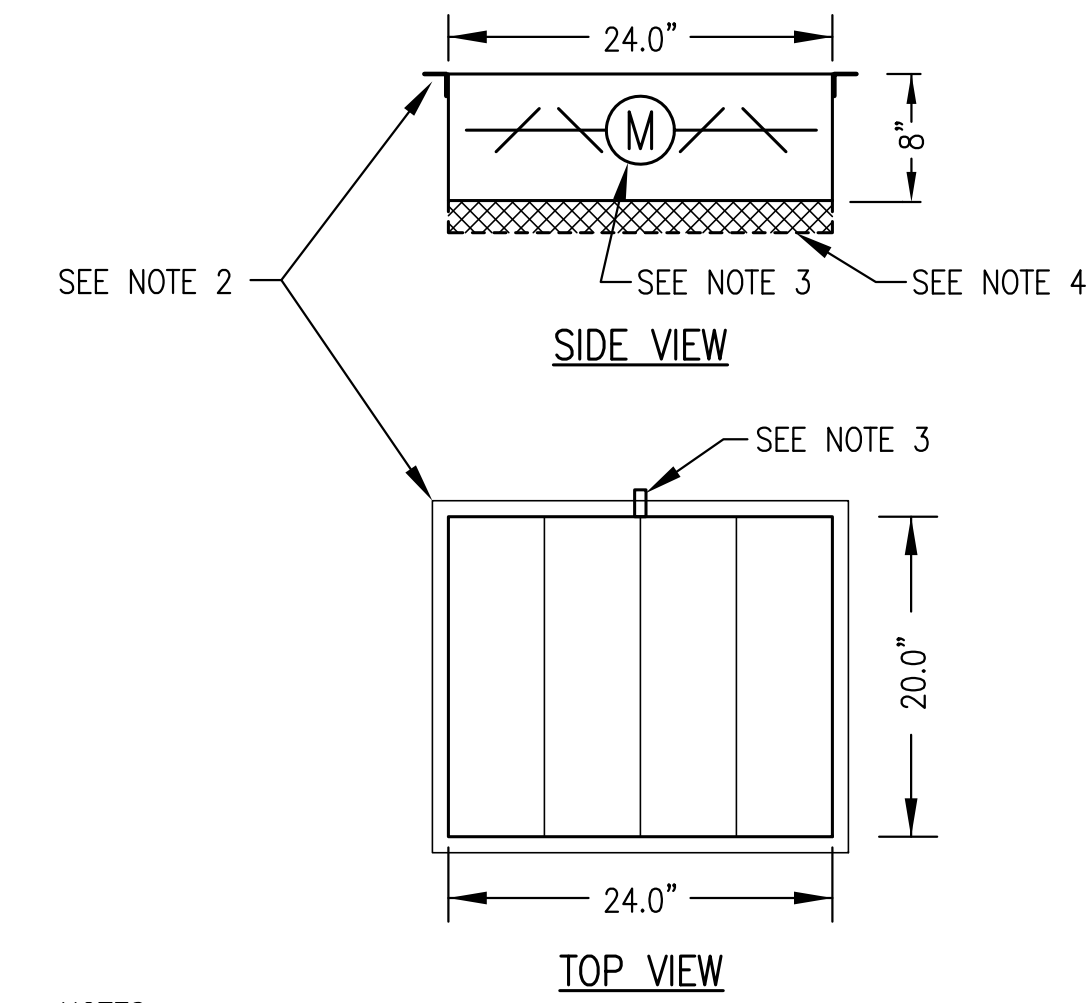


- NOTES:
- FABRICATE 3 IDENTICAL VENTILATION INTAKE ASSEMBLIES.
 - SHOP MOUNT DUCTMATE FLANGE.
 - PROVIDE MIN 3" DAMPER ROD EXTENSION ON SIDE INDICATED AND FABRICATE SHEET METAL STAND-OFF BRACKET TO FULLY SUPPORT THE ACTUATOR FROM THE DAMPER FRAME.
 - INSTALL FRAME FOR REMOVABLE 24"x24"x2" FURNACE FILTERS. FABRICATE FROM "C" CHANNEL THREE SIDES WITH LATCHING HINGED COVER ON FOURTH SIDE TO ALLOW FILTERS TO SLIDE OUT. SEE PLAN VIEW FOR DAMPER ACTUATOR AND FILTER PULL ORIENTATION. EXTEND FILTER FRAME 2"± BEYOND DAMPER FRAME EACH WAY ON NARROW DIMENSION.


1 INTAKE DUCT FABRICATION
M7.2 1"=1'-0"

2 INTAKE MESH FRAME
M7.2 1"=1'-0"

3 INTAKE AIR DAMPER FABRICATION
M7.2 1"=1'-0"

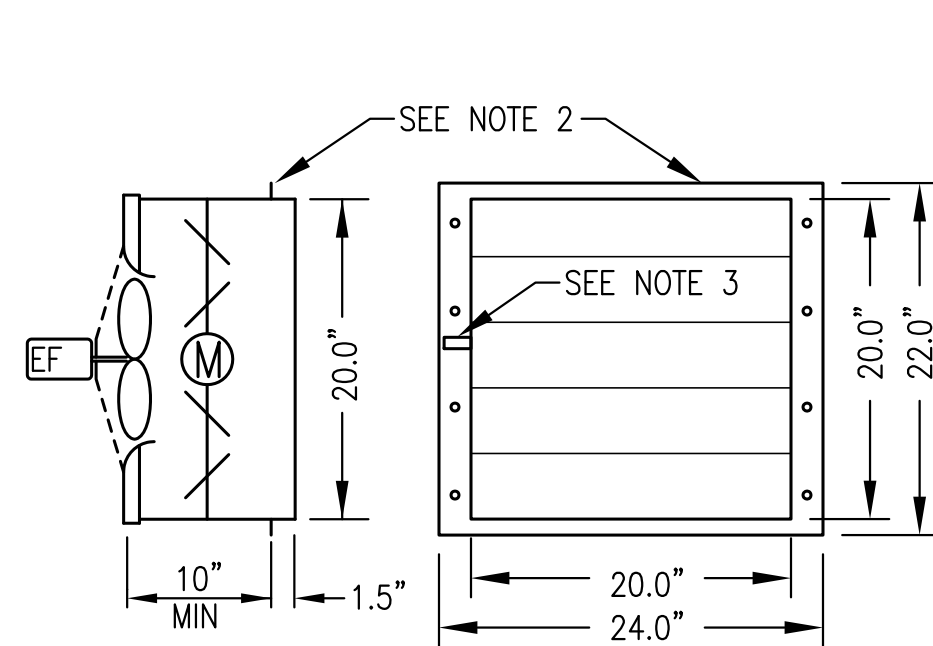

- NOTES:
- FABRICATE 2 IDENTICAL ASSEMBLIES COMPLETE WITH FAN AND DAMPER MOUNTED AND SEALED TO DUCT.
 - PROVIDE 2" WIDE MOUNTING FLANGE ON SIDES WITH 1/4" HOLES AT 5" O.C. PROVIDE 1" MOUNTING FLANGE ON TOP AND BOTTOM WITHOUT HOLES.
 - PROVIDE MIN 3" DAMPER ROD EXTENSION ON THE LEFT SIDE AND FABRICATE SHEET METAL STAND-OFF BRACKET TO FULLY SUPPORT THE ACTUATOR FROM THE DAMPER FRAME.

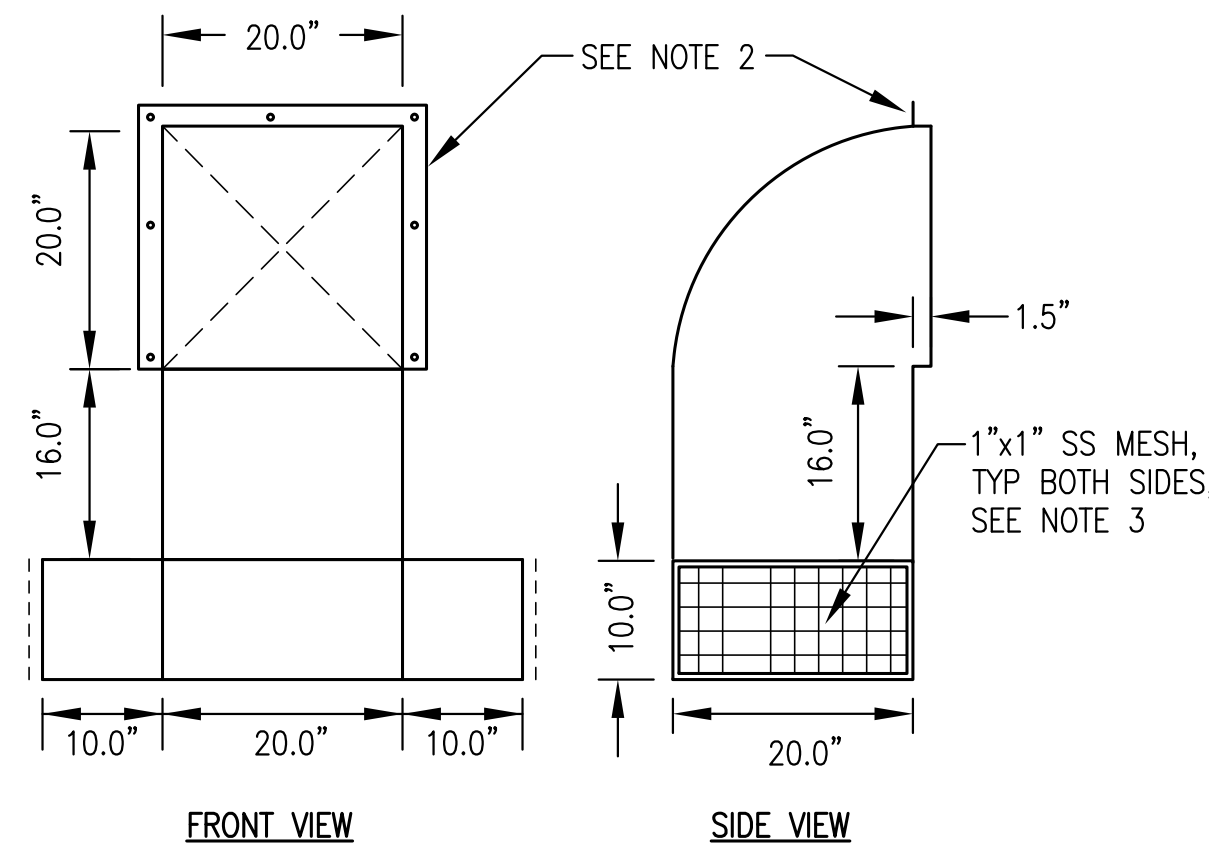


- NOTES:
- FABRICATE 2 IDENTICAL HOODS FROM 0.090" THICK TYPE 5052 ALUMINUM WITH ALL WELDED SEAMS.
 - PROVIDE 2" WIDE MOUNTING FLANGE ON TOP & SIDES WITH 1/4" HOLES AT 9" O.C.
 - INSTALL 1"x1" STAINLESS STEEL WIRE MESH IN HEMMED STAINLESS STEEL FRAME AND FASTEN TO ANGLE FRAME WITH STAINLESS STEEL SCREWS ALL AROUND.

4 EXHAUST FAN ASSEMBLY FABRICATION
M7.2 1"=1'-0"

5 EXHAUST HOOD FABRICATION
M7.2 3/4"=1'-0"


ISSUED FOR CONSTRUCTION DECEMBER 2018

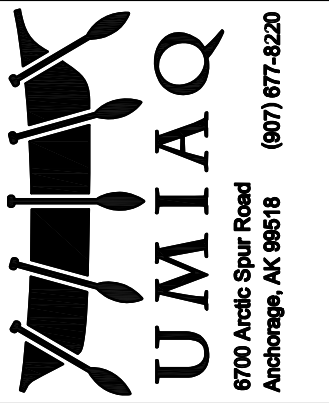

STATE OF ALASKA, AIDEA/AEA
RURAL POWER SYSTEM UPGRADE
CLARKS POINT POWER PLANT
CLARKS POINT, ALASKA

CONSTRUCTION DOCUMENTS	
REVISIONS	DESCRIPTION
REV	DATE


VERIFY SCALES
0 1"
THIS BAR REPRESENTS ONE INCH ON ORIGINAL DRAWING

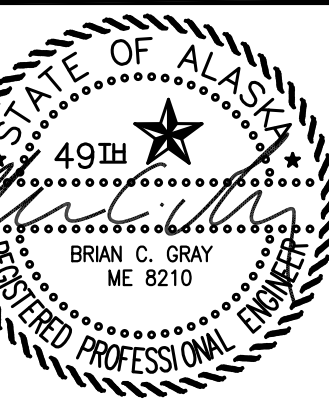


DATE: 1/14/19
DRAWN BY: JTD
CHECKED BY: BCG
JOB NUMBER:

DRAWING TITLE:
VENTILATION
FABRICATION DETAILS

M7.2
SHEET OF 7

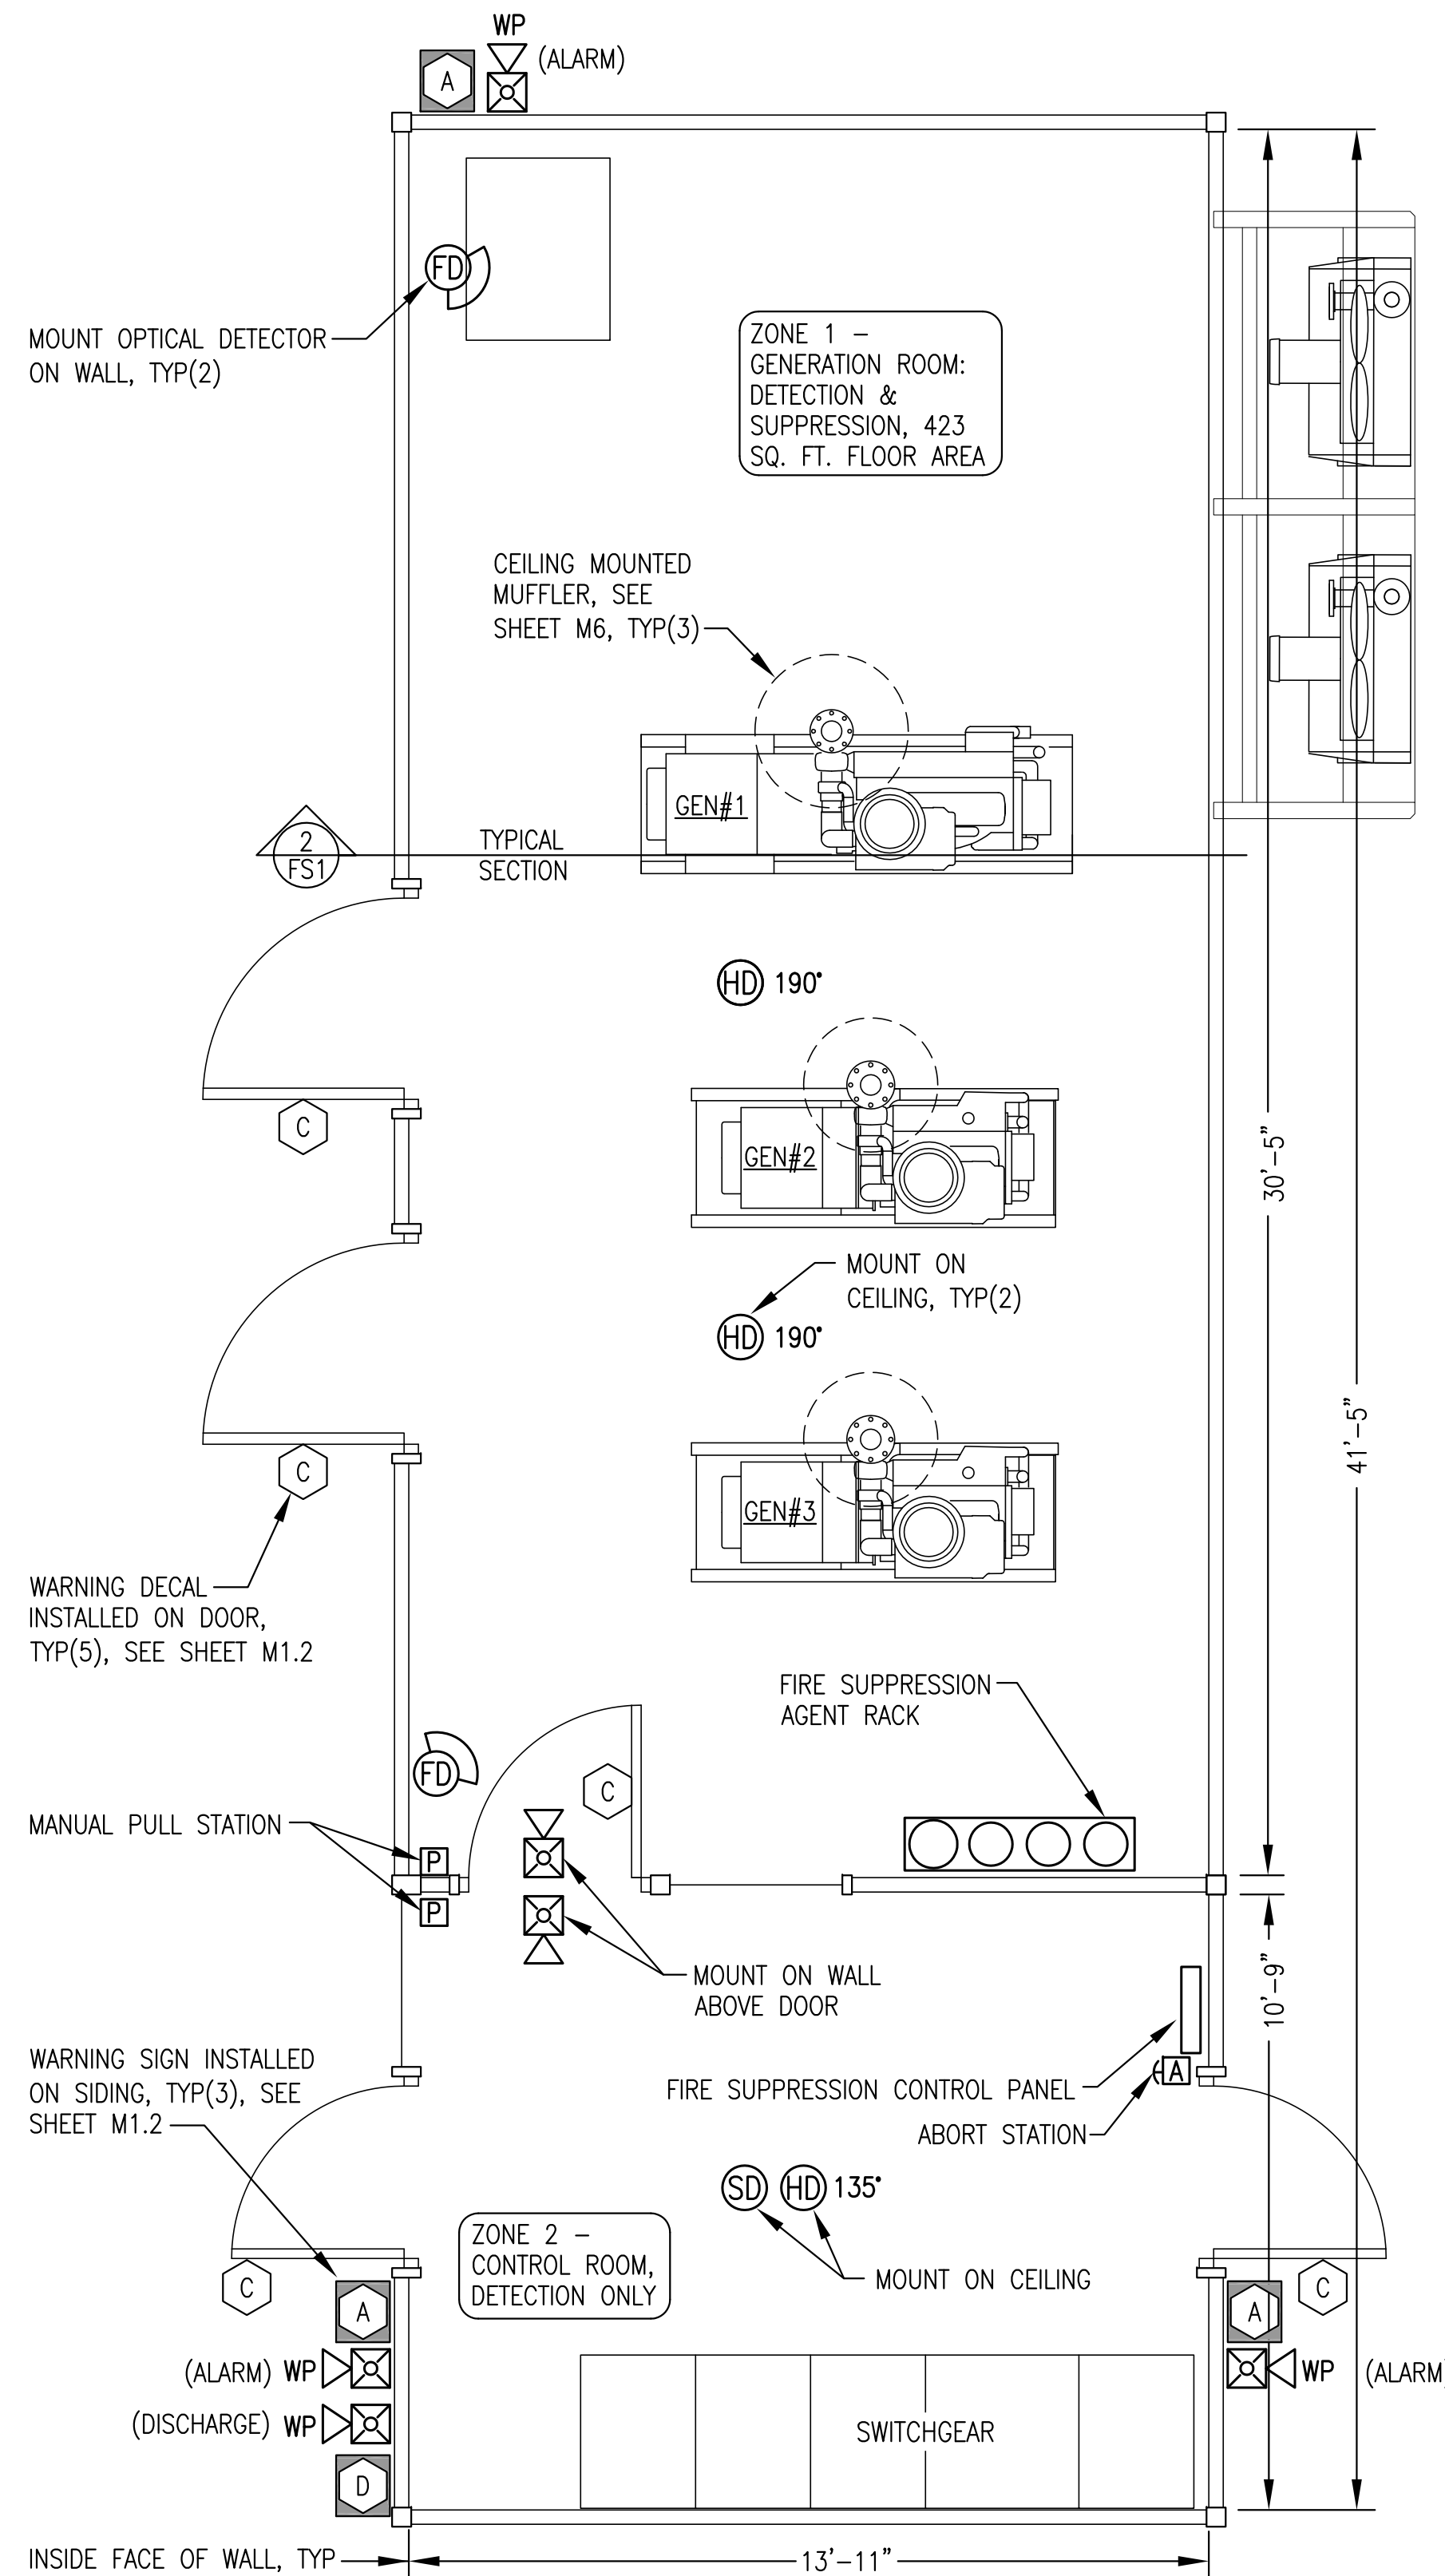

1 FIRE SUPPRESSION SYSTEM PLAN
FS1 3/8"=1'-0"

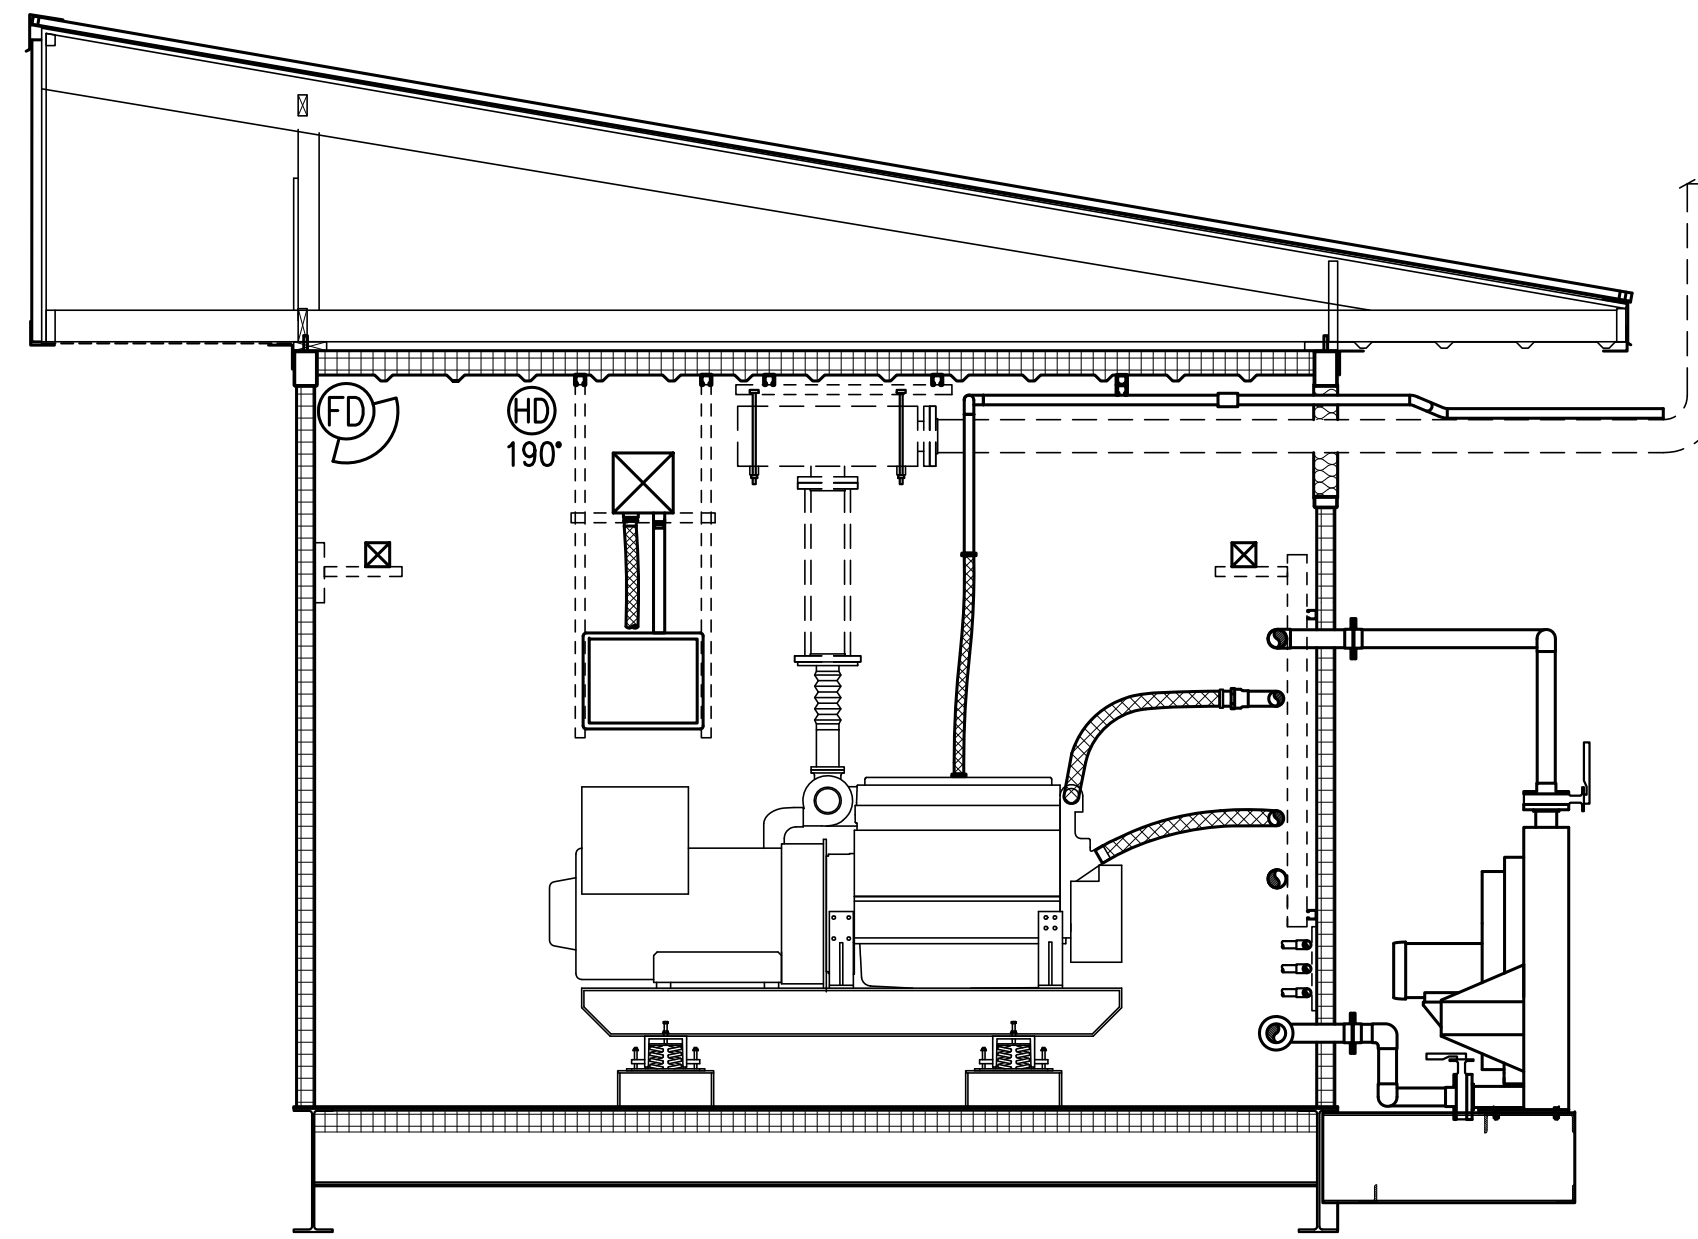

2 TYPICAL SECTION THROUGH MODULE
FS1 3/8"=1'-0"

FIRE SUPPRESSION SYMBOL LEGEND			
SYMBOL	DESCRIPTION	SYMBOL	DESCRIPTION
[P]	MANUAL PULL STATION	[HD]135'	NORMAL TEMP. (135°F) DETECTOR
[A]	ABORT STATION	[HD]190'	HIGH TEMP. (190°F) DETECTOR
[X]	INTERIOR ALARM HORN/STROBE	[FD]	FLAME (OPTICAL) DETECTOR
[X]WP	EXTERIOR ALARM HORN/STROBE	[SD]	SMOKE (IONIZATION) DETECTOR

FIRE SUPPRESSION PLACARD SCHEDULE	
SYMBOL	DESCRIPTION
[A]	"FIRE ALARM"
[C]	"CAUTION, ROOM PROTECTED BY WATER MIST FIRE PROTECTION SYSTEM, IN CASE OF FIRE KEEP DOOR CLOSED AND DO NOT ENTER"
[D]	"FLASHING LIGHT MEANS FIRE SUPPRESSION AGENT HAS DISCHARGED"

FIRE SUPPRESSION WIRE SCHEDULE			
SYMBOL	CIRCUIT DESCRIPTION	WIRE TYPE	WIRE COLOR
A	24V DC POWER	#14 AWG SOLID	RED & BLACK
B	DETECTION CIRCUITS	#14 AWG SOLID	BLUE & YELLOW
C	ANNUNCIATION ALARM	#14 AWG SOLID	BROWN & ORANGE
D	ANNUNCIATION DISCHARGE	#14 AWG SOLID	WHITE, & GRAY
E	24V DC AUX POWER	#14 AWG SOLID	RED & BLACK WITH GRAY STRIPE

FIRE SUPPRESSION GENERAL NOTES:

- INTERIOR FINISH OF ALL WALLS, FLOOR, AND CEILING WELDED STEEL PLATE. CEILING HEIGHT IN ALL ROOMS 10'-2" ABOVE FINISHED FLOOR.
- ALL DOORS SELF-CLOSING WITH GASKETS. ALL BUILDING PIPING AND CONDUIT PENETRATIONS SEALED LIQUID TIGHT. ALL BUILDING DUCT PENETRATIONS EQUIPPED WITH MOTORIZED DAMPERS THAT CLOSE ON GENERATOR SHUT DOWN.

FIRE SUPPRESSION SHOP/ON-SITE NOTES:

- UPON COMPLETION OF MODULE SHOP TESTING: DISCONNECT BATTERIES. DRAIN ALL WATER OUT OF THE SYSTEM AND BLOW OUT WITH AIR TO PREVENT FREEZE DAMAGE. LEAVE ONE FULLY CHARGED NITROGEN CYLINDER INSTALLED IN THE RACK PLUS ONE LOOSE SHIP FULLY CHARGED SPARE NITROGEN CYLINDER.
- DURING ON-SITE CONSTRUCTION: FILL BOTTLES WITH CLEAN POTABLE WATER IN ACCORDANCE WITH MANUFACTURER'S REQUIREMENTS. FULLY TEST AND CERTIFY SYSTEM. TRAIN AEA STAFF AND LOCAL OPERATORS.




**STATE OF ALASKA, AIDEA/AEA
RURAL POWER SYSTEM UPGRADE**

CLARKS POINT POWER PLANT
CLARKS POINT, ALASKA

CONSTRUCTION DOCUMENTS	
REVISIONS	DESCRIPTION
REV. DATE	

VERIFY SCALES
0 1"
THIS BAR REPRESENTS ONE INCH ON ORIGINAL DRAWING

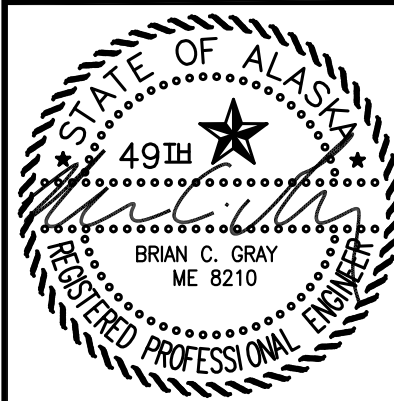

DATE: 1/14/19
DRAWN BY: JTD
CHECKED BY: BCG
JOB NUMBER:

DRAWING TITLE:
FIRE SUPPRESSION SYSTEM PLAN, SECTION, LEGEND, & NOTES

FS1
SHEET OF 1

ISSUED FOR CONSTRUCTION JANUARY 2019

BUILDING PLANS SYMBOL LEGEND

SYMBOL	DESCRIPTION
SS-##	HOME RUN TO PANEL & BREAKER(S) INDICATED. SHORT DASH INDICATES HOT CONDUCTOR, LONG DASH INDICATES NEUTRAL CONDUCTOR, CURVED DASH INDICATES GROUND CONDUCTOR. IF NOT SPECIFICALLY INDICATED, PROVIDE 2#12 AWG & 1#12 AWG GROUND.
◆	ELECTRICAL ITEM - SEE EQUIPMENT SCHEDULE
1/4	MOTOR (HORESPOWER INDICATED)
MD	MOTORIZED DAMPER - SEE MECHANICAL
⊖	125V, 20A, DUPLEX RECEPTACLE
⊕	LINE VOLTAGE THERMOSTAT
DT	DIGITAL THERMOSTAT, MODULATING
\$	SNAP SWITCH / SMALL MOTOR DISCONNECT
T\$	TIMER SWITCH
⊕	GROUND

EQUIPMENT REQUIREMENTS FOR APPROVED EQUALS (APPLIES TO ALL SCHEDULES):
 SPECIFIC PARTS MANUFACTURER AND MODEL SELECTED NOT ONLY TO MEET PERFORMANCE FUNCTION BUT ALSO TO COORDINATE AND INTERFACE WITH OTHER DEVICES AND SYSTEMS. APPROVED EQUAL SUBSTITUTIONS WILL BE ALLOWED ONLY BY ENGINEER'S APPROVAL. TO OBTAIN APPROVAL, SUBMITTALS MUST CLEARLY DEMONSTRATE HOW SUBSTITUTE ITEM MEETS OR EXCEEDS SPECIFIED ITEM QUALITY AND PERFORMANCE CHARACTERISTICS AND ALSO COMPLIES WITH MECHANICAL AND/OR ELECTRICAL CONNECTIONS AND PHYSICAL LAYOUT REQUIREMENTS.

ELECTRICAL EQUIPMENT SCHEDULE


SYMBOL	SERVICE/FUNCTION	DESCRIPTION	MANUFACTURER/MODEL
◆	DAY TANK ALARM HORN/STROBE	MULTI-TONE ALARM WITH STROBE, 115V, NEMA 3R, WEATHER RESISTANT SURFACE MOUNT BELL BOX	WHEELLOCK MT4-115-WH-VNS
◆	DIGITAL THERMOSTAT	MULTIPLE OUTPUT MODULATING DIGITAL THERMOSTAT	HONEYWELL TB7980B
◆	LINE VOLTAGE THERMOSTAT	HEATING/COOLING THERMOSTAT, 16 FLA @ 120V, SPDT, 50F TO 80F RANGE.	DAYTON 1UHH2
◆	AREA LIGHT	AREA LIGHT, WIDE DISPERSION WALL PACK WITH PHOTO CONTROL. LED, 17.7W, 120-277V DRIVER	HUBBELL NRG-356L-5K-U-PC
◆	EMERGENCY LIGHT	WALL MOUNT, WHITE 20 GA STEEL ENCLOSURE, 277/120VAC, 8.4A INPUT, SEALED LEAD-ACID BATTERY, DUAL 5.3W 6VDC LED LAMPS	HUBBEL DUAL-LITE CCU2
◆	EMERGENCY/EXIT LIGHT COMBO	WHITE PLASTIC ENCLOSURE, RED EXIT SIGN, 277/120V INPUT, DUAL 1.5W 9.6V LED LAMPS. OPTIONAL HIGH OUTPUT NI-CAD BATTERY	LITHONIA LHQM-LED-R-HO OR EQUAL
◆	NOT USED	NOT USED	NOT USED
◆	MODULE INTERIOR LIGHTING	SURFACE MOUNTED LED STRIPLIGHT FIXTURE, 48" LONG, 34W, 5000K WITH SNAP ON FROSTED DIFFUSER	LITHONIA L1N-L48-5000LM-FST
◆	TIMER SWITCH	0-5 MINUTE, 120V, 20A, 1HP RATED, INSTALL IN 4"x4" PRESSED STEEL BOX WITH METAL COVER.	INTERMATIC FF5M
◆	LIGHT SWITCH	SINGLE POLE SNAP SWITCH, 120V, 20A, METAL, 1-1/2HP RATED, INSTALL IN 4"x4" STEEL BOX WITH METAL COVER, IVORY.	HUBBELL 1221-I
◆	1Ø SMALL MOTOR DISCONNECT	SINGLE POLE SNAP SWITCH WITH RED PILOT LIGHT, 120V, 20A, 1-1/2HP RATED, INSTALL IN 4"x4" STEEL BOX WITH METAL COVER	HUBBELL 1221-PL
◆	NOT USED	NOT USED	NOT USED
◆	STATION SERVICE TRANSFORMER	DRY TYPE, ENERGY STAR, ENCLOSURE TYPE 3R WITH INTEGRAL WALL MOUNT BRACKETS, 9 kVA, HV 480 DELTA, LV 208Y/120	HAMMOND HPS C3F009KBS WITH NQT6 CASE
◆	STATION SERVICE PANELBOARD	COPPER BUS, 3 PHASE, 4 WIRE, 120/208V, 100A, 30 CIRCUITS, BOLT-IN BREAKERS, SURFACE MOUNT, NEMA 1	SIEMENS OR SQUARE D
◆	STANDARD RECEPTACLE	SURFACE MOUNT 125V NEMA 5-20R RECEPTACLE. INSTALL IN 4"x4" STEEL BOX WITH METAL COVER	PASS & SEYMOUR 5362W
◆	EXTERIOR GFCI RECEPTACLE	125V NEMA 5-20R GFCI RECEPTACLE. MOUNT IN CAST FDA BOX WITH WEATHERPROOF COVER	PASS & SEYMOUR 2095-W
◆	BATTERY CHARGER	12/24-VOLT SOLID STATE 20-AMP AUTO-EQUALIZING BATTERY CHARGER FOR 120 VAC INPUT, WITH OPTIONAL HIGH/LOW VOLTAGE, AC POWER FAILURE, & REMOTE SUMMARY ALARM RELAYS	SENS NRG22-20-RLCS OR CHARLES 93-INCHGR20-A
◆	WELDER/COMPR. RECEPTACLE	NEMA 6-30R, BLACK, 250V, 30A, 2 POLE, WITH GROUND. INSTALL IN DEEP 4"x4" STEEL BOX WITH 2.15"Ø HOLE METAL COVER	PASS & SEYMOUR 3801
◆	NOT USED	NOT USED	NOT USED
◆	RADIATOR MOTOR DISCONNECT	NON-FUSED LOCKABLE SAFETY SWITCH, NEMA 3R ENCLOSURE, 3PST, 600V, 30A, MIN 5HP RATED	SIEMENS HNF361R OR SQUARE D HU361R
◆	24VAC CONTROL TRANSFORMER	120V PRIMARY, 24V SECONDARY, 75VA OUTPUT, PLATE MOUNT, INSTALL ON 4"x4" PRESSED STEEL BOX	HONEYWELL AT175A1008
◆	ENCLOSED POWER RELAY	20A, 1HP RATED CONTACT, SPDT, 24VAC COIL, NEMA 1 ENCLOSURE, RED LED PILOT LIGHT	FUNCTIONAL DEVICES RIB2401B

ELECTRICAL CONDUCTOR SCHEDULE

SERVICE/FUNCTION	DESCRIPTION	MANUFACTURER/MODEL	NOTES:
GENERATOR LEADS & FEEDERS (480V) & ENGINE STARTER CABLES (24VDC)	HIGH TEMPERATURE, EXTRA FLEXIBLE CABLE, TIN COATED COPPER CONDUCTOR, THERMOSET EPDM INSULATION, UL 3340/3374, MINIMUM 600V, LISTED 150°C FOR NON-FLEXING	COBRA CABLE, BELDEN, OR OMINI	TERMINATE WITH COPPER COMPRESSION LUGS RATED FOR THE FULL AMPACITY OF THE CABLE AT 150°C.
GENERAL USE CONDUCTORS	CLASS B CONCENTRIC STRANDED, SOFT DRAWN COPPER. TYPE XHHW INSULATION, 600V AND 75C RATED.		
HIGH TEMPERATURE BOILER CONDUCTORS	STRANDED ANNEALED COPPER, NICKEL PLATED, GLASS REINFORCED MICA TAPE INSULATION, FIBERGLASS JACKET, 600V AND 450C RATED.	TEMPCO OR OMINI TYPE MG, UL 5107	USE FOR CONNECTION TO ELECTRIC BOILER ELEMENTS
SHIELDED/TWISTED INSTRUMENT & CONTROL CONDUCTORS	#18 AWG STRANDED TINNED COPPER CONDUCTORS, 600V POLYETHYLENE INSULATION, 100% COVERAGE ALUMINUM FOIL-POLYESTER TAPE SHIELD WITH STRANDED TINNED COPPER DRAIN WIRE & PVC OUTER JACKET	BELDEN PART #'S SINGLE PAIR: #1120A FOUR PAIR: #1049A SINGLE TRIAD: #1121A	GROUND SHIELD DRAIN WIRE AT PANEL END ONLY.
CANBUS (DEVICENET) COMMUNICATION CONDUCTORS	STRANDED TINNED COPPER CONDUCTORS, 600V PVC/NYLON & FRPP INSULATION, 100% COVERAGE ALUMINUM FOIL-POLYESTER TAPE SHIELD WITH TINNED COPPER BRAID SHIELD & PVC OUTER JACKET	TWO PAIR #16 & #18 BELDEN 7896A	GROUND SHIELD DRAIN WIRE AT PANEL END ONLY.
EHTERNET (CAT5e) COMMUNICATION CONDUCTORS	SOLID BARE COPPER CONDUCTORS, 300V FEP INSULATION & JACKET, 100% COVERAGE ALUMINUM FOIL-POLYESTER TAPE SHIELD WITH STRANDED TINNED COPPER DRAIN WIRE	FOUR PAIR #24 BELDEN 1585LC	GROUND SHIELD DRAIN WIRE AT PANEL END ONLY. ROUTE ALL CAT5e CABLES IN SEPARATE DEDICATED RACEWAY.
<p>COLOR CODING - UNLESS SPECIFICALLY INDICATED OTHERWISE CONDUCTORS SHALL BE COLOR CODED AS FOLLOWS:</p> <p>480-VOLT POWER CONDUCTORS PHASE A - BROWN PHASE B - ORANGE PHASE C - YELLOW NEUTRAL - WHITE WITH YELLOW STRIPE</p> <p>120/208-VOLT POWER CONDUCTORS PHASE A - BLACK PHASE B - RED PHASE C - BLUE NEUTRAL - WHITE</p> <p>24 VOLT DC CONDUCTORS +24VDC - RED or RED WITH GRAY STRIPE -24VDC - BLACK or BLACK WITH GRAY STRIPE</p> <p>CONTROL & INSTRUMENT CONDUCTORS COLOR CODED PER MANUFACTURER'S STANDARD</p>		<p>NOTES:</p> <p>1) FOR NO. 6 AWG AND SMALLER CONDUCTORS COLOR CODING SHALL BE PROVIDED BY USING CONDUCTORS WITH CONTINUOUS COLOR EMBEDDED IN THE INSULATION. FOR ALL CONDUCTORS LARGER THAN NO. 6 SCOTCH 35 MARKING TAPE OR EQUIVALENT MAY BE USED TO COLOR CODE THE CABLE. WHERE MARKING TAPE IS USED THE CABLE SHALL BE IDENTIFIED AT EVERY ACCESSIBLE LOCATION. PROVIDE A MINIMUM OF 2 INCHES OF TAPE AT EACH LOCATION.</p> <p>2) GROUNDING - PROVIDE A SEPARATE EQUIPMENT GROUNDING CONDUCTOR IN EACH RACEWAY. DO NOT USE THE CONDUIT AS AN EQUIPMENT GROUNDING CONDUCTOR. EQUIPMENT GROUNDING CONDUCTORS SHALL BE CLASS B CONCENTRIC STRANDED, SOFT-DRAWN COPPER OF THE SIZES INDICATED ON THE DRAWINGS. CONDUCTORS NOT INDICATED SHALL BE SIZED IN ACCORDANCE WITH THE NATIONAL ELECTRICAL CODE.</p>	

ELECTRICAL INSTRUMENTATION SCHEDULE

SYMBOL	SERVICE/FUNCTION	DESCRIPTION	MANUFACTURER/MODEL
TT	TEMPERATURE TRANSMITTER	RTD, 20-240°F RANGE, 4-20mA OUTPUT, 1/2" NPT PIPING CONNECTION, 6mm DIAMETER BY 2.5" LONG STEM, HIRSCHMANN ELECTRICAL CONNECTION	NOSHOK 800-20/240-1-1-8-8-025-6
PT	PRESSURE TRANSMITTER	0-60 PSIG RANGE, 4-20mA OUTPUT, 1/4" NPT PIPING CONNECTION, HIRSCHMANN ELECTRICAL CONNECTION	NOSHOK 100-60-1-1-2-7
FM	HEAT RECOVERY FLOW METER	150# ANSI FLANGED CONNECTION, SIZE AS INDICATED, PTFE LINER, HASTELLOY C ELECTRODES, RATED FOR 210F OPERATION. FURNISH WITH TRANSMITTER FOR DIRECT AND REMOTE MOUNTING, 115/230 VAC, 50/60 HZ, AND NEMA 4X BODY.	SIEMENS SITRANS METER: FM MAGFLO MAG 3100 TRANSMITTER: F M MAGFLO MAG 5000, CODE NO. FDK: 7ME6910, OPTION 1AA10-1AA0
FS	DAY TANK/HOPPER FLOAT SWITCH	VERTICAL ACTION FLOAT SWITCH, REVERSIBLE 70VSPST NC/NO SWITCH, 1/8" NPT, 1" MAX Ø BUNA-N FLOAT FOR S.G.=.47, MINIMUM 60" LONG PVC COATED #20 AWG LEAD WIRES	INNOVATIVE COMPONENTS LS-12-111/2
TLM	TANK LEVEL MONITOR PANEL	TANK LEVEL MONITOR CONSOLE FOR UP TO SIX TANKS, COLOR LCD SCREEN, ETHERNET CONNECTION WITH WEB INTERFACE, PROGRAMMABLE VOLUME CALCULATIONS WITH TEMPERATURE COMPENSATION	FRANKLIN/INCON COLIBRI CL6D
LSP	FUEL/OIL TANK LEVEL SENSOR PROBE	TOP-MOUNT TANK PROBE WITH INSTALLATION KIT FOR 2" NPT RISER, WATER TIGHT COMPRESSION GLAND FITTING FOR CABLE ENTRANCE. FRANKLIN FUEL SYSTEMS, NO SUBSTITUTES. PROBE AND RISER LENGTH AS INDICATED ON INSTALLATION DETAILS.	4' TANK PROBE: TSP-LL2-53-1 2' TANK PROBE: TSP-LL2-29-1 FLOAT: INTSP-IDF2 2" FOR DIESEL INSTALLATION KIT: TSP-K2A
LCA	GLYCOL TANK LOW COOLANT ALARM	LOW COOLANT LEVEL ALARM FLOAT SWITCH, SEE MECHANICAL FOR INSTALLATION DETAILS	MURPHY EL-150-K1
GLS	GLYCOL TANK LEVEL SENSOR PROBE	12" PROBE, 2" NPT TANK CONNECTION, SS FLOAT, 1/4" RESOLUTION, NEMA 4 ENCLOSURE WITH SIGNAL CONDITIONER AND 1/2" NPT CONDUIT CONNECTION	INNOVATIVE COMPONENTS CLM-2012-SS

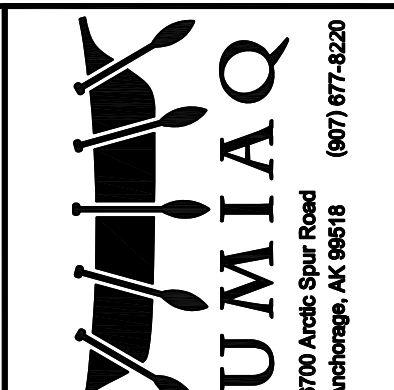


STATE OF ALASKA, AIDEA/AEA RURAL POWER SYSTEM UPGRADE

CLARKS POINT POWER PLANT
CLARKS POINT, ALASKA

REVISIONS	DESCRIPTION
REV DATE	

VERIFY SCALES
 0 1"
 THIS BAR REPRESENTS ONE INCH ON ORIGINAL DRAWING

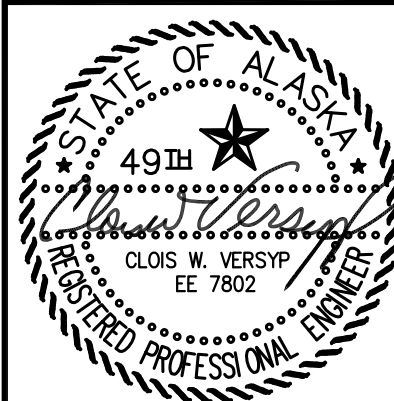


DATE: 1/14/19
 DRAWN BY: JTD
 CHECKED BY: CWV/BCG
 JOB NUMBER:

DRAWING TITLE:
 ELECTRICAL LEGENDS & SCHEDULES


E1.1

SHEET OF 7

ISSUED FOR CONSTRUCTION JANUARY 2019

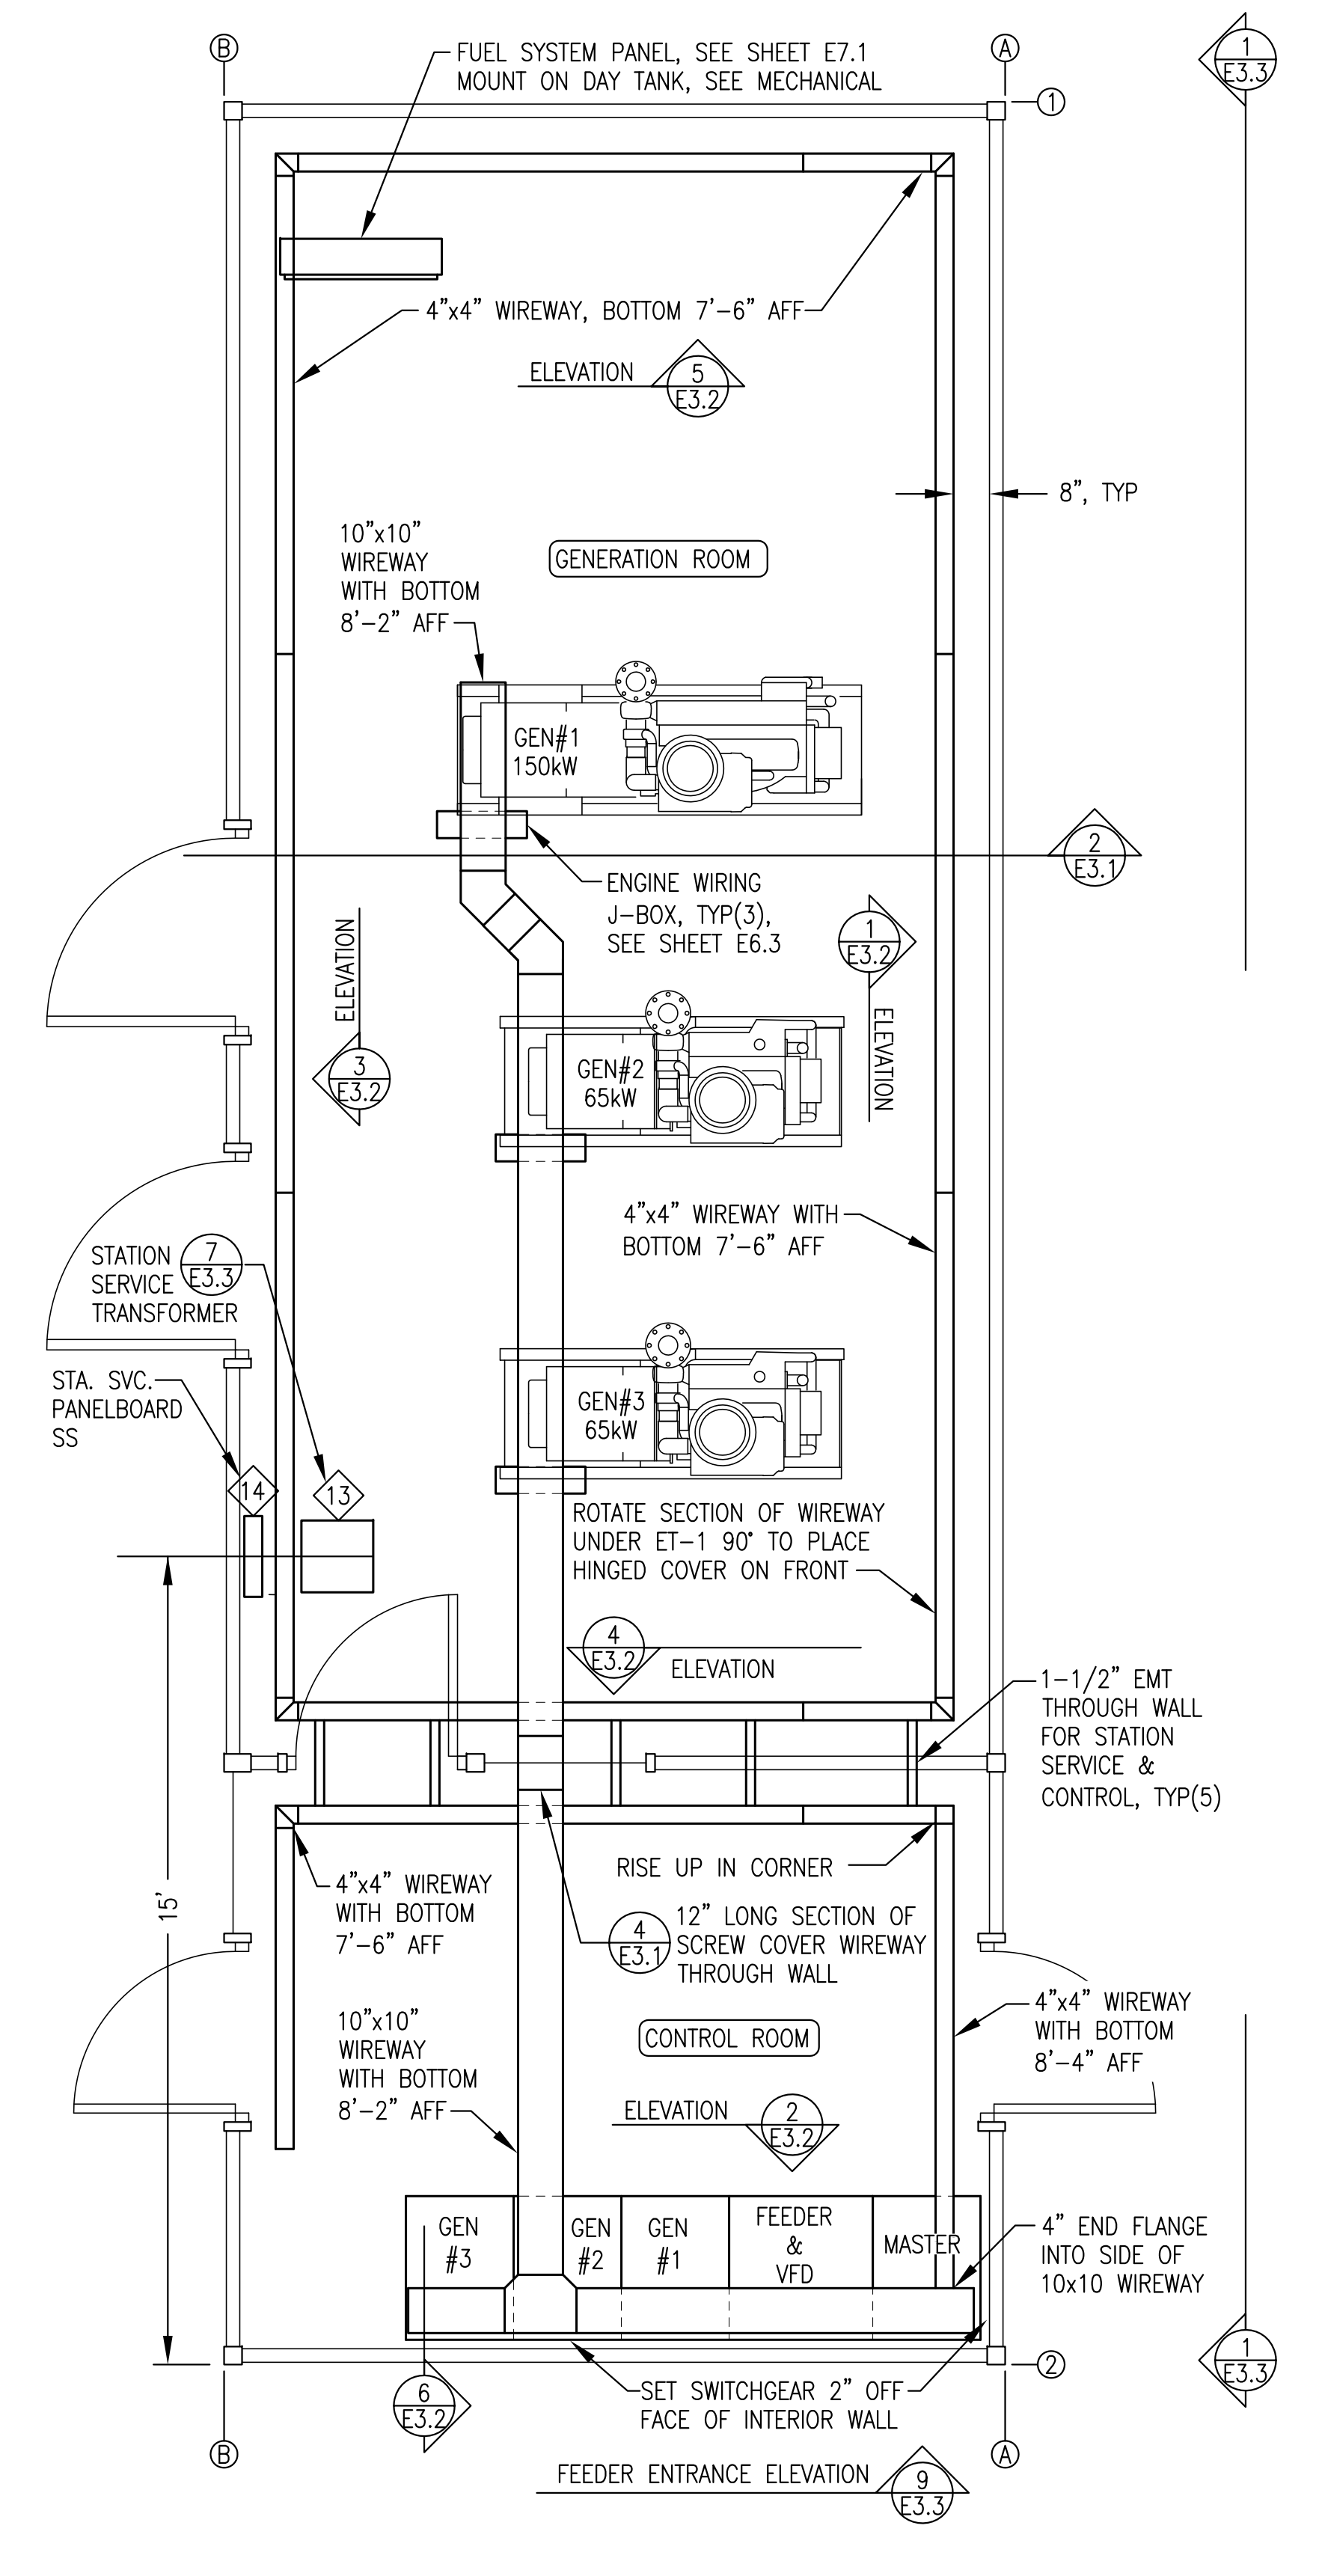


1 EQUIPMENT LAYOUT & WIREWAY PLAN
E3.1 3/8"=1'-0"

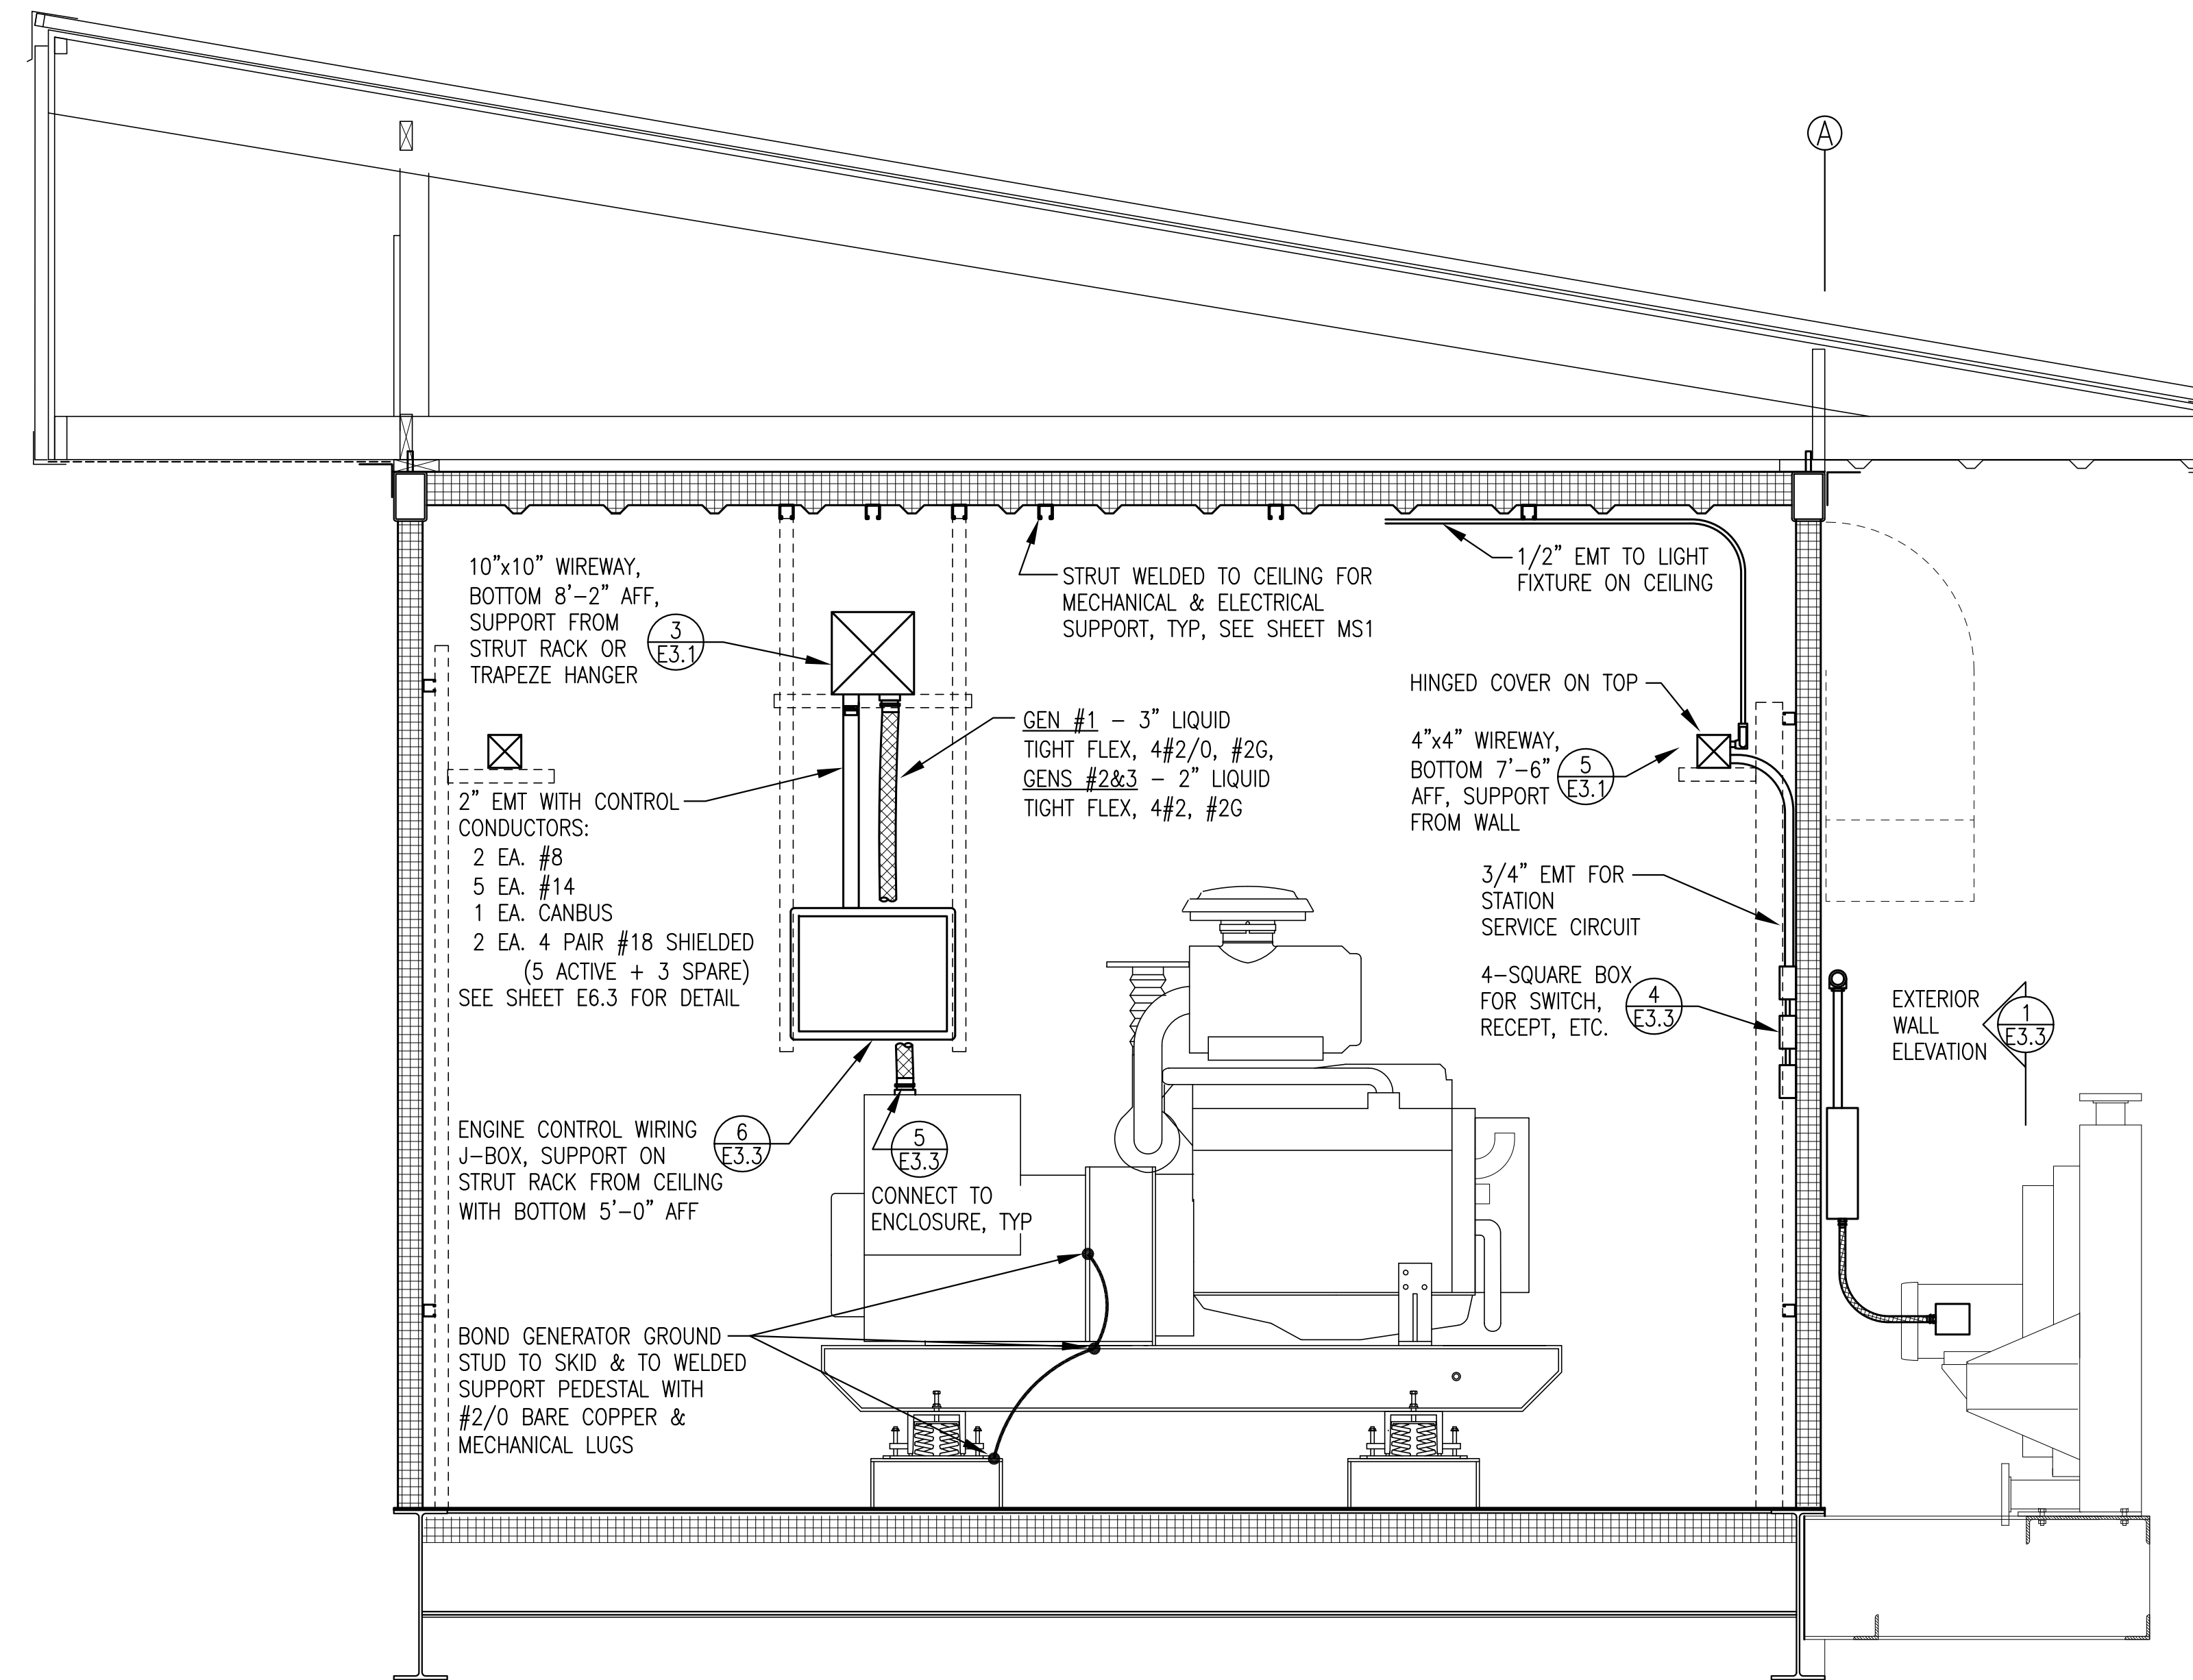


2 TYPICAL MODULE SECTION
E3.1 3/4"=1'-0"


NOTES:
1) INSTALL HANGER AT EACH JOINT & AT END.
2) HANGER NOT REQUIRED AT ENGINE J-BOX SUPPORT, SEE DETAIL 4/E4.3.

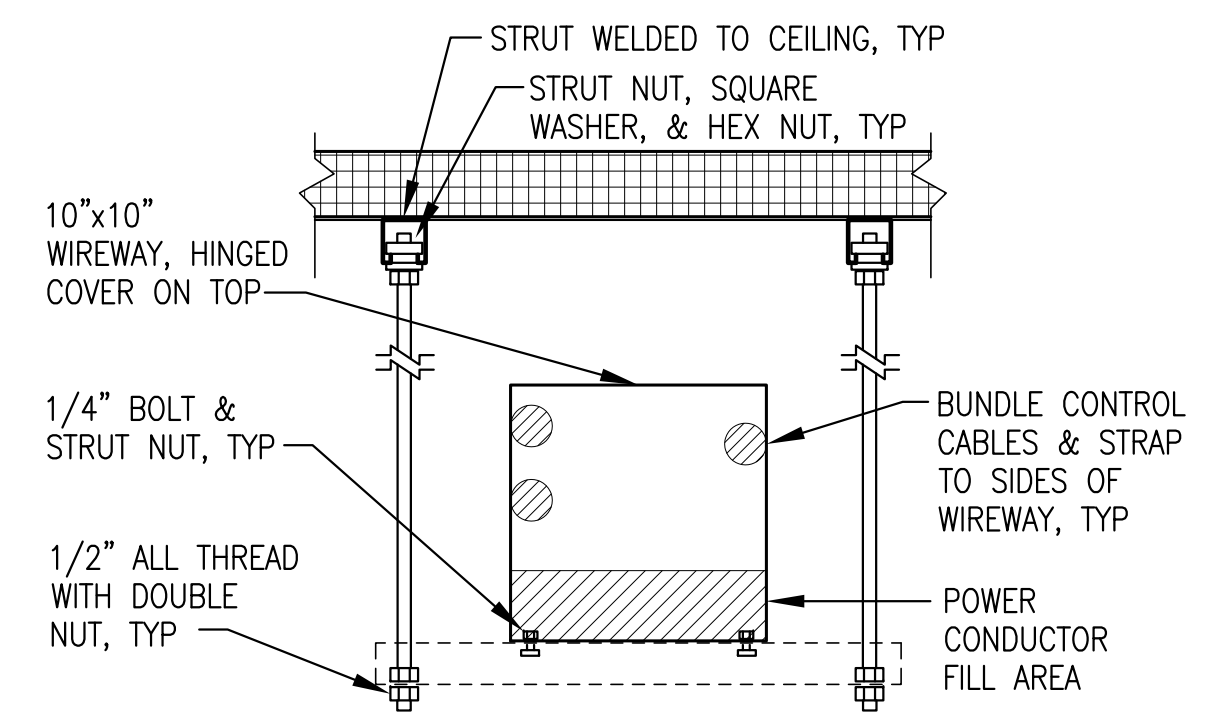

3 10" WIREWAY TRAPEZE HANGER
E3.1 NO SCALE

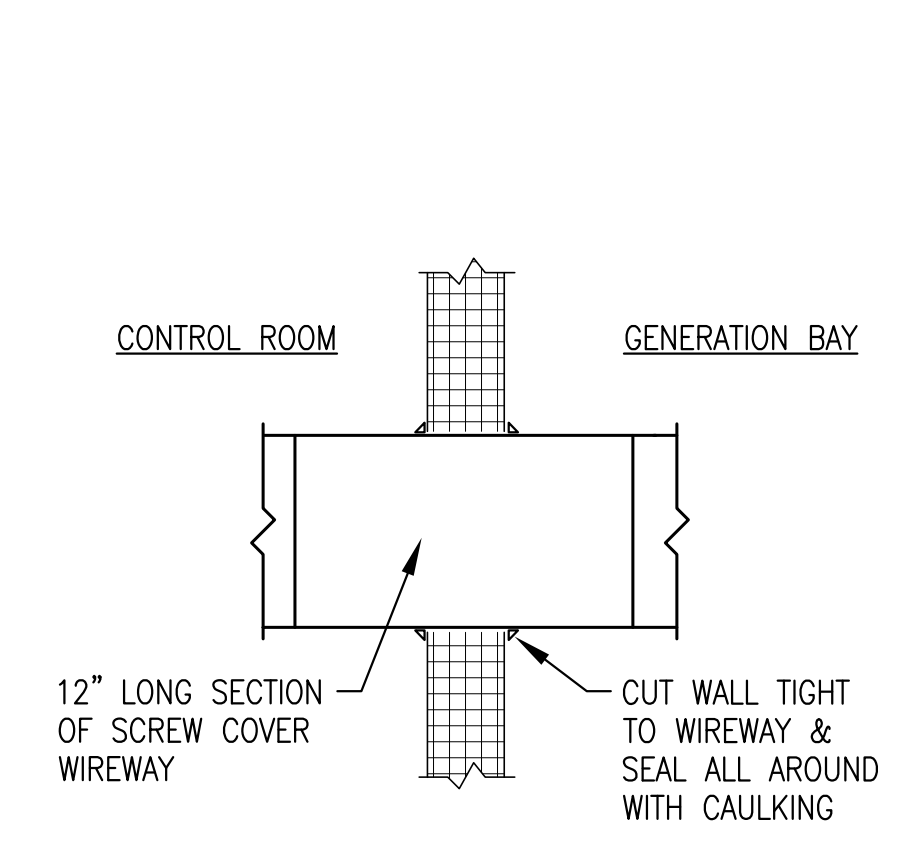

4 WIREWAY WALL PENETRATION
E3.1 NO SCALE

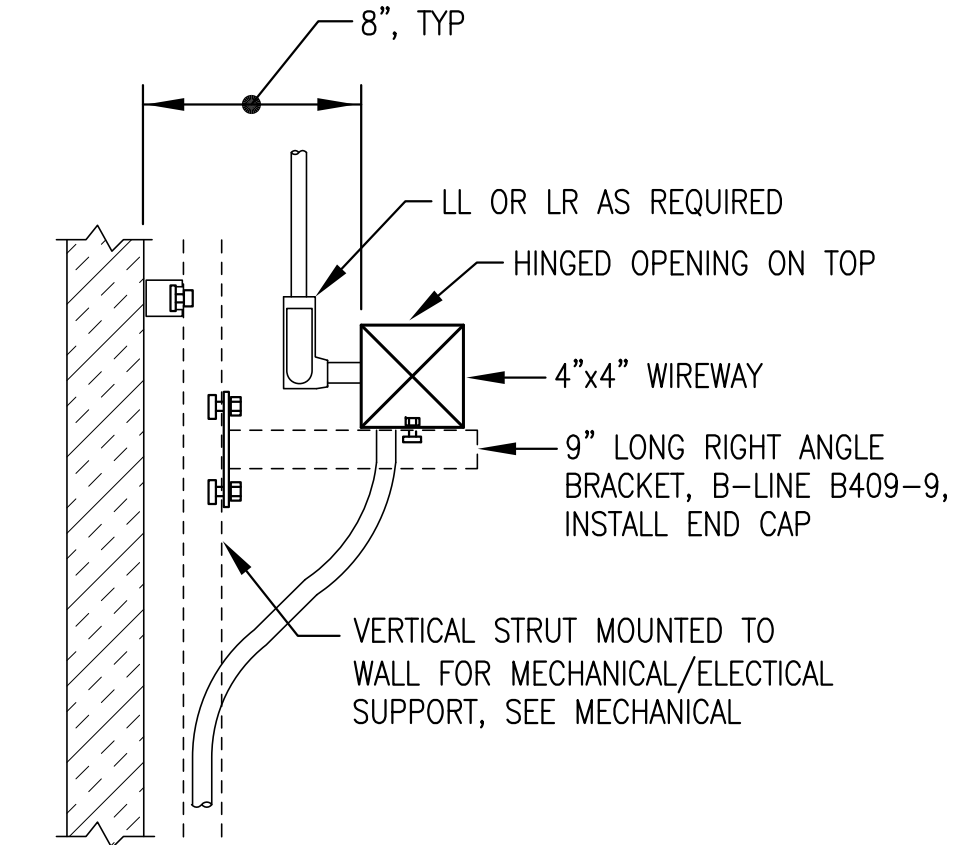

5 4" WIREWAY SUPPORT FROM WALL
E3.1 NO SCALE




Gray Stassel Engineering, Inc.
P.O. 111405
Anchorage, AK 99511
(907)949-0100

STATE OF ALASKA, AIDEA/AEA RURAL POWER SYSTEM UPGRADE
CLARKS POINT POWER PLANT
CLARKS POINT, ALASKA

REVISIONS	REV DATE	DESCRIPTION


VERIFY SCALES
0 1"
THIS BAR REPRESENTS ONE INCH ON ORIGINAL DRAWING

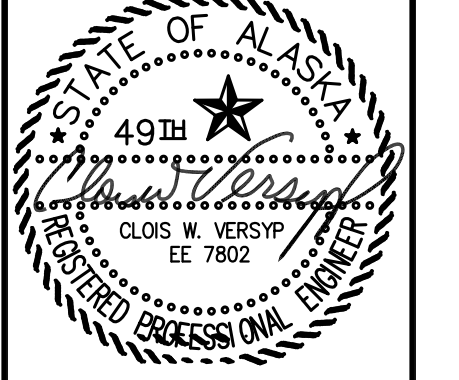


DATE: 1/14/19
DRAWN BY: JTD
CHECKED BY: CWV/BCG
JOB NUMBER:

DRAWING TITLE:
WIREWAY PLAN, MODULE SECTION, & DETAILS


ISSUED FOR CONSTRUCTION JANUARY 2019

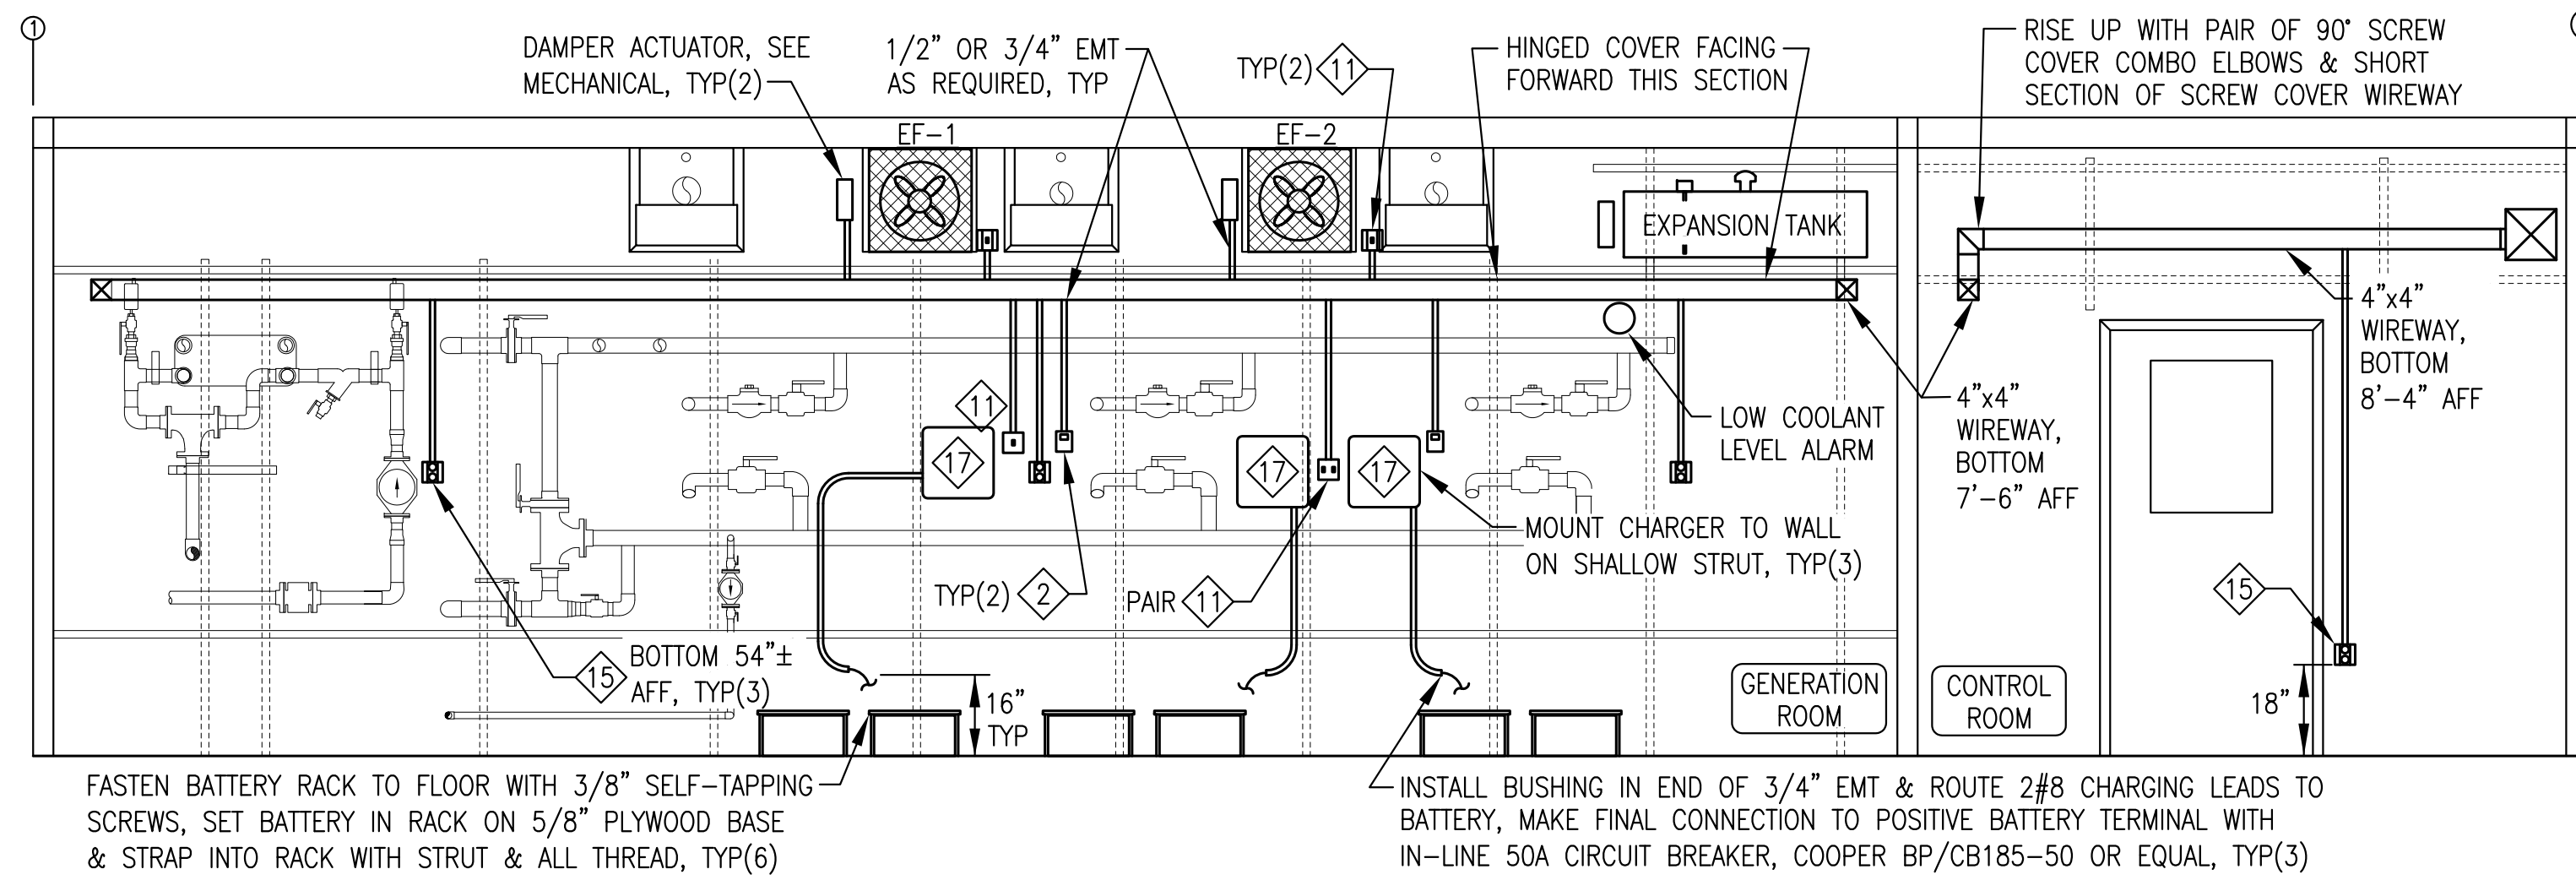


1 WALL ELEVATION AT GRID A
E3.2 3/8"=1'-0"

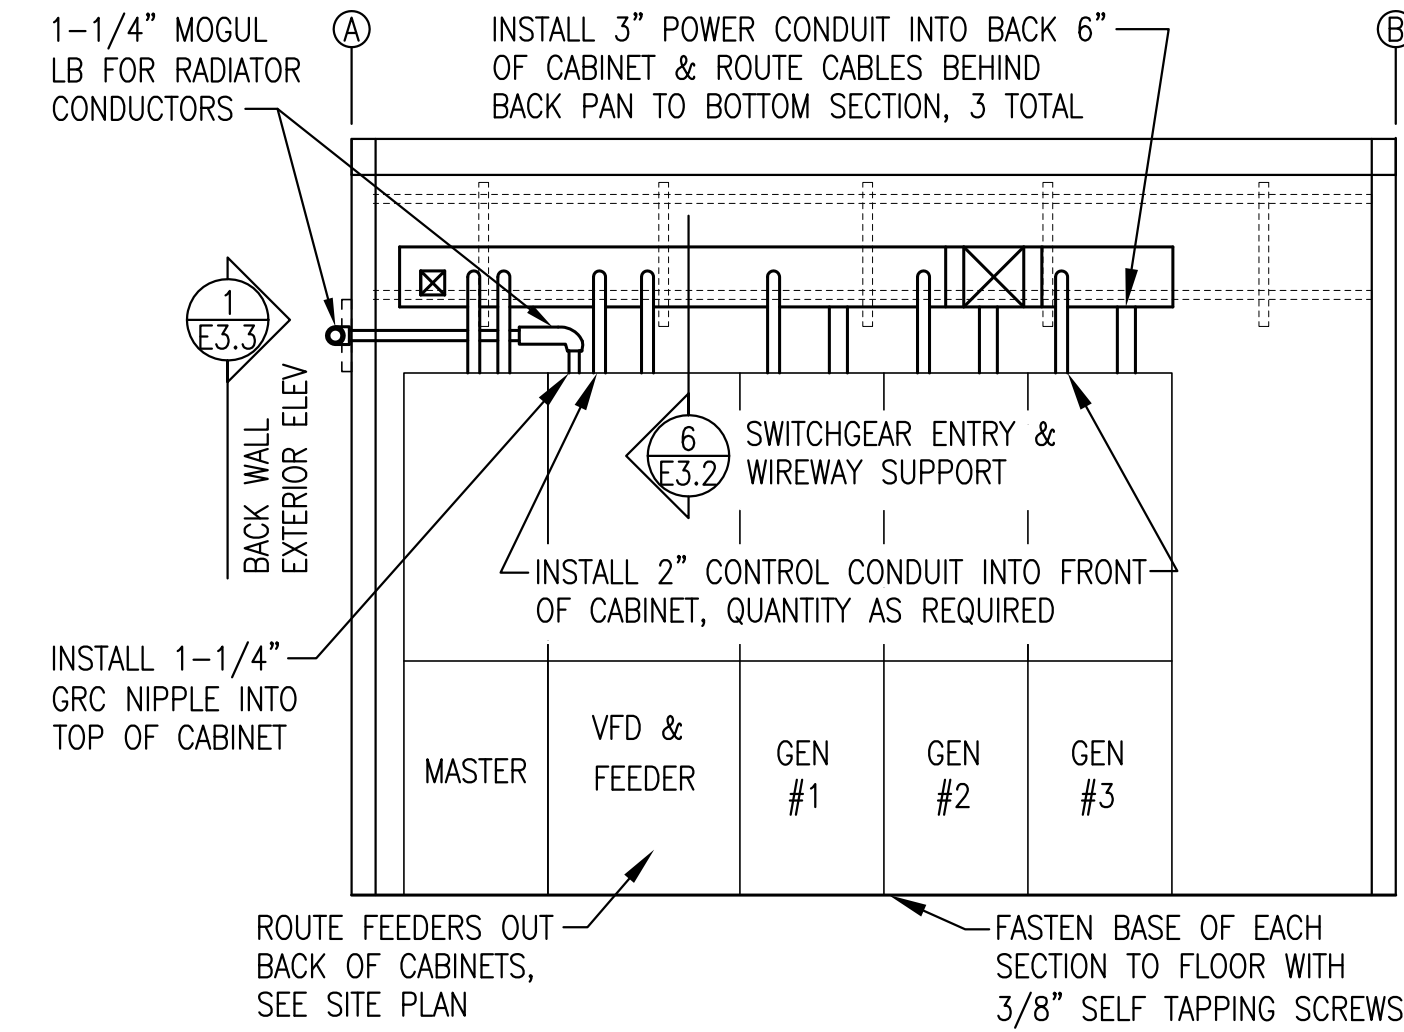


2 WALL ELEVATION AT GRID 2
E3.2 3/8"=1'-0"

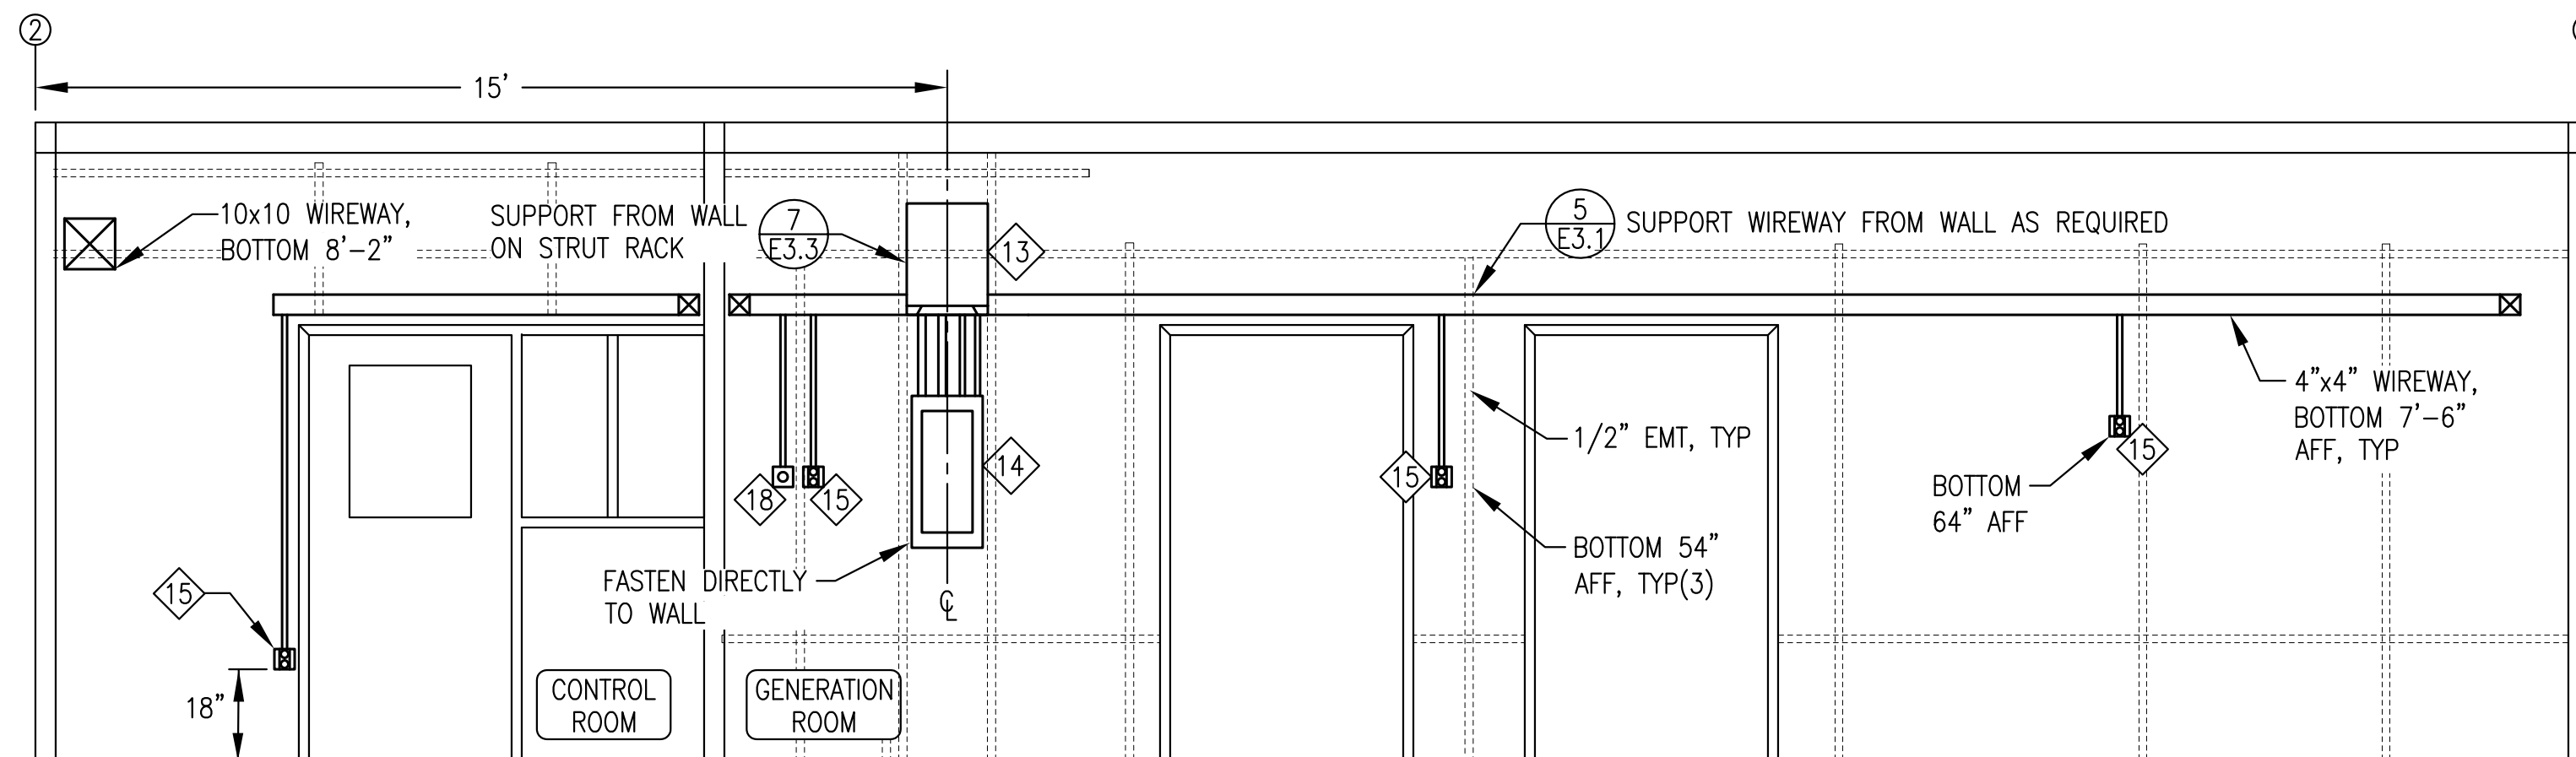


3 WALL ELEVATION AT GRID B
E3.2 3/8"=1'-0"

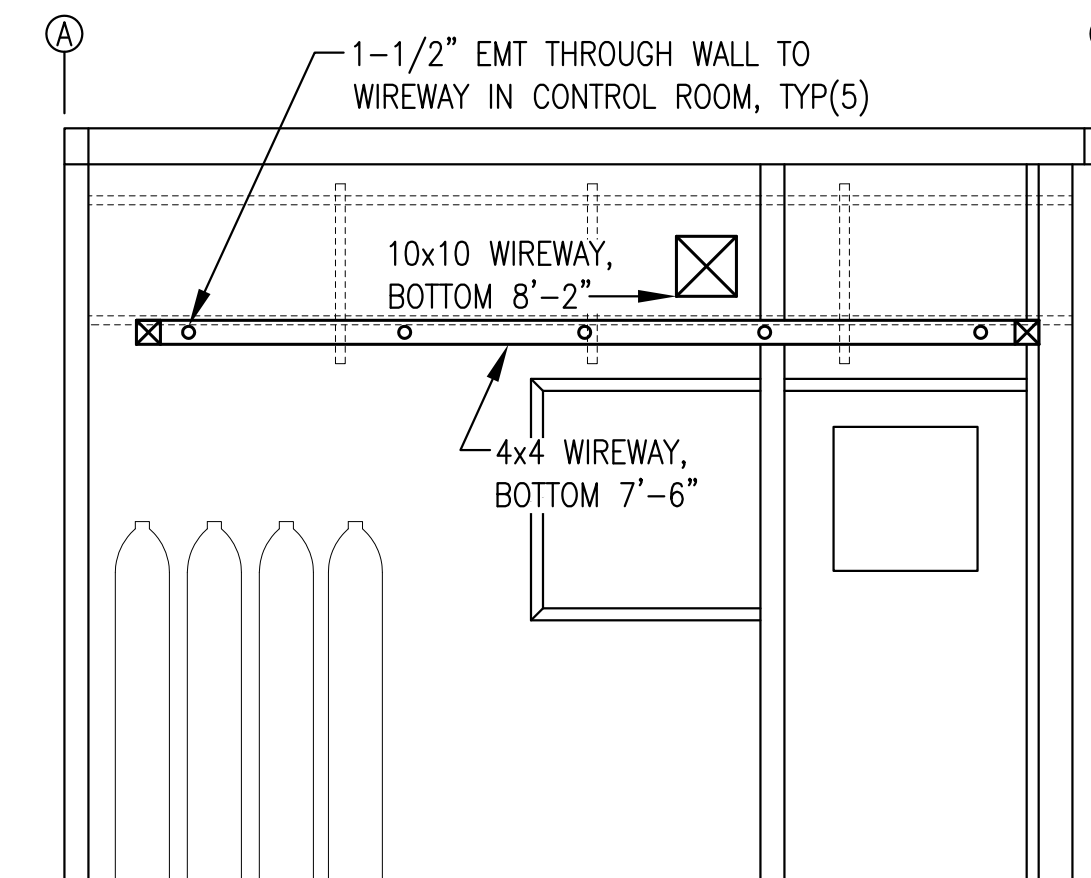


4 INTERIOR WALL ELEVATION
E3.2 3/8"=1'-0"

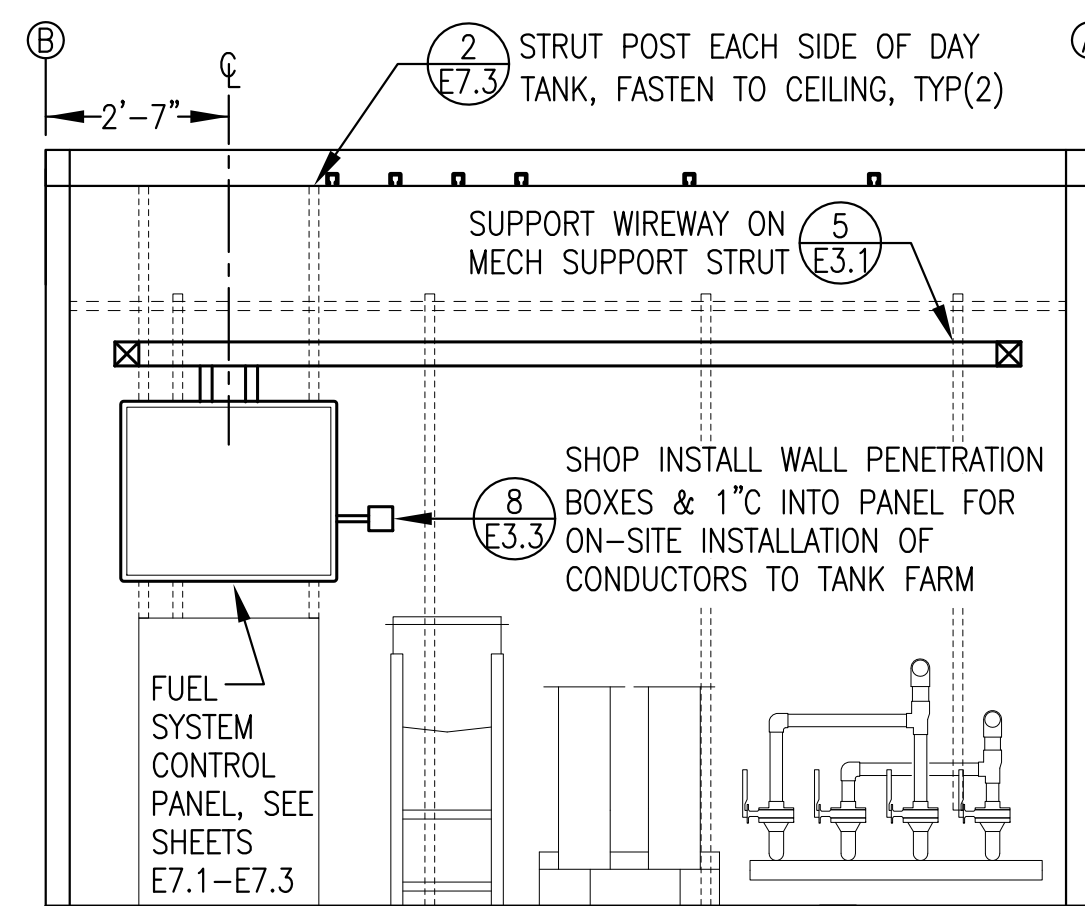

5 WALL ELEVATION AT GRID 1
E3.2 3/8"=1'-0"

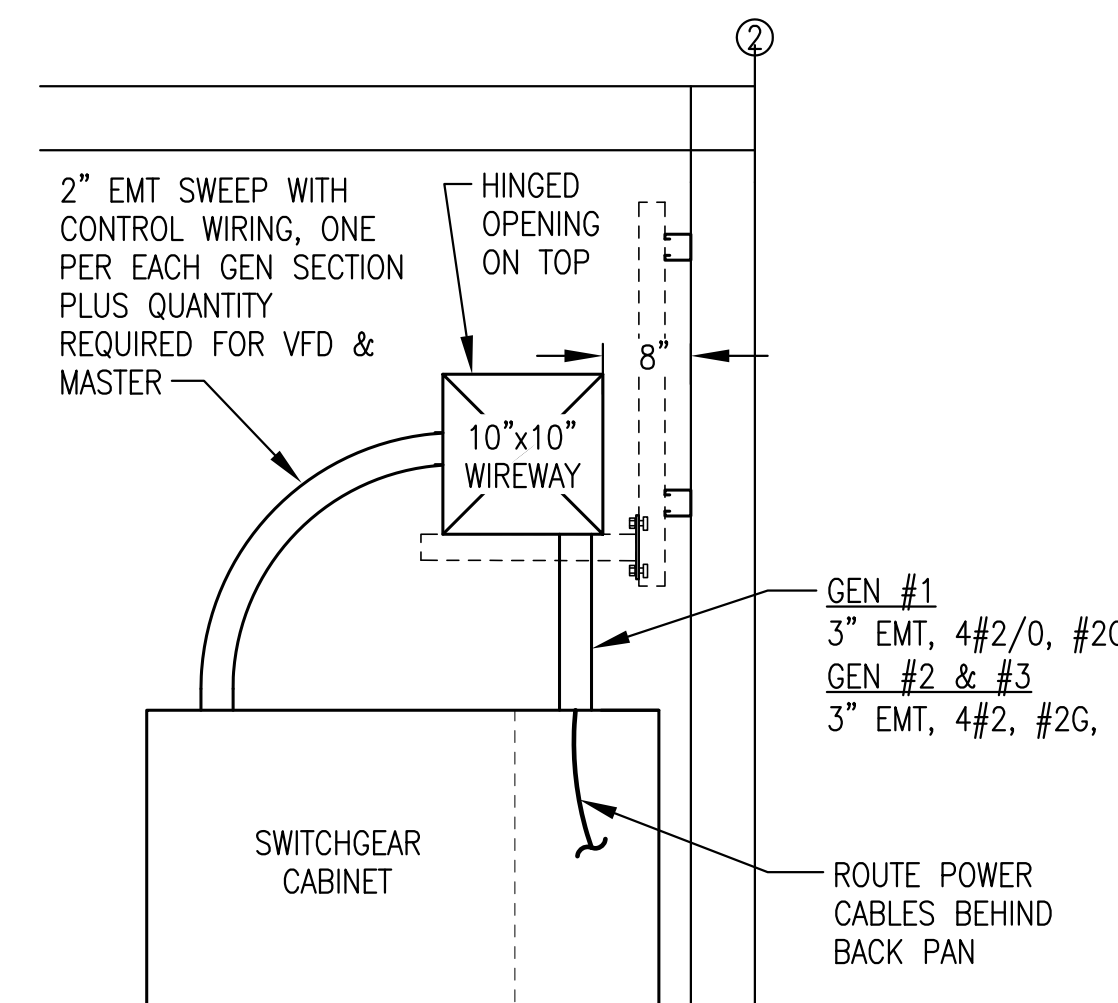

6 SWITCHGEAR ENTRY & WIREWAY SUPPORT
E3.2 NO SCALE

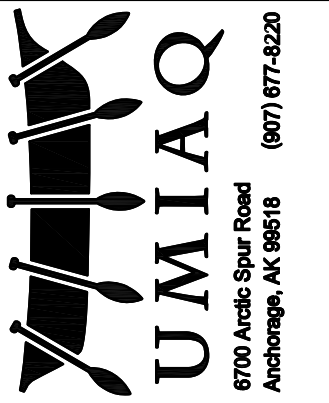

Gray Stassel Engineering, Inc.
P.O. 111405
Anchorage, AK 99511
(907)949-0100

STATE OF ALASKA, AIDEA/AEA RURAL POWER SYSTEM UPGRADE
CLARKS POINT POWER PLANT
CLARKS POINT, ALASKA

REVISIONS	DESCRIPTION

VERIFY SCALES
0 1"
THIS BAR REPRESENTS ONE INCH ON ORIGINAL DRAWING




DATE: 1/14/19
DRAWN BY: JTD
CHECKED BY: CWV/BCG
JOB NUMBER:


DRAWING TITLE:
ELEVATIONS & DETAILS

E3.2


ISSUED FOR CONSTRUCTION JANUARY 2019

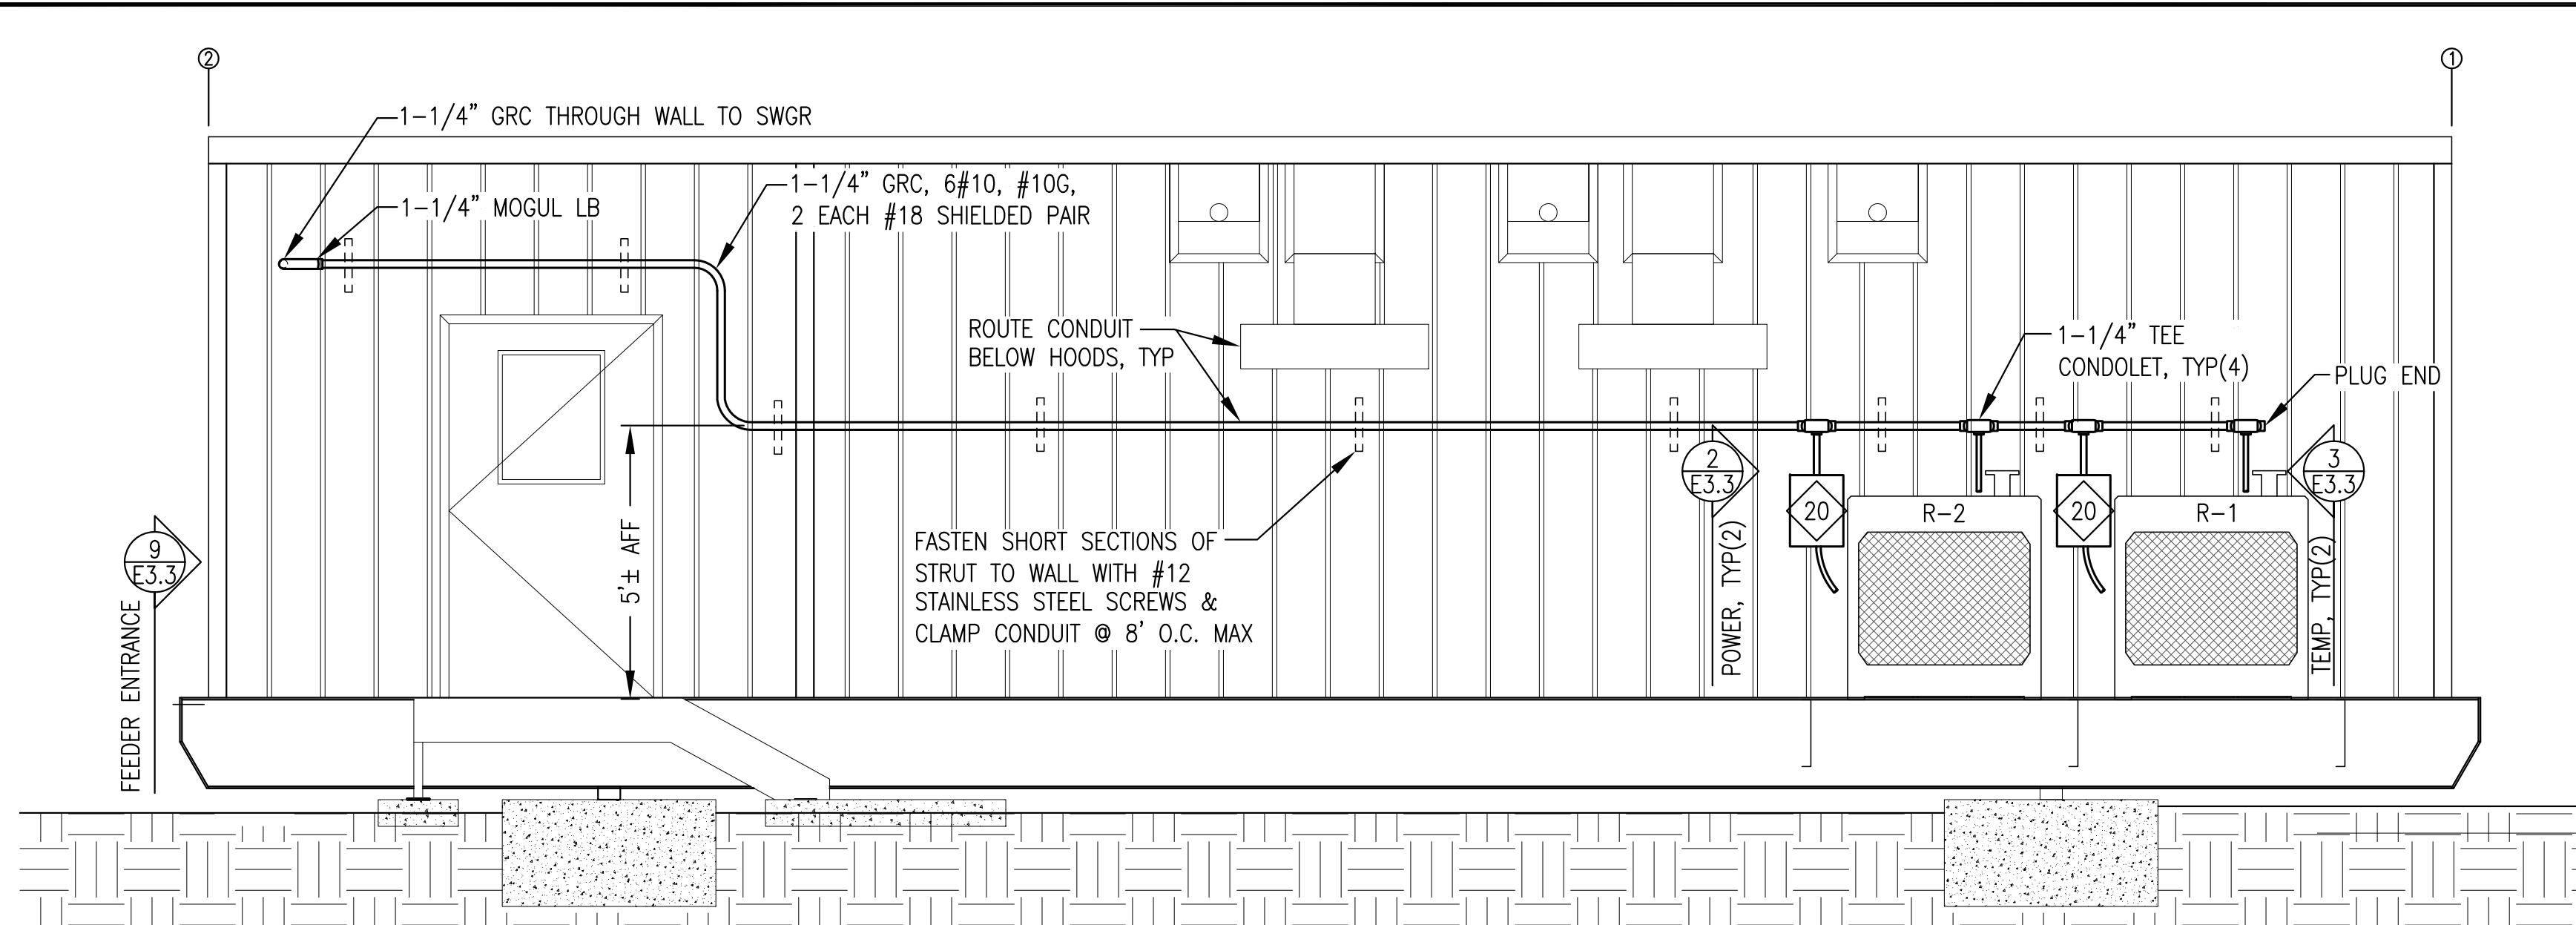

1 BACK WALL EXTERIOR ELEVATION
E3.3 3/8"=1'-0"

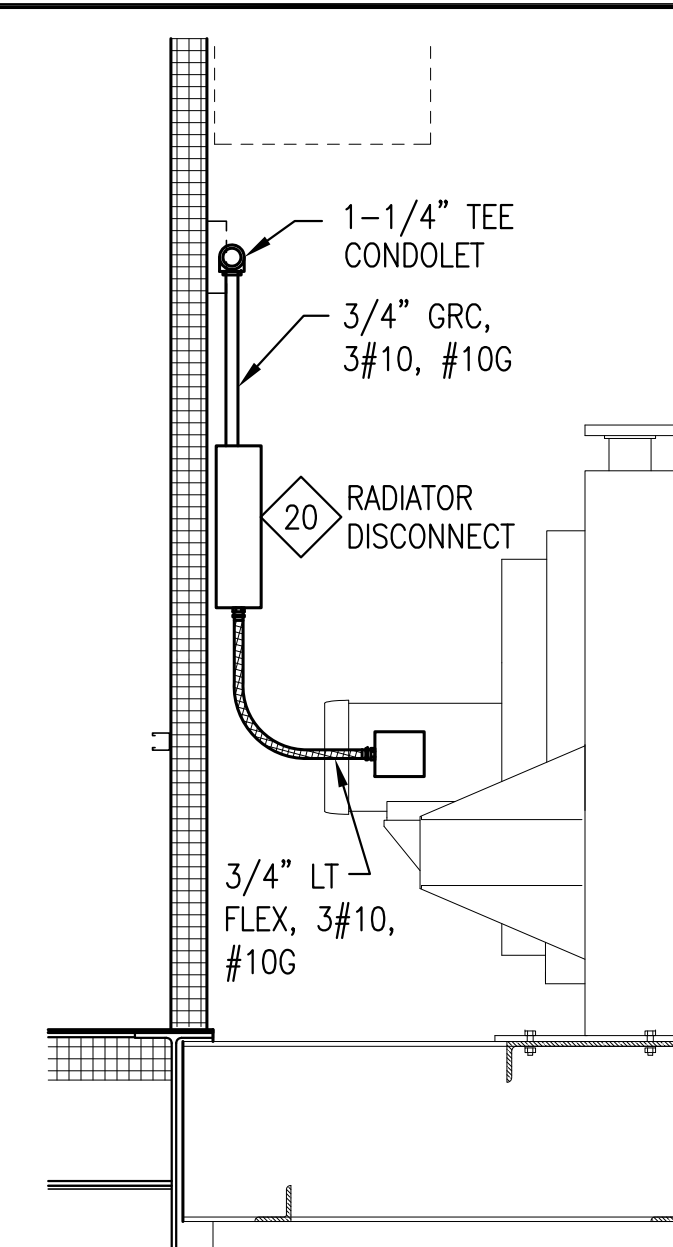


2 RADIATOR POWER CONNECTION
E3.3 3/4"=1'-0"

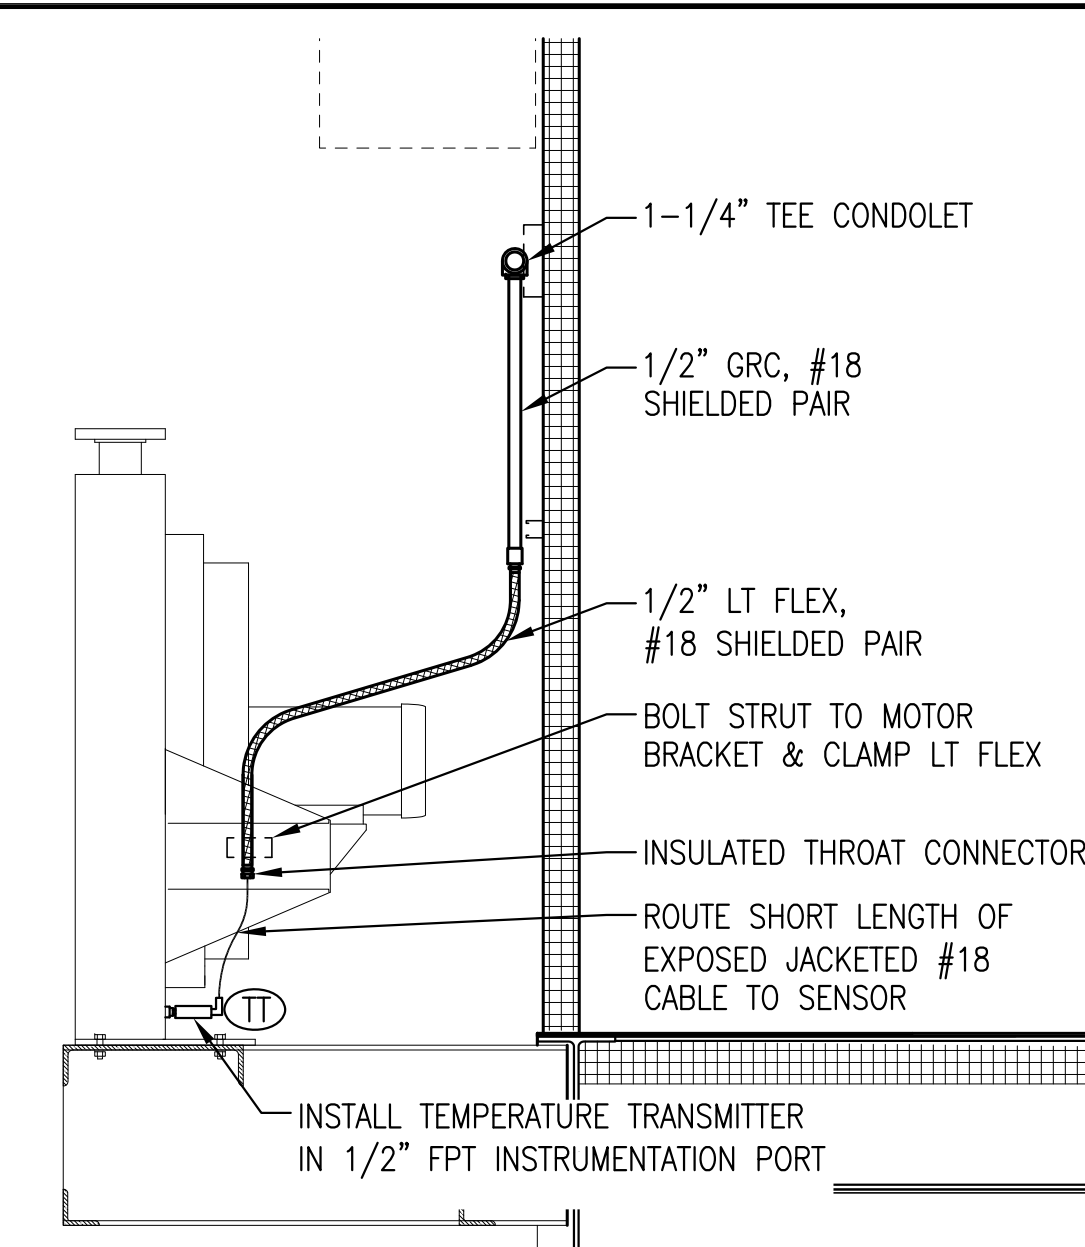

3 RADIATOR TEMPERATURE TRANSMITTER
E3.3 3/4"=1'-0"


NOTES:

- 1) THIS DETAIL APPLIES TO CONNECTIONS TO WIREWAY, GENERATOR ENCLOSURES, SWITCHGEAR, AND PANELS.
- 2) AT A MINIMUM INSTALL GROUNDING BUSHING ON ALL GENERATOR POWER CONDUIT, COMMUNITY FEEDER CONDUIT, STATION SERVICE FEEDERS, AND WHERE OTHERWISE INDICATED OR REQUIRED. BOND GROUNDING BUSHING TO EQUIPMENT GROUNDING CONDUCTOR.
- 3) INSTALL PLASTIC BUSHING WHERE GROUNDING BUSHING IS NOT REQUIRED.
- 4) ON GENERATOR ENCLOSURES MAKE ALL CONNECTIONS AS TIGHT AS POSSIBLE.

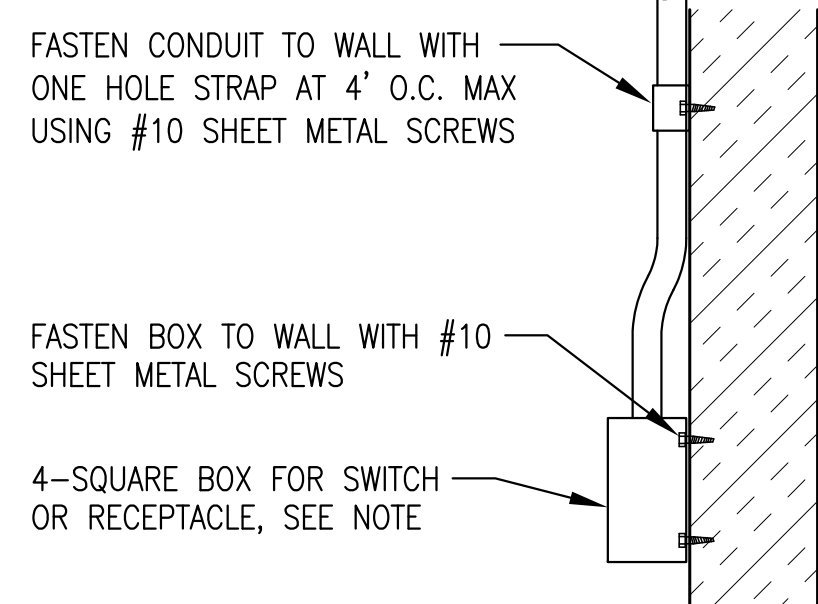


NOTE: INSTALL THERMOSTATS & TIMER SWITCHES IN DEEP SINGLE GANG BELL BOX INSTEAD OF 4-SQUARE BOX.


4 TYPICAL INTERIOR DEVICE MOUNTING
E3.3 NO SCALE

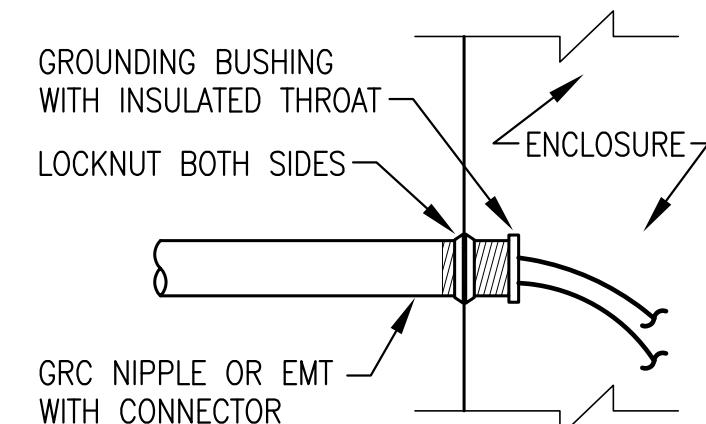


5 TYP ENCLOSURE CONNECTION
E3.3 NO SCALE

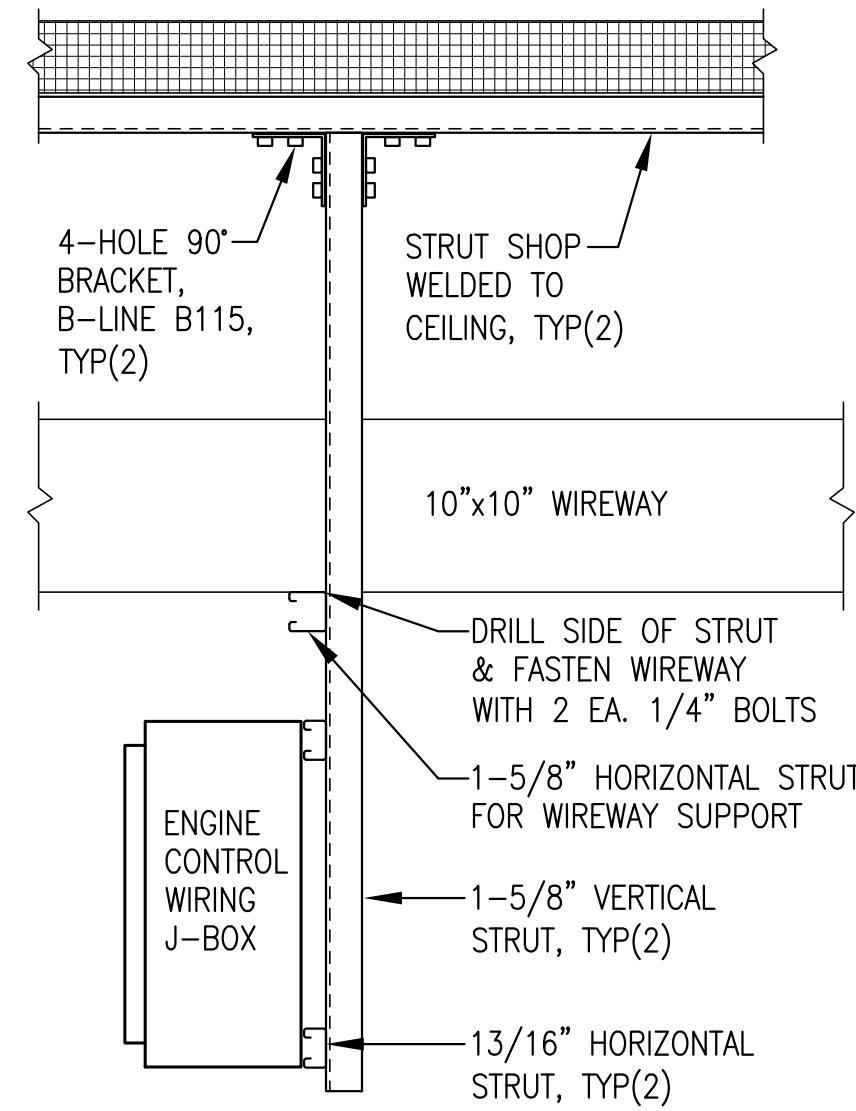

6 ENGINE WIRING J-BOX SUPPORT
E3.3 NO SCALE

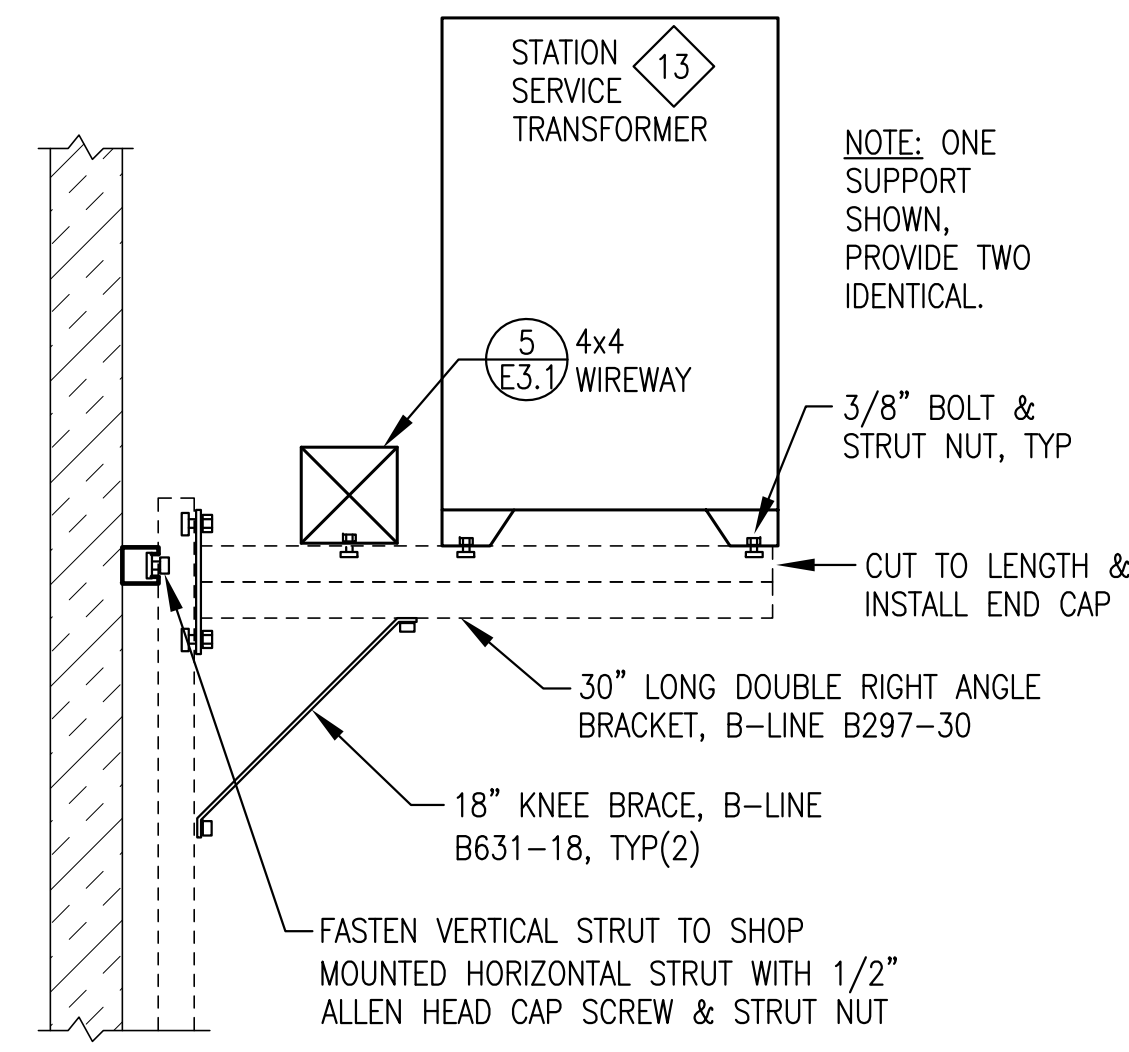

7 STATION SERVICE TRANSFORMER SUPPORT
E3.3 NO SCALE

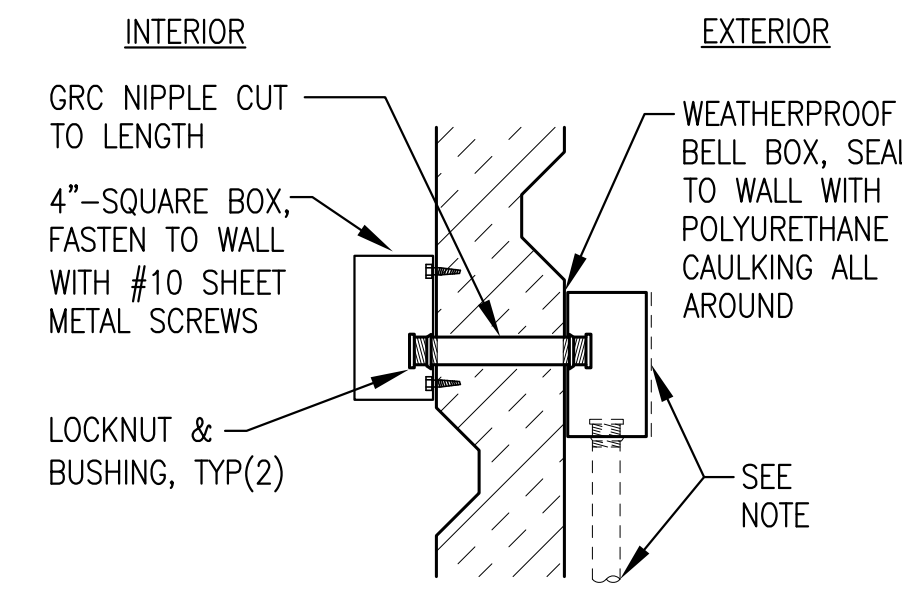


NOTE: FOR CONDUIT PENETRATIONS WITHOUT BELL BOX SEAL ALL AROUND CONDUIT WITH POLYURETHANE CAULK.

8 TYP EXTERIOR WALL-MOUNT DEVICE
E3.3 NO SCALE

FEEDER SHOP/ON-SITE NOTES:

- 1) DURING SHOP FABRICATION INSTALL WALL PENETRATION AS SHOWN AND SEAL COUPLING TO EXTERIOR WALL WITH POLYURETHANE CAULK ALL AROUND.
- 2) USE WALL PENETRATION TO ROUTE TEMPORARY CABLES TO LOAD BANK FOR TESTING. AFTER TESTING INSTALL THREADED PLUG IN COUPLING.
- 3) INSTALL FEEDER TO TRANSFORMER AS PART OF ON-SITE WORK, SEE SHEET E2 FOR CONTINUATION.

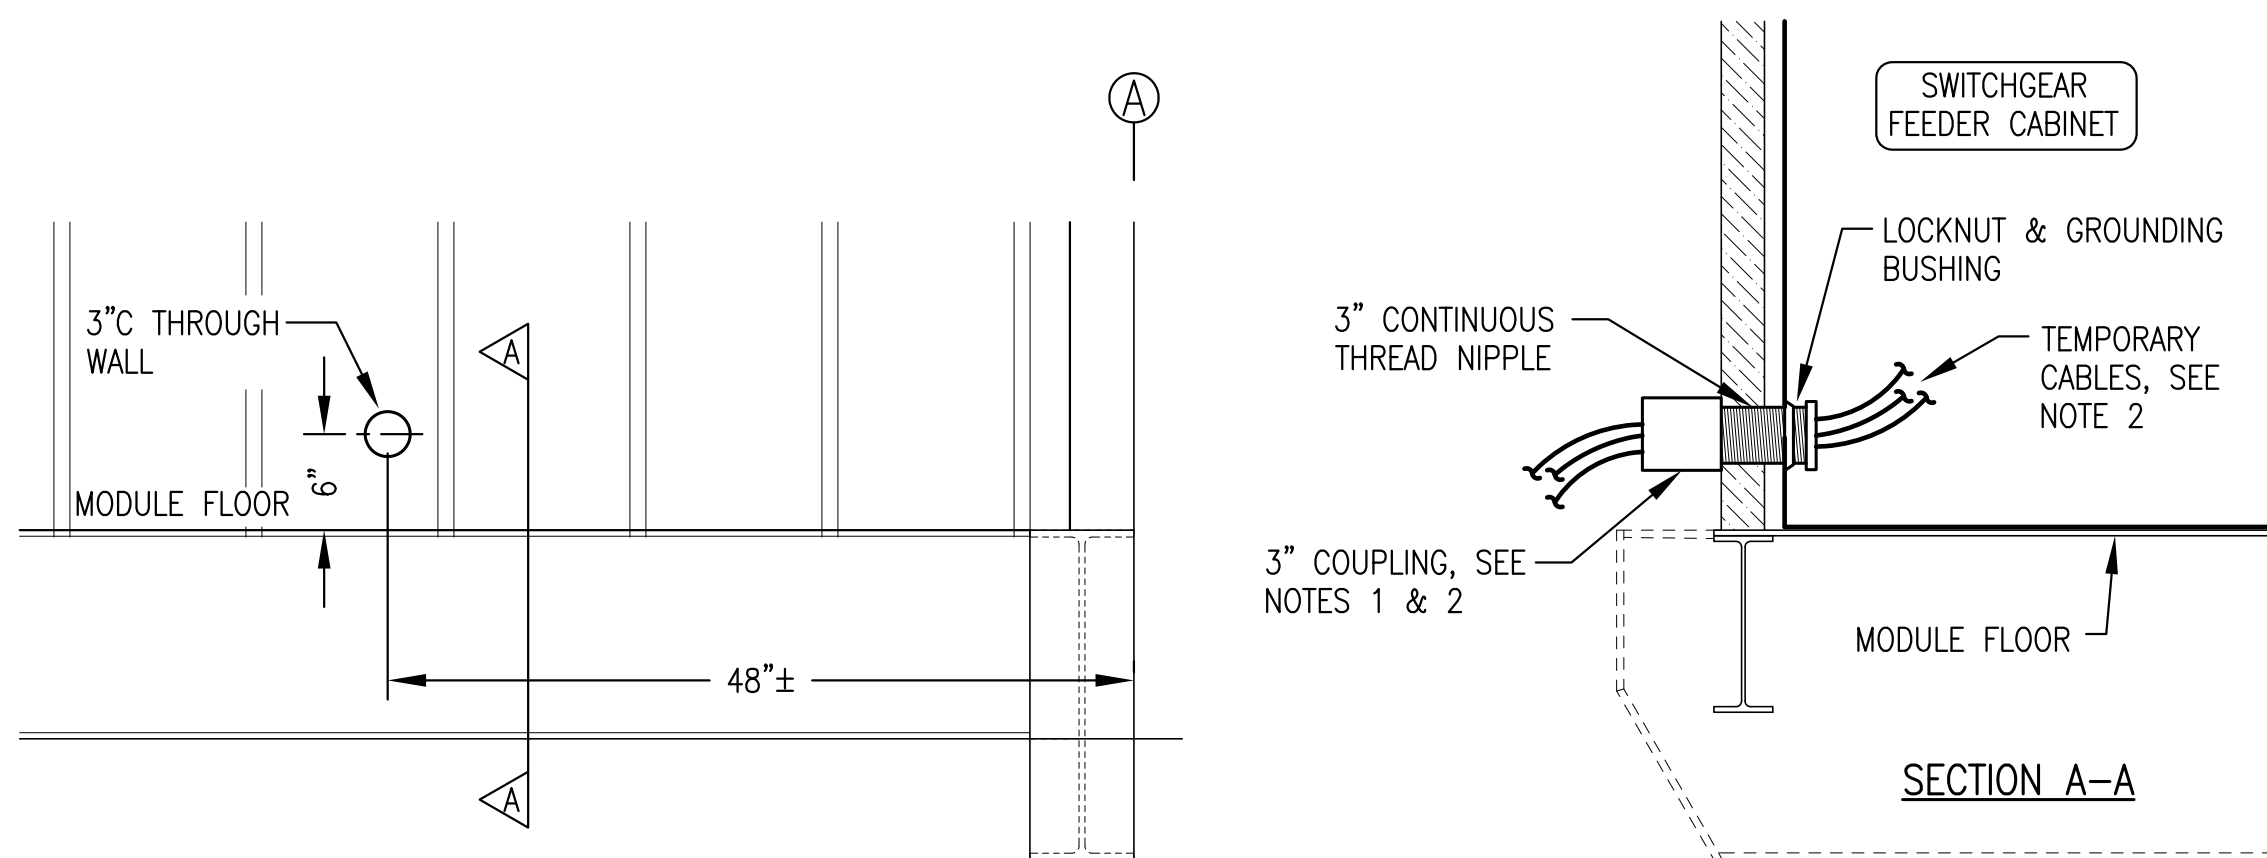

9 FEEDER ENTRANCE DETAIL
E3.3 1"=1'-0"




Gray Stassel Engineering, Inc.
P.O. 111405
Anchorage, AK 99511
(907)949-0100

STATE OF ALASKA, AIDEA/AEA RURAL POWER SYSTEM UPGRADE
CLARKS POINT POWER PLANT
CLARKS POINT, ALASKA

REVISIONS	REV DATE	DESCRIPTION

VERIFY SCALES
0 1"
THIS BAR REPRESENTS ONE INCH ON ORIGINAL DRAWING

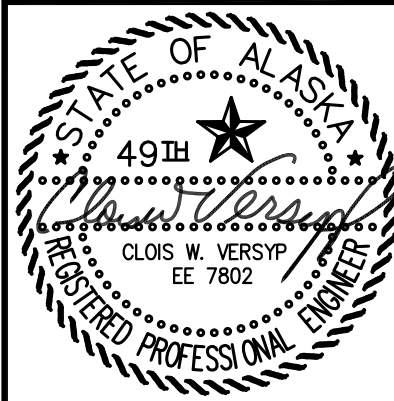


DATE: 1/14/19
DRAWN BY: JTD
CHECKED BY: CWV/BCG
JOB NUMBER:

DRAWING TITLE:
ELEVATIONS & DETAILS


E3.3
SHEET OF 7

ISSUED FOR CONSTRUCTION JANUARY 2019

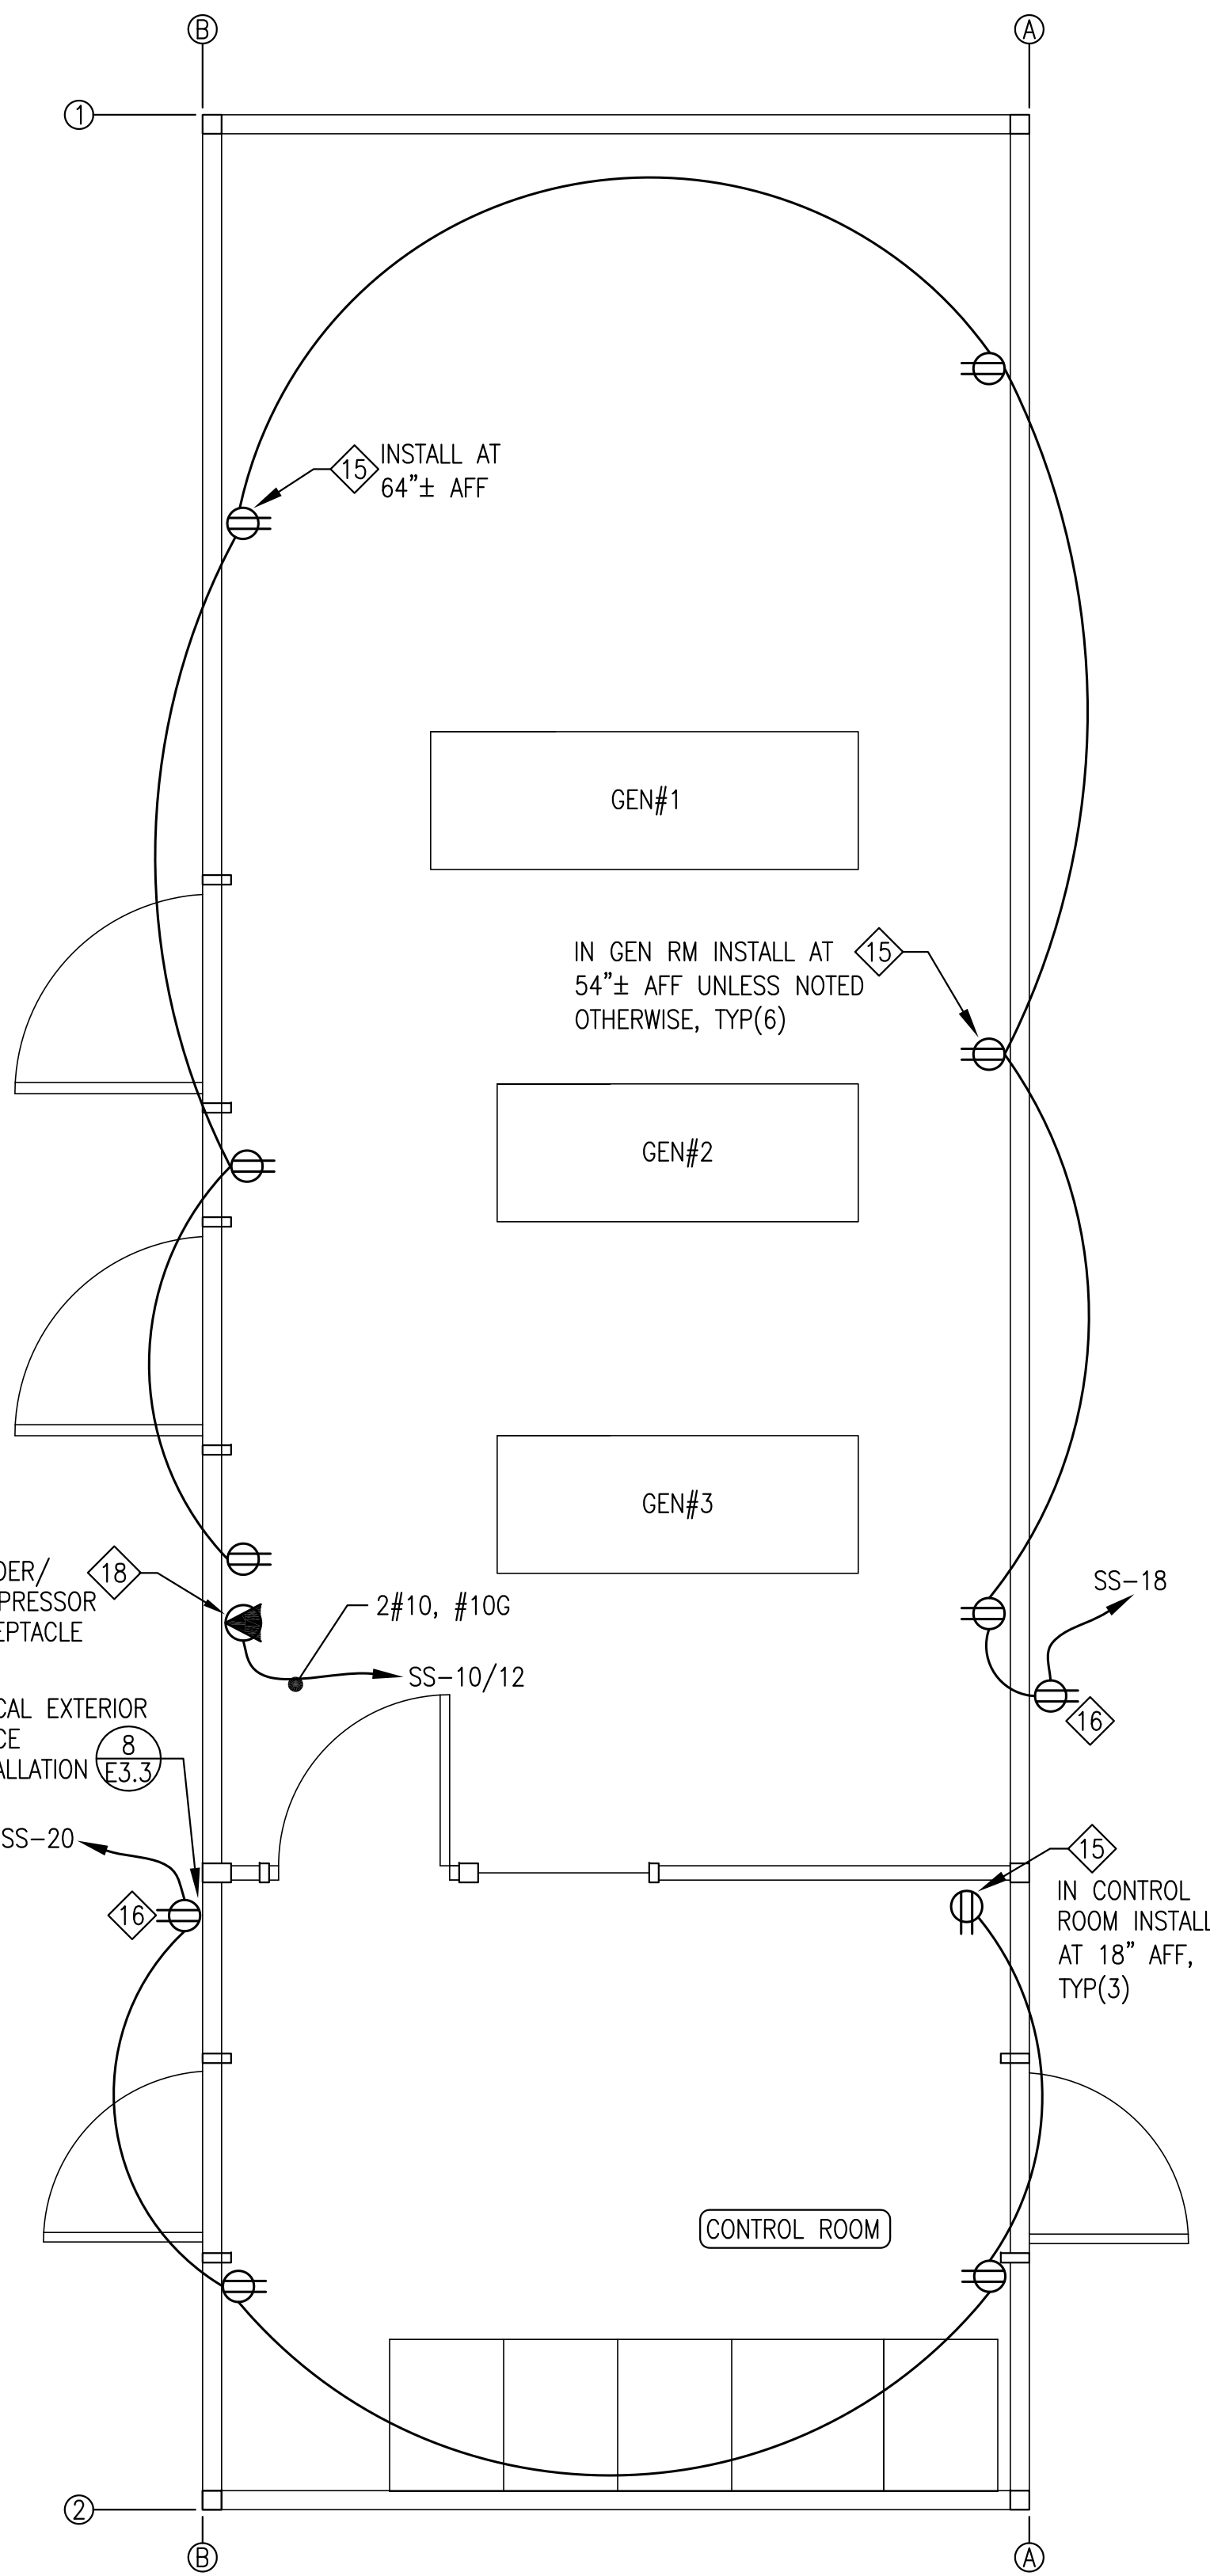


NOTE: ALL WIRING RUNS 2#12, #12G UNLESS SPECIFICALLY NOTED OTHERWISE.

1
E4.1 RECEPTACLE PLAN
3/8"=1'-0"

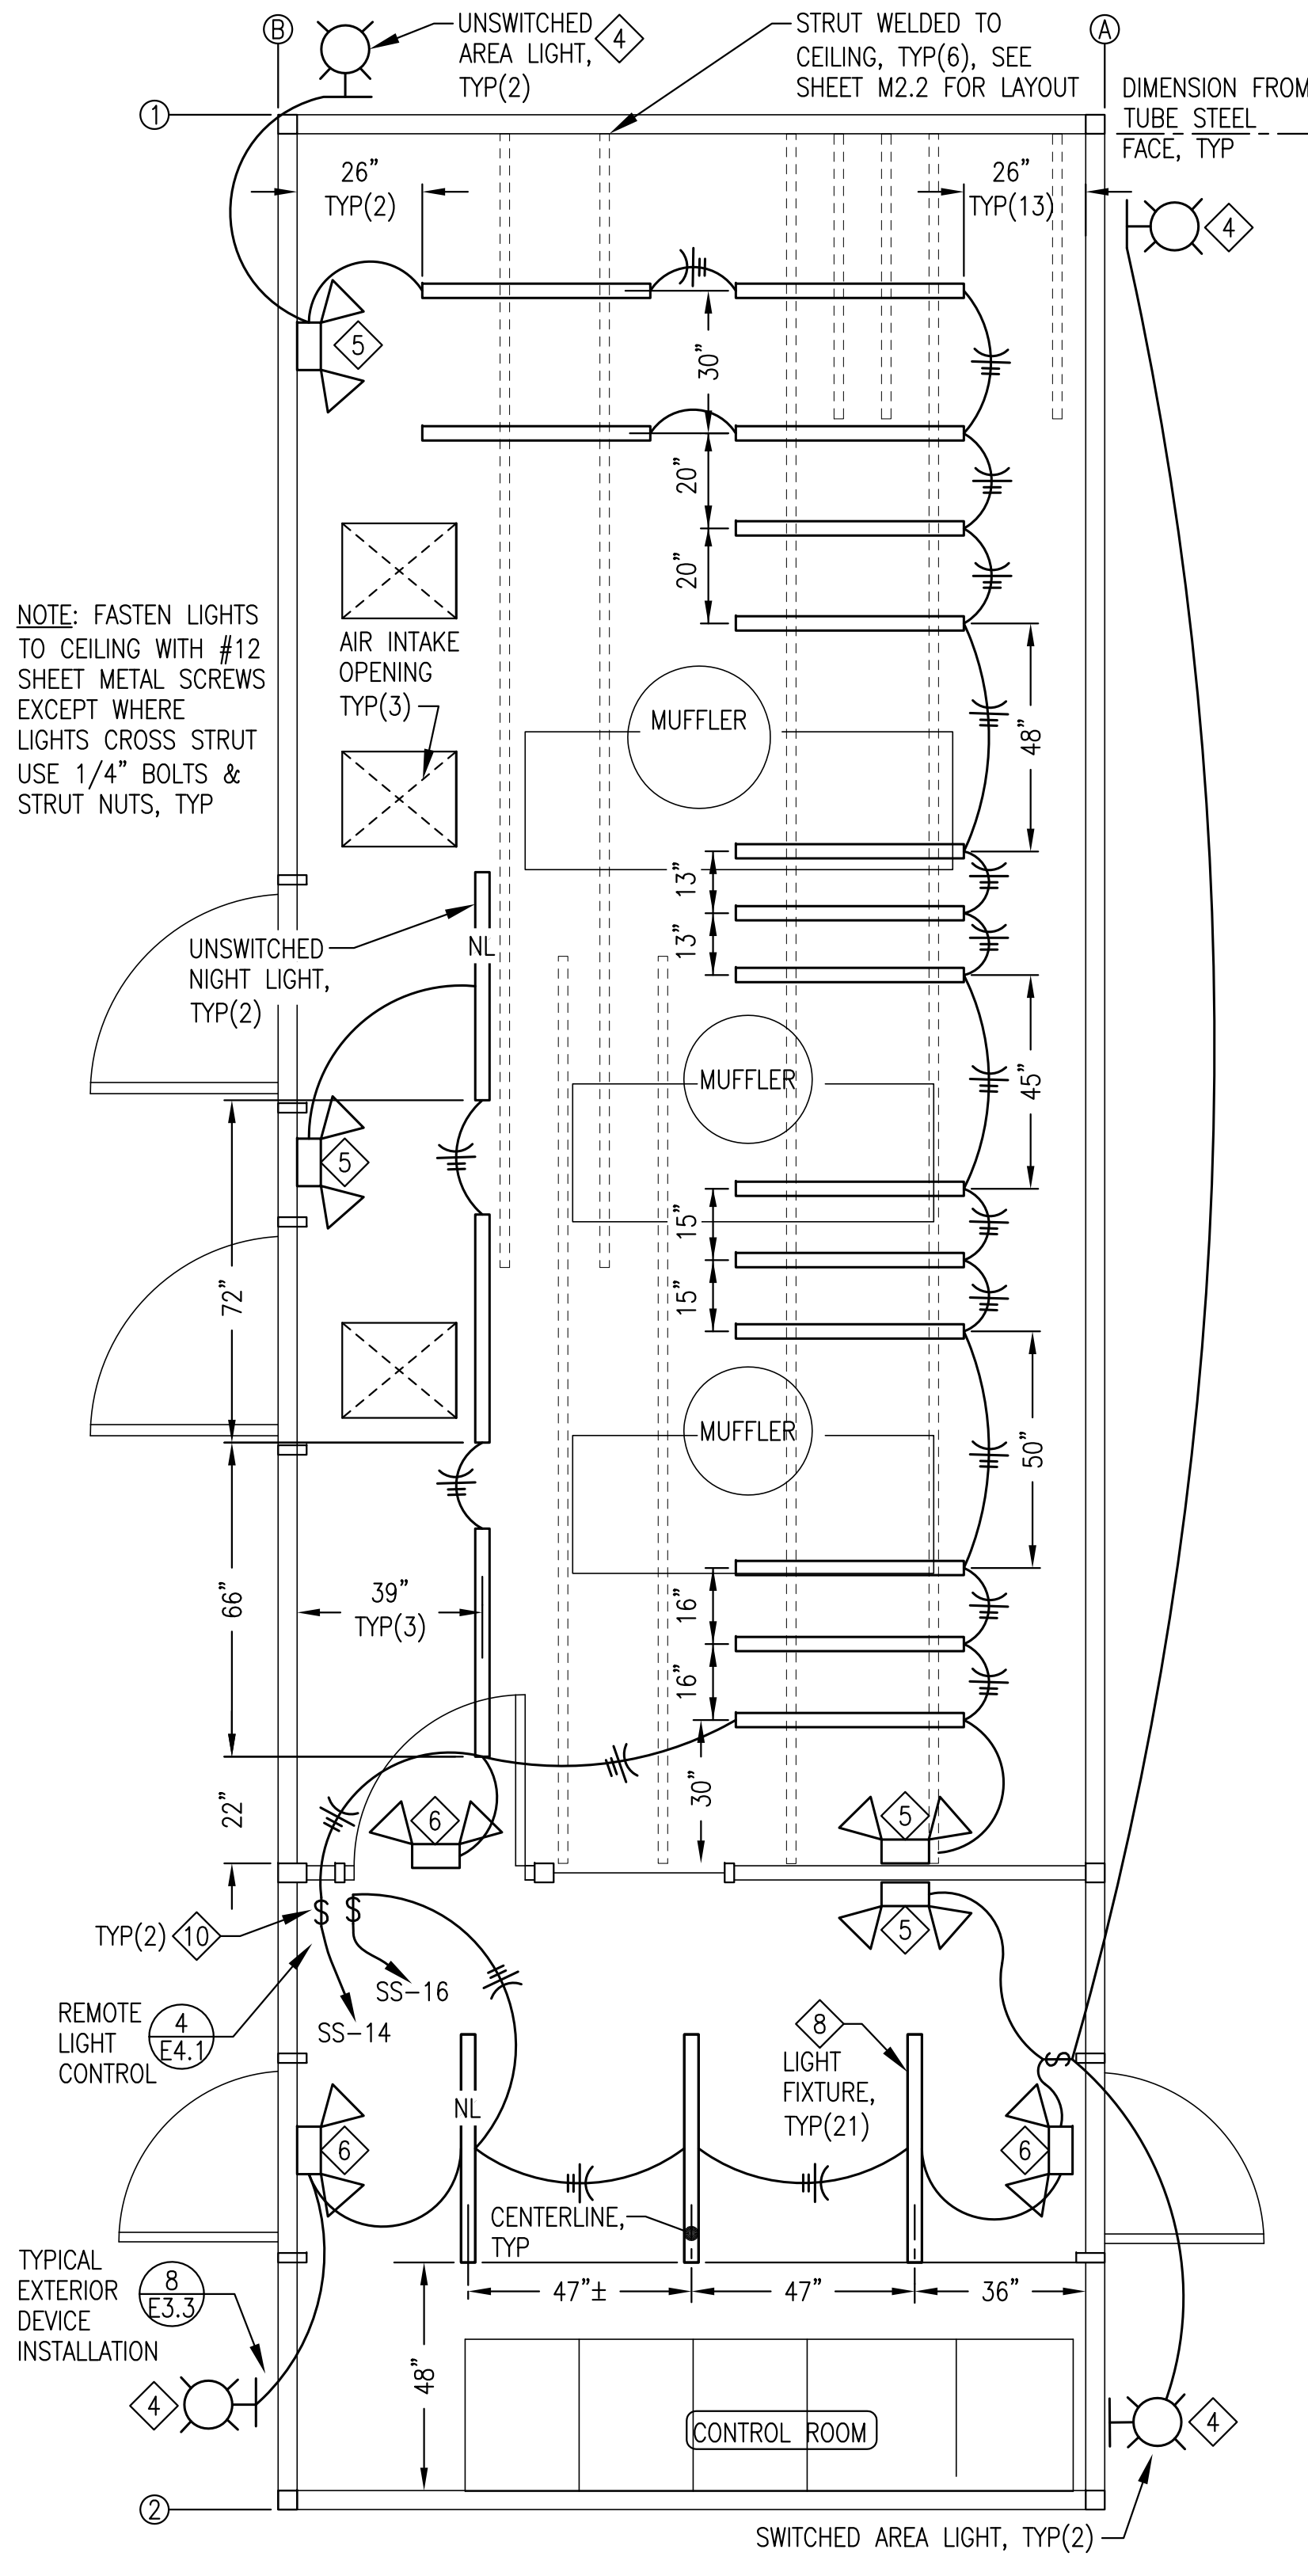


NOTE: ALL WIRING RUNS 2#12, #12G UNLESS SPECIFICALLY NOTED OTHERWISE.

2
E4.1 LIGHTING PLAN
3/8"=1'-0"

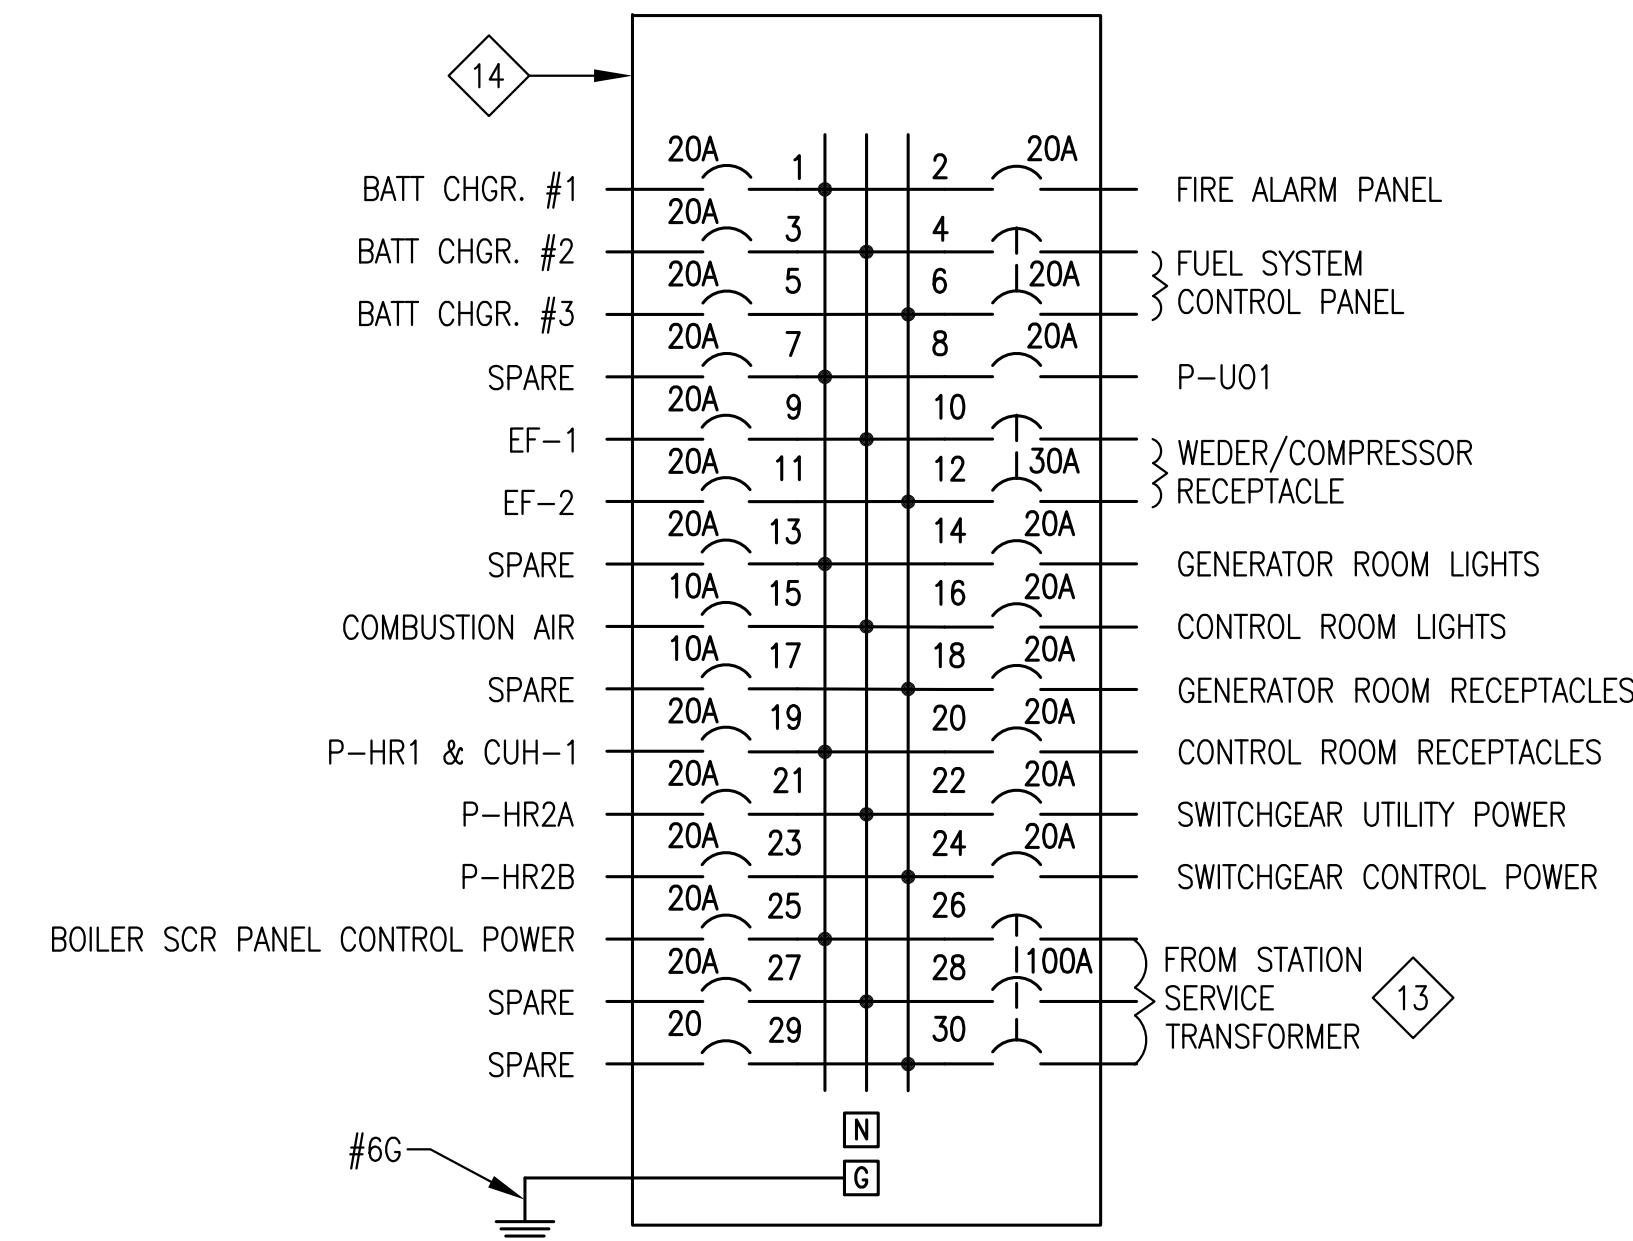

3
E4.1 STATION SERVICE PANEL "SS"
NO SCALE

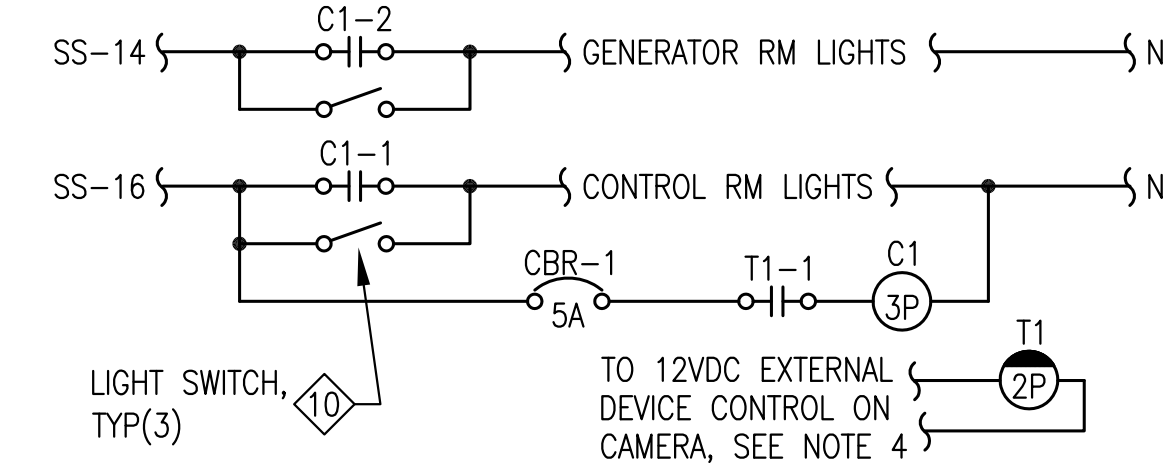

- NOTES:**
- INSTALL CONTACTOR, TIMER RELAY, AND CIRCUIT BREAKER IN 12"x12"x6" NEMA 1 JUNCTION BOX ON WALL ABOVE LIGHT SWITCHES.
 - ALL LIGHTING CIRCUIT WIRING MIN #12 AWG. ALL 5A CONTROL CIRCUIT WIRING MIN #16AWG.
 - SET TIMER FOR 5 MINUTES, SINGLE SHOT MODE.
 - CONNECT TO CONFIGURABLE OUTPUT PINS ON CAMERA AND PROGRAM TO POWER RELAY ON CAMERA OPERATION.
- BILL OF MATERIALS:**
- CBR1: 5A, 1P, RAIL MOUNT CIRCUIT BREAKER. ALLEN BRADLEY 1489-A1-050.
- C1: 23A, 3P CONTACTOR, 120V COIL. ALLEN BRADLEY 100-C23D10.
- T1: 10A, DPDT RELAY, 12VDC COIL, WITH SOCKET BASE AND TIMING MODULE. ALLEN BRADLEY 700-HA32212 RELAY WITH 700HN204 BASE AND 700HT3 SERIES B TIMING MODULE.

4
E4.1 LIGHTING REMOTE CONTROL SCHEMATIC
NO SCALE

BUILDING PLANS SYMBOL LEGEND		BUILDING PLANS SYMBOL LEGEND	
SYMBOL	DESCRIPTION	SYMBOL	DESCRIPTION
SS-##	HOME RUN TO PANEL & BREAKER(S) INDICATED. SHORT DASH INDICATES HOT CONDUCTOR, LONG DASH INDICATES NEUTRAL CONDUCTOR, CURVED DASH INDICATES GROUND CONDUCTOR. IF NOT SPECIFICALLY INDICATED, PROVIDE 2#12 AWG & 1#12 AWG GROUND.		125V, 20A, DUPLEX RECEPTACLE
	ELECTRICAL ITEM - SEE EQUIPMENT SCHEDULE ON SHEET E6		LINE VOLTAGE THERMOSTAT
	MOTOR (HORSEPOWER INDICATED)		DIGITAL THERMOSTAT, MODULATING
	MOTORIZED DAMPER - SEE MECHANICAL		SNAP SWITCH / SMALL MOTOR DISCONNECT
			TIMER SWITCH
			GROUND

ISSUED FOR CONSTRUCTION JANUARY 2019




**STATE OF ALASKA, AIDEA/AEA
RURAL POWER SYSTEM UPGRADE**

CLARKS POINT POWER PLANT
CLARKS POINT, ALASKA


CONSTRUCTION DOCUMENTS	
REVISIONS	DESCRIPTION
REV DATE	

VERIFY SCALES
0 1"
THIS BAR REPRESENTS ONE INCH ON ORIGINAL DRAWING

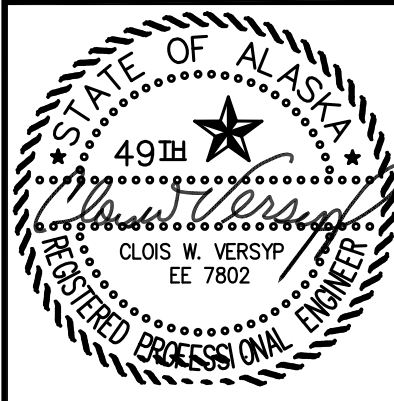

DATE: 1/14/19
DRAWN BY: JTD
CHECKED BY: CWV/BCG
JOB NUMBER:

DRAWING TITLE:
RECEPTACLE &
LIGHTING PLANS &
STATION SERVICE PANEL

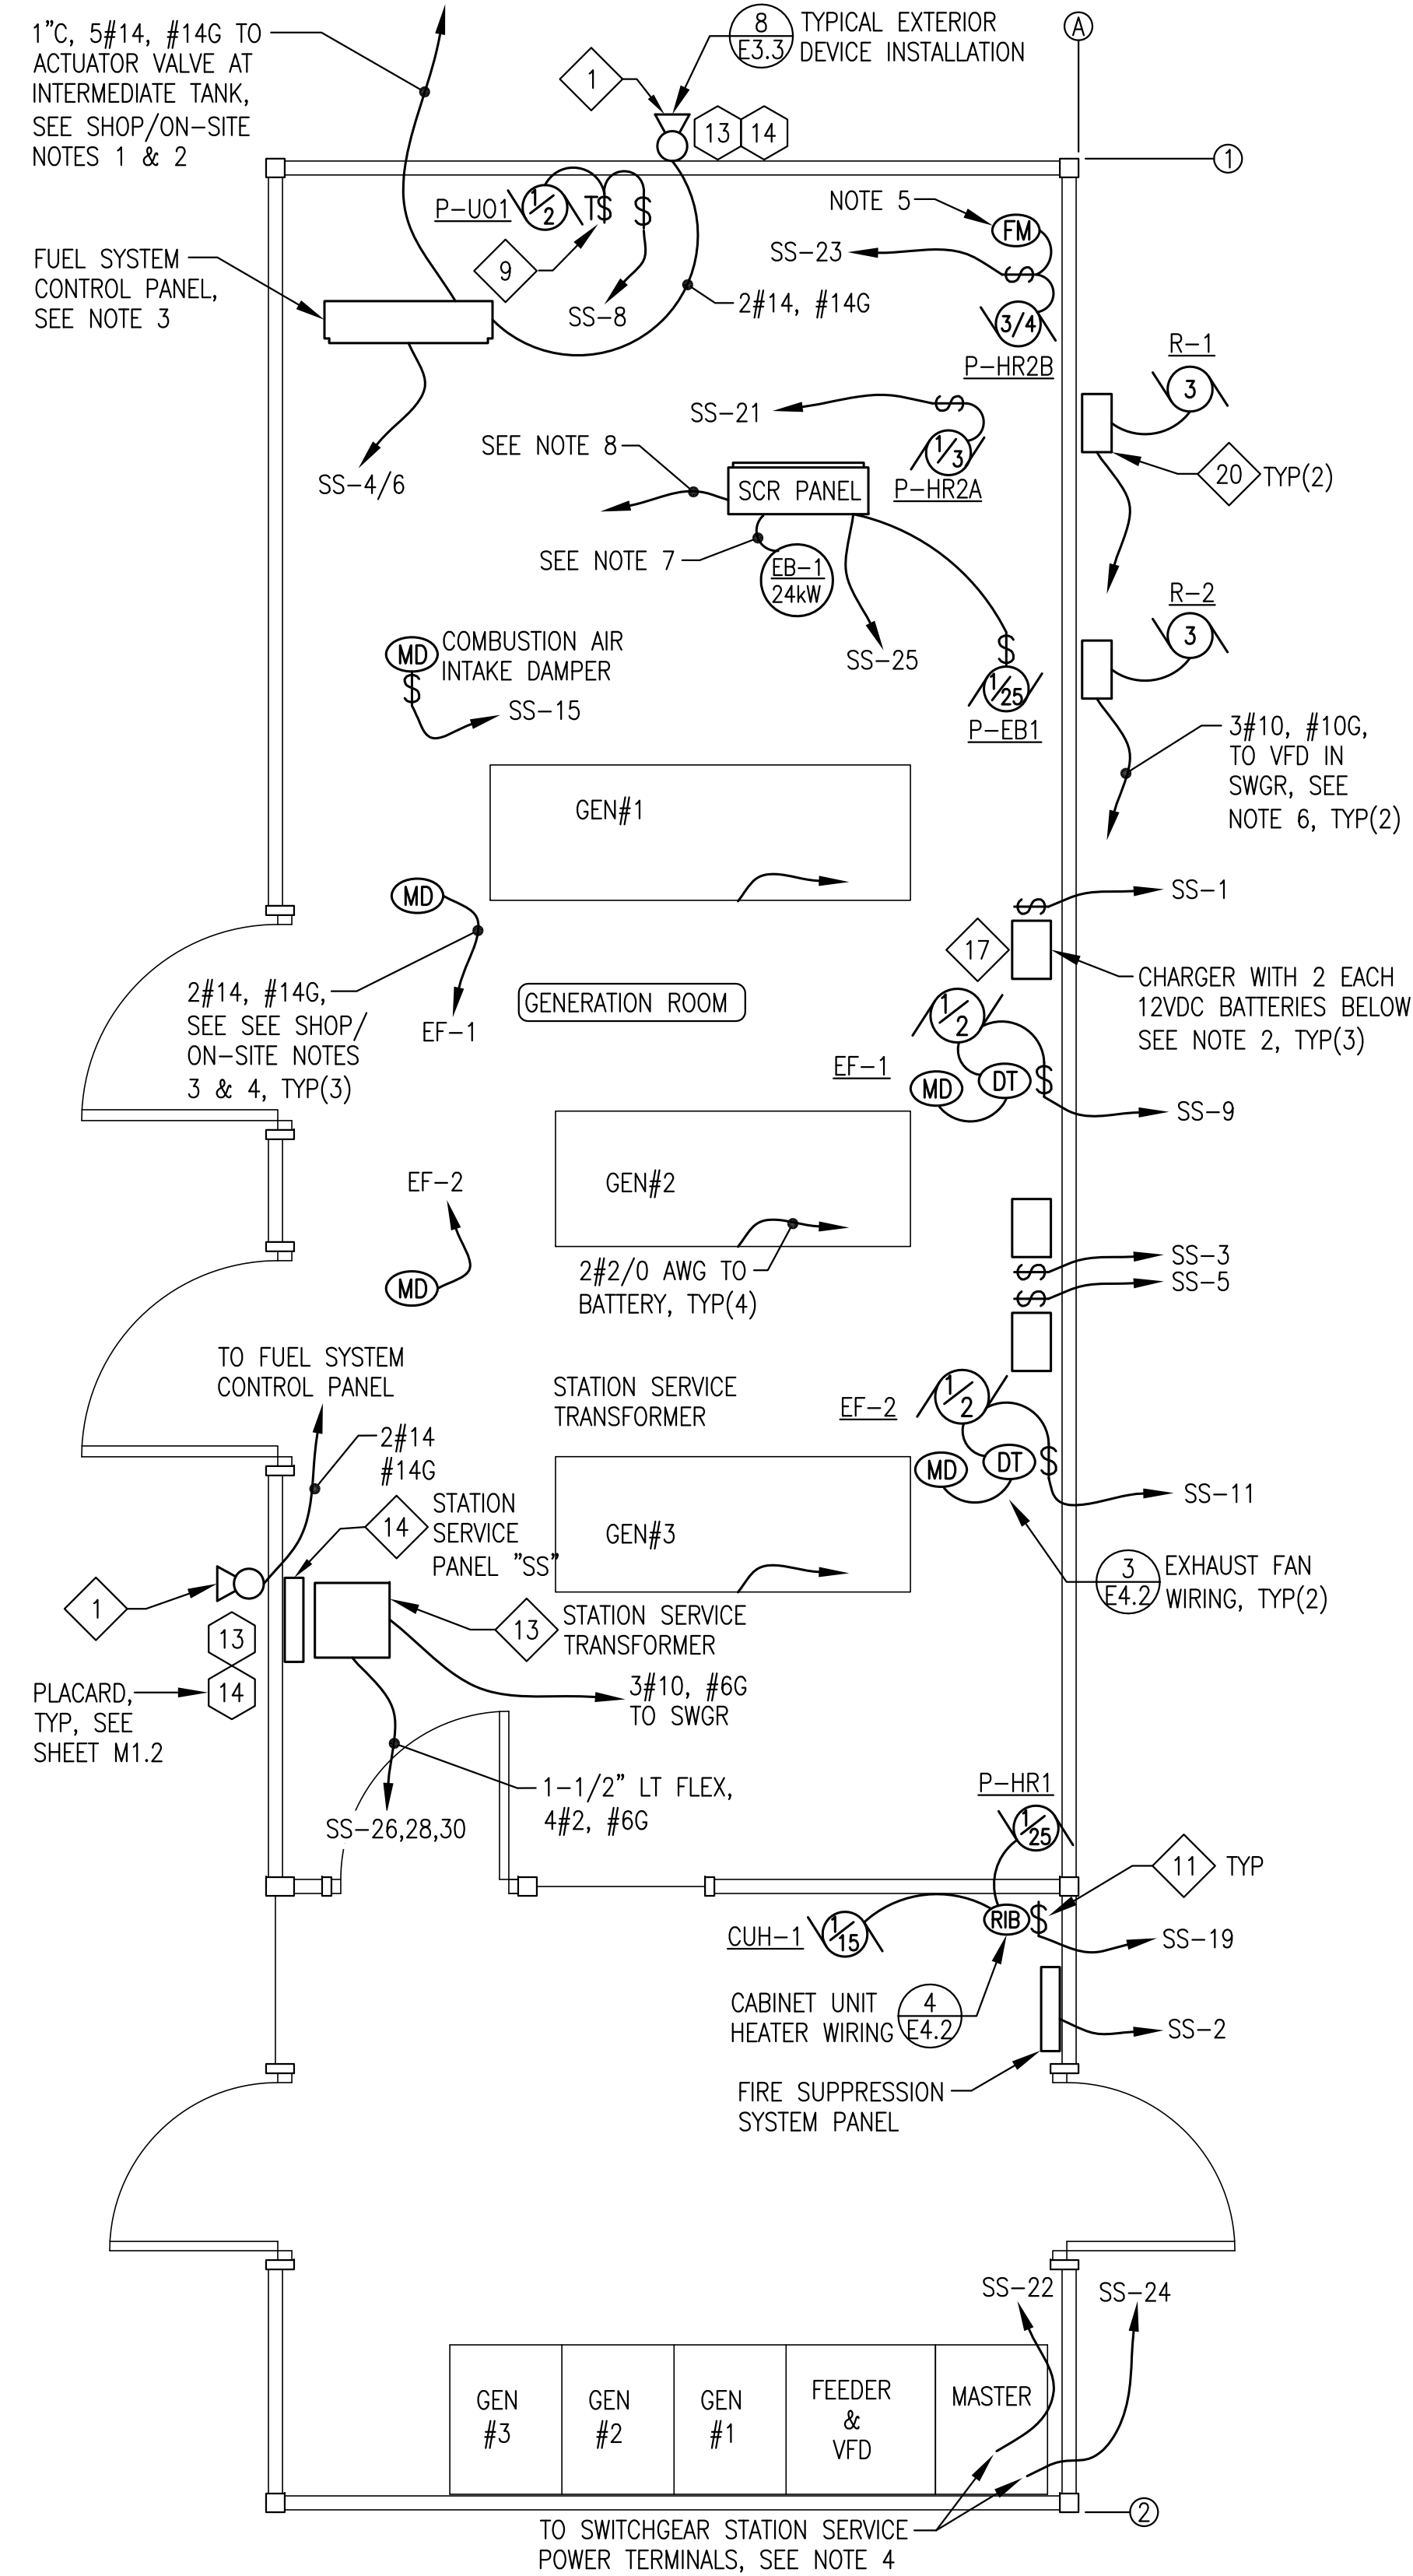


1 STATION SERVICE PLAN
E4.2 3/8"=1'-0"

STATION SERVICE GENERAL NOTES:


- 1) ALL WIRING RUNS 2#12, #12G UNLESS SPECIFICALLY NOTED OTHERWISE.
- 2) MOUNT BATTERY CHARGER TO WALL ON SHALLOW STRUT AND INSTALL BATTERIES ON FLOOR BELOW, SEE ELEVATION 1/E3.2.
- 3) SEE SHEETS E7.1-E7.3 FOR DAY TANK CONTROL PANEL DESIGN. ALL ACCESSORIES NOT SHOWN ON PLANS. SEE LOGIC DIAGRAMS FOR ADDITIONAL DETAIL.
- 4) SEE SWITCHGEAR SHOP DRAWINGS FOR TERMINATION OF ALL POWER AND CONTROL WIRING.
- 5) INSTALL FLOW METER FOR HEAT RECOVERY MONITORING WHERE SHOWN ON HEAT RECOVERY PIPING ISOMETRIC. PROVIDE POWER FROM P-HR2B DISCONNECT.
- 6) RADIATOR VFD POWER CONDUCTORS OVERSIZED FOR 80% DE-RATE. DO NOT ROUTE IN WIREWAY. ROUTE IN SEPARATE EXTERIOR CONDUIT, SEE ELEVATION 1/E3.3.
- 7) 1" WITH 6#10, #10G, HIGH TEMPERATURE CONDUCTORS FROM BOILER TO SCR PANEL. SEE SHEET E6.4. ROUTE IN SEPARATE CONDUIT, DO NOT ROUTE IN WIREWAY.
- 8) 3#8, #10G TO BREAKER IN SWITCHGEAR.

STATION SERVICE SHOP/ON-SITE NOTES:


- 1) DURING SHOP FABRICATION INSTALL WALL PENETRATION AND CONDUIT INTO DAY TANK PANEL. SEE ELEVATION 5/E3.2.
- 2) AS PART OF ON-SITE WORK INSTALL CONDUIT AND CONDUCTORS TO TANK FARM, SEE SHEET E2.
- 3) DURING SHOP FABRICATION INSTALL CEILING MOUNTED BOX ADJACENT TO DAMPER ACTUATOR AND TEMPORARILY CONNECT DAMPER TO VERIFY OPERATION.
- 4) AS PART OF ON-SITE WORK INSTALL CONDUIT AND CONDUCTORS TO DAMPER ACTUATOR. SEE SHEET M7.

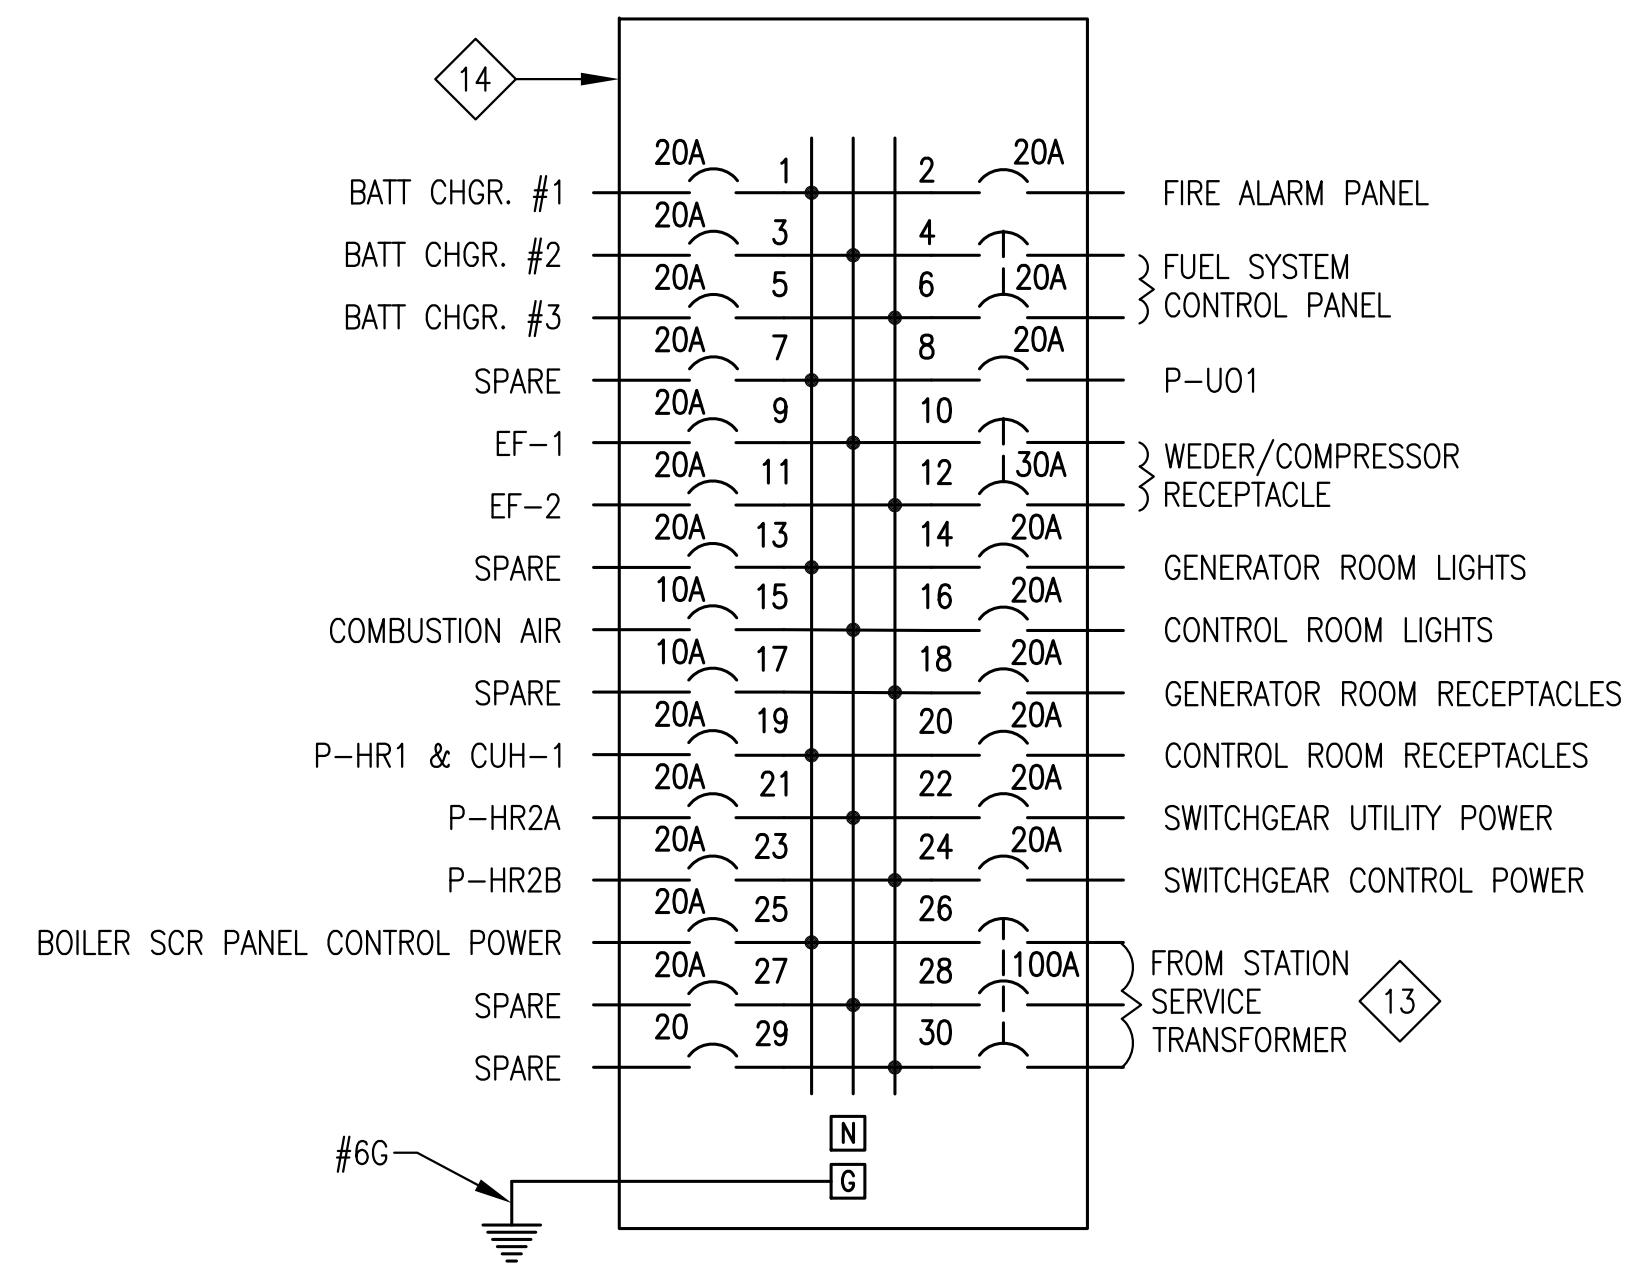

2 STATION SERVICE PANEL "SS"
E4.2 NO SCALE

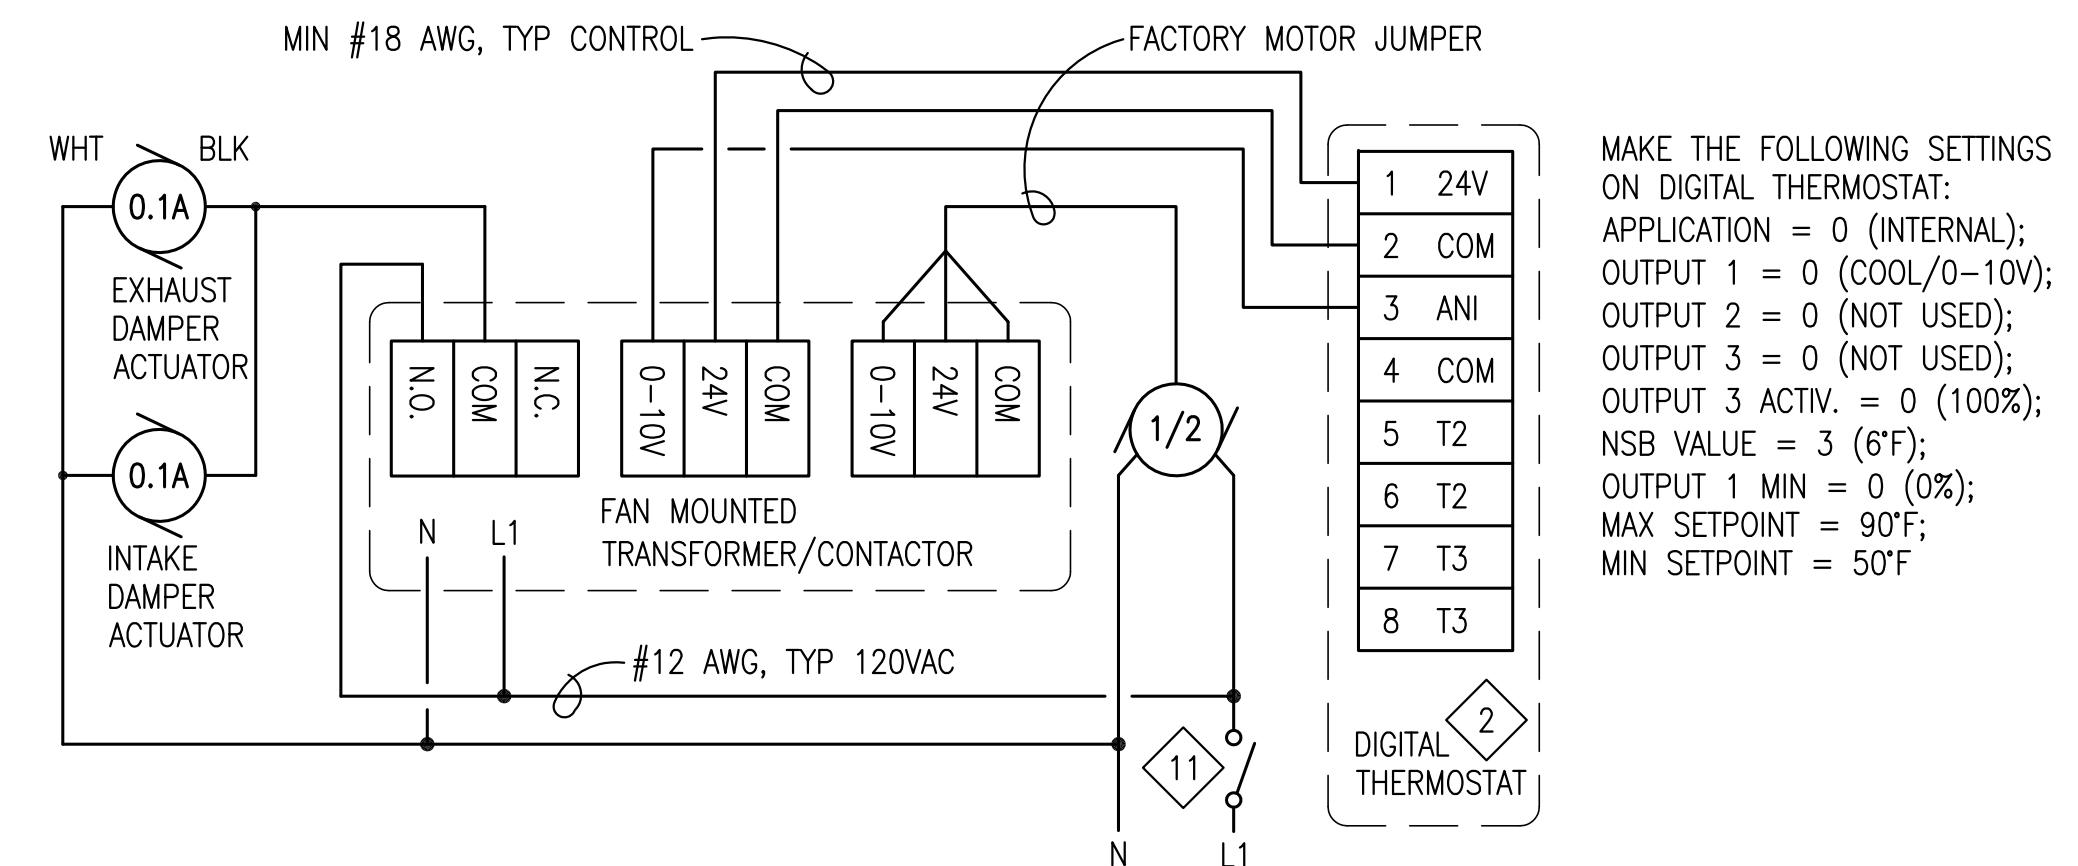

3 EXHAUST FAN WIRING DIAGRAM
E4.2 NO SCALE

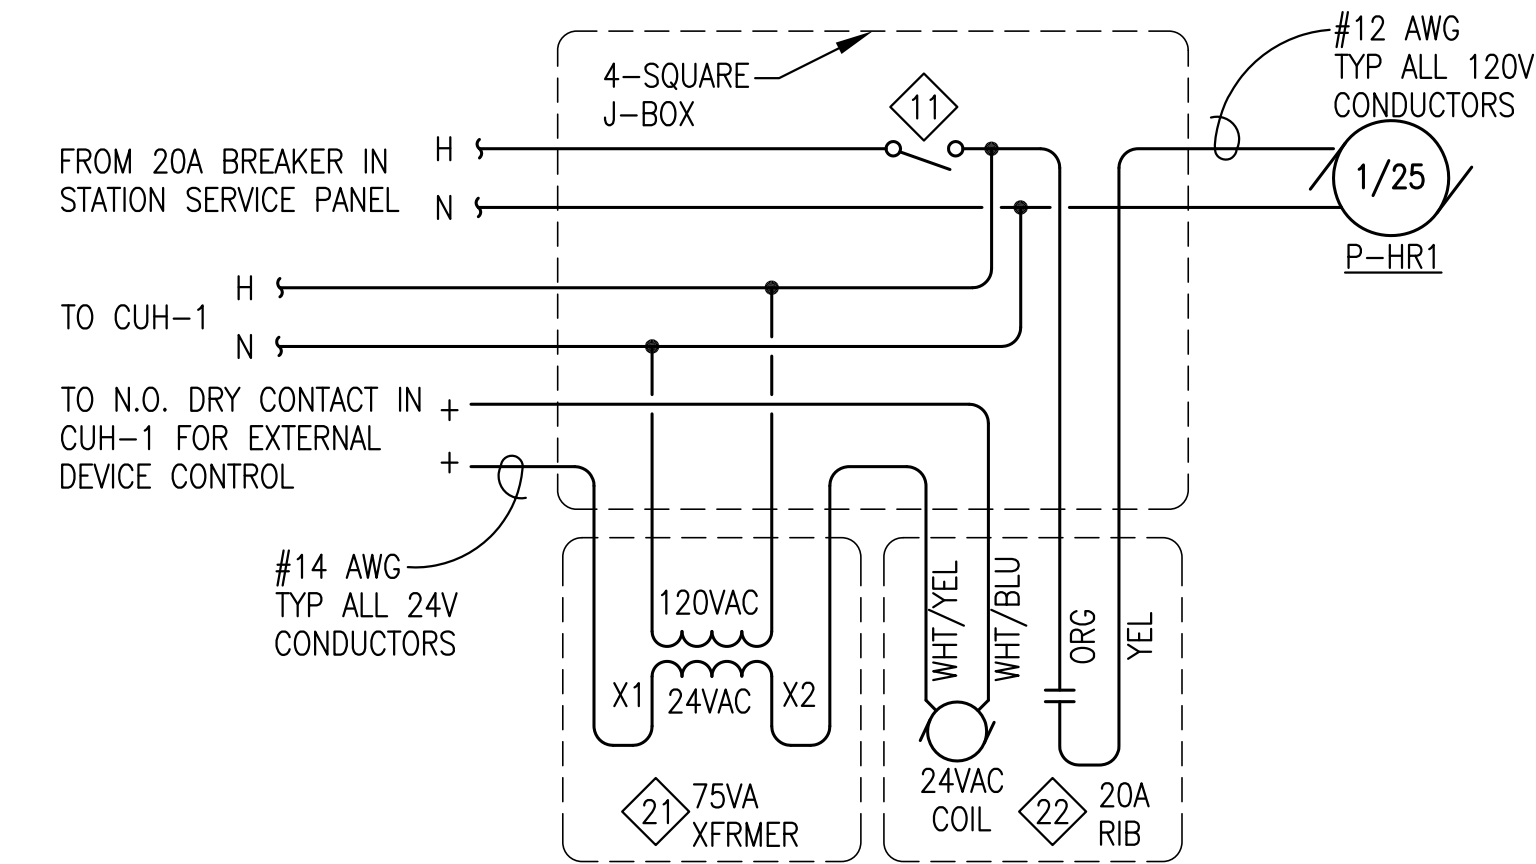


4 CUH-1 WIRING DIAGRAM
E4.2 NO SCALE



**STATE OF ALASKA, AIDEA/AEA
RURAL POWER SYSTEM UPGRADE**

CLARKS POINT POWER PLANT
CLARKS POINT, ALASKA


REVISIONS	DESCRIPTION
REV DATE	

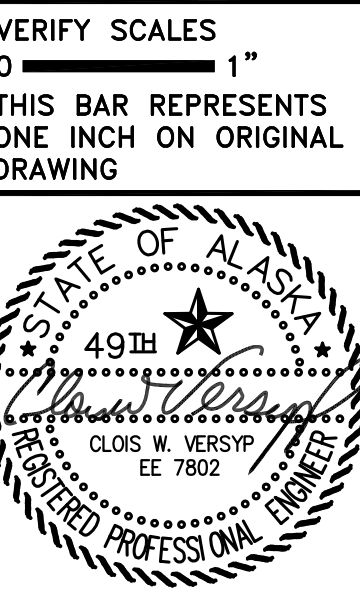

DATE: 1/14/19
DRAWN BY: JTD
CHECKED BY: CWV/BCG
JOB NUMBER:

DRAWING TITLE:
STATION SERVICE PLAN,
DETAILS, & PANEL

ISSUED FOR CONSTRUCTION JANUARY 2019

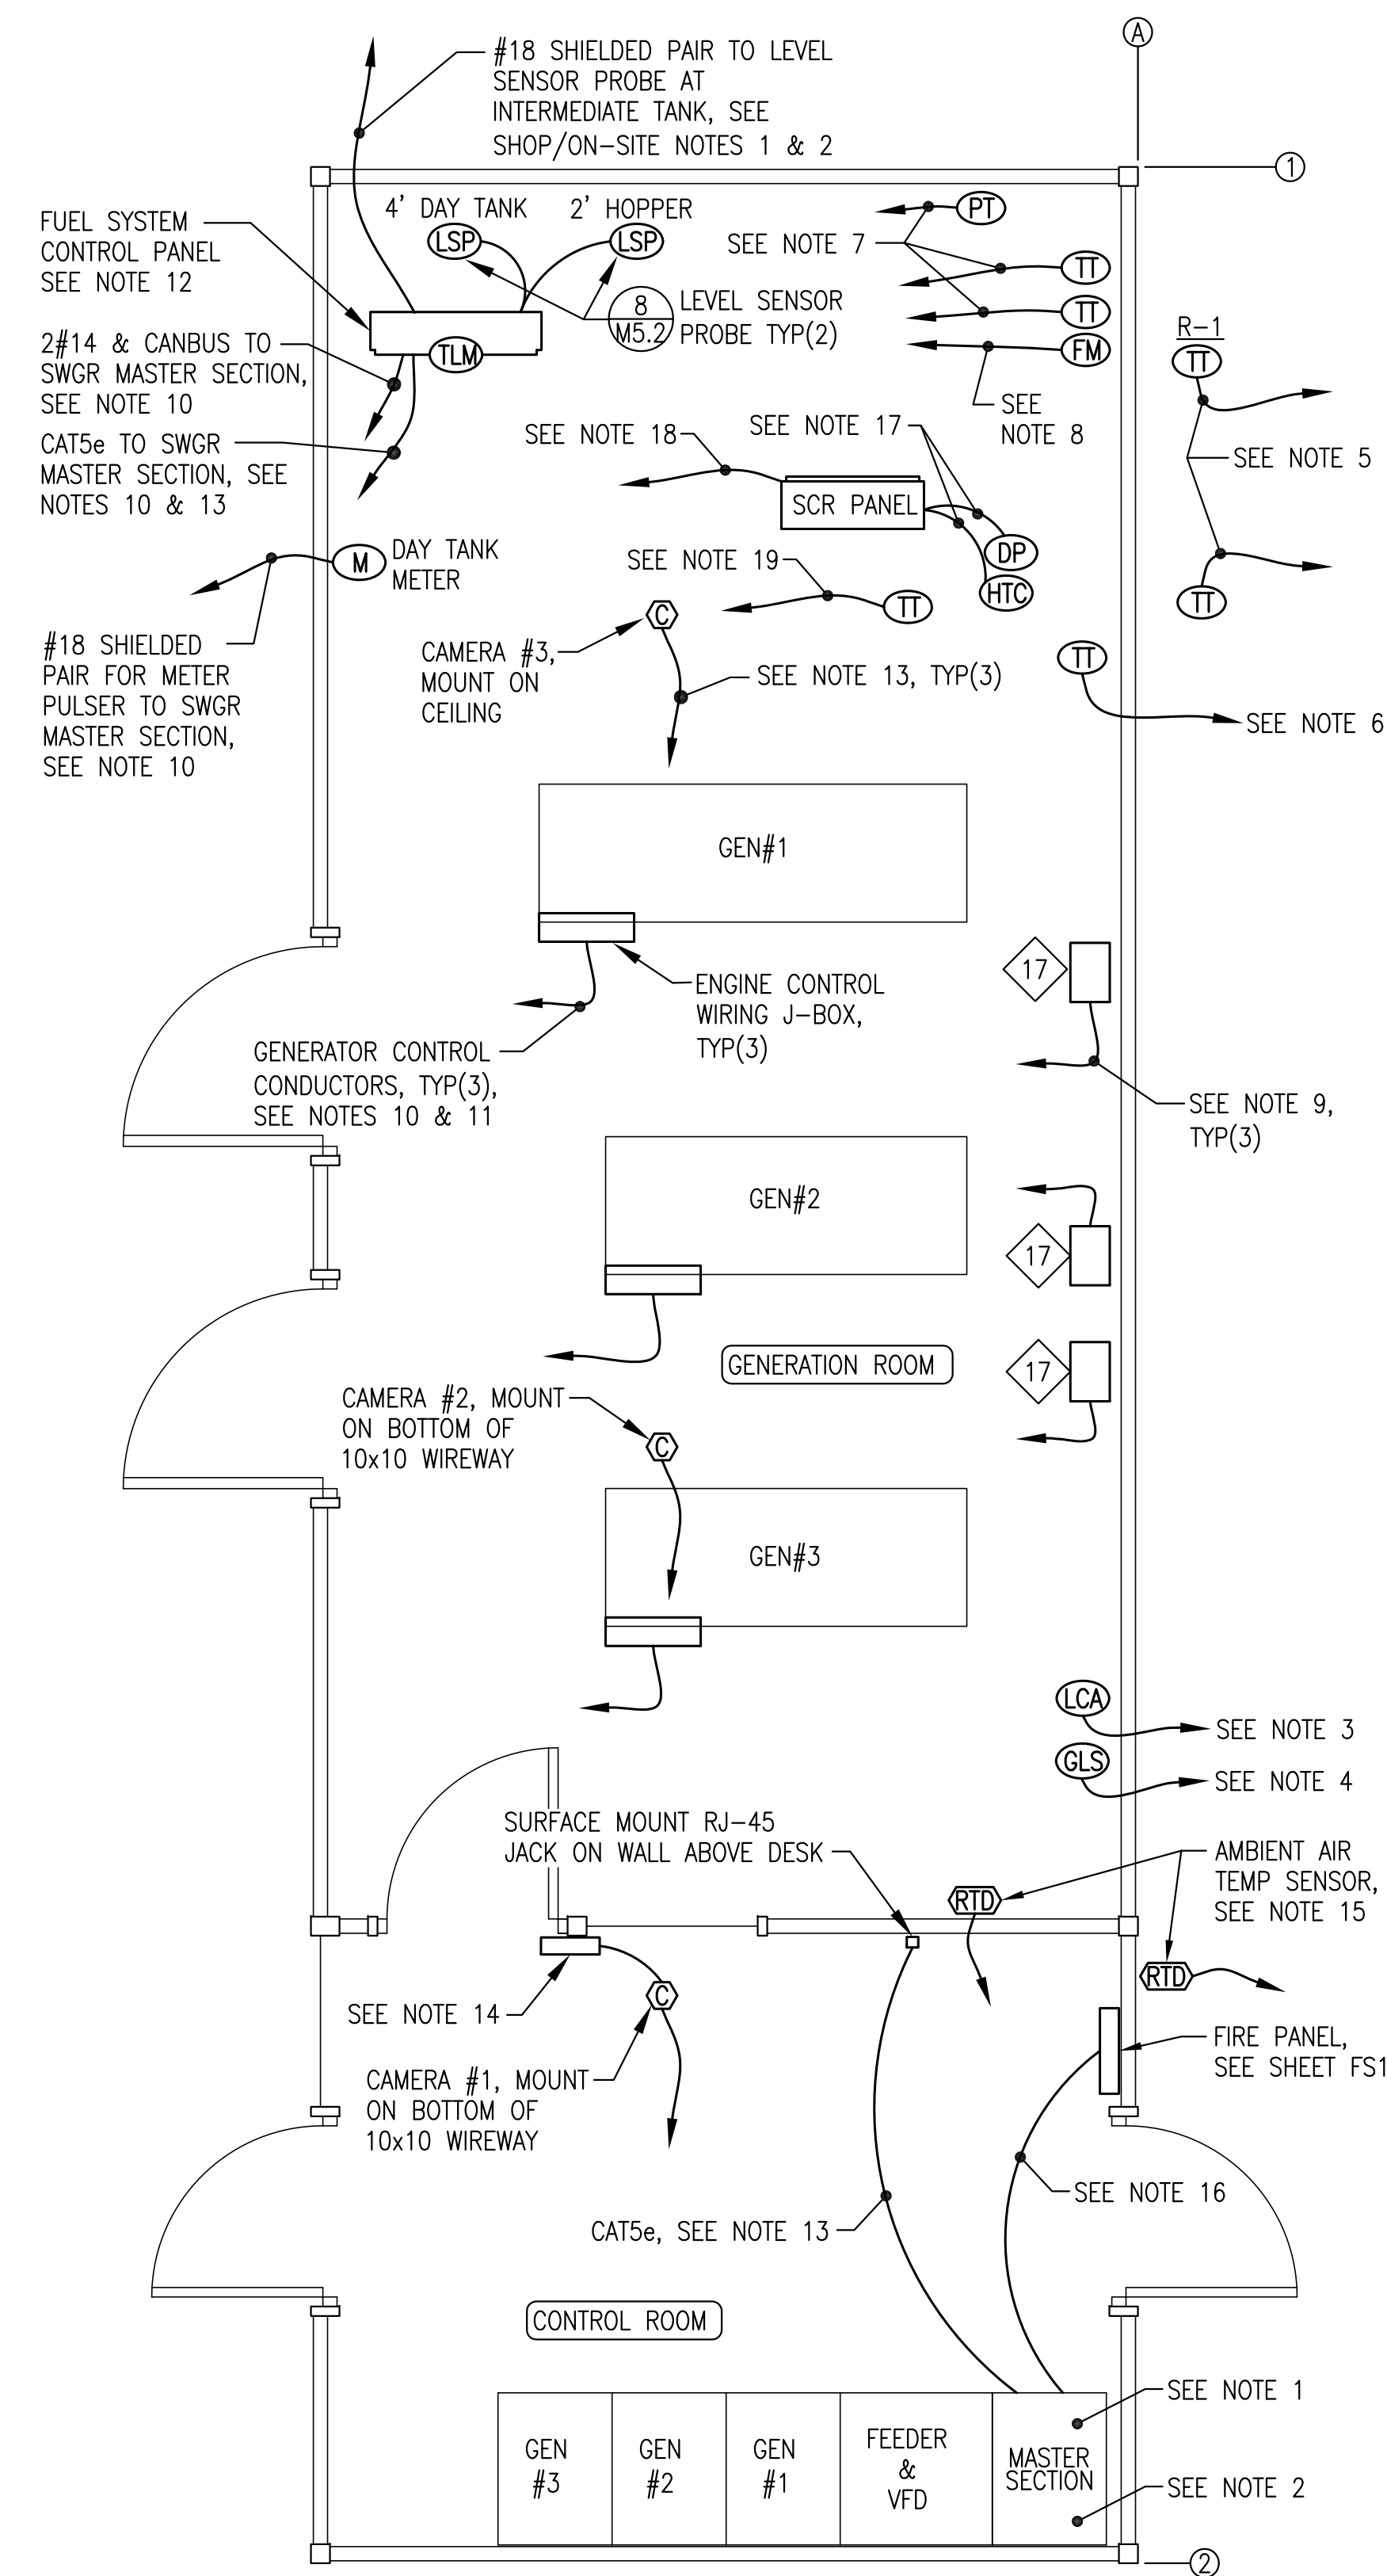

1
E5 INSTRUMENTATION & DATA PLAN
3/8"=1'-0"

INSTRUMENTATION & DATA PLAN NOTES:

1. INSTALL CAMERA POE+ SWITCH INSIDE MASTER SECTION. CONNECT TO 120VAC CONTROL POWER AND TO ETHERNET SWITCH, SEE NOTE 10.
2. INSTALL ROUTER ON TOP OF MASTER SECTION IN RACK OR CABINET. CONNECT TO 120VAC UPS AND TO ETHERNET SWITCH, SEE NOTE 10.
3. LOW COOLANT LEVEL ALARM SWITCH INSTALLED AT EXPANSION TANK, SEE MECHANICAL. CONNECT TO N.C. SWITCH (WHITE & RED) AND ROUTE 2#14 TO SWITCHGEAR MASTER SECTION. SEE NOTE 10.
4. GLYCOL LEVEL SENSOR PROBE INSTALLED IN EXPANSION TANK, SEE MECHANICAL. ROUTE #18 SHIELDED PAIR TO SWITCHGEAR. SEE NOTE 10.
5. INSTALL TEMP TRANSMITTER IN EACH RADIATOR, SEE DETAIL 3/E3.3. ROUTE #18 SHIELDED PAIR FROM EACH TO SWITCHGEAR VFD SECTION, SEE NOTE 10.
6. INSTALL COOLANT RETURN TEMP TRANSMITTER IN PIPING MAIN WHERE SHOWN ON COOLING PIPING ISOMETRIC. ROUTE #18 SHIELDED PAIR TO SWITCHGEAR MASTER SECTION, SEE NOTE 10.
7. INSTALL TWO TEMP TRANSMITTERS AND ONE PRESSURE TRANSMITTER FOR HEAT RECOVERY MONITORING WHERE SHOWN ON HEAT RECOVERY PIPING ISOMETRIC 2/M4.2. ROUTE #18 SHIELDED PAIR FROM EACH TO SWITCHGEAR MASTER SECTION. SEE NOTE 10.
8. INSTALL FLOW METER FOR HEAT RECOVERY MONITORING WHERE SHOWN ON HEAT RECOVERY PIPING ISOMETRIC. PROVIDE POWER FROM P-HR2B DISCONNECT. ROUTE #18 SHIELDED PAIR TO SWITCHGEAR MASTER SECTION. SEE NOTE 10.
9. ROUTE 2#14 FROM BATTERY CHARGER ALARM CONTACTS TO ASSOCIATED SWITCHGEAR GENERATOR SECTION, SEE NOTE 10 AND WIRING DIAGRAM 2/E5.
10. SEE SWITCHGEAR SHOP DRAWINGS FOR TERMINATION OF ALL INSTRUMENTATION AND DATA WIRING INCLUDING CONTROL POWER.
11. ROUTE GENERATOR CONTROL CONDUCTORS TO SWITCHGEAR IN 10x10 WIREWAY WITH POWER CONDUCTORS. SEE SHEETS E3.1, E6.3, AND NOTE 10.
12. SEE SHEETS E7.1-E7.3 FOR FUEL SYSTEM CONTROL PANEL DESIGN. ALL ACCESSORIES NOT SHOWN ON PLANS. SEE LOGIC DIAGRAMS FOR ADDITIONAL DETAIL.
13. ROUTE CAT5e CONDUCTORS FROM EACH CAMERA TO POE+ SWITCH IN MASTER SECTION. ROUTE CAT5e CONDUCTORS FROM FUEL SYSTEM PANEL, FIRE SUPPRESSION PANEL, AND RJ-45 JACK TO ETHERNET SWITCH IN SWITCHGEAR MASTER SECTION. SEE NOTE 10. INSTALL ALL CAT5e CONDUCTORS IN SEPARATE DEDICATED RACEWAYS - DO NOT ROUTE WITH STATION SERVICE OR POWER CONDUCTORS.
14. INSTALL CONTACTOR WITH TIMER RELAY FOR REMOTE LIGHTING CONTROL. OPERATE FROM DRY CONTACT ON CAMERA #1. TIMER TO TURN LIGHTS ON FOR 5 MINUTES EACH TIME CAMERA IS OPERATED. SEE SCHEMATIC 4/E4.1.
15. RTD TEMPERATURE SENSOR PROVIDED WITH SWITCHGEAR. ROUTE #18 SHIELDED PAIR TO SWITCHGEAR MASTER SECTION. SEE NOTE 10.
16. ROUTE CAT5e FOR DATA AND 2#14 FOR GENERATOR SHUT DOWN FROM FIRE PANEL TO SWITCHGEAR MASTER SECTION, SEE NOTES 10 AND 13.
17. #18 SHIELDED PAIR FROM DIFFERENTIAL PRESSURE SWITCH & HIGH TEMP CUTOUT TO BOILER SCR PANEL. SEE SHEET E6.4.
18. 4 EACH #18 SHIELDED PAIR TO SWITCHGEAR MASTER SECTION, 3 FOR SWITCH/ALARM INDICATION AND 1 FOR ANALOG SIGNAL. SEE SHEET E6.4.
19. INSTALL BOILER OUTLET TEMP TRANSMITTER IN PIPING WHERE SHOWN ON BOILER PIPING ISOMETRIC 4/M4.2. ROUTE #18 SHIELDED PAIR TO SWITCHGEAR MASTER SECTION, SEE NOTE 10.


INSTRUMENTATION SHOP/ON-SITE NOTES:

1. DURING SHOP FABRICATION INSTALL WALL PENETRATION AND CONDUIT INTO DAY TANK PANEL. SEE ELEVATION 5/E3.2.
2. AS PART OF ON-SITE WORK INSTALL CONDUIT AND CONDUCTORS TO TANK FARM, SEE SHEET E2.

DATA DEVICE SCHEDULE

DEVICE/FUNCTION	DESCRIPTION	MANUFACTURER/MODEL
ROUTER - HIGH SPEED INTERNET	4-PORT GIGABIT ROUTER, DUAL 2.4 AND 5 GHz WIFI WITH ADJUSTABLE ANTENNAS, 4 GIGABIT LAN, 1 GIGABIT WAN, MINIMUM 256 MB RAM	ASUS RT-N66U OR APPROVED EQUAL
POE+ - POWER OVER ETHERNET CAMERA SWITCH	MINIMUM 4 PORT MANAGED GIGABIT SWITCH, MINIMUM 14 GBPS THROUGHPUT, MINIMUM 30W POWER OVER ETHERNET PER PORT, MINIMUM 130W TOTAL, 120VAC POWER	AXIS T8508 POE+ OR APPROVED EQUAL
CAMERAS	NETWORK CAMERA, HDTV 1080P RESOLUTION, 360 DEGREE PAN, MINIMUM 90 DEGREE TILT, 10X ZOOM, AUTO FOCUS, POWER OVER ETHERNET, WITH PROGRAMMABLE OUTPUT CONNECTIONS FOR EXTERNAL CONTROL OF LIGHTING	AXIS M5525-E PTZ OR APPROVED EQUAL



NOTE: SPECIFIC PARTS MANUFACTURER AND MODEL SELECTED NOT ONLY TO MEET PERFORMANCE FUNCTION BUT ALSO TO COORDINATE AND INTERFACE WITH OTHER DEVICES AND SYSTEMS. APPROVED EQUAL SUBSTITUTIONS WILL BE ALLOWED ONLY BY ENGINEER'S APPROVAL. TO OBTAIN APPROVAL, SUBMITTALS MUST CLEARLY DEMONSTRATE HOW SUBSTITUTE ITEM MEETS OR EXCEEDS SPECIFIED ITEM QUALITY AND PERFORMANCE CHARACTERISTICS AND ALSO COMPLIES WITH MECHANICAL AND/OR ELECTRICAL CONNECTIONS AND PHYSICAL LAYOUT REQUIREMENTS.

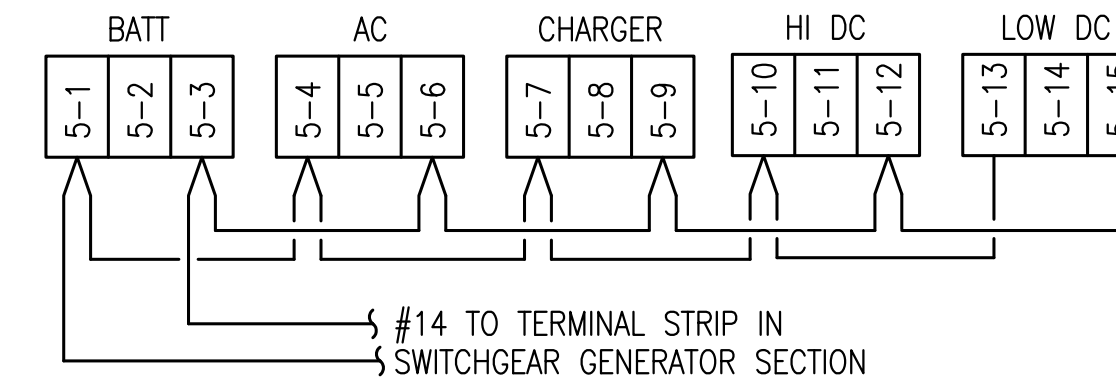

NOTE: PRIOR TO ENERGIZING MAKE THE FOLLOWING SETTINGS ON CHARGER:

- 1) AC LINE VOLTAGE SWITCH TO "115V".
- 2) AUTO BOOST JUMPER TO "NORM".
- 3) FLOAT VOLTAGE JUMPER TO "13.50/27.00" (FOR GEL CELL).
- 4) BATTERY RANGE JUMPER TO "24V".

2
E5 BATTERY CHARGER ALARM WIRING DIAGRAM
NO SCALE

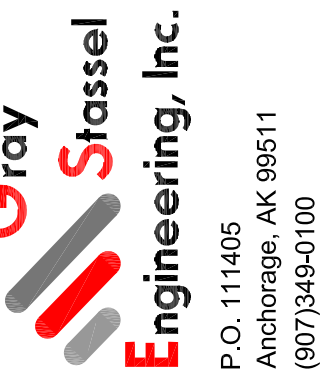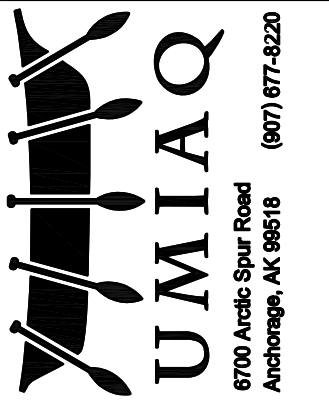


**STATE OF ALASKA, AIDEA/AEA
RURAL POWER SYSTEM UPGRADE**

CLARKS POINT POWER PLANT
CLARKS POINT, ALASKA

CONSTRUCTION DOCUMENTS	REVISIONS	DESCRIPTION
	REV DATE	

VERIFY SCALES
0 1"
THIS BAR REPRESENTS ONE INCH ON ORIGINAL DRAWING

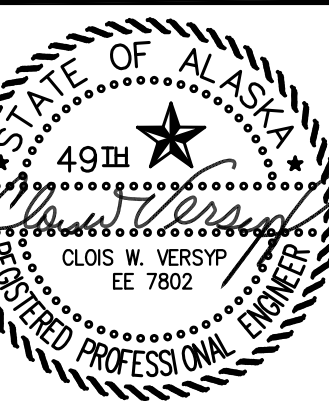


DATE: 1/14/19
DRAWN BY: JTD
CHECKED BY: CWV/BCG
JOB NUMBER:


DRAWING TITLE:
INSTRUMENTATION &
DATA PLAN & DETAILS

E5
SHEET OF 7

ISSUED FOR CONSTRUCTION JANUARY 2019

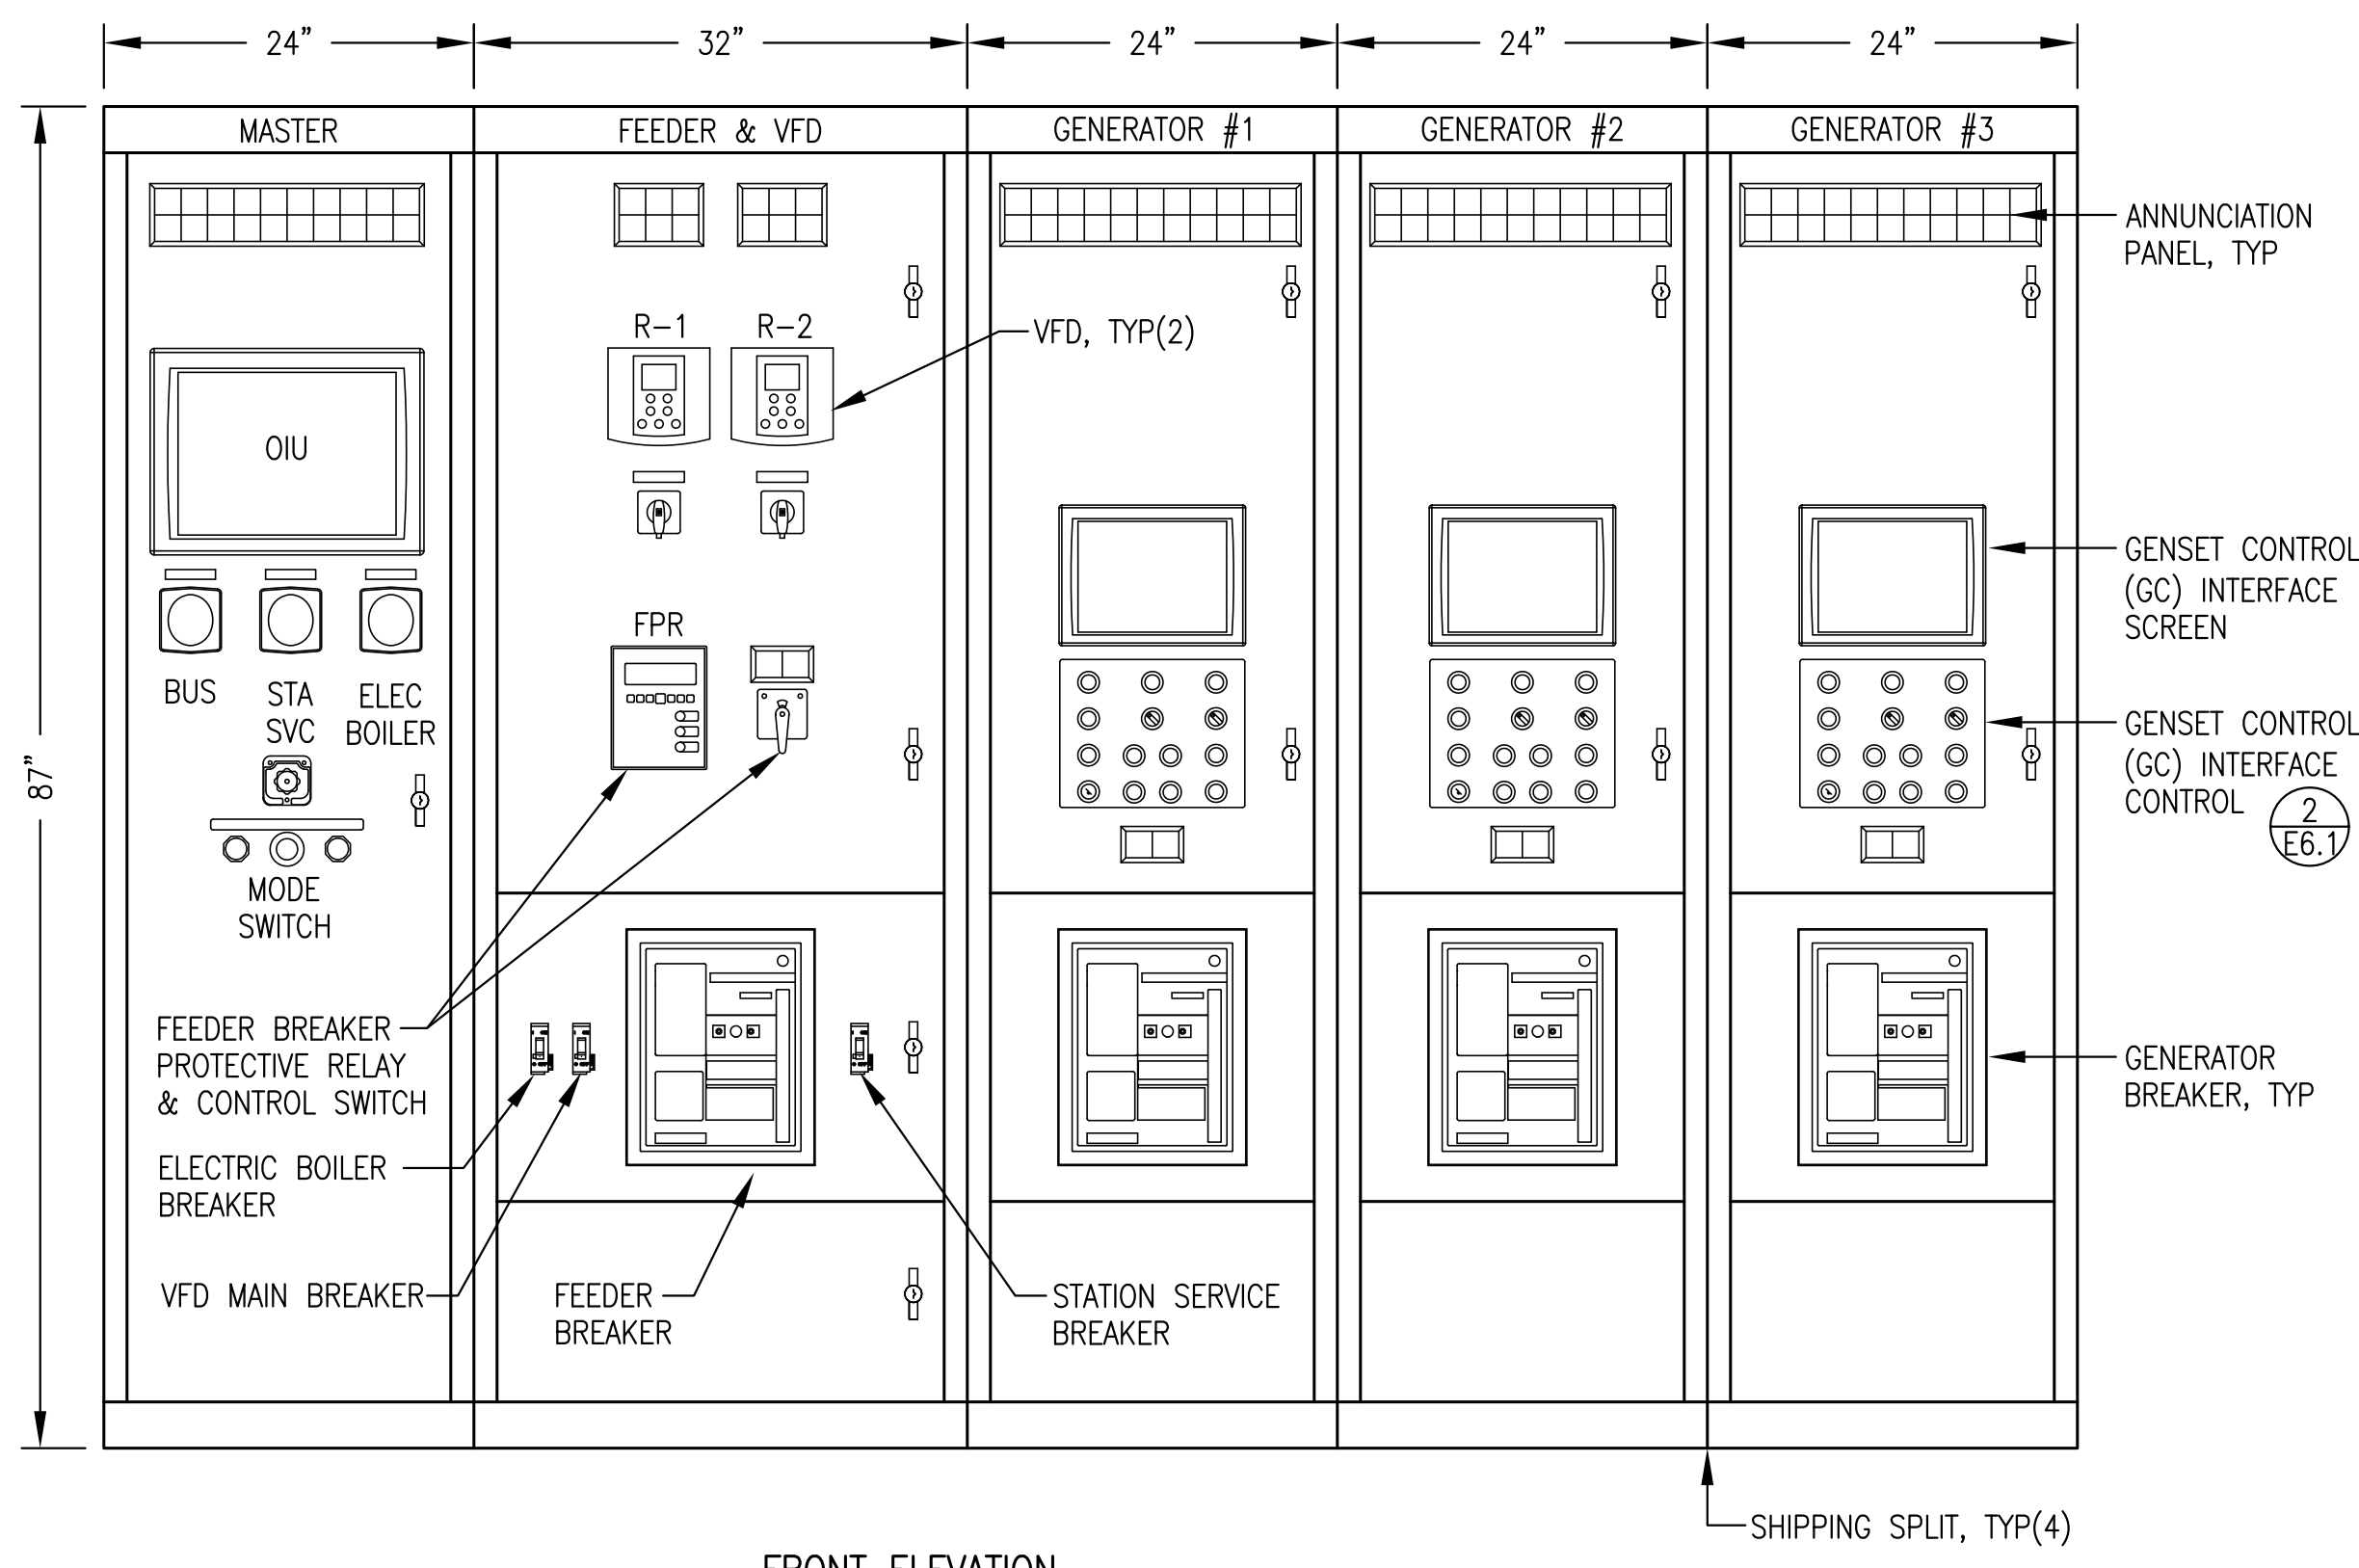


FRONT ELEVATION

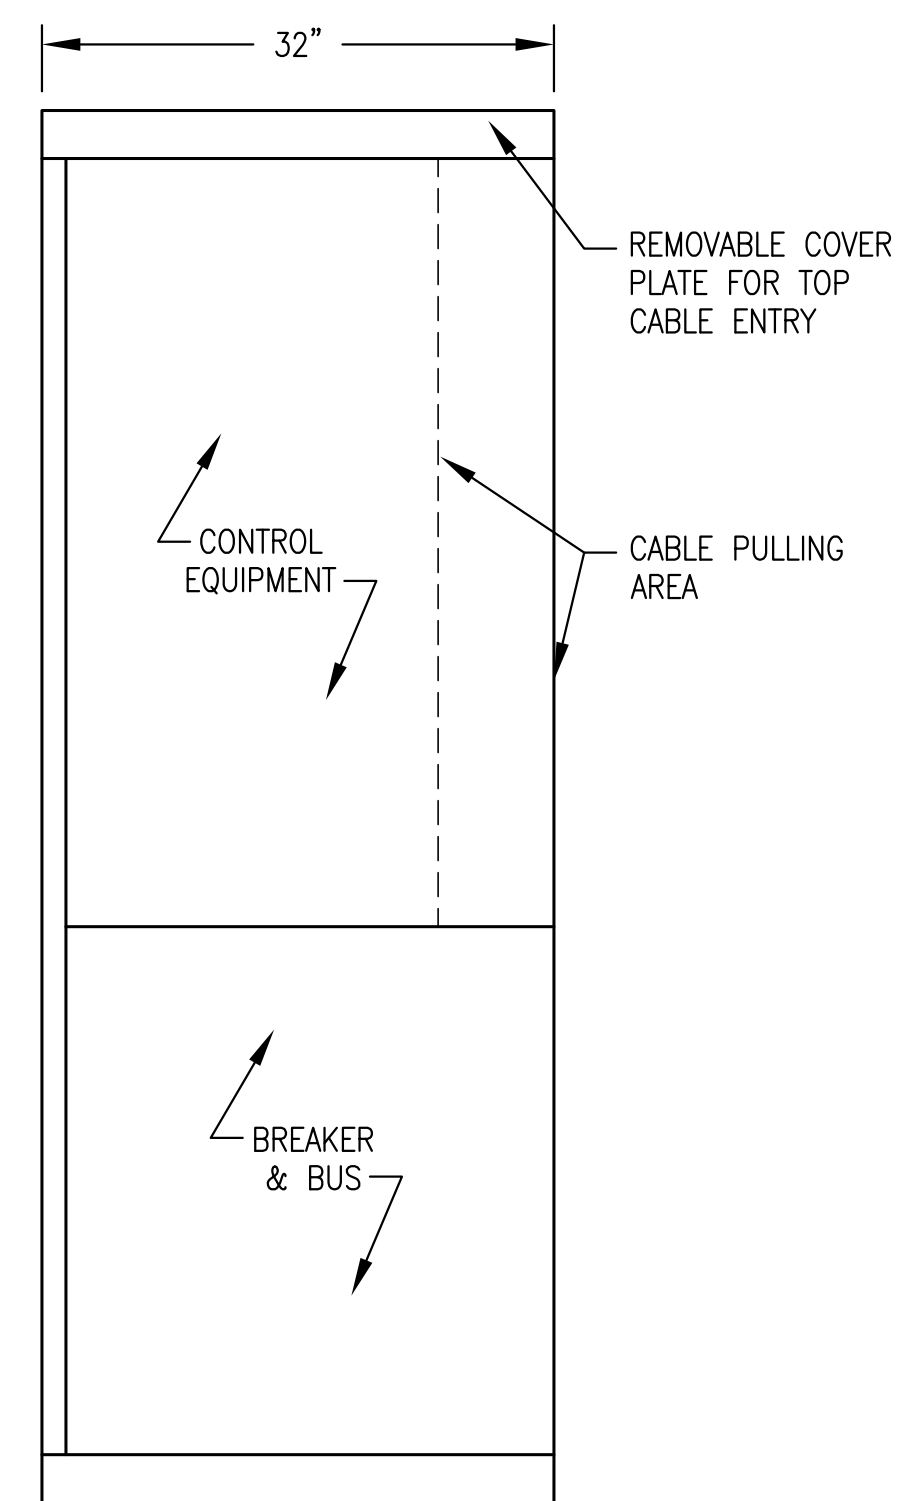

TYPICAL CROSS SECTION

1 SWITCHGEAR ENCLOSURE LAYOUT
E6.1 NO SCALE

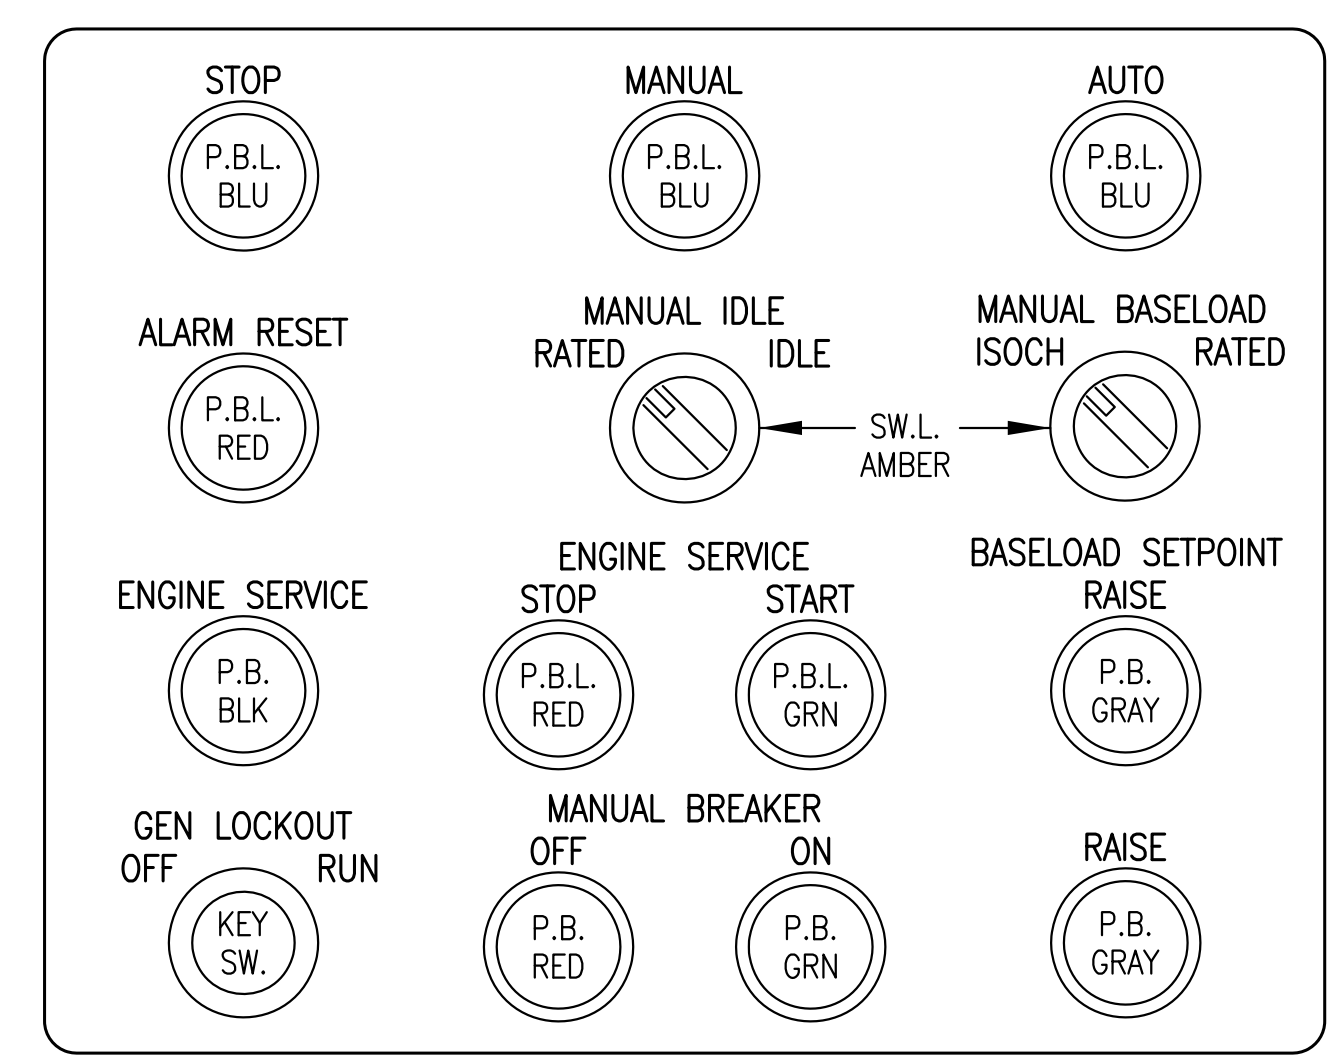

INTERFACE CONTROLS LEGEND:
P.B. PUSH BUTTON
P.B.L. PUSH BUTTON WITH LIGHT
SW.L. KNOB OPERATED SWITCH WITH LIGHT
KEY SW. KEY OPERATED LOCKABLE SWITCH


2 GENSET CONTROL (GC) INTERFACE CONTROLS
E6.1 NO SCALE



**STATE OF ALASKA, AIDEA/AEA
RURAL POWER SYSTEM UPGRADE**
CLARKS POINT POWER PLANT
CLARKS POINT, ALASKA

CONSTRUCTION DOCUMENTS	
REVISIONS	DESCRIPTION
REV/DATE	

VERIFY SCALES
0 1"
THIS BAR REPRESENTS ONE INCH ON ORIGINAL DRAWING

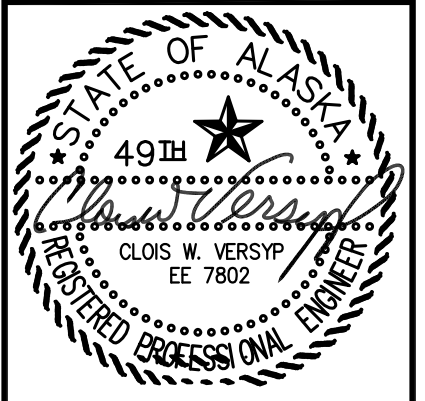

DATE: 1/14/19
DRAWN BY: JTD
CHECKED BY: CWV/BCG
JOB NUMBER:


DRAWING TITLE:
SWITCHGEAR ENCLOSURE LAYOUT

E6.1
SHEET OF 7

ISSUED FOR CONSTRUCTION JANUARY 2019

REVISIONS	DESCRIPTION


VERIFY SCALES
0 1" THIS BAR REPRESENTS ONE INCH ON ORIGINAL DRAWING

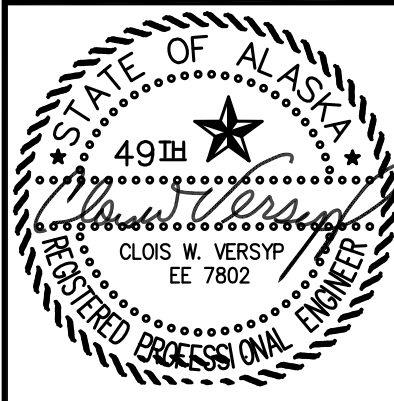

DATE: 1/14/19
DRAWN BY: JTD
CHECKED BY: CWV/BCG
JOB NUMBER:

DRAWING TITLE:
SWITCHGEAR
ONE-LINE & SCHEMATICS

3 MR CT's 600:5 MAX CONNECT FOR 300:5
1000A BUS, 277/480V, 3Ø, 4W

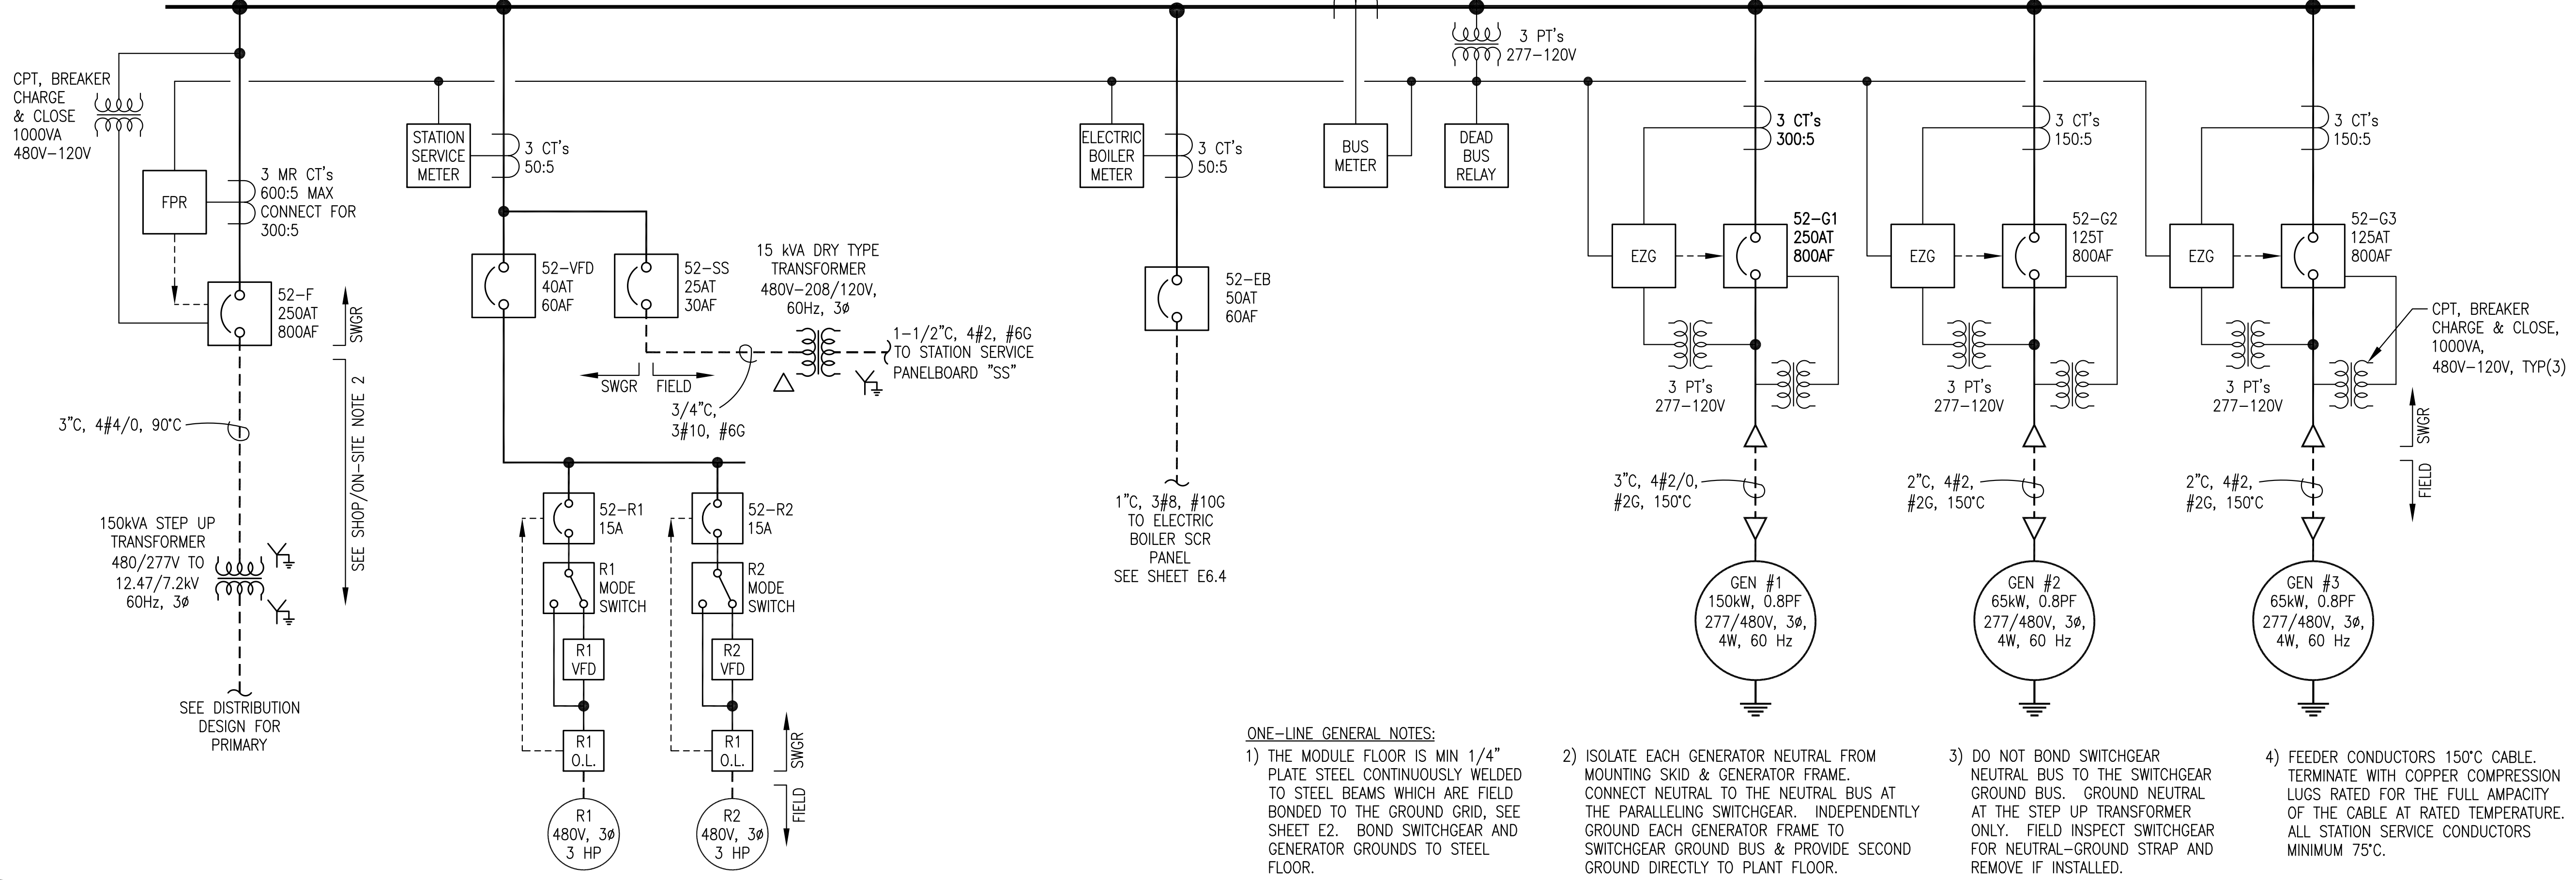


ONE-LINE GENERAL NOTES:


- 1) THE MODULE FLOOR IS MIN 1/4" PLATE STEEL CONTINUOUSLY WELDED TO STEEL BEAMS WHICH ARE FIELD BONDED TO THE GROUND GRID, SEE SHEET E2. BOND SWITCHGEAR AND GENERATOR GROUNDS TO STEEL FLOOR.
- 2) ISOLATE EACH GENERATOR NEUTRAL FROM MOUNTING SKID & GENERATOR FRAME. CONNECT NEUTRAL TO THE NEUTRAL BUS AT THE PARALLELING SWITCHGEAR. INDEPENDENTLY GROUND EACH GENERATOR FRAME TO SWITCHGEAR GROUND BUS & PROVIDE SECOND GROUND DIRECTLY TO PLANT FLOOR.
- 3) DO NOT BOND SWITCHGEAR NEUTRAL BUS TO THE SWITCHGEAR GROUND BUS. GROUND NEUTRAL AT THE STEP UP TRANSFORMER ONLY. FIELD INSPECT SWITCHGEAR FOR NEUTRAL-GROUND STRAP AND REMOVE IF INSTALLED.
- 4) FEEDER CONDUCTORS 150°C CABLE. TERMINATE WITH COPPER COMPRESSION LUGS RATED FOR THE FULL AMPACITY OF THE CABLE AT RATED TEMPERATURE. ALL STATION SERVICE CONDUCTORS MINIMUM 75°C.

1 SWITCHGEAR ONE-LINE DIAGRAM
E6.2 NO SCALE

NOTE: PROVIDE 120VAC POWER FOR SERVER FROM UPS. ALL OTHER DEVICES 24VDC.

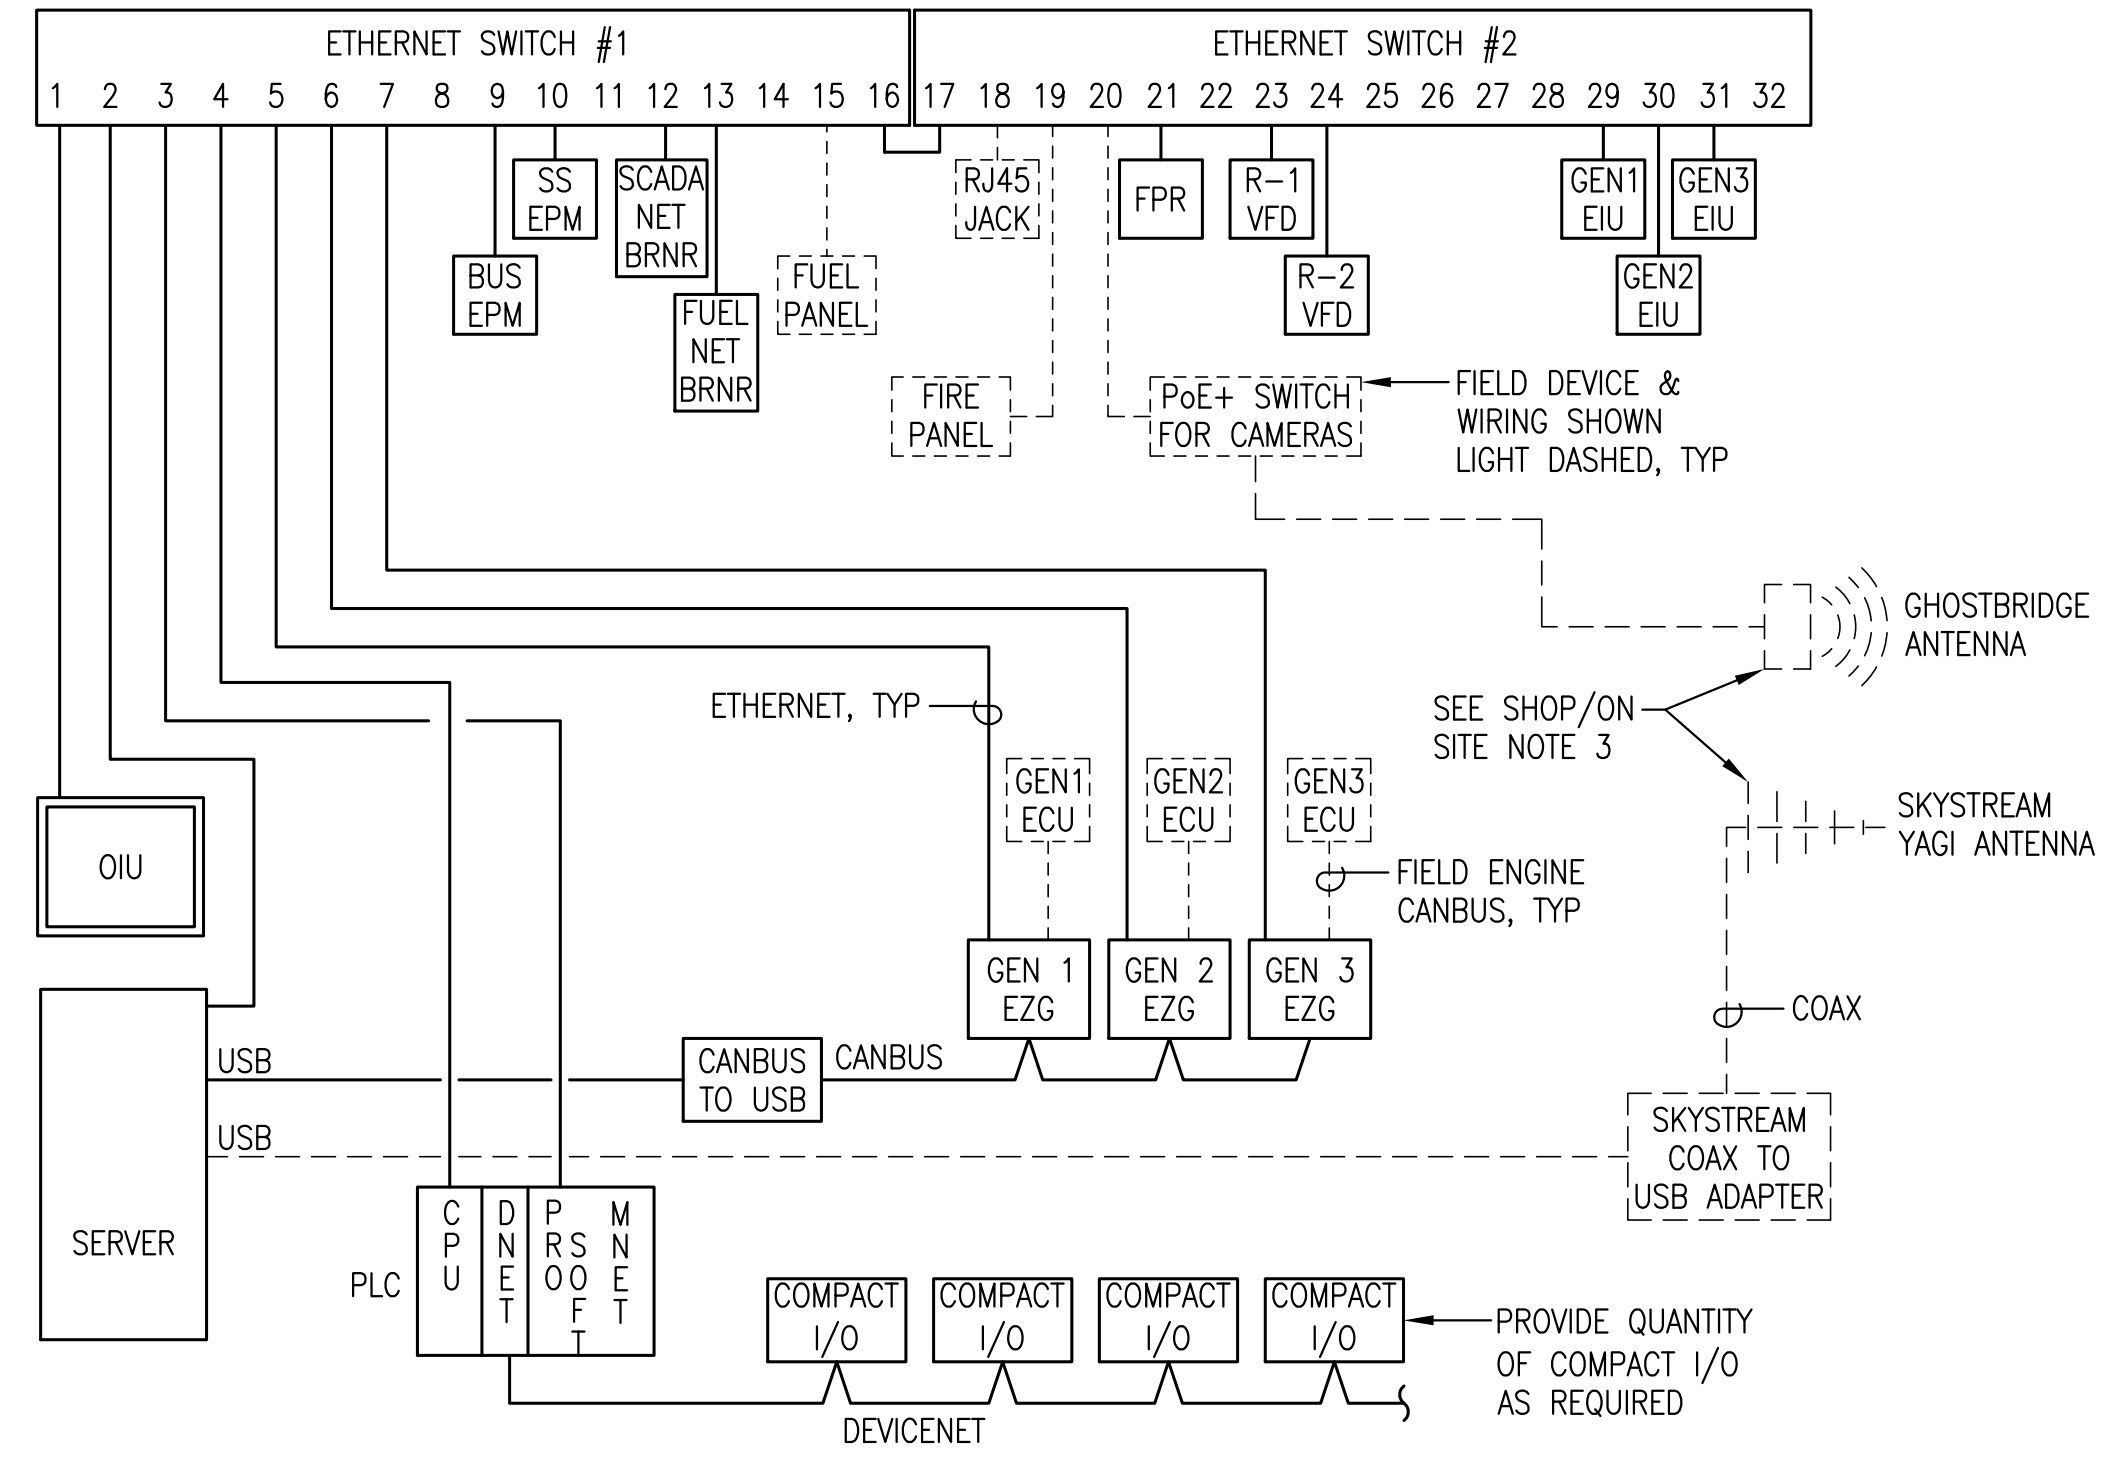

2 COMMUNICATION SCHEMATIC
E6.2 NO SCALE

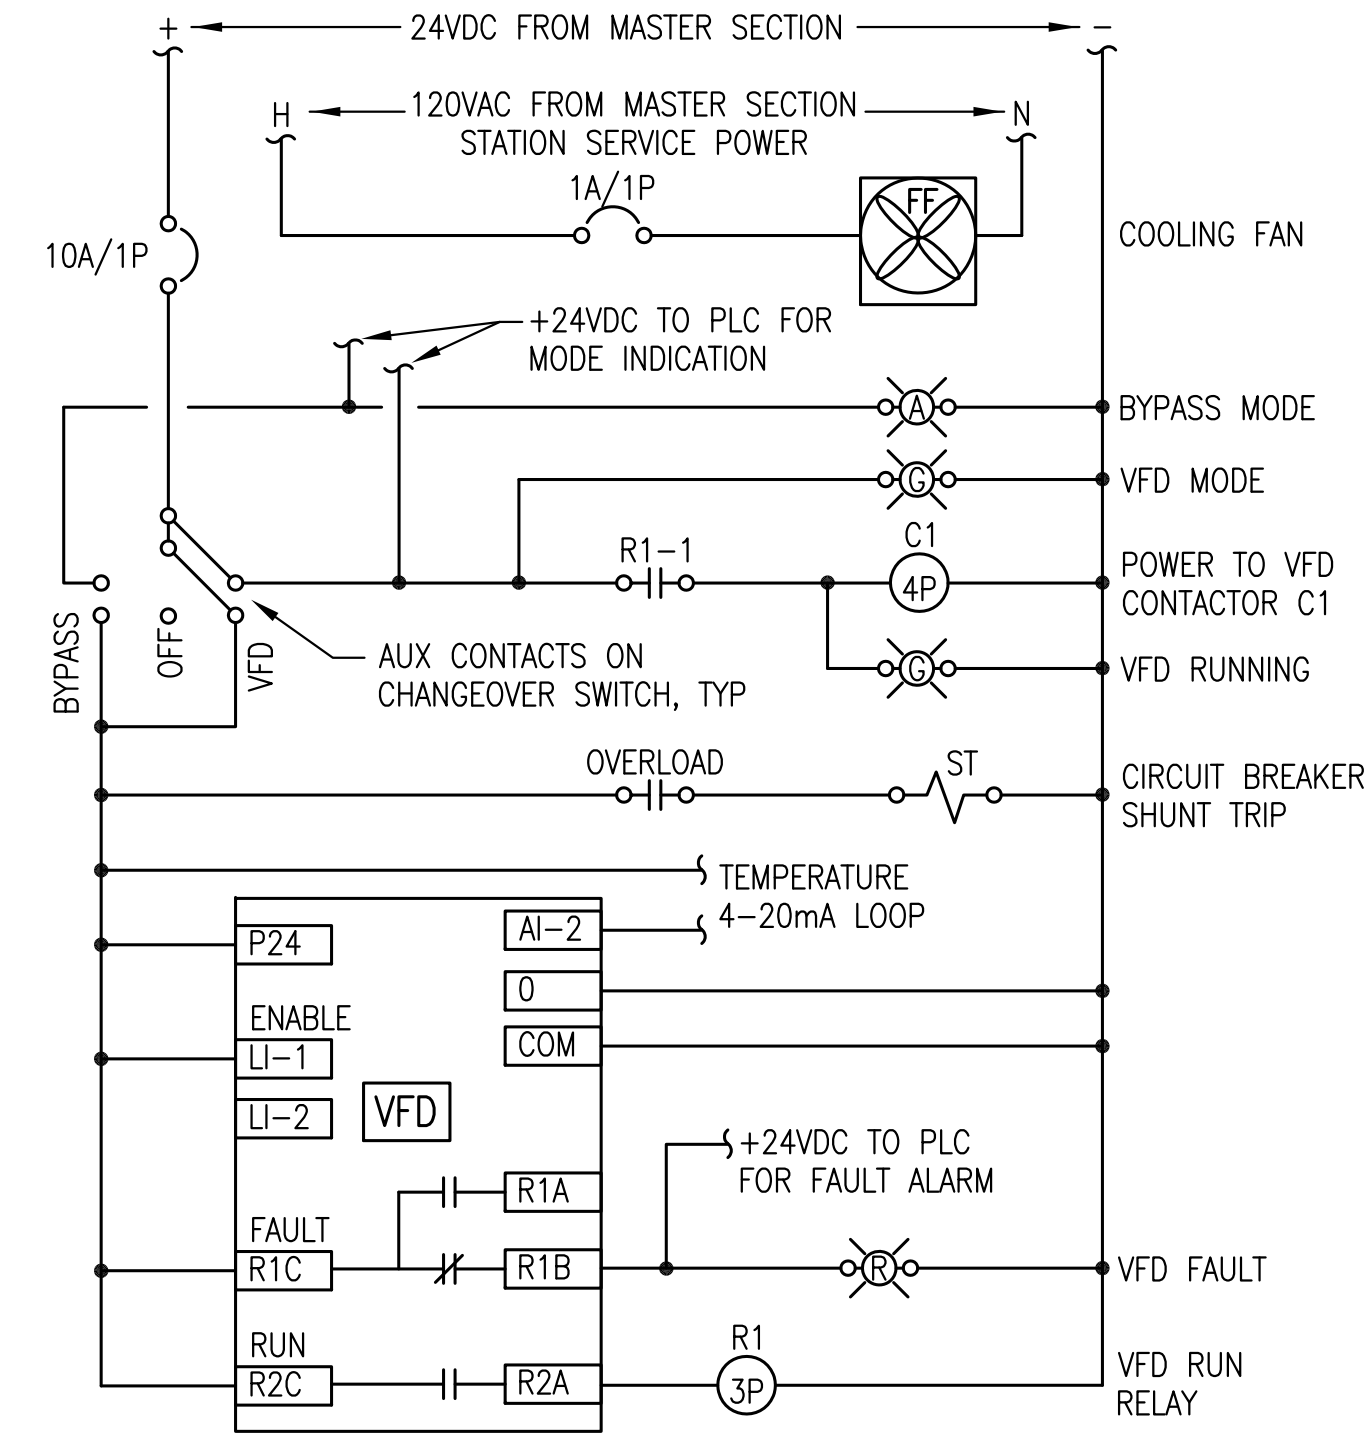


3 TYPICAL RADIATOR VFD LOGIC DIAGRAM
E6.2 NO SCALE


SWITCHGEAR SYMBOL LEGEND	
	TRANSFORMER PT=POTENTIAL XFRMR CPT=CONTROL POWER XFRMR
	CURRENT TRANSFORMER M.R. - INDICATES MULTIRATIO CT'S RATING FACTOR RF=2.0
	CIRCUIT BREAKER AT=AMP TRIP RATING AF=AMP FRAME RATING
	WOODWARD EASYSYEN GENSSET CONTROLLER
	FEEDER PROTECTION RELAY
	SHOP INSTALLED POWER WIRING/BUS
	FIELD INSTALLED POWER WIRING
	SHOP INSTALLED CONTROL WIRING

SWITCHGEAR SHOP/ON-SITE NOTES:

- 1) DEVICES AND WIRING NOTED AS FIELD ARE EXTERNAL TO THE SWITCHGEAR BUT ARE INCLUDED IN THE MODULE SHOP FABRICATION WORK.
- 2) THE FEEDER, STEP UP TRANSFORMER, AND DISTRIBUTION ARE TO BE INSTALLED AS PART OF THE ON-SITE WORK AND ARE NOT PART OF THE MODULE SHOP FABRICATION WORK.
- 3) THE COMMUNICATION DEVICES AND ASSOCIATED WIRING FOR COMMUNICATION WITH THE REMOTE WIND POWER GENERATORS ARE TO BE INSTALLED AS PART OF THE ON-SITE WORK AND ARE NOT PART OF THE MODULE SHOP FABRICATION WORK.

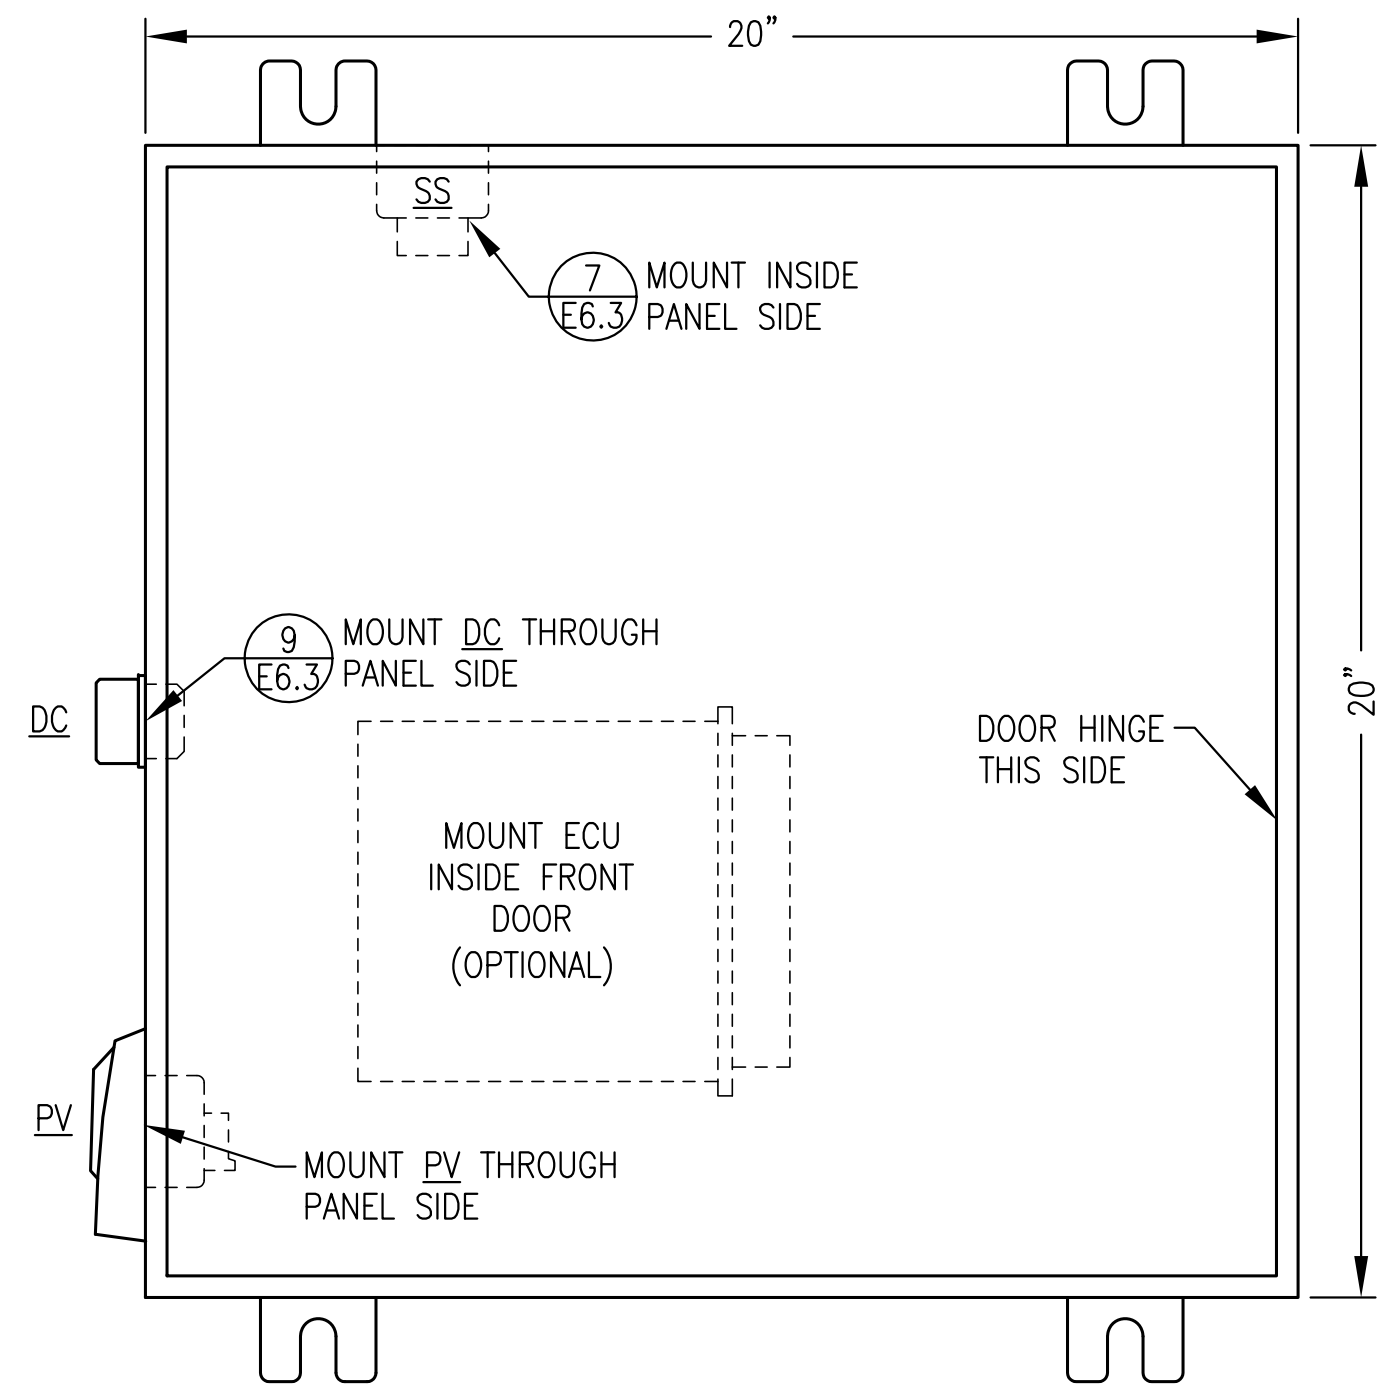

1 JUNCTION BOX FRONT PANEL LAYOUT
E6.3 NO SCALE

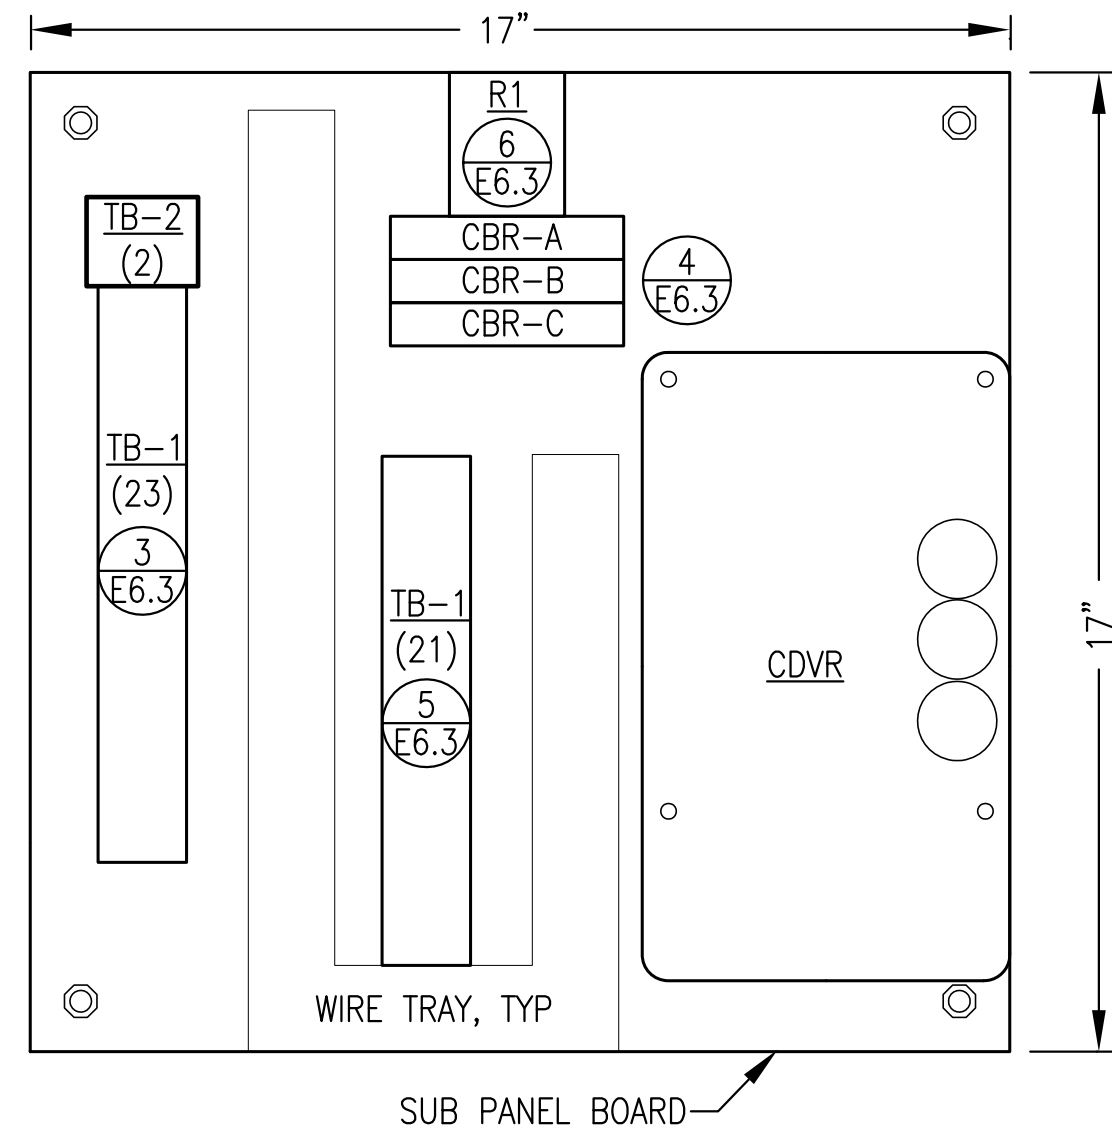

2 JUNCTION BOX SUB PANEL LAYOUT
E6.3 NO SCALE


BILL OF MATERIALS				NOTE: SPECIFIC PARTS MANUFACTURER AND MODEL SELECTED NOT ONLY TO MEET PERFORMANCE FUNCTION BUT ALSO TO COORDINATE AND INTERFACE WITH OTHER DEVICES AND SYSTEMS. APPROVED EQUAL SUBSTITUTIONS WILL BE ALLOWED ONLY BY ENGINEER'S APPROVAL. TO OBTAIN APPROVAL, SUBMITTALS MUST CLEARLY DEMONSTRATE HOW SUBSTITUTE ITEM MEETS OR EXCEEDS SPECIFIED ITEM QUALITY AND PERFORMANCE CHARACTERISTICS AND ALSO COMPLIES WITH MECHANICAL AND/OR ELECTRICAL CONNECTIONS AND PHYSICAL LAYOUT REQUIREMENTS.
TAG	MANUFACTURER	MODEL	DESCRIPTION	
ENCLOSURE	HOFFMAN	A20H20ALP	20x20x8" NEMA 12 BACK PANEL	
CDVR	CATERPILLAR	A20P20	DIGITAL VOLTAGE REGULATOR	
CDVR	CATERPILLAR	254-1265	HARNESS FOR VOLTAGE REGULATOR	
CBR	ALLEN-BRADLEY	1489-M1-C010	RAIL MOUNT CIRCUIT BREAKER, 1-POLE, 1A	
DC	JOHN DEERE	57M7919	DIAGNOSTIC CONNECTOR, 9-PIN, CAN-BUS	
	DEUTSCH	HD18-009	CONNECTOR STRAIN RELIEF	
	DEUTSCH	HDC16-9	CONNECTOR PROTECTIVE DUST CAP	
	DEUTSCH	HD10-9-GKT	CONNECTOR GASKET	
	DEUTSCH	JDL062397	CONNECTOR LANYARD	
PV	MURPHY	PV101-C-MSTD	POWER VIEW W/HARNESS	
R1	ALLEN-BRADLEY	700HAB2224	DPDT RELAY, 24VDC COIL	
	ALLEN-BRADLEY	700HN101	8 PIN SOCKET BASE	
SS	CATERPILLAR	9X-8124	STARTER AUXILIARY SOLENOID, 24V	
TB-1	IDEC	BNH15LW	15A DIN RAIL-MOUNT TERMINAL BLOCK	
TB-2	IDEC	BNH50W	50A DIN RAIL-MOUNT TERMINAL BLOCK	

SHOP FABRICATION NOTES:


- 1) PROVIDE ASSEMBLY WITH ALL DEVICES AND WIRING INDICATED.
- 2) INSTALL IN A NEMA 12 ENCLOSURE WITH MOUNTING FLANGES AT BACK, A MIN 14 GAUGE INTERIOR BACK PANEL AND HINGED LOCKABLE DOOR. SIZE AS INDICATED.
- 3) PROVIDE DIN RAIL, TERMINAL END PLATES, TERMINAL END STOPS, TERMINAL DUST COVERS AND OTHER MISCELLANEOUS HARDWARE AS REQUIRED TO MATCH TERMINALS. LABEL ALL TERMINALS EXACTLY AS INDICATED ON THE DETAILS.
- 4) ALL WIRE #14AWG EXCEPT WHERE SPECIFICALLY INDICATED OTHERWISE. LABEL BOTH ENDS OF ALL JUMPERS WITH THE ENGINE PANEL TERMINAL NUMBER.
- 5) PROVIDE MECHANICAL GROUND LUGS FASTENED TO BACK PANEL AND GROUNDED TO ENGINE-GENERATOR. GROUND ALL SHIELD DRAIN WIRES TO LUGS AT PANEL END ONLY.
- 6) PROVIDE WIRING HARNESSES FOR CONNECTION TO GENERATOR AND TO ENGINE. INSTALL WIRES IN LIQUID TIGHT FLEX OR FLEXIBLE PLASTIC WIRE LOOM AND PROVIDE SERVICE LOOPS IN ACCORDANCE WITH SPECIFICATIONS.
- 7) SHOP TEST EACH ENGINE-GENERATOR WITH ASSOCIATED JUNCTION BOX PERMANENTLY CONNECTED. UPON COMPLETION OF TESTING, COIL WIRING HARNESSES AND SECURE JUNCTION BOX TO GENERATOR FOR SHIPPING.

FIELD INSTALLATION NOTES:


- 1) PERFORM ALL FIELD WIRING IN ACCORDANCE WITH SPECIFICATIONS. LABEL BOTH ENDS OF ALL FIELD WIRING WITH THE ENGINE PANEL TERMINAL NUMBER.
- 2) ON SHIELDED CONDUCTORS GROUND ALL SHIELD DRAIN WIRES TO LUGS AT PANEL END ONLY.

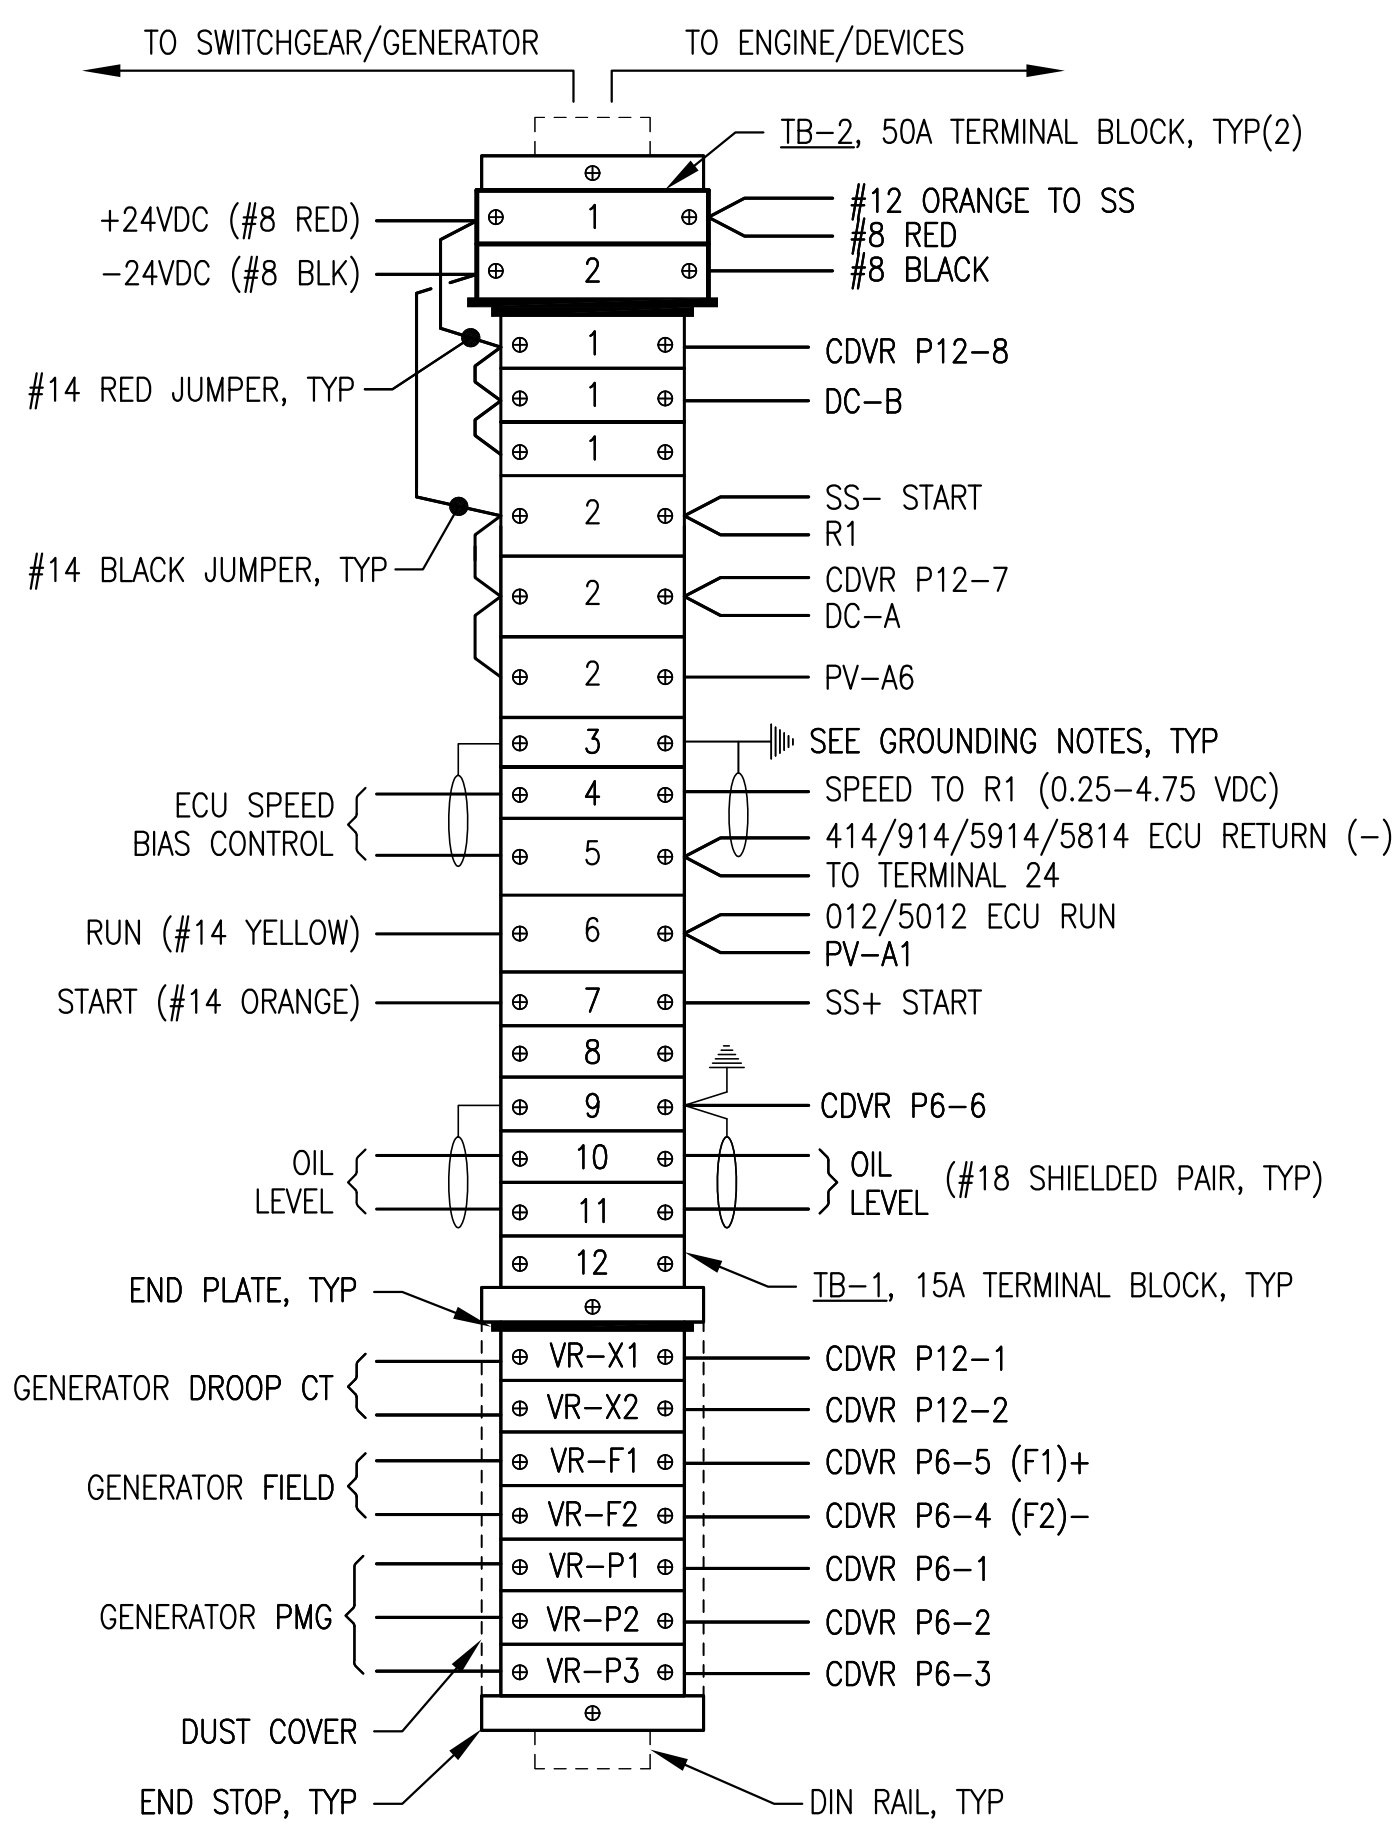

3 TERMINAL STRIP CONNECTIONS
E6.3 NO SCALE

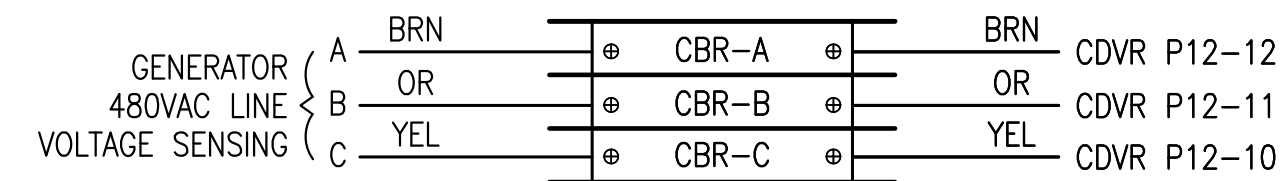


4 CIRCUIT BREAKER CONNECTIONS
E6.3 NO SCALE

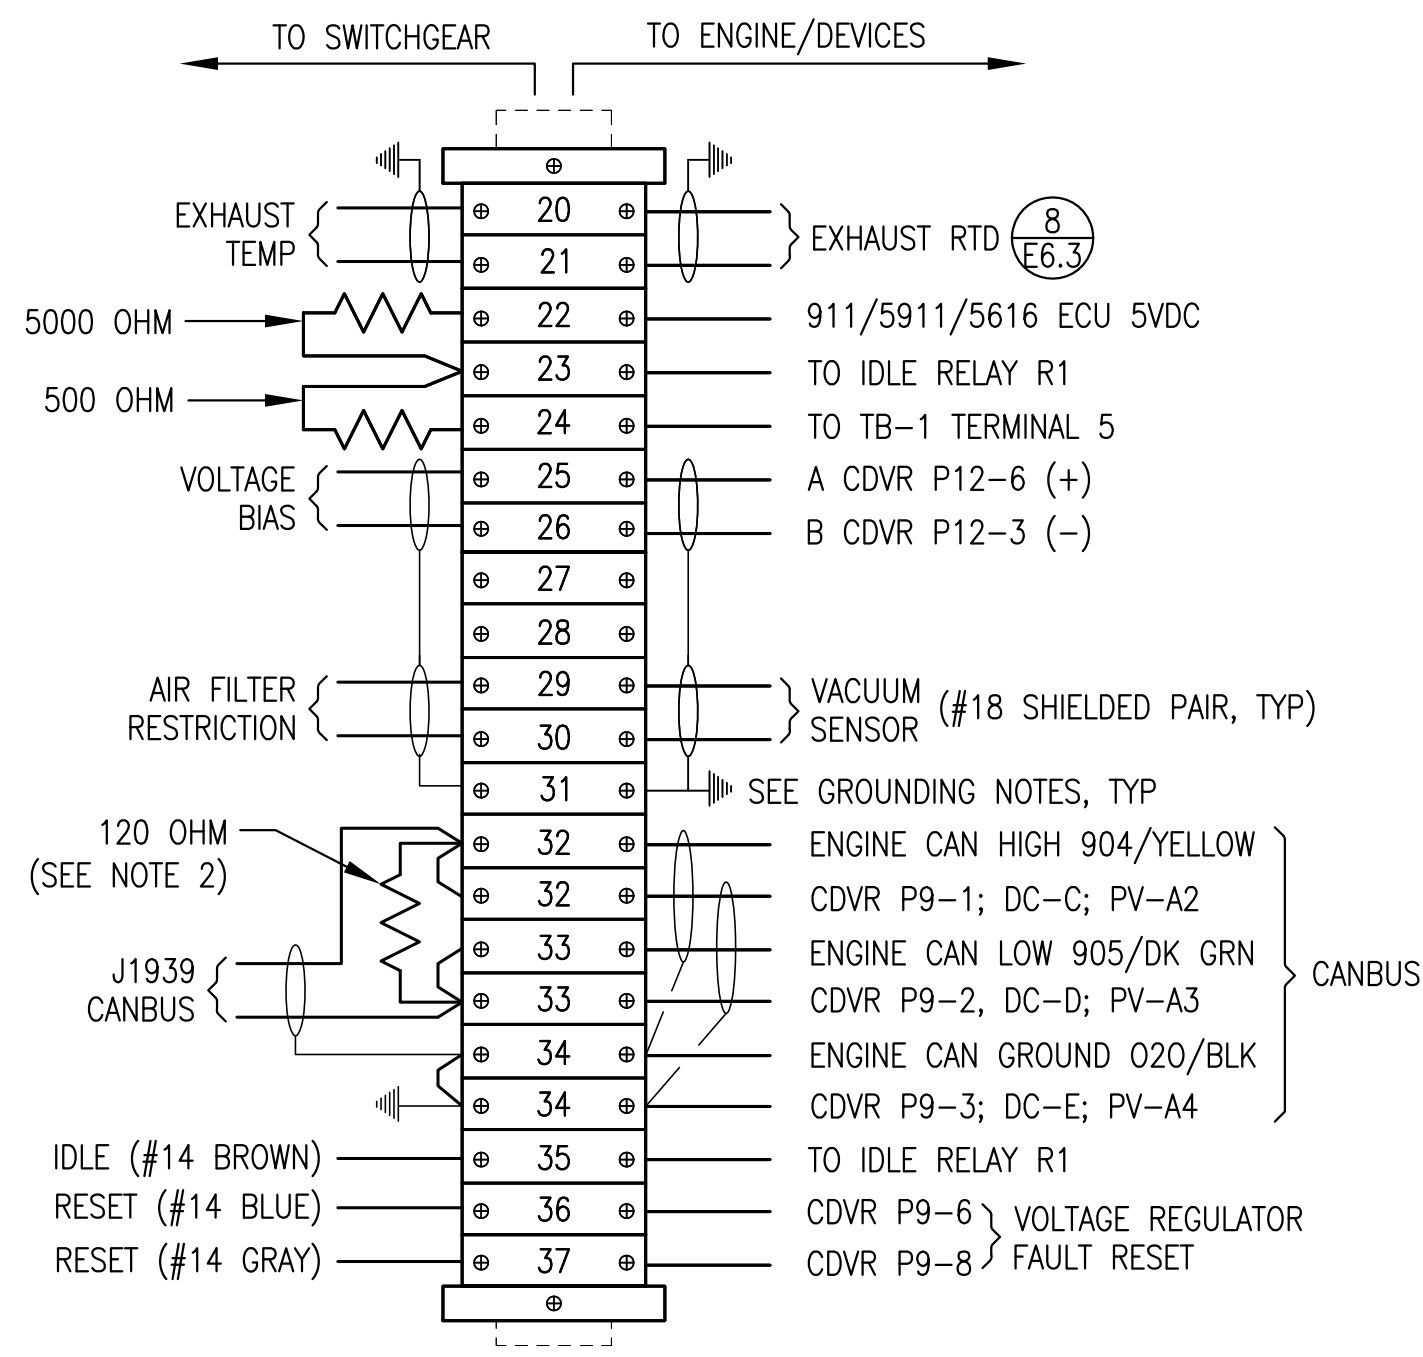


- NOTES: 1) ALL RESISTORS 0.25W.
2) REMOVE RESISTOR IF ENGINE WIRING HARNESS HAS 120 OHM END OF LINE RESISTOR.


5 TERMINAL STRIP CONNECTIONS
E6.3 NO SCALE

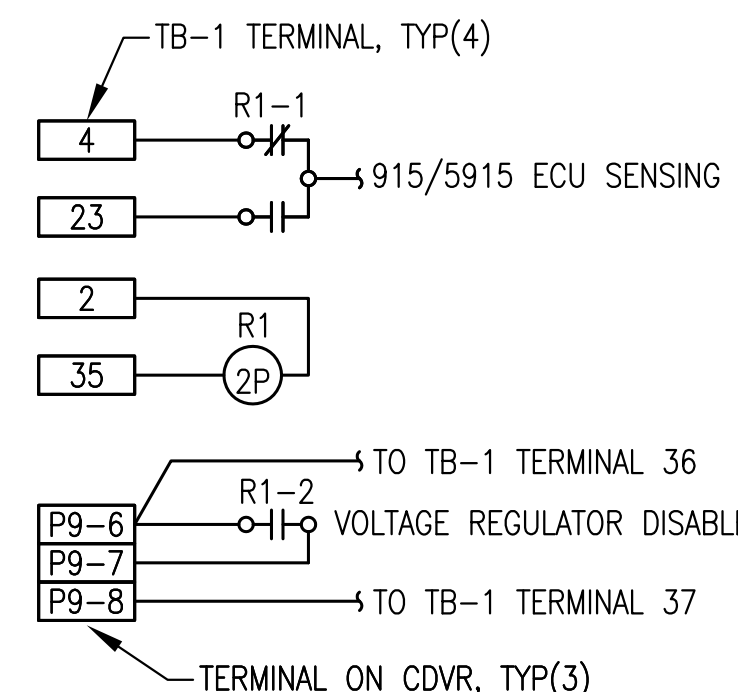


6 IDLE RELAY R1 WIRING DIAGRAM
E6.3 NO SCALE

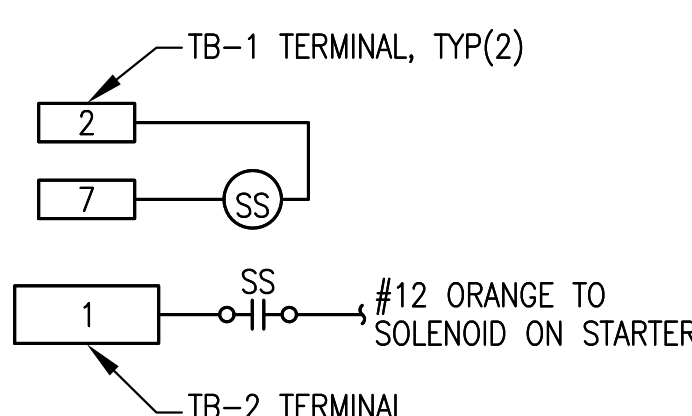


7 STARTER AUX SOLENOID SS WIRING
E6.3 NO SCALE

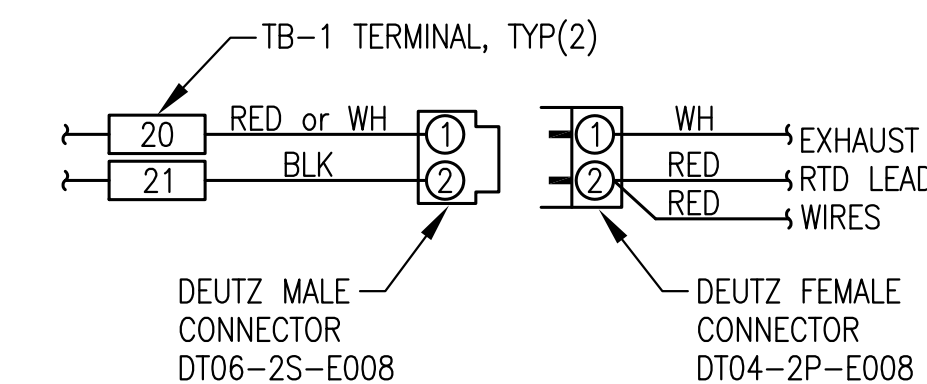

8 EXHAUST RTD CONNECTOR
E6.3 NO SCALE

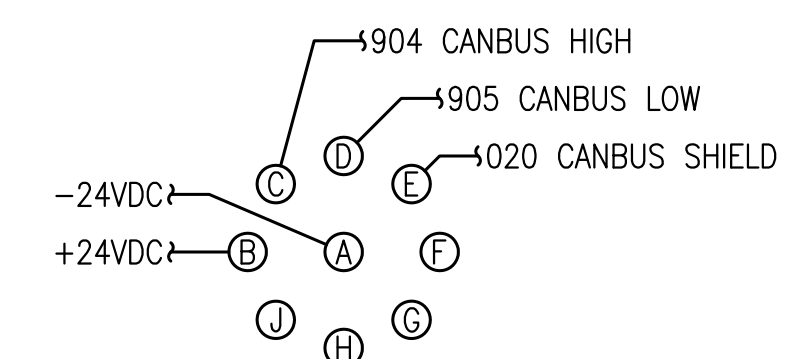

9 DIAGNOSTIC CONNECTOR WIRING
E6.3 NO SCALE

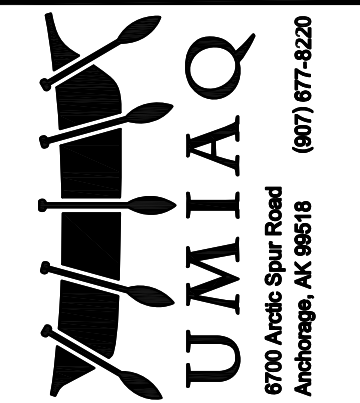


STATE OF ALASKA, AIDEA/AEA
RURAL POWER SYSTEM UPGRADE

CLARKS POINT POWER PLANT
CLARKS POINT, ALASKA

CONSTRUCTION DOCUMENTS

REVISIONS	DESCRIPTION
REV DATE	

VERIFY SCALES
0 1" THIS BAR REPRESENTS ONE INCH ON ORIGINAL DRAWING

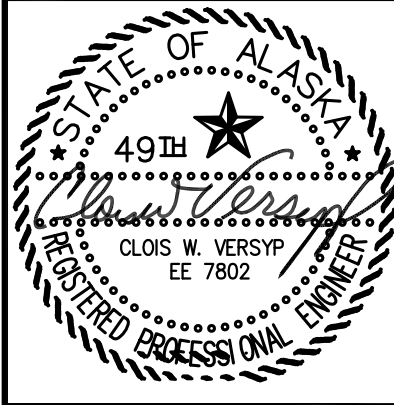


DATE: 1/14/19
DRAWN BY: JTD
CHECKED BY: CWV/BCG
JOB NUMBER:


DRAWING TITLE:
24VDC ENGINE WIRING JUNCTION BOX

E6.3


ISSUED FOR CONSTRUCTION JANUARY 2019

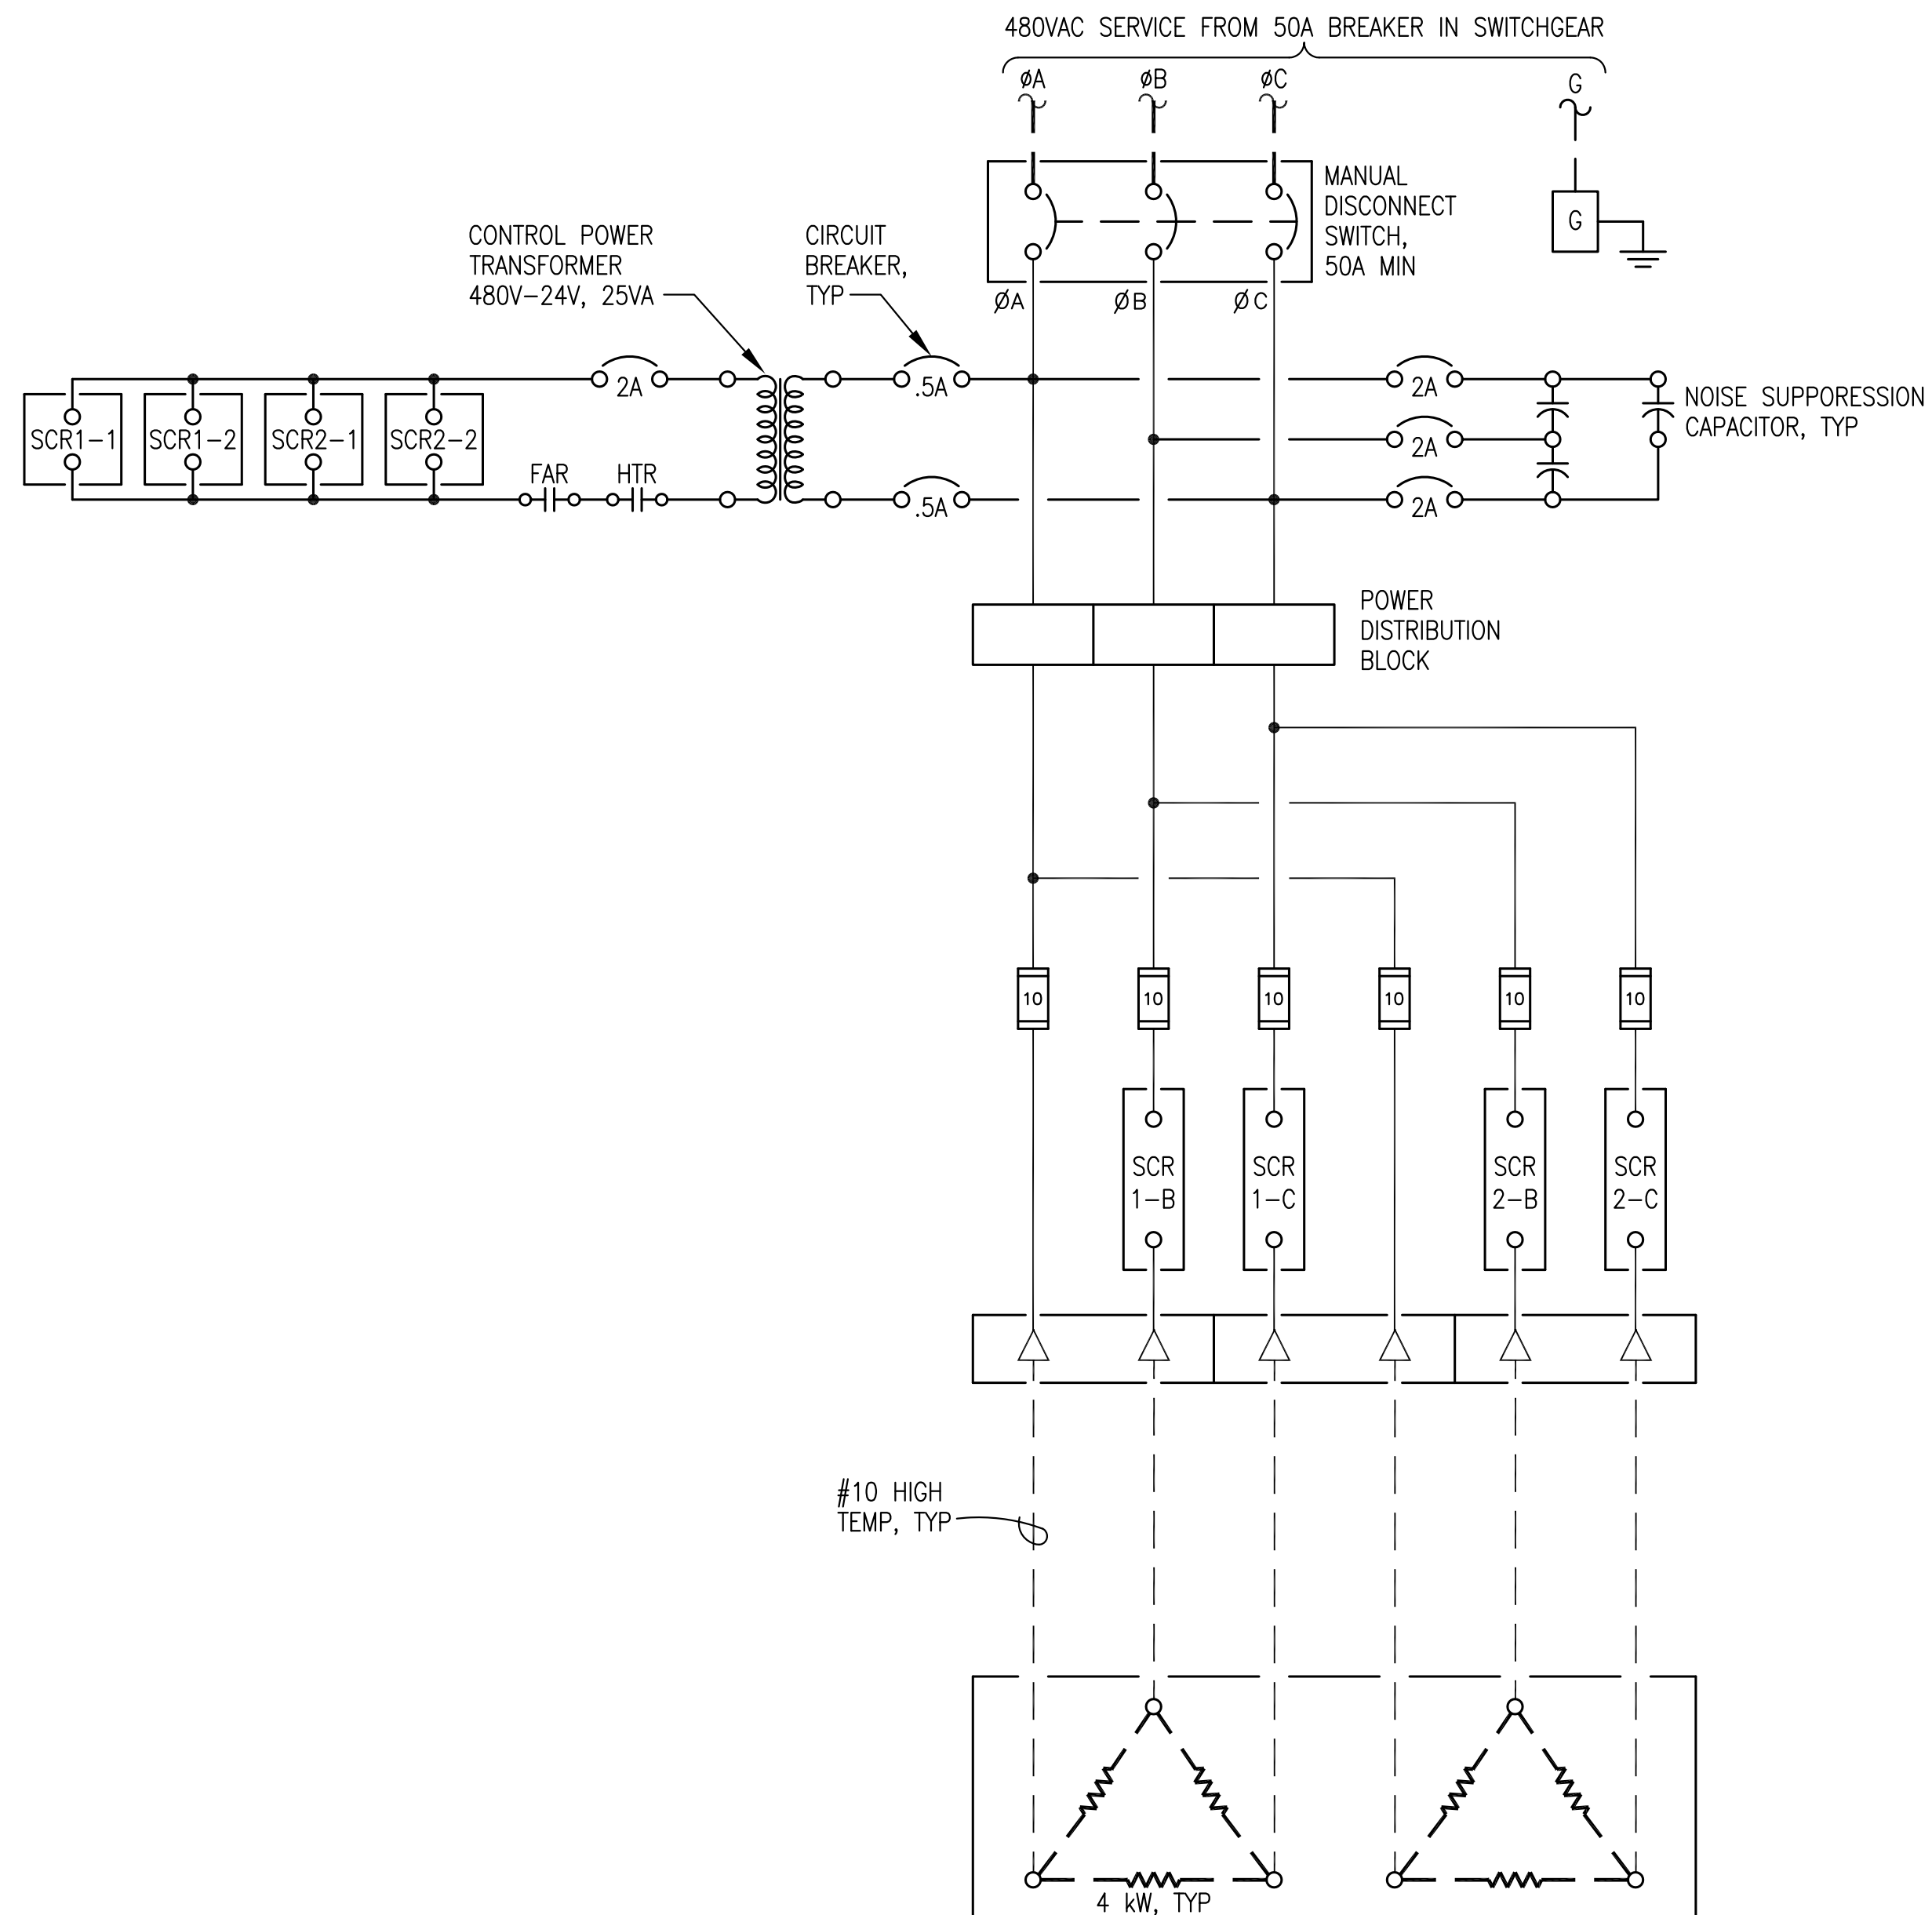


1 480VAC POWER 3-LINE DIAGRAM
E6.4 NO SCALE

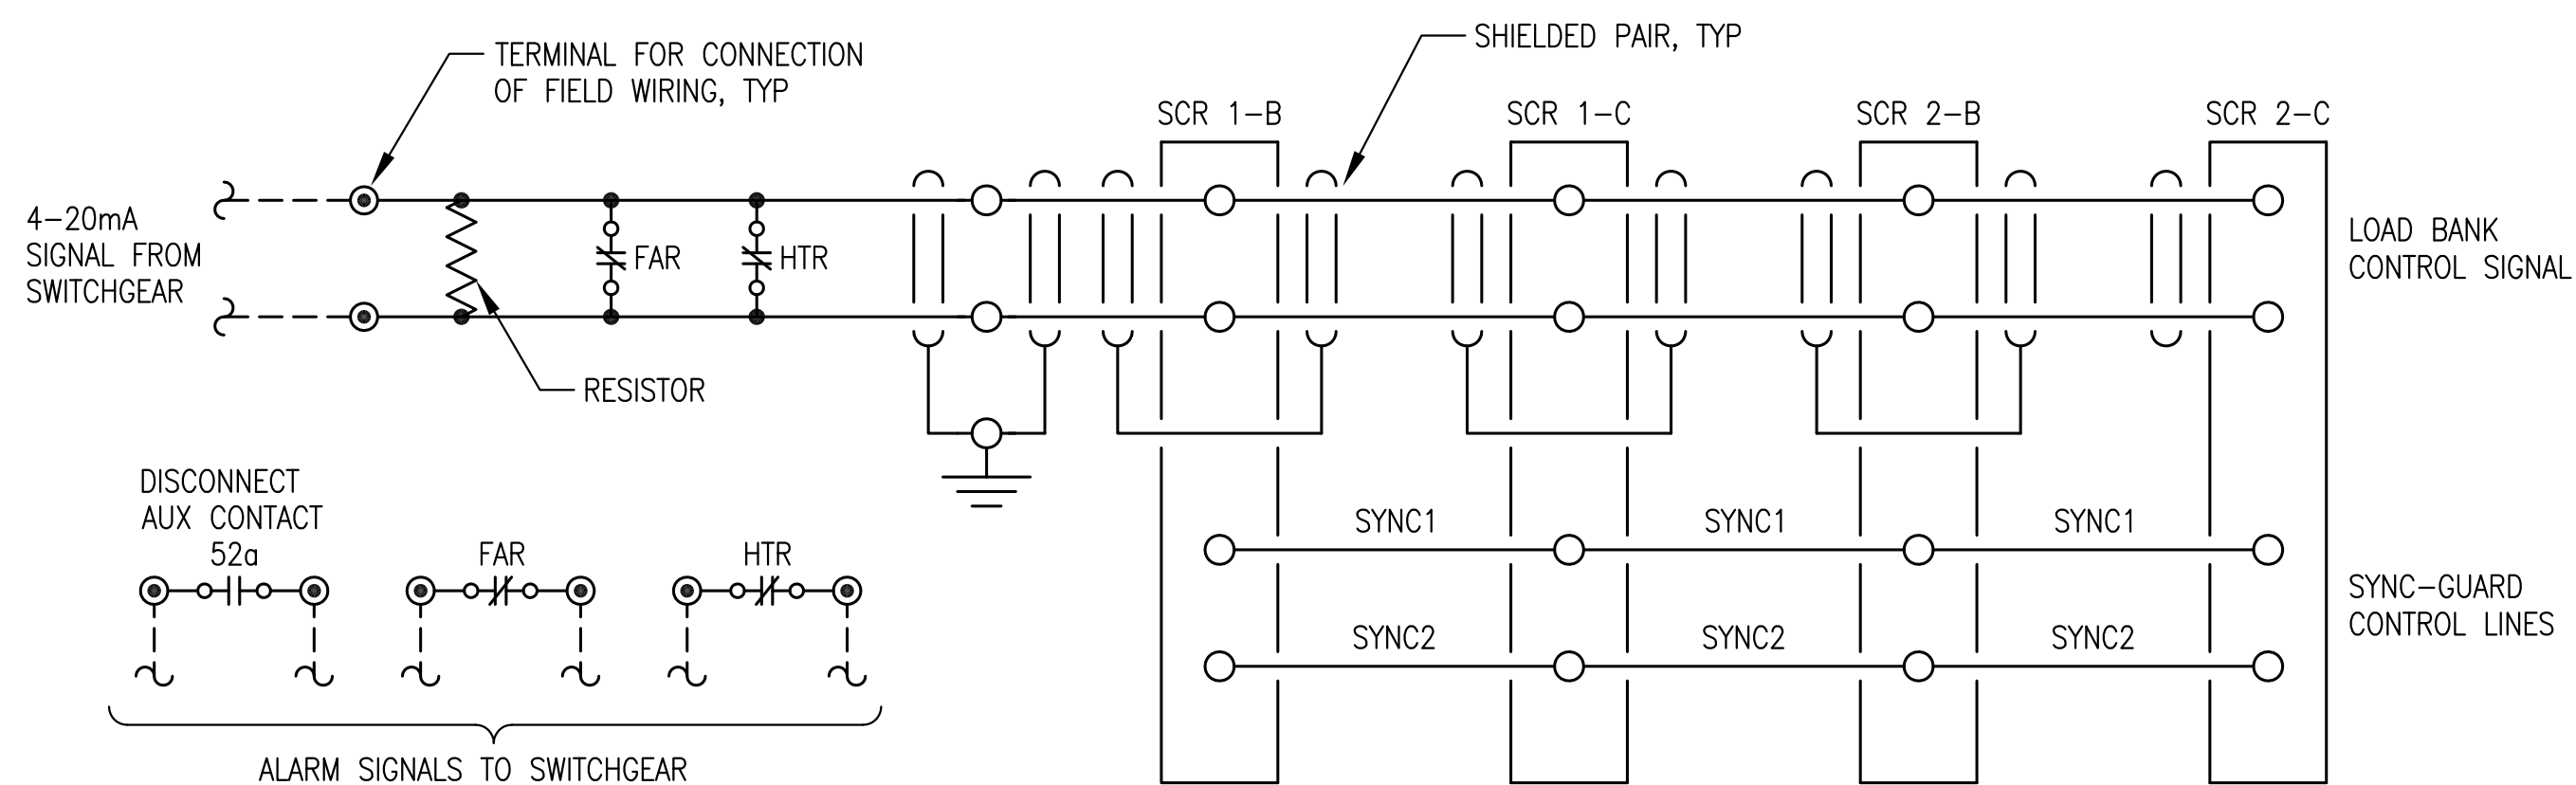

3 SCR CONTROL & ALARM SCHEMATIC
E6.4 NO SCALE

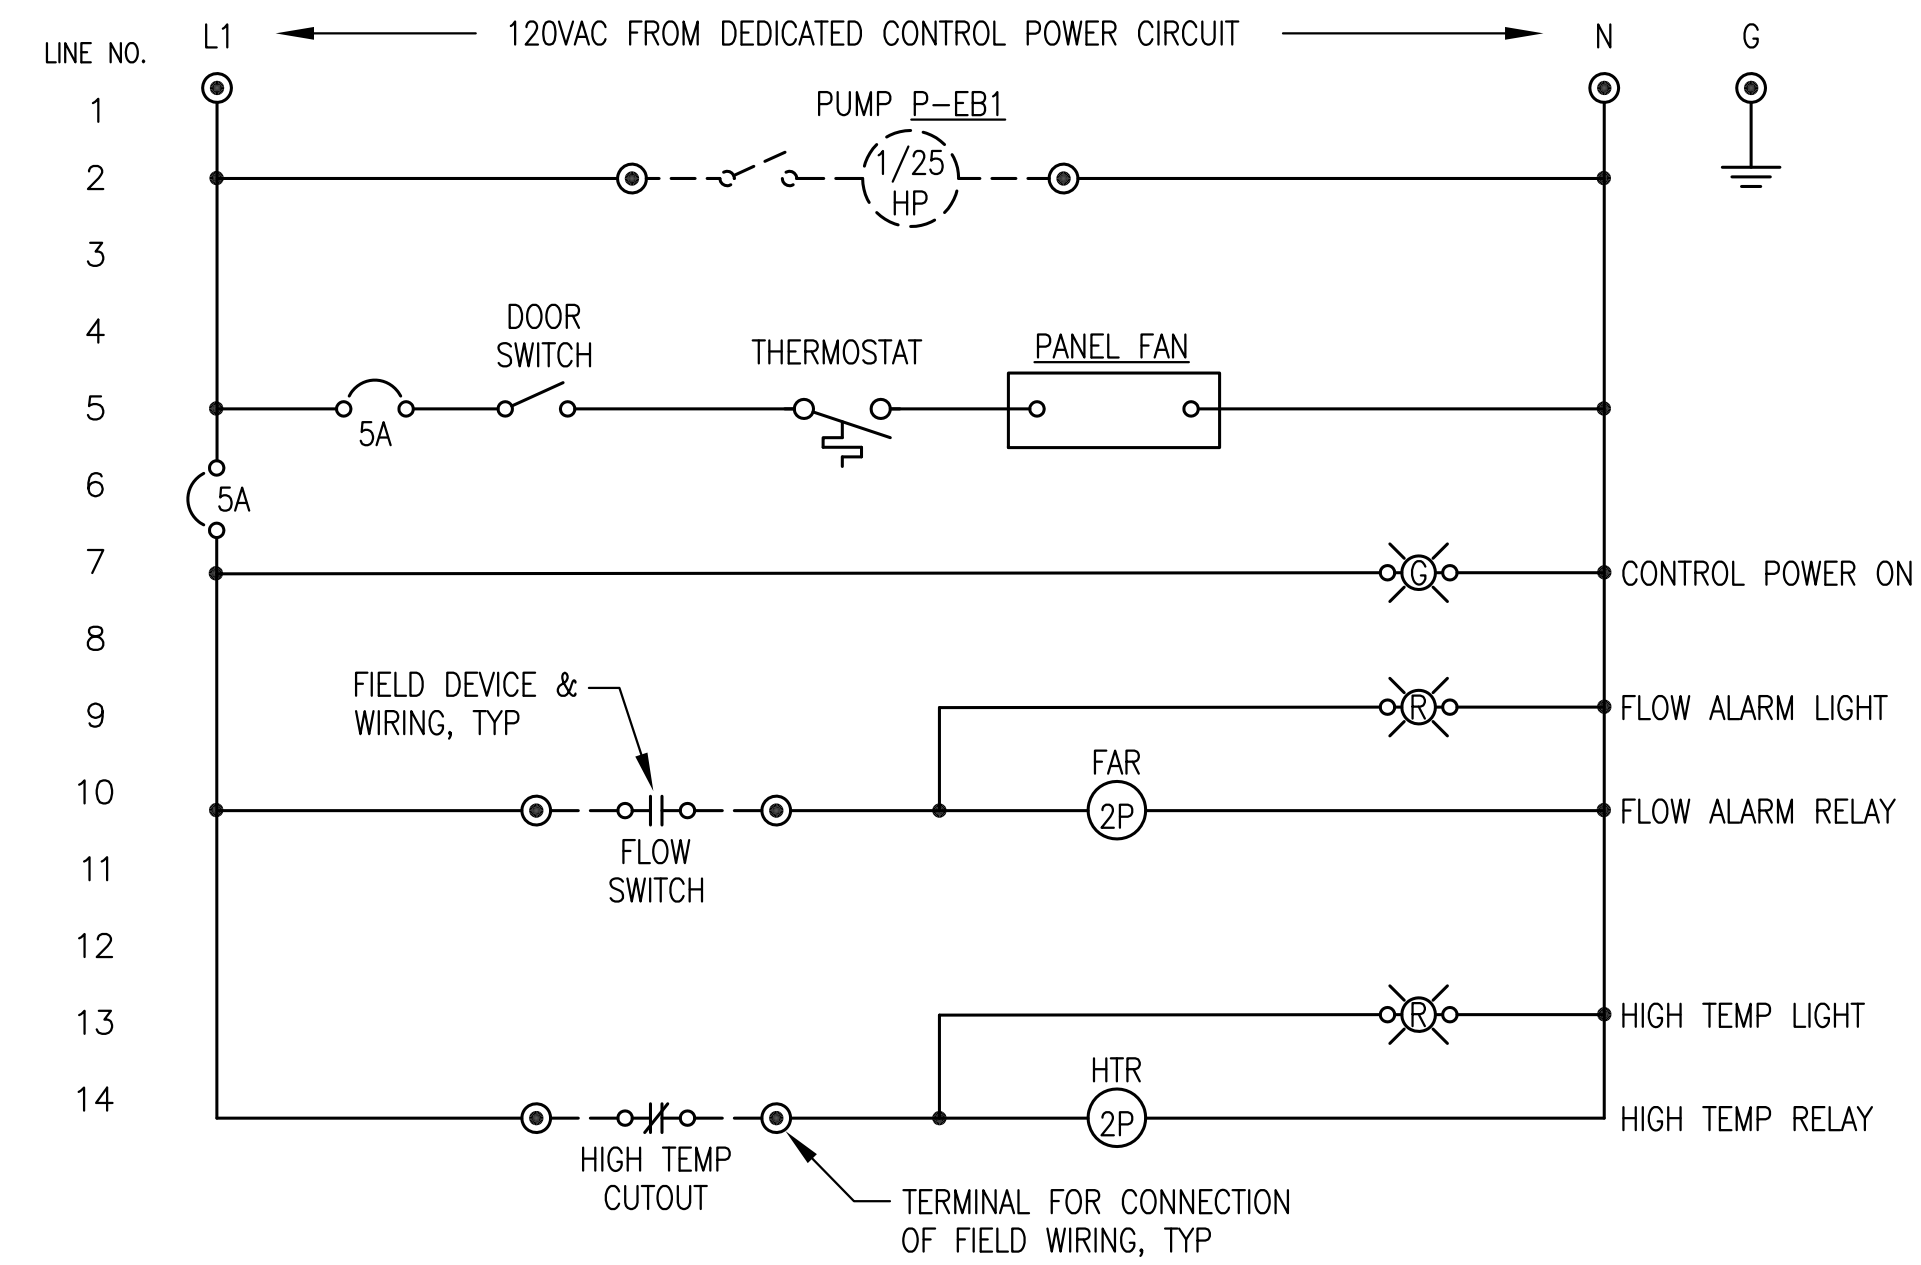

2 120VAC POWER & CONTROL SCHEMATIC
E6.4 NO SCALE

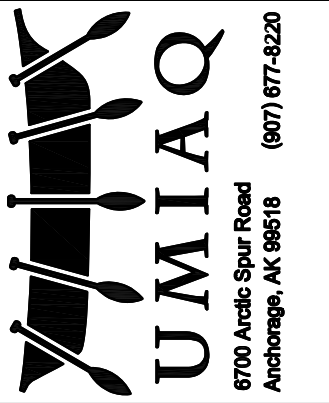


Gray Stassel Engineering, Inc.
P.O. 111405
Anchorage, AK 99511
(907)949-0100

STATE OF ALASKA, AIDEA/AEA
RURAL POWER SYSTEM UPGRADE
CLARKS POINT POWER PLANT
CLARKS POINT, ALASKA

CONSTRUCTION DOCUMENTS	
REVISIONS	DESCRIPTION
REV DATE	

VERIFY SCALES
0 1"
THIS BAR REPRESENTS ONE INCH ON ORIGINAL DRAWING

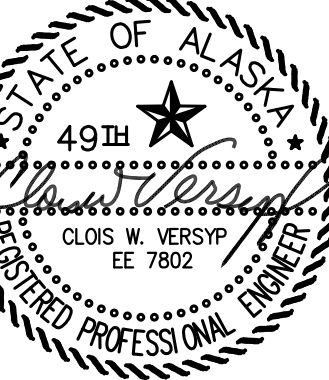


DATE: 1/14/19
DRAWN BY: JTD
CHECKED BY: CWV/BCG
JOB NUMBER:

DRAWING TITLE:
BOILER SCR PANEL
3-LINE & SCHEMATICS


E6.4

SHEET OF 7

ISSUED FOR CONSTRUCTION JANUARY 2019

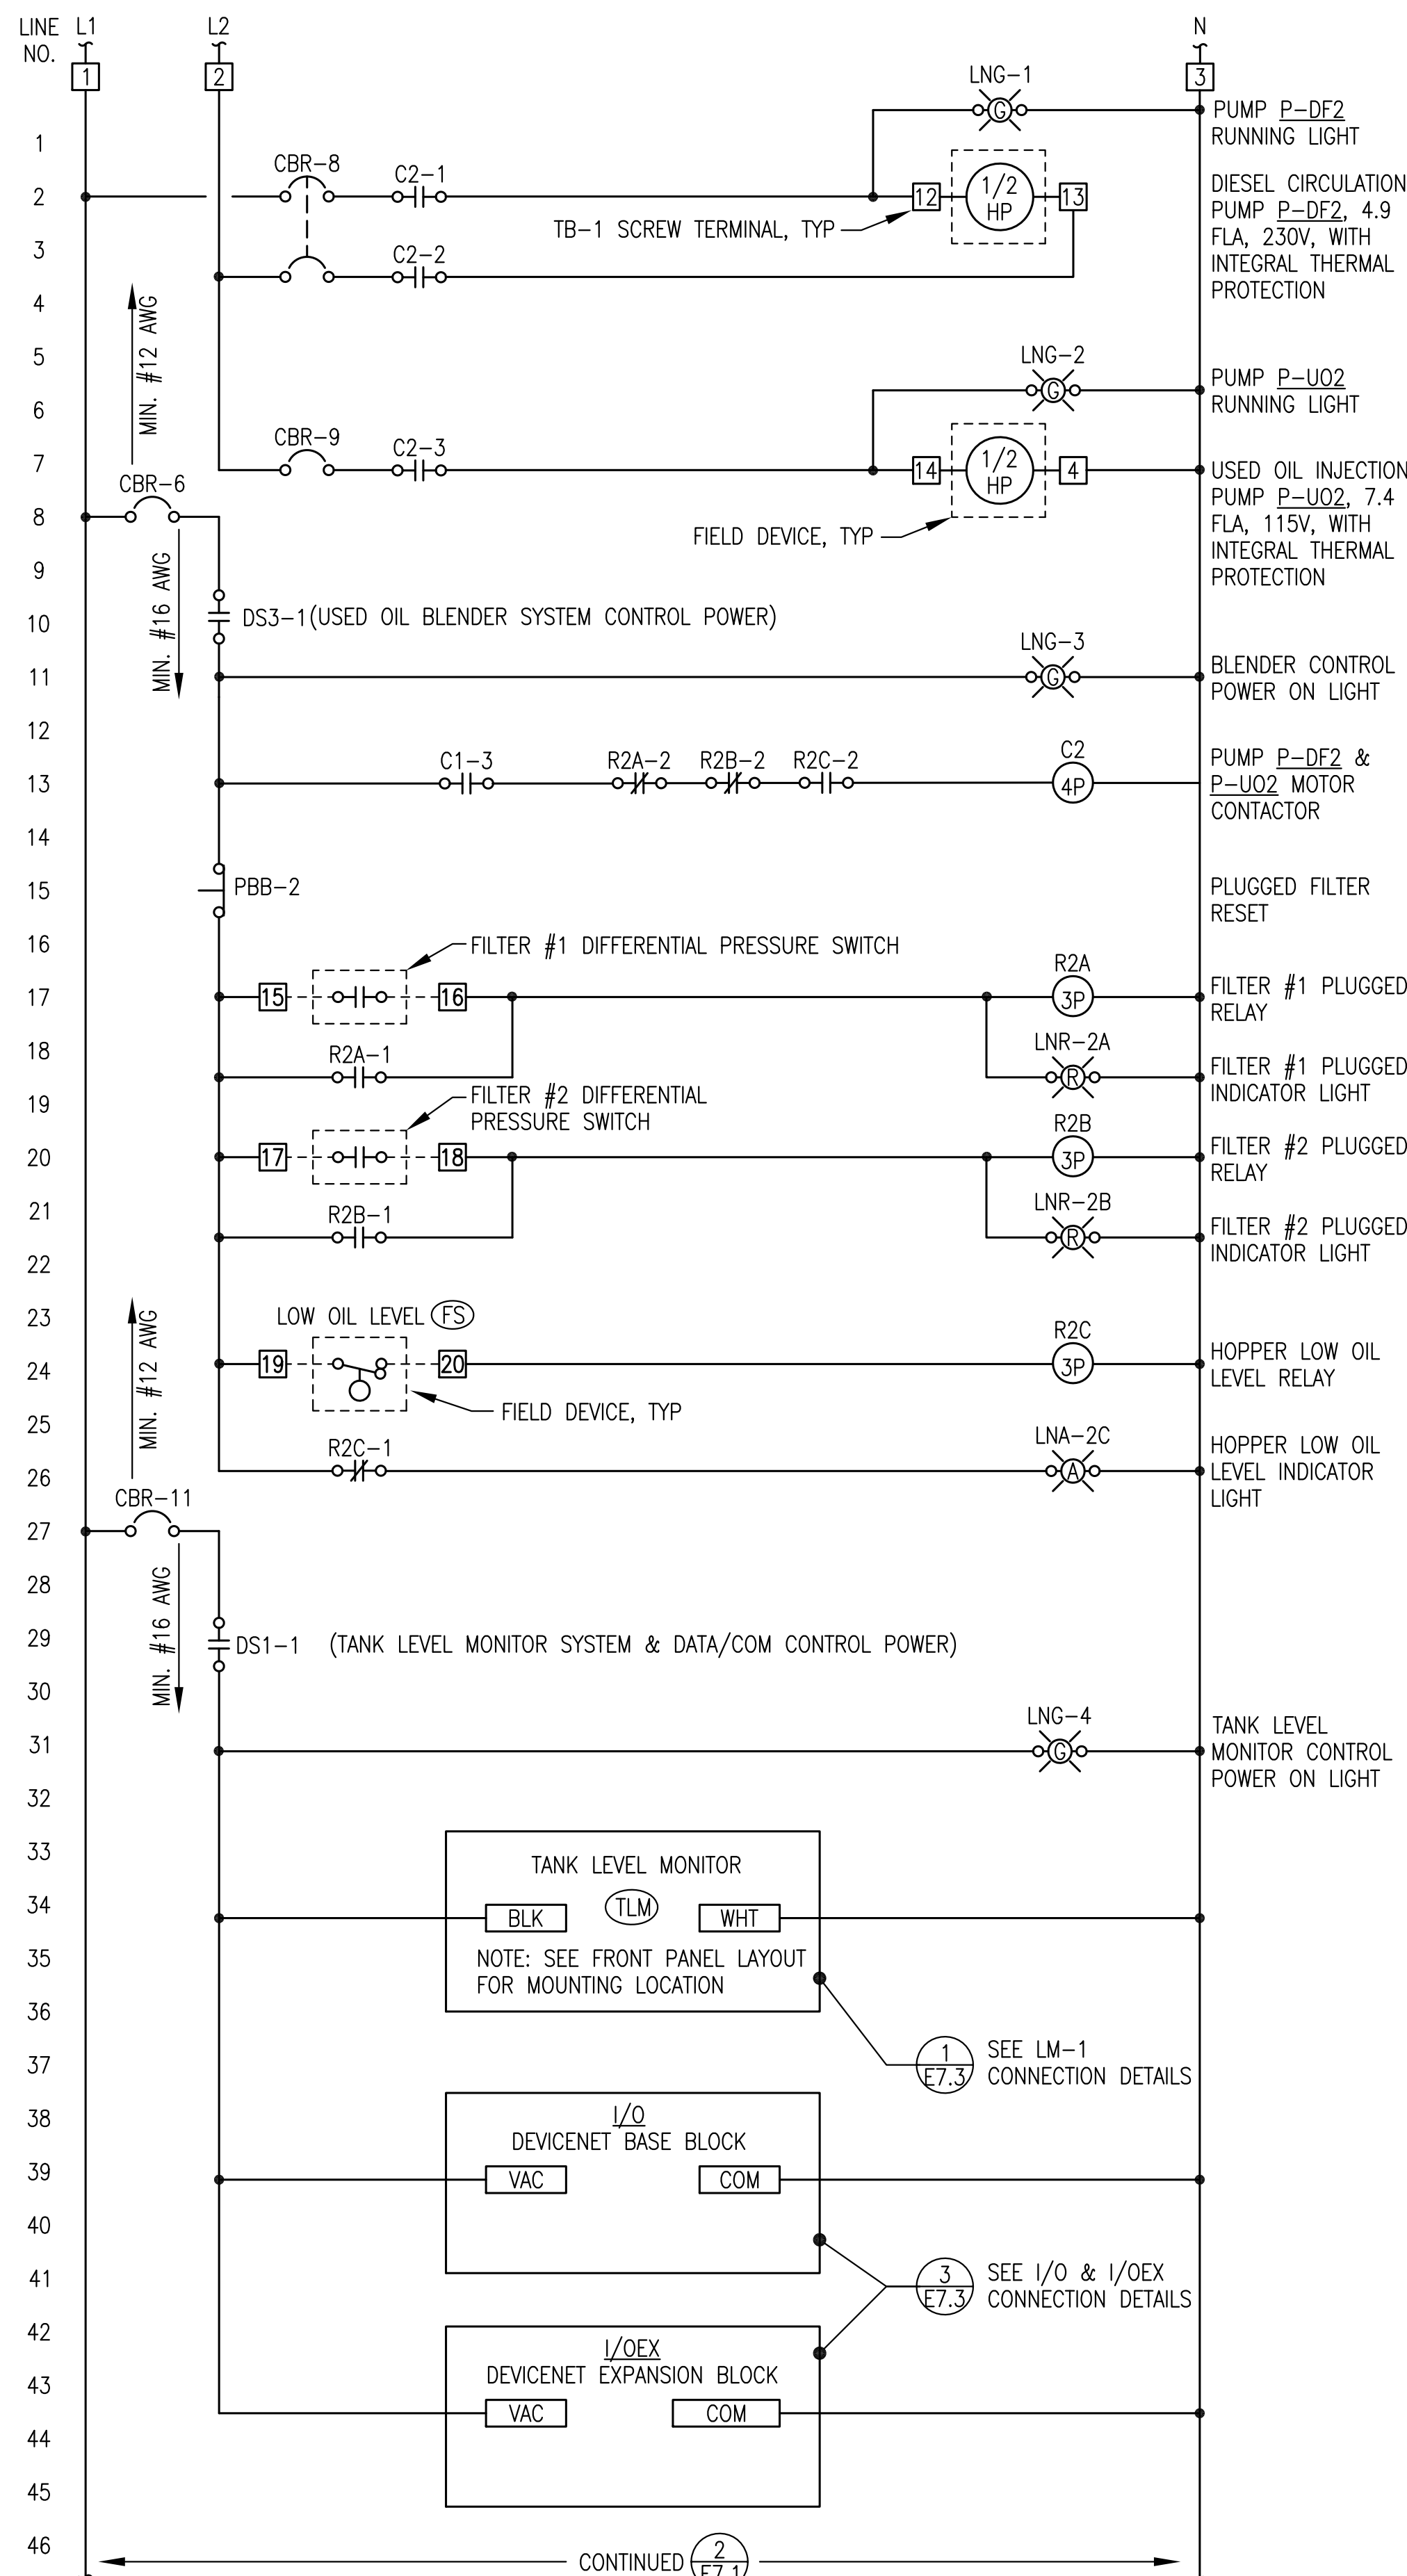

1 USED OIL BLENDER SYSTEM LOGIC DIAGRAM
NO SCALE

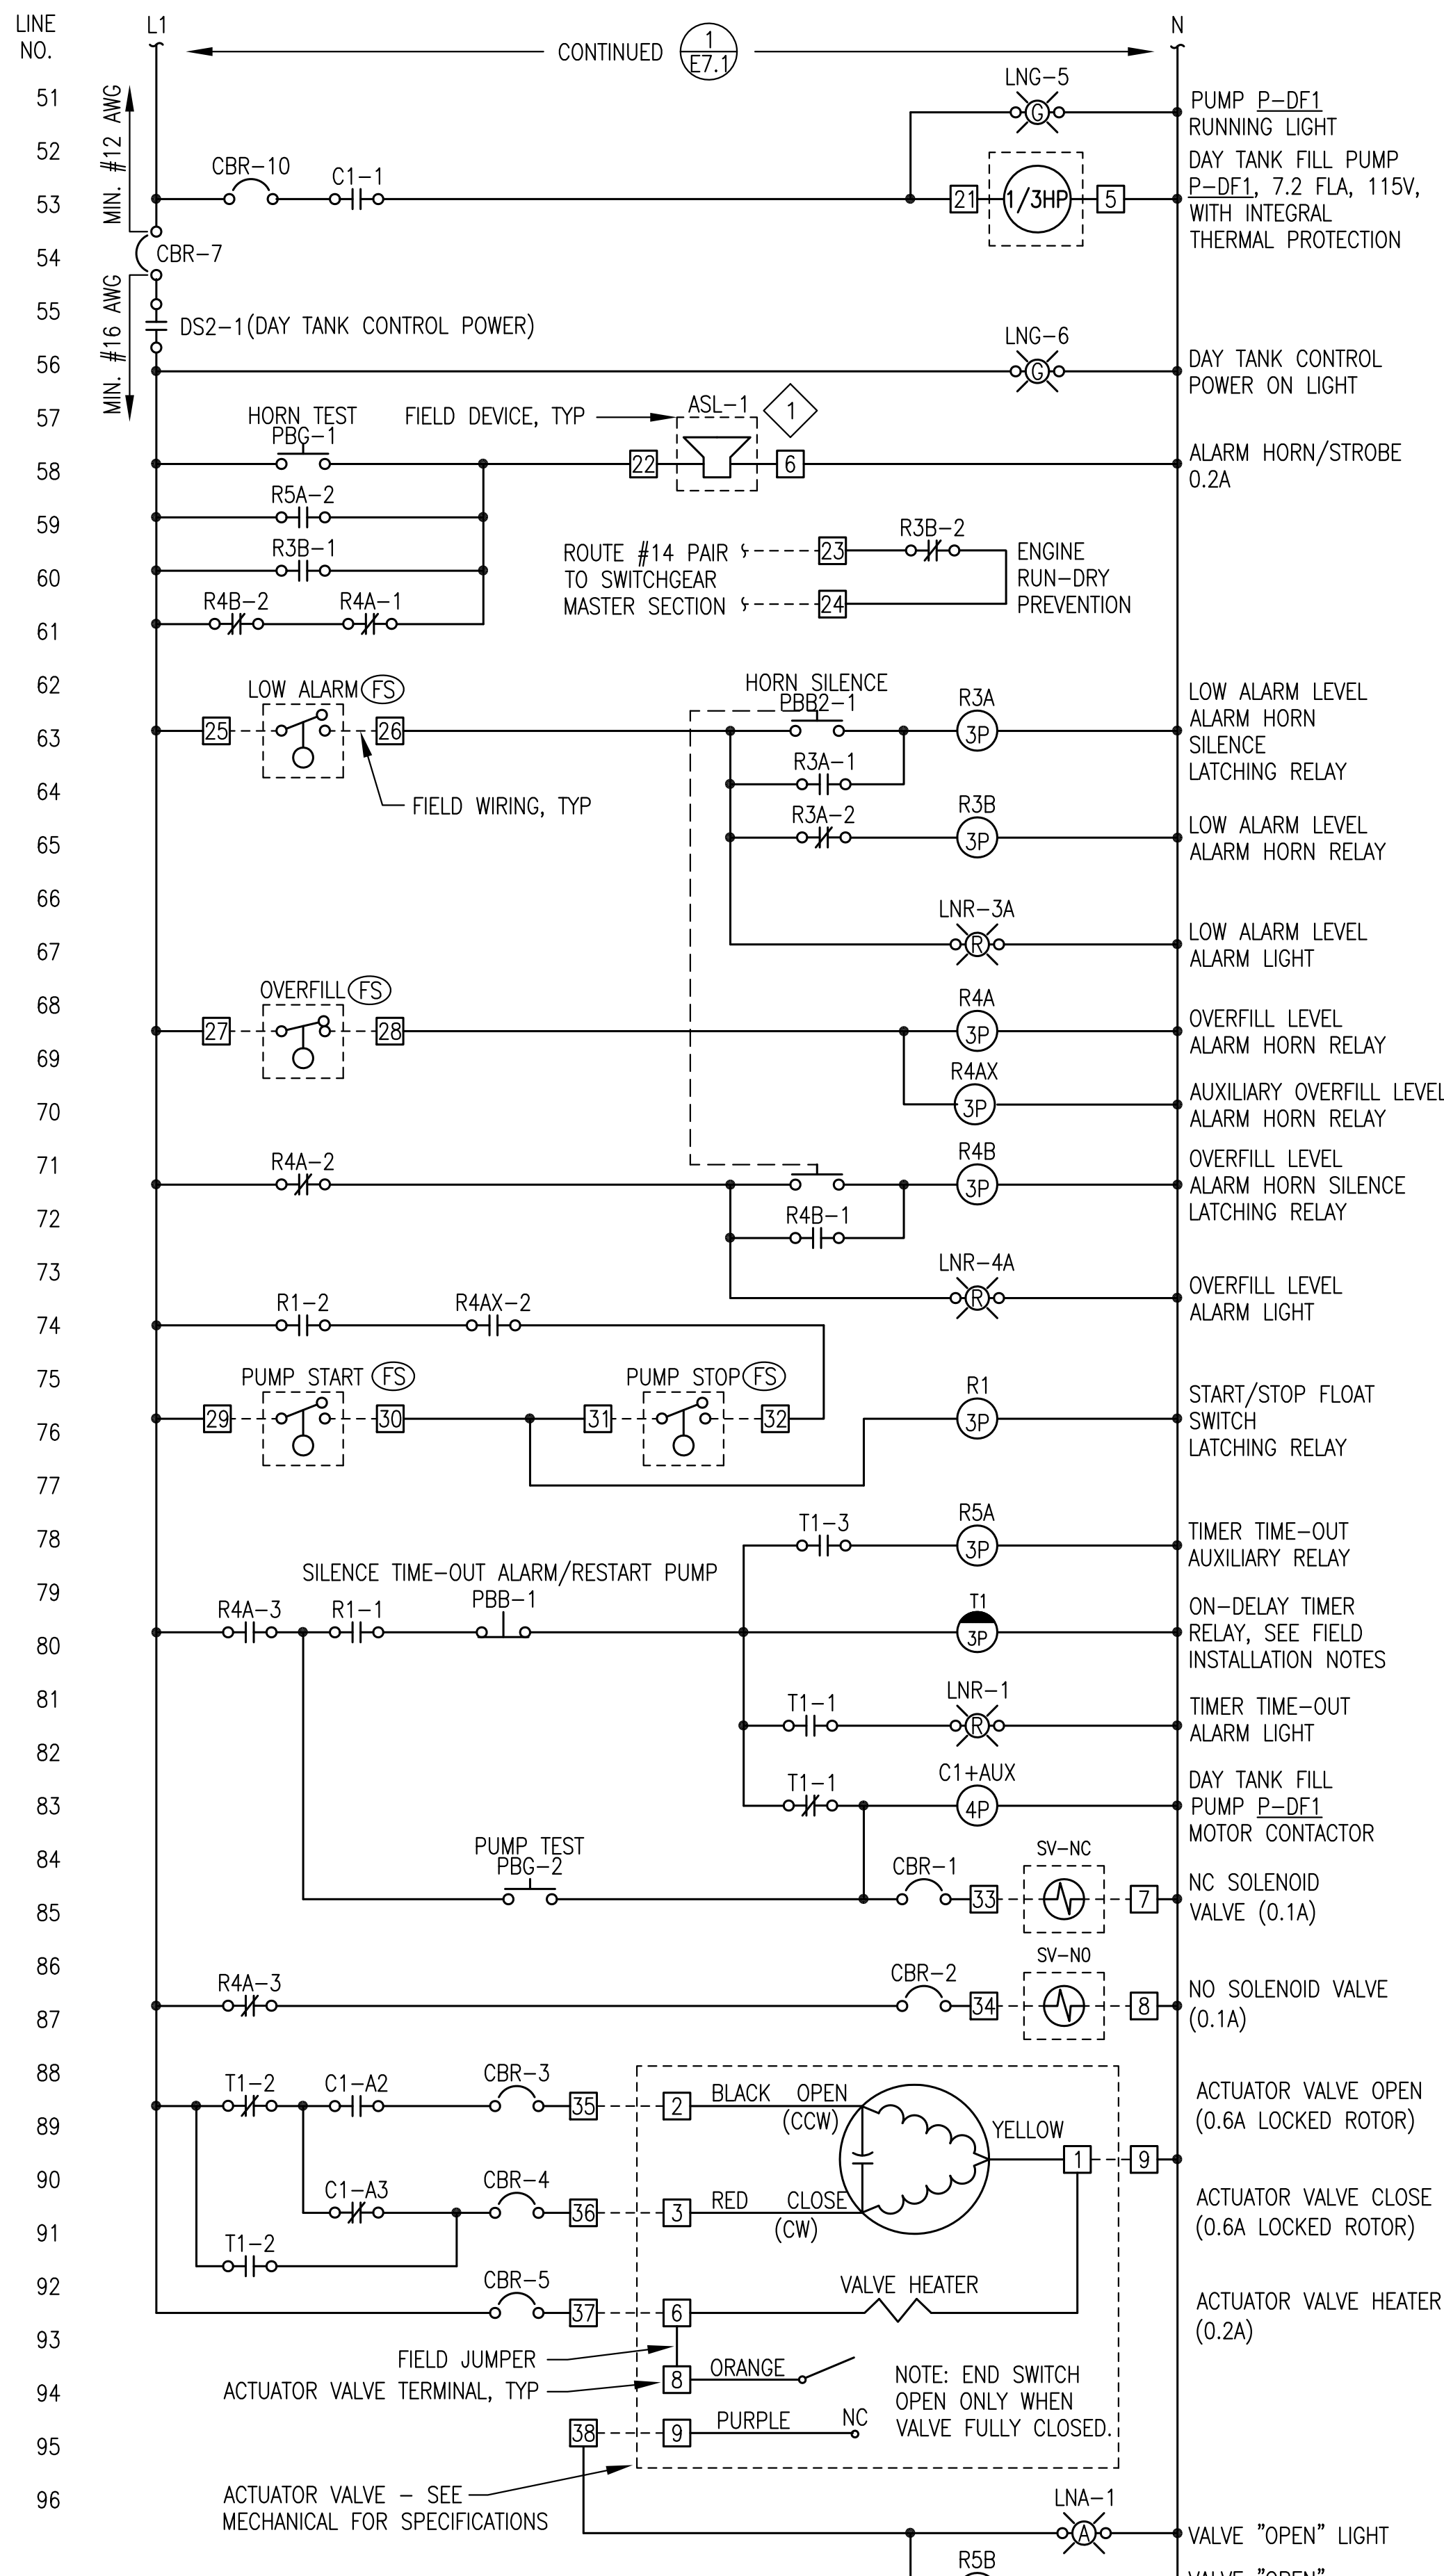

2 DAY TANK LOGIC DIAGRAM
NO SCALE


BILL OF MATERIALS

NOTE: SPECIFIC PARTS MANUFACTURER AND MODEL SELECTED NOT ONLY TO MEET PERFORMANCE FUNCTION BUT ALSO TO COORDINATE AND INTERFACE WITH OTHER DEVICES AND SYSTEMS. APPROVED EQUAL SUBSTITUTIONS WILL BE ALLOWED ONLY BY ENGINEER'S APPROVAL. TO OBTAIN APPROVAL, SUBMITTALS MUST CLEARLY DEMONSTRATE HOW SUBSTITUTE ITEM MEETS OR EXCEEDS SPECIFIED ITEM QUALITY AND PERFORMANCE CHARACTERISTICS AND ALSO COMPLIES WITH MECHANICAL AND/OR ELECTRICAL CONNECTIONS AND PHYSICAL LAYOUT REQUIREMENTS.

TAG	MANUFACTURER	MODEL	DESCRIPTION
AUX	ALLEN-BRADLEY	100SA11	AUXILIARY CONTACT FOR CONTACTOR, 2 POLE, NO, NC
C	ALLEN-BRADLEY	100C23D10	CONTACTOR, 120V COIL, 23A, 3 POLE WITH 1 NO AUX
CBR-1,2,3,4,5	ALLEN-BRADLEY	1489-M1-C010	RAIL-MOUNT CIRCUIT BREAKER, 1 POLE, 1A
CBR-6,7,11	ALLEN-BRADLEY	1489-M1-C050	RAIL-MOUNT CIRCUIT BREAKER, 1 POLE, 5A
CBR-8	ALLEN-BRADLEY	1489-M2-C150	RAIL-MOUNT CIRCUIT BREAKER, 2 POLE, 15A
CBR-9,10	ALLEN-BRADLEY	1489-M1-C150	RAIL-MOUNT CIRCUIT BREAKER, 1 POLE, 15A
DS	ALLEN-BRADLEY	194LE201753	DISCONNECT, 2 POSITION, 3 N.O., 20A, FACE MOUNT
LNG	ALLEN-BRADLEY	800HQRH2G	GREEN LED PILOT LIGHT, 12-130V, NEMA 4X
LNR	ALLEN-BRADLEY	800HQRH2R	RED LED PILOT LIGHT, 12-130V, NEMA 4X
LNA	ALLEN-BRADLEY	800HQRH2A	AMBER LED PILOT LIGHT, 12-130V, NEMA 4X
I/O	ALLEN-BRADLEY	1790D-T8A0	120VAC DEVICENET 8 INPUT BASE TERM. BLOCK
I/OEX	ALLEN-BRADLEY	1790D-T8A0X	120VAC DEVICENET 8 INPUT EXPANSION TERM. BLOCK
PBB	ALLEN-BRADLEY	800HAR2D2	MOMENTARY PUSH BUTTON, 1 NO, NEMA 4X, BLACK
PBB2	ALLEN-BRADLEY	800HAR2A2	MOMENTARY PUSH BUTTON, 2 NO, NEMA 4X, BLACK
PBG	ALLEN-BRADLEY	800HAR1D1	MOMENTARY PUSH BUTTON, 1 NO, NEMA 4X, GREEN
PP	PHOENIX CONTACTS	FLPPRJ45/RJ45	ETHERNET PATCH PANEL, RJ45xRJ45, DIN RAIL MOUNT
R	ALLEN-BRADLEY	700HA33A1	3PDT RELAY
	ALLEN-BRADLEY	700HN101	11 PIN SOCKET BASE
T	ALLEN-BRADLEY	700HT3	SERIES B TIMING MODULE
	ALLEN-BRADLEY	700HA33A1	3PDT RELAY
	ALLEN-BRADLEY	700HN205	11 PIN RELAY SOCKET BASE FOR TIMER
TB-1,2	ALLEN-BRADLEY	1492CAM1L	35A, 600V, LARGE-HEAD SCREW TERMINALS
*TLM	TANK LEVEL MONITOR, SEE INSTRUMENTATION SCHEDULE ON E1.1		

LEGEND

—	PANEL WIRING	---	FIELD WIRING
R#	CONTROL RELAY	R#-#	NORMALLY OPEN CONTACT
T#	TIME DELAY RELAY	SS-#	2-POSITION SELECTOR SWITCH
C#	CONTACTOR	R#-#	NORMALLY CLOSED CONTACT
CB-#	CIRCUIT BREAKER	O.L.	OVERLOADS
SW-#	NORMALLY OPEN FLOAT SWITCH	PB-#	NORMALLY OPEN MOMENTARY PUSH BUTTON
SW-#	NORMALLY CLOSED FLOAT SWITCH	PB-#	NORMALLY CLOSED MOMENTARY PUSH BUTTON
		SV#	SOLENOID VALVE
		ASL-#	ALARM & STROBE LIGHT

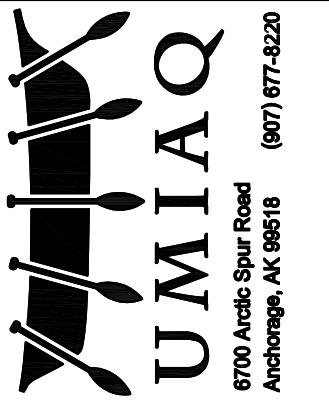


STATE OF ALASKA, AIDEA/AEA RURAL POWER SYSTEM UPGRADE

CONSTRUCTION DOCUMENTS

REVISIONS	REV DATE	DESCRIPTION

VERIFY SCALES
0 1" THIS BAR REPRESENTS ONE INCH ON ORIGINAL DRAWING



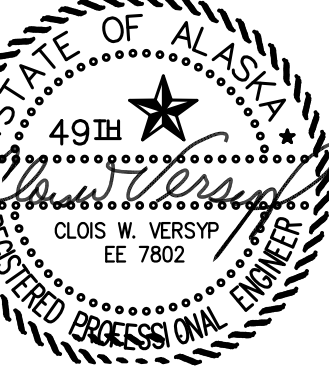


DATE: 1/14/19
DRAWN BY: JTD
CHECKED BY: CWV/BCG
JOB NUMBER:

DRAWING TITLE:
FUEL SYSTEM CONTROL PANEL LOGIC DIAGRAM & BILL OF MATERIALS

ISSUED FOR CONSTRUCTION JANUARY 2019

CLARKS POINT POWER PLANT
CLARKS POINT, ALASKA

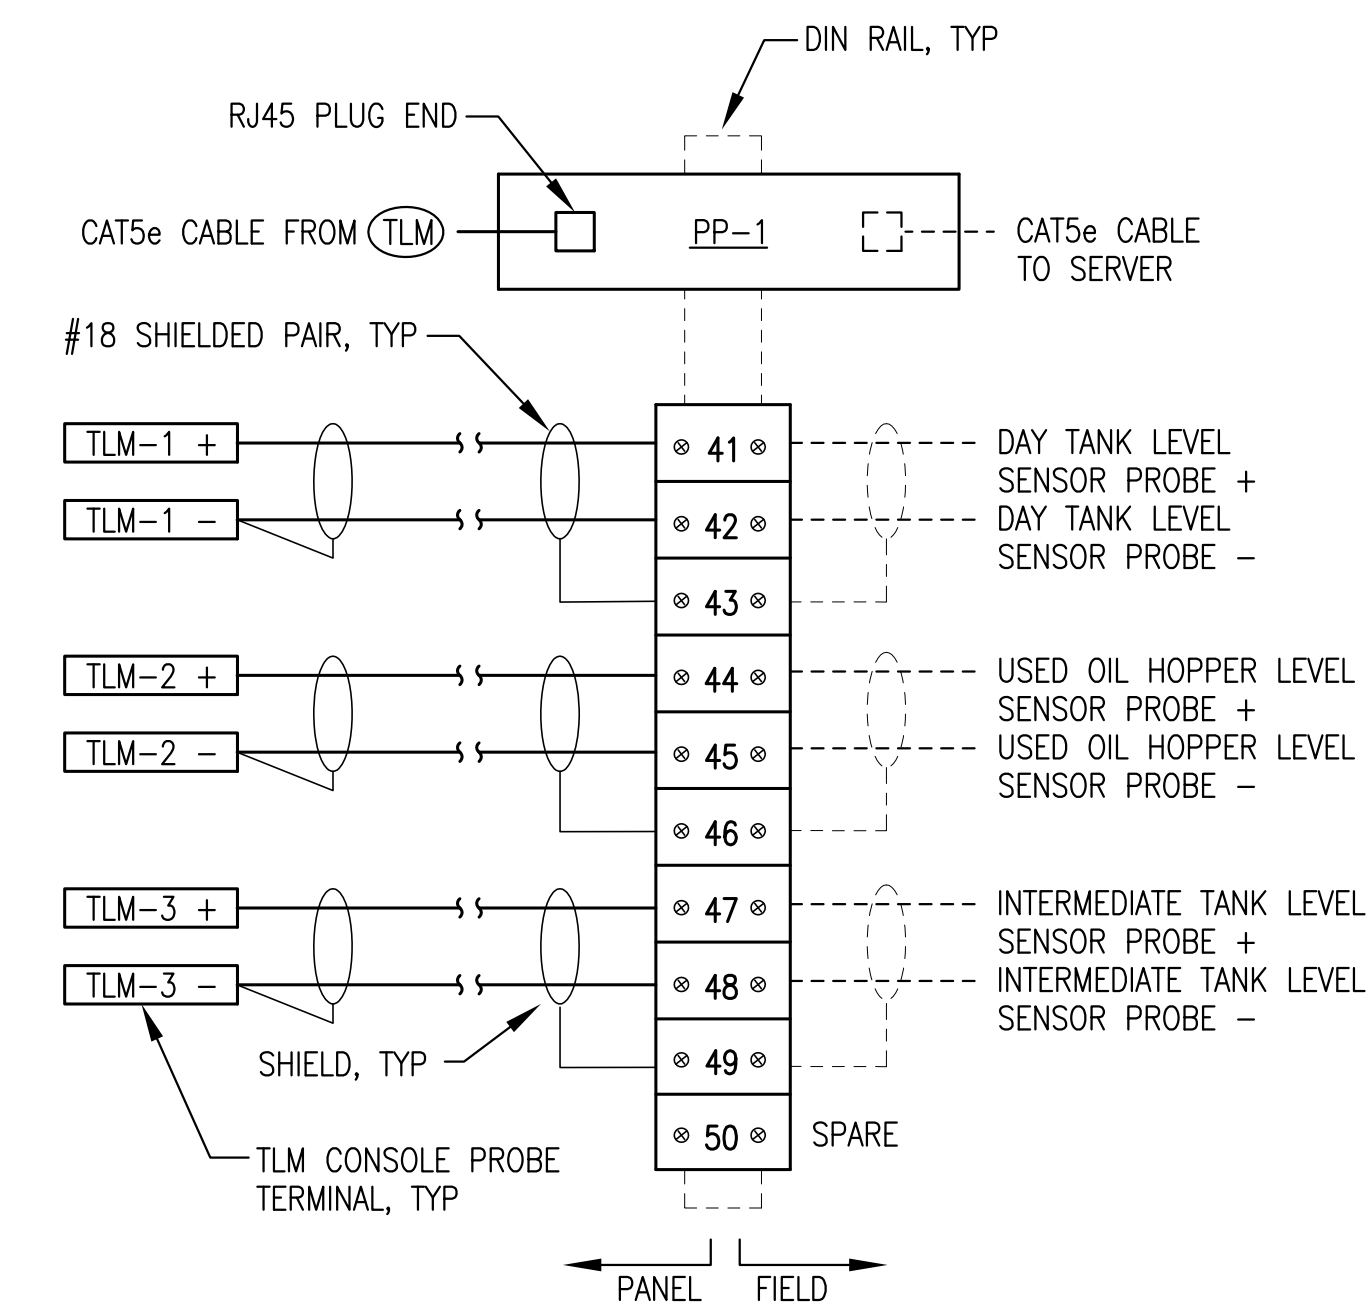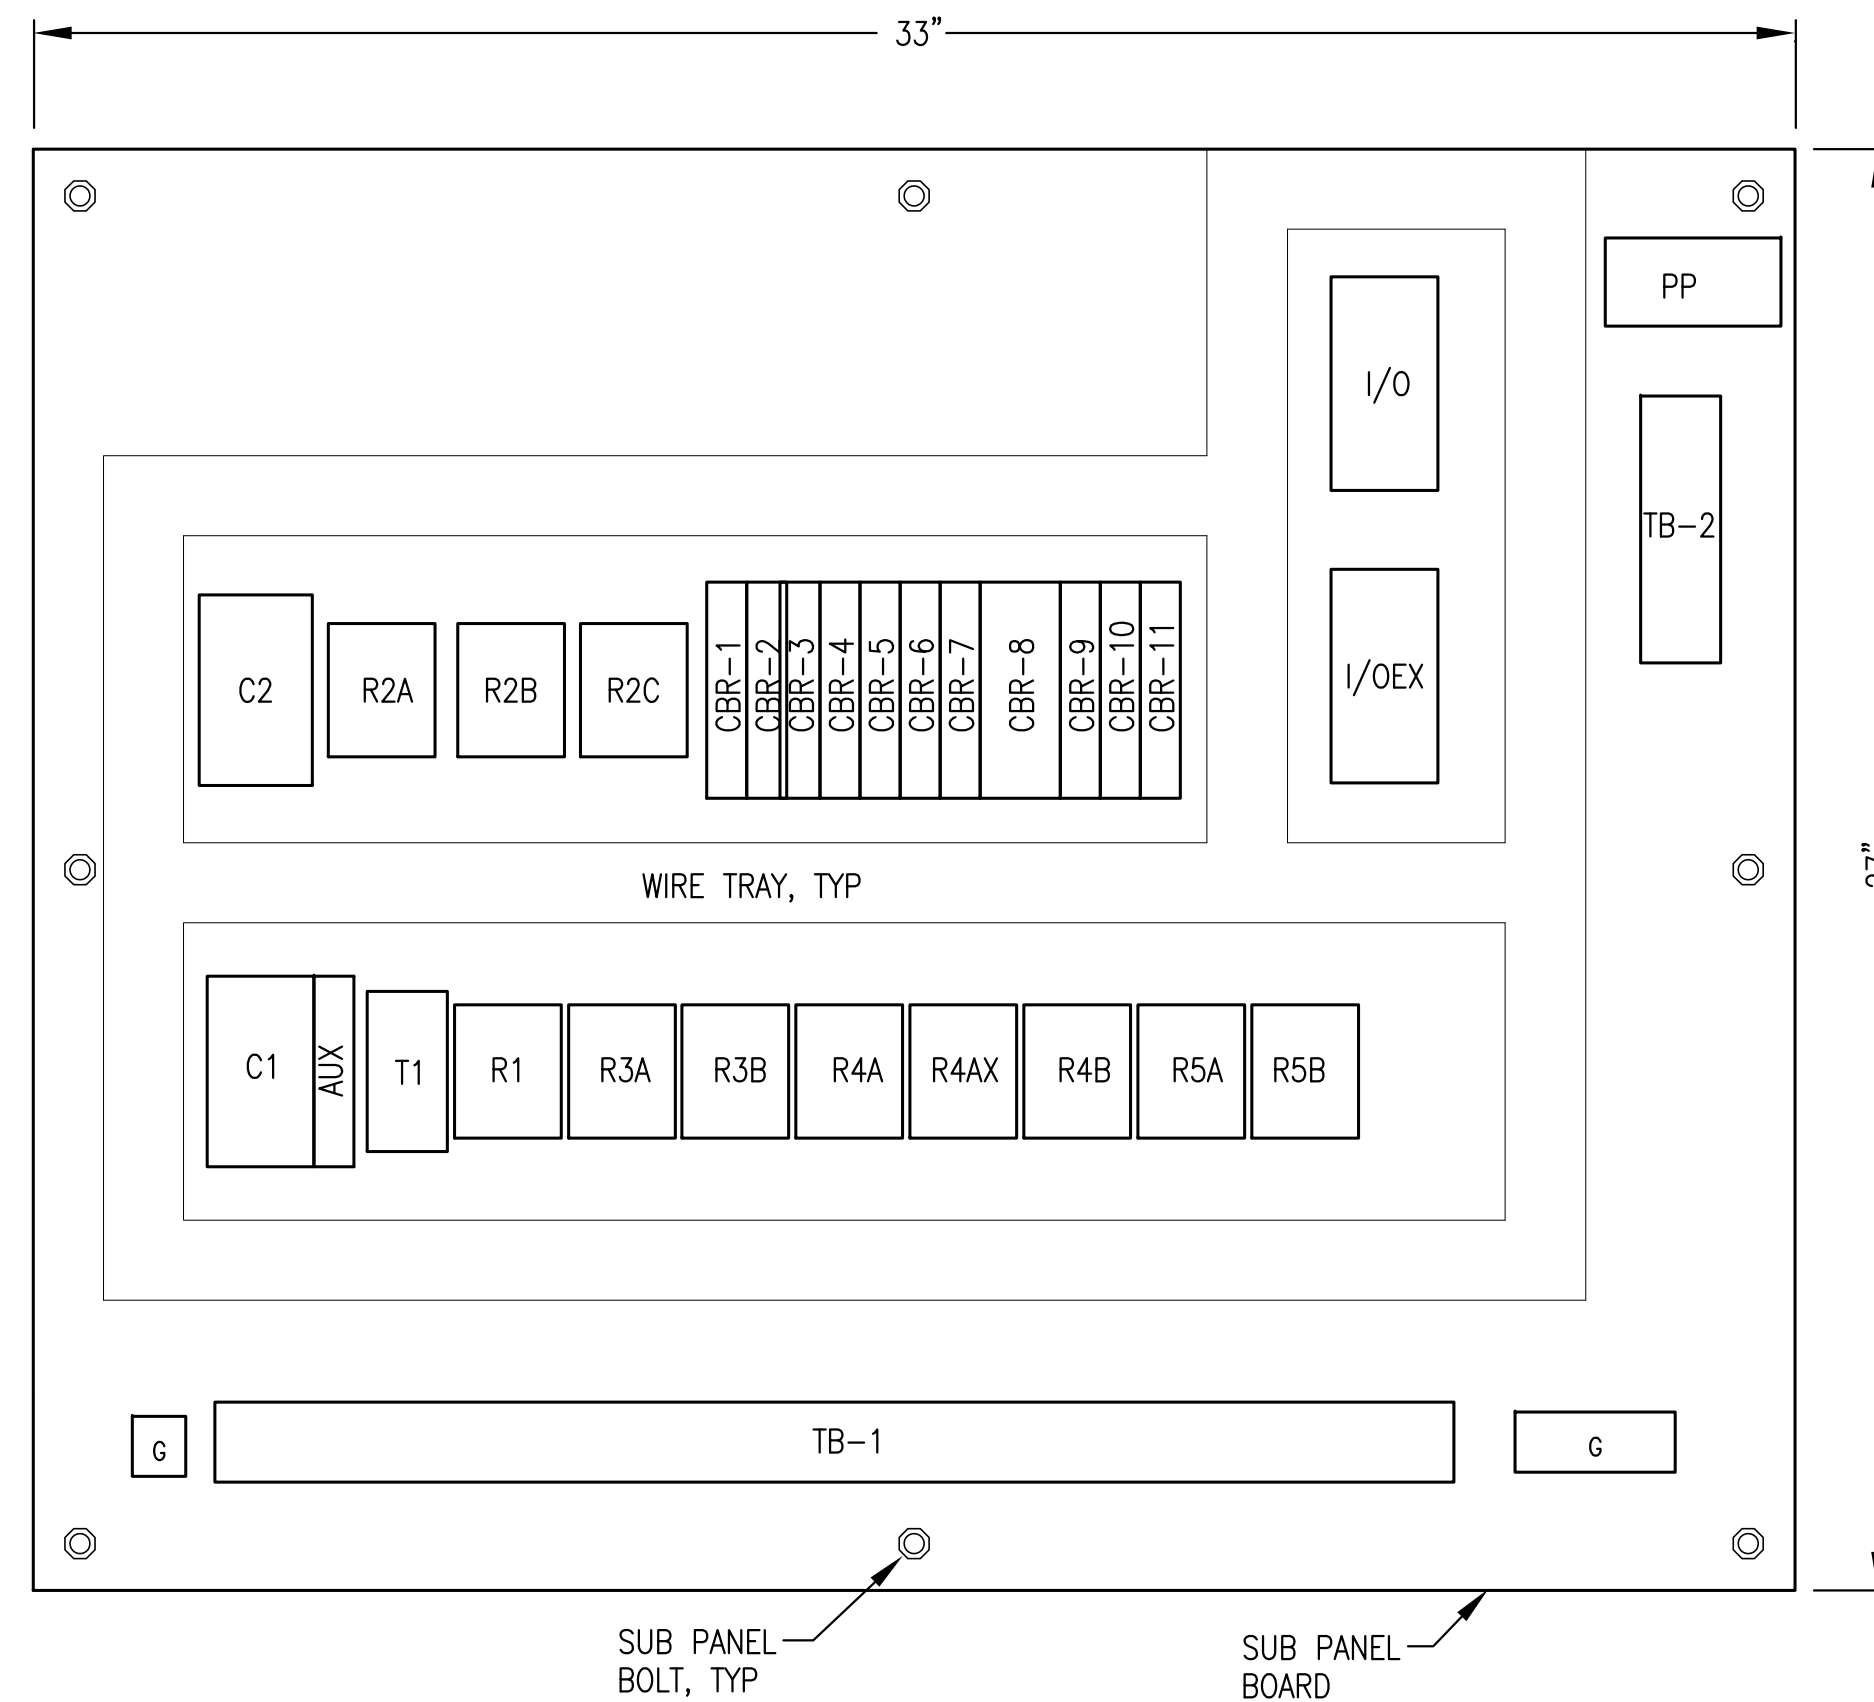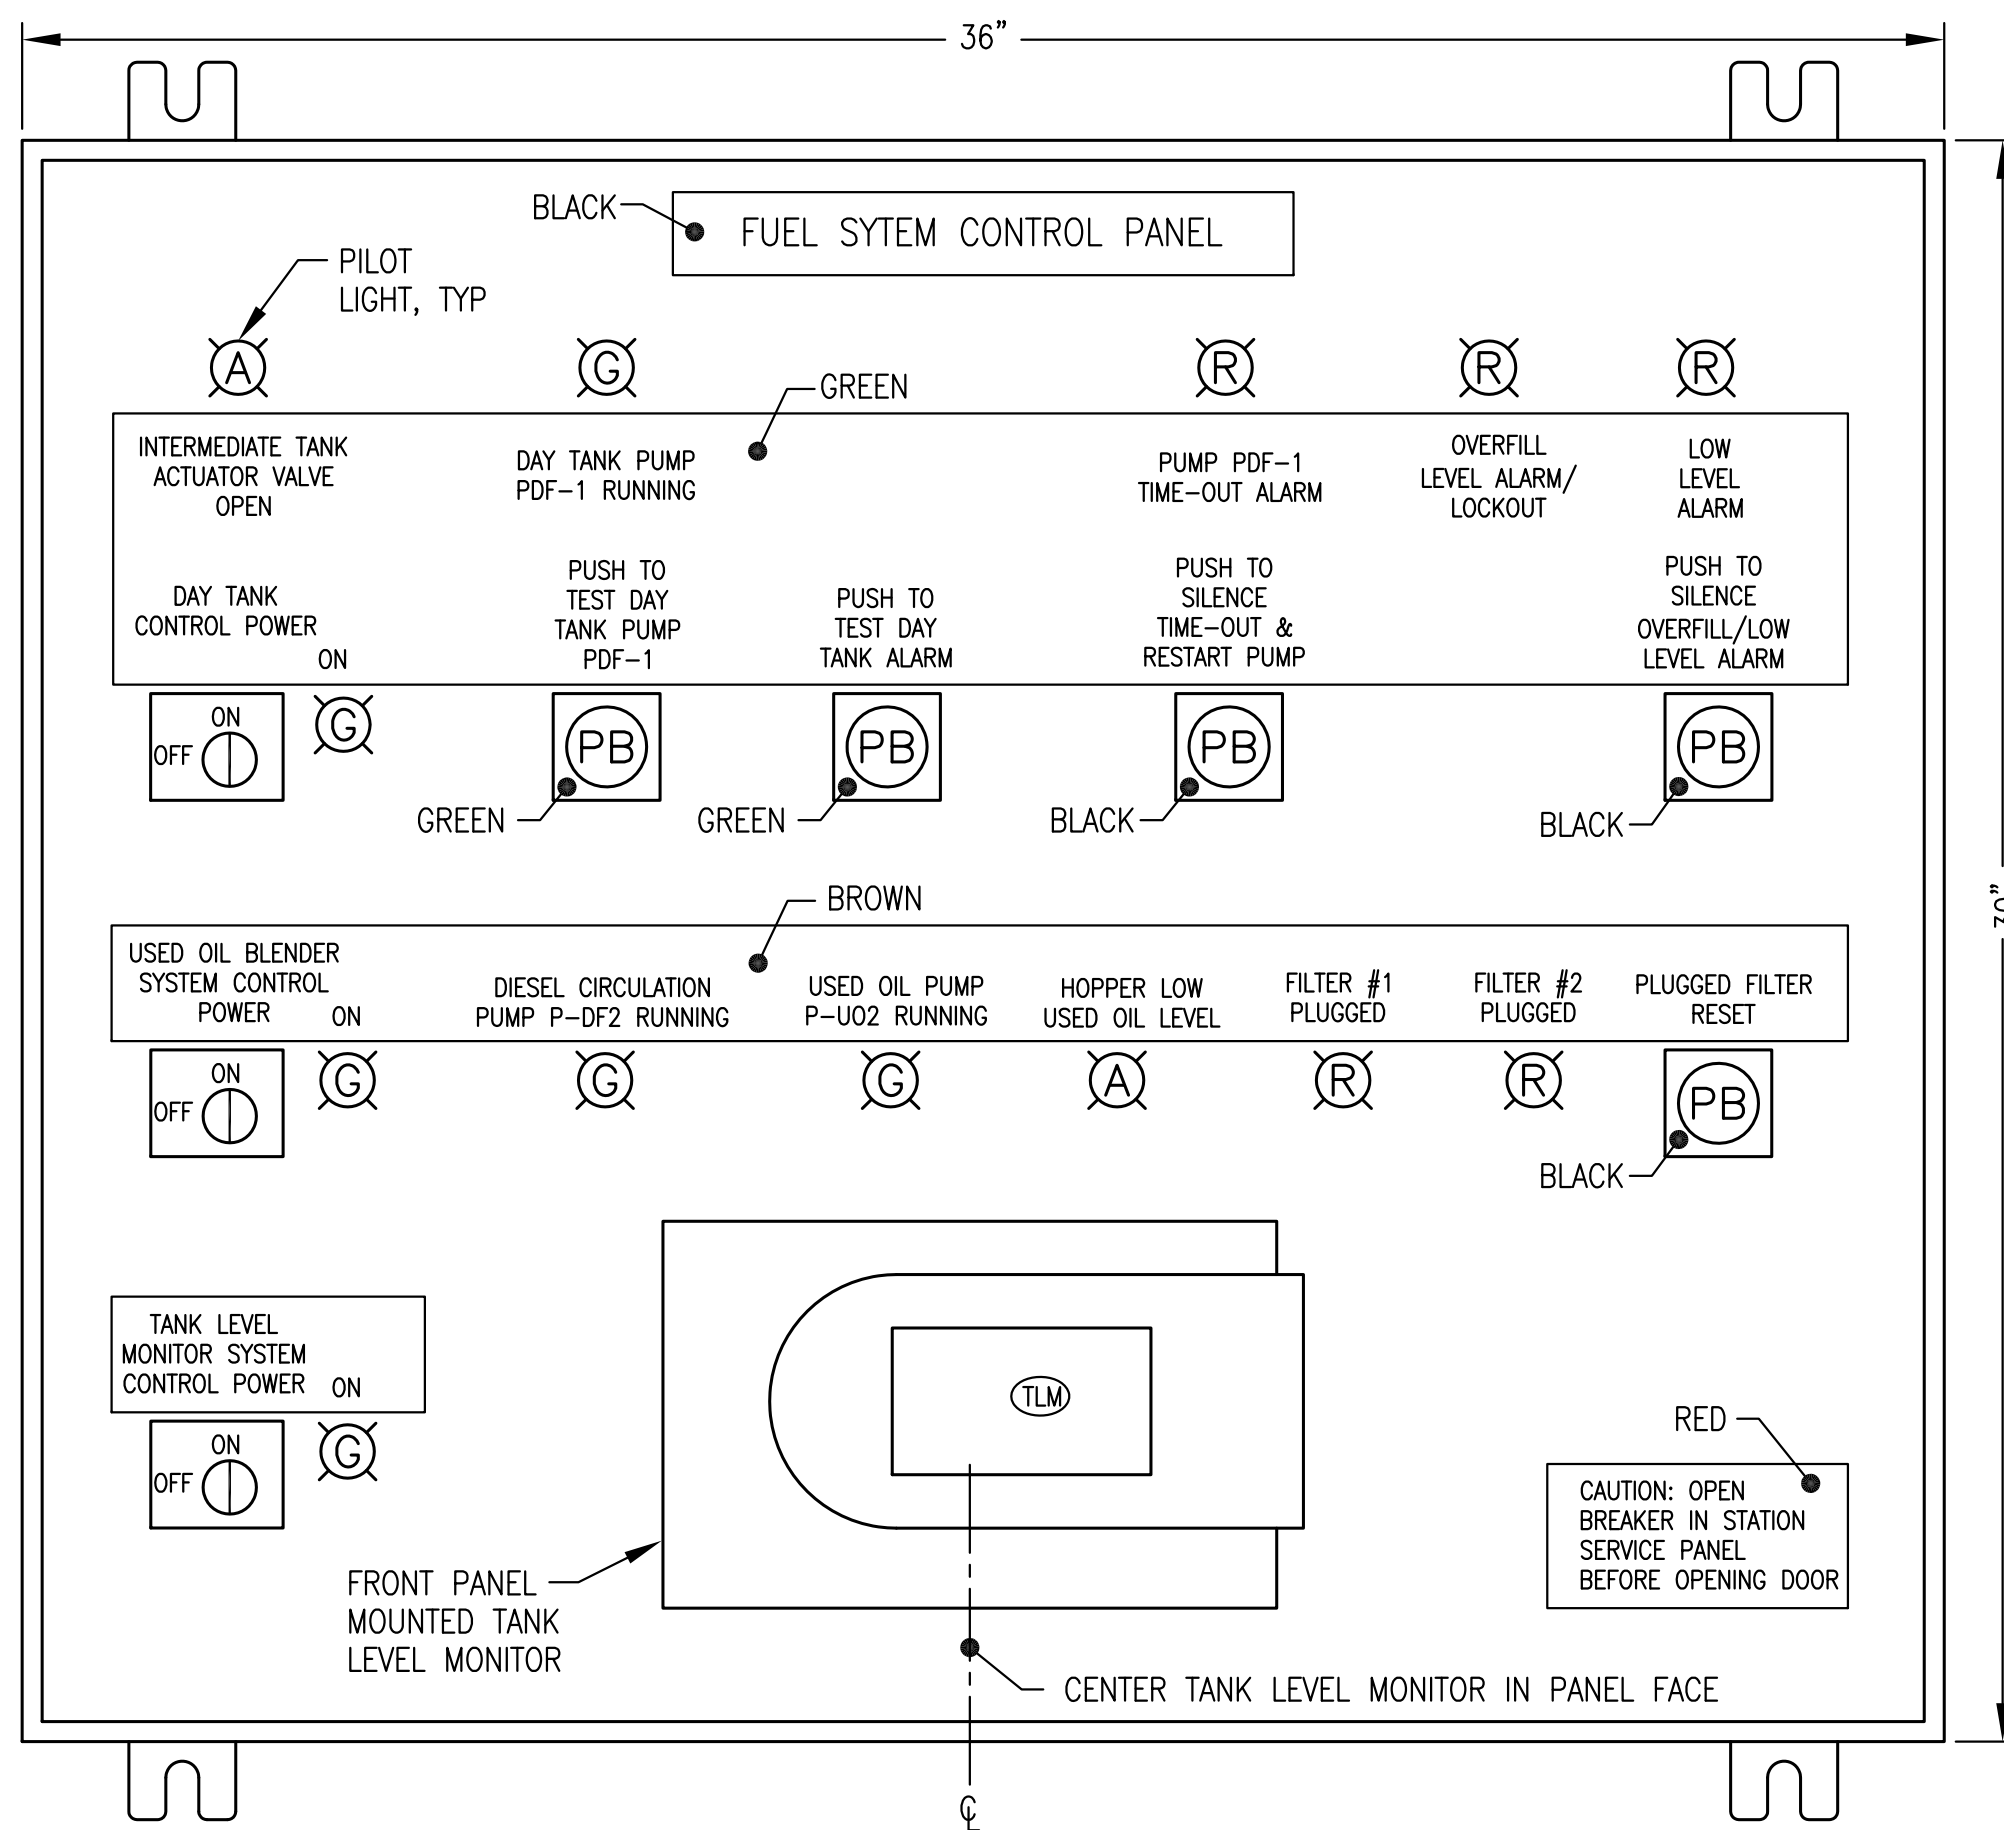


NOTES:

- INSTALL TERMINAL STRIP TB-2 AND ETHERNET PATCH PANEL PP-1 ON VERTICAL DIN RAIL AS SHOWN. LOCATE TERMINAL STRIP IN THE UPPER RIGHT CORNER OF PANEL TO ACCOMMODATE CONDUCTOR ENTRY THROUGH RIGHT SIDE OF PANEL, SEE SUB-PANEL LAYOUT.

1 FRONT PANEL LAYOUT
E7.2 NO SCALE

2 SUB PANEL LAYOUT
E7.2 NO SCALE

3 TB-2 TERM STRIP & PP-1 ENTHERNET PANEL LAYOUT
E7.2 NO SCALE

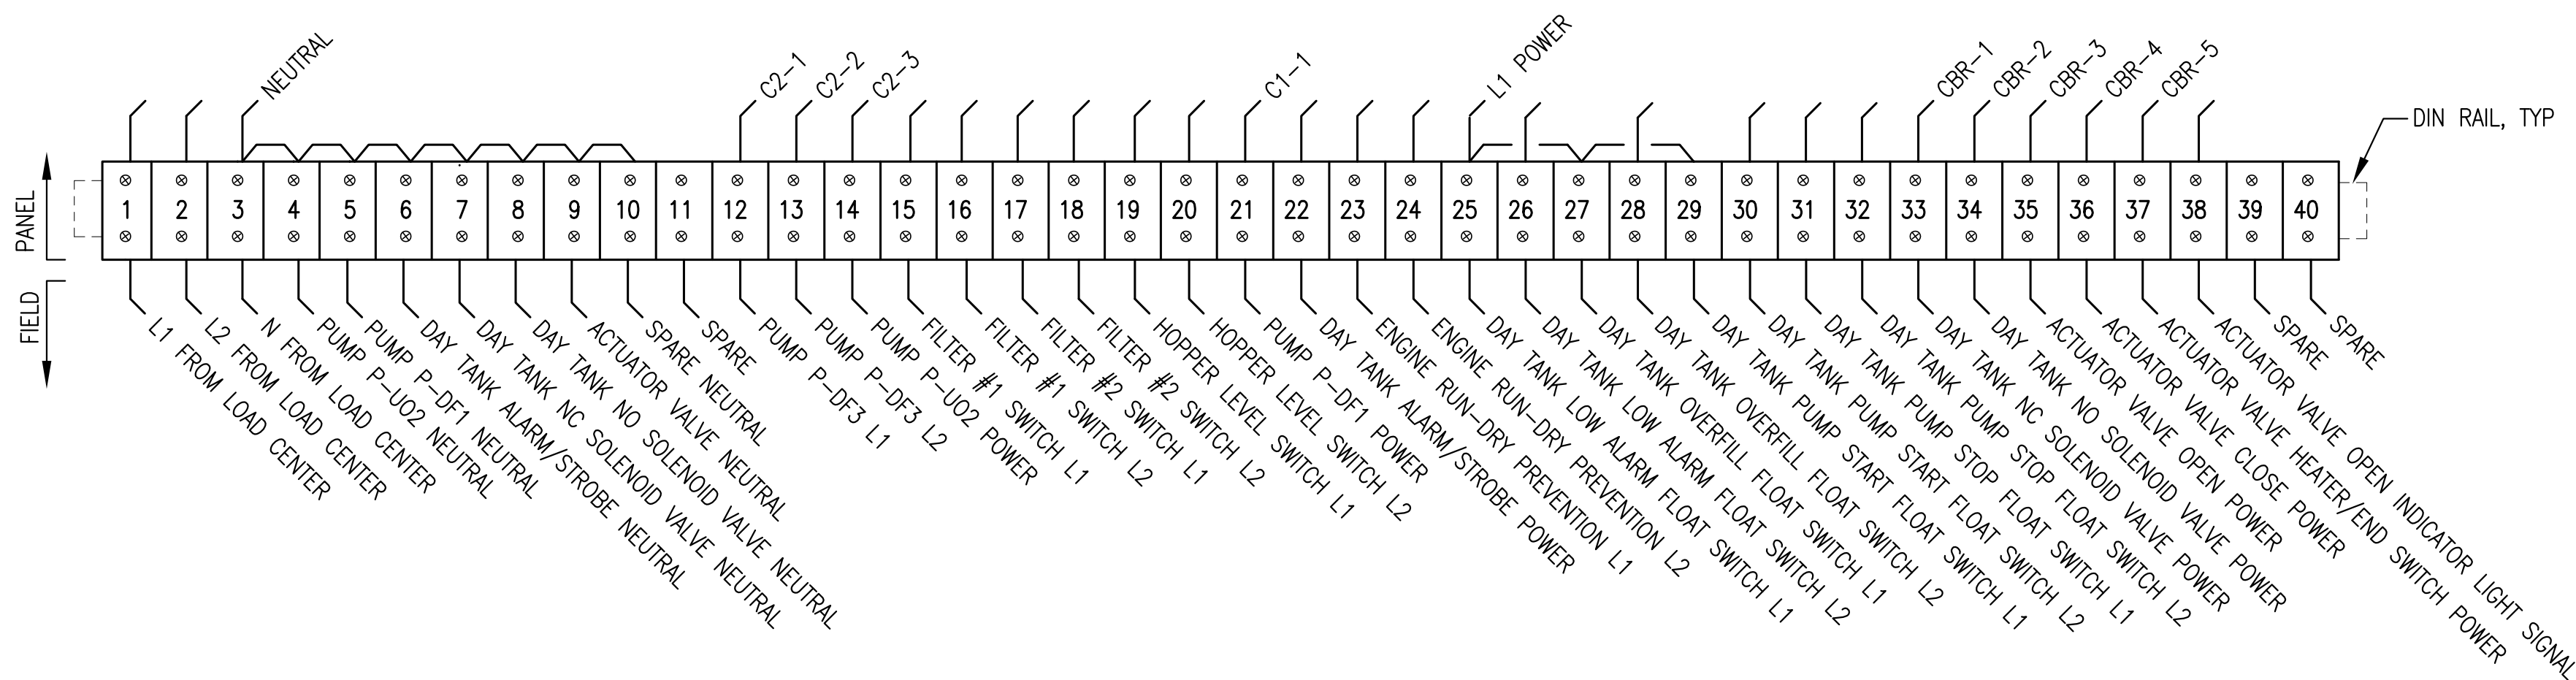

NOTES:

- INSTALL TERMINAL STRIP TB-1 ON HORIZONTAL DIN RAIL AS SHOWN. LOCATE TERMINAL STRIP BELOW PANEL DEVICES TO ACCOMMODATE CONDUCTOR ROUTING FROM CONDUITS CONNECTING TO BOTTOM OF PANEL, SEE SUB-PANEL LAYOUT.
- IN ADDITION TO THE TERMINAL STRIPS SHOWN, PROVIDE 6 EACH 35A SCREW TERMINAL GROUNDING BUS.

4 TB-1 TERMINAL STRIP LAYOUT
E7.2 NO SCALE




Gray Stassel Engineering, Inc.
P.O. 111405
Anchorage, AK 99511
(907)949-0100

STATE OF ALASKA, AIDEA/AEA
RURAL POWER SYSTEM UPGRADE
CLARKS POINT POWER PLANT
CLARKS POINT, ALASKA

REVISIONS	DESCRIPTION
REV DATE	

VERIFY SCALES
0 1"
THIS BAR REPRESENTS ONE INCH ON ORIGINAL DRAWING

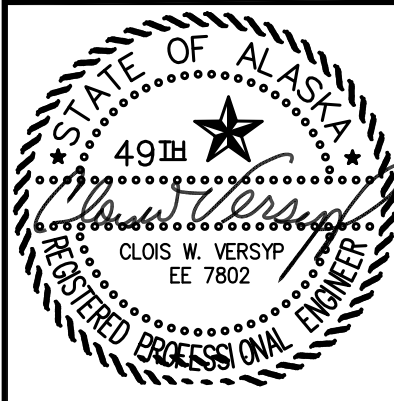

DATE: 1/14/19
DRAWN BY: JTD
CHECKED BY: CWV/BCG
JOB NUMBER:

DRAWING TITLE:
FUEL SYSTEM CONTROL PANEL LAYOUT & TERMINAL STRIPS

E7.2
SHEET OF 7

ISSUED FOR CONSTRUCTION JANUARY 2019

PANEL NOTES:

- 1) PROVIDE COMPLETE LISTED PANEL ASSEMBLY WITH ALL DEVICES INDICATED IN LOGIC DIAGRAM EXCEPT FOR FIELD DEVICES. INSTALL IN A NEMA 12 ENCLOSURE WITH 4 EACH INTEGRAL MOUNTING LUGS AT BACK. SEE SHEET E7.2 FOR PANEL LAYOUT DETAILS.
- 2) USE MIN #12 WIRE FOR ALL CIRCUITS UP TO FIRST IN-LINE PANEL BREAKERS (FOR 20A FEED). USE MIN #16 AWG ON ALL 5 AMP CIRCUITS AND MIN #14 AWG WIRE ON ALL 15A CIRCUITS. TAG EACH END OF ALL JUMPERS WITH DEVICE OR TERMINATION DESIGNATOR OF LANDING OF OPPOSITE END OF JUMPER (REVERSE ADDRESS).
- 3) LABEL ALL PANEL DEVICES ON BASE OR BACK PANEL ADJACENT TO ITEM. LABEL REMOTE EQUIPMENT CONNECTIONS AT EACH TERMINAL BLOCK BY THE ITEM TITLE AS SHOWN ON THE FIELD SIDE OF THE TERMINAL STRIP DRAWING. PROVIDE BEVELED EDGE WHITE CORE NAMEPLATES AS SHOWN ON THE PANEL FACE LAYOUT AND SECURE TO PANEL FACE WITH A MINIMUM OF TWO STAINLESS STEEL MOUNTING SCREWS, COLOR AS INDICATED.
- 4) BENCH TEST COMPLETED UNIT. PROVIDE MIN 48 HOURS NOTICE TO ENGINEER TO SCHEDULE OBSERVATION OF BENCH TEST. PROVIDE SWITCHES AND LAMPS TO SIMULATE OPERATION OF ALL FIELD DEVICES.
- 5) DEVICES AND WIRING NOTED AS "FIELD" AND SHOWN WITH DASHED LINES WILL BE FIELD INSTALLED AND ARE NOT PART OF THE PANEL SHOP FABRICATION. FOR BENCH TEST, PROVIDE TEMPORARY DEVICES AND WIRING AS REQUIRED TO SIMULATE FIELD DEVICES.
- 6) POWER TO PANEL PROVIDED FROM DEDICATED 20A 2-POLE CIRCUIT BREAKER IN LISTED LOAD CENTER. SEE FIELD INSTALLATION NOTE #3.

FIELD INSTALLATION NOTES:


- 1) SEE MECHANICAL FOR DAY TANK INSTALLATION & PIPING. INSTALL CONTROL PANEL & FIELD DEVICES AS INDICATED TO PROVIDE REDUNDANT HIGH & LOW LIMIT CONTROLS & OVERFILL PROTECTION.
- 2) FIELD WIRING TO FLOAT SWITCHES, SOLENOID VALVES, ACTUATOR VALVE, & ALARM HORN #14 AWG. ALL OTHER FIELD WIRING #12 AWG. LABEL BOTH ENDS OF ALL CONDUCTORS WITH CONTROL PANEL TERMINAL BLOCK TERMINATION NUMBERS. WHEN NOT IN CONDUIT, MAKE JACKETED COM CABLE ENCLOSURE ENTRIES WITH CABLE GLAND CONNECTORS.
- 3) PERFORM ALL FIELD WIRING IN ACCORDANCE WITH ELECTRICAL SPECIFICATIONS ON SHEET E2. PROVIDE POWER TO DAY TANK PANEL FROM DEDICATED 20A 2-POLE CIRCUIT BREAKER IN STATION SERVICE PANELBOARD.
- 4) VERIFY THAT ALL FLOAT SWITCHES ARE ORIENTED FOR N.C. (OPEN ON RISE) OPERATION PRIOR TO INSTALLATION. ALL FLOATS SHOWN ON LOGIC DIAGRAM WITH TANK AT FULL (PUMP STOP) LEVEL.
- 5) FILL PUMP CAVITIES WITH LUBE OIL PRIOR TO INITIAL OPERATION. VERIFY PROPER ROTATION OF PUMPS. PRIME SYSTEM WITH HAND PRIMING PUMP PRIOR TO BEGINNING DAY TANK FILL.
- 6) FIELD TEST COMPLETED UNIT TO VERIFY ALL CONTROL AND ALARM FUNCTIONS. MANIPULATE FLOAT SWITCHES BY REACHING IN THROUGH ADJACENT 4" BUNG. TEMPORARILY SET TIMING RELAY TO 30 SECONDS TO VERIFY TIME-OUT AND RESET FUNCTIONS.
- 7) SET TIMING RELAY TIME DELAY TO 30 MINUTES (APPROX. 55 GALS. REQUIRED FROM PUMP START TO PUMP STOP LEVEL @ APPROX. 4 GPM). ON THE INITIAL TANK FILL, THE PUMP TEST/RESET BUTTON MAY HAVE TO BE MANUALLY RESET IN ORDER TO GET THE FUEL LEVEL TO WITHIN THE NORMAL OPERATING RANGE. SEE SEQUENCE OF OPERATIONS.

DAY TANK FILL SEQUENCE OF OPERATIONS:

- 1) WHEN THE DAY TANK CIRCUIT BREAKER AND CONTROL POWER SWITCH ARE CLOSED, THE POWER LIGHT IS ON AND POWER IS PROVIDED TO THE REMOTE ACTUATOR VALVE HEATER/OVEN LIGHT CIRCUIT.
- 2) WHEN THE DAY TANK IS NOT CALLING FOR FUEL, POWER IS PROVIDED TO THE REMOTE ACTUATOR VALVE CLOSE CIRCUIT. WHEN THE ACTUATOR IS IN THE FULLY CLOSED POSITION, THE CLOSING CIRCUIT IS BROKEN BY INTERNAL ACTUATOR LIMIT SWITCH #2 AND THE REMOTE ACTUATOR VALVE "OPEN" LIGHT IS OFF.
- 3) NORMAL FILL OPERATION - WHEN THE FUEL LEVEL DROPS TO THE "PUMP START" SWITCH, THE TIMER IS STARTED, THE N.C. DAY TANK SOLENOID VALVE OPENS, THE REMOTE ACTUATOR VALVE OPENS & THE VALVE "OPEN" LIGHT TURNS ON, THE DAY TANK SOLENOID VALVE CLOSES, THE VALVE "OPEN" LIGHT TURNS OFF, AND THE USED OIL BLENDER RUN SIGNAL DRY CONTACT CLOSURES. WHEN THE ACTUATOR IS IN THE FULLY OPEN POSITION, THE OPENING CIRCUIT IS BROKEN BY INTERNAL ACTUATOR LIMIT SWITCH #7 AND THE REMOTE ACTUATOR VALVE "OPEN" LIGHT REMAINS ON. WHEN FUEL REACHES THE "PUMP STOP" FLOAT SWITCH BEFORE THE TIMER TIMES-OUT, THE TIMER IS RESET, THE N.C. DAY TANK SOLENOID VALVE AND REMOTE ACTUATOR VALVE CLOSE, THE REMOTE ACTUATOR VALVE "OPEN" LIGHT TURNS OFF, THE PUMP DE-ENERGIZES, THE PUMP "ON" LIGHT TURNS OFF, AND THE USED OIL BLENDER RUN SIGNAL DRY CONTACT OPENS.
- 4) TIMER OPERATION - IF THE TIMER TIMES-OUT THE N.C. DAY TANK SOLENOID VALVE AND REMOTE ACTUATOR VALVE CLOSE, THE REMOTE ACTUATOR VALVE "OPEN" LIGHT TURNS OFF, THE PUMP DE-ENERGIZES, THE PUMP "ON" LIGHT TURNS OFF, THE USED OIL BLENDER RUN SIGNAL DRY CONTACT OPENS, THE "TIME-OUT" ALARM LIGHT TURNS ON, AND THE TIME-OUT ALARM HORN SOUNDS. PRESSING THE "TIME-OUT ALARM SILENCE / PUMP RESTART" BUTTON RESETS THE TIMER, SILENCES THE ALARM HORN, AND STARTS THE NORMAL FILL OPERATION. SEE FIELD INSTALLATION NOTES FOR TIMER SETTING.
- 5) OVERFILL FUEL LEVEL - IF THE TANK OVERFILLS AND THE FUEL LEVEL REACHES THE "OVERFILL" FLOAT SWITCH, THE N.O. DAY TANK SOLENOID VALVE CLOSES, THE "OVERFILL LEVEL" ALARM LIGHT TURNS ON, THE N.C. DAY TANK SOLENOID VALVE AND REMOTE ACTUATOR VALVE CLOSE, THE VALVE "OPEN" LIGHT TURNS OFF, THE PUMP DE-ENERGIZES, THE PUMP "ON" LIGHT TURNS OFF, THE USED OIL BLENDER RUN SIGNAL DRY CONTACT OPENS, THE "OVERFILL LEVEL" ALARM LIGHT TURNS ON, AND THE ALARM HORN SOUNDS. PRESSING THE LEVEL ALARM HORN "SILENCE" BUTTON SILENCES THE ALARM HORN WHILE LEAVING THE "OVERFILL LEVEL" ALARM LIGHT ON. WHEN THE FUEL LEVEL FALLS BELOW THE "OVERFILL" FLOAT SWITCH, THE "OVERFILL LEVEL" ALARM LIGHT TURNS OFF, THE N.O. DAY TANK SOLENOID VALVE OPENS AND THE ALARM HORN TURNS OFF (IF NOT PREVIOUSLY SILENCED). WHEN THE FUEL LEVEL REACHES THE "PUMP START" FLOAT SWITCH, THE NORMAL FILL OPERATION IS REPEATED.
- 6) LOW FUEL LEVEL - IF THE FUEL LEVEL FALLS BELOW THE "LOW ALARM" FLOAT SWITCH, THE "LOW FUEL LEVEL" ALARM LIGHT TURNS ON, THE ENGINE RUN-DRY PREVENTION DRY CONTACT OPENS, AND THE ALARM HORN SOUNDS. THE LEVEL ALARM HORN "SILENCE" BUTTON SILENCES THE ALARM HORN WHILE LEAVING THE "LOW FUEL LEVEL" ALARM LIGHT ON. WHEN THE FUEL LEVEL RISES ABOVE THE "LOW ALARM" FLOAT SWITCH THE "LOW FUEL LEVEL" ALARM LIGHT TURNS OFF, THE ENGINE RUN-DRY PREVENTION DRY CONTACT CLOSURES, AND THE ALARM HORN TURNS OFF (IF NOT PREVIOUSLY SILENCED).
- 7) PUMP & HORN TEST - MOMENTARY CONTACT BUTTONS ARE PROVIDED TO TEST FUNCTION OF THE DAY TANK PUMP AND ALARM HORN. PRESSING THE "PUSH TO TEST DAY TANK PUMP" BUTTON STARTS THE TIMER, MOMENTARILY OPENS THE N.C. DAY TANK SOLENOID VALVE & ACTUATED BALL VALVE, ENERGIZES THE DAY TANK PUMP, TURNS ON THE DAY TANK PUMP "RUNNING" LIGHT AND CLOSURES THE USED OIL BLENDER RUN SIGNAL DRY CONTACT. THE "PUSH TO TEST DAY TANK PUMP" BUTTON IS LOCKED OUT IF THE DAY TANK IS AT THE OVERFILL LEVEL. PRESSING THE "PUSH TO TEST DAY TANK ALARM" BUTTON MOMENTARILY ENERGIZES THE ALARM HORN/STROBE.

USED OIL BLENDER SYSTEM SEQUENCE OF OPERATIONS:


- 1) WHEN THE BLENDER CIRCUIT BREAKER AND CONTROL POWER SWITCH ARE CLOSED; THE GREEN POWER LIGHT IS ON AND POWER IS PROVIDED TO ALL CONTROL DEVICES.
- 2) NORMAL OPERATION - WHENEVER THE DAY TANK FILL SEQUENCE IS INITIATED, BOTH THE DIESEL CIRCULATING PUMP P-DF2 AND THE USED OIL INJECTION PUMP P-U02 RUN AND THE ASSOCIATED GREEN PUMP RUNNING LIGHTS ARE ON.
- 3) PLUGGED FILTER - IF THE DIFFERENTIAL PRESSURE ACROSS A FILTER REACHES THE ALARM SETPOINT, BOTH PUMPS STOP RUNNING AND THE RED FILTER PLUGGED LIGHT FOR THE ASSOCIATED FILTER TURNS ON. THE ALARM LATCHES AND THE SYSTEM WILL NOT OPERATE UNTIL THE PROBLEM IS CORRECTED. AFTER THE FILTER ELEMENT HAS BEEN CHANGED THE BLACK RESET BUTTON MUST BE PRESSED TO RESUME NORMAL OPERATION.
- 4) HOPPER LOW OIL LEVEL - WHEN THE OIL LEVEL FALLS BELOW THE LOW LEVEL FLOAT SWITCH, BOTH PUMPS STOP RUNNING AND THE AMBER HOPPER LOW OIL LEVEL LIGHT TURNS ON. THE SYSTEM WILL NOT OPERATE UNTIL THE USED OIL LEVEL IN THE HOPPER RISES ABOVE THE LOW LEVEL. RESET IS NOT REQUIRED.

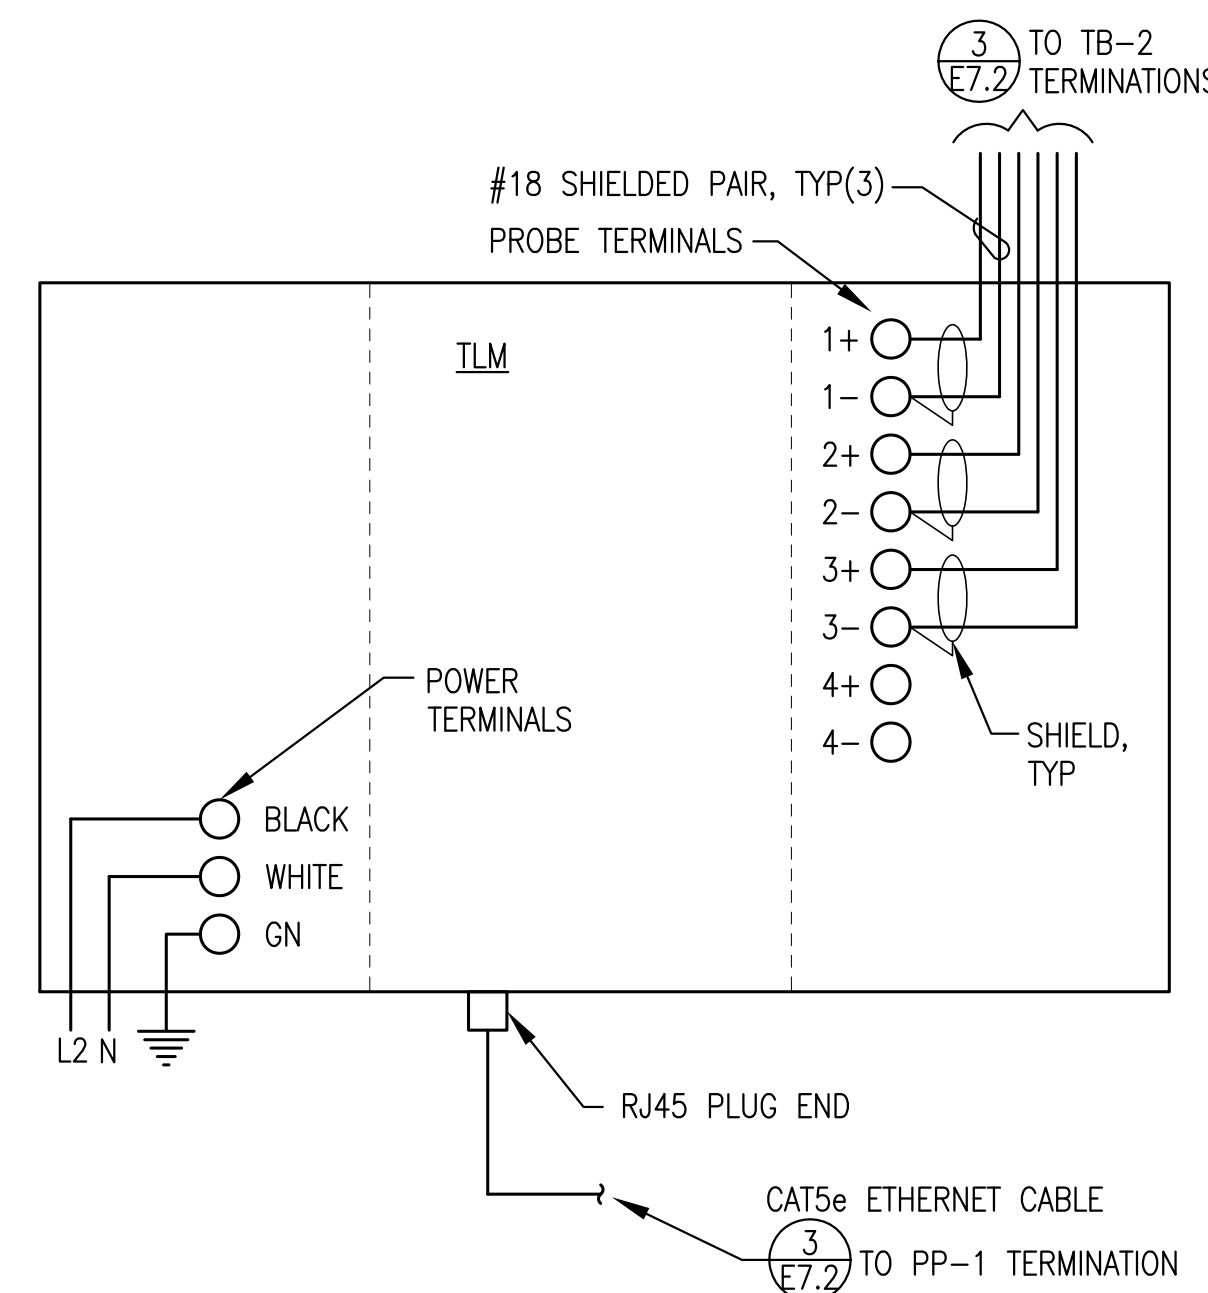

1 TANK LEVEL MONITOR (TLM) CONSOLE CONNECTIONS
NO SCALE

STRUT COLUMN EACH SIDE OF DAY TANK, FASTEN BASE TO TANK MOUNTED STRUT, FASTEN TOP TO CEILING


BOLT HORIZONTAL STRUT TO VERTICAL STRUT, TYP(2) & BOLT INTEGRAL PANEL MOUNTING LUGS TO HORIZONTAL STRUT, TYP(4)

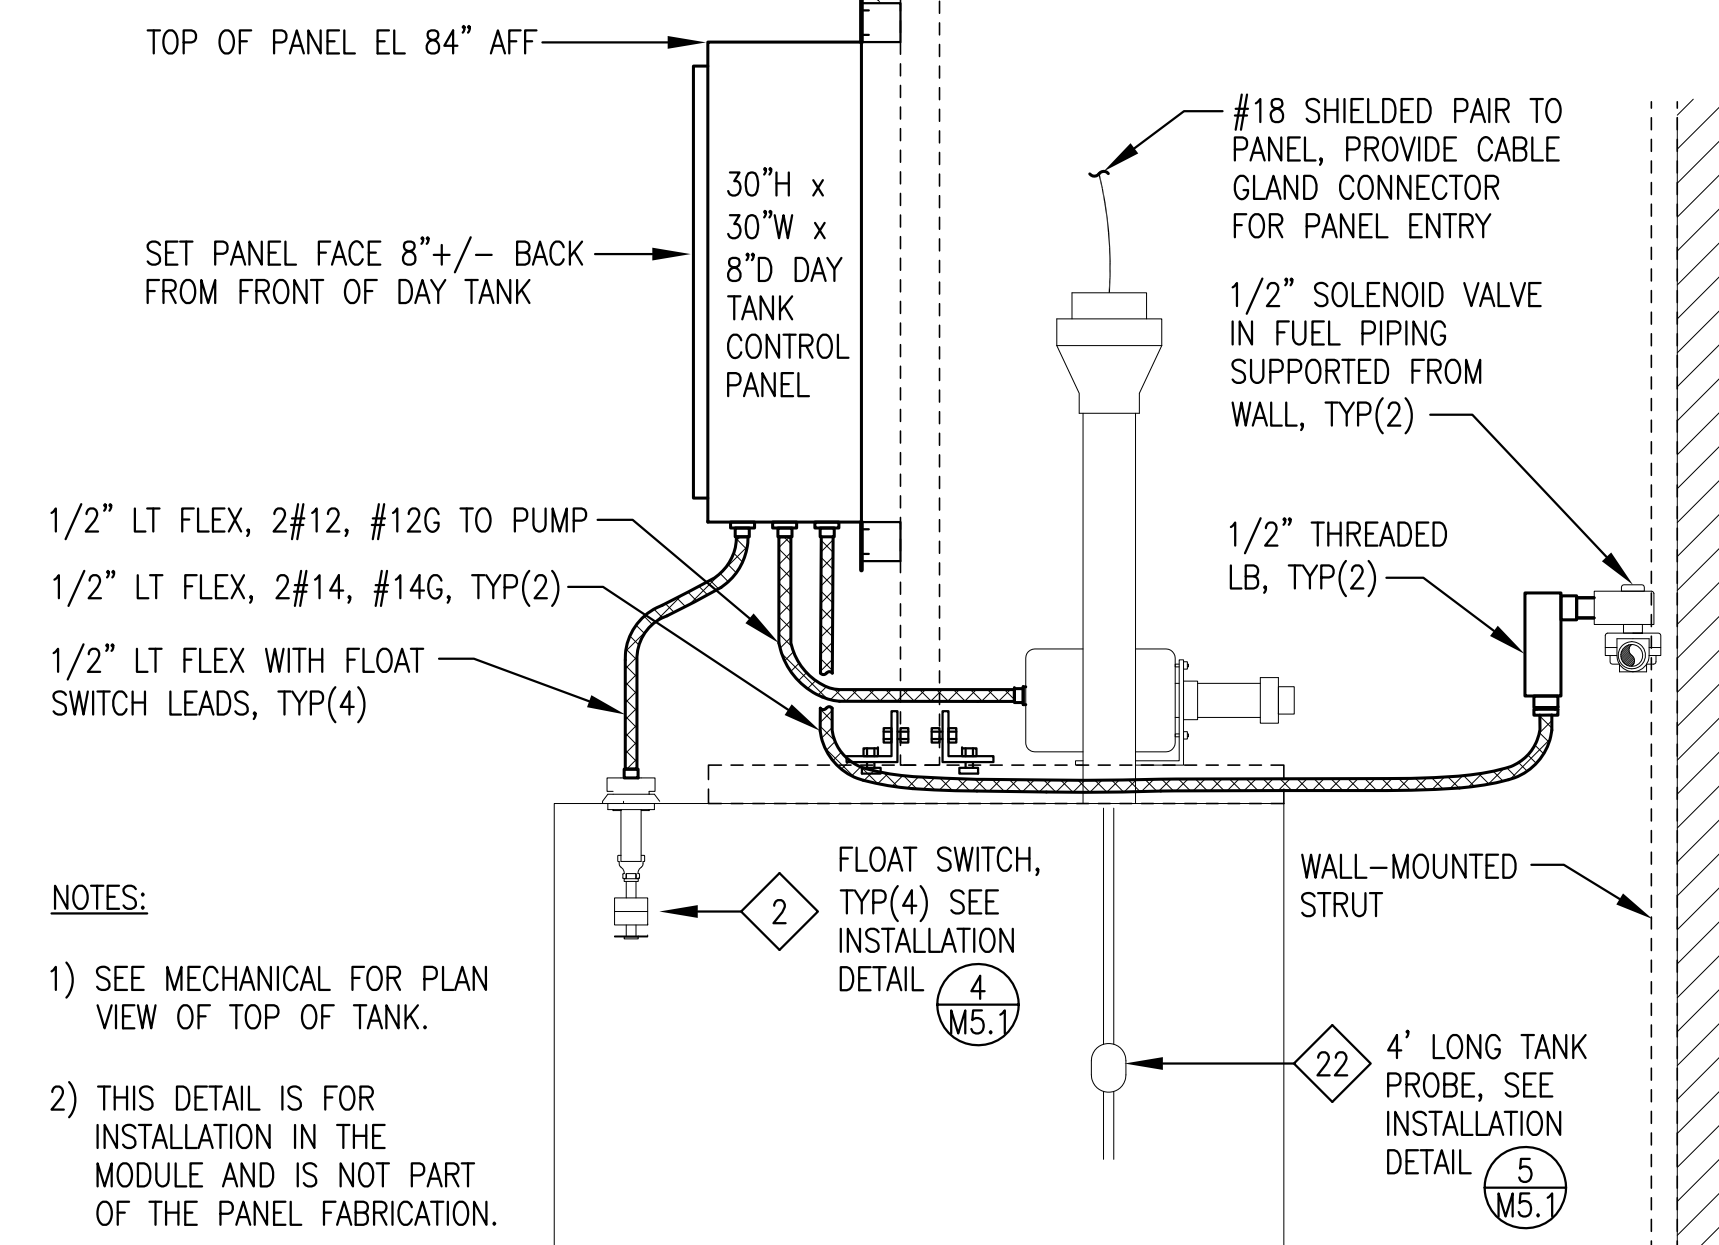


NOTES:

- 1) SEE MECHANICAL FOR PLAN VIEW OF TOP OF TANK.
- 2) THIS DETAIL IS FOR INSTALLATION IN THE MODULE AND IS NOT PART OF THE PANEL FABRICATION.

2 DAY TANK CONTROL PANEL & DEVICE INSTALLATION
NO SCALE

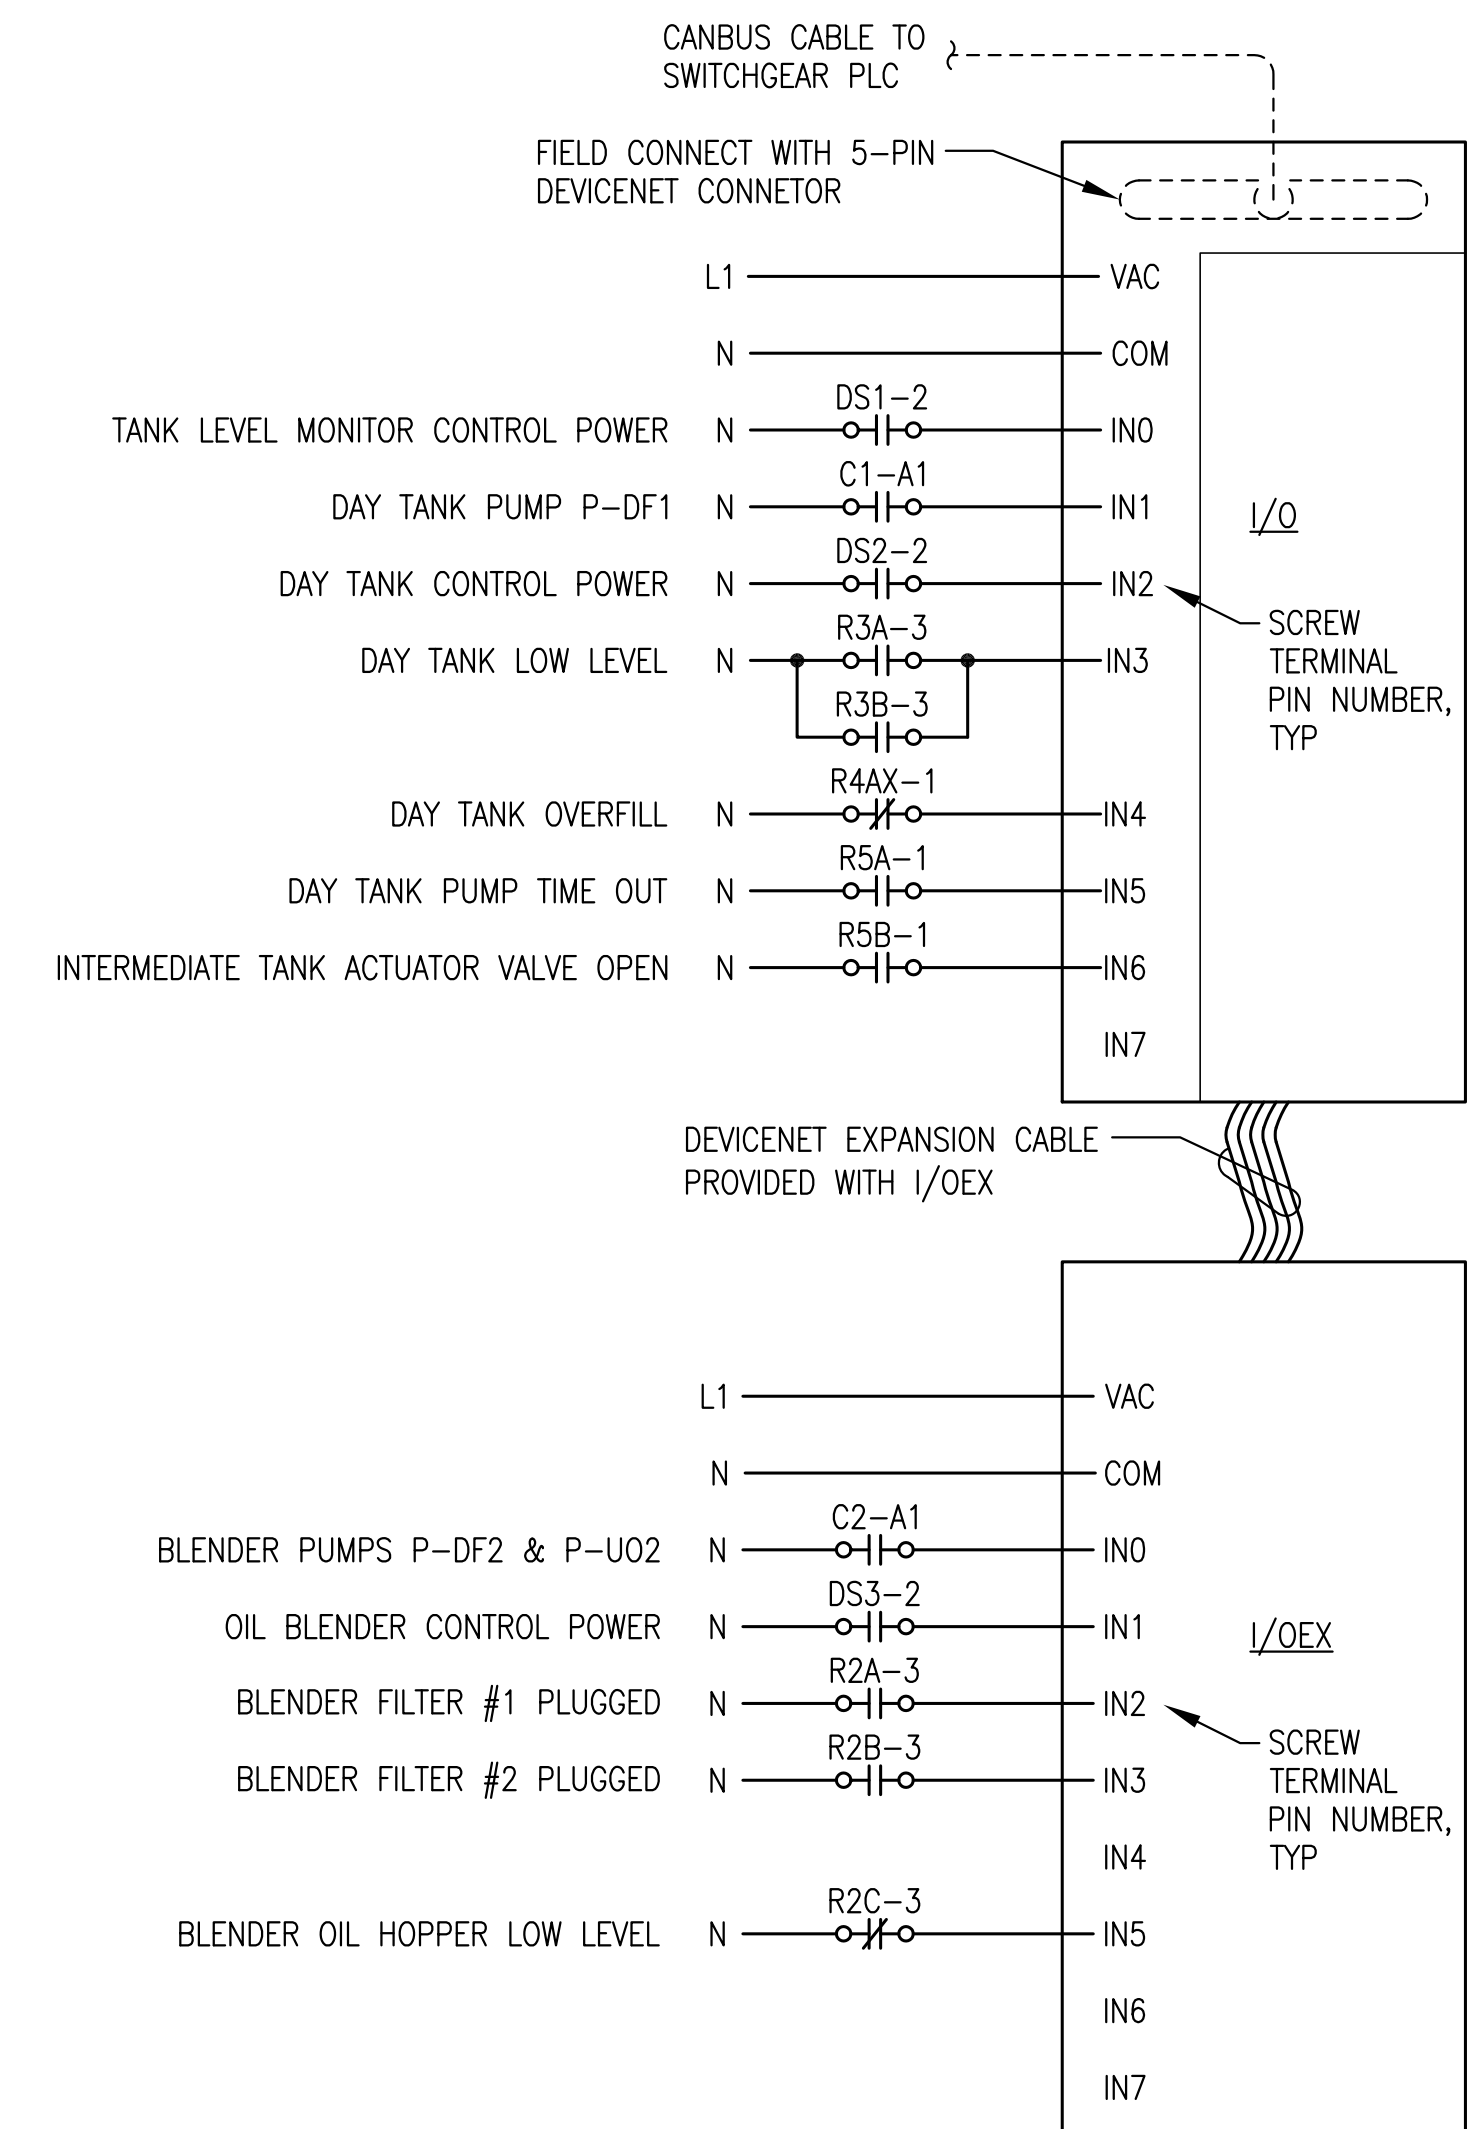

3 DEVICENET TERMINAL BLOCKS (I/O & I/OEX) CONNECTIONS
NO SCALE

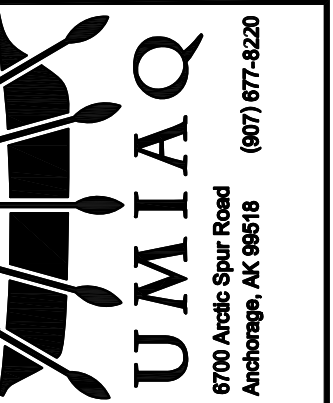

Gray Stassel Engineering, Inc.
P.O. 111405
Anchorage, AK 99511
(907)945-0100


STATE OF ALASKA, AIDEA/AEA RURAL POWER SYSTEM UPGRADE

CLARKS POINT POWER PLANT
CLARKS POINT, ALASKA

CONSTRUCTION DOCUMENTS

REVISIONS	DESCRIPTION
REV DATE	

VERIFY SCALES
0 1" THIS BAR REPRESENTS ONE INCH ON ORIGINAL DRAWING

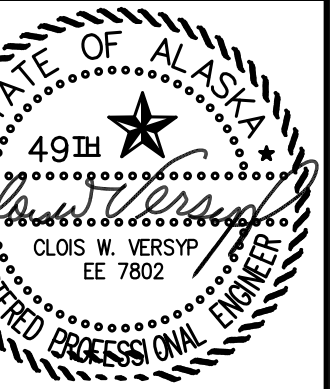


DATE: 1/14/19
DRAWN BY: JTD
CHECKED BY: CWV/BCG
JOB NUMBER:

DRAWING TITLE:
FUEL SYSTEM CONTROL PANEL SEQUENCE OF OPERATION & DETAILS


E7.3

SHEET OF 7

ISSUED FOR CONSTRUCTION JANUARY 2019

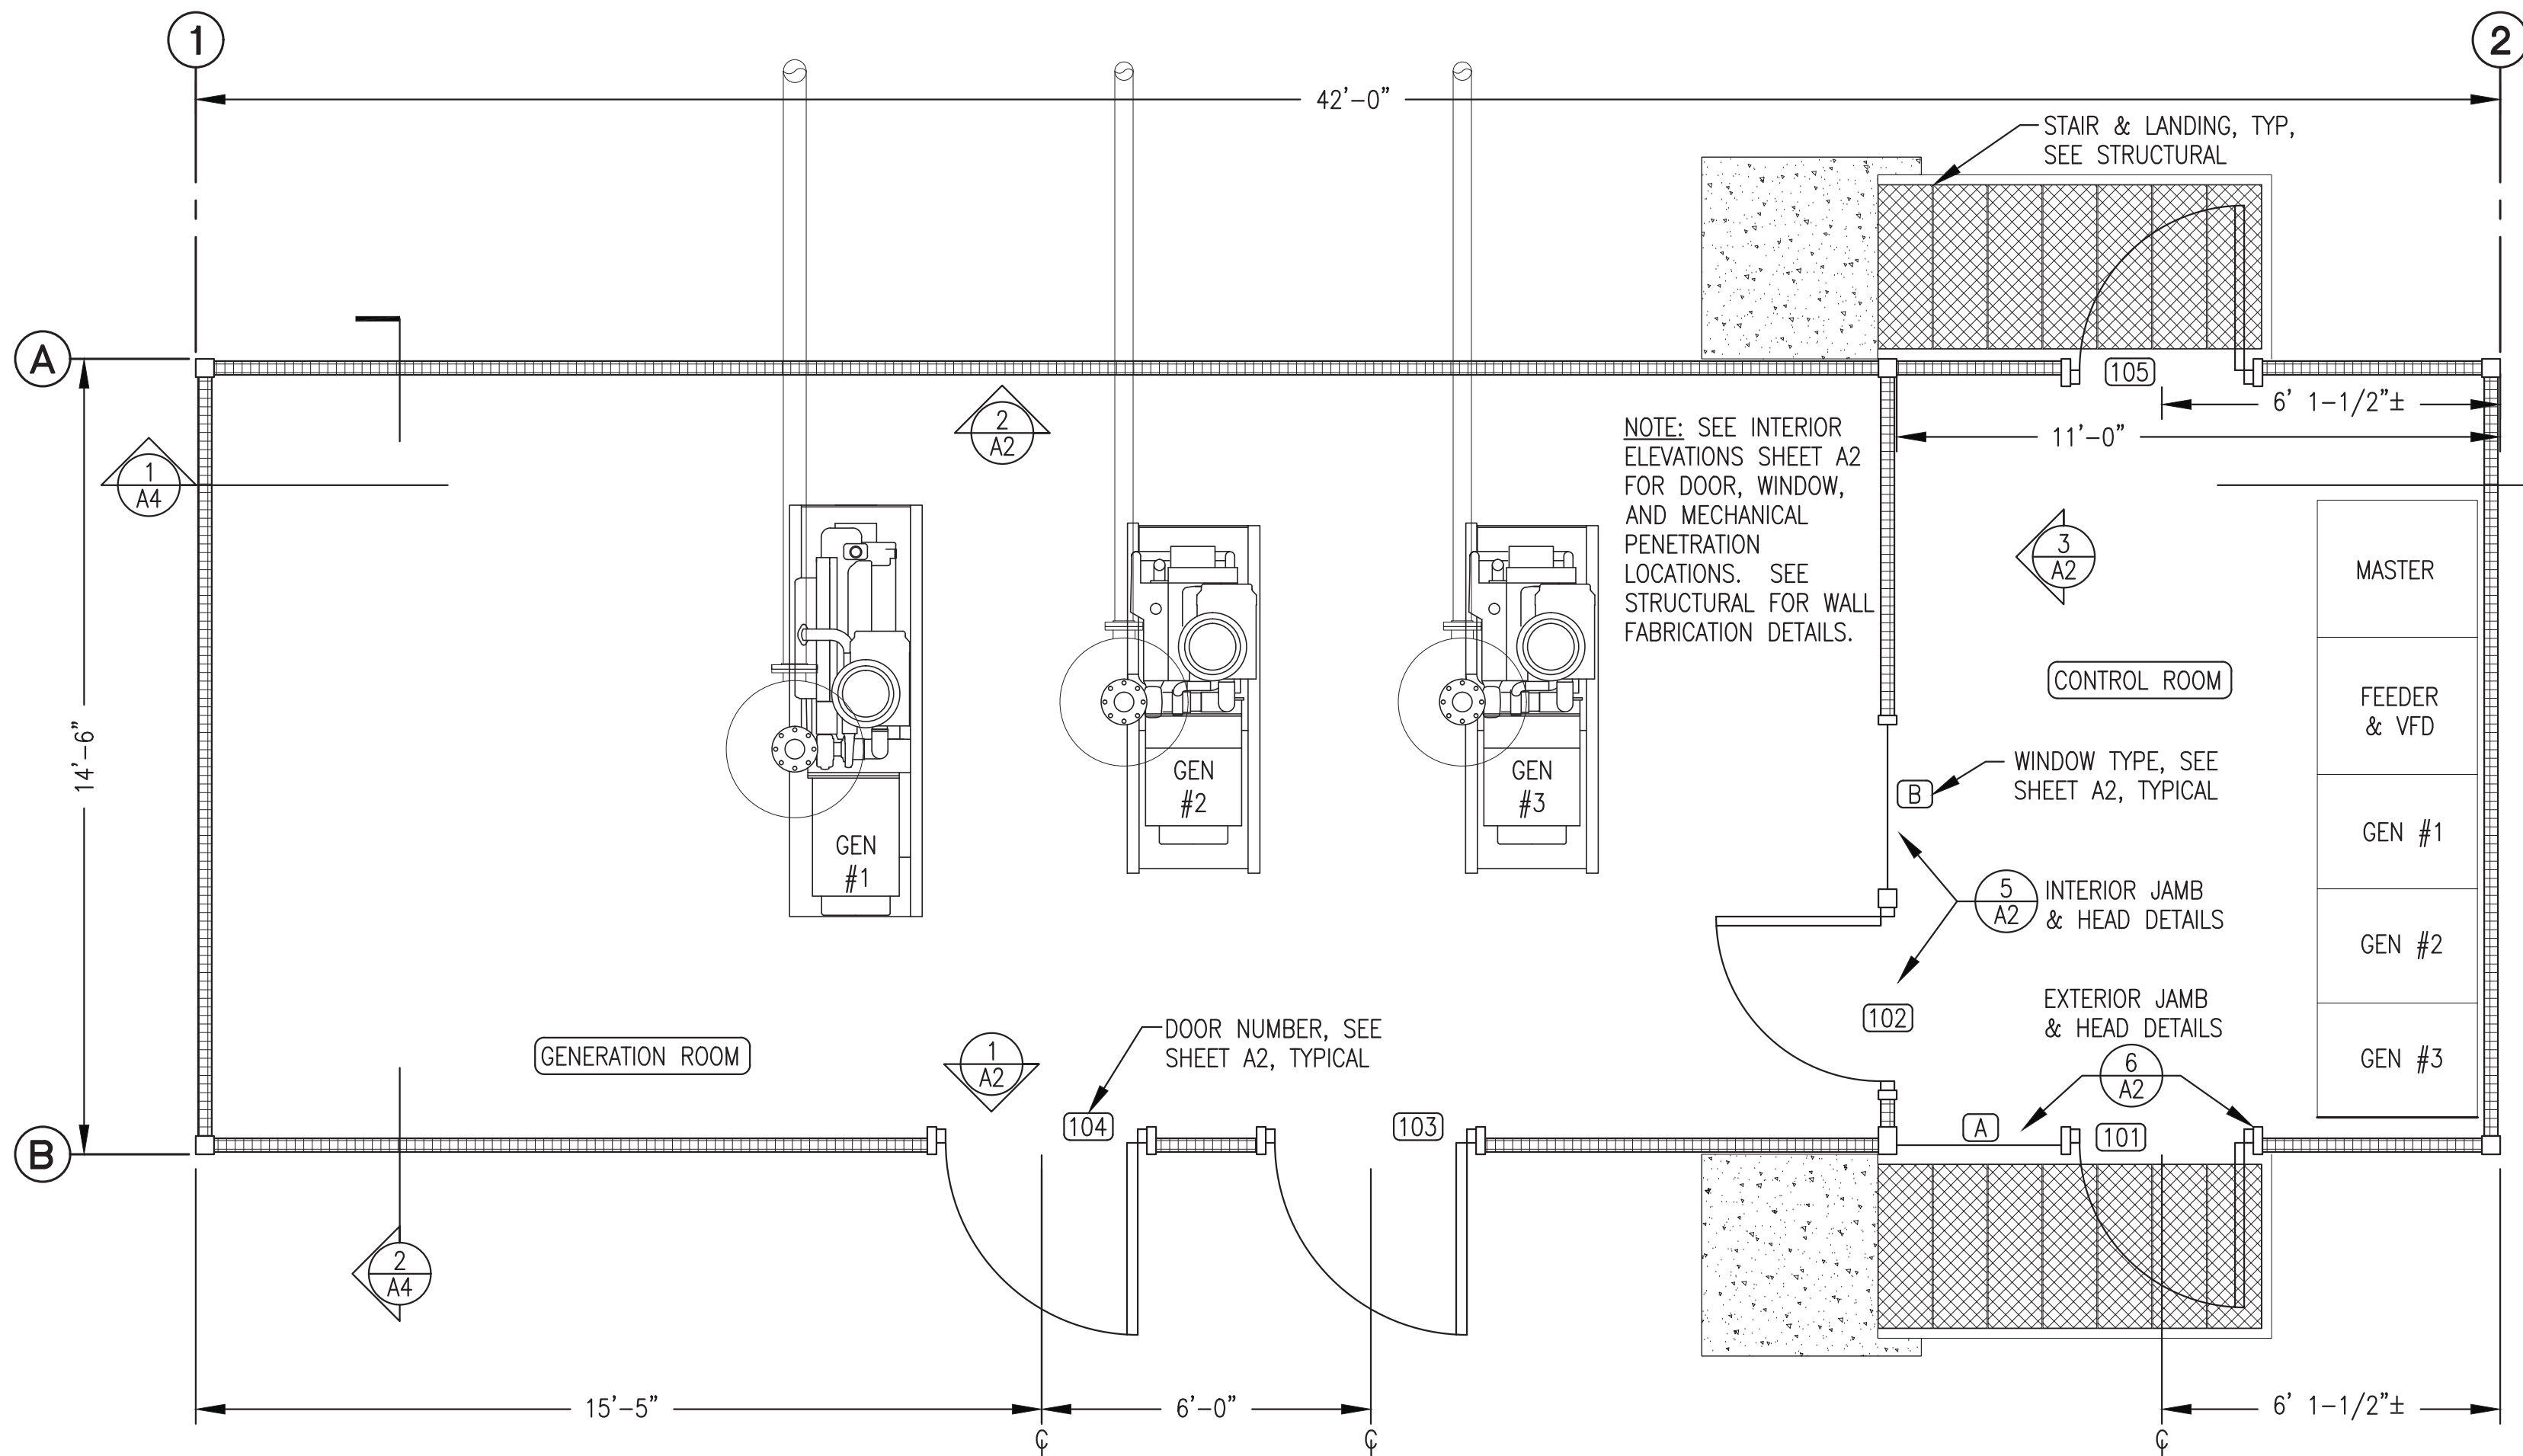

1 FLOOR PLAN
3/8"=1'-0"

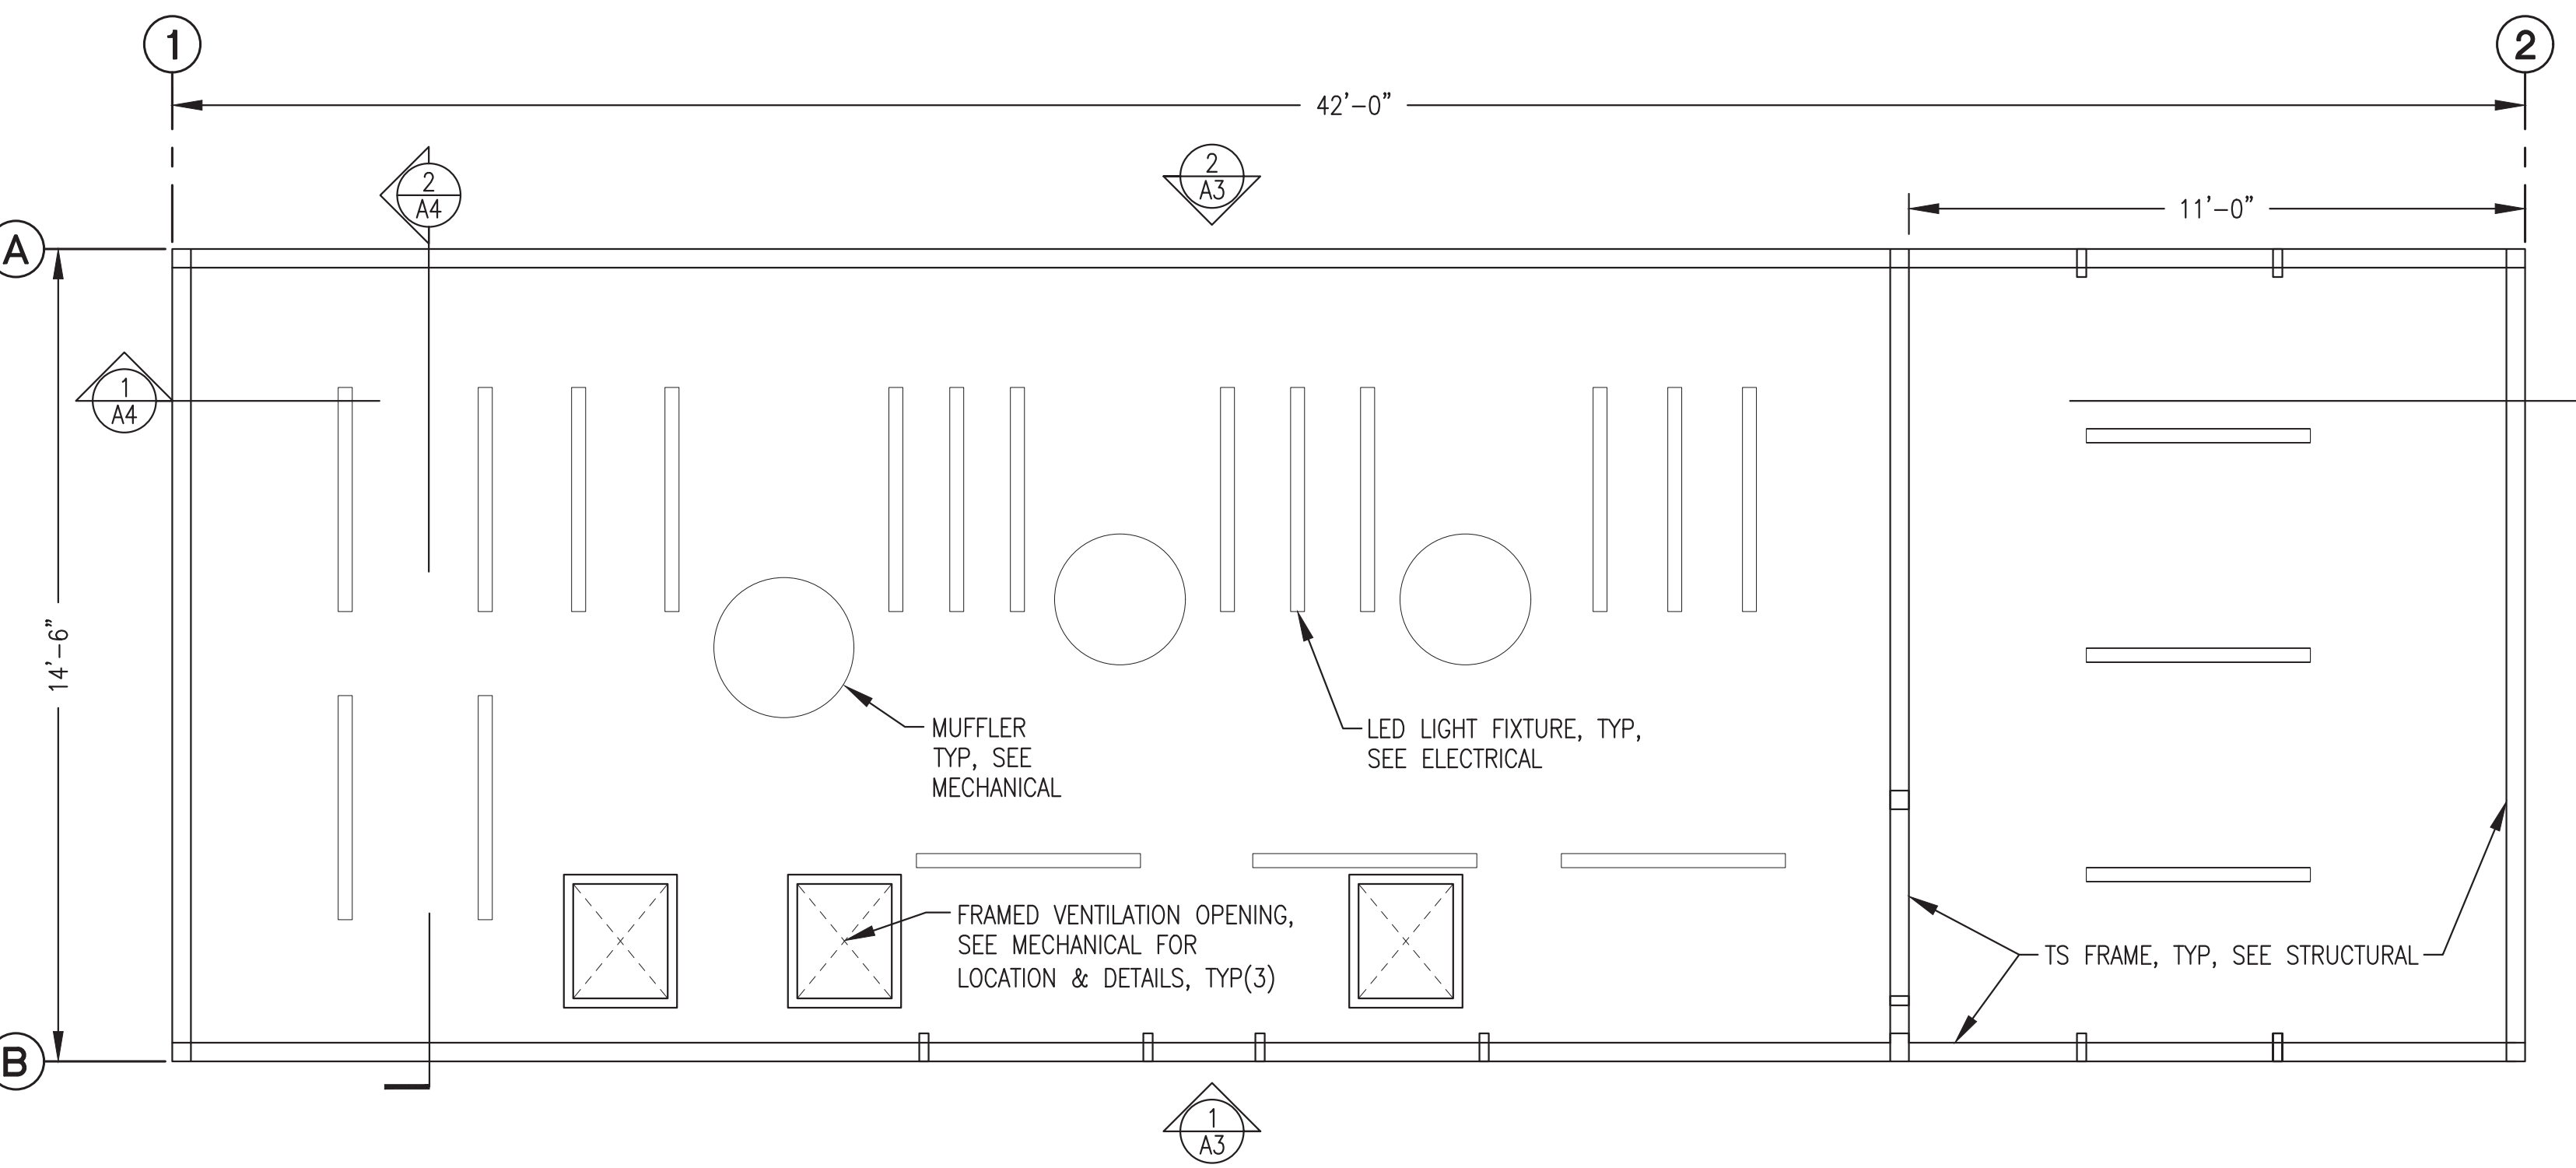

2 REFLECTED CEILING PLAN
3/8"=1'-0"

CODE ANALYSIS – 2012 EDITION INTERNATIONAL BUILDING CODE

OCCUPANCY CLASSIFICATION		REF: IBC-2012, SEC. 306.2
GROUP F-1: FACTORY INDUSTRIAL MODERATE HAZARD – ELECTRIC GENERATION PLANT		
TYPE OF CONSTRUCTION		REF: IBC-2012, TABLE 601
TYPE V-B (NON-RATED)		REF: IBC-2012, SEC. 602.5
BUILDING HEIGHTS AND AREAS		REF: IBC-2012, TABLE 503
ALLOWED	40'-0" 1 STORY 8,500 S.F.	PROVIDED: 17'-0" 1 STORY 610 S.F.
FIRE RESISTANCE RATING REQUIREMENTS FOR BUILDING ELEMENTS		REF: IBC-2012, TABLE 601
STRUCTURAL FRAME 0 HR BEARING WALLS 0 HR INTERIOR PARTITIONS 0 HR FLOOR 0 HR ROOF 0 HR		
FIRE RESISTANCE RATING REQUIREMENTS FOR EXTERIOR WALLS		REF: IBC-2012, TABLE 602
EXTERIOR WALLS 10' ≤ X ≤ 30' 0 HR		
FIRE PROTECTION SYSTEM		REF: IBC-2012, SEC. 903.2.4
FIRE PROTECTION NOT REQUIRED. WATER MIST FIRE SUPPRESSION SYSTEM PROVIDED (SEE MECHANICAL).		
OCCUPANT LOAD		REF: IBC-2012, TABLE 1004.1.2
MECHANICAL/STORAGE = 300 S.F./PERSON 610 S.F./300 S.F. PER OCCUPANT = 2 OCCUPANTS		
MEANS OF EGRESS – TRAVEL DISTANCE		REF: IBC-2012, TABLE 1016.2
REQUIRED 200' PROVIDED 20'		

ARCHITECTURAL GENERAL NOTES:

- SEE CIVIL SITE PLAN FOR LOCATION AND LAYOUT. PROVIDE SEPARATION TO PROPERTY BOUNDARIES IN ACCORDANCE WITH CODE ANALYSIS.
- DO NOT BLOCK OR OBSTRUCT ACCESS, REQUIRED PARKING AREAS, OR REQUIRED EGRESS FROM NEIGHBORING FACILITIES. PROVIDE TEMPORARY BARRICADES OR OTHER FORMS OF PROTECTION TO PROTECT EMPLOYEES, RESIDENTS, AND VISITORS FROM INJURIES DURING CONSTRUCTION ACTIVITIES
- PROJECT MANAGER SHALL BE RESPONSIBLE FOR ALL BUILDING PERMITS, LETTERS OF NON-OBJECTION, UTILITY SERVICES AND APPLICATIONS AS REQUIRED. PROJECT MANAGER OR CONSTRUCTION MANAGER TO BE RESPONSIBLE FOR ALL REQUIRED SAFETY PRECAUTIONS, METHODS AND TECHNIQUES.
- PROVIDE A COMPLETE AND OPERATIONAL FACILITY. ALL WORK TO BE IN ACCORDANCE WITH CURRENT APPROVED EDITIONS OF THE IBC, IMC, IFG, AND NEC INCLUDING STATE OF ALASKA AMENDMENTS.
- SEE SHEETS A3 AND A4 FOR DESCRIPTION OF FIELD INSTALLED ROOF SYSTEM.
- INSULATE ALL WALLS, FLOORS, AND CEILINGS WITH HIGH TEMPERATURE MINERAL FIBER ACOUSTICAL FIRE BATT INSULATION, MIN R VALUE 4 PER INCH, MIN 2000F MELTING TEMP. ROXUL AFB OR EQUAL. FILL ALL PANEL VOIDS OR PROVIDE THICKNESS AS INDICATED ON DRAWINGS. MECHANICALLY FASTEN FLOOR INSULATION TIGHT TO FLOOR.
- UPON COMPLETION OF FABRICATION ROUND ALL CORNERS AND GRIND EDGES SMOOTH AND PAINT ALL INTERIOR AND EXTERIOR EXPOSED STEEL. PERFORM ALL PAINTING IN A WARM DRY ENVIRONMENT IN ACCORDANCE WITH MANUFACTURER'S INSTRUCTIONS INCLUDING DRYING TIME TO RE-COAT.
- SANDBLAST EXTERIOR SURFACE TO SSPC-SP-10. PRIME WITH ONE COAT OF REINFORCED INORGANIC ZINC PRIMER, DEVOE CATHA-COAT 302, NO SUBSTITUTES, COLOR GREEN, TO 3 MILS DRY FILM THICKNESS. COVER WITH TWO COATS OF EPOXY, DEVOE BAR-RUST 236, NO SUBSTITUTES, TO 12 MILS DRY FILM THICKNESS. FIRST COAT COLOR GRAY, SECOND COAT COLOR WHITE.
- FINISH EXTERIOR WALLS AND SKIDS (ALL EXPOSED VERTICAL EXTERIOR SURFACES) WITH ONE COAT OF ALIPHATIC URETHANE ENAMEL, DEVOE DEVTHANE 389, NO SUBSTITUTES, COLOR WHITE, TO 3 MILS DRY FILM THICKNESS.
- SANDBLAST INTERIOR SURFACE TO SSPC-SP-6. PRIME AND FINISH WITH TWO COATS OF EPOXY, SHERWIN WILLIAMS MACROPOXY 646, NO SUBSTITUTES, TO 8 MILS TOTAL DRY FILM THICKNESS. CEILING COLOR WHITE. WALL AND FLOOR COLOR STRUCTURAL GRAY 4031. NOTE THAT FIRST COAT ON WALLS AND FLOOR MAY BE WHITE.

NOTE: THIS DRAWING INCLUDES DETAILS THAT ARE NOT PART OF THE MODULE ASSEMBLY SCOPE AND IS PROVIDED STRICTLY FOR IDENTIFYING LOCATIONS, INSTALLATION DETAILS, AND SPECIFICATIONS FOR DOORS AND WINDOWS.



STATE OF ALASKA, AIDEA/AEA
RURAL POWER SYSTEM UPGRADE
CLARKS POINT POWER PLANT
CLARKS POINT, ALASKA

100% DESIGN DOCUMENTS



REVISIONS	REV	DATE	DESCRIPTION

VERIFY SCALES
0 1" = 1"
THIS BAR REPRESENTS ONE INCH ON ORIGINAL DRAWING




DATE: 12/14/18
DRAWN BY: RW
CHECKED BY: RW
JOB NUMBER: 1026.03

DRAWING TITLE:
FLOOR PLAN,
REFLECTED CEILING
PLAN, CODE ANALYSIS,
& GENERAL NOTES

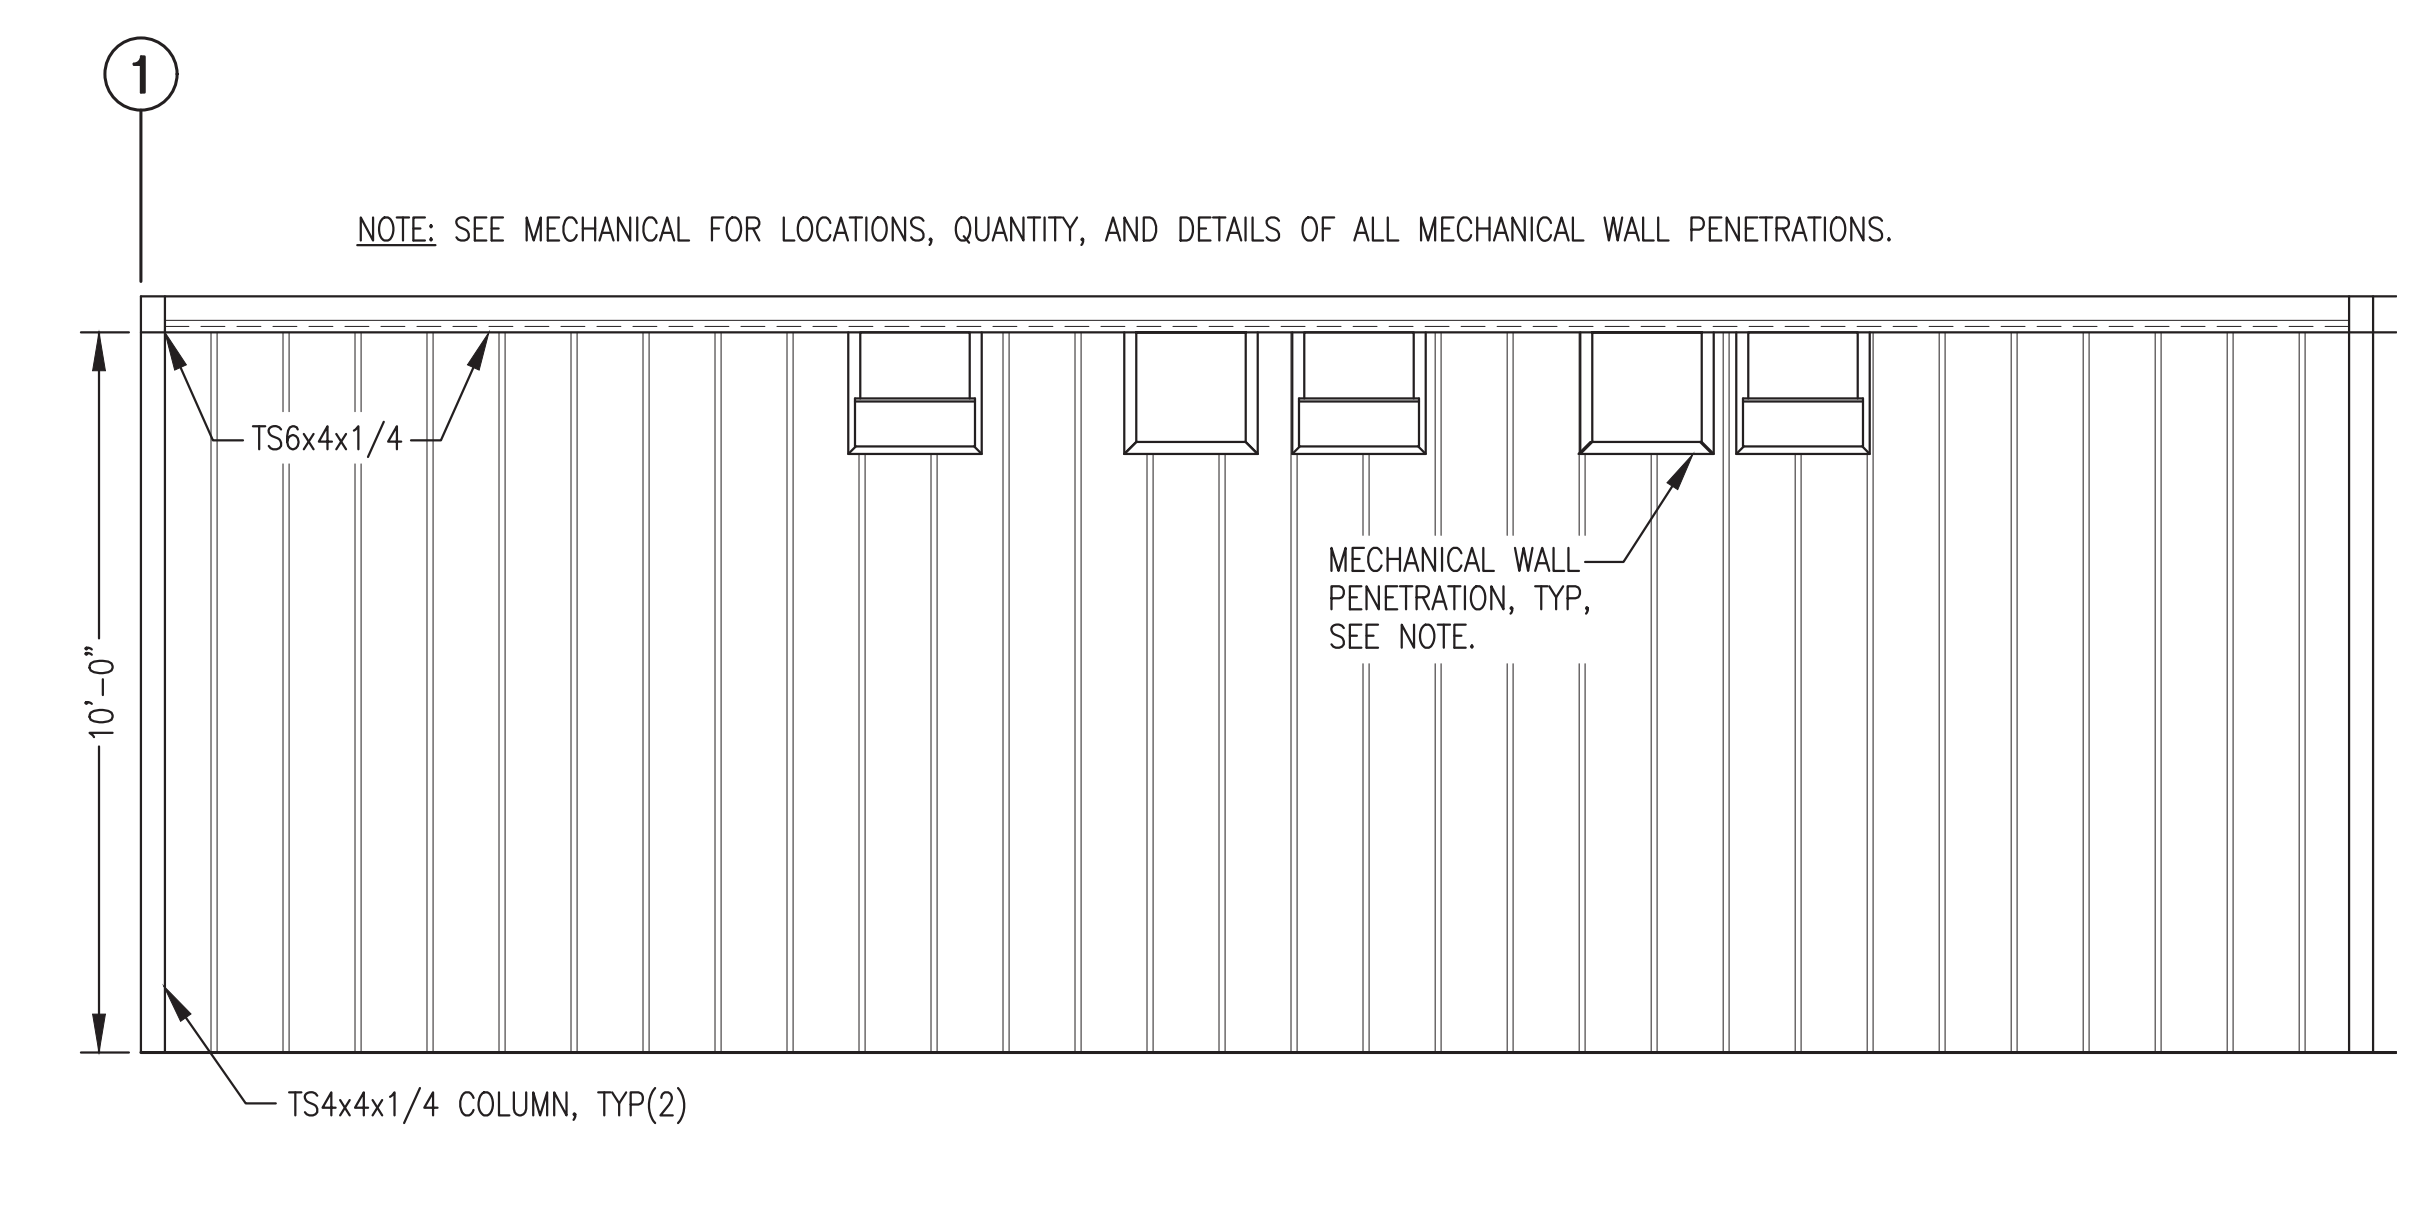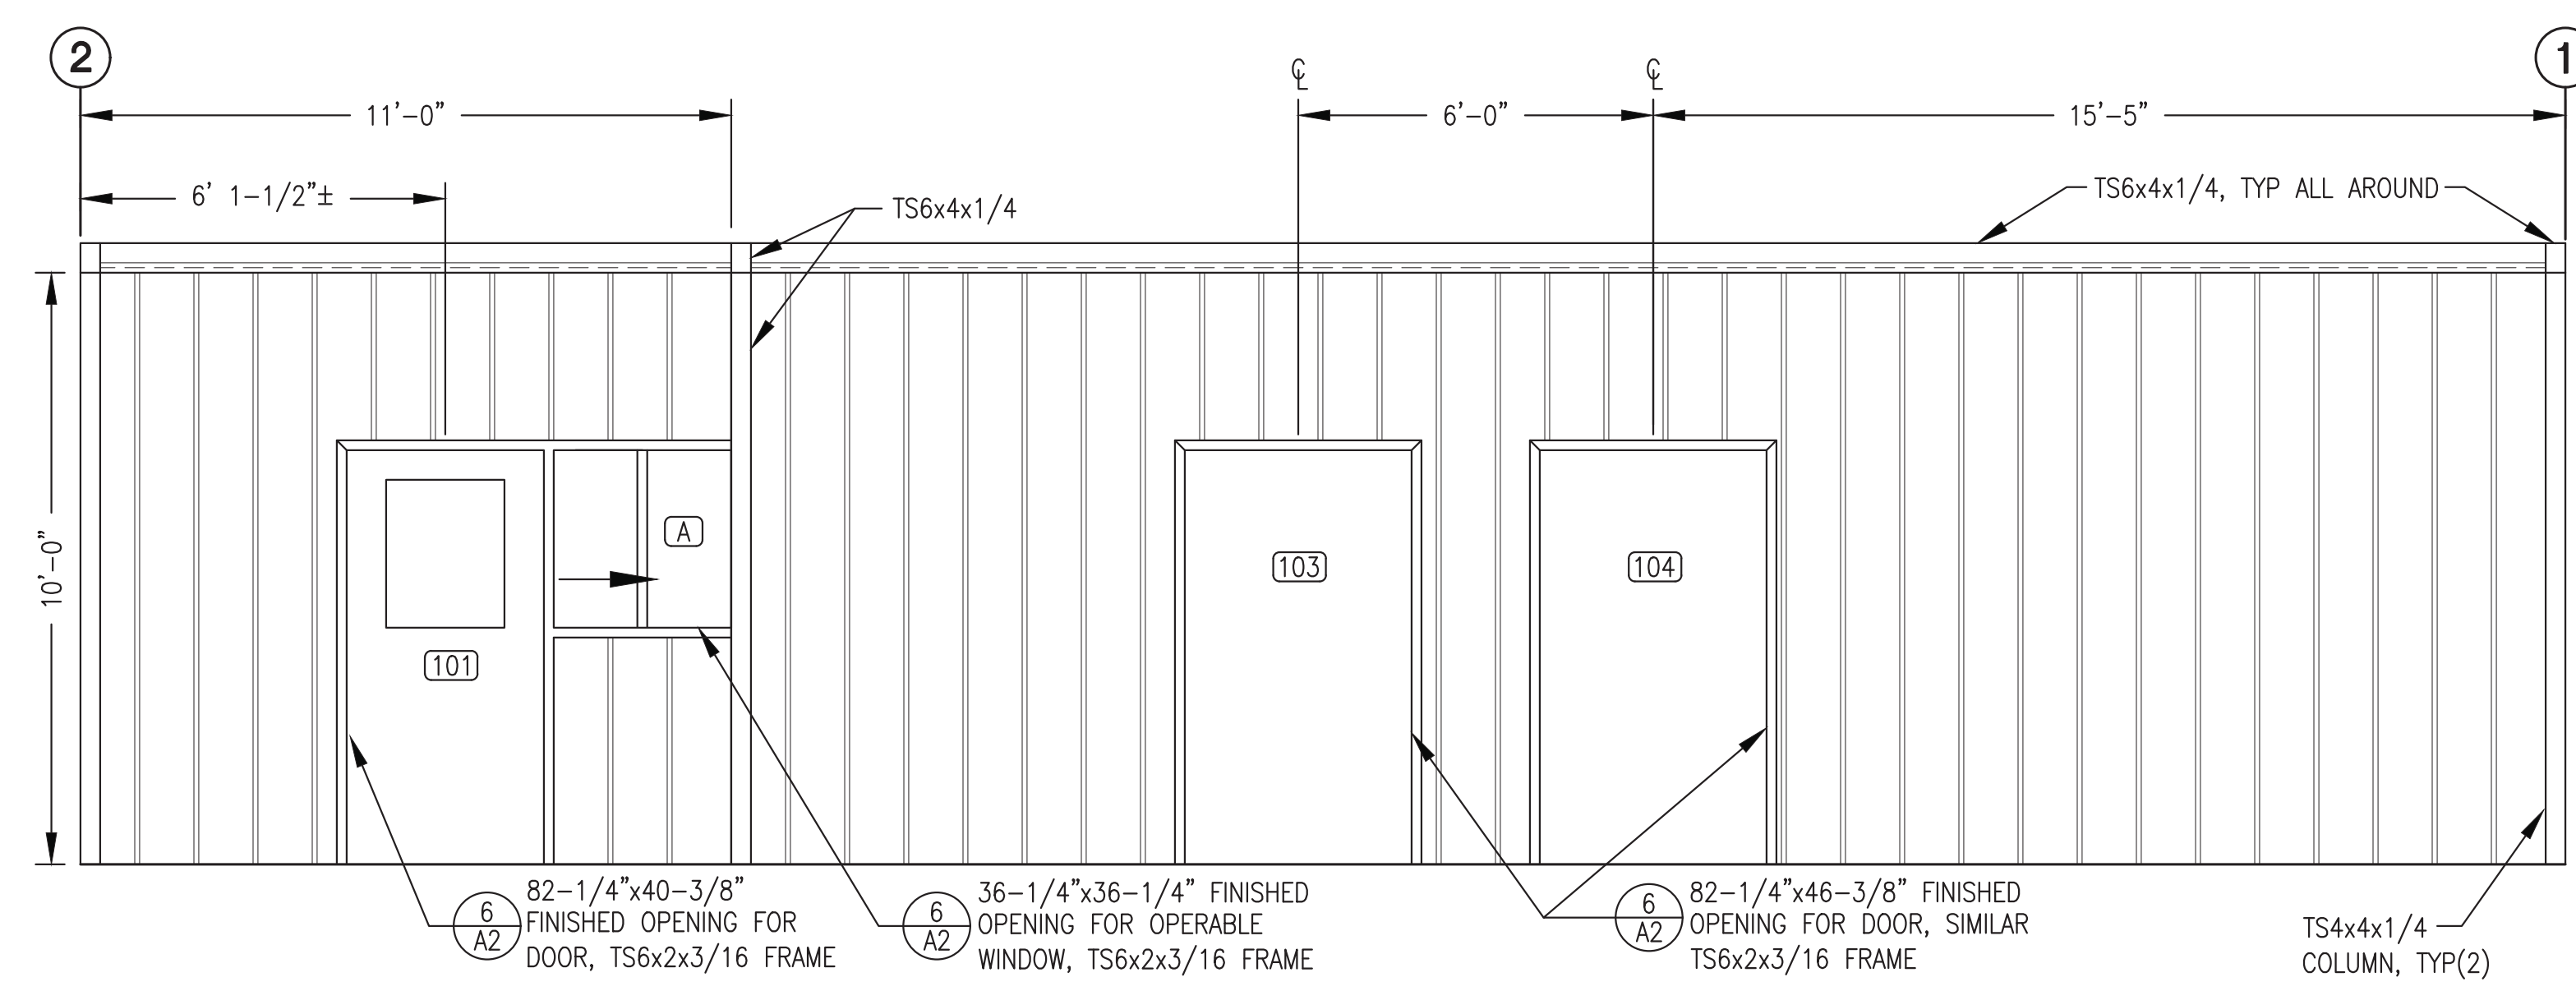

1 FRONT WALL INTERIOR ELEVATION
3/8"=1'-0"


2 PARTIAL GENERATOR ROOM BACK WALL INTERIOR ELEVATION
3/8"=1'-0"

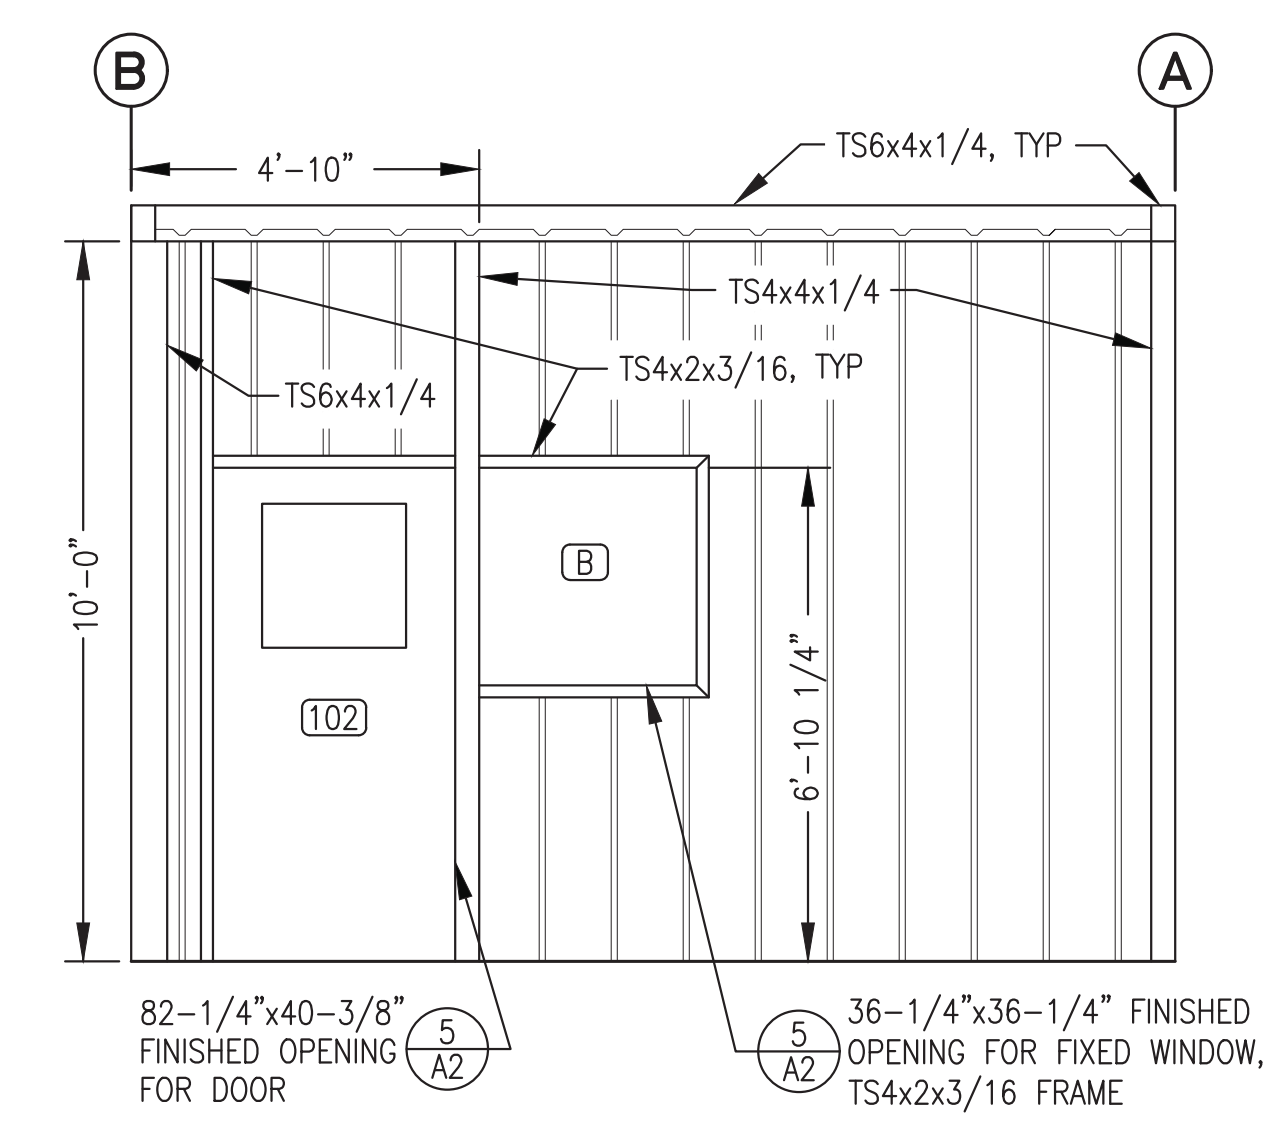

3 CONTROL ROOM WALL INTERIOR ELEVATION
3/8"=1'-0"

FRAMED OPENING NOTES:

- FABRICATE FRAMED OPENINGS FOR DOORS, WINDOWS, ETC, WITH MITERED CORNERS AND FULL PENETRATION GROOVE WELDS. GRIND OUT INSIDE OF MITERED CORNERS TO PROVIDE FULL CLEAR OPENING.
- FABRICATE TO FINISHED INSIDE (CLEAR) DIMENSIONS INDICATED AND LOCATE TO INSIDE EDGE OR CENTERLINE AS INDICATED.

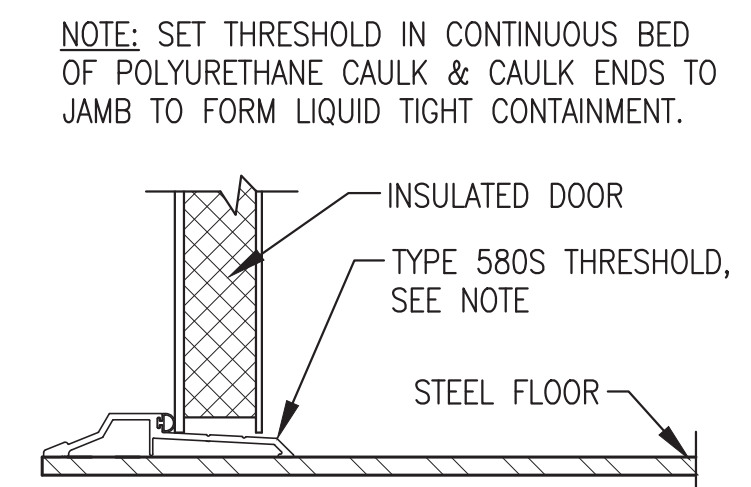

4 TYPICAL DOOR THRESHOLD
NO SCALE

DOOR CONSTRUCTION						FRAME CONSTRUCTION							
DOOR NO.	WIDTH	HEIGHT	THICKNESS	MATERIAL	CORE	REMARKS	WALL THICK.	MATERIAL	TYPE	PROFILE	PREP.	FIRE RATING	HWDR. GROUP
101	3'-0"	6'-8"	1-3/4"	16 GA. H.M.	POLYURETHANE	24"x24" RE-LIGHT {4}	N/A	16 GA. H.M.	WELDED	SINGLE RABBETED	DIMPLE & PUNCH	NONE	HW-1
102	3'-0"	6'-8"	1-3/4"	16 GA. H.M.	POLYURETHANE	24"x24" RE-LIGHT {4}	N/A	16 GA. H.M.	WELDED	SINGLE RABBETED	DIMPLE & PUNCH	NONE	HW-2
103	3'-6"	6'-8"	1-3/4"	16 GA. H.M.	POLYURETHANE		N/A	16 GA. H.M.	WELDED	SINGLE RABBETED	DIMPLE & PUNCH	NONE	HW-3
104	3'-6"	6'-8"	1-3/4"	16 GA. H.M.	POLYURETHANE		N/A	16 GA. H.M.	WELDED	SINGLE RABBETED	DIMPLE & PUNCH	NONE	HW-3
105	3'-0"	6'-8"	1-3/4"	16 GA. H.M.	POLYURETHANE	24"x24" RE-LIGHT {4}	N/A	16 GA. H.M.	WELDED	SINGLE RABBETED	DIMPLE & PUNCH	NONE	HW-1

DOOR HARDWARE:				DOOR FRAME PROFILE:			
HW-1	3 EA	HINGES	HAGER BB1191 4.5 x 4.5NRP x 630	HW-3	3 EA	HINGES	HAGER BB1191 4.5 x 4.5NRP x 630
	1 EA	EXIT DEVICE	PRECISION 2108 x 4908AX3 x 630		1 EA	EXIT LOCK	SCHLAGE ND250 x RHODES x 626
	1 EA	CORE	BEST BROWN CONSTRUCTION CORE		1 EA	OVERHEAD STOP	ROCKWOOD OH1004M x US32D
	1 EA	DOOR CLOSER	LCN 4040 x CUSH x 689		1 EA	WEATHER STRIP	PEMCO 2891AS x 42 (HEAD)
	1 EA	KICK PLATE	ROCKWOOD K1050 10 x 34 x 630		2 EA	WEATHER STRIP	PEMCO 290AS x 80 (SIDE JAMBS)
	1 EA	WEATHER STRIP	PEMCO 2891AS x 36 (HEAD)		1 EA	THRESHOLD	HAGER 580S x 42
	2 EA	WEATHER STRIP	PEMCO 290AS x 80 (SIDE JAMBS)				
	1 EA	THRESHOLD	HAGER 580S x 36				
HW-2	3 EA	HINGES	HAGER BB1191 4.5 x 4.5 x 630				
	1 EA	EXIT DEVICE	PRECISION 2108 x 4908AX3 x 630				
	1 EA	DOOR CLOSER	LCN 4040 x CUSH x 689				
	1 EA	KICK PLATE	ROCKWOOD K1050 10 x 34 x 630				
	1 EA	MOP PLATE	ROCKWOOD K1050 10 x 35 x 630				
	1 EA	SOUND SEAL	PEMCO 2891AS x 36 (HEAD)				
	2 EA	SOUND SEAL	PEMCO 290AS x 80 (SIDE JAMBS)				
	1 EA	THRESHOLD	HAGER 580S x 36				

WINDOW TYPES:

{1} DOORS AND HOLLOW METAL FRAMES GALVANIZED AND FACTORY PRIMED. ALL FRAMES WELDED CONSTRUCTION, DIMPLED AND PUNCHED.

{2} DOORS TO HAVE SOLID POLYURETHANE INSULATION CORE WITH TOPS INVERTED AND CAULKED WATER TIGHT.


{3} FINISH ALL DOORS AND HOLLOW METAL FRAMES WITH TWO COATS OF SHERWIN WILLIAMS MACROPOXY 646, NO SUBSTITUTES, COLOR STRUCTURAL GRAY 4031.

{4} INSTALL INSULATED RE-LIGHT WITH TWO PANES OF 1/4" LAMINATED SAFETY GLASS WITH 1/2" AIR GAP IN EACH DOOR PANEL, 24"x24" OR 24"x18" AS INDICATED.


OPERABLE SLIDER WITH WHITE VINYL FRAME & 1" INSULATED GLAZING

FIXED SINGLE RABBET HOLLOW METAL FRAME WITH 2 PANES OF 1/4" LAMINATED SAFETY GLASS

NOTE: DIMENSIONS ARE OVERALL FRAME SIZE.

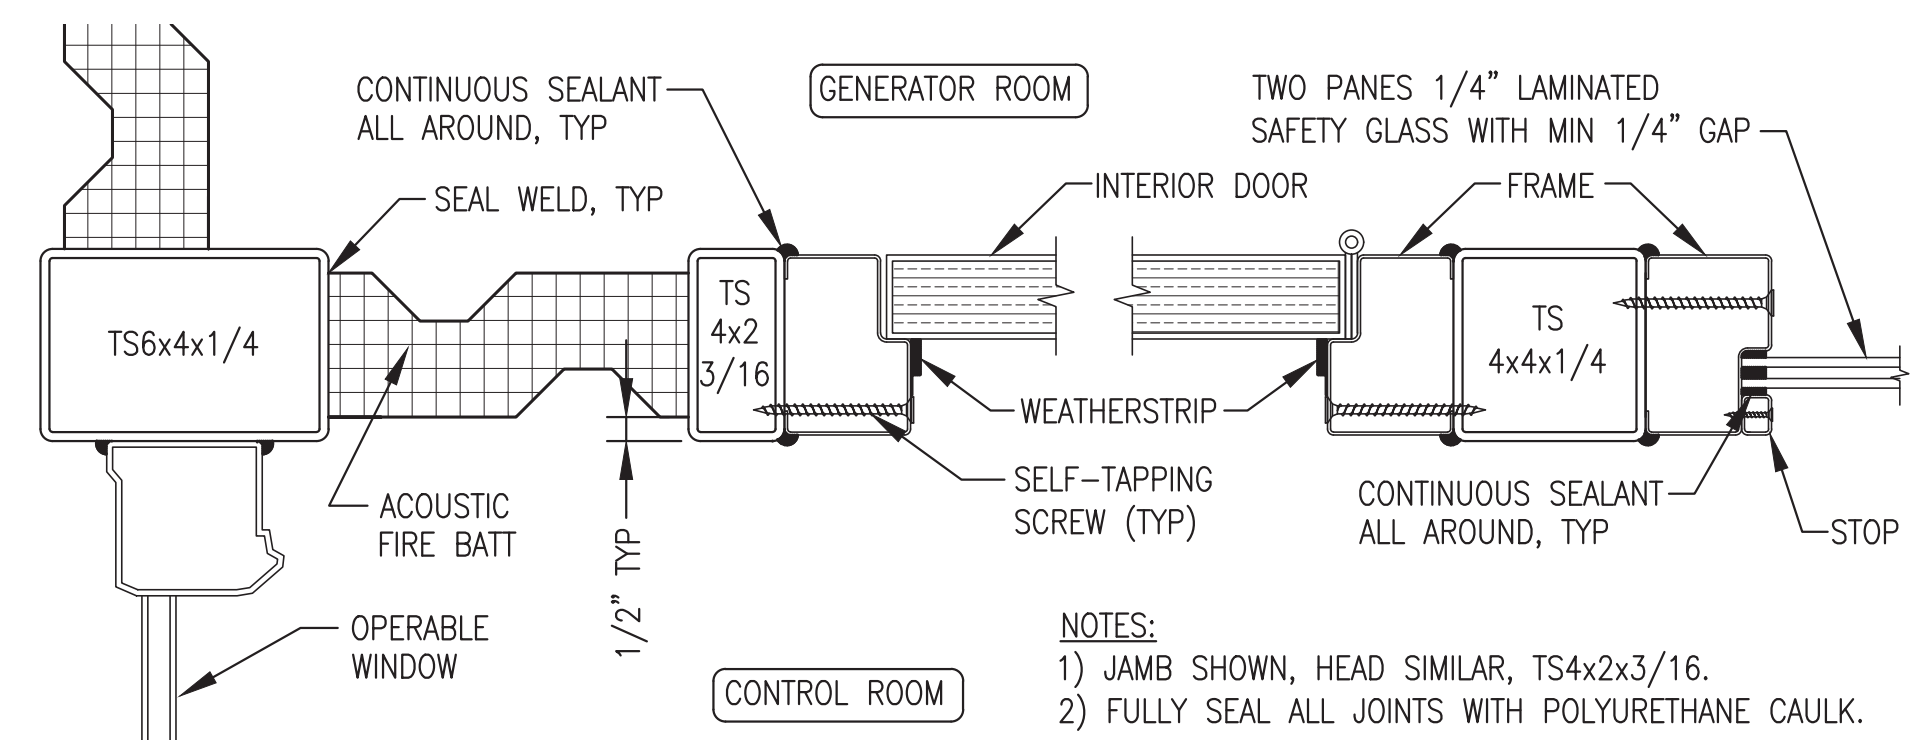

5 INTERIOR DOOR AND WINDOW JAMB/HEAD
3/8"=1'-0"

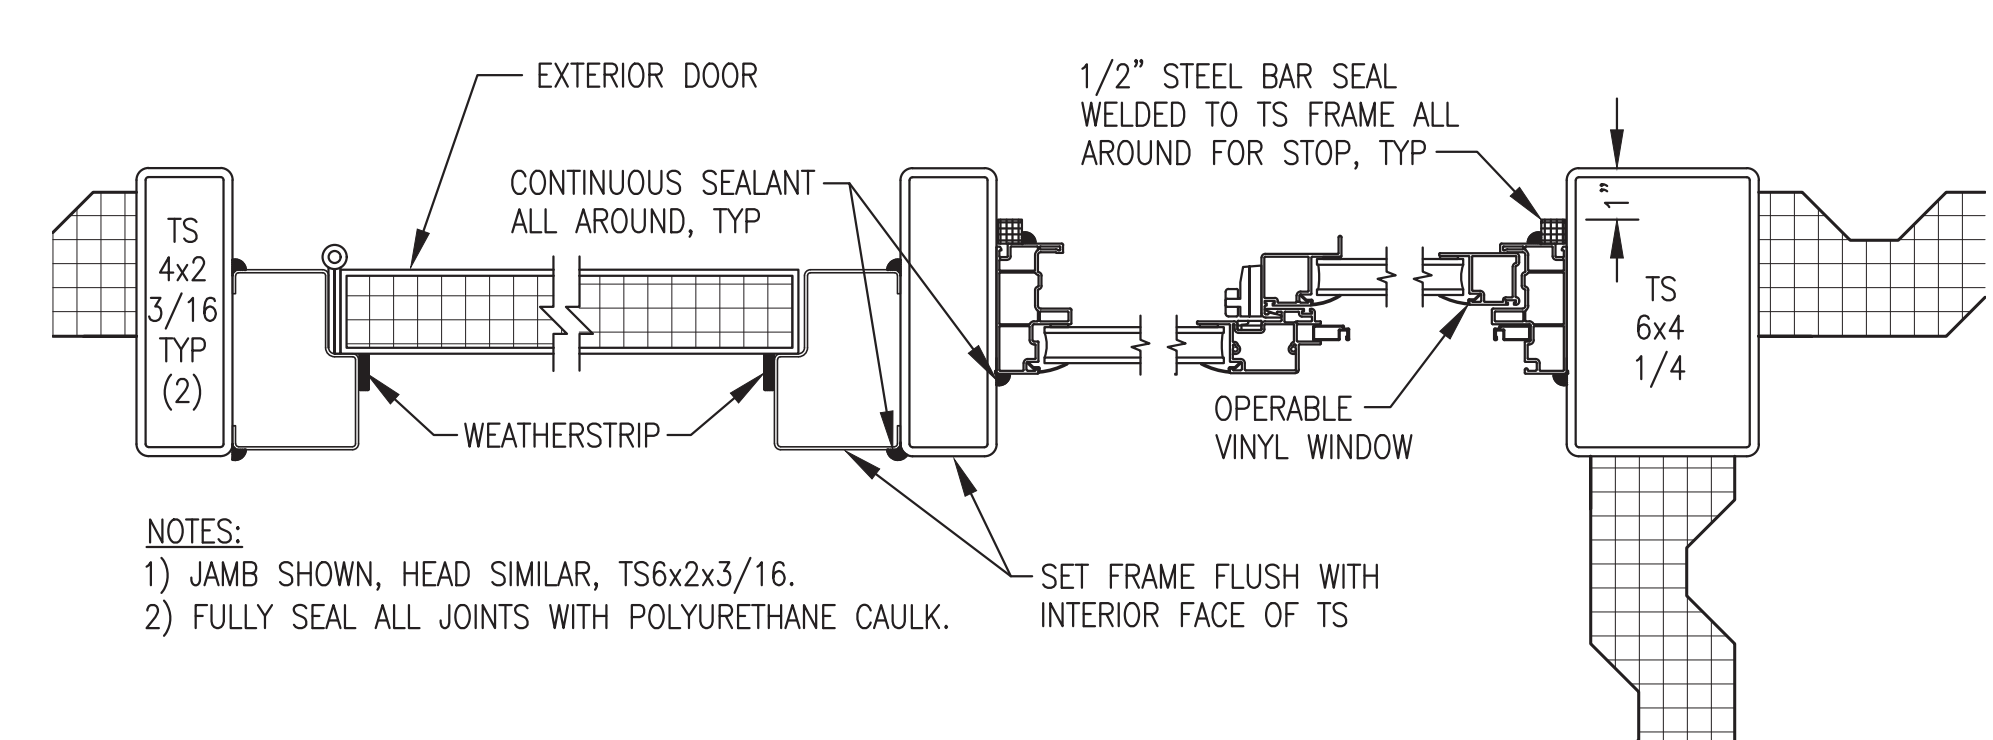

6 TYPICAL EXTERIOR DOOR AND WINDOW JAMB/HEAD
3/8"=1'-0"

NOTE: THIS DRAWING INCLUDES DETAILS THAT ARE NOT PART OF THE MODULE ASSEMBLY SCOPE AND IS PROVIDED STRICTLY FOR IDENTIFYING LOCATIONS, INSTALLATION DETAILS, AND SPECIFICATIONS FOR DOORS AND WINDOWS.

LEGEND	
	DIRECTION OF FLOW
	CHANGE OF PIPE SIZE
	PIPING CONNECTION (TEE)
	ELBOW TURNED DOWN
	ELBOW TURNED UP
	FLANGED JOINT
	UNION
	FLEXIBLE CONNECTOR
	BUTTERFLY VALVE
	BALL VALVE
	CHECK VALVE
	HOSE END DRAIN VALVE
	GAUGE COCK
	AUTOMATIC AIR VENT
	THERMOMETER
	PRESSURE GAUGE
	TEMPERATURE TRANSMITTER
	PRESSURE TRANSMITTER
	FLOW METER
	FLOAT SWITCH
	LOW COOLANT ALARM
	TANK LEVEL MONITOR
	LEVEL SENSOR PROBE
	GLYCOL LEVEL SENSOR
ABBREVIATIONS	
Ø	DIAMETER (PHASE)
A	AMPS
AFF	ABOVE FINISHED FLOOR
BTU	BRITISH THERMAL UNIT
DFR	DIESEL FUEL RETURN
DFS	DIESEL FUEL SUPPLY
EWT	ENTERING WATER TEMPERATURE
EXIST	EXISTING
ECR	ENGINE COOLANT RETURN
ECS	ENGINE COOLANT SUPPLY
FPT	FEMALE PIPE THREAD
GA	GAUGE
GALV	GALVANIZED
GPM	GALLONS PER MINUTE
GRC	GALVANIZED RIGID CONDUIT
HP	HORSEPOWER
HRR	HEAT RECOVERY RETURN
HRS	HEAT RECOVERY SUPPLY
ID	INSIDE DIAMETER
KW	KILOWATT
LT	LIQUID TIGHT
LWT	LEAVING WATER TEMPERATURE
MAX	MAXIMUM
MBH	THOUSAND BTU PER HOUR
MIN	MINIMUM
MPT	MALE PIPE THREAD
NC	NORMALLY CLOSED
NO	NORMALLY OPEN
OC	ON CENTER
OD	OUTSIDE DIAMETER
PRV	PRESSURE RELIEF VALVE
PSI	POUNDS/PER SQUARE INCH
PSID	PSI DIFFERENTIAL
PSIG	PSI GAUGE
SCH	SCHEDULE
TDH	TOTAL DEVELOPED HEAD
TYP	TYPICAL
UOR	USED OIL RETURN
V	VOLTS
W	WATTS
WG	WATER GAUGE
WPD	WATER PRESSURE DROP

EQUIPMENT REQUIREMENTS FOR APPROVED EQUALS (APPLIES TO ALL SCHEDULES):
 SPECIFIC PARTS MANUFACTURER AND MODEL SELECTED NOT ONLY TO MEET PERFORMANCE FUNCTION BUT ALSO TO COORDINATE AND INTERFACE WITH OTHER DEVICES AND SYSTEMS. APPROVED EQUAL SUBSTITUTIONS WILL BE ALLOWED ONLY BY ENGINEER'S APPROVAL. TO OBTAIN APPROVAL, SUBMITTALS MUST CLEARLY DEMONSTRATE HOW SUBSTITUTE ITEM MEETS OR EXCEEDS SPECIFIED ITEM QUALITY AND PERFORMANCE CHARACTERISTICS AND ALSO COMPLIES WITH MECHANICAL AND/OR ELECTRICAL CONNECTIONS AND PHYSICAL LAYOUT REQUIREMENTS.

ENGINE COOLING SYSTEM EQUIPMENT SCHEDULE			
SYMBOL	SERVICE/FUNCTION	DESCRIPTION	MANUFACTURER/MODEL
R-1 R-2	GLYCOL RADIATOR	SINGLE PASS, 4 ROW, VERTICAL CORE, 3" FLANGED CONNECTIONS, GALVANIZED COATING, EXPANDED METAL GUARD. 6,000 BTU/MIN AT 77°F AMBIENT, 50 GPM 50% ETHYLENE GLYCOL AT 192°F IN, 0.22 PSI MAX GLYCOL PRESSURE DROP. 3 HP, 460 V, 3 PH, MOTOR SUITABLE FOR VFD OPERATION AT 10:1 TURNDOWN RATIO.	DIESEL RADIATOR PART NO. DR3490
TV-1	COOLANT THERMOSTATIC VALVE	3" ANSI 125# FLAT FACED FLANGES, CAST IRON BODY, FACTORY SET NON-ADJUSTABLE FIELD REPLACEABLE THERMOSTATIC ELEMENTS - 185F NOMINAL TEMPERATURE	FPE PART NO. A3010-185
TV-2	HEAT RECOV. THERMOSTATIC VALVE	2-1/2" ANSI 125# FLAT FACED FLANGES, CAST IRON BODY, FACTORY SET NON-ADJUSTABLE FIELD REPLACEABLE THERMOSTATIC ELEMENTS, 185F NOMINAL TEMPERATURE.	FPE PART NO. A2510-185
ET-1	GEN COOLANT EXPANSION TANK	24 GALLON CAPACITY TANK, 12.75" O.D x 48" LONG FABRICATED STEEL TANK, SEE FABRICATION DETAIL	CUSTOM FABRICATION
HP-EC	ENGINE COOLANT FILL HAND PUMP	DOUBLE ACTION PISTON PUMP, ALUM HOUSING, SS PISTON SHAFT & LINER, BUNA-N SEALS, ANTI-SIPHONING VALVE.	GPI MODEL HP-100
G-EC	ENGINE COOLANT GLYCOL TANK LEVEL GAUGE	MAGNETIC OPERATED SPIRAL GAUGE FOR #1 DIESEL, 25 PSIG MAX OPERATING PRESSURE, 35" LIQUID COLUMN PLUS 4" RISER.	ROCHESTER MODEL 8660

HEAT RECOVERY & PLANT HEATING EQUIPMENT SCHEDULE:			
HX-1	POWER PLANT HEAT EXCHANGER	316 SS PLATES, BRAZED CONST. 2.5" NPT, 600 MBH MIN CAPACITY. PRIMARY: 65 GPM 195F EWT (50% ETHYLENE) 1.2 PSI MAX WPD, SECONDARY: 60 GPM 185F LWT (50% PROPYLENE) 1.3 PSI MAX WPD	AMERIDEX SL-140-90
P-HR1	CONTROL ROOM HEAT	1 GPM AT 18' TDH, 1/25HP, 115V, 1Ø. PROVIDE WITH 3/4" SOLDER COMPANION FLANGES, GASKETS, & BOLTS.	GRUNDFOS UPS 15-58FC, SPEED 3
P-HR2A	HEAT RECOV. PRIMARY	65 GPM AT 8' TDH, 1/3HP, 115V, 1Ø. PROVIDE WITH 2" NPT COMPANION FLANGES, GASKETS, & BOLTS.	GRUNDFOS UPS 50-40/4, SPEED 3
P-HR2B	HEAT RECOV. SECONDARY	60 GPM AT 23' TDH, 3/4HP, 115V, 1Ø. PROVIDE WITH 2" NPT COMPANION FLANGES, GASKETS, & BOLTS.	GRUNDFOS UPS 50-80/2, SPEED 3
CUH-1	CONTROL ROOM HEAT	FLOOR MOUNTED HOT WATER CABINET UNIT HEATER, 18 MBH AT 1 GPM 180F EWT & 60F EAT.	TOYOTOMI HC-20
ET-2	HEAT RECOV. EXP. TANK	BLADDER TYPE EXPANSION TANK, 106 GALLON TANK, 125 PSIG WORKING PRESSURE, 10 PSIG PRE-CHARGE.	AMTROL 400L

VENTILATION EQUIPMENT SCHEDULE:			
EF-1 EF-2	GENERATION ROOM EXHAUST FANS	DIRECT DRIVE 14"Ø PROPELLER SIDEWALL EXHAUST FAN, 2,100 CFM AT 0.375" SP, 1,750 RPM. FURNISH WITH SPECIAL 1/2 HP, 115 V, 1 PH VARIGREEN MOTOR WITH OPTIONAL 0-10V LEADS	GREENHECK SE1-14-436-VG (1/2 HP)
EF-1 EF-2 COMB.	FAN & INTAKE DAMPERS	OPPOSED BLADE LOW-LEAKAGE CONTROL DAMPER, GALVANIZED STEEL CONSTRUCTION, 304 STAINLESS STEEL BEARINGS AND JAMB SEALS, EPDM BLADE SEALS.	GREENHECK VCD-23
MD	MOTORIZED DAMPER ACTUATOR	120V SPRING RETURN ACTUATOR	BELIMO AF-BUP

FUEL SYSTEM EQUIPMENT SCHEDULE			
SYMBOL	SERVICE/FUNCTION	DESCRIPTION	MANUFACTURER/MODEL
P-DF1 & P-UO1	DAY TANK FILL PUMP & USED OIL DRAIN PUMP	ROTARY GEAR PUMP, 1/2" FPT INLET AND OUTLET, DUCTILE IRON CONSTRUCTION WITH STAINLESS STEEL SHAFT, BUNA-N LIP SEAL, CARBON BEARINGS, DIRECT FLEX COUPLED TO 1725 RPM ODP THERMALLY PROTECTED, AUTO RESET MOTOR, 1/3 HP, 115 V, 1 PH, 60 HZ, 4.0 GPM @ 20 PSID.	OBERDORFER C992M3E5QF50
HP-DI	DAY TANK FILL HAND PUMP (& GLYCOL FILL)	DOUBLE ACTION PISTON HAND PUMP, ALUM HOUSING, SS PISTON SHAFT & LINER, BUNA-N SEALS, ANTI-SIPHONING VALVE.	GPI MODEL HP-100
G-DI	DAY TANK LEVEL GAUGE	MAGNETIC OPERATED SPIRAL GAUGE FOR #1 DIESEL, 25 PSIG MAX OPERATING PRESSURE, 35" LIQUID COLUMN PLUS 4" RISER.	ROCHESTER MODEL 8660
M-DI	DAY TANK METER	STEEL BODY, 1" ANSI 300# FLANGED ENDS, 20-800 GPH FLOW RANGE, O-RINGS AND SEALS COMPATIBLE WITH #1 DIESEL, DIRECT READ 6-DIGIT REGISTER TO 0.1 GAL, DRY CONTACT PULSER.	ISTEC CONTOIL 9226-F
F-DI	DAY TANK FILTER	10 MICRON FILTER FOR DIESEL FUEL, CLEAR BOWL WITH BOTTOM DRAIN VALVE, 150 PSIG MAXIMUM OPERATING PRESSURE, 25 GPM MAXIMUM FLOW. REPLACE FPT HEAD ASSEMBLY WITH CUSTOM FABRICATED STEEL HEAD WITH ANSI 150# FLANGED ENDS. FURNISH COMPLETE WITH WRENCH AND 5 SPARE FILTER ELEMENTS.	SUPERIOR MACHINE & WELDING HEAD WITH GOLDEN ROD NO. 495-4 BOWL, 491 WRENCH, 470-5 ELEMENTS

PIPE/TUBING STRUT CLAMP SCHEDULE				
PIPE/TUBE	CLAMP #	PIPE/TUBE	CLAMP #	NOTES:
1/2" COPPER	BVT062	1/2" STEEL	B2008	1) ALL CLAMP NUMBERS ARE B-LINE. EQUIVALENT EQUALS ACCEPTABLE. 2) ALL COPPER TUBE CLAMPS TO BE CUSHIONED, VIBRA-CLAMP. 3) ALL STEEL PIPE CLAMPS NOT CUSHIONED. USE FOR ALL STEEL PIPE AND RIGID CONDUIT. 4) SEE PLANS, ELEVATIONS, ISOMETRICS, AND DETAILS FOR ACTUAL PIPE SIZES.
3/4" COPPER	BVT087	3/4" STEEL	B2009	
1" COPPER	BVT112	1" STEEL	B2010	
1-1/4" COPPER	BVT125	1-1/4" STEEL	B2011	
1-1/2" COPPER	BVT162	1-1/2" STEEL	B2012	
2" COPPER	BVT212	2" STEEL	B2013	
2-1/2" COPPER	BVT262	2-1/2" STEEL	B2014	
3" COPPER	BVT312	3" STEEL	B2015	
4" COPPER	BVT412	4" STEEL	B2017	

INSTRUMENTATION: SEE ELECTRICAL INSTRUMENTATION SCHEDULE ON SHEET E1.1 FOR INSTRUMENTATION DEVICES SHOWN ON THE MECHANICAL DRAWINGS.

SEQUENCE OF OPERATIONS

DAY TANK WILL HAVE AUTOMATIC FILL CONTROLS WITH REDUNDANT HIGH AND LOW LEVEL ALARMS AND TIMERS. SEE FUEL SYSTEM CONTROL PANEL DRAWINGS FOR DETAILED SEQUENCE.

ALL DAMPER MOTORS WILL BE NORMALLY CLOSED SPRING RETURN AND WILL CLOSE ON LOSS OF POWER (FIRE ALARM) IN LESS THAN 30 SECONDS. VENTILATION AIR INTAKE AND EXHAUST MOTORIZED DAMPERS WILL OPEN ANY TIME ASSOCIATED EXHAUST FAN OPERATES. THE COMBUSTION AIR INTAKE MOTORIZED DAMPER WILL BE OPEN ANY TIME PLANT OPERATES (STATION SERVICE POWER ON).

EXHAUST FANS EF-1 AND EF-2 WILL OPERATE ON A CALL FOR COOLING THROUGH A 24VAC DIGITAL MODULATING THERMOSTAT. THE THERMOSTAT WILL PROVIDE A 0-10V SIGNAL TO MODULATE THE FAN SPEED AS REQUIRED TO MAINTAIN GENERATING ROOM TEMPERATURE, 75F, ADJUSTABLE.

CABINET UNIT HEATER CUH-1 AND CIRCULATING PUMP P-HR1 WILL OPERATE ON A CALL FOR HEATING THROUGH THE INTERNAL CUH CONTROLS TO MAINTAIN CONTROL ROOM TEMPERATURE, 65F, ADJUSTABLE.

RADIATOR FAN MOTORS WILL OPERATE UNDER VARIABLE FREQUENCY DRIVE (VFD) CONTROL. WHEN THE COOLANT RETURN TEMP REACHES THE WAKE UP SETPOINT THE MOTOR WILL START AT MINIMUM SPEED AND RAMP UP TO THE REQUIRED SPEED. USING PID CONTROL, THE VFD WILL MODULATE THE FAN SPEED AS REQUIRED TO MAINTAIN COOLANT RETURN TEMP AT THE PID REFERENCE SETPOINT. AS THE COOLANT RETURN TEMP RISES, THE VFD WILL INCREASE THE SPEED OF THE FAN MOTOR UP TO 100%. ONCE THE FAN REACHES THE MINIMUM SPEED, THE VFD WILL MAINTAIN THAT SPEED UNTIL THE LOW SPEED TIME OUT EXPIRES. WHEN THE LOW SPEED TIME OUT EXPIRES THE MOTOR WILL STOP. THE MOTOR WILL REMAIN OFF UNTIL THE COOLANT RETURN TEMP RISES TO THE WAKE UP SETPOINT. THE INITIAL OPERATING SETTINGS SHALL BE SET TO THE FOLLOWING VALUES AND SHALL BE ADJUSTABLE:
 170F = PID REFERENCE TEMPERATURE 160F = WAKE UP TEMPERATURE
 0.93 = PROPORTIONAL GAIN 0.3 = INTEGRAL GAIN 0 = DERIVATIVE
 6 HZ = MINIMUM SPEED 60 SEC = LOW SPEED TIME OUT


HEAT RECOVERY PUMPS P-HR2A AND P-HR2B WILL OPERATE CONTINUOUSLY UNDER MANUAL CONTROL.

WHEN THE SYSTEM PRESSURE IN THE HEAT RECOVERY PIPING DROPS BELOW 15 PSIG FOR 15 MINUTES, A RED LAMP "HEAT RECOVERY LOSS OF PRESSURE" LOCATED IN THE SWITCHGEAR MASTER SECTION WILL ILLUMINATE.


WHEN THE HEAT RECOVERY RETURN TEMP. IS EQUAL TO OR GREATER THAN THE HEAT RECOVERY SUPPLY TEMP. FOR 60 MINUTES, AN AMBER LAMP "NO LOAD ON HEAT RECOVERY" LOCATED IN THE SWITCHGEAR MASTER SECTION WILL ILLUMINATE. WHEN THE HEAT RECOVERY SUPPLY TEMP. IS A MIN. OF 1°F GREATER THAN THE HEAT RECOVERY RETURN TEMP. THE LAMP WILL TURN OFF.

WHEN THE FLOW RATE IN THE HEAT RECOVERY PIPING FALLS BELOW 10 GPM FOR 15 MINUTES, A RED LAMP "HEAT RECOVERY LOSS OF FLOW" LOCATED IN THE SWITCHGEAR MASTER SECTION WILL ILLUMINATE.

ISSUED FOR
 CONSTRUCTION
 JANUARY 2019

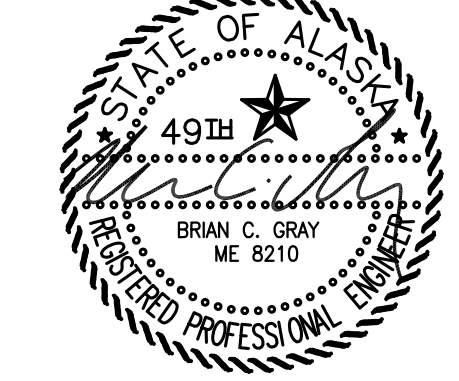

ALASKA ENERGY AUTHORITY		
PROJECT: PORT HEIDEN RURAL POWER SYSTEM POWER PLANT UPGRADE		
TITLE: MECHANICAL LEGEND, SCHEDULES, & SEQUENCE OF OPERATIONS		
	DRAWN BY: JTD	SCALE: AS NOTED
DESIGNED BY: BCG	DATE: 1-14-19	
FILE NAME: PTH PPU M2-7	SHEET: M1.1 OF 7	
PROJECT NUMBER: P.O. 111405, Anchorage, AK 99511 (907)349-0100		

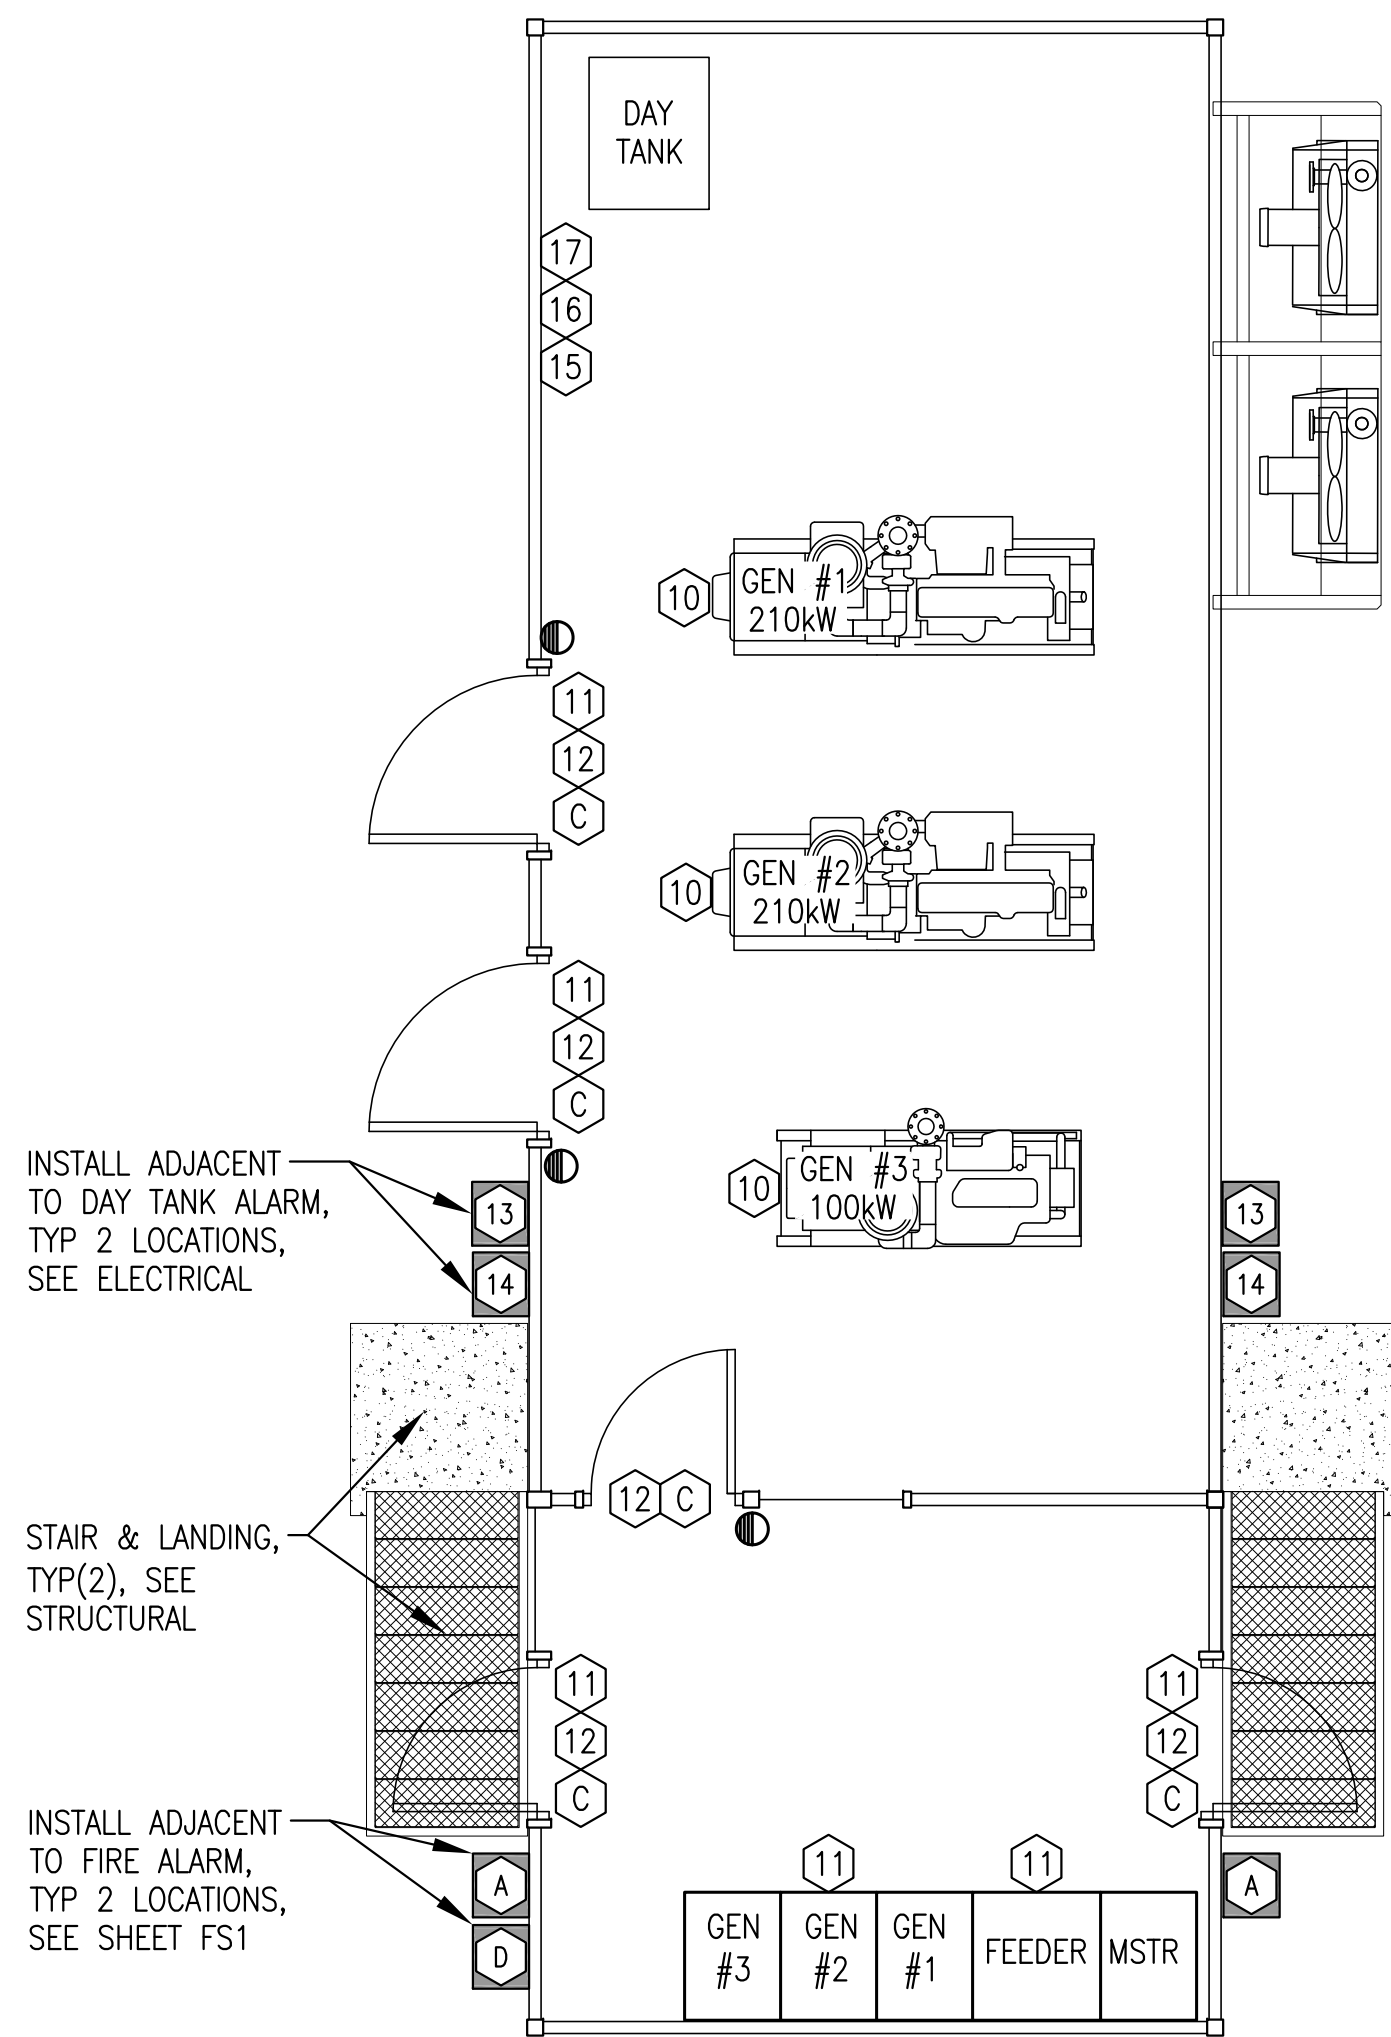

WARNING SIGN & INFORMATIONAL PLACARD SCHEDULE:

WARNING SIGNS & INFORMATIONAL PLACARDS – PROVIDE DECALS AND SIGN BOARDS AS INDICATED IN THE SCHEDULE BELOW, QUANTITY & LOCATION WHERE SHOWN ON THE WARNING SIGN/PLACARD PLAN THIS SHEET.

DECALS
 # DECALS TO BE WHITE NON-REFLECTIVE VINYL BACKGROUND, 3M 3650-10, WITH 3M SERIES 225 HIGH PERFORMANCE VINYL LETTERS, ONE SIDE ONLY, SELF ADHESIVE BACK. NOMINAL 10"x14" SIZE UNLESS INDICATED OTHERWISE OR REQUIRED TO BE LARGER FOR SPECIFIED LETTER SIZE. WARNING LITES OR EQUAL. INSTALL ON FACE OF DOORS OR ELECTRICAL ENCLOSURES WHERE INDICATED. CLEAN SURFACES AND APPLY IN ACCORDANCE WITH MANUFACTURER'S INSTRUCTIONS.

BOARDS
 # SIGN BOARDS TO BE EQUAL TO DECALS EXCEPT MOUNTED ON 0.08" ALUMINUM PLATE. PROVIDE 3/16" HOLES IN ALL FOUR CORNERS. ATTACH TO CHAIN LINK FENCING WITH HOG RINGS OR STAINLESS STEEL TIES. ATTACH TO WALLS OR STRUCTURES WITH STAINLESS STEEL SCREWS OR BOLTS.

WARNING SIGNS – RED LETTERING ON WHITE BACKGROUND.

- #A "FIRE ALARM"
- #C "CAUTION, ROOM PROTECTED BY WATER MIST FIRE PROTECTION SYSTEM, IN CASE OF FIRE KEEP DOOR CLOSED AND DO NOT ENTER"
- #D "FLASHING LIGHT MEANS FIRE SUPPRESSION AGENT HAS DISCHARGED"
- #10 "CAUTION: THIS UNIT STARTS AUTOMATICALLY, LOCK & TAG OUT PRIOR TO SERVICE"
- #11 "DANGER HIGH VOLTAGE, AUTHORIZED PERSONNEL ONLY"
- #12 "CAUTION HEARING & EYE PROTECTION REQUIRED"
- #13 "FUEL OIL DAY TANK ALARM"
- #14 "IN CASE OF SPILL CALL DEC 1-800-478-9300"

INFORMATIONAL PLACARDS – BLACK LETTERING ON WHITE BACKGROUND.

- #15 "CHECK BULK TANK LEVEL DAILY, SWITCH TO A DIFFERENT BULK TANK WHEN LEVEL DROPS BELOW 12" "
- #16 "TO MANUALLY FILL DAY TANK IN CASE OF EMERGENCY:
 1) TURN OFF POWER TO THE DAY TANK CONTROL PANEL
 2) MANUALLY OPEN ACTUATOR VALVE AT TANK FARM USING A WRENCH
 3) OPEN NORMALLY CLOSED VALVE BY HAND PUMP
 4) OPERATE HAND PUMP WHILE MONITORING LEVEL GAUGE"
- #17 "TO CHANGE ENGINE OIL:
 1) LOCK & TAG GENERATOR OUT OF SERVICE
 2) DRAIN ENGINE OIL INTO DRUM OR BUCKET
 3) CHANGE FILTER
 4) CLOSE DRAIN VALVE & REFILL ENGINE
 5) RUN ENGINE, SHUT OFF, & CHECK DIPSTICK
 6) TOP OFF & PLACE ENGINE BACK IN SERVICE"

VALVE TAG SCHEDULE:

VALVE TAGS – 3"x5"x.08" ALUMINUM, 3/16" HOLES IN ALL FOUR CORNERS, BLACK GERBER THERMAL TRANSFER FILM PRINTED LETTERS ON GERBER 220 HIGH PERFORMANCE VINYL BACKGROUND, COLOR AS INDICATED, ONE SIDE ONLY. WARNING LITES OR APPROVED EQUAL.
 NOTE: PROVIDE TAGS NOTED AS DECALS WITHOUT ALUMINUM BACKING PLATE.

- GREEN (DIESEL FUEL)
 - #21 "NORMALLY OPEN, CLOSE ONLY FOR EMERGENCIES & TEMPORARY MAINTENANCE OF DAY TANK & DEVICES"
 - #22 "NORMALLY CLOSED, OPEN ONLY FOR HAND PRIMING DAY TANK"
 - #23 NOT USED
 - #24 "NORMALLY OPEN, CLOSE ONLY FOR TEMPORARY MAINTENANCE OF ENGINE"
- BROWN (USED OIL)
 - #41 "NORMALLY CLOSED, OPEN ONLY FOR ENGINE OIL CHANGE"
- PINK (COOLING/ETHYLENE GLYCOL)
 - #51 "NORMALLY CLOSED, OPEN ONLY FOR ADDING COOLANT – ETHYLENE GLYCOL ONLY"
 - #52 "NORMALLY CLOSED, OPEN ONLY ON HIGH COOLANT TEMPERATURE ALARM"
 - #53 "NORMALLY OPEN, CLOSE ONLY ON HIGH COOLANT TEMPERATURE ALARM"
 - #54 "NORMALLY OPEN, HEAT RECOVERY SUPPLY"
 - #55 "NORMALLY OPEN, HEAT RECOVERY RETURN"
- ORANGE (HEAT RECOVERY/PROPYLENE GLYCOL)
 - #61 "NORMALLY CLOSED, OPEN ONLY FOR ADDING FLUID – PROPYLENE GLYCOL ONLY"
 - #62 "NORMALLY OPEN, HEAT RECOVERY SUPPLY"
 - #63 "NORMALLY OPEN, HEAT RECOVERY RETURN"
 - #64 "NORMALLY OPEN, CLOSE ONLY FOR TEMPORARY MAINTENANCE OF SYSTEM"

INSTALLATION – SECURE EACH TAG TIGHT TO VALVE, PIPE, OR DEVICE WITH STAINLESS STEEL CABLE TIES OR SAFETY WIRE THROUGH ALL FOUR CORNERS OR FASTEN TO ADJACENT WALL OR SECTION OF STRUT WITH SCREWS.

NOTES:


- 1) SEE DRAWINGS THAT FOLLOW FOR LOCATIONS OF ALL SPECIFIC FUNCTION TAGS.
- 2) FOR ALL VALVES NOT INDICATED WITH A SPECIFIC FUNCTION TAG PROVIDE 1-1/2"Ø BRASS TAG LABELED "N.O." FOR NORMALLY OPEN VALVES AND 1"Ø BRASS TAG LABELED "N.C." FOR NORMALLY CLOSED VALVES. SECURE TAGS TO VALVE OR ADJACENT PIPE WITH BEADED BRASS CHAIN.

MODULE SHOP/ON-SITE NOTES:


- 1) FURNISH AND INSTALL ALL DECALS, SIGN BOARDS. AND FIRE EXTINGUISHERS AS PART OF THE MODULE SHOP FABRICATION WORK.
- 2) FURNISH AND INSTALL ALL VALVE TAGS AS PART OF THE MODULE SHOP FABRICATION WORK.


1 POWER PLANT WARNING SIGN/PLACARD & FIRE EXTINGUISHER PLAN
 M1.2 1/4"=1'-0"

ISSUED FOR
 CONSTRUCTION
 JANUARY 2019

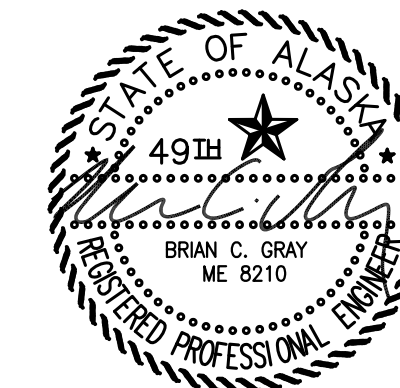


PROJECT: PORT HEIDEN RURAL POWER SYSTEM POWER PLANT UPGRADE		
TITLE: WARNING SIGN & FIRE EXTINGUISHER PLAN, SIGN & VALVE TAG SCHEDULES		
DRAWN BY: JTD	SCALE: AS NOTED	
DESIGNED BY: BCG	DATE: 1-14-19	
FILE NAME: PTH PPU M2-7	SHEET: M1.2	OF 7
PROJECT NUMBER: P.O. 111405, Anchorage, AK 99511 (907)349-0100		

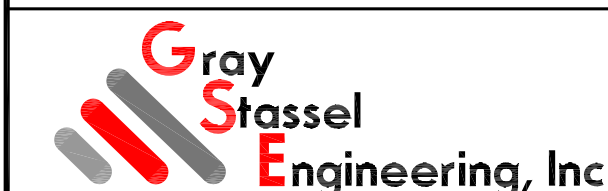

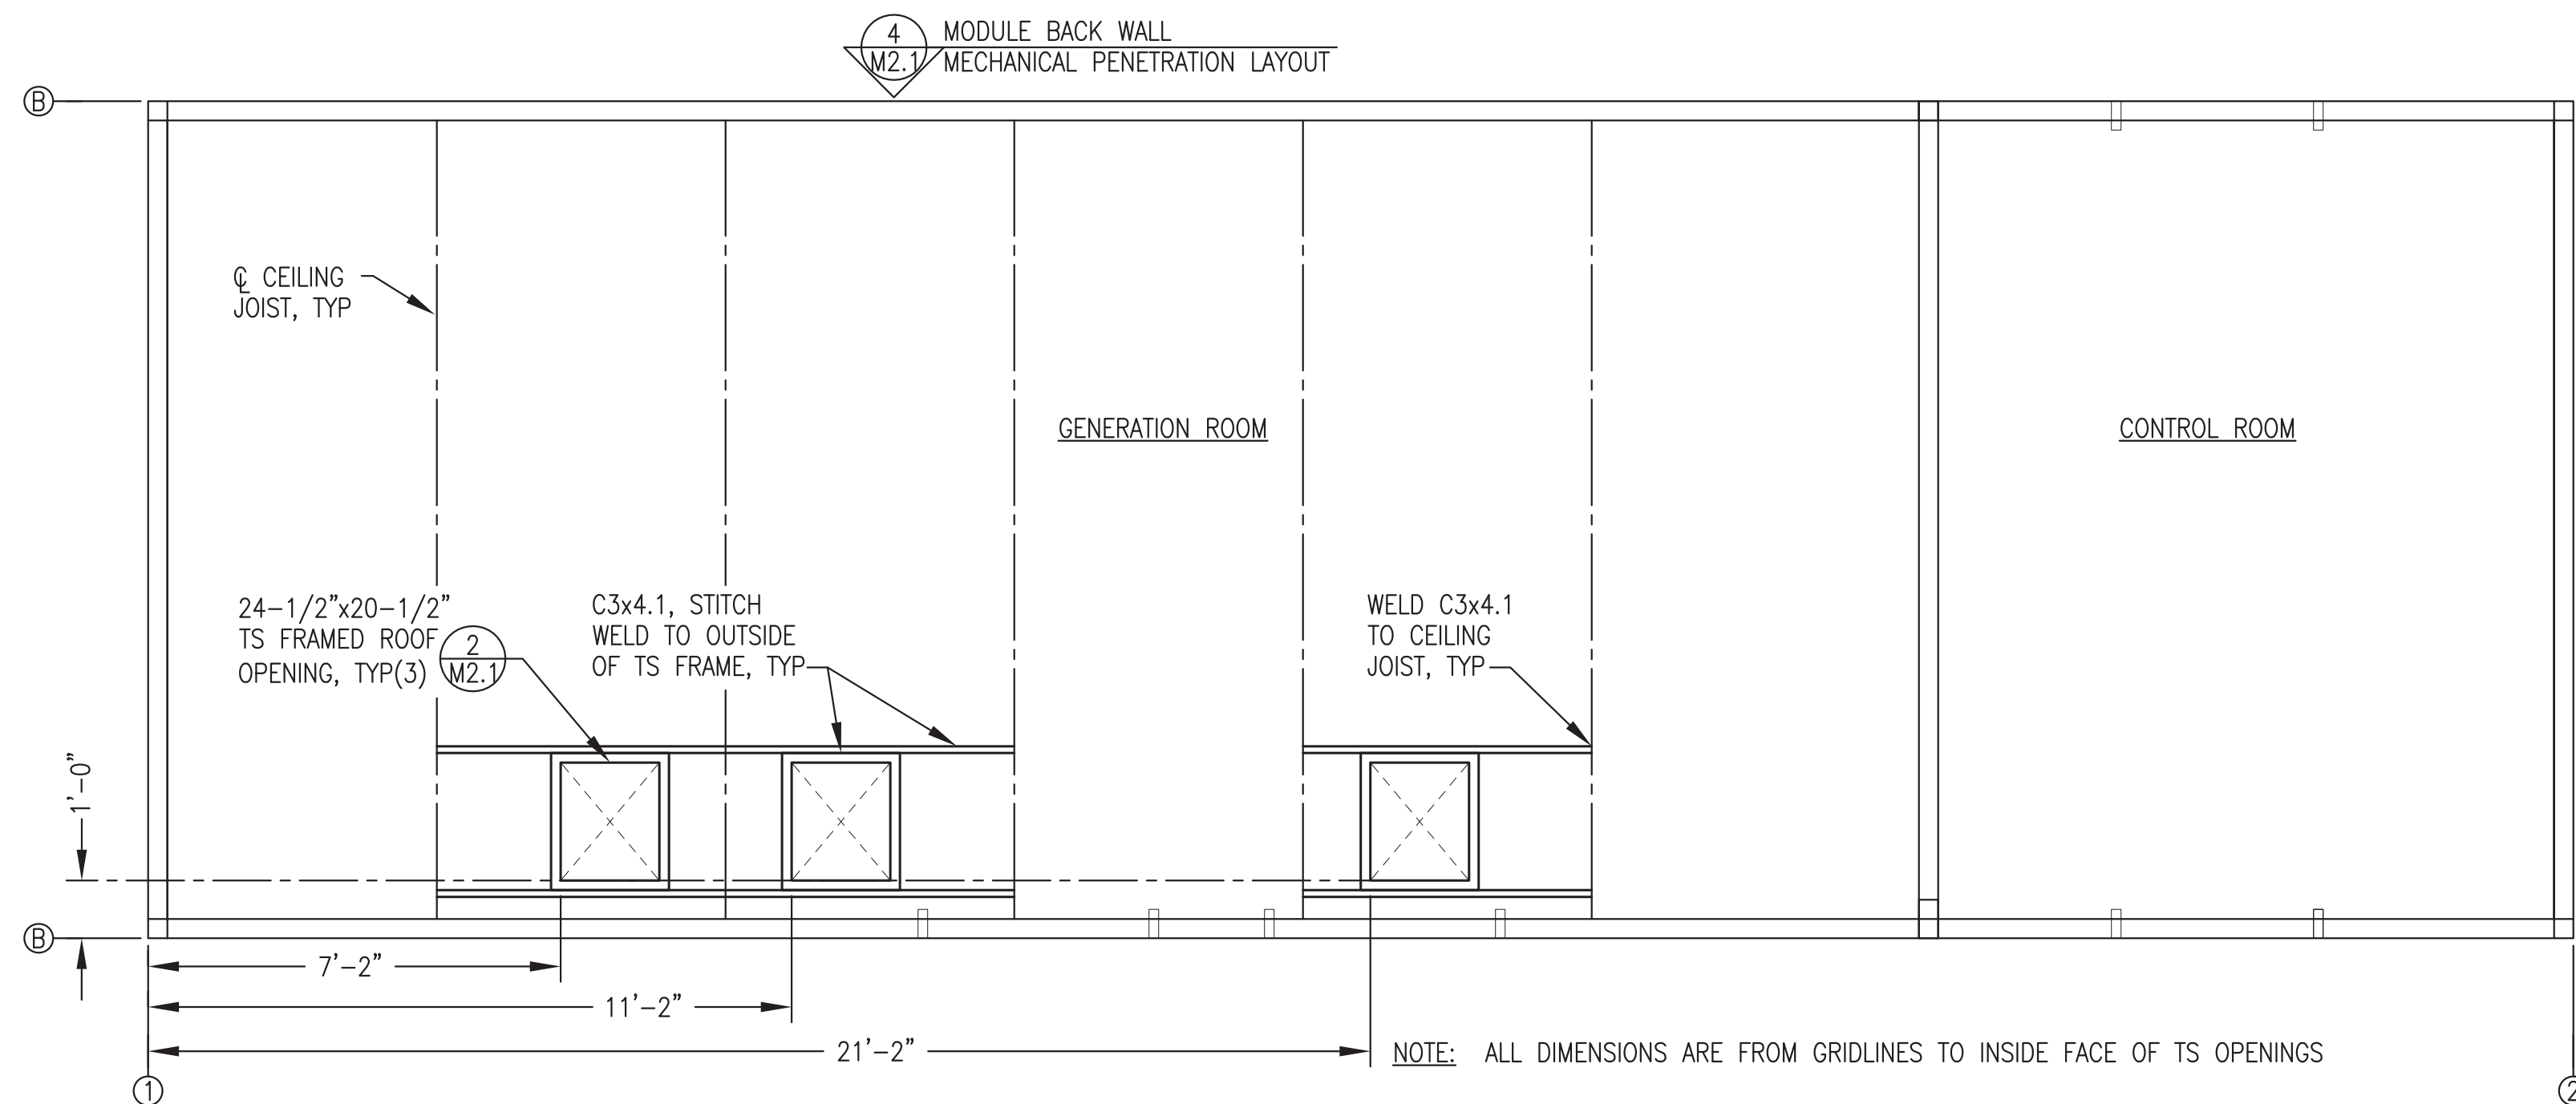


1 MODULE MECHANICAL ROOF PENETRATION PLAN
M2.1 3/8"=1'-0"

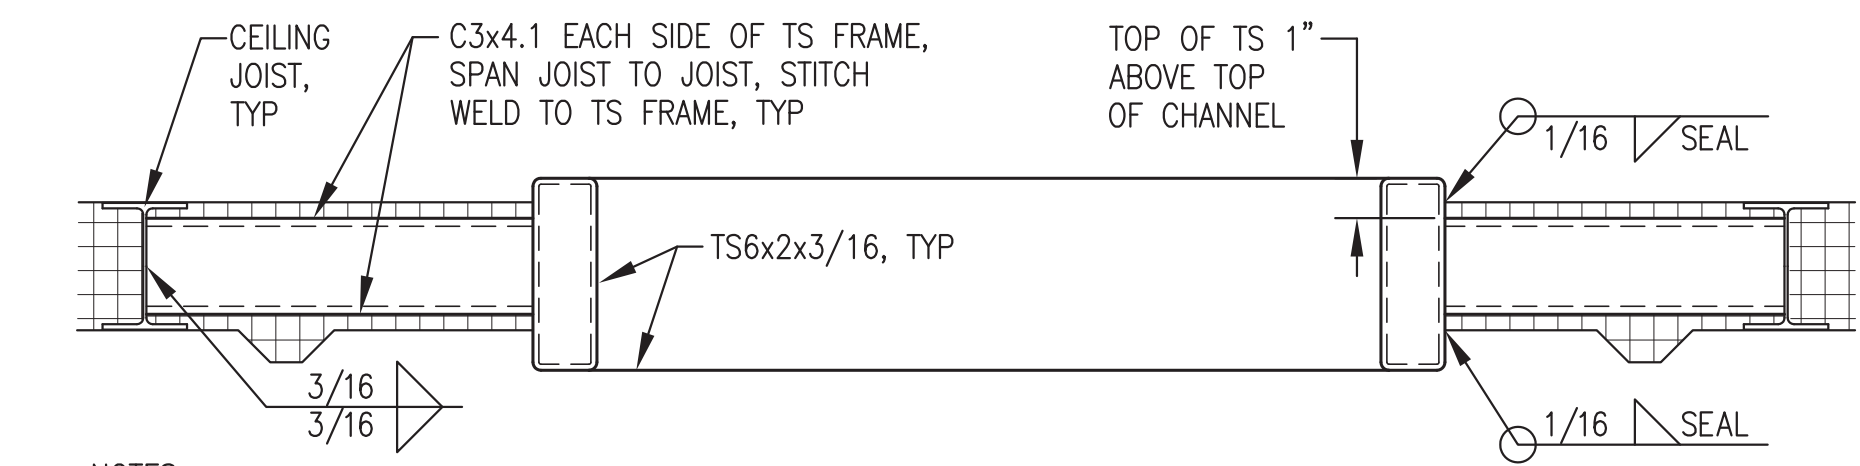


- NOTES:
- 1) FABRICATE FRAMED OPENING WITH MITERED CORNERS AND FULL PENETRATION GROOVE WELDS.
 - 2) FABRICATE TO FINISHED INSIDE (CLEAR) DIMENSIONS INDICATED ON PLANS.
 - 3) GRIND OUT INSIDE OF MITERED CORNERS TO PROVIDE FULL CLEAR OPENING.

2 TYPICAL ROOF OPENING DETAIL
M2.1 2"=1'-0"

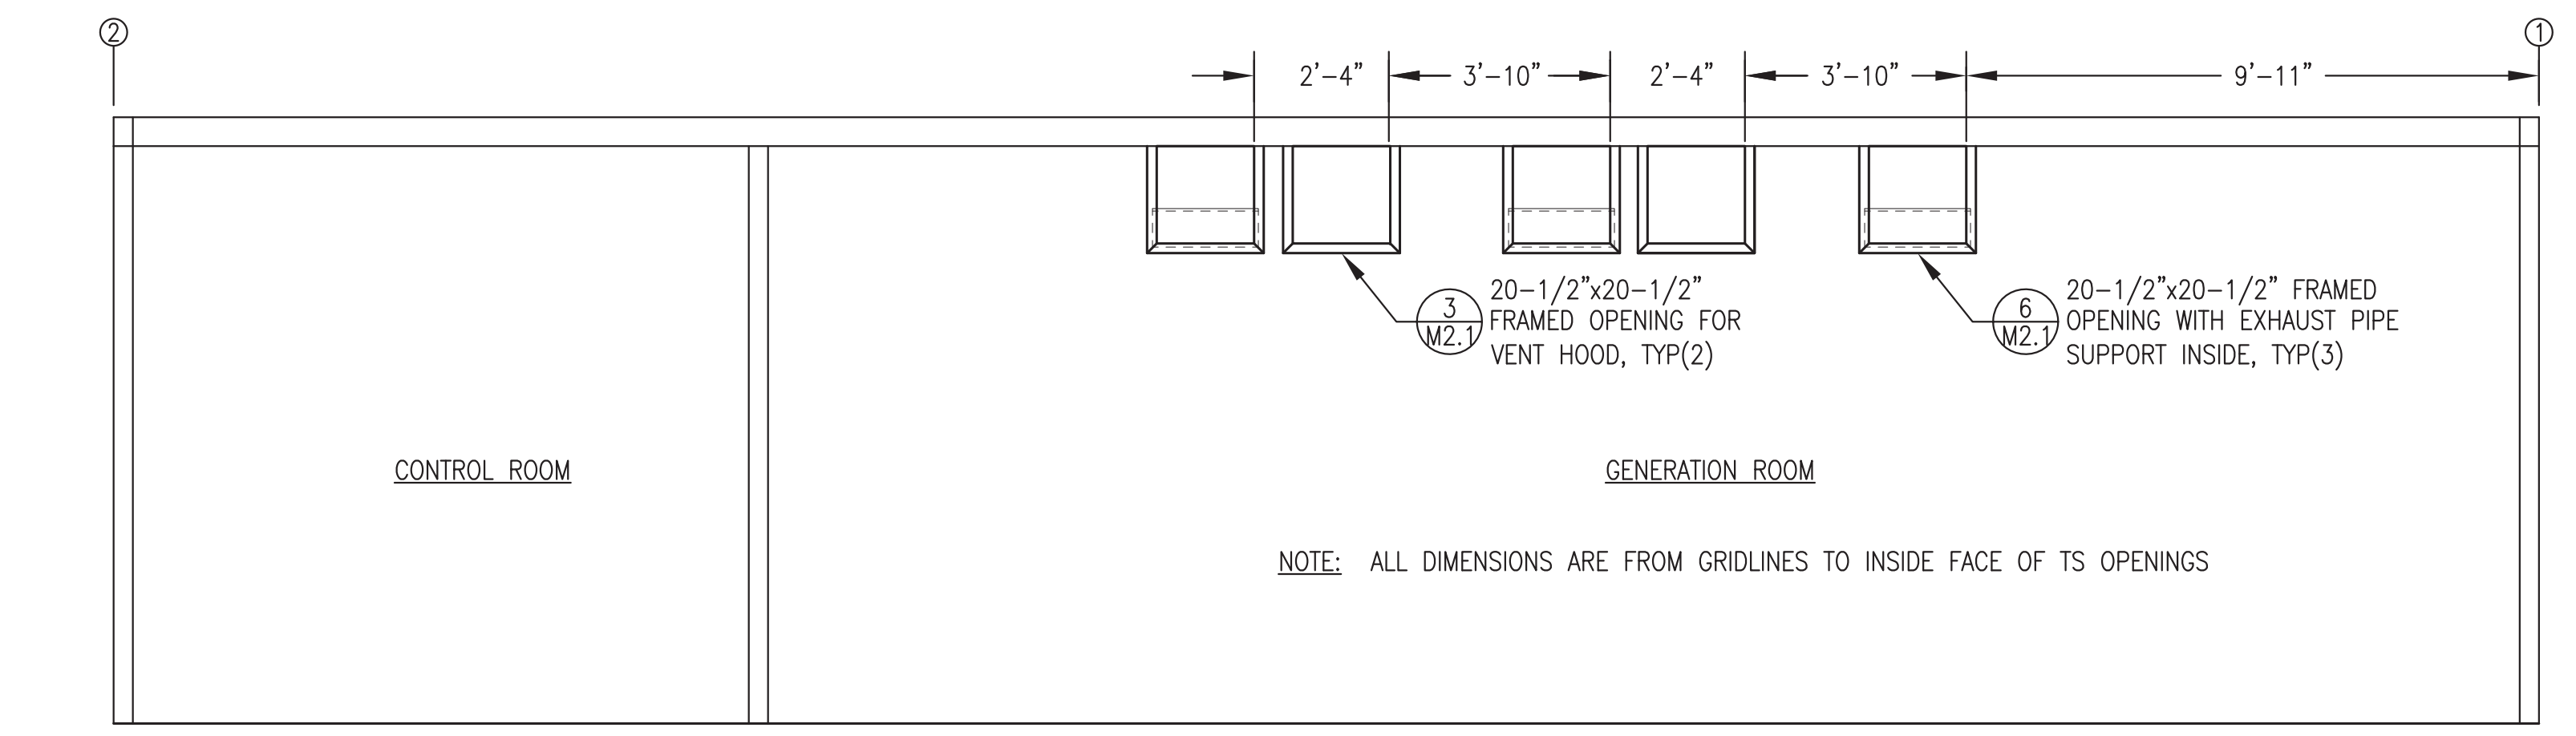


4 MODULE MECHANICAL WALL PENETRATIONS AT GRID A - EXTERIOR ELEVATION
M2.1 1/2"=1'-0"

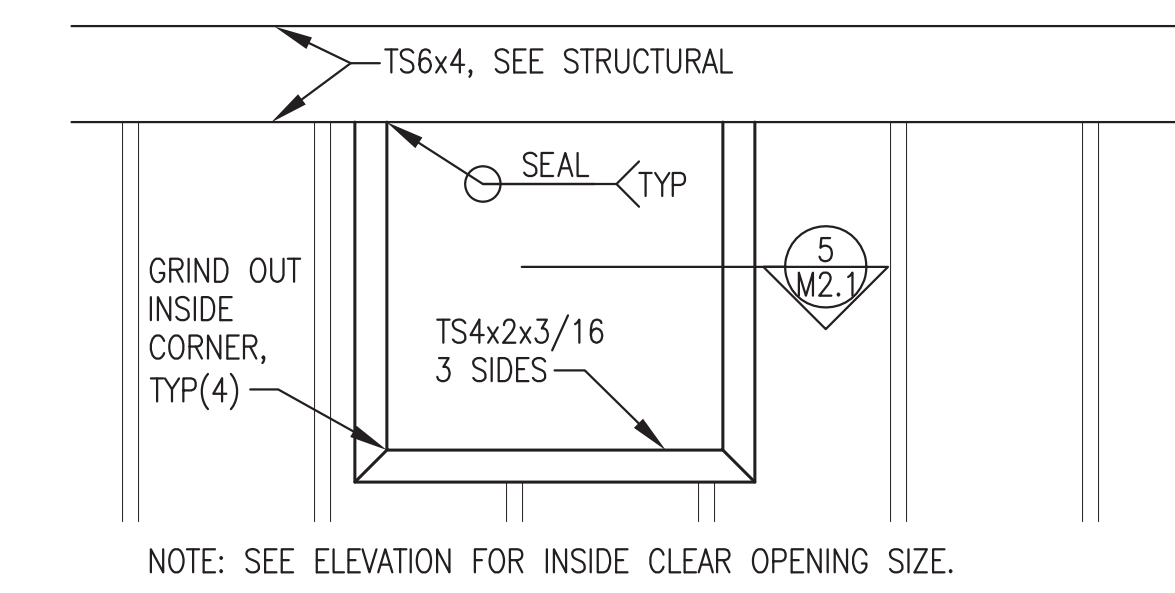


3 TYPICAL WALL OPENING - ELEVATION
M2.1 1"=1'-0"

NOTE: THIS DRAWING SHOWS WORK THAT WAS PERFORMED BY OTHERS AS PART OF THE FABRICATION OF THE OWNER FURNISHED MODULE STRUCTURE AND IS PROVIDED FOR REFERENCE ONLY. SEE OWNER FURNISHED MODULE SHOP DRAWINGS FOR ADDITIONAL DETAIL.

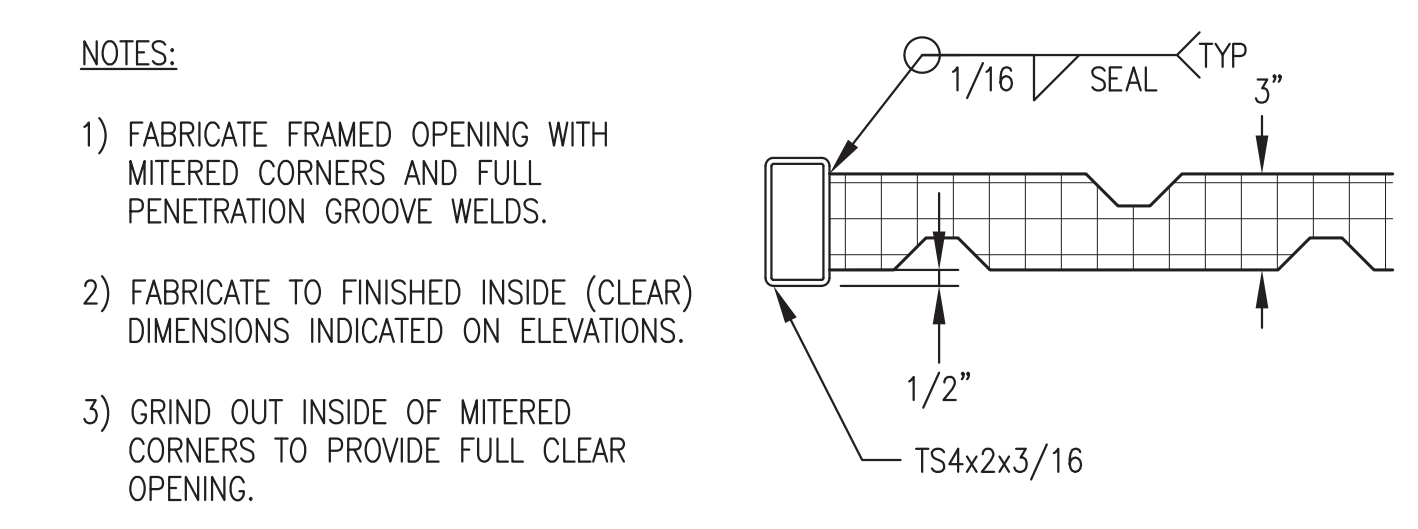

5 TYPICAL SECTION THROUGH WALL OPENING
M2.1 2"=1'-0"

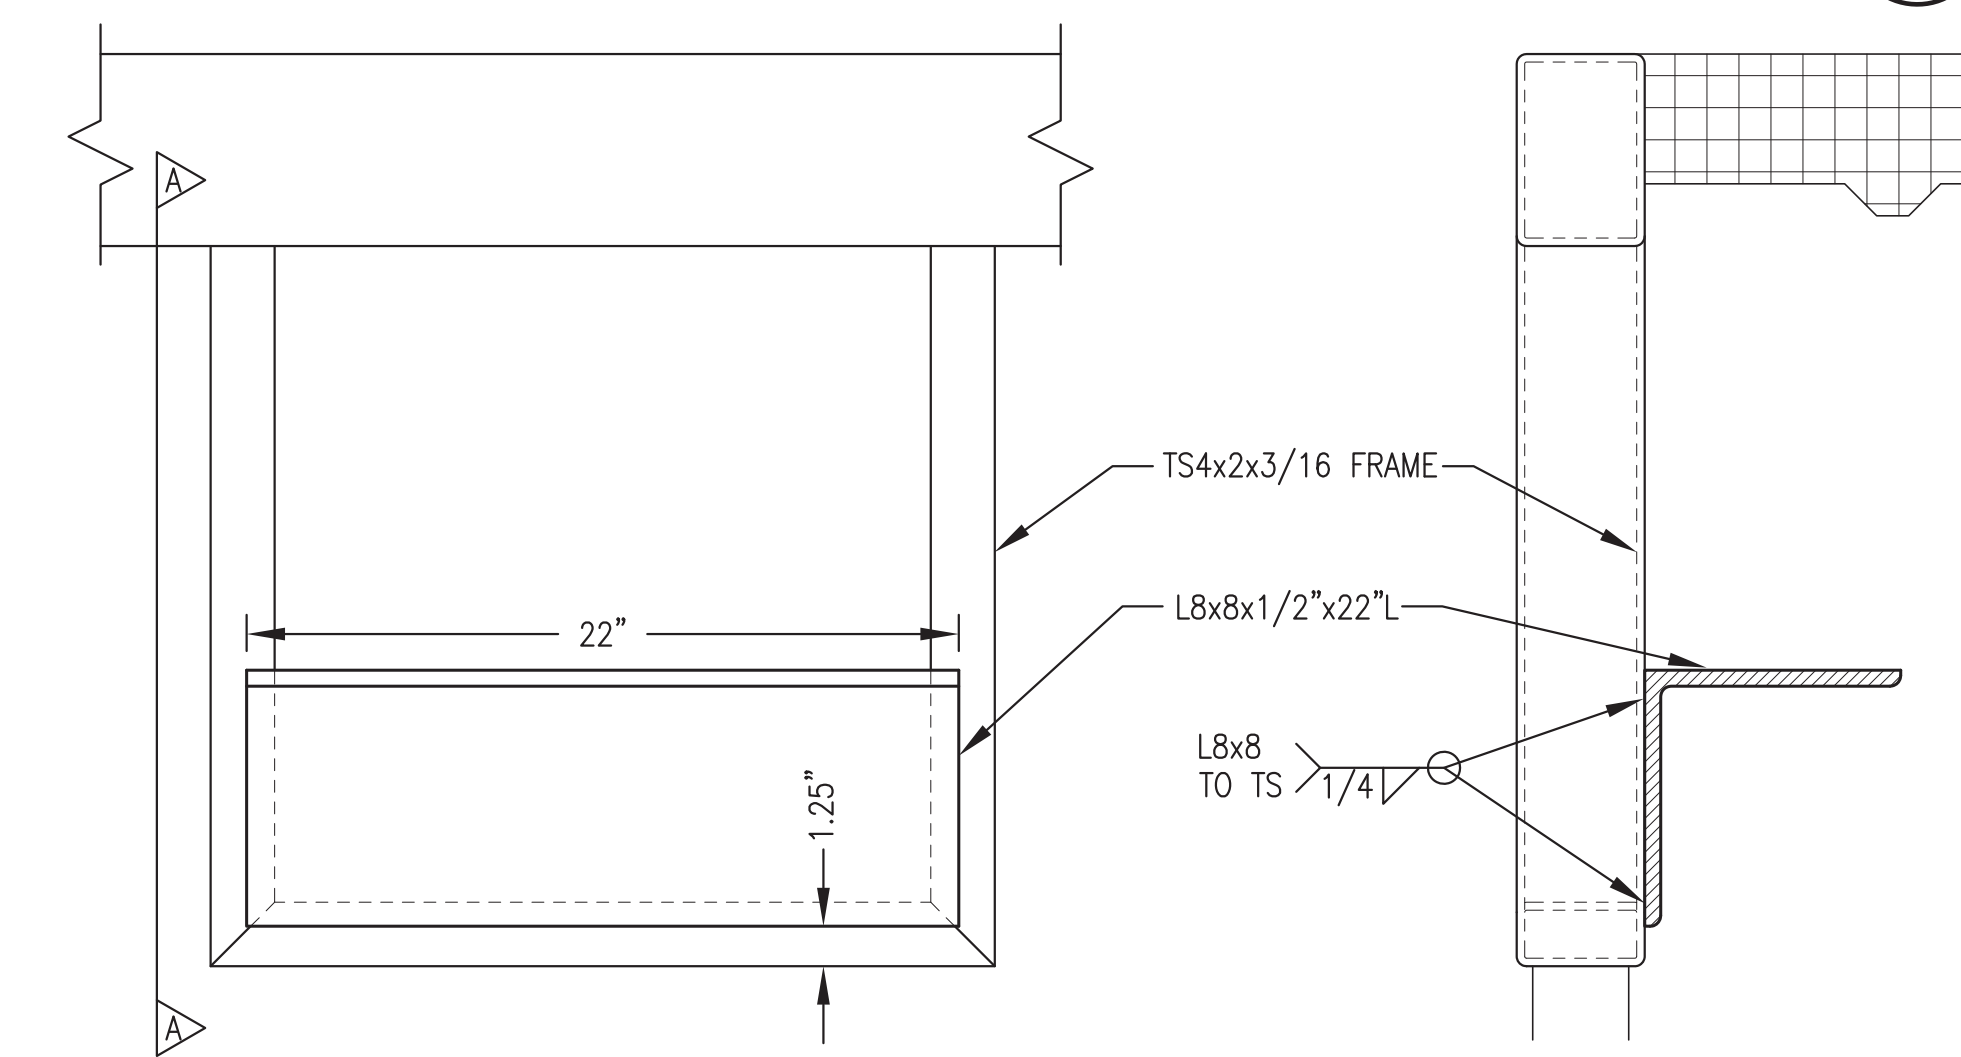


6 EXHAUST PIPE SUPPORT AT FRAMED OPENING
M2.1 2"=1'-0"

ISSUED FOR CONSTRUCTION
JANUARY 2019




 ALASKA ENERGY AUTHORITY		
PROJECT: PORT HEIDEN RURAL POWER SYSTEM POWER PLANT UPGRADE		
TITLE: MECHANICAL PENETRATIONS PLAN, ELEVATION, & DETAILS		
 Gray Stassel Engineering, Inc. P.O. 111405, Anchorage, AK 99511 (907)349-0100	DRAWN BY: JTD DESIGNED BY: BCG FILE NAME: PTH PPU M2-7 PROJECT NUMBER:	SCALE: AS NOTED DATE: 1-14-19 SHEET: M2.1 OF 7


NOTE: ALL DIMENSIONS FROM GRIDLINE (OUTSIDE OF DECK)

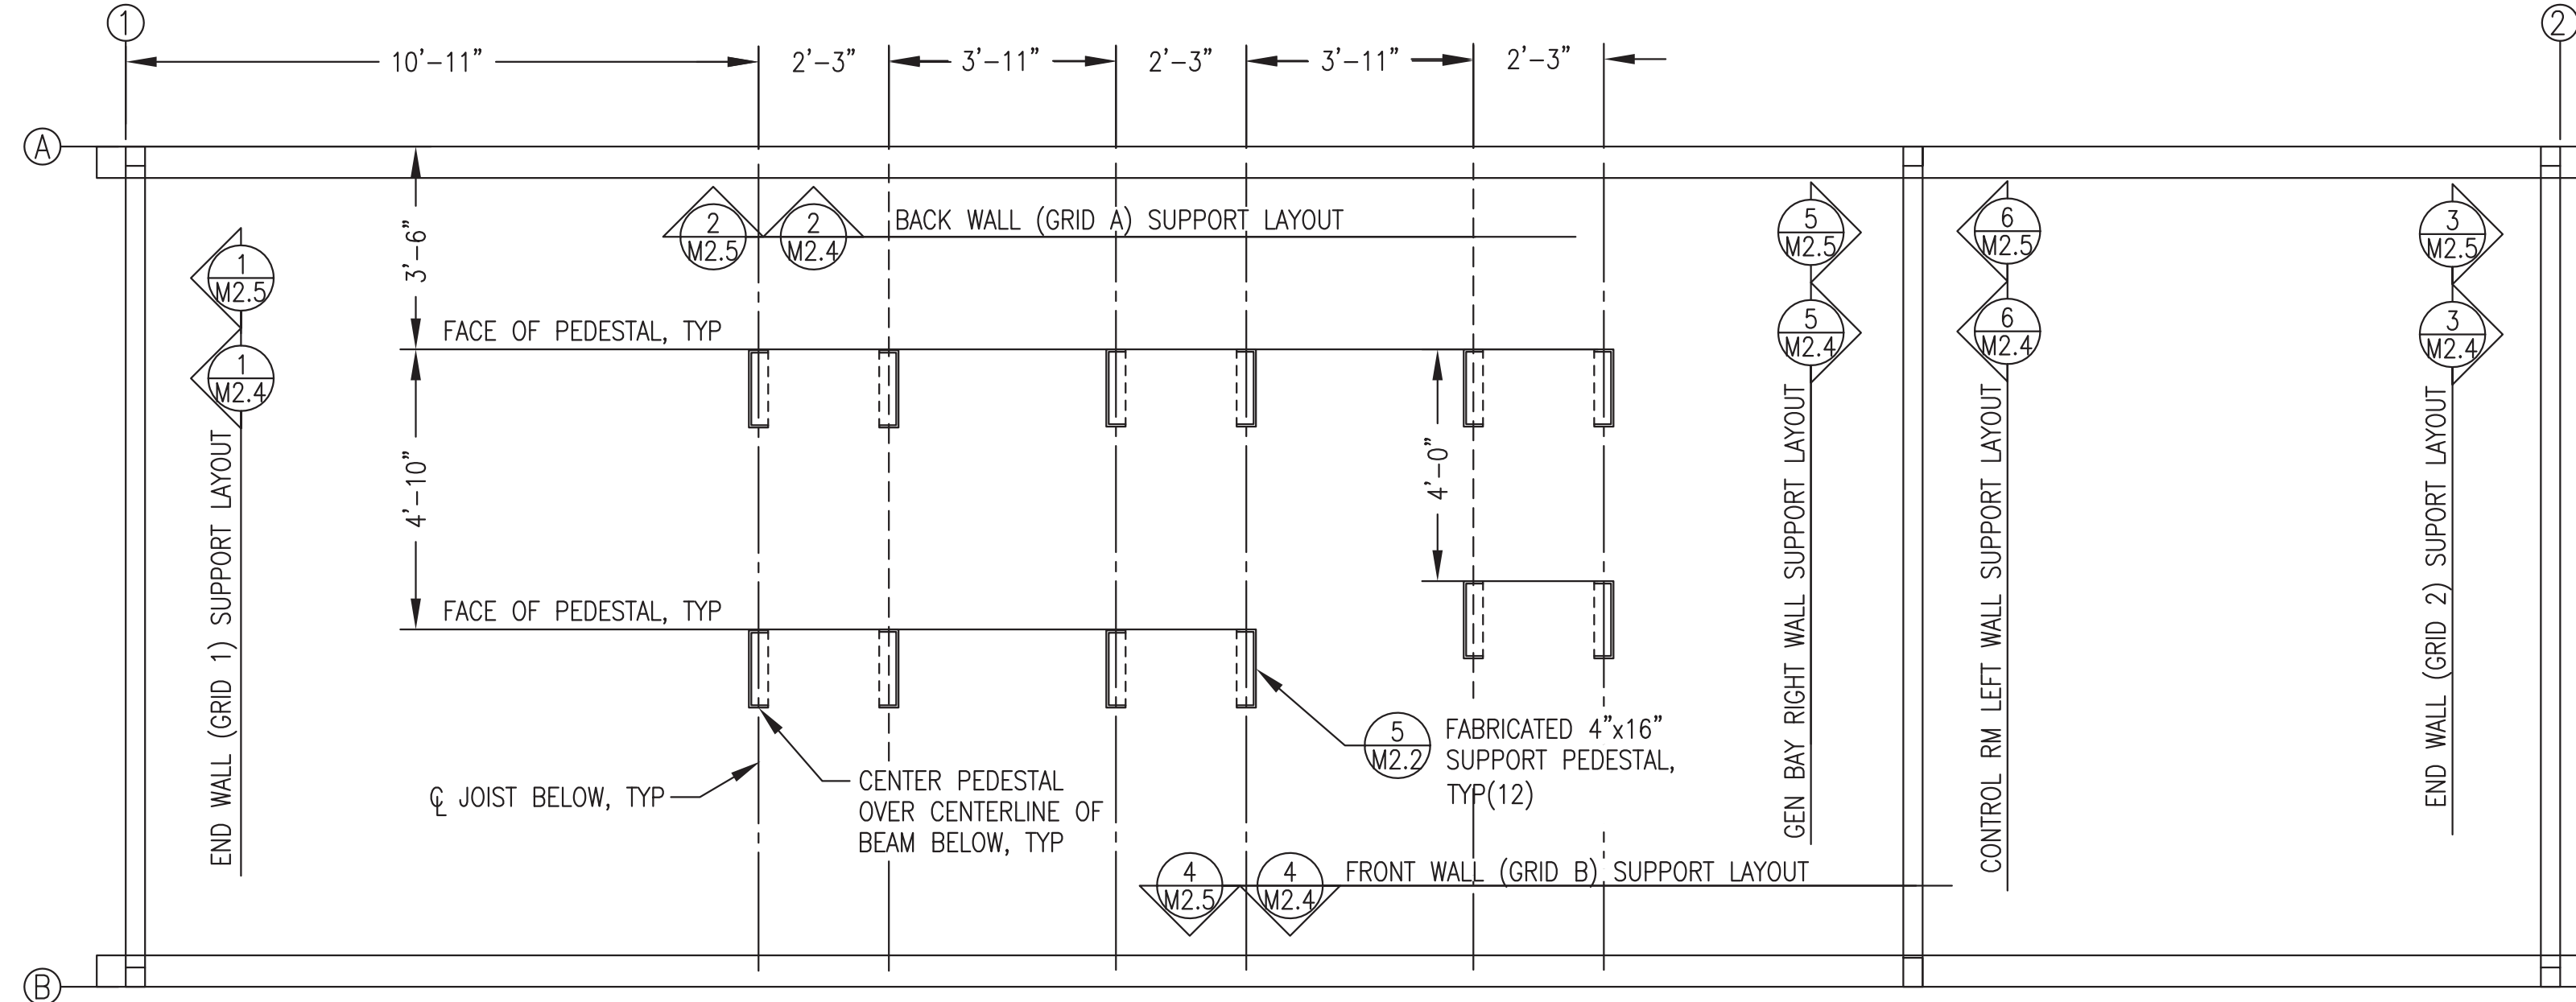



1 MODULE MECHANICAL SUPPORT PLAN
M2.2 3/8"=1'-0"

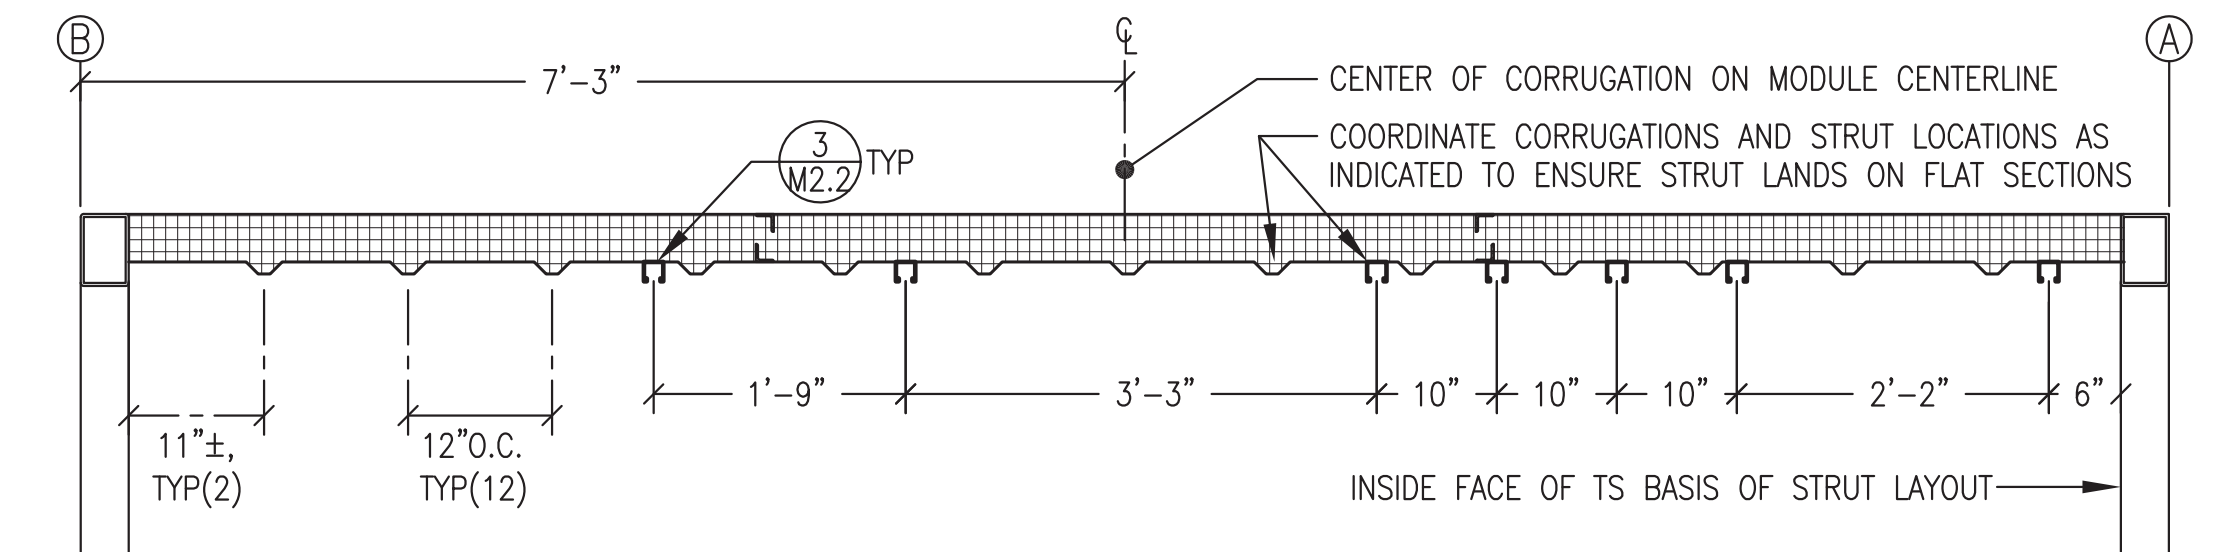

2 SECTION THROUGH CEILING - CORRUGATION & STRUT LAYOUT
M2.2 3/4"=1'-0"

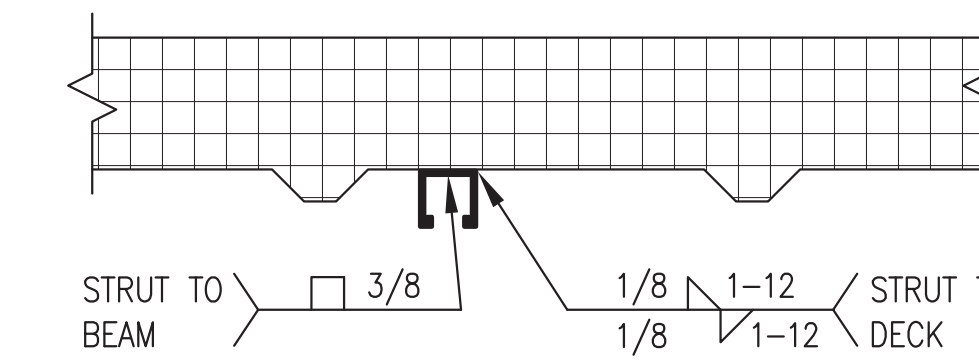

3 STRUT ATTACHMENT TO CEILING
M2.2 NO SCALE

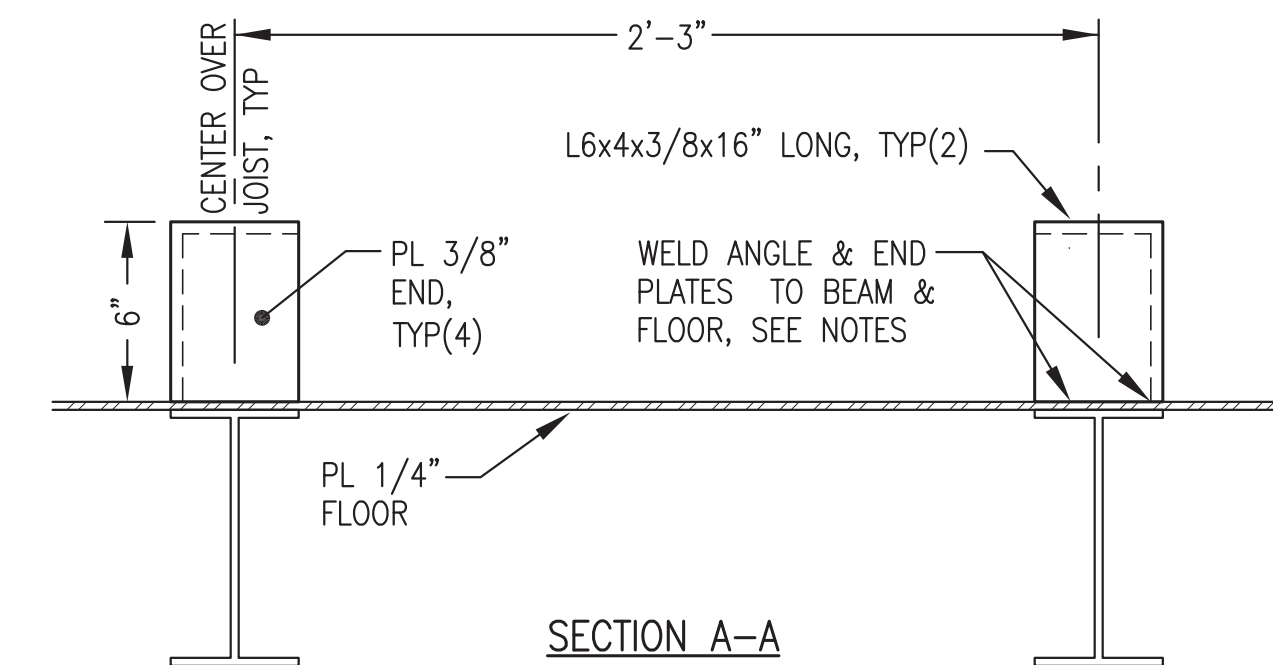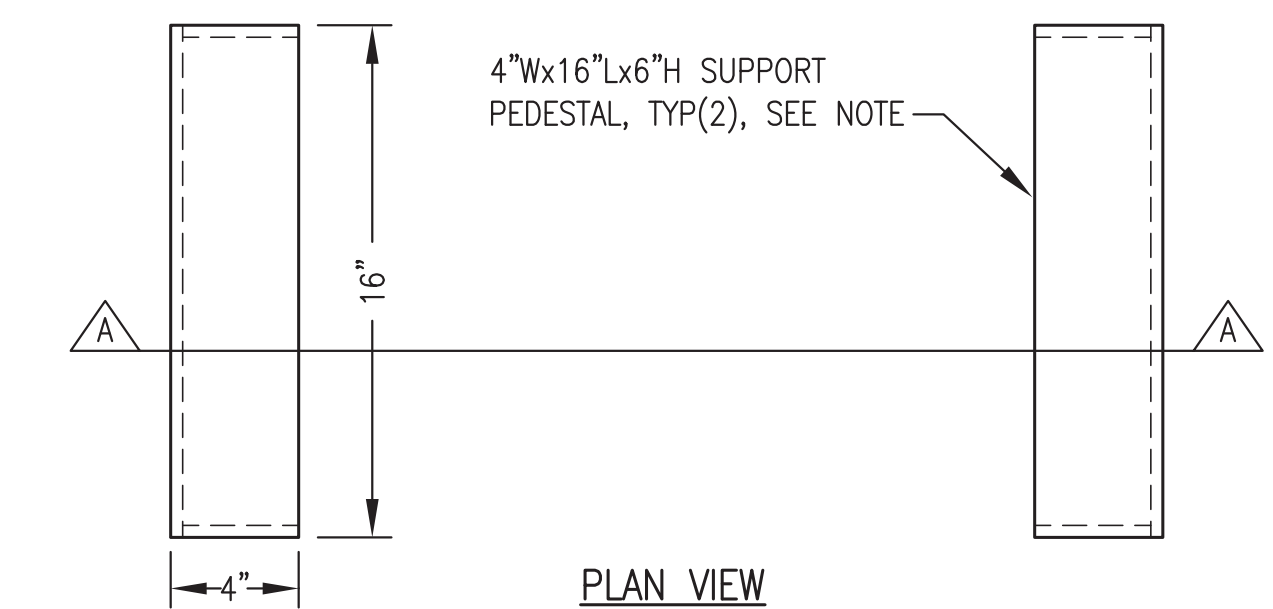


NOTES: 1) MAKE ALL JOINTS WITH CONTINUOUS GROOVE OR FILLET WELDS.
2) SLOT FLOOR PLATE 3 SIDES THEN WELD PEDESTAL TO TOP OF BEAM AND SEAL WELD TO FLOOR PLATE ALL AROUND.


5 SUPPORT PEDESTAL FABRICATION
M2.2 2"=1'-0"

NOTE: THIS DRAWING SHOWS WORK THAT WAS PERFORMED BY OTHERS AS PART OF THE FABRICATION OF THE OWNER FURNISHED MODULE STRUCTURE AND IS PROVIDED FOR REFERENCE ONLY. SEE OWNER FURNISHED MODULE SHOP DRAWINGS FOR ADDITIONAL DETAIL.

- GENERAL NOTES:**
- 1) FABRICATE PEDESTALS FROM ASTM A36 ANGLE AND PLATES AS SHOWN.
 - 2) ALL STRUT 12 GAUGE 1-5/8"x1-5/8" SOLID BACK PLAIN (UNFINISHED). B-LINE B22-PLN OR EQUAL. PURCHASE IN 20' LENGTHS TO MINIMIZE SPLICES.
 - 3) INSTALL ALL SUPPORTS INDICATED AND GRIND SMOOTH PRIOR TO SANDBLASTING MODULE. SANDBLAST AND PAINT ALL SUPPORTS THIS SHEET EQUIVALENT TO MODULE INTERIOR. SEE SHEET A1 FOR PAINTING SPECIFICATIONS.

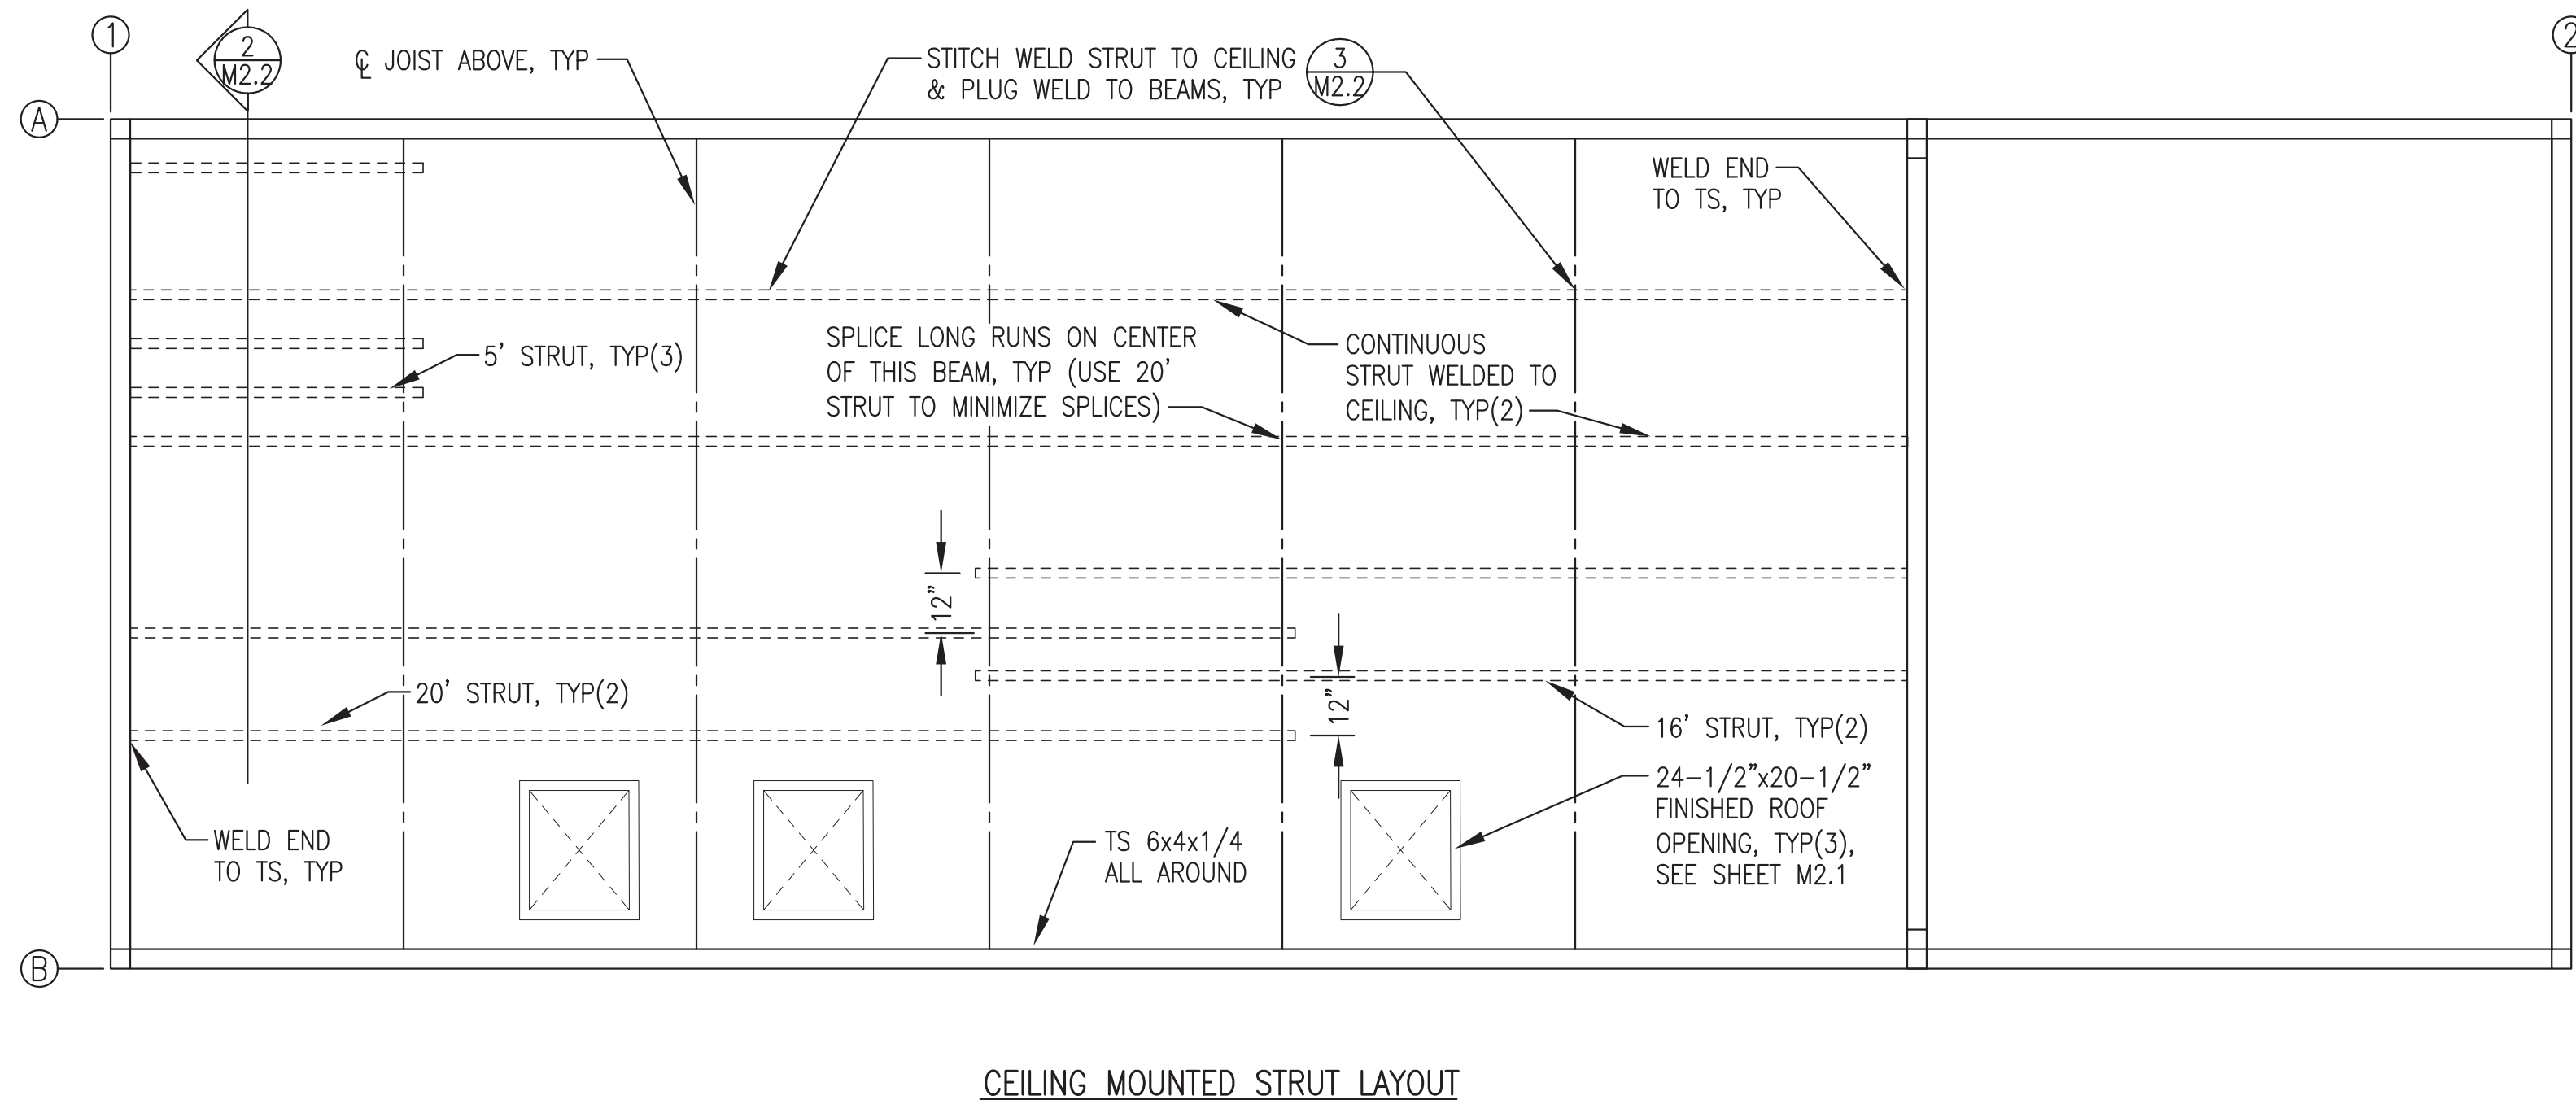

4 CEILING STRUT SUPPORT LAYOUT PLAN
M2.2 3/8"=1'-0"

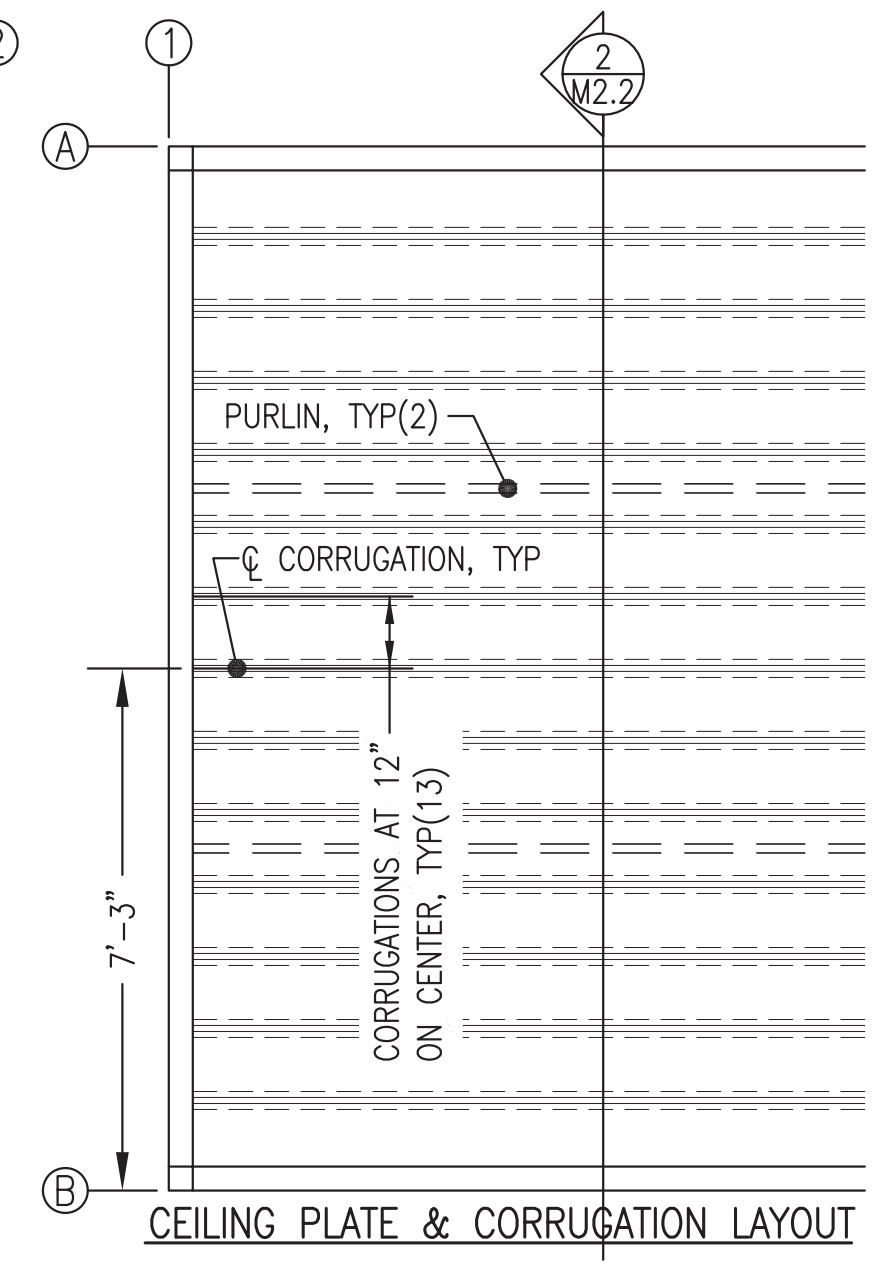


CEILING PLATE & CORRUGATION LAYOUT



ISSUED FOR CONSTRUCTION
JANUARY 2019



ALASKA ENERGY AUTHORITY		
PROJECT: PORT HEIDEN RURAL POWER SYSTEM POWER PLANT UPGRADE		
TITLE: MECHANICAL SUPPORT PLANS & DETAILS		
	DRAWN BY: JTD DESIGNED BY: BCG FILE NAME: PTH PPU M2-7 PROJECT NUMBER:	SCALE: AS NOTED DATE: 1-14-19 SHEET: M2.2 OF 7
P.O. 111405, Anchorage, AK 99511 (907)349-0100		

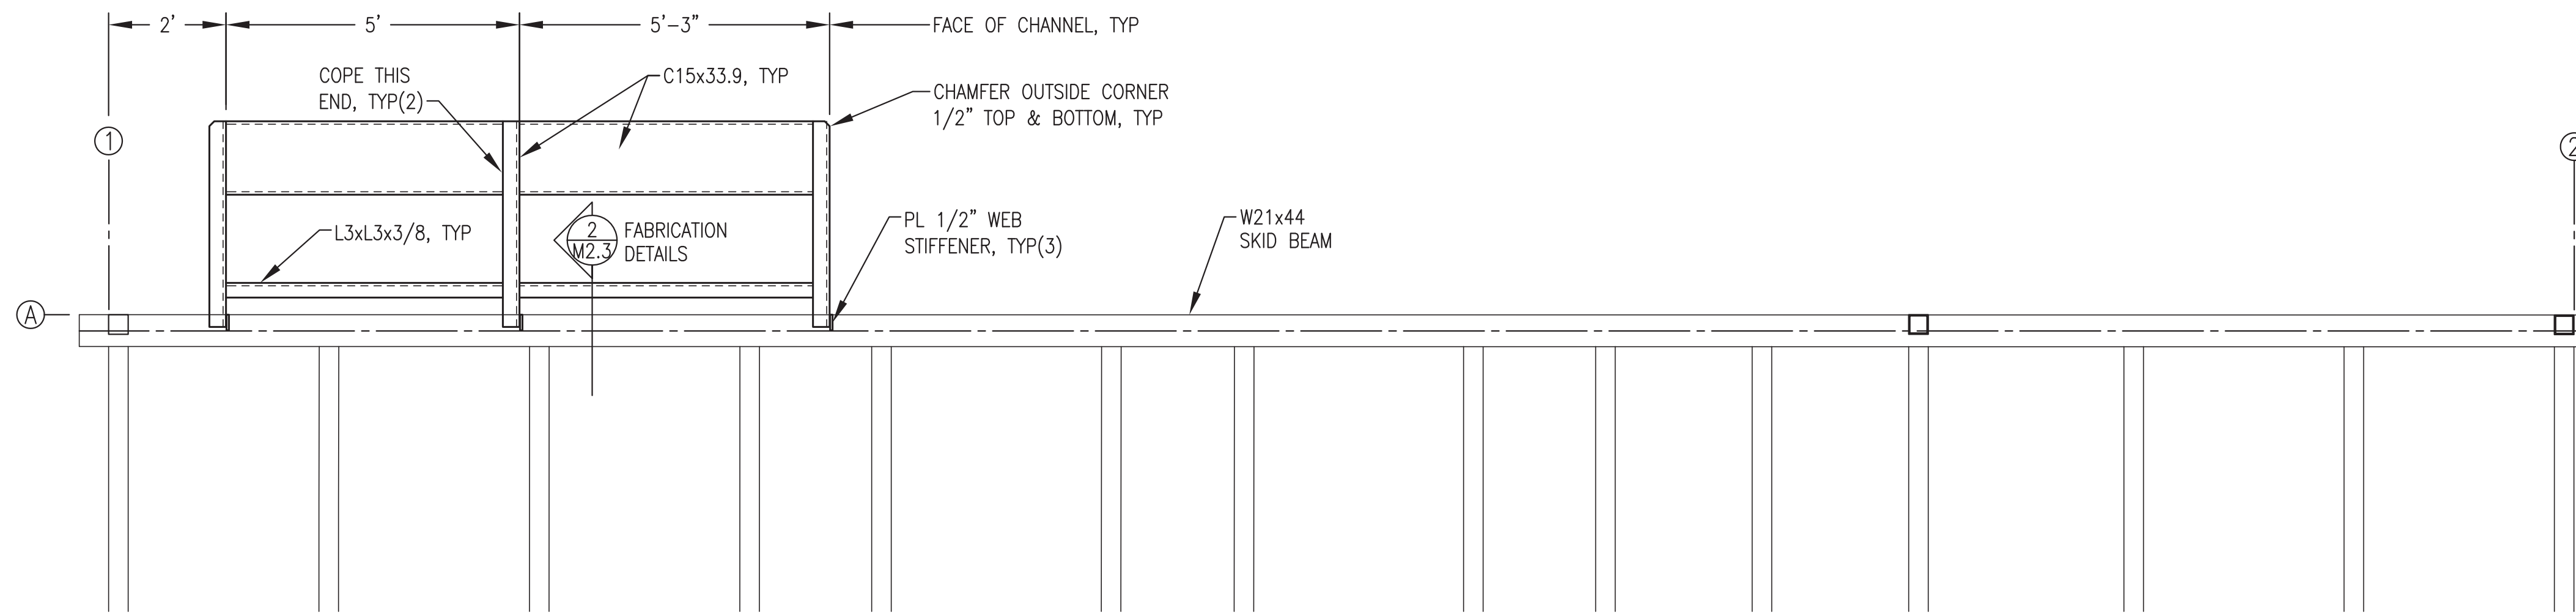

1 RADIATOR SUPPORT PLAN
 M2.3 1/2"=1'-0"

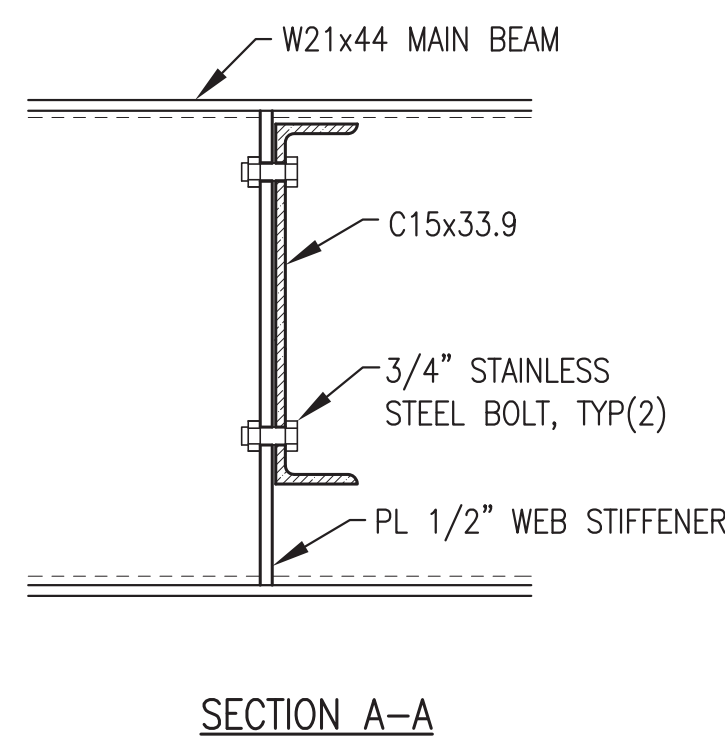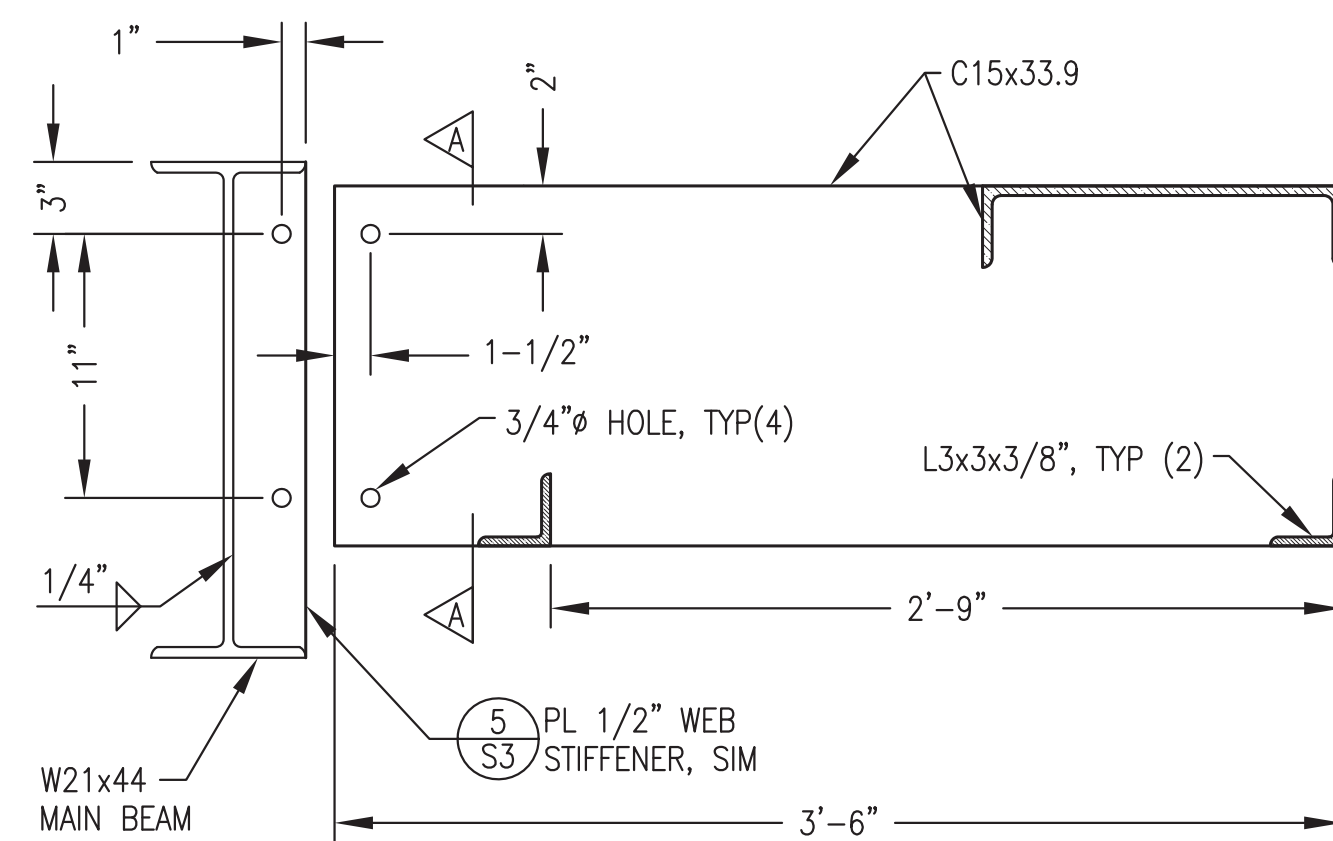


- SUPPORT FABRICATION NOTES:**
- 1) FABRICATE SUPPORT FROM ASTM A36 ANGLE & CHANNEL AS SHOWN.
 - 2) RACK ALL SUPPORT BRACKETS LEVEL & PERPENDICULAR TO SKID WITH CONNECTIONS BOLTED TIGHT PRIOR TO WELDING.
 - 3) UPON COMPLETION OF WELDING ROUND CORNERS AND GRIND EDGES SMOOTH.
 - 4) PRIOR TO SANDBLASTING MODULE REMOVE SUPPORTS THEN SANDBLAST AND PAINT EQUIVALENT TO MODULE EXTERIOR WALLS. SEE SHEET A1 FOR PAINTING SPECIFICATIONS.


NOTE: THIS DRAWING SHOWS WORK THAT WAS PERFORMED BY OTHERS AS PART OF THE FABRICATION OF THE OWNER FURNISHED MODULE STRUCTURE AND IS PROVIDED FOR REFERENCE ONLY. SEE OWNER FURNISHED MODULE SHOP DRAWINGS FOR ADDITIONAL DETAIL.

2 RADIATOR SUPPORT FABRICATION
 M2.3 1-1/2"=1'-0"


ISSUED FOR
 CONSTRUCTION
 JANUARY 2019

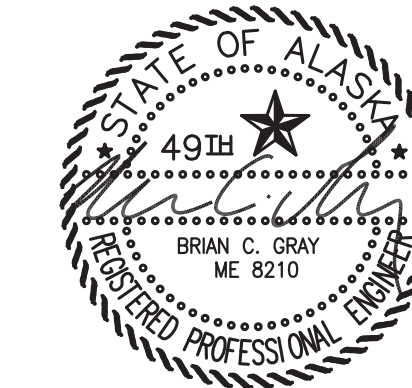


ALASKA ENERGY AUTHORITY		
PROJECT:	PORT HEIDEN RURAL POWER SYSTEM POWER PLANT UPGRADE	
TITLE:	RADIATOR SUPPORT PLAN & DETAILS	
	DRAWN BY: JTD	SCALE: AS NOTED
	DESIGNED BY: BCG	DATE: 1-14-19
	FILE NAME: PTH PPU M2-7	SHEET: M2.3 OF 7
P.O. 111405, Anchorage, AK 99511 (907)349-0100		

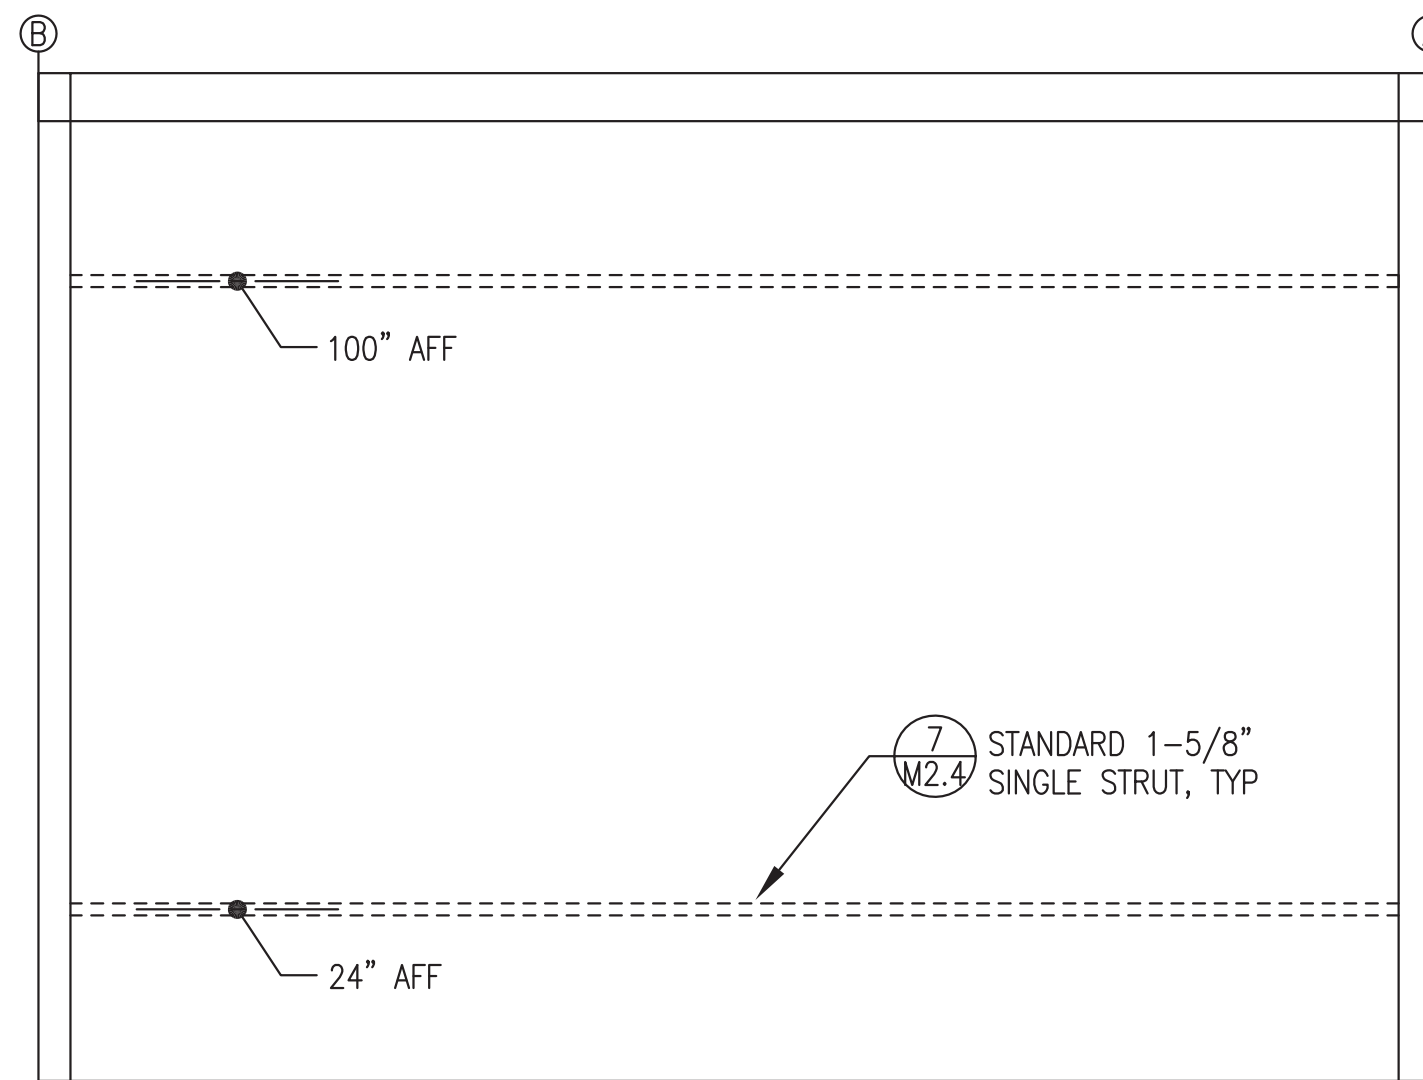


1 END WALL (GRID 1) HORIZONTAL WALL STRUT LAYOUT
M2.4 1/2"=1'-0"

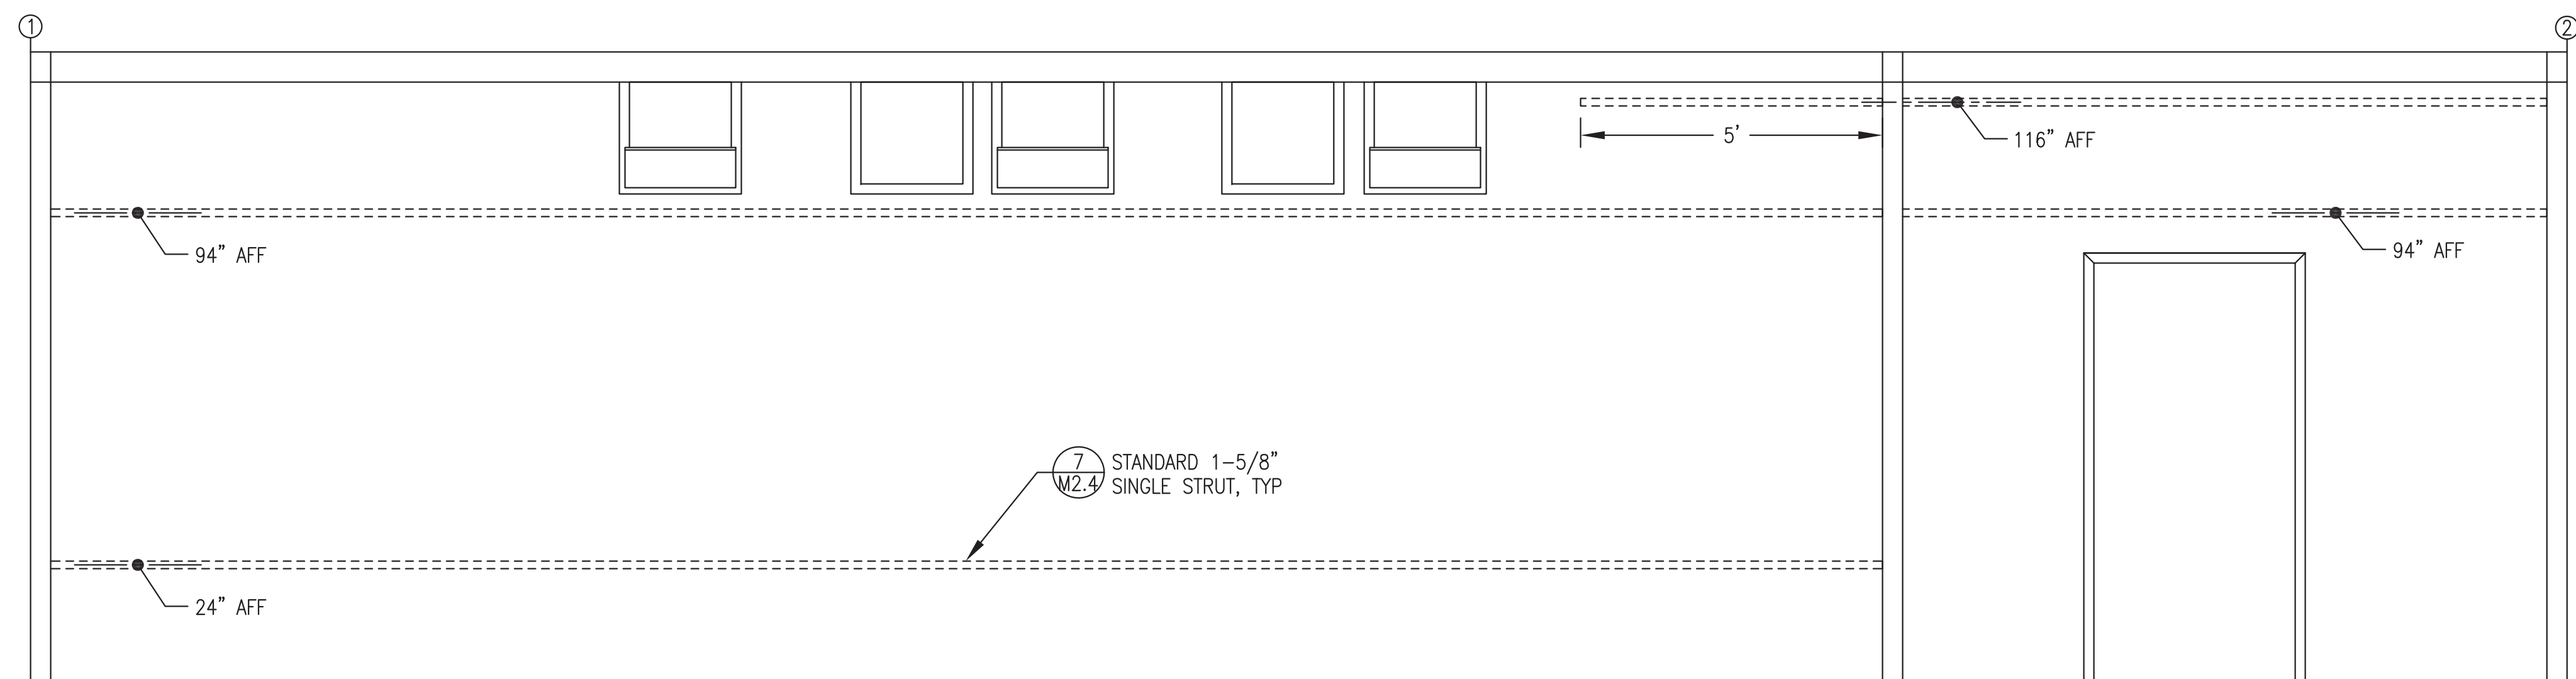


2 BACK WALL (GRID A) HORIZONTAL WALL STRUT LAYOUT
M2.4 1/2"=1'-0"

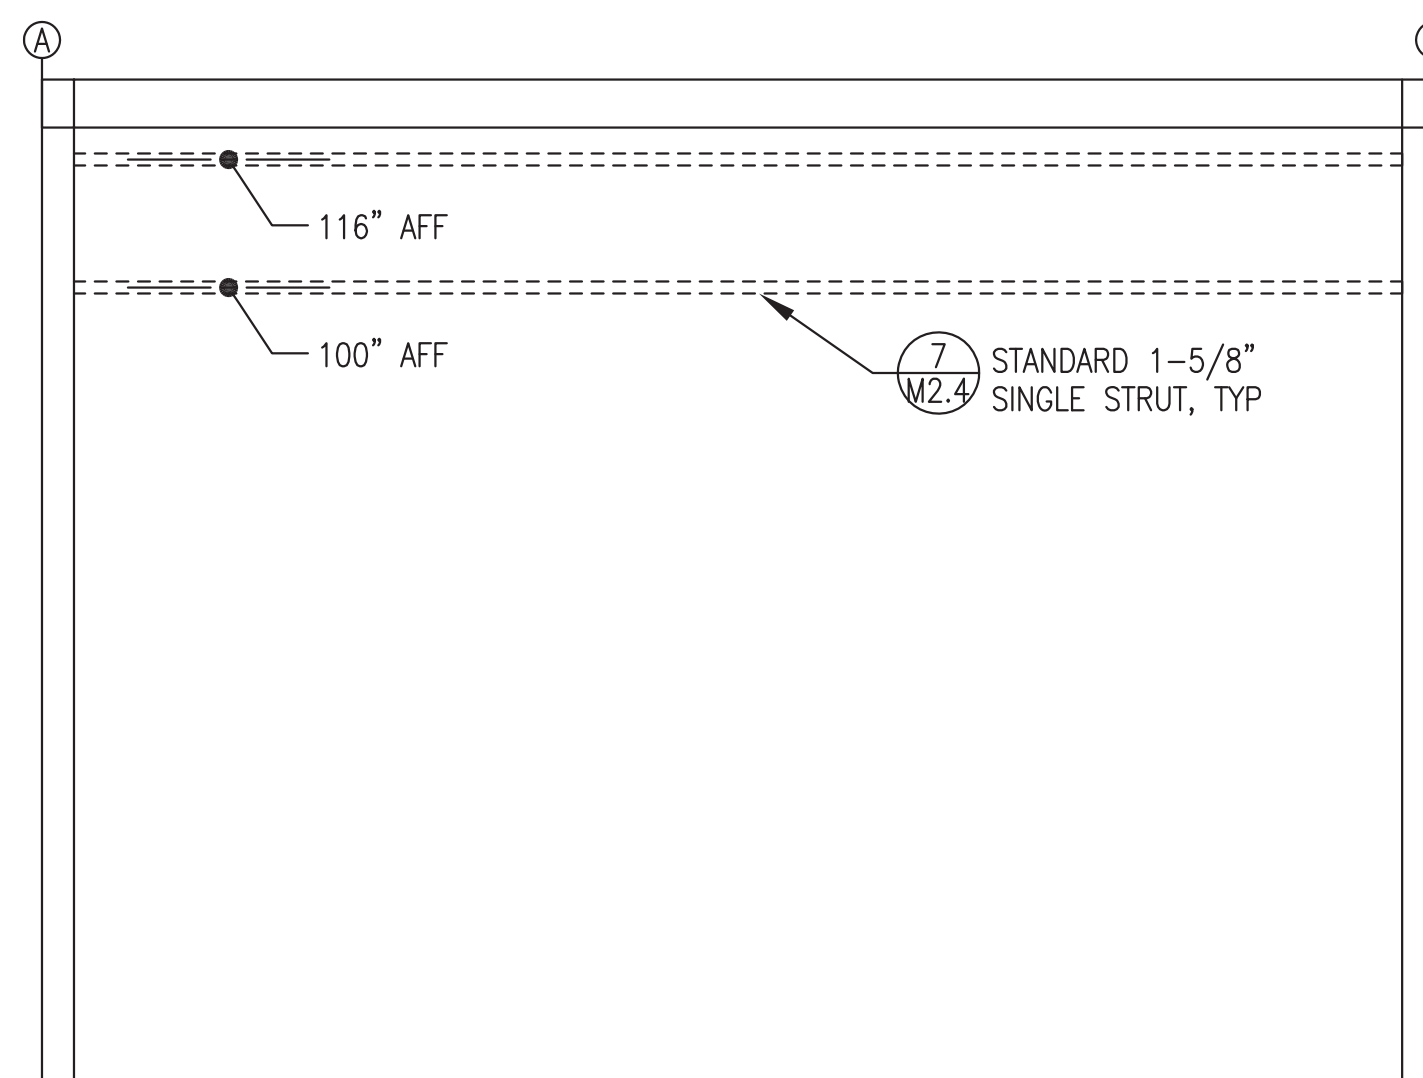


3 END WALL (GRID 2) HORIZONTAL WALL STRUT LAYOUT
M2.4 1/2"=1'-0"

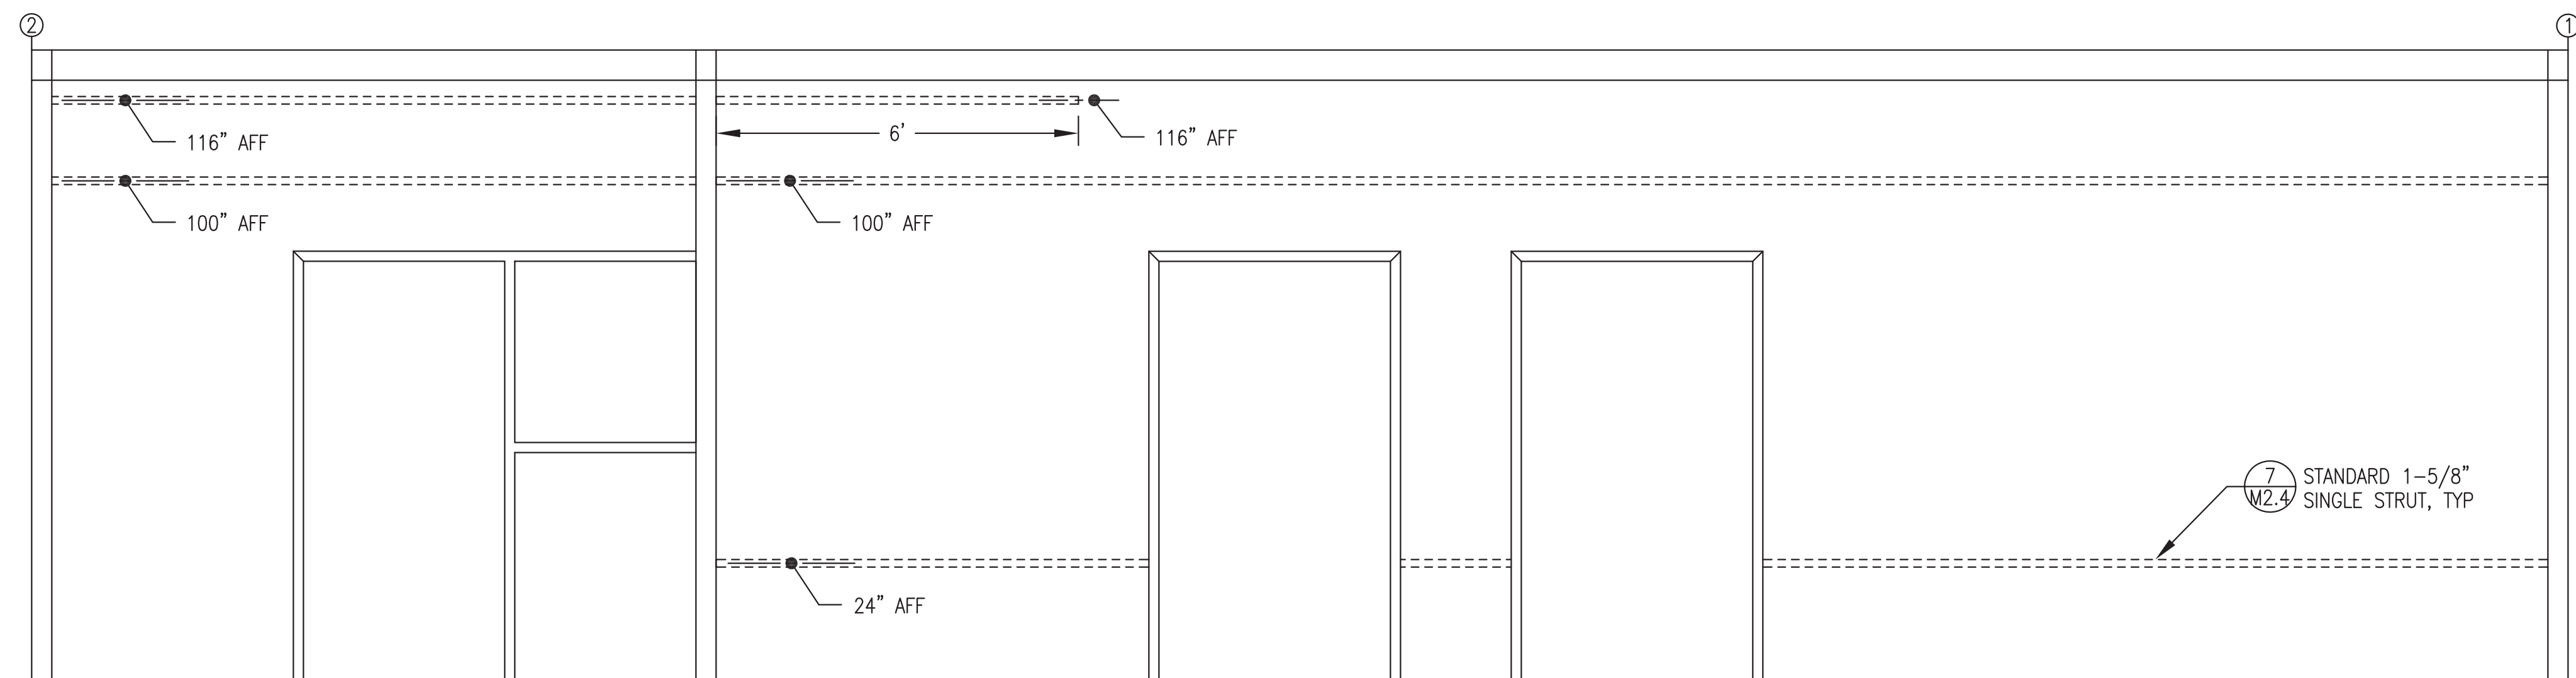


4 FRONT WALL (GRID B) HORIZONTAL WALL STRUT LAYOUT
M2.4 1/2"=1'-0"

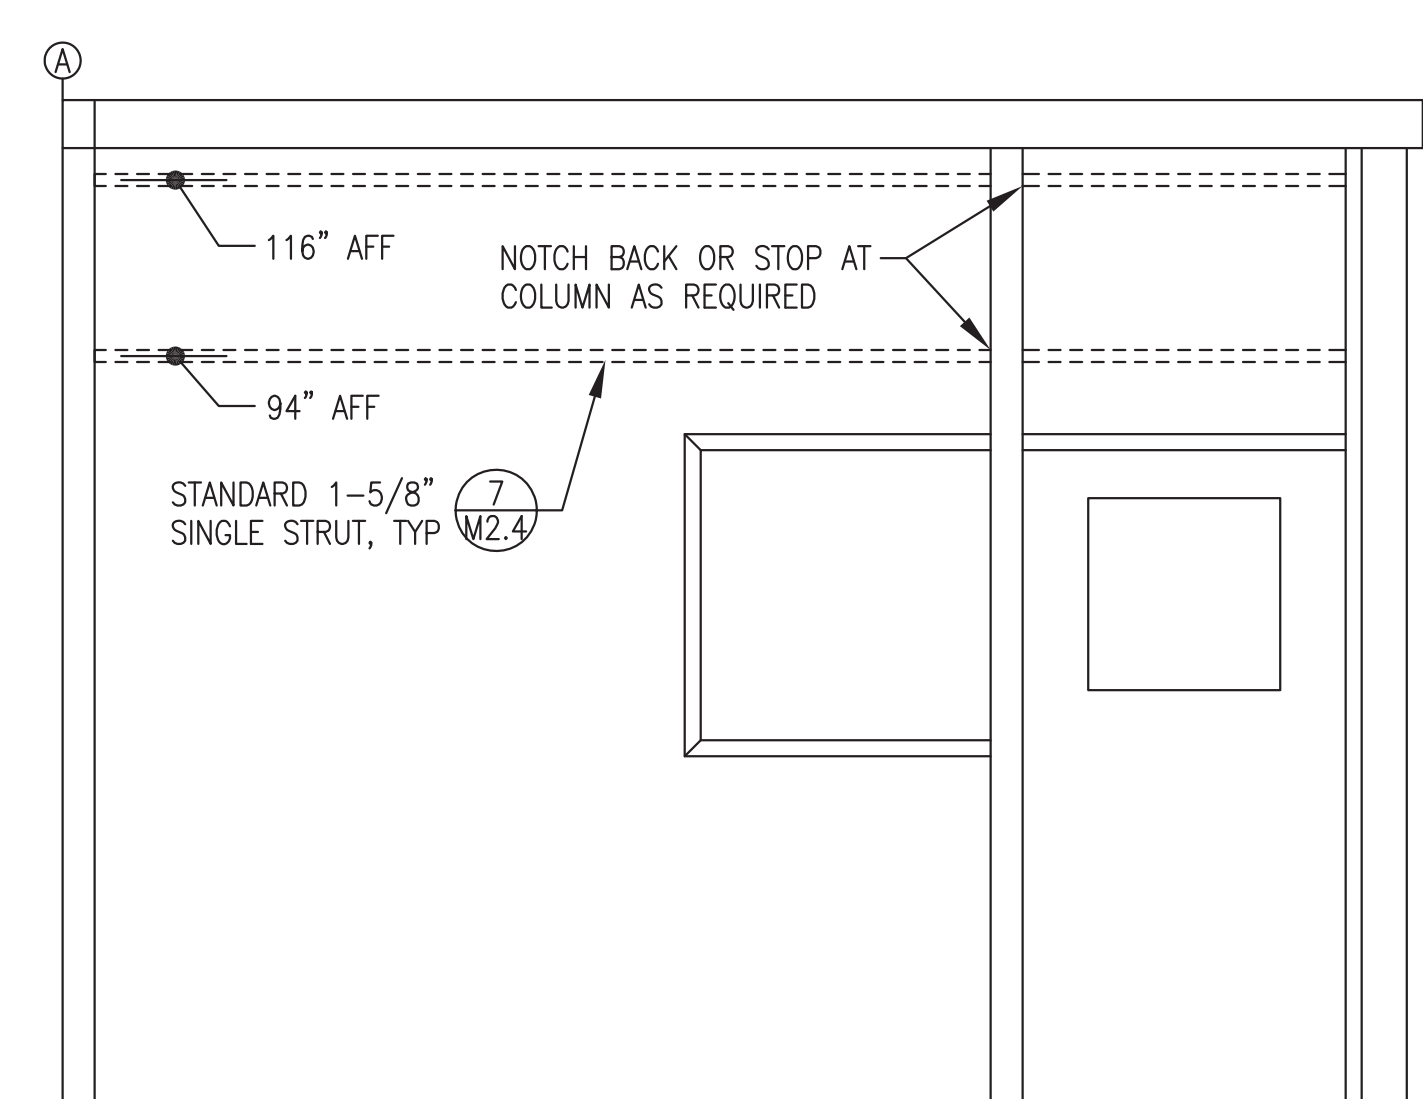

5 GEN BAY RIGHT WALL HORIZONTAL WALL STRUT LAYOUT
M2.4 1/2"=1'-0"

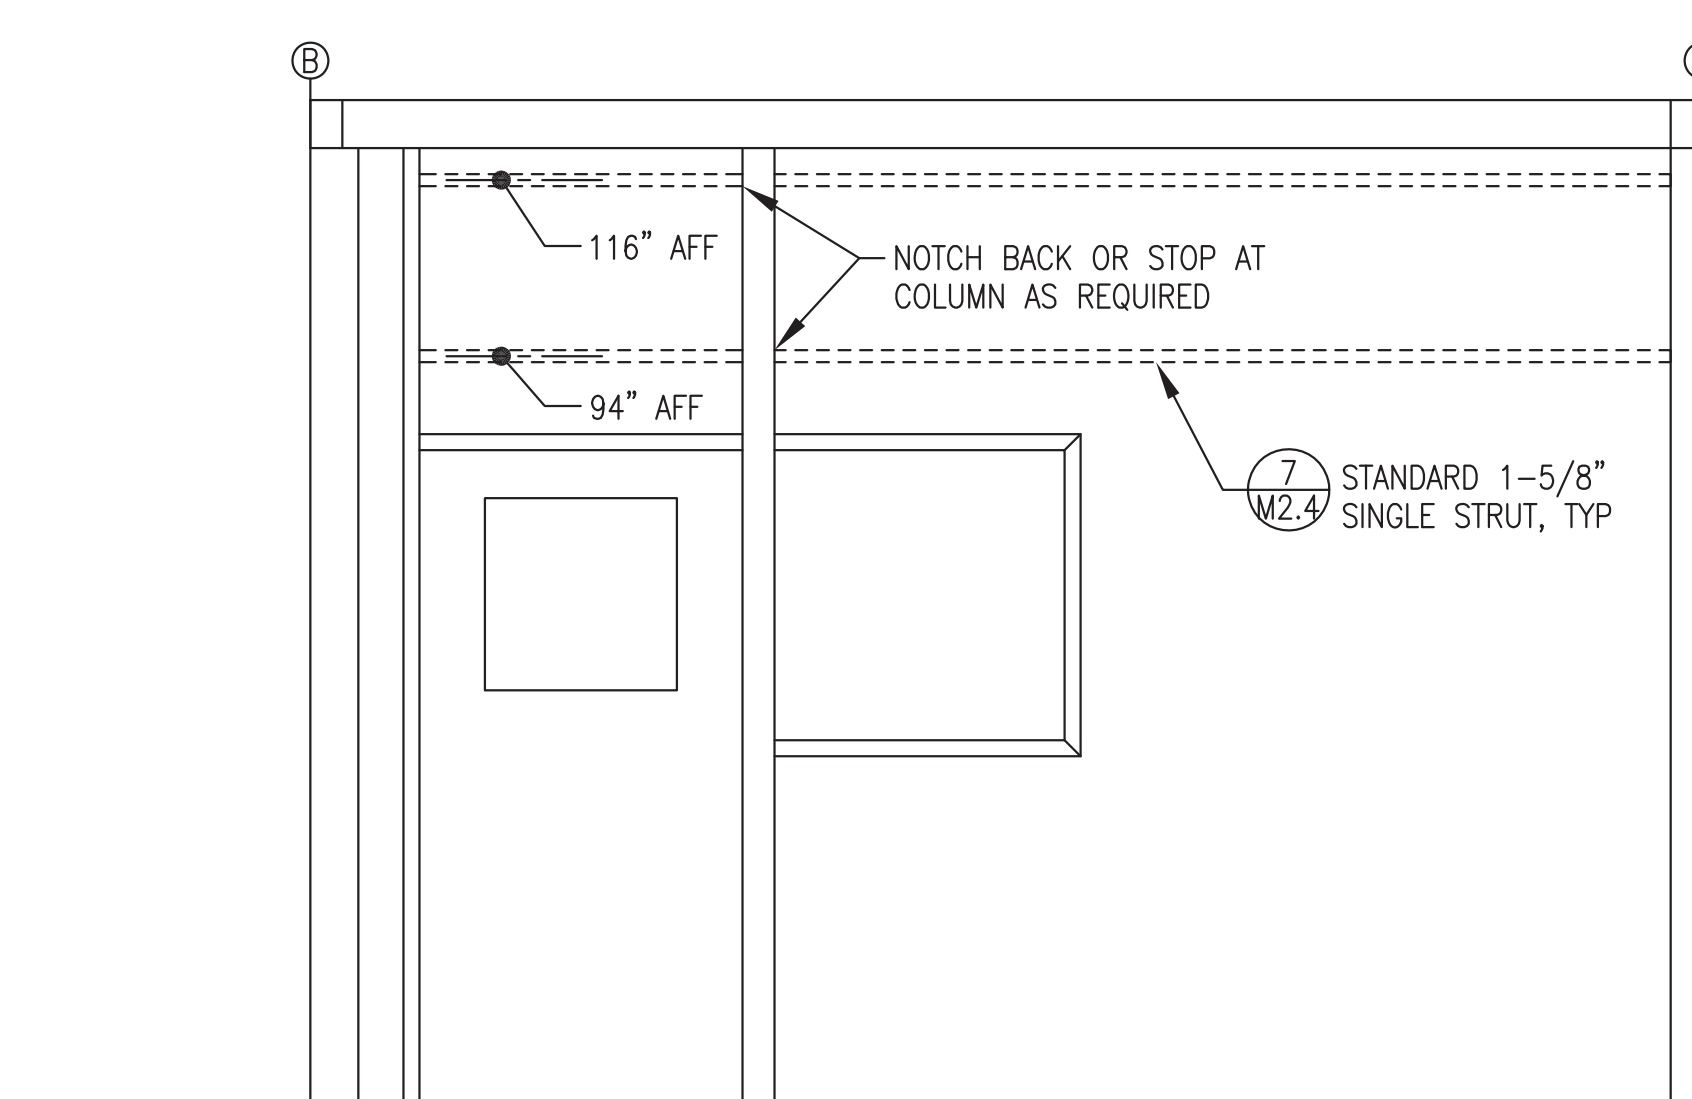


6 CONTROL ROOM LEFT WALL HORIZONTAL WALL STRUT LAYOUT
M2.4 1/2"=1'-0"

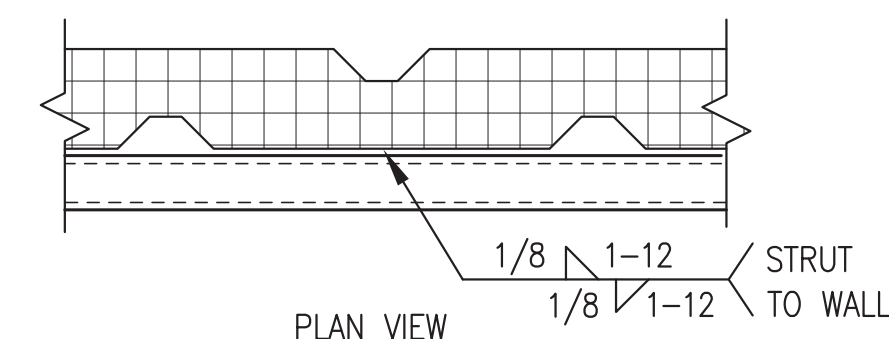

7 HORIZONTAL WALL STRUT ATTACHMENT
M2.4 NO SCALE


- HORIZONTAL WALL STRUT NOTES:**
- 1) ALL LOCATIONS ARE CENTERLINE OF STRUT ABOVE FINISHED FLOOR (AFF).
 - 2) ALL STRUT SHALL BE 12 GAUGE, 1-5/8" x 1-5/8", PLAIN (UN-FINISHED BLACK) WITH SOLID BACK, B-LINE B22-PLN OR EQUAL.
 - 3) PRIOR TO PAINTING MODULE, WELD ALL HORIZONTAL STRUT SECTIONS TO WALLS AS SHOWN. SANDBLAST AND PAINT STRUT WITH MODULE INTERIOR WALLS. SEE SHEET A1 FOR PAINTING SPECIFICATIONS.

ISSUED FOR
CONSTRUCTION
JANUARY 2019

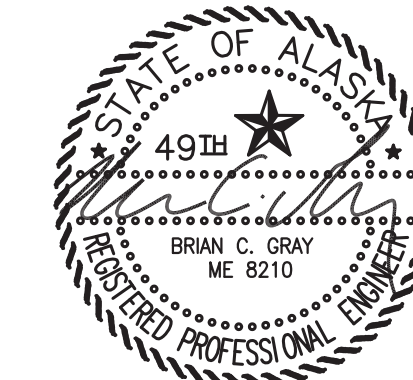


NOTE: THIS DRAWING SHOWS WORK THAT WAS PERFORMED BY OTHERS AS PART OF THE FABRICATION OF THE OWNER FURNISHED MODULE STRUCTURE AND IS PROVIDED FOR REFERENCE ONLY. SEE OWNER FURNISHED MODULE SHOP DRAWINGS FOR ADDITIONAL DETAIL.


ALASKA ENERGY AUTHORITY		
PROJECT:	PORT HEIDEN RURAL POWER SYSTEM POWER PLANT UPGRADE	
TITLE:	MECHANICAL SUPPORT HORIZONTAL WALL STRUT INSTALLATION	
	DRAWN BY: JTD	SCALE: AS NOTED
	DESIGNED BY: BCG	DATE: 1-14-19
FILE NAME: PTH PPU M2-7	SHEET:	M2.4 OF 7
PROJECT NUMBER:		
P.O. 111405, Anchorage, AK 99511 (907)349-0100		

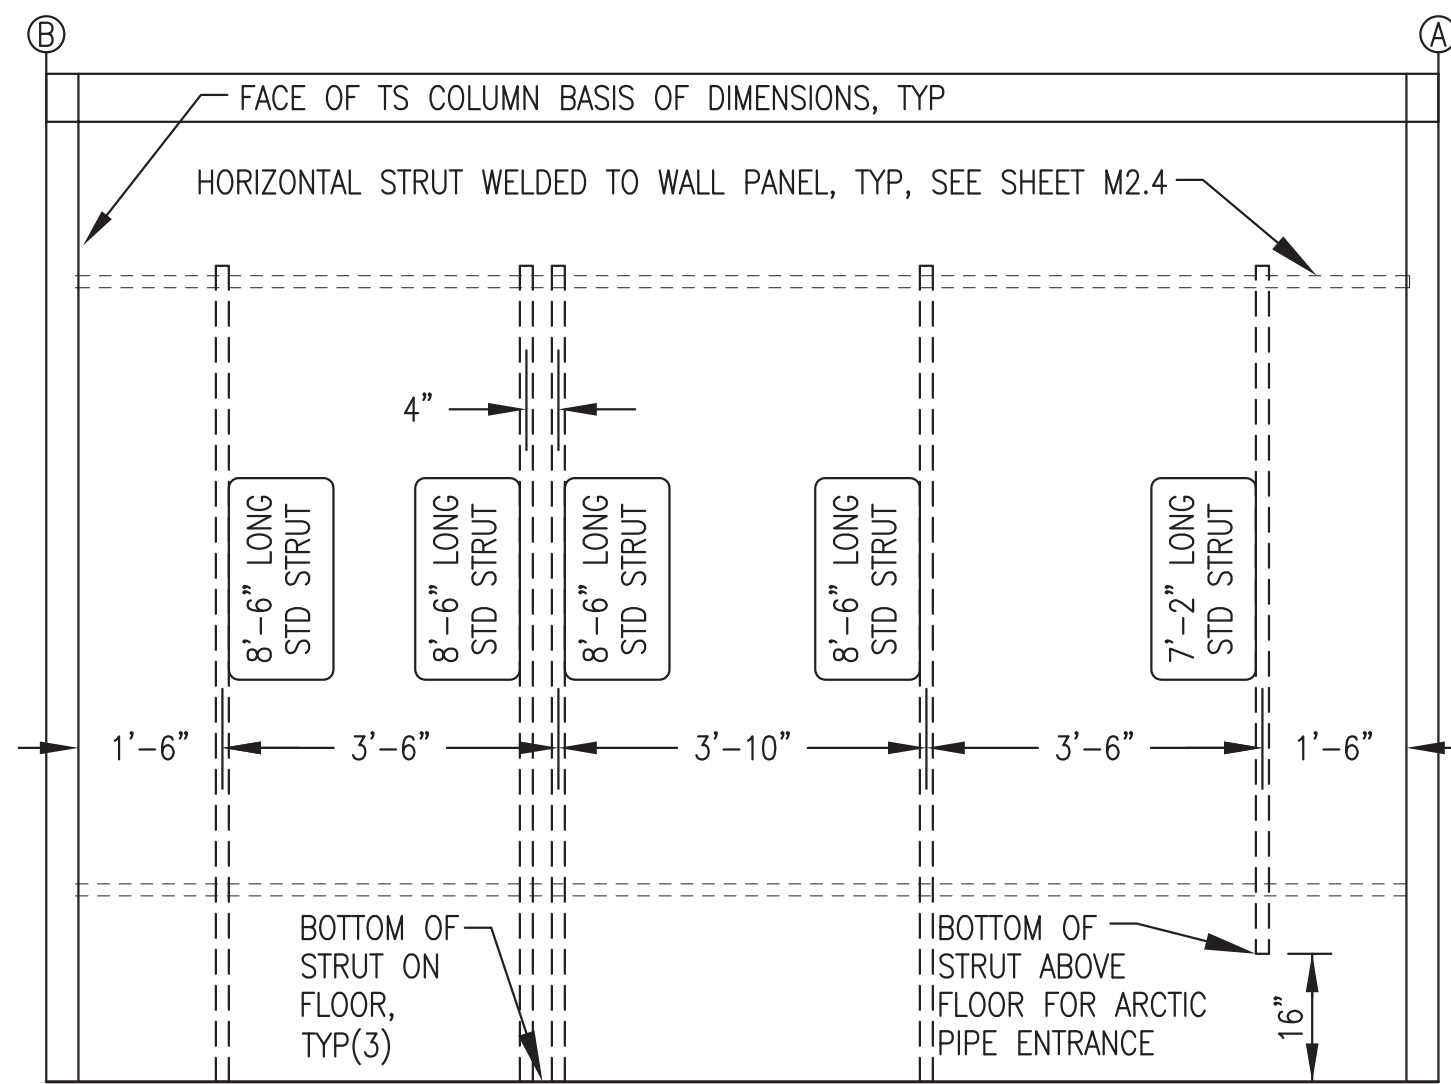


1 END WALL (GRID 1) VERTICAL WALL STRUT LAYOUT
M2.5 1/2"=1'-0"

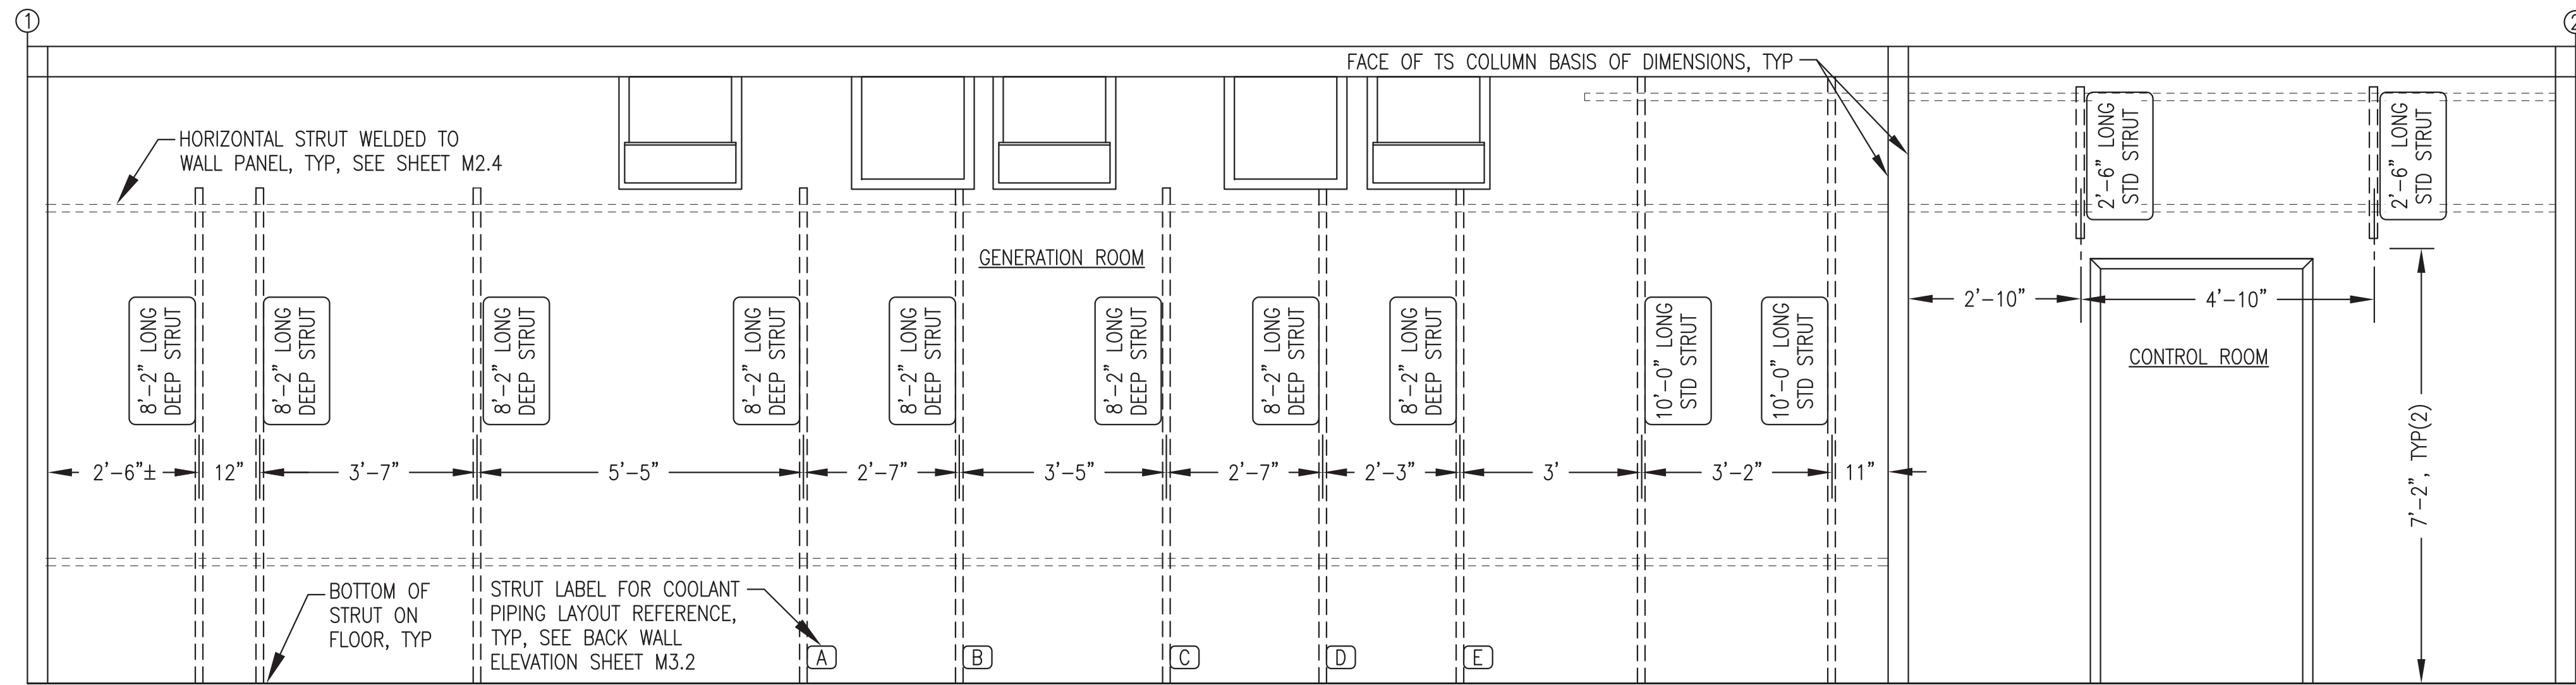


2 BACK WALL (GRID A) VERTICAL WALL STRUT LAYOUT
M2.5 1/2"=1'-0"

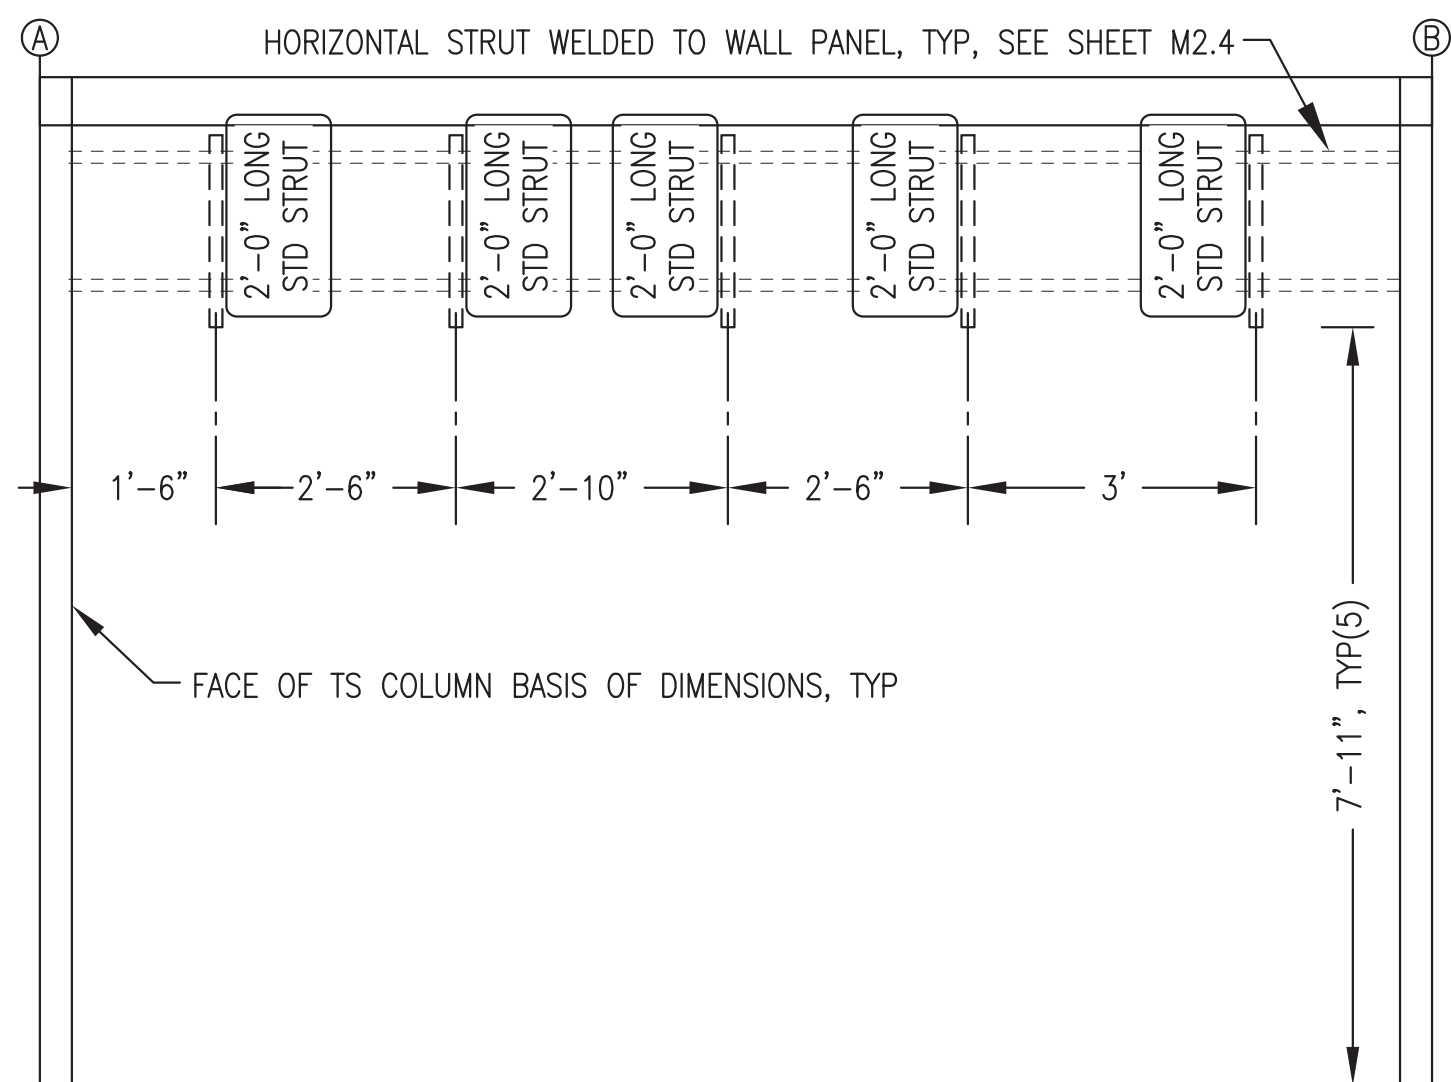


3 END WALL (GRID 2) VERTICAL WALL STRUT LAYOUT
M2.5 1/2"=1'-0"

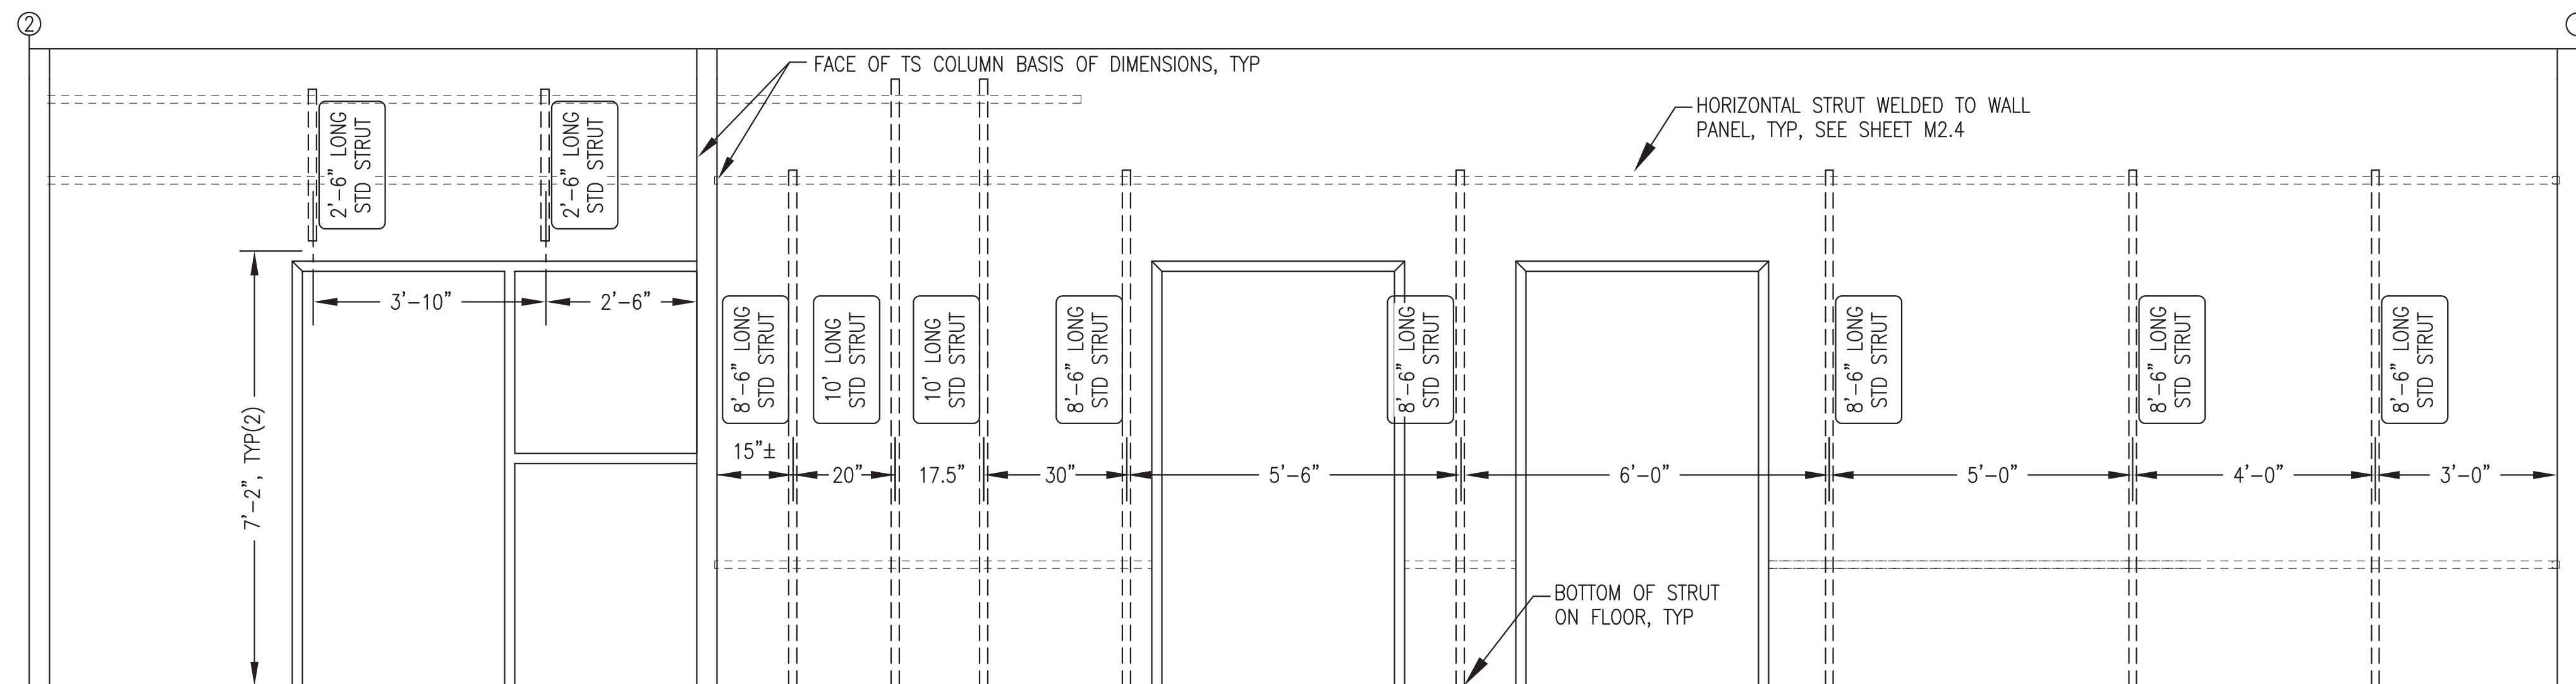

4 FRONT WALL (GRID B) VERTICAL WALL STRUT LAYOUT
M2.5 1/2"=1'-0"

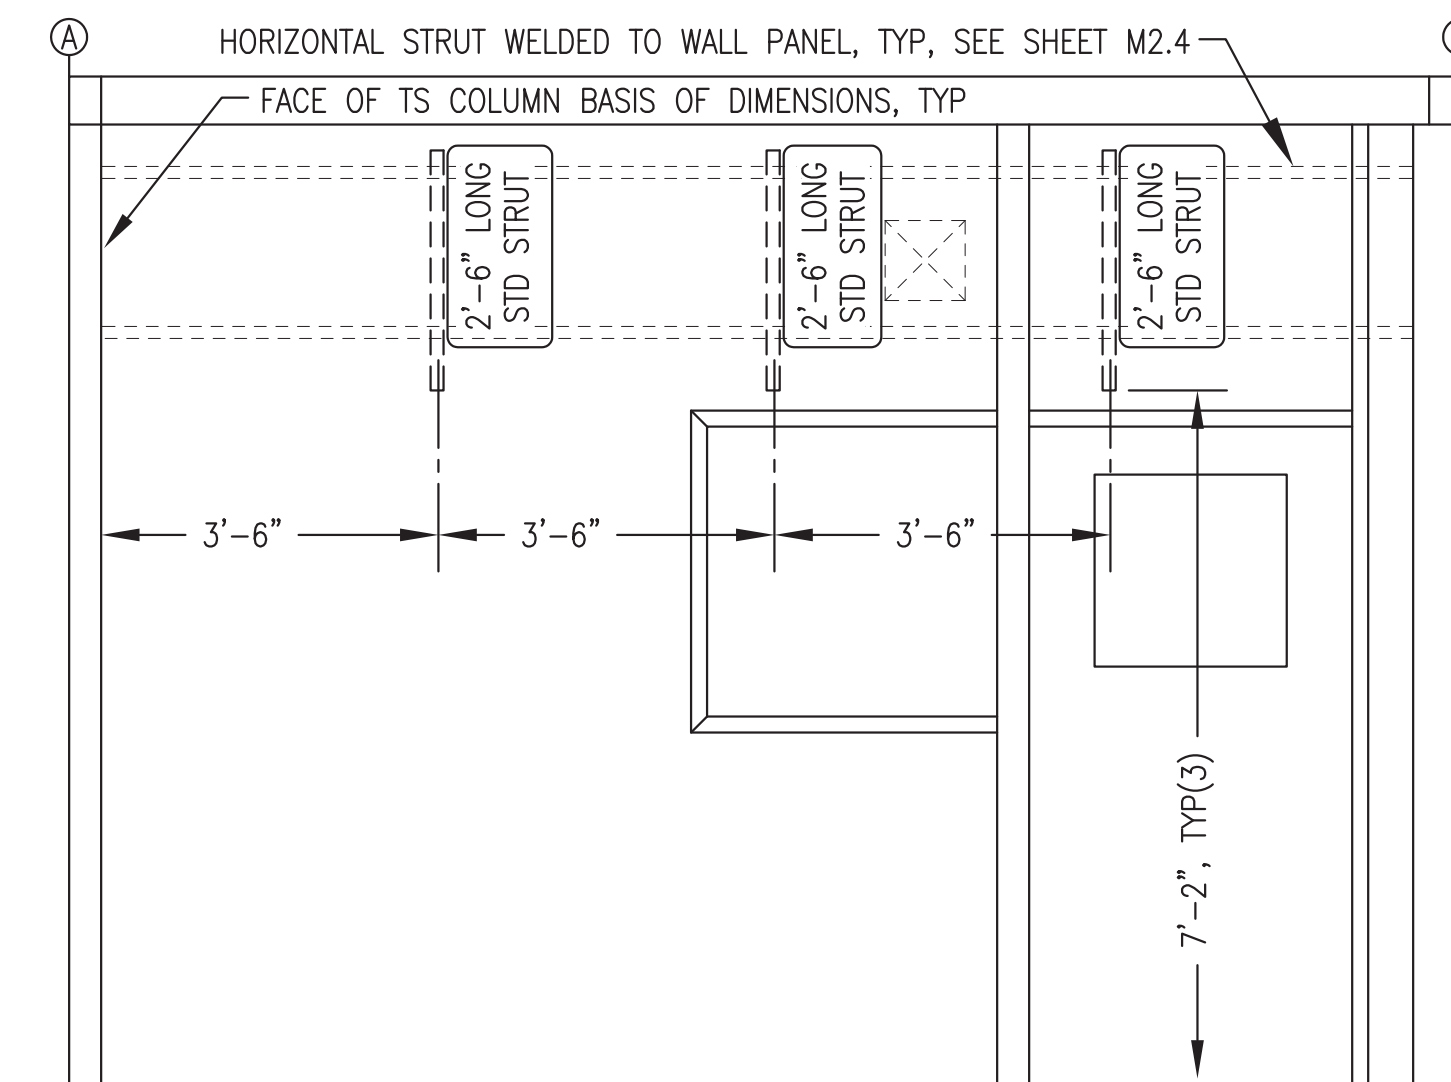

5 GEN BAY RIGHT WALL VERTICAL WALL STRUT LAYOUT
M2.5 1/2"=1'-0"

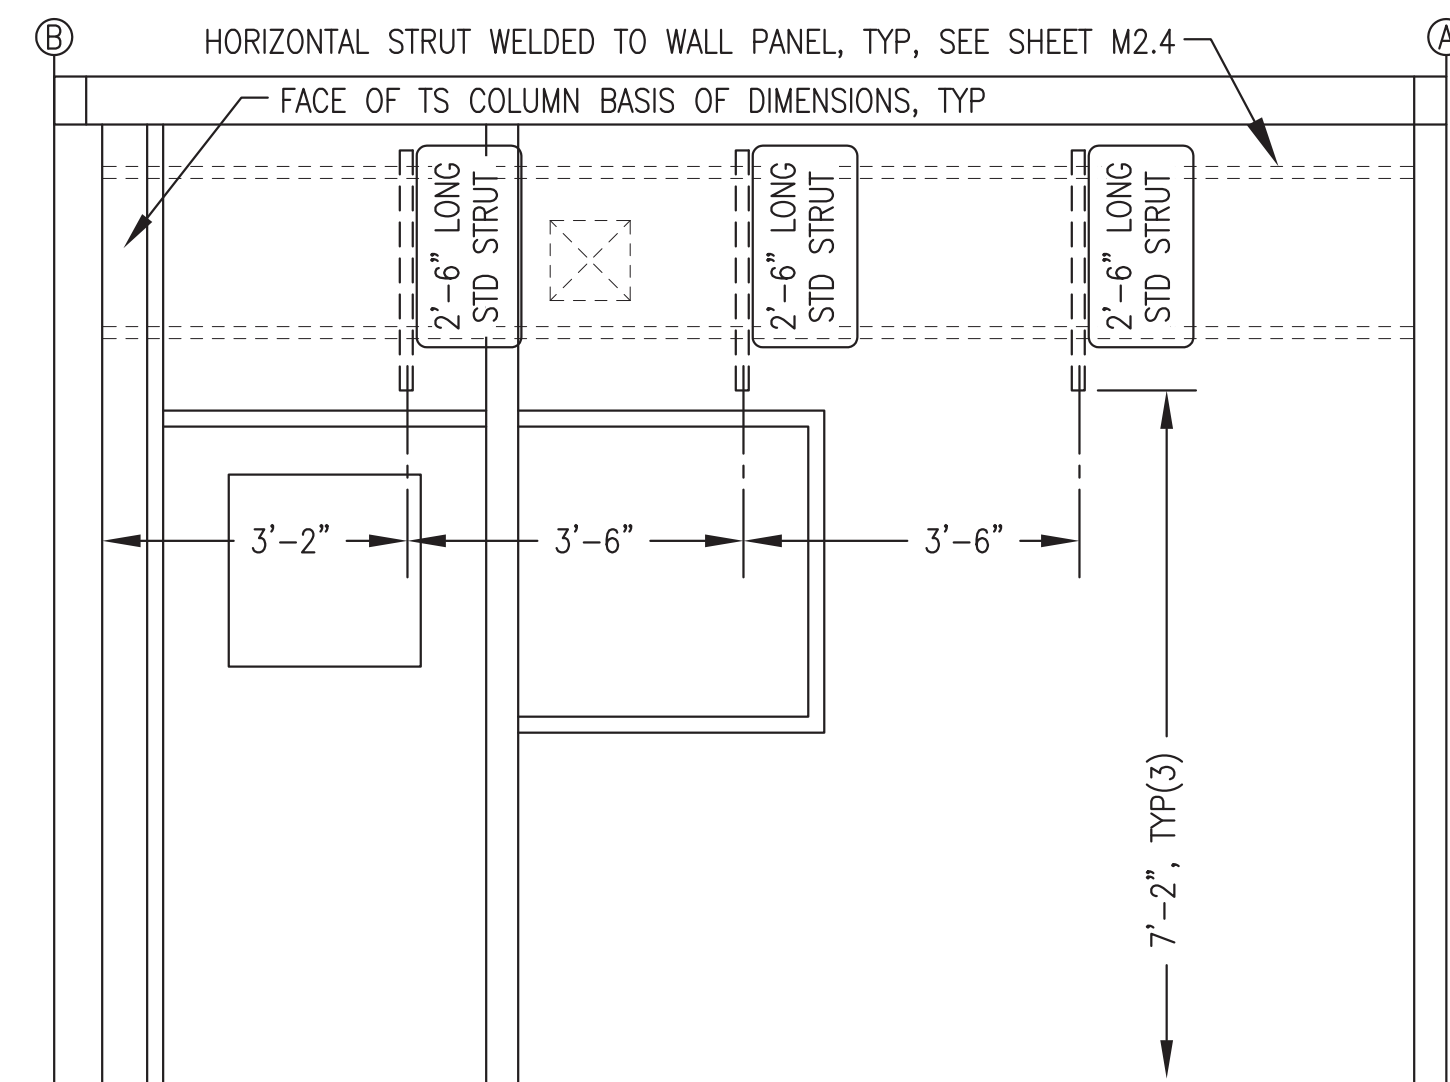


6 CONTROL ROOM LEFT WALL VERTICAL WALL STRUT LAYOUT
M2.5 1/2"=1'-0"

VERTICAL WALL STRUT INSTALLATION NOTES:

- 1) ALL HORIZONTAL LOCATIONS ARE CENTERLINE OF STRUT FROM FACE OF TS COLUMNS. ALL VERTICAL LOCATIONS ARE END OF STRUT ABOVE FINISHED FLOOR.
- 2) ALL STRUT SHALL BE 12 GAUGE, PRE-GALVANIZED FINISH WITH SLOTTED BACK. "STD" DESIGNATES STANDARD 1-5/8" x 1-5/8" SINGLE STRUT, B-LINE B22-SH-GALV OR EQUAL. "DEEP" DESIGNATES 3-1/4" x 1-5/8" SINGLE STRUT, B-LINE B11-SH-GALV OR EQUAL.
- 3) FASTEN ALL VERTICAL STRUT SECTIONS TO HORIZONTAL STRUT WITH 1/2"x1" ALLEN HEAD CAP SCREWS & STRUT NUTS.
- 4) ONLY MAJOR WALL MOUNTED EQUIPMENT SUPPORT STRUT SHOWN THIS SHEET. SEE MECHANICAL AND ELECTRICAL DRAWINGS FOR OTHER EQUIPMENT, PIPING, AND WIREWAY STRUT SUPPORT DETAILS.

ISSUED FOR
CONSTRUCTION
JANUARY 2019

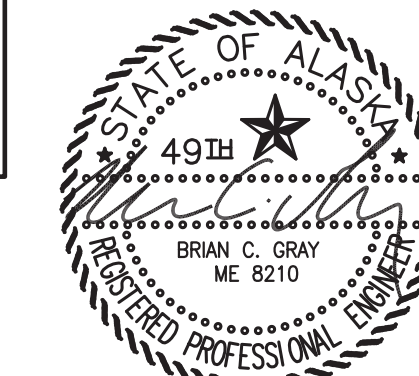


ALASKA ENERGY AUTHORITY

PROJECT: PORT HEIDEN RURAL POWER SYSTEM
POWER PLANT UPGRADE


TITLE: MECHANICAL SUPPORT VERTICAL
WALL STRUT INSTALLATION

DRAWN BY: JTD	SCALE: AS NOTED
DESIGNED BY: BCG	DATE: 1-14-19
FILE NAME: PTH PPU M2-7	SHEET: M2.5 OF 7
PROJECT NUMBER:	


Gray
Stassel
Engineering, Inc.
P.O. 111405, Anchorage, AK 99511 (907)349-0100

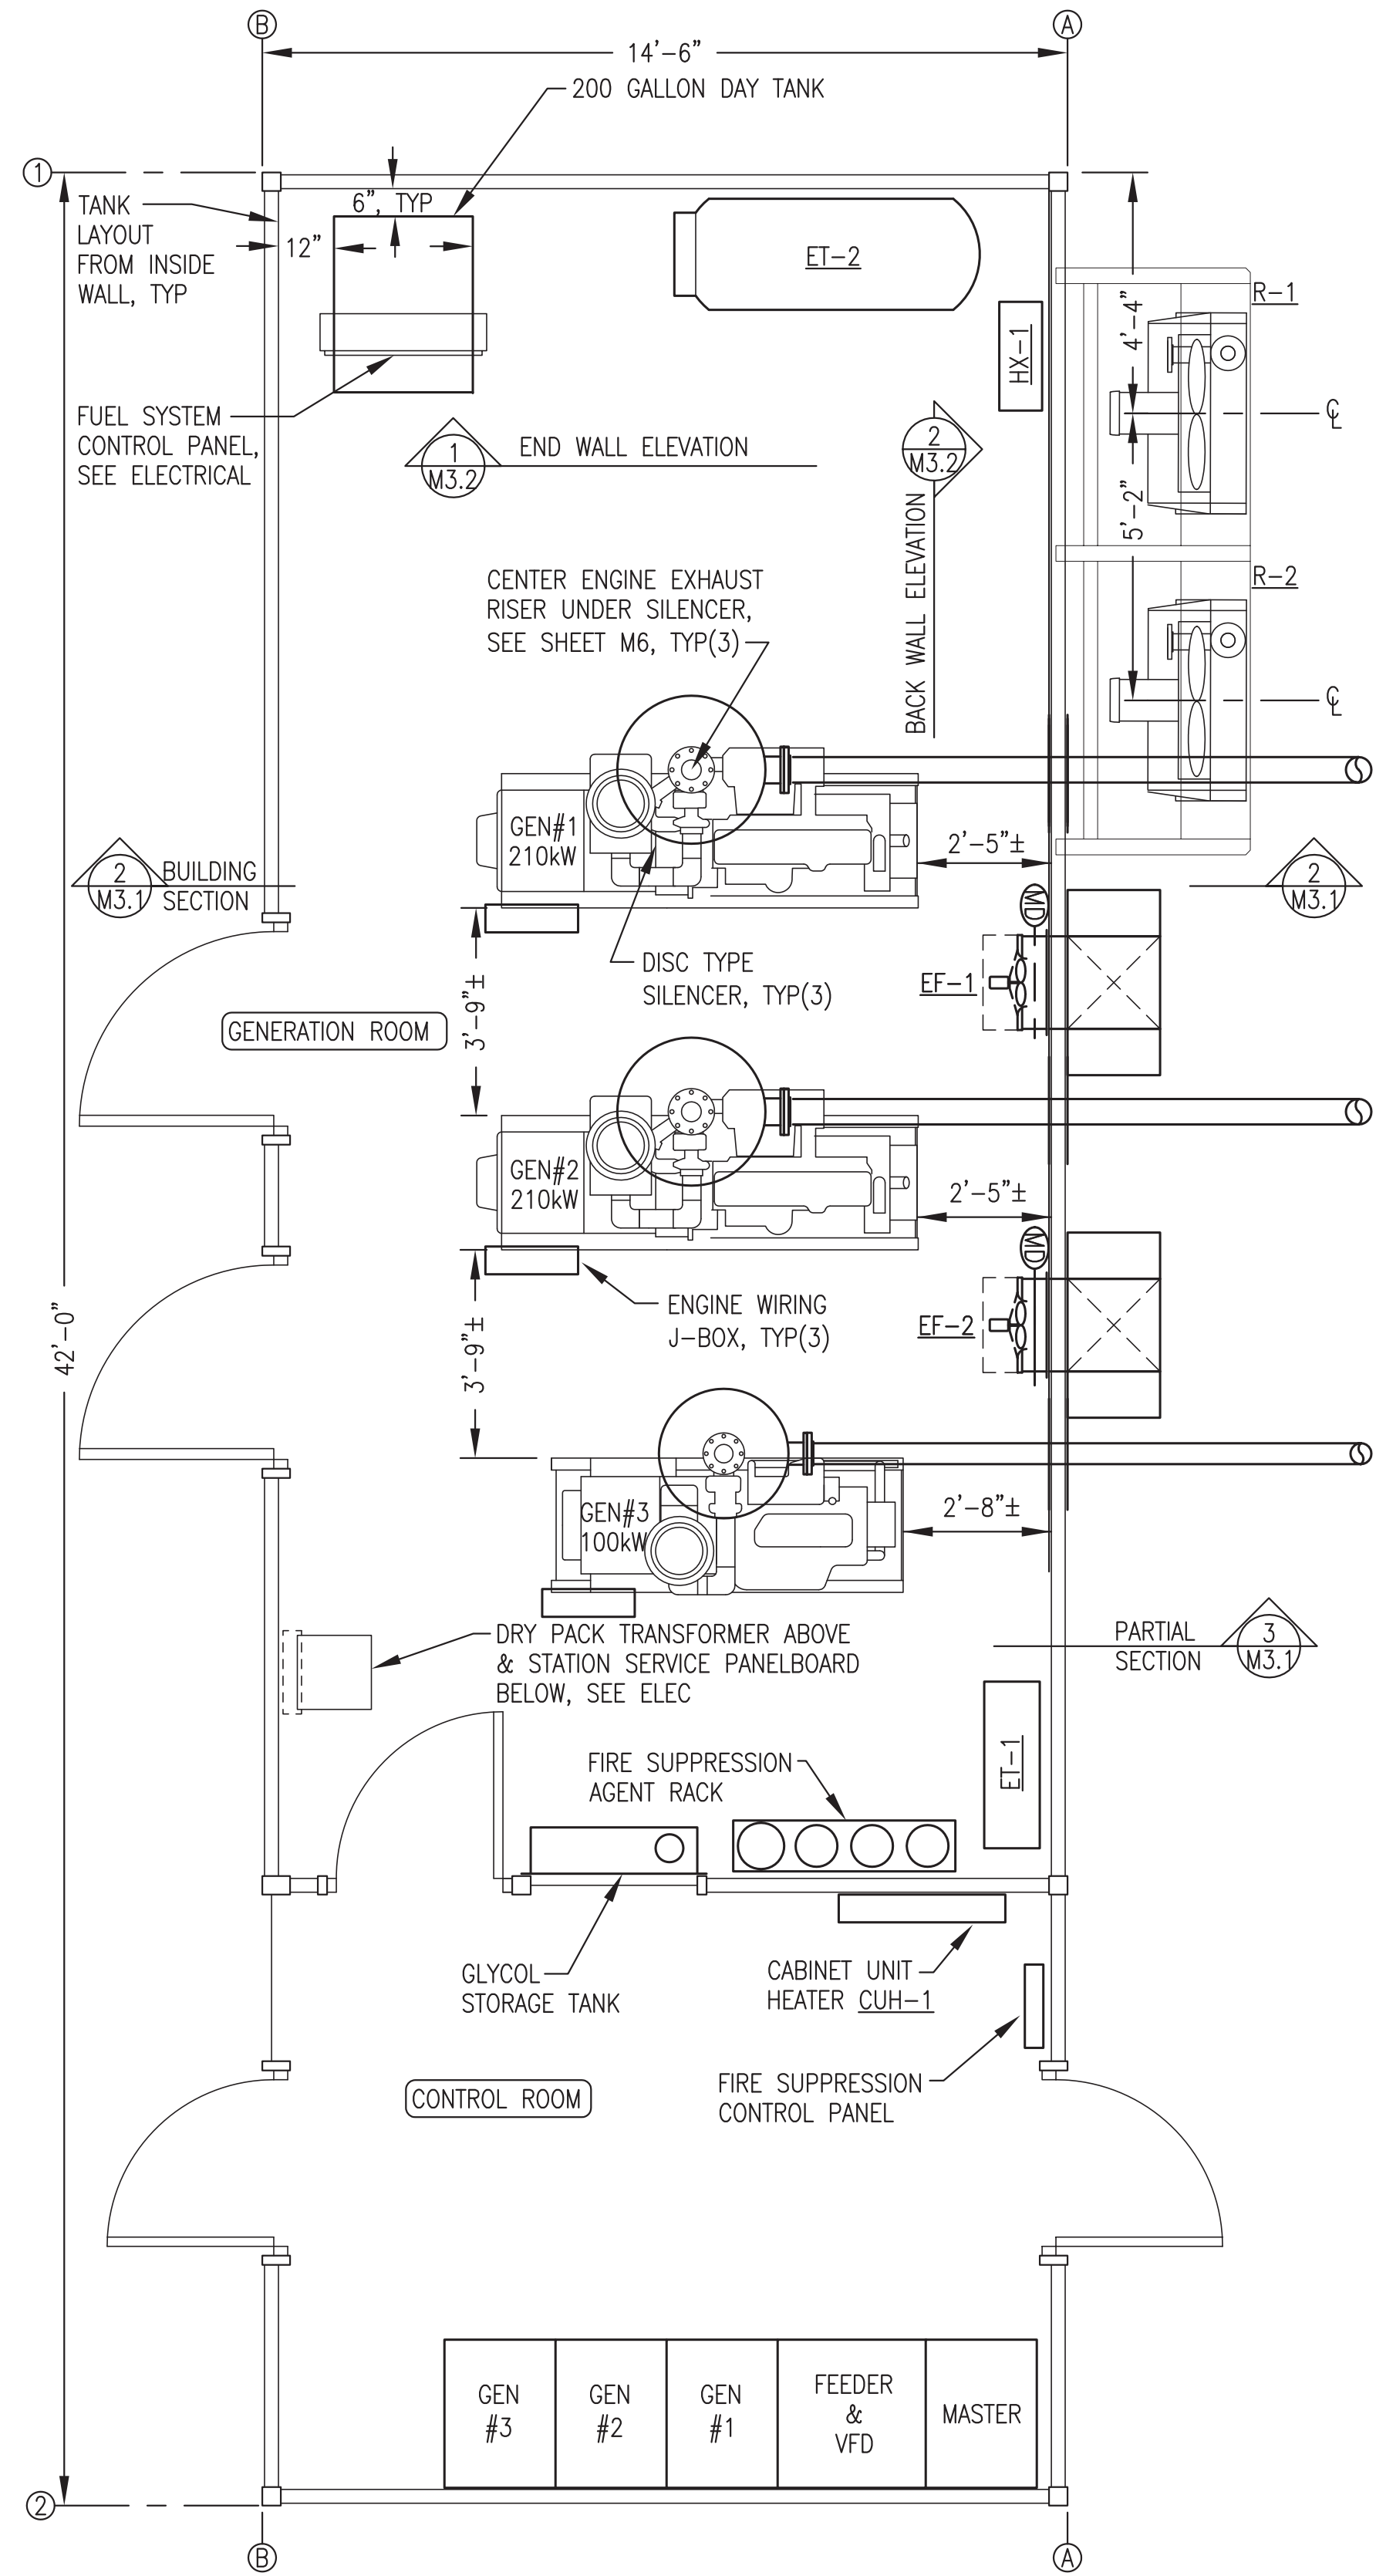


1 EQUIPMENT LAYOUT PLAN
M3.1 3/8"=1'-0"

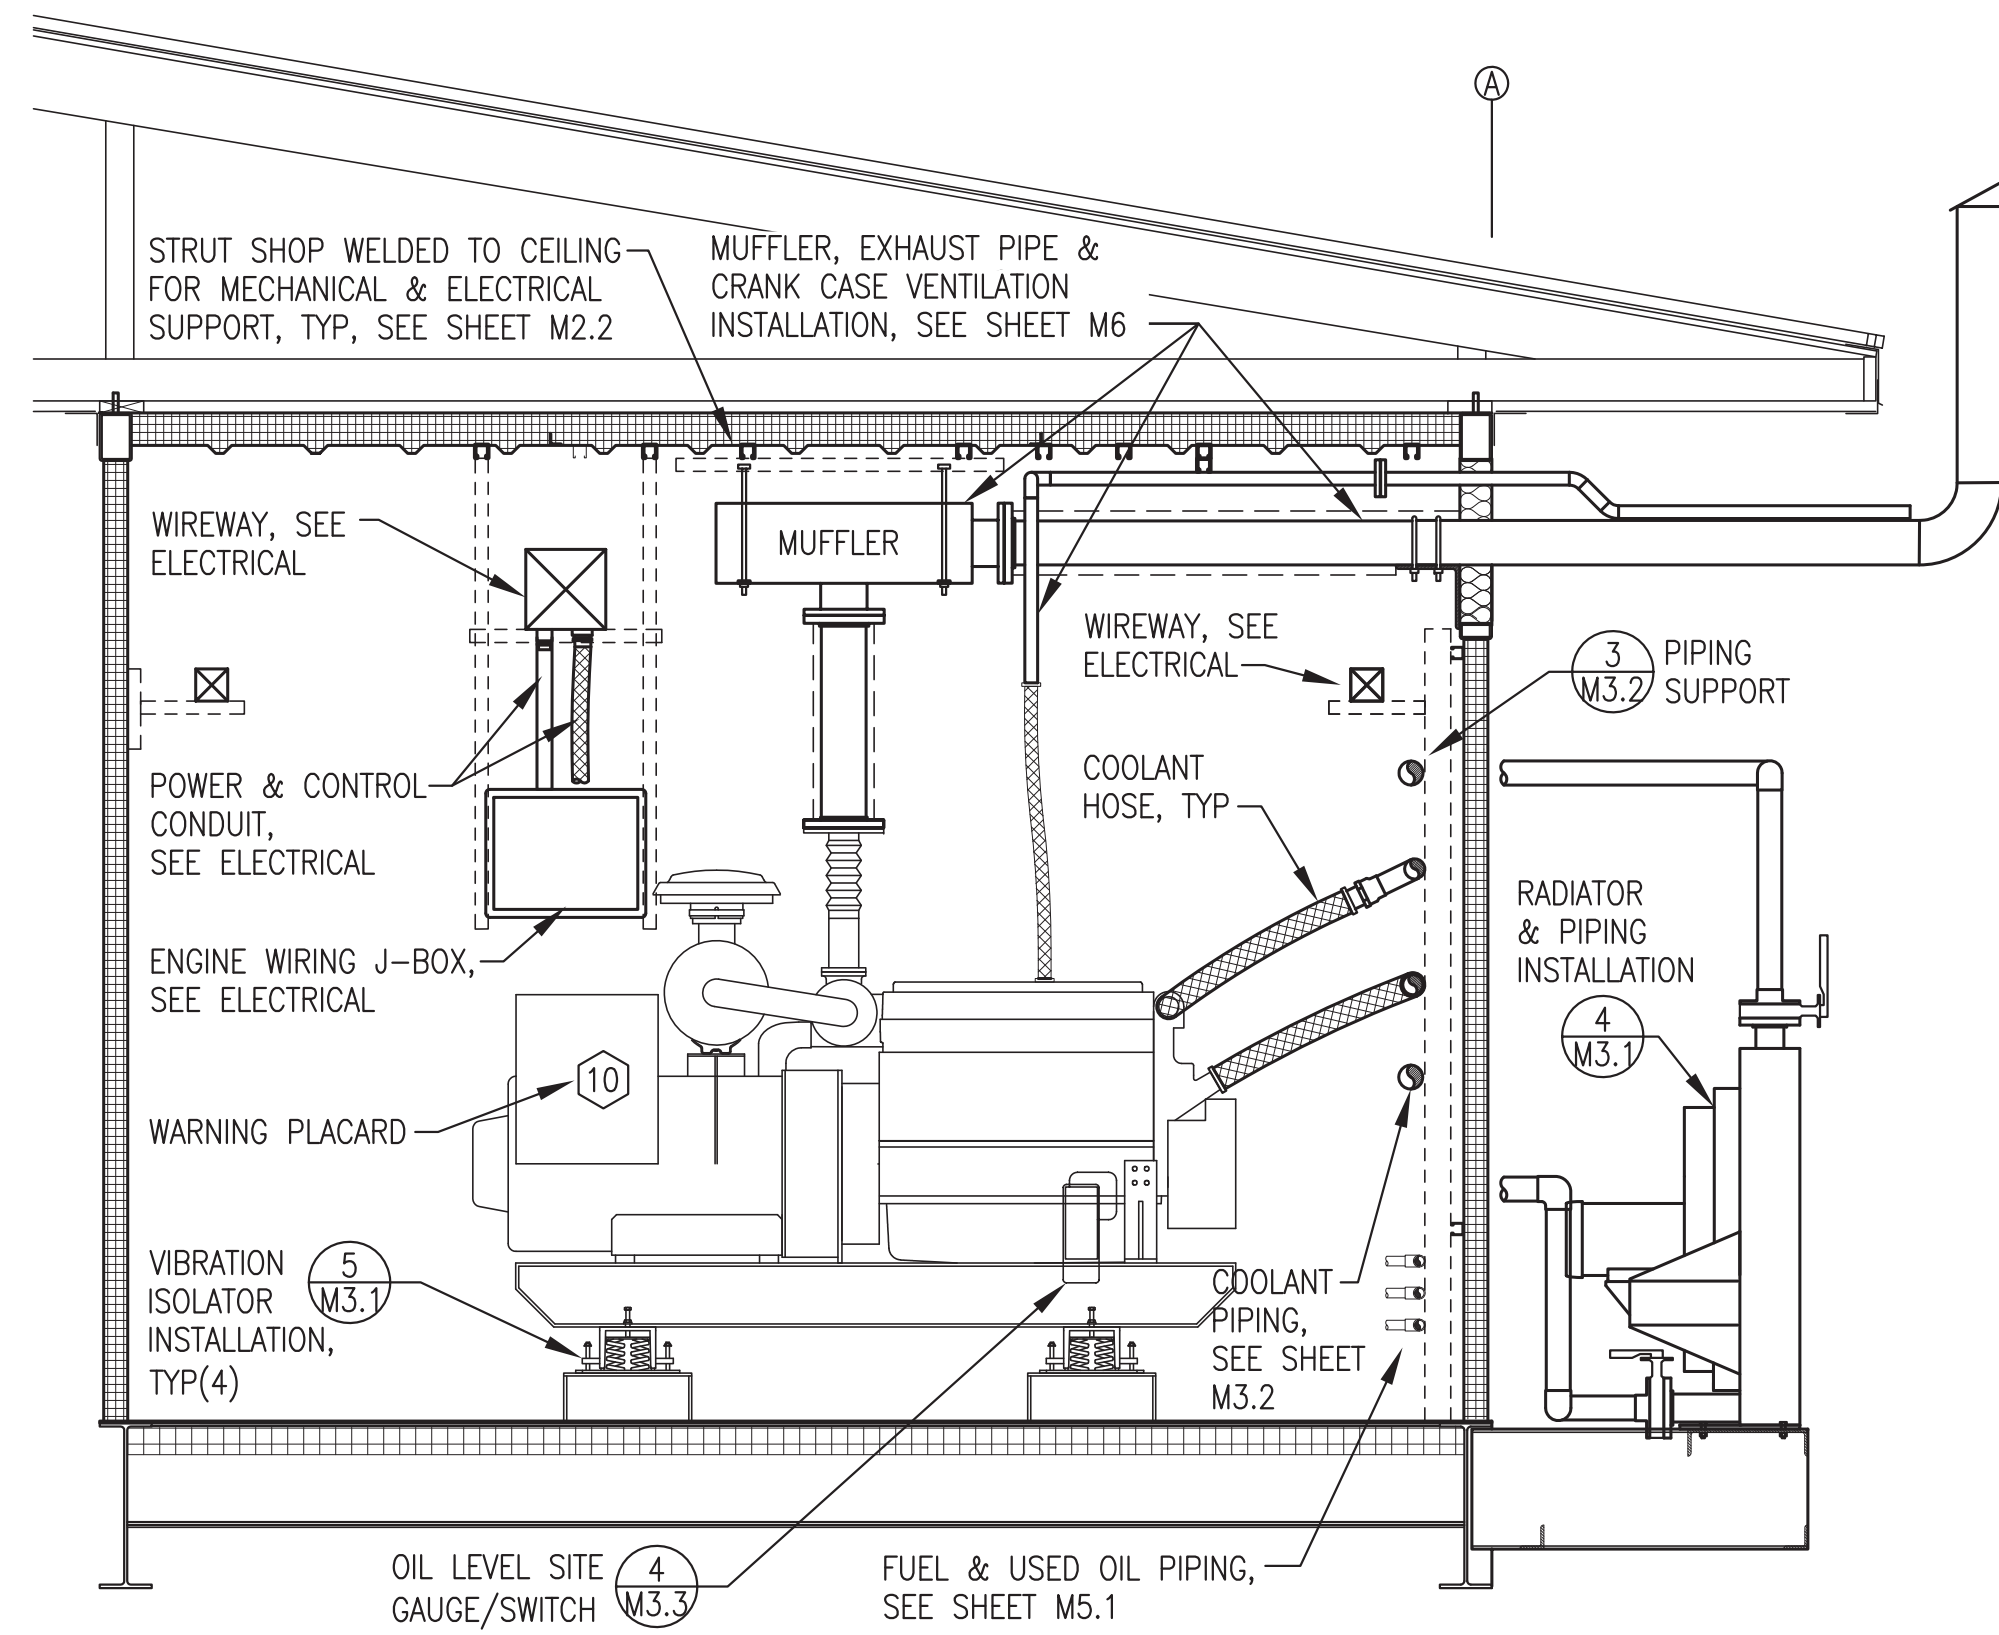

2 BUILDING SECTION/GENERATOR #1/#2 INSTALLATION
M3.1 1/2"=1'-0"

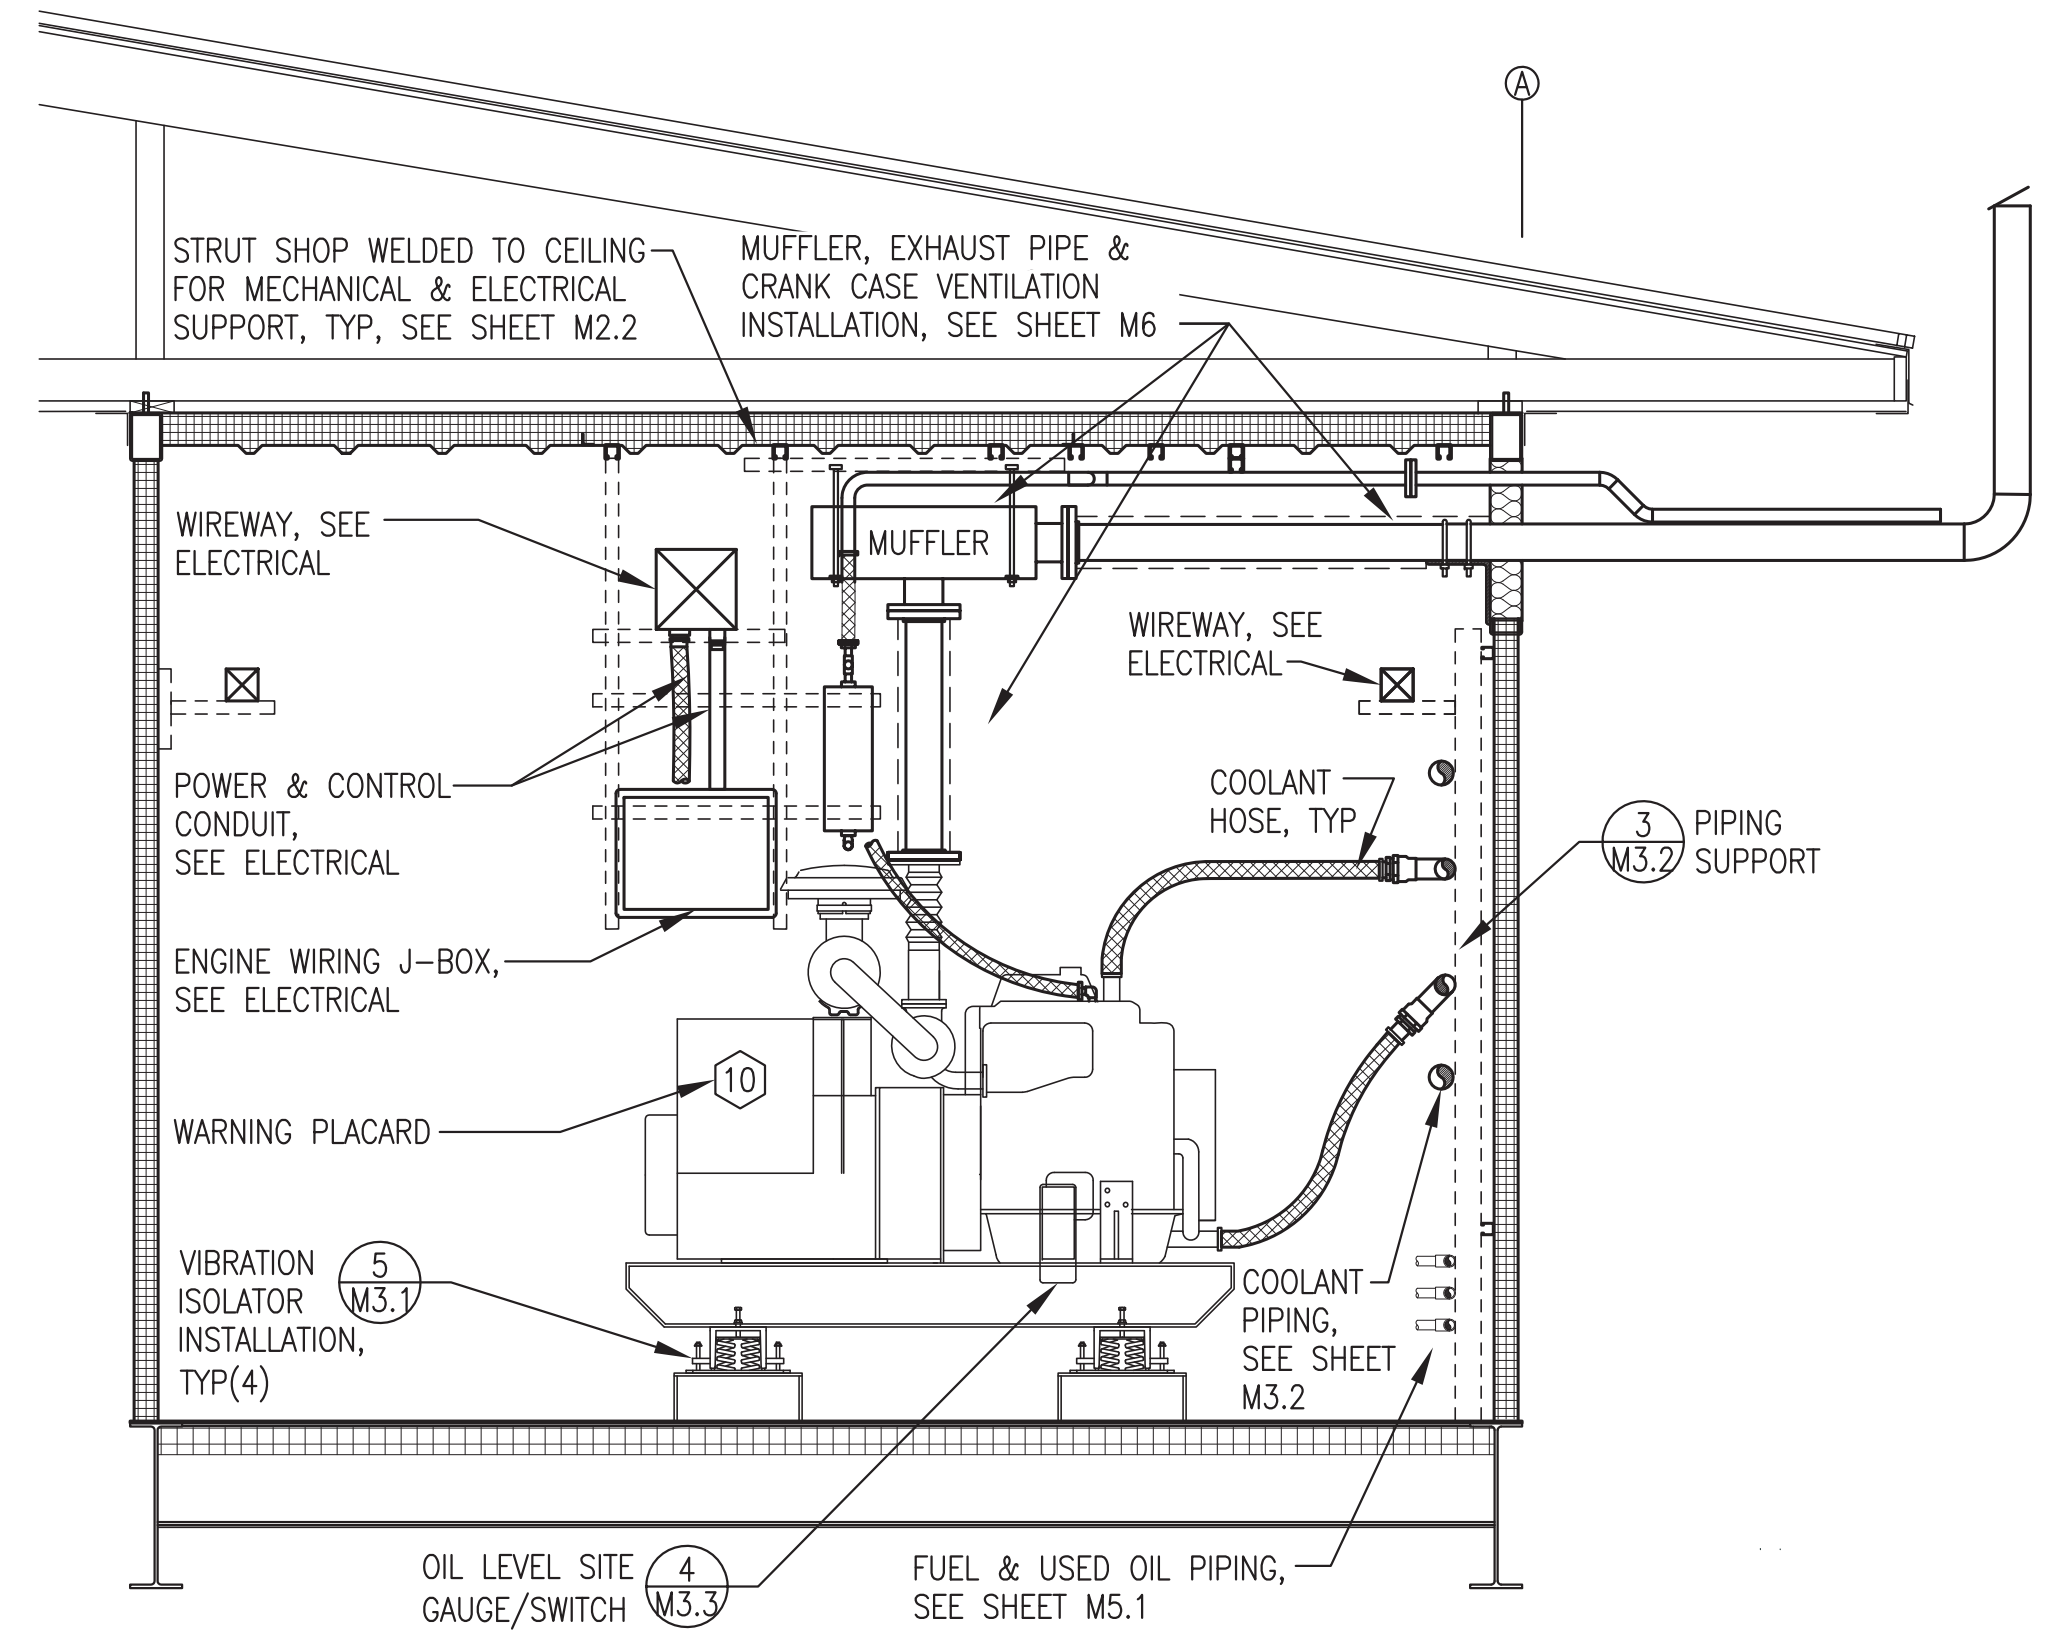


3 BUILDING SECTION/GENERATOR #3 INSTALLATION
M3.1 1/2"=1'-0"

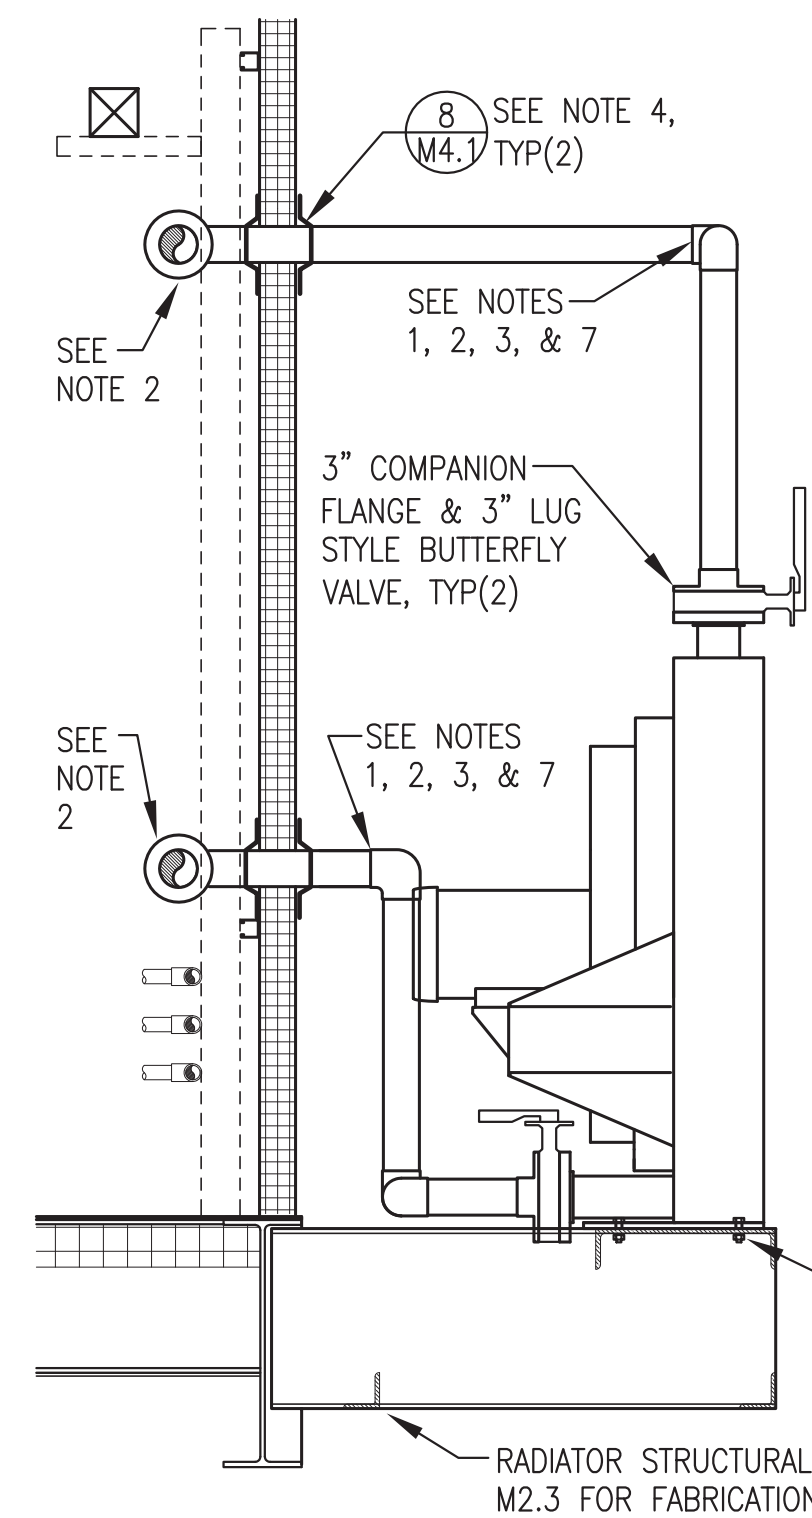

4 RADIATOR & PIPING INSTALLATION
M3.1 3/4"=1'-0"


MODULE SHOP/ON-SITE NOTES:

- 1) DURING SHOP FABRICATION DRY FIT PIPE INTO TEE/EL & USE HOSE FOR TEMPORARY SEAL DURING TESTING.
- 2) AFTER TESTING REMOVE HOSE & TAKE APART FLANGE AT BUTTERFLY VALVE. REMOVE PIPE & STORE IN MODULE. SEAL WALL PENETRATION FOR SHIPPING.
- 3) IN FIELD REINSTALL PIPE THROUGH WALL & SOLDER TO EL.
- 4) IN SHOP HOLE SAW 1"Ø OVERSIZE OPENING. AFTER FINAL FIELD ASSEMBLY FLASH & SEAL PENETRATION IN ACCORDANCE WITH DETAIL.
- 5) DURING SHOP FABRICATION BOLT RADIATOR SUPPORT TO MODULE & RADIATORS TO SUPPORTS.
- 6) AFTER TESTING REMOVE RADIATOR SUPPORT ASSEMBLY COMPLETE WITH RADIATORS & PIPING MANIFOLD. PACKAGE FOR SHIPPING.
- 7) IN FIELD BOLT RADIATOR ASSEMBLY TO MODULE, REINSTALL PIPING SECTIONS, & MAKE FINAL SOLDER CONNECTION TO ELS.

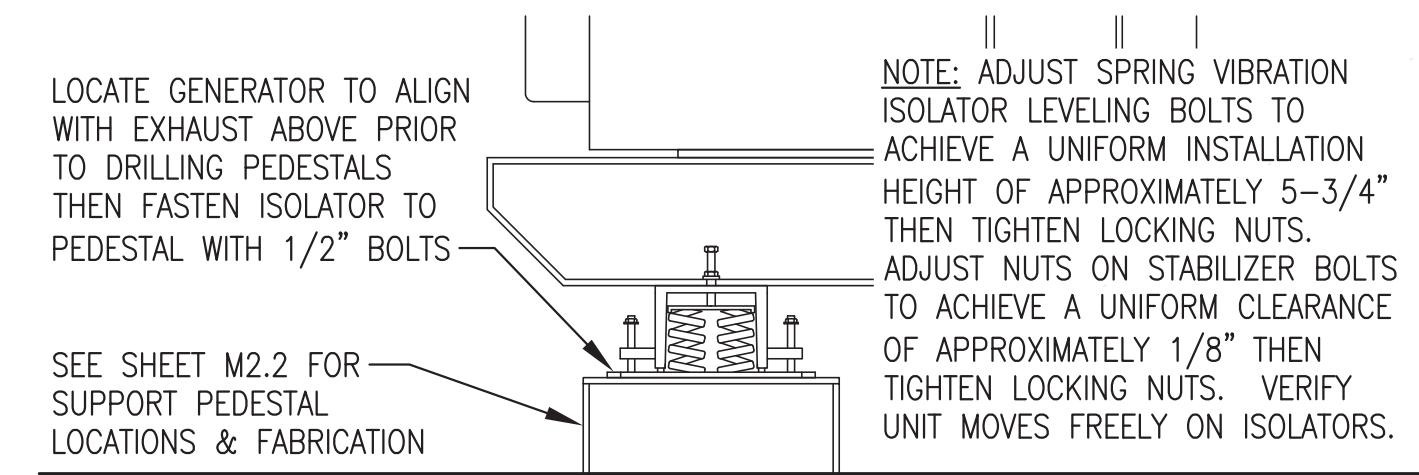


5 VIBRATION ISOATOR INSTALLATION
M3.1 1"=1'-0"

ISSUED FOR CONSTRUCTION
JANUARY 2019

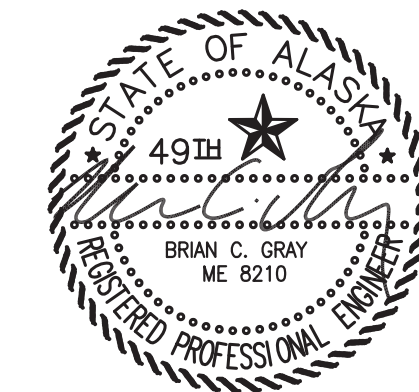


PROJECT: PORT HEIDEN RURAL POWER SYSTEM POWER PLANT UPGRADE	
TITLE: EQUIPMENT LAYOUT, PLAN, SECTIONS, & DETAILS	
DRAWN BY: JTD	SCALE: AS NOTED
DESIGNED BY: BCG	DATE: 1-14-19
FILE NAME: PTH PPU M2-7	SHEET: M3.1 OF 7
PROJECT NUMBER:	


Gray Stassel Engineering, Inc.
P.O. 111405, Anchorage, AK 99511 (907)349-0100

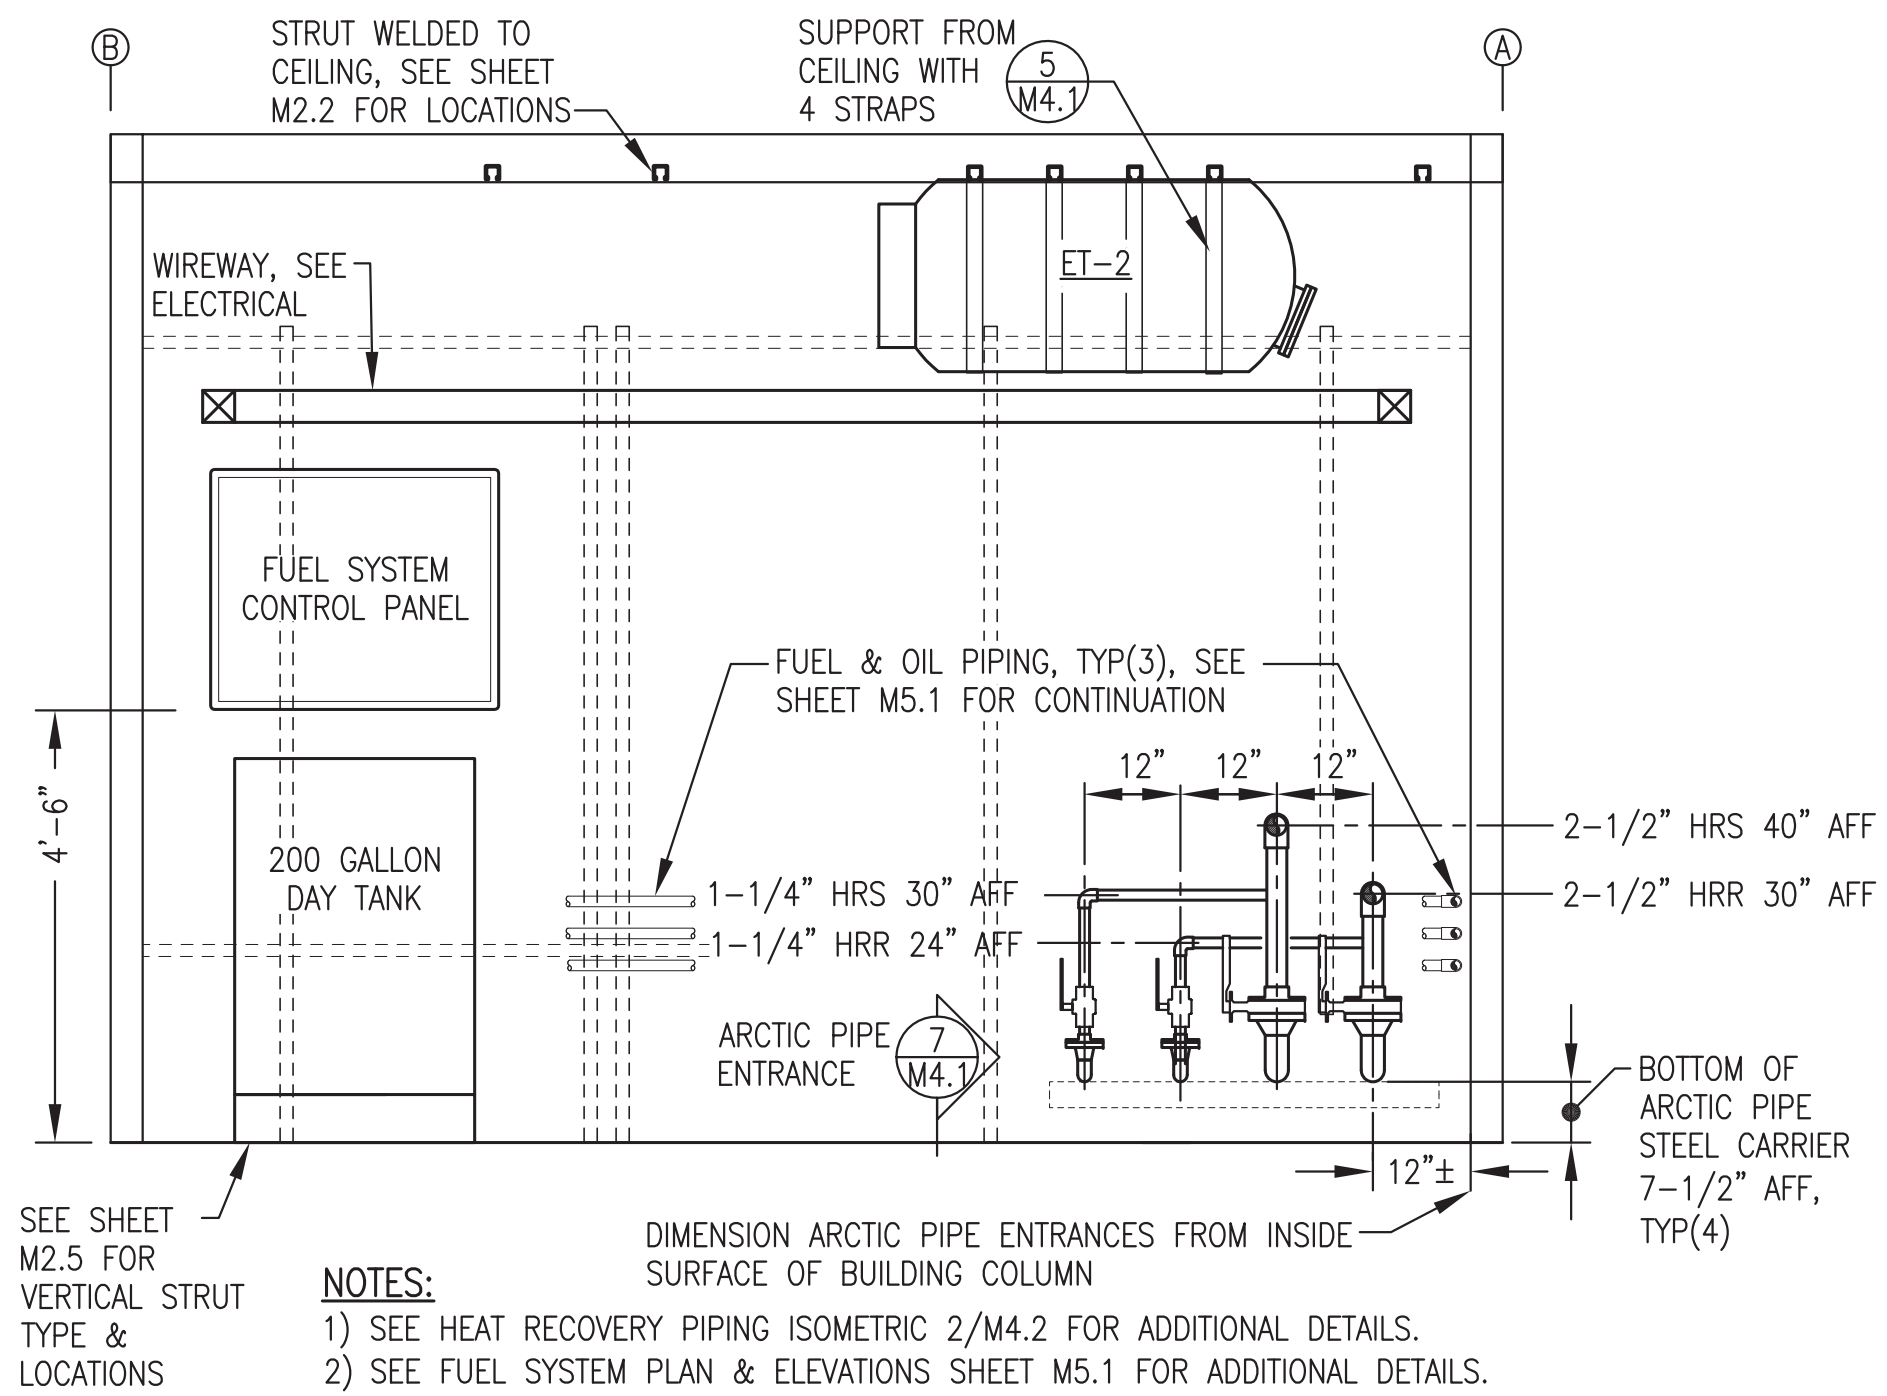


1 END WALL ELEVATION
M3.2 1/2"=1'-0"

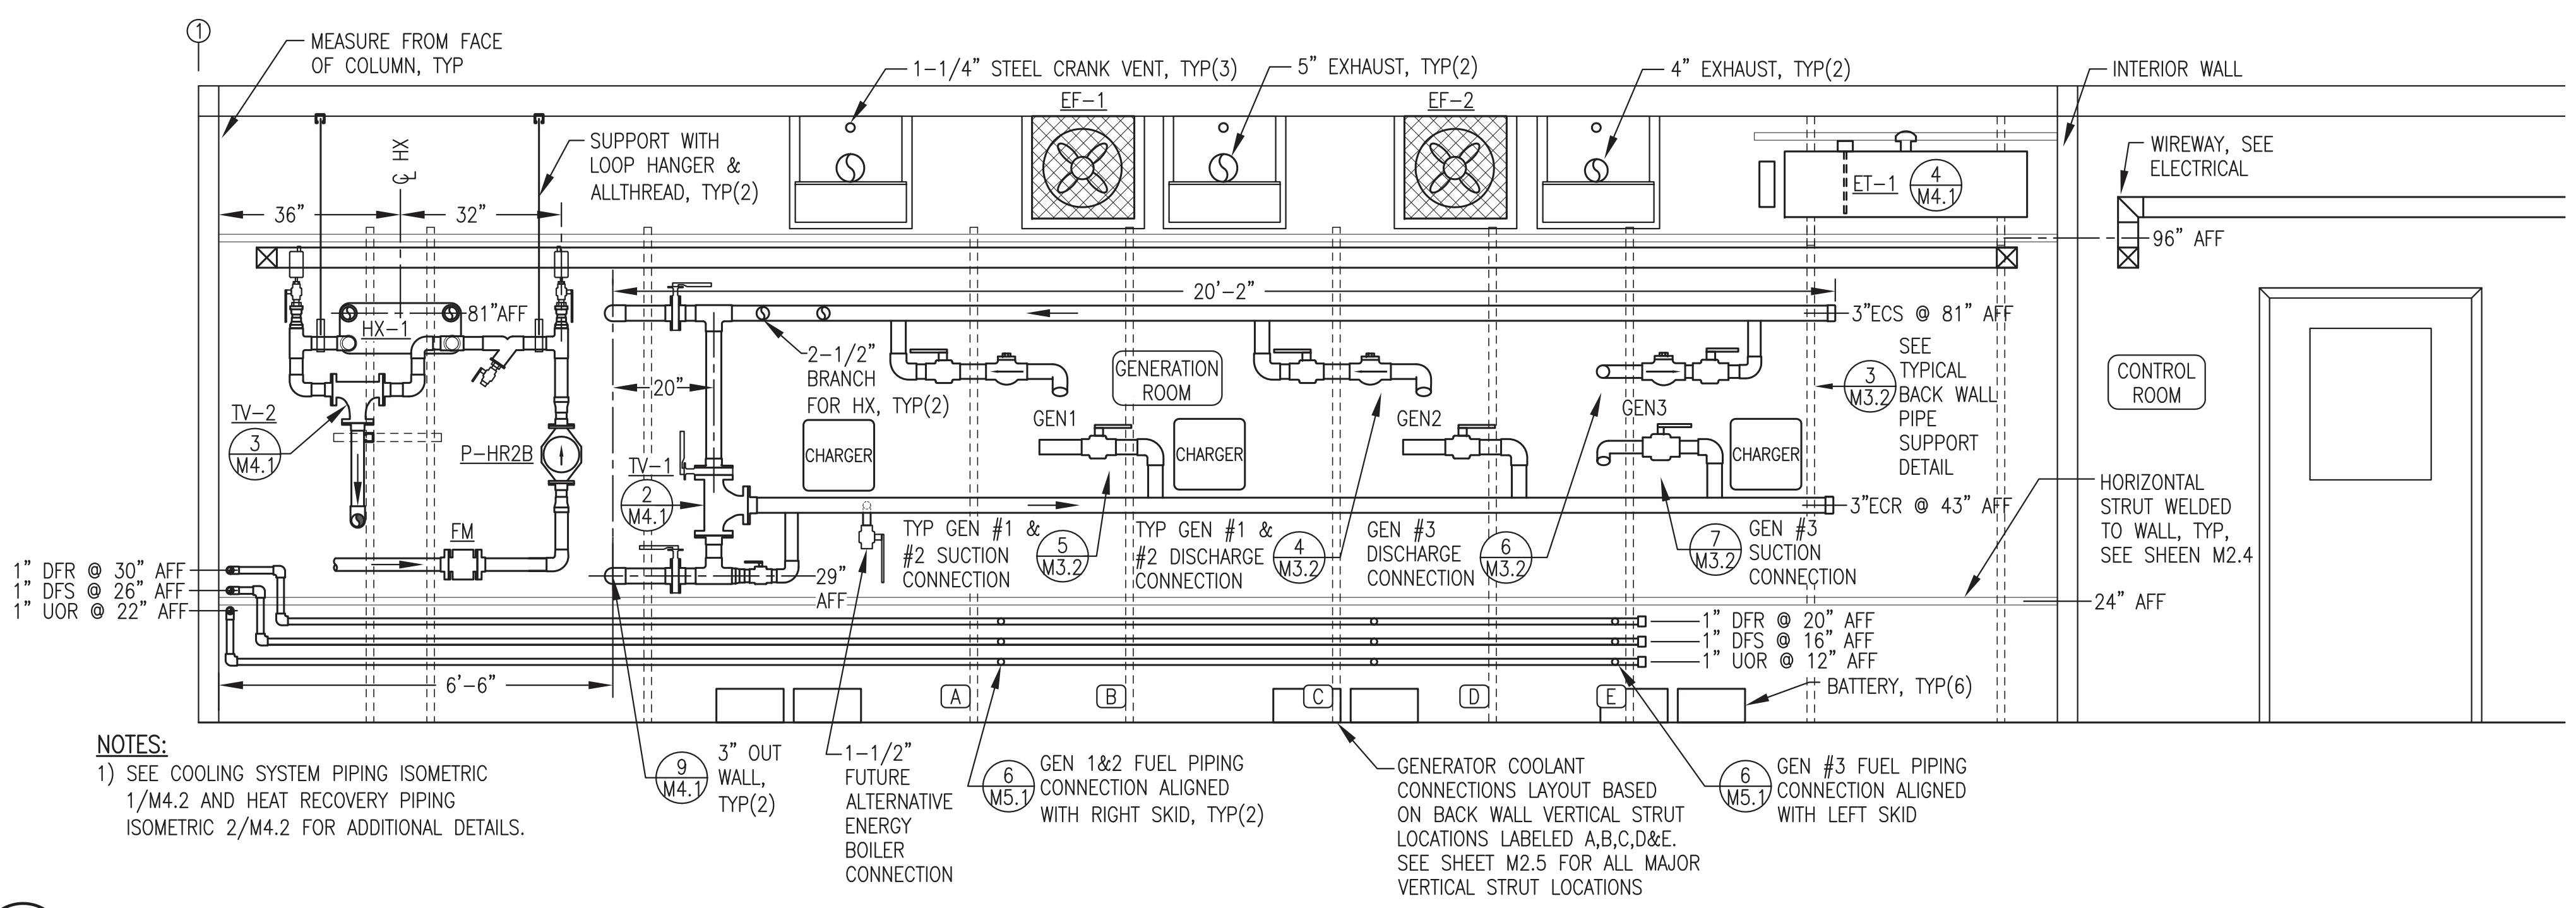


2 BACK WALL ELEVATION
M3.2 1/2"=1'-0"

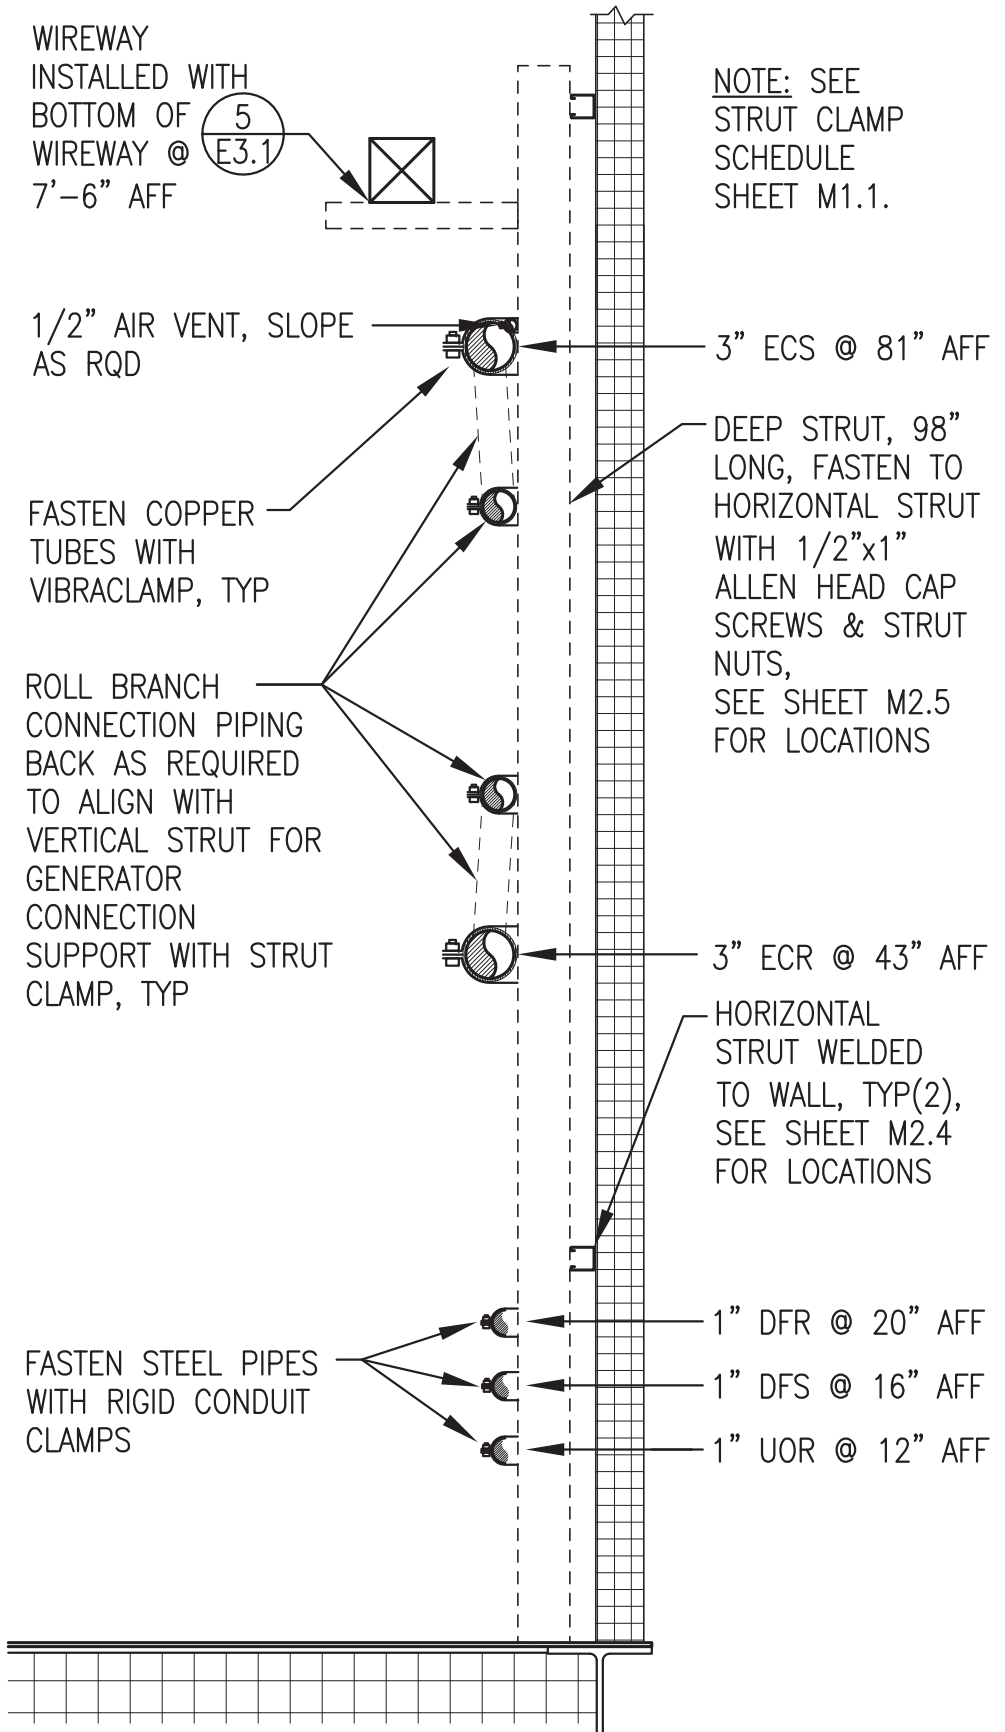


3 TYPICAL PIPE SUPPORT AT BACK WALL
M3.2 1"=1'-0"

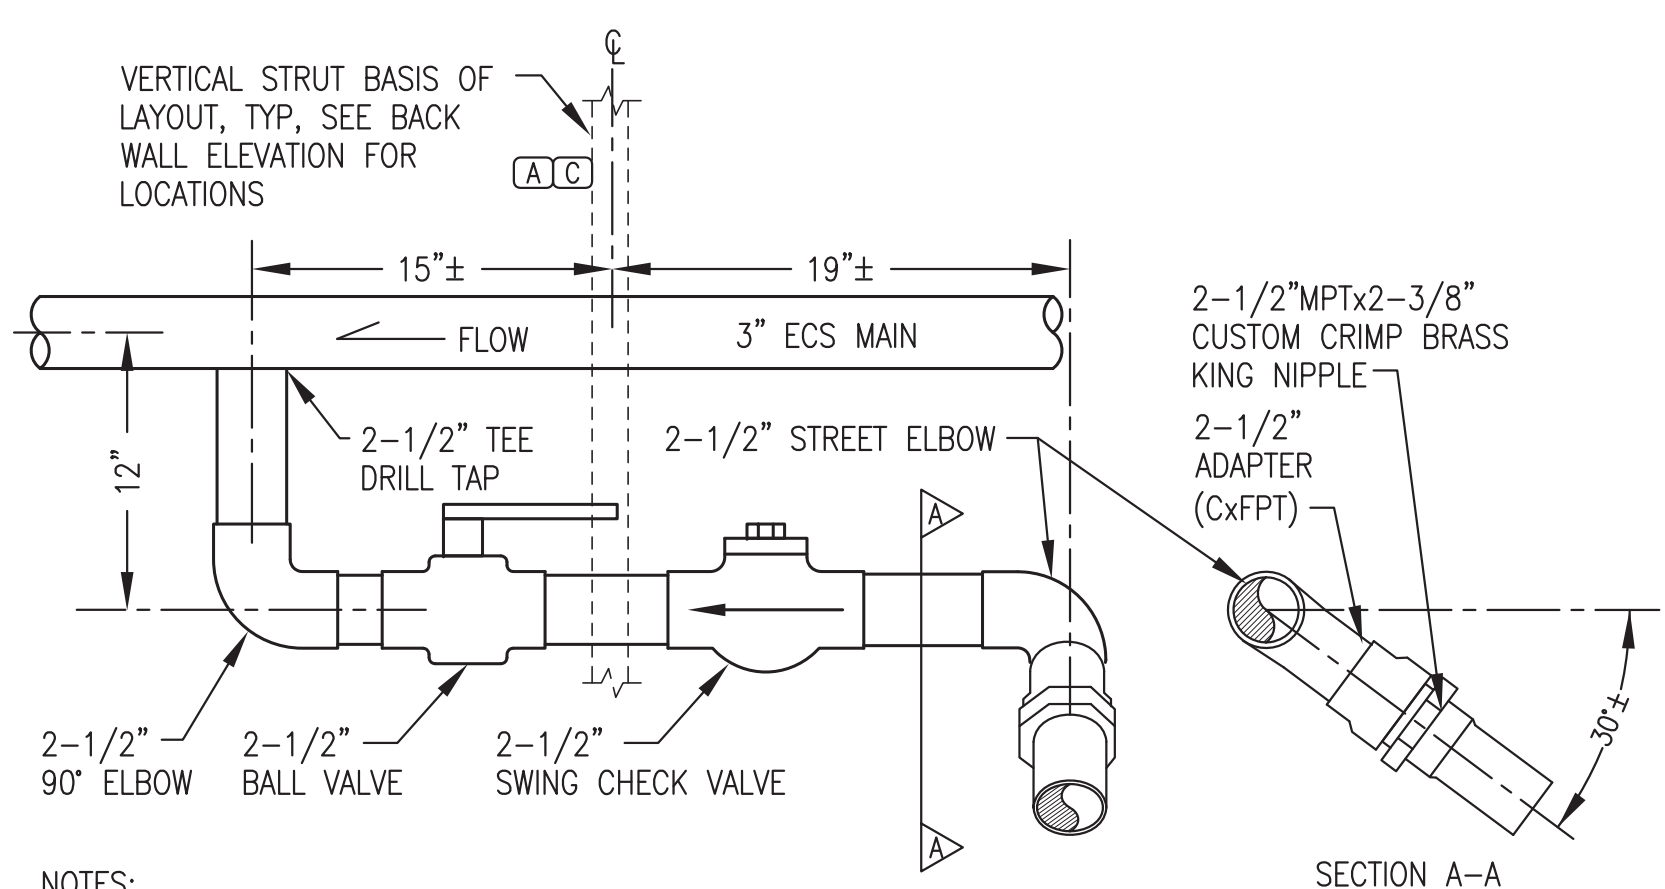


4 GENERATOR #1 & #2 DISCHARGE CONNECTION
M3.2 NO SCALE

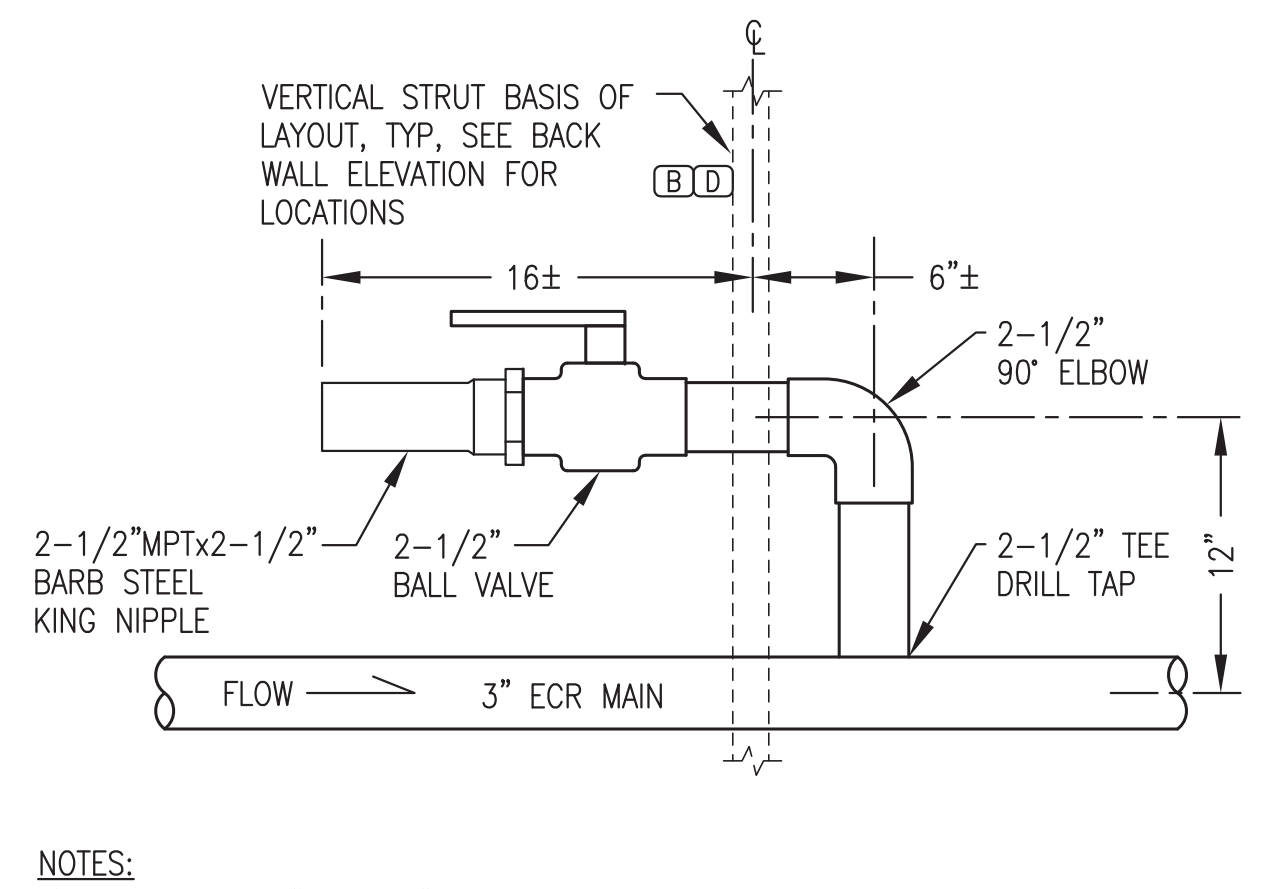

5 GENERATOR #1 & #2 SUCTION CONNECTION
M3.2 NO SCALE

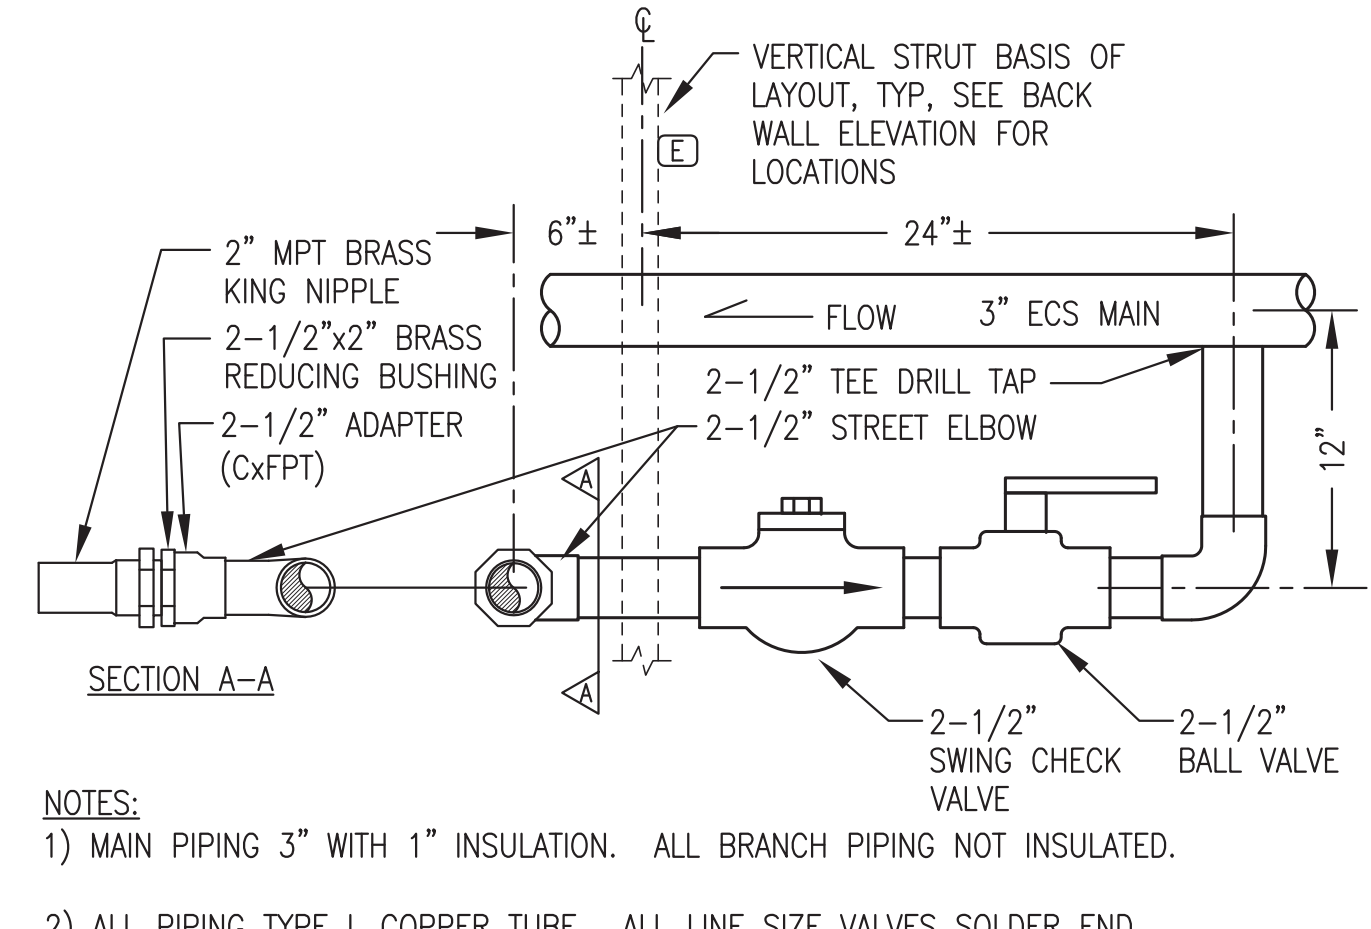

6 GENERATOR #3 DISCHARGE CONNECTION
M3.2 NO SCALE

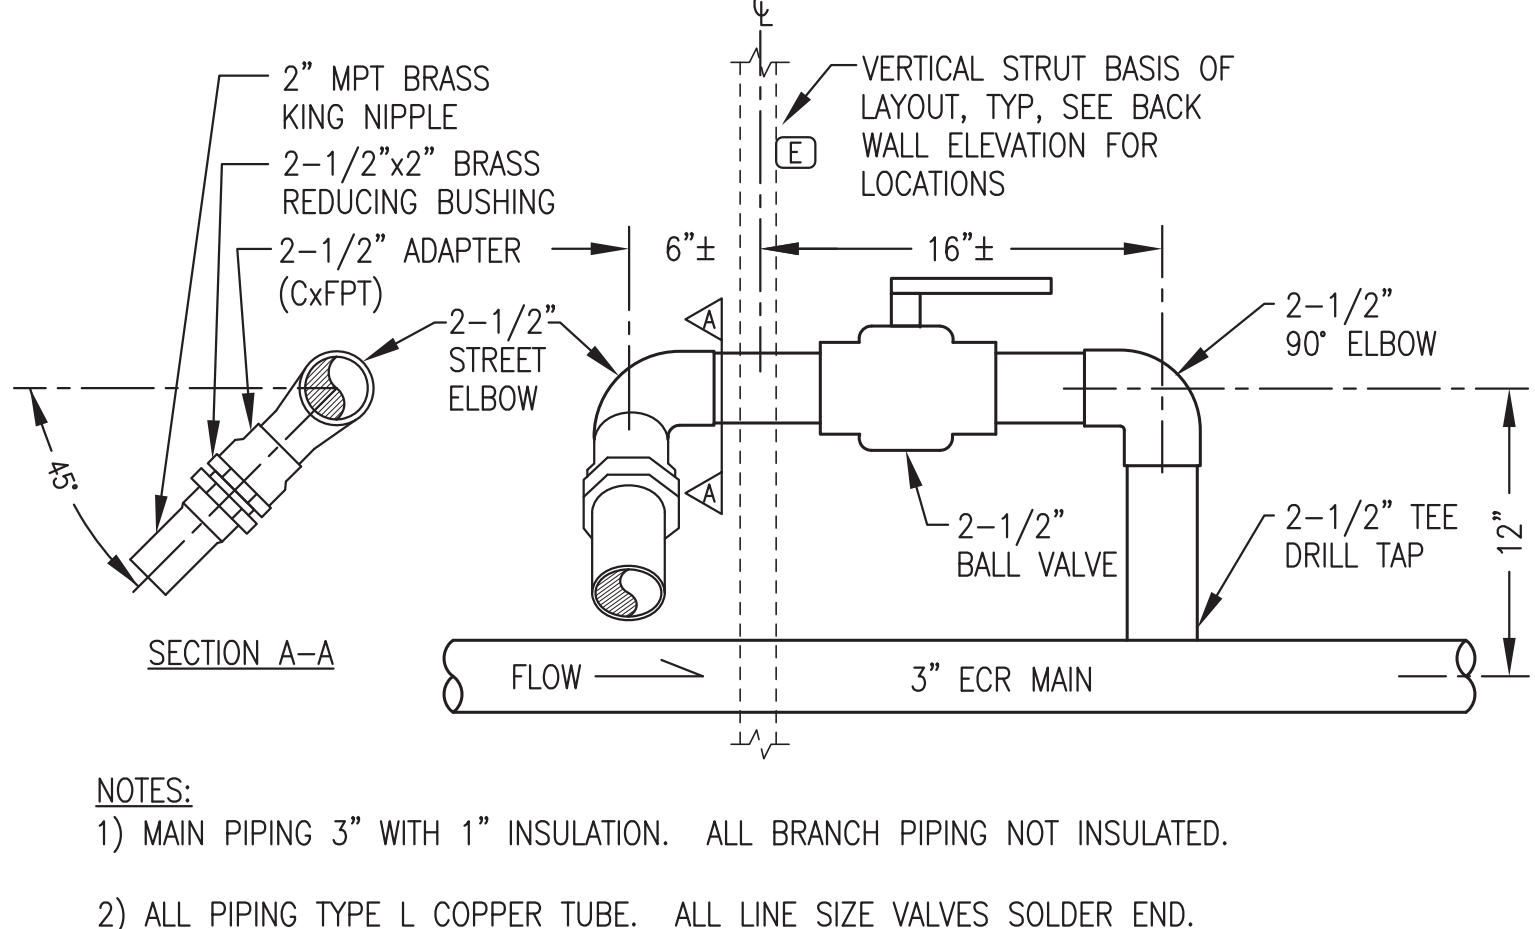


7 GENERATOR #3 SUCTION CONNECTION
M3.2 NO SCALE

NOTES:
1) SEE COOLING SYSTEM PIPING ISOMETRIC 1/M4.2 AND HEAT RECOVERY PIPING ISOMETRIC 2/M4.2 FOR ADDITIONAL DETAILS.


NOTES:
1) MAIN PIPING 3" WITH 1" INSULATION. ALL BRANCH PIPING NOT INSULATED.
2) ALL PIPING TYPE L COPPER TUBE. ALL LINE SIZE VALVES SOLDER END.

NOTES:
1) MAIN PIPING 3" WITH 1" INSULATION. ALL BRANCH PIPING NOT INSULATED.
2) ALL PIPING TYPE L COPPER TUBE. ALL LINE SIZE VALVES SOLDER END.


ISSUED FOR CONSTRUCTION
JANUARY 2019

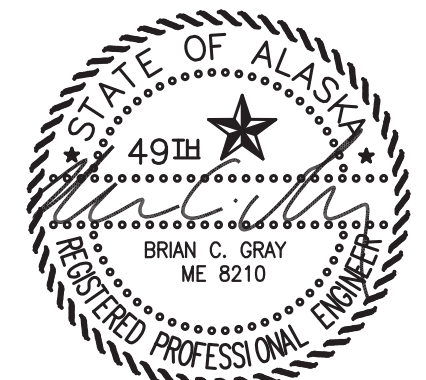


ALASKA ENERGY AUTHORITY	
PROJECT: PORT HEIDEN RURAL POWER SYSTEM POWER PLANT UPGRADE	
TITLE: WALL ELEVATIONS & PIPING DETAILS	
	DRAWN BY: JTD DESIGNED BY: BCG FILE NAME: PTH PPU M2-7 PROJECT NUMBER:
SCALE: AS NOTED DATE: 1-14-19 SHEET: M3.2 OF 7	P.O. 111405, Anchorage, AK 99511 (907)349-0100

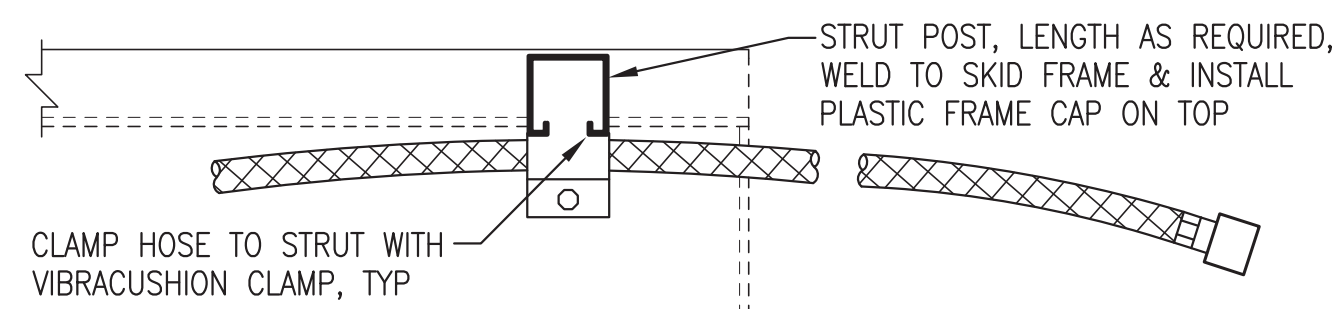

GEN #3 (4045) LEFT SKID PLAN (TOP) VIEW

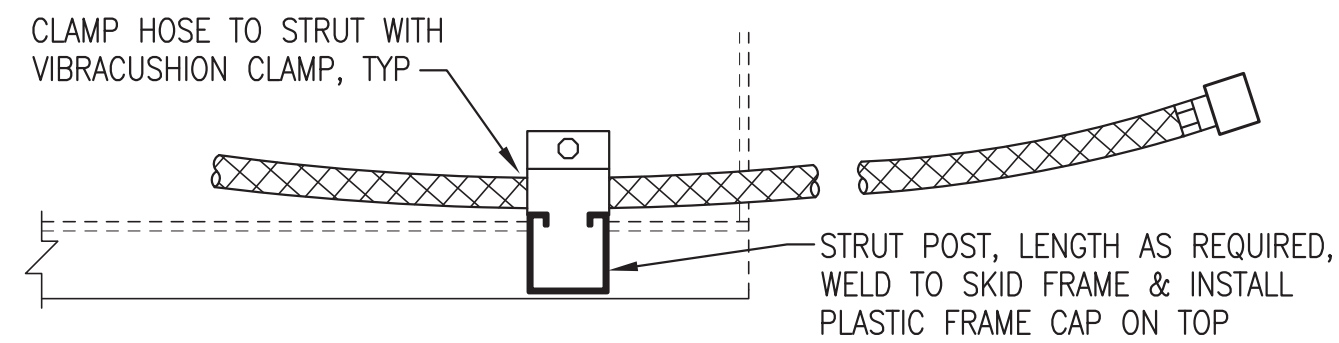

GEN #1 & #2 (6090) RIGHT SKID PLAN (TOP) VIEW

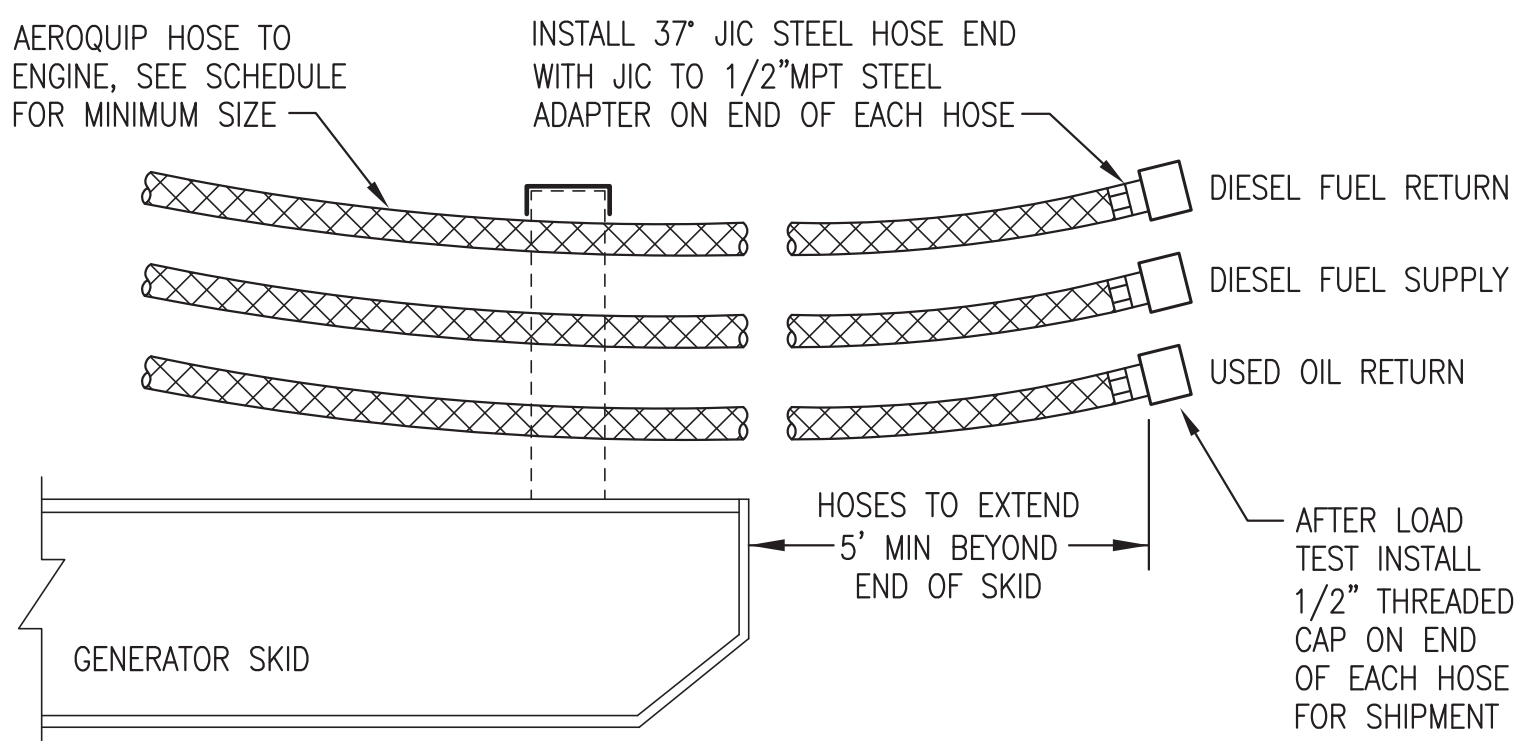


ELEVATION (SIDE) VIEW


MINIMUM HOSE SIZE SCHEDULE		
FUEL SUPPLY	FUEL RETURN	USED OIL
#8	#8	#10

NOTE:
ON 4045 GROUP HOSES ON LEFT SKID AND ON 6090 GROUP HOSES ON RIGHT SKID AS SHOWN TO COORDINATE WITH COOLANT HOSES.


1 FUEL & OIL HOSE TERMINATIONS
M3.3 NO SCALE

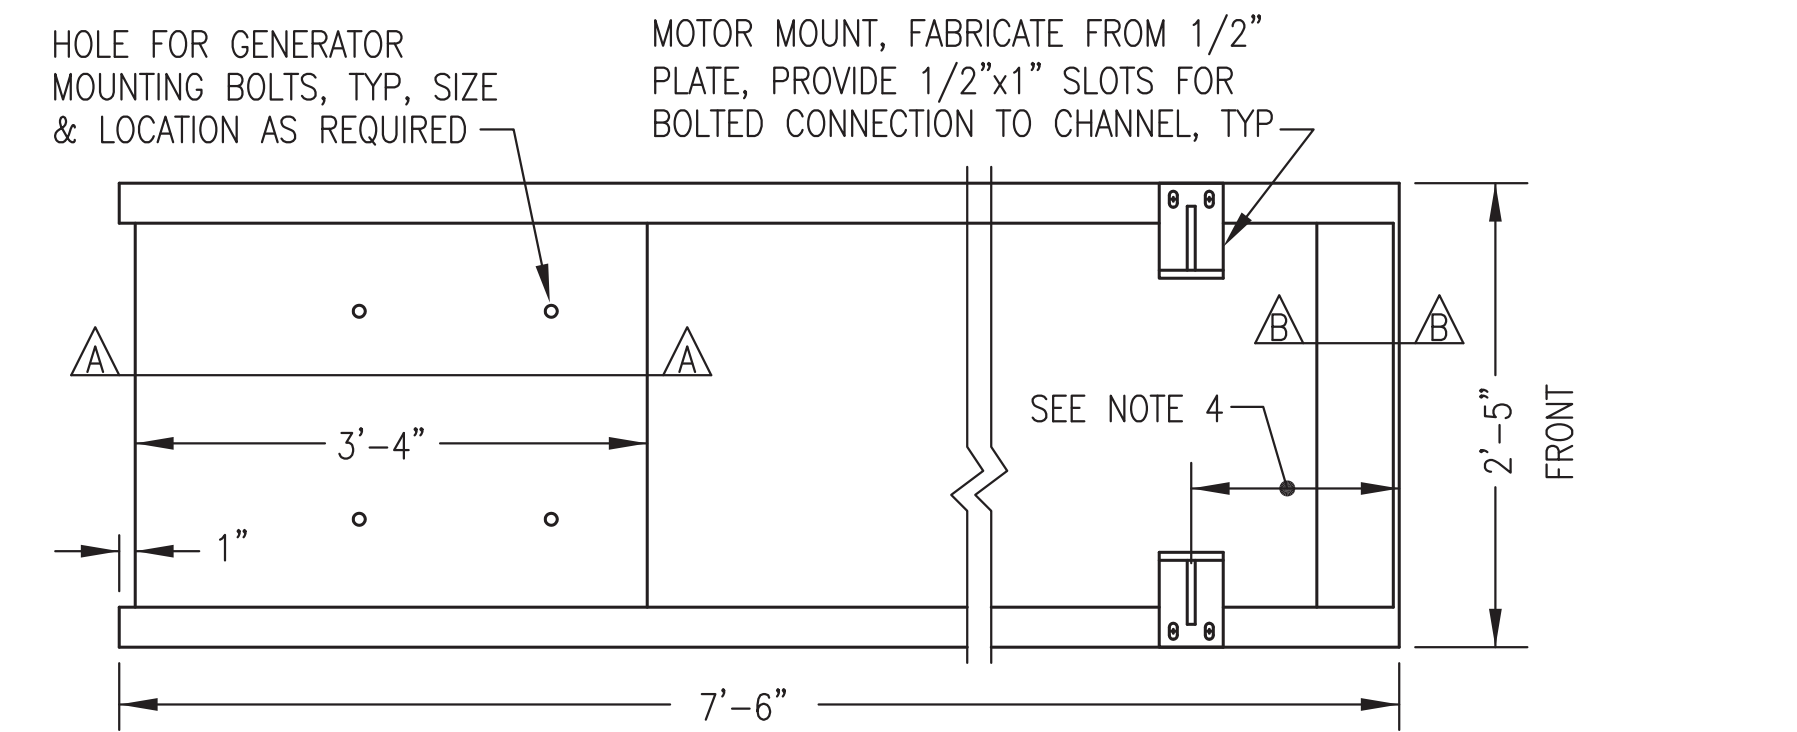


PLAN (TOP) VIEW

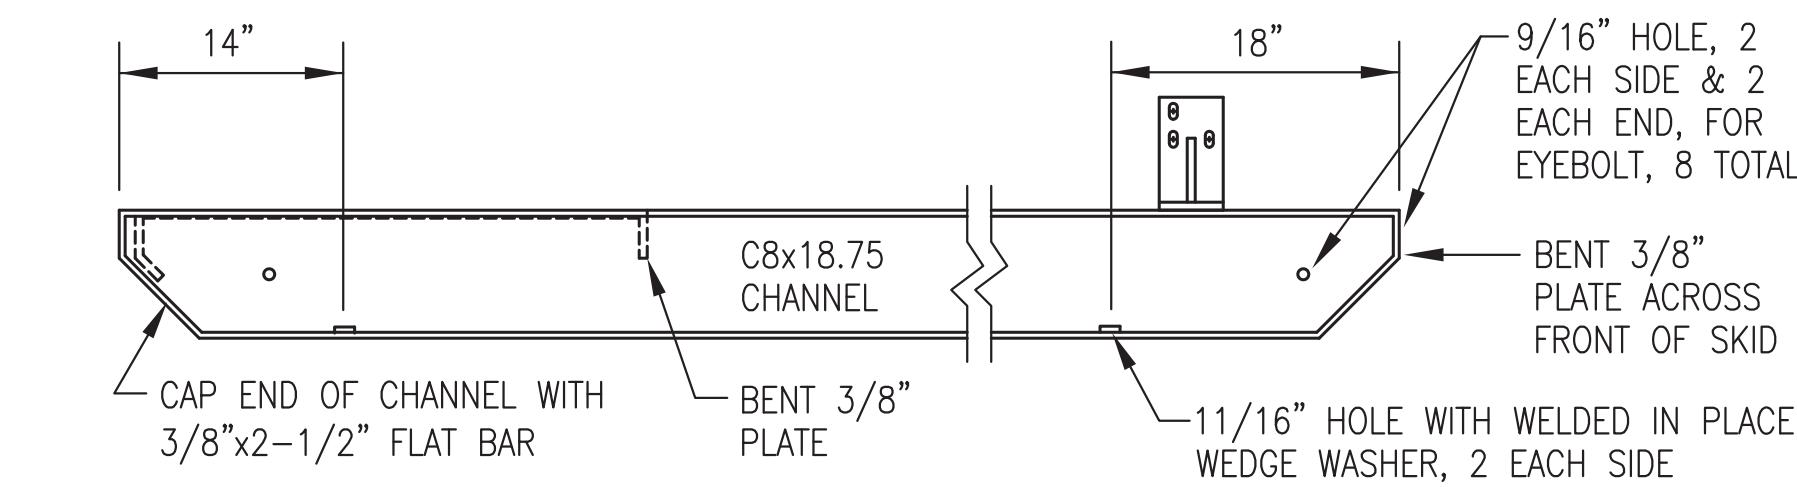

ELEVATION (SIDE) VIEW

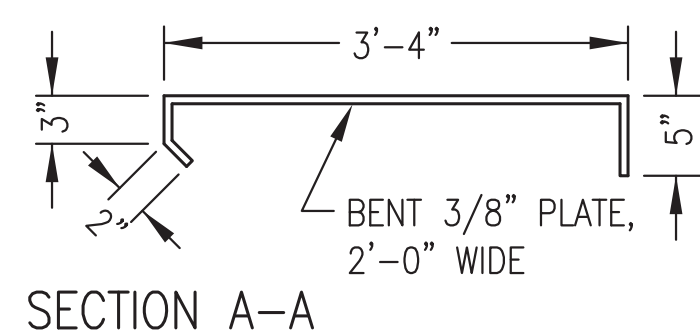

SECTION A-A

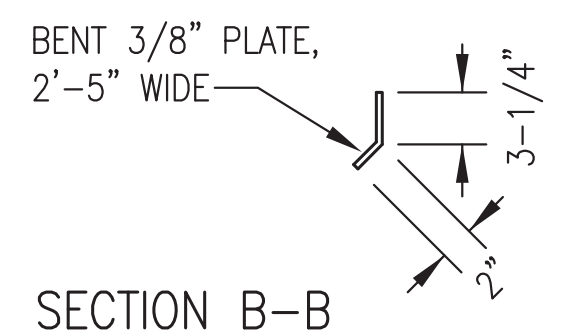


SECTION B-B


NOTES:

- 1) FABRICATE FROM ASTM A-36 STEEL. BEND PLATES & CUT ENDS OF CHANNELS AT 90° & 45° AS SHOWN.
- 2) EXCEPT WHERE INDICATED AS BOLTED MAKE ALL CONNECTIONS WITH CONTINUOUS WELDS (FILLET OR FULL-PENETRATION GROOVE AS REQUIRED) IN ACCORDANCE WITH CURRENT AWS STANDARD CODE.
- 3) ROUND ALL CORNERS & GRIND WELDS SMOOTH AFTER FABRICATION. PAINT TO MATCH ENGINE-GENERATOR.
- 4) PLACE UNIT ON SKID SO THAT THE EXHAUST RISER CENTERLINE IS 4'-1" FROM THE FRONT OF THE SKID.


2 GENERATOR #1 & #2 (JOHN DEERE 6090AFM75) SKID DESIGN
M3.3 NO SCALE

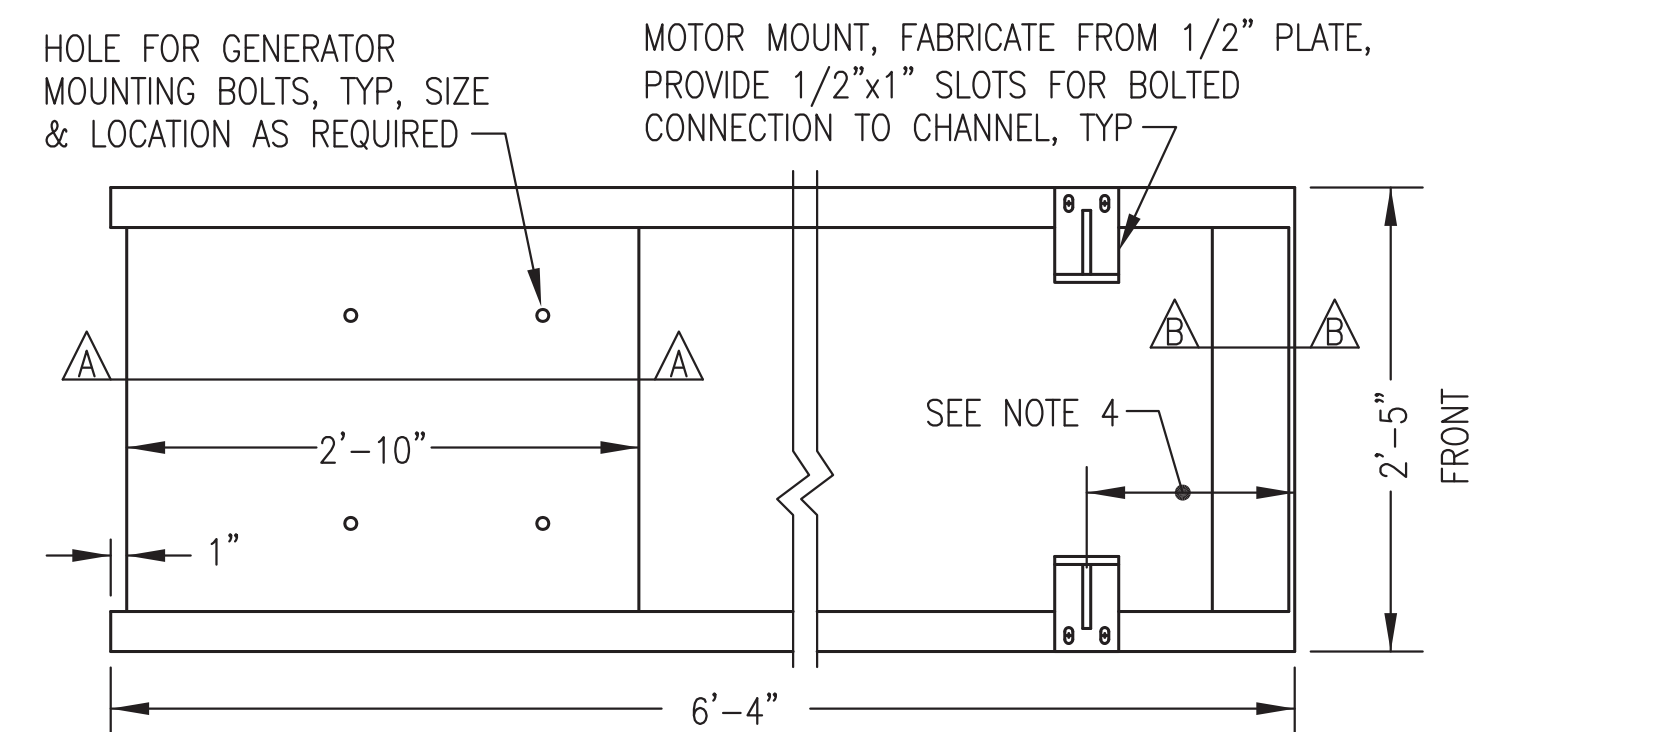


PLAN (TOP) VIEW

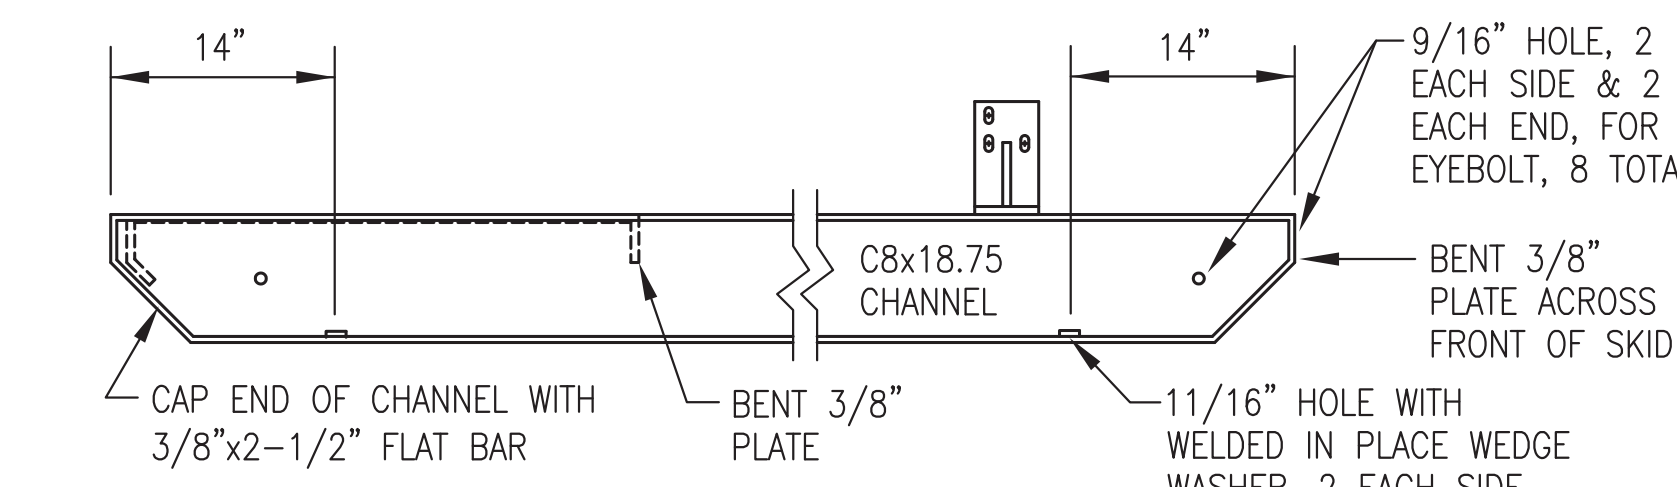

ELEVATION (SIDE) VIEW

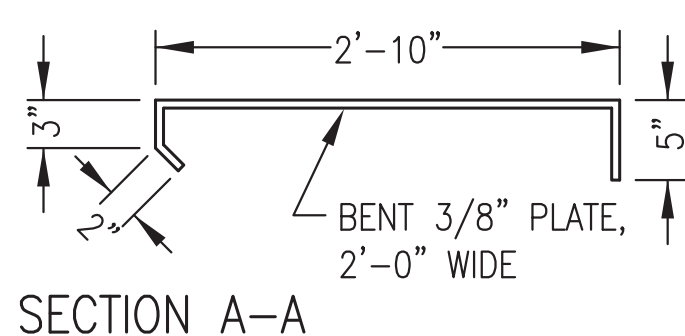

SECTION A-A

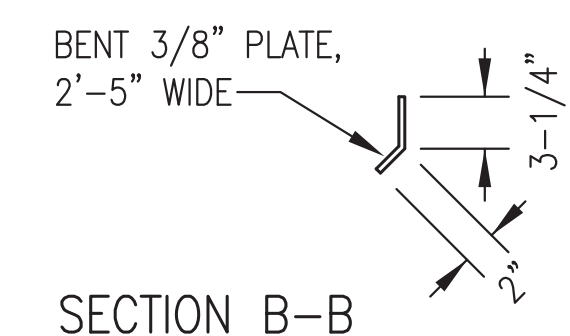


SECTION B-B

NOTES:

- 1) FABRICATE FROM ASTM A-36 STEEL. BEND PLATES & CUT ENDS OF CHANNELS AT 90° & 45° AS SHOWN.
- 2) EXCEPT WHERE INDICATED AS BOLTED MAKE ALL CONNECTIONS WITH CONTINUOUS WELDS (FILLET OR FULL-PENETRATION GROOVE AS REQUIRED) IN ACCORDANCE WITH CURRENT AWS STANDARD CODE.
- 3) ROUND ALL CORNERS & GRIND WELDS SMOOTH AFTER FABRICATION. PAINT TO MATCH ENGINE-GENERATOR.
- 4) PLACE UNIT ON SKID SO THAT THE EXHAUST RISER CENTERLINE IS 3'-2" FROM THE FRONT OF THE SKID.


3 GENERATOR #3 (JOHN DEERE 4045AFM85) SKID DESIGN
M3.3

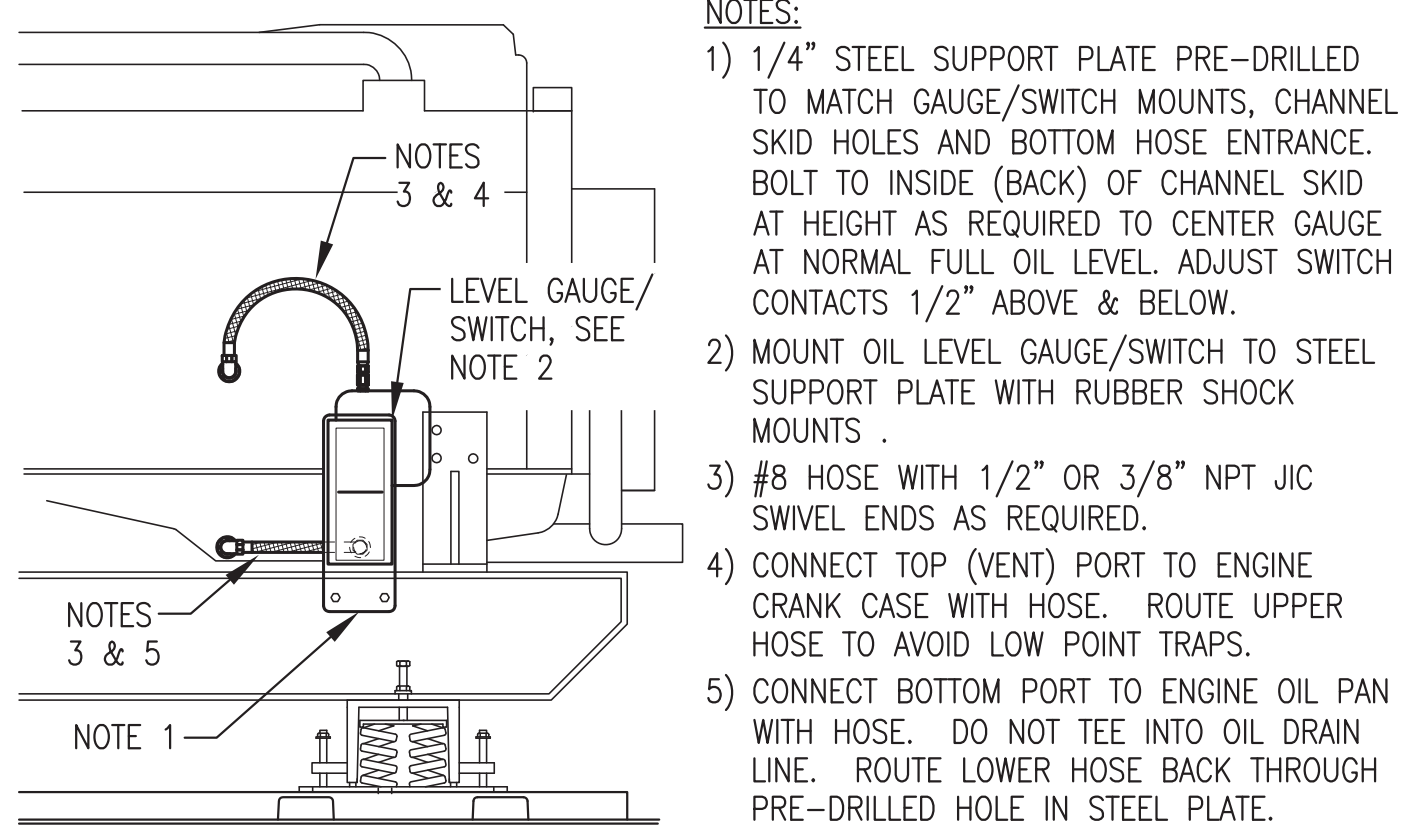

NOTES:


- 1) 1/4" STEEL SUPPORT PLATE PRE-DRILLED TO MATCH GAUGE/SWITCH MOUNTS, CHANNEL SKID HOLES AND BOTTOM HOSE ENTRANCE. BOLT TO INSIDE (BACK) OF CHANNEL SKID AT HEIGHT AS REQUIRED TO CENTER GAUGE AT NORMAL FULL OIL LEVEL. ADJUST SWITCH CONTACTS 1/2" ABOVE & BELOW.
- 2) MOUNT OIL LEVEL GAUGE/SWITCH TO STEEL SUPPORT PLATE WITH RUBBER SHOCK MOUNTS.
- 3) #8 HOSE WITH 1/2" OR 3/8" NPT JIC SWIVEL ENDS AS REQUIRED.
- 4) CONNECT TOP (VENT) PORT TO ENGINE CRANK CASE WITH HOSE. ROUTE UPPER HOSE TO AVOID LOW POINT TRAPS.
- 5) CONNECT BOTTOM PORT TO ENGINE OIL PAN WITH HOSE. DO NOT TEE INTO OIL DRAIN LINE. ROUTE LOWER HOSE BACK THROUGH PRE-DRILLED HOLE IN STEEL PLATE.

4 TYPICAL OIL LEVEL GAUGE/SWITCH INSTALLATION
M3.3 NO SCALE

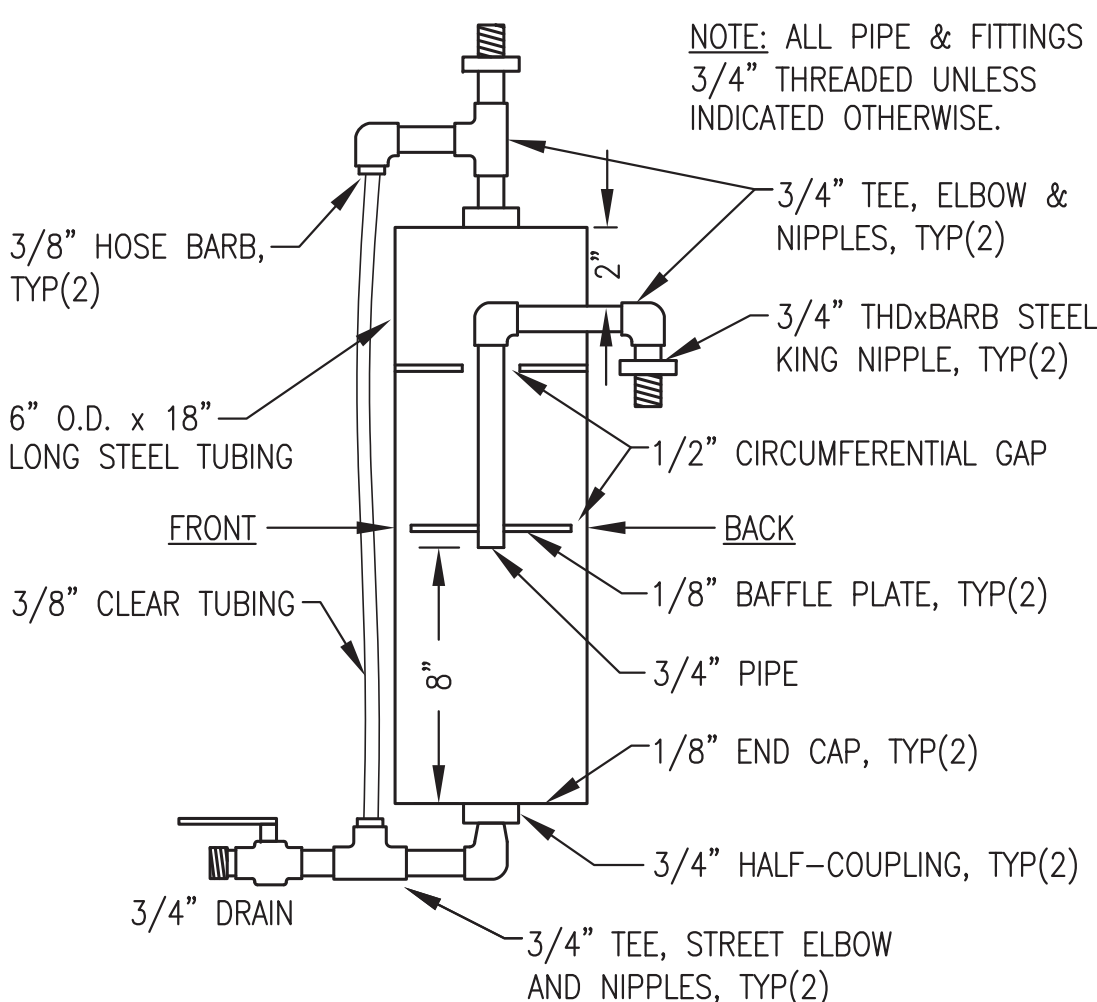

5 CONDENSATE TRAP FABRICATION
M3.3 NO SCALE

ISSUED FOR CONSTRUCTION
JANUARY 2019

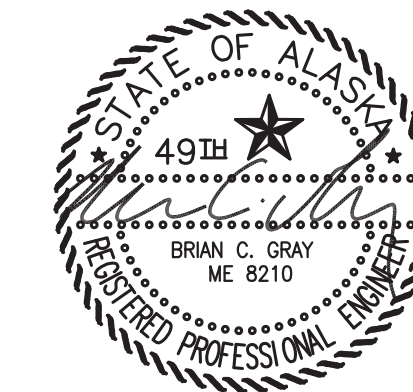

PROJECT: PORT HEIDEN RURAL POWER SYSTEM POWER PLANT UPGRADE	
TITLE: GENERATOR FABRICATION DETAILS	
DRAWN BY: JTD	SCALE: AS NOTED
DESIGNED BY: BCG	DATE: 1-14-19
FILE NAME: PTH PPU M2-7	SHEET: M3.3 OF 7
PROJECT NUMBER:	

Gray Stassel Engineering, Inc.
P.O. 111405, Anchorage, AK 99511 (907)349-0100

GLYCOL TANK SPECIFIC NOTES:



- 1) 1-1/2" FPT - INSTALL DAY TANK GAUGE G-DT.
- 2) 2" FPT - INSTALL 2" SCREENED VENT CAP ON 2"x6" NIPPLE.
- 3) 1" SCHEDULE 80 PIPE WITH THREADED TOP CONNECTION (WITHDRAWAL)
- 4) 1" SOCKETWELD 90° ELBOW
- 5) 1" THREADED HAND PUMP ADAPTER FLANGE, TOP OF FLANGE FLUSH WITH TOP OF TANK. INSTALL DAY TANK HAND PUMP HP-DT.
- 6) 2x1/4" FLAT BAR CONTINUOUS THREE SIDES
- 7) 3/8" HOLE AT 8" O.C. ALL AROUND
- 8) L2x2x1/4"x6' LONG. SET FACE TO BOLT TO HAND PUMP.

GLYCOL TANK GENERAL NOTES:

- 1. FABRICATE SINGLE WALL 60 GALLON NOMINAL CAPACITY GLYCOL TANK.
- 2. FABRICATE FROM ASTM A-36 STEEL PLATE, 10 GAUGE MINIMUM EXCEPT FOR TOP 3/16" MINIMUM. ALL TANK SEAM JOINTS TO BE FULL CONTINUOUS WELDS.
- 3. PROVIDE WITH ALL OPENINGS AND ATTACHMENTS INDICATED. SEAL WELD ALL TANK ATTACHMENTS.
- 4. ALL FPT OPENINGS TO BE FORGED STEEL HALF COUPLINGS.
- 5. UPON COMPLETION OF FABRICATION, ROUND ALL CORNERS AND SHARP EDGES. SANDBLAST TANK EXTERIOR AND ALL ATTACHMENTS IN ACCORDANCE WITH SSPC-SP-6. PAINT WITH TWO COATS OF SHERWIN WILLIAMS MACROPOXY 646 OR APPROVED EQUAL, COLOR STRUCTURAL GRAY 4031.
- 6. UPON COMPLETION FLUSH INTERIOR OF TANK TO REMOVE ALL DIRT AND DEBRIS AND AIR DRY INTERIOR. INSTALL VENT CAP, GAUGE, AND HAND PUMP.

EXPANSION TANK GENERAL NOTES:


- 1) FABRICATE SINGLE WALL 24 GALLON NOMINAL CAPACITY GLYCOL EXPANSION TANK.
- 2) FABRICATE SHELL FROM MINIMUM 10 GAUGE ASTM A-36 PLATE STEEL ROLLED AND WELDED OR SCHEDULE 5 LIGHTWALL ASTM A53 STEEL PIPE. FABRICATE HEADS FROM 3/16" THICK ASTM A-36 PLATE STEEL. MAKE ALL JOINTS WITH CONTINUOUS FULL-PENETRATION WELDS.
- 3) PROVIDE WITH ALL OPENINGS INDICATED USING MINIMUM 3000# FORGED STEEL PIPE HALF COUPLINGS IN ACCORDANCE WITH U.L 142 FIGURE 7.1 #2.
- 4) PRESSURE TEST COMPLETED ASSEMBLY TO 15 PSIG MINIMUM.
- 5) UPON COMPLETION OF FABRICATION, ROUND ALL CORNERS AND SHARP EDGES. SANDBLAST TANK EXTERIOR AND ALL ATTACHMENTS IN ACCORDANCE WITH SSPC-SP-6. PAINT WITH TWO COATS OF SHERWIN WILLIAMS MACROPOXY 646 OR APPROVED EQUAL, COLOR STRUCTURAL GRAY 4031.
- 6) UPON COMPLETION FLUSH INTERIOR OF TANK TO REMOVE ALL DIRT AND DEBRIS, AIR DRY INTERIOR, AND SEAL ALL TANK OPENINGS WITH PLASTIC PLUGS.

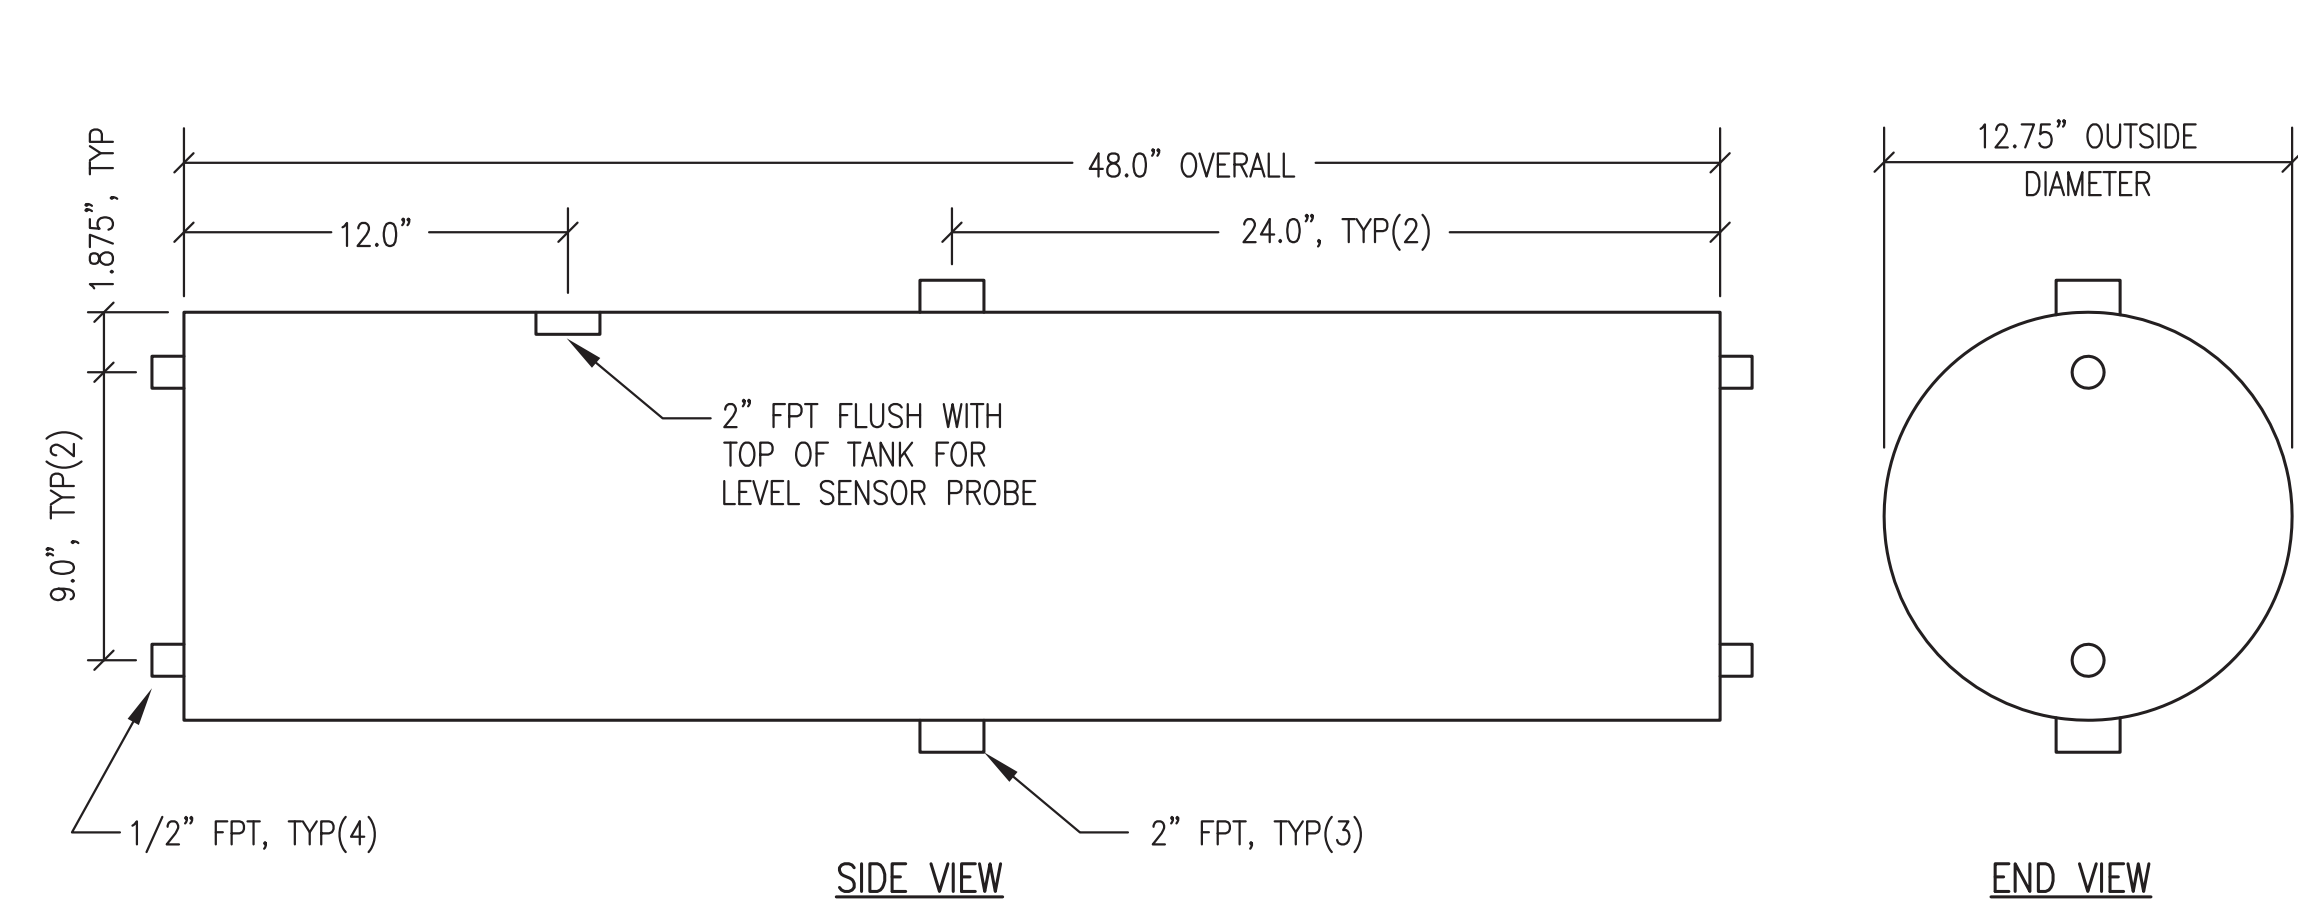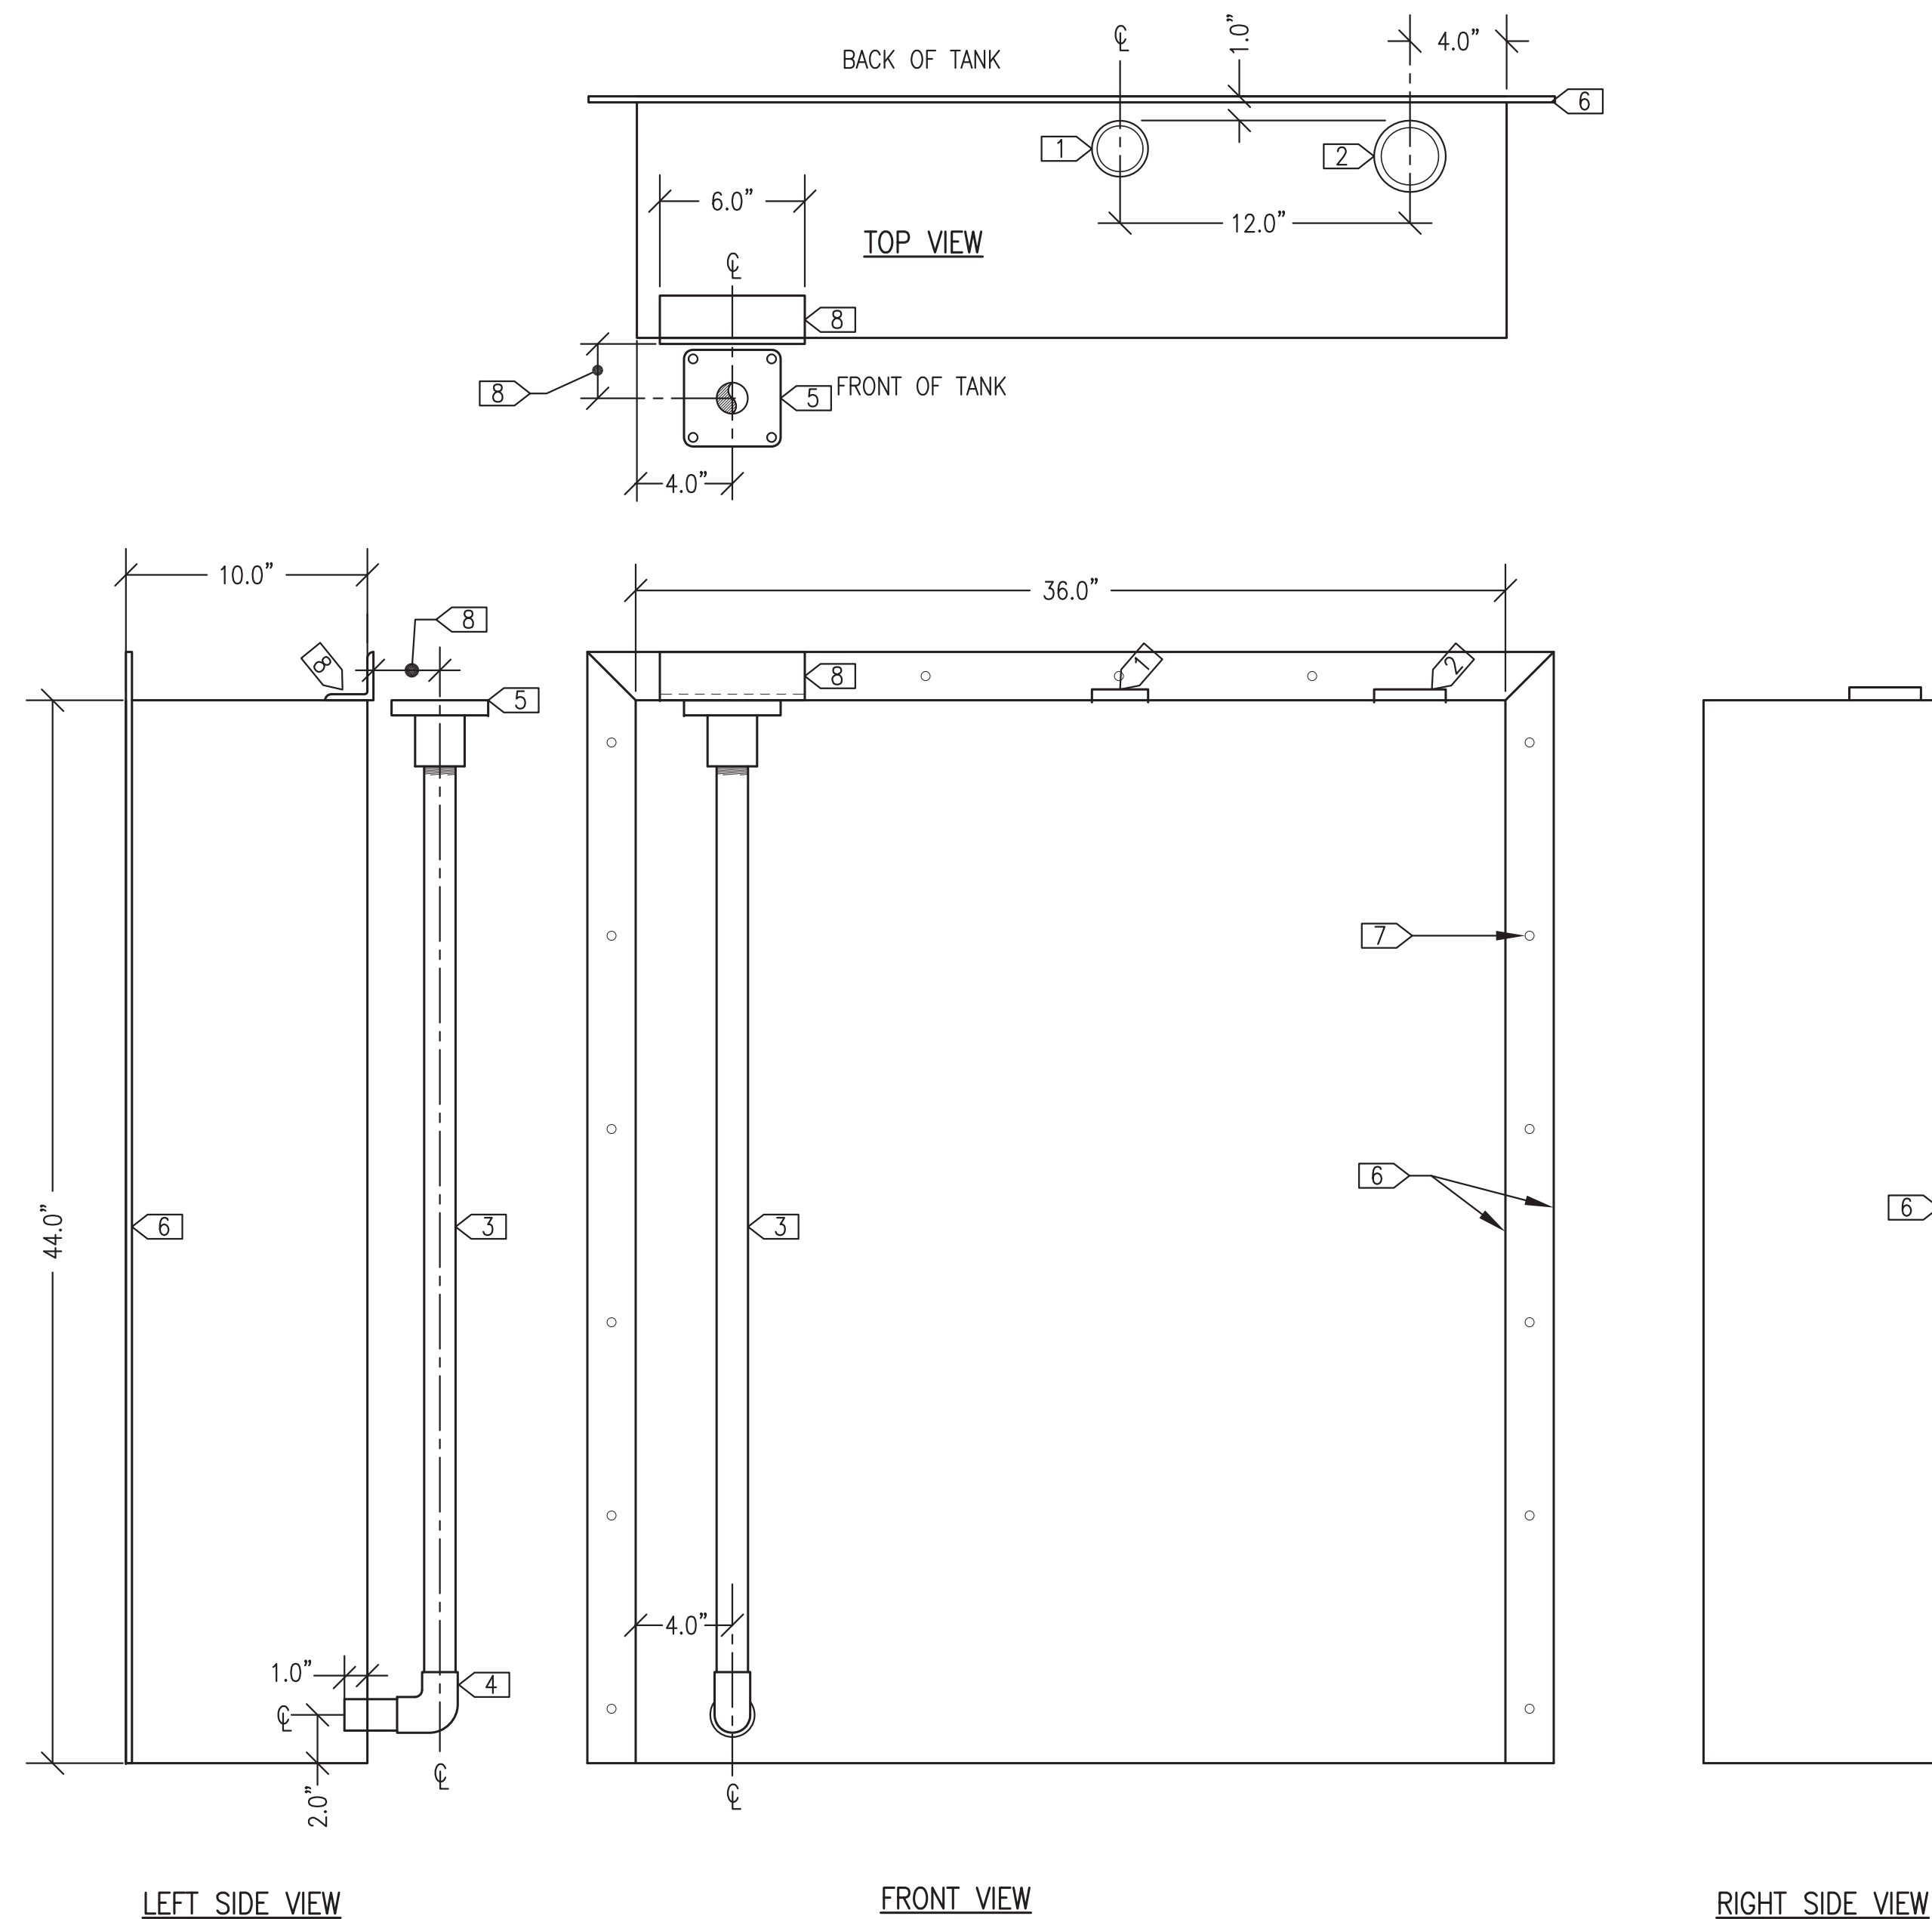


2 24 GALLON GLYCOL EXPANSION TANK
M3.4 1"=6"

1 60 GALLON GLYCOL STORAGE TANK
M3.4 1"=6"


ISSUED FOR
CONSTRUCTION
JANUARY 2019

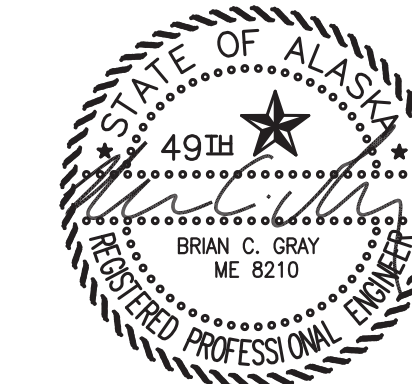


ALASKA ENERGY AUTHORITY		
PROJECT:	PORT HEIDEN RURAL POWER SYSTEM POWER PLANT UPGRADE	
TITLE:	GLYCOL STORAGE & EXPANSION TANK FABRICATION	
DESIGNED BY: BCG	DRAWN BY: JTD	SCALE: AS NOTED
FILE NAME: PTH PPU M2-7		DATE: 1-14-19
PROJECT NUMBER:		SHEET: M3.4 OF 7
P.O. 111405, Anchorage, AK 99511 (907)349-0100		

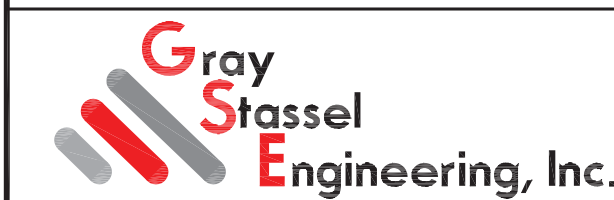


BURIED HEAT RECOVERY ARCTIC PIPE LOOPS TO COMMUNITY SHOP BUILDINGS & SCHOOL, SEE SHEET M8 FOR CONTINUATION

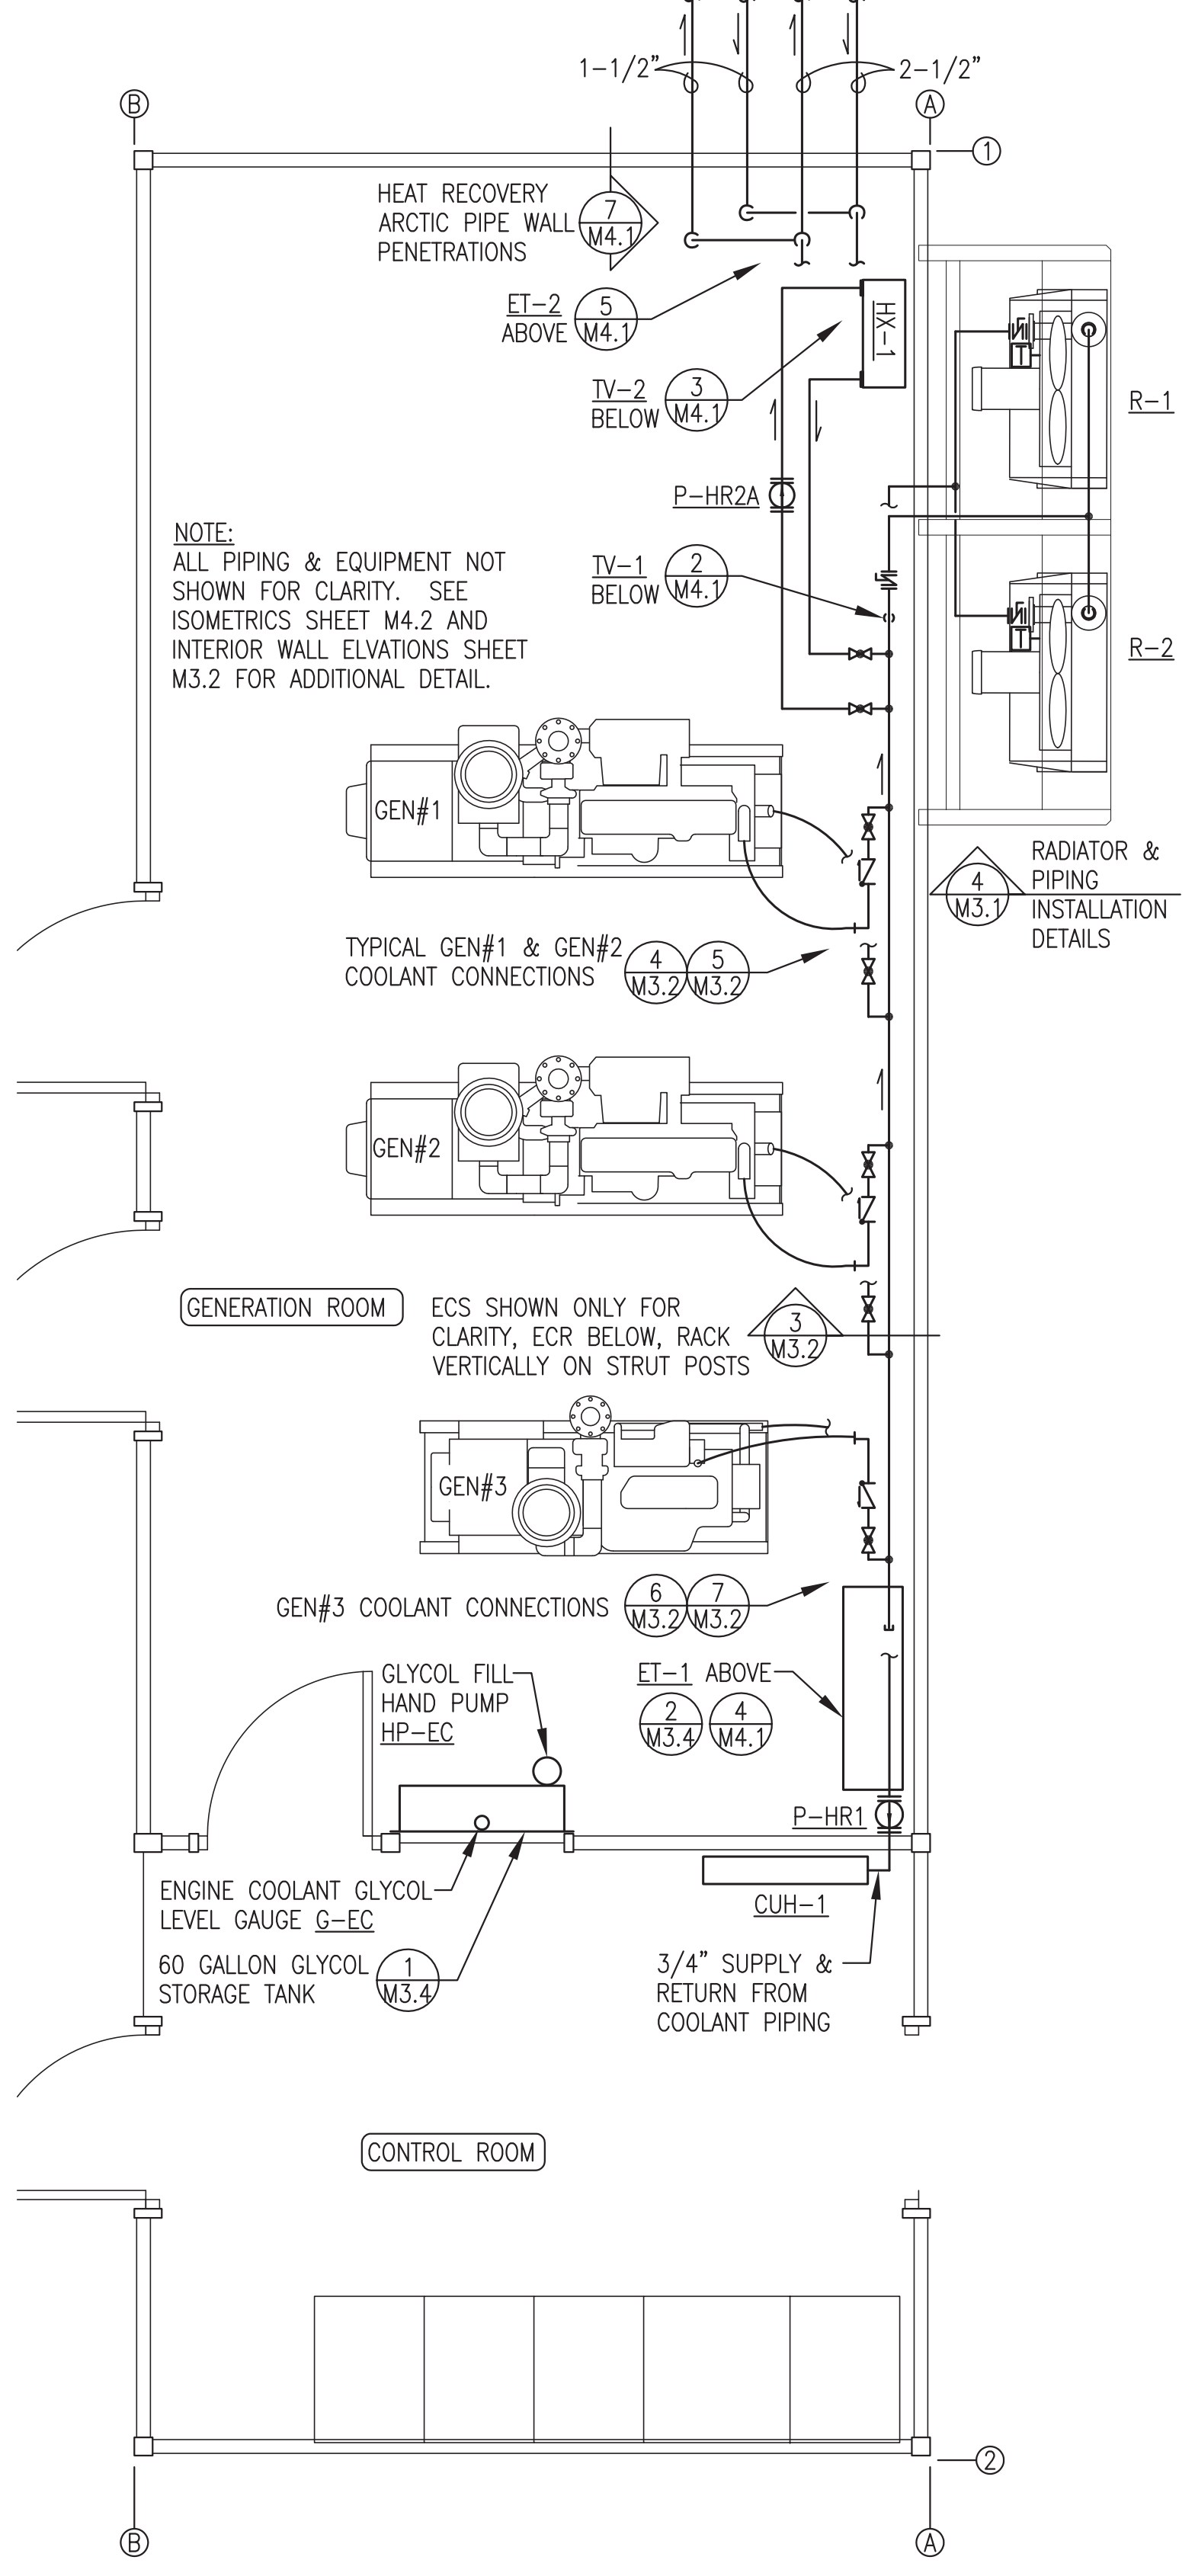


1 COOLANT AND HEAT RECOVERY PIPING PLAN
M4.1 3/8"=1'-0"

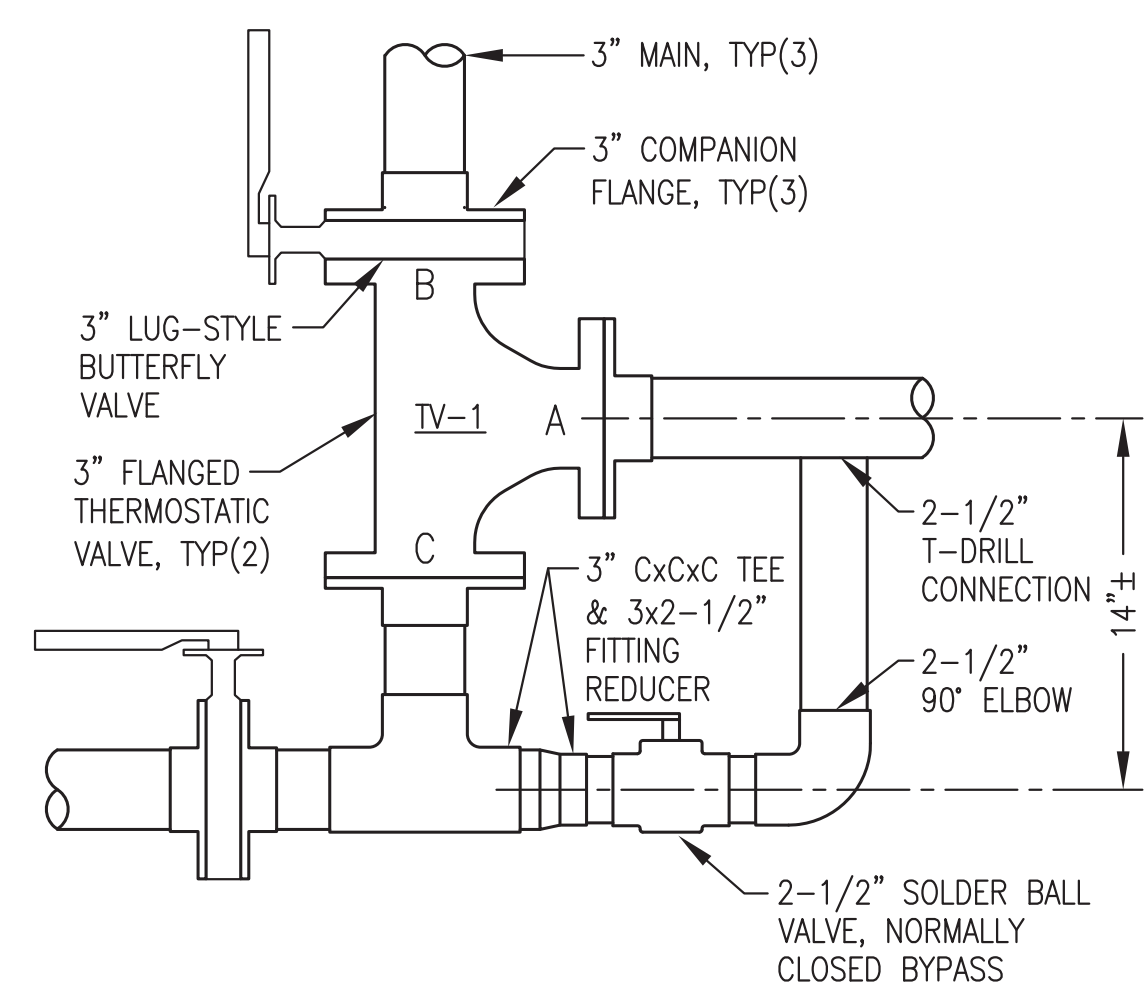


2 TV-1 INSTALLATION
M4.1 NO SCALE

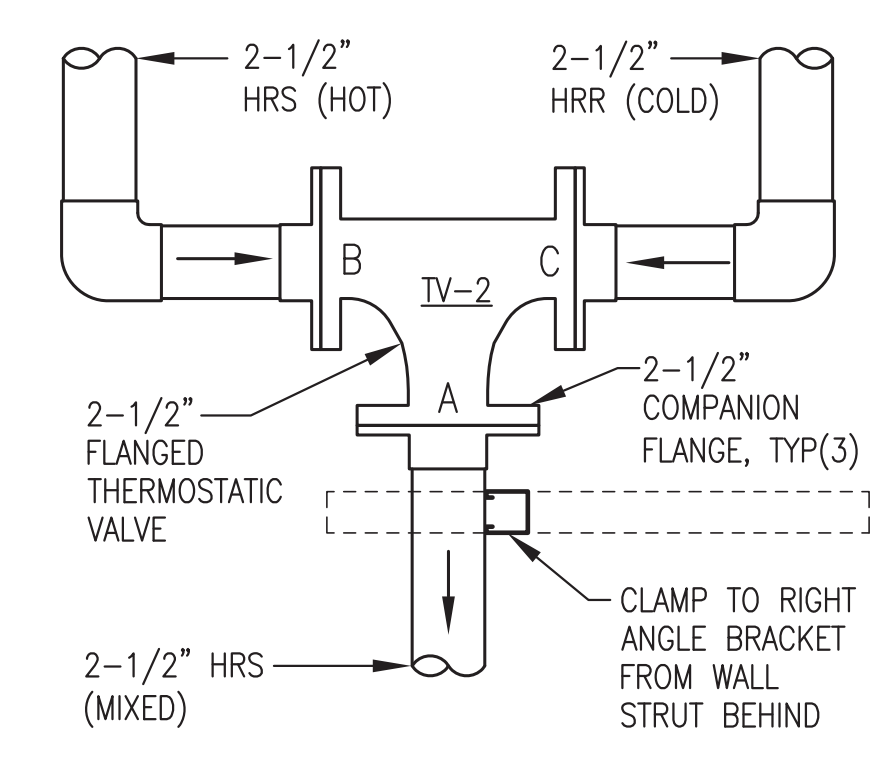



3 TV-2 INSTALLATION
M4.1 NO SCALE

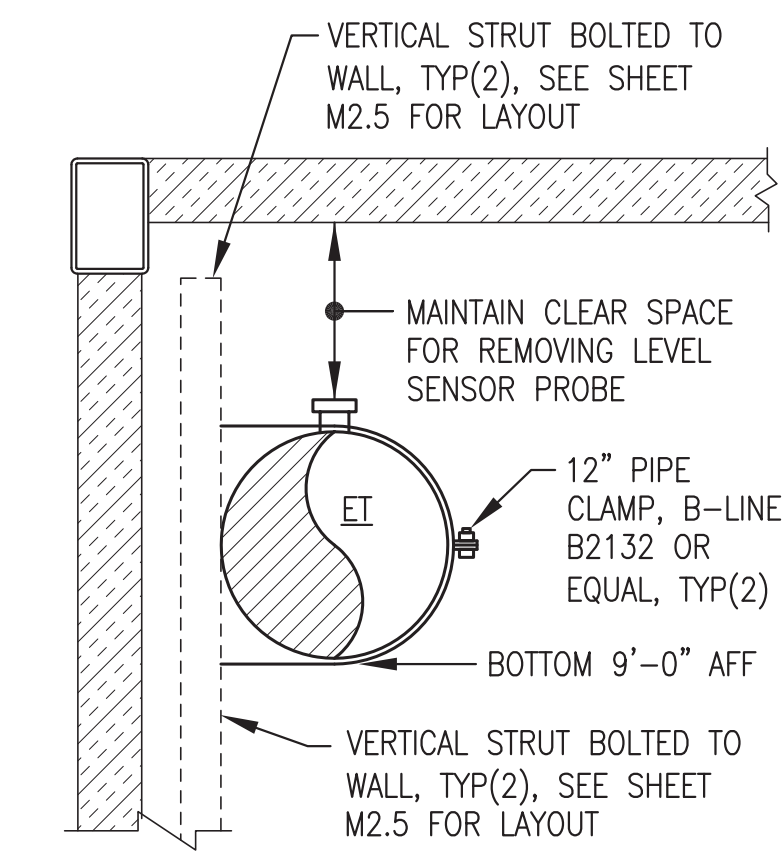

4 EXP TANK ET-1 SUPPORT
M4.1 NO SCALE

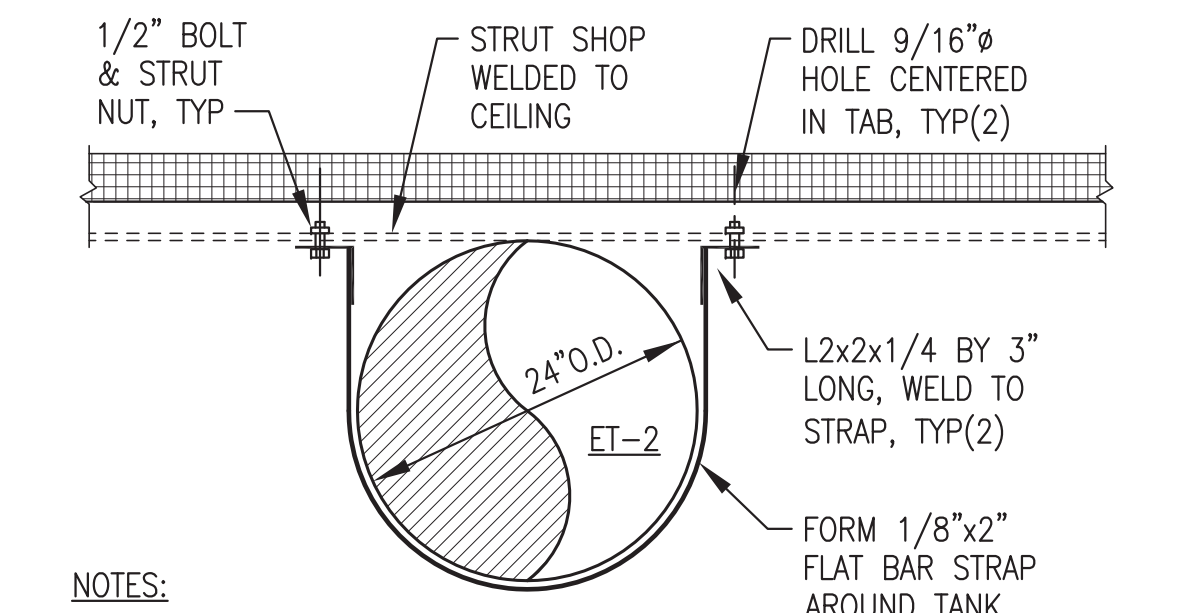

5 HEAT RECOVERY EXP TANK ET-2 SUPPORT
M4.1 NO SCALE

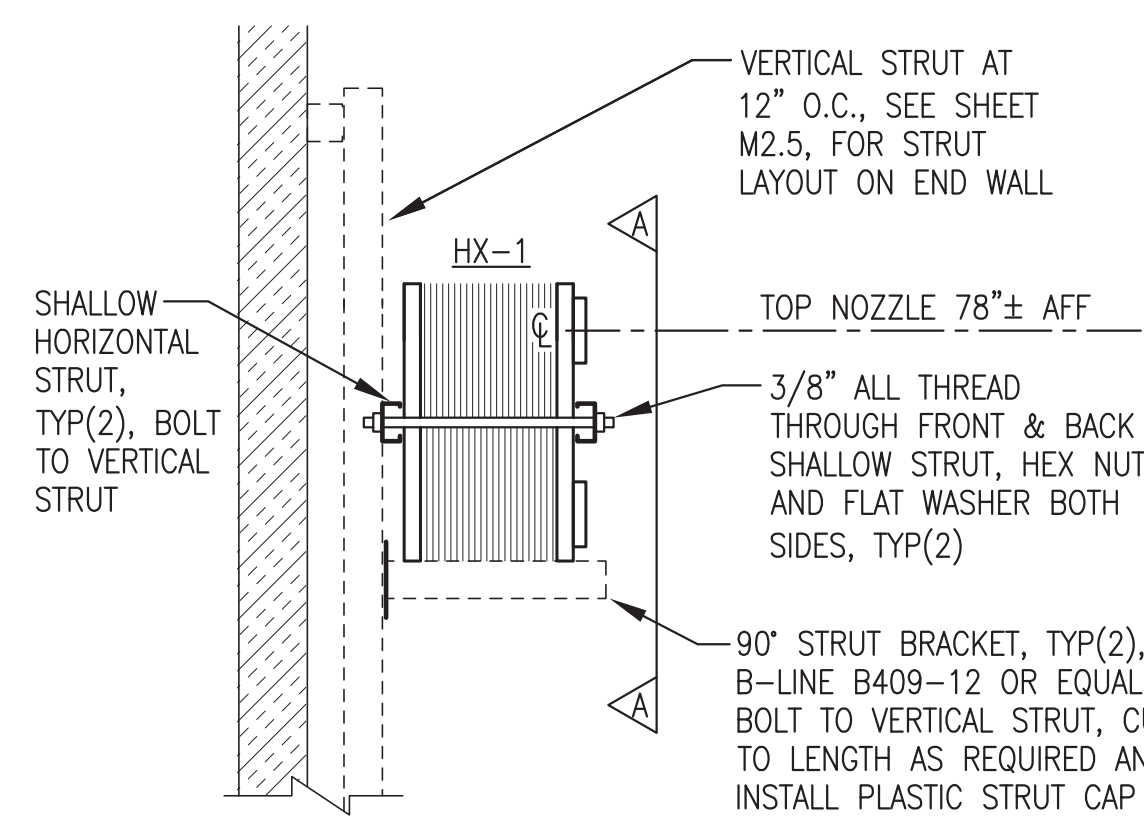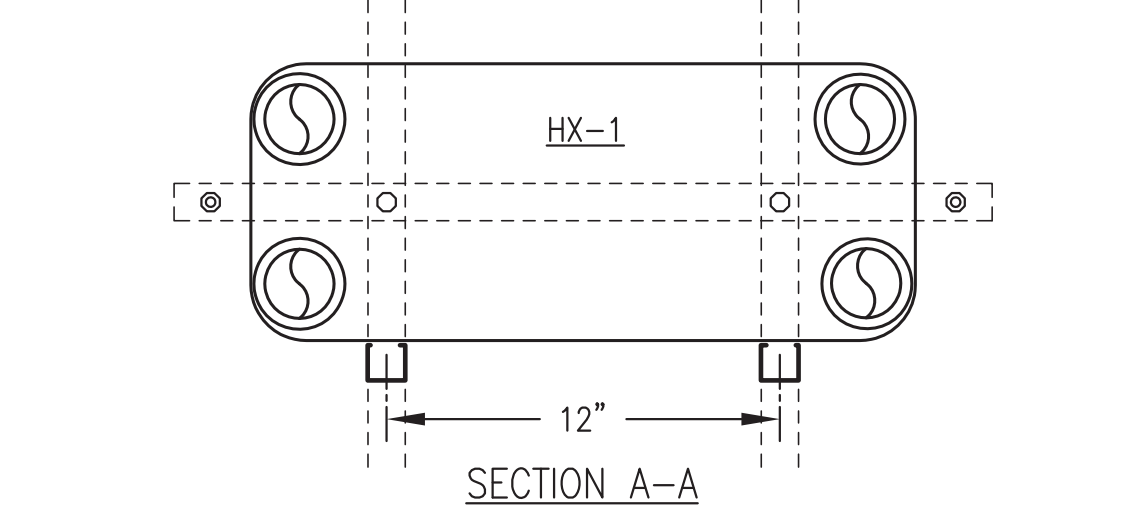


6 HEAT EXCHANGER SUPPORT FROM WALL
M4.1 NO SCALE

ARCTIC PIPE GENERAL NOTES:


- 1) SEE ELEVATION 3/M3.2 FOR PENETRATION LOCATIONS.
- 2) ONE PIPE FOR EACH SIZE SHOWN. PROVIDE TWO IDENTICAL FOR EACH SIZE.

ARCTIC PIPE SHOP/ON-SITE NOTES:

- 1) SHOP INSTALLATION SHOWN. STUB PIPE 8" MIN BEYOND WALL & TEMPORARILY CONNECT SUPPLY TO RETURN FOR TESTING.
- 2) AFTER TESTING REMOVE TEMPORARY CONNECTION, BREAK FLANGE JOINT, AND STORE PIPE IN MODULE. PLUG WALL PENETRATION FOR SHIPPING.
- 3) AS PART OF ON-SITE INSTALLATION REINSTALL PIPE THROUGH WALL AND CONNECT TO ARCTIC PIPE, SEE SHEET M8.

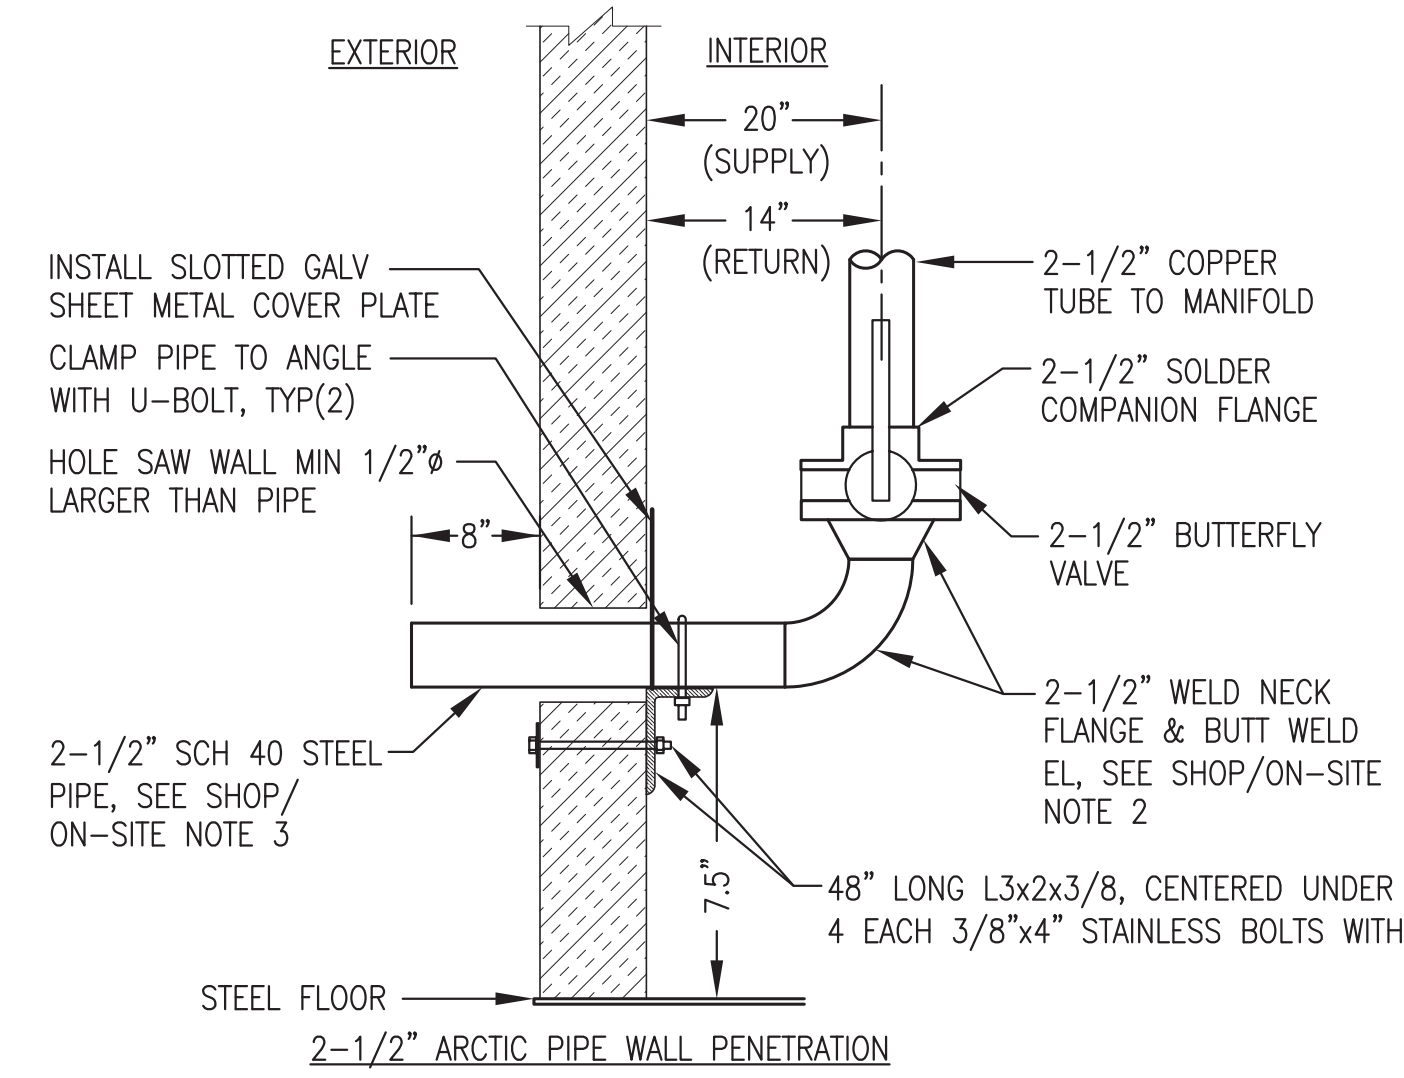

7 HEAT RECOVERY ARCTIC PIPE WALL PENETRATIONS
M4.1 NO SCALE

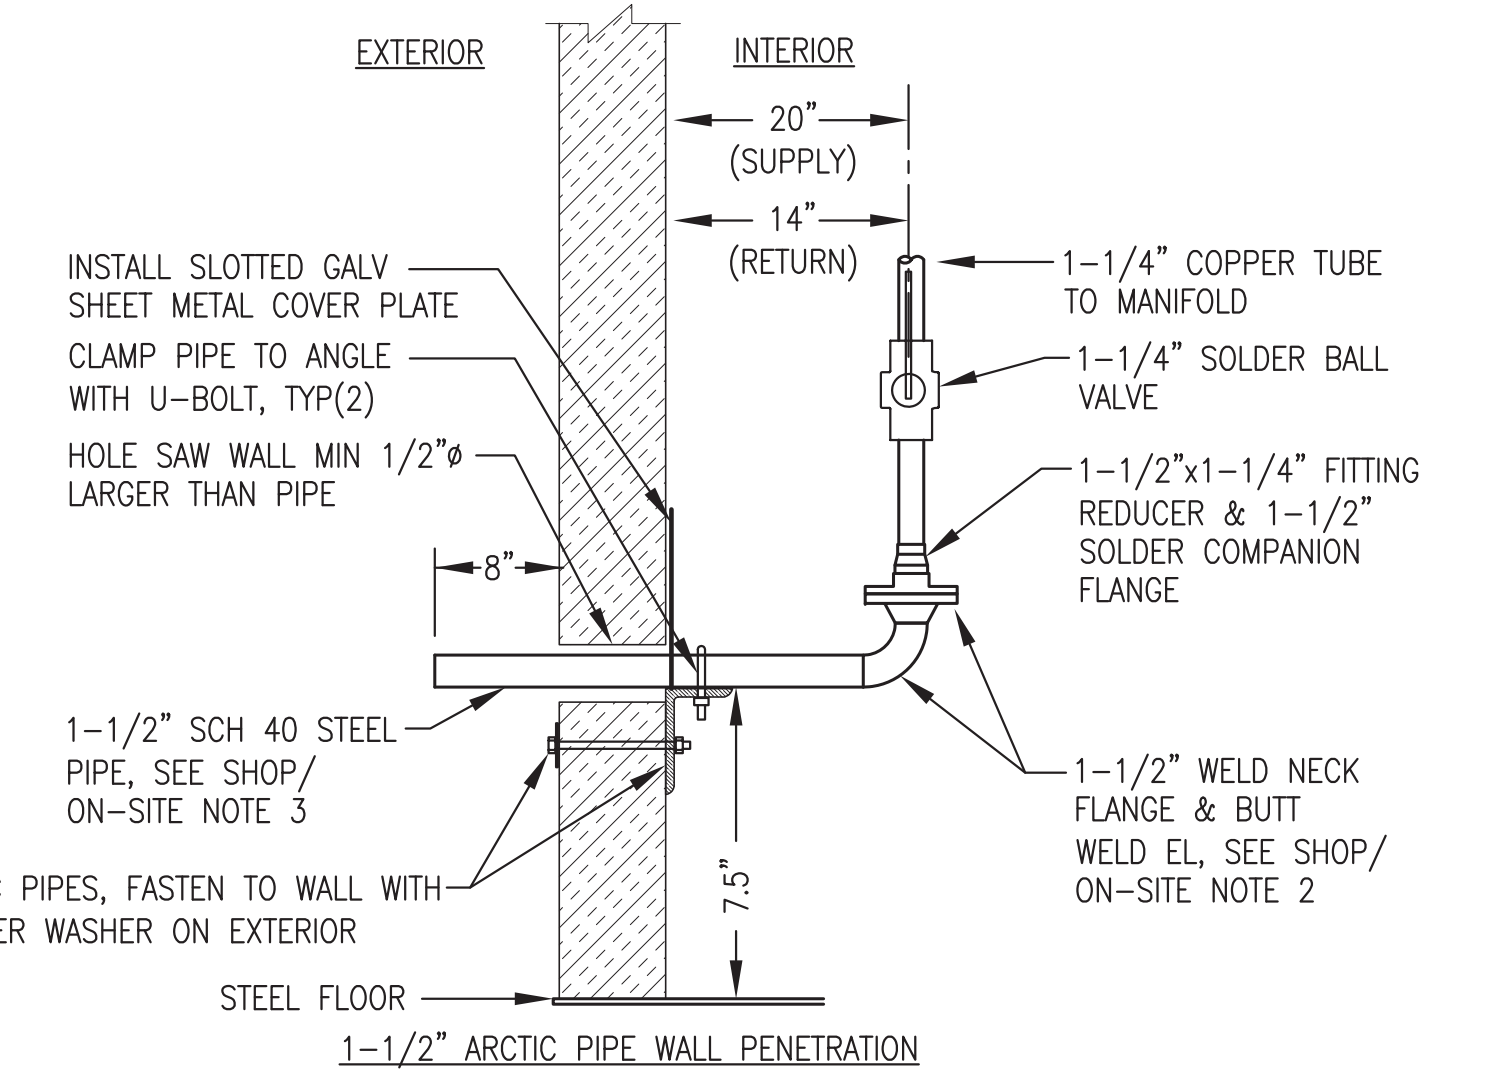


SHOP/ON-SITE NOTES:


- 1) FLASH OPENINGS AS PART OF ON-SITE WORK.

GENERAL NOTES:

- 1) THIS DETAIL APPLIES TO ALL PIPE & CONDUIT 2" & LARGER EXCEPT ARCTIC PIPE.
- 2) FLASH ALL OPENINGS TO EXTERIOR WALL WHERE ACCESSIBLE ON INTERIOR, INSTALL FLASHING OR CAULK ALL AROUND.

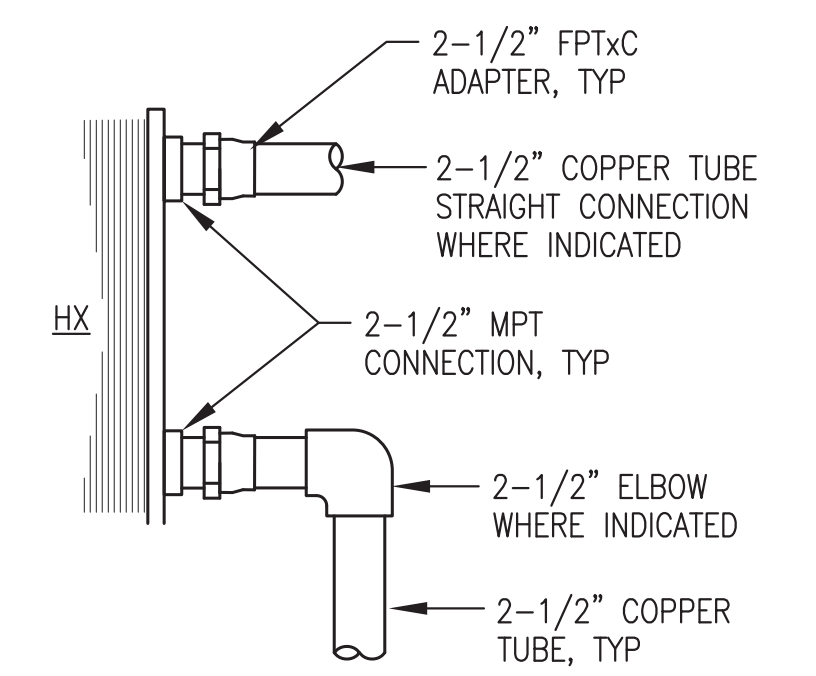


8 HX PIPING CONNECTION
M4.1 NO SCALE

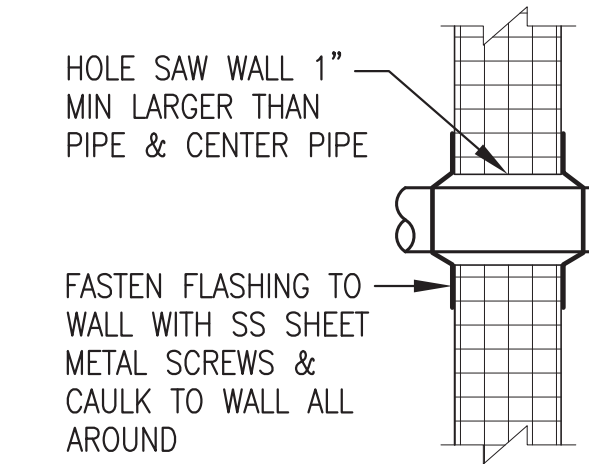

9 TYP WALL PENETRATION
M4.1 NO SCALE

- NOTES:**
- 1) ON INITIAL STARTUP INSTALL HOSE ADAPTER IN PLACE OF BUSHING & USE HOSE TO FLUSH & BLEED.
 - 2) AFTER BLEEDING SYSTEM OF AIR INSTALL BUSHING & AIR VENT & CLOSE BALL VALVE.

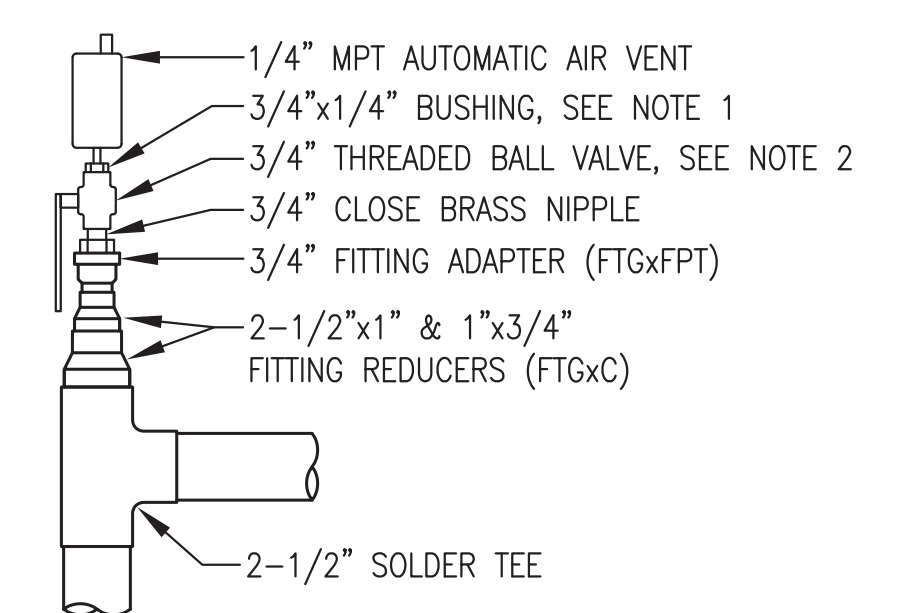


10 TYPICAL AIR VENT INSTALLATION
M4.1 NO SCALE

ISSUED FOR CONSTRUCTION
JANUARY 2019




ALASKA ENERGY AUTHORITY									
PROJECT: PORT HEIDEN RURAL POWER SYSTEM POWER PLANT UPGRADE									
TITLE: COOLANT & HEAT RECOVERY PIPING PLAN & DETAILS									
Gray Stassel Engineering, Inc. P.O. 111405, Anchorage, AK 99511 (907)349-0100	<table border="1"> <tr> <td>DRAWN BY: JTD</td> <td>SCALE: AS NOTED</td> </tr> <tr> <td>DESIGNED BY: BCG</td> <td>DATE: 1-14-19</td> </tr> <tr> <td>FILE NAME: PTH PPU M2-7</td> <td>SHEET: M4.1 OF 7</td> </tr> <tr> <td>PROJECT NUMBER:</td> <td></td> </tr> </table>	DRAWN BY: JTD	SCALE: AS NOTED	DESIGNED BY: BCG	DATE: 1-14-19	FILE NAME: PTH PPU M2-7	SHEET: M4.1 OF 7	PROJECT NUMBER:	
DRAWN BY: JTD	SCALE: AS NOTED								
DESIGNED BY: BCG	DATE: 1-14-19								
FILE NAME: PTH PPU M2-7	SHEET: M4.1 OF 7								
PROJECT NUMBER:									

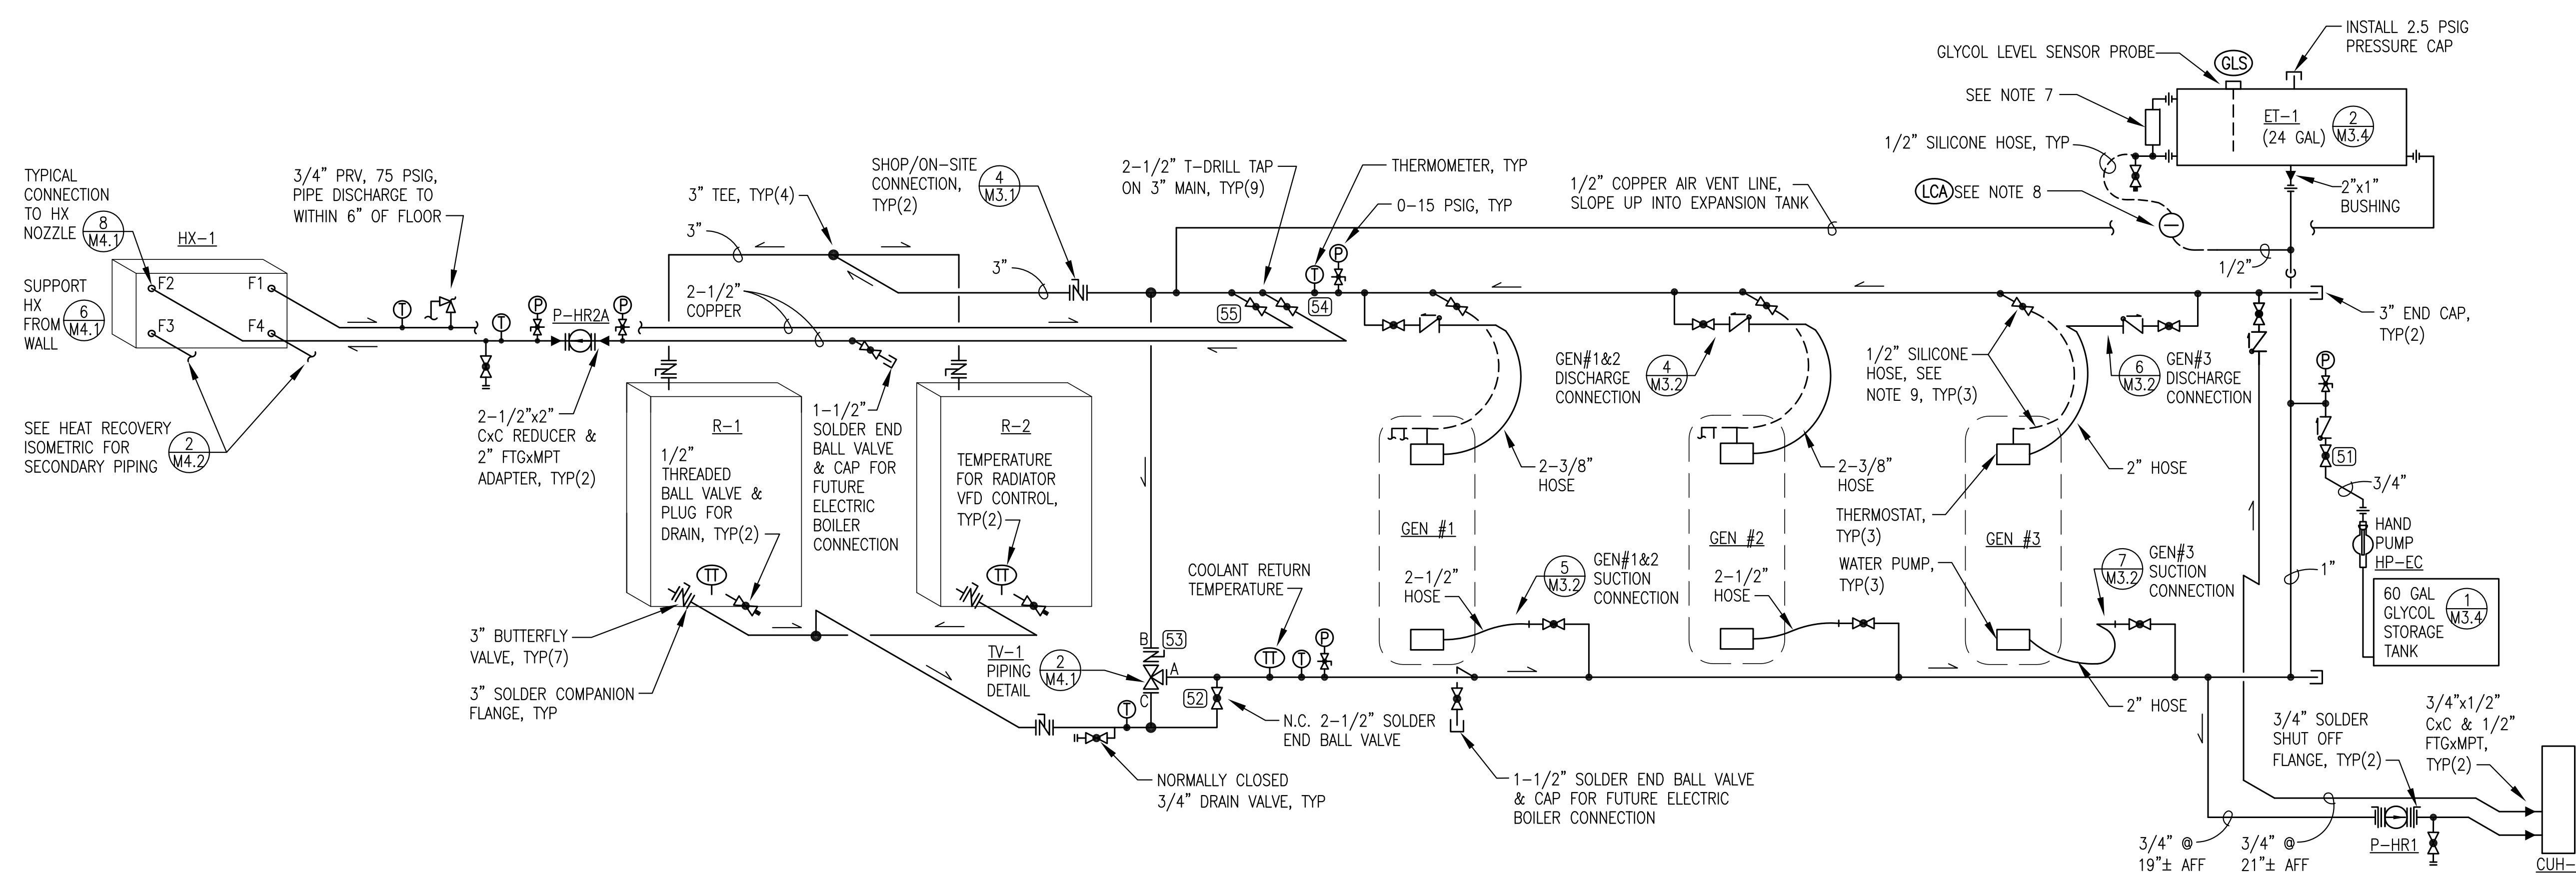


- NOTES:**
- 1) ALL PIPING SHOWN THIS ISOMETRIC TYPE "L" COPPER WITH SOLDER JOINTS, 3"Ø EXCEPT WHERE SPECIFICALLY INDICATED OTHERWISE. ALL FLANGES ANSI 150# PATTERN BRONZE COMPANION WITH SOLDER ENDS.
 - 2) MAKE ALL CONNECTIONS FOR INSTRUMENTATION WITH T-DRILL TAP, SEE DETAIL 3/M4.2. MAKE ALL OTHER REDUCING BRANCH CONNECTIONS WITH T-DRILL TAP OR TEE AS REQUIRED.
 - 3) ALL COOLANT PRESSURE GAUGES 0-15 PSIG. ALL THERMOMETERS FAHRENHEIT RANGE.
 - 4) SEE ELECTRICAL INSTRUMENTATION SCHEDULE FOR TEMPERATURE TRANSMITTERS AND OTHER INSTRUMENTATION.
 - 5) UPON COMPLETION OF FABRICATION VALVE OFF CABINET UNIT HEATER AND FLUSH PIPING TO REMOVE ALL DEBRIS, SEE SPECIFICATIONS.
 - 6) INSULATE COOLANT PIPING MAINS FROM GENERATOR VALVES TO RADIATORS. ALL OTHER PIPING NOT INSULATED.
 - 7) INSTALL 9" LONG COOLANT SITE GAUGE ON 1/2" TEES, INSTALL 1/2" THREADED BALL VALVE WITH PLUG FOR DRAIN.
 - 8) LOW COOLANT ALARM SWITCH, MOUNT WITH SWITCH POINT LEVEL WITHIN 12" OF TANK BOTTOM. CONNECT TO HOSE WITH NPTx5/8" BARB, 1/2" ON BOTTOM, 1/4" ON TOP.
 - 9) 3/4" THREADED BALL VALVE, 3/4"xMPTx5/8" BARB BRASS KING NIPPLE, & 1/2" HOSE FOR ENGINE VENT & PRE-HEAT.
 - 10) SET P-HR1 & P-HR2A TO OPERATE ON SPEED 3.

1 COOLING SYSTEM PIPING ISOMETRIC
M4.2 NO SCALE

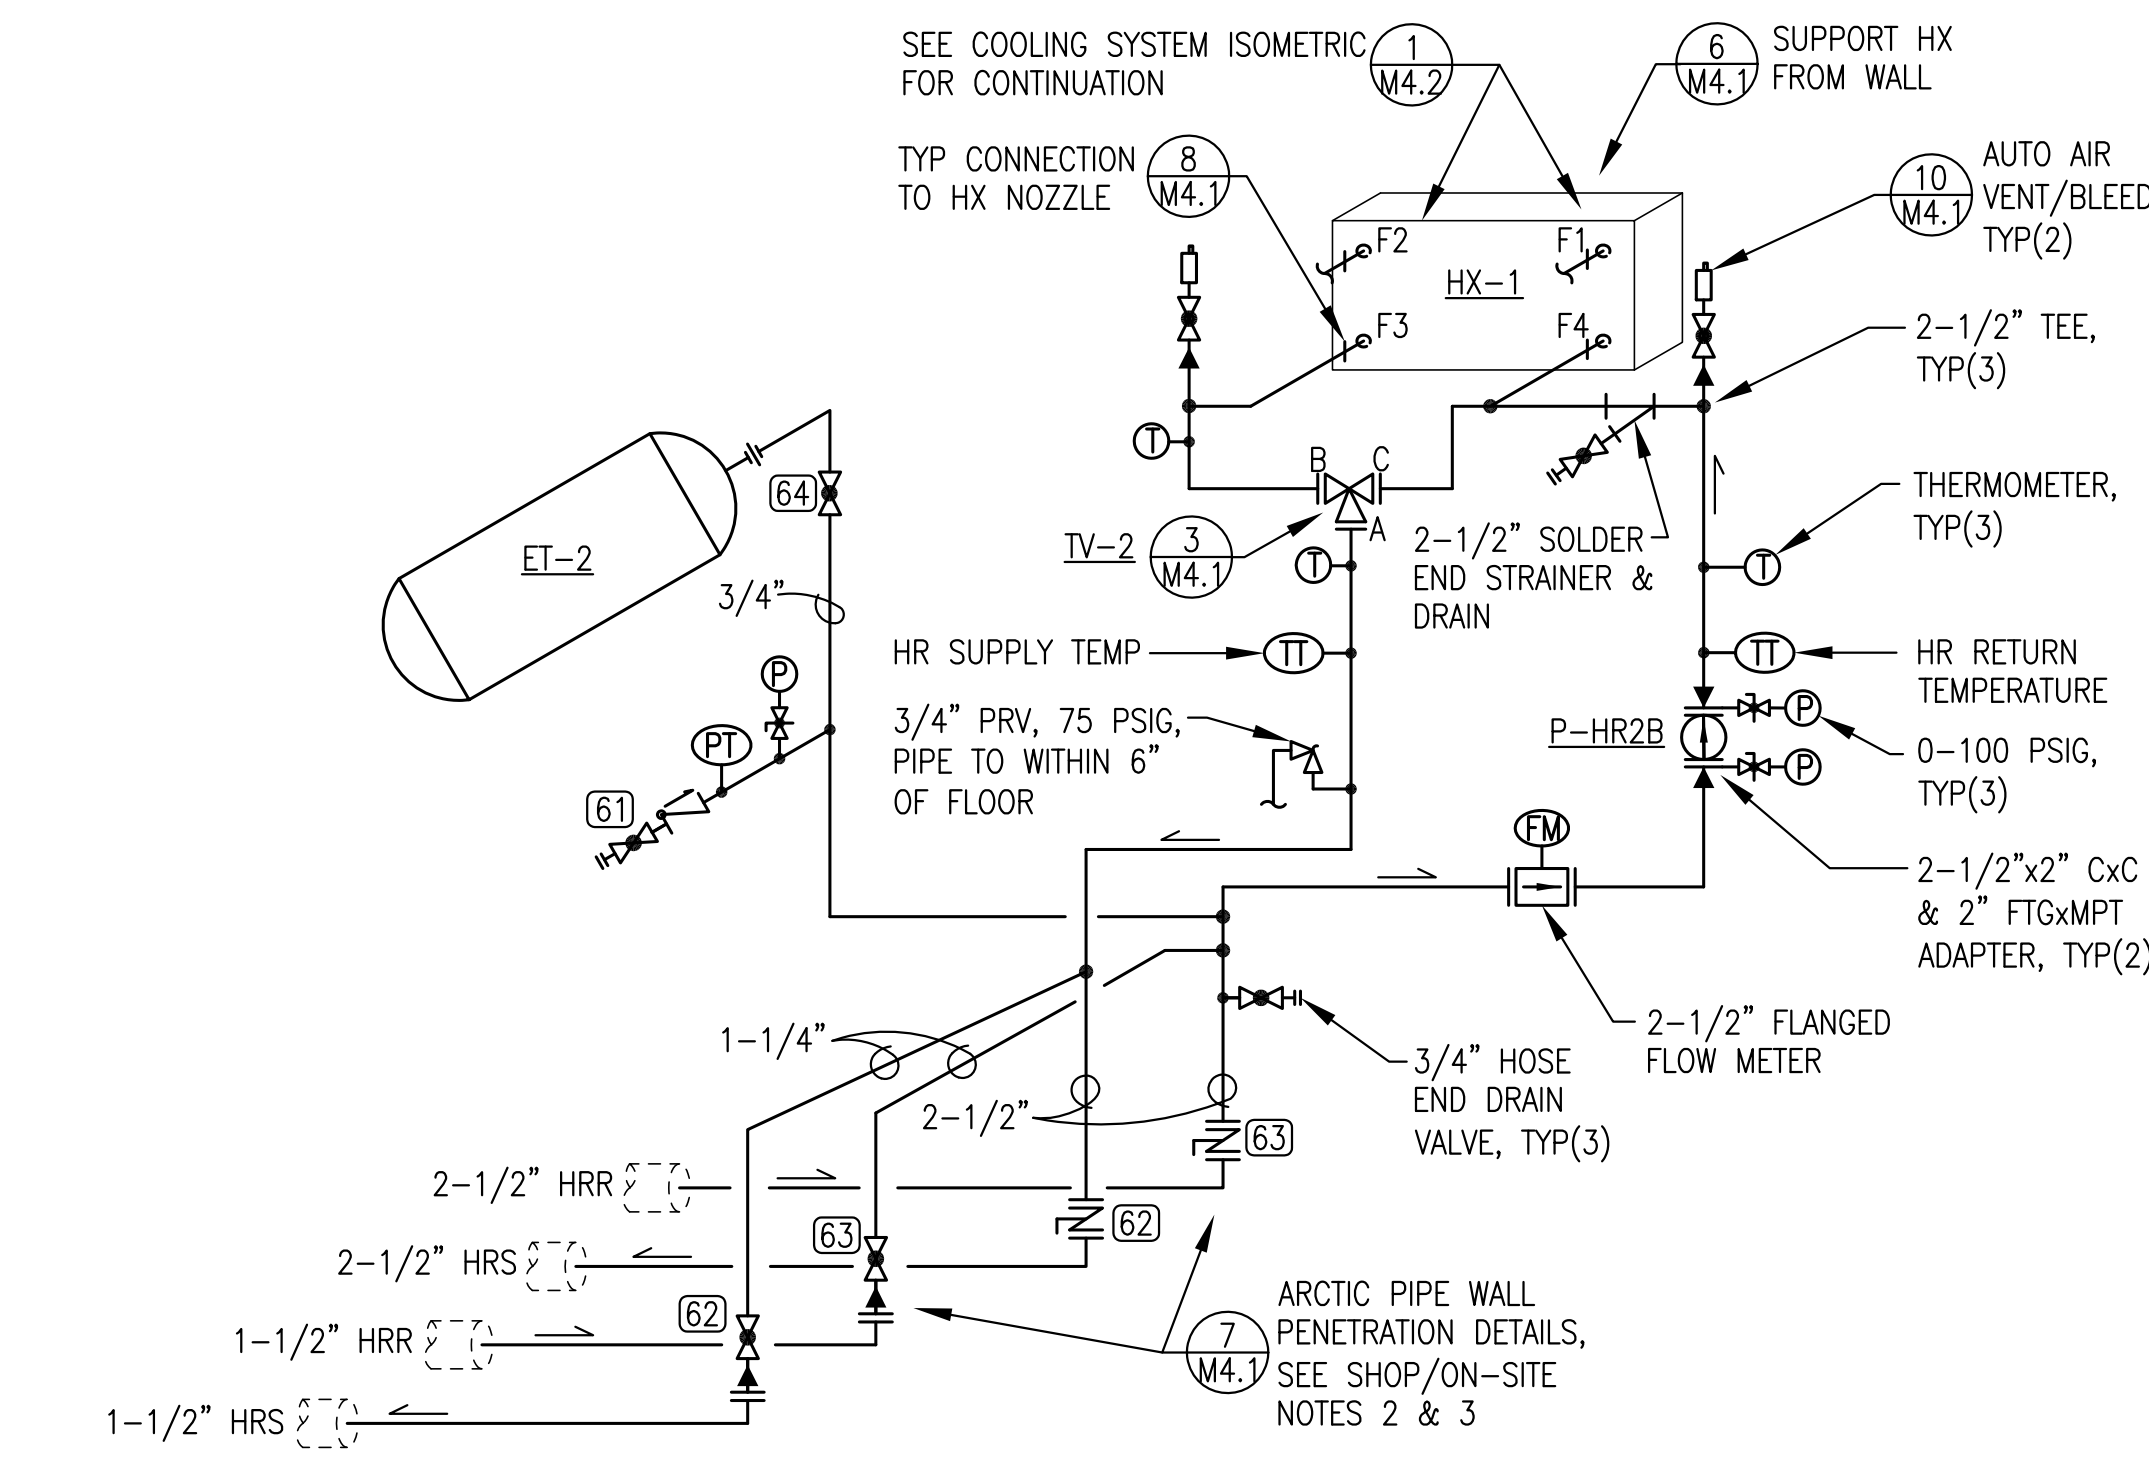

- NOTES:**
- 1) ALL PIPING SHOWN THIS ISOMETRIC 2-1/2" TYPE L HARD DRAWN COPPER UNLESS SPECIFICALLY INDICATED OTHERWISE. ALL FLANGES ANSI 150# PATTERN BRONZE COMPANION WITH SOLDER ENDS.
 - 2) UNLESS SPECIFIED OTHERWISE MAKE ALL CONNECTIONS FOR INSTRUMENTATION WITH T-DRILL TAP, SEE DETAIL 3/M4.2. MAKE ALL OTHER REDUCING BRANCH CONNECTIONS WITH T-DRILL TAP AS REQUIRED UNLESS INDICATED OTHERWISE.
 - 3) ALL HEAT RECOVERY PRESSURE GAUGES 0-100 PSIG. ALL THERMOMETERS FAHRENHEIT RANGE.
 - 4) SEE ELECTRICAL INSTRUMENTATION SCHEDULE FOR TEMPERATURE AND PRESSURE TRANSMITTERS AND FLOW METER.
 - 5) UPON COMPLETION OF FABRICATION FLUSH PIPING TO REMOVE ALL DEBRIS, SEE SPECIFICATIONS.
 - 6) INSULATE HEAT RECOVERY PIPING MAINS.
 - 7) SET P-HR2B TO OPERATE ON SPEED 3.

2 HEAT RECOVERY SYSTEM PIPING ISOMETRIC
M4.2 NO SCALE

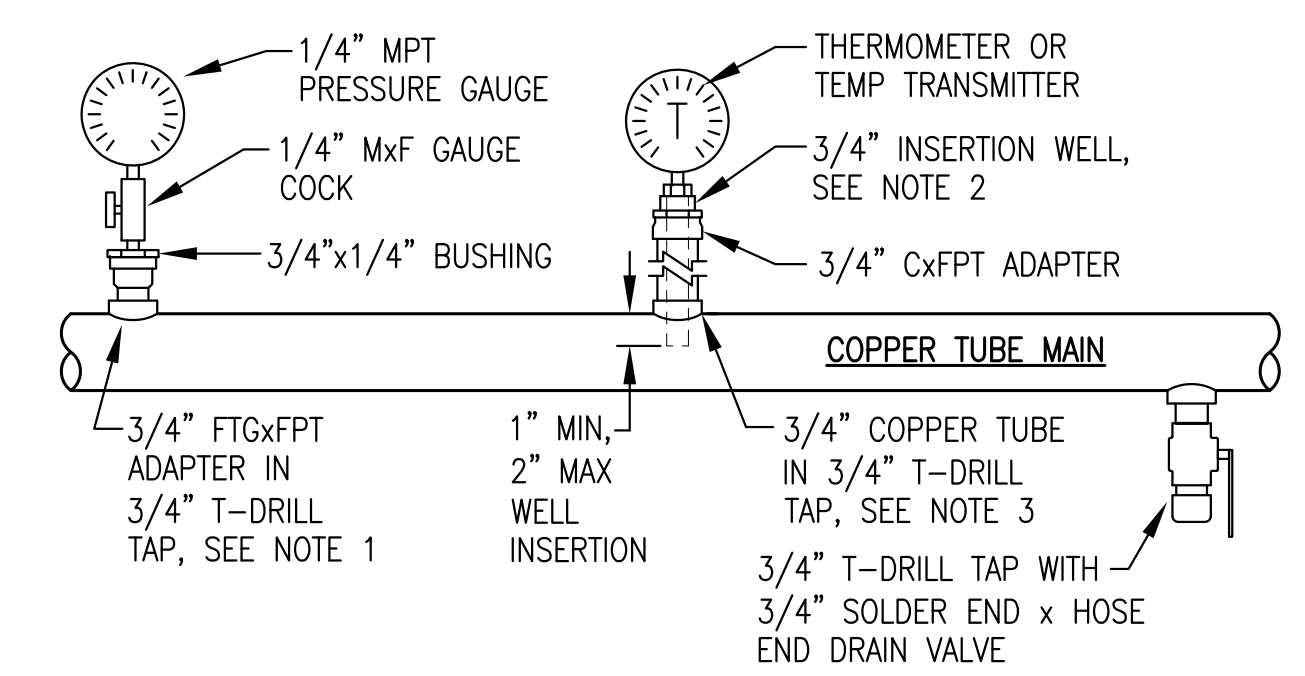

- NOTES:**
- 1) USE T-DRILL TAPS AS SHOWN FOR INSTALLATIONS IN 1-1/4" AND LARGER COPPER MAINS. USE LINE SIZE TEE FITTINGS FOR INSTALLING INSTRUMENTATION IN 1" AND SMALLER MAINS. ADJUST ADAPTER AND BUSHING SIZES TO MATCH TEES.
 - 2) TEMPERATURE TRANSMITTER INSTALLATION SIMILAR TO THERMOMETER EXCEPT USE 3/4"x1/2" BUSHING.
 - 3) FOR MAINS SMALLER THAN 2" USE COPPER TUBE RISER AS SHOWN, LENGTH AS REQUIRED FOR 1" TO 2" WELL INSERTION INTO MAIN. FOR LARGER PIPES OMIT RISER AND INSERT 3/4" FTGXFT ADAPTER INTO T-DRILL TAP.


3 TYPICAL INSTRUMENT INSTALLATION
M4.2 NO SCALE

- HYDRONIC PIPING SHOP/ON-SITE NOTES:**
- 1) SEE SPECIFICATION 23 21 13 FOR COOLING AND HEAT RECOVERY PIPING TESTING, FLUSHING, DRAINING, AND FILLING REQUIREMENTS.
 - 2) SEE DETAILS 4/M3.1 AND 7/M4.1 FOR SPECIFIC REQUIREMENTS FOR PIPING THROUGH THE EXTERIOR WALLS.
 - 3) ARCTIC PIPE TO BE INSTALLED AS PART OF THE ON-SITE WORK.


ISSUED FOR CONSTRUCTION
JANUARY 2019




ALASKA ENERGY AUTHORITY	
PROJECT: PORT HEIDEN RURAL POWER SYSTEM POWER PLANT UPGRADE	
TITLE: COOLANT & HEAT RECOVERY ISOMETRICS AND DETAILS	
 Gray Stassel Engineering, Inc. P.O. 111405, Anchorage, AK 99511 (907)349-0100	DRAWN BY: JTD DESIGNED BY: BCG FILE NAME: PTH PPU M2-7 PROJECT NUMBER:
SCALE: AS NOTED	DATE: 1-14-19
SHEET: M4.2	OF 7

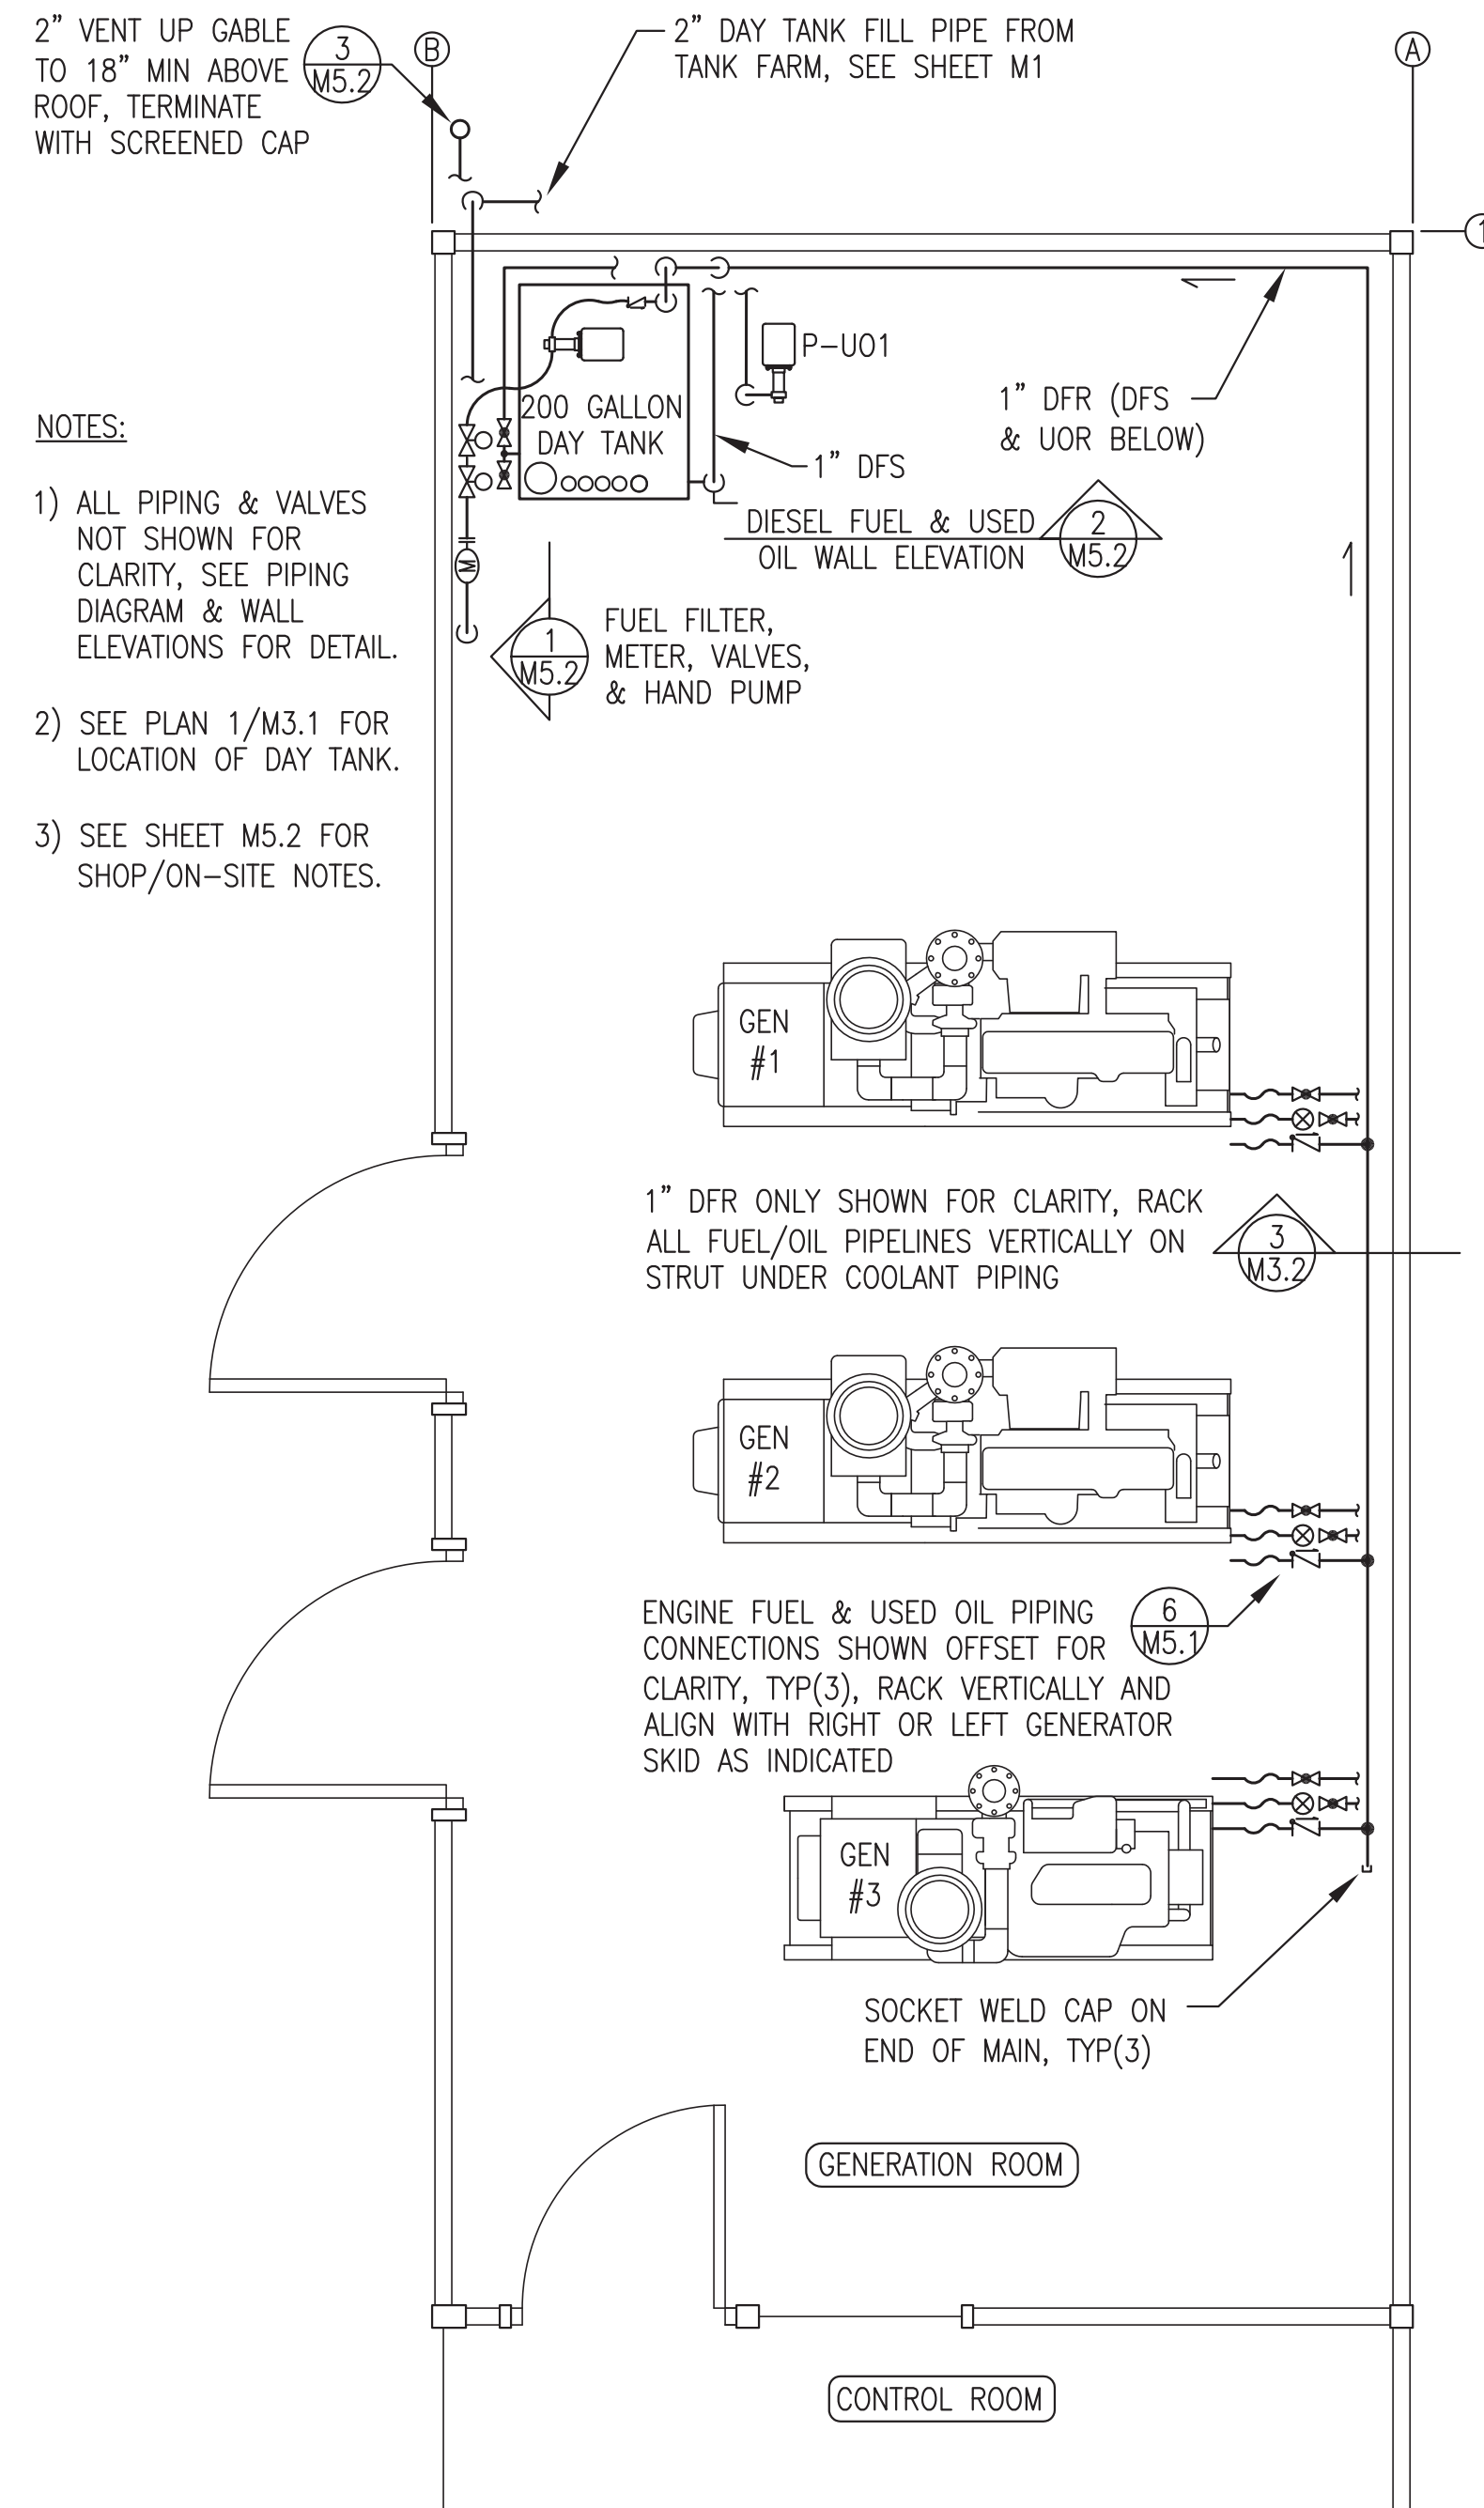


1 DIESEL FUEL SYSTEM & USED OIL PIPING PLAN
M5.1 3/8"=1'

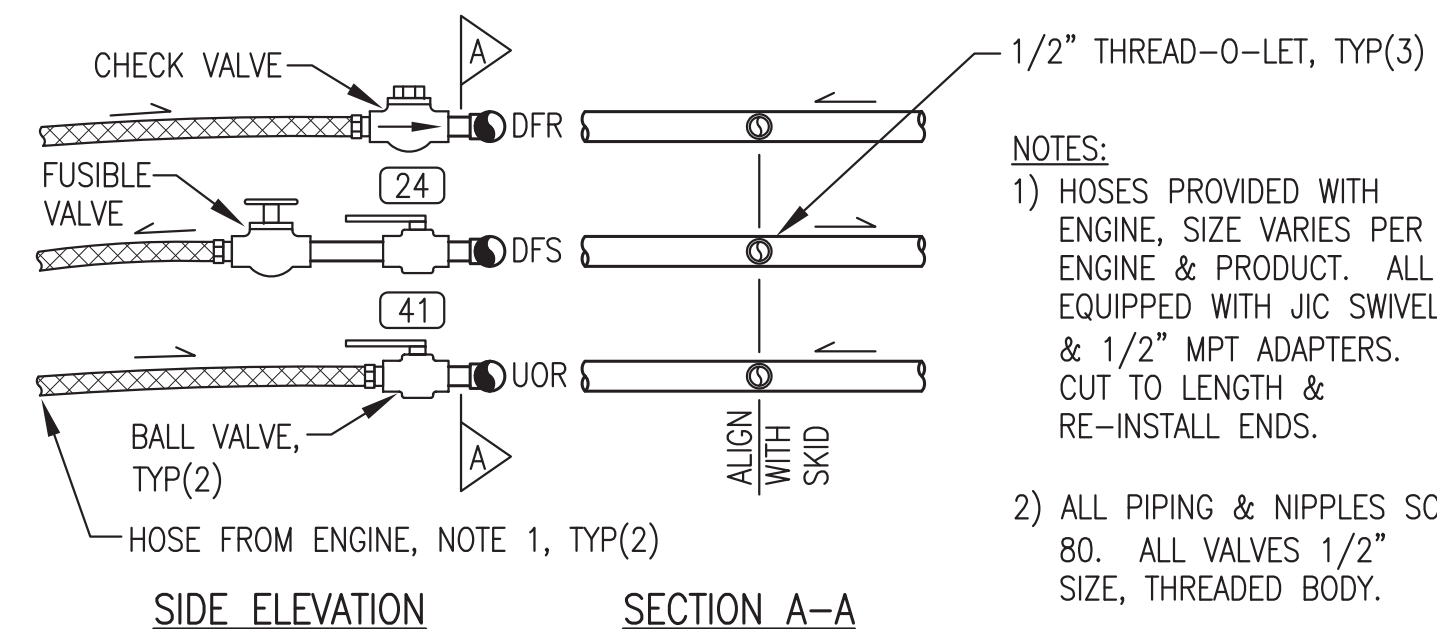

6 ENGINE FUEL PIPING CONNECTION
M5.1 NO SCALE

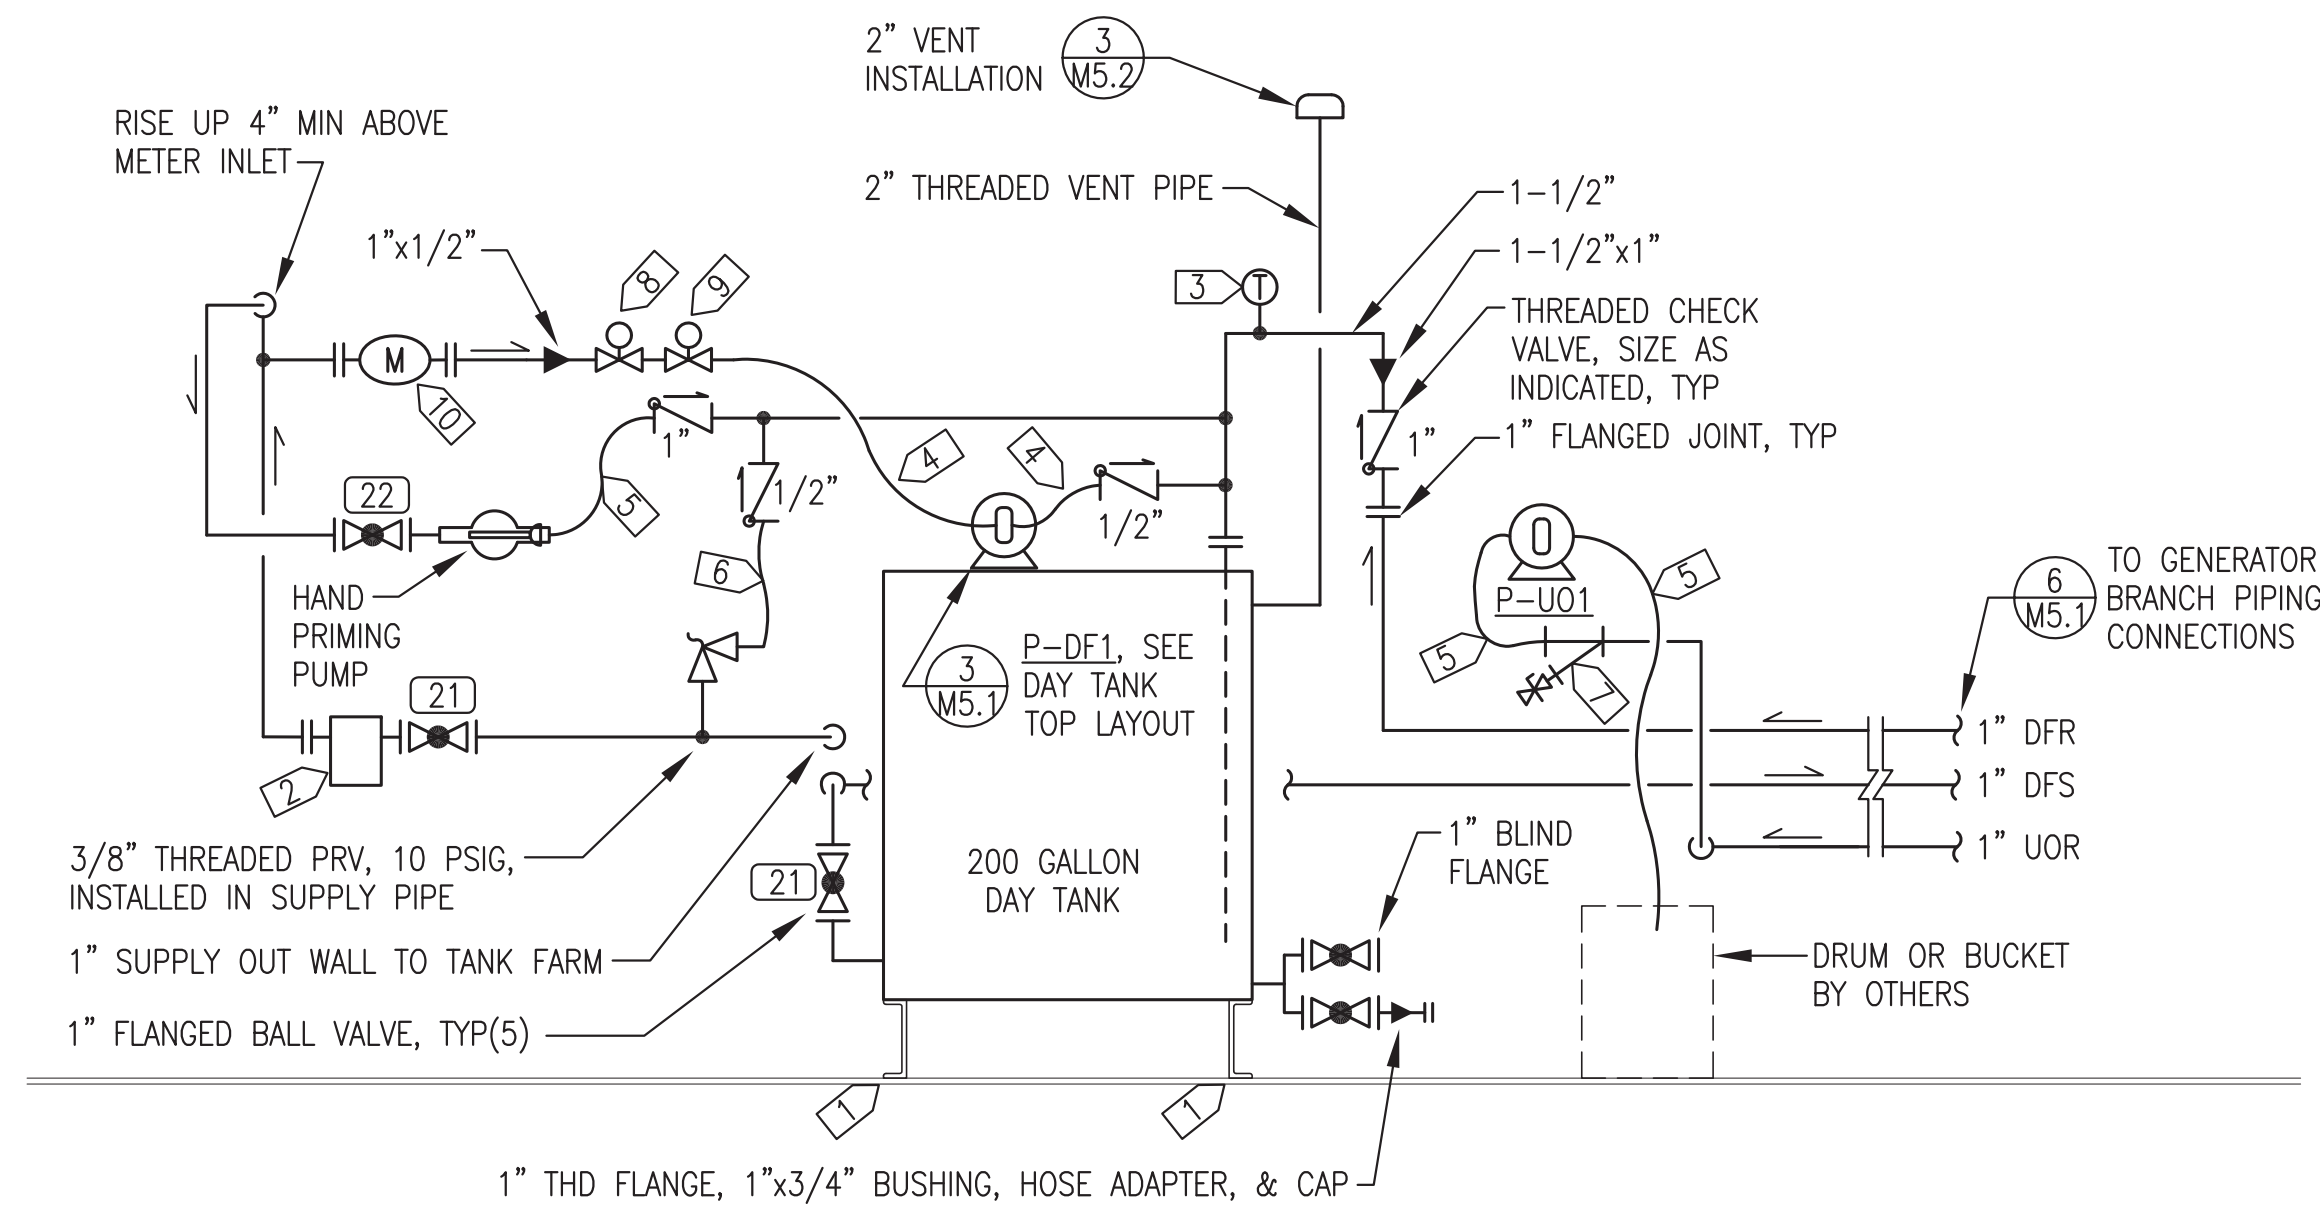

2 DIESEL FUEL & USED OIL PIPING DIAGRAM
M5.1 NO SCALE

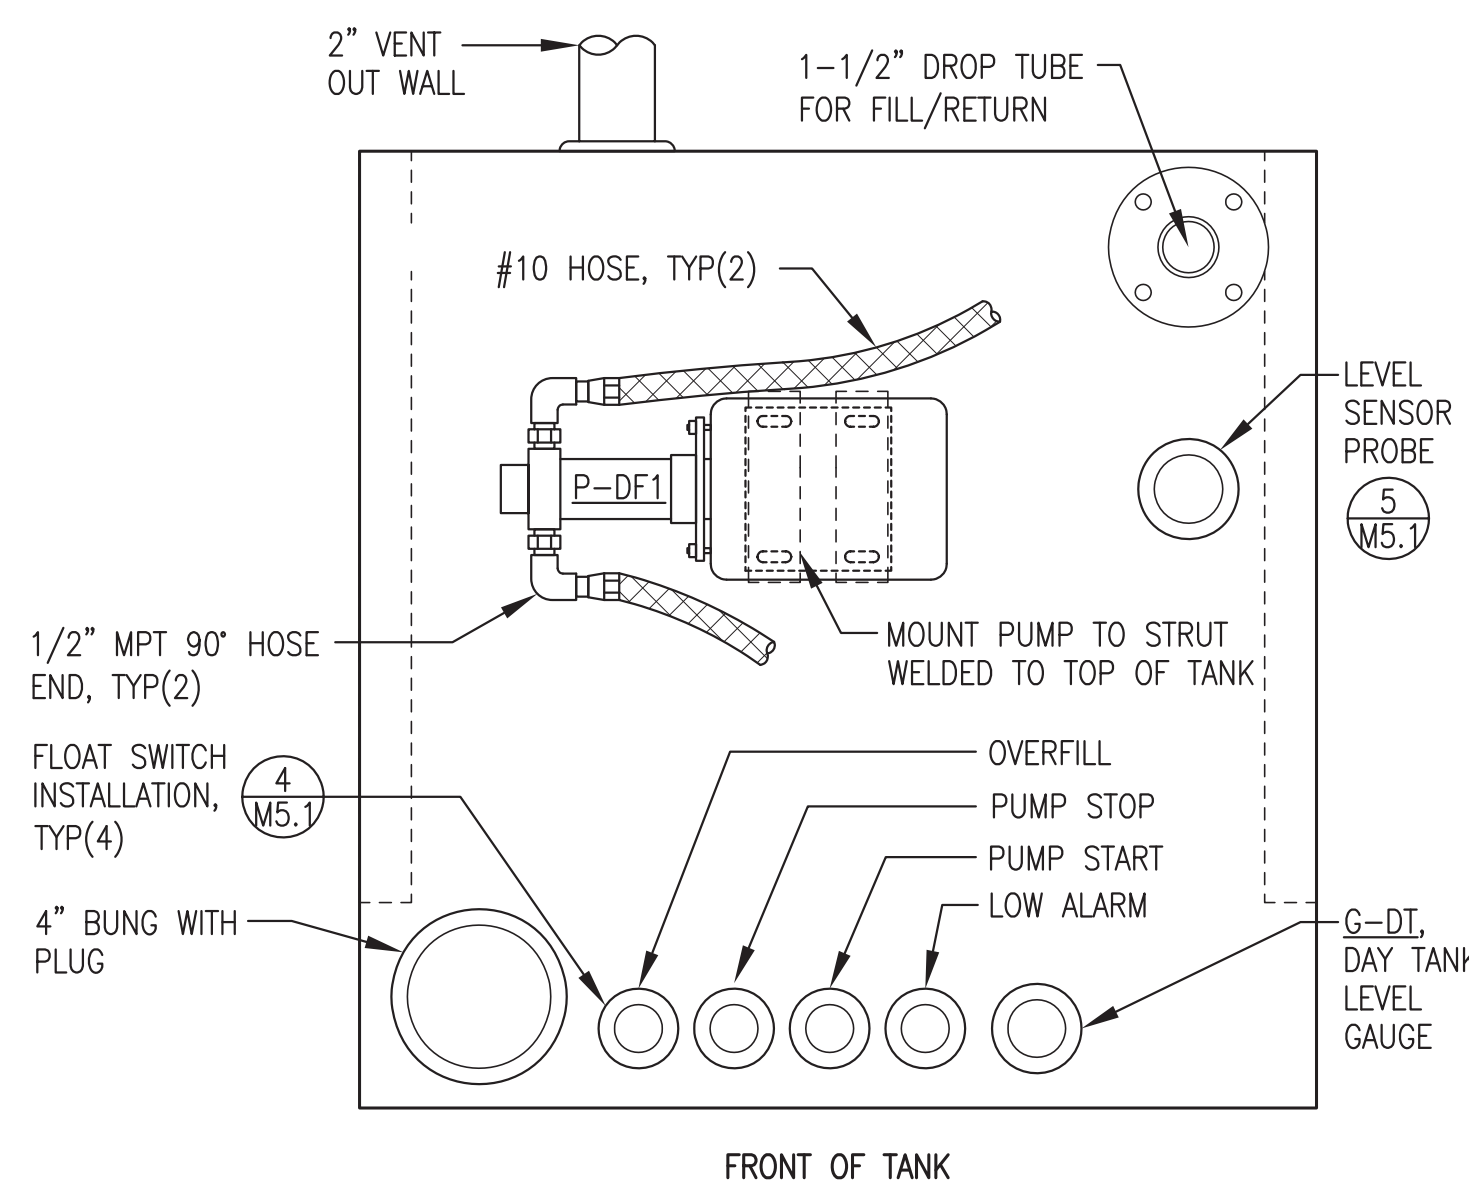

3 TOP OF DAY TANK - PLAN VIEW
M5.1 NO SCALE

4 DAY TANK FLOAT SWITCH INSTALLATION
M5.1 NO SCALE


5 TYPICAL LEVEL SENSOR PROBE INSTALLATION
M5.1 NO SCALE

PIPING DIAGRAM GENERAL NOTES:

- 1) FABRICATE DAY TANK, FILTER BANK, & HOPPER IN ACCORDANCE WITH FABRICATION PLANS AND DETAILS.
- 2) ALL DAY TANK SUPPLY & RETURN PIPING 1" SCH 80 EXCEPT WHERE INDICATED AS 1-1/2". ALL VENT PIPING 2" SCH 40.
- 3) ALL PIPING JOINTS SOCKET OR BUTT WELD EXCEPT FOR THREADED VENT & CONNECTIONS TO EQUIPMENT & VALVES.
- 4) ON ALL HOSES INSTALL JIC/NPT SWIVEL ENDS, SIZE REQUIRED TO MATCH PIPING OR PUMPS.

PIPING DIAGRAM SPECIFIC NOTES:

- 1) FASTEN DEVICE TO FLOOR WITH MIN 1"x3/16" FILLET WELD ALL 4 CORNERS, WIRE BRUSH AND RE-PAINT WELD AREA TO MATCH EXISTING.
- 2) 1" ANSI 150# FLANGED FILTER F-DI, REMOVE DRAIN VALVE & INSTALL 1/8"xMxF DRAIN COCK.
- 3) THERMOMETER, INSTALL WELL IN 3/4" THREAD-O-LET.
- 4) #10 HOSE WITH 1/2" OR 3/4" NPT ENDS.
- 5) #12 HOSE WITH 1/2", 3/4", OR 1" NPT ENDS.
- 6) #6 HOSE WITH 1/8", 1/4", OR 3/8" NPT ENDS.
- 7) 1" THREADED STRAINER IN 1" UOR WITH GAUGE COCK BLOW DOWN.
- 8) 1/2" NO SOLENOID VALVE.
- 9) 1/2" NC SOLENOID VALVE.
- 10) METER M-DI, EQUIPPED WITH 300# FLANGED ENDS, PROVIDE 1" ANSI 300# FLANGES & GASKETS, SOCKET WELD ON INLET & THREADED ON OUTLET.

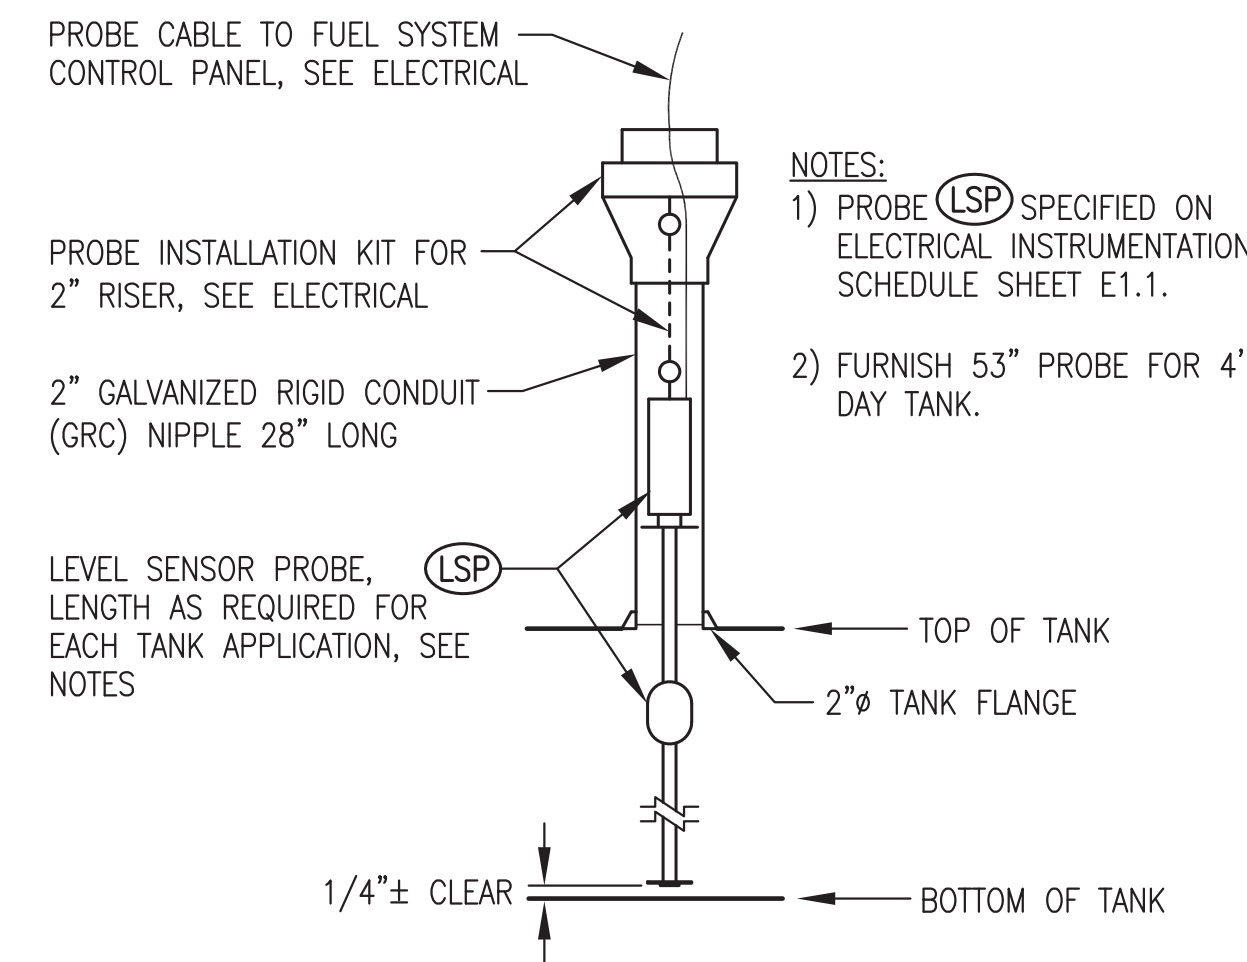

ISSUED FOR CONSTRUCTION
JANUARY 2019




ALASKA ENERGY AUTHORITY

PROJECT: PORT HEIDEN RURAL POWER SYSTEM
POWER PLANT UPGRADE

TITLE: DIESEL FUEL & USED OIL PIPING
PLAN, DIAGRAM, & DETAILS


<p>Gray Stassel Engineering, Inc. P.O. 111405, Anchorage, AK 99511 (907)349-0100</p>	<p>DRAWN BY: JTD</p> <p>DESIGNED BY: BCG</p> <p>FILE NAME: PTH PPU M2-7</p> <p>PROJECT NUMBER:</p>	<p>SCALE: AS NOTED</p> <p>DATE: 1-14-19</p> <p>SHEET: M5.1 OF 7</p>
--	--	---

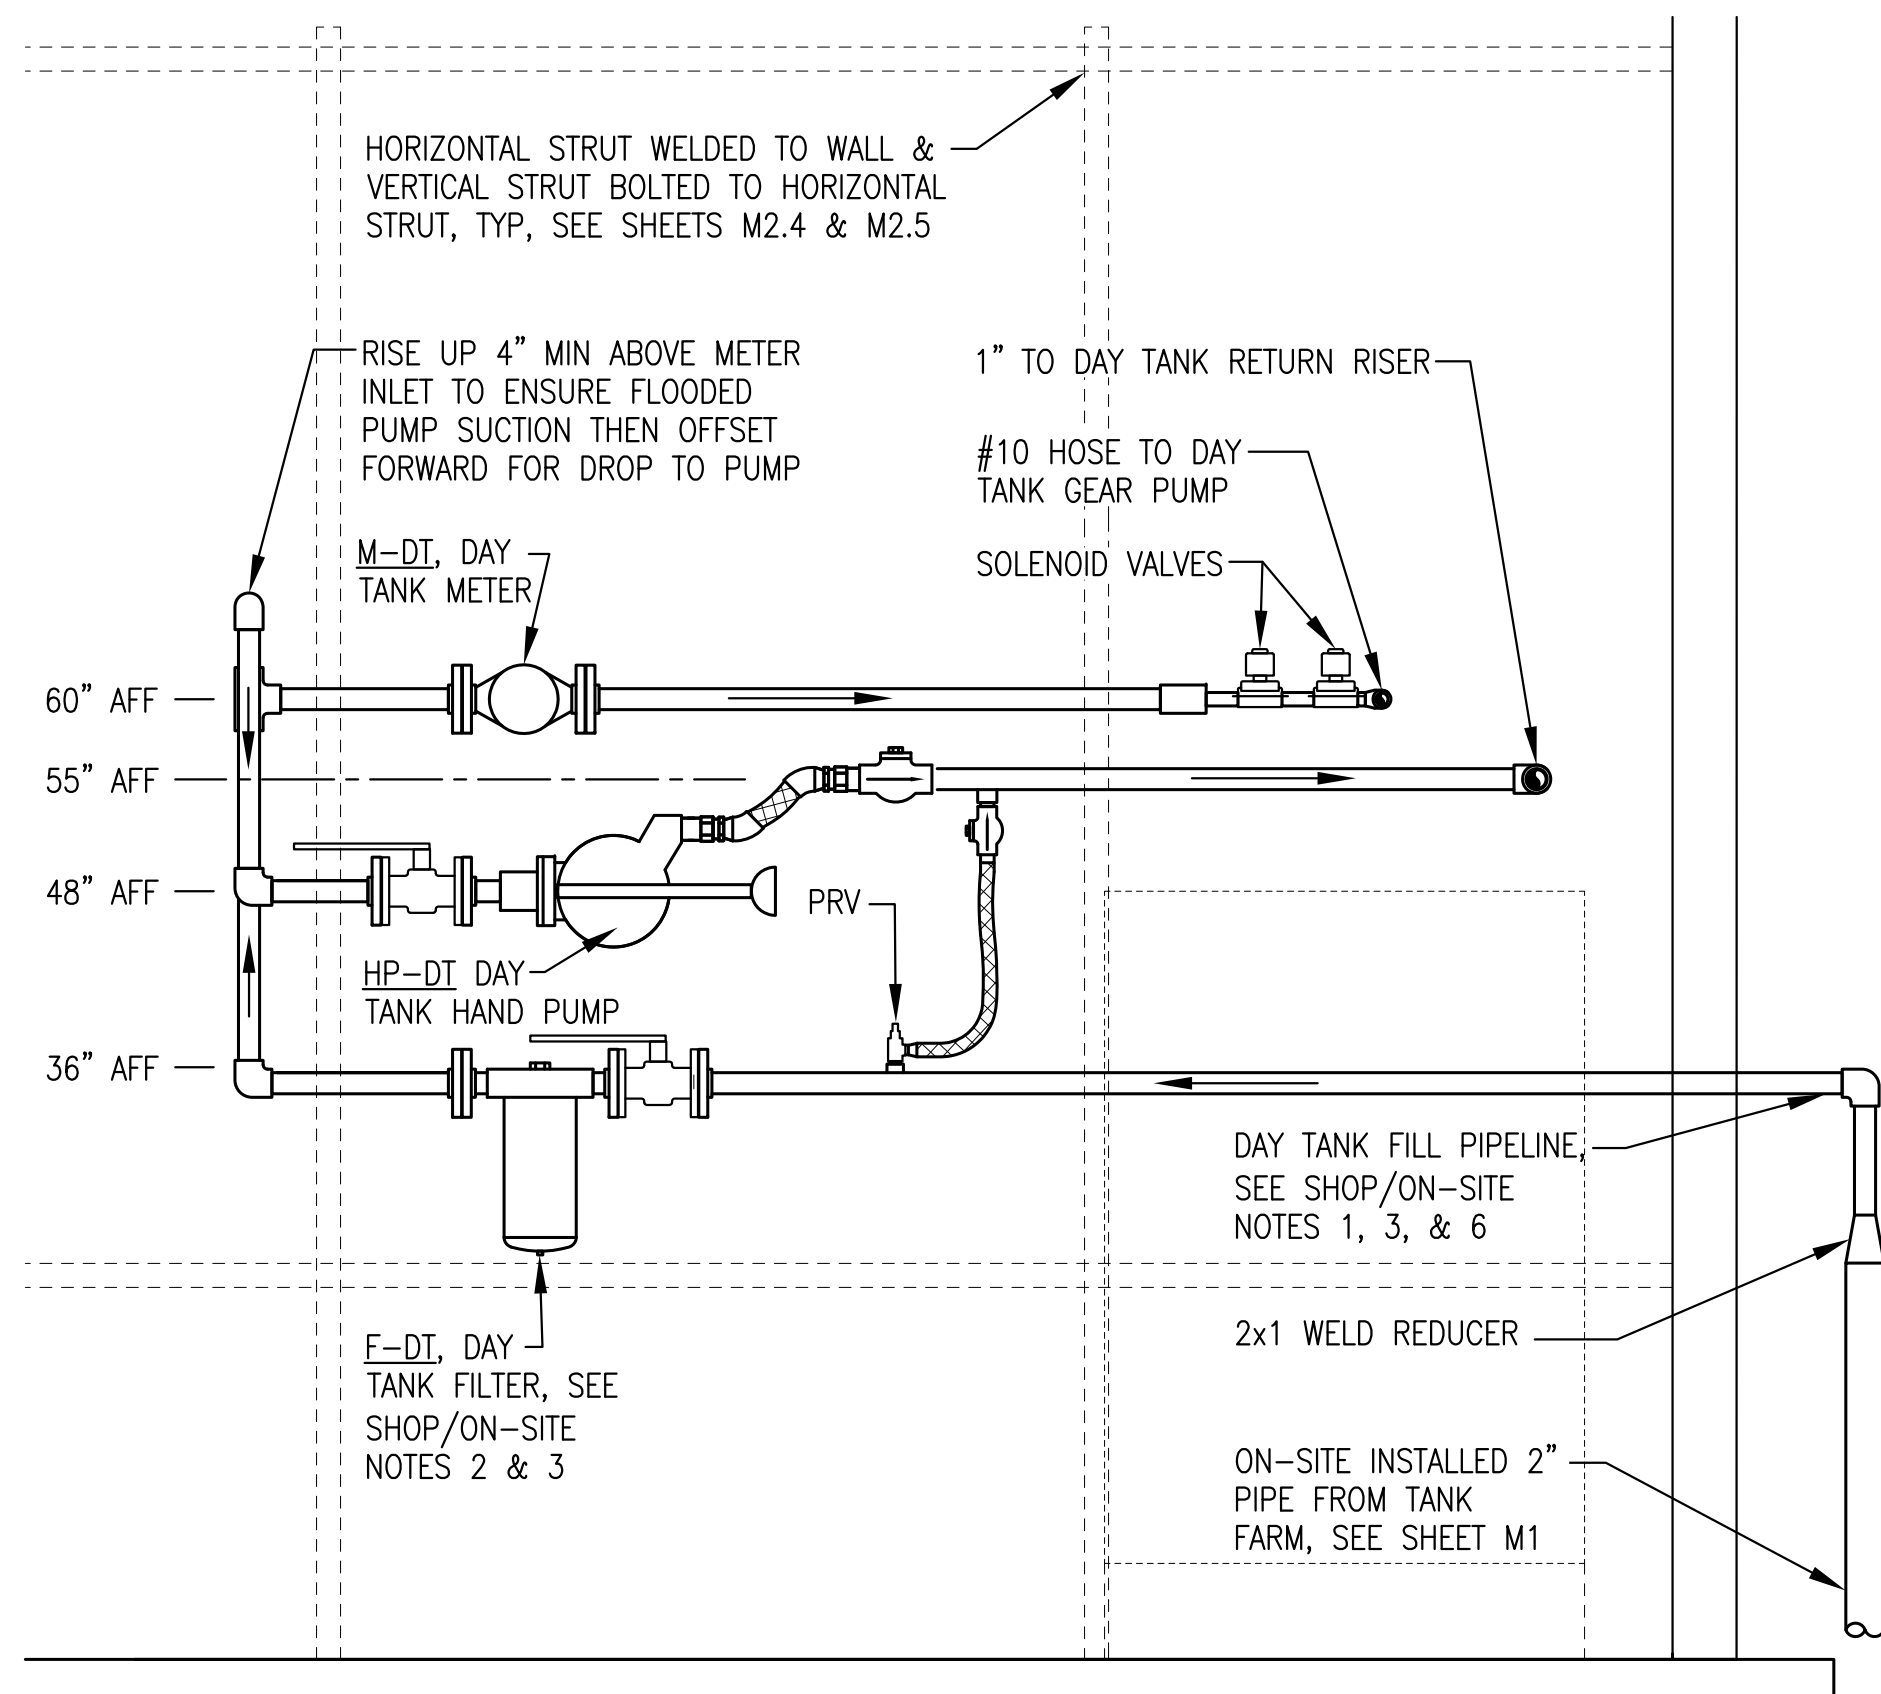


1 DIESEL FUEL FRONT WALL ELEVATION
M5.1 1"=1'

MODULE SHOP/ON-SITE NOTES:

1. DURING SHOP FABRICATION STUB DAY TANK FILL PIPE 8" MIN BEYOND WALL & TERMINATE WITH 1" MALE THREAD FOR TESTING.
2. UPON COMPLETION OF TESTING, DRAIN & REMOVE FILTER & STORE IN MODULE. SLIDE PIPE OVER & SECURE FOR SHIPPING.
3. AS PART OF ON-SITE INSTALLATION REINSTALL FILTER THEN CUT THREADS OFF END OF EXTERIOR PIPE & INSTALL SOCKET WELD ELBOW.
4. DURING SHOP FABRICATION INSTALL TEMPORARY VENT PIPE OUT WALL. REMOVE TEMP PIPE FOR SHIPPING.
5. AS PART OF ON-SITE INSTALLATION INSTALL 2" GALVANIZED THREADED VENT PIPE OUT WALL & UP TO VENT, SEE DETAIL 3/M5.2.
6. DURING SHOP FABRICATION HOLE SAW 1/2" Ø OVERSIZE OPENING THEN SEAL FOR SHIPPING AFTER REMOVING PIPE. UPON FINAL ON-SITE ASSEMBLY SEAL 1" PIPE TO EXTERIOR WALL WITH POLYURETHANE CAULKING & INSTALL FLASHING ON 2" VENT, SEE DETAIL 9/M4.1.

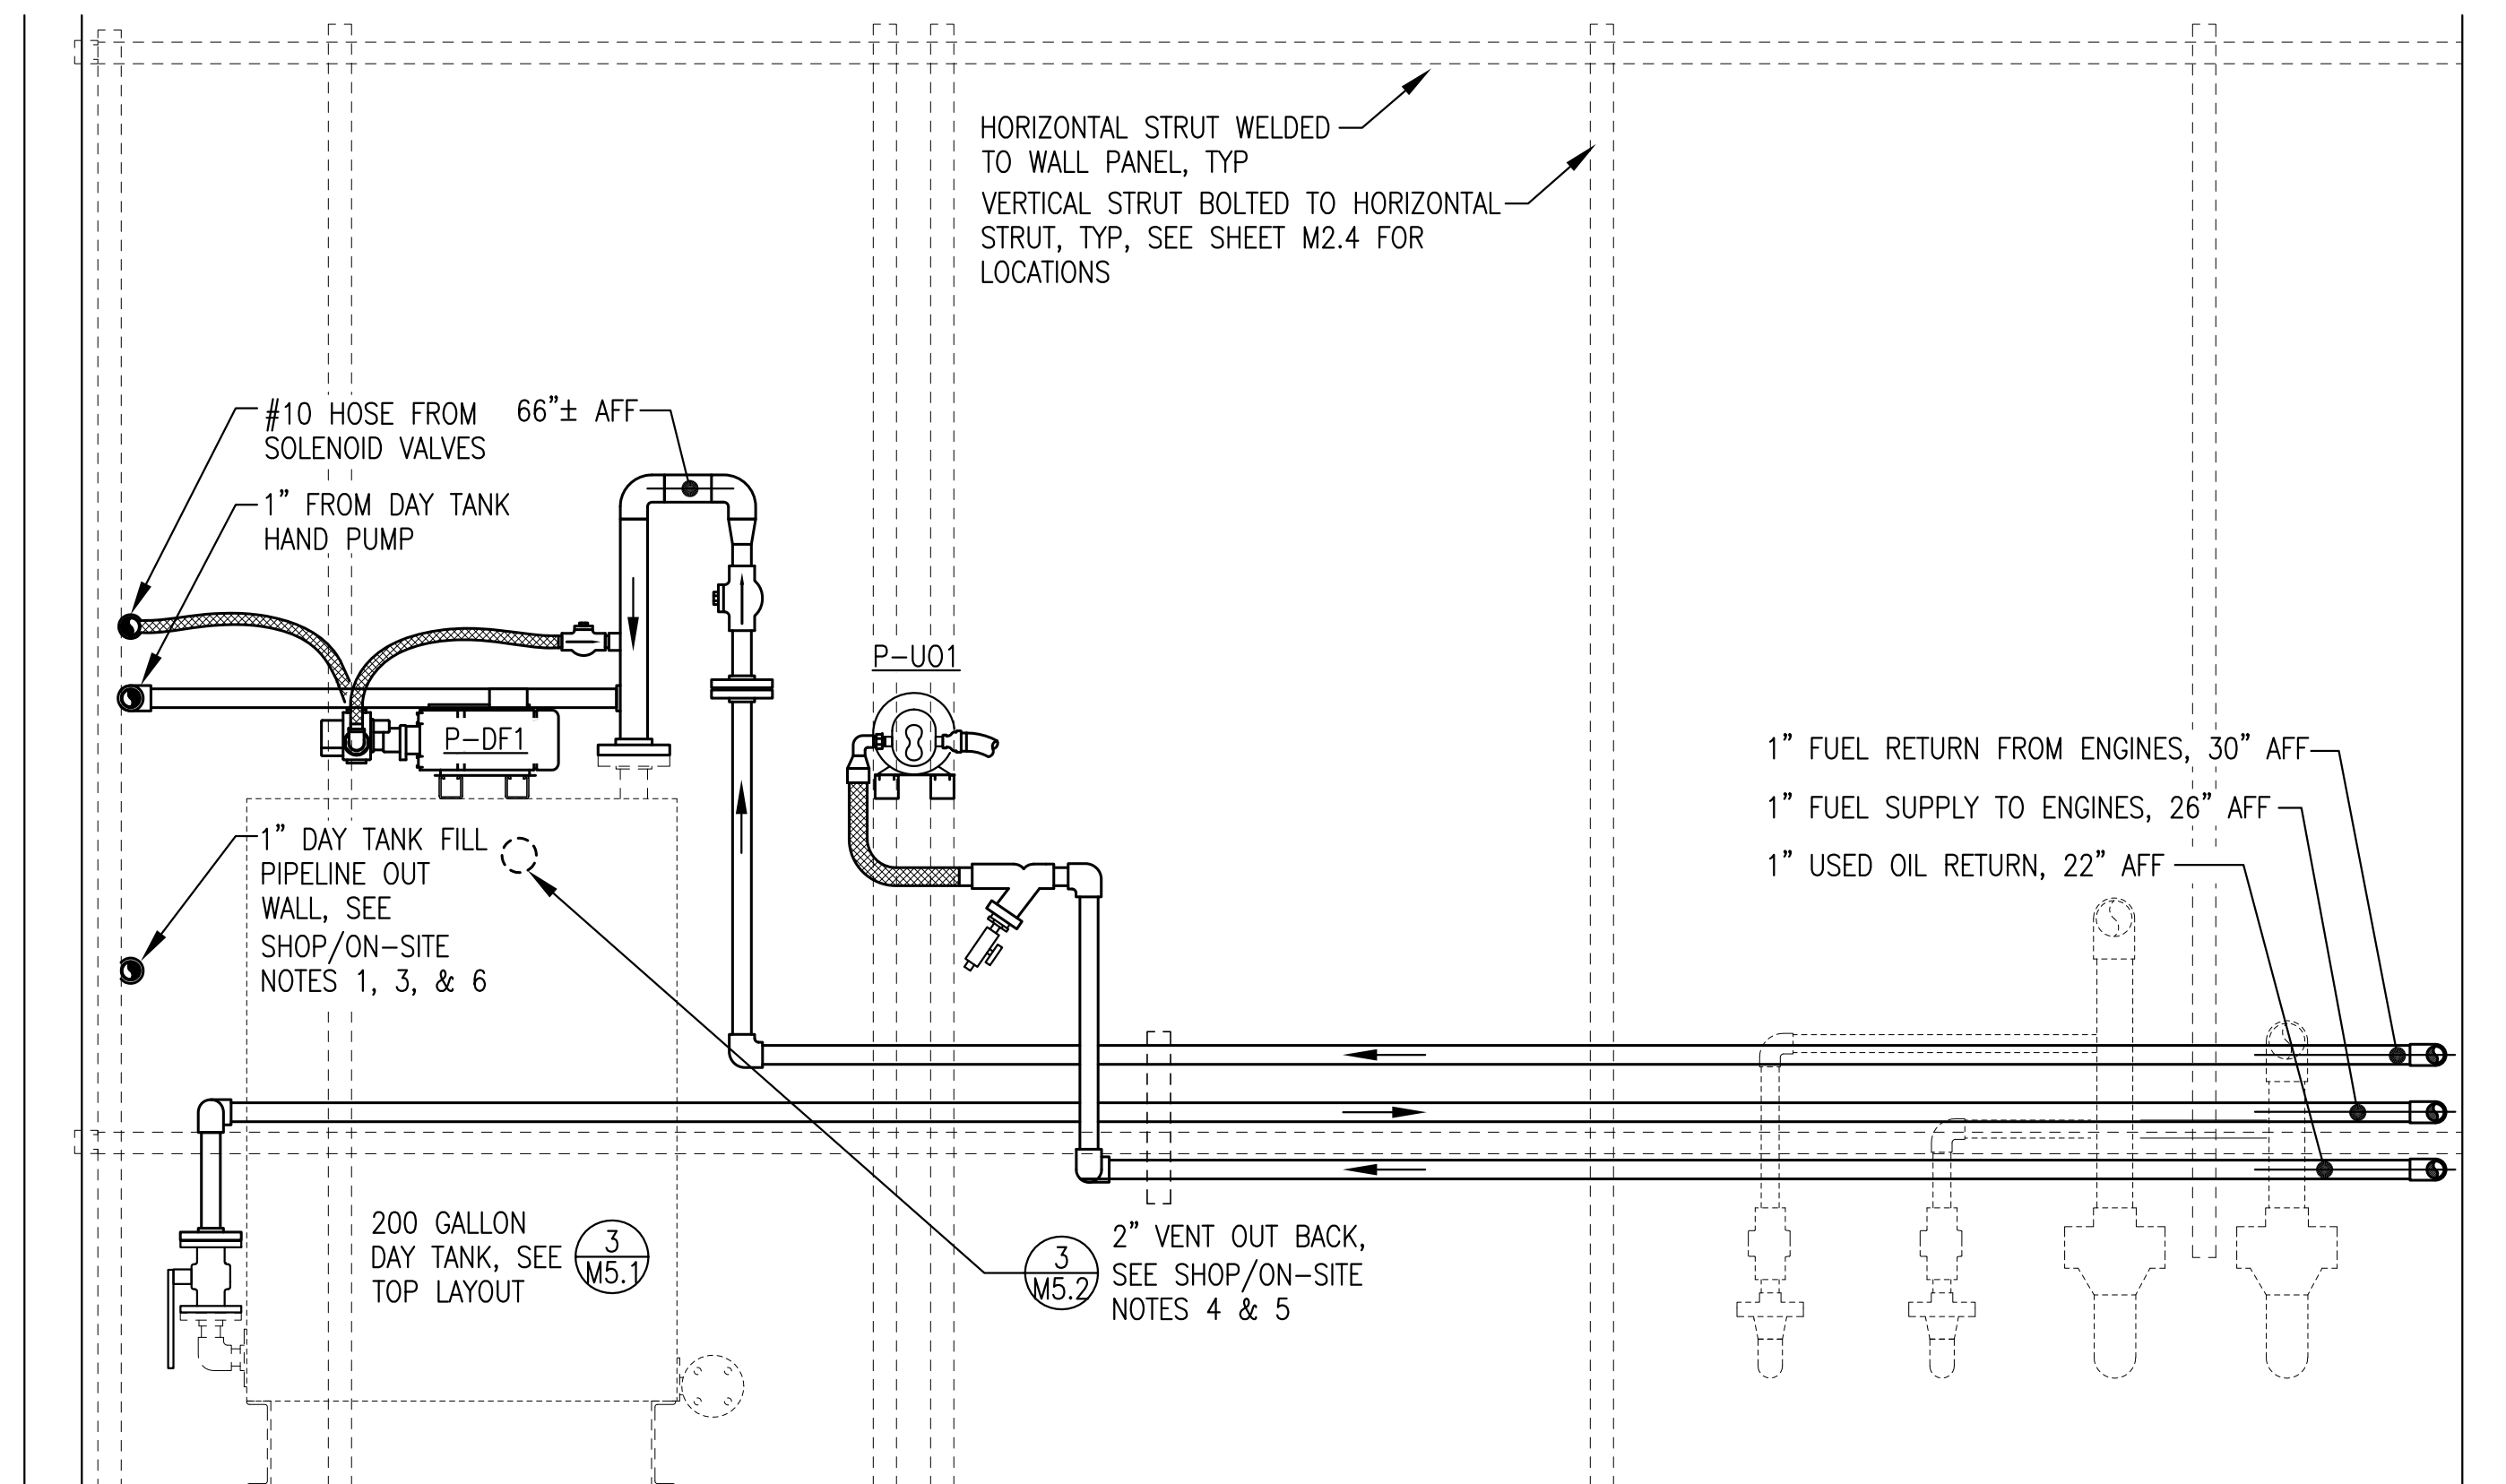


2 DIESEL FUEL & USED OIL END WALL ELEVATION
M5.2 1"=1'

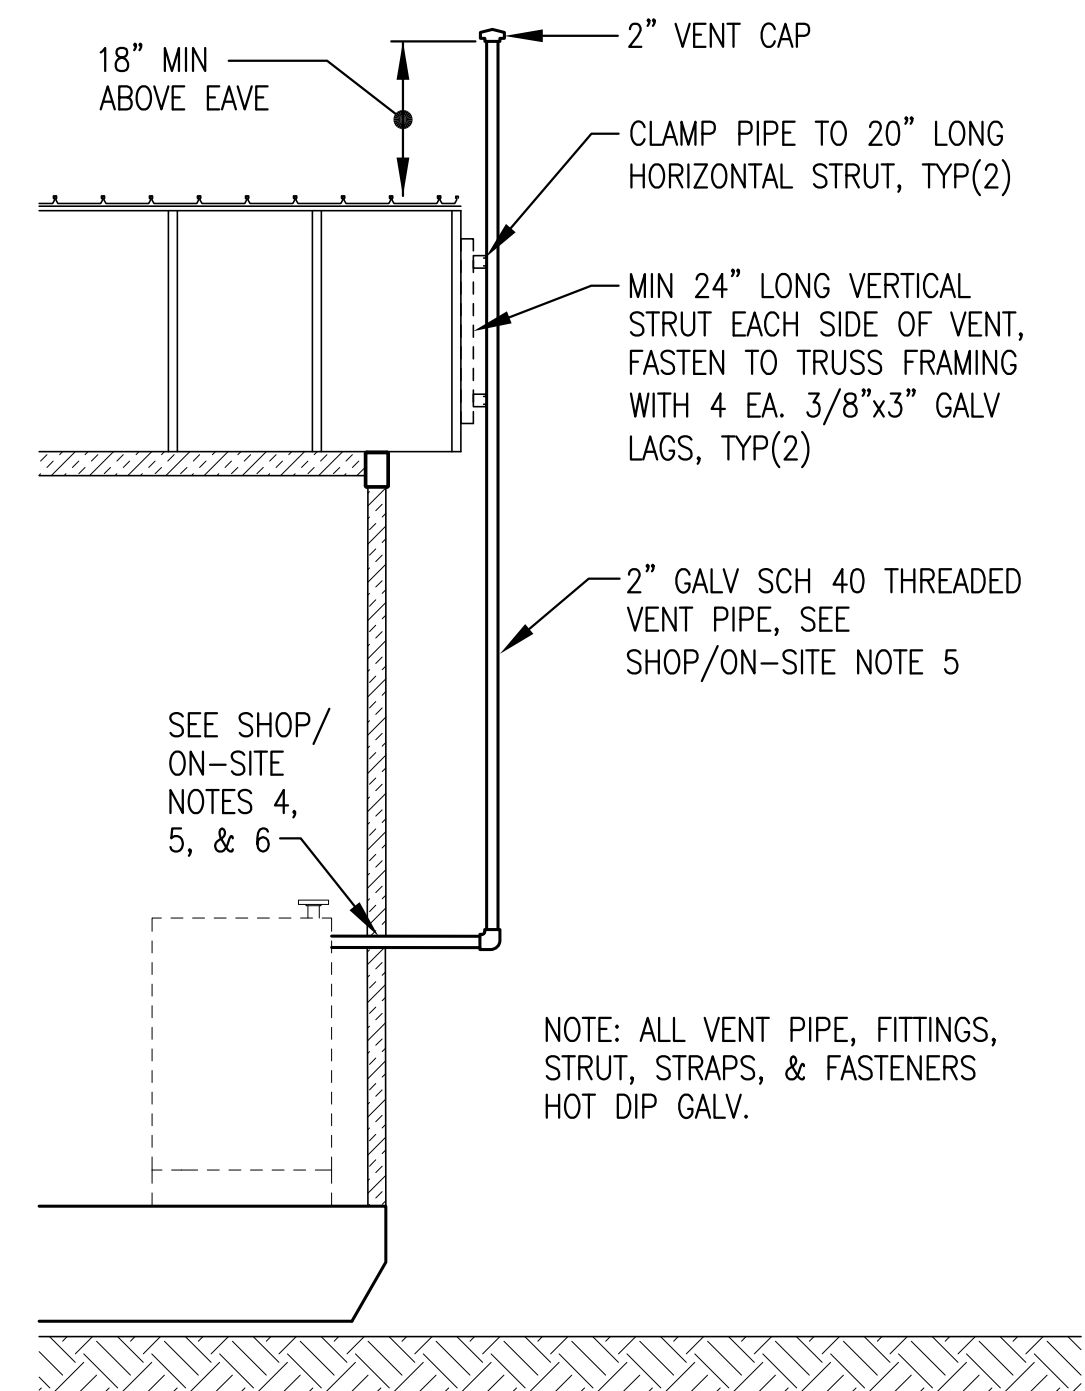

3 DAY TANK VENT INSTALLATION
M5.2 3/8"=1'-0"

ISSUED FOR
CONSTRUCTION
JANUARY 2019

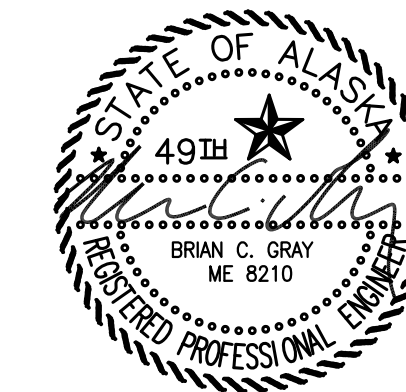

ALASKA ENERGY AUTHORITY

PROJECT: PORT HEIDEN RURAL POWER SYSTEM
POWER PLANT UPGRADE

TITLE: DIESEL FUEL & USED OIL
PIPING ELEVATIONS & DETAILS






 P.O. 111405, Anchorage, AK 99511 (907)349-0100	DRAWN BY: JTD	SCALE: AS NOTED
	DESIGNED BY: BCG	DATE: 1-14-19
FILE NAME: PTH PPU M2-7	SHEET:	M5.2 OF 7
PROJECT NUMBER:		

DAY TANK SPECIFICATIONS:


- 1) FABRICATE SINGLE WALL 200 GALLON NOMINAL CAPACITY DAY TANK. FABRICATE IN ACCORDANCE WITH UL 142.
- 2) FABRICATE FROM ASTM A-36 STEEL PLATE, 10 GAUGE MINIMUM EXCEPT FOR TOP 3/16" MINIMUM. ALL TANK SEAM JOINTS TO BE FULL CONTINUOUS WELDS IN ACCORDANCE WITH UL 142 FIGURE 6.5 - #1, #6, #7, OR #8.
- 3) PROVIDE WITH ALL OPENINGS AND ATTACHMENTS INDICATED. ALL STRUT TO BE 1-5/8"x1-5/8"x12 GA SOLID BACK PLAIN (BLACK), B-LINE B22 PLN OR EQUAL. SEAL WELD ALL TANK ATTACHMENTS.
- 4) INSTALL ALL FPT OPENINGS IN ACCORDANCE WITH UL 142 FIGURE 7.1 - #4 UNLESS INDICATED OTHERWISE. ALL DROP TUBES SCH 40 ASTM A53 STEEL PIPE WITH MPT OR FLANGED END AS INDICATED.
- 5) UPON COMPLETION OF FABRICATION, ROUND ALL CORNERS AND SHARP EDGES. SANDBLAST TANK EXTERIOR AND ALL ATTACHMENTS IN ACCORDANCE WITH SSPC-SP-6. PAINT WITH TWO COATS OF SHERWIN WILLIAMS MACROPOXY 646 OR APPROVED EQUAL, COLOR STRUCTURAL GRAY 4031.
- 6) LABEL ALL OPENINGS WITH 1/4" BLACK LETTERS INDICATING FUNCTION AS LISTED IN PARENTHESES IN SPECIFIC NOTES.
- 7) UPON COMPLETION FLUSH INTERIOR OF TANK TO REMOVE ALL DIRT AND DEBRIS AND AIR DRY INTERIOR. SEAL ALL MPT OPENINGS WITH THREADED STEEL CAPS. SEAL FPT TANK OPENINGS WITH THREADED STEEL PIPE PLUGS WHERE INDICATED. INSTALL 1-1/4" VENT CAP WHERE INDICATED. SEAL ALL OTHER FPT OPENINGS WITH PLASTIC OR STEEL PLUGS.

DAY TANK SPECIFIC NOTES:

- 1) PROVIDE 2" HIGH LETTERING: "DIESEL FUEL 200 GALLONS"
- 2) 4" FPT (MANUAL FILL) - INSTALL THREADED STEEL PLUG
- 3) 1-1/4" FPT (OVERFILL) - INSTALL VENT CAP FOR SHIPPING
- 4) 1-1/4" FPT (PUMP STOP)
- 5) 1-1/4" FPT (PUMP START)
- 6) 1-1/4" FPT (LOW ALARM)
- 7) 1-1/2" FPT (TANK GAUGE)
- 8) 30"L STRUT, END FLUSH WITH BACK OF TANK
- 9) 6"L STRUT
- 10) NOT USED
- 11) NOT USED
- 12) NOT USED
- 13) 1-1/2" SCH 40 DROP TUBE (FILL) WITH 150# FLANGE
- 14) 1" FPT (SPARE) - INSTALL THREADED STEEL PLUG
- 15) 2" FPT (VENT)
- 16) 3" FPT (EMERGENCY VENT) - INSTALL THREADED STEEL PLUG
- 17) 1" FLANGE (SUPPLY) - SEE DETAIL 2/M5.3
- 18) NOT USED
- 19) 1" FLANGE (DRAIN) - SEE DETAIL 3/M5.3
- 20) C6x8.2, 38" LONG
- 21) 2" FPT (TANK LEVEL PROBE)

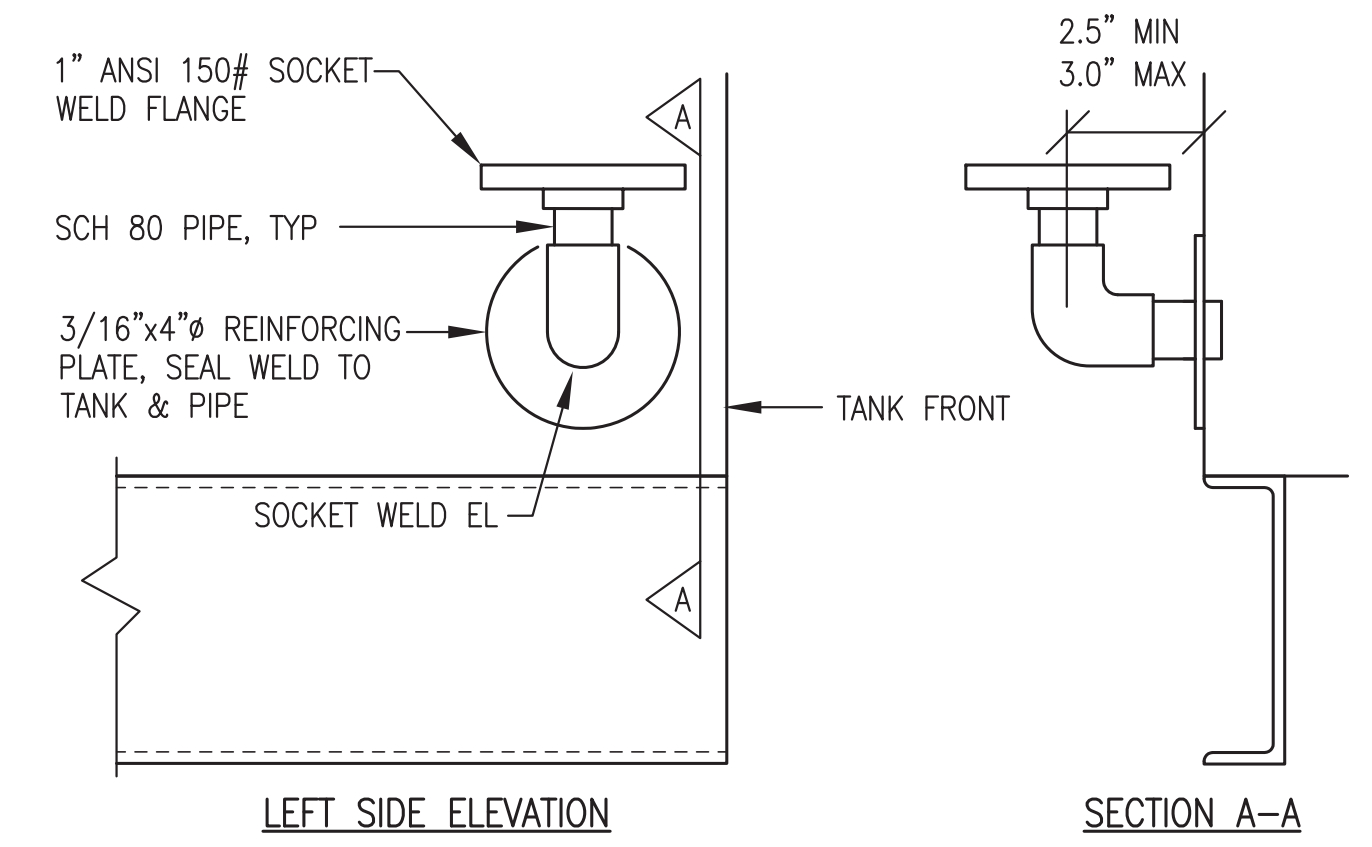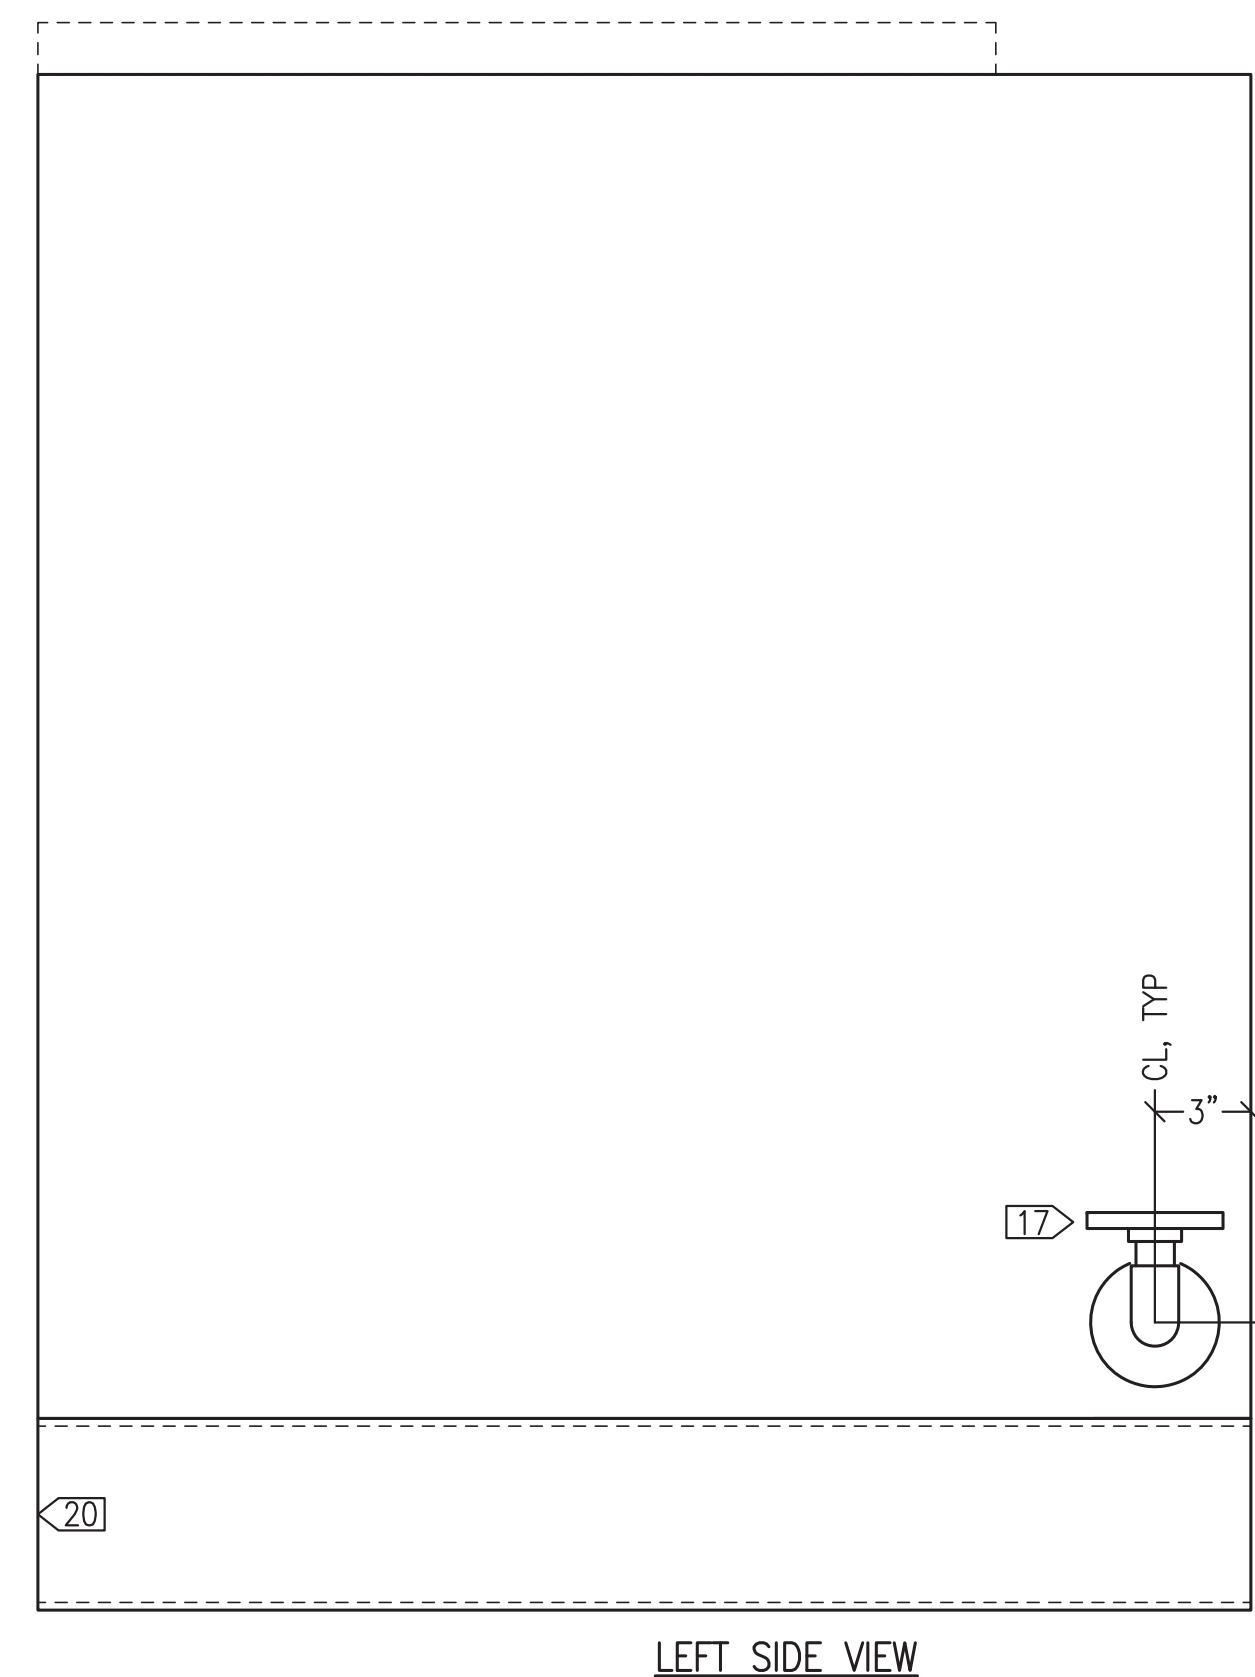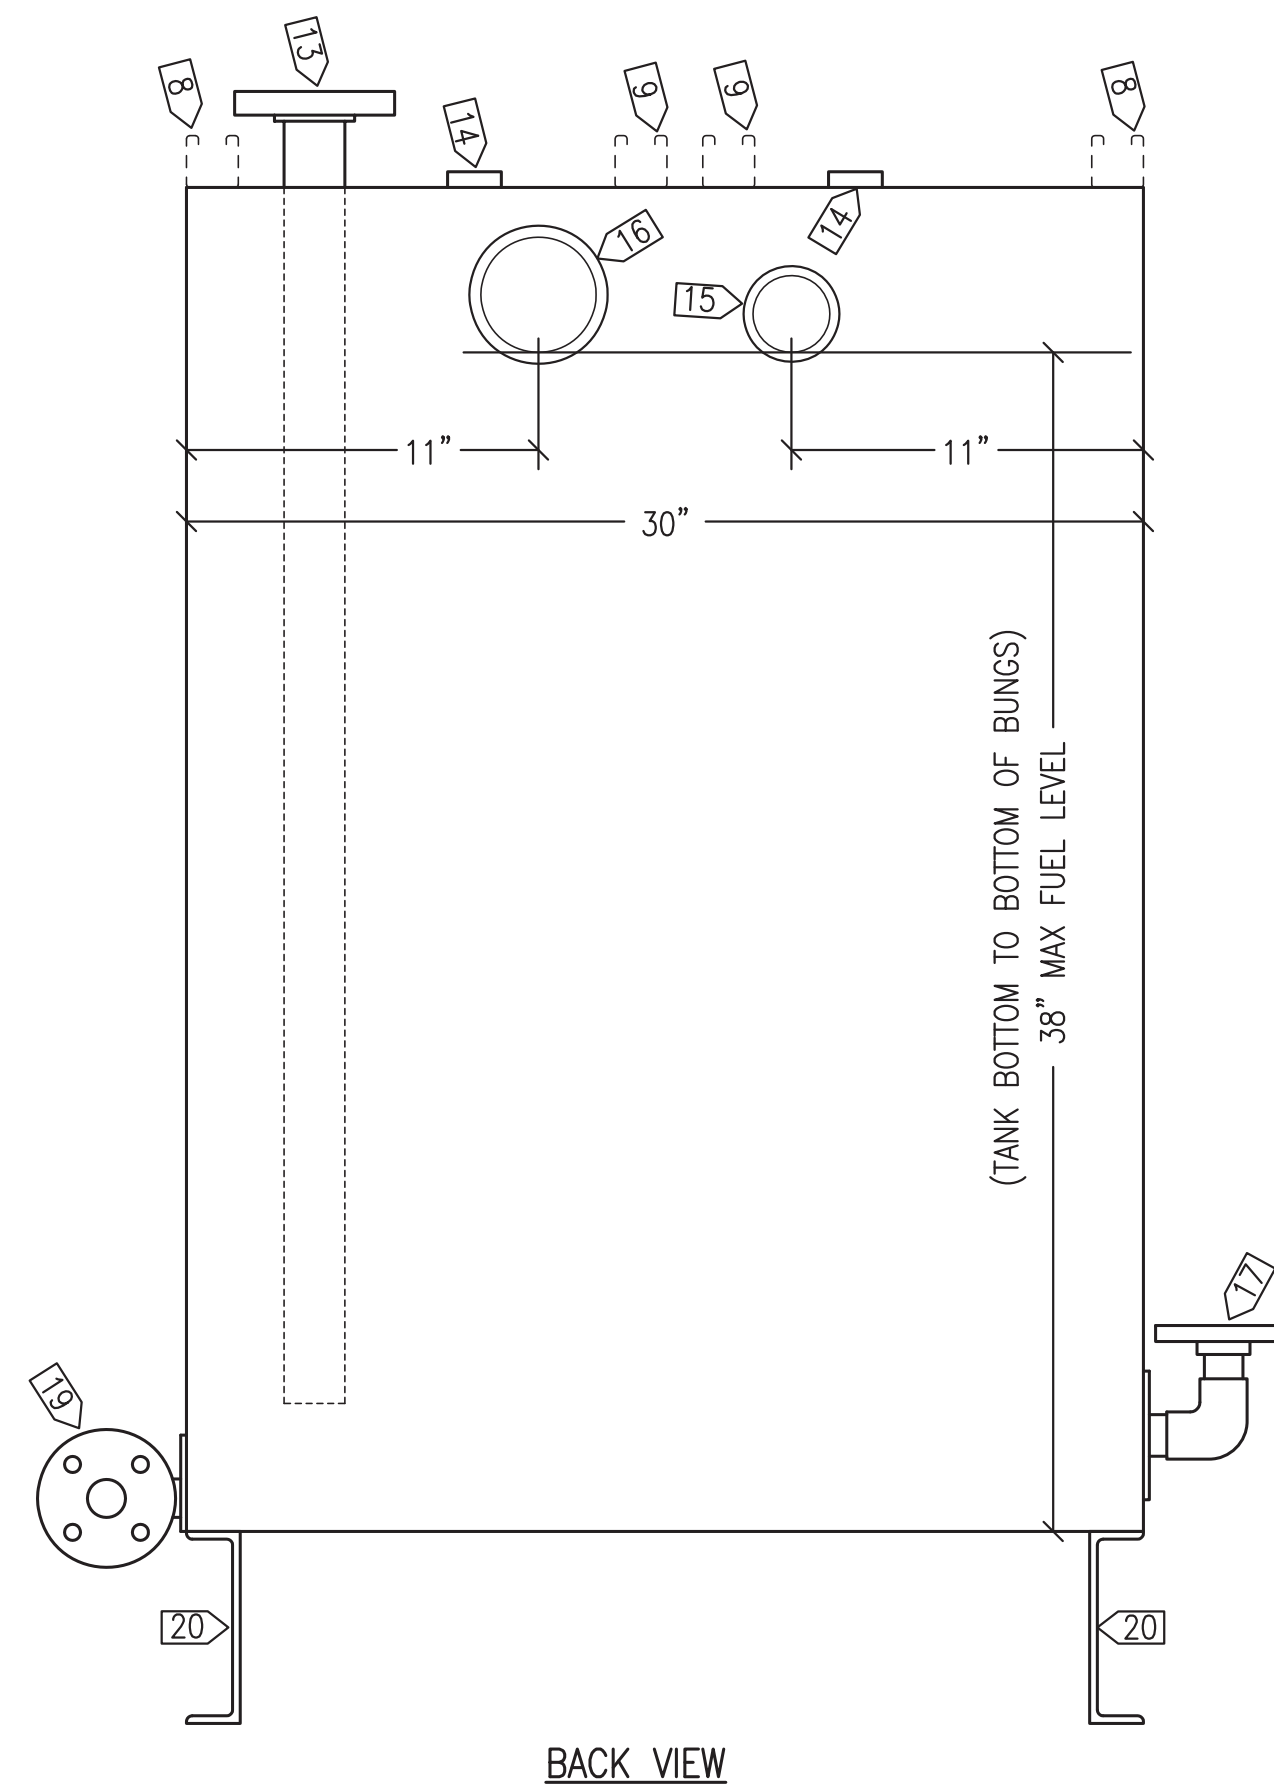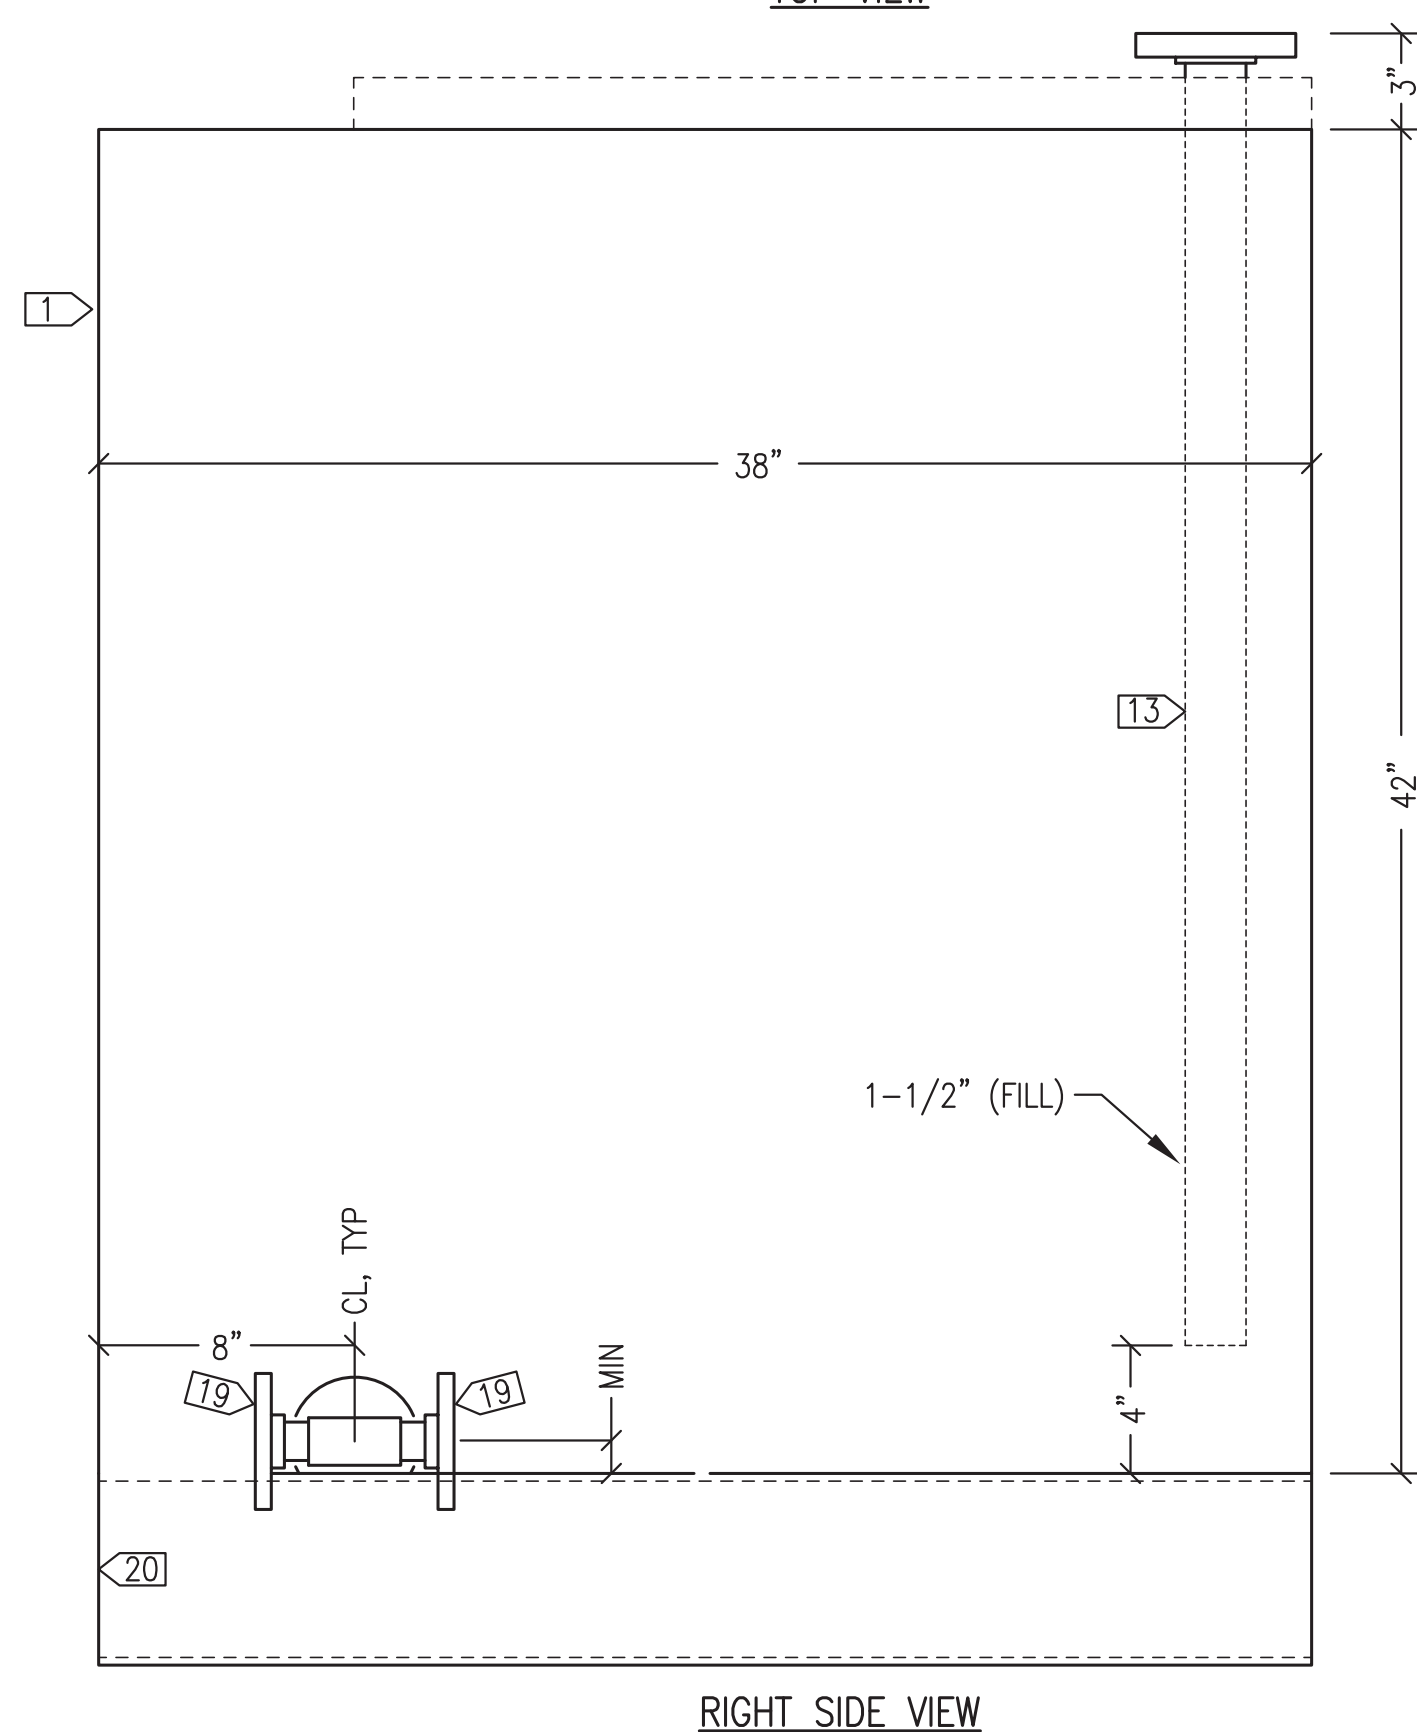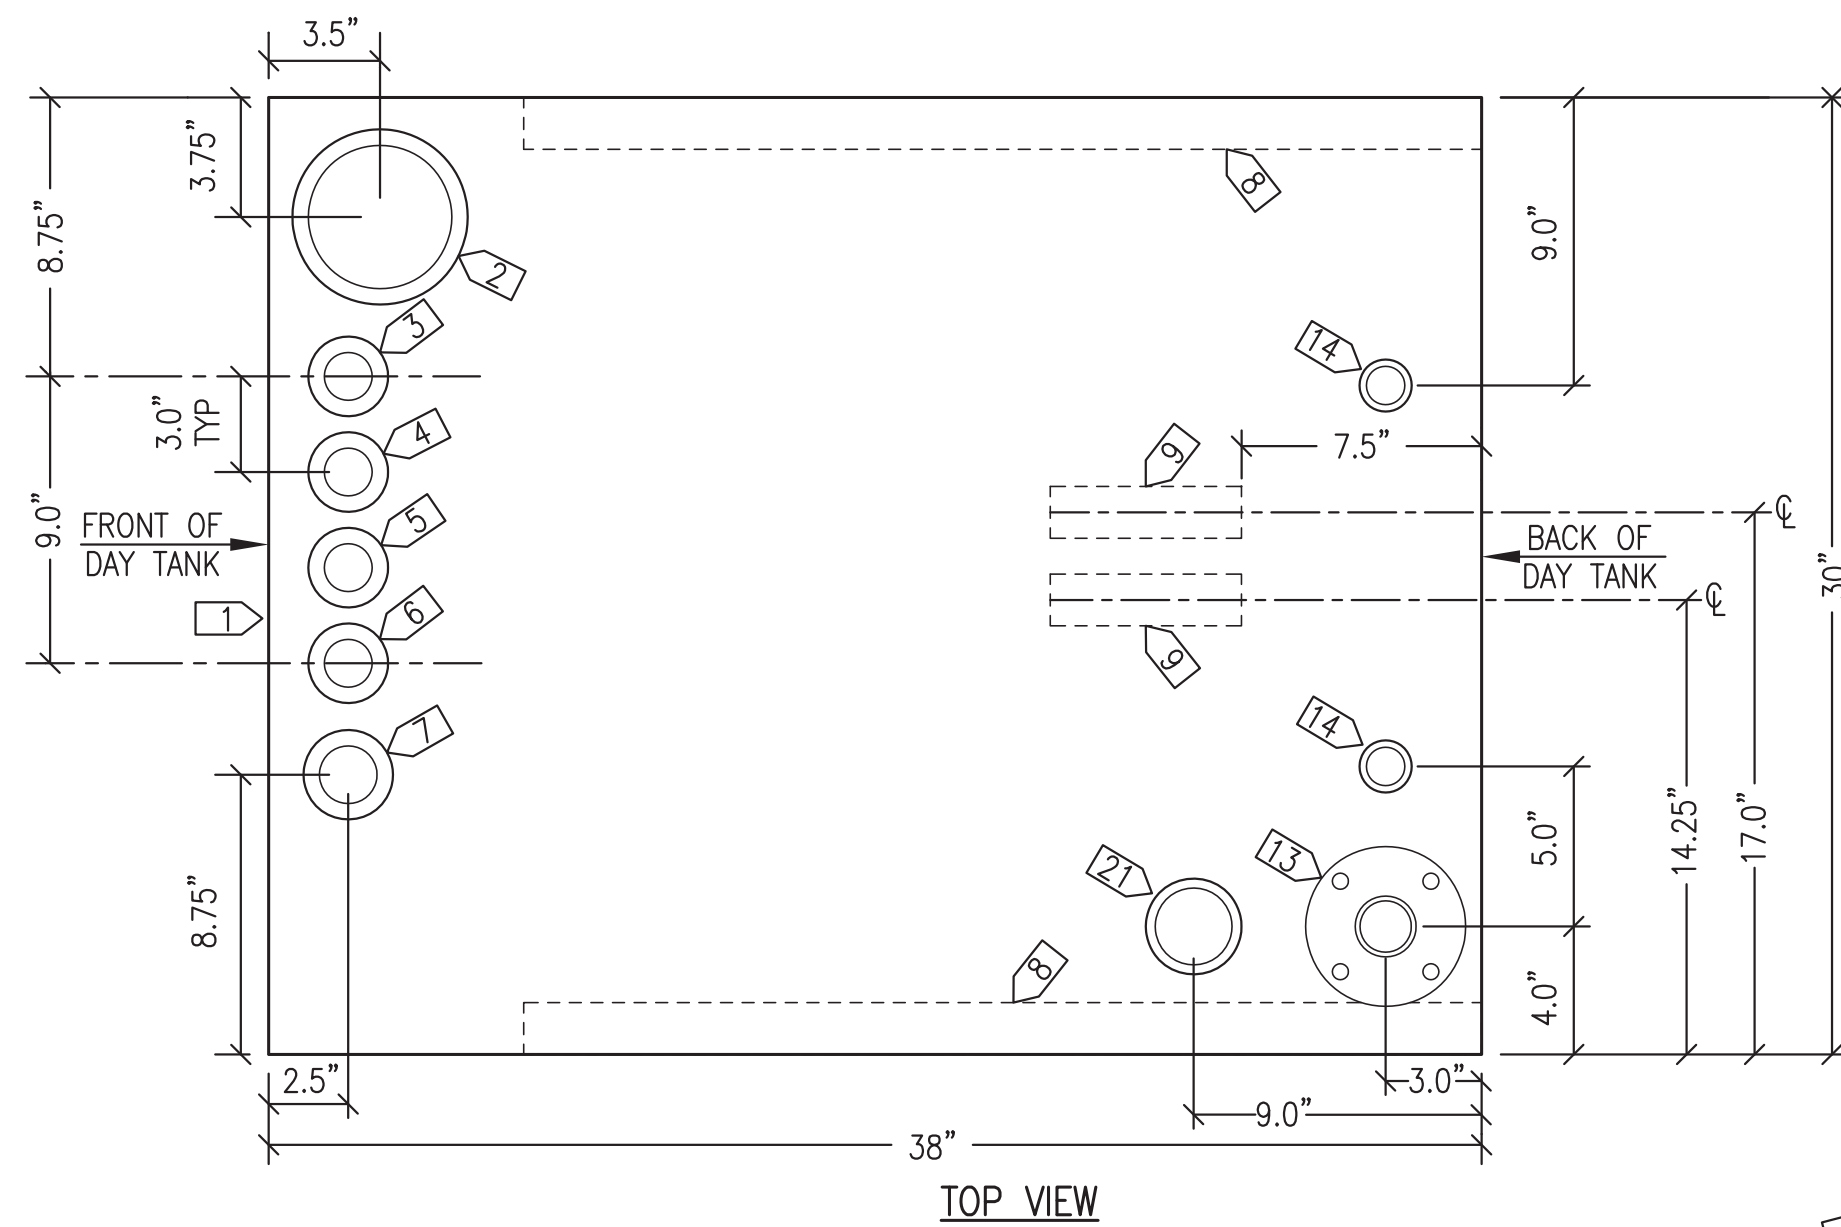

2 1" FLANGED SUPPLY CONNECTION
M5.3 NO SCALE

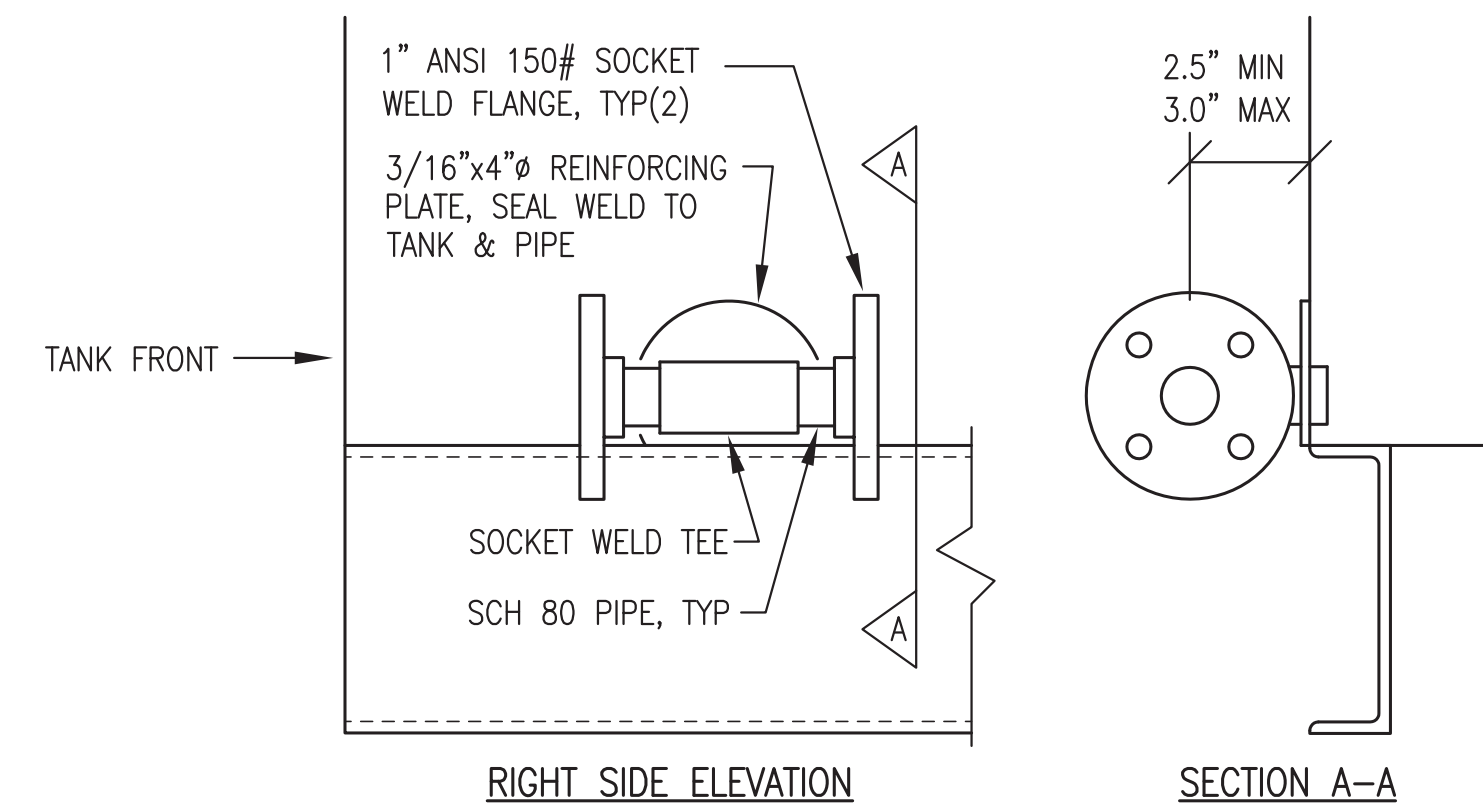


3 1" FLANGED DRAIN CONNECTION
M5.3 NO SCALE


ISSUED FOR CONSTRUCTION
JANUARY 2019




ALASKA ENERGY AUTHORITY		
PROJECT:	PORT HEIDEN RURAL POWER SYSTEM POWER PLANT UPGRADE	
TITLE:	200 GALLON DAY TANK FABRICATION	
DRAWN BY: JTD	DESIGNED BY: BCG	SCALE: AS NOTED
FILE NAME: PTH PPU M2-7	PROJECT NUMBER:	DATE: 1-14-19
P.O. 111405, Anchorage, AK 99511 (907)349-0100	Gray Stassel Engineering, Inc.	SHEET: M5.3 OF 7

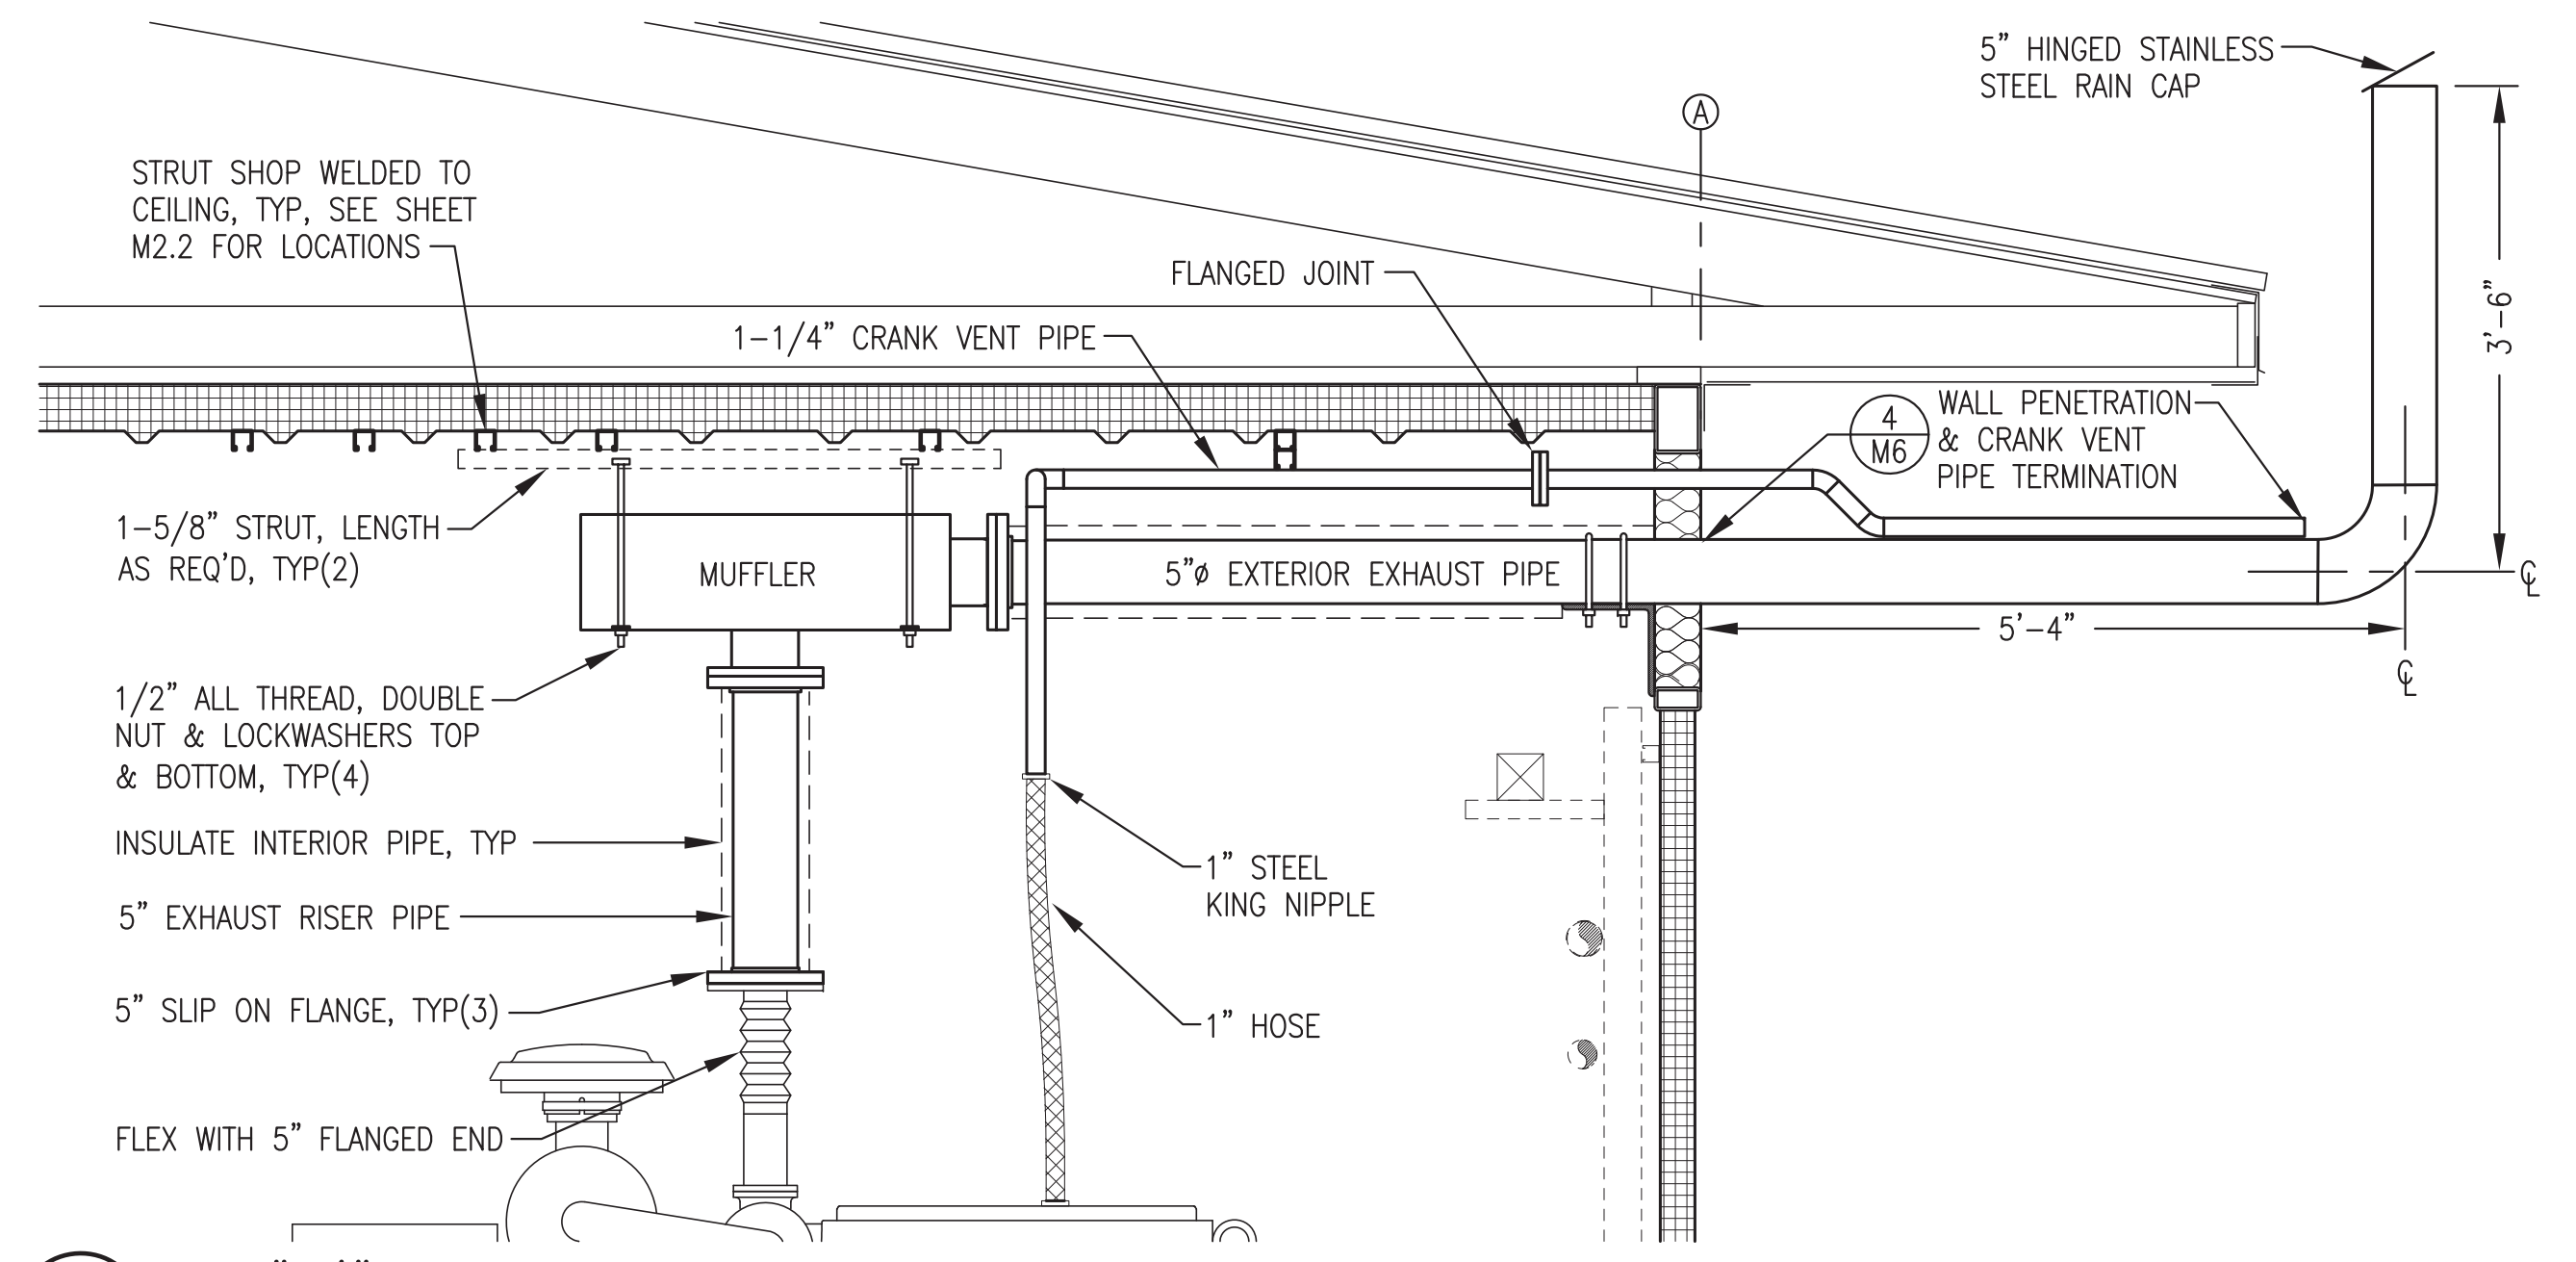


1 GEN #1/#2 MUFFLER, EXHAUST & CRANK VENT PIPE INSTALLATION
 3/4"=1'-0"

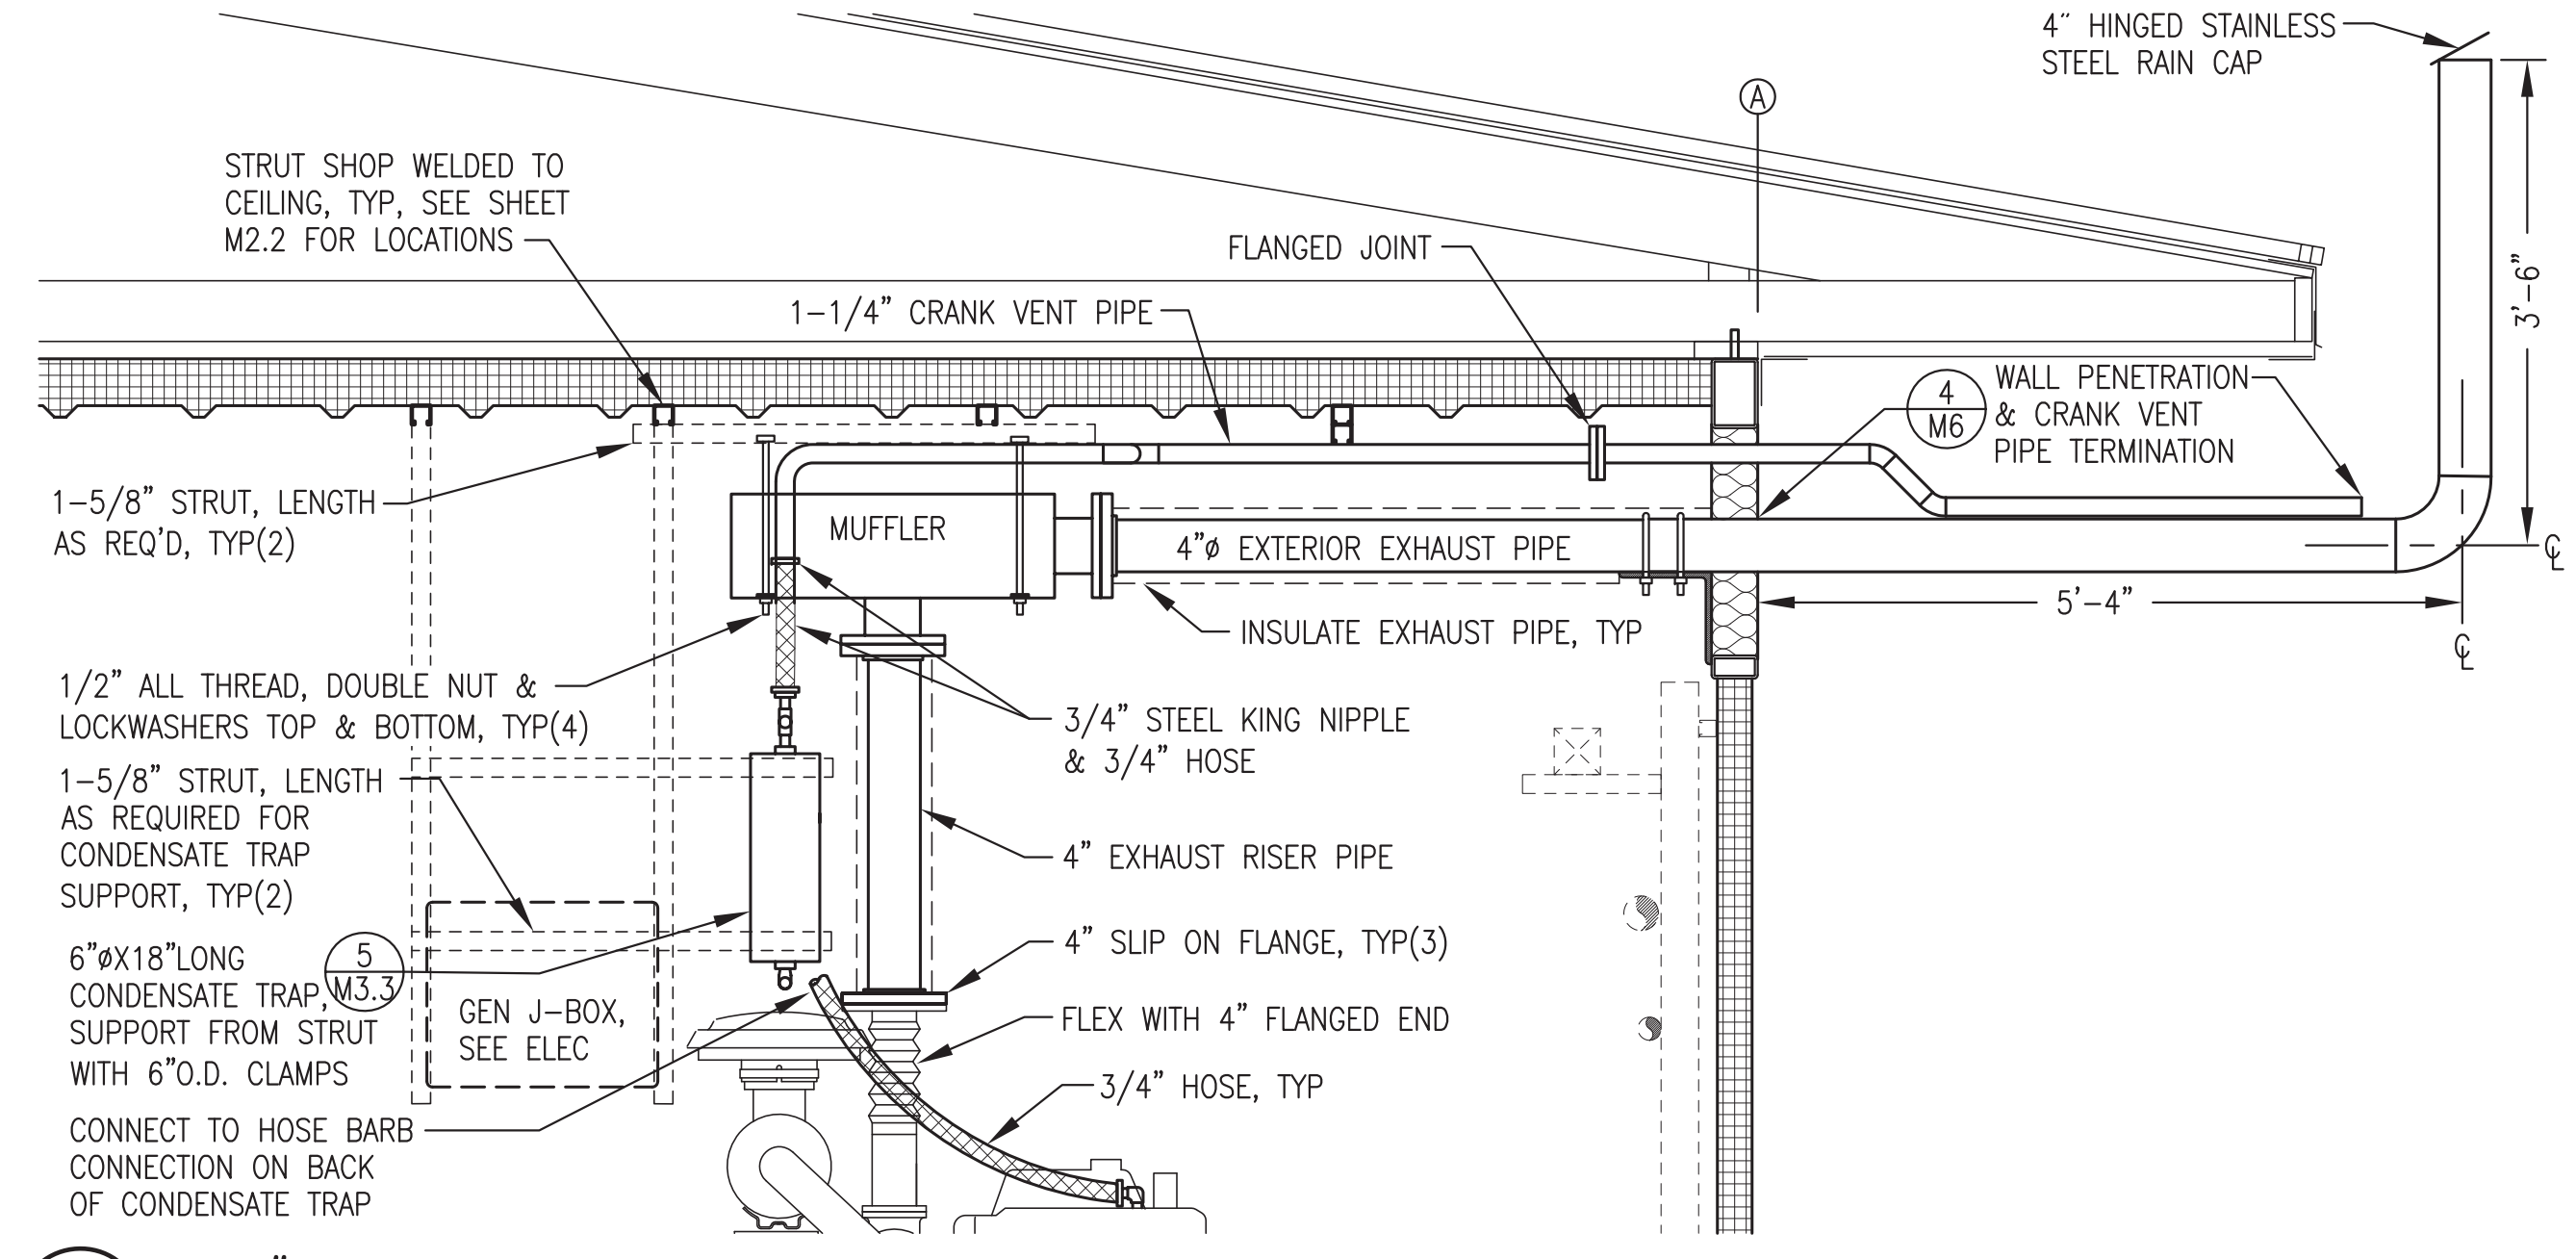

2 GEN #3 MUFFLER, EXHAUST, CONDENSATE TRAP & CRANK VENT PIPE INSTALLATION
 3/4"=1'-0"

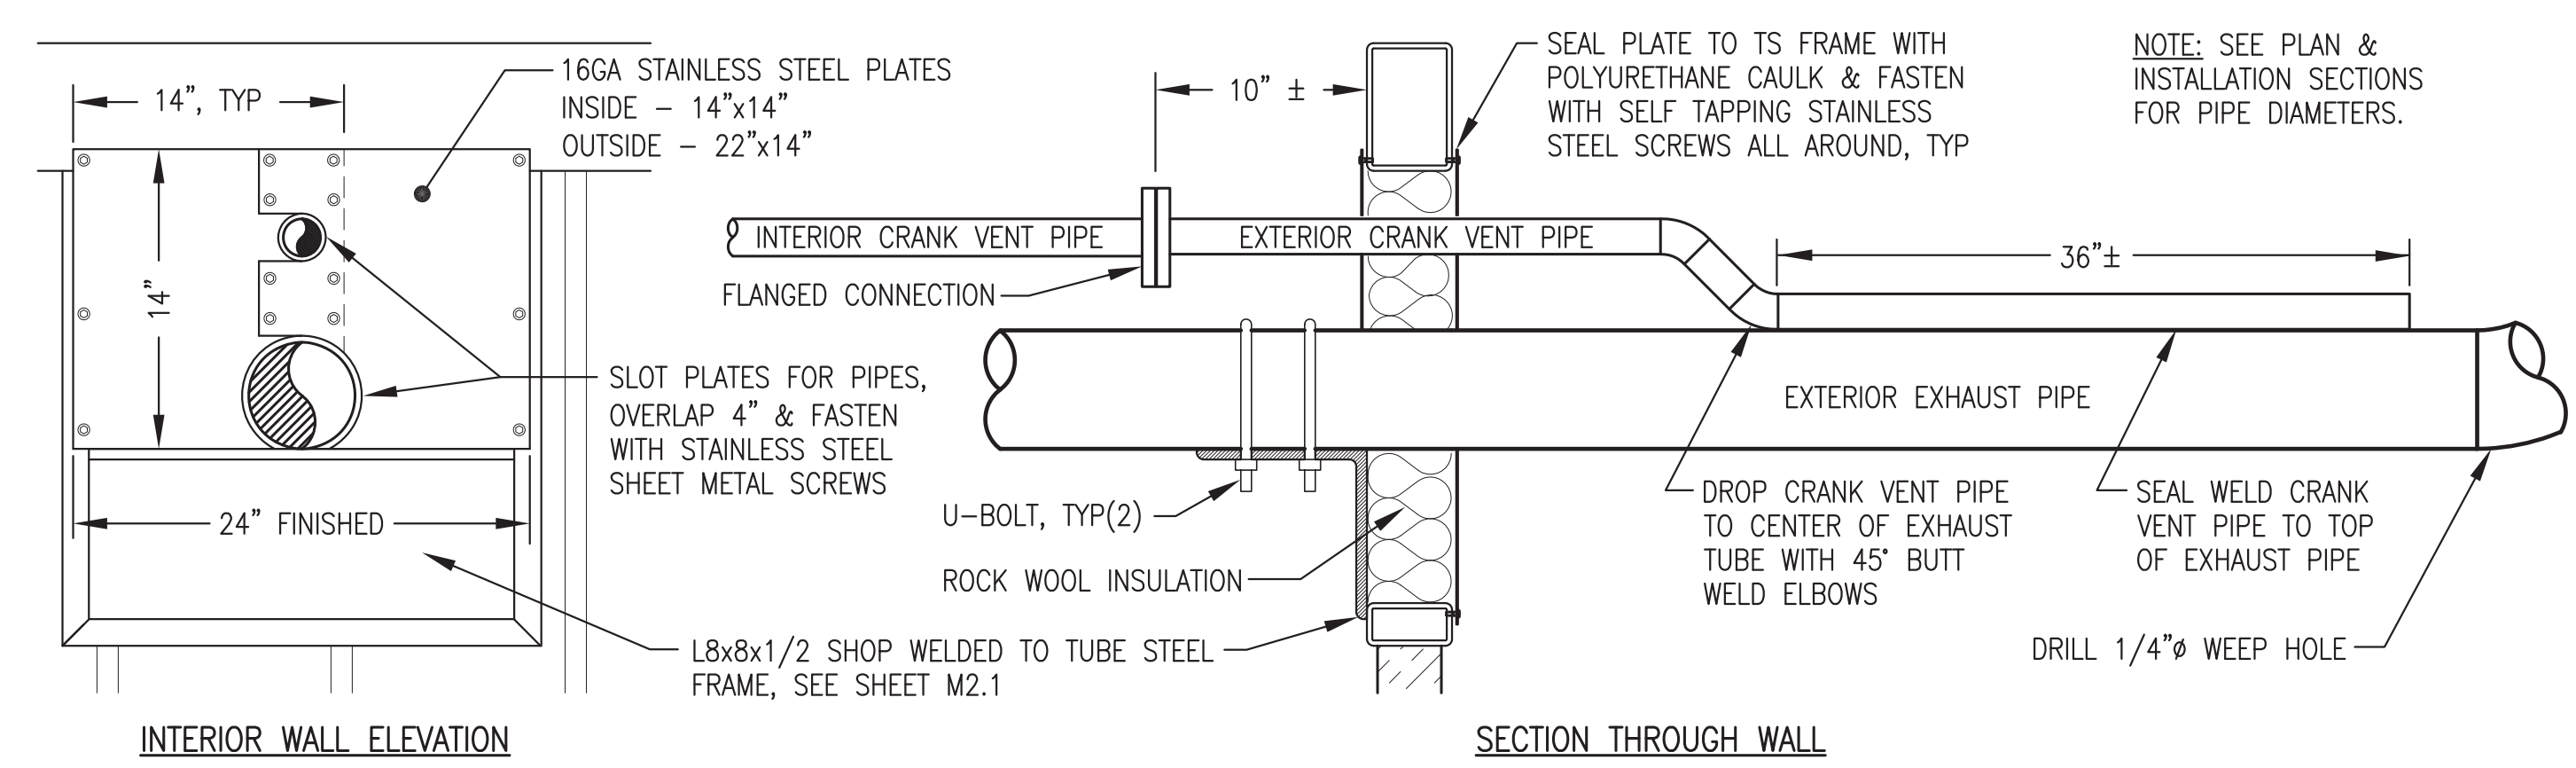

4 WALL PENETRATION & CRANK VENT PIPE TERMINATION
 NO SCALE

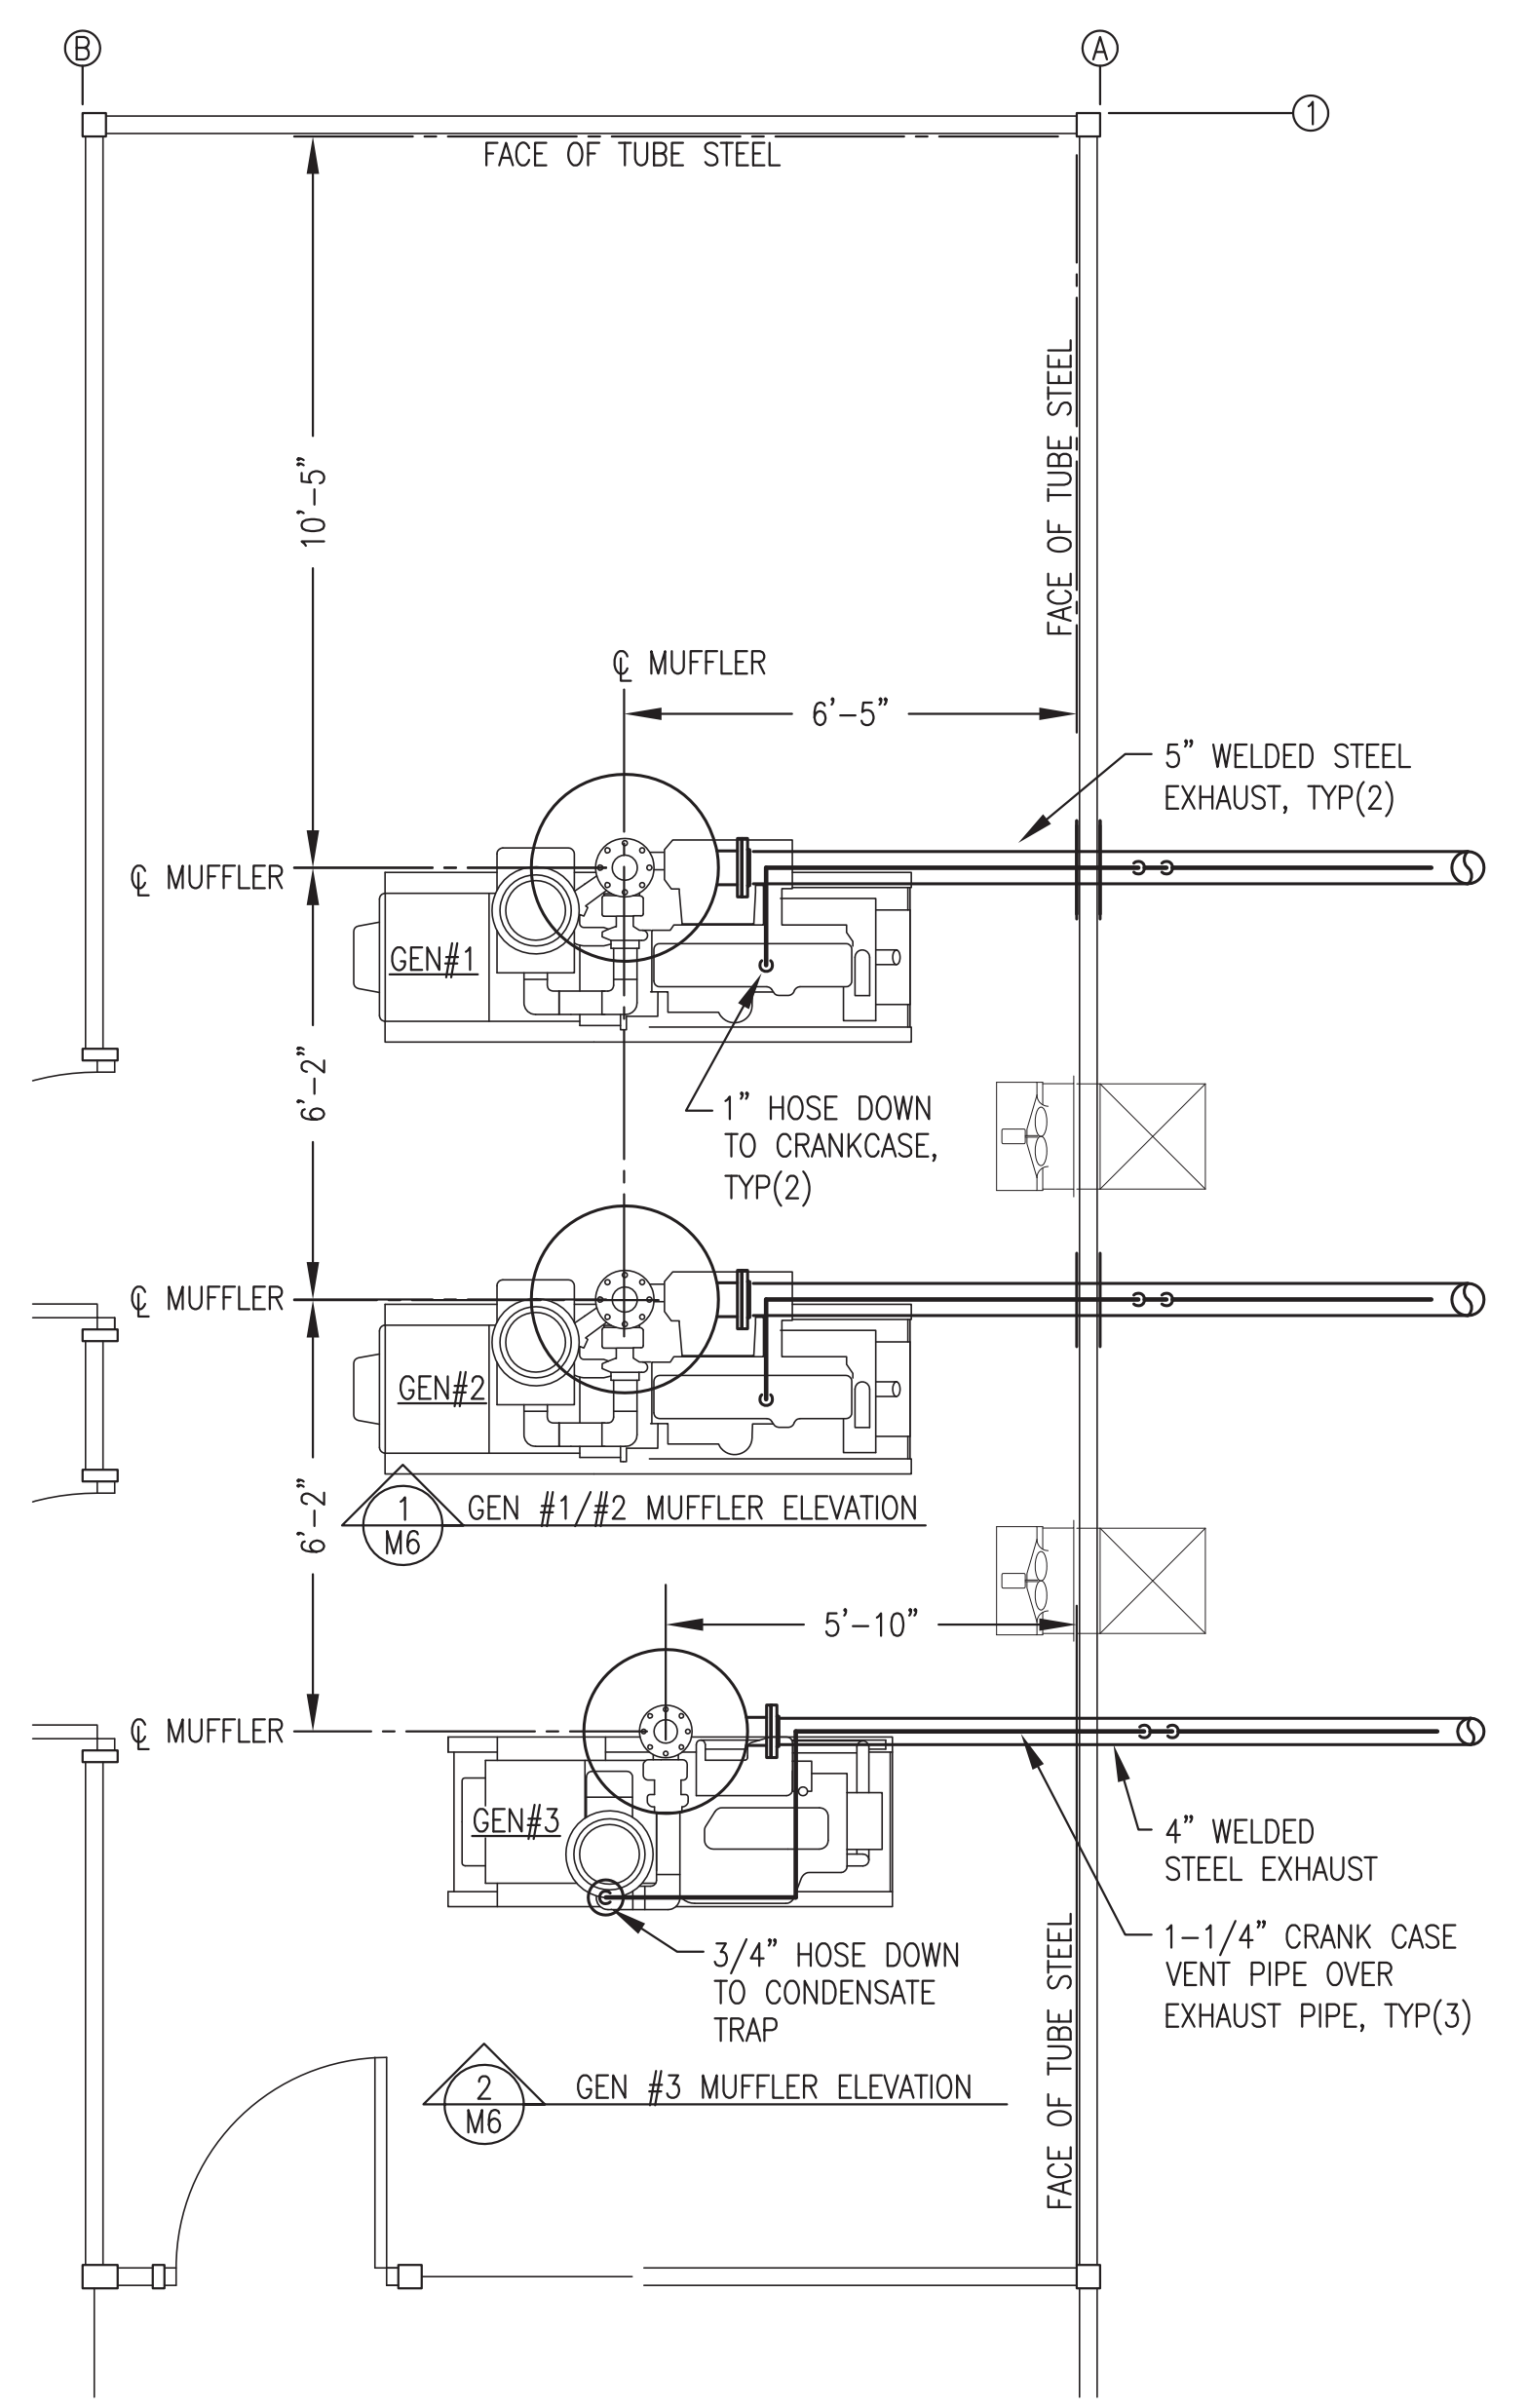

3 MUFFLER, EXHAUST & CRANK VENT PIPE PLAN
 3/8"=1'-0"


EXHAUST & CRANK VENT GENERAL NOTES:

- 1) ALL EXTERIOR EXHAUST PIPE AND FITTINGS (FROM MUFFLER TO RAIN CAP) TYPE 304L STAINLESS STEEL WITH BUTT WELD FITTINGS. INTERIOR EXHAUST PIPE RISER (FROM FLEX TO MUFFLER) CARBON STEEL OR MAY BE STAINLESS AT CONTRACTORS OPTION. ALL FLANGES ANSI 150# FLAT FACED SLIP ON.
- 2) ALL EXTERIOR CRANK VENT PIPE AND FITTINGS TYPE 304L STAINLESS STEEL WITH BUTT WELD FITTINGS. ALL INTERIOR CRANK VENT PIPE AND FITTINGS CARBON STEEL WITH SOCKET WELD FITTINGS OR MAY BE STAINLESS AT CONTRACTORS OPTION. ALL FLANGES ANSI 150# FLAT FACED SOCKET WELD.
- 3) ALL EXHAUST FLANGE BOLTS BLACK OR STAINLESS STEEL. COAT WITH HIGH TEMPERATURE ANTI-SIEZE.

EXHAUST & CRANK VENT SHOP/ON-SITE NOTES:


- 1) SHOP FABRICATE COMPLETE EXHAUST AND CRANK VENT PIPING SYSTEM AS INDICATED.
- 2) SHOP INSTALL INSULATION FROM FLEX TO MUFFLER. SHOP FIT INSULATION FROM MUFFLER TO WALL, LABEL FOR THE ASSOCIATED GENERATOR AND STORE INSIDE MODULE.
- 3) SHOP FABRICATE STAINLESS STEEL COVER PLATES BUT DO NOT INSTALL. LABEL COVER PLATES FOR THE ASSOCIATED GENERATOR AND STORE INSIDE MODULE.
- 4) UPON COMPLETION OF TESTING BREAK EXHAUST FLANGE JOINT ON MUFFLER OUTLET AND CRANK VENT FLANGE JOINT AND REMOVE U-BOLTS. REMOVE PIPING FOR SHIPPING AND TEMPORARILY SEAL WALL PENETRATION.
- 5) IN FIELD REINSTALL PIPING WITH NEW FLANGE GASKETS. RE-INSTALL PIPING INSULATION. INSULATE WALL PENETRATION, INSTALL COVER PLATES, AND SEAL TO WALL.

ISSUED FOR
 CONSTRUCTION
 JANUARY 2019

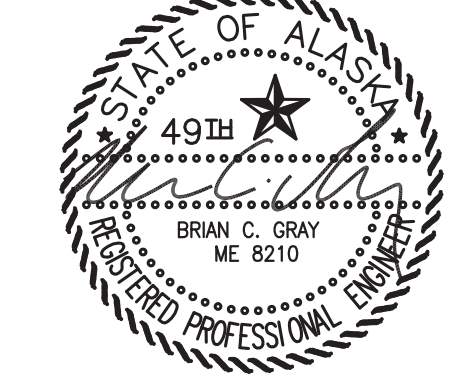


PROJECT: PORT HEIDEN RURAL POWER SYSTEM POWER PLANT UPGRADE	
TITLE: EXHAUST & CRANK VENT PLAN & DETAILS	
DRAWN BY: JTD	SCALE: AS NOTED
DESIGNED BY: BCG	DATE: 1-14-19
FILE NAME: PTH PPU M2-7	SHEET: M6 OF 7
PROJECT NUMBER:	




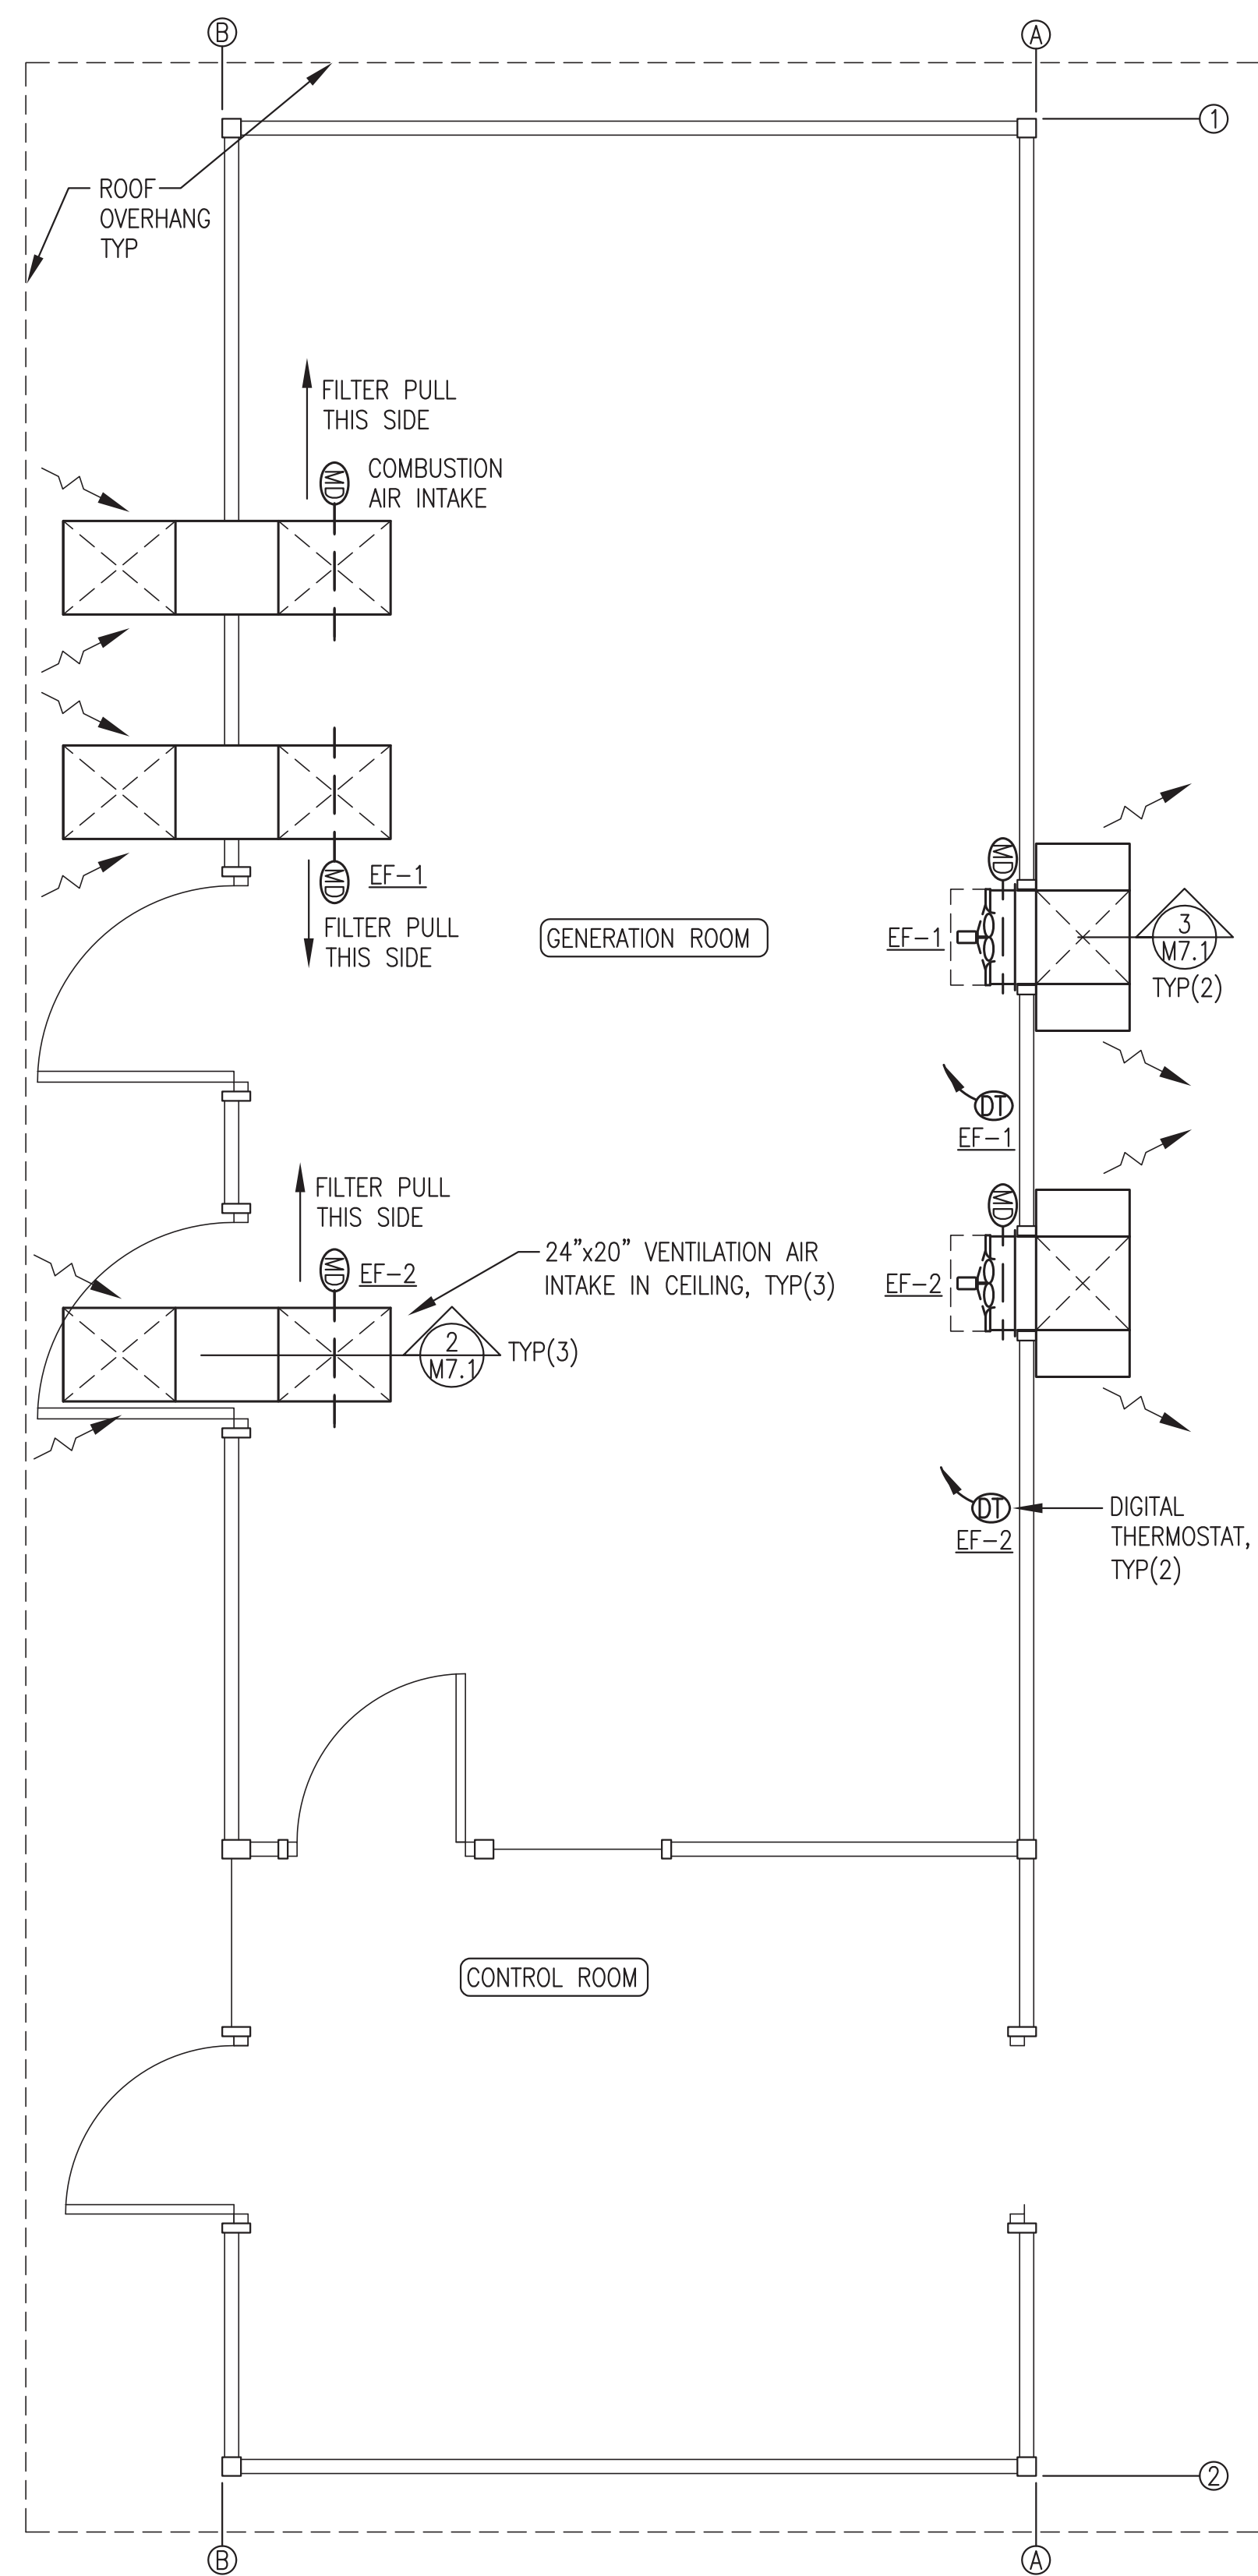


1
M7.1 VENTILATION PLAN
3/8"=1'-0"

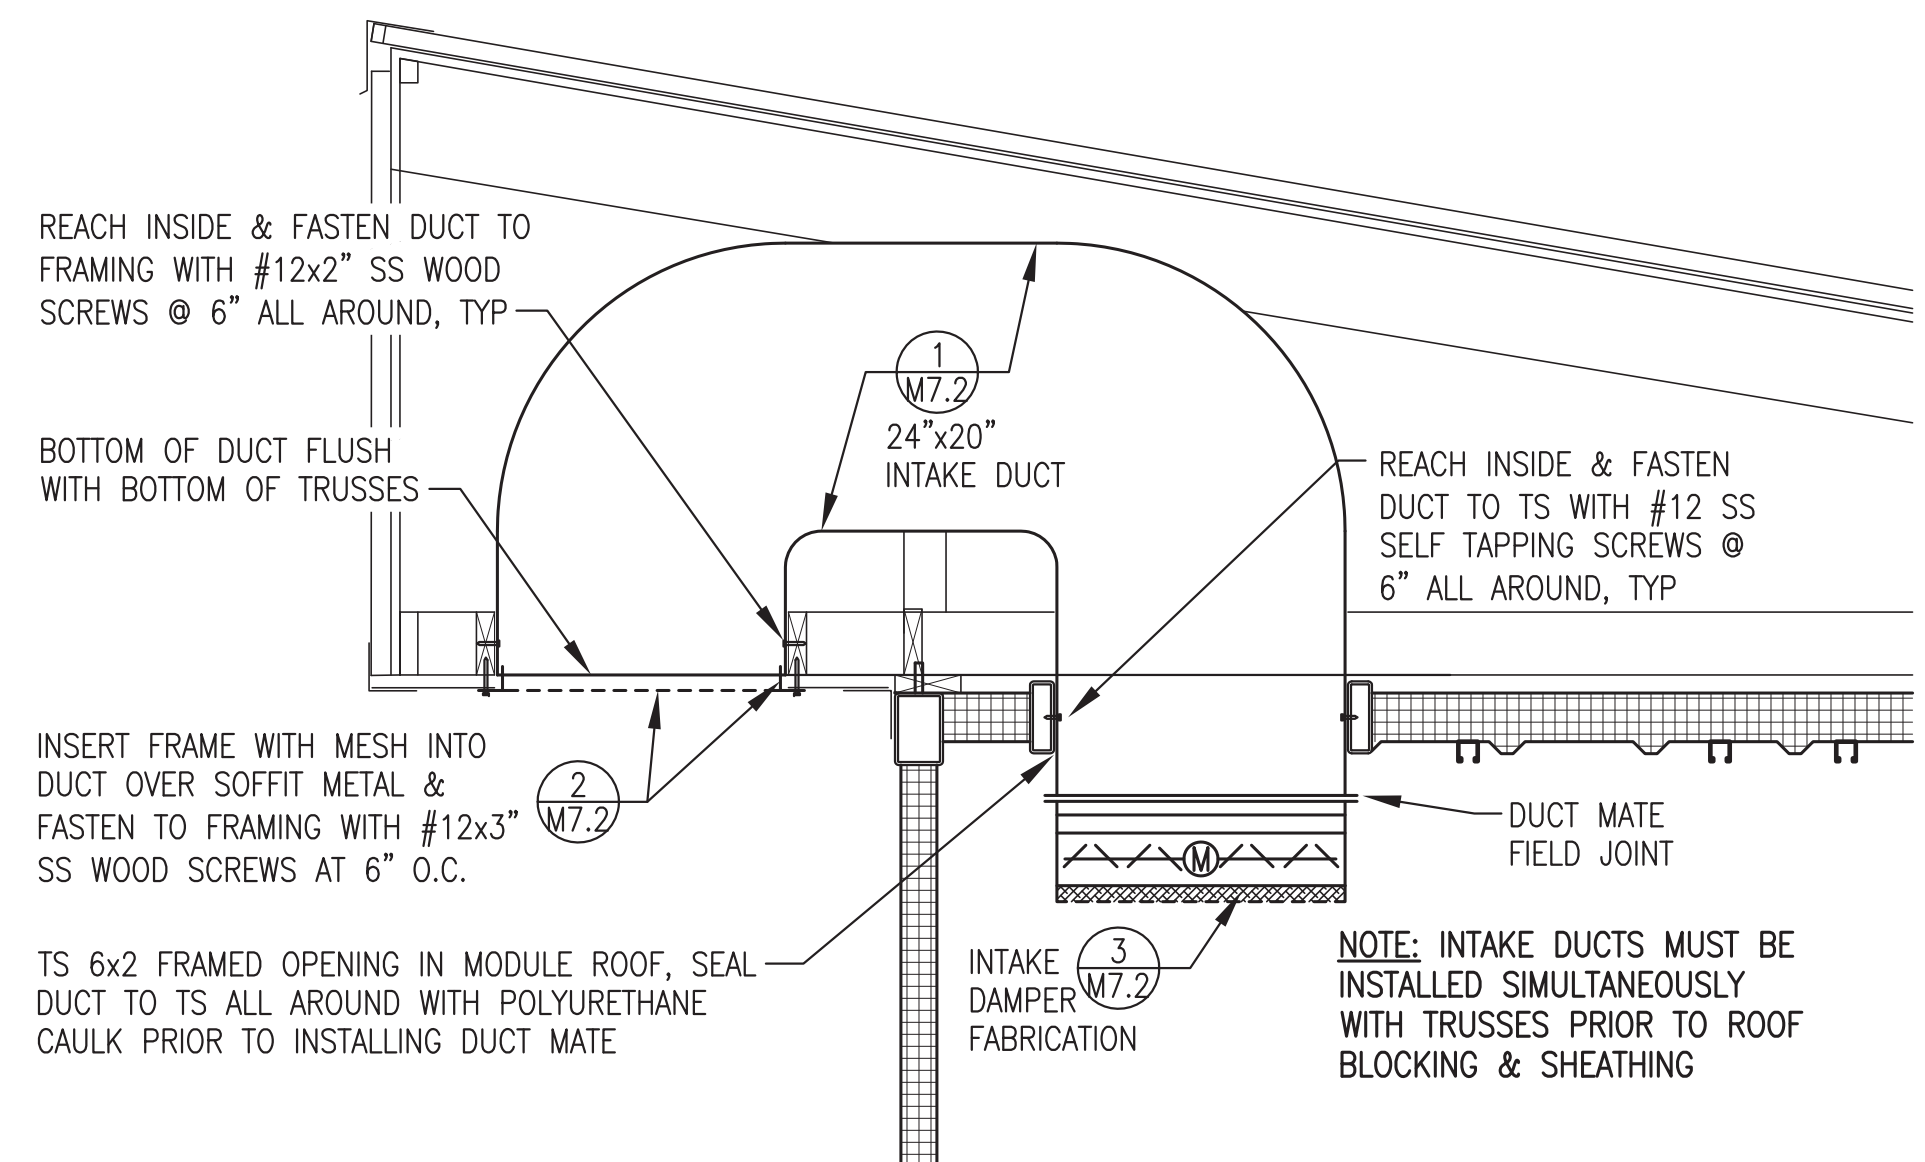

2
M7.1 INTAKE DUCT INSTALLATION
3/4"=1'-0"

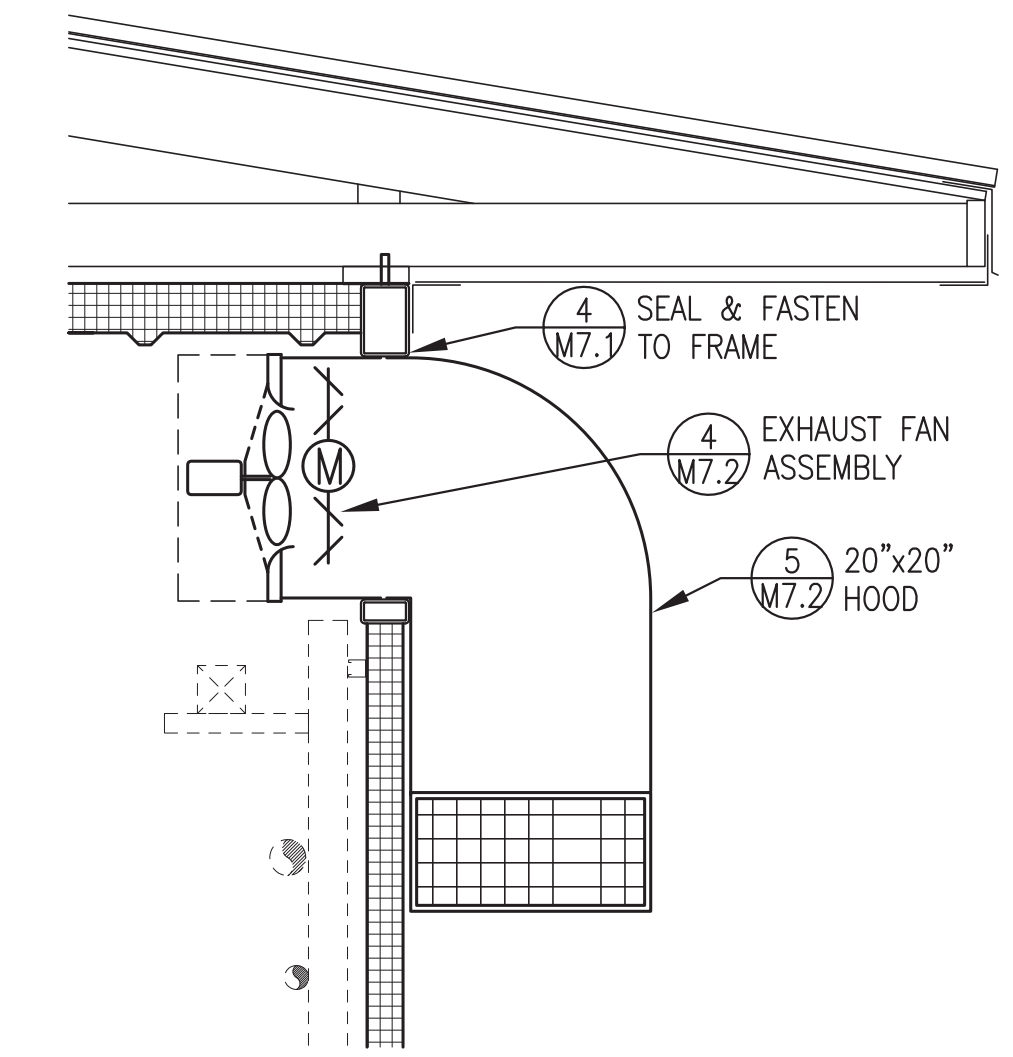

3
M7.1 EXHAUST FAN INSTALLATION
3/4"=1'-0"

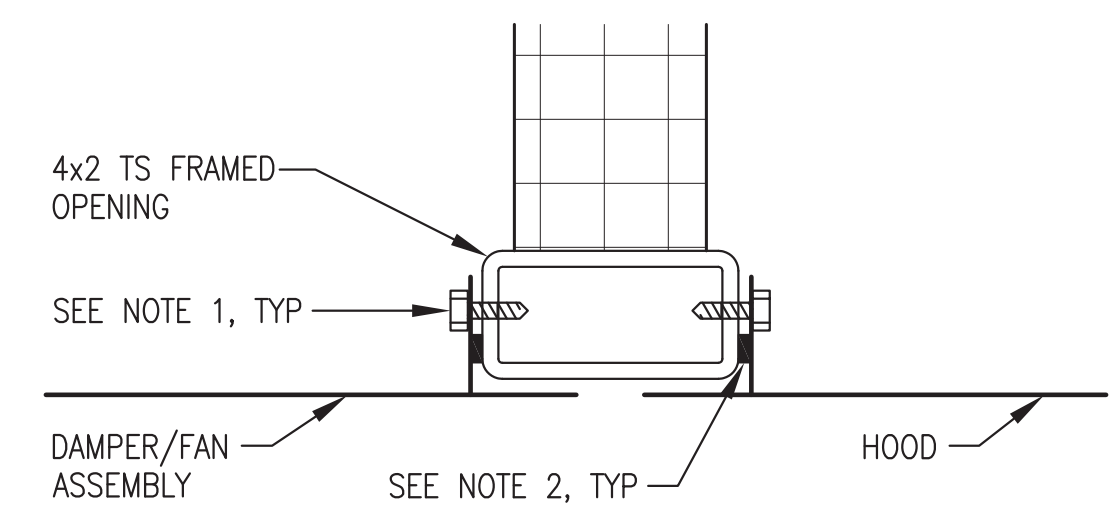

- NOTES:**
- 1) FASTEN MOUNTING FLANGE TO TS WITH #12 STAINLESS STEEL SELF TAPPING SCREWS. ON HOODS FASTEN ON TOP AND SIDES ONLY. ON EXHAUST FANS FASTEN ON SIDES ONLY.
 - 2) SEAL MOUNTING FLANGE TO TS WITH CONTINUOUS BEAD OF POLYURETHANE CAULKING ALL AROUND.

4
M7.1 TYPICAL WALL PENETRATION
4"=1'-0"


VENTILATION SYSTEM SHOP/ON-SITE NOTES:

- 1) FURNISH ENTIRE VENTILATION SYSTEM AS PART OF MODULE SHOP FABRICATION.
- 2) DURING SHOP FABRICATION INSTALL EXHAUST FAN ASSEMBLY. TEST FIT EXTERIOR HOODS AND INTAKE DUCTS BUT DO NOT INSTALL.
- 3) DURING SHOP FABRICATION TEMPORARILY CONNECT INTAKE DAMPERS TO ELECTRICAL ROUGH IN AND TEST TO VERIFY FUNCTION. SEE SHEET E4.2.
- 4) AS PART OF ON-SITE WORK INSTALL EXHAUST HOODS AND INTAKE DUCTING AS INDICATED.


ISSUED FOR
CONSTRUCTION
JANUARY 2019



ALASKA ENERGY AUTHORITY		
PROJECT:	PORT HEIDEN RURAL POWER SYSTEM POWER PLANT UPGRADE	
TITLE:	VENTILATION PLAN & DETAILS	
DRAWN BY: JTD	SCALE: AS NOTED	DATE: 1-14-19
DESIGNED BY: BCG	FILE NAME: PTH PPU M2-7	SHEET: M7.1 OF 7
P.O. 111405, Anchorage, AK 99511 (907)349-0100		

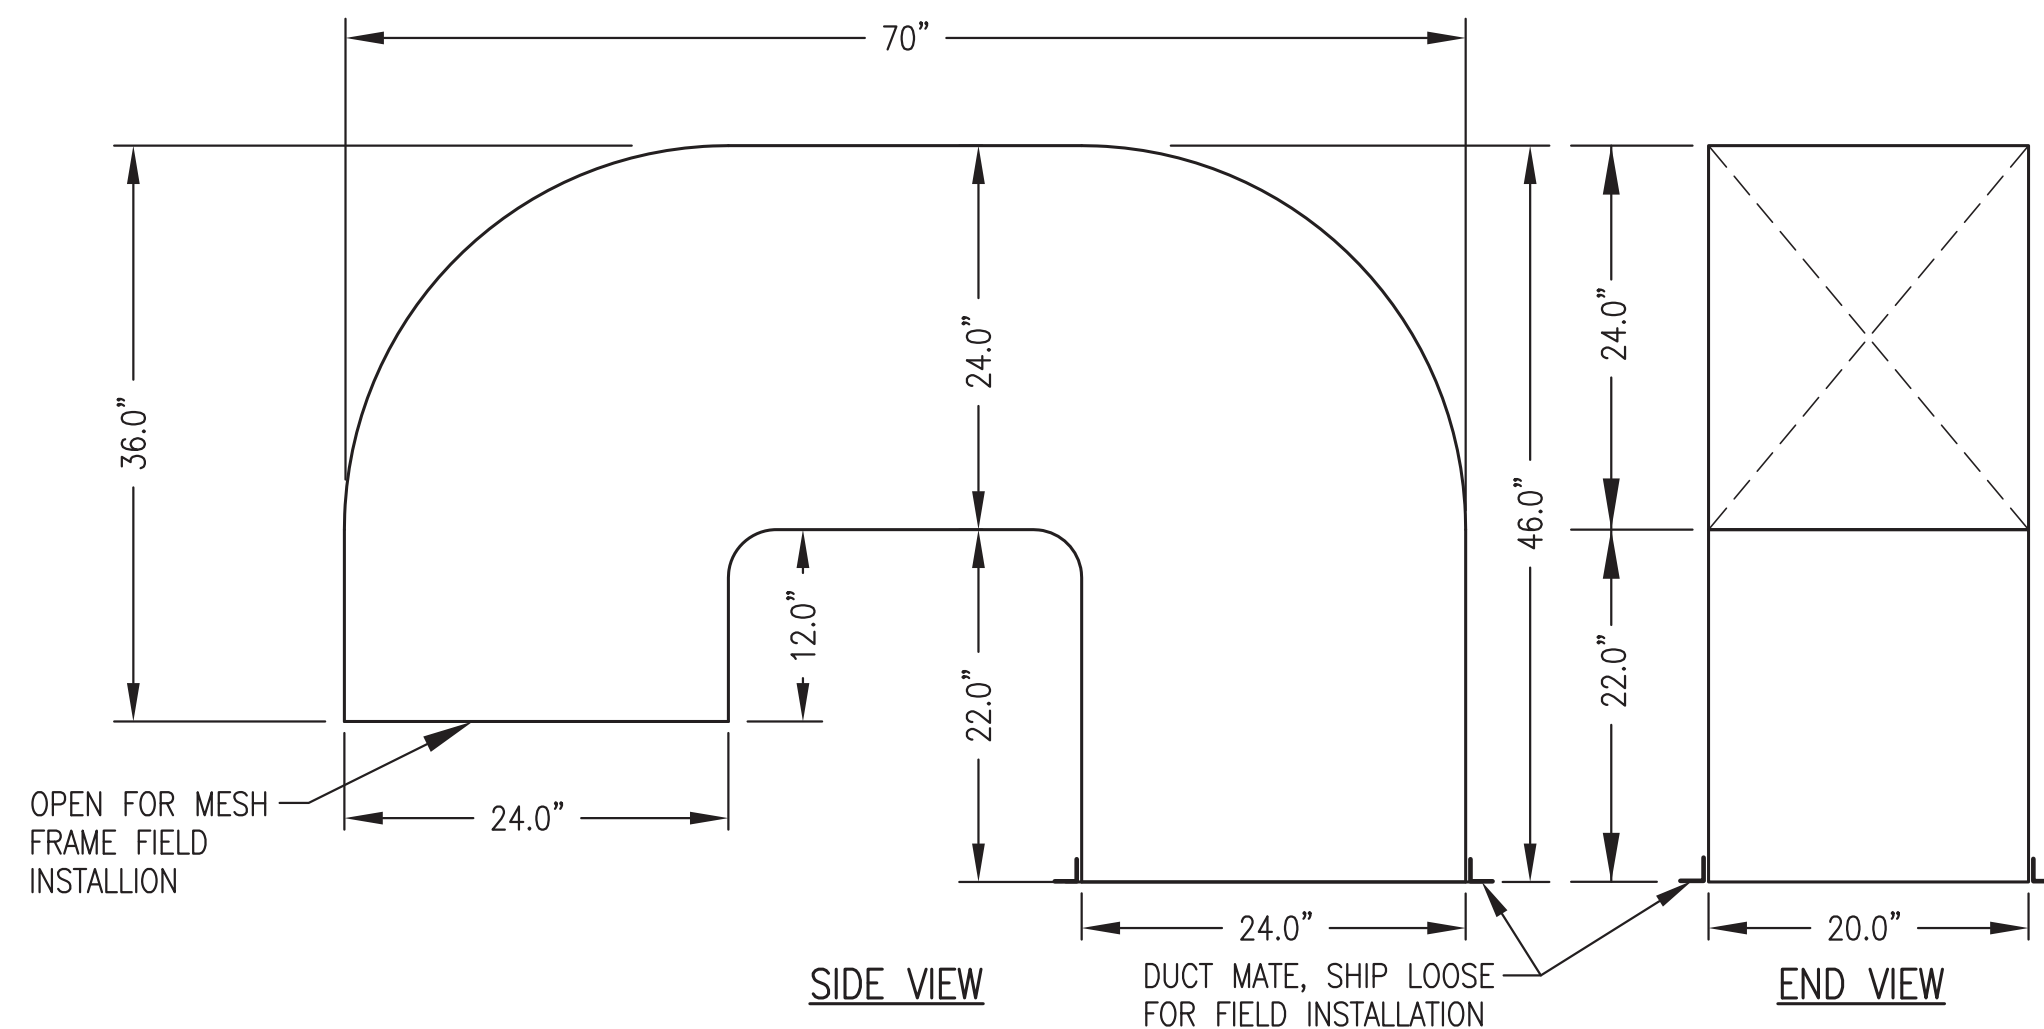


NOTE: FABRICATE 3 IDENTICAL DUCTS FROM MIN 18 GAUGE GALV SHEET METAL WITH SEALED MECHANICAL JOINTS OR AT CONTRACTORS OPTION 0.090" THICK TYPE 5052 ALUMINUM WITH ALL WELDED SEAMS.

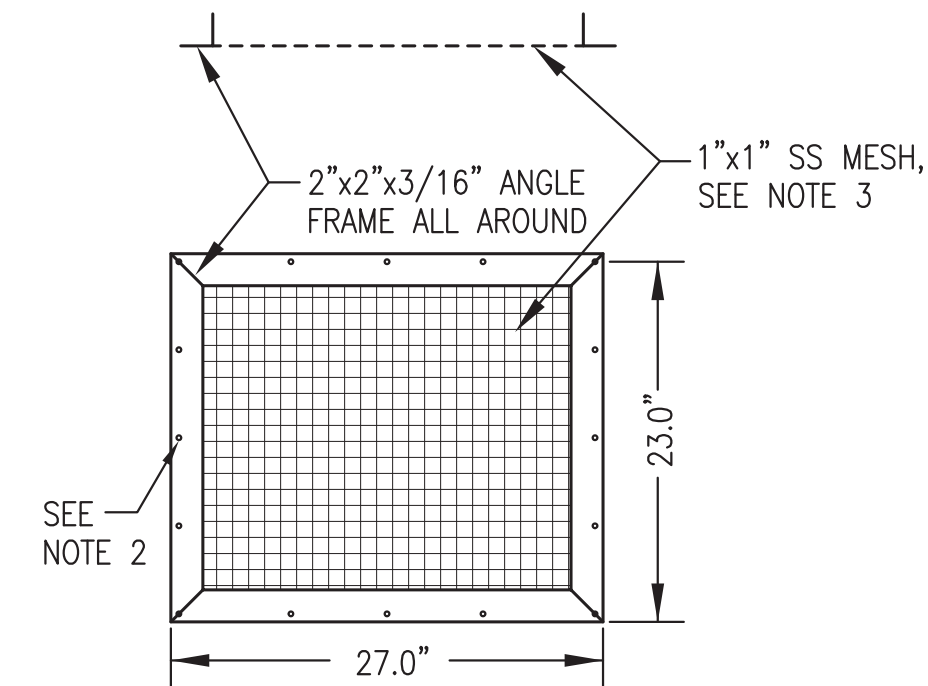

NOTES:

- FABRICATE 3 IDENTICAL AIR INTAKE MESH FRAMES.
- FABRICATE FRAME FROM 2"x2"x3/16" ALUMINUM ANGLE WITH MITERED AND WELDED CORNERS AND 1/4" HOLES AT 6" O.C. ALL AROUND, 1/2" FROM OUTSIDE EDGE OF FRAME.
- INSTALL 1"x1" STAINLESS STEEL WIRE MESH IN HEMMED STAINLESS STEEL FRAME AND FASTEN TO ANGLE FRAME WITH STAINLESS STEEL SCREWS ALL AROUND.

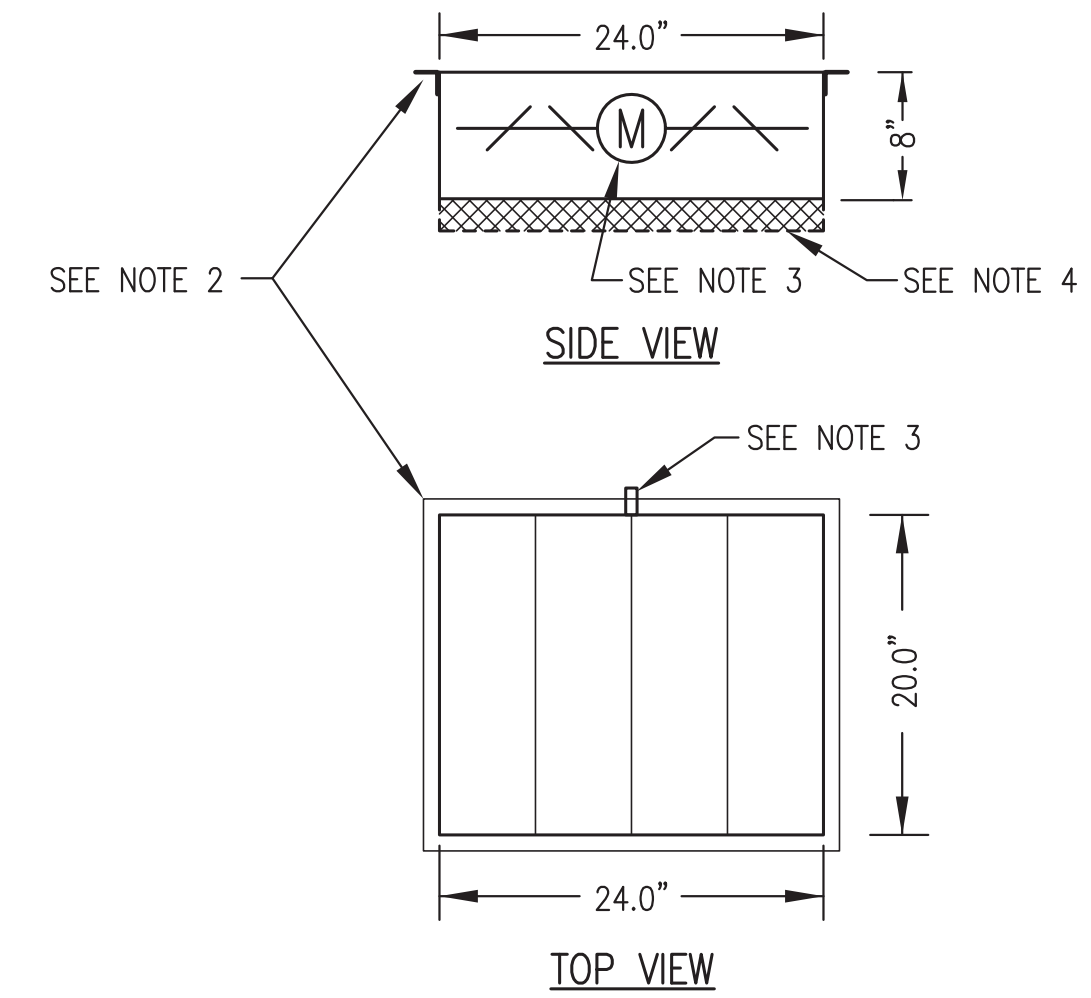


NOTES:

- FABRICATE 3 IDENTICAL VENTILATION INTAKE ASSEMBLIES.
- SHOP MOUNT DUCTMATE FLANGE.
- PROVIDE MIN 3" DAMPER ROD EXTENSION ON SIDE INDICATED AND FABRICATE SHEET METAL STAND-OFF BRACKET TO FULLY SUPPORT THE ACTUATOR FROM THE DAMPER FRAME.
- INSTALL FRAME FOR REMOVABLE 24"x24"x2" FURNACE FILTERS. FABRICATE FROM "C" CHANNEL THREE SIDES WITH LATCHING HINGED COVER ON FOURTH SIDE TO ALLOW FILTERS TO SLIDE OUT. SEE PLAN VIEW FOR DAMPER ACTUATOR AND FILTER PULL ORIENTATION. EXTEND FILTER FRAME 2"± BEYOND DAMPER FRAME EACH WAY ON NARROW DIMENSION.

1 INTAKE DUCT FABRICATION
M7.2 1"=1'-0"


2 INTAKE MESH FRAME
M7.2 1"=1'-0"

3 INTAKE AIR DAMPER FABRICATION
M7.2 1"=1'-0"

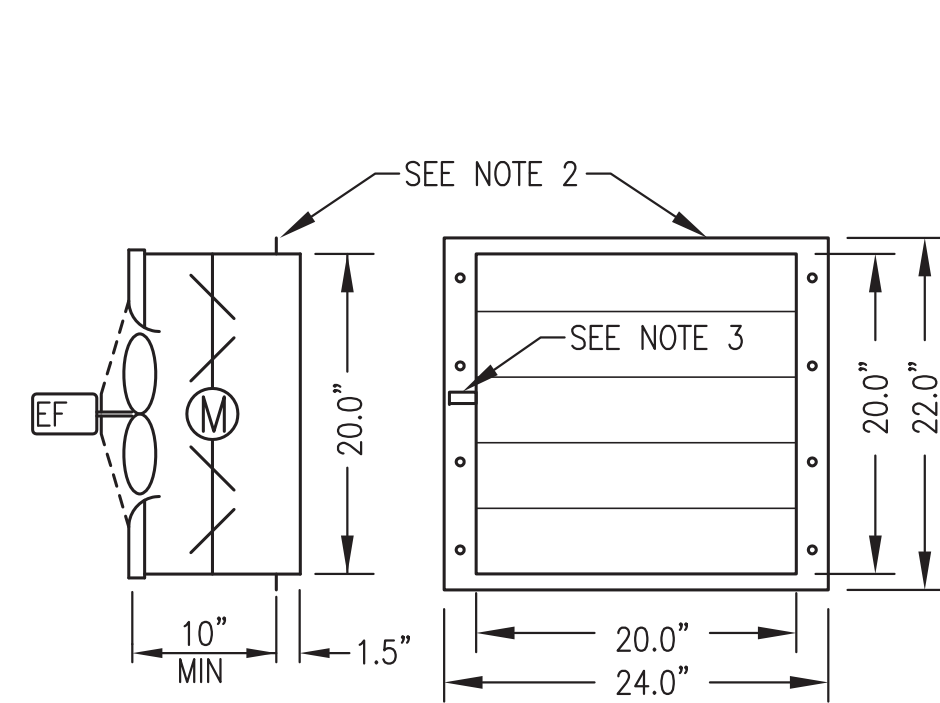

NOTES:

- FABRICATE 2 IDENTICAL ASSEMBLIES COMPLETE WITH FAN AND DAMPER MOUNTED AND SEALED TO DUCT.
- PROVIDE 2" WIDE MOUNTING FLANGE ON SIDES WITH 1/4" HOLES AT 5" O.C. PROVIDE 1" MOUNTING FLANGE ON TOP AND BOTTOM WITHOUT HOLES.
- PROVIDE MIN 3" DAMPER ROD EXTENSION ON THE LEFT SIDE AND FABRICATE SHEET METAL STAND-OFF BRACKET TO FULLY SUPPORT THE ACTUATOR FROM THE DAMPER FRAME.

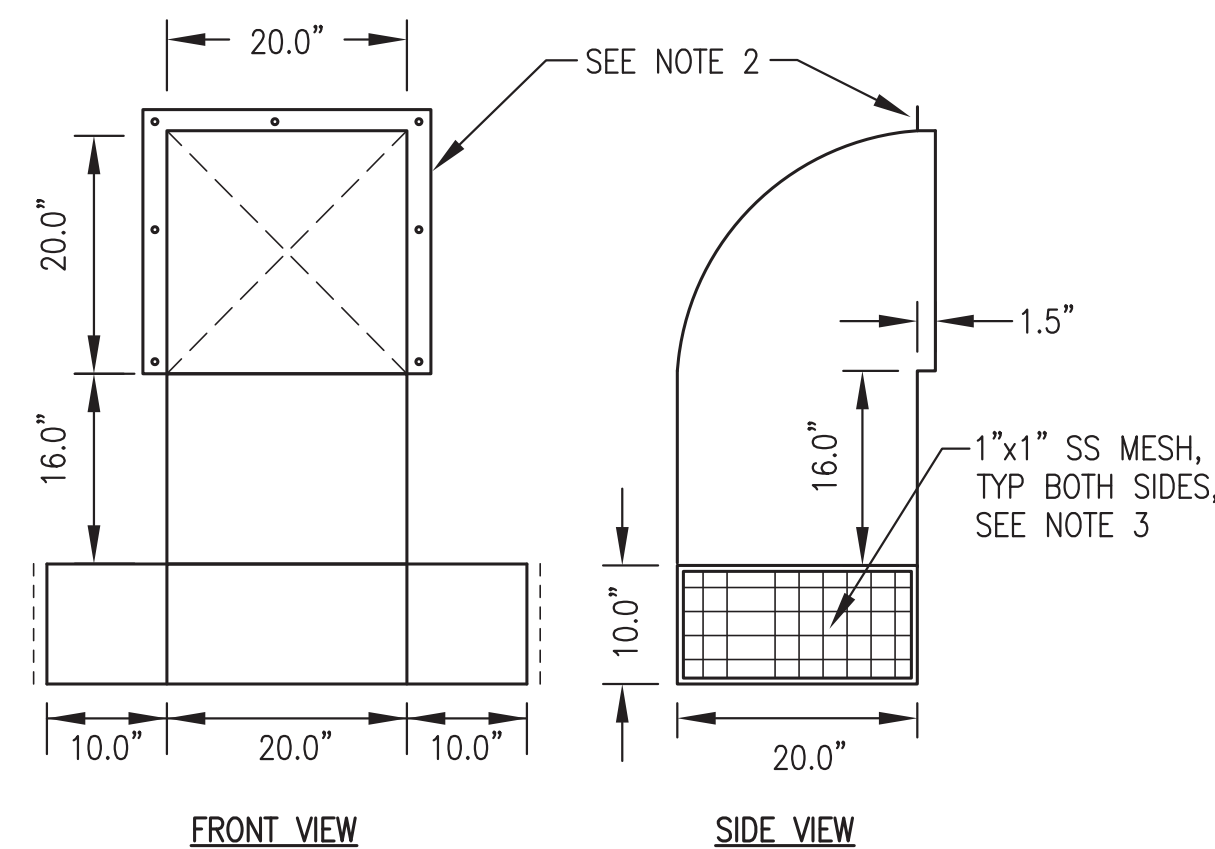


NOTES: 1) FABRICATE 2 IDENTICAL HOODS FROM 0.090" THICK TYPE 5052 ALUMINUM WITH ALL WELDED SEAMS.

- PROVIDE 2" WIDE MOUNTING FLANGE ON TOP & SIDES WITH 1/4" HOLES AT 9" O.C.
- INSTALL 1"x1" STAINLESS STEEL WIRE MESH IN HEMMED STAINLESS STEEL FRAME AND FASTEN TO ANGLE FRAME WITH STAINLESS STEEL SCREWS ALL AROUND.

4 EXHAUST FAN ASSEMBLY FABRICATION
M7.2 1"=1'-0"


5 EXHAUST HOOD FABRICATION
M7.2 3/4"=1'-0"

ISSUED FOR
CONSTRUCTION
JANUARY 2019

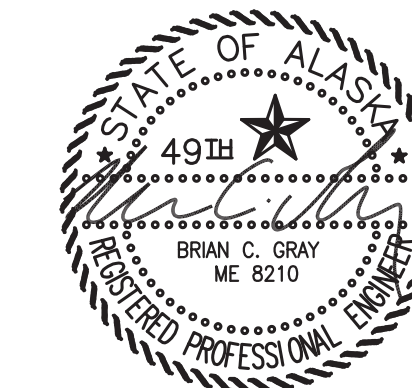


ALASKA ENERGY AUTHORITY

PROJECT:	PORT HEIDEN RURAL POWER SYSTEM POWER PLANT UPGRADE	
TITLE:	VENTILATION FABRICATION DETAILS	
DRAWN BY: JTD	SCALE: AS NOTED	DESIGNED BY: BCG
FILE NAME: PTH PPU M2-7	PROJECT NUMBER:	SHEET: M7.2 OF 7
P.O. 111405, Anchorage, AK 99511 (907)349-0100		

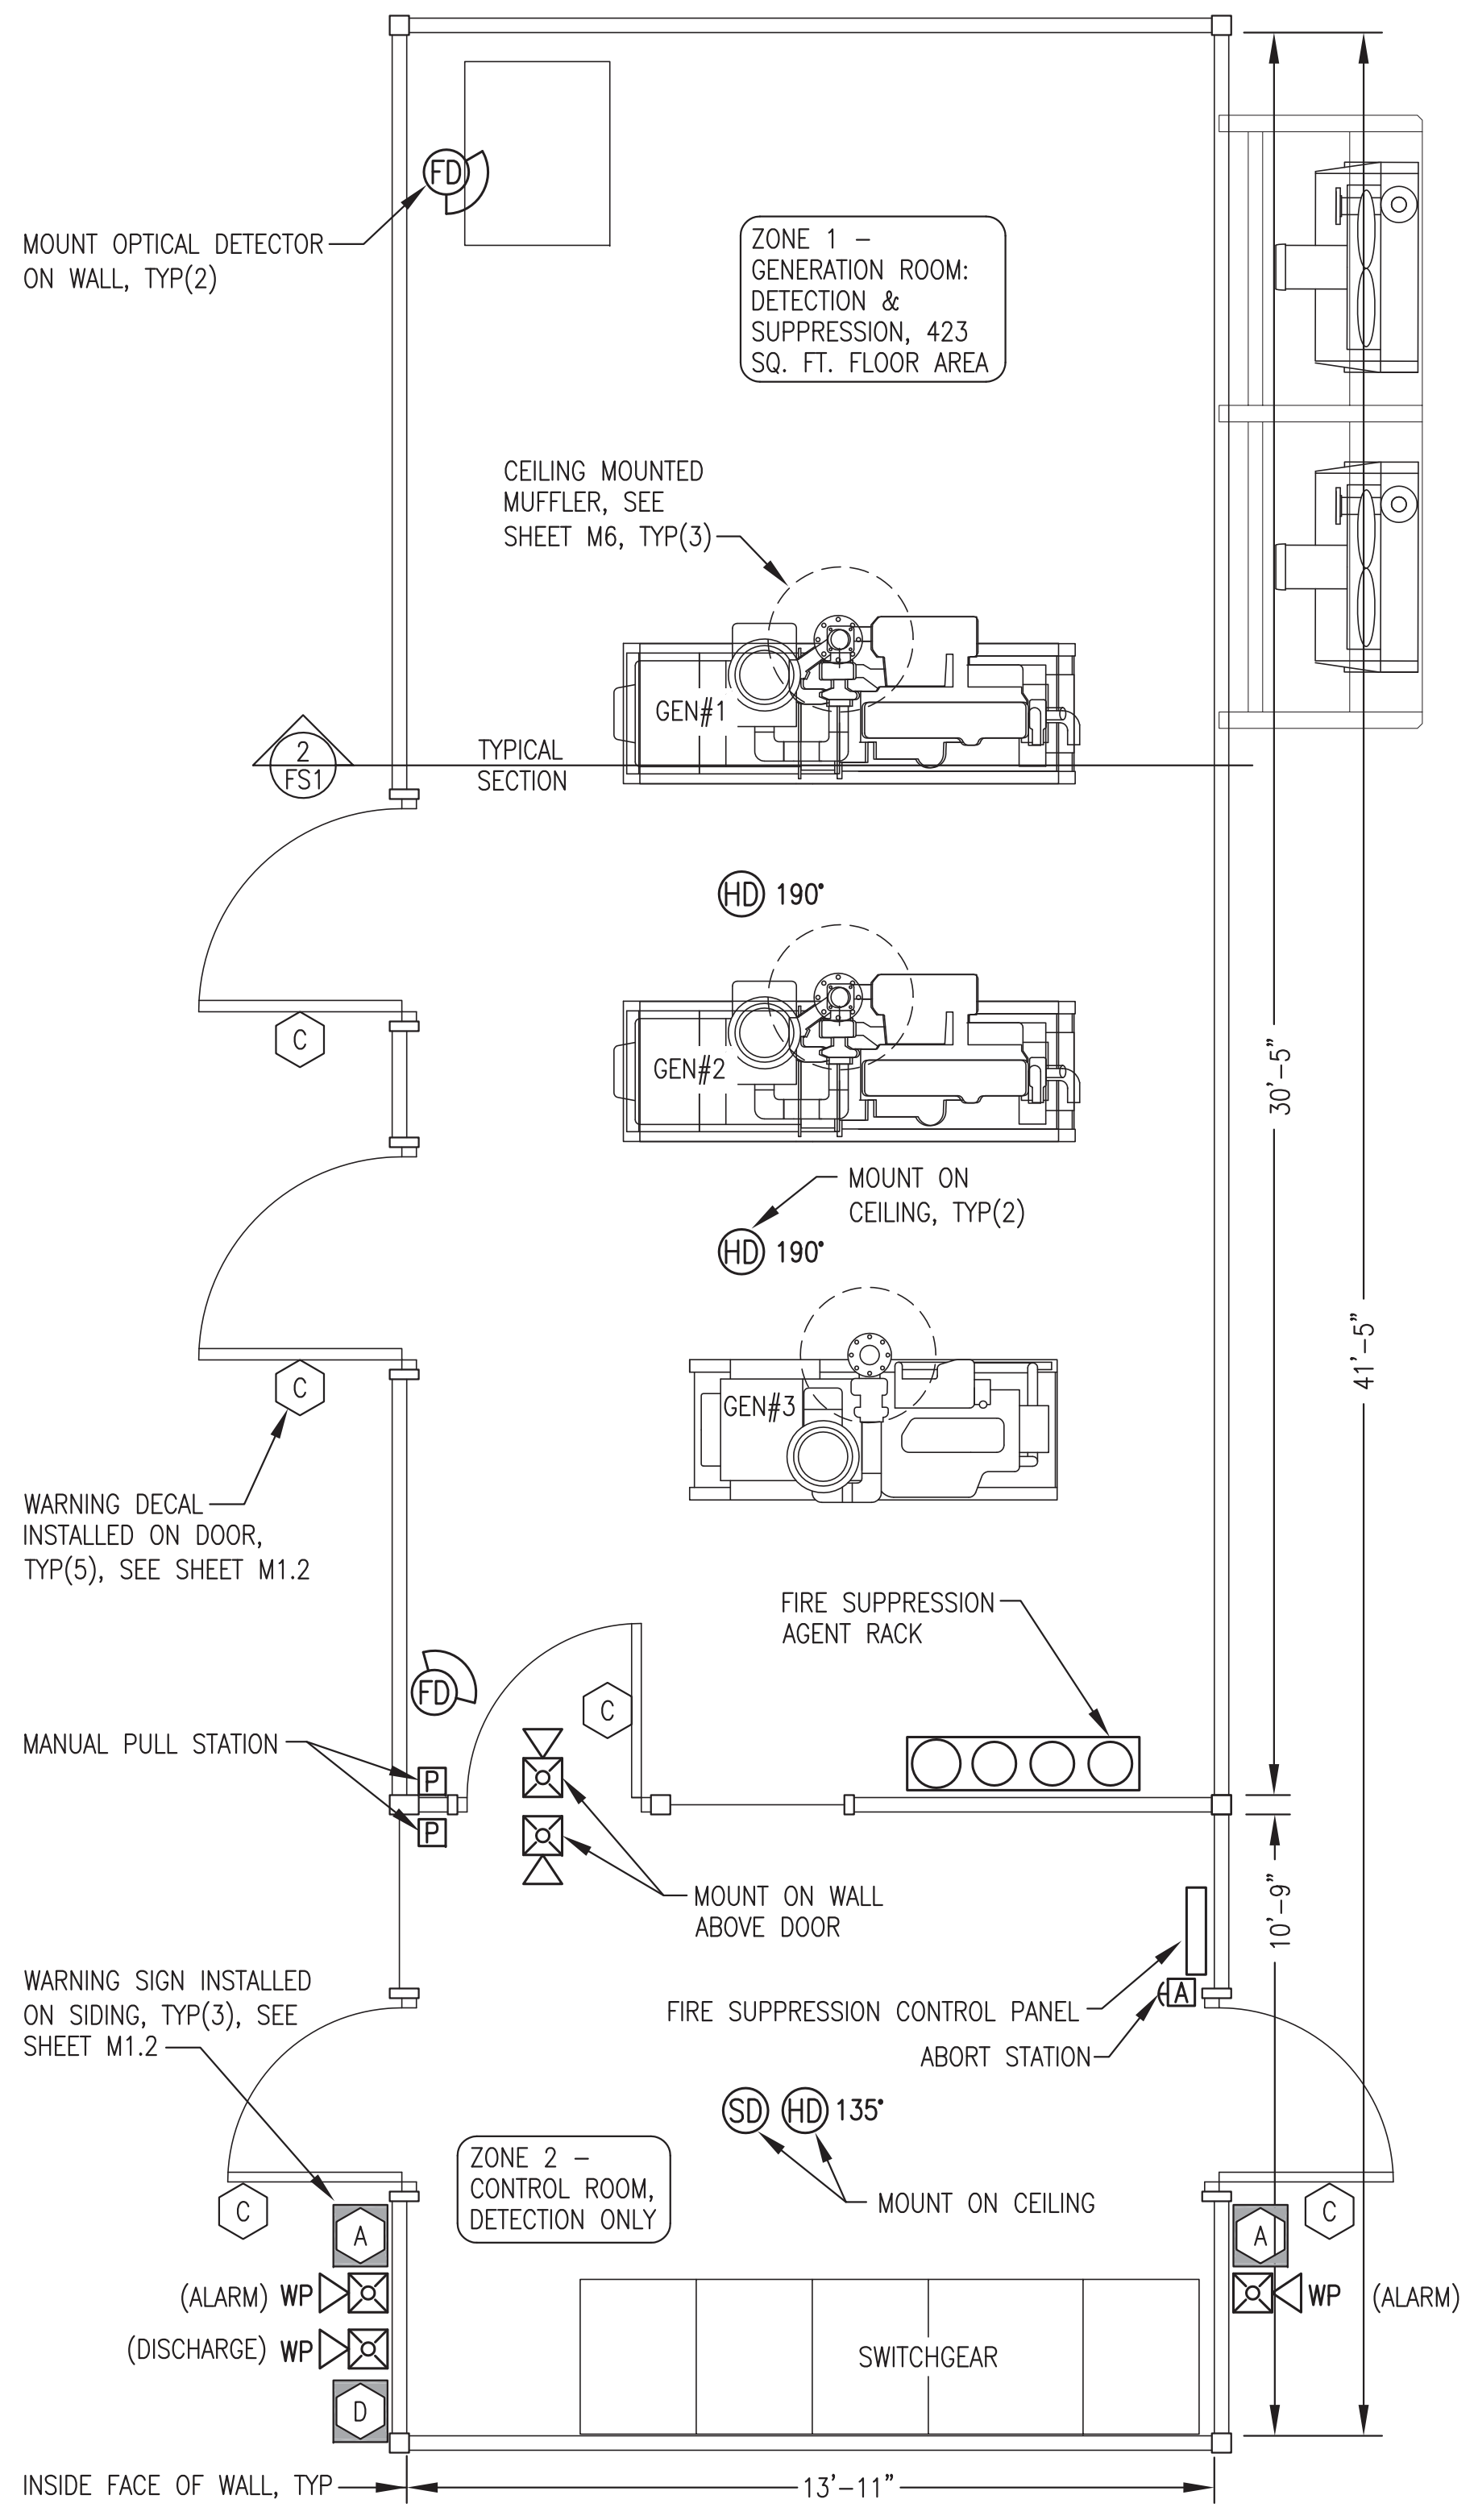

1 FIRE SUPPRESSION SYSTEM PLAN
 FS1 3/8"=1'-0"

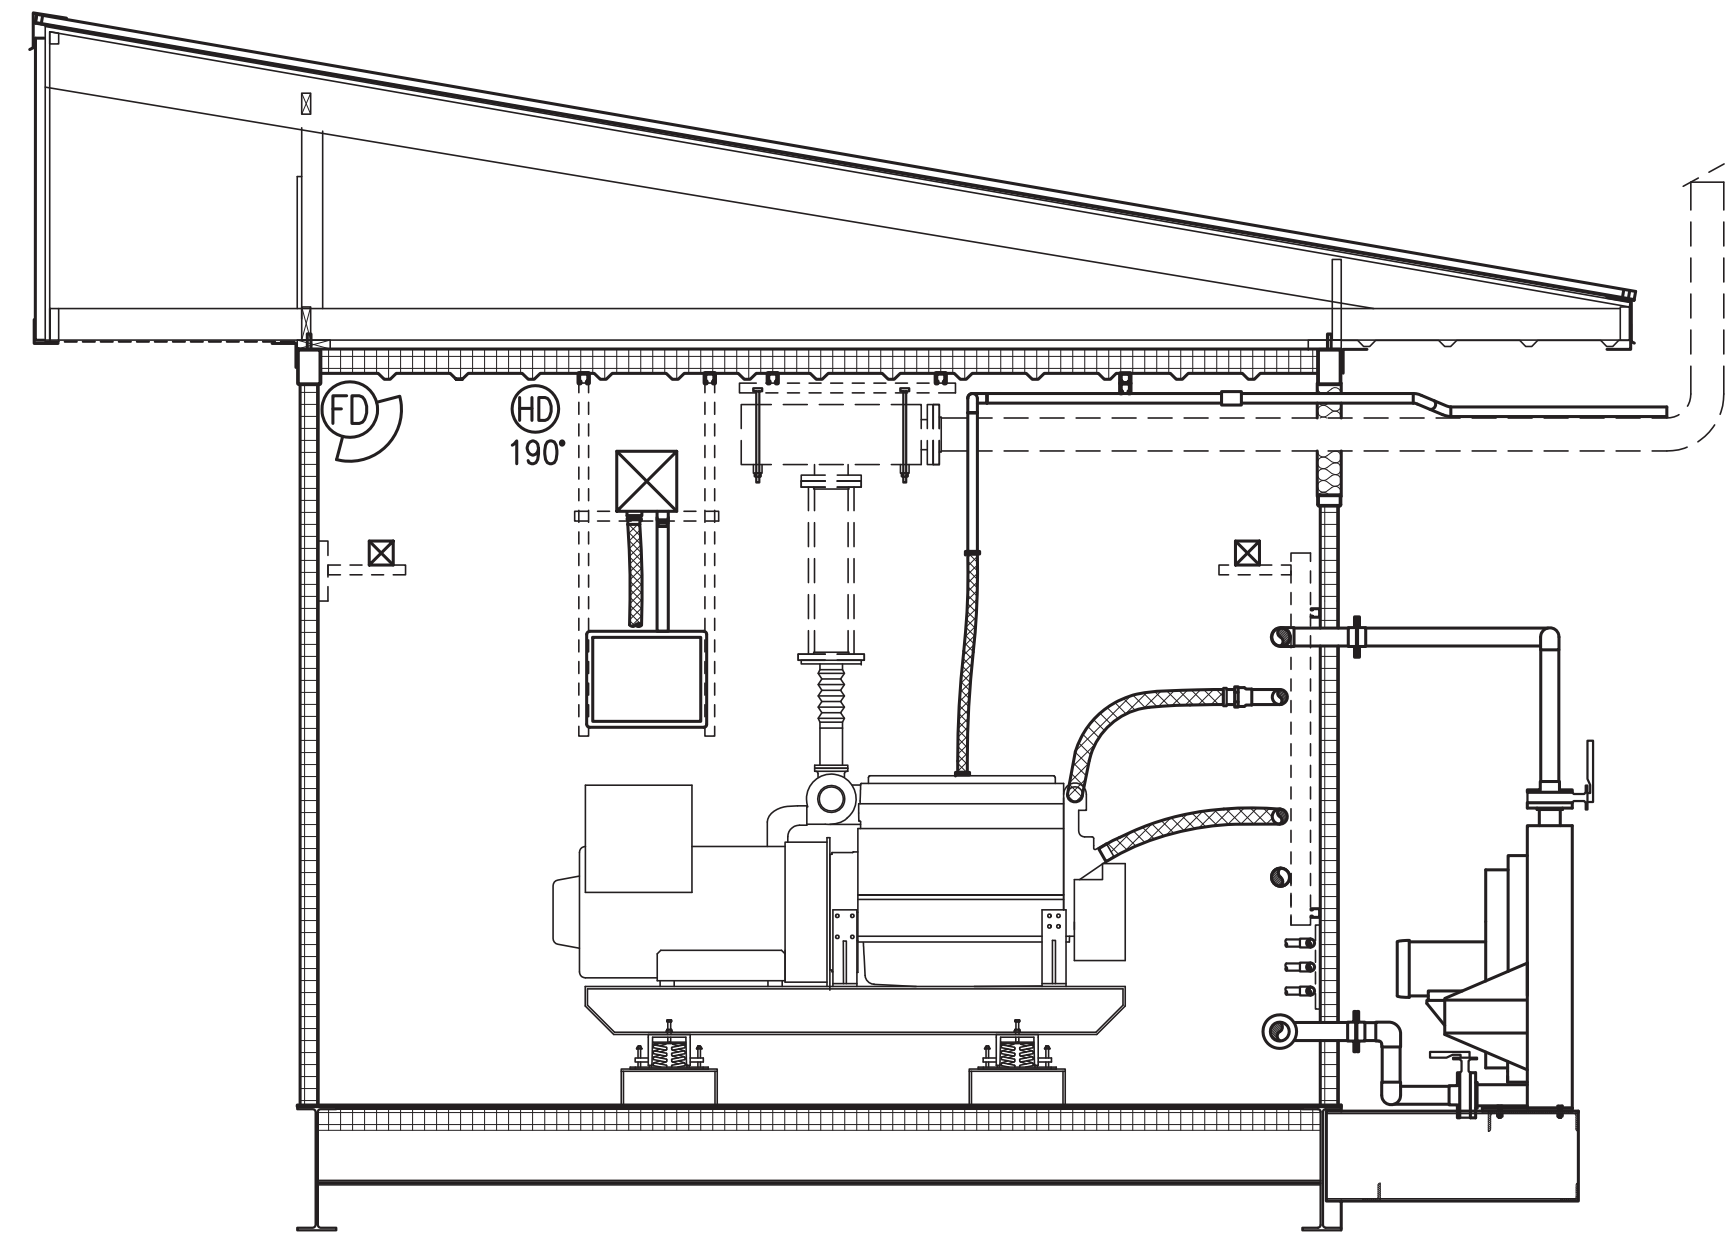

2 TYPICAL SECTION THROUGH MODULE
 FS1 3/8"=1'-0"

- FIRE SUPPRESSION GENERAL NOTES:**
- INTERIOR FINISH OF ALL WALLS, FLOOR, AND CEILING WELDED STEEL PLATE. CEILING HEIGHT IN ALL ROOMS 10'-2" ABOVE FINISHED FLOOR.
 - ALL DOORS SELF-CLOSING WITH GASKETS. ALL BUILDING PIPING AND CONDUIT PENETRATIONS SEALED LIQUID TIGHT. ALL BUILDING DUCT PENETRATIONS EQUIPPED WITH MOTORIZED DAMPERS THAT CLOSE ON GENERATOR SHUT DOWN.
- FIRE SUPPRESSION SHOP/ON-SITE NOTES:**
- UPON COMPLETION OF MODULE SHOP TESTING: DISCONNECT BATTERIES. DRAIN ALL WATER OUT OF THE SYSTEM AND BLOW OUT WITH AIR TO PREVENT FREEZE DAMAGE. LEAVE ONE FULLY CHARGED NITROGEN CYLINDER INSTALLED IN THE RACK PLUS ONE LOOSE SHIP FULLY CHARGED SPARE NITROGEN CYLINDER.
 - DURING ON-SITE CONSTRUCTION: FILL BOTTLES WITH CLEAN POTABLE WATER IN ACCORDANCE WITH MANUFACTURER'S REQUIREMENTS. FULLY TEST AND CERTIFY SYSTEM. TRAIN AEA STAFF AND LOCAL OPERATORS.

FIRE SUPPRESSION SYMBOL LEGEND			
SYMBOL	DESCRIPTION	SYMBOL	DESCRIPTION
[P]	MANUAL PULL STATION	(HD)135'	NORMAL TEMP. (135°F) DETECTOR
[A]	ABORT STATION	(HD)190'	HIGH TEMP. (190°F) DETECTOR
[X]	INTERIOR ALARM HORN/STROBE	(FD)	FLAME (OPTICAL) DETECTOR
[X] WP	EXTERIOR ALARM HORN/STROBE	(SD)	SMOKE (IONIZATION) DETECTOR

FIRE SUPPRESSION PLACARD SCHEDULE	
SYMBOL	DESCRIPTION
[A]	"FIRE ALARM"
[C]	"CAUTION, ROOM PROTECTED BY WATER MIST FIRE PROTECTION SYSTEM, IN CASE OF FIRE KEEP DOOR CLOSED AND DO NOT ENTER"
[D]	"FLASHING LIGHT MEANS FIRE SUPPRESSION AGENT HAS DISCHARGED"

FIRE SUPPRESSION WIRE SCHEDULE			
SYMBOL	CIRCUIT DESCRIPTION	WIRE TYPE	WIRE COLOR
A	24V DC POWER	#14 AWG SOLID	RED & BLACK
B	DETECTION CIRCUITS	#14 AWG SOLID	BLUE & YELLOW
C	ANNUNCIATION ALARM	#14 AWG SOLID	BROWN & ORANGE
D	ANNUNCIATION DISCHARGE	#14 AWG SOLID	WHITE, & GRAY
E	24V DC AUX POWER	#14 AWG SOLID	RED & BLACK WITH GRAY STRIPE

ISSUED FOR CONSTRUCTION
 JANUARY 2019



 ALASKA ENERGY AUTHORITY		
PROJECT:	PORT HEIDEN RURAL POWER SYSTEM POWER PLANT UPGRADE	
TITLE:	FIRE SUPPRESSION SYSTEM PLAN, SECTION, LEGEND, & NOTES	
 Gray Stassel Engineering, Inc. P.O. 111405, Anchorage, AK 99511 (907)349-0100	DRAWN BY: BCG DESIGNED BY: BCG FILE NAME: PTH PPU FS1 PROJECT NUMBER:	SCALE: AS NOTED DATE: 1-14-19 SHEET: FS1 OF 1

EQUIPMENT REQUIREMENTS FOR APPROVED EQUALS (APPLIES TO ALL SCHEDULES):
 SPECIFIC PARTS MANUFACTURER AND MODEL SELECTED NOT ONLY TO MEET PERFORMANCE FUNCTION BUT ALSO TO
 COORDINATE AND INTERFACE WITH OTHER DEVICES AND SYSTEMS. APPROVED EQUAL SUBSTITUTIONS WILL BE ALLOWED
 ONLY BY ENGINEER'S APPROVAL. TO OBTAIN APPROVAL, SUBMITTALS MUST CLEARLY DEMONSTRATE HOW SUBSTITUTE ITEM
 MEETS OR EXCEEDS SPECIFIED ITEM QUALITY AND PERFORMANCE CHARACTERISTICS AND ALSO COMPLIES WITH MECHANICAL
 AND/OR ELECTRICAL CONNECTIONS AND PHYSICAL LAYOUT REQUIREMENTS.

ELECTRICAL EQUIPMENT SCHEDULE

SYMBOL	SERVICE/FUNCTION	DESCRIPTION	MANUFACTURER/MODEL
1	DAY TANK ALARM HORN/STROBE	MULTI-TONE ALARM WITH STROBE, 115V, NEMA 3R, WEATHER RESISTANT SURFACE MOUNT BELL BOX	WHEELLOCK MT4-115-WH-VNS
2	DIGITAL THERMOSTAT	MULTIPLE OUTPUT MODULATING DIGITAL THERMOSTAT	HONEYWELL TB7980B
3	LINE VOLTAGE THERMOSTAT	HEATING/COOLING THERMOSTAT, 16 FLA @ 120V, SPDT, 50F TO 80F RANGE.	DAYTON 1UHH2
4	AREA LIGHT	AREA LIGHT, WIDE DISPERSION WALL PACK WITH PHOTO CONTROL. LED, 17.7W, 120-277V DRIVER	HUBBELL NRG-356L-5K-U-PC
5	EMERGENCY LIGHT	WALL MOUNT, WHITE 20 GA STEEL ENCLOSURE, 277/120VAC, 8.4A INPUT, SEALED LEAD-ACID BATTERY, DUAL 5.3W 6VDC LED LAMPS	HUBBEL DUAL-LITE CCU2
6	EMERGENCY/EXIT LIGHT COMBO	WHITE PLASTIC ENCLOSURE, RED EXIT SIGN, 277/120V INPUT, DUAL 1.5W 9.6V LED LAMPS. OPTIONAL HIGH OUTPUT NI-CAD BATTERY	LITHONIA LHQM-LED-R-HO OR EQUAL
7	NOT USED	NOT USED	NOT USED
8	MODULE INTERIOR LIGHTING	SURFACE MOUNTED LED STRIPLIGHT FIXTURE, 48" LONG, 34W, 5000K WITH SNAP ON FROSTED DIFFUSER	LITHONIA L1N-L48-5000LM-FST
9	TIMER SWITCH	0-5 MINUTE, 120V, 20A, 1HP RATED, INSTALL IN 4"x4" PRESSED STEEL BOX WITH METAL COVER.	INTERMATIC FF5M
10	LIGHT SWITCH	SINGLE POLE SNAP SWITCH, 120V, 20A, METAL, 1-1/2HP RATED, INSTALL IN 4"x4" STEEL BOX WITH METAL COVER, IVORY.	HUBBELL 1221-I
11	1Ø SMALL MOTOR DISCONNECT	SINGLE POLE SNAP SWITCH WITH RED PILOT LIGHT, 120V, 20A, 1-1/2HP RATED, INSTALL IN 4"x4" STEEL BOX WITH METAL COVER	HUBBELL 1221-PL
12	NOT USED	NOT USED	NOT USED
13	STATION SERVICE TRANSFORMER	DRY TYPE, ENERGY STAR, ENCLOSURE TYPE 3R WITH INTEGRAL WALL MOUNT BRACKETS, 9 KVA, HV 480 DELTA, LV 208Y/120	HAMMOND HPS C3F009KBS WITH NQT6 CASE
14	STATION SERVICE PANELBOARD	COPPER BUS, 3 PHASE, 4 WIRE, 120/208V, 100A, 30 CIRCUITS, BOLT-IN BREAKERS, SURFACE MOUNT, NEMA 1	SIEMENS OR SQUARE D
15	STANDARD RECEPTACLE	SURFACE MOUNT 125V NEMA 5-20R RECEPTACLE. INSTALL IN 4"x4" STEEL BOX WITH METAL COVER	PASS & SEYMOUR 5362W
16	EXTERIOR GFCI RECEPTACLE	125V NEMA 5-20R GFCI RECEPTACLE. MOUNT IN CAST FDA BOX WITH WEATHERPROOF COVER	PASS & SEYMOUR 2095-W
17	BATTERY CHARGER	12/24-VOLT SOLID STATE 20-AMP AUTO-EQUALIZING BATTERY CHARGER FOR 120 VAC INPUT, WITH OPTIONAL HIGH/LOW VOLTAGE, AC POWER FAILURE, & REMOTE SUMMARY ALARM RELAYS	SENS NRC22-20-RCLS OR CHARLES 93-INCHGR20-A
18	WELDER/COMPR. RECEPTACLE	NEMA 6-30R, BLACK, 250V, 30A, 2 POLE, WITH GROUND. INSTALL IN DEEP 4"x4" STEEL BOX WITH 2.15"Ø HOLE METAL COVER	PASS & SEYMOUR 3801
19	NOT USED	NOT USED	NOT USED
20	RADIATOR MOTOR DISCONNECT	NON-FUSED LOCKABLE SAFETY SWITCH, NEMA 3R ENCLOSURE, 3PST, 600V, 30A, MIN 5HP RATED	SIEMENS HNF361R OR SQUARE D HU361R
21	24VAC CONTROL TRANSFORMER	120V PRIMARY, 24V SECONDARY, 75VA OUTPUT, PLATE MOUNT, INSTALL ON 4"x4" PRESSED STEEL BOX	HONEYWELL AT175A1008
22	ENCLOSED POWER RELAY	20A, 1HP RATED CONTACT, SPDT, 24VAC COIL, NEMA 1 ENCLOSURE, RED LED PILOT LIGHT	FUNCTIONAL DEVICES RIB2401B

ELECTRICAL CONDUCTOR SCHEDULE

SERVICE/FUNCTION	DESCRIPTION	MANUFACTURER/MODEL	NOTES:
GENERATOR LEADS & FEEDERS (480V) & ENGINE STARTER CABLES (24VDC)	HIGH TEMPERATURE, EXTRA FLEXIBLE CABLE, TIN COATED COPPER CONDUCTOR. THERMOSET EPDM INSULATION, UL 3340/3374, MINIMUM 600V, LISTED 150°C FOR NON-FLEXING	COBRA CABLE, BELDEN, OR OMNI	TERMINATE WITH COPPER COMPRESSION LUGS RATED FOR THE FULL AMPACITY OF THE CABLE AT 150°C.
GENERAL USE CONDUCTORS	CLASS B CONCENTRIC STRANDED, SOFT DRAWN COPPER. TYPE XHHW INSULATION, 600V AND 75C RATED.		
SHIELDED/TWISTED INSTRUMENT & CONTROL CONDUCTORS	#18 AWG STRANDED TINNED COPPER CONDUCTORS, 600V POLYETHYLENE INSULATION, 100% COVERAGE ALUMINUM FOIL-POLYESTER TAPE SHIELD WITH STRANDED TINNED COPPER DRAIN WIRE & PVC OUTER JACKET	BELDEN PART #'S SINGLE PAIR: #1120A FOUR PAIR: #1049A SINGLE TRIAD: #1121A	GROUND SHIELD DRAIN WIRE AT PANEL END ONLY.
CANBUS (DEVICENET) COMMUNICATION CONDUCTORS	STRANDED TINNED COPPER CONDUCTORS, 600V PVC/NYLON & FRPP INSULATION, 100% COVERAGE ALUMINUM FOIL-POLYESTER TAPE SHIELD WITH TINNED COPPER BRAID SHIELD & PVC OUTER JACKET	TWO PAIR #16 & #18 BELDEN 7896A	GROUND SHIELD DRAIN WIRE AT PANEL END ONLY.
EHTERNET (CAT5e) COMMUNICATION CONDUCTORS	SOLID BARE COPPER CONDUCTORS, 300V FEP INSULATION & JACKET, 100% COVERAGE ALUMINUM FOIL-POLYESTER TAPE SHIELD WITH STRANDED TINNED COPPER DRAIN WIRE	FOUR PAIR #24 BELDEN 1585LC	GROUND SHIELD DRAIN WIRE AT PANEL END ONLY. ROUTE ALL CAT5e CABLES IN SEPARATE DEDICATED RACEWAY.
COLOR CODING - UNLESS SPECIFICALLY INDICATED OTHERWISE CONDUCTORS SHALL BE COLOR CODED AS FOLLOWS: 480-VOLT POWER CONDUCTORS PHASE A - BROWN PHASE B - ORANGE PHASE C - YELLOW NEUTRAL - WHITE WITH YELLOW STRIPE 120/208-VOLT POWER CONDUCTORS PHASE A - BLACK PHASE B - RED PHASE C - BLUE NEUTRAL - WHITE 24 VOLT DC CONDUCTORS +24VDC - RED or RED WITH GRAY STRIPE -24VDC - BLACK or BLACK WITH GRAY STRIPE CONTROL & INSTRUMENT CONDUCTORS COLOR CODED PER MANUFACTURER'S STANDARD		NOTES: 1) FOR NO. 6 AWG AND SMALLER CONDUCTORS COLOR CODING SHALL BE PROVIDED BY USING CONDUCTORS WITH CONTINUOUS COLOR EMBEDDED IN THE INSULATION. FOR ALL CONDUCTORS LARGER THAN NO. 6 SCOTCH 35 MARKING TAPE OR EQUIVALENT MAY BE USED TO COLOR CODE THE CABLE. WHERE MARKING TAPE IS USED THE CABLE SHALL BE IDENTIFIED AT EVERY ACCESSIBLE LOCATION. PROVIDE A MINIMUM OF 2 INCHES OF TAPE AT EACH LOCATION. 2) GROUNDING - PROVIDE A SEPARATE EQUIPMENT GROUNDING CONDUCTOR IN EACH RACEWAY. DO NOT USE THE CONDUIT AS AN EQUIPMENT GROUNDING CONDUCTOR. EQUIPMENT GROUNDING CONDUCTORS SHALL BE CLASS B CONCENTRIC STRANDED, SOFT-DRAWN COPPER OF THE SIZES INDICATED ON THE DRAWINGS. CONDUCTORS NOT INDICATED SHALL BE SIZED IN ACCORDANCE WITH THE NATIONAL ELECTRICAL CODE.	


ELECTRICAL INSTRUMENTATION SCHEDULE

SYMBOL	SERVICE/FUNCTION	DESCRIPTION	MANUFACTURER/MODEL
TT	TEMPERATURE TRANSMITTER	RTD, 20-240°F RANGE, 4-20mA OUTPUT, 1/2" NPT PIPING CONNECTION, 6mm DIAMETER BY 2.5" LONG STEM, HIRSCHMANN ELECTRICAL CONNECTION	NOSHOK 800-20/240-1-1-8-8-025-6
PT	PRESSURE TRANSMITTER	0-60 PSIG RANGE, 4-20mA OUTPUT, 1/4" NPT PIPING CONNECTION, HIRSCHMANN ELECTRICAL CONNECTION	NOSHOK 100-60-1-1-2-7
FM	HEAT RECOVERY FLOW METER	150# ANSI FLANGED CONNECTION, SIZE AS INDICATED, PTFE LINER, HASTELLOY C ELECTRODES, RATED FOR 210F OPERATION. FURNISH WITH TRANSMITTER FOR DIRECT AND REMOTE MOUNTING, 115/230 VAC, 50/60 HZ, AND NEMA 4X BODY.	SIEMENS SITRANS METER: FM MAGFLO MAG 3100 TRANSMITTER: F M MAGFLO MAG 5000, CODE NO. FDK: 7ME6910, OPTION 1AA10-1AA0
FS	DAY TANK/HOPPER FLOAT SWITCH	VERTICAL ACTION FLOAT SWITCH, REVERSIBLE 70VSPST NC/NO SWITCH, 1/8" NPT, 1" MAX Ø BUNA-N FLOAT FOR S.G.=.47, MINIMUM 60" LONG PVC COATED #20 AWG LEAD WIRES	INNOVATIVE COMPONENTS LS-12-111/2
TLM	TANK LEVEL MONITOR PANEL	TANK LEVEL MONITOR CONSOLE FOR UP TO SIX TANKS, COLOR LCD SCREEN, ETHERNET CONNECTION WITH WEB INTERFACE, PROGRAMMABLE VOLUME CALCULATIONS WITH TEMPERATURE COMPENSATION	FRANKLIN/INCON COLIBRI CL6D
LSP	FUEL/OIL TANK LEVEL SENSOR PROBE	TOP-MOUNT TANK PROBE WITH INSTALLATION KIT FOR 2" NPT RISER, WATER TIGHT COMPRESSION GLAND FITTING FOR CABLE ENTRANCE. FRANKLIN FUEL SYSTEMS, NO SUBSTITUTES. PROBE AND RISER LENGTH AS INDICATED ON INSTALLATION DETAILS.	4' TANK PROBE: TSP-LL2-53-1 FLOAT: INTSP-IDF2 2" FOR DIESEL INSTALLATION KIT: TSP-K2A
LCA	GLYCOL TANK LOW COOLANT ALARM	LOW COOLANT LEVEL ALARM FLOAT SWITCH, SEE MECHANICAL FOR INSTALLATION DETAILS	MURPHY EL-150-K1
GLS	GLYCOL TANK LEVEL SENSOR PROBE	12" PROBE, 2" NPT TANK CONNECTION, SS FLOAT, 1/4" RESOLUTION, NEMA 4 ENCLOSURE WITH SIGNAL CONDITIONER AND 1/2" NPT CONDUIT CONNECTION	INNOVATIVE COMPONENTS CLM-2012-SS

BUILDING PLANS SYMBOL LEGEND

SYMBOL	DESCRIPTION
SS-##	HOME RUN TO PANEL & BREAKER(S) INDICATED. SHORT DASH INDICATES HOT CONDUCTOR, LONG DASH INDICATES NEUTRAL CONDUCTOR, CURVED DASH INDICATES GROUND CONDUCTOR. IF NOT SPECIFICALLY INDICATED, PROVIDE 2#12 AWG & 1#12 AWG GROUND.
⚡	ELECTRICAL ITEM - SEE EQUIPMENT SCHEDULE
1/4	MOTOR (HORESPOWER INDICATED)
MD	MOTORIZED DAMPER - SEE MECHANICAL
⊖	125V, 20A, DUPLEX RECEPTACLE
T	LINE VOLTAGE THERMOSTAT
DT	DIGITAL THERMOSTAT, MODULATING
\$	SNAP SWITCH / SMALL MOTOR DISCONNECT
T\$	TIMER SWITCH
⏚	GROUND


ISSUED FOR CONSTRUCTION JANUARY 2019

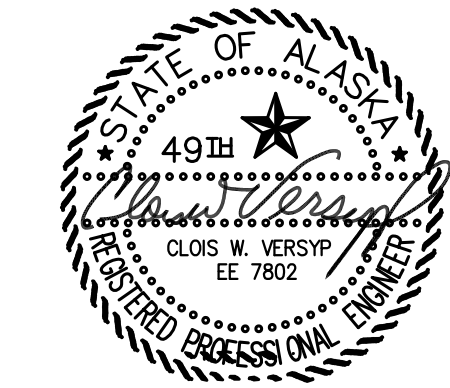


ALASKA ENERGY AUTHORITY

PROJECT: PORT HEIDEN RURAL POWER SYSTEM POWER PLANT UPGRADE		
TITLE: ELECTRICAL LEGENDS & SCHEDULES		
DRAWN BY: JTD	SCALE: AS NOTED	
DESIGNED BY: BCG	DATE: 1/14/19	
FILE NAME: PTH PPU E1-E2	SHEET: E1.1	OF 7
PROJECT NUMBER:		

Gray Stassel Engineering, Inc.
 P.O. 111405, Anchorage, AK 99511 (907)349-0100

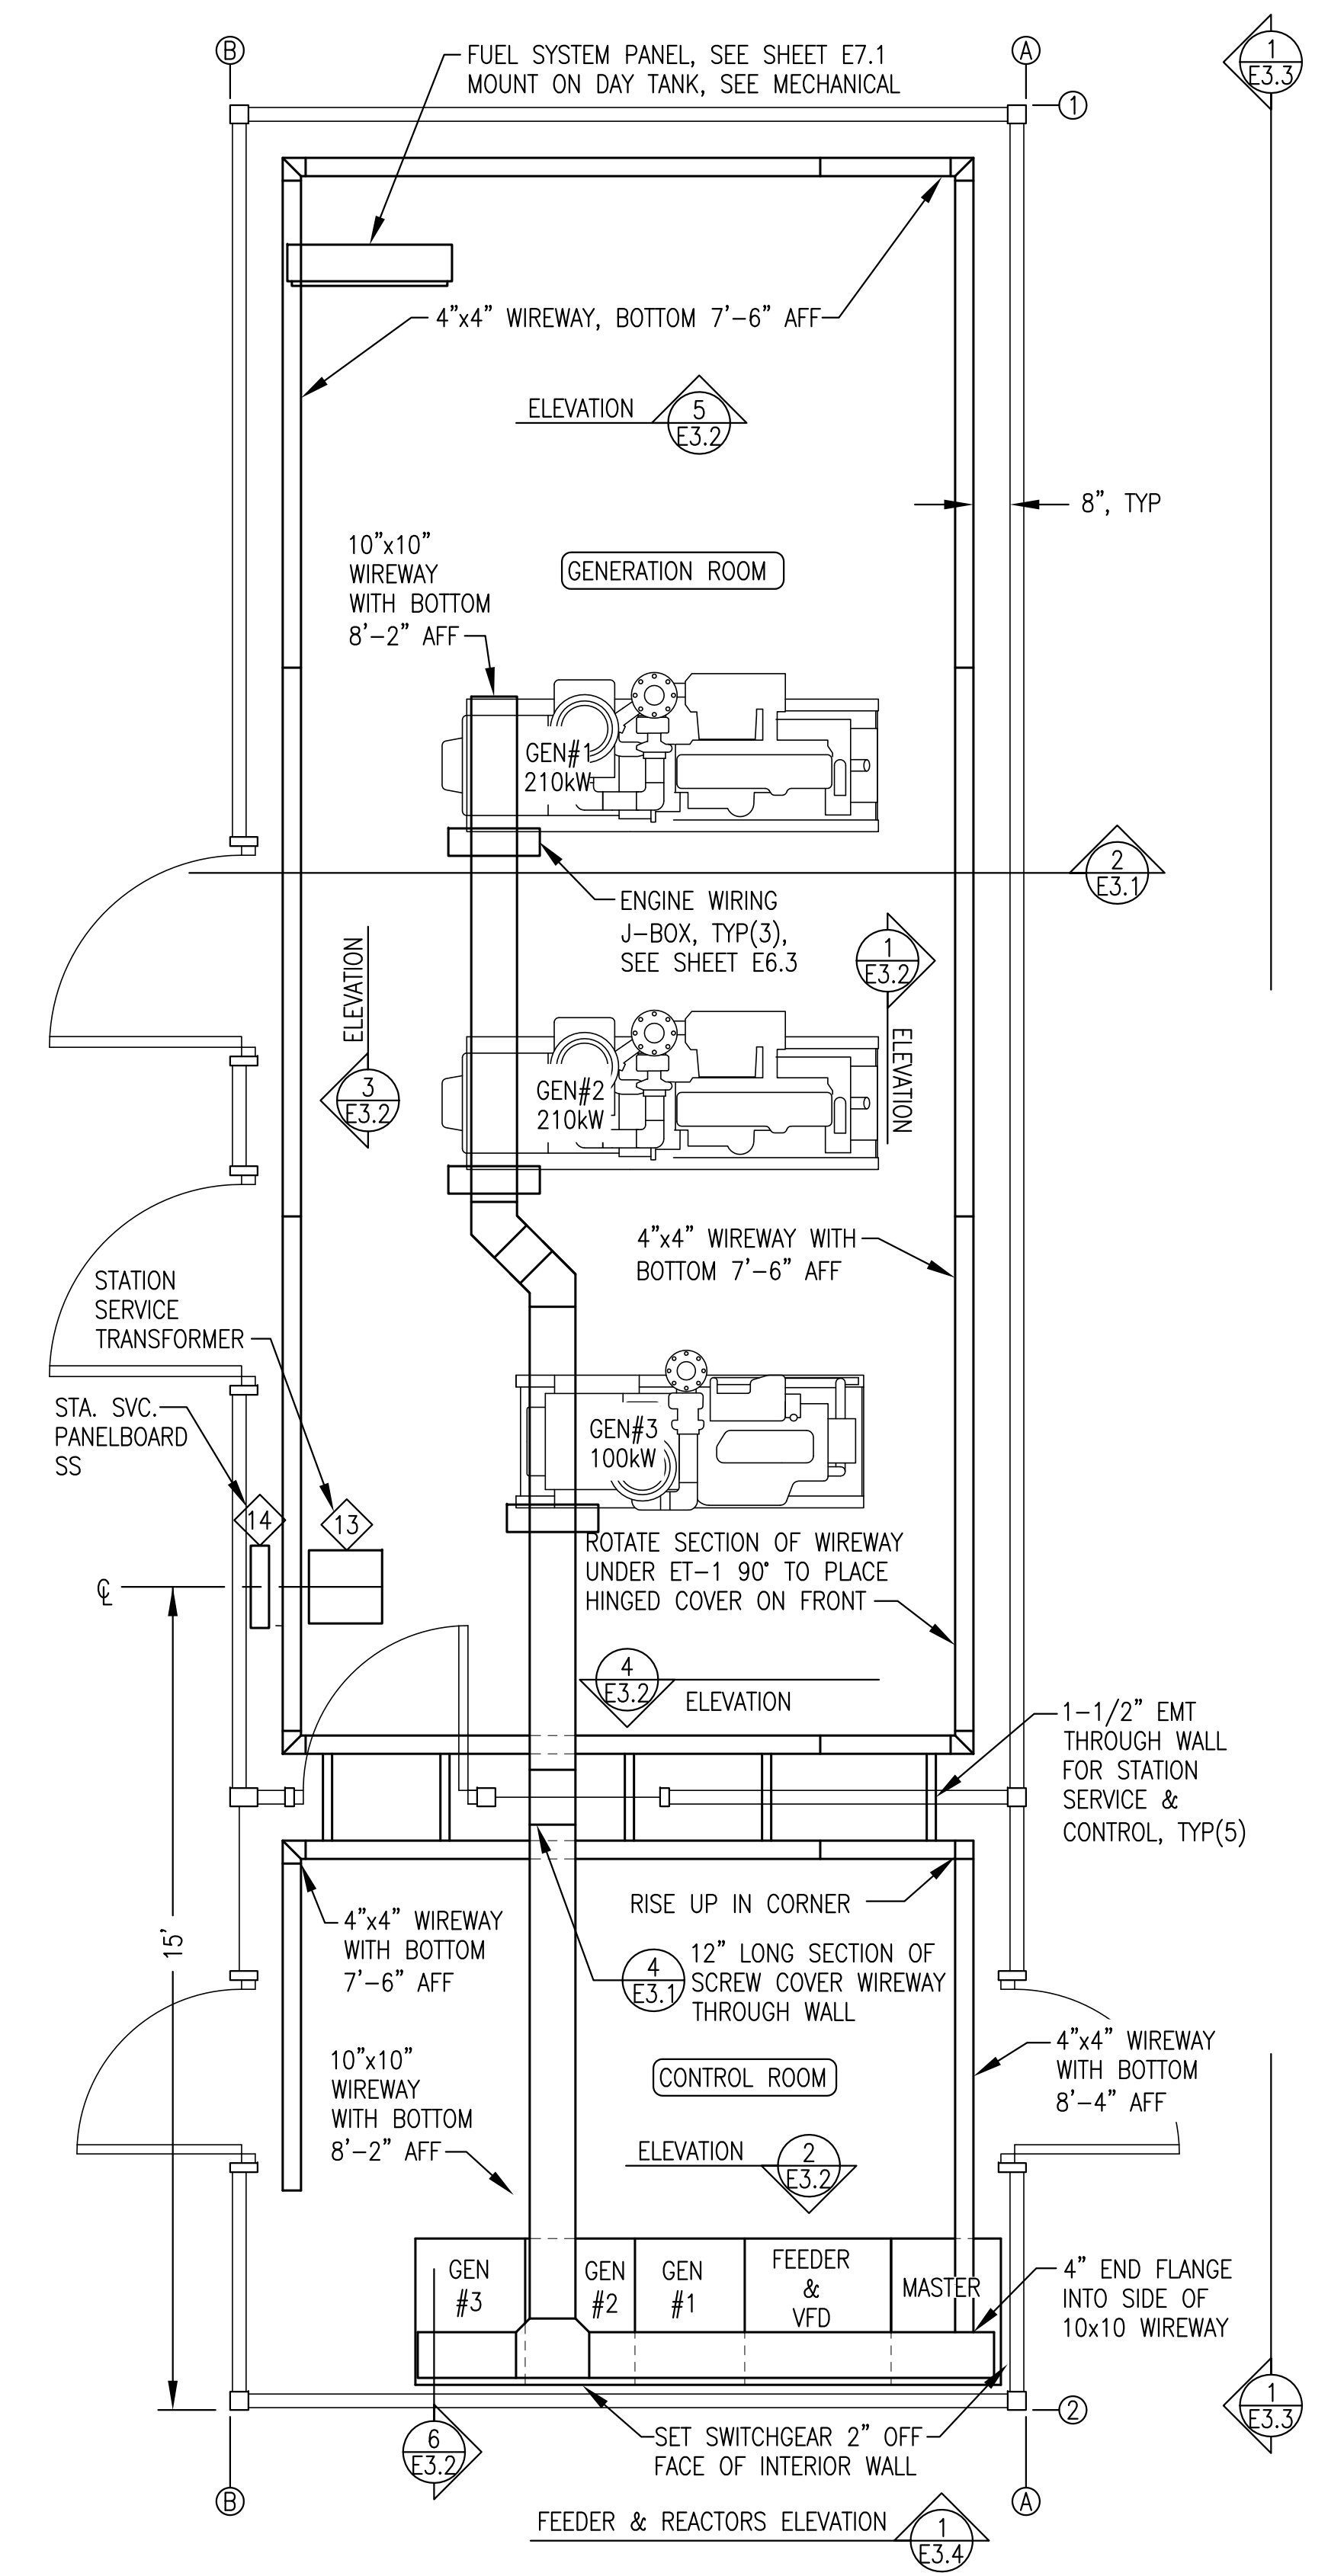


1 EQUIPMENT LAYOUT & WIREWAY PLAN
E3.1 3/8"=1'-0"

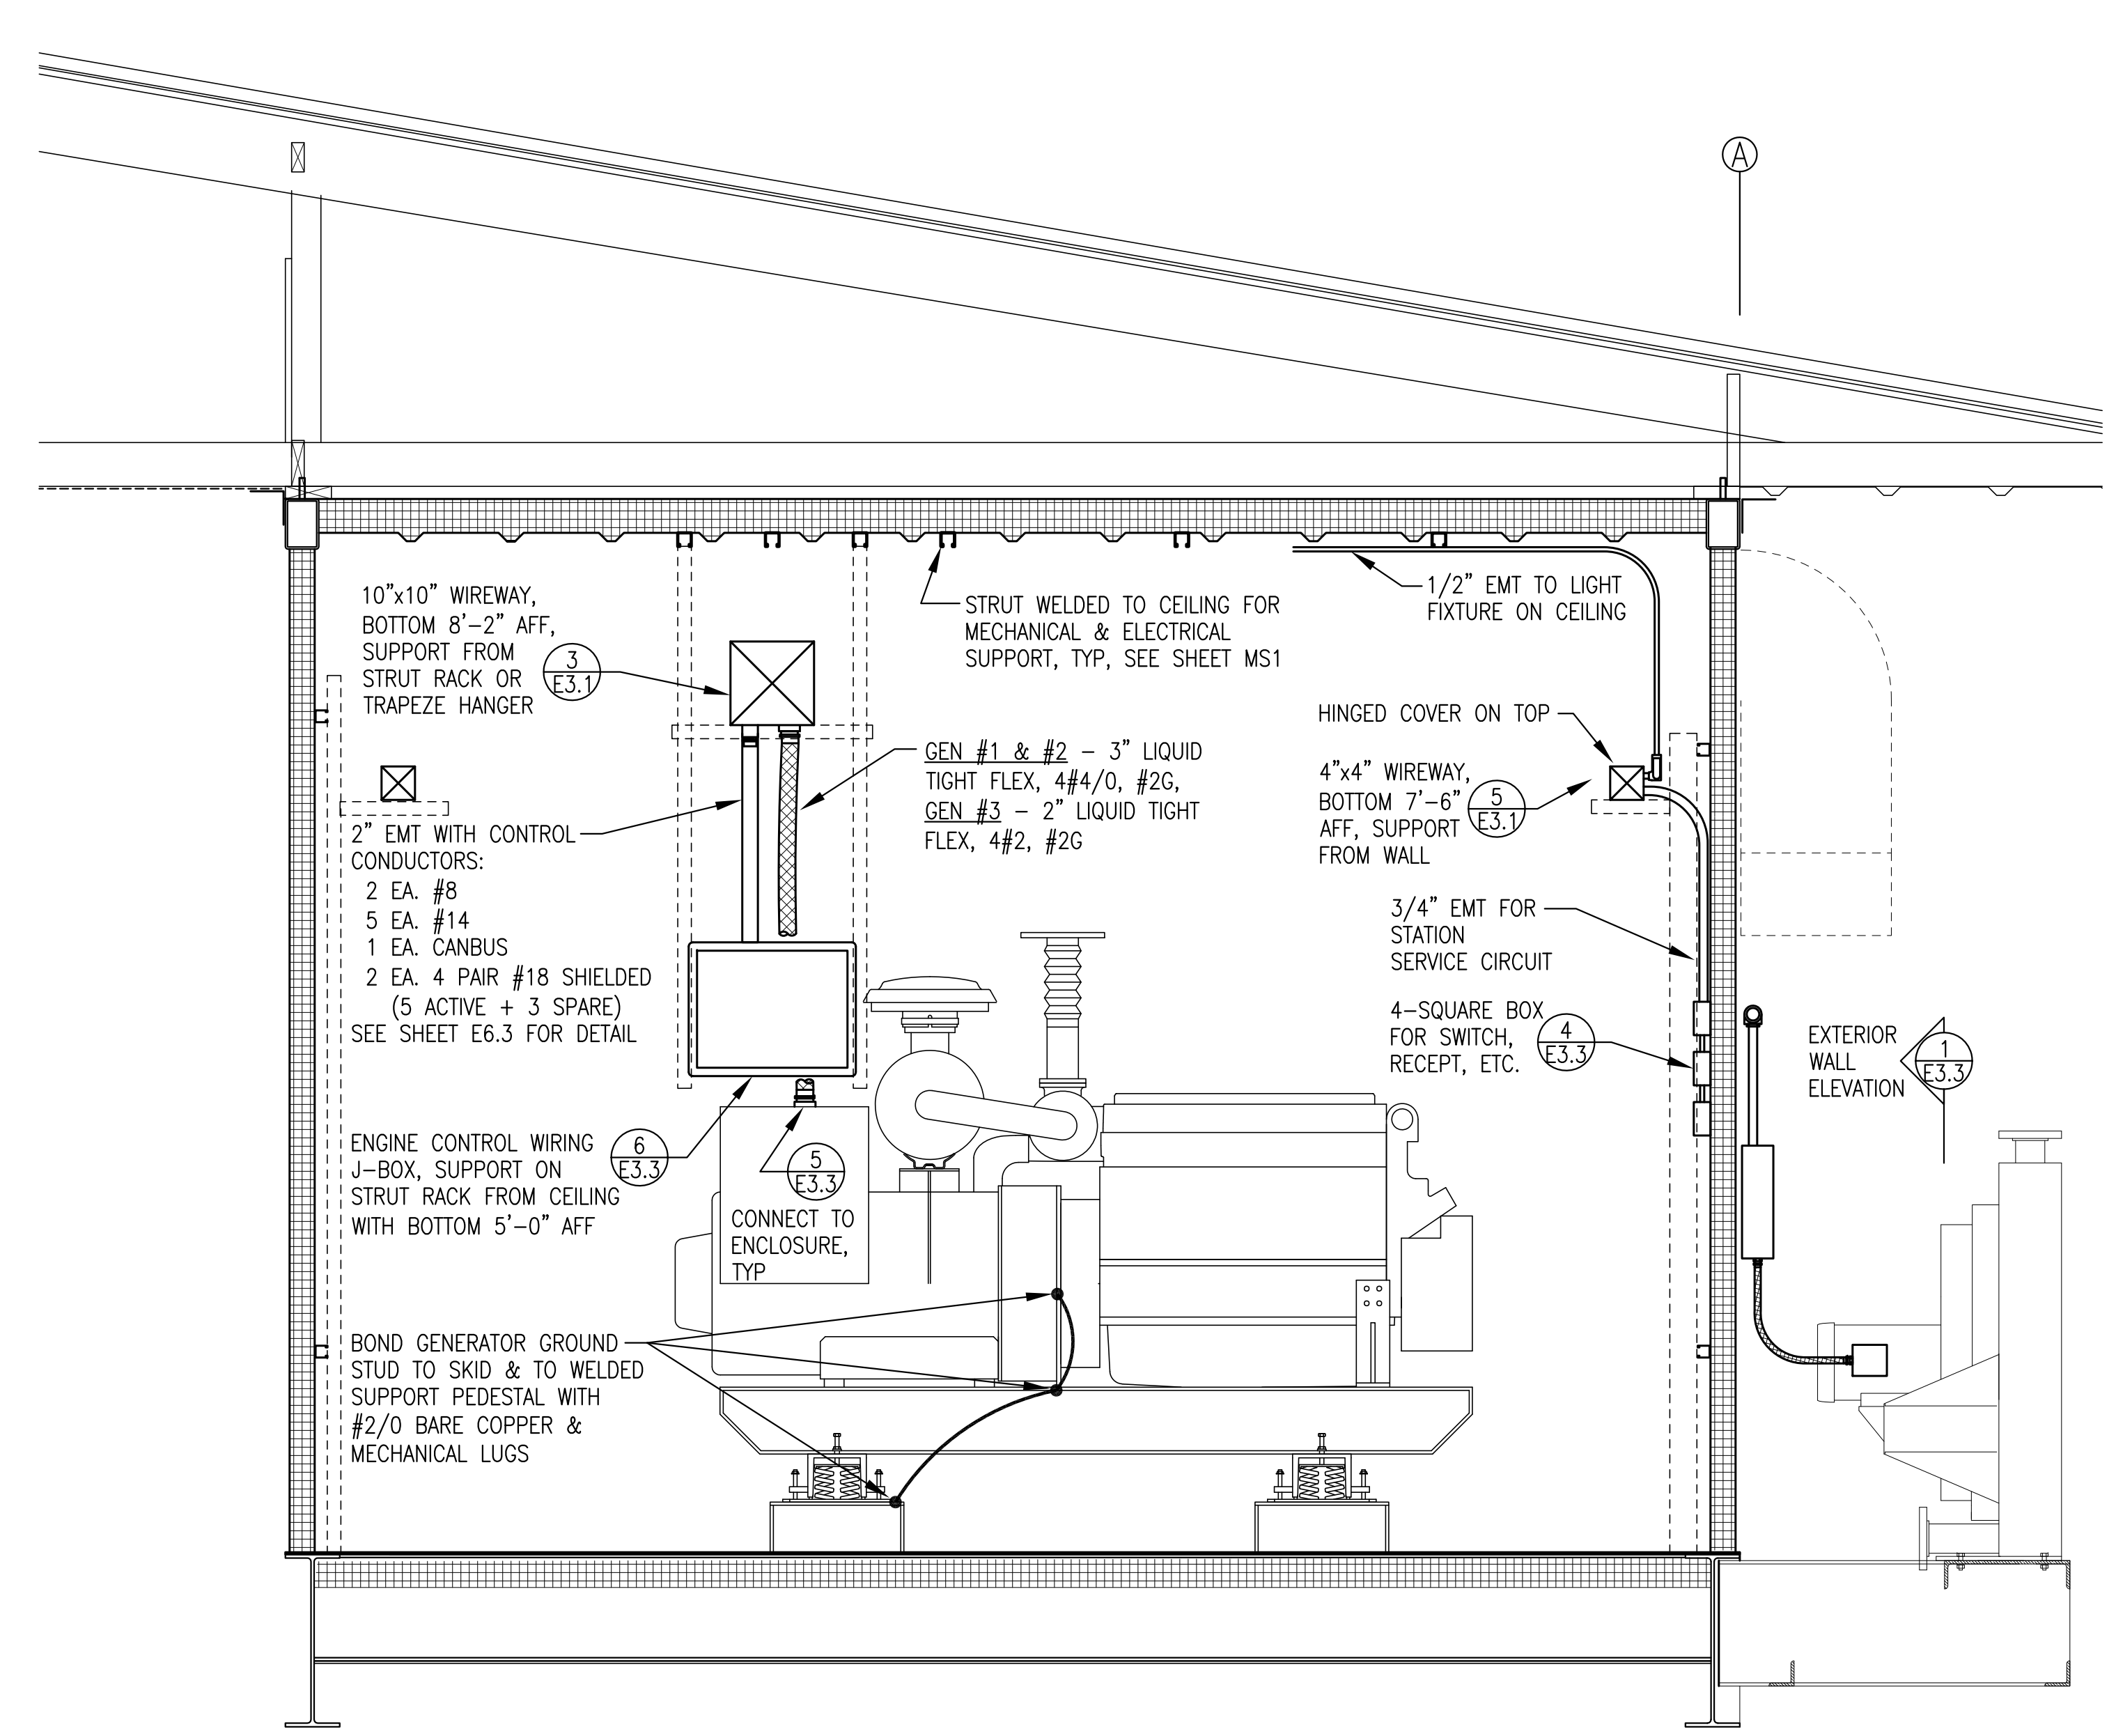


2 TYPICAL MODULE SECTION
E3.1 3/4"=1'-0"


NOTES:
 1) INSTALL HANGER AT EACH JOINT & AT END.
 2) HANGER NOT REQUIRED AT ENGINE J-BOX SUPPORT, SEE DETAIL 4/E4.3.

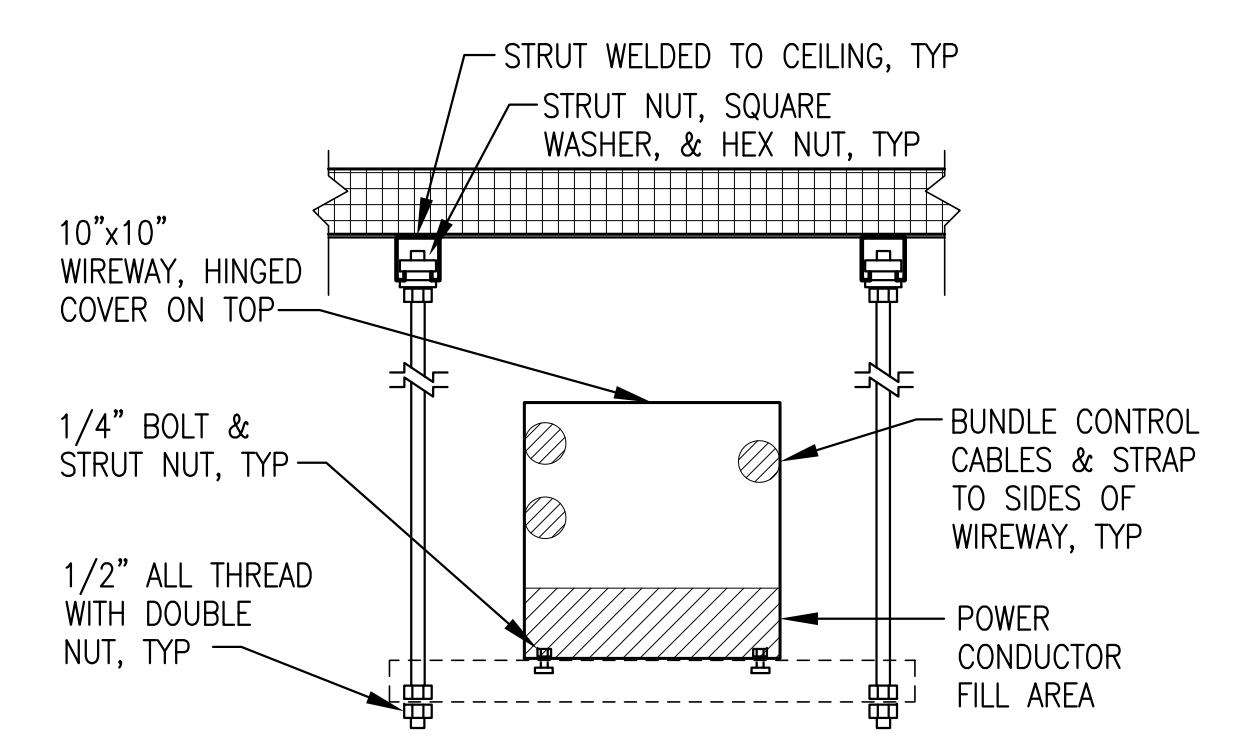

3 10" WIREWAY TRAPEZE HANGER
E3.1 NO SCALE

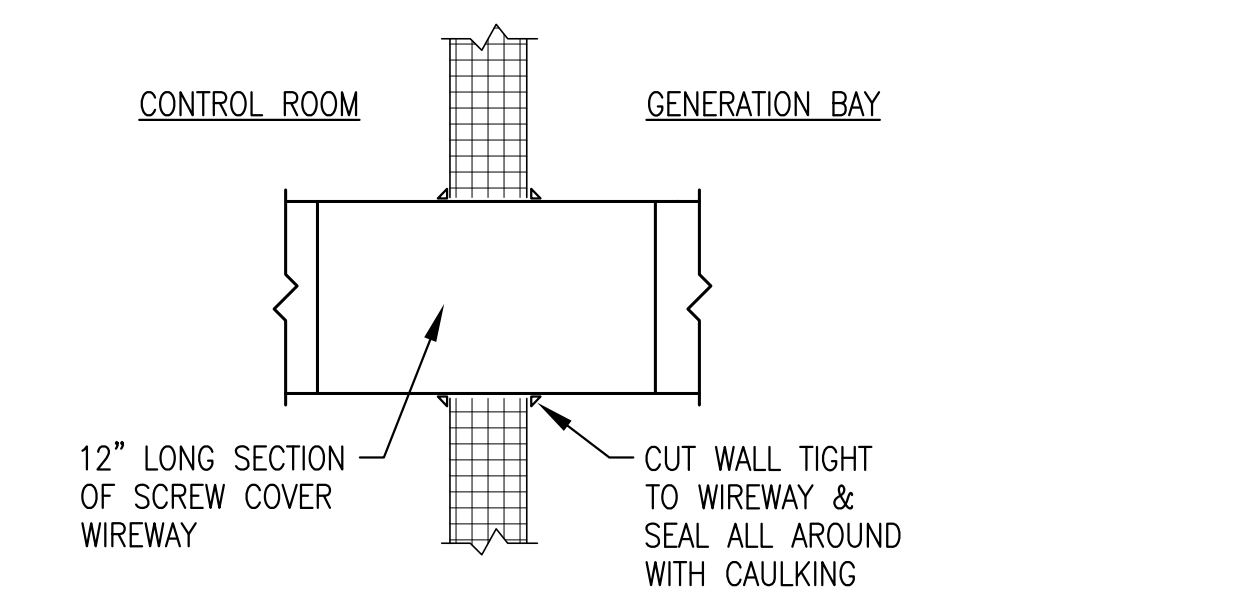


4 WIREWAY WALL PENETRATION
E3.1 NO SCALE

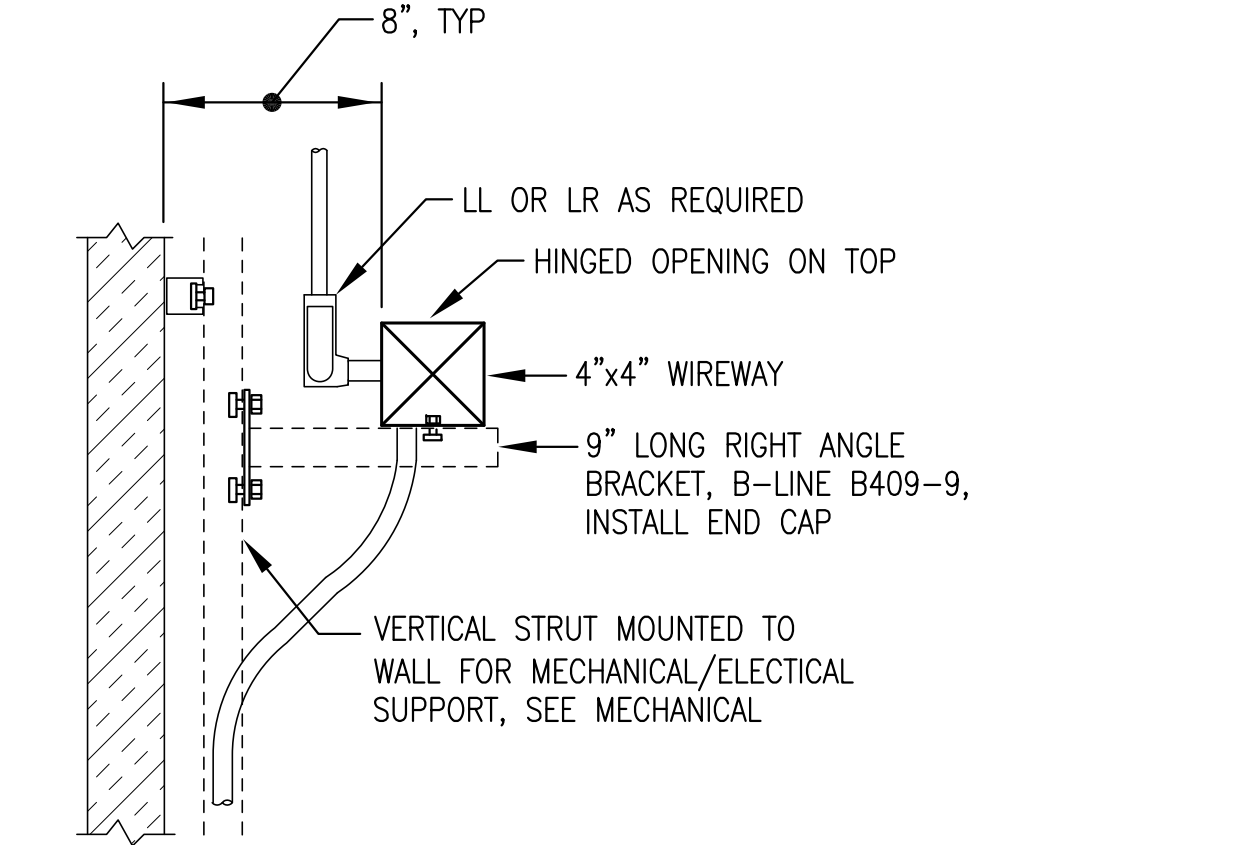



5 4" WIREWAY SUPPORT FROM WALL
E3.1 NO SCALE

ISSUED FOR
 CONSTRUCTION
 JANUARY 2019

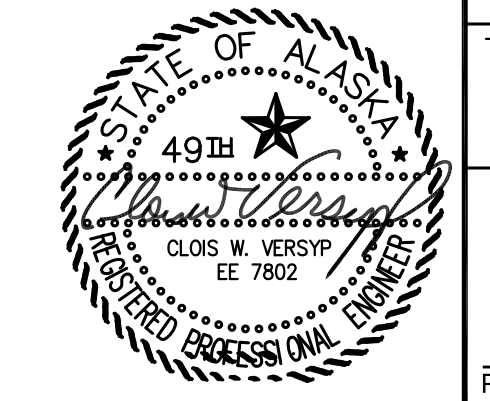


ALASKA ENERGY AUTHORITY	
PROJECT:	PORT HEIDEN RURAL POWER SYSTEM POWER PLANT UPGRADE
TITLE:	WIREWAY PLAN, MODULE SECTION, & DETAILS
DRAWN BY: JTD	SCALE: AS NOTED
DESIGNED BY: BCG	DATE: 1/14/19
FILE NAME: PTH PPU E3-E5	SHEET: E3.1 OF 7
PROJECT NUMBER:	

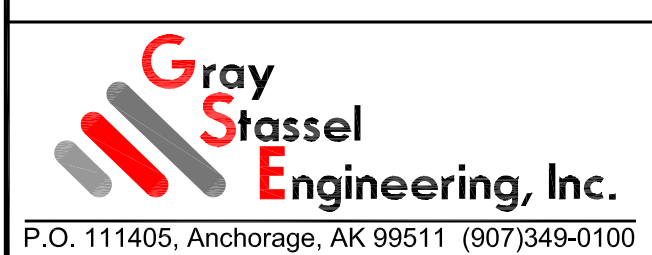


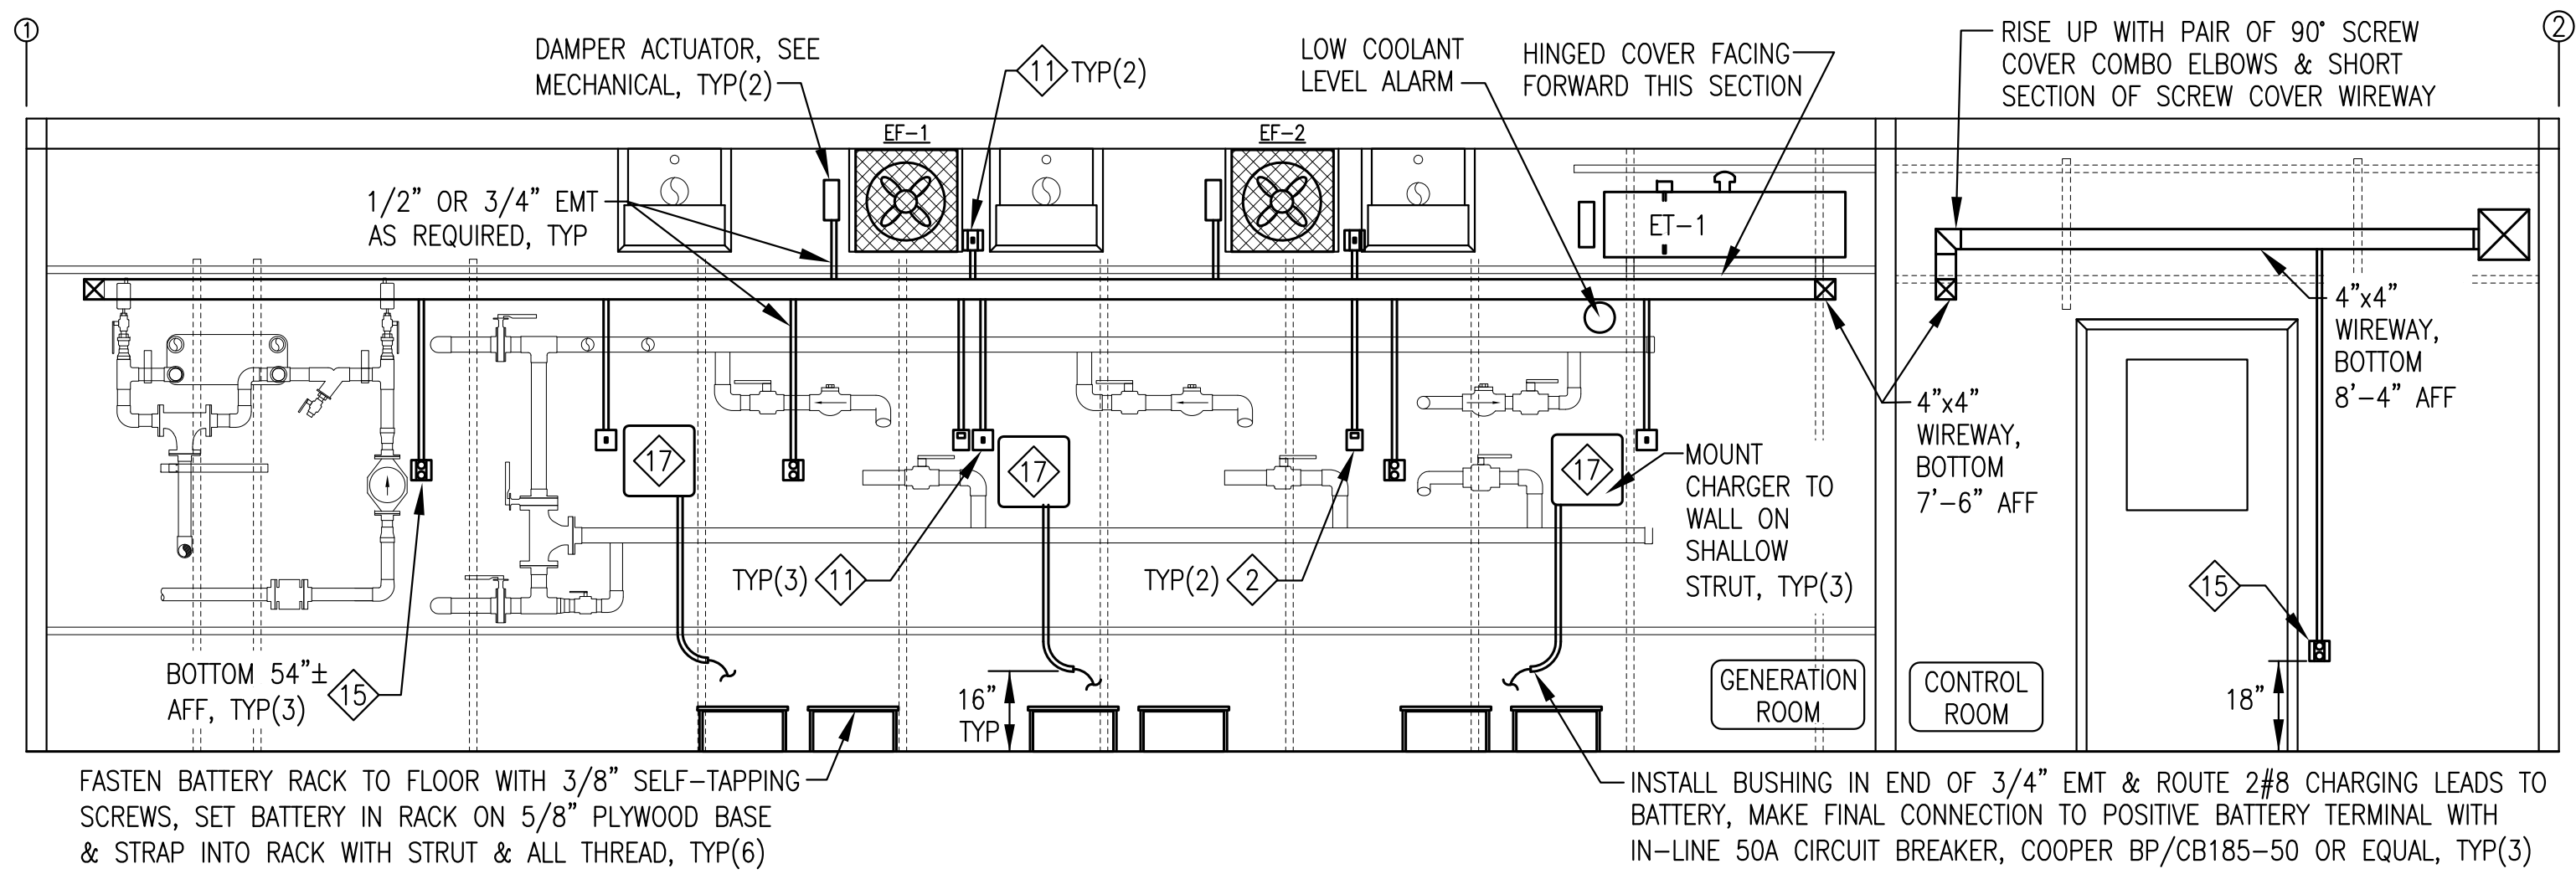


1 WALL ELEVATION AT GRID A
E3.2 3/8"=1'-0"

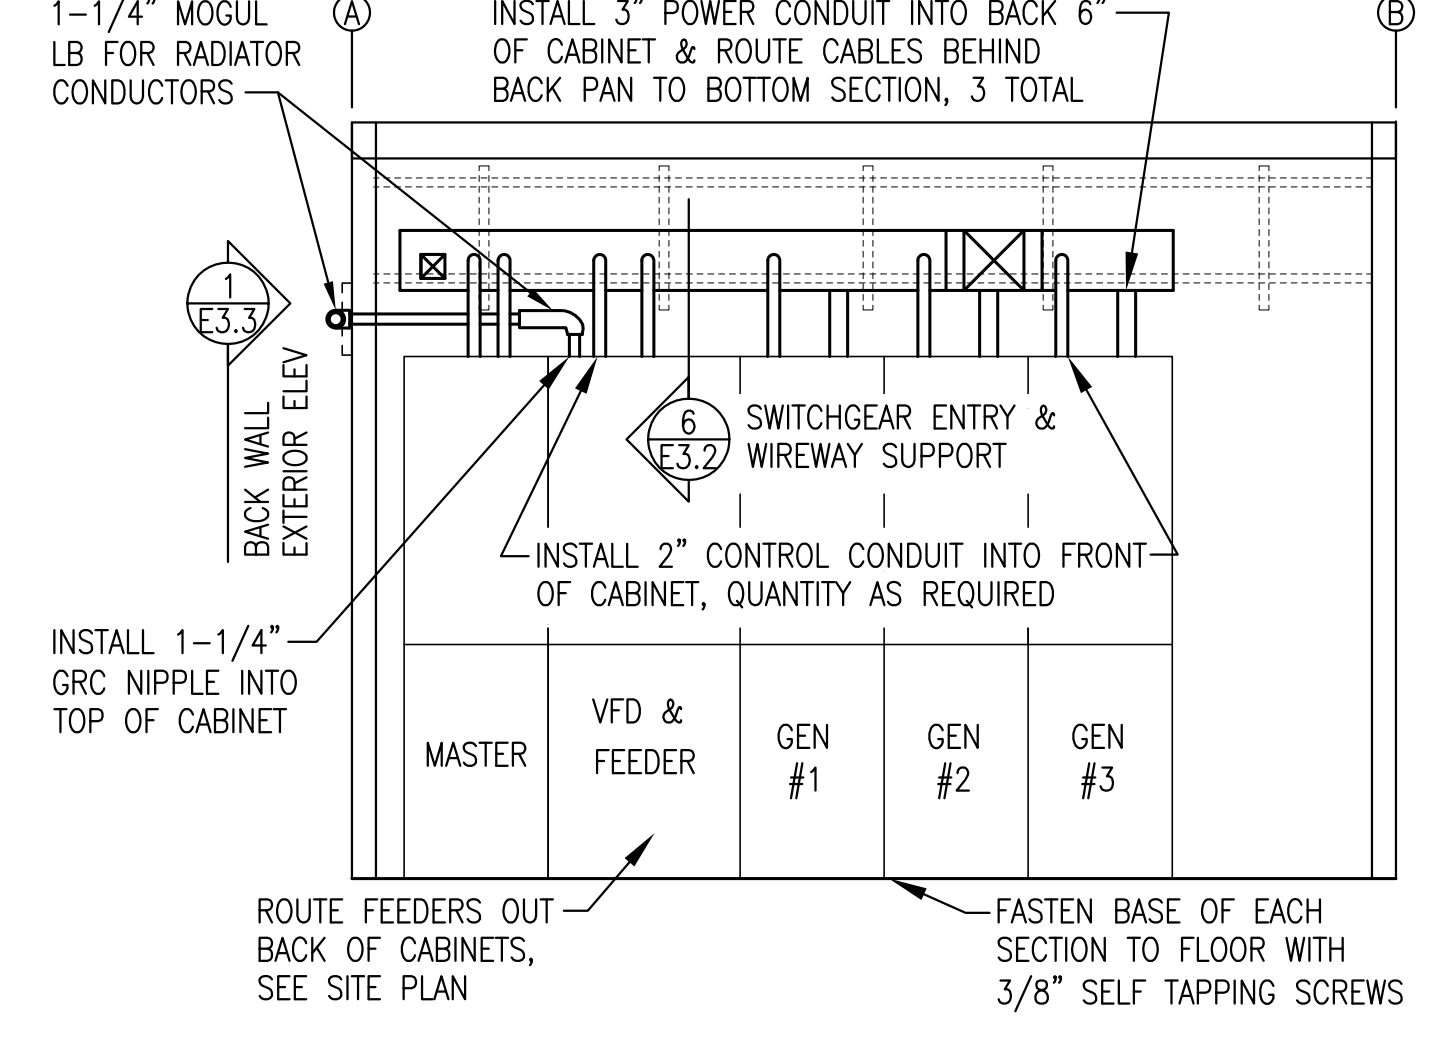


2 WALL ELEVATION AT GRID 2
E3.2 3/8"=1'-0"

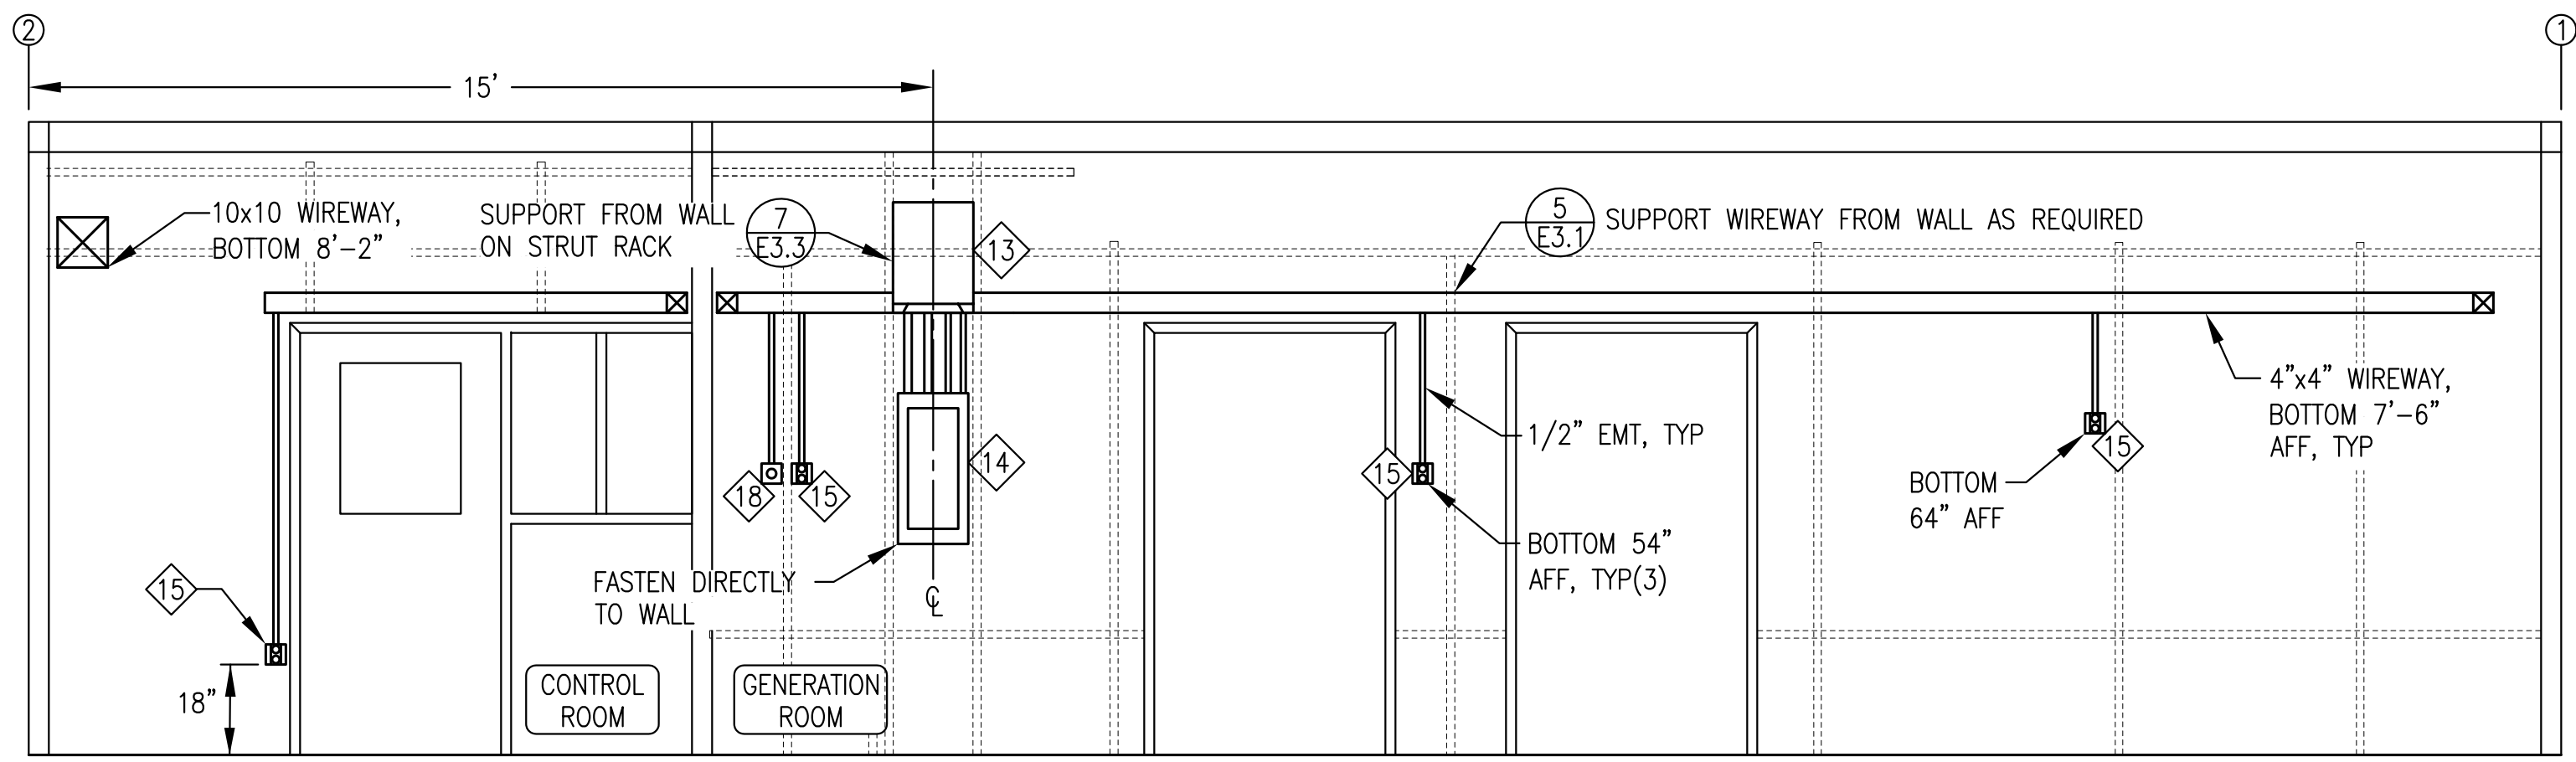


3 WALL ELEVATION AT GRID B
E3.2 3/8"=1'-0"

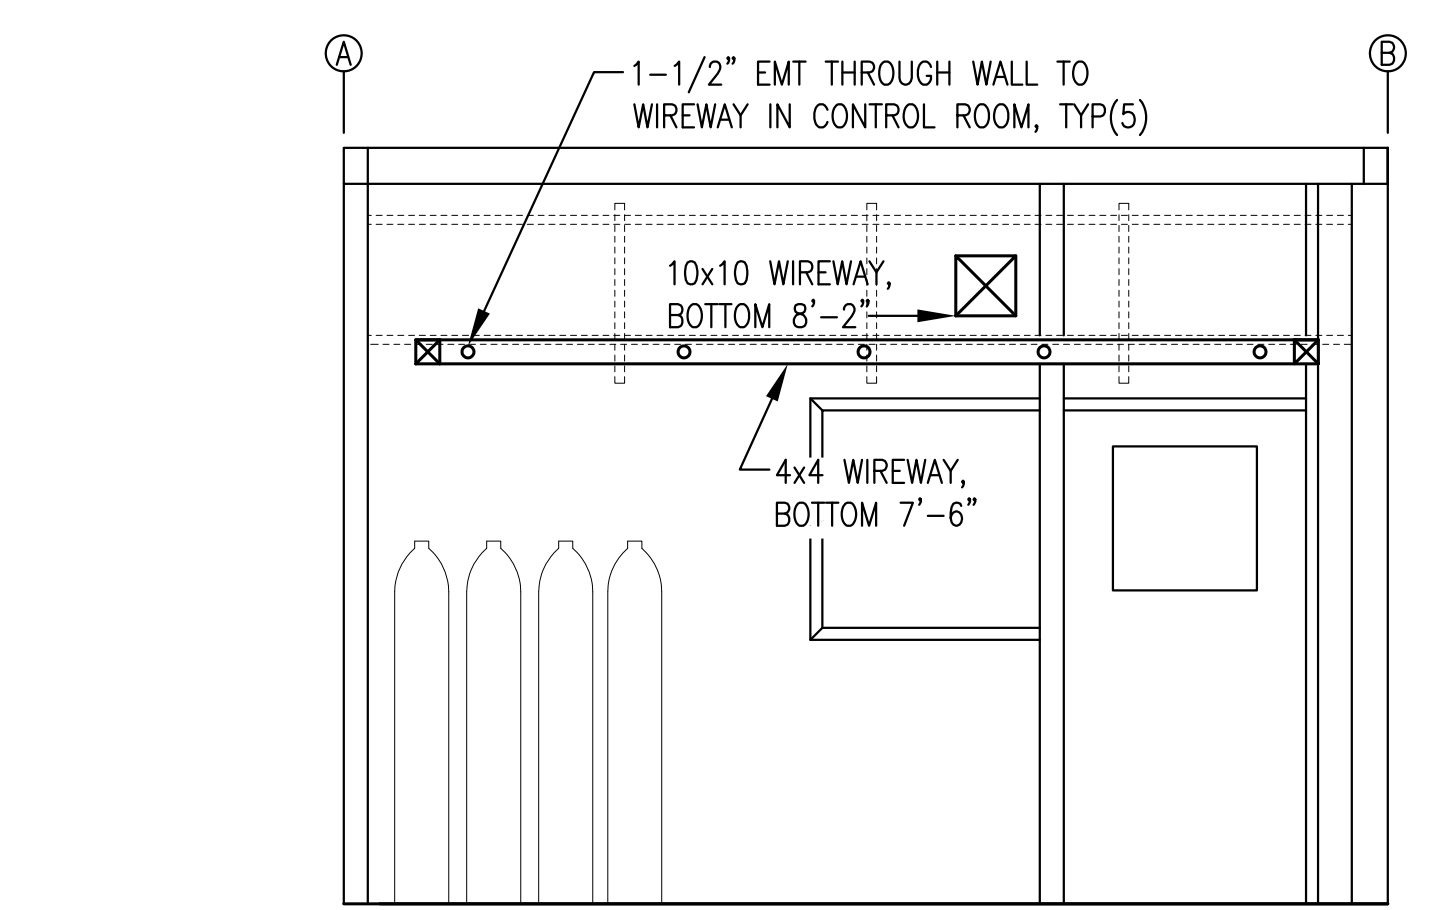

4 INTERIOR WALL ELEVATION
E3.2 3/8"=1'-0"

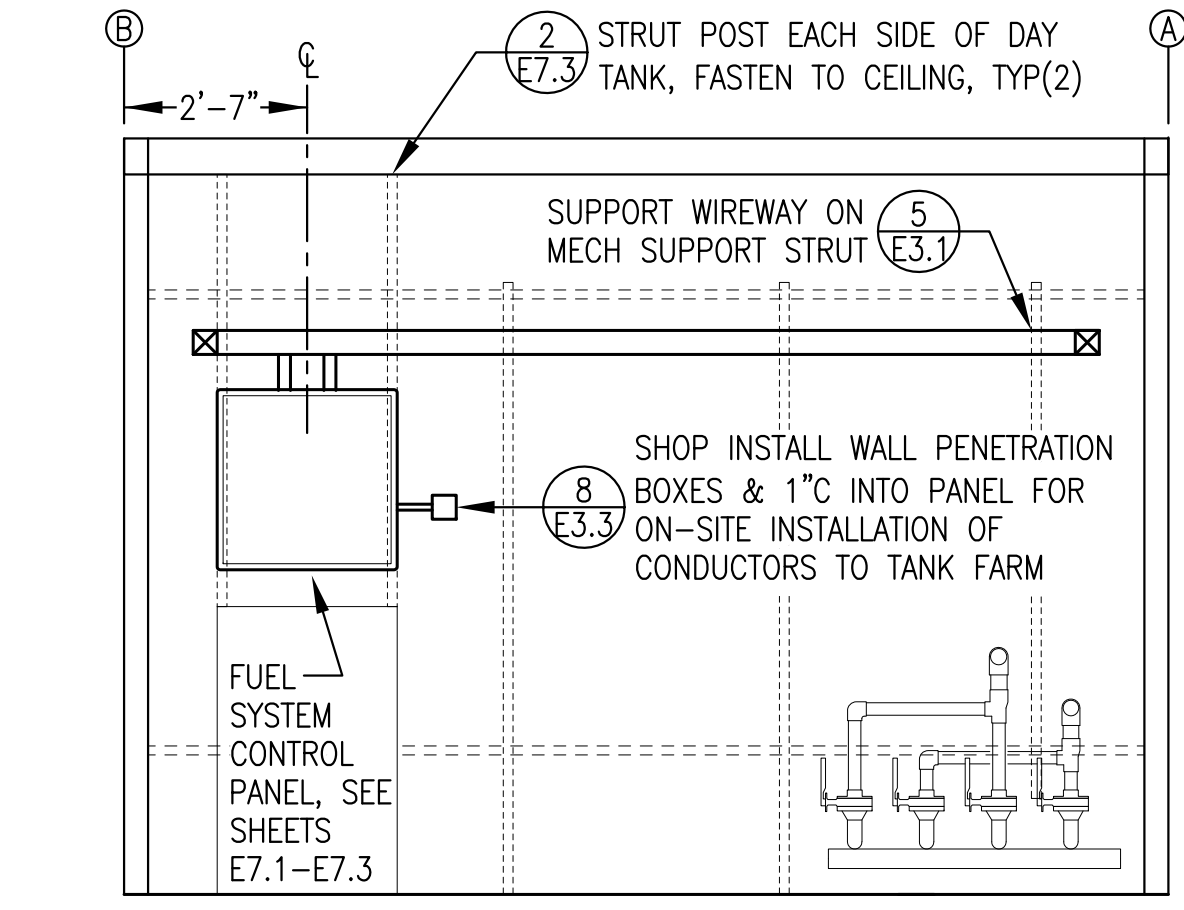


5 WALL ELEVATION AT GRID 1
E3.2 3/8"=1'-0"

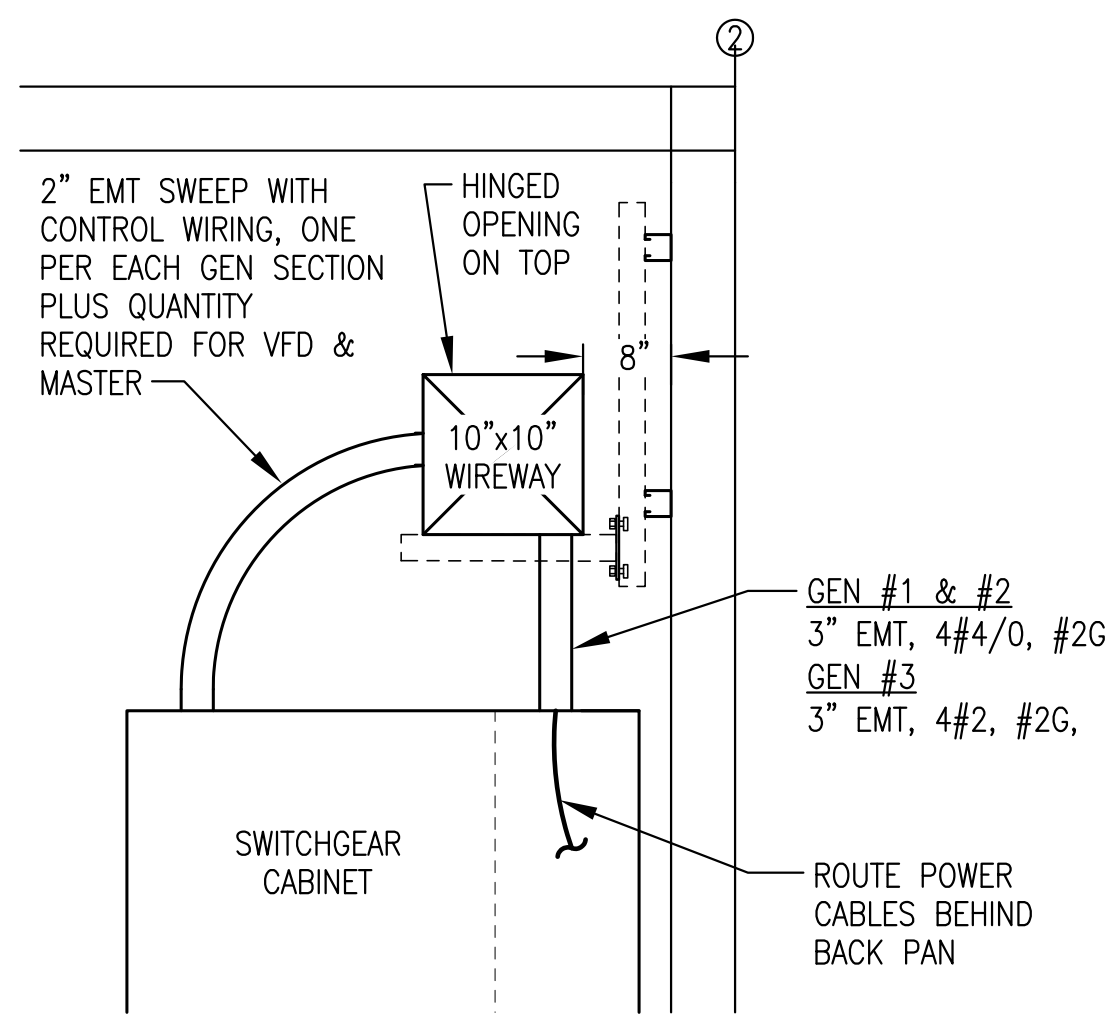


6 SWITCHGEAR ENTRY & WIREWAY SUPPORT
E3.2 NO SCALE

ISSUED FOR CONSTRUCTION JANUARY 2019

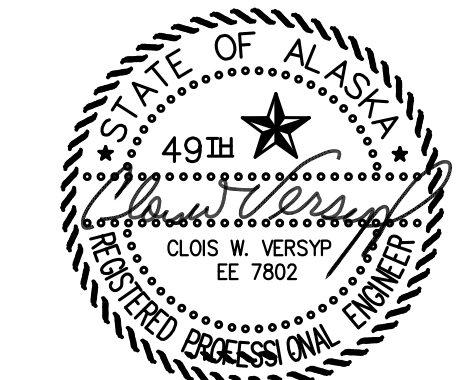


ALASKA ENERGY AUTHORITY	
PROJECT:	PORT HEIDEN RURAL POWER SYSTEM POWER PLANT UPGRADE
TITLE:	ELEVATIONS & DETAILS
DRAWN BY: JTD	SCALE: AS NOTED
DESIGNED BY: CWV/BCG	DATE: 1/14/19
FILE NAME: PTH PPU E3-E5	SHEET: E3.2 OF 7
PROJECT NUMBER:	




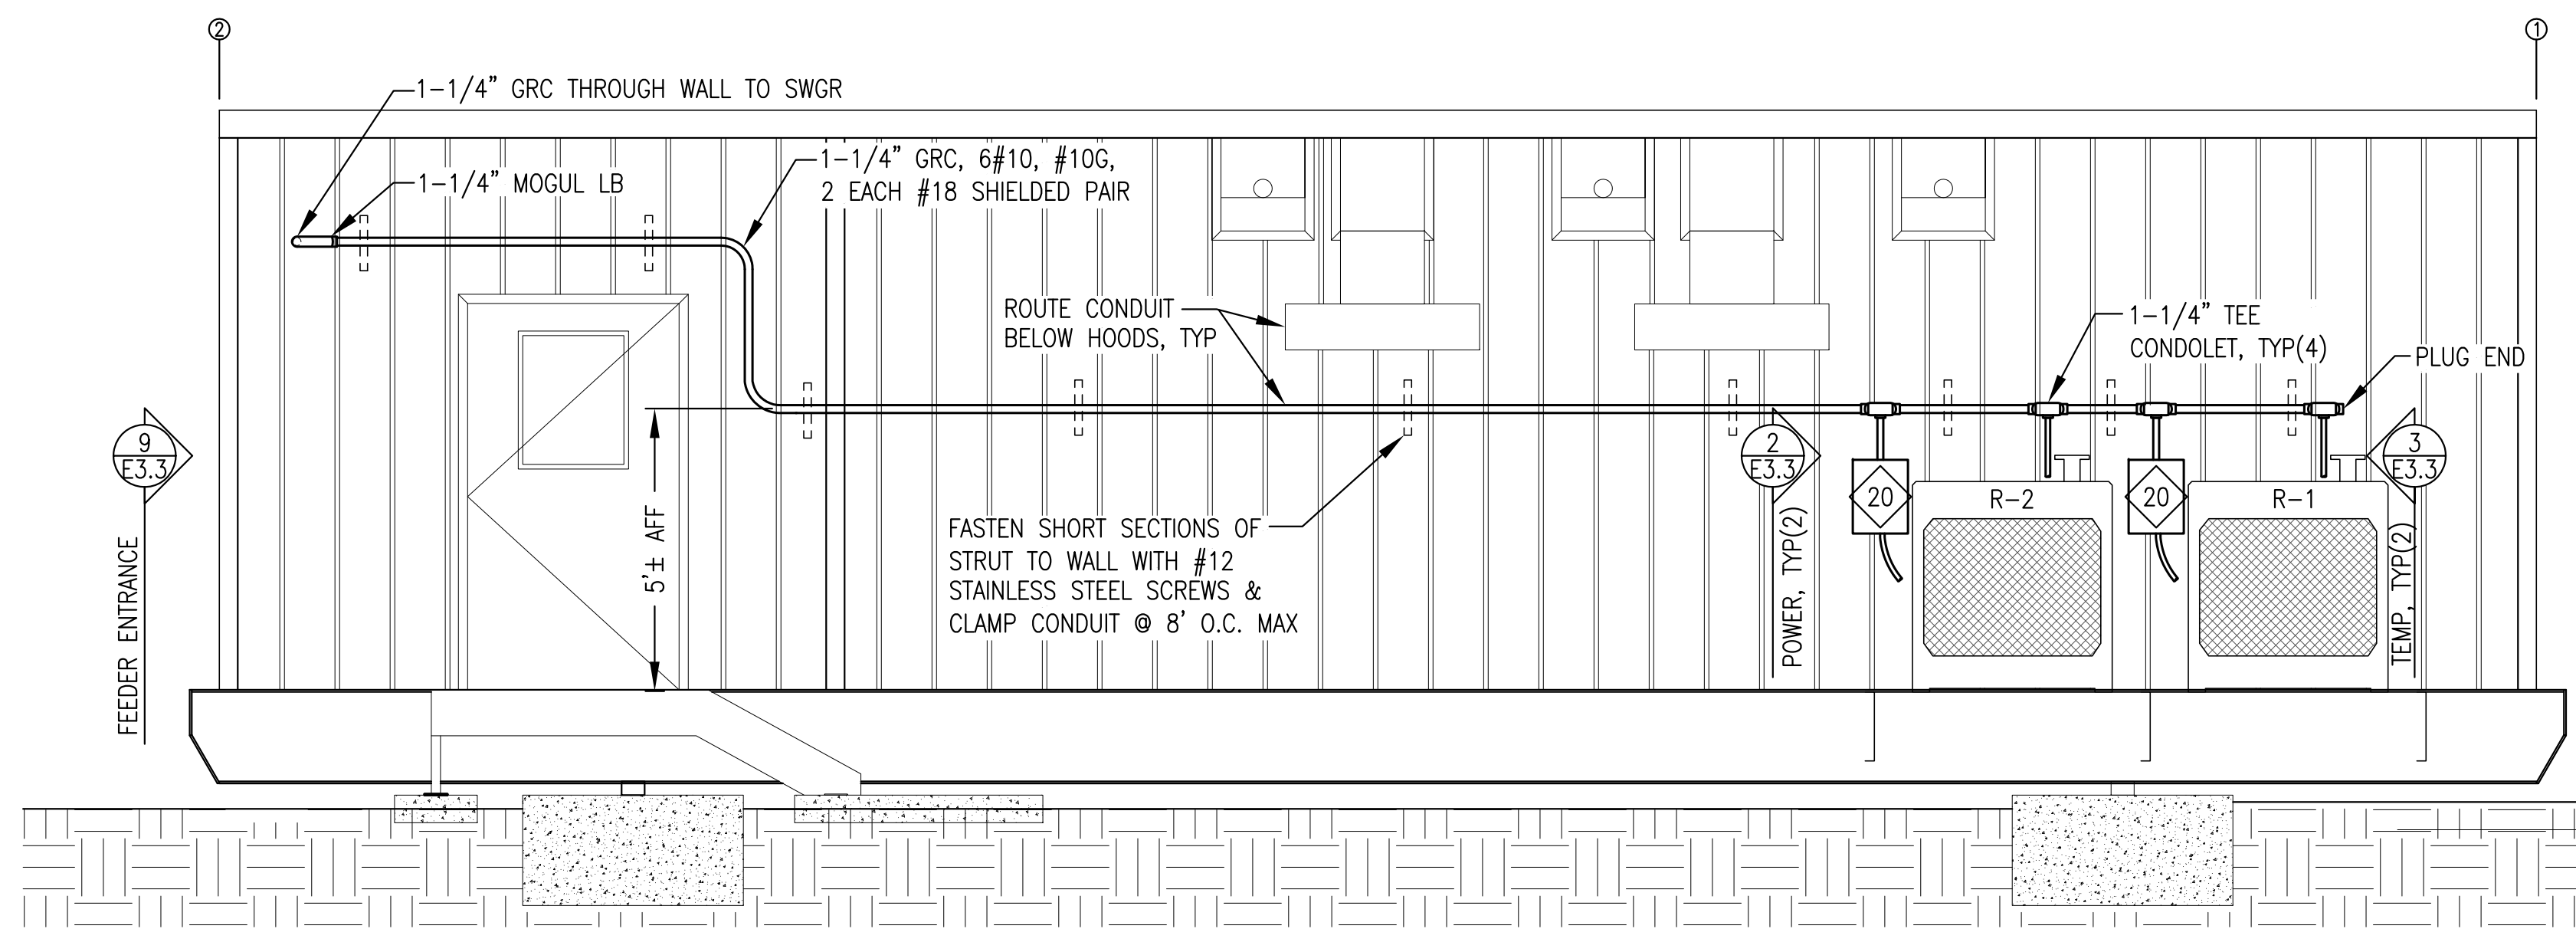

1 BACK WALL EXTERIOR ELEVATION
E3.3 3/8"=1'-0"

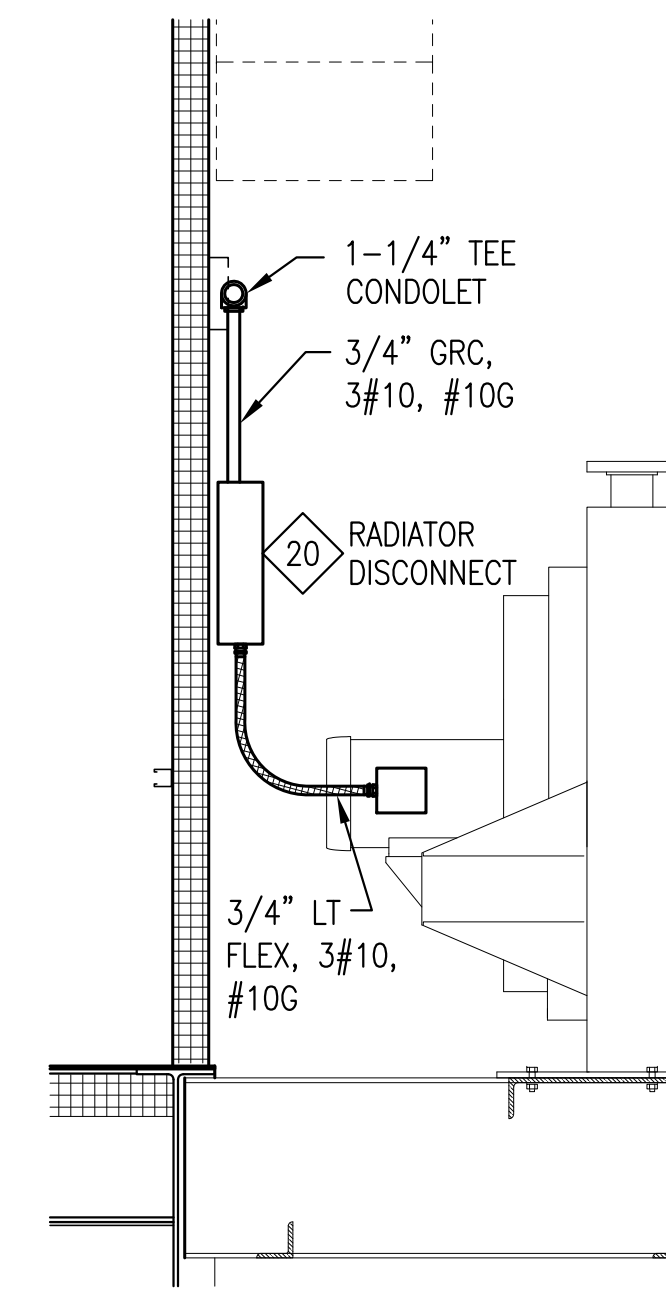


2 RADIATOR POWER CONNECTION
E3.3 3/4"=1'-0"

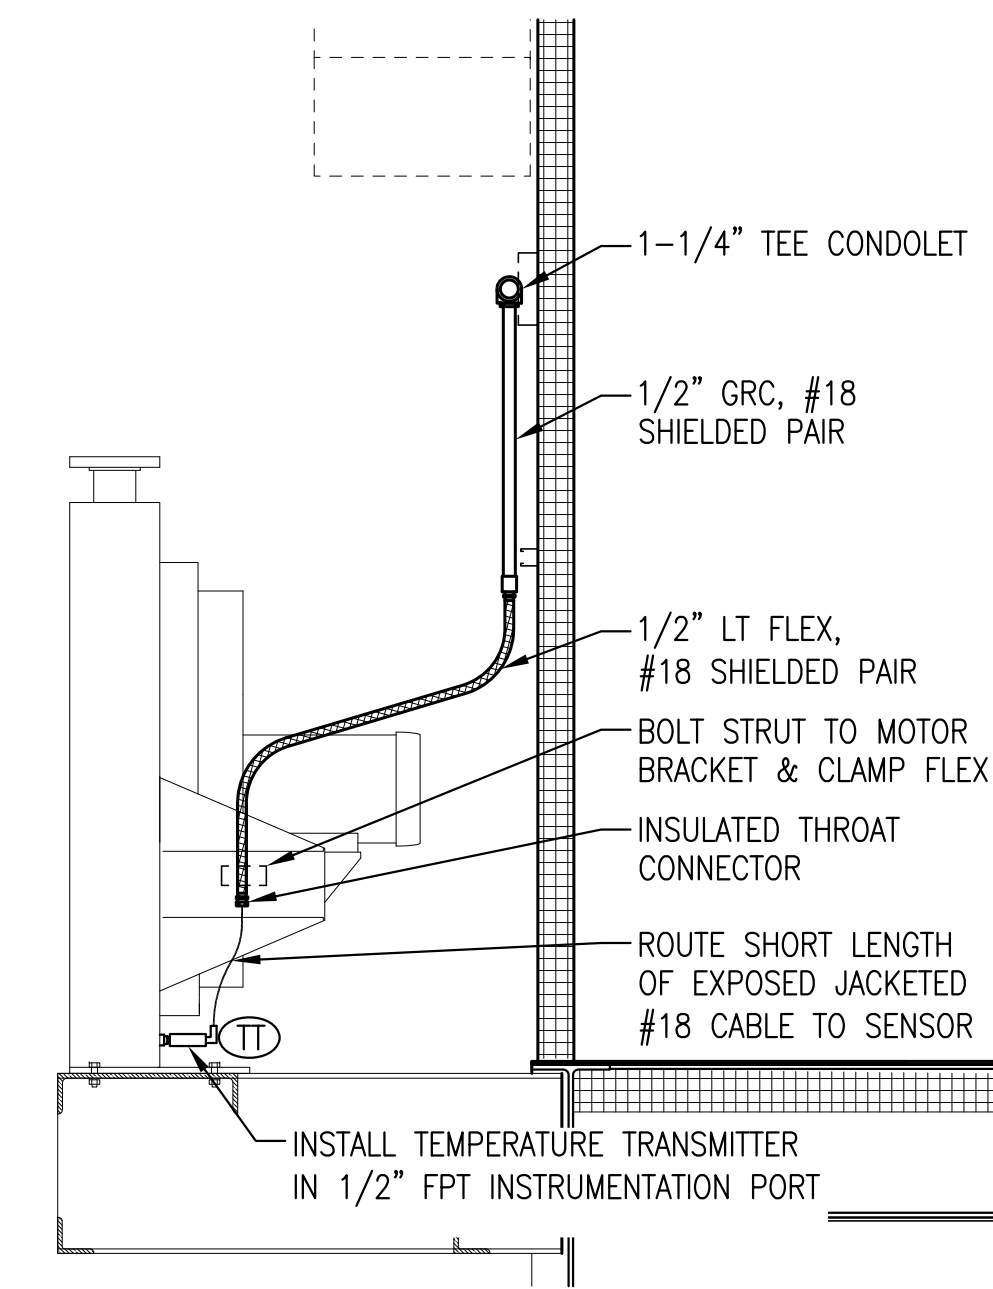

3 RADIATOR TEMPERATURE TRANSMITTER
E3.3 3/4"=1'-0"

RADIATOR SHOP/ON-SITE NOTES:


- 1) DURING SHOP FABRICATION INSTALL ALL DEVICES AND RACEWAYS AS INDICATED.
- 2) AS PART OF ON-SITE WORK, IF RADIATORS ARE REMOVED FOR SHIPPING DISCONNECT LIQUID TIGHT FLEXES AND SEAL ENDS. COIL AND SECURE CONDUCTORS AND FLEXES FOR SHIPPING.
- 3) AS PART OF ON-SITE WORK REINSTALL AS INDICATED.

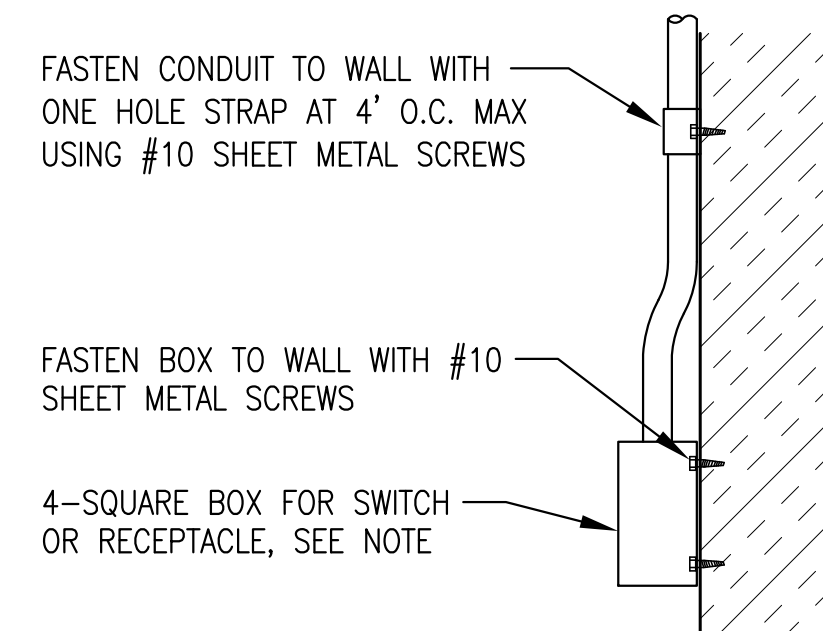


4 TYPICAL INTERIOR DEVICE MOUNTING
E3.3 NO SCALE

NOTES:


- 1) THIS DETAIL APPLIES TO CONNECTIONS TO WIREWAY, GENERATOR ENCLOSURES, SWITCHGEAR, AND PANELS.
- 2) AT A MINIMUM INSTALL GROUNDING BUSHING ON ALL GENERATOR POWER CONDUIT, COMMUNITY FEEDER CONDUIT, STATION SERVICE FEEDERS, AND WHERE OTHERWISE INDICATED OR REQUIRED. BOND GROUNDING BUSHING TO EQUIPMENT GROUNDING CONDUCTOR.
- 3) INSTALL PLASTIC BUSHING WHERE GROUNDING BUSHING IS NOT REQUIRED.
- 4) ON GENERATOR ENCLOSURES MAKE ALL CONNECTIONS AS TIGHT AS POSSIBLE.

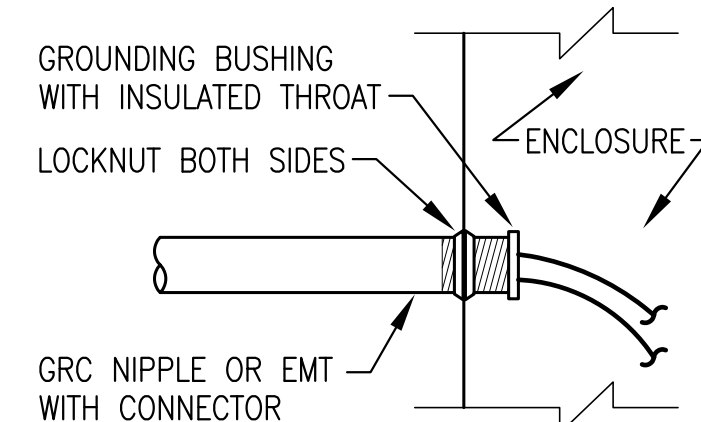


5 TYP ENCLOSURE CONNECTION
E3.3 NO SCALE

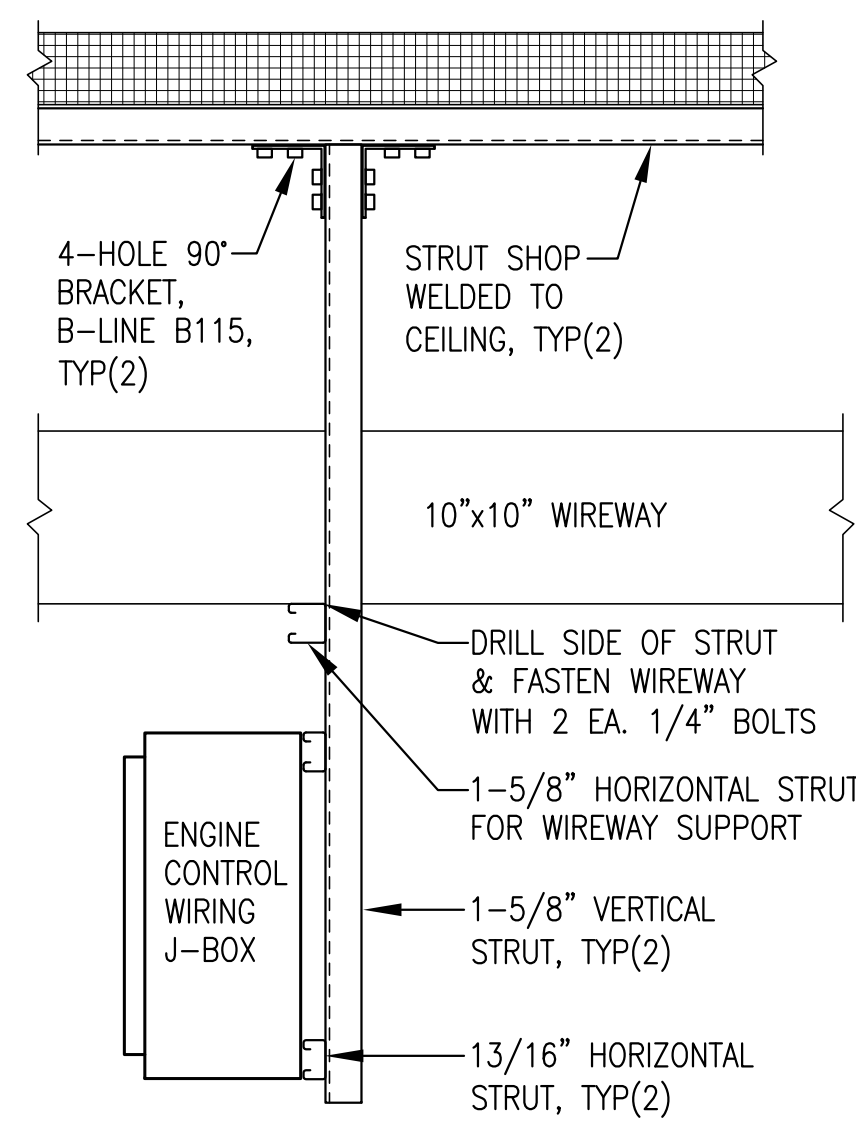


6 ENGINE WIRING J-BOX SUPPORT
E3.3 NO SCALE

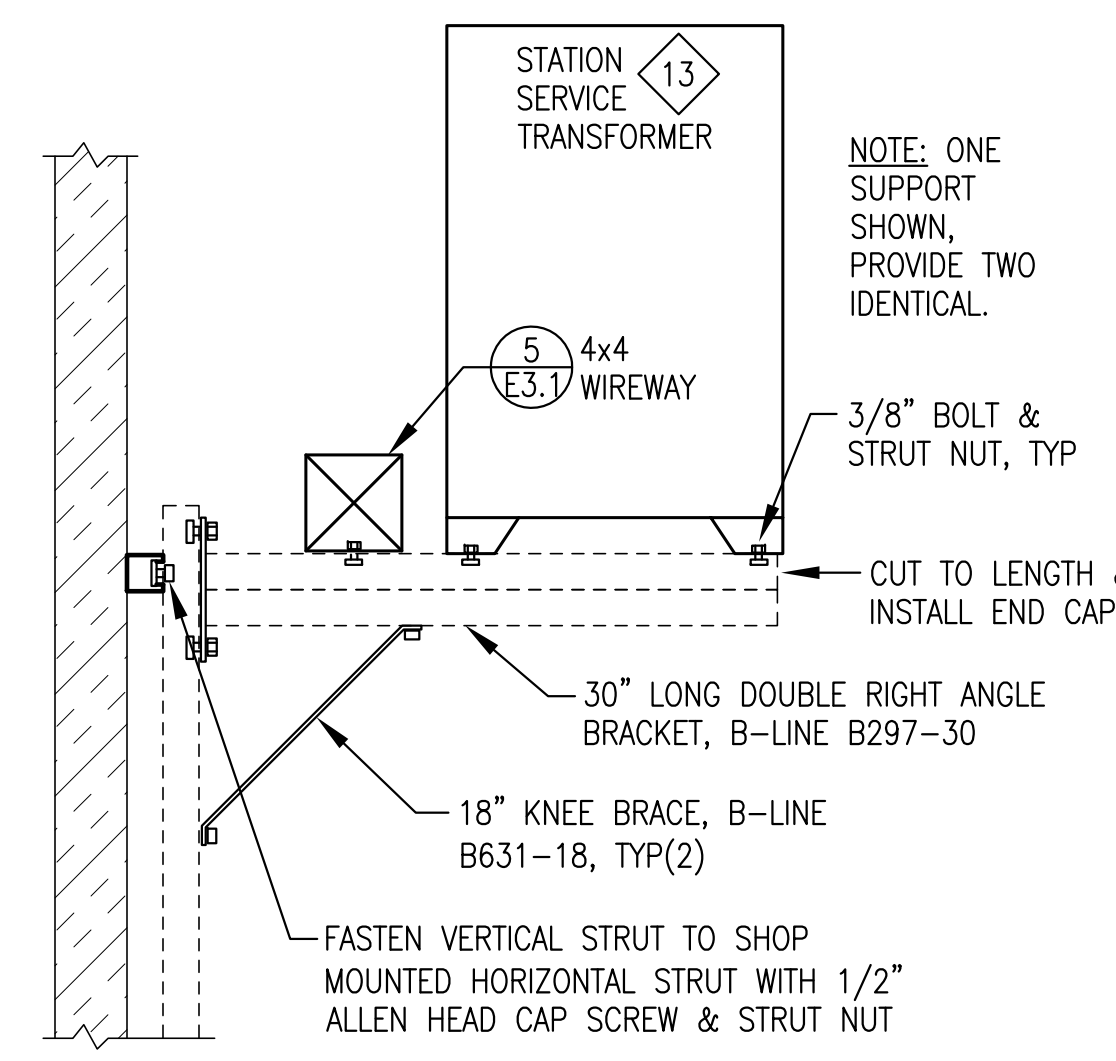

7 STATION SERVICE TRANSFORMER SUPPORT
E3.3 NO SCALE

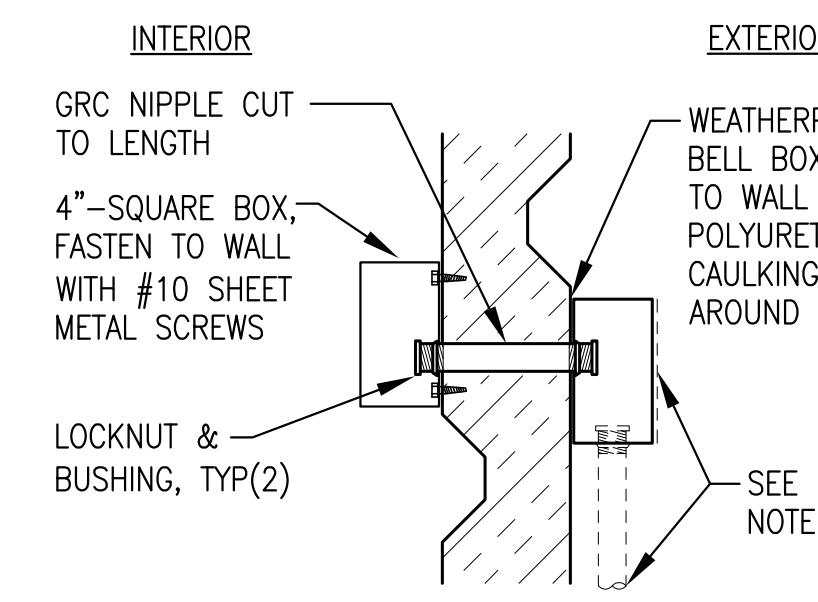

8 TYP EXTERIOR DEVICE INSTALLATION
E3.3 NO SCALE

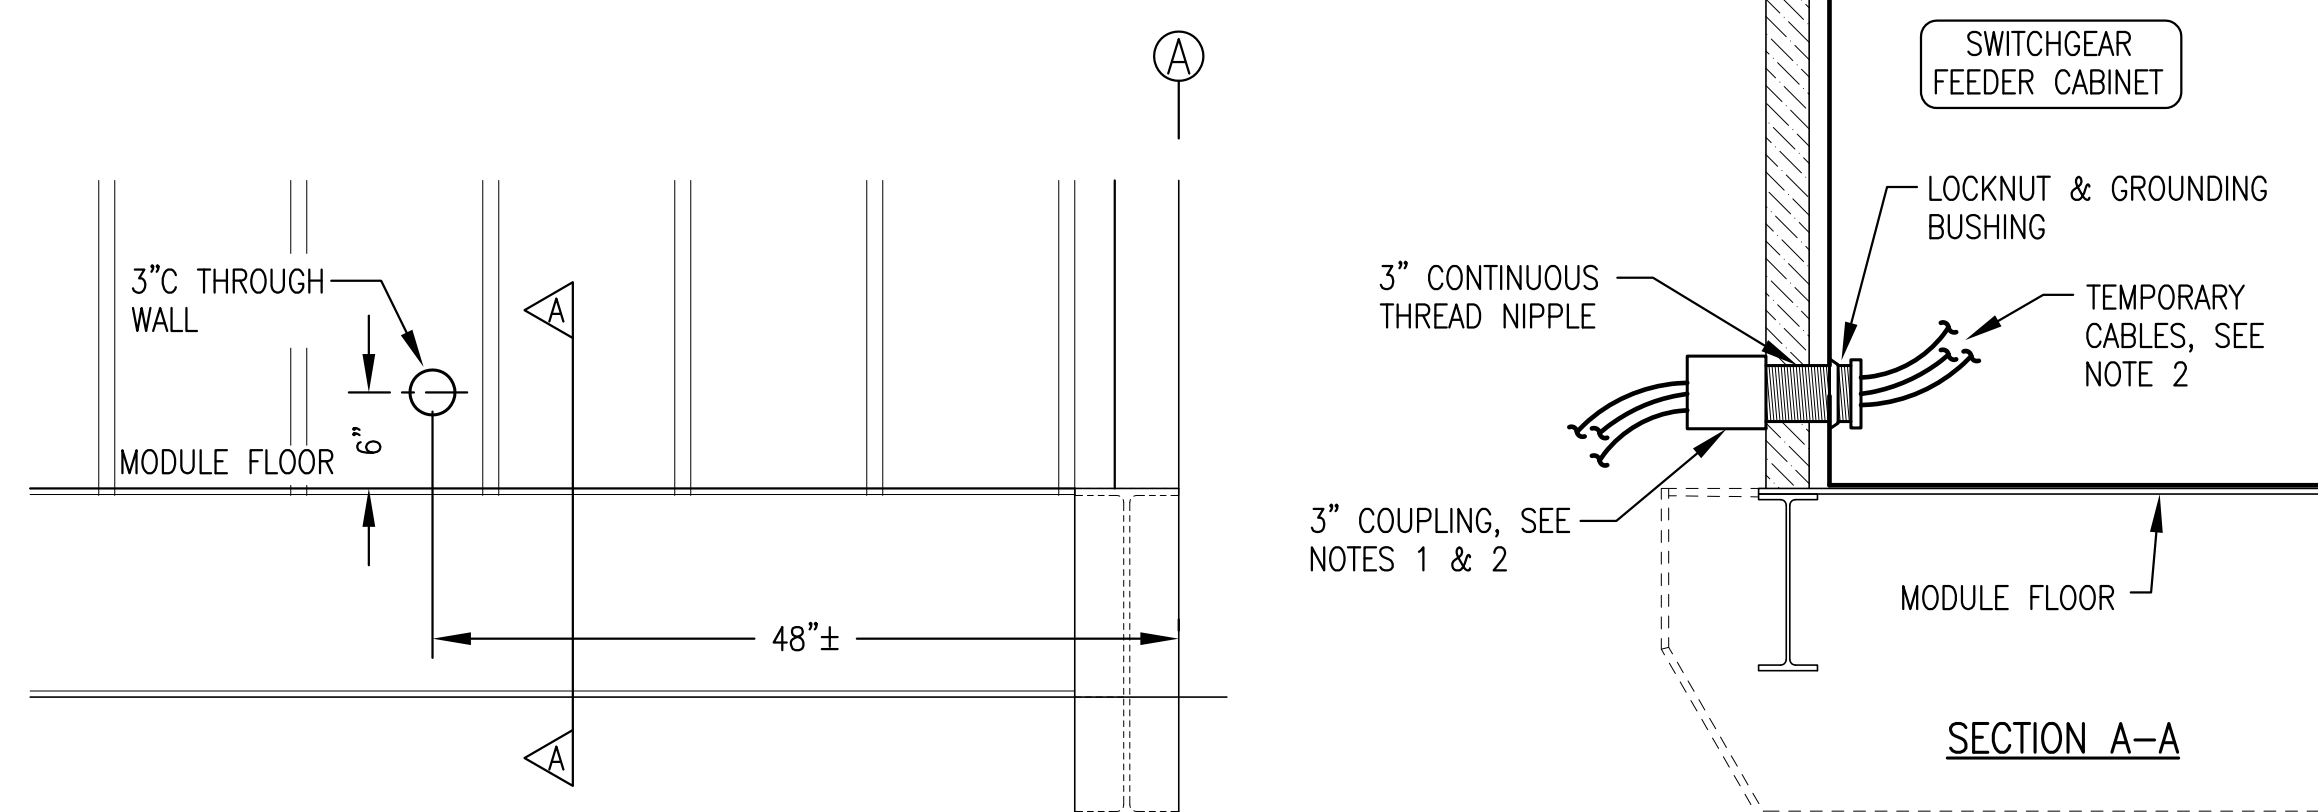


9 FEEDER ENTRANCE DETAIL
E3.3 1"=1'-0"

FEEDER SHOP/ON-SITE NOTES:


- 1) DURING SHOP FABRICATION INSTALL WALL PENETRATION AS SHOWN AND SEAL COUPLING TO EXTERIOR WALL WITH POLYURETHANE CAULK ALL AROUND.
- 2) USE WALL PENETRATION TO ROUTE TEMPORARY CABLES TO LOAD BANK FOR TESTING. AFTER TESTING INSTALL THREADED PLUG IN COUPLING.
- 3) INSTALL FEEDER TO TRANSFORMER AS PART OF ON-SITE WORK, SEE SHEET E2 FOR CONTINUATION.

ISSUED FOR CONSTRUCTION
JANUARY 2019

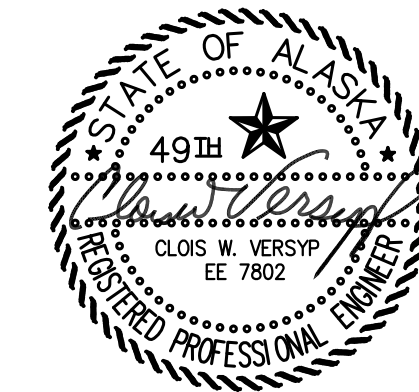


PROJECT: PORT HEIDEN RURAL POWER SYSTEM POWER PLANT UPGRADE	
TITLE: ELEVATIONS & DETAILS	
DRAWN BY: JTD	SCALE: AS NOTED
DESIGNED BY: CWV/BCG	DATE: 1/14/19
FILE NAME: PTH PPU E3-E5	SHEET: E3.3 OF 7
PROJECT NUMBER:	


Gray Stassel Engineering, Inc.
P.O. 111405, Anchorage, AK 99511 (907)349-0100

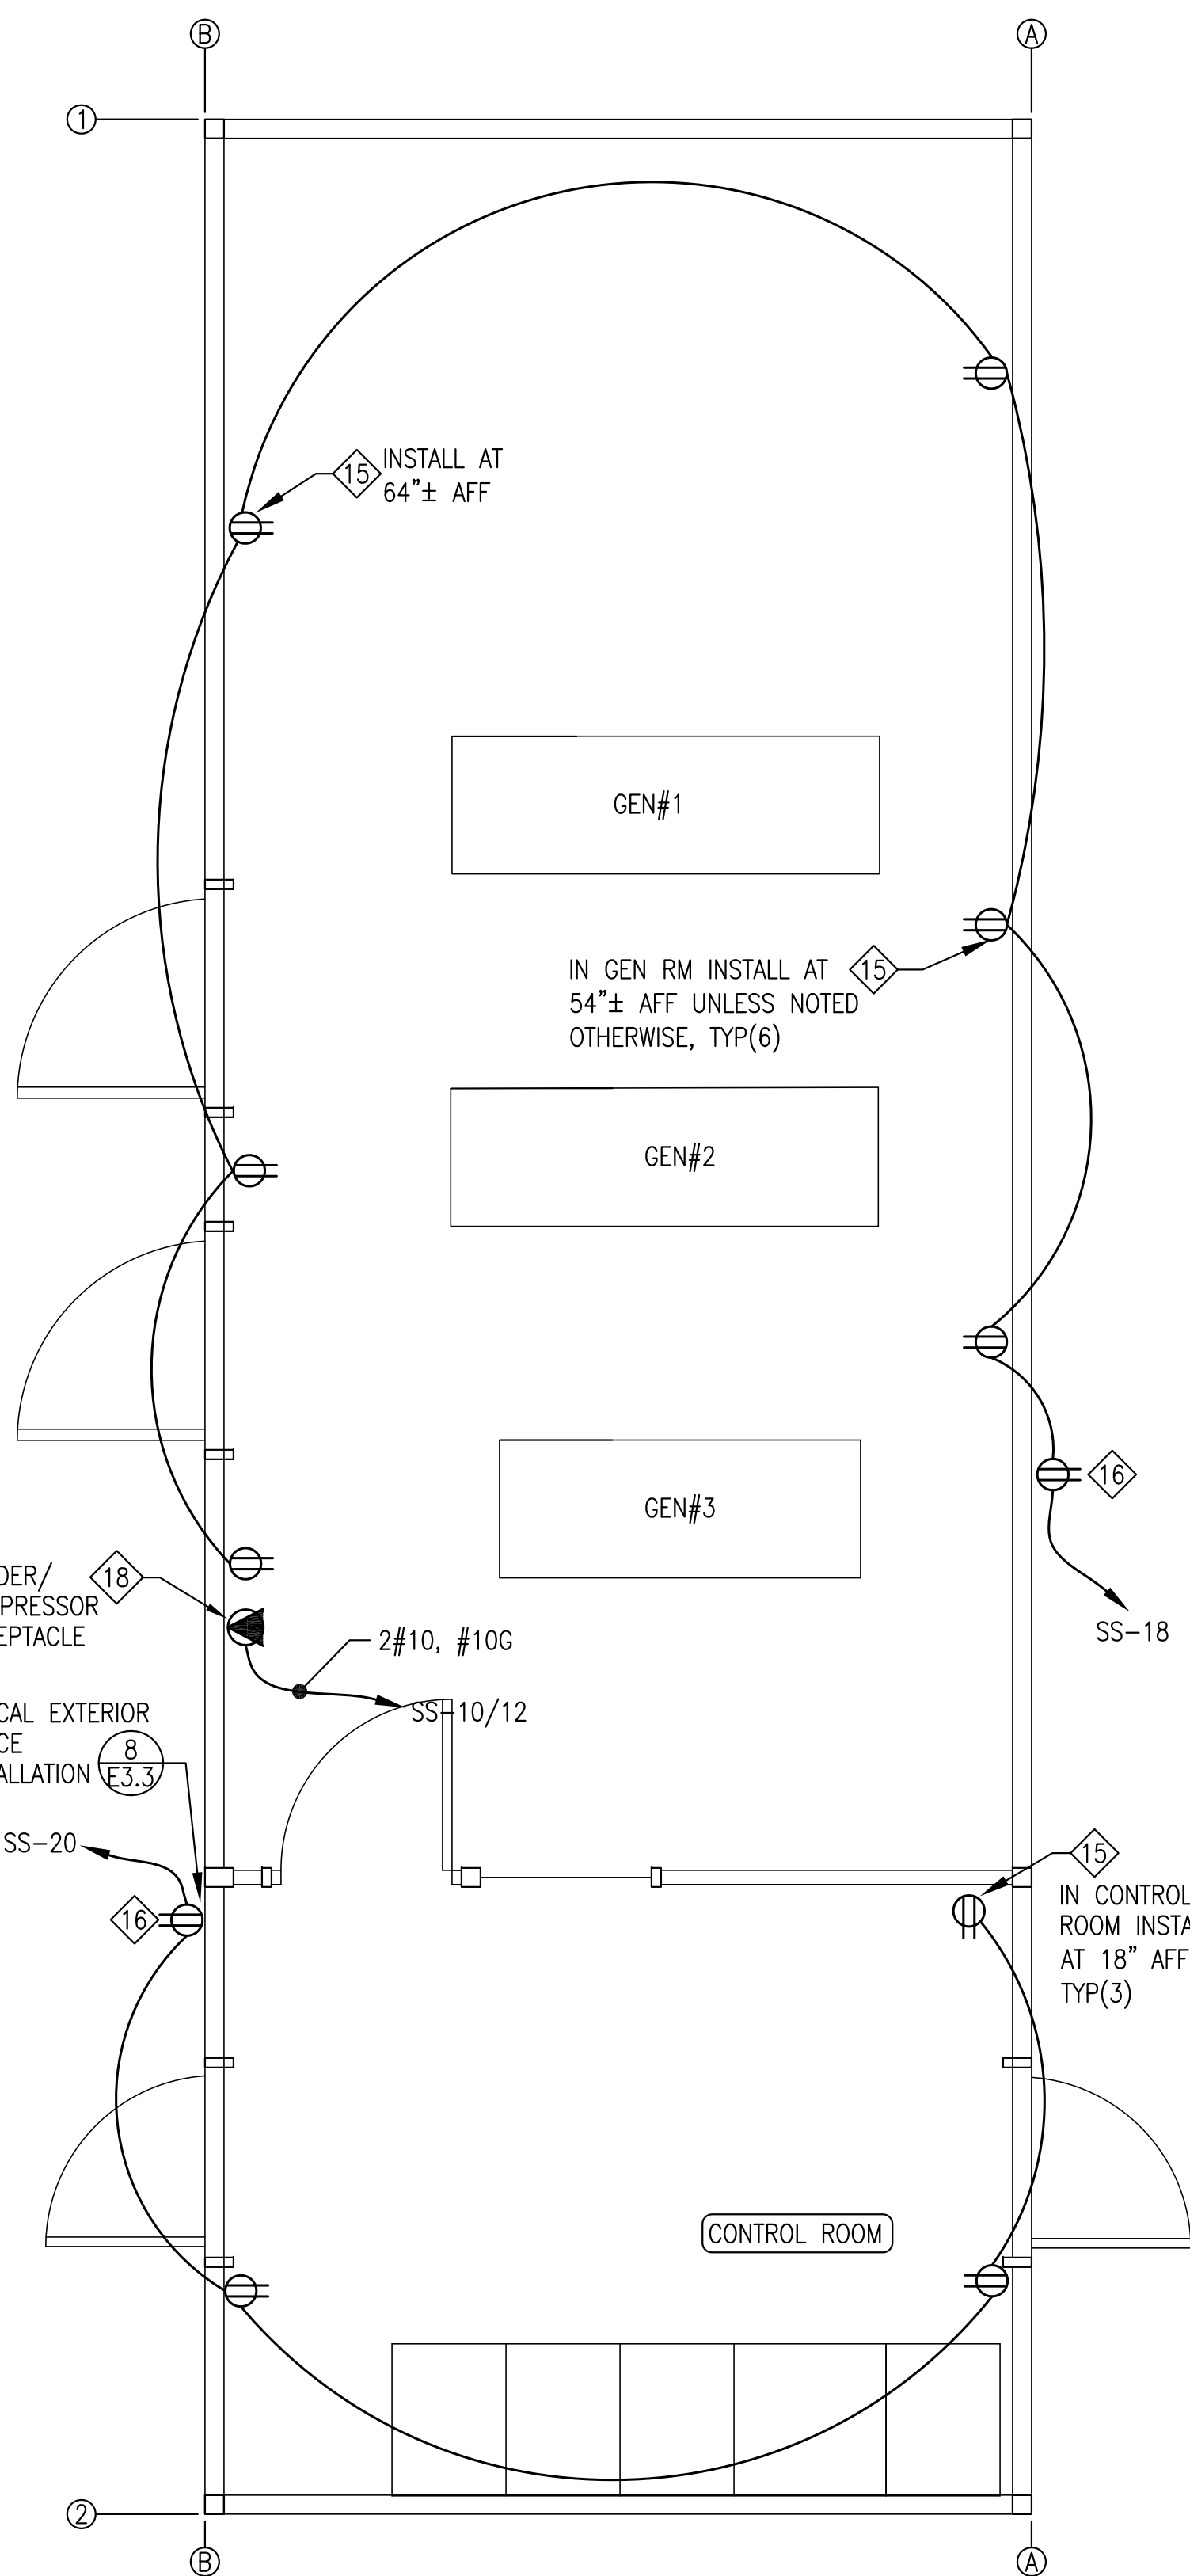


NOTE: ALL WIRING RUNS 2#12, #12G UNLESS SPECIFICALLY NOTED OTHERWISE.

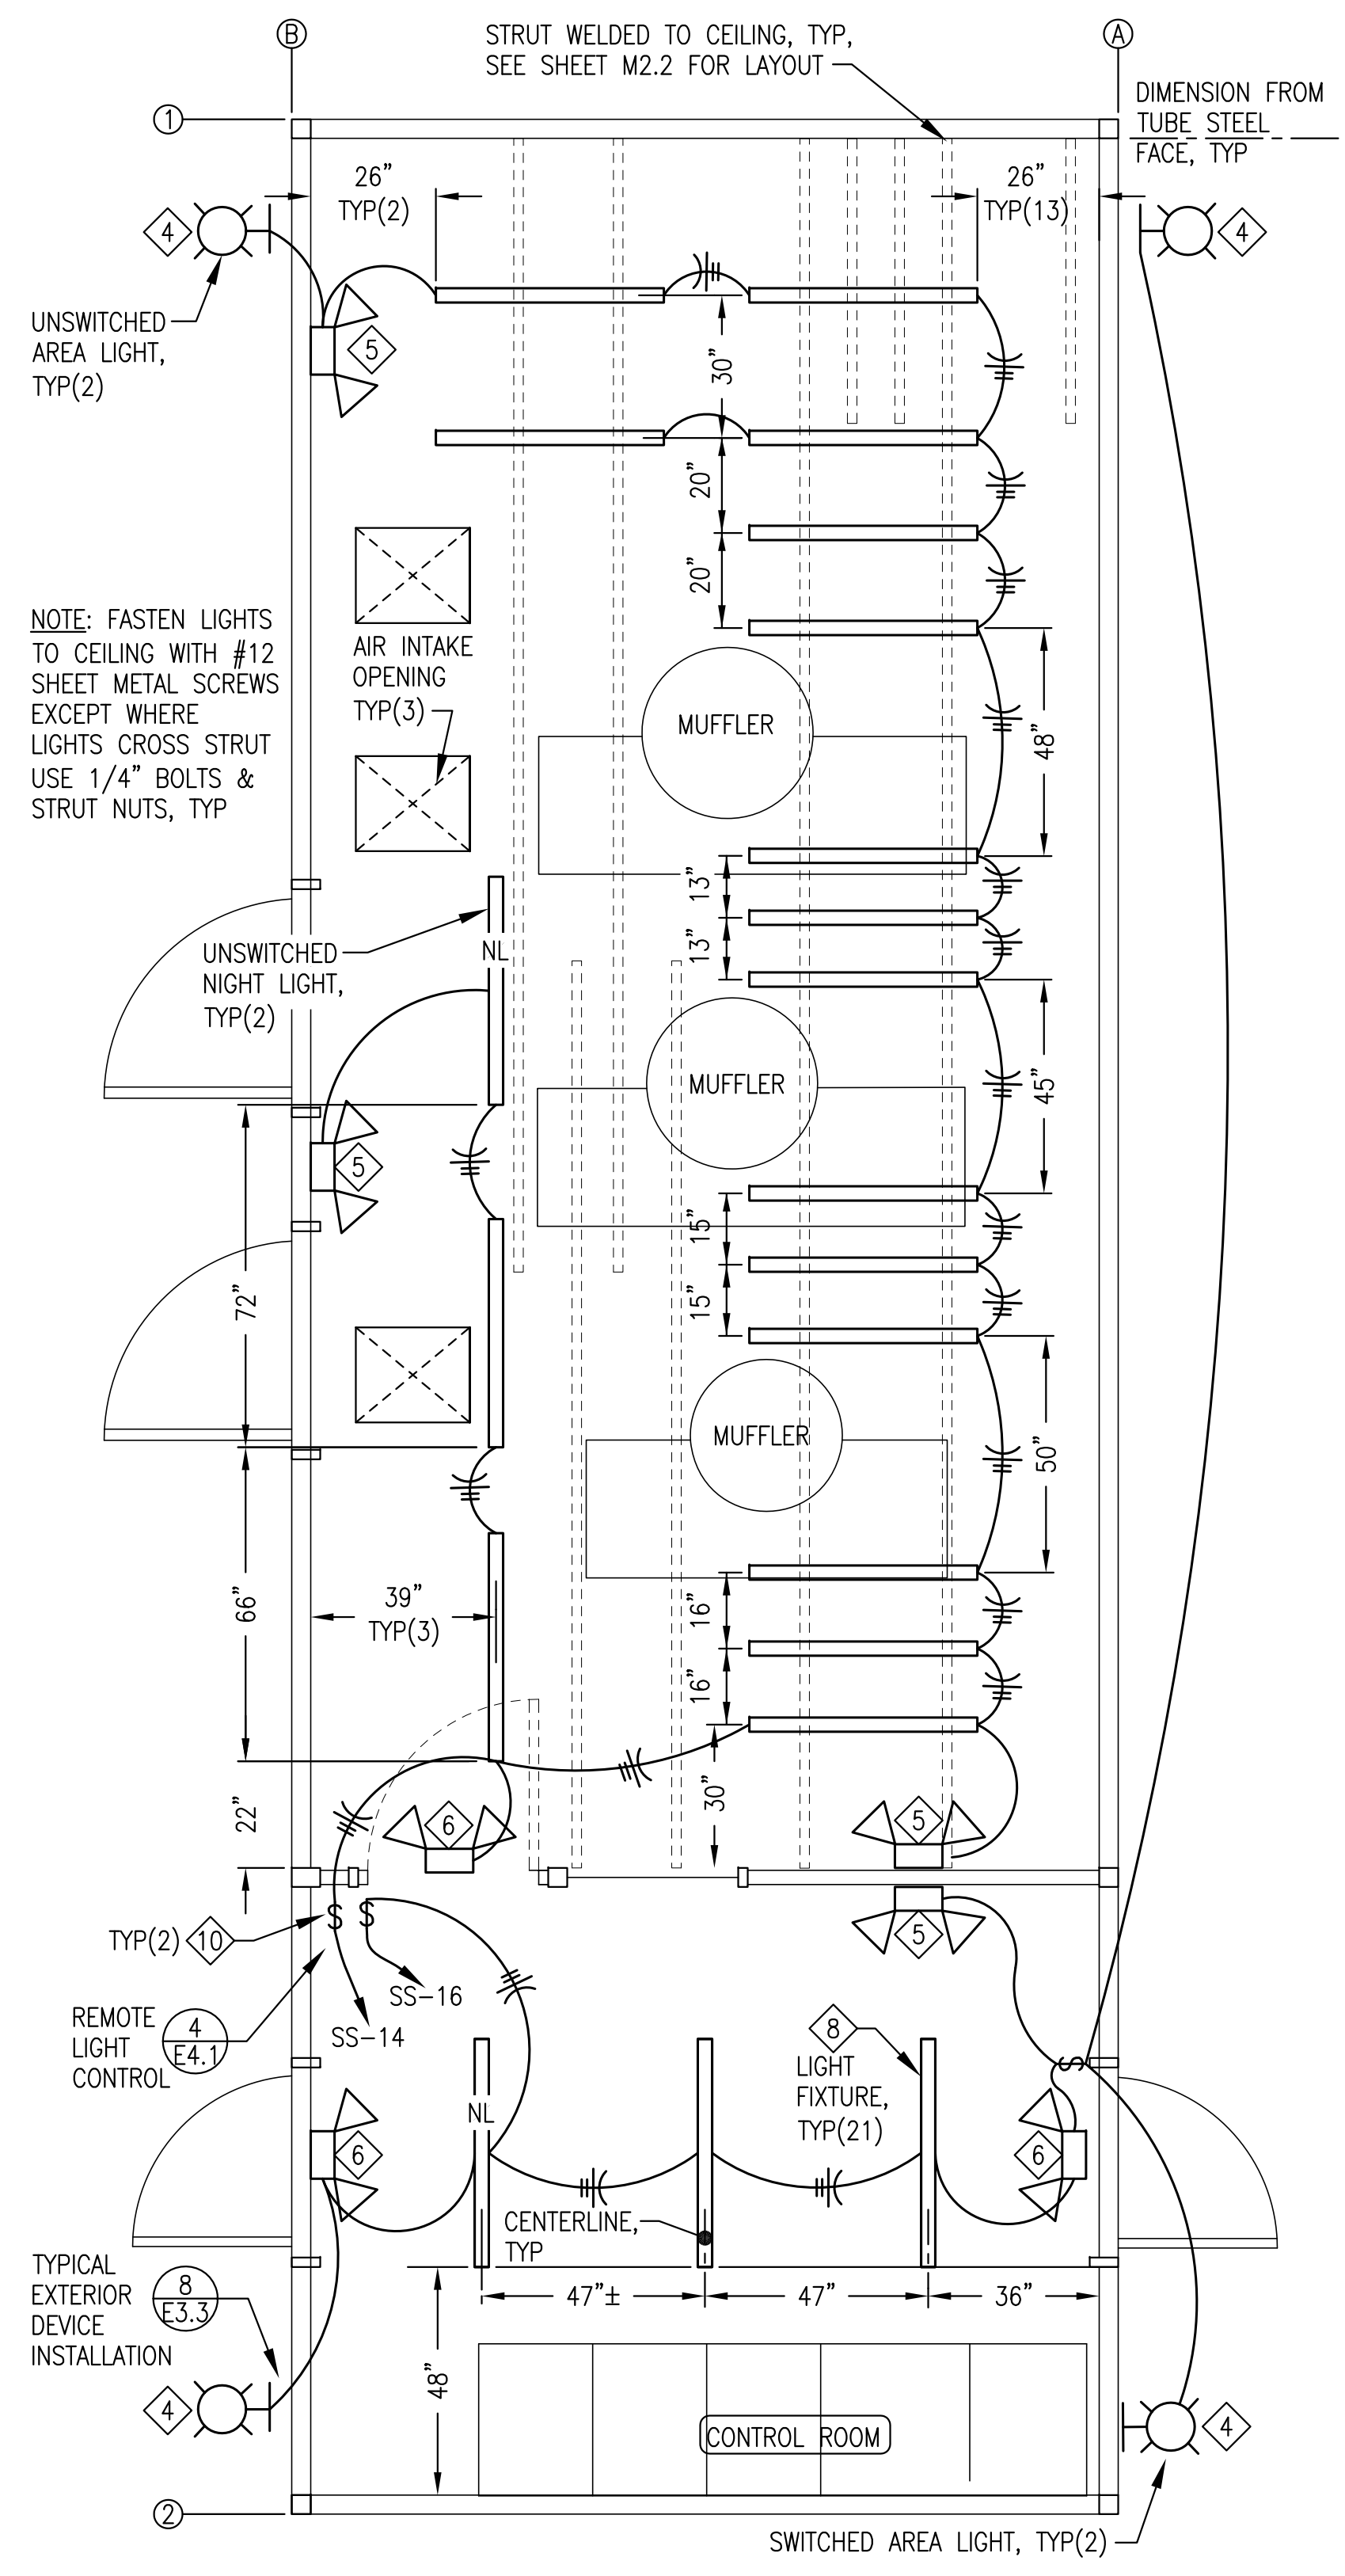

NOTE: ALL WIRING RUNS 2#12, #12G UNLESS SPECIFICALLY NOTED OTHERWISE.

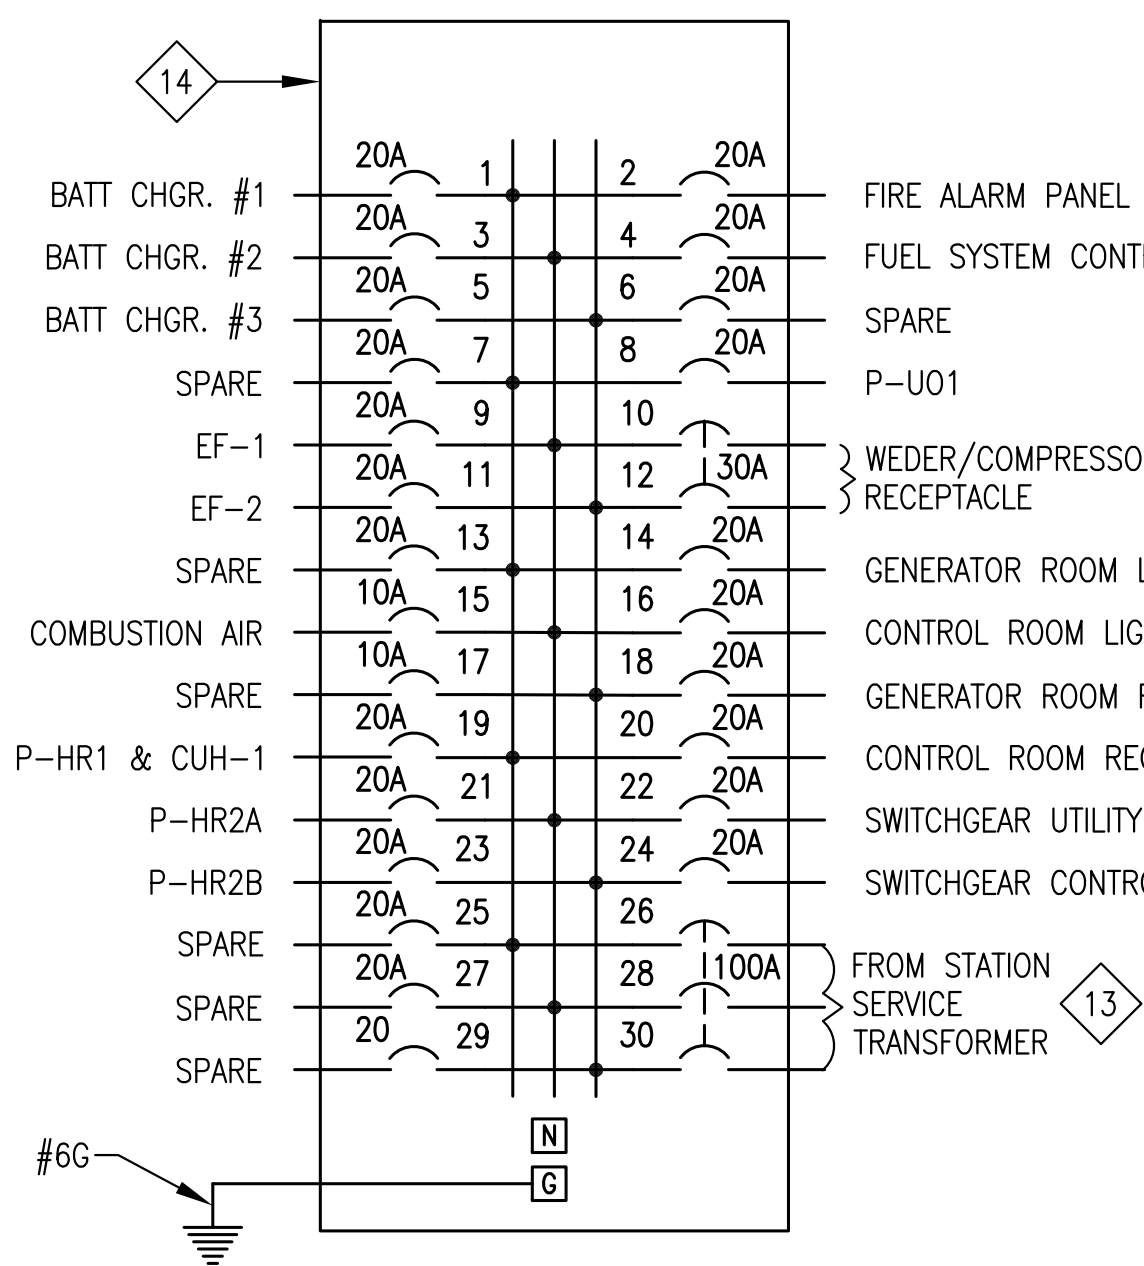

3 STATION SERVICE PANEL "SS"
E4.1 NO SCALE

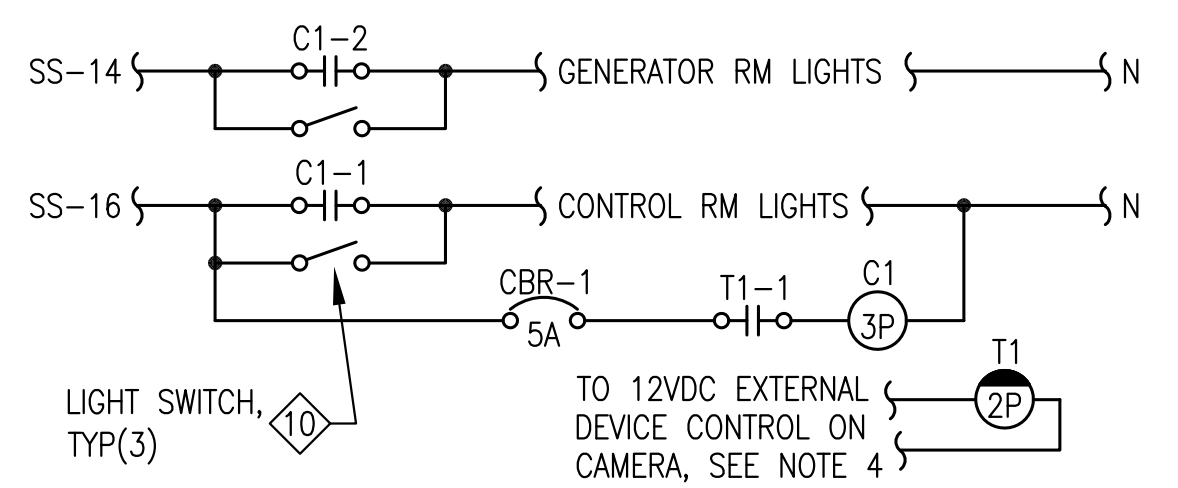

NOTES:

- INSTALL CONTACTOR, TIMER RELAY, AND CIRCUIT BREAKER IN 12"x12"x6" NEMA 1 JUNCTION BOX ON WALL ABOVE LIGHT SWITCHES.
- ALL LIGHTING CIRCUIT WIRING MIN #12 AWG. ALL 5A CONTROL CIRCUIT WIRING MIN #16AWG.
- SET TIMER FOR 5 MINUTES, SINGLE SHOT MODE.
- CONNECT TO CONFIGURABLE OUTPUT PINS ON CAMERA AND PROGRAM TO POWER RELAY ON CAMERA OPERATION.

BILL OF MATERIALS:

CBR1: 5A, 1P, RAIL MOUNT CIRCUIT BREAKER. ALLEN BRADLEY 1489-A1-050.

C1: 23A, 3P CONTACTOR, 120V COIL. ALLEN BRADLEY 100-C23D10.

T1: 10A, DPDT RELAY, 12VDC COIL, WITH SOCKET BASE AND TIMING MODULE. ALLEN BRADLEY 700-HA32Z12 RELAY WITH 700HN204 BASE AND 700HT3 SERIES B TIMING MODULE.


4 LIGHTING REMOTE CONTROL SCHEMATIC
E4.1 NO SCALE

BUILDING PLANS SYMBOL LEGEND			
SYMBOL	DESCRIPTION	SYMBOL	DESCRIPTION
SS-##	HOME RUN TO PANEL & BREAKER(S) INDICATED. SHORT DASH INDICATES HOT CONDUCTOR, LONG DASH INDICATES NEUTRAL CONDUCTOR, CURVED DASH INDICATES GROUND CONDUCTOR. IF NOT SPECIFICALLY INDICATED, PROVIDE 2#12 AWG & 1#12 AWG GROUND.		125V, 20A, DUPLEX RECEPTACLE
			LINE VOLTAGE THERMOSTAT
			DIGITAL THERMOSTAT, MODULATING SNAP SWITCH / SMALL MOTOR DISCONNECT
	MOTOR (HORSEPOWER INDICATED)		TIMER SWITCH
	MOTORIZED DAMPER - SEE MECHANICAL		GROUND

1 RECEPTACLE PLAN
E4.1 3/8"=1'-0"

2 LIGHTING PLAN
E4.1 3/8"=1'-0"

ISSUED FOR CONSTRUCTION
JANUARY 2019

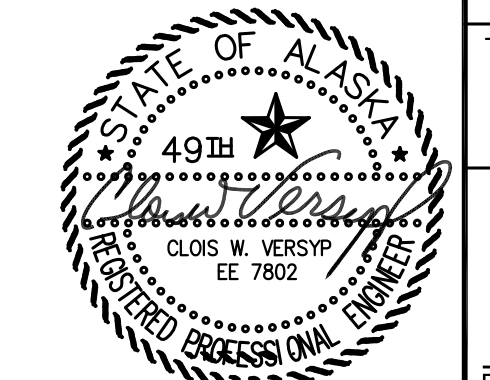


ALASKA ENERGY AUTHORITY

PROJECT: PORT HEIDEN RURAL POWER SYSTEM
POWER PLANT UPGRADE

TITLE: RECEPTACLE & LIGHTING PLANS,
& STATION SERVICE PANEL

DRAWN BY: JTD	SCALE: AS NOTED
DESIGNED BY: CWV/BCG	DATE: 1/14/19
FILE NAME: PTH PPU E3-E5	SHEET: E4.1 OF 7
PROJECT NUMBER:	

Gray Stassel Engineering, Inc.
P.O. 111405, Anchorage, AK 99511 (907)349-0100

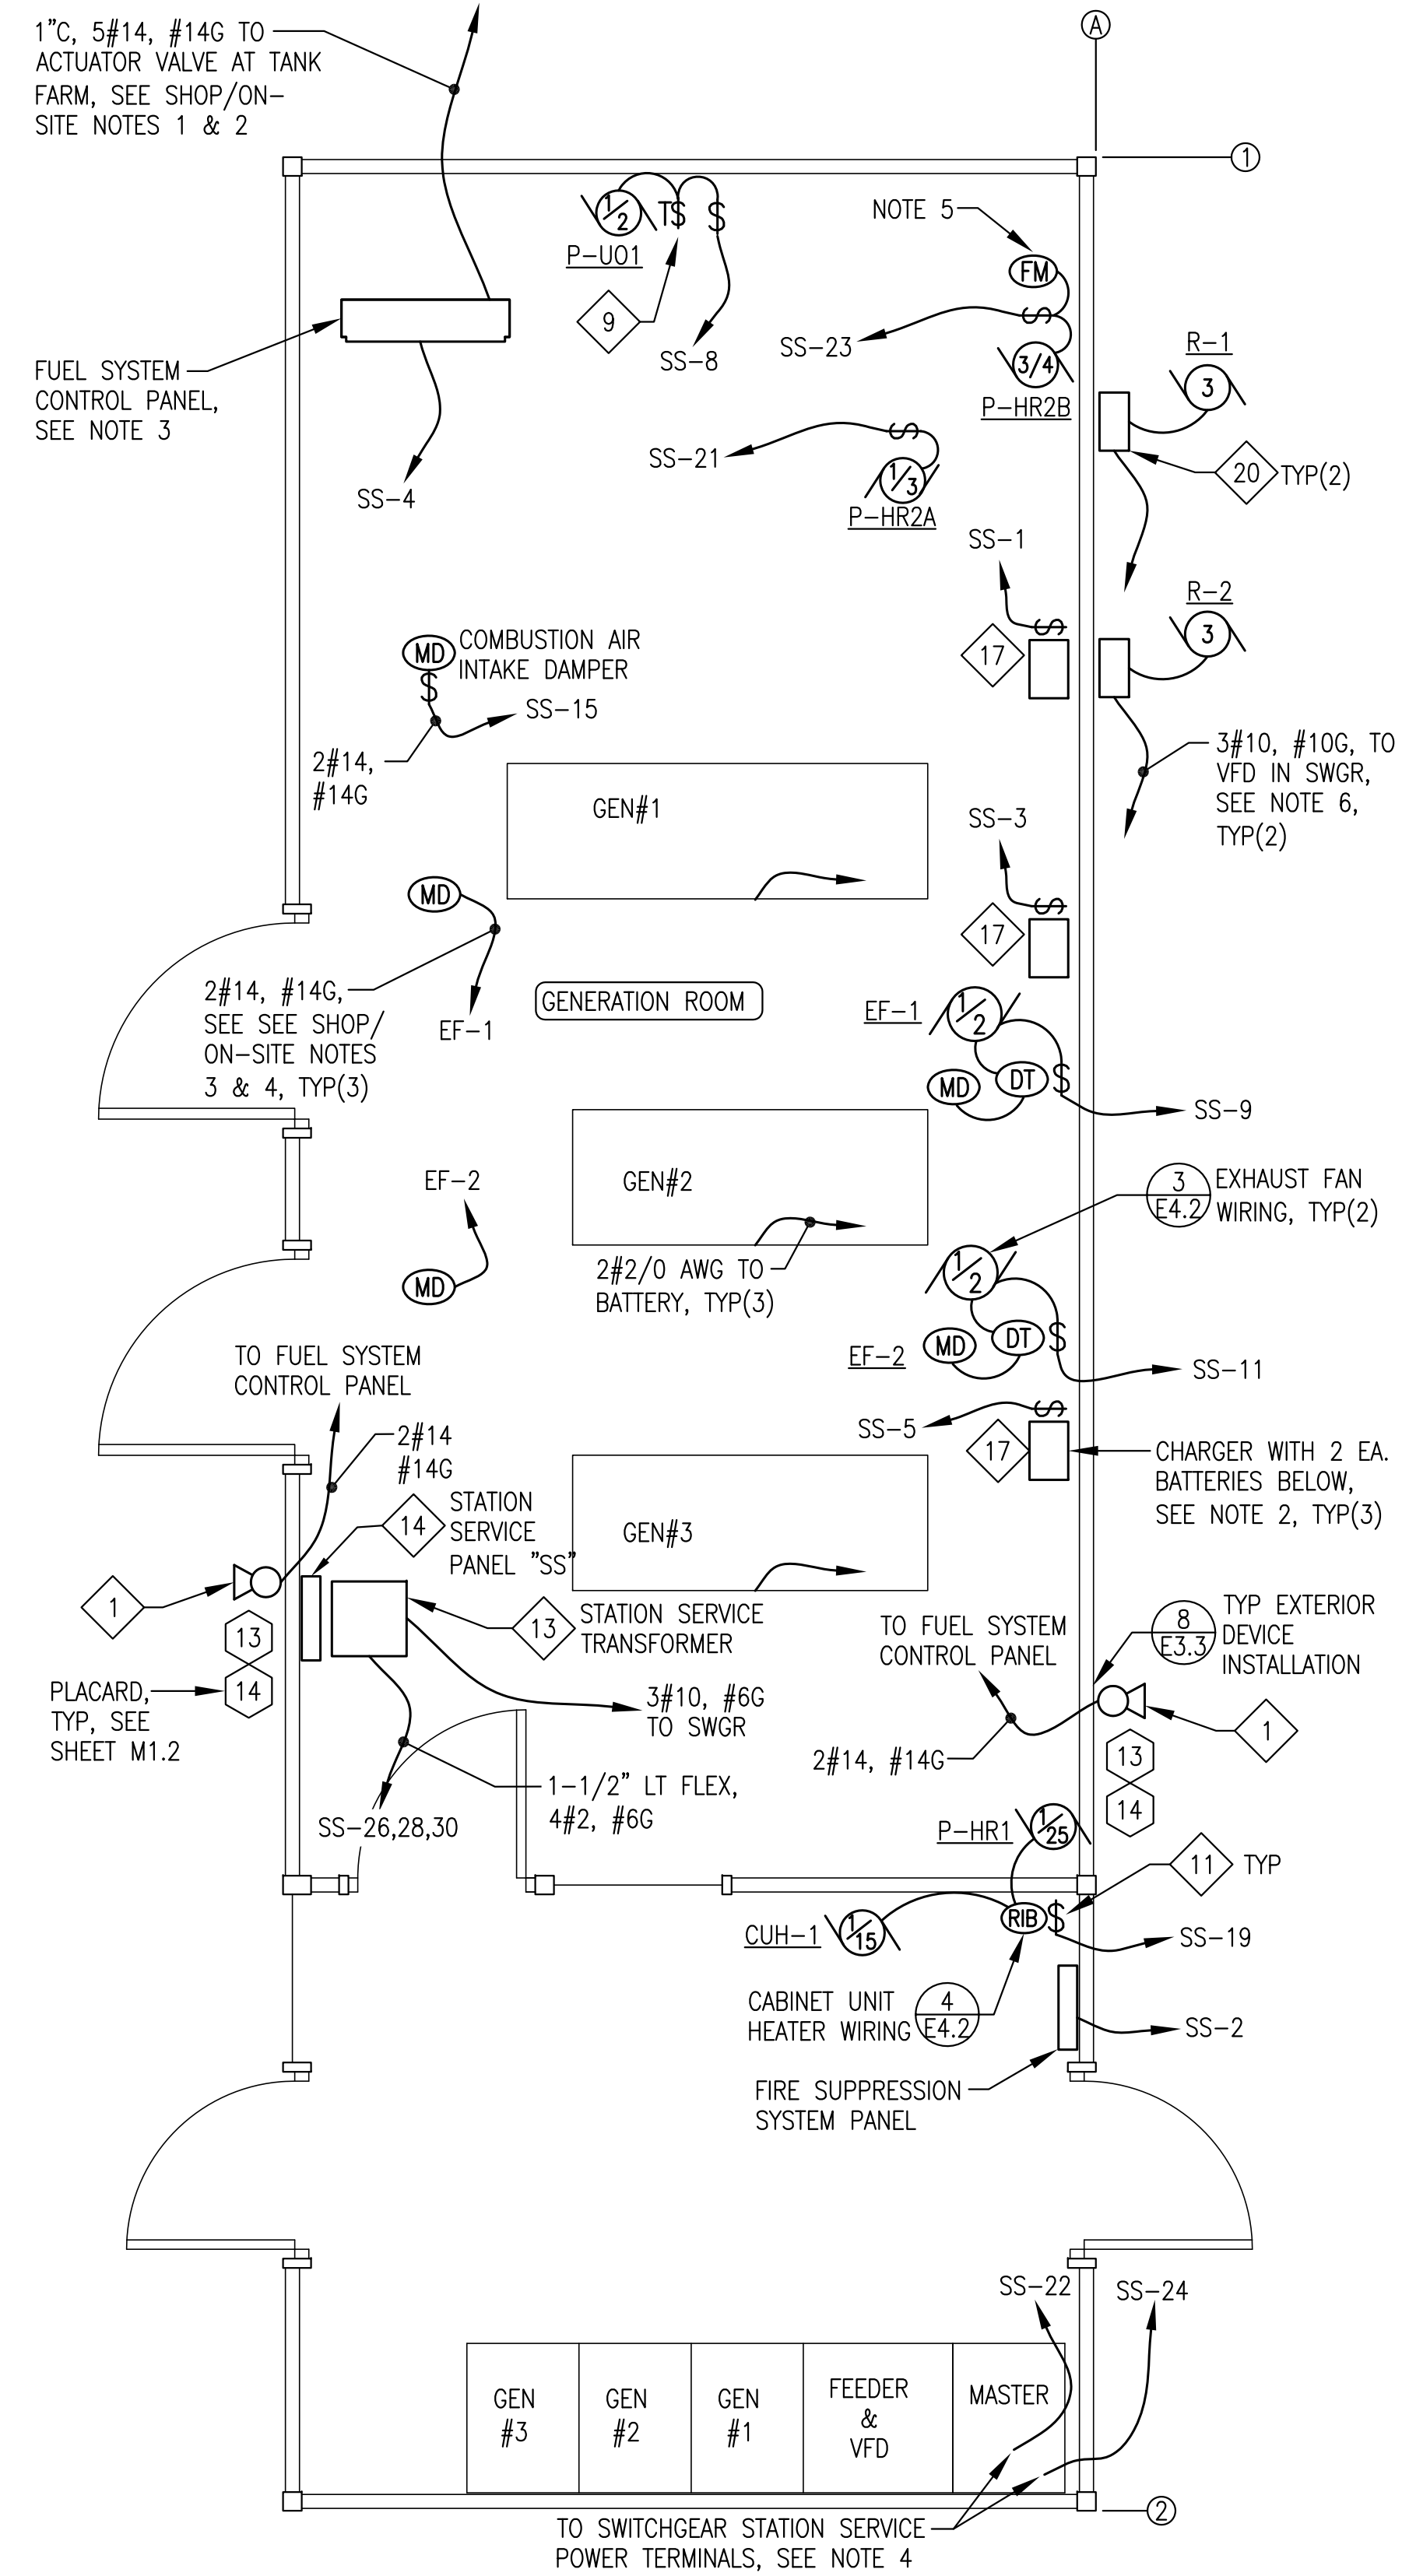


STATION SERVICE GENERAL NOTES:


- 1) ALL WIRING RUNS 2#12, #12G UNLESS SPECIFICALLY NOTED OTHERWISE.
- 2) MOUNT BATTERY CHARGER TO WALL ON SHALLOW STRUT AND INSTALL BATTERIES ON FLOOR BELOW, SEE ELEVATION 1/E3.2.
- 3) SEE SHEETS E7.1-E7.3 FOR DAY TANK CONTROL PANEL DESIGN. ALL ACCESSORIES NOT SHOWN ON PLANS. SEE LOGIC DIAGRAMS FOR ADDITIONAL DETAIL.
- 4) SEE SWITCHGEAR SHOP DRAWINGS FOR TERMINATION OF ALL POWER AND CONTROL WIRING.
- 5) INSTALL FLOW METER FOR HEAT RECOVERY MONITORING WHERE SHOWN ON HEAT RECOVERY PIPING ISOMETRIC. PROVIDE POWER FROM P-HR2B DISCONNECT.
- 6) RADIATOR VFD POWER CONDUCTORS OVERSIZED FOR 80% DE-RATE. DO NOT ROUTE IN WIREWAY. ROUTE IN SEPARATE EXTERIOR CONDUIT, SEE ELEVATION 1/E3.3.

STATION SERVICE SHOP/ON-SITE NOTES:


- 1) DURING SHOP FABRICATION INSTALL WALL PENETRATION AND CONDUIT INTO DAY TANK PANEL. SEE ELEVATION 5/E3.2.
- 2) AS PART OF ON-SITE WORK INSTALL CONDUIT AND CONDUCTORS TO TANK FARM, SEE SHEET E2.
- 3) DURING SHOP FABRICATION INSTALL CEILING MOUNTED BOX ADJACENT TO DAMPER ACTUATOR AND TEMPORARILY CONNECT DAMPER TO VERIFY OPERATION.
- 4) AS PART OF ON-SITE WORK INSTALL CONDUIT AND CONDUCTORS TO DAMPER ACTUATOR. SEE SHEET M7.

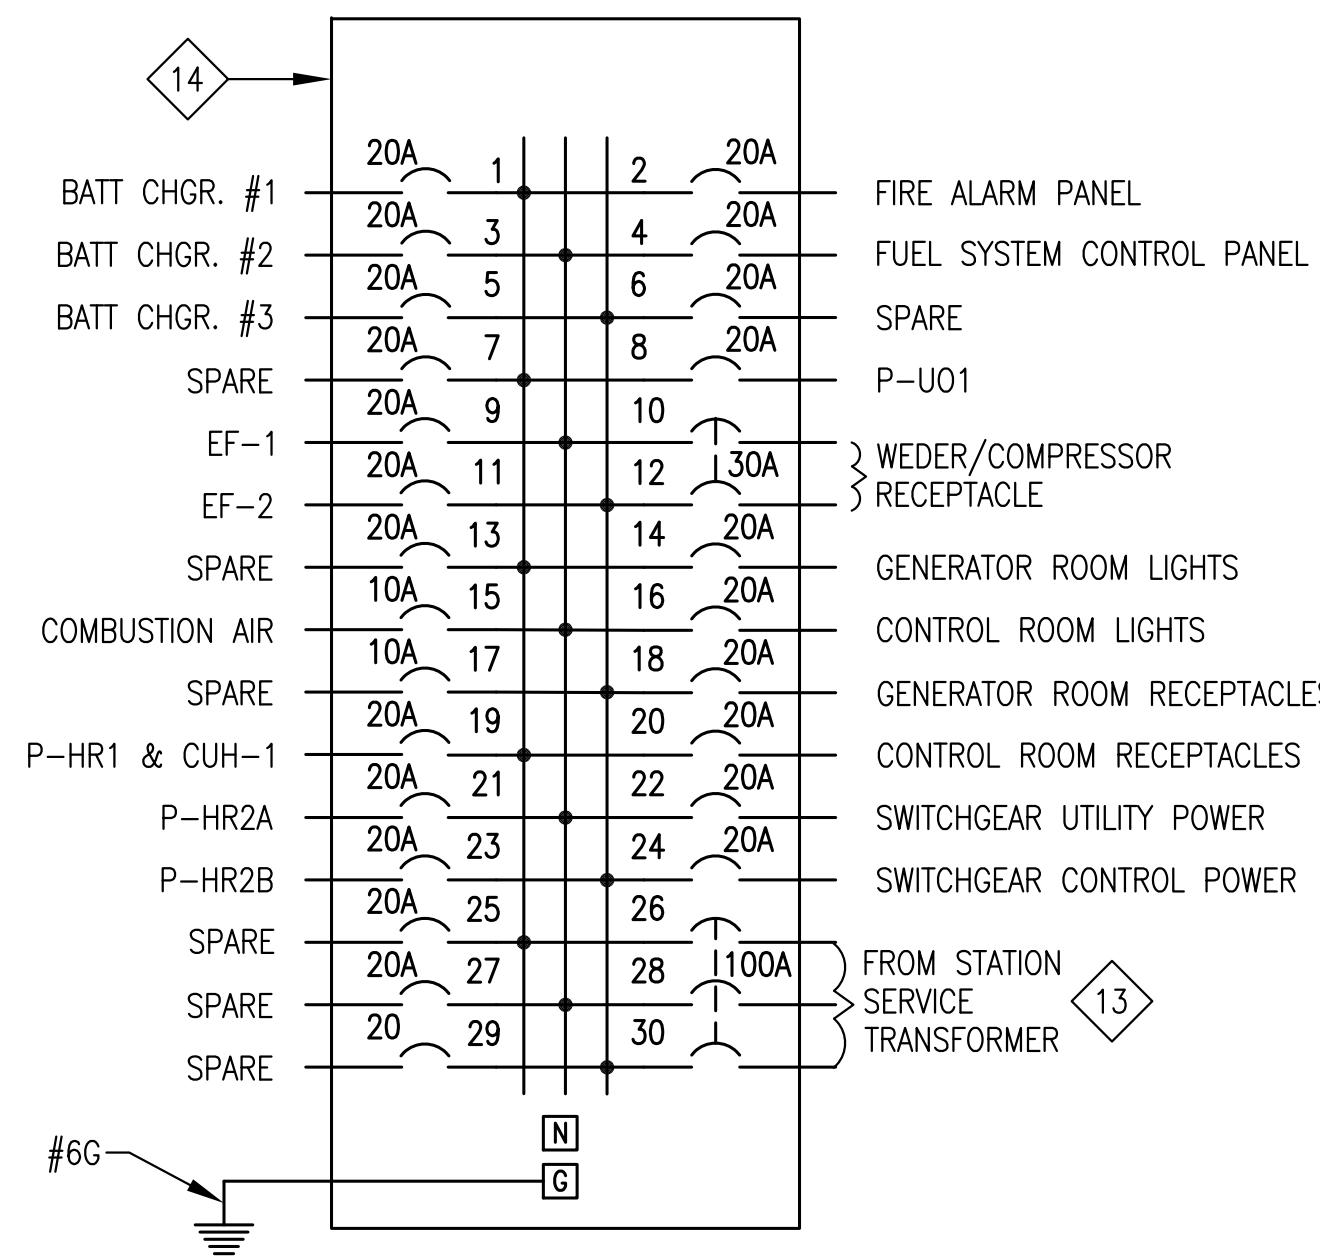

2 STATION SERVICE PANEL "SS"
E4.2 NO SCALE

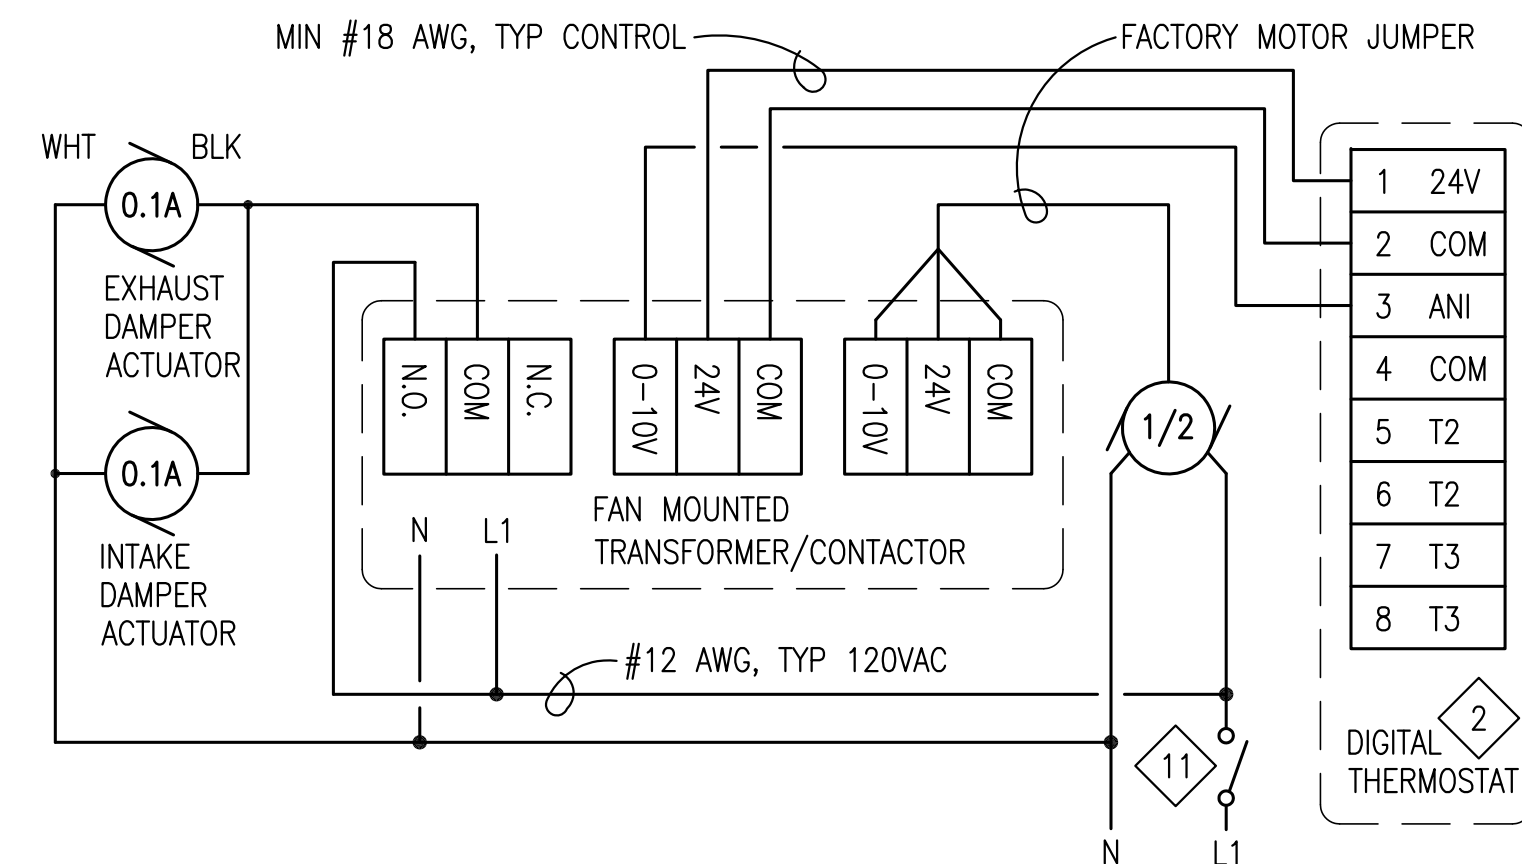


3 EXHAUST FAN WIRING DIAGRAM
E4.2 NO SCALE

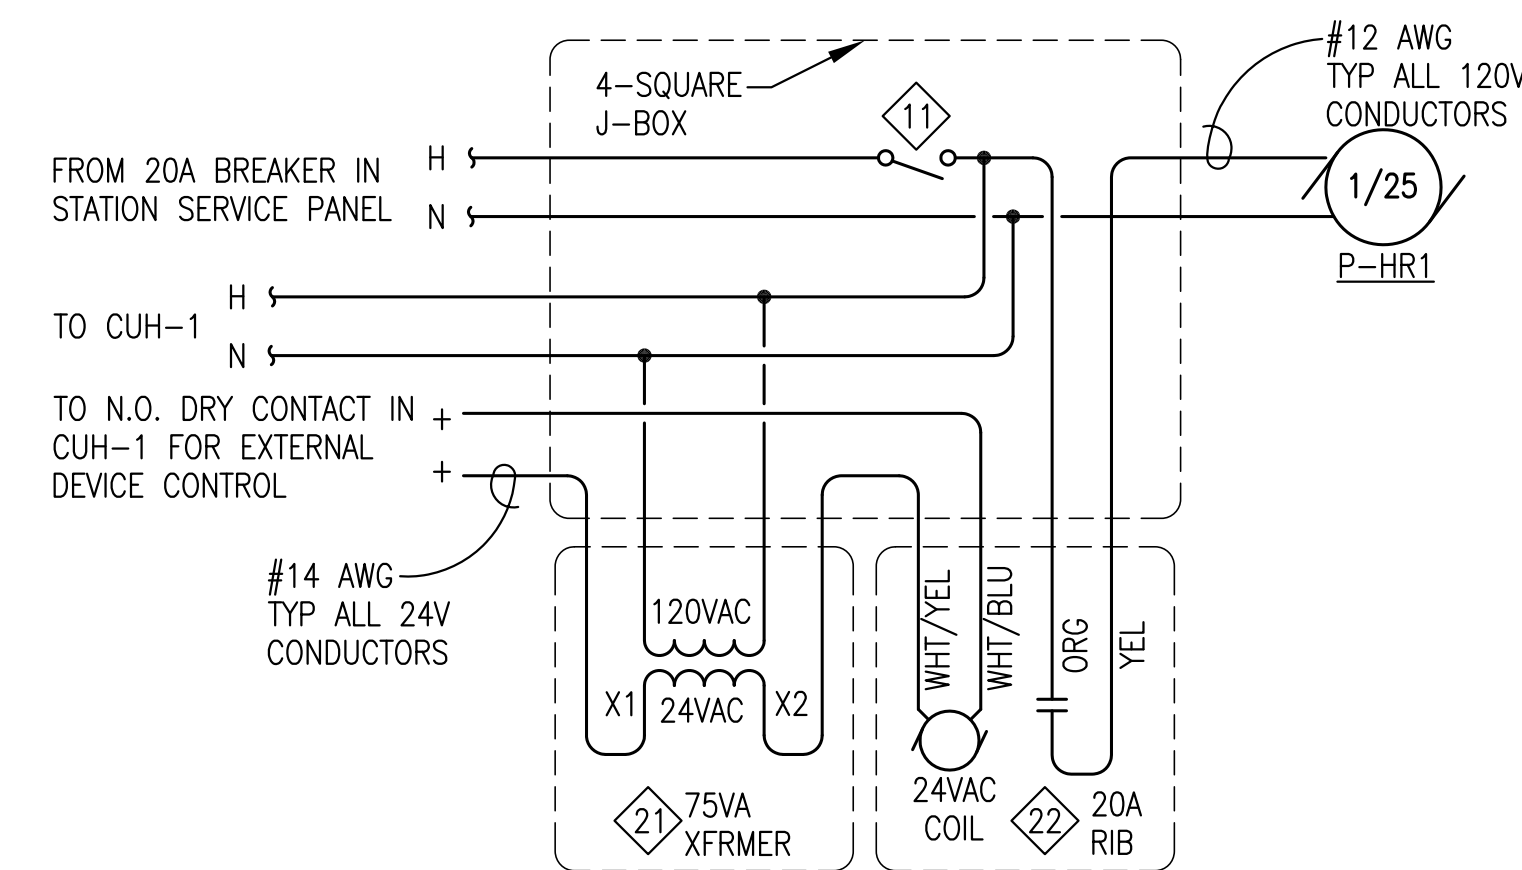

4 CUH-1 WIRING DIAGRAM
E4.2 NO SCALE


1 STATION SERVICE PLAN
E4.2 3/8"=1'-0"

ISSUED FOR CONSTRUCTION
JANUARY 2019

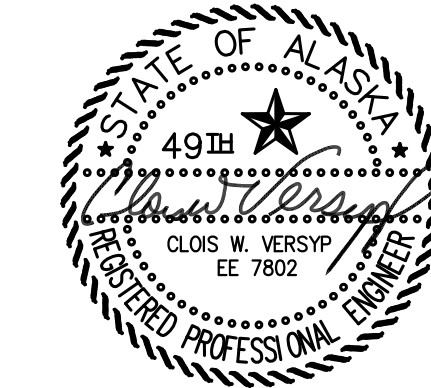

ALASKA ENERGY AUTHORITY	
PROJECT:	PORT HEIDEN RURAL POWER SYSTEM POWER PLANT UPGRADE
TITLE:	STATION SERVICE PLAN, DETAILS, & PANEL
DRAWN BY: JTD	SCALE: AS NOTED
DESIGNED BY: BCG	DATE: 1/14/19
FILE NAME: PTH PPU E3-35	SHEET: E4.2 OF 7
PROJECT NUMBER:	

Gray Stassel Engineering, Inc.
P.O. 111405, Anchorage, AK 99511 (907)349-0100

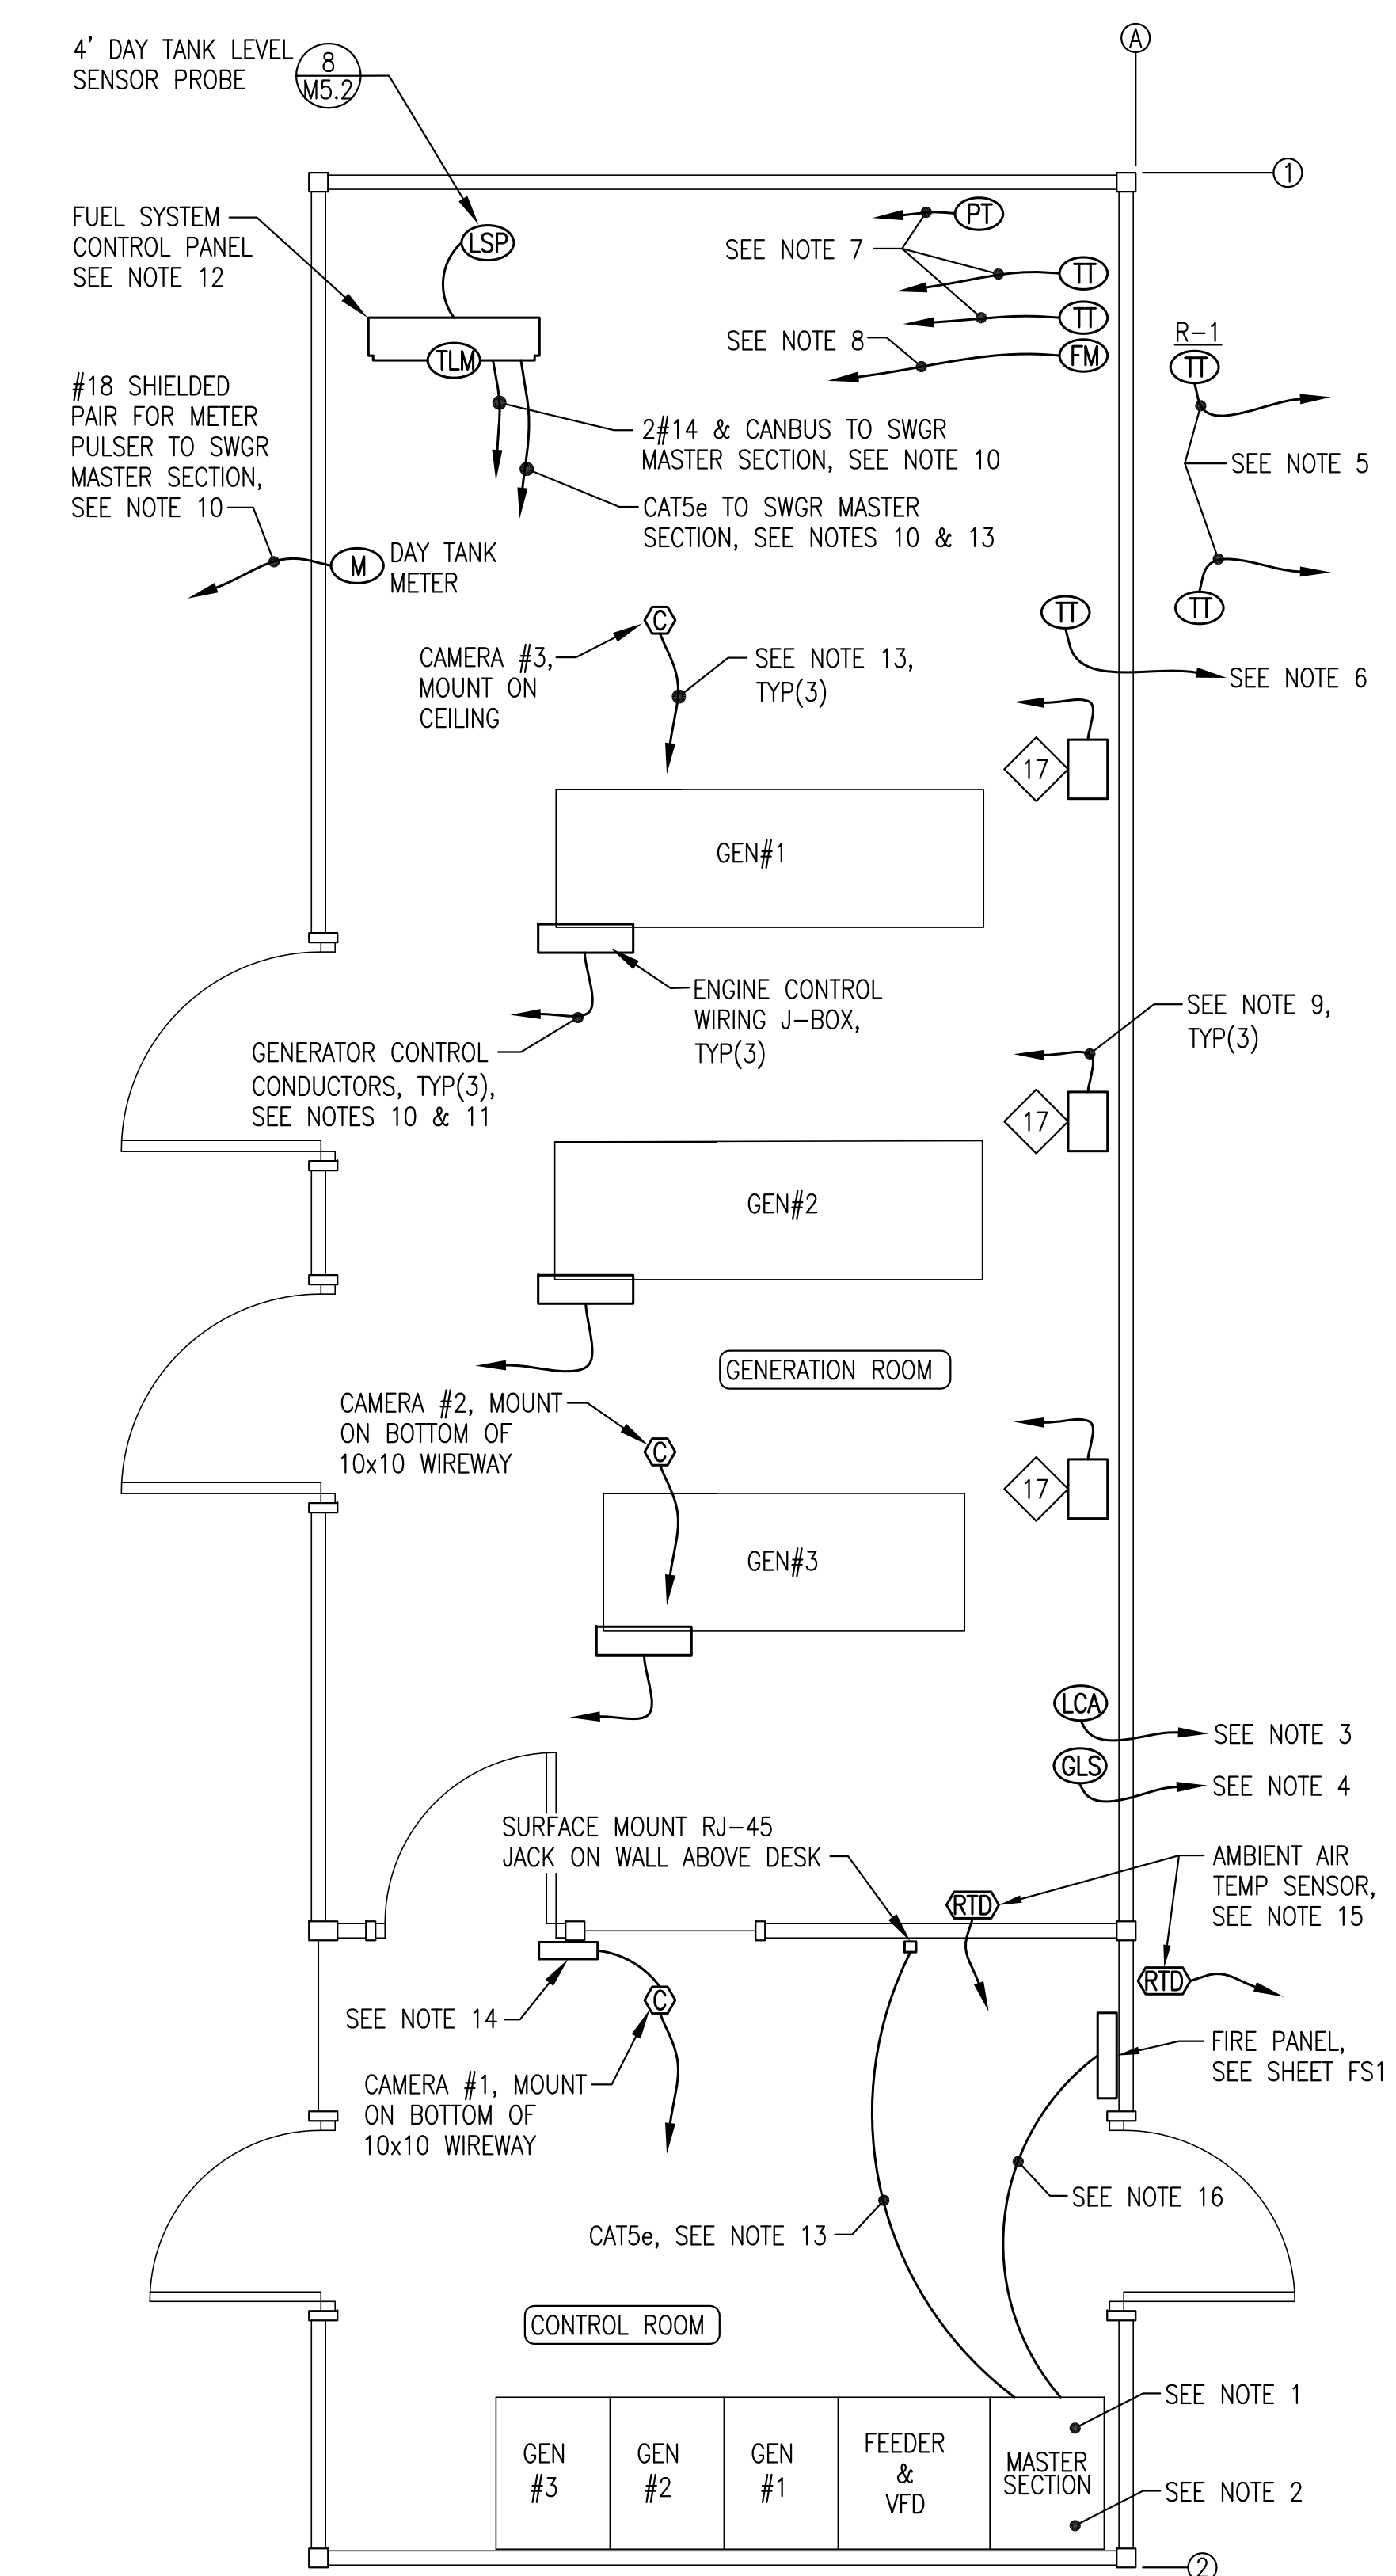


INSTRUMENTATION & DATA PLAN NOTES:

1. INSTALL CAMERA POE+ SWITCH INSIDE MASTER SECTION. CONNECT TO 120VAC CONTROL POWER AND TO ETHERNET SWITCH, SEE NOTE 10.
2. INSTALL ROUTER ON TOP OF MASTER SECTION IN RACK OR CABINET. CONNECT TO 120VAC UPS AND TO ETHERNET SWITCH, SEE NOTE 10.
3. LOW COOLANT LEVEL ALARM SWITCH INSTALLED AT EXPANSION TANK, SEE MECHANICAL. CONNECT TO N.C. SWITCH (WHITE & RED) AND ROUTE 2#14 TO SWITCHGEAR MASTER SECTION. SEE NOTE 10.
4. GLYCOL LEVEL SENSOR PROBE INSTALLED IN EXPANSION TANK, SEE MECHANICAL. ROUTE #18 SHIELDED PAIR TO SWITCHGEAR. SEE NOTE 10.
5. INSTALL TEMP TRANSMITTER IN EACH RADIATOR, SEE DETAIL 3/E3.3. ROUTE #18 SHIELDED PAIR FROM EACH TO SWITCHGEAR VFD SECTION, SEE NOTE 10.
6. INSTALL COOLANT RETURN TEMP TRANSMITTER IN PIPING MAIN WHERE SHOWN ON COOLING PIPING ISOMETRIC. ROUTE #18 SHIELDED PAIR TO SWITCHGEAR MASTER SECTION, SEE NOTE 10.
7. INSTALL TWO TEMP TRANSMITTERS AND ONE PRESSURE TRANSMITTER FOR HEAT RECOVERY MONITORING WHERE SHOWN ON HEAT RECOVERY PIPING ISOMETRIC 2/M4.2. ROUTE #18 SHIELDED PAIR FROM EACH TO SWITCHGEAR MASTER SECTION. SEE NOTE 10.
8. INSTALL FLOW METER FOR HEAT RECOVERY MONITORING WHERE SHOWN ON HEAT RECOVERY PIPING ISOMETRIC. PROVIDE POWER FROM P-HR2B DISCONNECT. ROUTE #18 SHIELDED PAIR TO SWITCHGEAR MASTER SECTION. SEE NOTE 10.
9. ROUTE 2#14 FROM BATTERY CHARGER ALARM CONTACTS TO ASSOCIATED SWITCHGEAR GENERATOR SECTION, SEE NOTE 10 AND WIRING DIAGRAM 2/E5.
10. SEE SWITCHGEAR SHOP DRAWINGS FOR TERMINATION OF ALL INSTRUMENTATION AND DATA WIRING INCLUDING CONTROL POWER.
11. ROUTE GENERATOR CONTROL CONDUCTORS TO SWITCHGEAR IN 10x10 WIREWAY WITH POWER CONDUCTORS. SEE SHEETS E3.1, E6.3, AND NOTE 10.
12. SEE SHEETS E7.1-E7.3 FOR FUEL SYSTEM CONTROL PANEL DESIGN. ALL ACCESSORIES NOT SHOWN ON PLANS. SEE LOGIC DIAGRAMS FOR ADDITIONAL DETAIL.
13. ROUTE CAT5e CONDUCTORS FROM EACH CAMERA TO POE+ SWITCH IN MASTER SECTION. ROUTE CAT5e CONDUCTORS FROM FUEL SYSTEM PANEL, FIRE SUPPRESSION PANEL, AND RJ-45 JACK TO ETHERNET SWITCH IN SWITCHGEAR MASTER SECTION. SEE NOTE 10. INSTALL ALL CAT5e CONDUCTORS IN SEPARATE DEDICATED RACEWAYS - DO NOT ROUTE WITH STATION SERVICE OR POWER CONDUCTORS.
14. INSTALL CONTACTOR WITH TIMER RELAY FOR REMOTE LIGHTING CONTROL. OPERATE FROM DRY CONTACT ON CAMERA #1. TIMER TO TURN LIGHTS ON FOR 5 MINUTES EACH TIME CAMERA IS OPERATED. SEE SCHEMATIC 4/E4.1.
15. RTD TEMPERATURE SENSOR PROVIDED WITH SWITCHGEAR. ROUTE #18 SHIELDED PAIR TO SWITCHGEAR MASTER SECTION. SEE NOTE 10.
16. ROUTE CAT5e FOR DATA AND 2#14 FOR GENERATOR SHUT DOWN FROM FIRE PANEL TO SWITCHGEAR MASTER SECTION, SEE NOTES 10 AND 13.

DATA DEVICE SCHEDULE

DEVICE/FUNCTION	DESCRIPTION	MANUFACTURER/MODEL
ROUTER - HIGH SPEED INTERNET	4-PORT GIGABIT ROUTER, DUAL 2.4 AND 5 GHz WIFI WITH ADJUSTABLE ANTENNAS, 4 GIGABIT LAN, 1 GIGABIT WAN, MINIMUM 256 MB RAM	ASUS RT-N66U OR APPROVED EQUAL
POE+ - POWER OVER ETHERNET CAMERA SWITCH	MINIMUM 4 PORT MANAGED GIGABIT SWITCH, MINIMUM 14 GBPS THROUGHPUT, MINIMUM 30W POWER OVER ETHERNET PER PORT, MINIMUM 130W TOTAL, 120VAC POWER	AXIS T8508 POE+ OR APPROVED EQUAL
CAMERAS	NETWORK CAMERA, HDTV 1080P RESOLUTION, 360 DEGREE PAN, MINIMUM 90 DEGREE TILT, 10X ZOOM, AUTO FOCUS, POWER OVER ETHERNET, WITH PROGRAMMABLE OUTPUT CONNECTIONS FOR EXTERNAL CONTROL OF LIGHTING	AXIS M5525-E PTZ OR APPROVED EQUAL

NOTE: SPECIFIC PARTS MANUFACTURER AND MODEL SELECTED NOT ONLY TO MEET PERFORMANCE FUNCTION BUT ALSO TO COORDINATE AND INTERFACE WITH OTHER DEVICES AND SYSTEMS. APPROVED EQUAL SUBSTITUTIONS WILL BE ALLOWED ONLY BY ENGINEER'S APPROVAL. TO OBTAIN APPROVAL, SUBMITTALS MUST CLEARLY DEMONSTRATE HOW SUBSTITUTE ITEM MEETS OR EXCEEDS SPECIFIED ITEM QUALITY AND PERFORMANCE CHARACTERISTICS AND ALSO COMPLIES WITH MECHANICAL AND/OR ELECTRICAL CONNECTIONS AND PHYSICAL LAYOUT REQUIREMENTS.

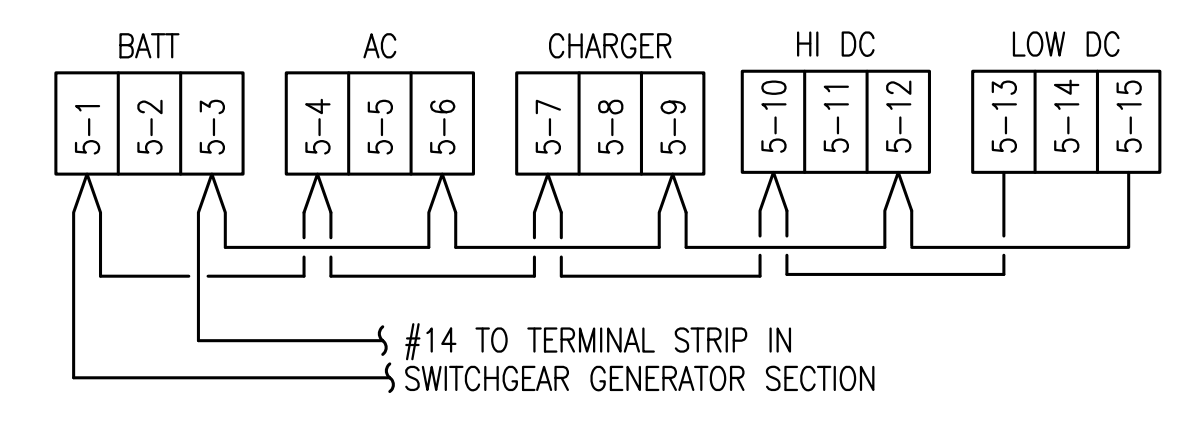


NOTE: PRIOR TO ENERGIZING MAKE THE FOLLOWING SETTINGS ON CHARGER:
 1) AC LINE VOLTAGE SWITCH TO "115V".
 2) AUTO BOOST JUMPER TO "NORM".
 3) FLOAT VOLTAGE JUMPER TO "13.50/27.00" (FOR GEL CELL).
 4) BATTERY RANGE JUMPER TO "24V".


2
E5 BATTERY CHARGER ALARM WIRING DIAGRAM
 NO SCALE


1
E5 INSTRUMENTATION & DATA PLAN
 3/8"=1'-0"

ISSUED FOR
 CONSTRUCTION
 JANUARY 2019

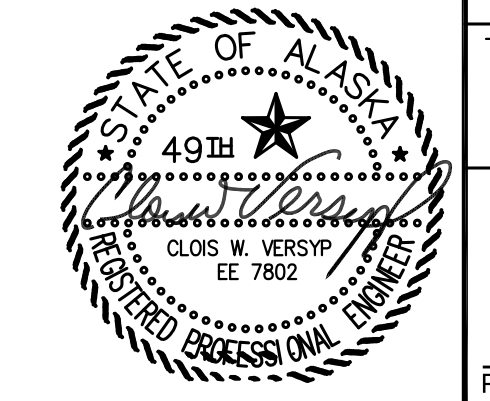


ALASKA ENERGY AUTHORITY	
PROJECT:	PORT HEIDEN RURAL POWER SYSTEM POWER PLANT UPGRADE
TITLE:	INSTRUMENTATION & DATA PLAN & DETAILS
DRAWN BY: JTD	SCALE: AS NOTED
DESIGNED BY: CWV/BCG	DATE: 1/14/19
FILE NAME: PTH PPU E3-E5	SHEET: E5 OF 7
PROJECT NUMBER:	

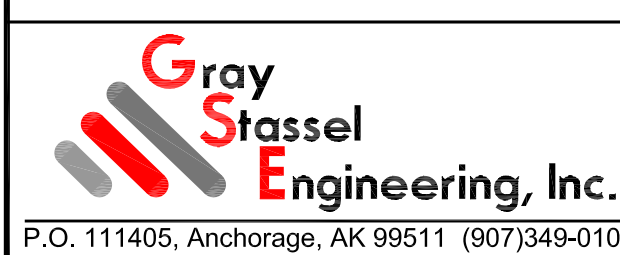

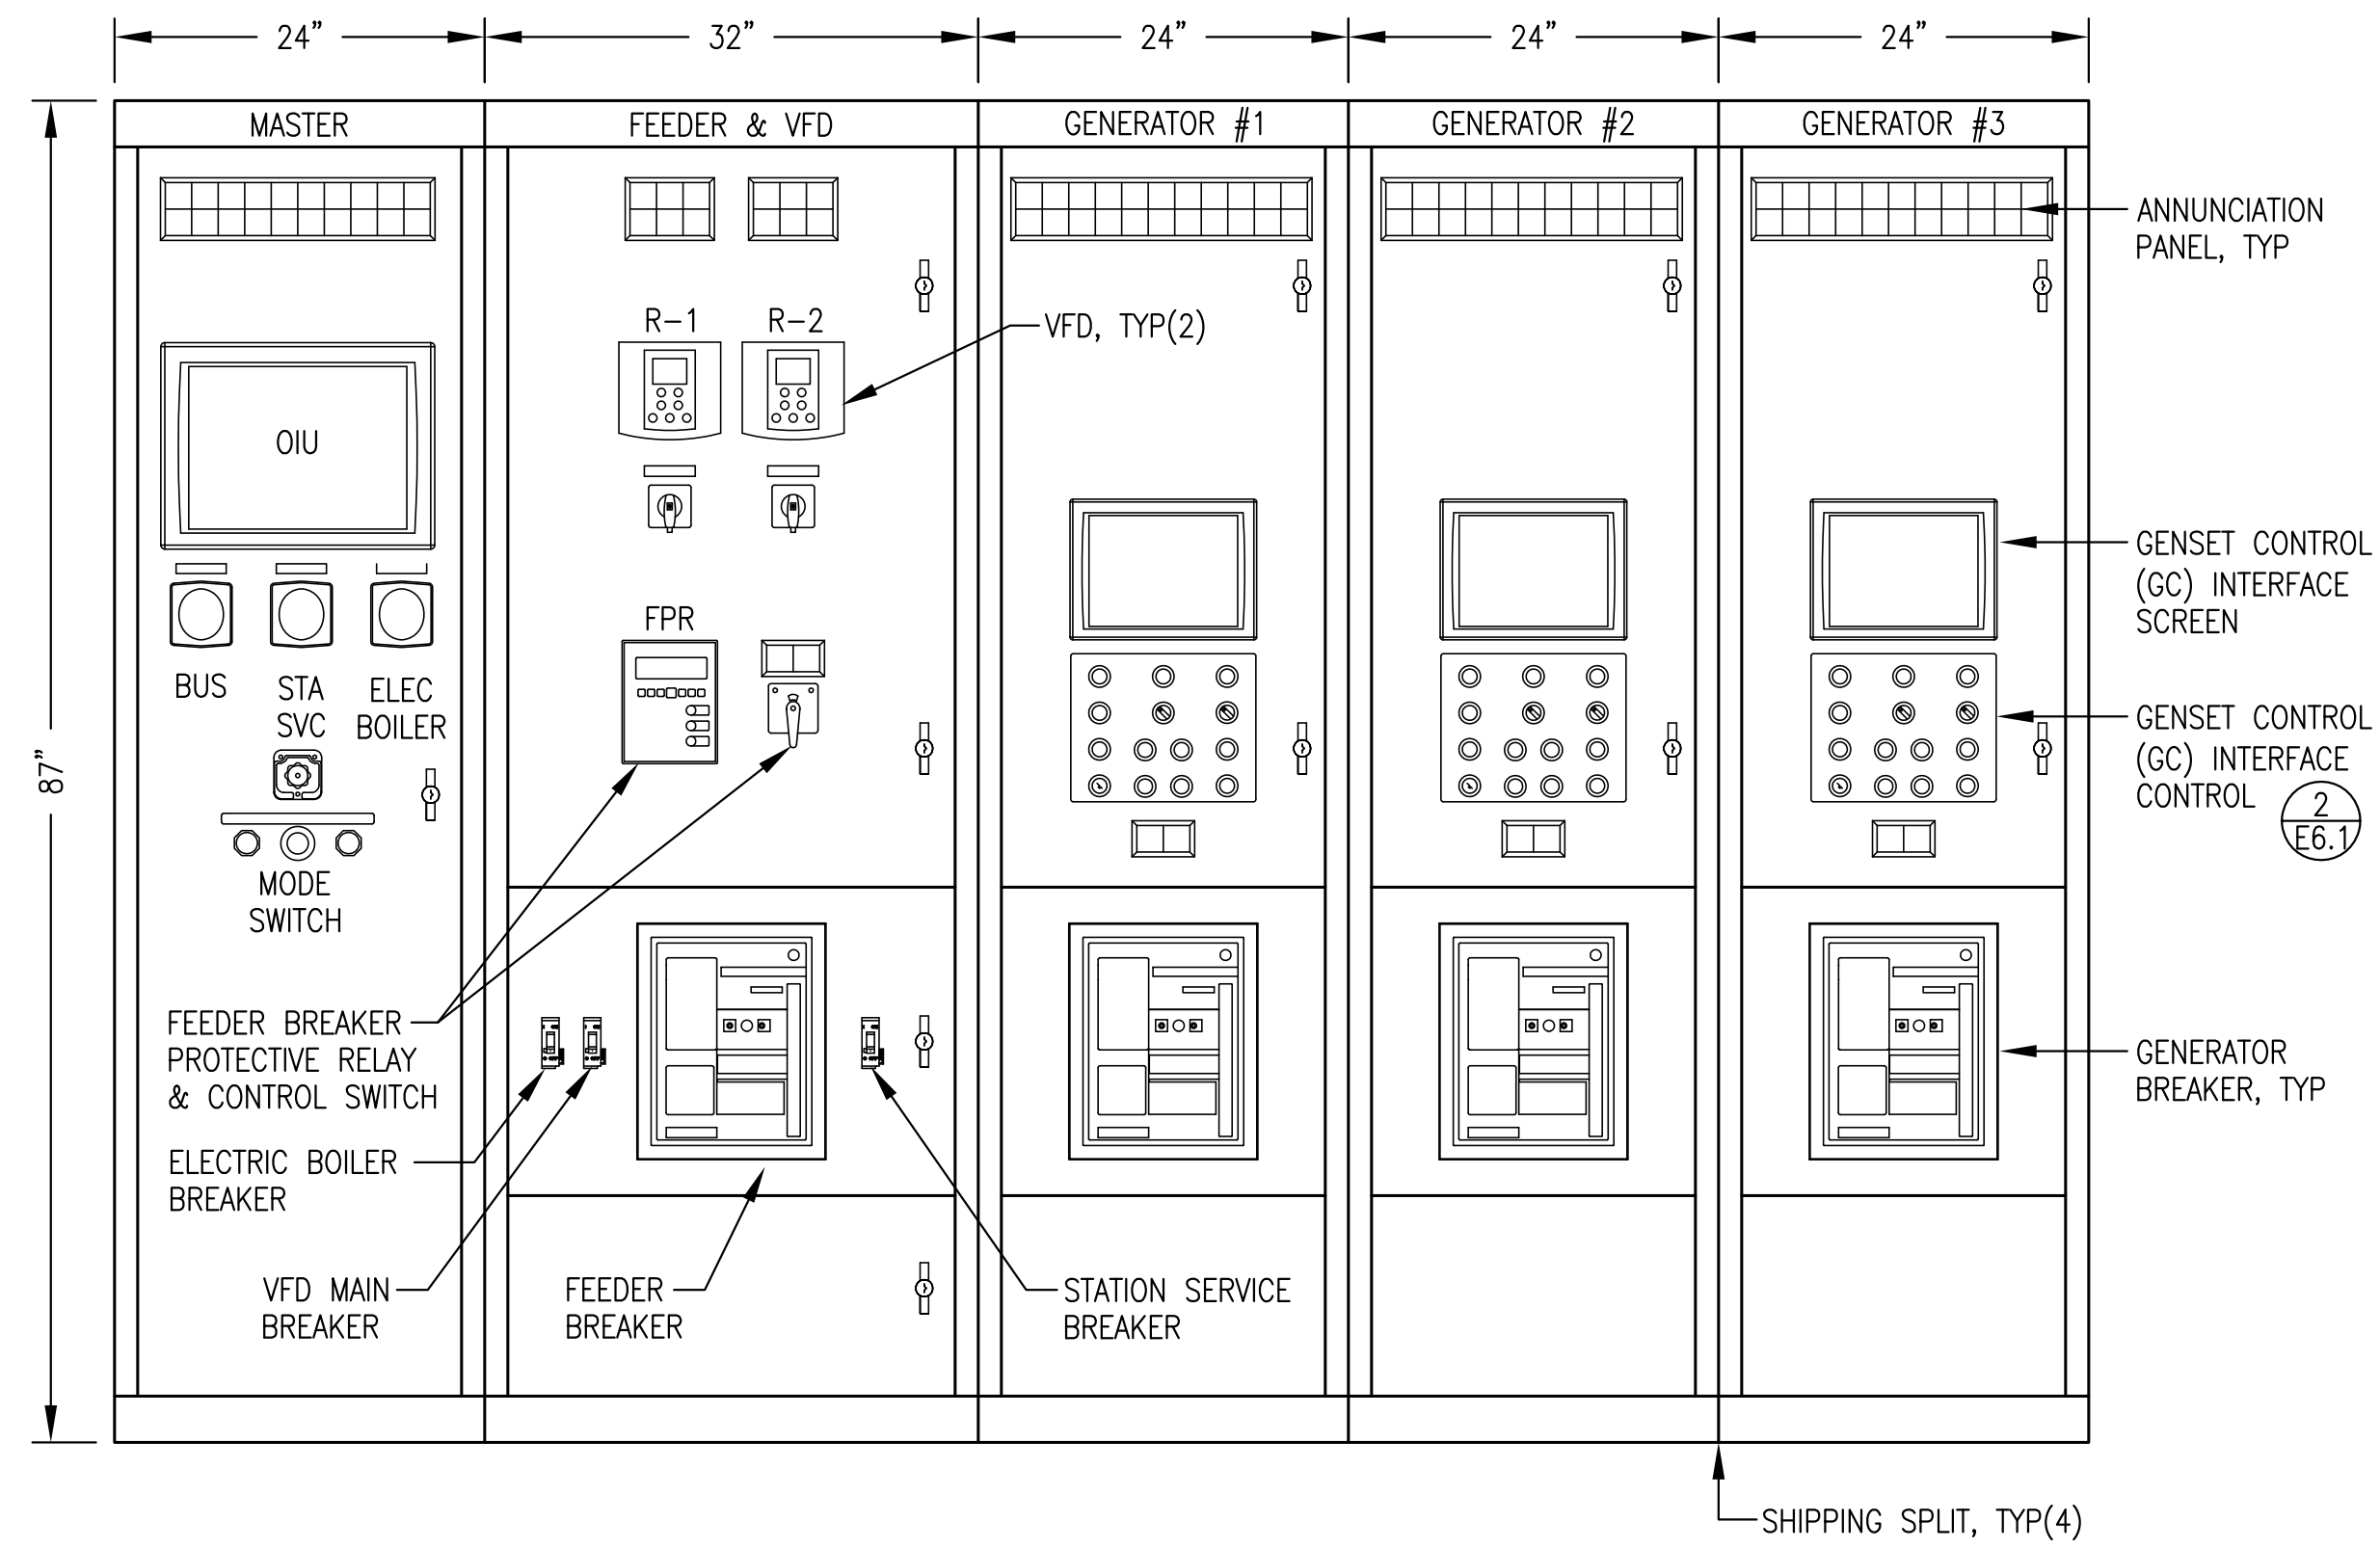


FRONT ELEVATION

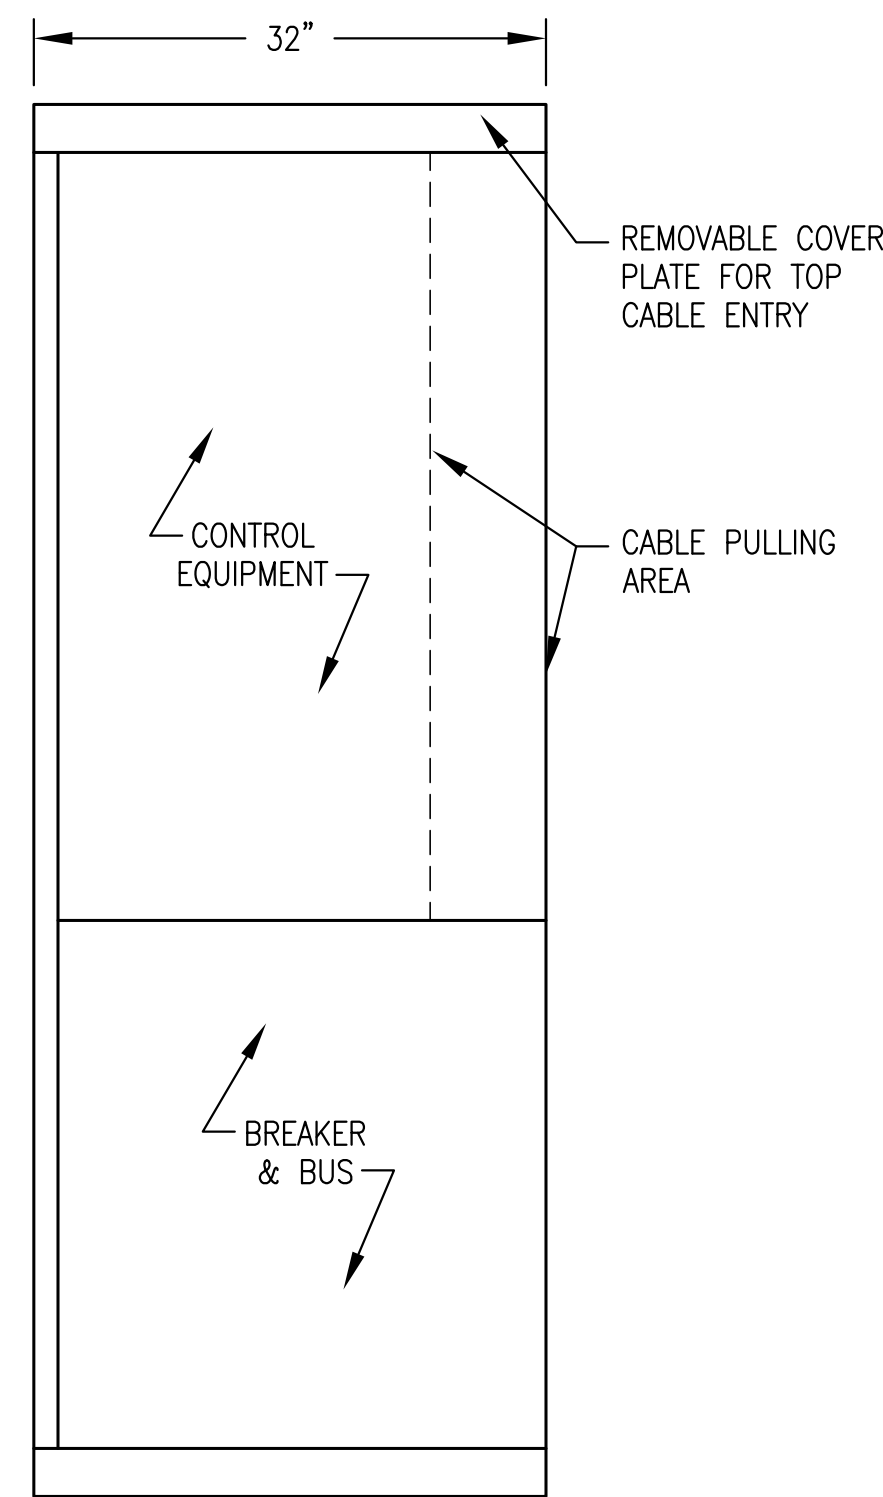

TYPICAL CROSS SECTION


1 SWITCHGEAR ENCLOSURE LAYOUT
E6.1 NO SCALE

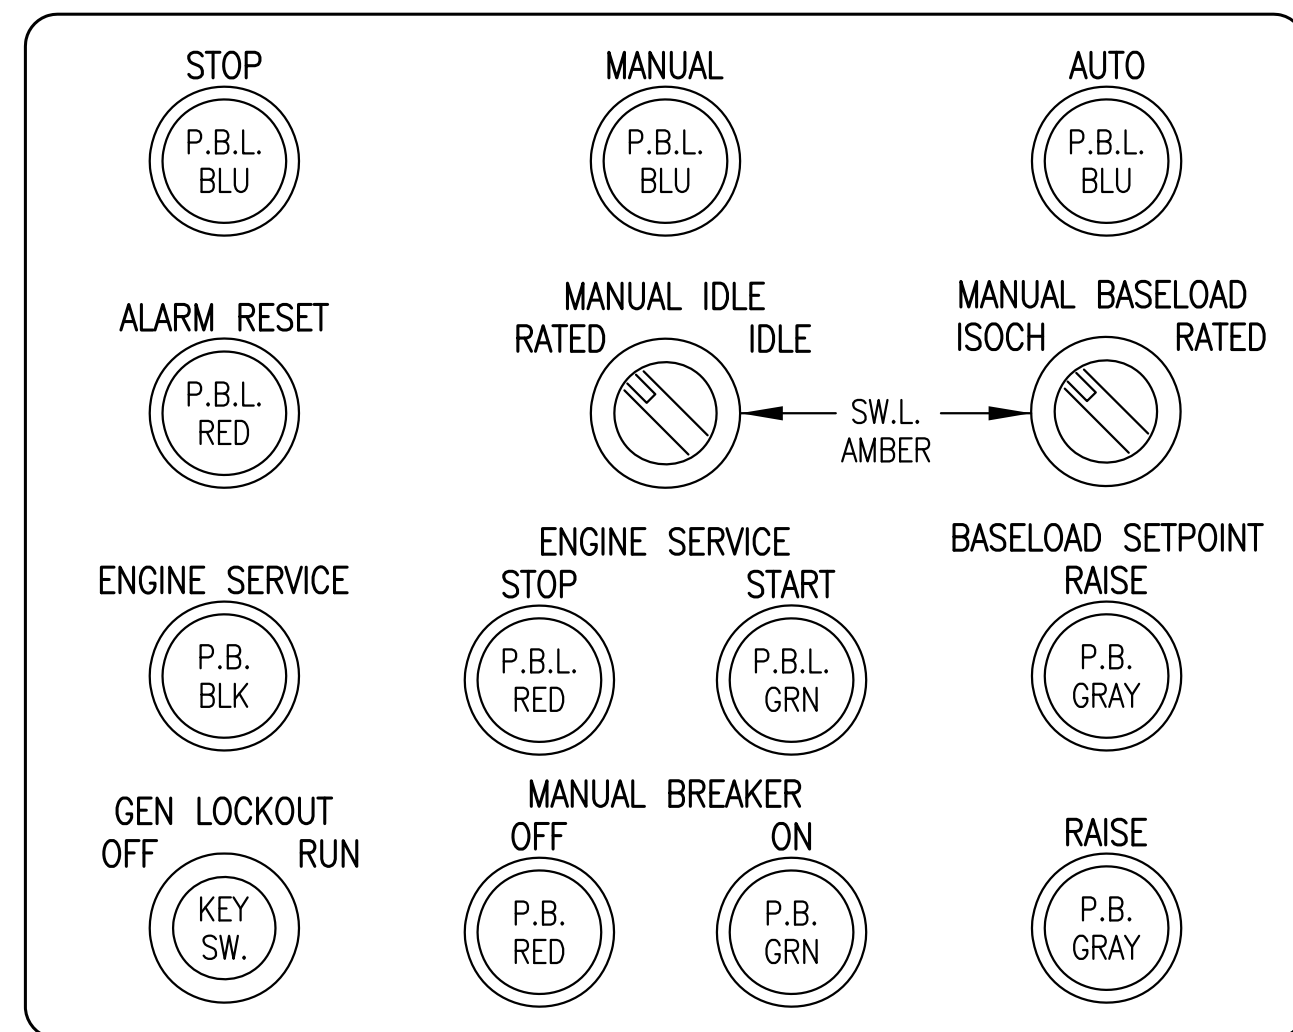


- LEGEND:**
- P.B. PUSH BUTTON
 - P.B.L. PUSH BUTTON WITH LIGHT
 - SW.L. SWITCH WITH LIGHT
 - KEY SW. LOCKABLE KEY SWITCH

2 EASYGEN INTERFACE CONTROLS
E6.1 NO SCALE

ISSUED FOR
CONSTRUCTION
JANUARY 2019

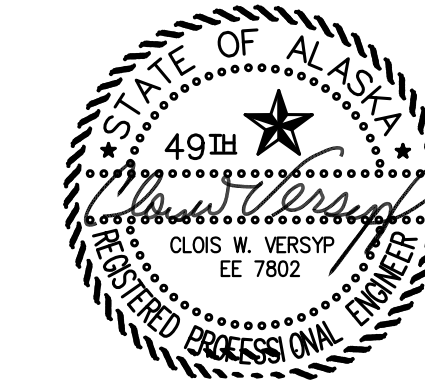


PROJECT:	PORT HEIDEN RURAL POWER SYSTEM POWER PLANT UPGRADE	
TITLE:	SWITCHGEAR ENCLOSURE LAYOUT	
DRAWN BY:	JTD	SCALE: AS NOTED
DESIGNED BY:	CWV/BCG	DATE: 1/14/19
FILE NAME:	PTH PPU E6	SHEET:
PROJECT NUMBER:		E6.1 OF 7
P.O. 111405, Anchorage, AK 99511 (907)349-0100		

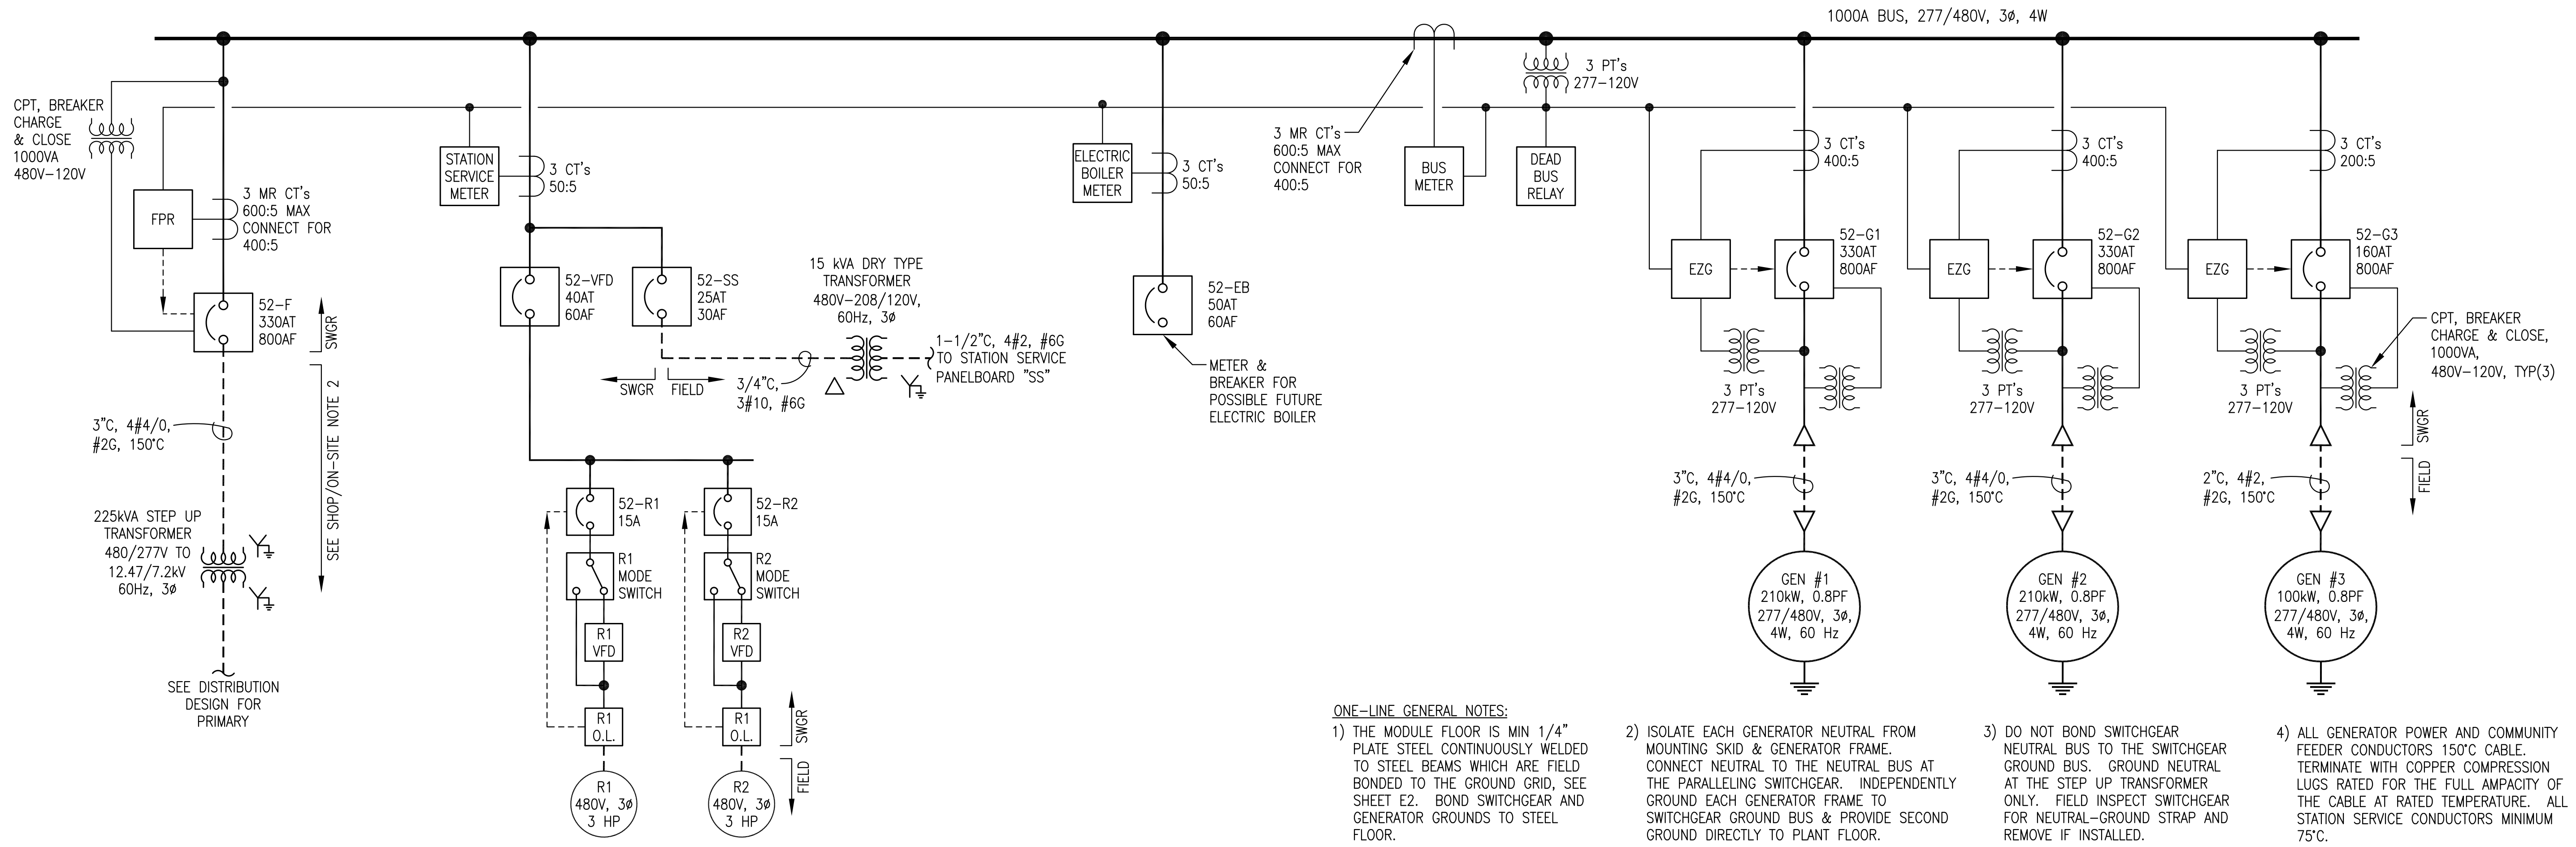


- ONE-LINE GENERAL NOTES:**
- 1) THE MODULE FLOOR IS MIN 1/4" PLATE STEEL CONTINUOUSLY WELDED TO STEEL BEAMS WHICH ARE FIELD BONDED TO THE GROUND GRID, SEE SHEET E2. BOND SWITCHGEAR AND GENERATOR GROUNDS TO STEEL FLOOR.
 - 2) ISOLATE EACH GENERATOR NEUTRAL FROM MOUNTING SKID & GENERATOR FRAME. CONNECT NEUTRAL TO THE NEUTRAL BUS AT THE PARALLELING SWITCHGEAR. INDEPENDENTLY GROUND EACH GENERATOR FRAME TO SWITCHGEAR GROUND BUS & PROVIDE SECOND GROUND DIRECTLY TO PLANT FLOOR.
 - 3) DO NOT BOND SWITCHGEAR NEUTRAL BUS TO THE SWITCHGEAR GROUND BUS. GROUND NEUTRAL AT THE STEP UP TRANSFORMER ONLY. FIELD INSPECT SWITCHGEAR FOR NEUTRAL-GROUND STRAP AND REMOVE IF INSTALLED.
 - 4) ALL GENERATOR POWER AND COMMUNITY FEEDER CONDUCTORS 150°C CABLE. TERMINATE WITH COPPER COMPRESSION LUGS RATED FOR THE FULL AMPACITY OF THE CABLE AT RATED TEMPERATURE. ALL STATION SERVICE CONDUCTORS MINIMUM 75°C.

1 SWITCHGEAR ONE-LINE DIAGRAM
E6.2 NO SCALE

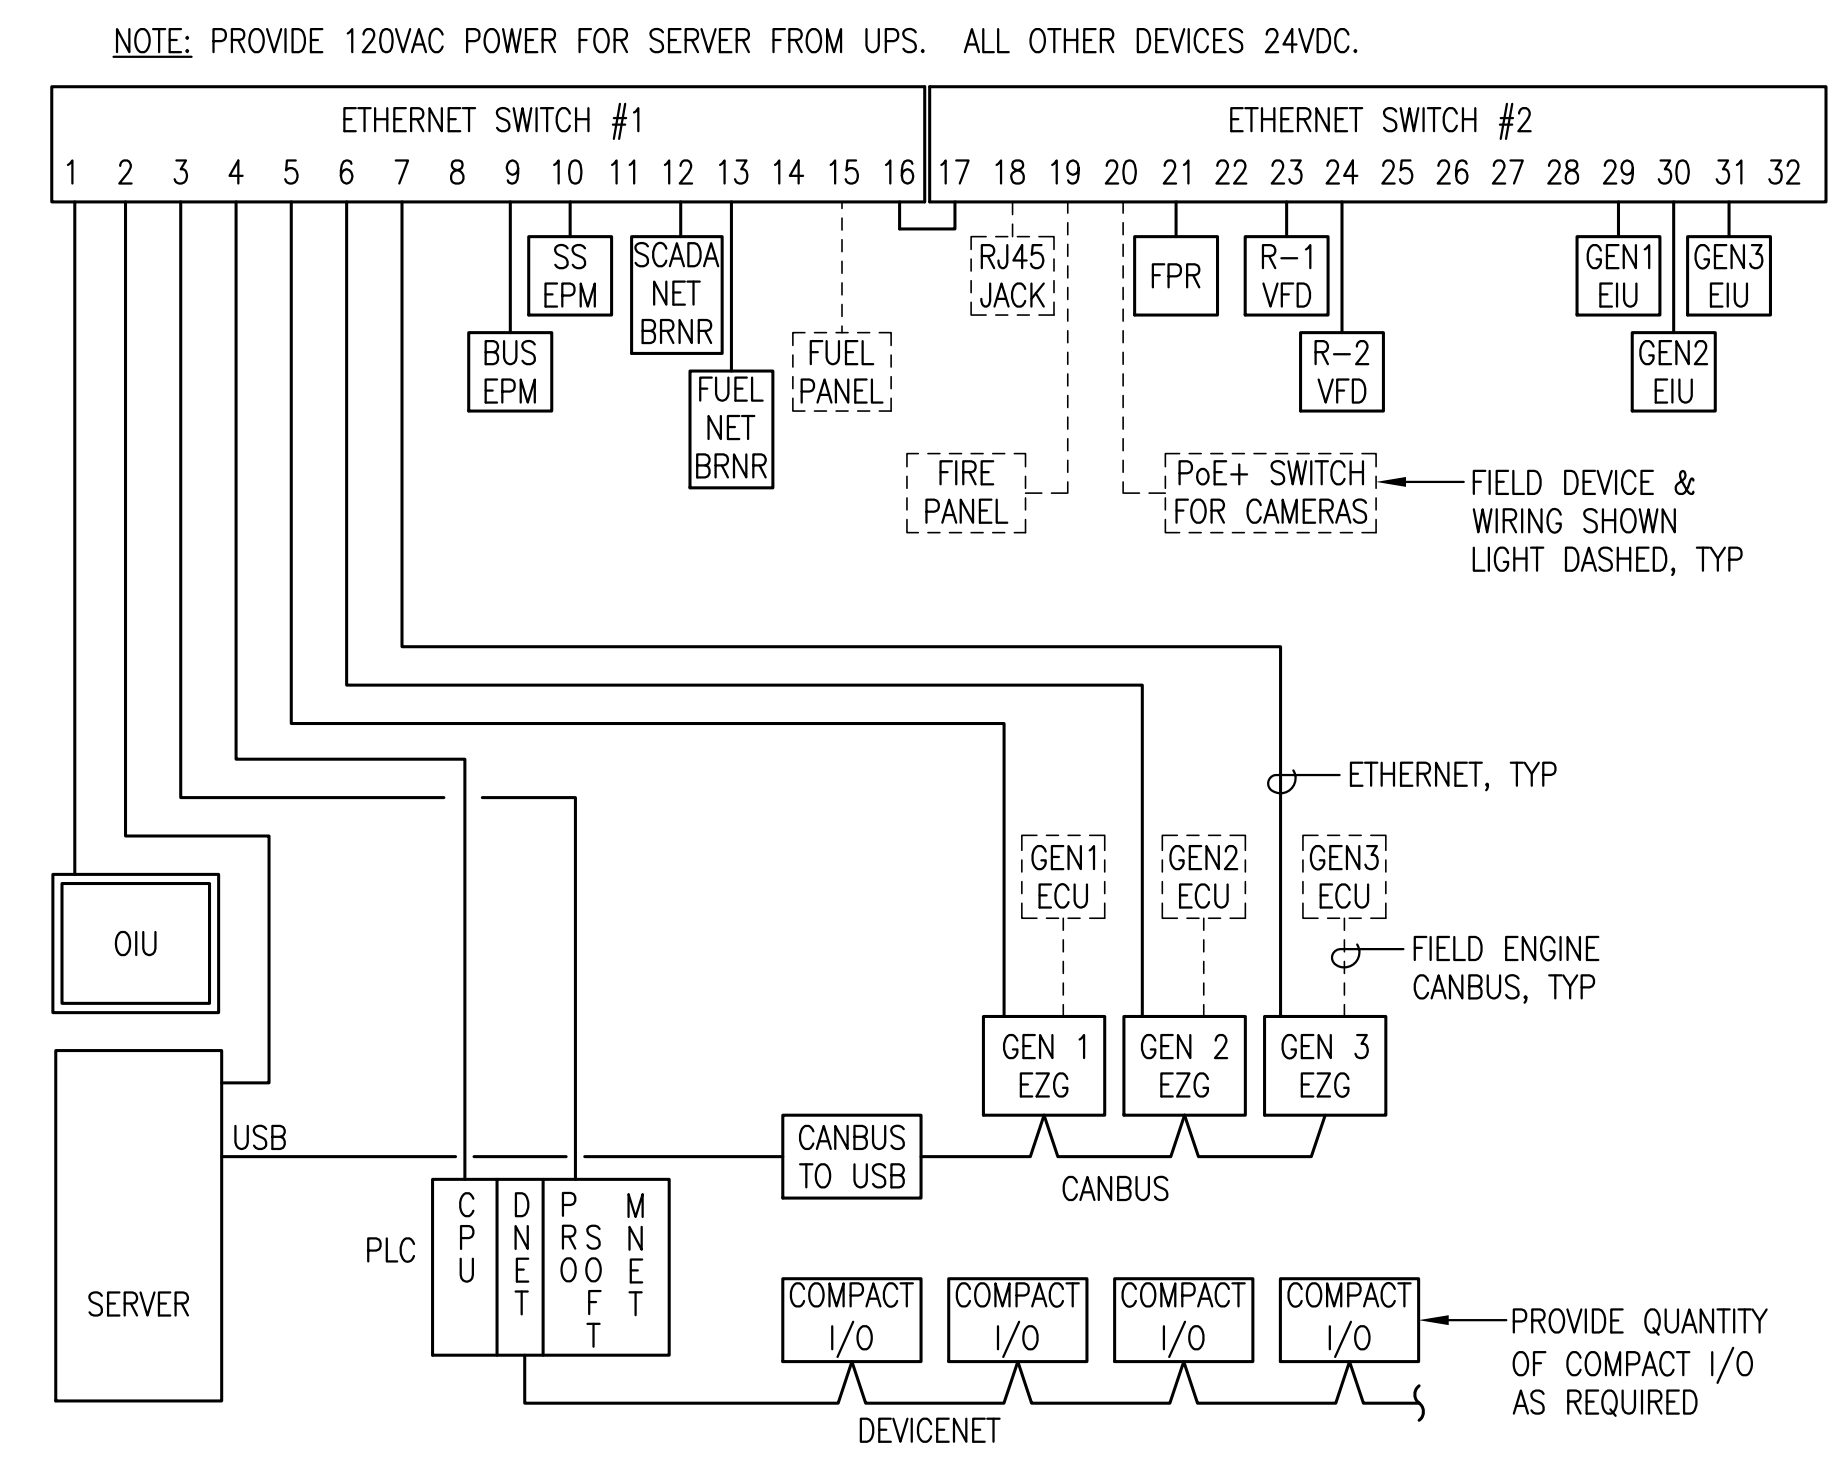

2 COMMUNICATION SCHEMATIC
E6.2 NO SCALE

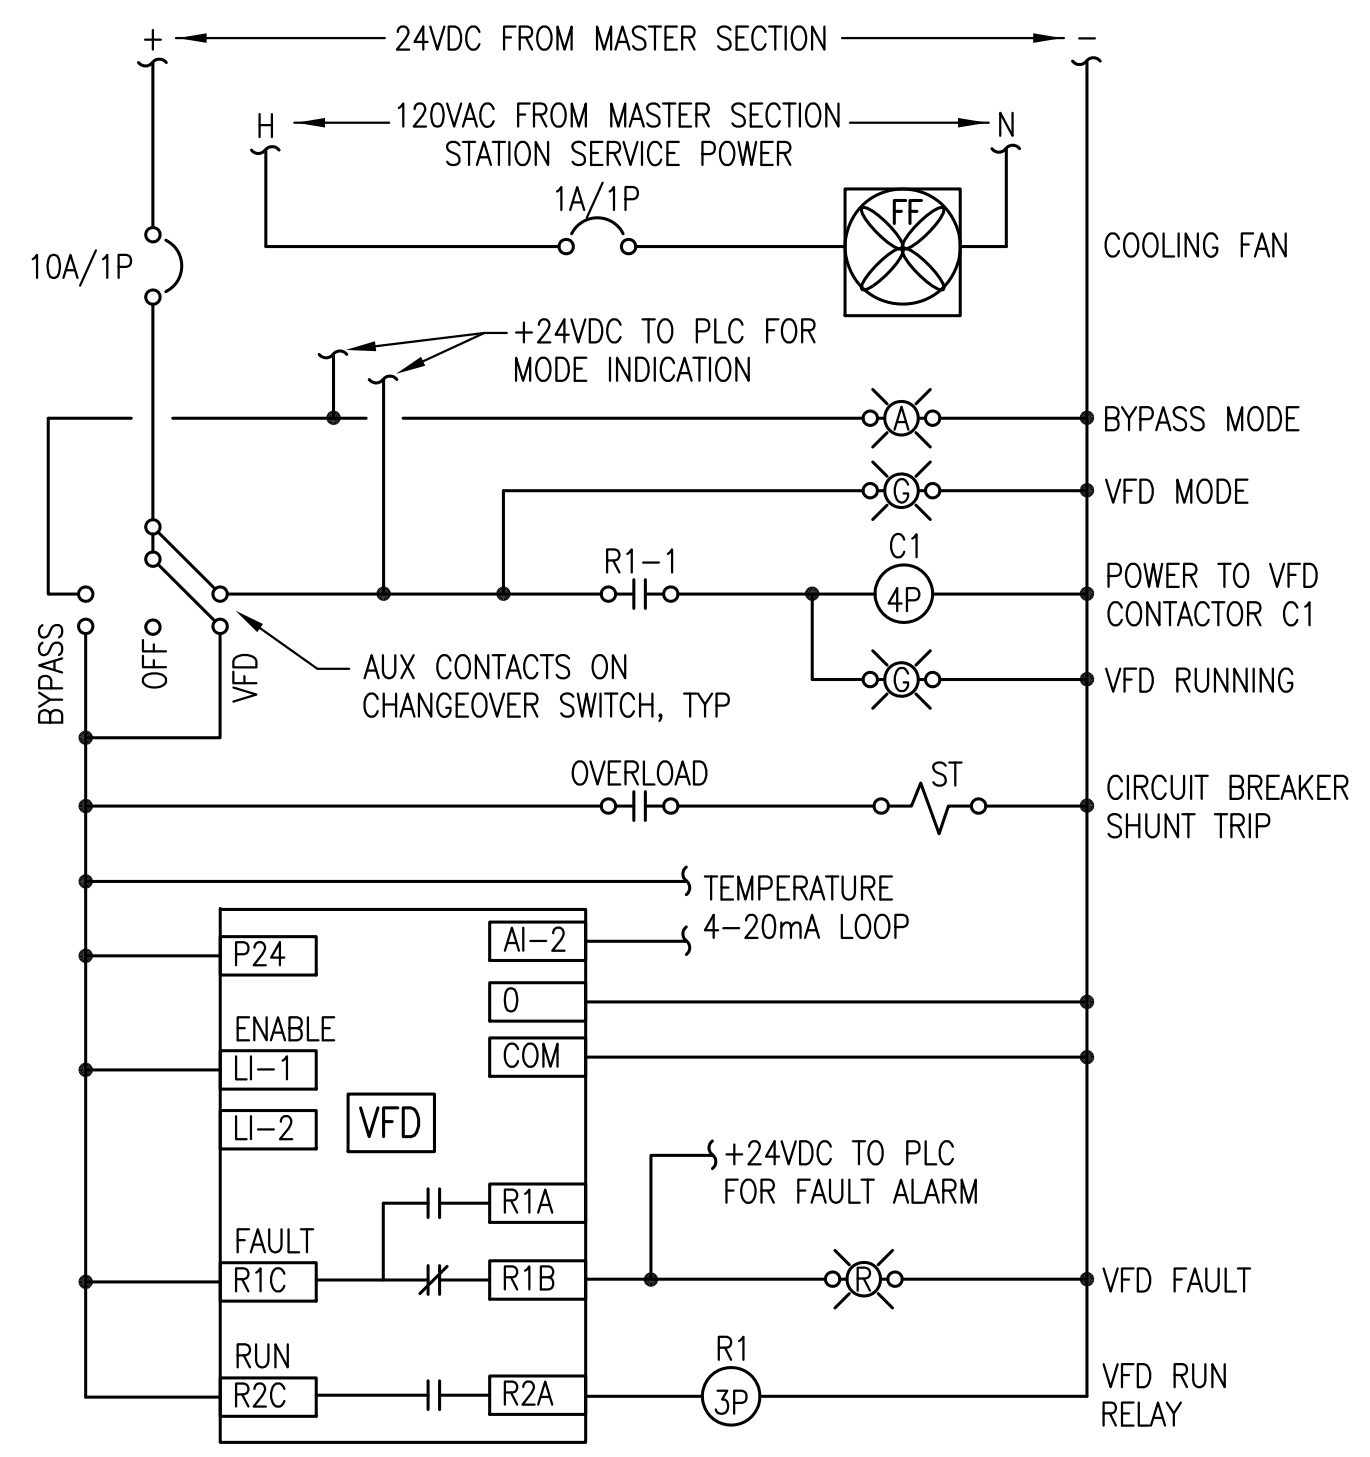

3 TYPICAL RADIATOR VFD LOGIC DIAGRAM
E6.2 NO SCALE

SWITCHGEAR SYMBOL LEGEND

	TRANSFORMER
	PT=POTENTIAL XFRMR
	CPT=CONTROL POWER XFRMR
	CURRENT TRANSFORMER
	M.R. - INDICATES MULTIRATIO
	CT'S RATING FACTOR RF=2.0
	CIRCUIT BREAKER
	AT=AMP TRIP RATING
	AF=AMP FRAME RATING
	WOODWARD EASYGEN GENSET CONTROLLER
	FEEDER PROTECTION RELAY
	SHOP INSTALLED POWER WIRING/BUS
	FIELD INSTALLED POWER WIRING
	SHOP INSTALLED CONTROL WIRING

SWITCHGEAR SHOP/ON-SITE NOTES:

- 1) DEVICES AND WIRING NOTED AS FIELD ARE EXTERNAL TO THE SWITCHGEAR BUT ARE INCLUDED IN THE MODULE SHOP FABRICATION WORK.
- 2) THE FEEDER, STEP UP TRANSFORMER, AND DISTRIBUTION ARE TO BE INSTALLED AS PART OF THE ON-SITE WORK AND ARE NOT PART OF THE MODULE SHOP FABRICATION WORK.

ISSUED FOR CONSTRUCTION
JANUARY 2019




ALASKA ENERGY AUTHORITY

PROJECT: **PORT HEIDEN RURAL POWER SYSTEM POWER PLANT UPGRADE**


TITLE: **SWITCHGEAR ONE-LINE & SCHEMATICS**

DRAWN BY: JTD	SCALE: AS NOTED
DESIGNED BY: CWV/BCG	DATE: 1/14/19
FILE NAME: PTH PPU E6	SHEET: E6.2 OF 7
PROJECT NUMBER:	


Gray Stassel Engineering, Inc.
P.O. 111405, Anchorage, AK 99511 (907)349-0100

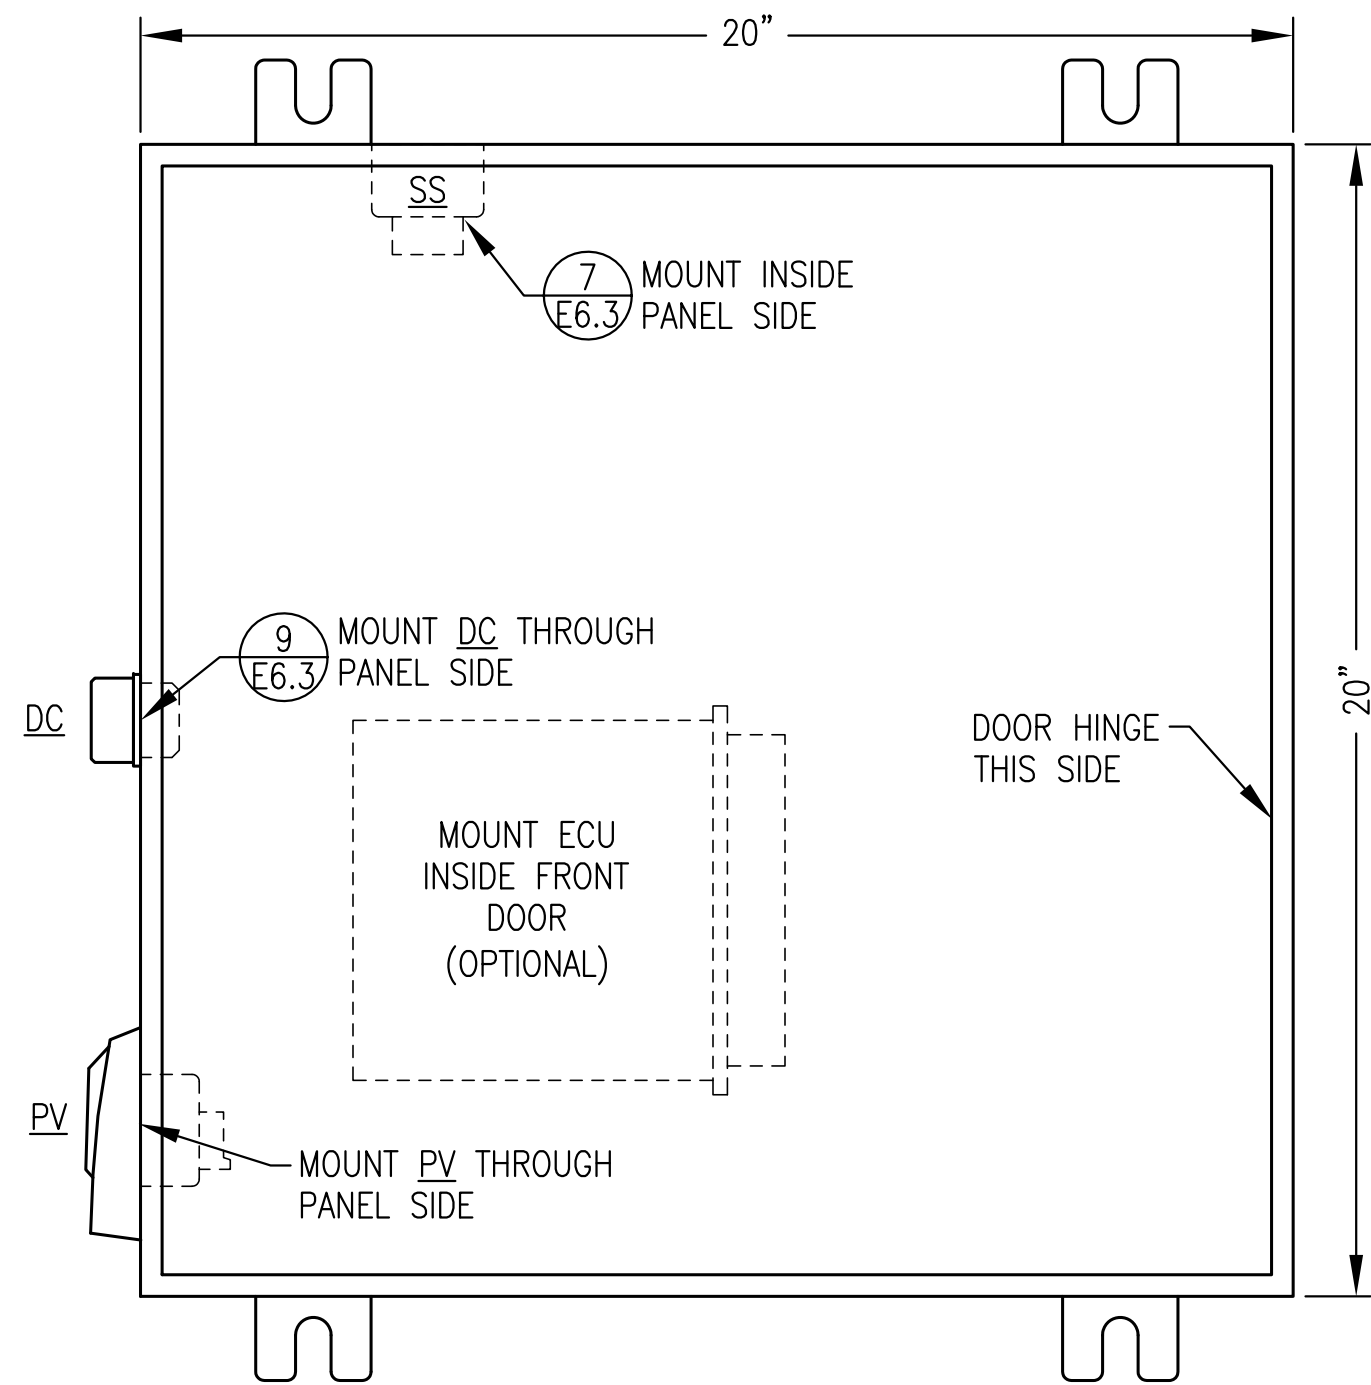

1 JUNCTION BOX FRONT PANEL LAYOUT
E6.3 NO SCALE

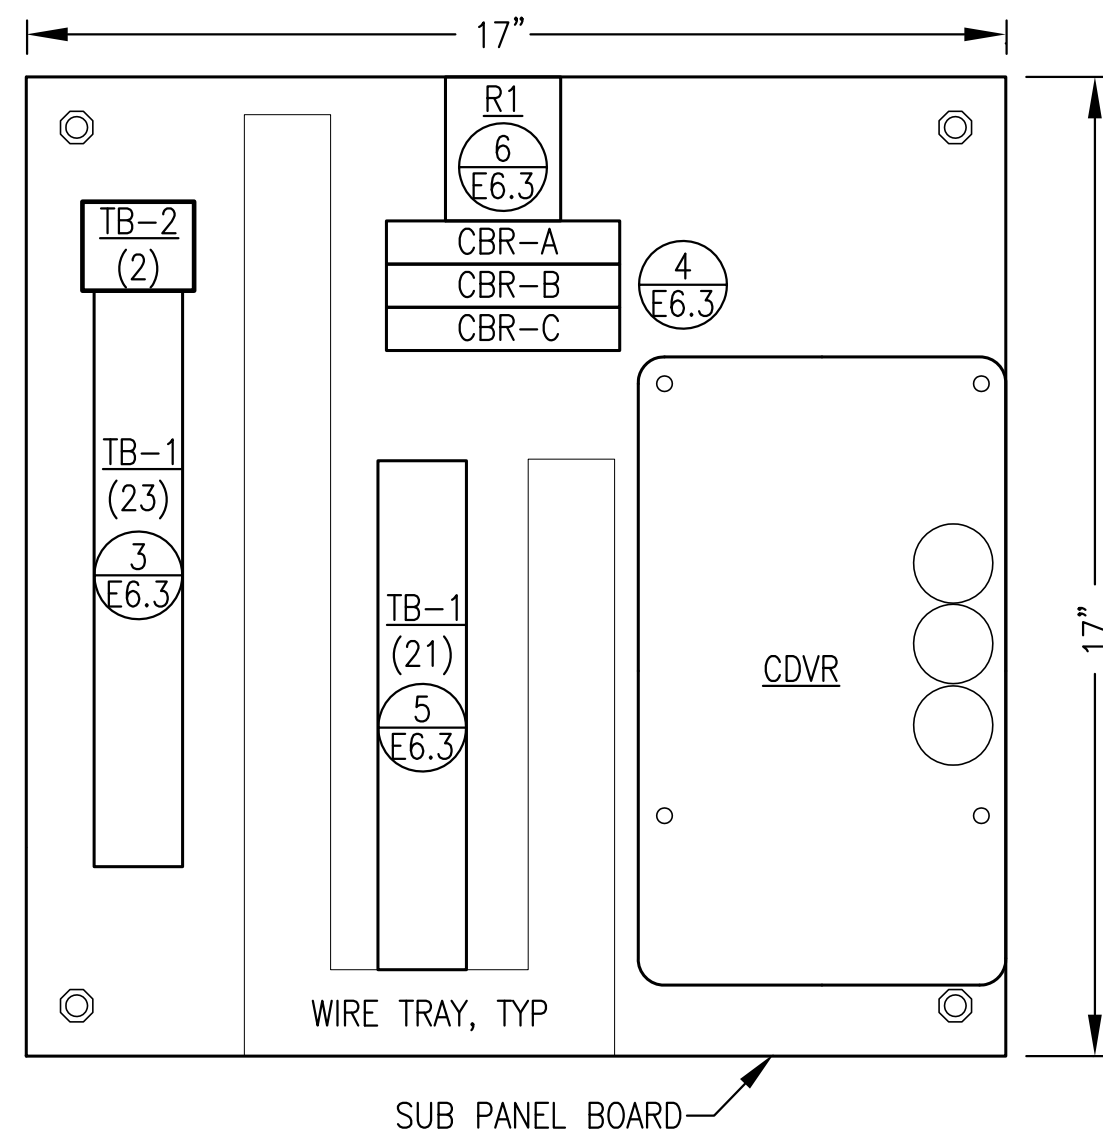


2 JUNCTION BOX SUB PANEL LAYOUT
E6.3 NO SCALE

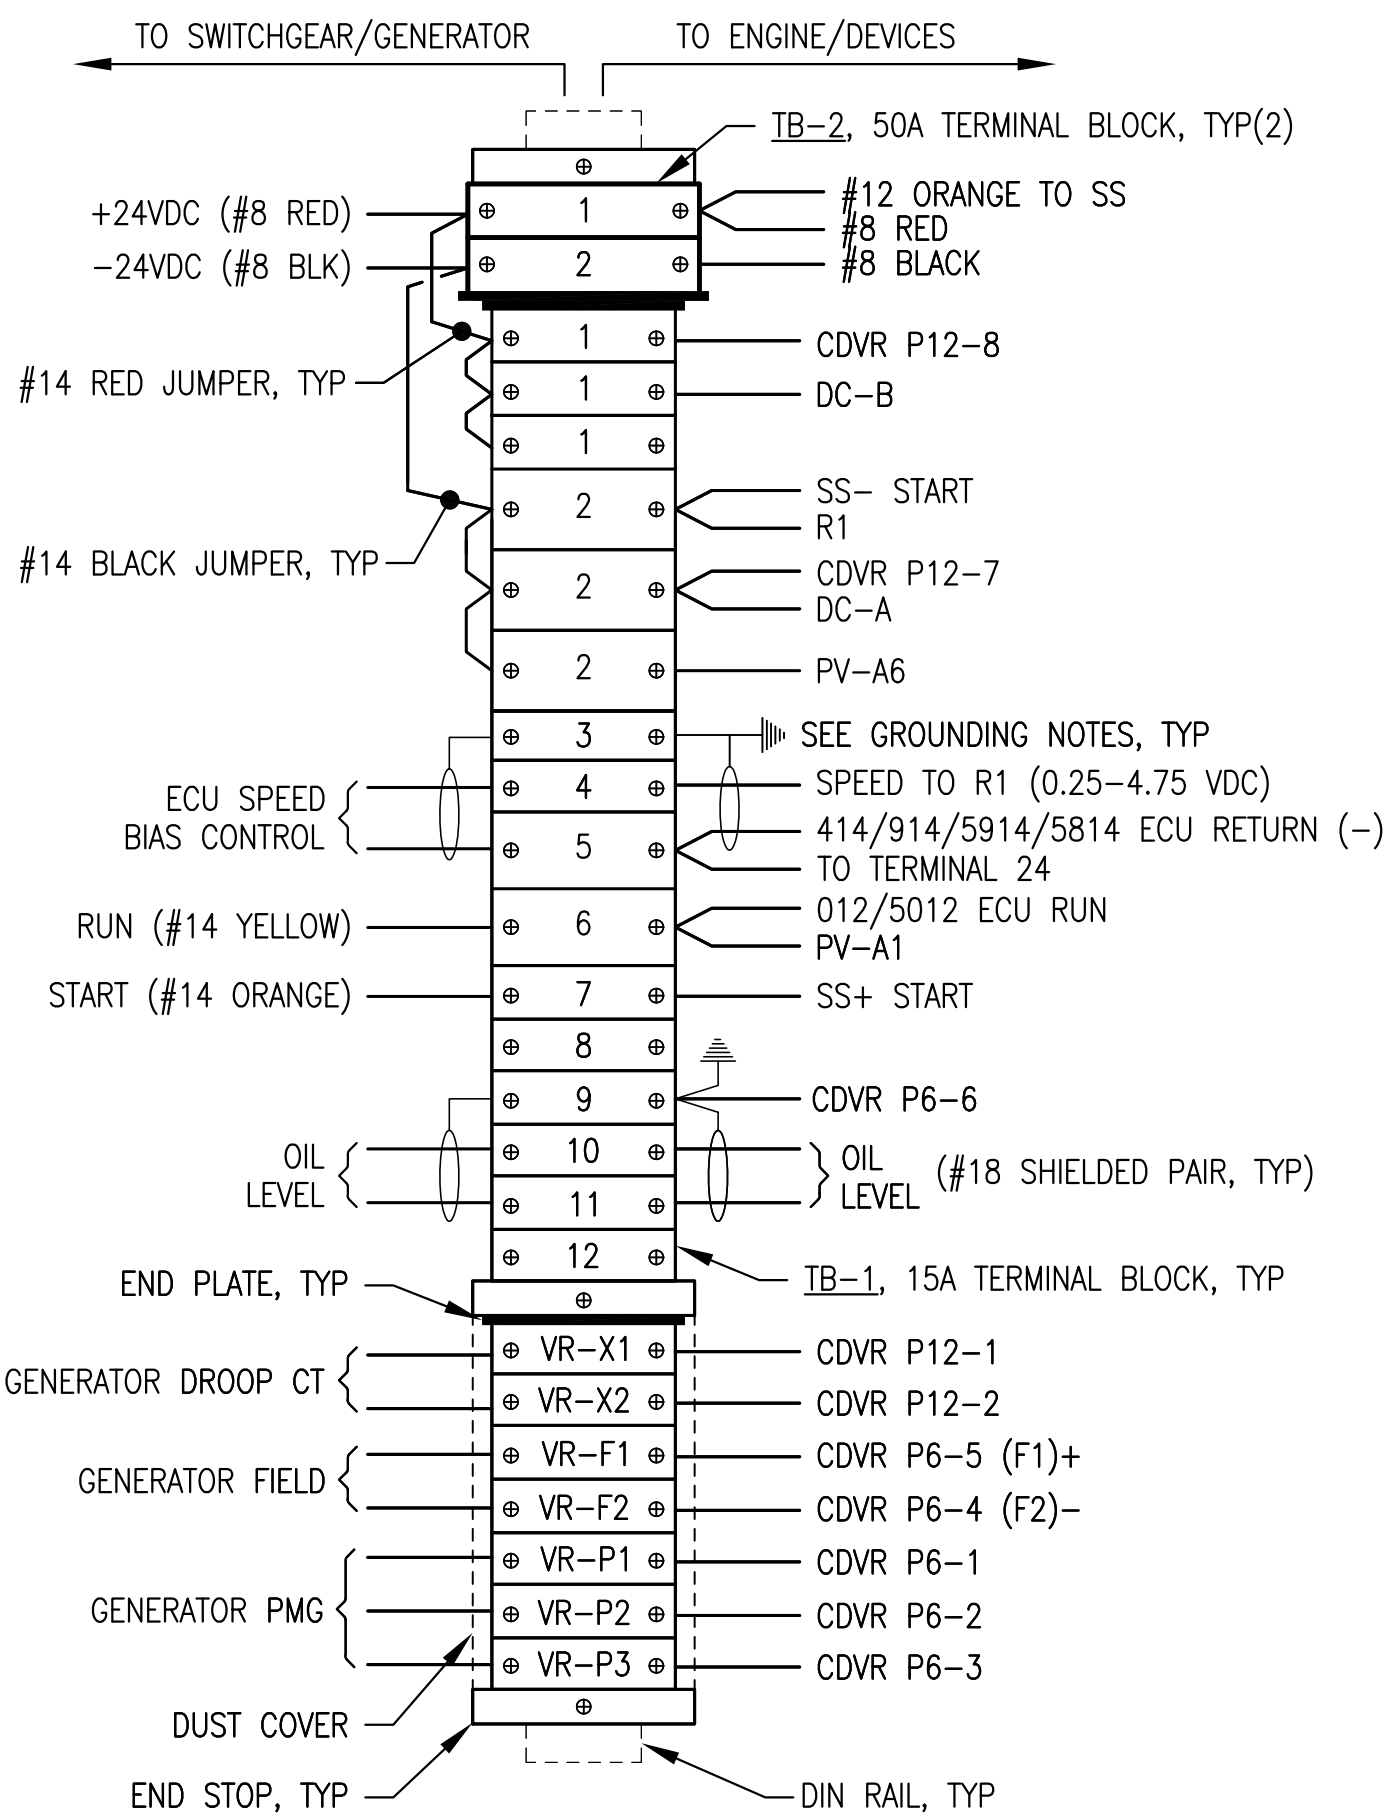


NOTE: TYPICAL JOHN DEERE ECU CONNECTION NUMBERS SHOWN. SEE WIRING HARNESS FOR EACH ENGINE FOR ACTUAL ECU CONNECTIONS.

3 TERMINAL STRIP CONNECTIONS
E6.3 NO SCALE

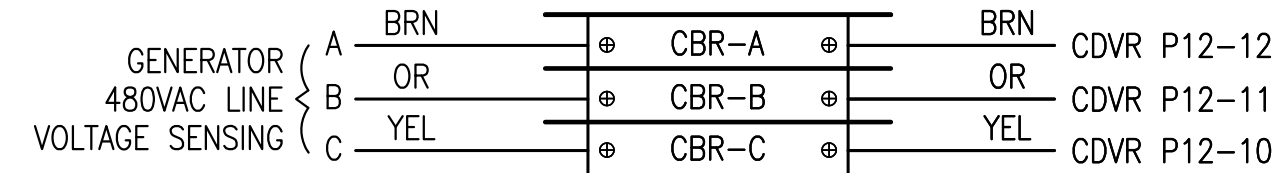

4 CIRCUIT BREAKER CONNECTIONS
E6.3 NO SCALE

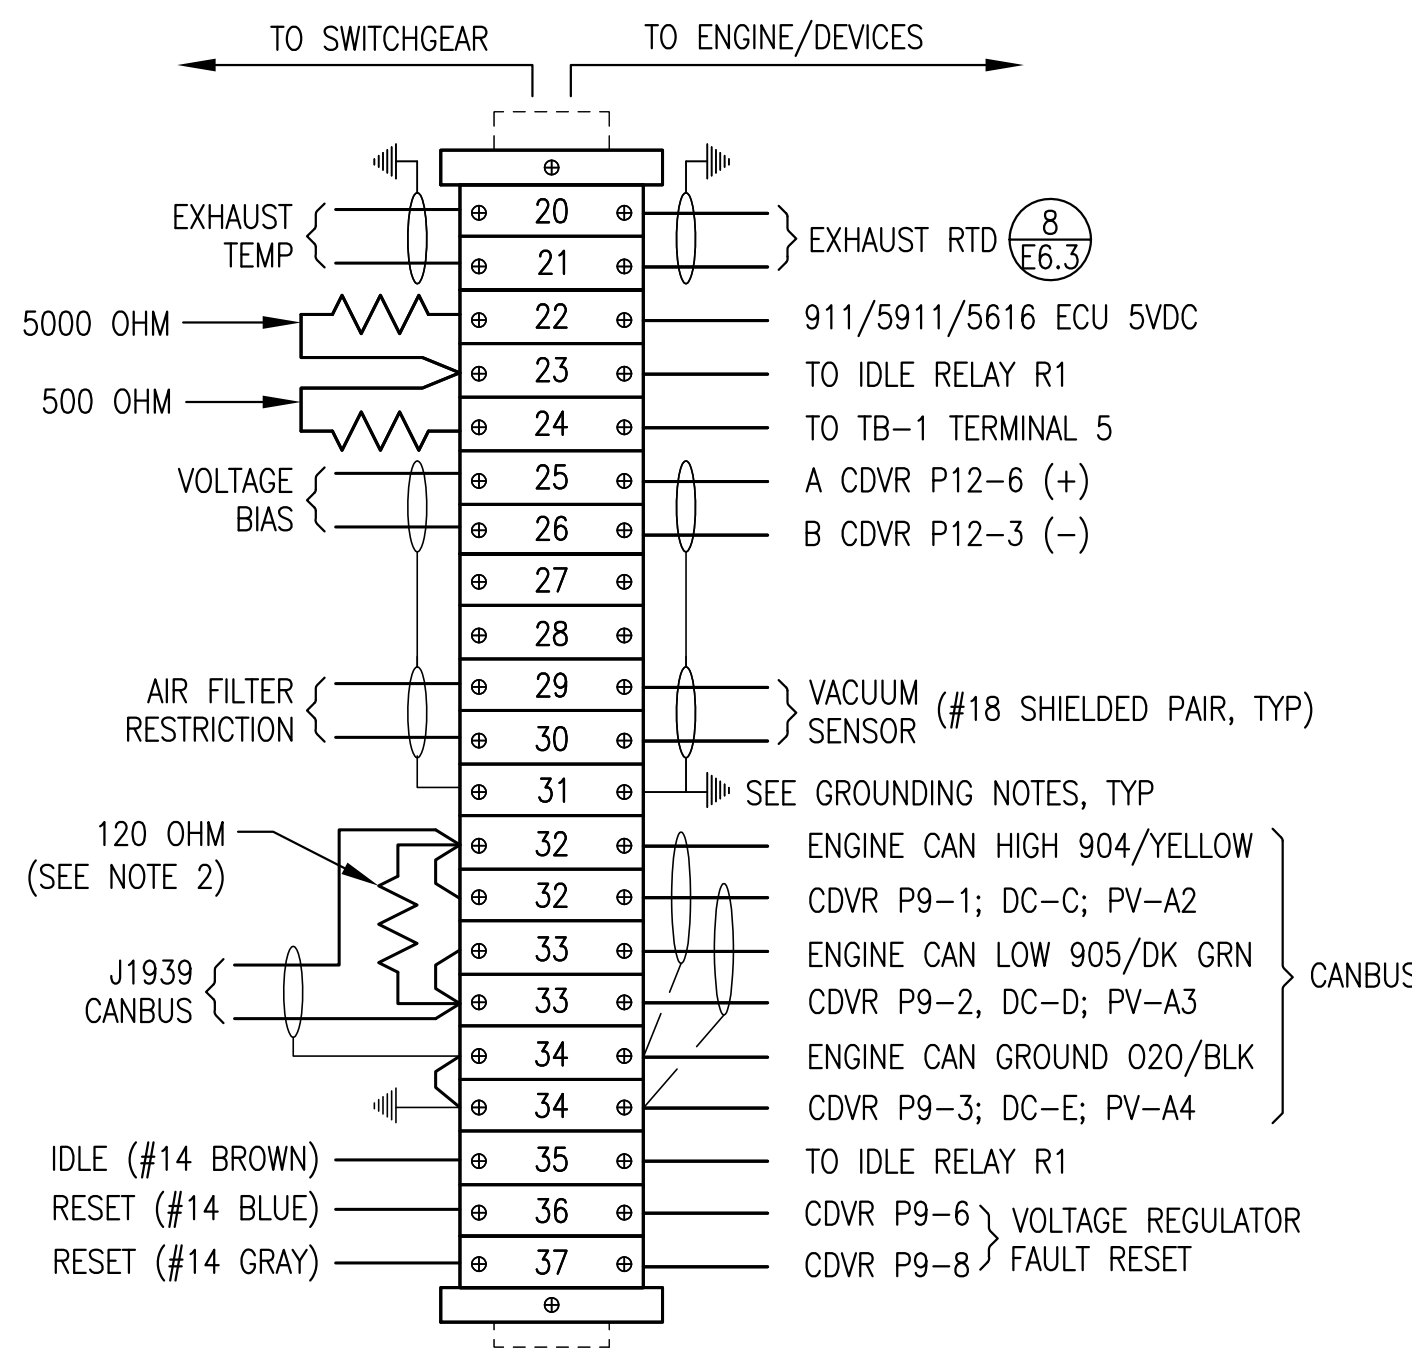

NOTES: 1) ALL RESISTORS 0.25W.
2) REMOVE RESISTOR IF ENGINE WIRING HARNESS HAS 120 OHM END OF LINE RESISTOR.

5 TERMINAL STRIP CONNECTIONS
E6.3 NO SCALE


BILL OF MATERIALS				NOTE: SPECIFIC PARTS MANUFACTURER AND MODEL SELECTED NOT ONLY TO MEET PERFORMANCE FUNCTION BUT ALSO TO COORDINATE AND INTERFACE WITH OTHER DEVICES AND SYSTEMS. APPROVED EQUAL SUBSTITUTIONS WILL BE ALLOWED ONLY BY ENGINEER'S APPROVAL. TO OBTAIN APPROVAL, SUBMITTALS MUST CLEARLY DEMONSTRATE HOW SUBSTITUTE ITEM MEETS OR EXCEEDS SPECIFIED ITEM QUALITY AND PERFORMANCE CHARACTERISTICS AND ALSO COMPLIES WITH MECHANICAL AND/OR ELECTRICAL CONNECTIONS AND PHYSICAL LAYOUT REQUIREMENTS.
TAG	MANUFACTURER	MODEL	DESCRIPTION	
ENCLOSURE	HOFFMAN	A20H20ALP	20x20x8" NEMA 12 BACK PANEL	
CDVR	CATERPILLAR	314-7755	DIGITAL VOLTAGE REGULATOR	
CBR	ALLEN-BRADLEY	1489-M1-C010	RAIL MOUNT CIRCUIT BREAKER, 1-POLE, 1A	
DC	JOHN DEERE	57M7919	DIAGNOSTIC CONNECTOR, 9-PIN, CAN-BUS	
	DEUTSCH	HD18-009	CONNECTOR STRAIN RELIEF	
	DEUTSCH	HDC16-9	CONNECTOR PROTECTIVE DUST CAP	
	DEUTSCH	HD10-9-GKT	CONNECTOR GASKET	
	DEUTSCH	JDLO62397	CONNECTOR LANYARD	
PV	MURPHY	PV101-C-MSTD	POWER VIEW W/HARNESS	
R1	ALLEN-BRADLEY	700HAB2224	DPDT RELAY, 24VDC COIL	
	ALLEN-BRADLEY	700HN101	8 PIN SOCKET BASE	
SS	CATERPILLAR	9X-8124	STARTER AUXILIARY SOLENOID, 24V	
TB-1	IDEC	BNH15LW	15A DIN RAIL-MOUNT TERMINAL BLOCK	
TB-2	IDEC	BNH50W	50A DIN RAIL-MOUNT TERMINAL BLOCK	

SHOP FABRICATION NOTES:


- 1) PROVIDE ASSEMBLY WITH ALL DEVICES AND WIRING INDICATED.
- 2) INSTALL IN A NEMA 12 ENCLOSURE WITH MOUNTING FLANGES AT BACK, A MIN 14 GAUGE INTERIOR BACK PANEL AND HINGED LOCKABLE DOOR. SIZE AS INDICATED.
- 3) PROVIDE DIN RAIL, TERMINAL END PLATES, TERMINAL END STOPS, TERMINAL DUST COVERS AND OTHER MISCELLANEOUS HARDWARE AS REQUIRED TO MATCH TERMINALS. LABEL ALL TERMINALS EXACTLY AS INDICATED ON THE DETAILS.
- 4) ALL WIRE #14AWG EXCEPT WHERE SPECIFICALLY INDICATED OTHERWISE. LABEL BOTH ENDS OF ALL JUMPERS WITH THE ENGINE PANEL TERMINAL NUMBER.
- 5) PROVIDE MECHANICAL GROUND LUGS FASTENED TO BACK PANEL AND GROUNDED TO ENGINE-GENERATOR. GROUND ALL SHIELD DRAIN WIRES TO LUGS AT PANEL END ONLY.
- 6) PROVIDE WIRING HARNESSES FOR CONNECTION TO GENERATOR AND TO ENGINE. INSTALL WIRES IN LIQUID TIGHT FLEX OR FLEXIBLE PLASTIC WIRE LOOM AND PROVIDE SERVICE LOOPS IN ACCORDANCE WITH SPECIFICATIONS.
- 7) SHOP TEST EACH ENGINE-GENERATOR WITH ASSOCIATED JUNCTION BOX PERMANENTLY CONNECTED. UPON COMPLETION OF TESTING, COIL WIRING HARNESSES AND SECURE JUNCTION BOX TO GENERATOR FOR SHIPPING.

FIELD INSTALLATION NOTES:


- 1) PERFORM ALL FIELD WIRING IN ACCORDANCE WITH SPECIFICATIONS. LABEL BOTH ENDS OF ALL FIELD WIRING WITH THE ENGINE PANEL TERMINAL NUMBER.
- 2) ON SHIELDED CONDUCTORS GROUND ALL SHIELD DRAIN WIRES TO LUGS AT PANEL END ONLY.

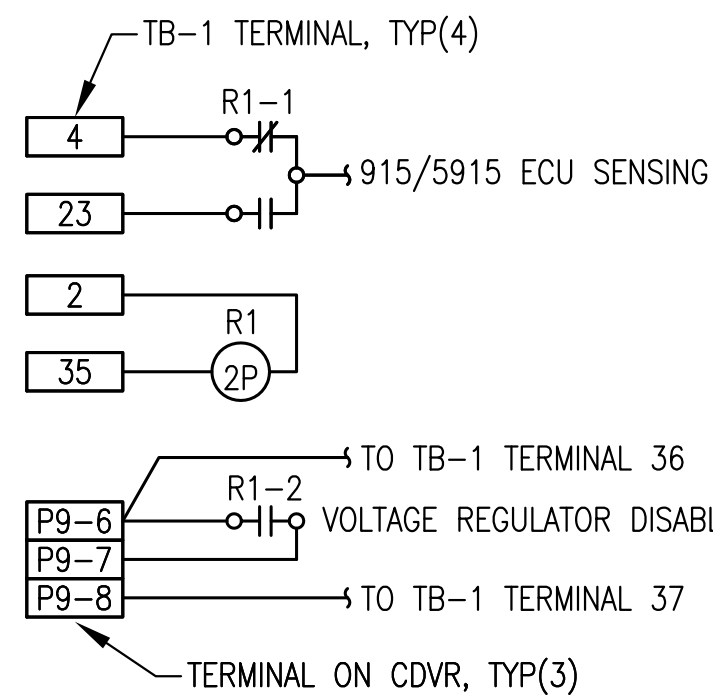


6 IDLE RELAY R1 WIRING DIAGRAM
E6.3 NO SCALE

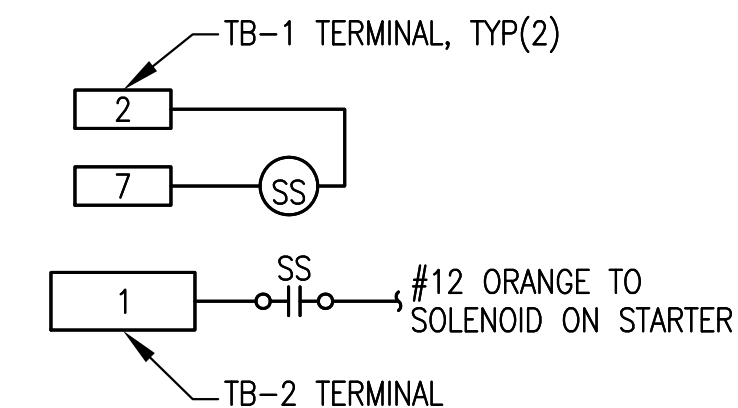

7 STARTER AUX SOLENOID SS WIRING
E6.3 NO SCALE

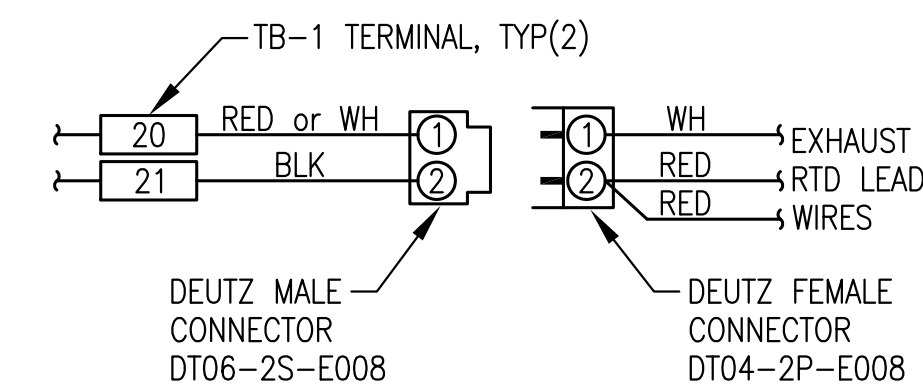


8 EXHAUST RTD CONNECTOR
E6.3 NO SCALE

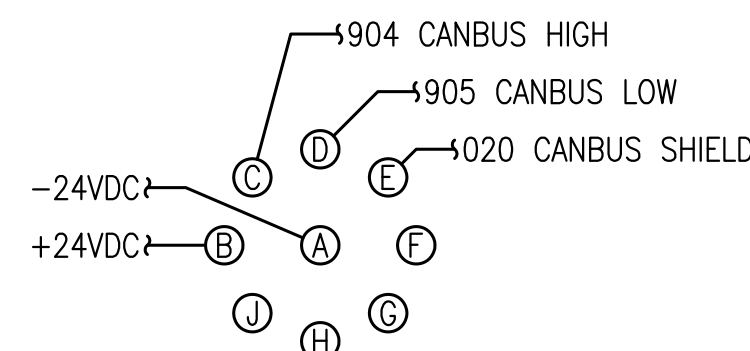

9 DIAGNOSTIC CONNECTOR WIRING
E6.3 NO SCALE

ISSUED FOR CONSTRUCTION
JANUARY 2019

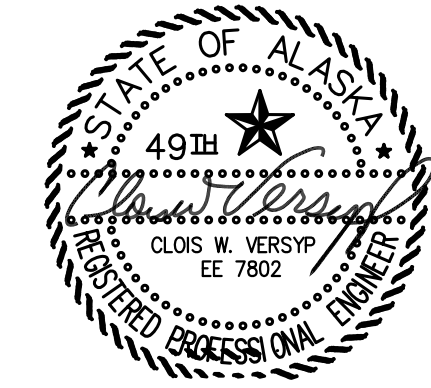

ALASKA ENERGY AUTHORITY


PROJECT: PORT HEIDEN RURAL POWER SYSTEM POWER PLANT UPGRADE

TITLE: 24VDC ENGINE WIRING JUNCTION BOX


DESIGNED BY: CWV/BCG	DATE: 1/14/19
FILE NAME: PTH PPU E6	SHEET: E6.3 OF 7
PROJECT NUMBER:	

Gray Stassel Engineering, Inc.
P.O. 111405, Anchorage, AK 99511 (907)349-0100

DRAWN BY: JTD
SCALE: AS NOTED

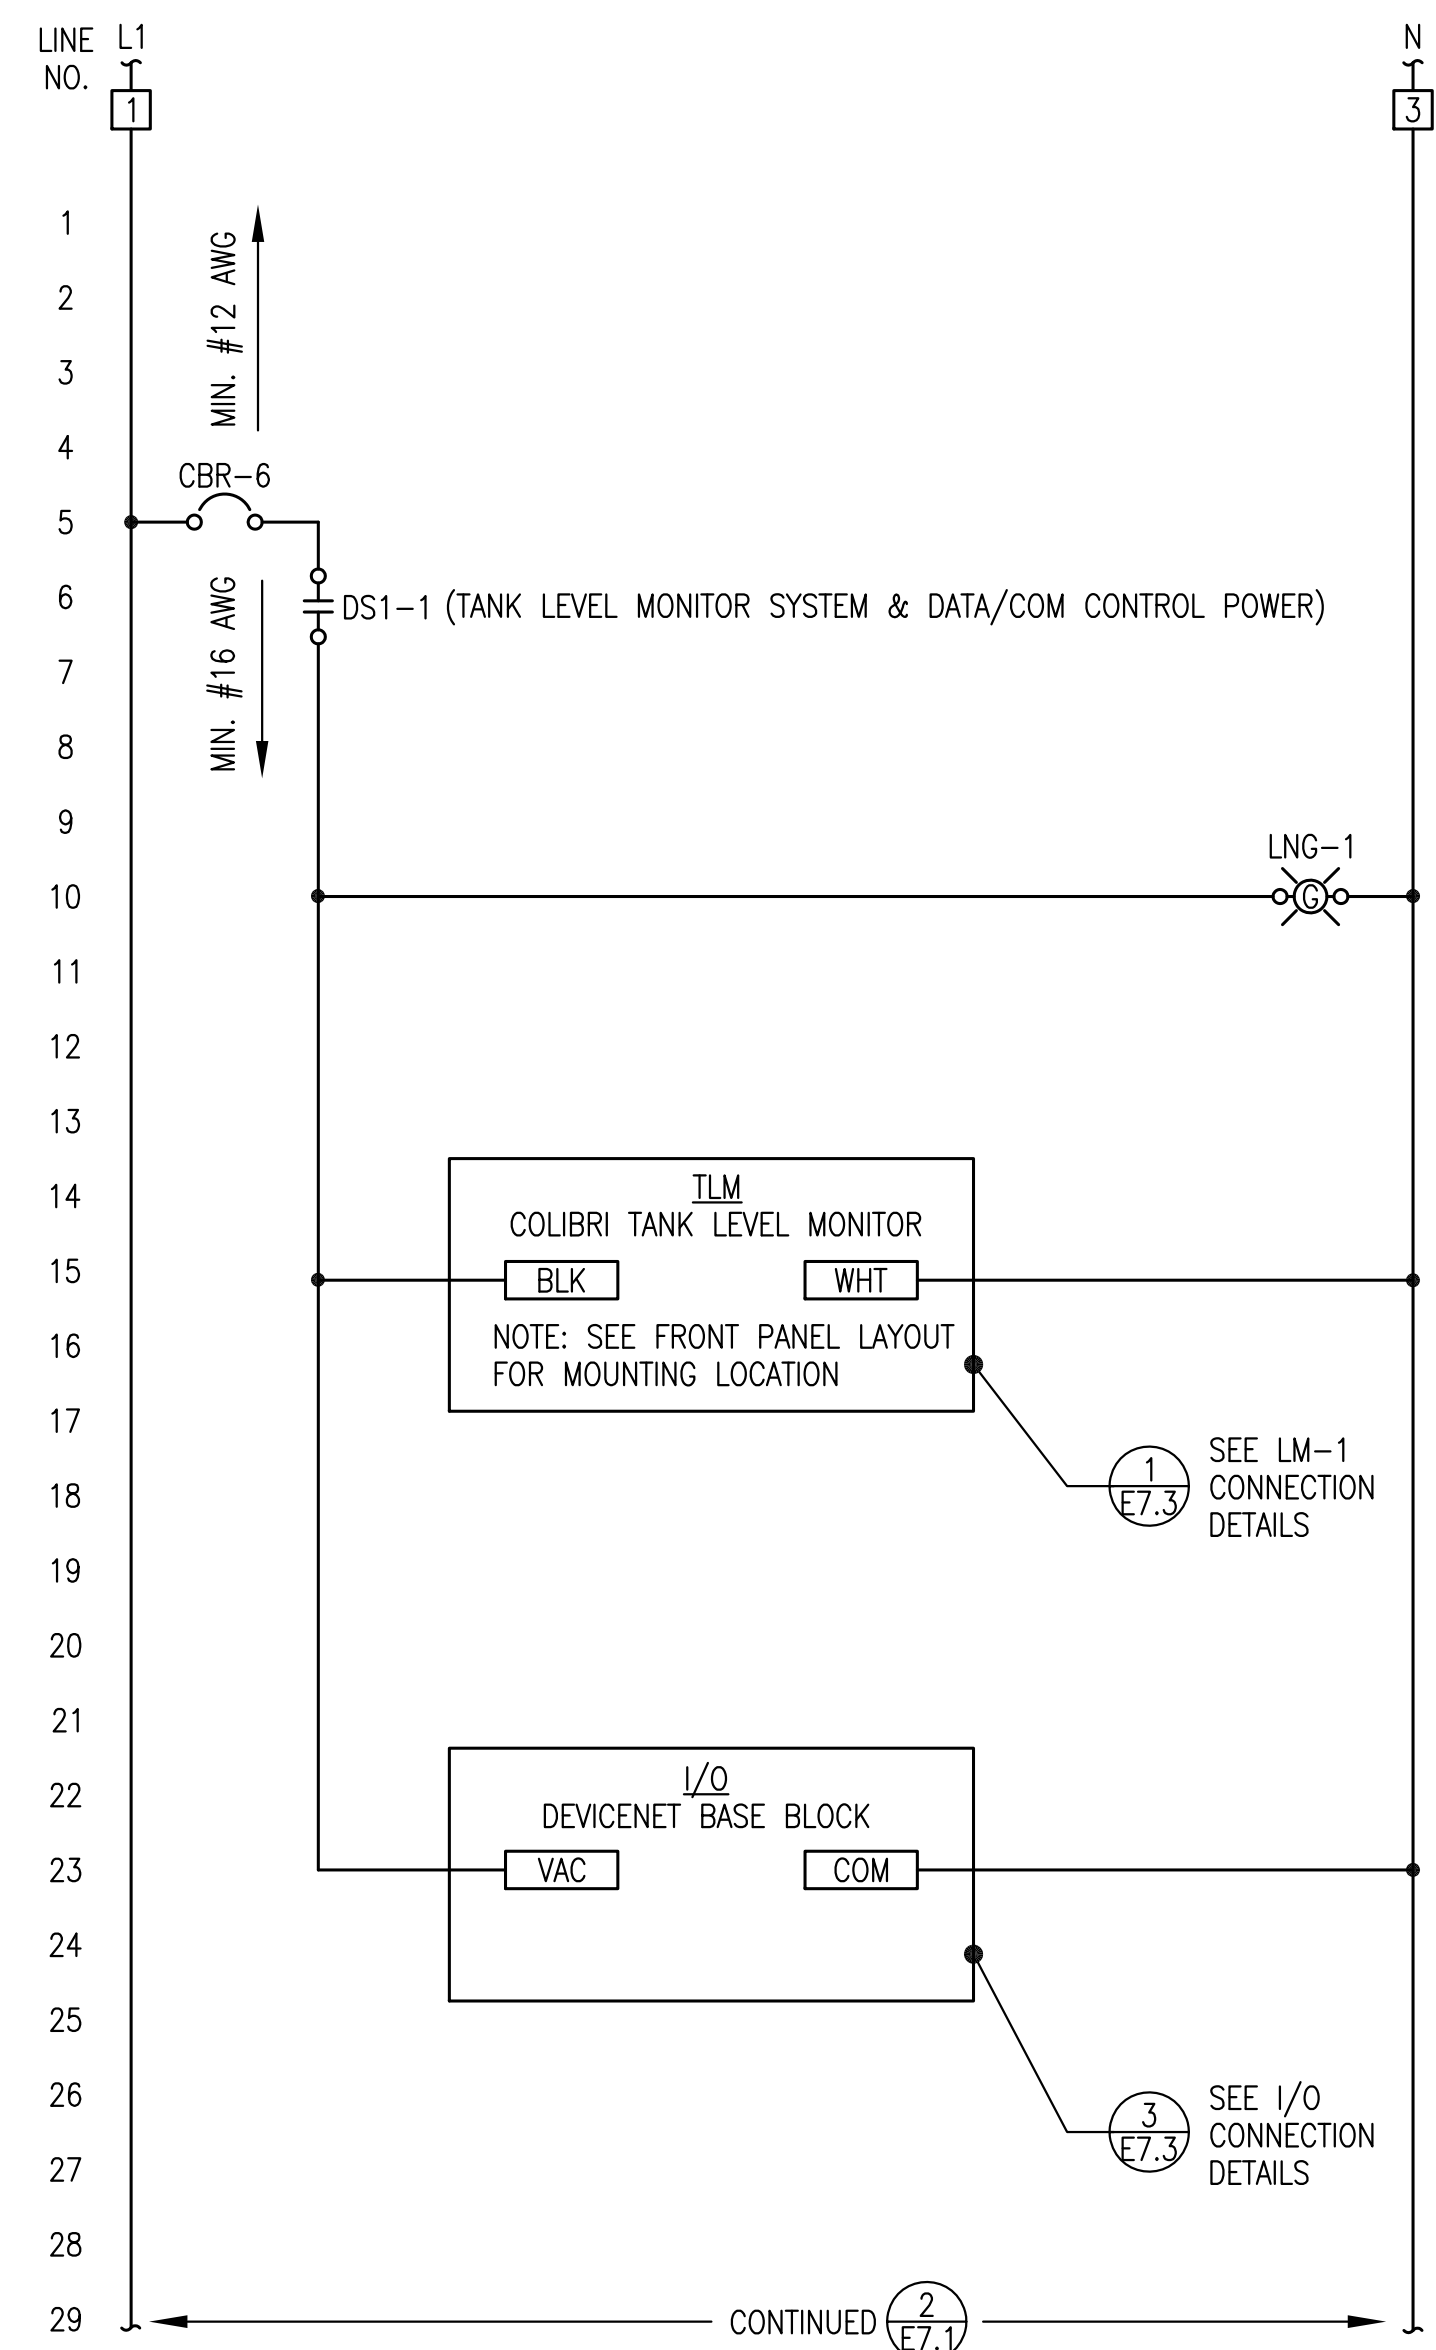

1 DAY TANK LOGIC LOGIC DIAGRAM
E7.1 NO SCALE

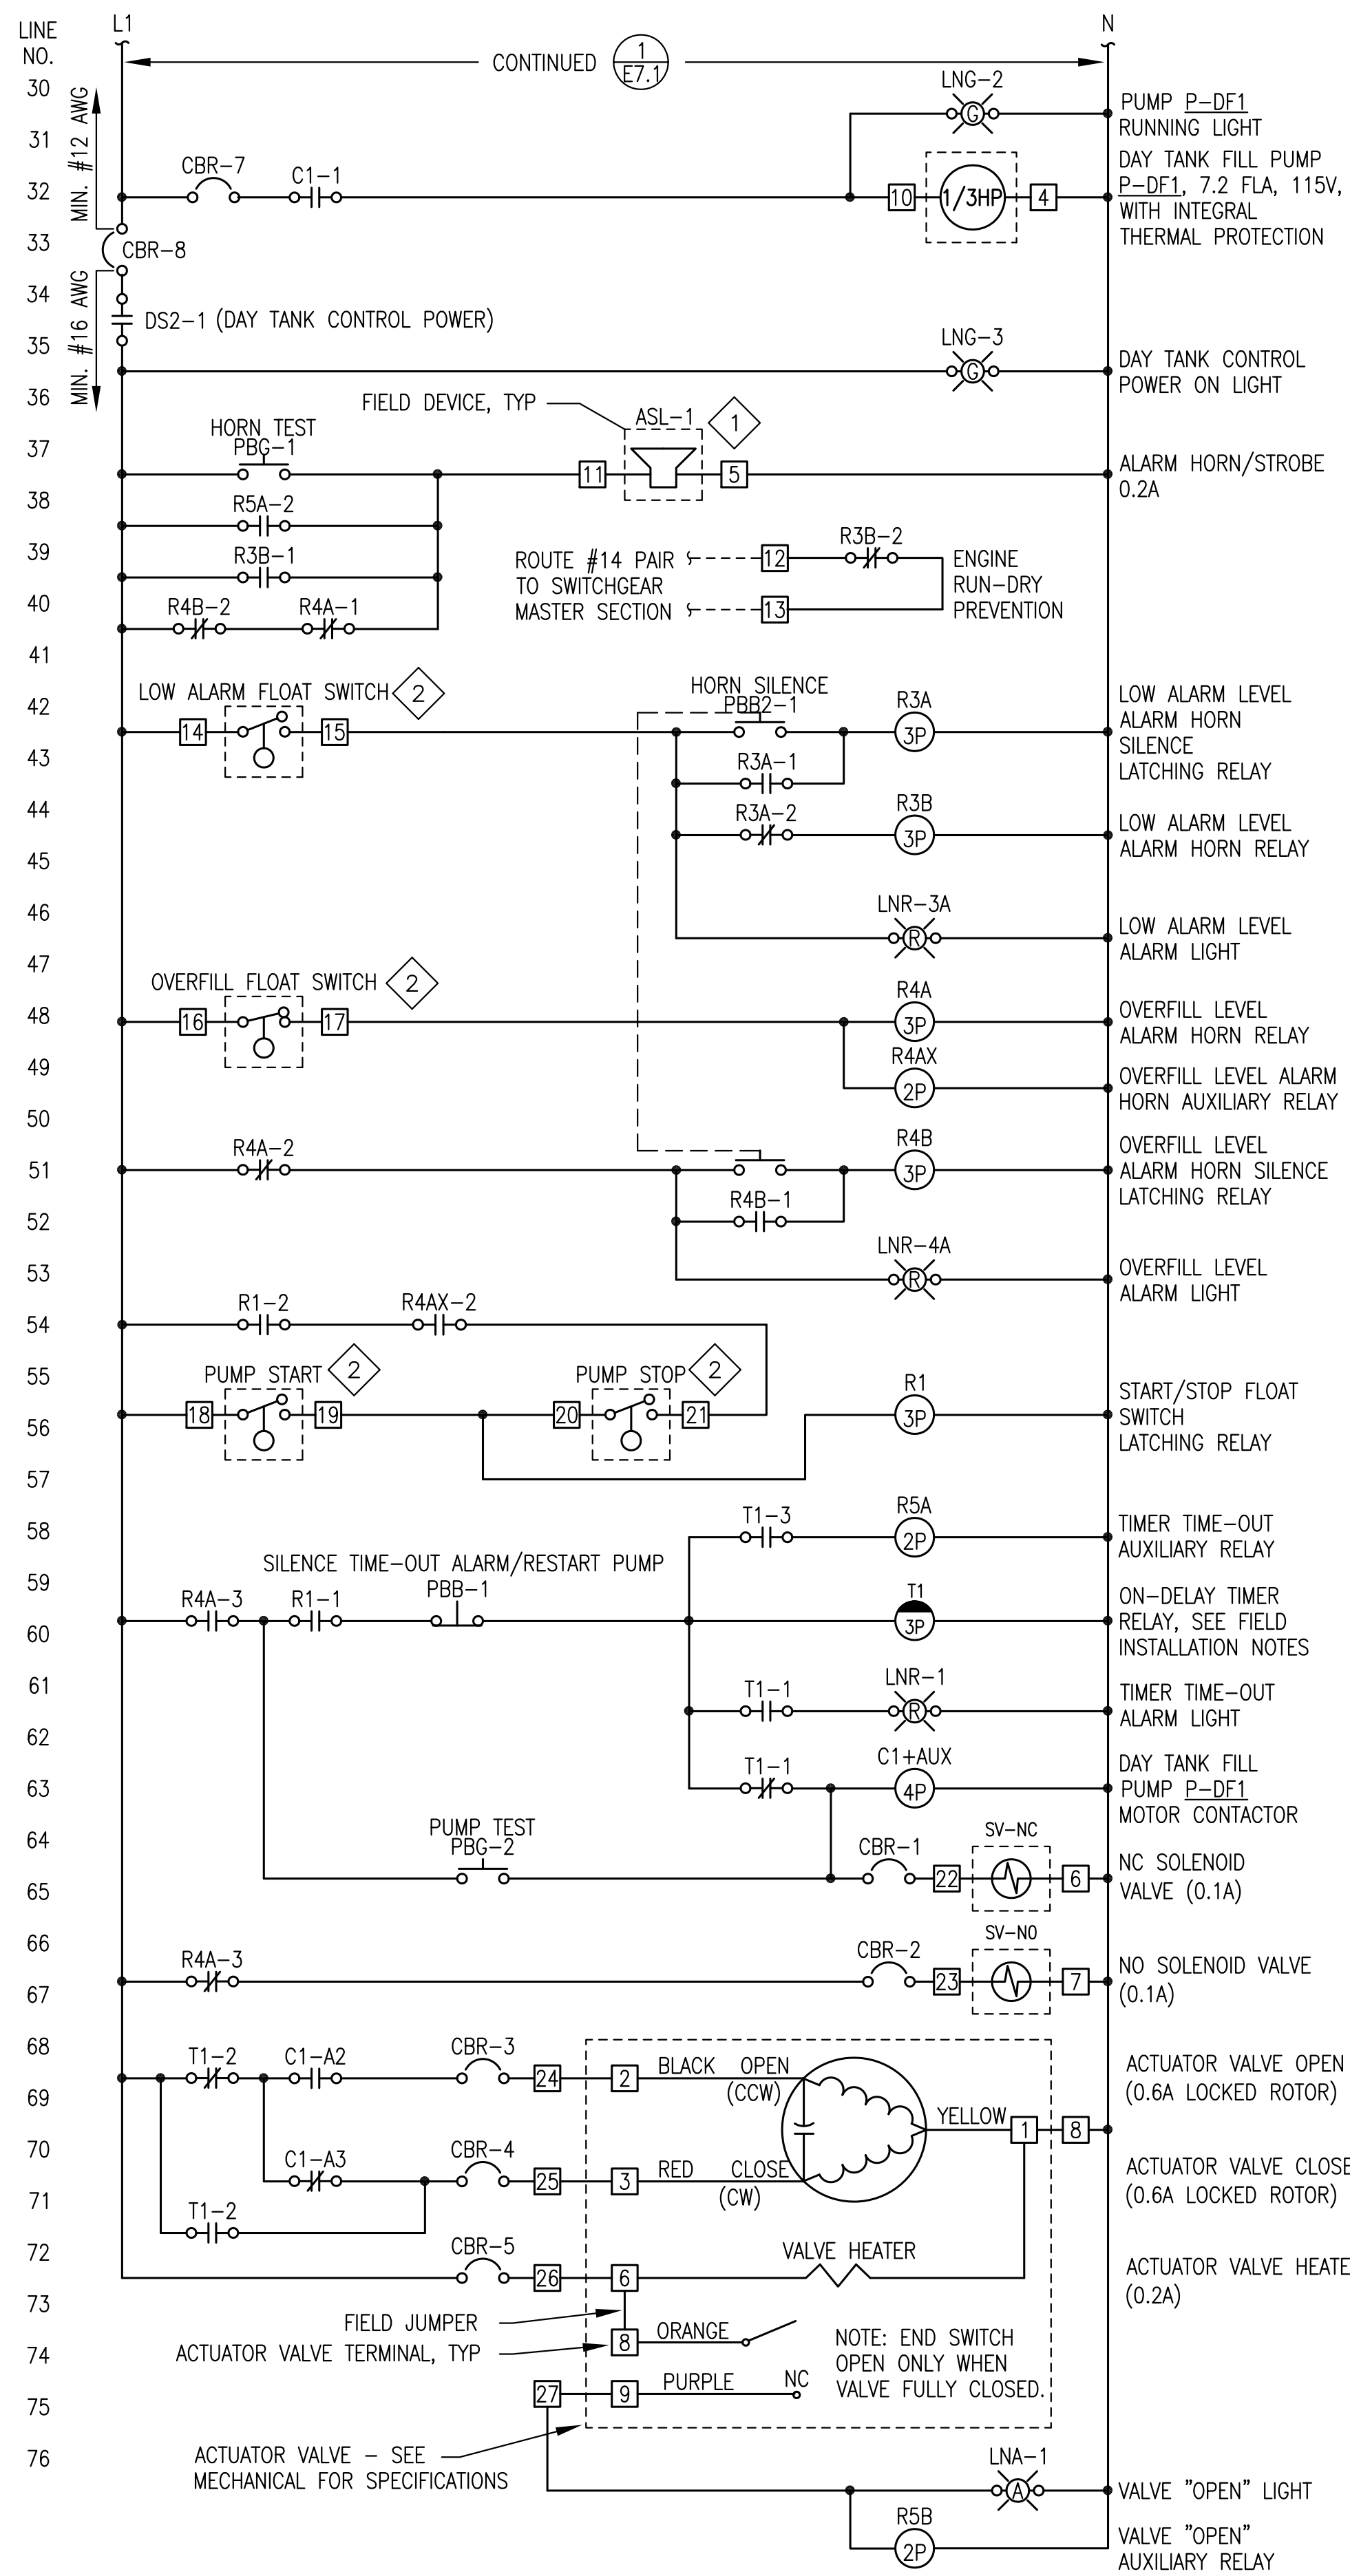


2 DAY TANK LOGIC DIAGRAM (CONTINUED)
E7.1 NO SCALE

BILL OF MATERIALS (NOTE: PROVIDE MATERIALS AS SPECIFIED - NO SUBSTITUTIONS ALLOWED)				
TAG	QTY	MANUFACTURER	MODEL	DESCRIPTION
AUX	1	ALLEN-BRADLEY	100SA11	AUXILIARY CONTACT FOR CONTACTOR, 2 POLE, NO, NC
C	1	ALLEN-BRADLEY	100C23D10	CONTACTOR, 120V COIL, 23A, 3 POLE WITH 1 NO AUX
CBR-1,2,3,4,5	5	ALLEN-BRADLEY	1489-M1-C010	RAIL-MOUNT CIRCUIT BREAKER, 1 POLE, 1A
CBR-6,8	2	ALLEN-BRADLEY	1489-M1-C050	RAIL-MOUNT CIRCUIT BREAKER, 1 POLE, 5A
CBR-7	1	ALLEN-BRADLEY	1489-M1-C150	RAIL-MOUNT CIRCUIT BREAKER, 1 POLE, 15A
DS	2	ALLEN-BRADLEY	194LE201753	DISCONNECT, 2 POSITION, 3 N.O., 20A, FACE MOUNT
LNG	2	ALLEN-BRADLEY	194LHC4E1751	KNOB ACTUATOR FOR LOAD SWITCH, ON/OFF, LOCKABLE
LNG	3	ALLEN-BRADLEY	800HQRH2G	GREEN LED PILOT LIGHT, 12-130V, NEMA 4X
LNR	3	ALLEN-BRADLEY	800HQRH2R	RED LED PILOT LIGHT, 12-130V, NEMA 4X
LNA	1	ALLEN-BRADLEY	800HQRH2A	AMBER LED PILOT LIGHT, 12-130V, NEMA 4X
I/O	1	ALLEN-BRADLEY	1790D-T8A0	120VAC DEVICENET 8 INPUT BASE TERM. BLOCK
PBB	1	ALLEN-BRADLEY	800HAR2D2	MOMENTARY PUSH BUTTON, 1 NC, NEMA 4X, BLACK
PBB2	1	ALLEN-BRADLEY	800HAR2A2	MOMENTARY PUSH BUTTON, 2 NO, NEMA 4X, BLACK
PBG	2	ALLEN-BRADLEY	800HAR1D1	MOMENTARY PUSH BUTTON, 1 NO, NEMA 4X, GREEN
PP	1	PHOENIX CONTACTS	FLPPRJ45/RJ45	ETHERNET PATCH PANEL, RJ45xRJ45, DIN RAIL MOUNT
R (3P)	5	ALLEN-BRADLEY	700HA33A1	3PDT RELAY
	5	ALLEN-BRADLEY	700HN101	11 PIN SOCKET BASE
R (2P)	3	ALLEN-BRADLEY	700HA32A1	DPDT RELAY
T	3	ALLEN-BRADLEY	700HN100	8 PIN SOCKET BASE
	1	ALLEN-BRADLEY	700HA33A1	3PDT RELAY
	1	ALLEN-BRADLEY	700HN205	11 PIN RELAY SOCKET BASE FOR TIMER
	1	ALLEN-BRADLEY	700HT3	SERIES B TIMING MODULE
TB-1/2	42	ALLEN-BRADLEY	1492CAM1L	35A, 600V, LARGE-HEAD SCREW TERMINALS
*TLM	*1	* OWNER FURNISHED COMPONENT TO BE INSTALLED BY PANEL FABRICATOR IN PANEL FACE AND CONNECTED AS INDICATED		* FRANKLIN/INCON COLIBRI CL6D TANK LEVEL MONITOR CONSOLE, COLOR LCD SCREEN, ETHERNET CONNECTION WITH WEB INTERFACE, PROGRAMMABLE VOLUME CALCULATIONS FOR UP TO SIX TANKS WITH TEMPERATURE COMPENSATION

LEGEND			
	CONTROL RELAY		R#-# NORMALLY OPEN CONTACT
	TIME DELAY RELAY		SS-# 2-POSITION SELECTOR SWITCH
	CONTACTOR		R#-# NORMALLY CLOSED CONTACT
	TERMINAL BLOCK		O.L. OVERLOADS
	CIRCUIT BREAKER		PB-# NORMALLY OPEN MOMENTARY PUSH BUTTON
	PANEL WIRING		PB-# NORMALLY CLOSED MOMENTARY PUSH BUTTON
			SW-# NORMALLY OPEN FLOAT SWITCH
			SW-# NORMALLY CLOSED FLOAT SWITCH
			SV# SOLENOID VALVE
			ASL-# ALARM & STROBE LIGHT




ISSUED FOR CONSTRUCTION JANUARY 2019

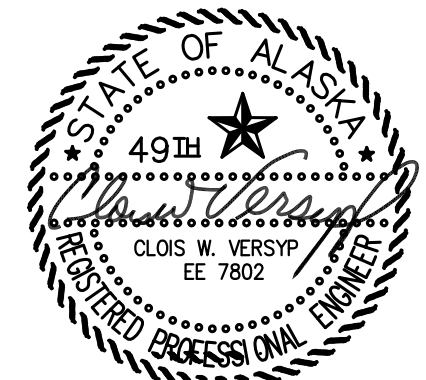

ALASKA ENERGY AUTHORITY

PROJECT:	PORT HEIDEN RURAL POWER SYSTEM POWER PLANT UPGRADE	
TITLE:	DAY TANK CONTROL PANEL LOGIC DIAGRAM & BILL OF MATERIALS	
DRAWN BY: JTD	DESIGNED BY: BCG/CWV	SCALE: AS NOTED
FILE NAME: PTH_PP_E7	PROJECT NUMBER:	SHEET: E7.1 OF 7


P.O. 111405, Anchorage, AK 99511 (907)349-0100

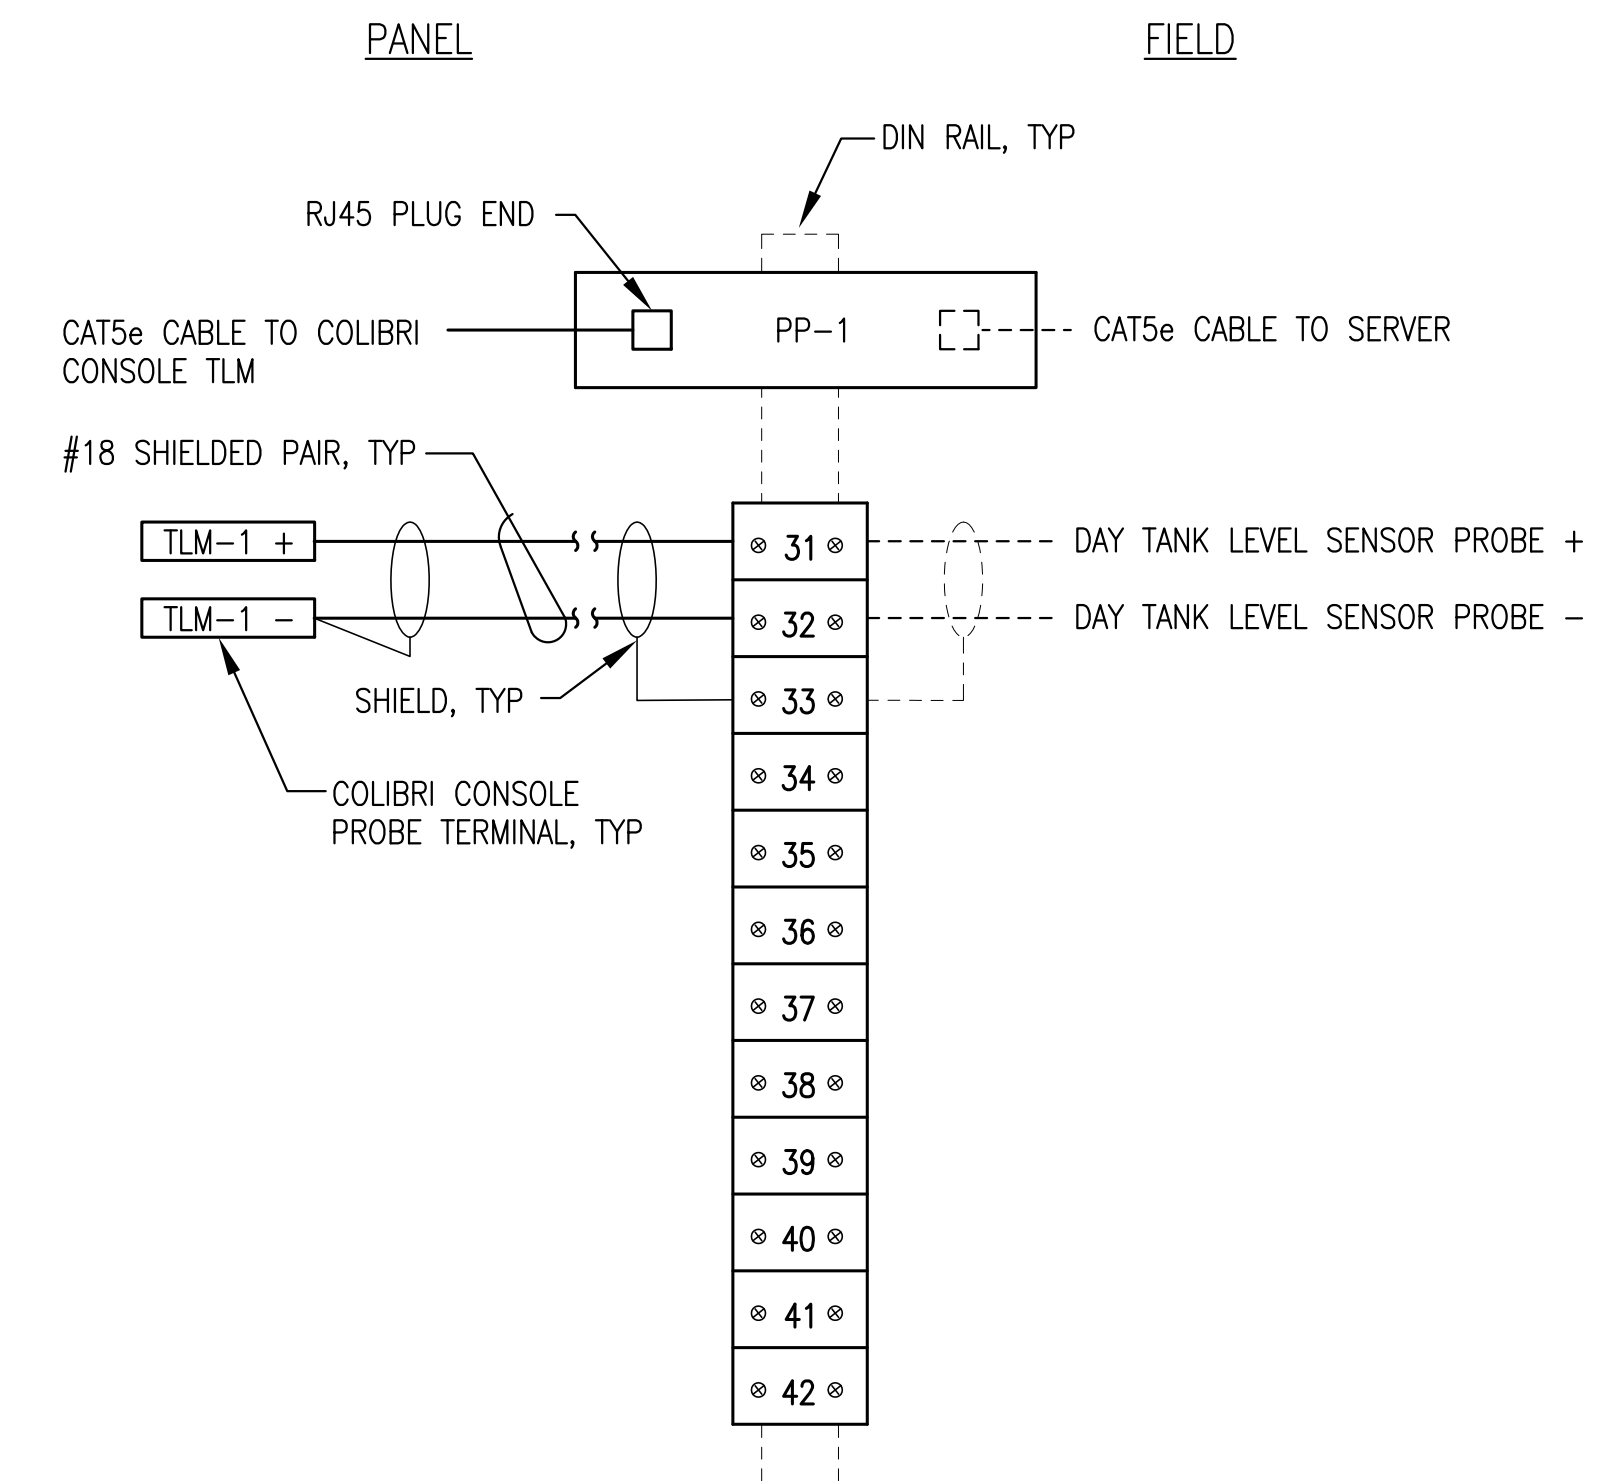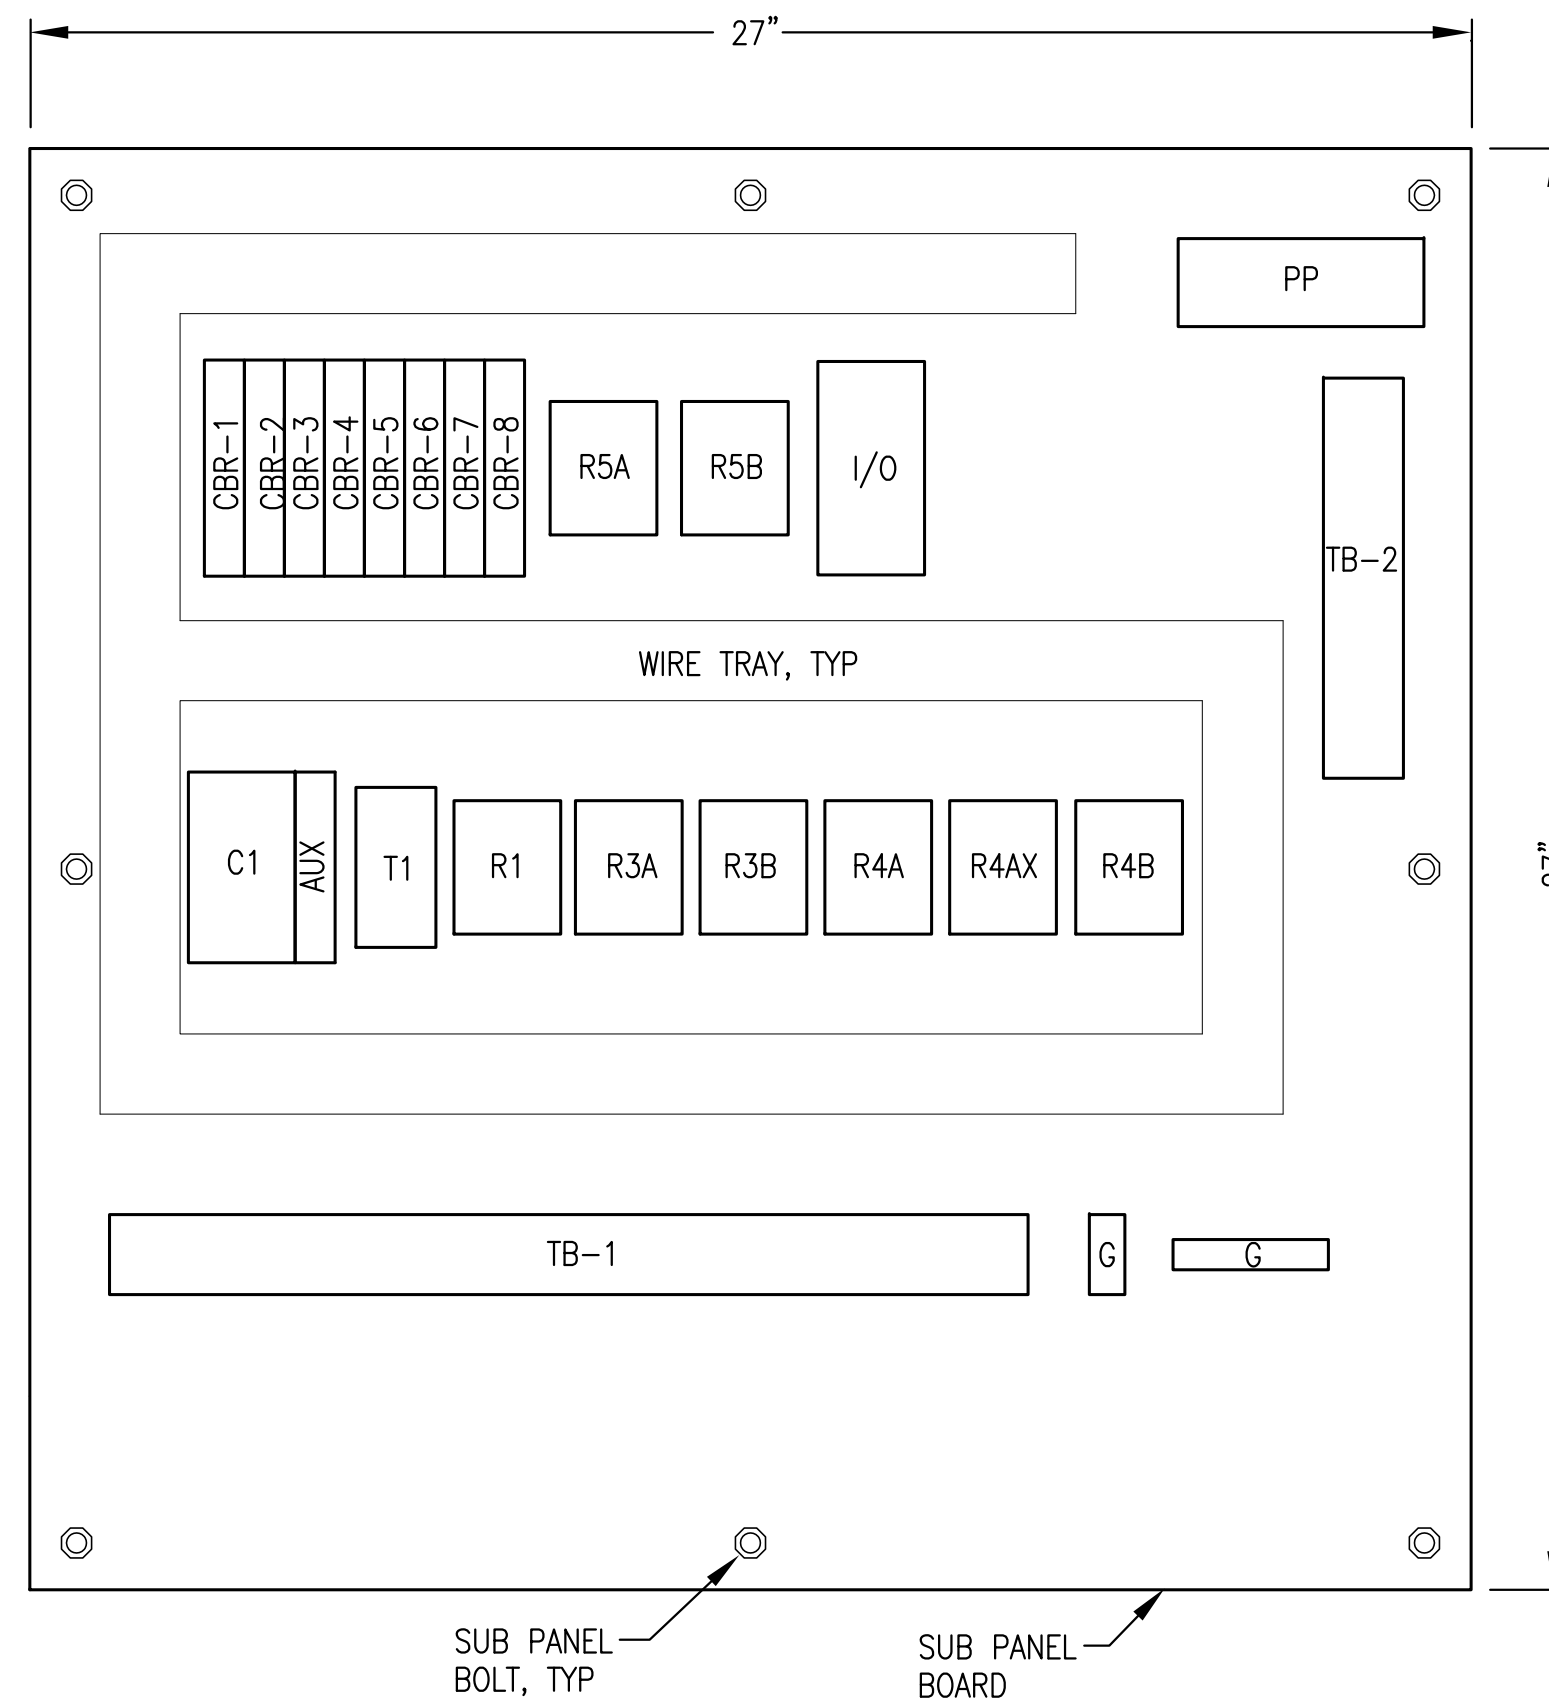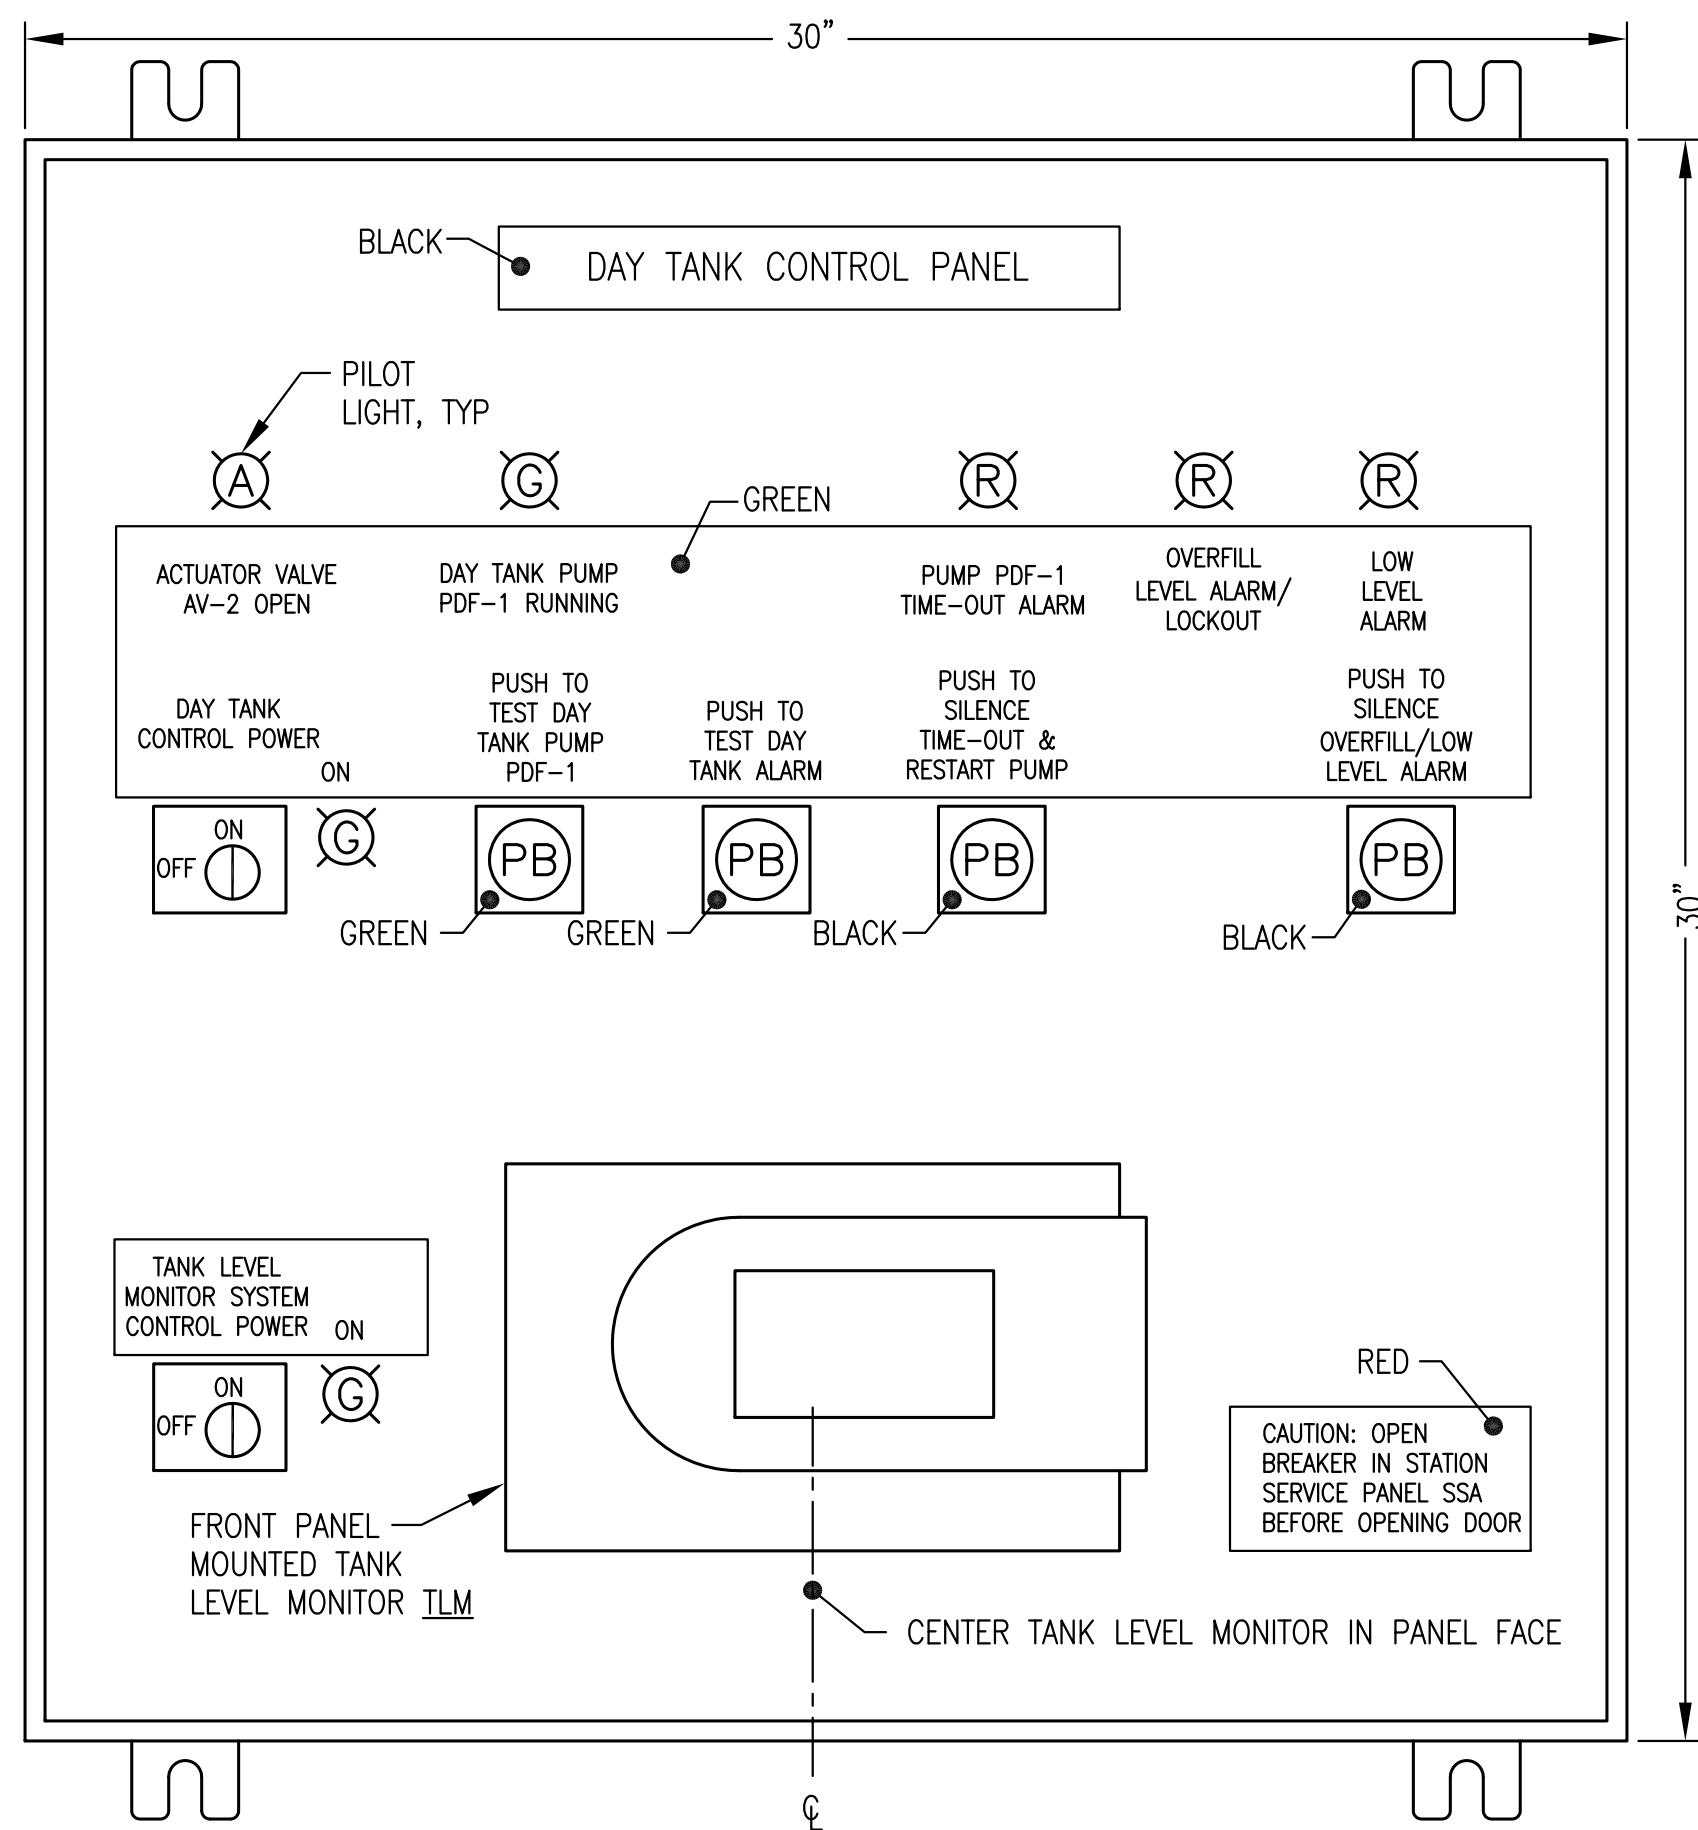

1 FRONT PANEL LAYOUT
E7.2 NO SCALE

2 SUB PANEL LAYOUT
E7.2 NO SCALE


3 TB-2 TERMINAL STRIP AND PP-1 ETHERNET PATCH PANEL LAYOUT
E7.2 NO SCALE

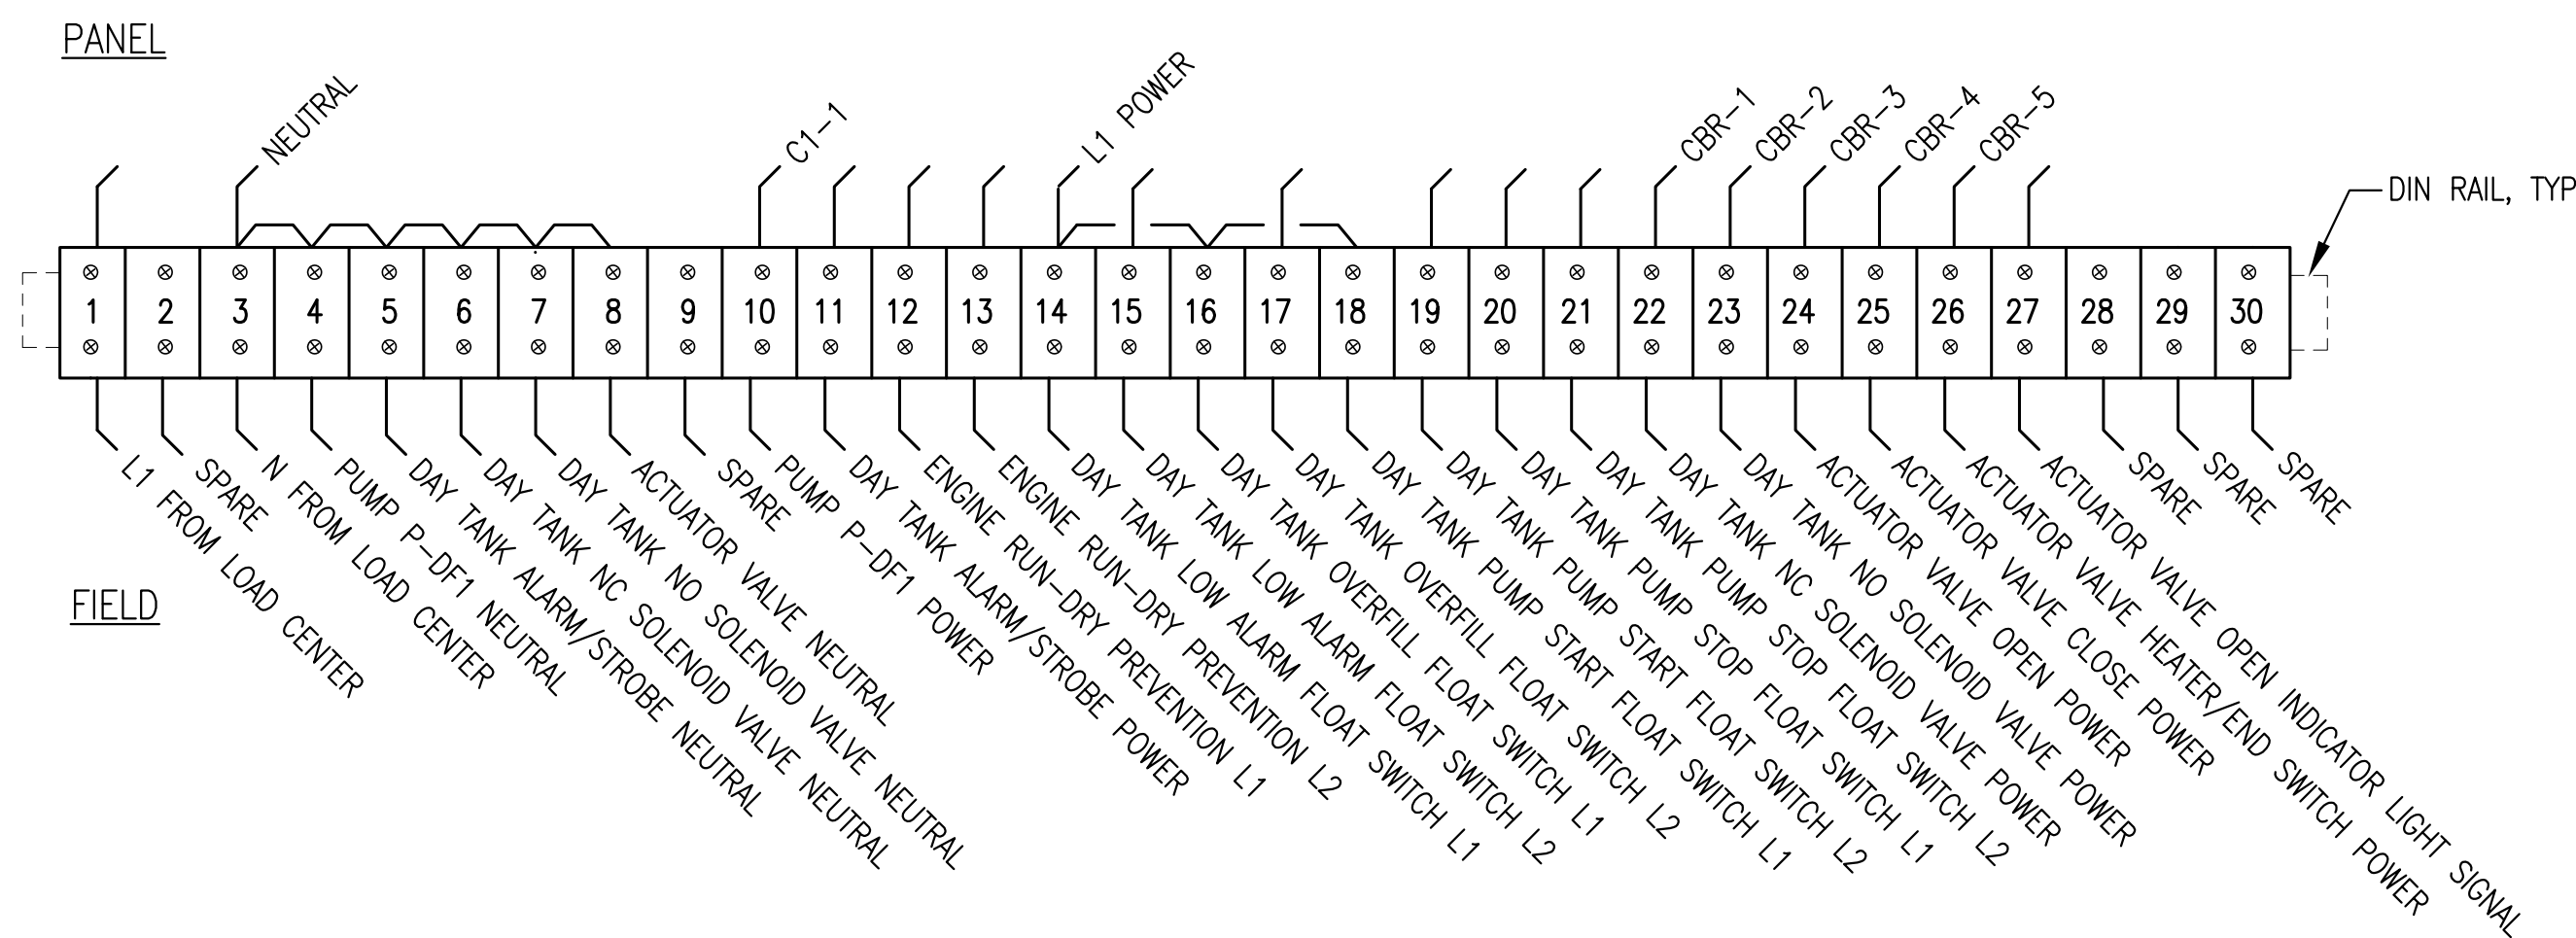

NOTES:
1) INSTALL TERMINAL STRIP TB-1 ON HORIZONTAL DIN RAIL AS SHOWN. LOCATE TERMINAL STRIP BELOW PANEL DEVICES TO ACCOMMODATE CONDUIT ROUTING FROM CONDUITS CONNECTING TO BOTTOM OF PANEL. SEE SUB-PANEL LAYOUT.
2) IN ADDITION TO THE TERMINAL STRIPS SHOWN, PROVIDE 6 EACH 35A SCREW TERMINAL GROUNDING BUS.

4 TB-1 TERMINAL STRIP LAYOUT
E7.2 NO SCALE

ISSUED FOR CONSTRUCTION
JANUARY 2019

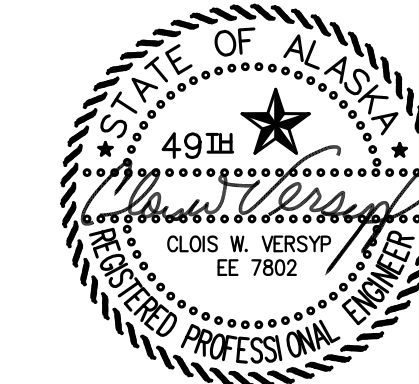

ALASKA ENERGY AUTHORITY

PROJECT:	PORT HEIDEN RURAL POWER SYSTEM POWER PLANT UPGRADE	
TITLE:	DAY TANK CONTROL PANEL LAYOUT & TERMINAL STRIPS	
DRAWN BY:	JTD	SCALE: AS NOTED
DESIGNED BY:	BCG/CWV	DATE: 1/14/19
FILE NAME:	PHL PP E7	SHEET:
PROJECT NUMBER:		E7.2 OF 7

Gray Stassel Engineering, Inc.
P.O. 111405, Anchorage, AK 99511 (907)349-0100

PANEL NOTES:


- 1) PROVIDE COMPLETE UL LISTED PANEL ASSEMBLY WITH ALL DEVICES INDICATED IN LOGIC DIAGRAM EXCEPT FOR FIELD DEVICES. FIELD DEVICES ARE INDICATED WITH DASHED OUTLINE. INSTALL IN A 30" TALL x 30" WIDE x 8" DEEP NEMA 12 ENCLOSURE WITH 4 EACH INTEGRAL MOUNTING LUGS AT BACK. SEE SHEET E7 FOR PANEL LAYOUT DETAILS.
- 2) USE MIN #12 WIRE FOR ALL CIRCUITS UP TO FIRST IN-LINE PANEL BREAKERS (FOR 20A FEED). USE MIN #16 AWG ON ALL 5 AMP CIRCUITS AND MIN #14 AWG WIRE ON ALL 15A CIRCUITS. FOR ALL JUMPERS THAT RUN CONTINUOUSLY (ONE-PIECE WIRE) BETWEEN THE DESIGNATED BEGINNING AND ENDING POINTS, TAG EACH END WITH DEVICE OR TERMINATION DESIGNATOR OF LANDING OF OPPOSITE END OF JUMPER (REVERSE ADDRESS). FOR ALL JUMPERS THAT RUN DISCONTINUOUSLY (MULTIPLE WIRES) BETWEEN THE DESIGNATED BEGINNING AND ENDING POINTS, TAG WITH A COMMON JUMPER NUMBER. TAG ALL NEUTRALS WITH A COMMON JUMPER NUMBER. PROVIDE AN AS-BUILT LOGIC WIRING DIAGRAM THAT INCLUDES ALL ASSIGNED JUMPER TAGS.
- 3) LABEL ALL PANEL DEVICES ON BASE OR BACK PANEL ADJACENT TO ITEM. LABEL REMOTE EQUIPMENT CONNECTIONS AT EACH TERMINAL BLOCK BY THE ITEM TITLE AS SHOWN ON THE FIELD SIDE LAYOUT OF THE TERMINAL STRIP DRAWING. PROVIDE BEVELED EDGE WHITE CORE NAMEPLATES AS SHOWN ON THE PANEL FACE LAYOUT AND SECURE TO PANEL FACE WITH A MINIMUM OF TWO STAINLESS STEEL MOUNTING SCREWS, COLOR AS INDICATED.
- 4) BENCH TEST COMPLETED UNIT. PROVIDE MIN 48 HOURS NOTICE TO ENGINEER TO SCHEDULE OBSERVATION OF BENCH TEST. PROVIDE SWITCHES AND LAMPS TO SIMULATE OPERATION OF ALL FIELD DEVICES.
- 5) FIELD WIRING AND FIELD INSTALLED DEVICES PROVIDED BY OTHERS ARE SHOWN FOR INFORMATIONAL PURPOSES ONLY AND ARE NOT PART OF THE PANEL BID.
- 6) POWER TO PANEL PROVIDED FROM DEDICATED 20A 2-POLE CIRCUIT BREAKER IN LISTED LOAD CENTER. SEE FIELD INSTALLATION NOTE #3.

FIELD INSTALLATION NOTES:


- 1) SEE MECHANICAL FOR DAY TANK INSTALLATION & PIPING. INSTALL CONTROL PANEL & FIELD DEVICES AS INDICATED TO PROVIDE REDUNDANT HIGH & LOW LIMIT CONTROLS & OVERFILL PROTECTION.
- 2) FIELD WIRING TO FLOAT SWITCHES, SOLENOID VALVES, ACTUATOR VALVE, & ALARM HORN #14 AWG. ALL OTHER FIELD WIRING #12 AWG. LABEL BOTH ENDS OF ALL CONDUCTORS WITH CONTROL PANEL TERMINAL BLOCK TERMINATION NUMBERS. WHEN NOT IN CONDUIT, MAKE JACKETED COM CABLE ENCLOSURE ENTRIES WITH CABLE GLAND CONNECTORS.
- 3) PERFORM ALL FIELD WIRING IN ACCORDANCE WITH ELECTRICAL SPECIFICATIONS ON SHEET E2. PROVIDE POWER TO DAY TANK PANEL FROM DEDICATED 20A 2-POLE CIRCUIT BREAKER IN LISTED LOAD CENTER.
- 4) VERIFY THAT ALL FLOAT SWITCHES ARE ORIENTED FOR N.C. (OPEN ON RISE) OPERATION PRIOR TO INSTALLATION. ALL FLOATS SHOWN ON LOGIC DIAGRAM WITH TANK AT FULL (PUMP STOP) LEVEL.
- 5) FILL PUMP CAVITY WITH LUBE OIL PRIOR TO INITIAL OPERATION. VERIFY PROPER ROTATION OF PUMP. PRIME SYSTEM WITH HAND PRIMING PUMP PRIOR TO OPERATING DAY TANK PUMP.
- 6) FIELD TEST COMPLETED UNIT TO VERIFY ALL CONTROL AND ALARM FUNCTIONS. MANIPULATE FLOAT SWITCHES BY REACHING IN THROUGH ADJACENT 4" BUNG. TEMPORARILY SET TIMING RELAY TO 30 SECONDS TO VERIFY TIME-OUT AND RESET FUNCTIONS.
- 7) SET TIMING RELAY TIME DELAY TO 30 MINUTES (APPROX. 55 GALS. REQUIRED FROM PUMP START TO PUMP STOP LEVEL @ APPROX. 4 GPM). ON THE INITIAL TANK FILL, THE SILENCE TIME OUT/RESTART BUTTON MAY HAVE TO BE PRESSED IN ORDER TO GET THE FUEL LEVEL TO WITHIN THE NORMAL OPERATING RANGE. SEE "SEQUENCE OF OPERATIONS".

DAY TANK FILL SEQUENCE OF OPERATIONS:


- 1) WHEN THE DAY TANK CIRCUIT BREAKER AND CONTROL POWER SWITCH ARE CLOSED, THE POWER LIGHT IS ON AND POWER IS PROVIDED TO THE REMOTE ACTUATOR VALVE HEATER/"OPEN" LIGHT CIRCUIT.
- 2) WHEN THE DAY TANK IS NOT CALLING FOR FUEL, POWER IS PROVIDED TO THE REMOTE ACTUATOR VALVE CLOSE CIRCUIT. WHEN THE ACTUATOR IS IN THE FULLY CLOSED POSITION, THE CLOSING CIRCUIT IS BROKEN BY INTERNAL ACTUATOR LIMIT SWITCH #2 AND THE REMOTE ACTUATOR VALVE "OPEN" LIGHT IS OFF.
- 3) NORMAL FILL OPERATION - WHEN THE FUEL LEVEL DROPS TO THE "PUMP START" SWITCH, THE TIMER IS STARTED, THE N.C. DAY TANK SOLENOID VALVE OPENS, THE REMOTE ACTUATOR VALVE OPENS & THE VALVE "OPEN" LIGHT TURNS ON, THE DAY TANK PUMP IS ENERGIZED, AND THE PUMP "ON" LIGHT TURNS ON. WHEN THE ACTUATOR IS IN THE FULLY OPEN POSITION, THE OPENING CIRCUIT IS BROKEN BY INTERNAL ACTUATOR LIMIT SWITCH #7 AND THE REMOTE ACTUATOR VALVE "OPEN" LIGHT REMAINS ON. WHEN FUEL REACHES THE "PUMP STOP" FLOAT SWITCH BEFORE THE TIMER TIMES-OUT, THE TIMER IS RESET, THE N.C. DAY TANK SOLENOID VALVE AND REMOTE ACTUATOR VALVE CLOSE, THE REMOTE ACTUATOR VALVE "OPEN" LIGHT TURNS OFF, THE PUMP DE-ENERGIZES, AND THE PUMP "ON" LIGHT TURNS OFF.
- 4) TIMER OPERATION - IF THE TIMER TIMES-OUT THE N.C. DAY TANK SOLENOID VALVE AND REMOTE ACTUATOR VALVE CLOSE, THE REMOTE ACTUATOR VALVE "OPEN" LIGHT TURNS OFF, THE PUMP DE-ENERGIZES, THE PUMP "ON" LIGHT TURNS OFF, THE "TIME-OUT" ALARM LIGHT TURNS ON, AND THE TIME-OUT ALARM HORN SOUNDS. PRESSING THE "TIME-OUT ALARM SILENCE / PUMP RESTART" BUTTON RESETS THE TIMER, SILENCES THE ALARM HORN, AND STARTS THE NORMAL FILL OPERATION. SEE FIELD INSTALLATION NOTES FOR TIMER SETTING.
- 5) OVERFILL FUEL LEVEL - IF THE TANK OVERFILLS AND THE FUEL LEVEL REACHES THE "OVERFILL" FLOAT SWITCH, THE N.O. DAY TANK SOLENOID VALVE CLOSSES, THE "OVERFILL LEVEL" ALARM LIGHT TURNS ON, THE N.C. DAY TANK SOLENOID VALVE AND REMOTE ACTUATOR VALVE CLOSE, THE VALVE "OPEN" LIGHT TURNS OFF, THE PUMP DE-ENERGIZES, THE PUMP "ON" LIGHT TURNS OFF, THE "OVERFILL LEVEL" ALARM LIGHT TURNS ON, AND THE ALARM HORN SOUNDS. PRESSING THE LEVEL ALARM HORN "SILENCE" BUTTON SILENCES THE ALARM HORN WHILE LEAVING THE "OVERFILL LEVEL" ALARM LIGHT ON. WHEN THE FUEL LEVEL FALLS BELOW THE "OVERFILL" FLOAT SWITCH, THE "OVERFILL LEVEL" ALARM LIGHT TURNS OFF, THE N.O. DAY TANK SOLENOID VALVE OPENS AND THE ALARM HORN TURNS OFF (IF NOT PREVIOUSLY SILENCED). WHEN THE FUEL LEVEL REACHES THE "PUMP START" FLOAT SWITCH, THE NORMAL FILL OPERATION IS REPEATED.
- 6) LOW FUEL LEVEL - IF THE FUEL LEVEL FALLS BELOW THE "LOW ALARM" FLOAT SWITCH, THE "LOW FUEL LEVEL" ALARM LIGHT TURNS ON, THE ENGINE RUN-DRY PREVENTION DRY CONTACT OPENS, AND THE ALARM HORN SOUNDS. THE LEVEL ALARM HORN "SILENCE" BUTTON SILENCES THE ALARM HORN WHILE LEAVING THE "LOW FUEL LEVEL" ALARM LIGHT ON. WHEN THE FUEL LEVEL RISES ABOVE THE "LOW ALARM" FLOAT SWITCH THE "LOW FUEL LEVEL" ALARM LIGHT TURNS OFF, THE ENGINE RUN-DRY PREVENTION DRY CONTACT CLOSSES, AND THE ALARM HORN TURNS OFF (IF NOT PREVIOUSLY SILENCED).
- 7) PUMP & HORN TEST - MOMENTARY CONTACT BUTTONS ARE PROVIDED TO TEST FUNCTION OF THE DAY TANK PUMP AND ALARM HORN. PRESSING THE "PUSH TO TEST DAY TANK PUMP" BUTTON STARTS THE TIMER, MOMENTARILY OPENS THE N.C. DAY TANK SOLENOID VALVE & ACTUATED BALL VALVE, ENERGIZES THE DAY TANK PUMP, AND TURNS ON THE DAY TANK PUMP "RUNNING" LIGHT. THE "PUSH TO TEST DAY TANK PUMP" BUTTON IS LOCKED OUT IF THE DAY TANK IS AT THE OVERFILL LEVEL. PRESSING THE "PUSH TO TEST DAY TANK ALARM" BUTTON MOMENTARILY ENERGIZES THE ALARM HORN/STROBE.

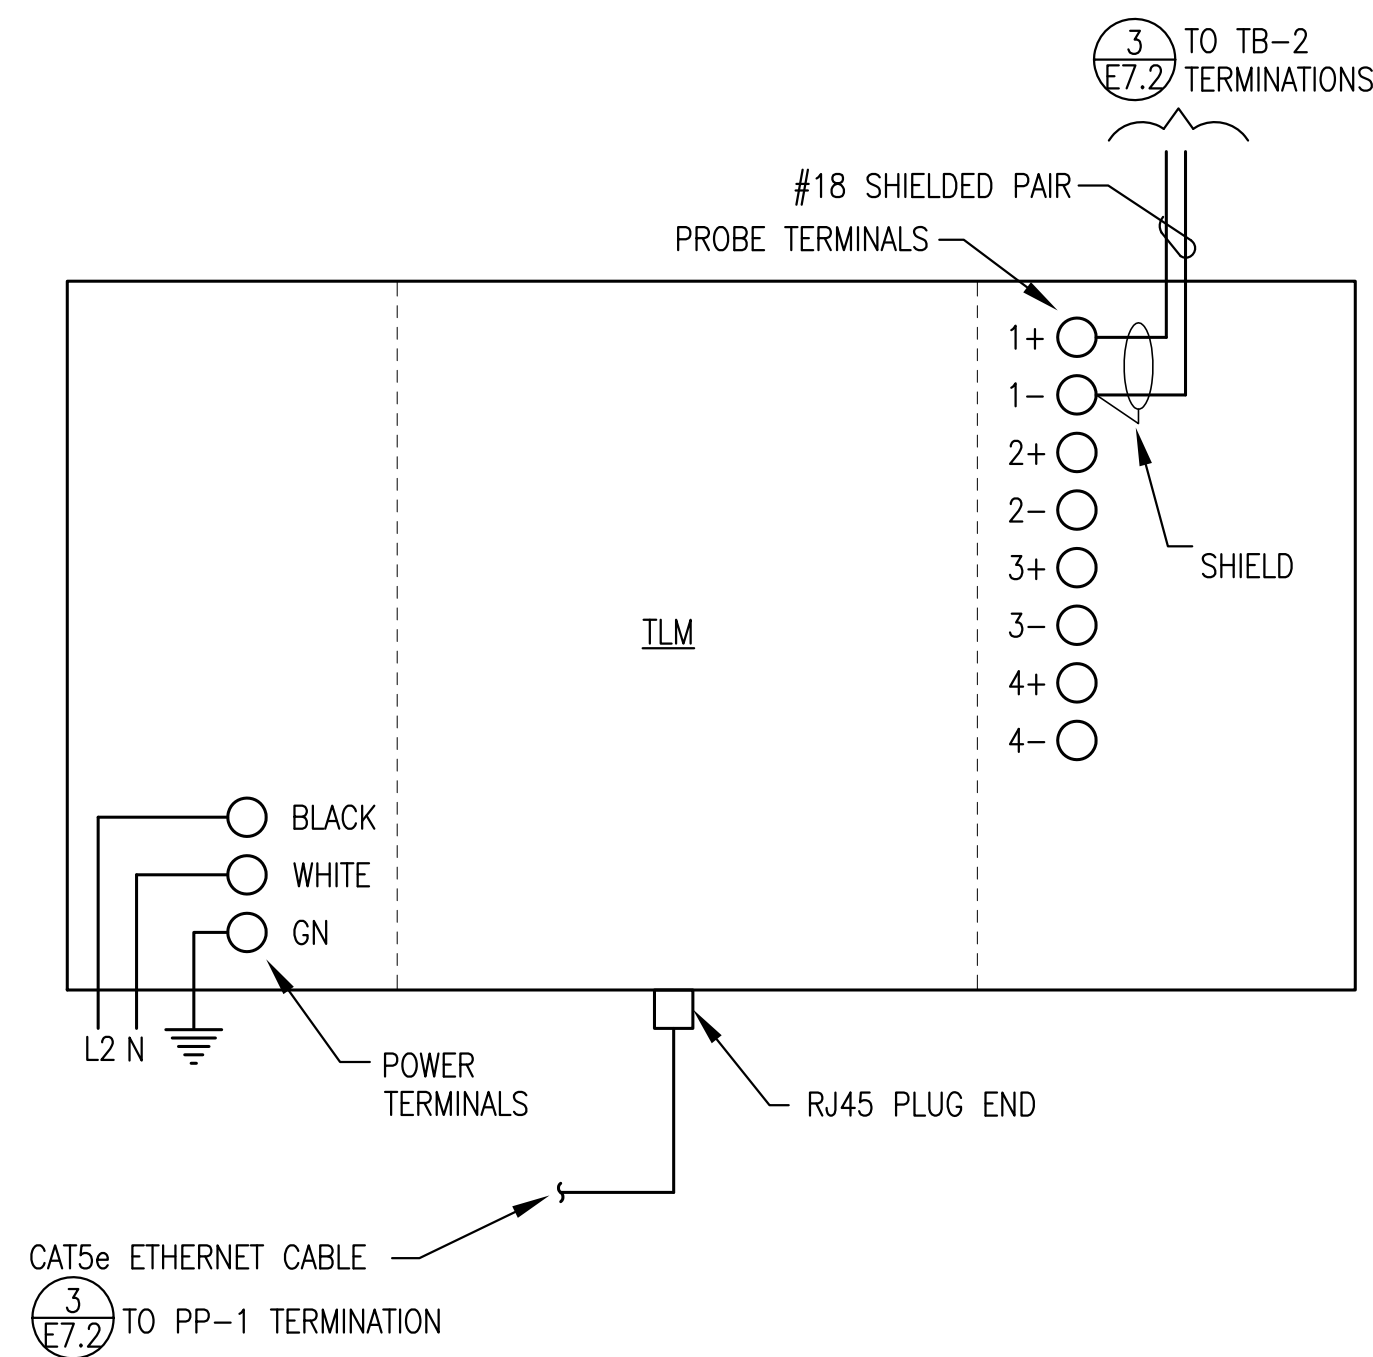

1 TANK LEVEL MONITOR (TLM) CONSOLE CONNECTION DETAILS
E7.3 NO SCALE

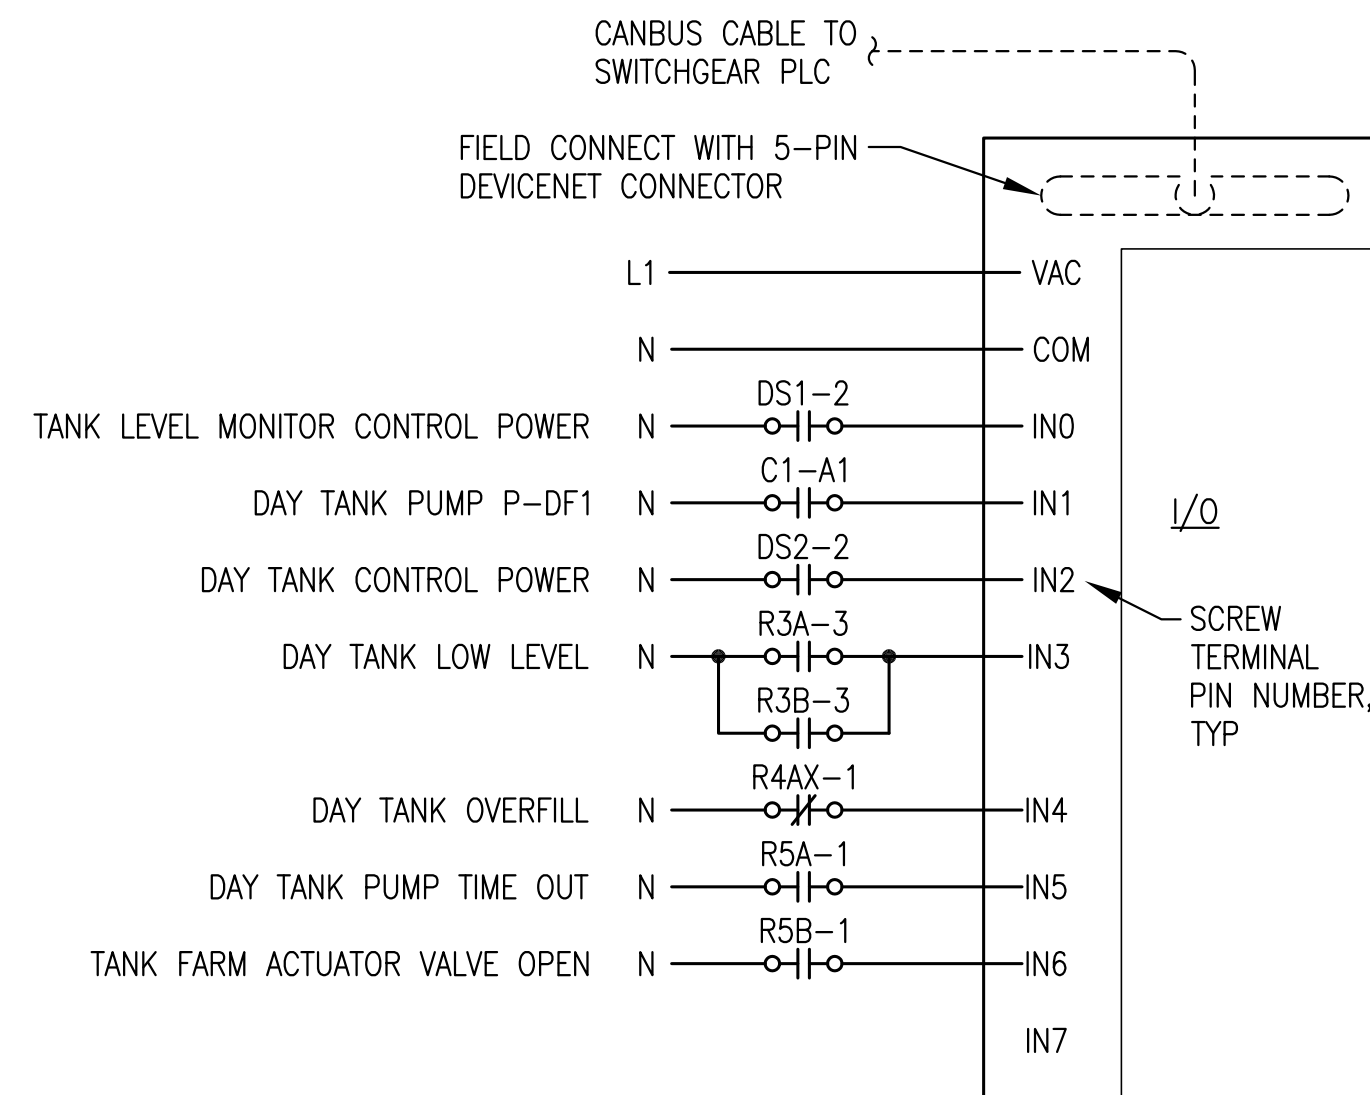


3 DEVICENET TERMINAL BLOCKS (I/O) LOGIC & CONNECTION DETAILS
E7.3 NO SCALE

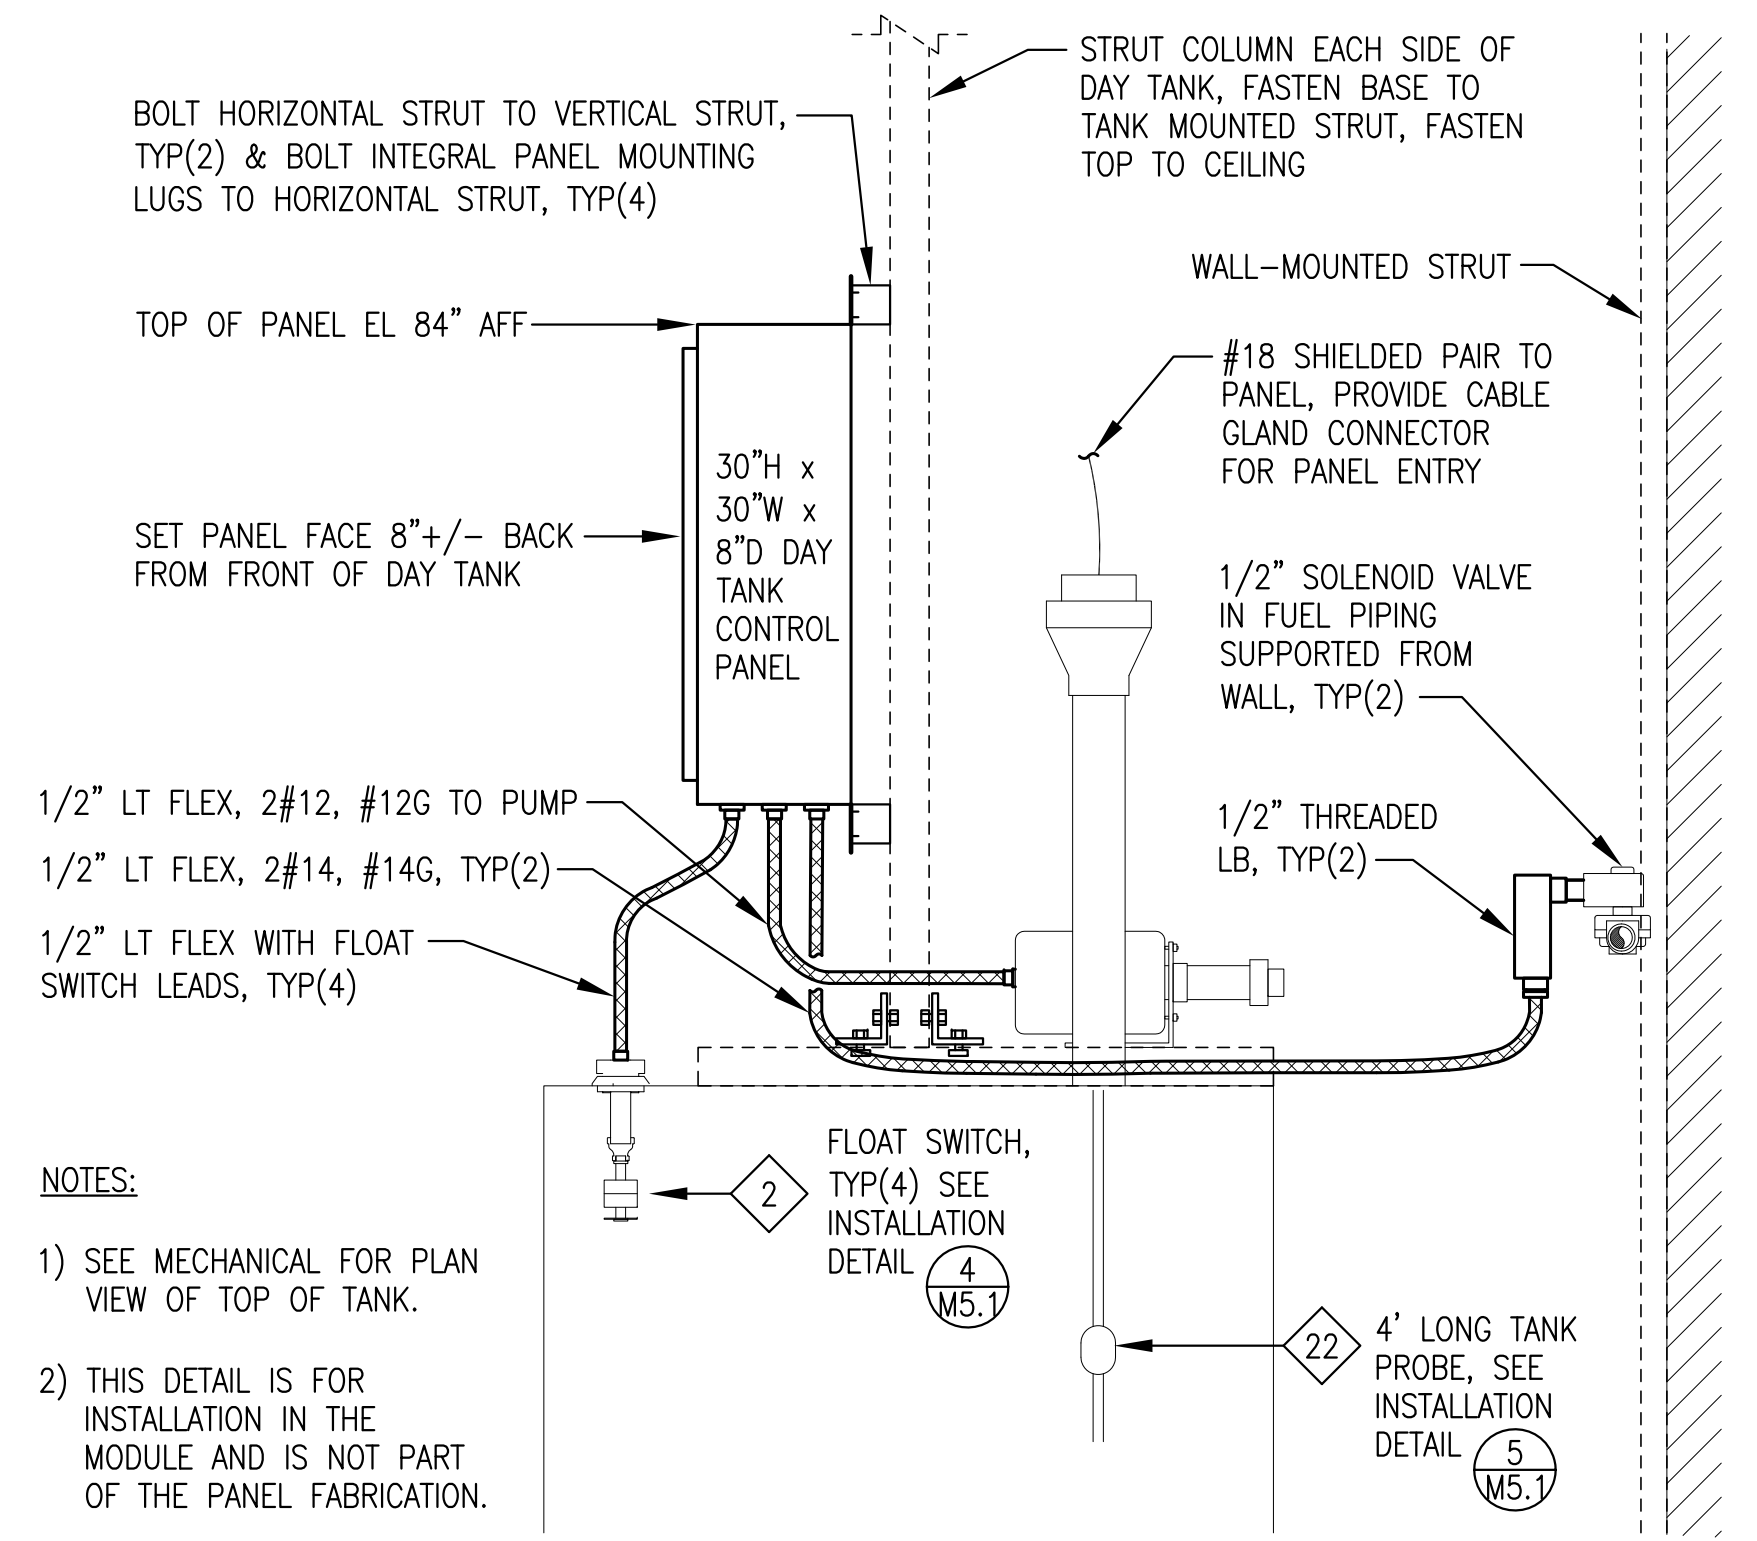


- NOTES:**
- 1) SEE MECHANICAL FOR PLAN VIEW OF TOP OF TANK.
 - 2) THIS DETAIL IS FOR INSTALLATION IN THE MODULE AND IS NOT PART OF THE PANEL FABRICATION.

2 DAY TANK CONTROL PANEL & DEVICE INSTALLATION
E7.3 NO SCALE


ISSUED FOR CONSTRUCTION JANUARY 2019

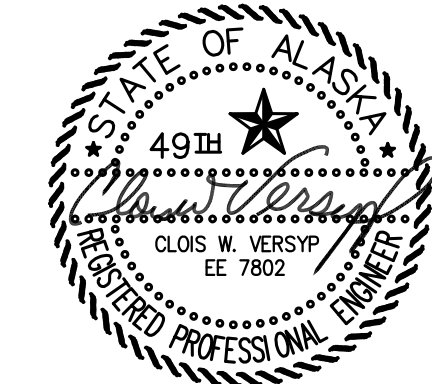

ALASKA ENERGY AUTHORITY		
PROJECT:	PORT HEIDEN RURAL POWER SYSTEM POWER PLANT UPGRADE	
TITLE:	DAY TANK CONTROL PANEL SEQUENCE OF OPERATION & DETAILS	
DRAWN BY: JTD	DESIGNED BY: BCG/CWV	SCALE: AS NOTED
FILE NAME: PTH PP E7	PROJECT NUMBER:	DATE: 1/14/19
P.O. 111405, Anchorage, AK 99511 (907)349-0100		E7.3 OF 7

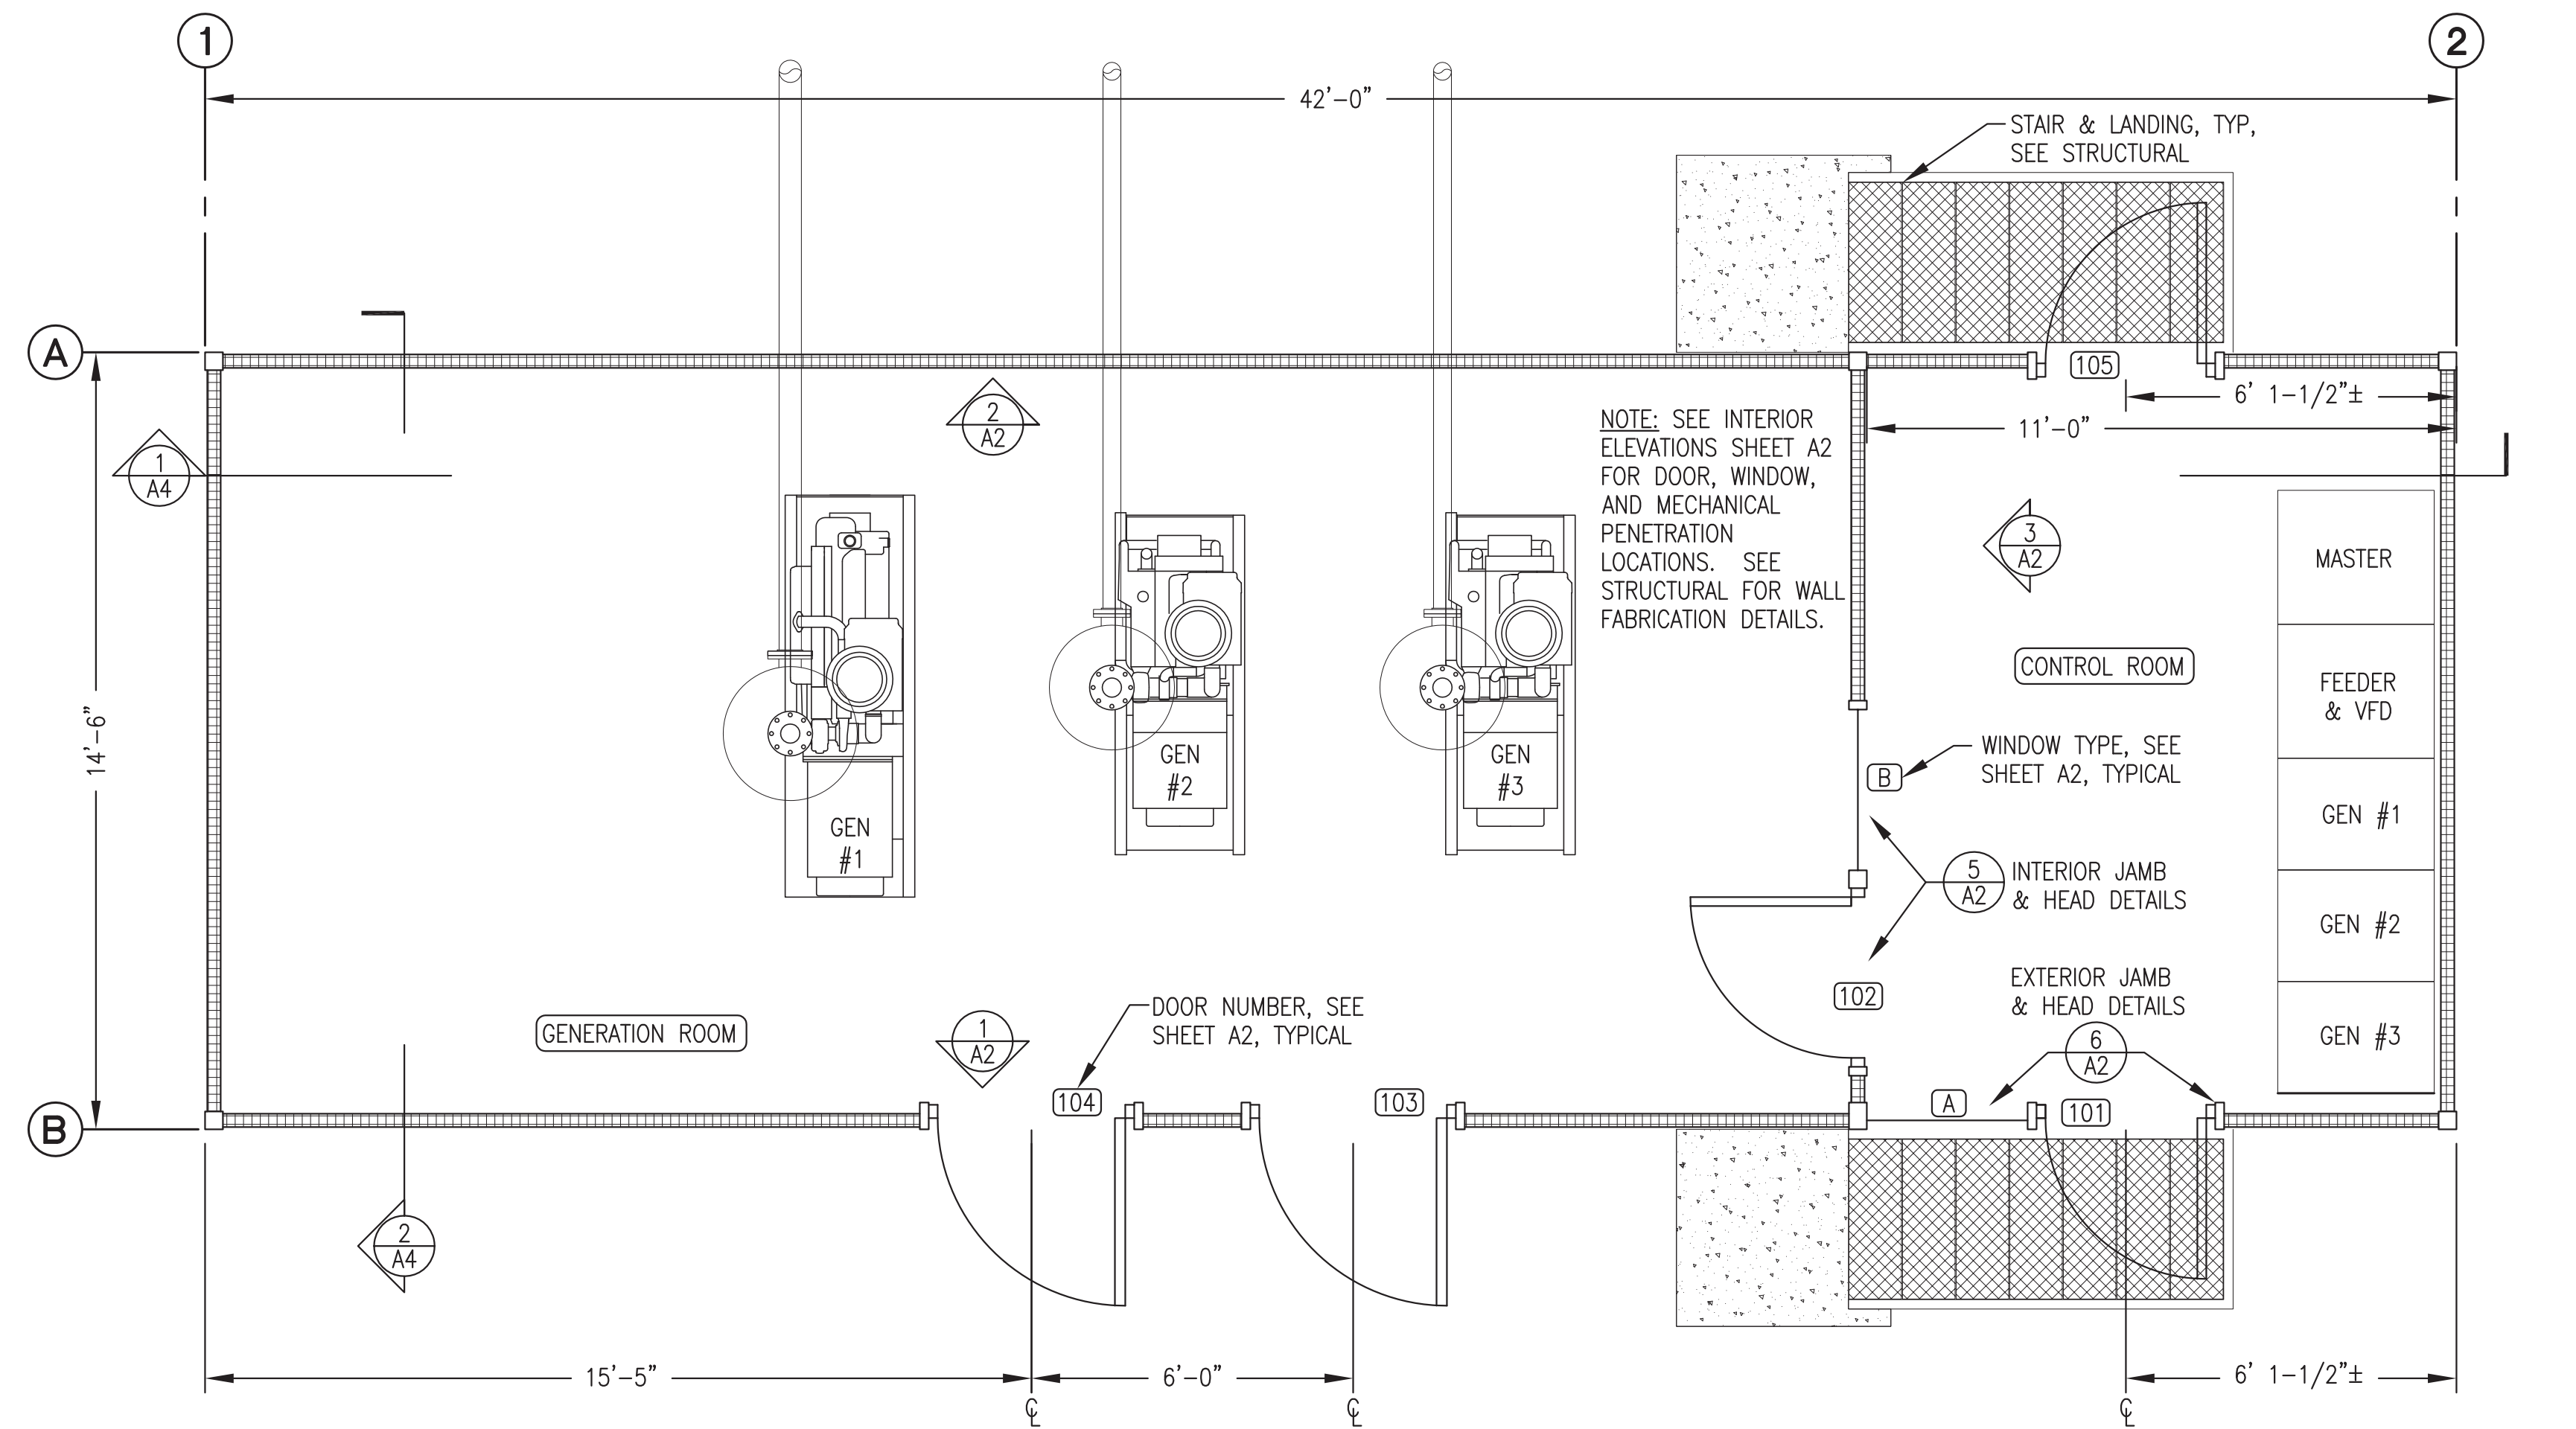

1 FLOOR PLAN
3/8"=1'-0"

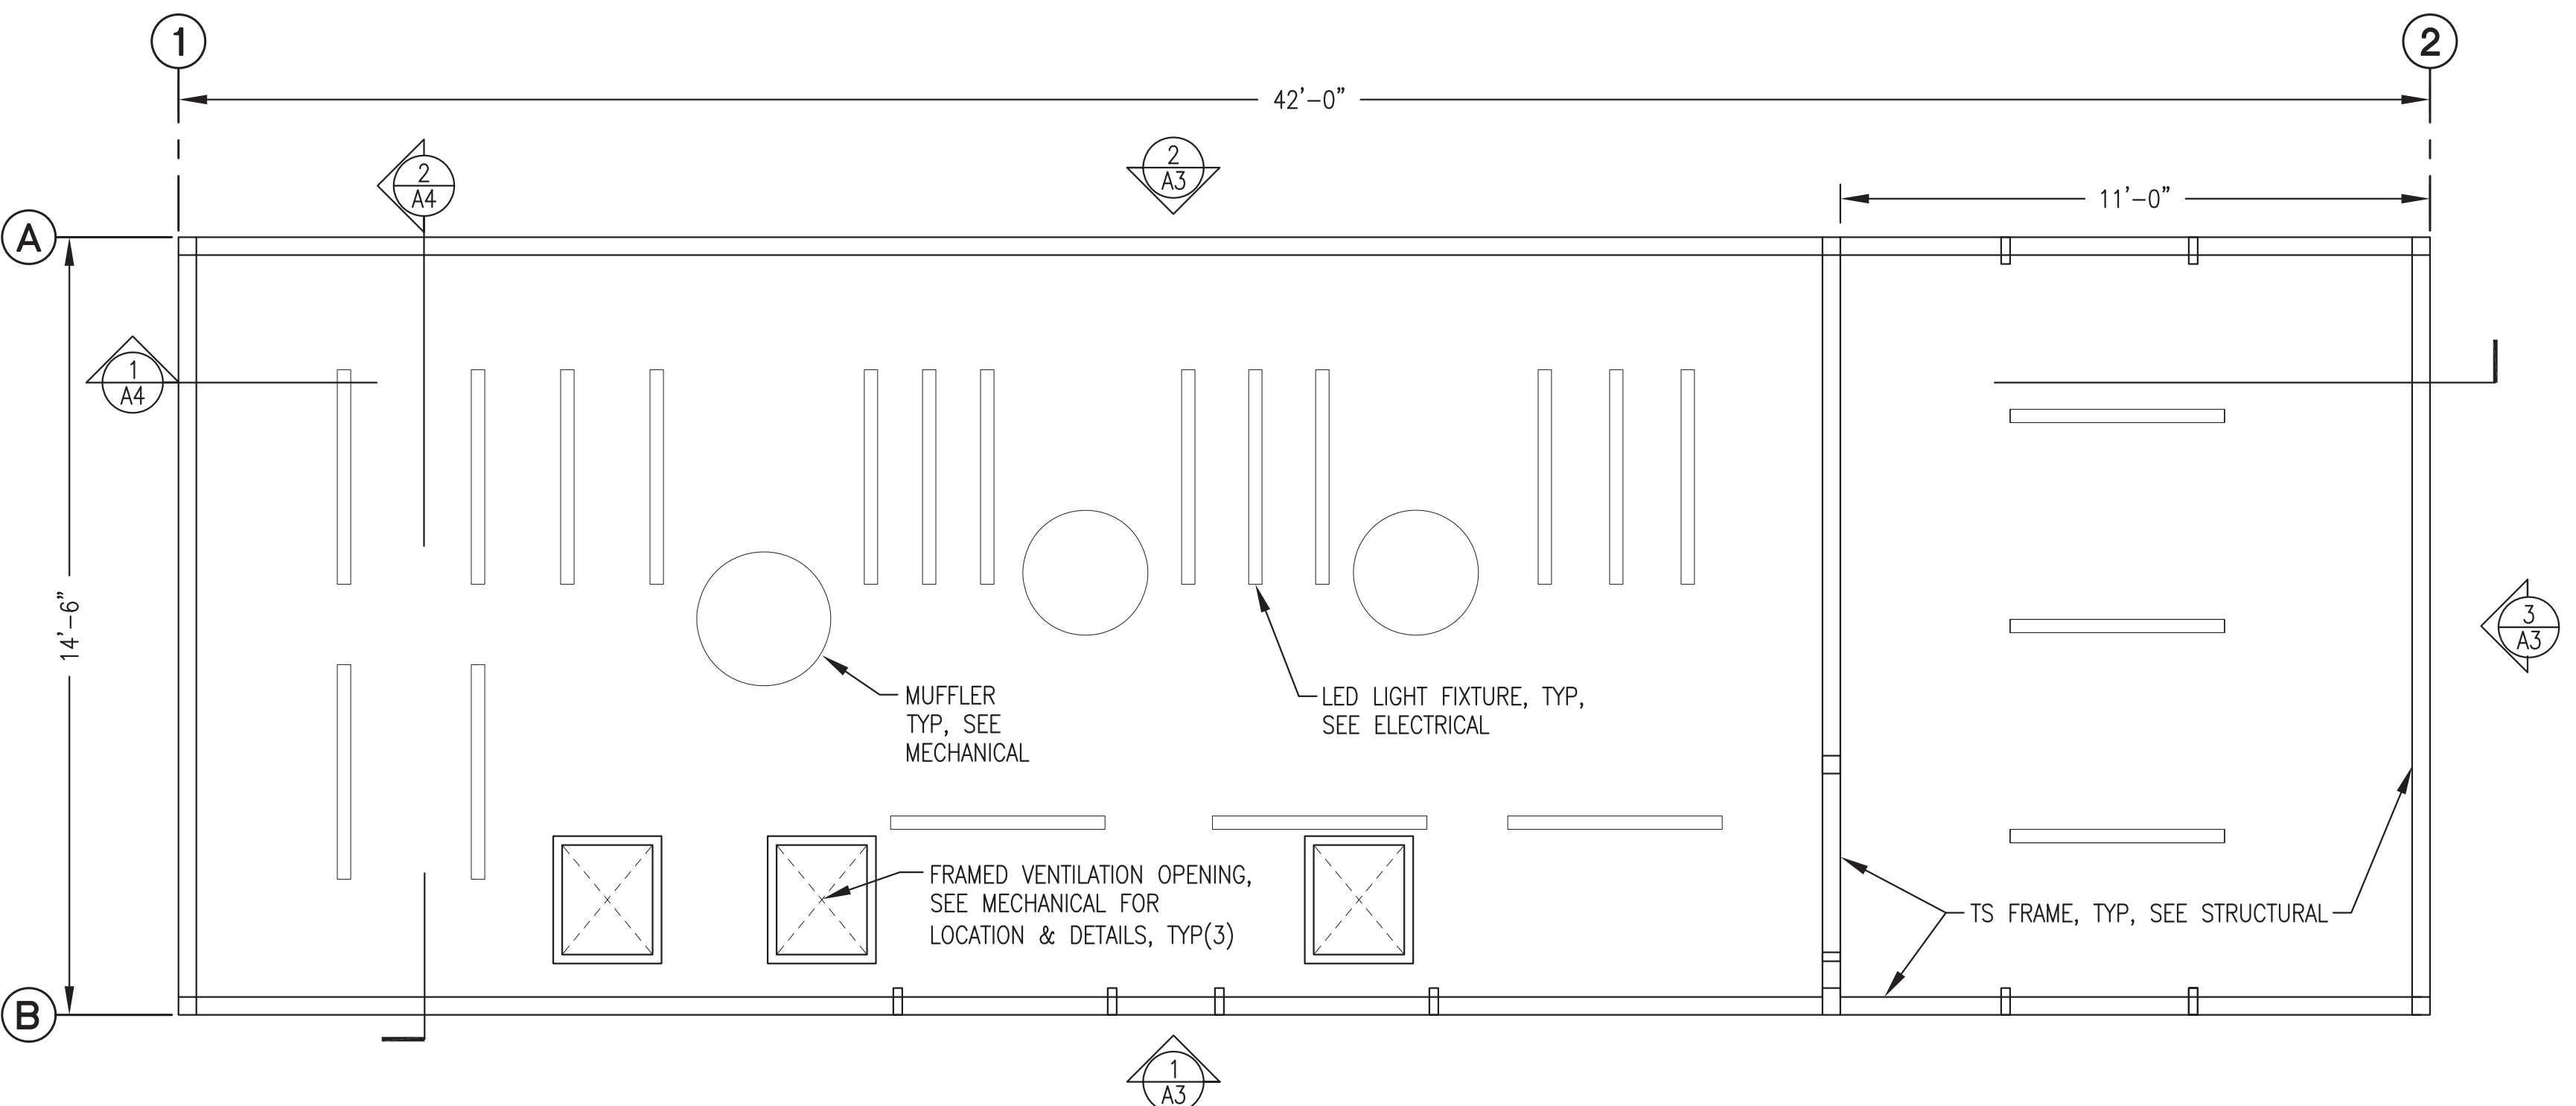

2 REFLECTED CEILING PLAN
3/8"=1'-0"

CODE ANALYSIS – 2012 EDITION INTERNATIONAL BUILDING CODE

OCCUPANCY CLASSIFICATION		REF: IBC-2012, SEC. 306.2
GROUP F-1: FACTORY INDUSTRIAL MODERATE HAZARD – ELECTRIC GENERATION PLANT		
TYPE OF CONSTRUCTION		REF: IBC-2012, TABLE 601
TYPE V-B (NON-RATED)		REF: IBC-2012, SEC. 602.5
BUILDING HEIGHTS AND AREAS		REF: IBC-2012, TABLE 503
ALLOWED	40'-0" 1 STORY 8,500 S.F.	PROVIDED: 17'-0" 1 STORY 610 S.F.
FIRE RESISTANCE RATING REQUIREMENTS FOR BUILDING ELEMENTS		REF: IBC-2012, TABLE 601
STRUCTURAL FRAME	0 HR	BEARING WALLS 0 HR
INTERIOR PARTITIONS	0 HR	FLOOR 0 HR
ROOF	0 HR	
FIRE RESISTANCE RATING REQUIREMENTS FOR EXTERIOR WALLS		REF: IBC-2012, TABLE 602
EXTERIOR WALLS	10' ≤ X ≤ 30'	0 HR
FIRE PROTECTION SYSTEM		REF: IBC-2012, SEC. 903.2.4
FIRE PROTECTION NOT REQUIRED. WATER MIST FIRE SUPPRESSION SYSTEM PROVIDED (SEE MECHANICAL).		
OCCUPANT LOAD		REF: IBC-2012, TABLE 1004.1.2
MECHANICAL/STORAGE	= 300 S.F./PERSON	610 S.F./300 S.F. PER OCCUPANT = 2 OCCUPANTS
MEANS OF EGRESS – TRAVEL DISTANCE		REF: IBC-2012, TABLE 1016.2
REQUIRED	200'	PROVIDED 20'

ARCHITECTURAL GENERAL NOTES:

- SEE CIVIL SITE PLAN FOR LOCATION AND LAYOUT. PROVIDE SEPARATION TO PROPERTY BOUNDARIES IN ACCORDANCE WITH CODE ANALYSIS.
- DO NOT BLOCK OR OBSTRUCT ACCESS, REQUIRED PARKING AREAS, OR REQUIRED EGRESS FROM NEIGHBORING FACILITIES. PROVIDE TEMPORARY BARRICADES OR OTHER FORMS OF PROTECTION TO PROTECT EMPLOYEES, RESIDENTS, AND VISITORS FROM INJURIES DURING CONSTRUCTION ACTIVITIES
- PROJECT MANAGER SHALL BE RESPONSIBLE FOR ALL BUILDING PERMITS, LETTERS OF NON-OBJECTION, UTILITY SERVICES AND APPLICATIONS AS REQUIRED. PROJECT MANAGER OR CONSTRUCTION MANAGER TO BE RESPONSIBLE FOR ALL REQUIRED SAFETY PRECAUTIONS, METHODS AND TECHNIQUES.
- PROVIDE A COMPLETE AND OPERATIONAL FACILITY. ALL WORK TO BE IN ACCORDANCE WITH CURRENT APPROVED EDITIONS OF THE IBC, IMC, IFC, AND NEC INCLUDING STATE OF ALASKA AMENDMENTS.
- SEE SHEETS A3 AND A4 FOR DESCRIPTION OF FIELD INSTALLED ROOF SYSTEM.
- INSULATE ALL WALLS, FLOORS, AND CEILINGS WITH HIGH TEMPERATURE MINERAL FIBER ACOUSTICAL FIRE BATT INSULATION, MIN R VALUE 4 PER INCH, MIN 2000F MELTING TEMP. ROXUL AFB OR EQUAL. FILL ALL PANEL VOIDS OR PROVIDE THICKNESS AS INDICATED ON DRAWINGS. MECHANICALLY FASTEN FLOOR INSULATION TIGHT TO FLOOR.
- UPON COMPLETION OF FABRICATION ROUND ALL CORNERS AND GRIND EDGES SMOOTH AND PAINT ALL INTERIOR AND EXTERIOR EXPOSED STEEL. PERFORM ALL PAINTING IN A WARM DRY ENVIRONMENT IN ACCORDANCE WITH MANUFACTURER'S INSTRUCTIONS INCLUDING DRYING TIME TO RE-COAT.
- SANDBLAST EXTERIOR SURFACE TO SSPC-SP-10. PRIME WITH ONE COAT OF REINFORCED INORGANIC ZINC PRIMER, DEVOE CATHA-COAT 302, NO SUBSTITUTES, COLOR GREEN, TO 3 MILS DRY FILM THICKNESS. COVER WITH TWO COATS OF EPOXY, DEVOE BAR-RUST 236, NO SUBSTITUTES, TO 12 MILS DRY FILM THICKNESS. FIRST COAT COLOR GRAY, SECOND COAT COLOR WHITE.
- FINISH EXTERIOR WALLS AND SKIDS (ALL EXPOSED VERTICAL EXTERIOR SURFACES) WITH ONE COAT OF ALIPHATIC URETHANE ENAMEL, DEVOE DEVTHANE 389, NO SUBSTITUTES, COLOR WHITE, TO 3 MILS DRY FILM THICKNESS.
- SANDBLAST INTERIOR SURFACE TO SSPC-SP-6. PRIME AND FINISH WITH TWO COATS OF EPOXY, SHERWIN WILLIAMS MACROPOXY 646, NO SUBSTITUTES, TO 8 MILS TOTAL DRY FILM THICKNESS. CEILING COLOR WHITE. WALL AND FLOOR COLOR STRUCTURAL GRAY 4031. NOTE THAT FIRST COAT ON WALLS AND FLOOR MAY BE WHITE.

NOTE: THIS DRAWING INCLUDES DETAILS THAT ARE NOT PART OF THE MODULE ASSEMBLY SCOPE AND IS PROVIDED STRICTLY FOR IDENTIFYING LOCATIONS, INSTALLATION DETAILS, AND SPECIFICATIONS FOR DOORS AND WINDOWS.

ISSUED FOR CONSTRUCTION
OCTOBER 2018





ALASKA ENERGY AUTHORITY

PROJECT:	PORT HEIDEN RURAL POWER SYSTEM POWER PLANT UPGRADE	
TITLE:	FLOOR PLAN, REFLECTED CEILING PLAN, CODE ANALYSIS, & GENERAL NOTES	
DRAWN BY:	JTD	SCALE: AS NOTED
DESIGNED BY:	BCG/DGT	DATE: 10/16/18
FILE NAME:	PTH PPU A1-4	SHEET: A1 OF 4
PROJECT NUMBER:		

Gray Stassel Engineering, Inc.
P.O. 111405, Anchorage, AK 99511 (907)349-0100


NOTE: THIS DRAWING INCLUDES DETAILS THAT ARE NOT PART OF THE MODULE ASSEMBLY SCOPE AND IS PROVIDED STRICTLY FOR IDENTIFYING LOCATIONS, INSTALLATION DETAILS, AND SPECIFICATIONS FOR DOORS AND WINDOWS.

NOTE: SEE MECHANICAL FOR LOCATIONS, QUANTITY, AND DETAILS OF ALL MECHANICAL WALL PENETRATIONS.

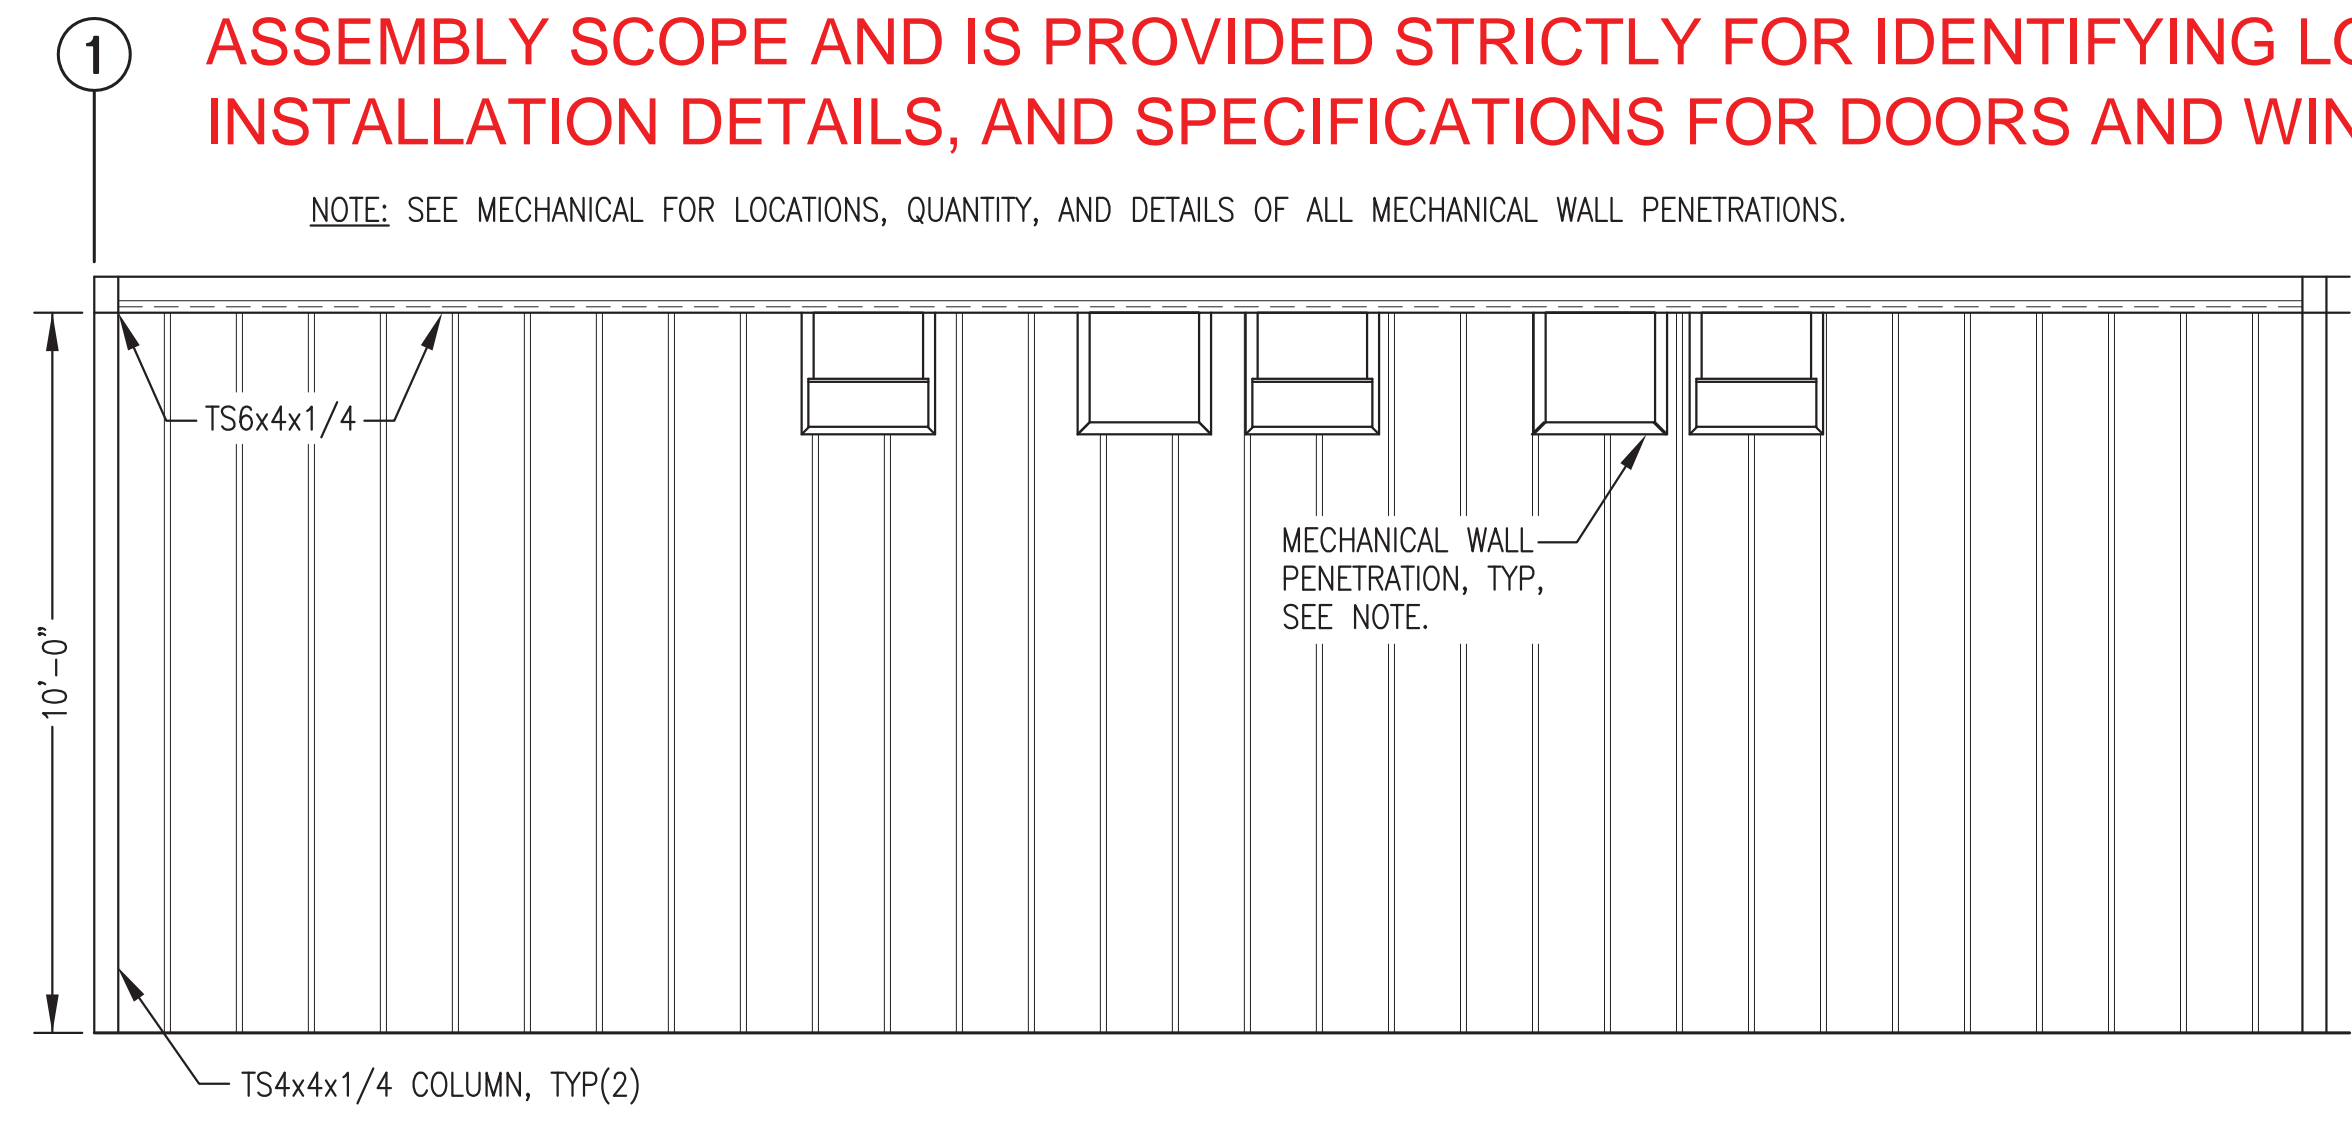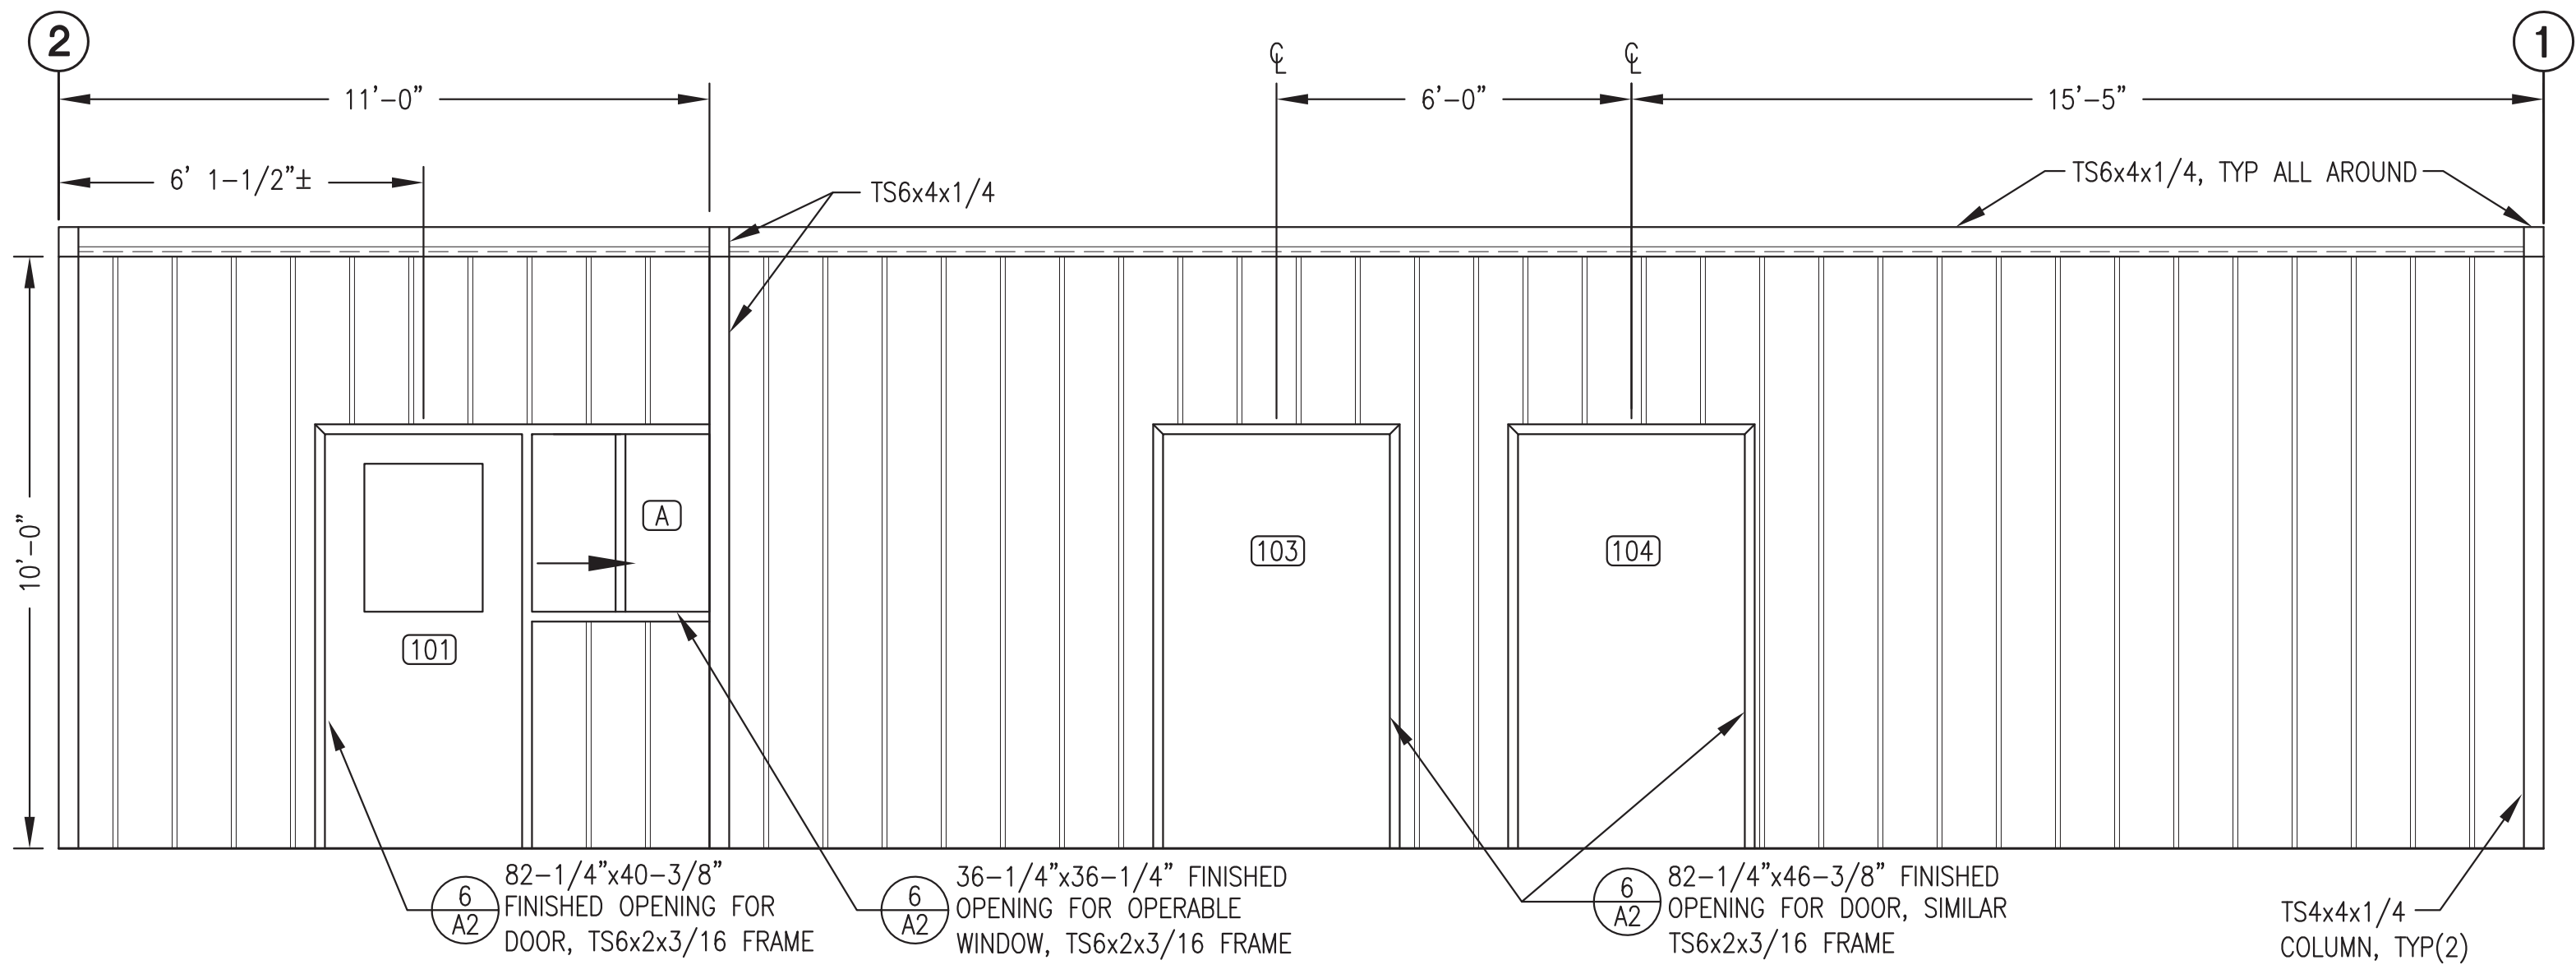


1 FRONT WALL INTERIOR ELEVATION
A2 3/8"=1'-0"

2 PARTIAL GENERATOR ROOM BACK WALL INTERIOR ELEVATION
A2 3/8"=1'-0"

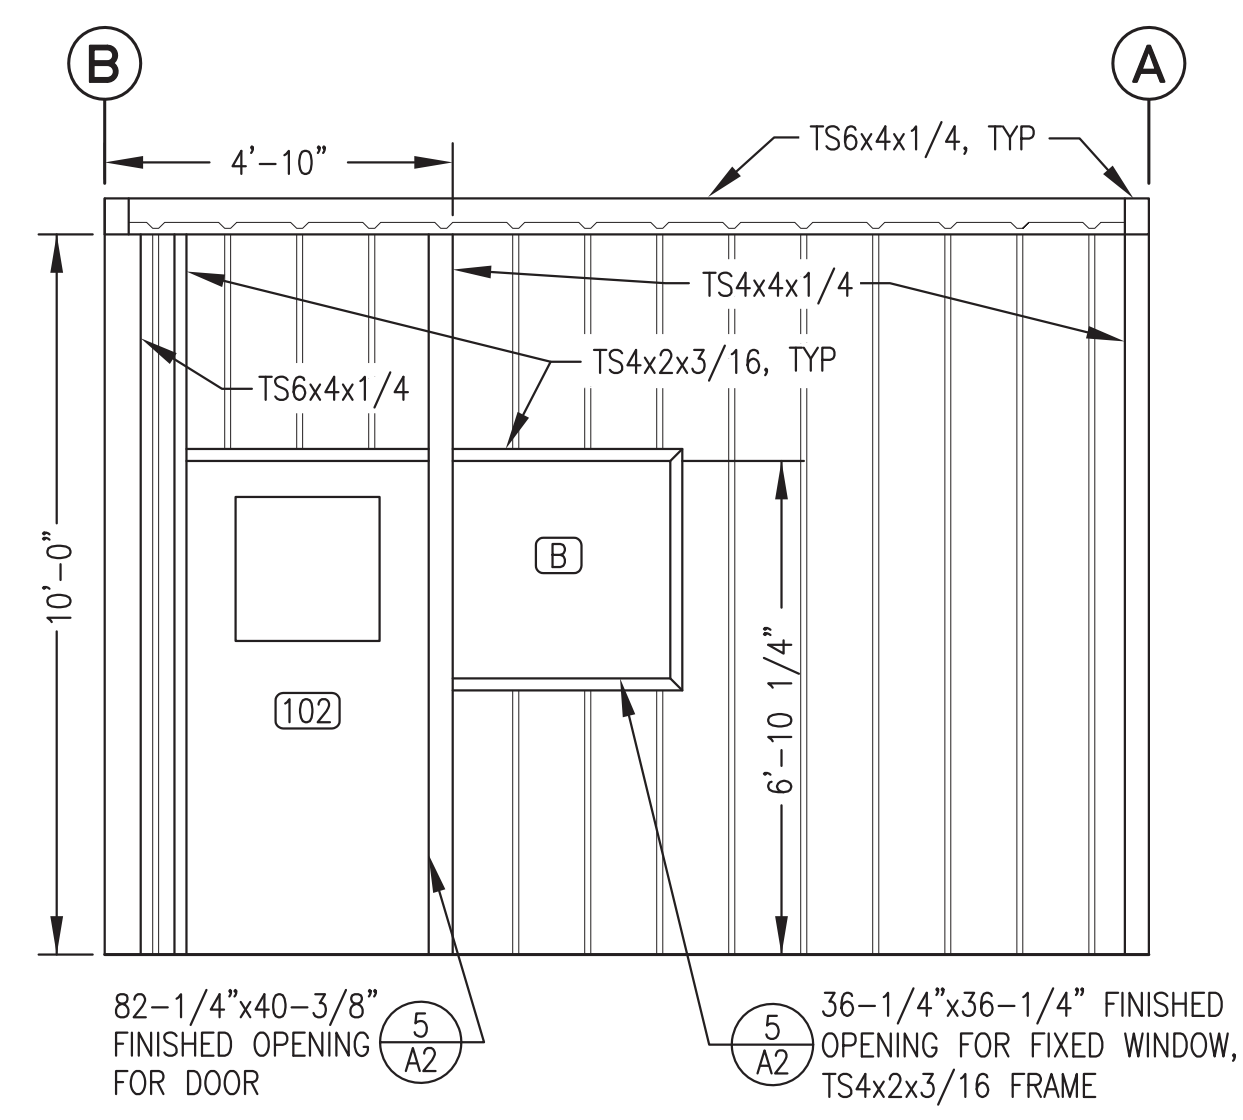

FRAMED OPENING NOTES:

- FABRICATE FRAMED OPENINGS FOR DOORS, WINDOWS, ETC, WITH MITERED CORNERS AND FULL PENETRATION GROOVE WELDS. GRIND OUT INSIDE OF MITERED CORNERS TO PROVIDE FULL CLEAR OPENING.
- FABRICATE TO FINISHED INSIDE (CLEAR) DIMENSIONS INDICATED AND LOCATE TO INSIDE EDGE OR CENTERLINE AS INDICATED.

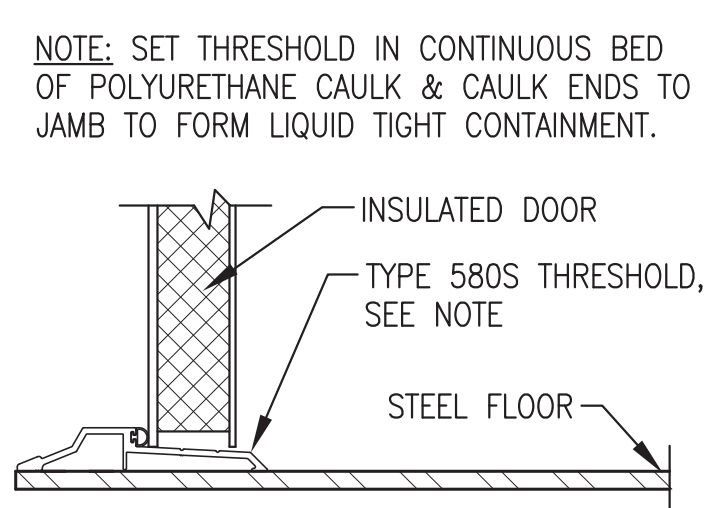

4 TYPICAL DOOR THRESHOLD
A2 NO SCALE


DOOR CONSTRUCTION						FRAME CONSTRUCTION							
DOOR NO.	WIDTH	HEIGHT	THICK NESS	MATERIAL	CORE	REMARKS	WALL THICK.	MATERIAL	TYPE	PROFILE	PREP.	FIRE RATING	HDWR. GROUP
101	3'-0"	6'-8"	1-3/4"	16 GA. H.M.	POLYURETHANE	24"x24" RE-LIGHT {4}	N/A	16 GA. H.M.	WELDED	SINGLE RABBETED	DIMPLE & PUNCH	NONE	HW-1
102	3'-0"	6'-8"	1-3/4"	16 GA. H.M.	POLYURETHANE	24"x24" RE-LIGHT {4}	N/A	16 GA. H.M.	WELDED	SINGLE RABBETED	DIMPLE & PUNCH	NONE	HW-2
103	3'-6"	6'-8"	1-3/4"	16 GA. H.M.	POLYURETHANE		N/A	16 GA. H.M.	WELDED	SINGLE RABBETED	DIMPLE & PUNCH	NONE	HW-3
104	3'-6"	6'-8"	1-3/4"	16 GA. H.M.	POLYURETHANE		N/A	16 GA. H.M.	WELDED	SINGLE RABBETED	DIMPLE & PUNCH	NONE	HW-3
105	3'-0"	6'-8"	1-3/4"	16 GA. H.M.	POLYURETHANE	24"x24" RE-LIGHT {4}	N/A	16 GA. H.M.	WELDED	SINGLE RABBETED	DIMPLE & PUNCH	NONE	HW-1

DOOR HARDWARE:				DOOR FRAME PROFILE:			
HW-1	3 EA	HINGES	HAGER BB1191 4.5 x 4.5NRP x 630	HW-3	3 EA	HINGES	HAGER BB1191 4.5 x 4.5NRP x 630
	1 EA	EXIT DEVICE	PRECISION 2108 x 4908AX3 x 630		1 EA	EXIT LOCK	SCHLAGE ND25D x RHODES x 626
	1 EA	CORE	BEST BROWN CONSTRUCTION CORE		1 EA	OVERHEAD STOP	ROCKWOOD OH1004M x US32D
	1 EA	DOOR CLOSER	LCN 4040 x CUSH x 689		1 EA	WEATHER STRIP	PEMCO 2891AS x 42 (HEAD)
	1 EA	KICK PLATE	ROCKWOOD K1050 10 x 34 x 630		2 EA	WEATHER STRIP	PEMCO 290AS x 80 (SIDE JAMBS)
	1 EA	WEATHER STRIP	PEMCO 2891AS x 36 (HEAD)		1 EA	THRESHOLD	HAGER 580S x 42
	2 EA	WEATHER STRIP	PEMCO 290AS x 80 (SIDE JAMBS)				
	1 EA	THRESHOLD	HAGER 580S x 36				
HW-2	3 EA	HINGES	HAGER BB1191 4.5 x 4.5 x 630				
	1 EA	EXIT DEVICE	PRECISION 2108 x 4908AX3 x 630				
	1 EA	DOOR CLOSER	LCN 4040 x CUSH x 689				
	1 EA	KICK PLATE	ROCKWOOD K1050 10 x 34 x 630				
	1 EA	MOP PLATE	ROCKWOOD K1050 10 x 35 x 630				
	1 EA	SOUND SEAL	PEMCO 2891AS x 36 (HEAD)				
	2 EA	SOUND SEAL	PEMCO 290AS x 80 (SIDE JAMBS)				
	1 EA	THRESHOLD	HAGER 580S x 36				


NOTES:

- DOORS AND HOLLOW METAL FRAMES GALVANIZED AND FACTORY PRIMED. ALL FRAMES WELDED CONSTRUCTION, DIMPLED AND PUNCHED.
- DOORS TO HAVE SOLID POLYURETHANE INSULATION CORE WITH TOPS INVERTED AND CAULKED WATER TIGHT.
- FINISH ALL DOORS AND HOLLOW METAL FRAMES WITH TWO COATS OF SHERWIN WILLIAMS MACROPOXY 646, NO SUBSTITUTES, COLOR STRUCTURAL GRAY 4031.
- INSTALL INSULATED RE-LIGHT WITH TWO PANES OF 1/4" LAMINATED SAFETY GLASS WITH 1/2" AIR GAP IN EACH DOOR PANEL, 24"x24" OR 24"x18" AS INDICATED.

3 CONTROL ROOM WALL INTERIOR ELEVATION
A2 3/8"=1'-0"

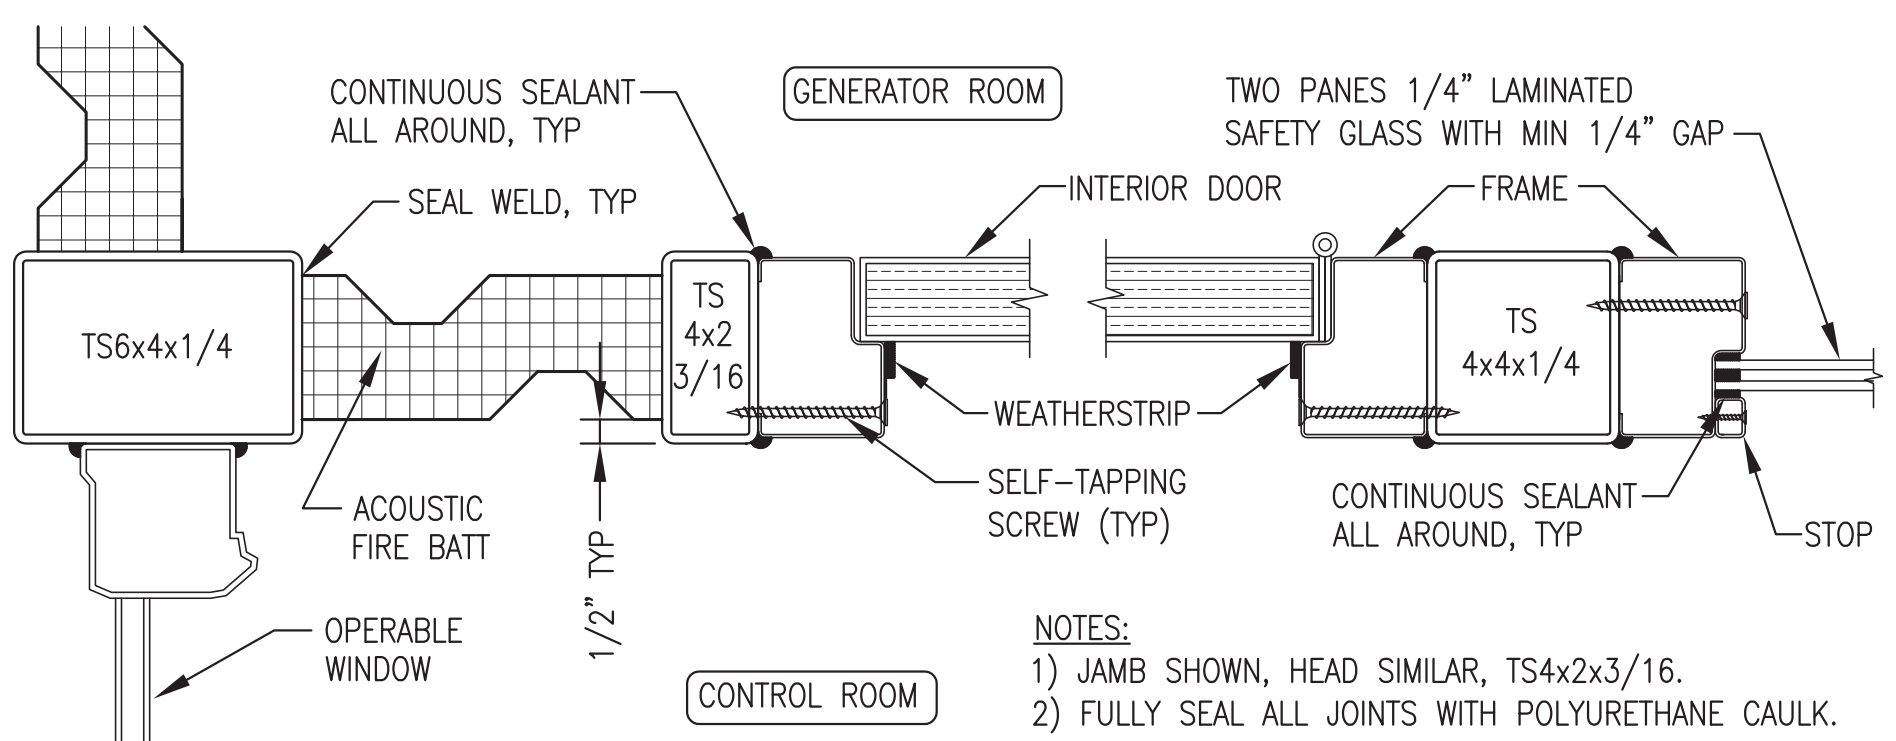

5 INTERIOR DOOR AND WINDOW JAMB/HEAD
A2 3/8"=1'-0"

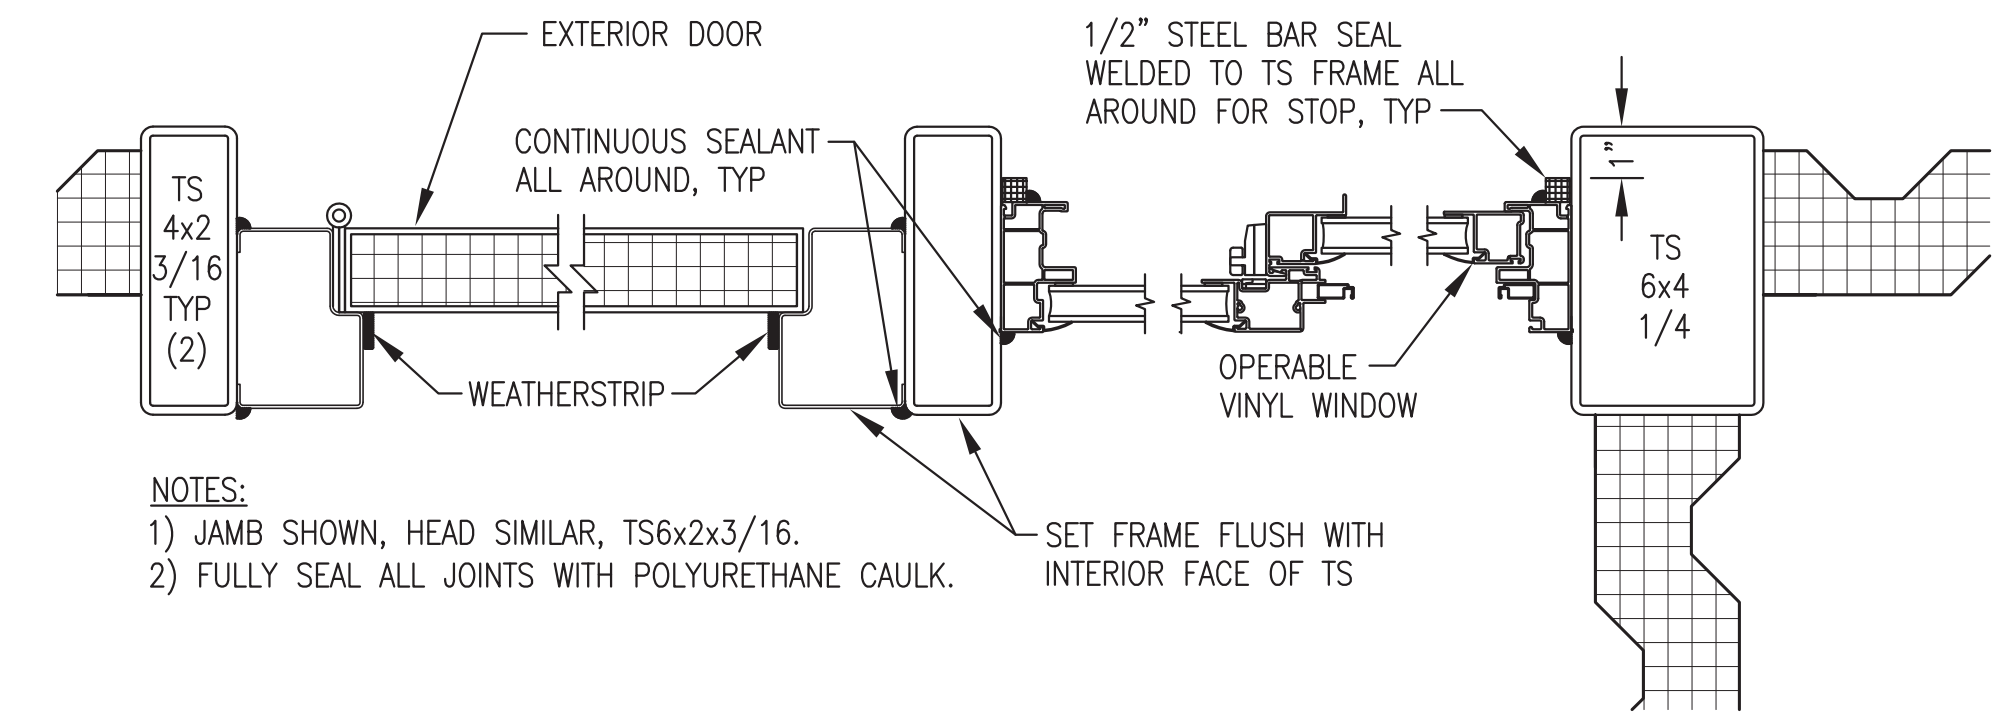

6 TYPICAL EXTERIOR DOOR AND WINDOW JAMB/HEAD
A2 3/8"=1'-0"

ISSUED FOR CONSTRUCTION
OCTOBER 2018



ALASKA ENERGY AUTHORITY

PROJECT: **PORT HEIDEN RURAL POWER SYSTEM POWER PLANT UPGRADE**


TITLE: **INTERIOR ELEVATIONS & DOOR/WINDOW DETAILS**

Gray Stassel Engineering, Inc.
P.O. 111405, Anchorage, AK 99511 (907)349-0100


DRAWN BY: JTD
DESIGNED BY: BCG/DGT
FILE NAME: PTH PPU A1-4
PROJECT NUMBER:

SCALE: AS NOTED
DATE: 10/16/18
SHEET: **A2** OF 4


Structural Detailing Services of Alaska 907-336-2220 Fax: 907-336-2231 dtholland@pci.net

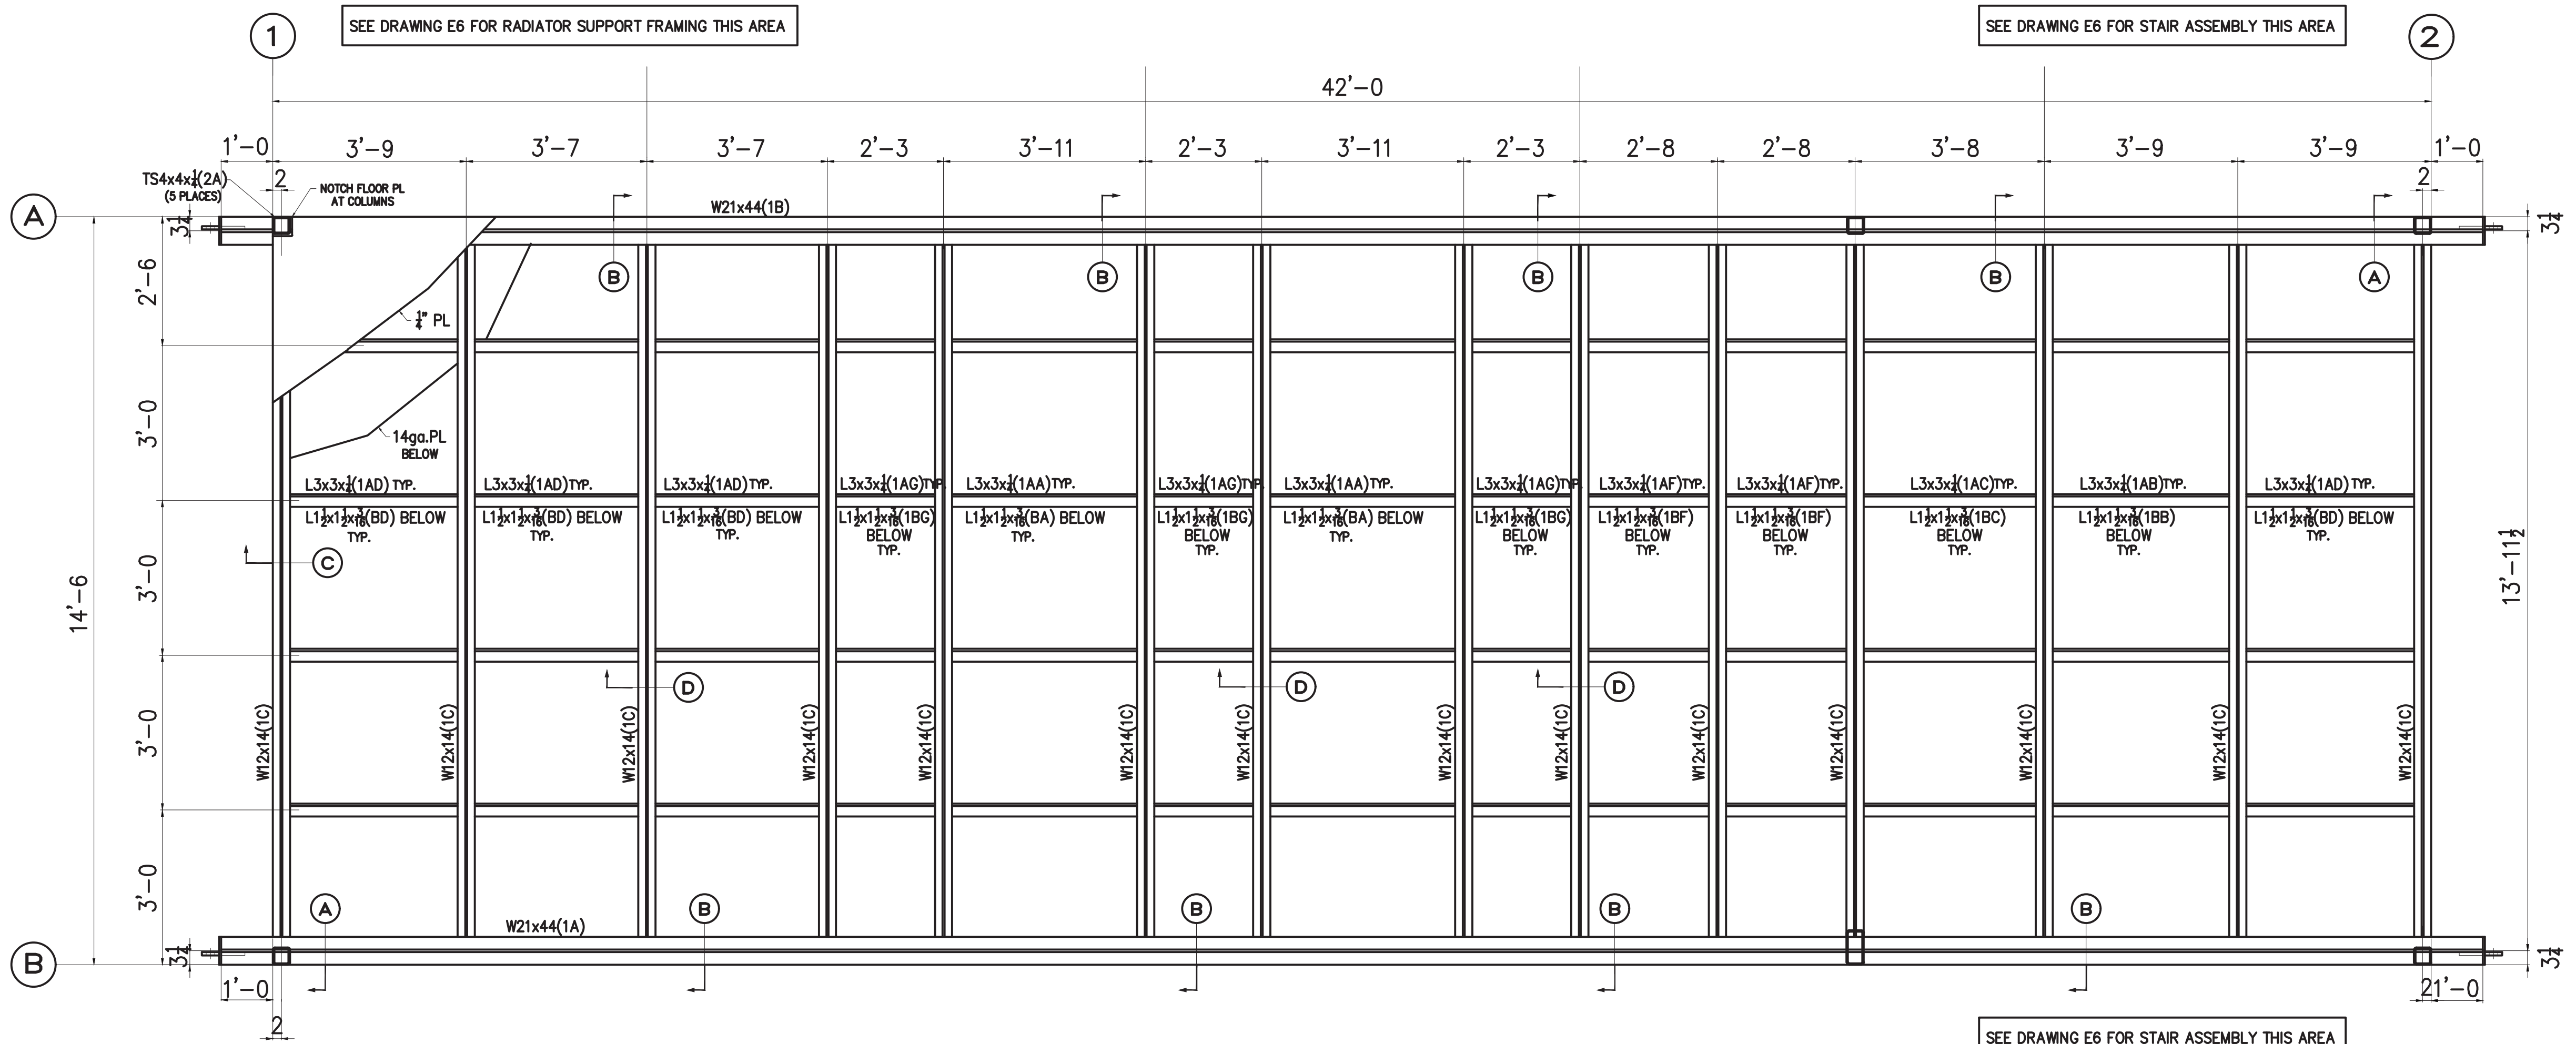


BASE FRAMING PLAN

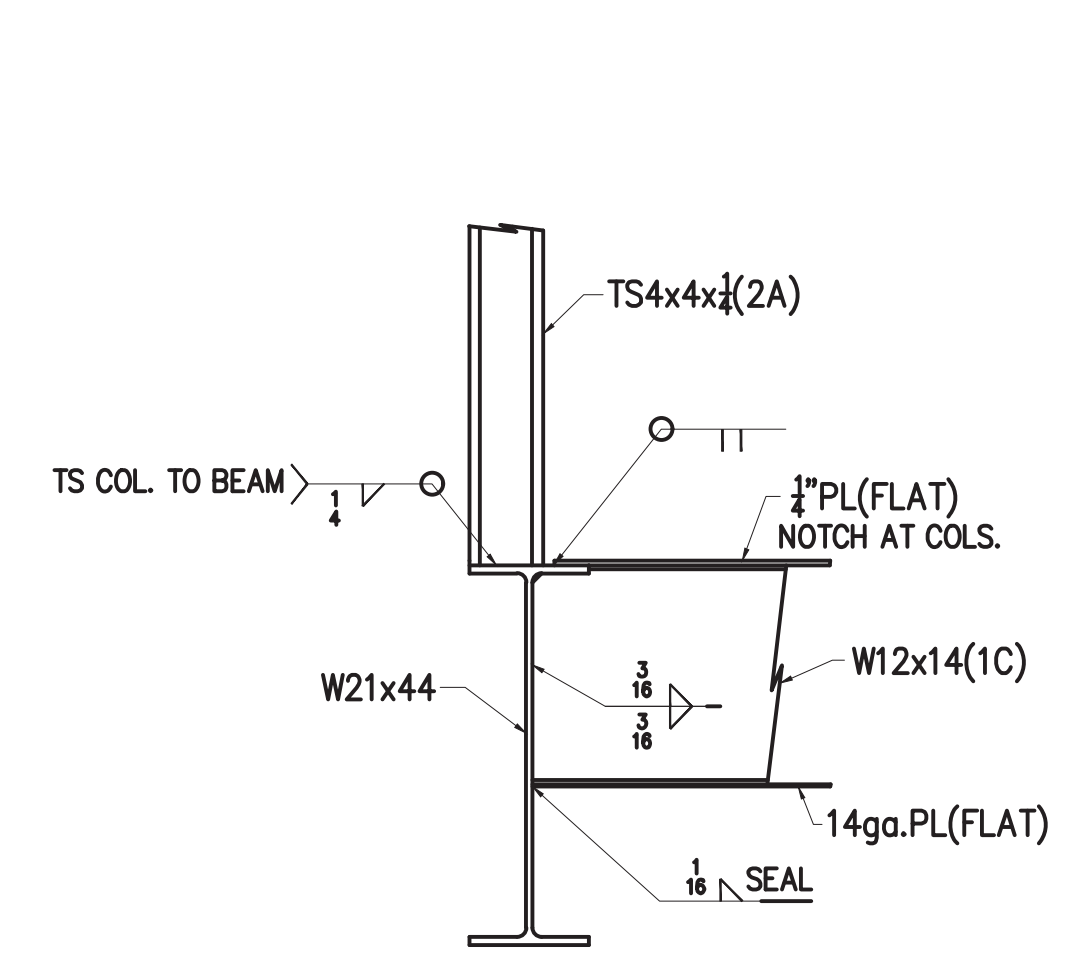


SECTION A

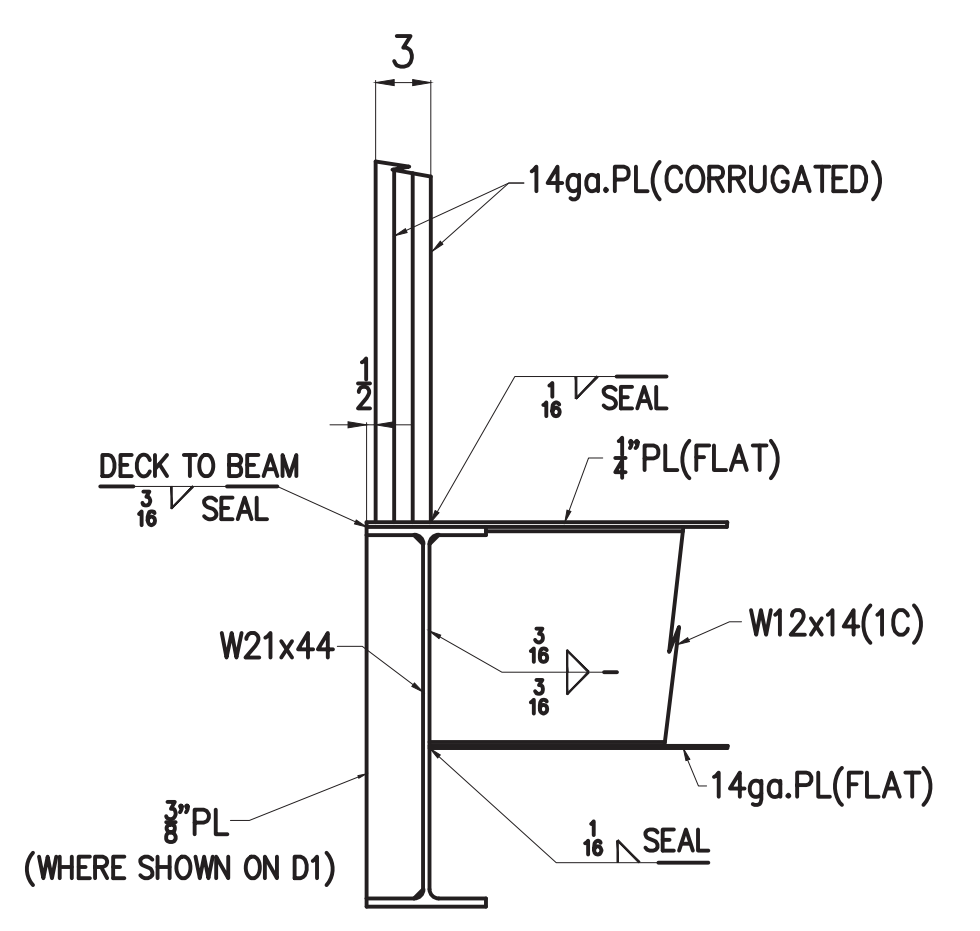

SECTION B

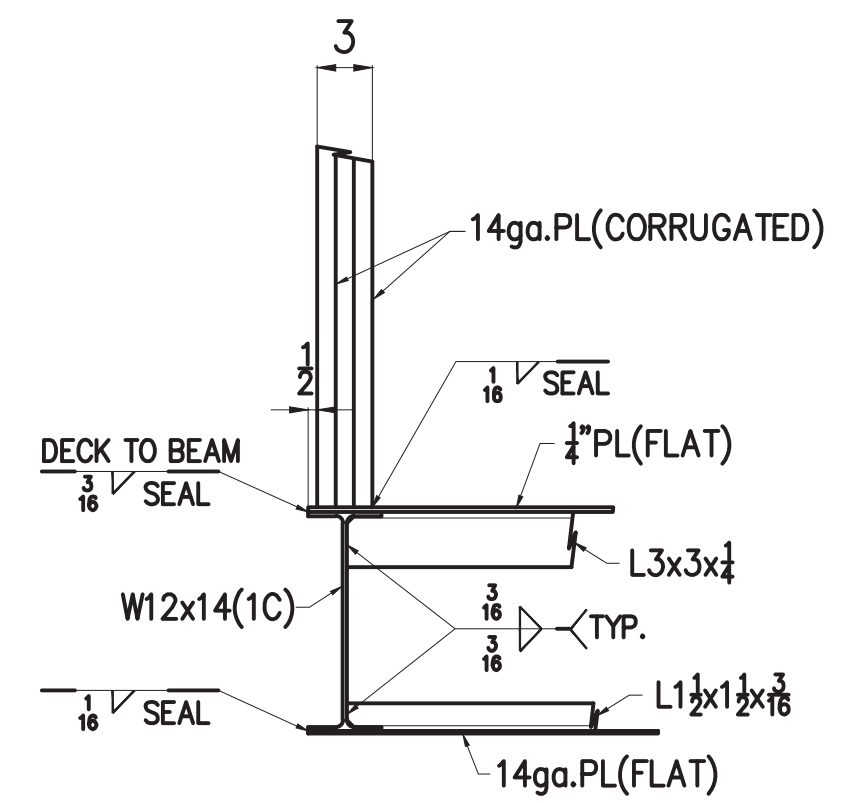

SECTION C

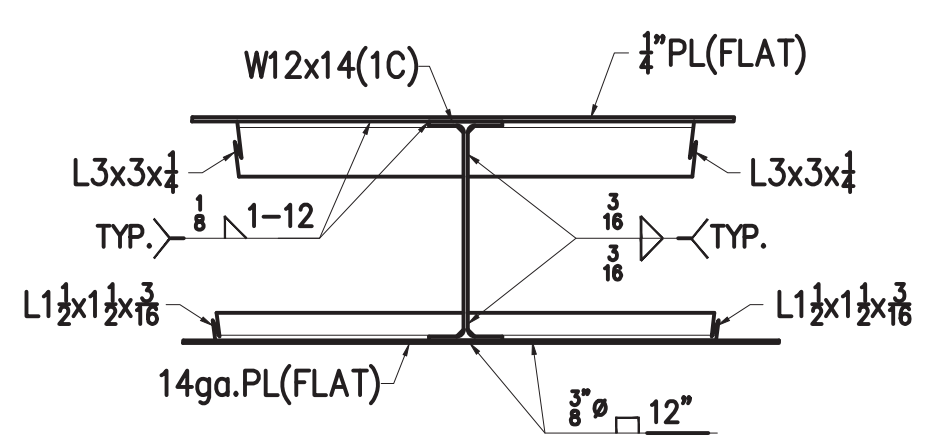

SECTION D

APPROVED
 APPROVED WITH CORRECTIONS NOTED
 REJECTED
 REVISE AND RESUBMIT
 SUBMIT SPECIFIED ITEM

Submittal review is only for ascertaining general performance with the Contract Documents. Approval does not relieve the Contractor of responsibility for full compliance with the Contract Documents.

By: *[Signature]* Date: **1-7-19**
 PO Box 111405
 Anchorage, AK
 P (907) 349-0100
 F (907) 349-8001

Gray Stassel Engineering, Inc.


REV. No.	DATE	BY	DESCRIPTION
1	1/4/19	DWH	REVISED SEC. A & B
0	12/28/18	DWH	ISSUED FOR APPROVAL

WEONA CORPORATION


10501 OLIVE LANE
ANCHORAGE, AK 99515

PHONE: (907) 344-1921
FAX: (907) 344-8244


CLEANING PAINT	BLAST & PAINT PER SPECS.	PROJECT	CLARKS POINT POWER SYSTEM UPGRADE	
WELDS	3/16" FILLET U.N.O.	CUSTOMER	ALASKA ENERGY AUTHORITY	
OPEN HOLES	13/16" U.N.O.	DATE	JOB No.	DWG. NO.
		12/22/18		E1

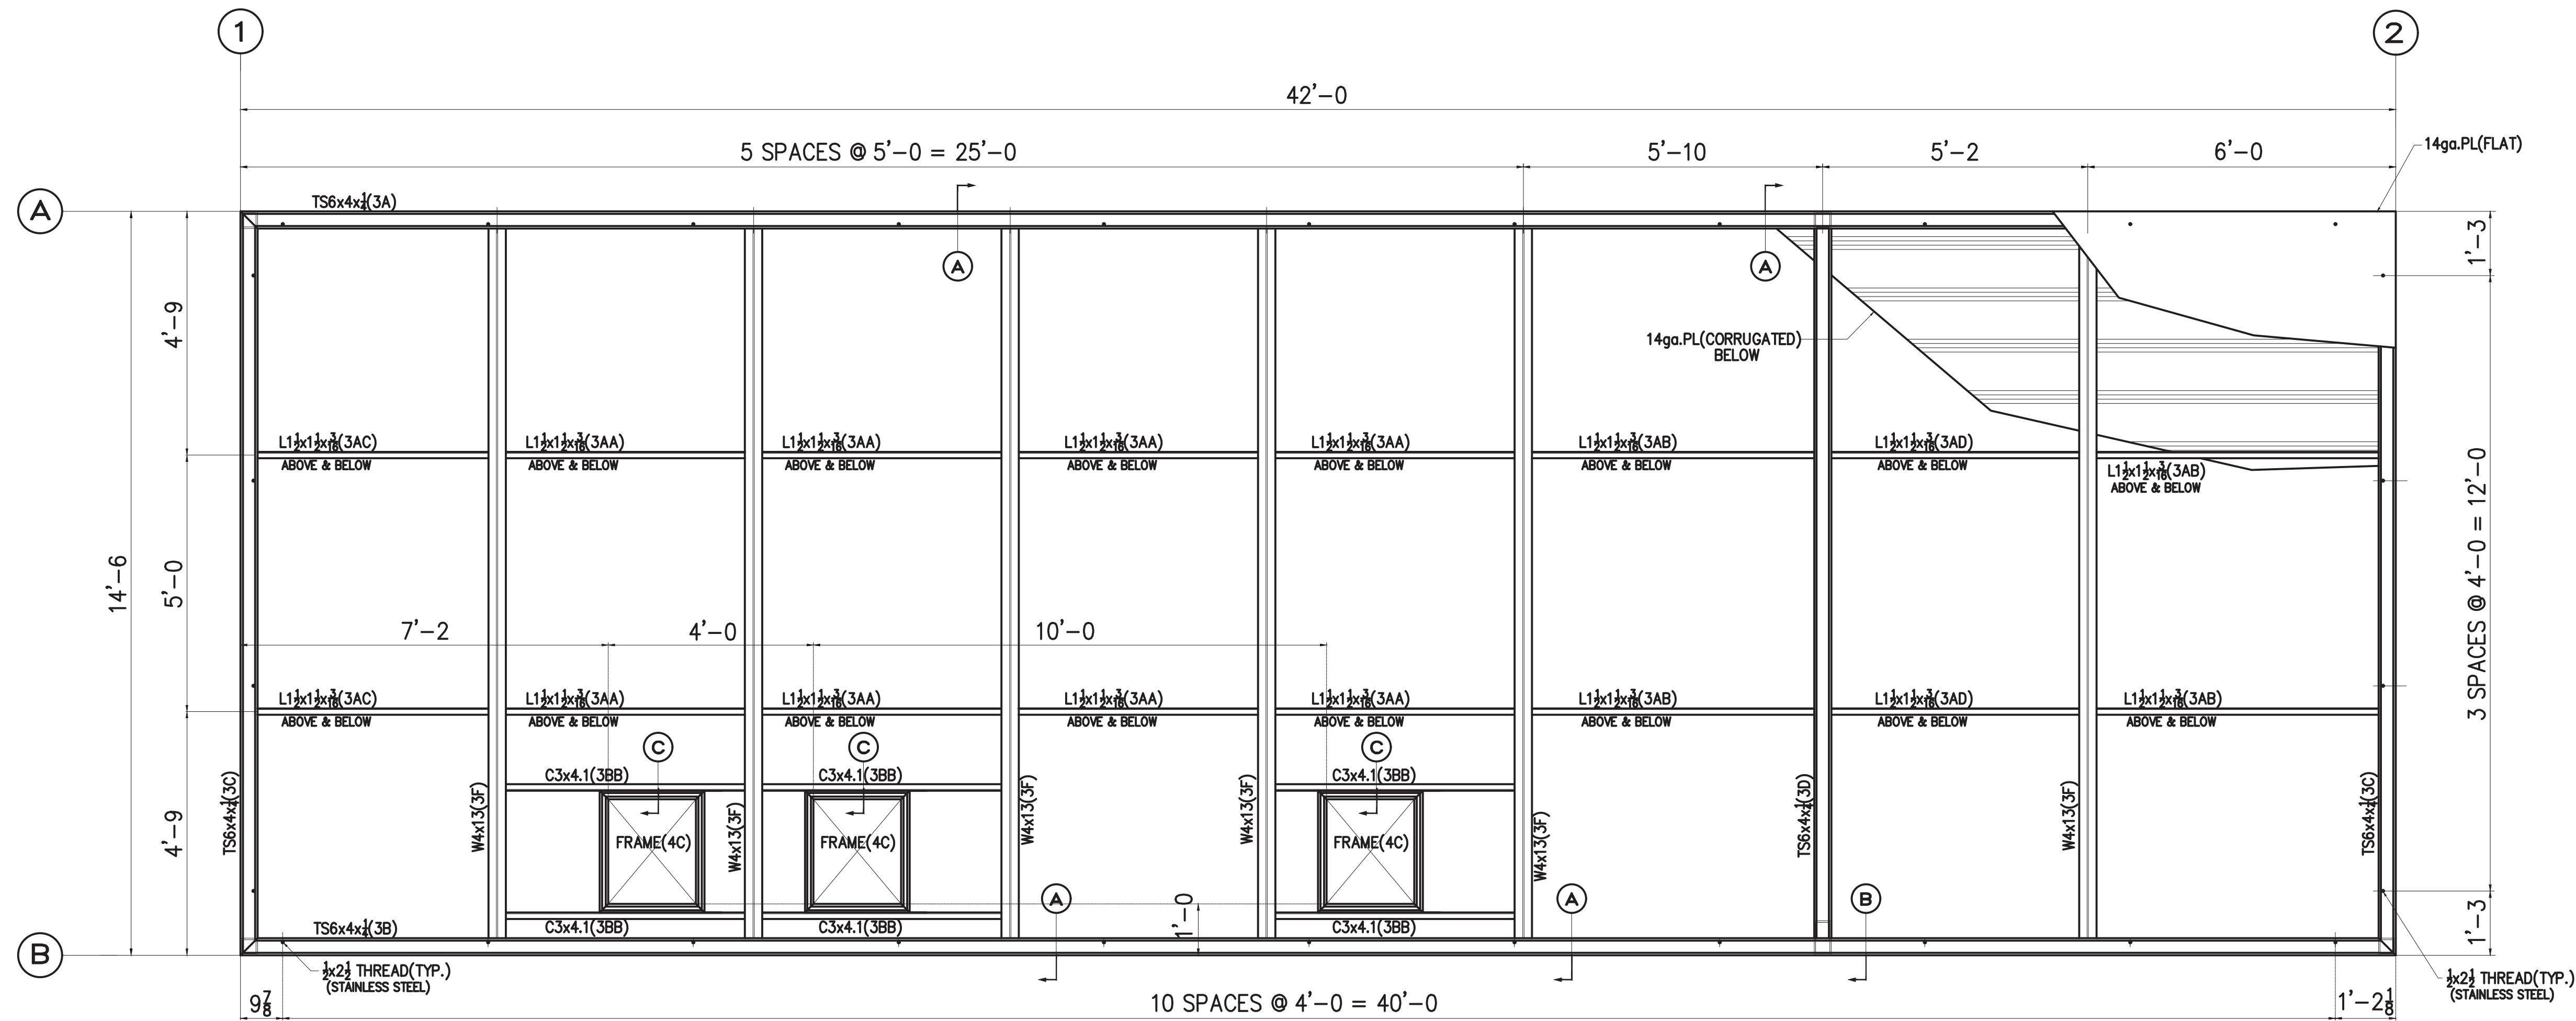


CEILING FRAMING PLAN

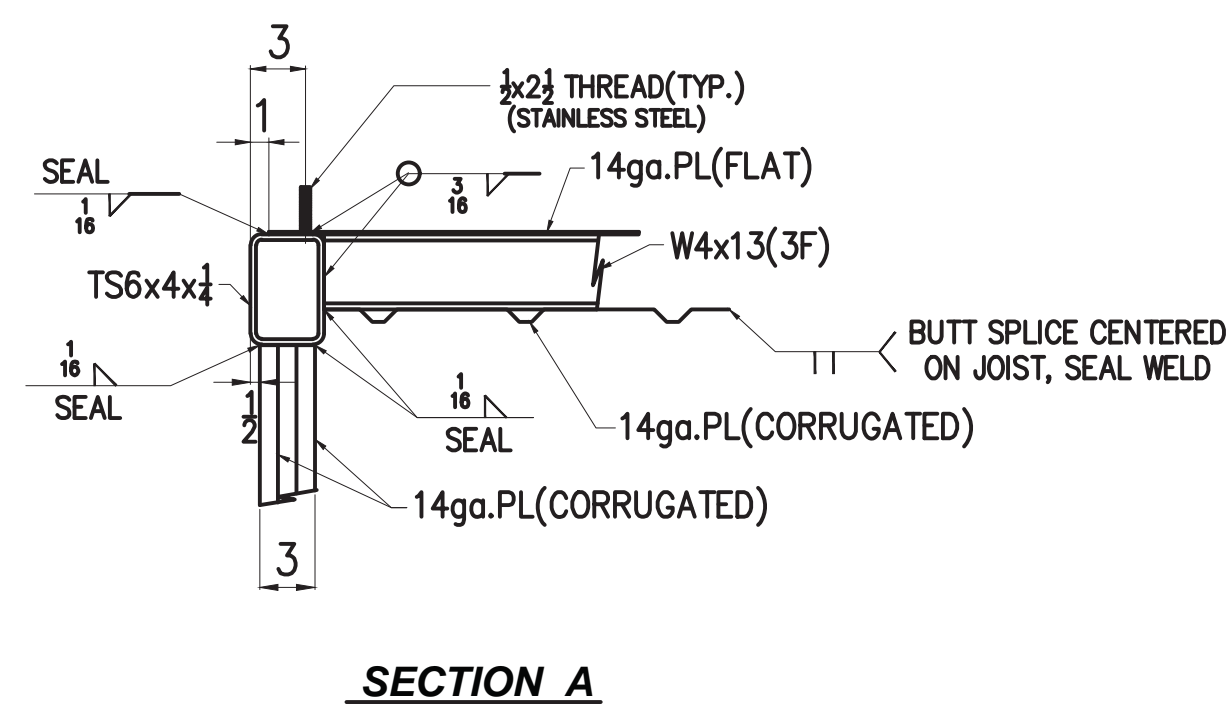

SECTION A

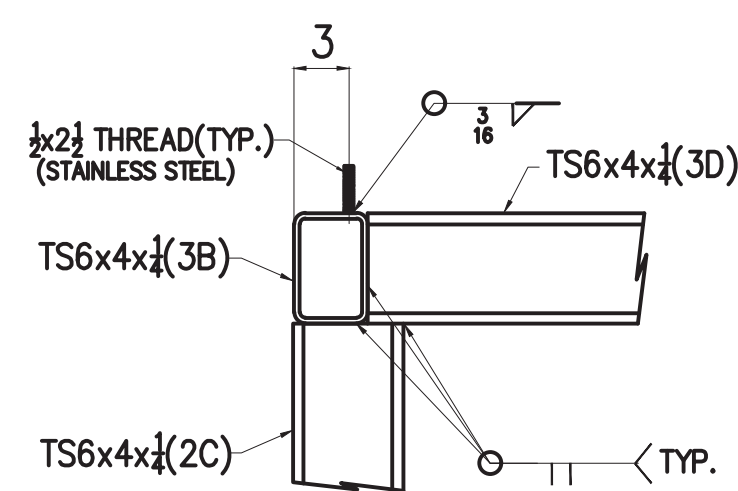

SECTION B

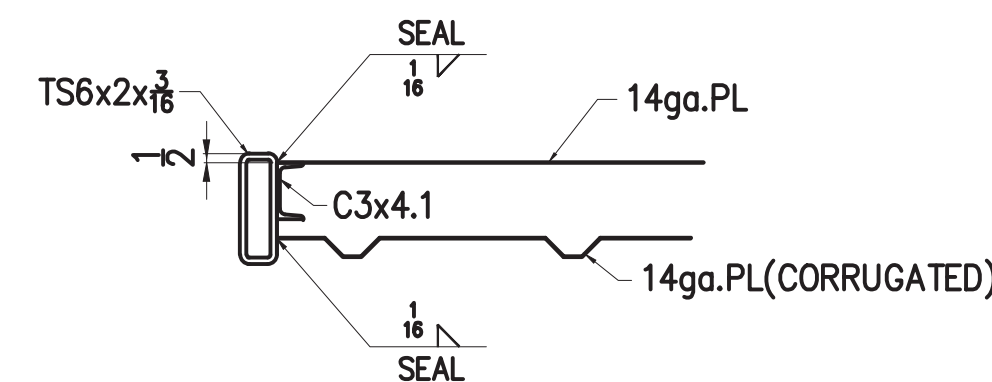

SECTION C

APPROVED
 APPROVED WITH CORRECTIONS NOTED
 REJECTED
 REVISE AND RESUBMIT
 SUBMIT SPECIFIED ITEM

Submittal review is only for ascertaining general conformance with the Contract Documents. Approval does not relieve the Contractor of responsibility for full compliance with the Contract Documents.

By: *[Signature]* Date: 1-7-19
 Gray Stassel Engineering, Inc.
 PO Box 111405
 Anchorage, AK
 P (907) 349-0100
 F (907) 349-8001


REV. No.	DATE	BY	DESCRIPTION
0	12/28/18	DWH	ISSUED FOR APPROVAL


WEONA CORPORATION
 10501 OLIVE LANE ANCHORAGE, AK 99515
 PHONE:(907)344-1921 FAX:(907)344-8244


CLEANING PAINT	PROJECT	CUSTOMER
BLAST & PAINT PER SPECS.	CLARKS POINT POWER SYSTEM UPGRADE	ALASKA ENERGY AUTHORITY
WELDS 3/16" FILLET U.N.O.	CEILING FRAMING PLAN	DATE 12/22/18
OPEN HOLES 13/16" U.N.O.		JOB No. DWG. No. E2

Structural Detailing Services of Alaska 907-336-2220 Fax: 907-336-2231 dtholland@pci.net

Structural Detailing Services of Alaska 907-336-2220 Fax: 907-336-2231 dholand@pci.net

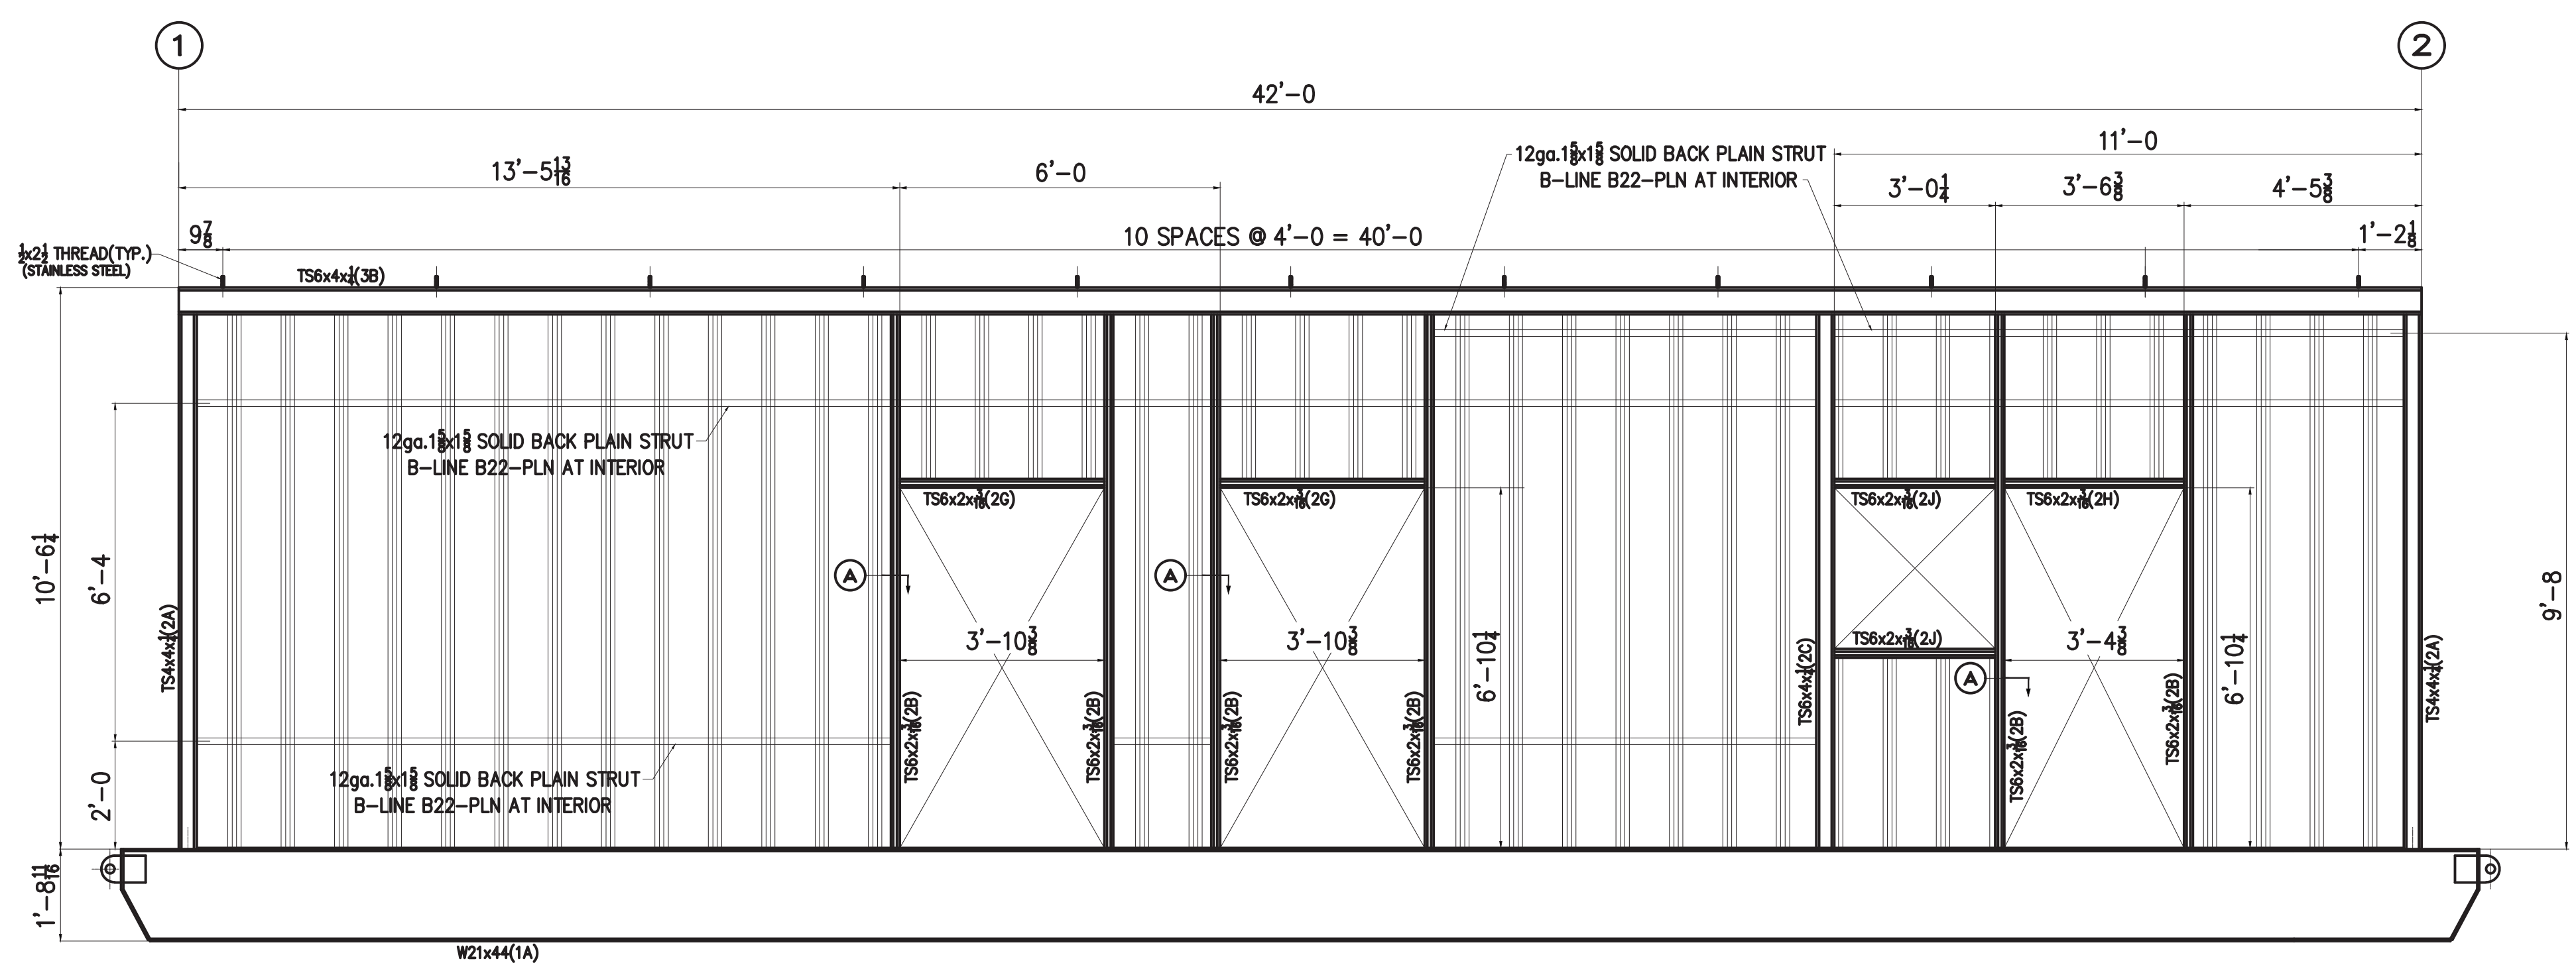


FRONT ELEVATION

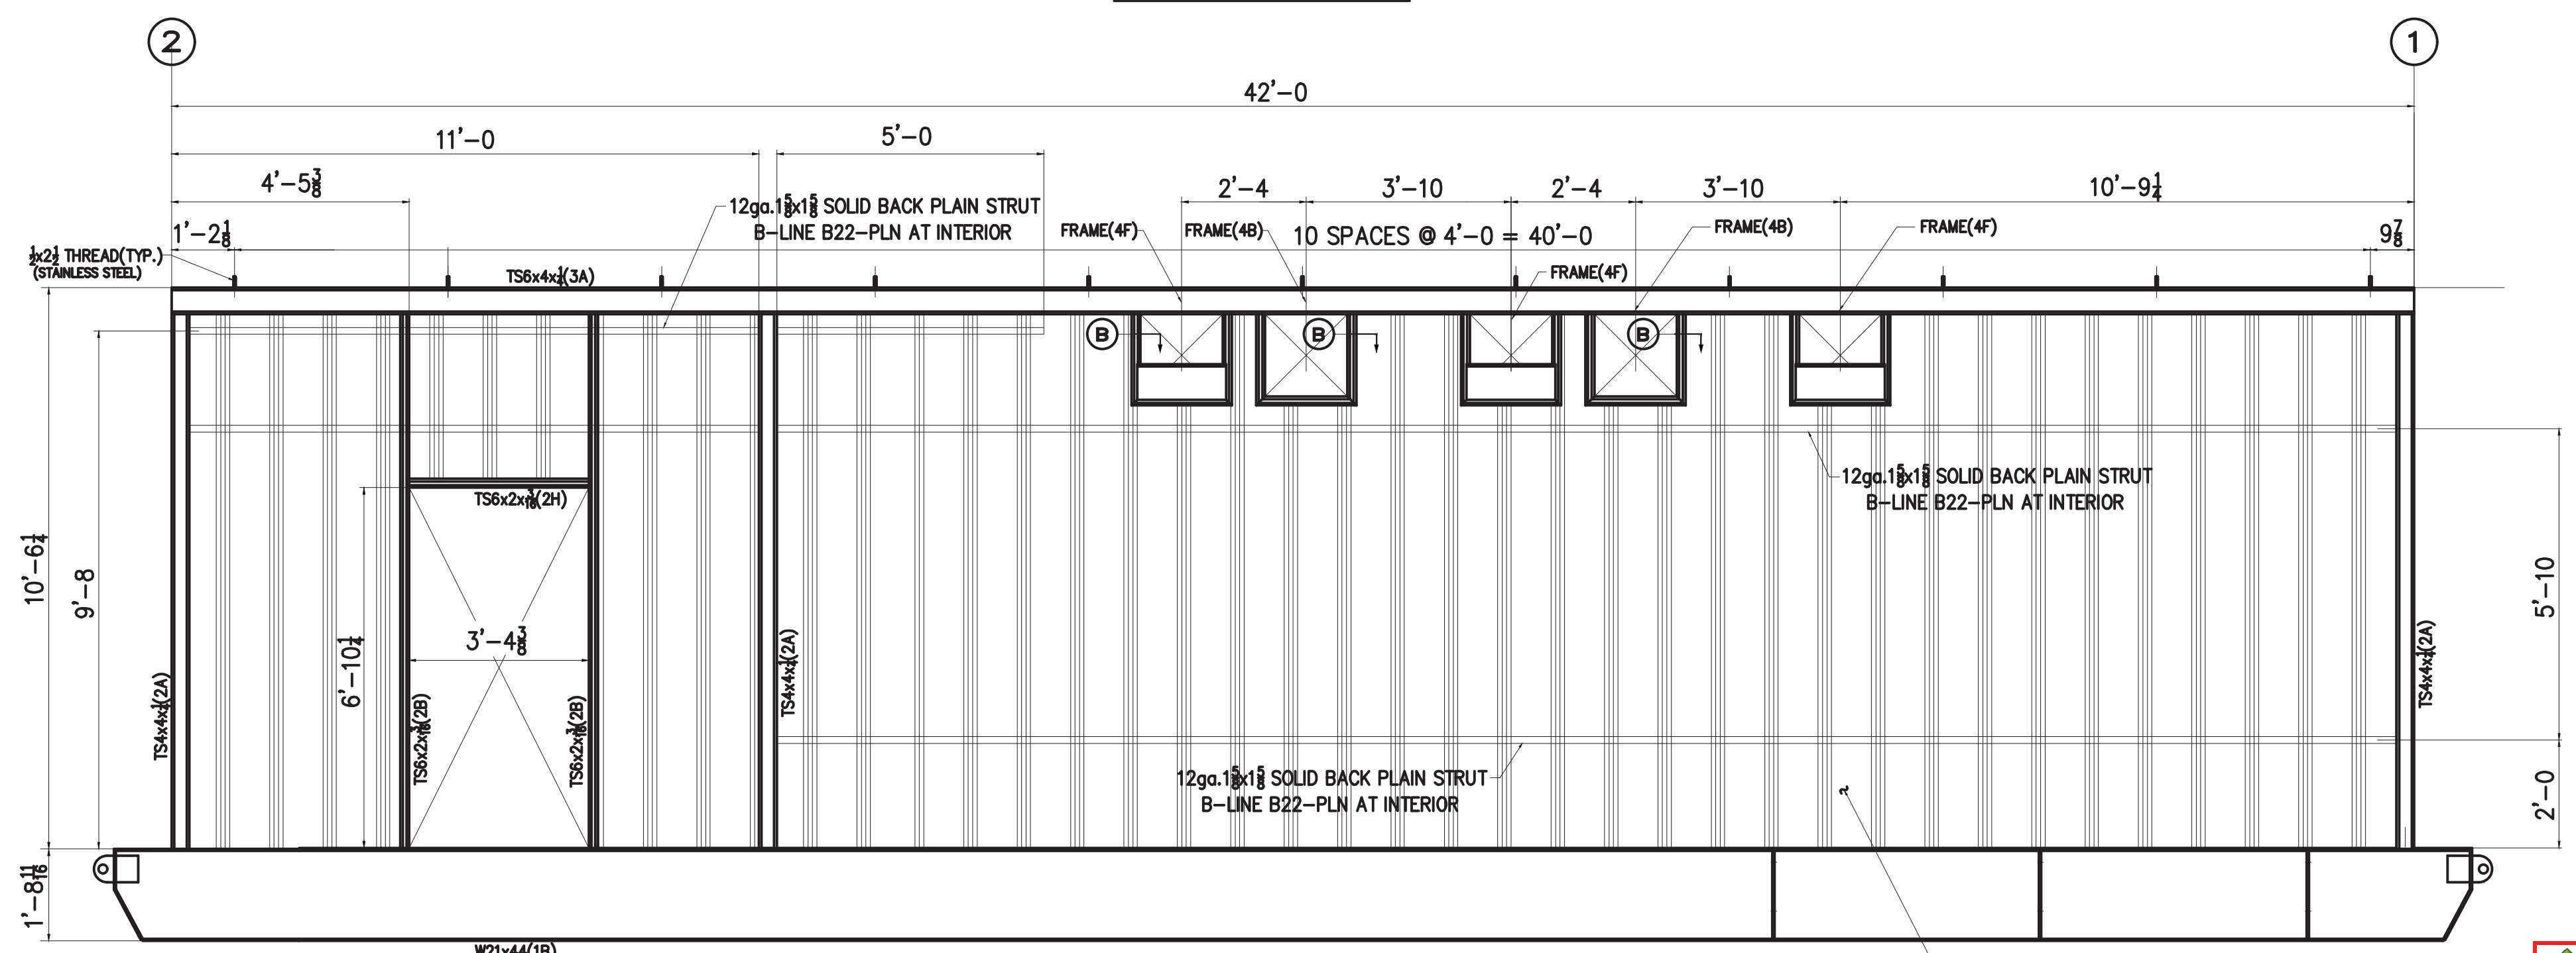


REAR ELEVATION

GENERAL NOTES:
STRUCTURAL STEEL
 1.) THE DESIGN, FABRICATION, AND ERECTION OF ALL STRUCTURAL STEEL SHALL COMPLY WITH THE CODE OF STANDARD PRACTICE OF THE AMERICAN INSTITUTE OF STEEL CONSTRUCTION.
 2.) ALL STEEL PLATE, SHAPES AND ROLLED SECTIONS SHALL BE ASTM A36. ALL STEEL TUBING SHALL BE ASTM A500, GRADE B.
 3.) ALL METAL TO METAL CONNECTIONS SHALL BE EQUAL TO STANDARD CONNECTION, OR AS DETAILED USING A325 BOLTS (BEARING TYPE CONNECTIONS). TIGHTEN HIGH STRENGTH BOLTS WITH PROPERLY CALIBRATED WRENCHES, BY TURN-OF-THE-NUT METHOD, OR BY LOAD WASHERS. ALL CONNECTIONS UNLESS OTHERWISE DETAILED, SHALL HAVE THE MAXIMUM NUMBER OF 3/4" BOLTS USING STANDARD GAUGES AND CLEARANCES.
 4.) ALL WELDING SHALL BE DONE IN ACCORDANCE WITH THE CURRENT CODE OF THE AMERICAN WELDING SOCIETY. USE AWS 5.1 E70XX ELECTRODES. MINIMUM FILLET WELDS SHALL BE 3/16" EXCEPT FOR SEAL WELDS TO GAUGE METAL AS INDICATED.
FINISH
 A.) INSULATE ALL WALLS, FLOORS, AND CEILINGS WITH HIGH TEMPERATURE MINERAL FIBER ACOUSTICAL FIRE BATT INSULATION, MIN. R VALUE 4 PER INCH, MIN. 2000F. MELTING TEMP., ROXUL AFB OR EQUAL. FILL ALL PANEL VOIDS OR PROVIDE THICKNESS AS INDICATED ON DRAWINGS. MECHANICALLY FASTEN FLOOR INSULATION TO TIGHT FLOOR.
 B.) UPON COMPLETION OF FABRICATION ROUND ALL CORNERS AND GRIND EDGES SMOOTH AND PAINT ALL INTERIOR AND EXTERIOR EXPOSED STEEL. PERFORM ALL PAINTING IN A WARM, DRY ENVIRONMENT IN ACCORDANCE WITH MANUFACTURER'S INSTRUCTIONS INCLUDING DRYING TIME TO RE-COAT.
 C.) SANDBLAST EXTERIOR SURFACE TO SSPC-SP-10. PRIME WITH ONE COAT OF REINFORCED INORGANIC ZINC PRIMER, DEVOC CATHA-COAT 302, NO SUBSTITUTES, COLOR GREEN, TO 3 MILS DRY FILM THICKNESS. COVER WITH TWO COATS OF EPOXY, DEVOC BAR-RUST 236, NO SUBSTITUTES, TO 12 MILS DRY FILM THICKNESS. FIRST COAT COLOR GRAY, SECOND COAT COLOR WHITE.
 D.) FINISH EXTERIOR WALLS AND SKIDS (ALL EXPOSED VERTICAL EXTERIOR SURFACES) WITH ONE COAT OF ALIPHATIC URETHANE ENAMEL, DEVOC DEVTHANE 389, NO SUBSTITUTES, COLOR WHITE, TO 3 MILS DFT.
 E.) SANDBLAST INTERIOR SURFACE TO SSPC-SP-6. PRIME AND FINISH WITH TWO COATS OF EPOXY, SHERWIN WILLIAMS MACROPOXY 646, NO SUBSTITUTES, TO 8 MILS TOTAL DRY FILM THICKNESS. CEILING COLOR WHITE. WALL AND FLOOR COLOR STRUCTURAL GRAY 4031. NOTE THAT FIRST COAT ON WALLS AND FLOOR MAY BE WHITE.

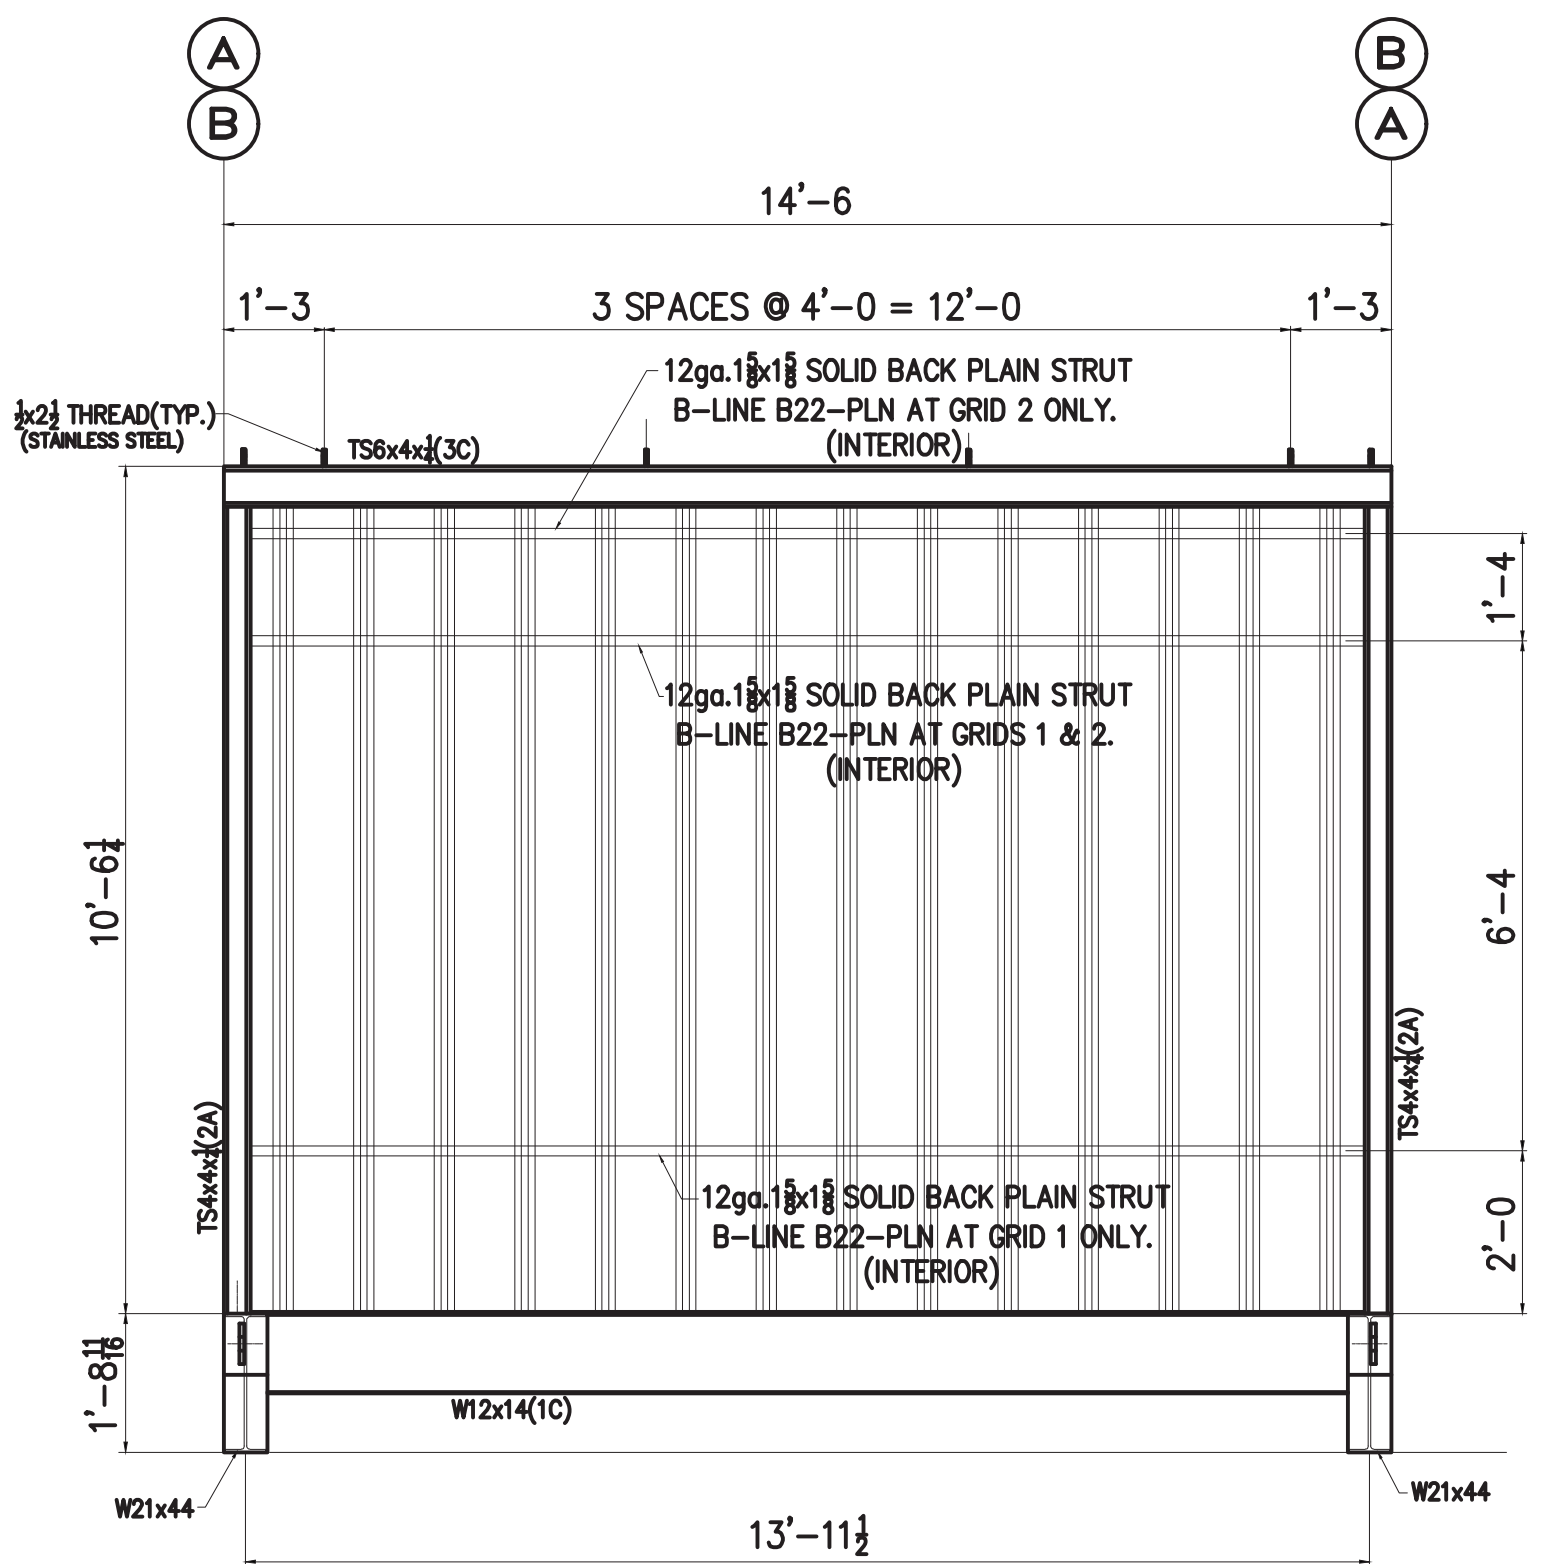

END ELEVATION

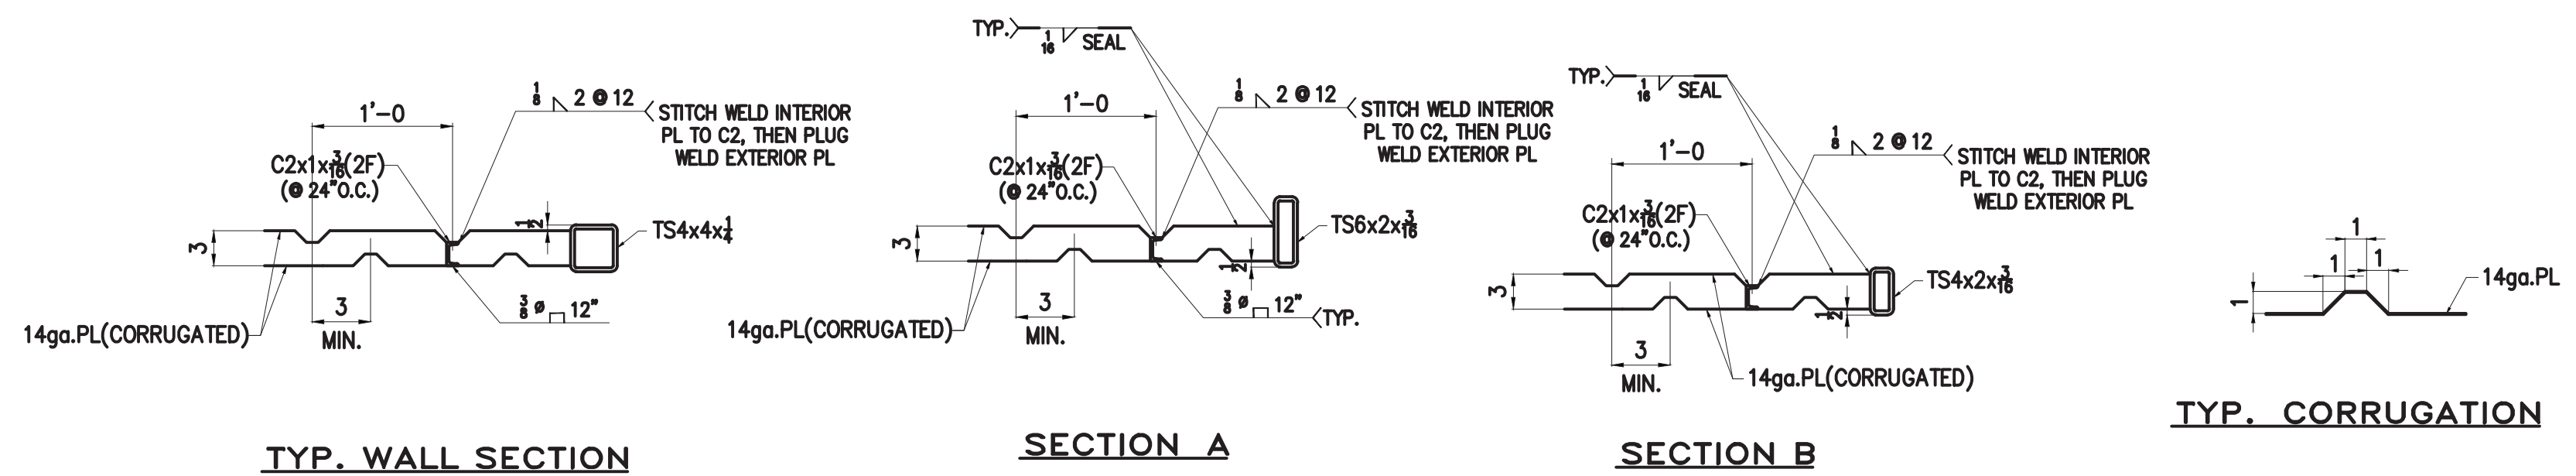

- APPROVED
 - APPROVED WITH CORRECTIONS NOTED
 - REJECTED
 - REVISE AND RESUBMIT
 - SUBMIT SPECIFIED ITEM
- Submittal review is only for ascertaining general conformance with the Contract Documents. Approval does not relieve the Contractor of responsibility for full compliance with the Contract Documents.

By: *[Signature]* Date: 1-7-19
 PO Box 111405
 Anchorage, AK
 P (907) 349-0100
 F (907) 349-8001

CLEANING PAINT	BLAST & PAINT PER SPECS.
WELDS	3/16" FILLET U.N.O.
OPEN HOLES	13/16" U.N.O.

REV. No.	DATE	BY	DESCRIPTION
0	12/28/18	DWH	ISSUED FOR APPROVAL

WEONA CORPORATION
 10501 OLIVE LANE ANCHORAGE, AK 99515
 PHONE:(907)344-1921 FAX:(907)344-8244

PROJECT
 CLARKS POINT POWER SYSTEM UPGRADE
 EXTERIOR ELEVATIONS

CUSTOMER
 ALASKA ENERGY AUTHORITY


DATE 12/22/18
JOB No.
DWG. NO. E3

APPROVED
 APPROVED WITH CORRECTIONS NOTED
 REJECTED
 REVISE AND RESUBMIT
 SUBMIT SPECIFIED ITEM


Submittal review is only for ascertaining general conformance with the Contract Documents. Approval does not relieve the Contractor of responsibility for full compliance with the Contract Documents.

By: *[Signature]* Date: **1-7-19**
 PO Box 111405
 Anchorage, AK
 P (907) 349-0100
 F (907) 349-8001


Gray Stassel Engineering, Inc.

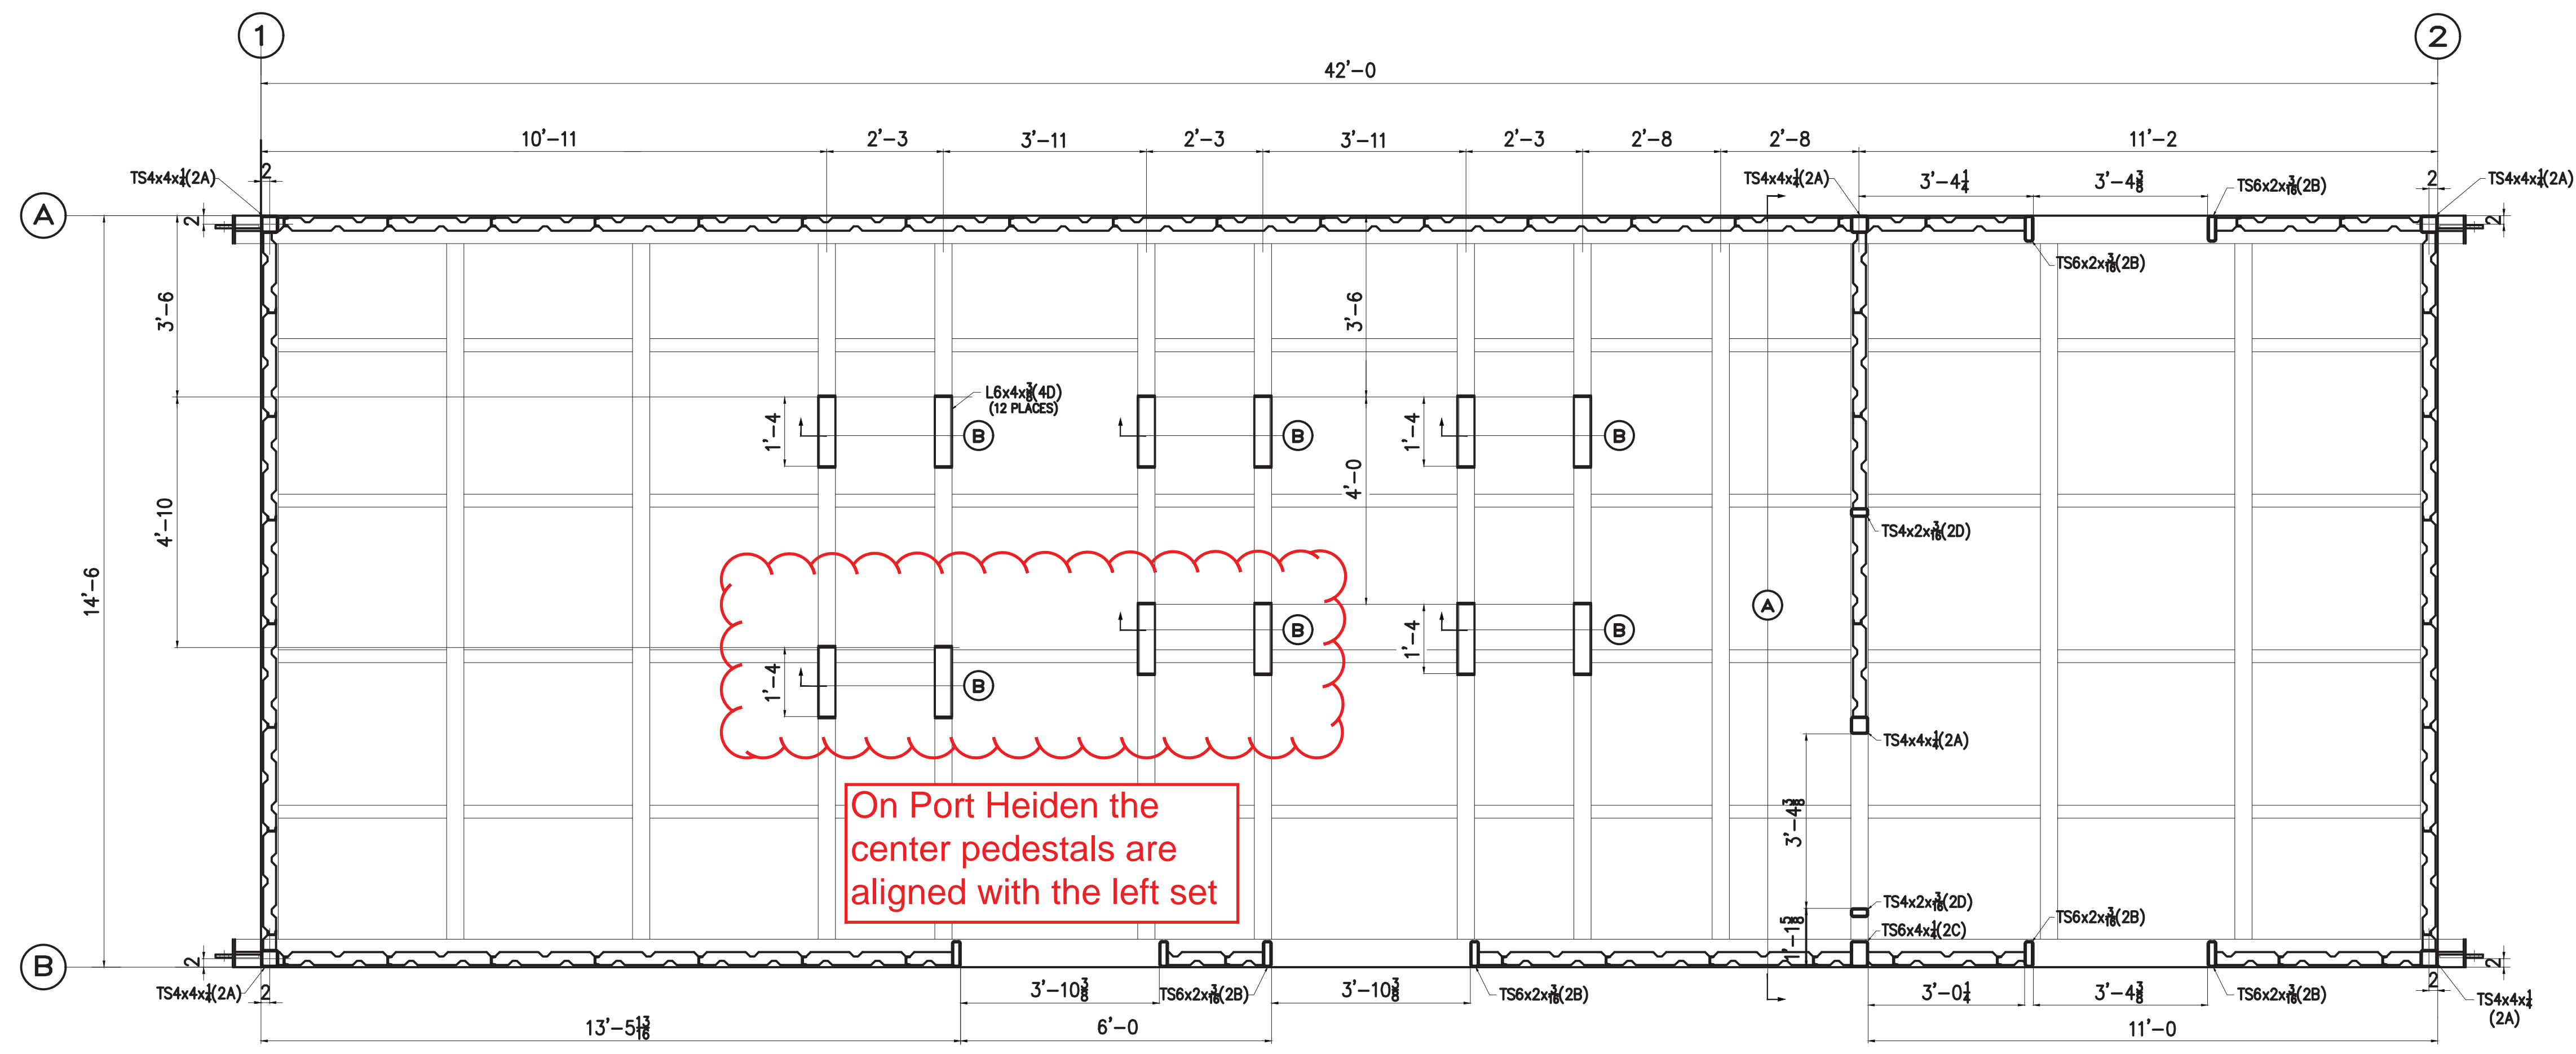


FLOOR PLAN

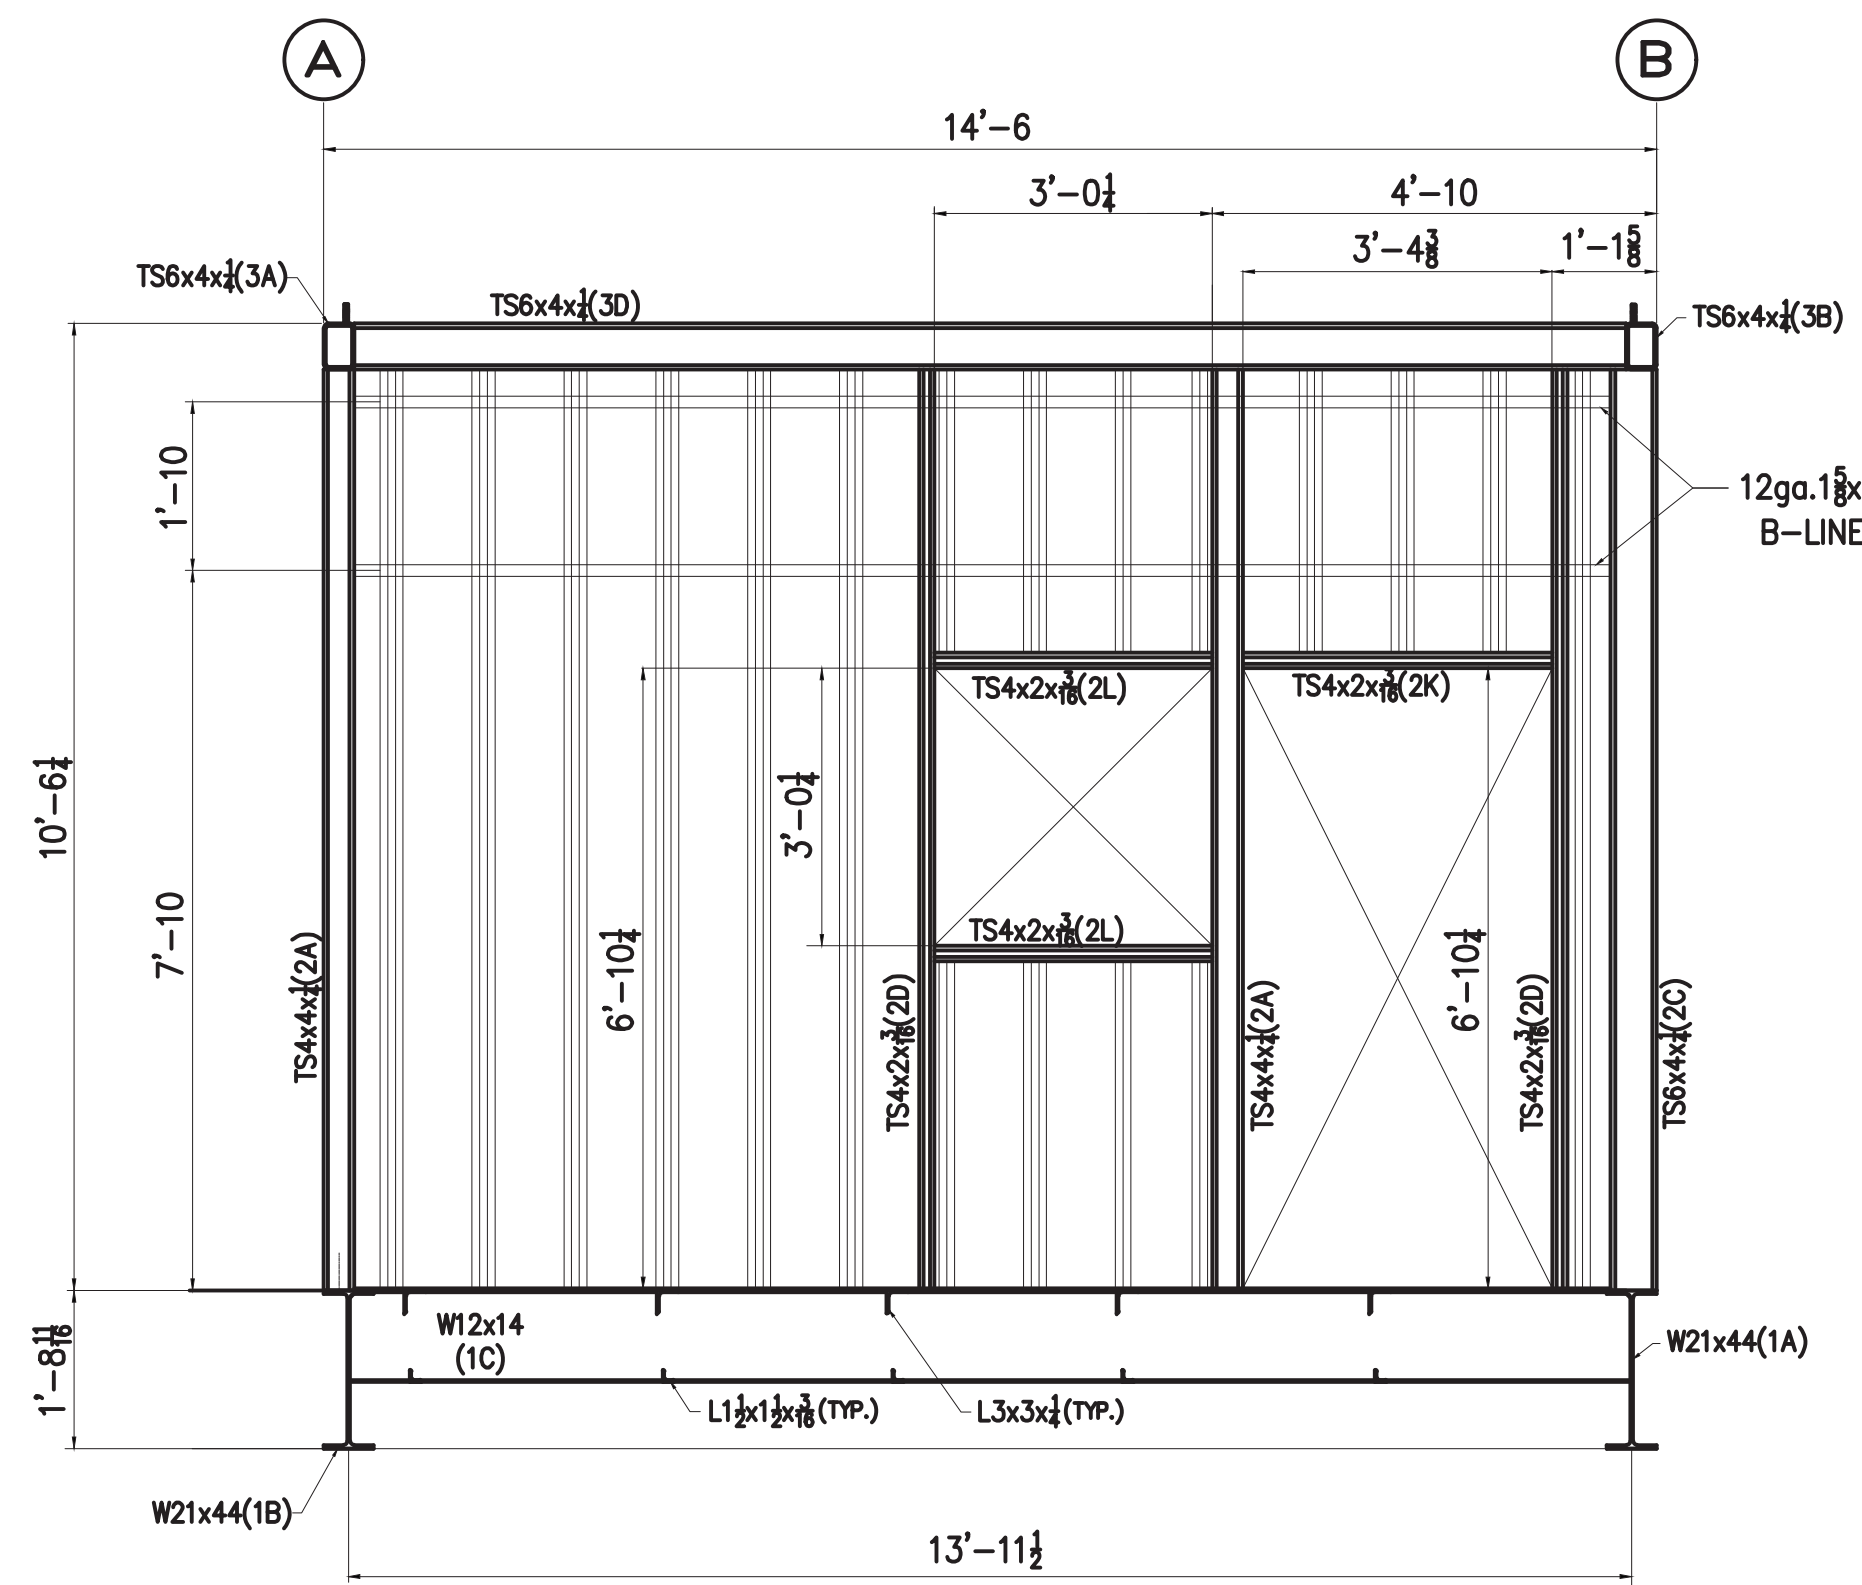


A INTERIOR WALL SECTION

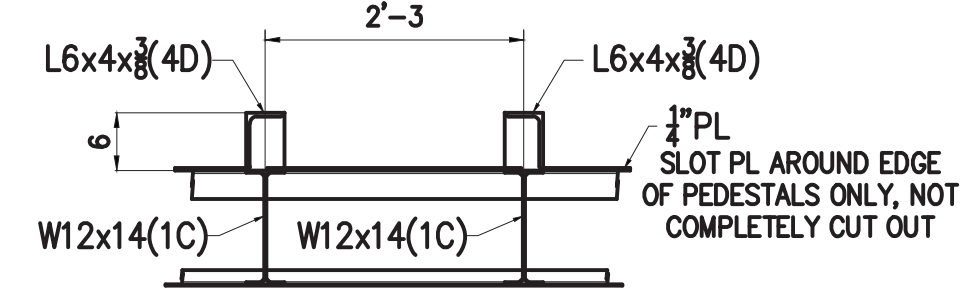

B SECTION

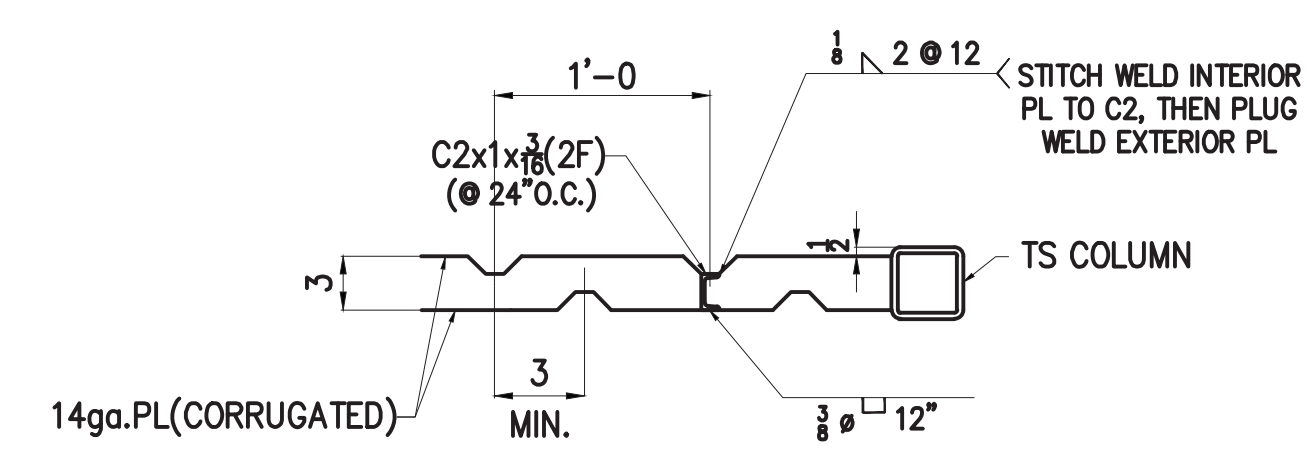

TYP. WALL SECTION

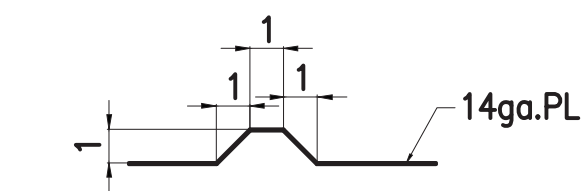

TYP. CORRUGATION

SHOP NOTES:

- 1.) MAKE ALL JOINTS WITH CONTINUOUS GROOVE OR FILLET WELDS.
- 2.) SLOT FLOOR PLATE 3 SIDES THEN WELD PEDESTAL TO TOP OF BEAM AND SEAL WELD TO FLOOR PLATE ALL AROUND.


REV. No.	DATE	BY	DESCRIPTION
1	1/4/19	DWH	REVISED INTERIOR SECTION
0	12/28/18	DWH	ISSUED FOR APPROVAL


WEONA CORPORATION
 10501 OLIVE LANE ANCHORAGE, AK 99515
 PHONE: (907) 344-1921 FAX: (907) 344-8244


CLEANING PAINT BLAST & PAINT PER SPECS.	PROJECT CLARKS POINT POWER SYSTEM UPGRADE	CUSTOMER ALASKA ENERGY AUTHORITY	
	WELDS 3/16" FILLET U.N.O.	DATE 12/22/18	JOB No.
	OPEN HOLES 13/16" U.N.O.	FLOOR PLAN	DWG. NO. E4

Structural Detailing Services of Alaska 907-336-2220 Fax: 907-336-2231 dholland@pci.net

Structural Detailing Services of Alaska 907-336-2220 Fax: 907-336-2231 dholland@aci.net

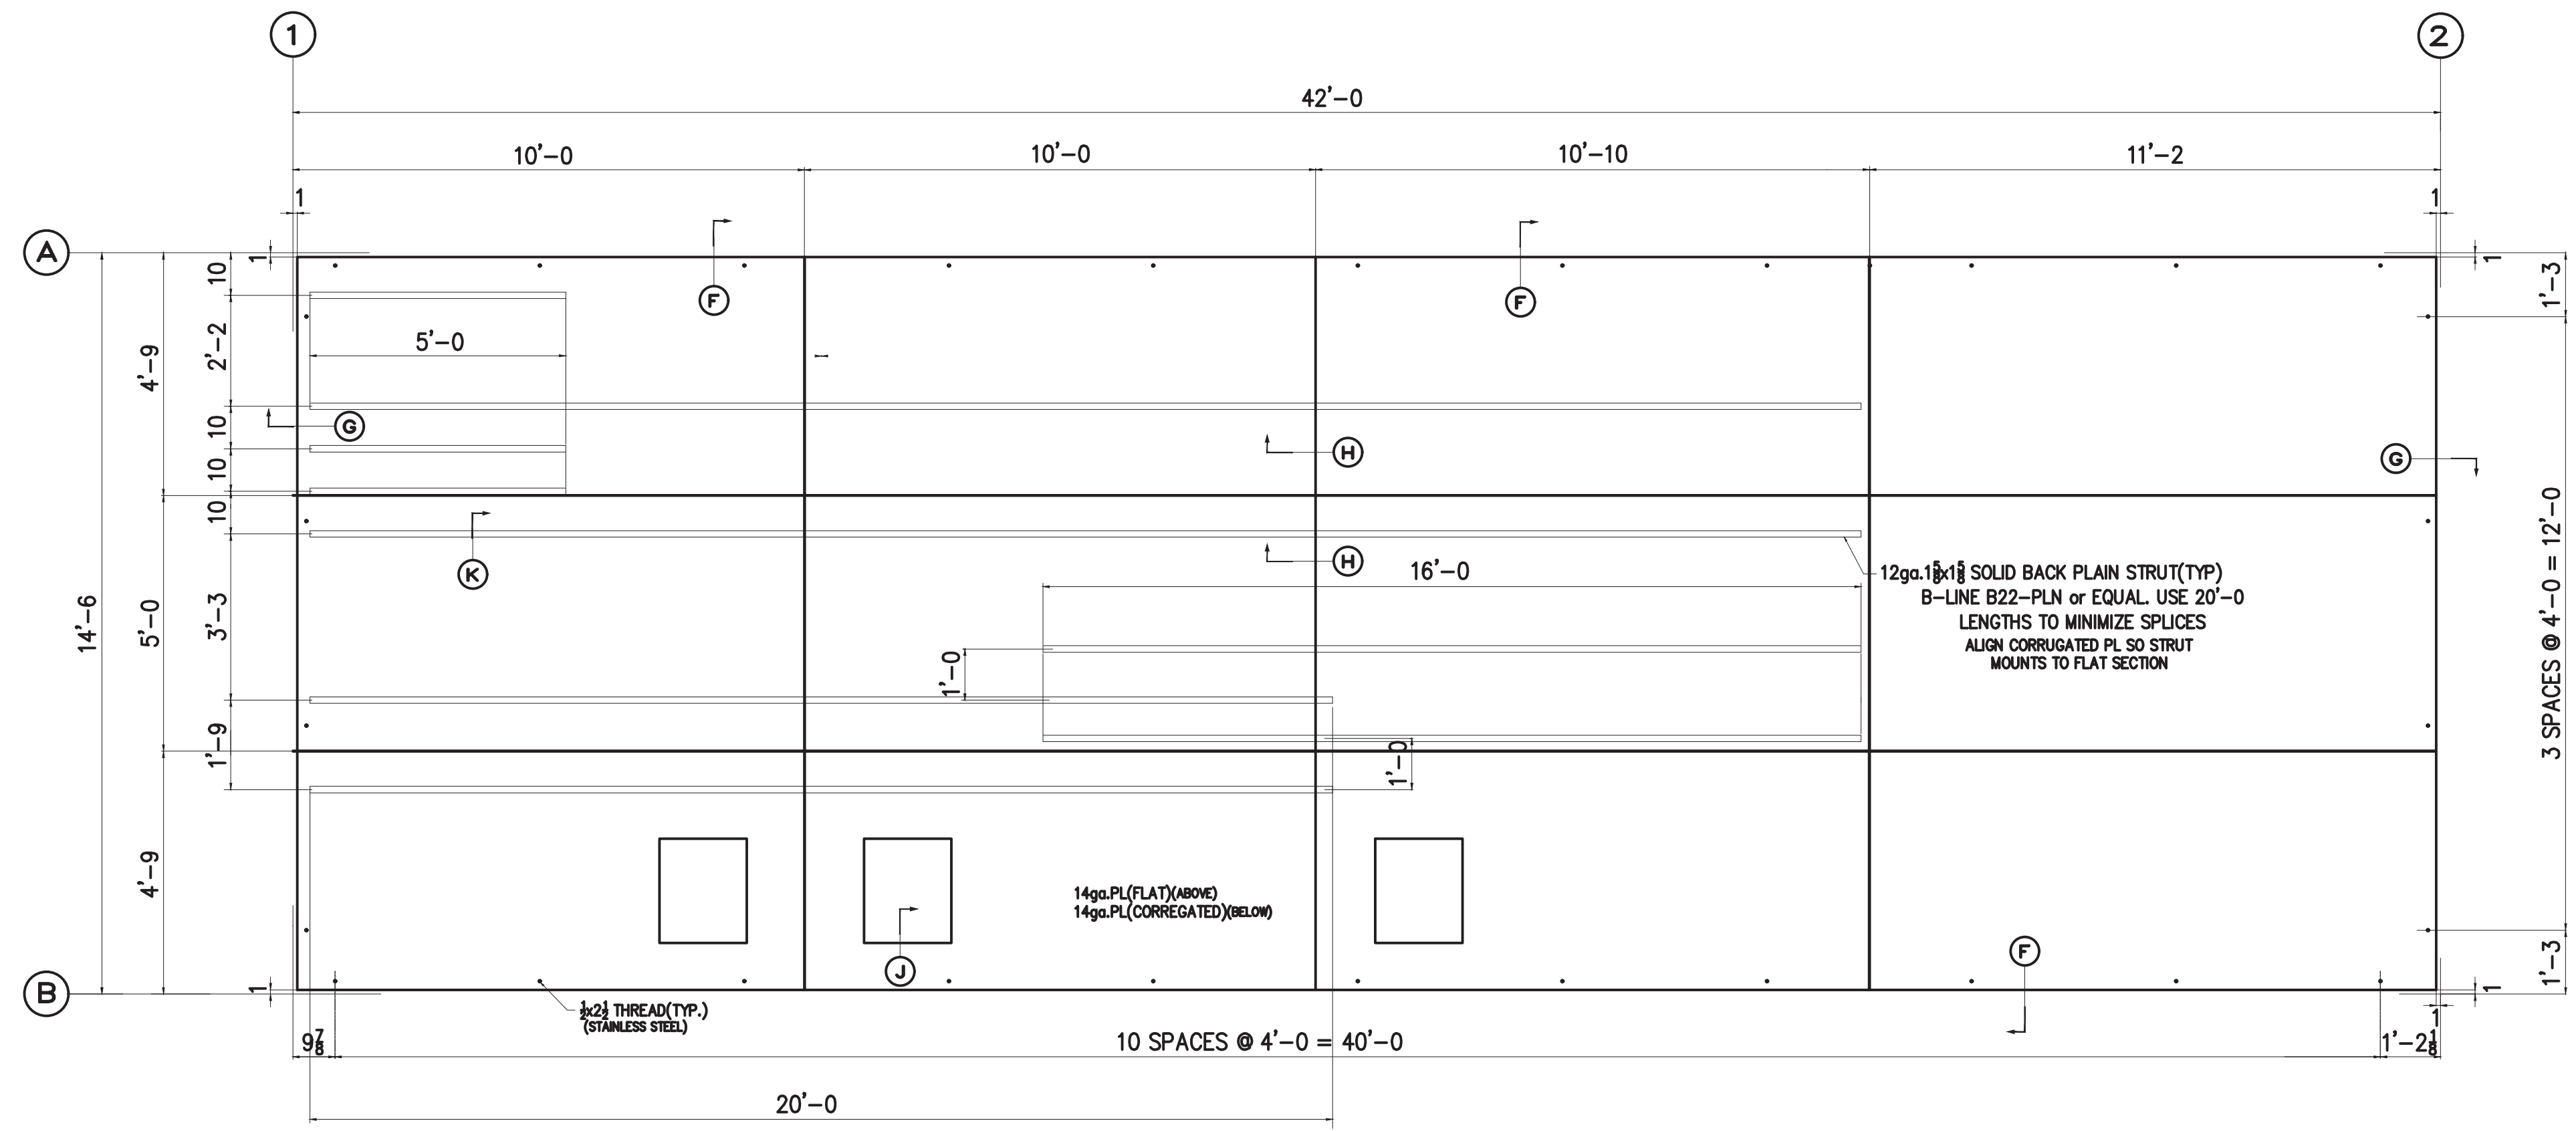


CEILING PLATE LAYOUT








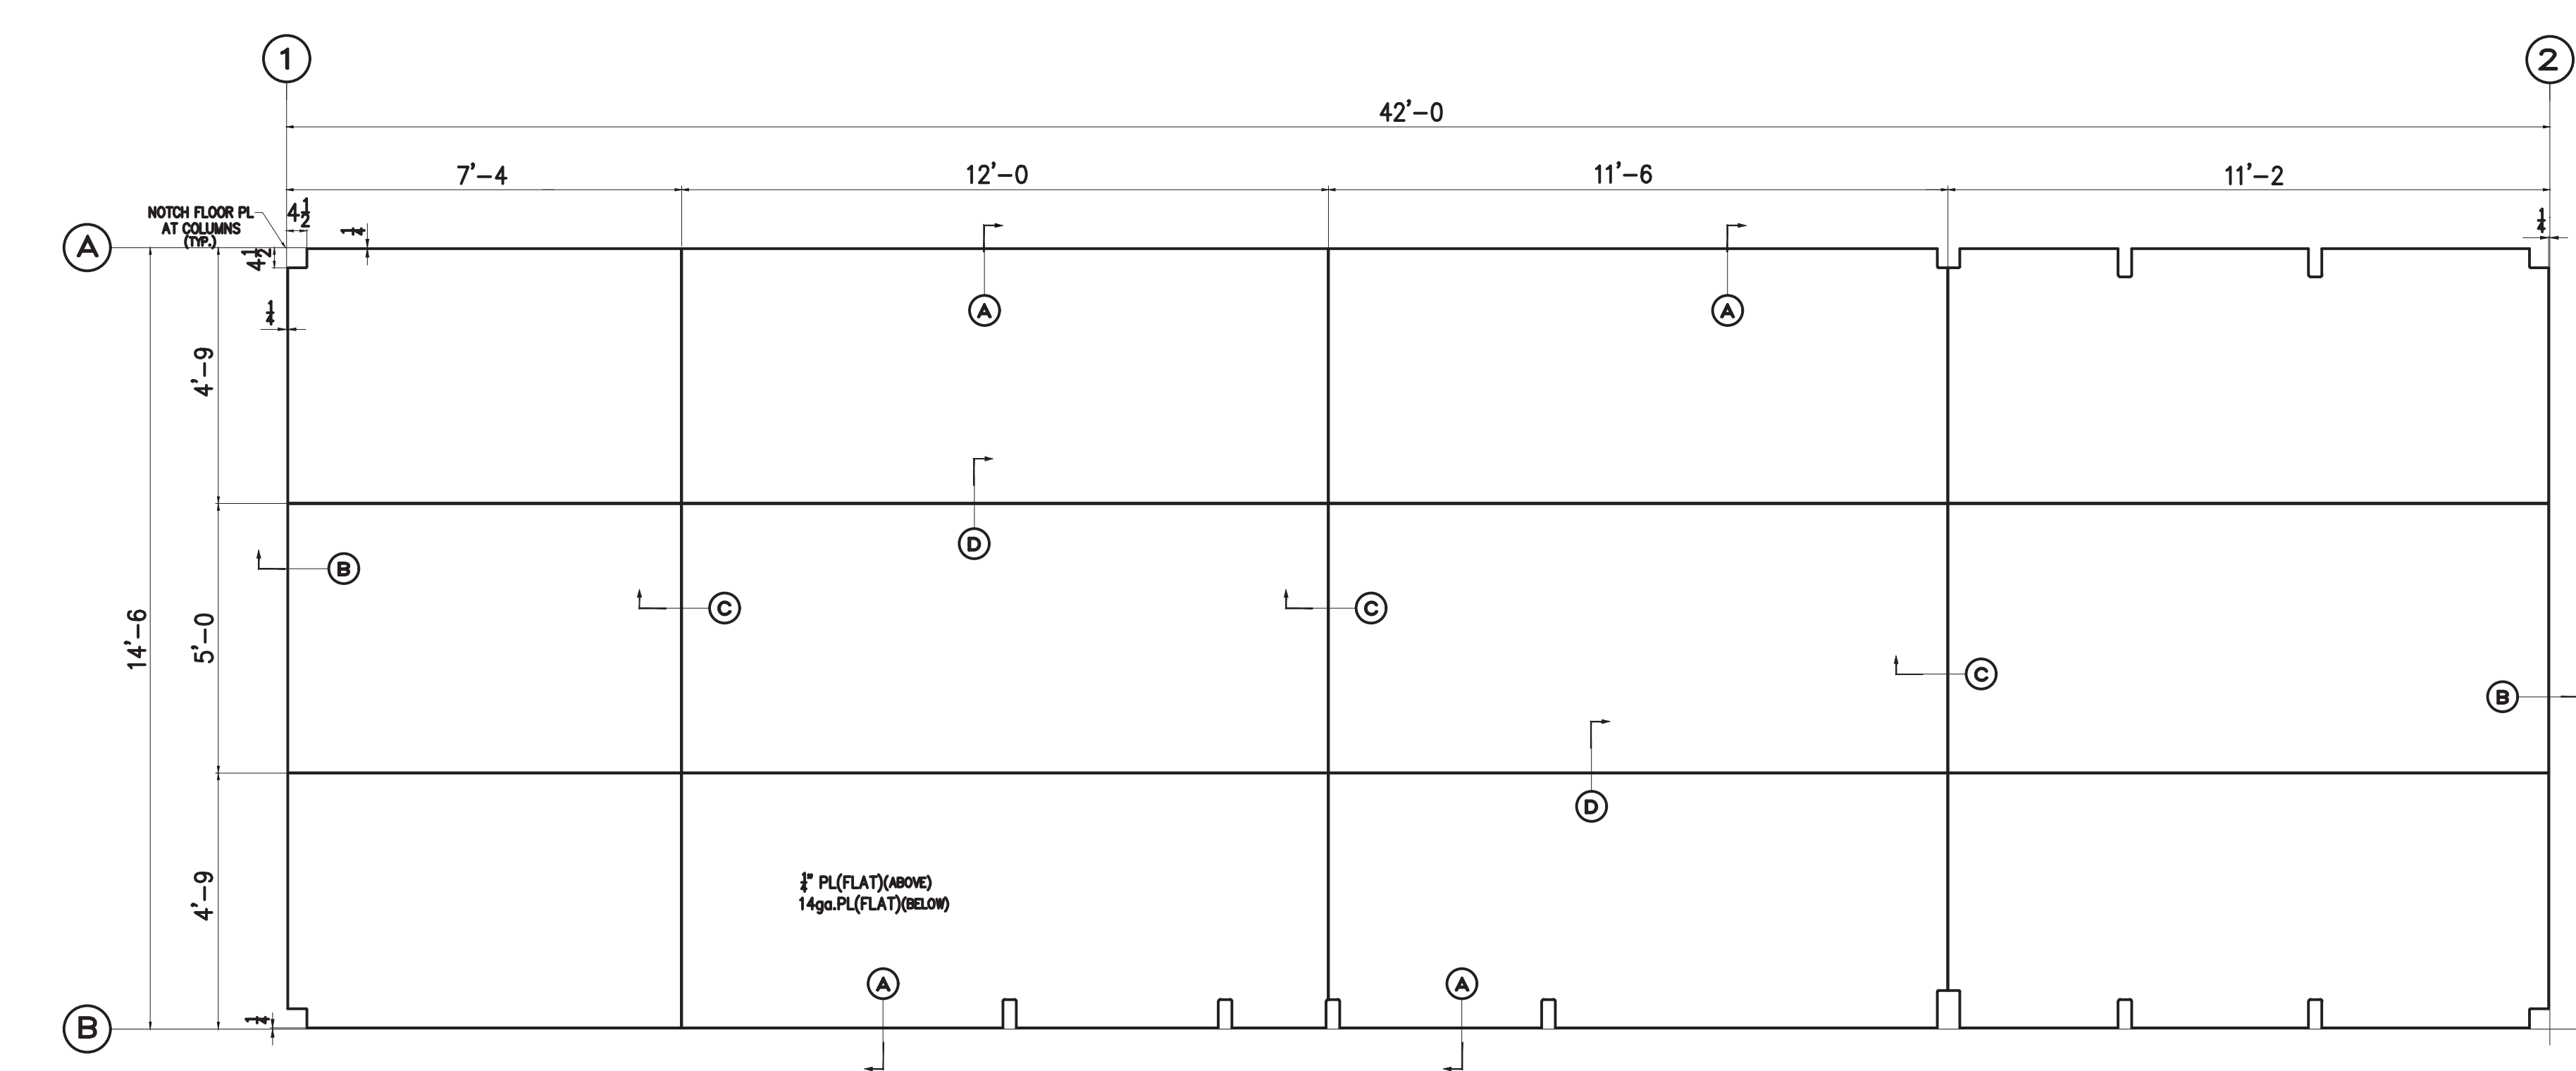


FLOOR PLATE LAYOUT

SHOP NOTES:
 1.) FABRICATE FLOOR AND PAN DECK DECKS USING 5' AND 6' WIDE SHEETS WITH ALL JOINTS CENTERED ON PURLINS & JOISTS.
 2.) FABRICATE CEILING ASSEMBLY (FLAT & CORRUGATED) USING 5' AND 6' WIDE SHEETS WITH ALL JOINTS CENTERED ON JOISTS & PURLINS.

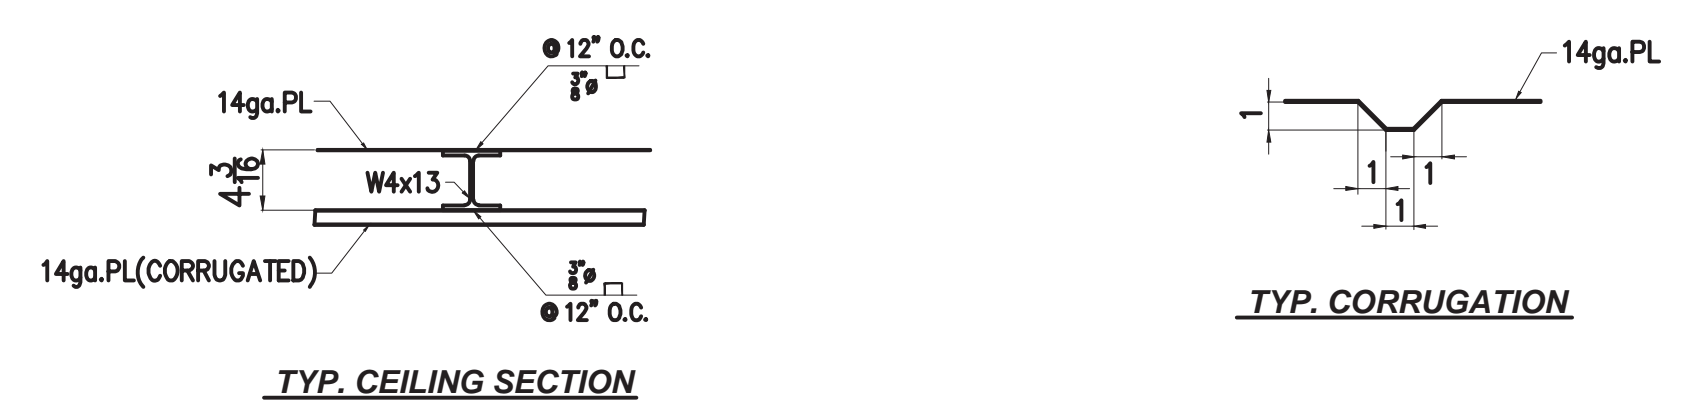

TYP. CORRUGATION

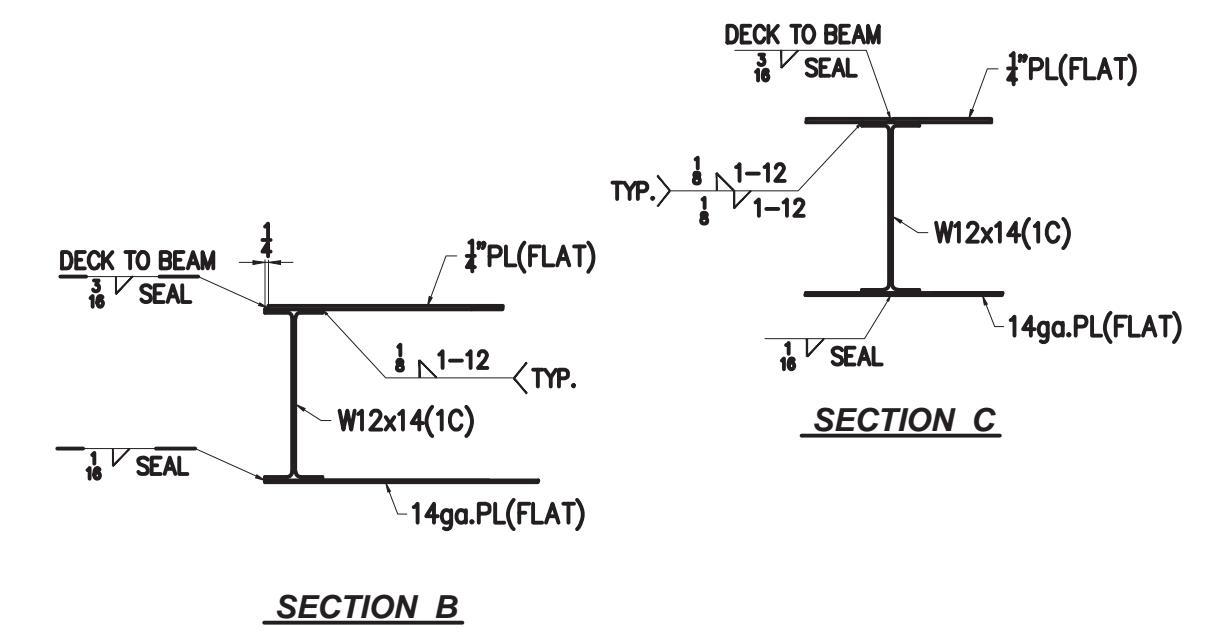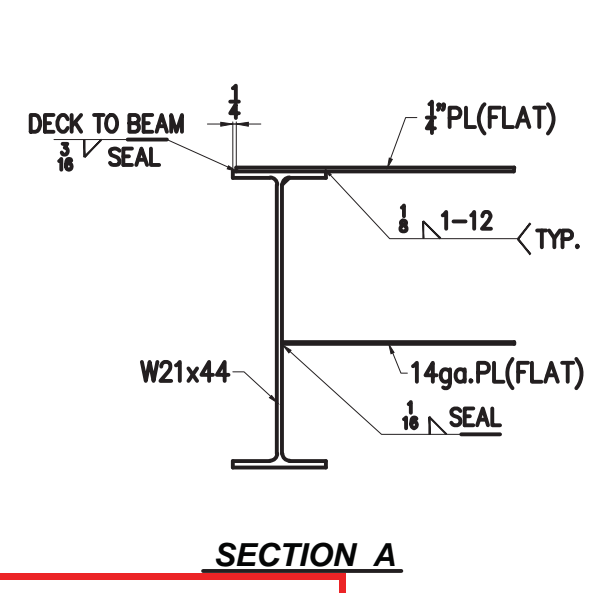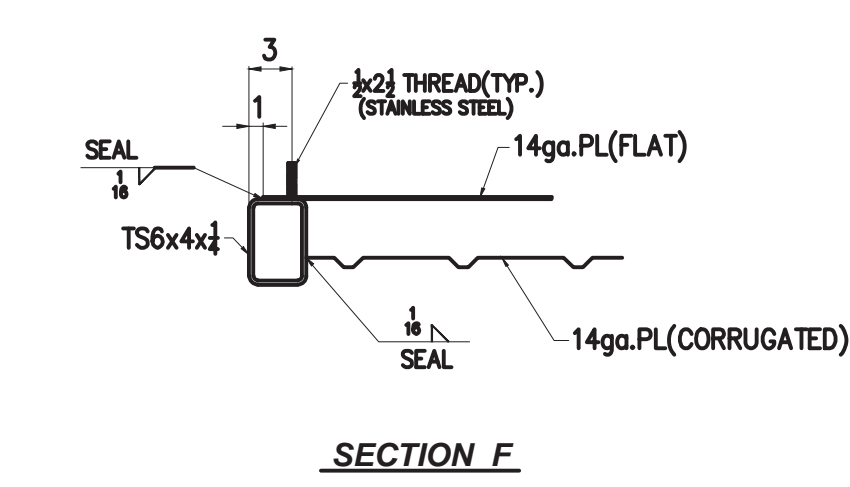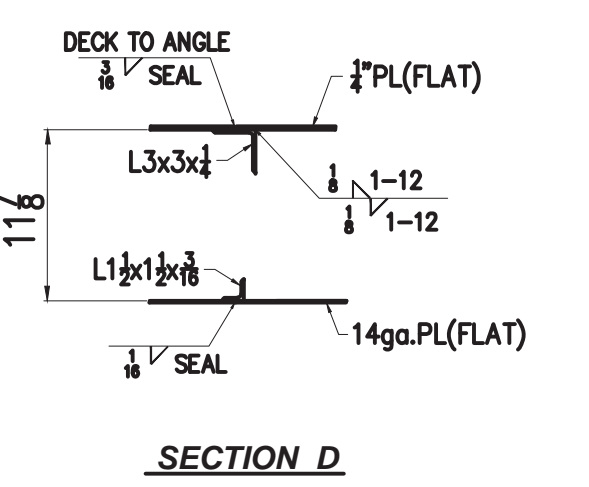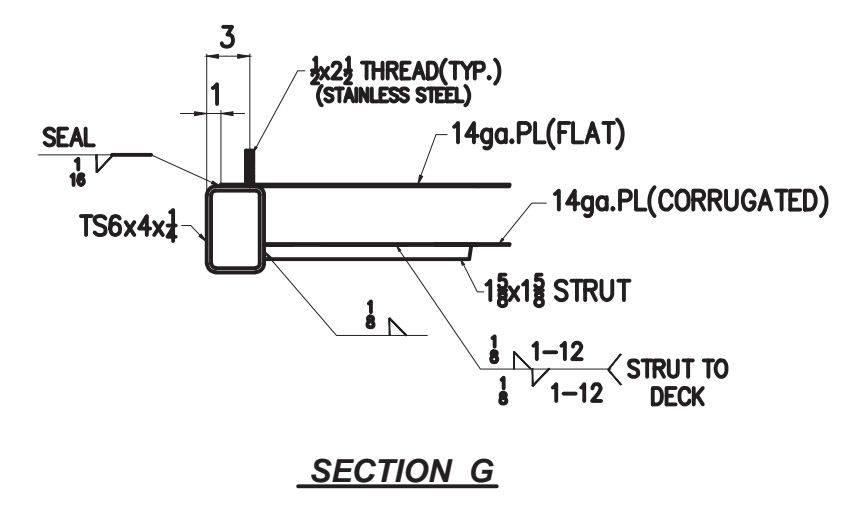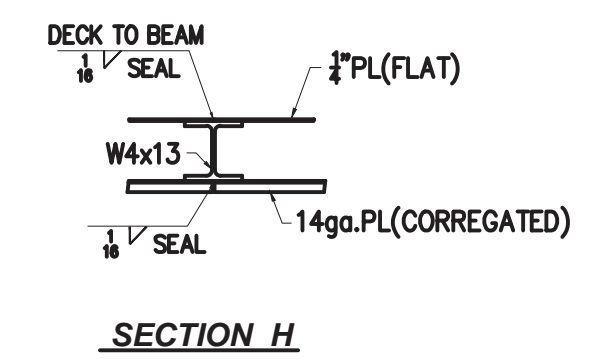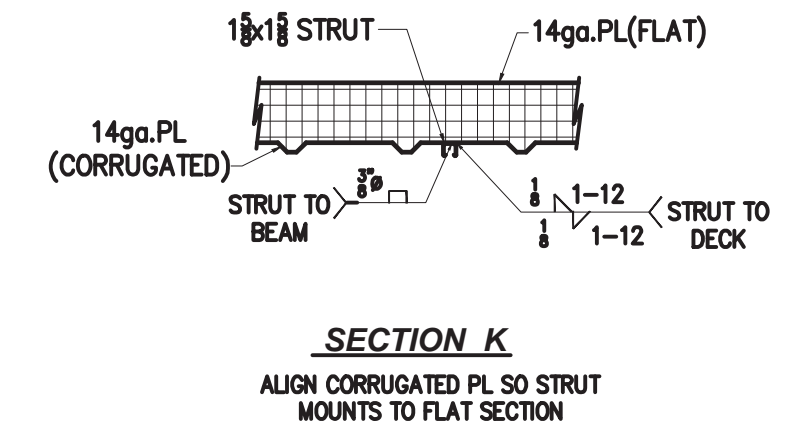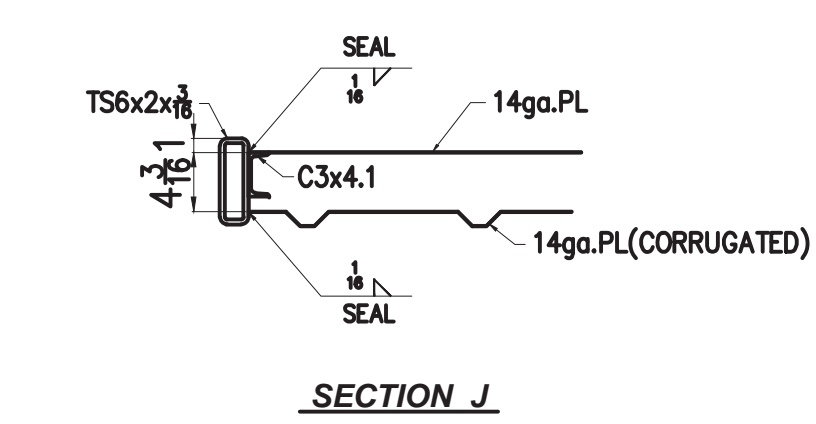


APPROVED
 APPROVED WITH CORRECTIONS NOTED
 REJECTED
 REVISE AND RESUBMIT
 SUBMIT SPECIFIED ITEM
 Submittal review is only for ascertaining general conformance with the Contract Documents. Approval does not relieve the Contractor of responsibility for full compliance with the Contract Documents.
 By: *[Signature]* Date: 1-7-19
 PO Box 111405
 Anchorage, AK
 P (907) 349-0100
 F (907) 349-8001


REV. No.	DATE	BY	DESCRIPTION
0	12/28/18	DWH	ISSUED FOR APPROVAL

WEONA CORPORATION
 10501 OLIVE LANE ANCHORAGE, AK 99515
 PHONE: (907) 344-1921
 FAX: (907) 344-8244


CLEAN PAINT	BLAST & PAINT PER SPECS.	PROJECT	CLARKS POINT POWER SYSTEM UPGRADE	CUSTOMER	ALASKA ENERGY AUTHORITY
WELDS	3/16" FILLET U.N.O.	DECK & CEILING PLATES	DATE	12/22/18	JOB No.
OPEN HOLES	13/16" U.N.O.		DWG. NO.	E5	

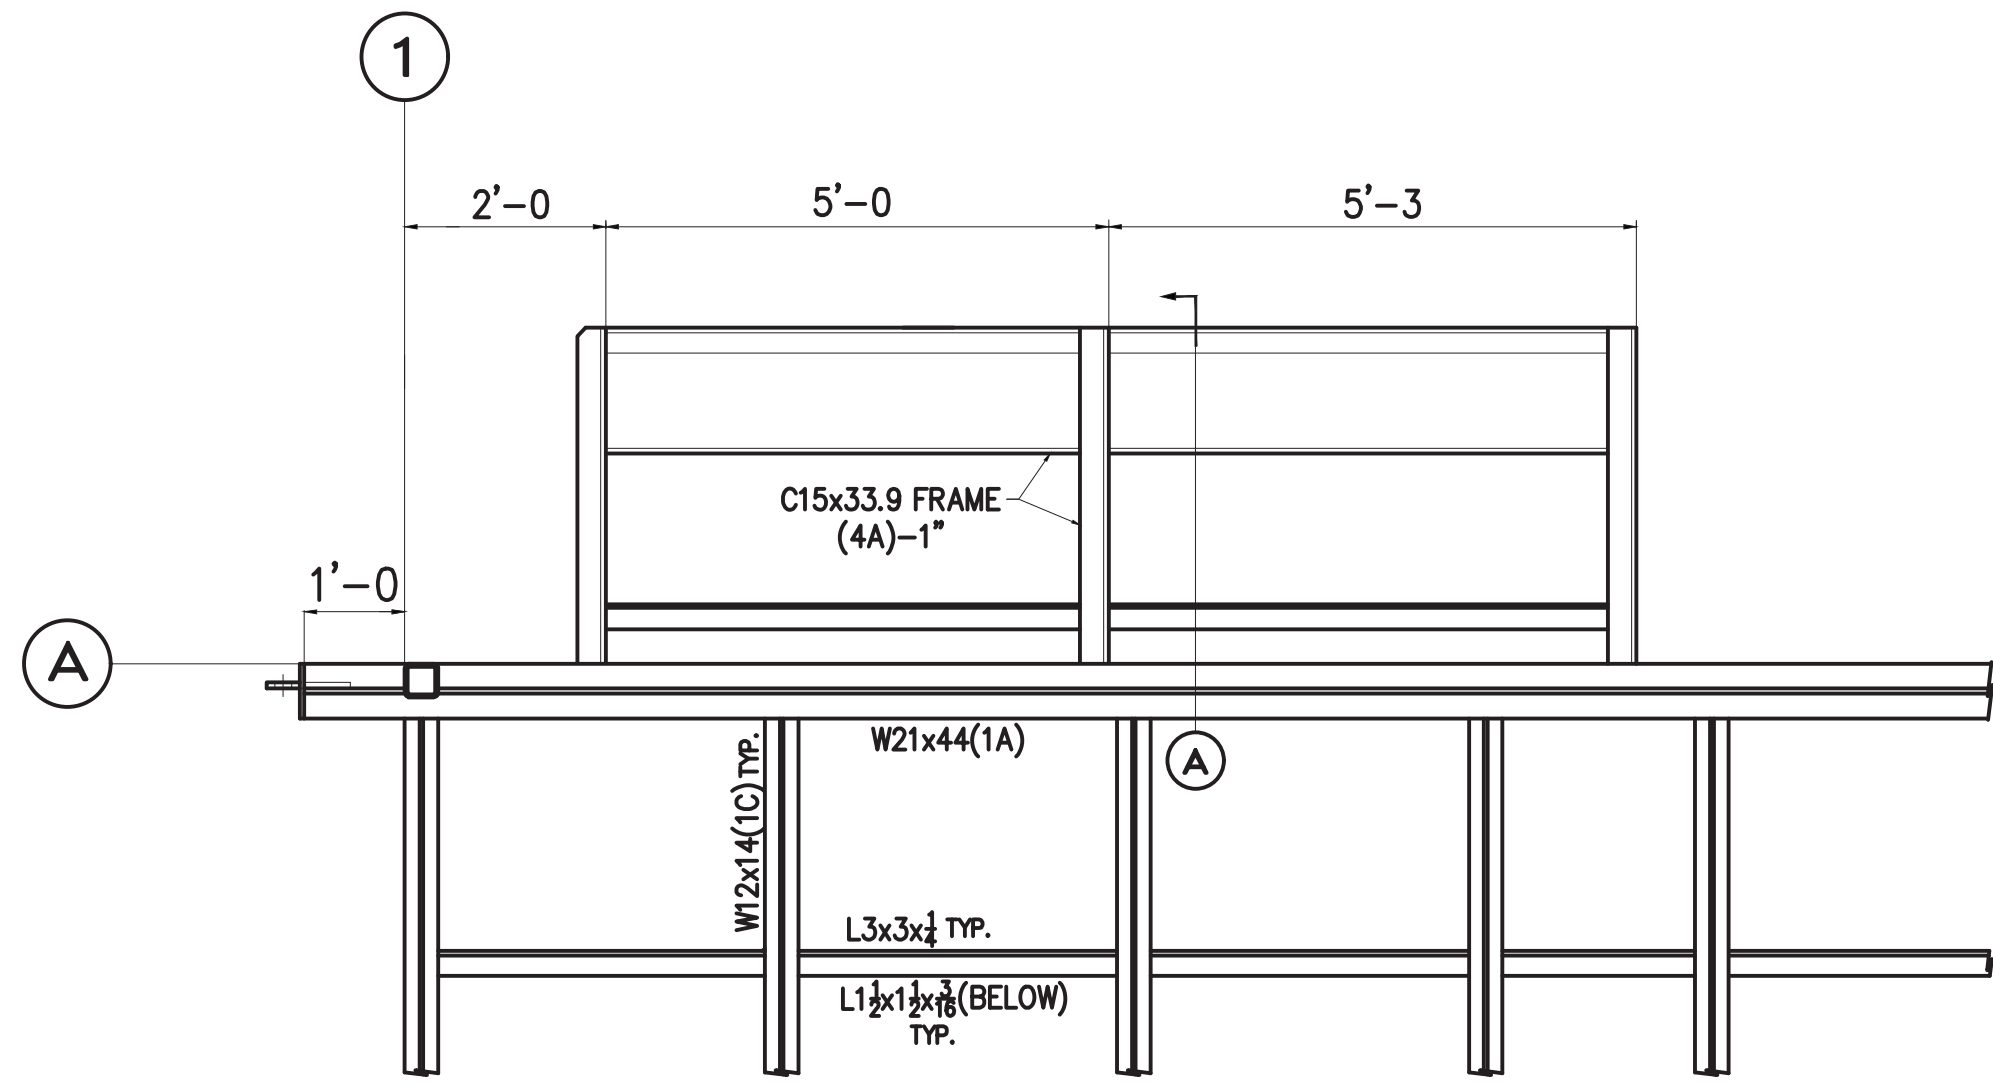


RADIATOR SUPPORTS FRAMING PLAN

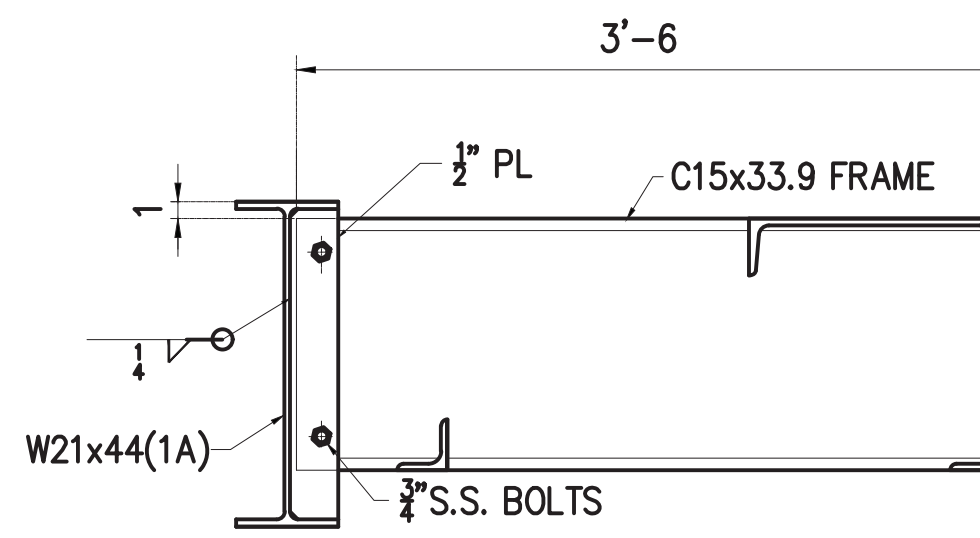

SECTION A

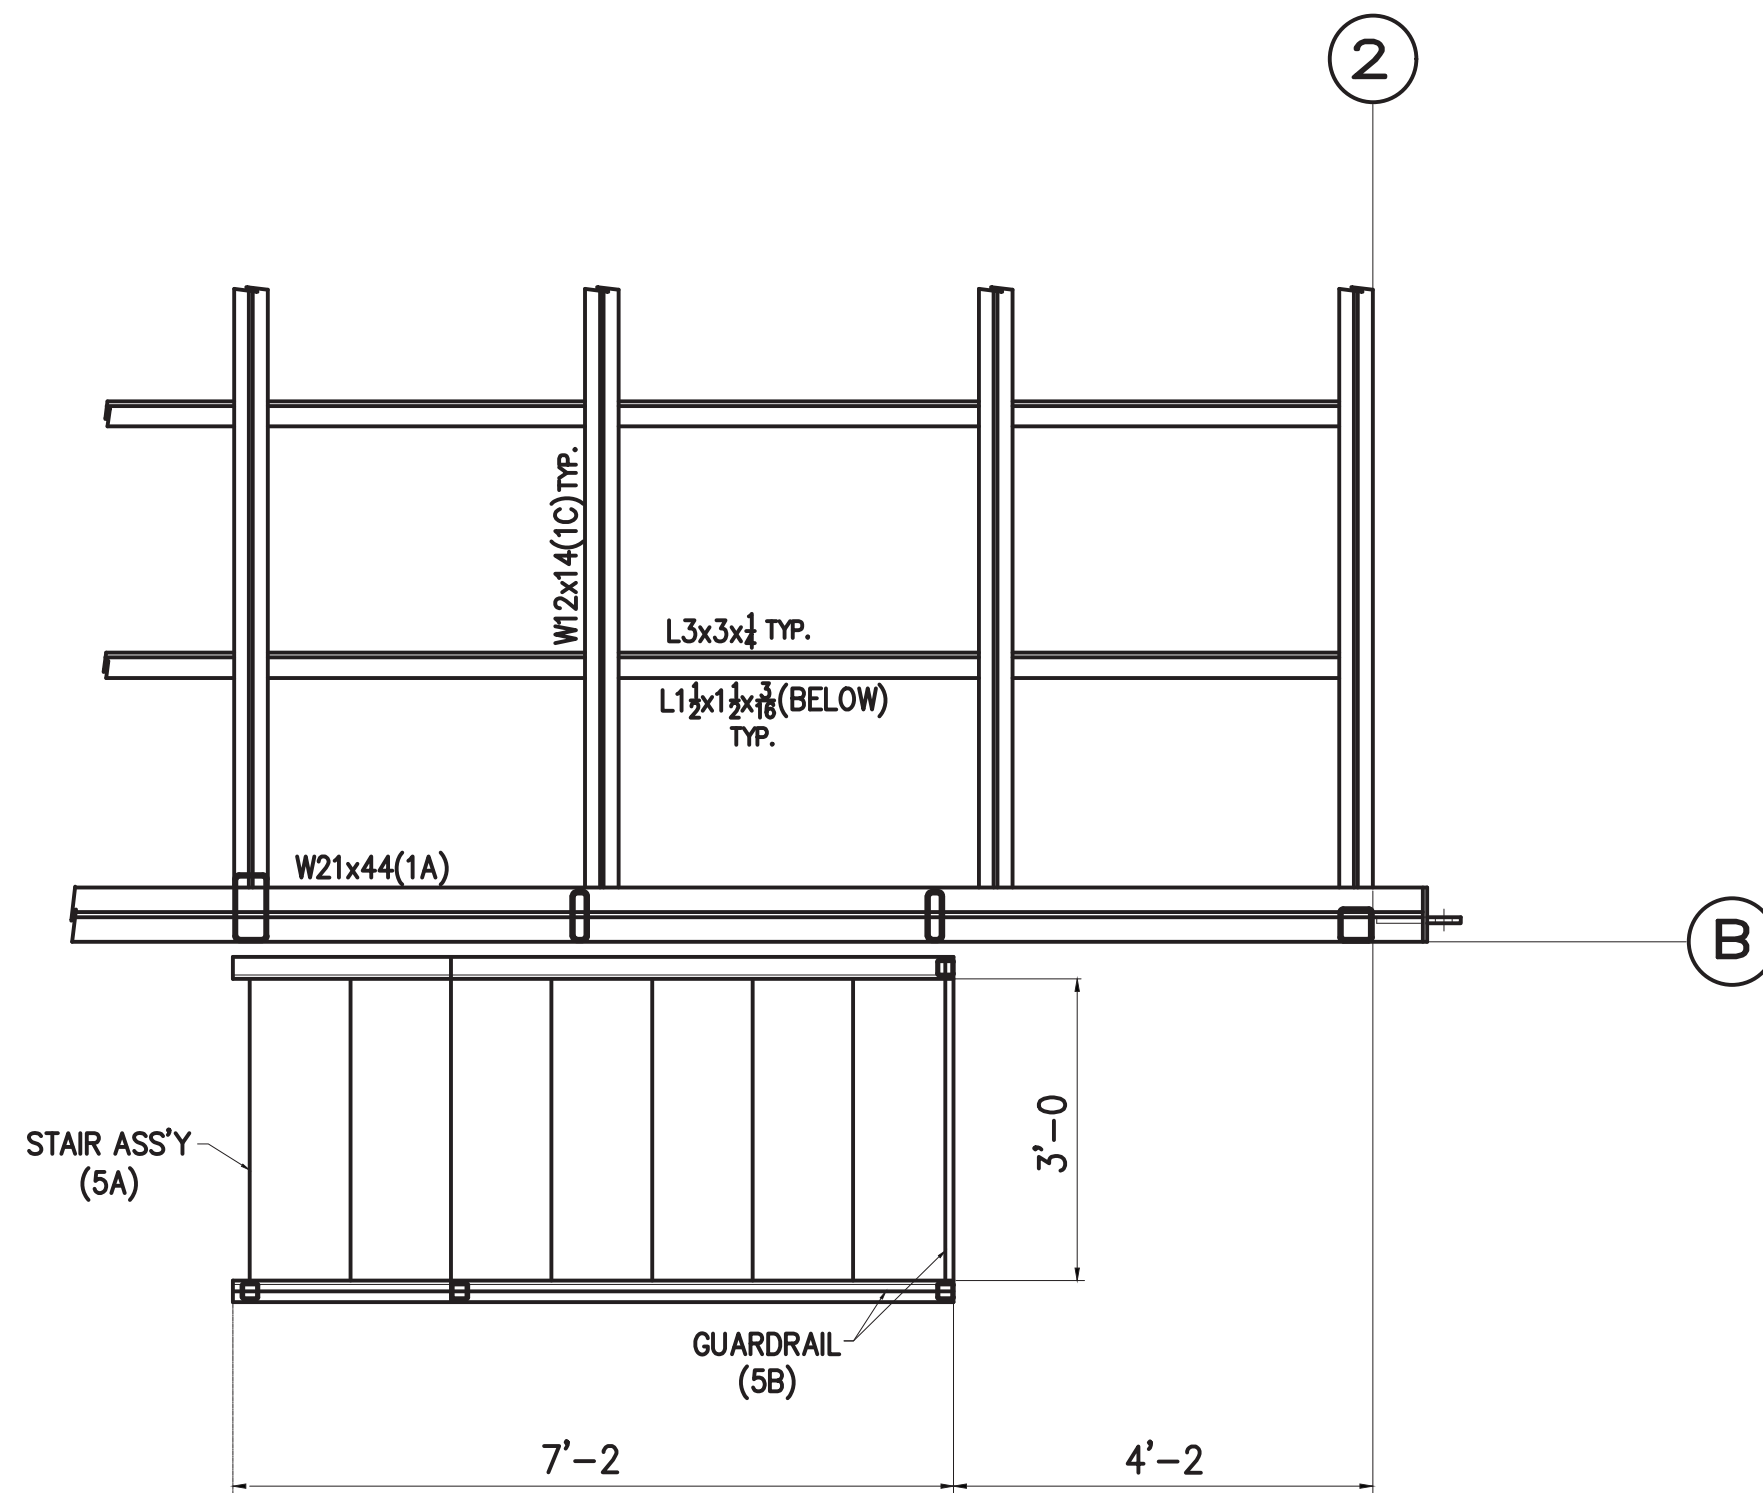

STAIR/PLATFORM FRAMING PLAN

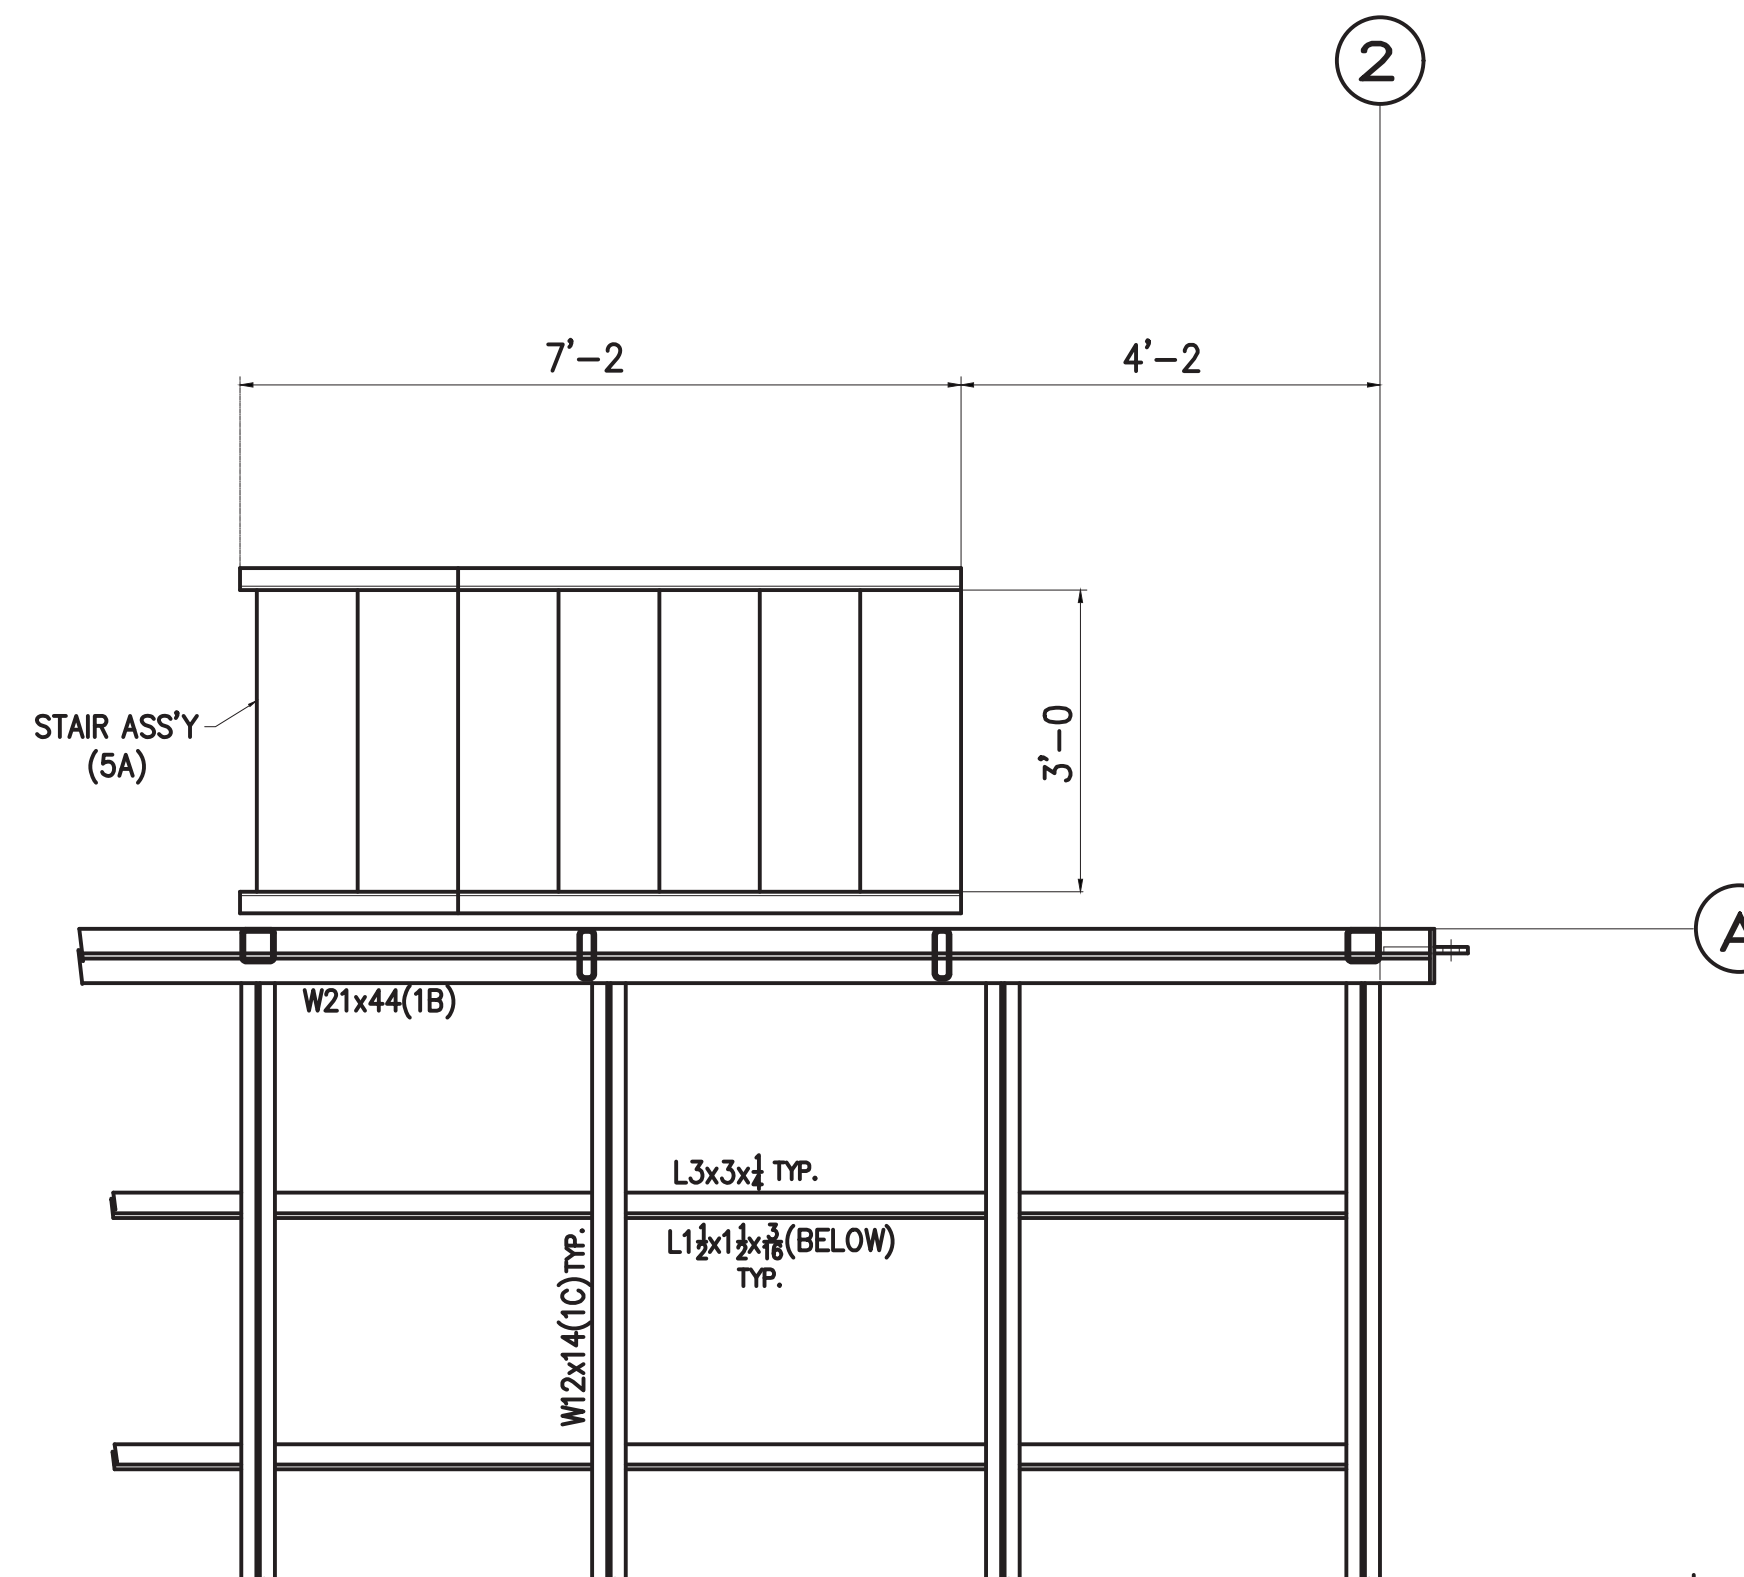

STAIR/PLATFORM FRAMING PLAN

APPROVED
 APPROVED WITH CORRECTIONS NOTED
 REJECTED
 REVISE AND RESUBMIT
 SUBMIT SPECIFIED ITEM
 Submittal review is only for ascertaining general conformance with the Contract Documents. Approval does not relieve the Contractor of responsibility for full compliance with the Contract Documents.


By: *[Signature]* Date: 1-7-19
 Gray Stassel Engineering, Inc.
 PO Box 111405
 Anchorage, AK
 P (907) 349-0100
 F (907) 349-8001

REV. No.	DATE	BY	DESCRIPTION
0	12/28/18	DWH	ISSUED FOR APPROVAL


WEONA CORPORATION
 10501 OLIVE LANE ANCHORAGE, AK 99515
 PHONE: (907) 344-1921
 FAX: (907) 344-8244

CLEANING PAINT BLAST & PAINT PER SPECS.	PROJECT	CUSTOMER	
	CLARKS POINT POWER SYSTEM UPGRADE	ALASKA ENERGY AUTHORITY	
	RADIATOR SUPPORTS & STAIR FRAMING PLANS	DATE	JOB No.
WELDS	3/16" FILLET U.N.O.	12/22/18	
OPEN HOLES	13/16" U.N.O.		DWG. NO. E6

Structural Detailing Services of Alaska 907-336-2220 Fax: 907-336-2231 dholland@aci.net

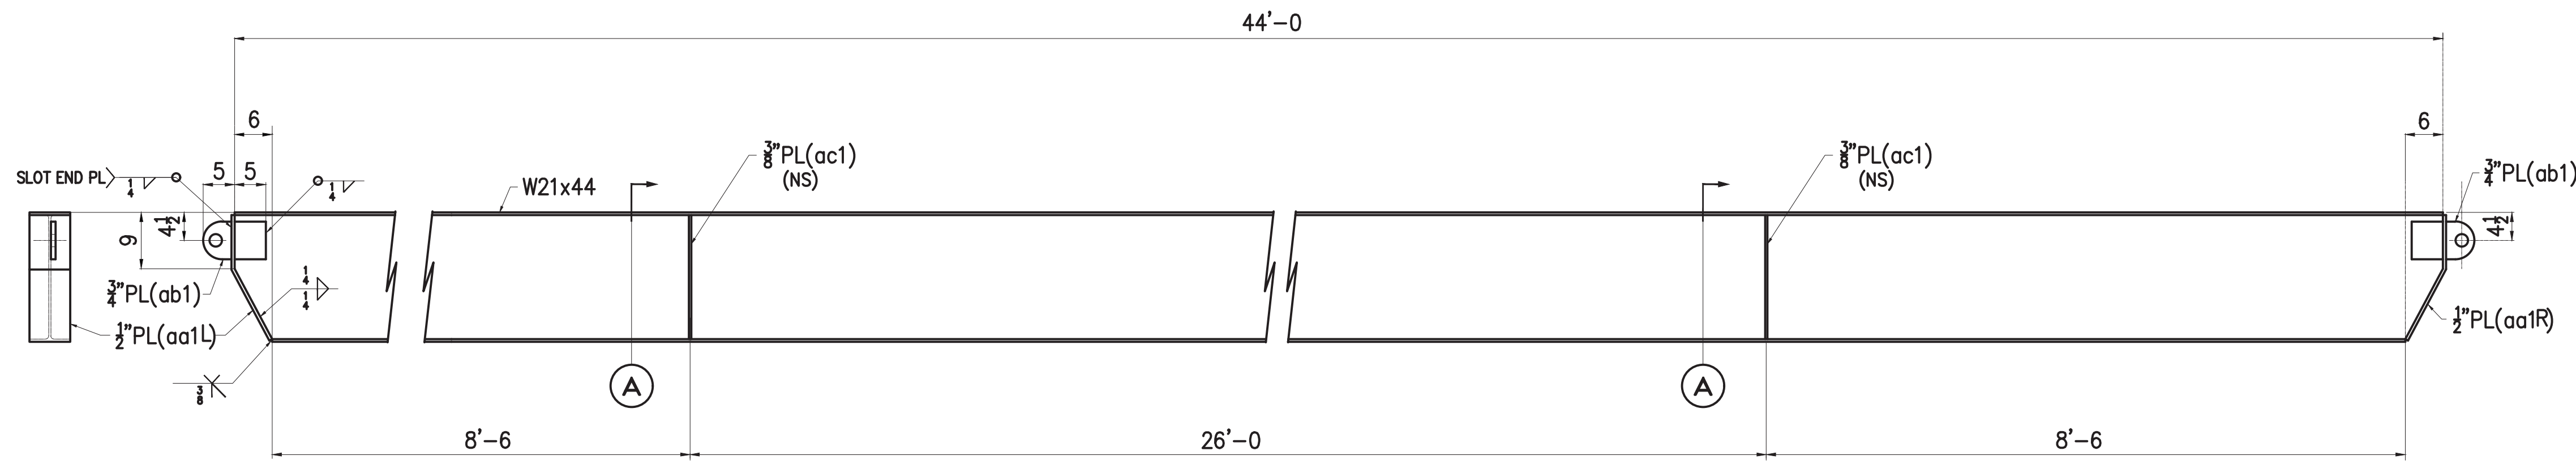

ONE ~ MAIN BEAM ~ 1A



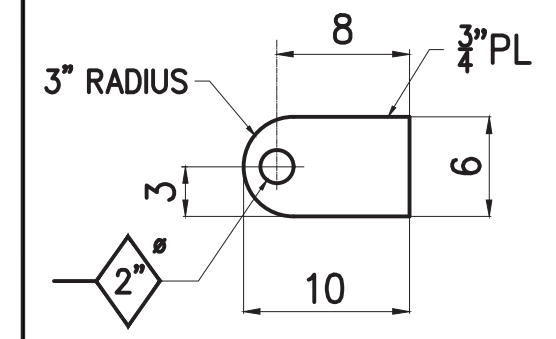



PLATE ~ 'ab1'

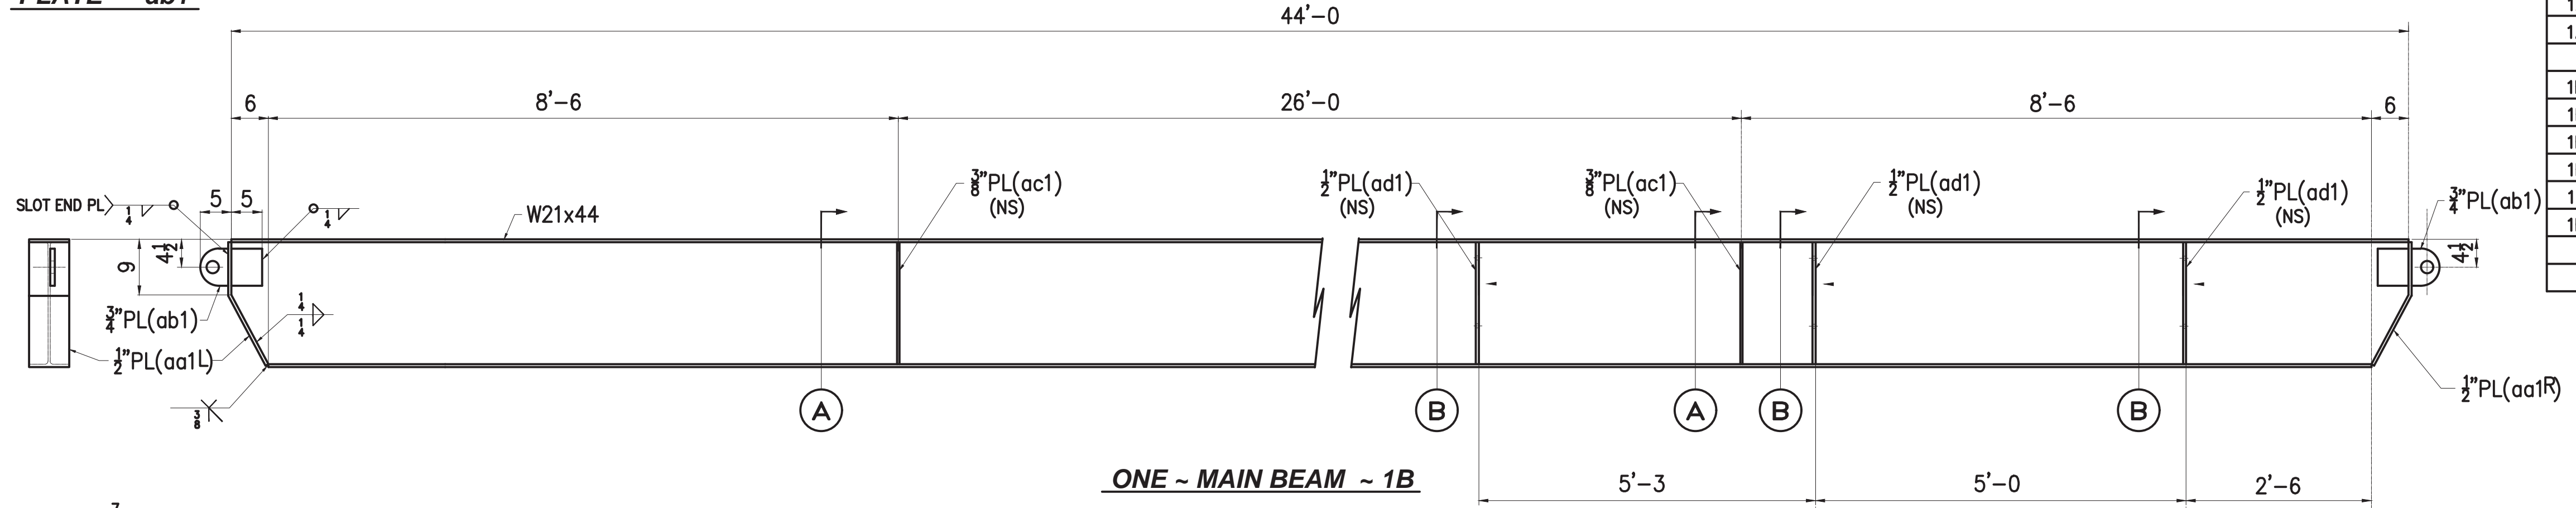


ONE ~ MAIN BEAM ~ 1B

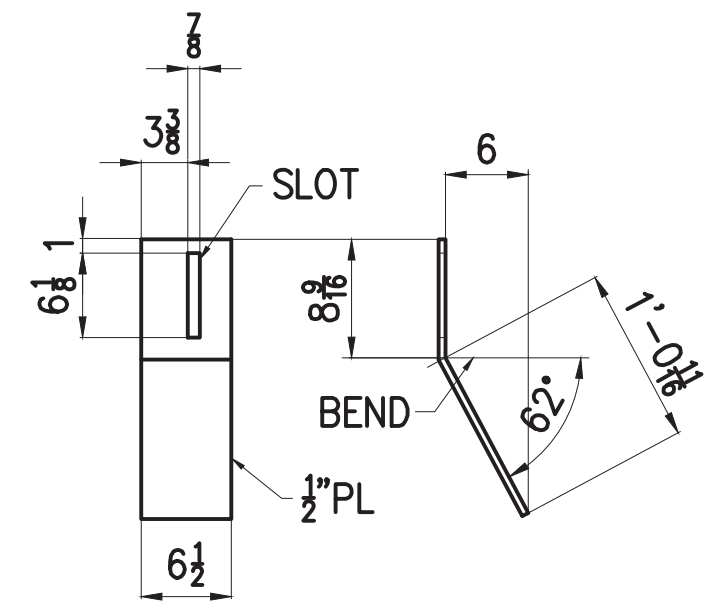

BENT PL ~ 'aa1L' (AS SHOWN)
BENT PL ~ 'aa1R' (OPP. HAND)

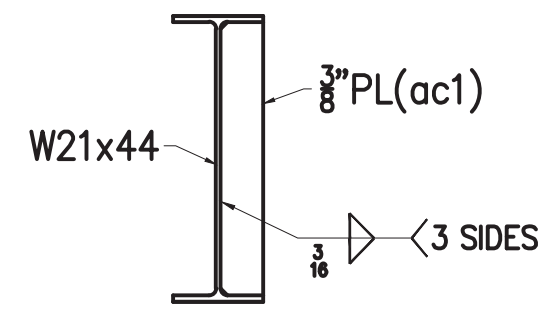

SECTION A

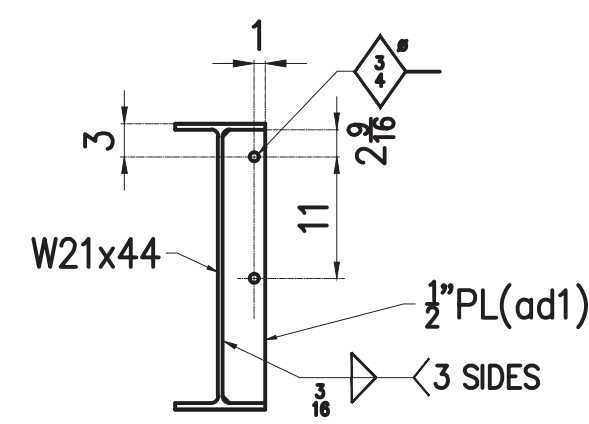


SECTION B

1AA	3'-10 3/4"
1AB	3'-8 3/4"
1AC	3'-7 3/4"
1AD	3'-6 3/4"
1AF	2'-7 3/4"
1AG	2'-2 3/4"

- 8 ea. ~ ANGLES ~ 1AA
- 4 ea. ~ ANGLES ~ 1AB
- 4 ea. ~ ANGLES ~ 1AC
- 16 ea. ~ ANGLES ~ 1AD
- 8 ea. ~ ANGLES ~ 1AF
- 12 ea. ~ ANGLES ~ 1AG

1BA	3'-10 3/4"
1BB	3'-8 3/4"
1BC	3'-7 3/4"
1BD	3'-6 3/4"
1BF	2'-7 3/4"
1BG	2'-2 3/4"

- 8 ea. ~ ANGLES ~ 1BA
- 4 ea. ~ ANGLES ~ 1BB
- 4 ea. ~ ANGLES ~ 1BC
- 16 ea. ~ ANGLES ~ 1BD
- 8 ea. ~ ANGLES ~ 1BF
- 12 ea. ~ ANGLES ~ 1BG

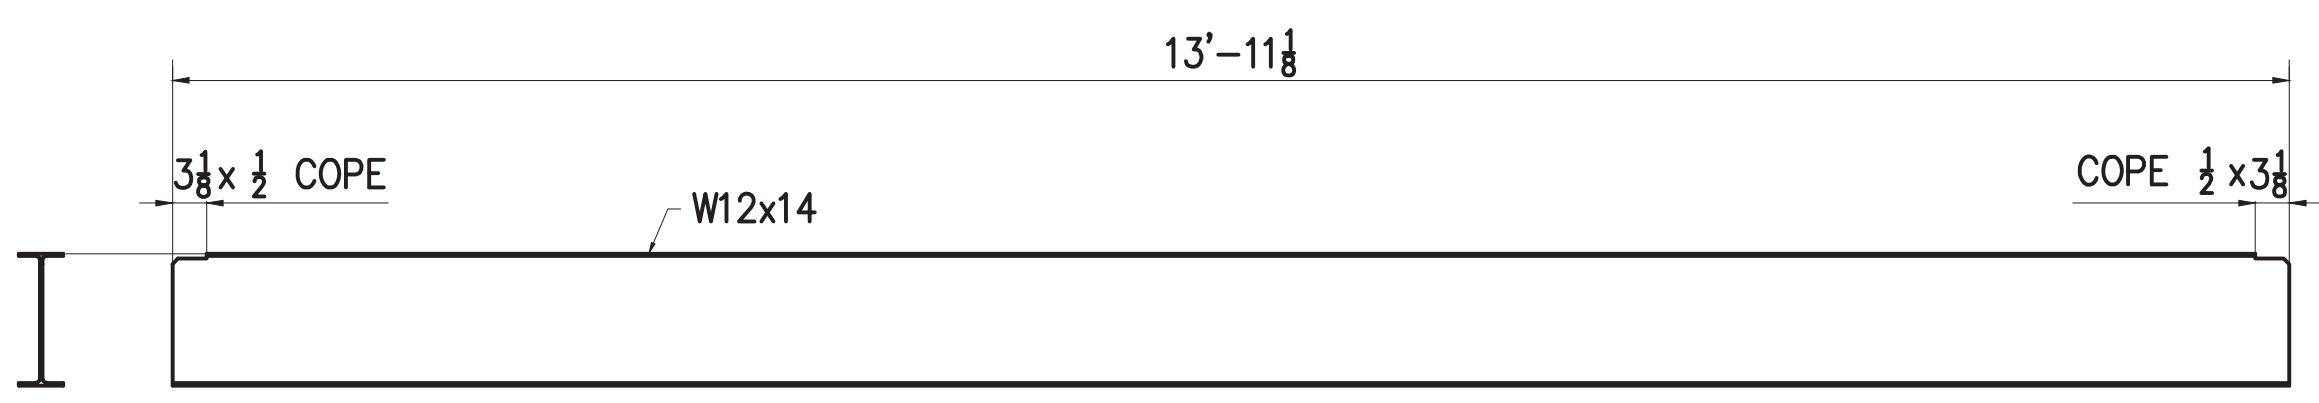

14 ea. ~ CROSS BEAMS ~ 1C

BILL OF MATERIAL

FIELD MARK	SHOP MARK	NO. PCS	SECTION	LENGTH	REMARKS	WT
1A		ONE	MAIN BEAM			
1A	ONE	W21 x 44		44'-0"		
aa1L	2	PL 1/2 x 6 1/2 BENT		1'-9 1/4"	1 LEFT/1 RIGHT	
ab1	2	PL 3/4 x 6		10	RADIUS	
ac1	2	PL 3/8 x 3 1/8		1'-7 3/4"	STIFF. PL	
1B		ONE	MAIN BEAM			
1B	ONE	W21 x 44		44'-0"		
aa1L	2	PL 1/2 x 6 1/2 BENT		1'-9 1/4"	1 LEFT/1 RIGHT	
ab1	2	PL 3/4 x 6		10	RADIUS	
ac1	2	PL 3/8 x 3 1/8		1'-7 3/4"	STIFF. PL	
ad1	3	PL 1/2 x 3 1/8		1'-7 3/4"	CONN. PL	
1C		14	CROSS BEAMS			
1C	14	W12 x 14		13'-11 1/8"	COPE ENDS	
			ANGLES			
1AA	8	L3 x 3 x 1/4		3'-10 3/4"	COPE ENDS	
1AB	4	L3 x 3 x 1/4		3'-8 3/4"	do	
1AC	4	L3 x 3 x 1/4		3'-7 3/4"		
1AD	16	L3 x 3 x 1/4		3'-6 3/4"		
1AF	8	L3 x 3 x 1/4		2'-7 3/4"		
1AG	12	L3 x 3 x 1/4		2'-2 3/4"		
1BA	8	L1 1/2 x 1 1/2 x 3/16		3'-10 3/4"	COPE ENDS	
1BB	4	L1 1/2 x 1 1/2 x 3/16		3'-8 3/4"	do	
1BC	4	L1 1/2 x 1 1/2 x 3/16		3'-7 3/4"		
1BD	16	L1 1/2 x 1 1/2 x 3/16		3'-6 3/4"		
1BF	8	L1 1/2 x 1 1/2 x 3/16		2'-7 3/4"		
1BG	12	L1 1/2 x 1 1/2 x 3/16		2'-2 3/4"		

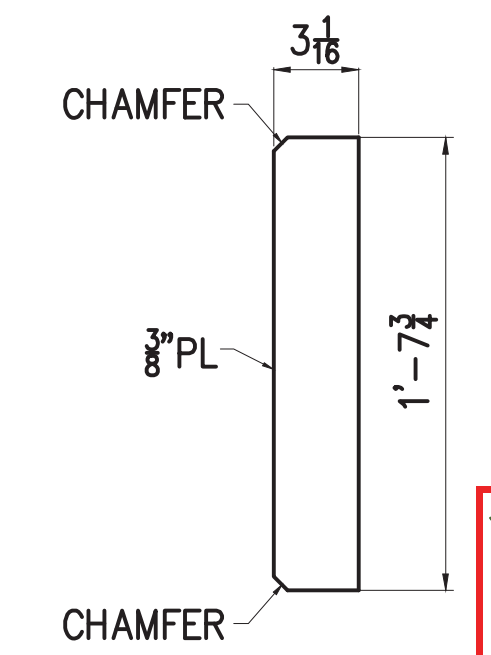



PLATE ~ 'ac1'

APPROVED
 APPROVED WITH CORRECTIONS NOTED
 REJECTED
 REVISE AND RESUBMIT
 SUBMIT SPECIFIED ITEM

Submittal review is only for ascertaining general conformance with the Contract Documents. Approval does not relieve the Contractor of responsibility for full compliance with the Contract Documents.

By: *[Signature]* Date: 1-7-19
 Gray Stassel Engineering, Inc.
 PO Box 111405
 Anchorage, AK
 P (907) 349-0100
 F (907) 349-8001

REV. No.	DATE	BY	DESCRIPTION
0	12/28/18	DWH	ISSUED FOR APPROVAL




WEONA CORPORATION
10501 OLIVE LANE
ANCHORAGE, AK 99515


PHONE: (907) 344-1921
FAX: (907) 344-8244

PROJECT CLARKS POINT POWER SYSTEM UPGRADE	CUSTOMER ALASKA ENERGY AUTHORITY
CLEANING PAINT BLAST & PAINT PER SPECS.	DATE 12/22/18
WELDS 3/16" FILLET U.N.O.	JOB No.
OPEN HOLES 13/16" U.N.O.	DWG. No. D1


Structural Detailing Services of Alaska 907-336-2220 Fax: 907-336-2231 dtholland@pci.net

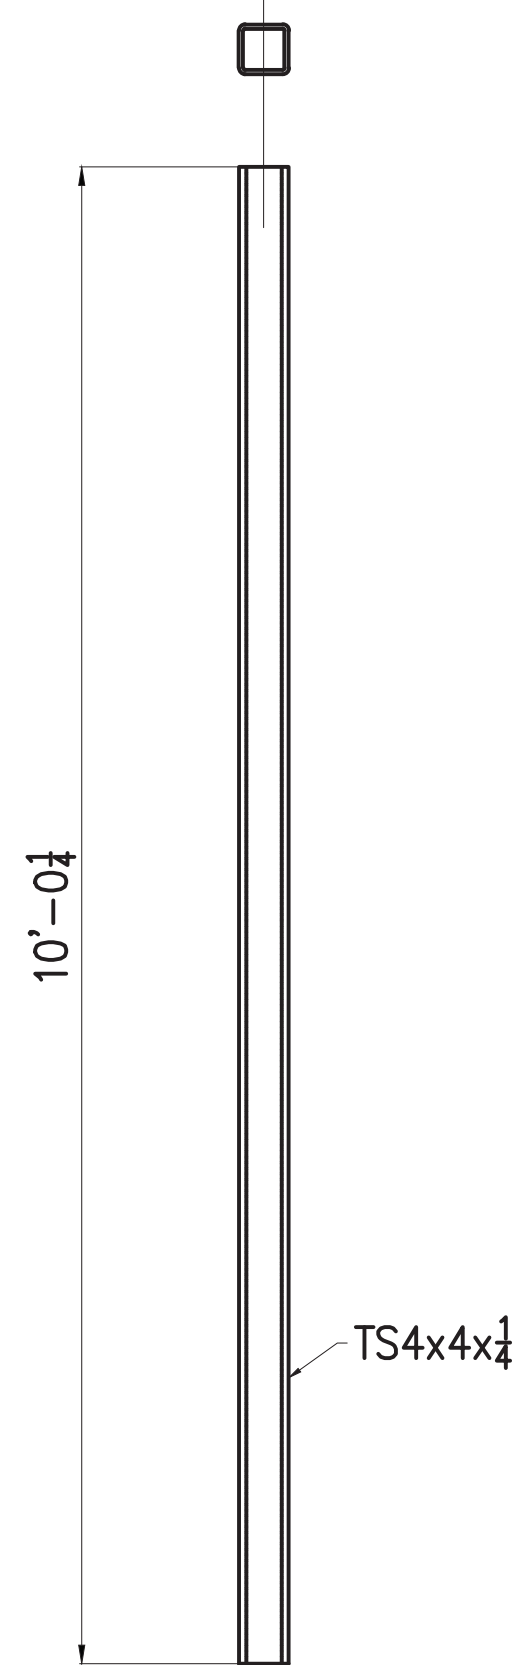


6 ea. ~ TS POSTS ~ 2A

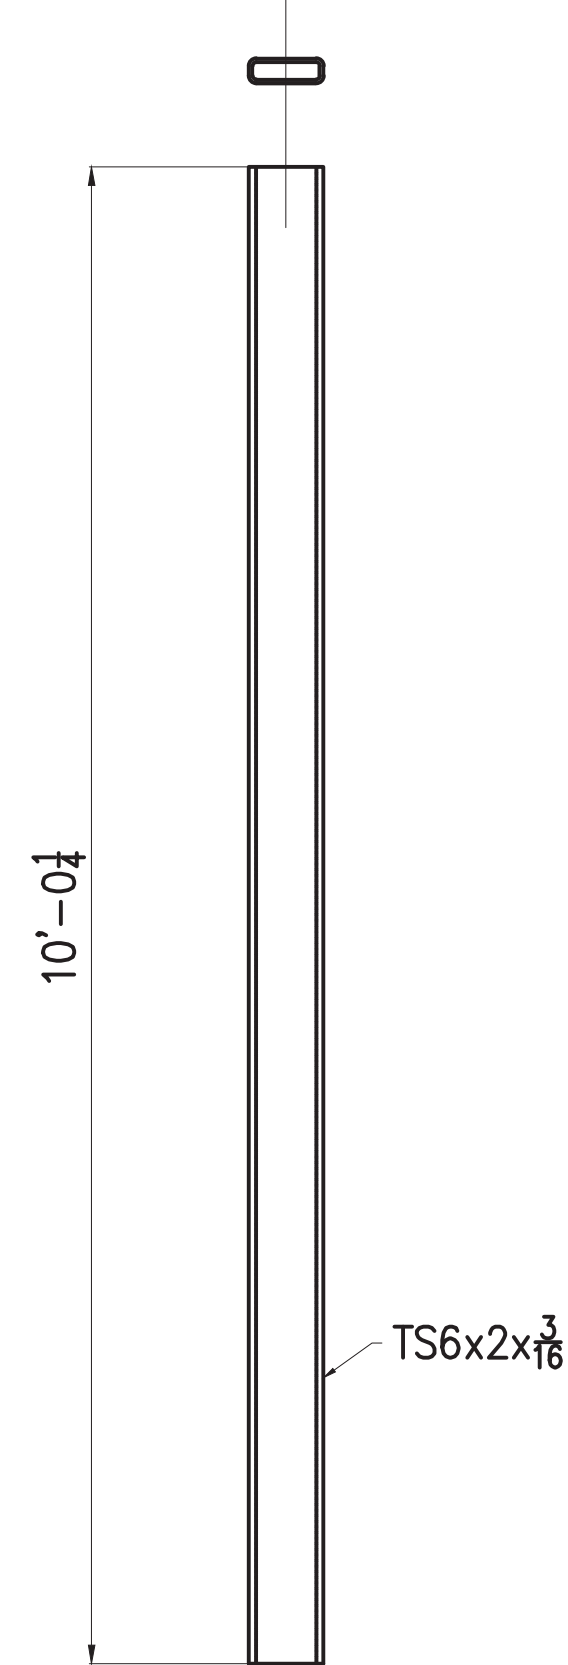


8 ea. ~ TS POSTS ~ 2B

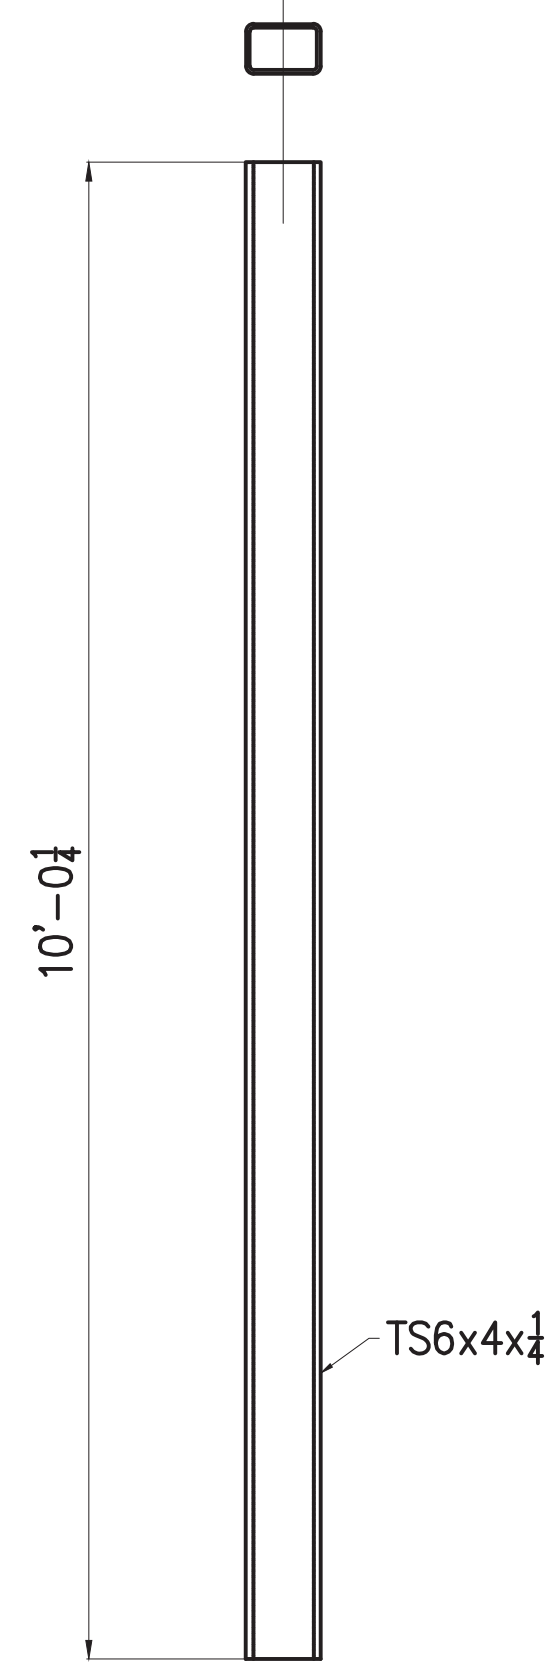

ONE ~ TS POST ~ 2C

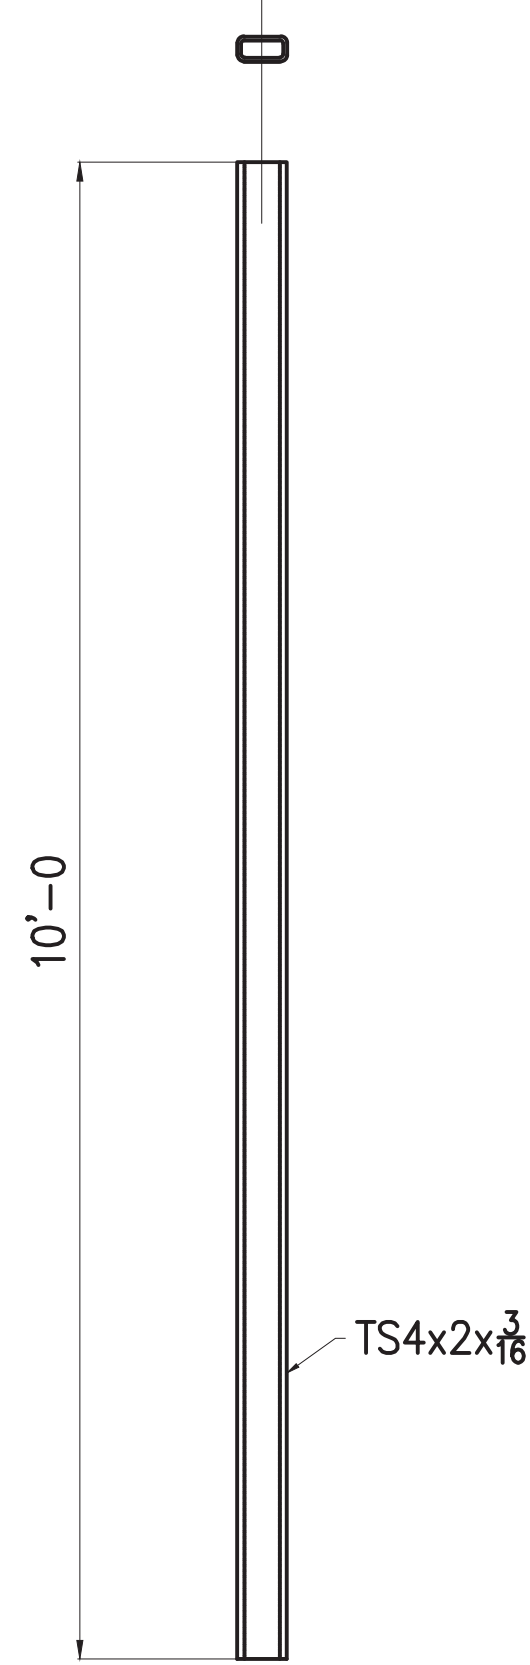


2 ea. ~ TS POSTS ~ 2D

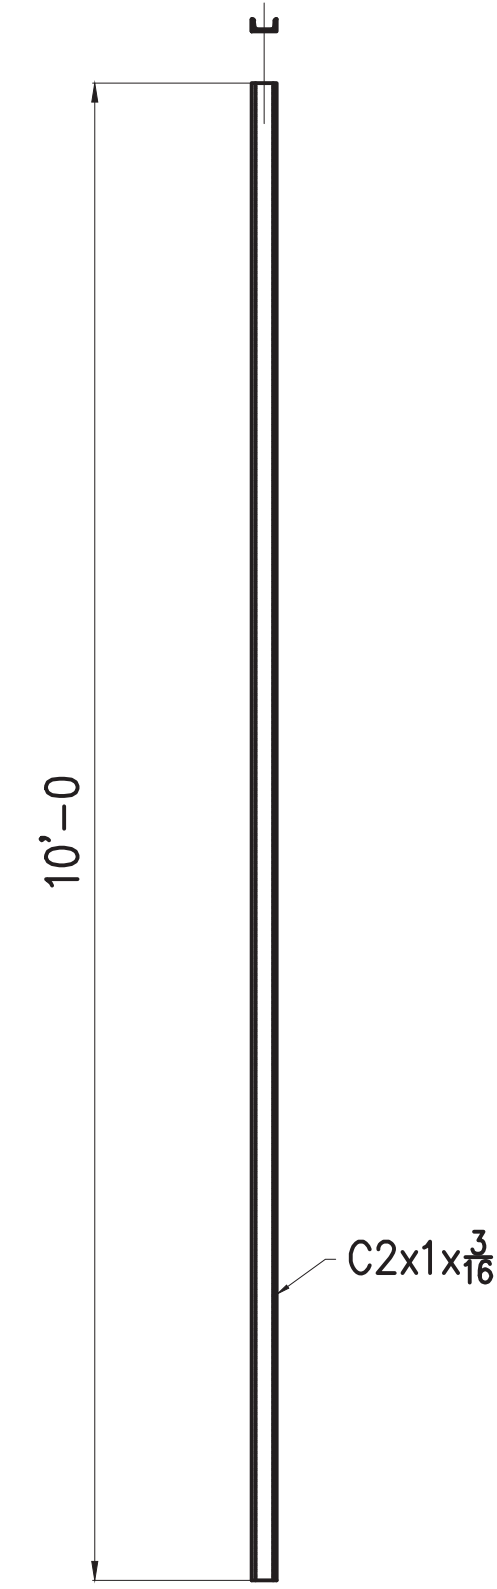


56 ea. ~ CHANNELS ~ 2F

BILL OF MATERIAL


FIELD MARK	SHOP MARK	NO. PCS	SECTION	LENGTH	REMARKS	WT
2A		6	TS POSTS			
	2A	6	TS4 x 4 x 1/4	10'-0 1/4		
2B		8	TS POSTS			
	2B	8	TS6 x 2 x 3/16	10'-0 1/4		
2C		ONE	TS POST			
	2C	ONE	TS6 x 4 x 1/4	10'-0 1/4		
2D		2	TS POSTS			
	2D	2	TS4 x 2 x 3/16	10'-0		
2F		56	CHANNELS			
	2F	56	C2 x 1 x 3/16	10'-0		
2G		2	TS HEADER			
	2G	2	TS6 x 2 x 3/16	3'-10 3/8		
2H		2	TS HEADER			
	2H	2	TS6 x 2 x 3/16	3'-4 3/8		
2J		2	WINDOW TUBE			
	2J	2	TS6 x 2 x 3/16	3'-0 1/4		
2K		ONE	TS HEADER			
	2K	ONE	TS4 x 2 x 3/16	3'-4 3/8		
2L		2	WINDOW TUBE			
	2L	2	TS4 x 2 x 3/16	3'-0 1/4		

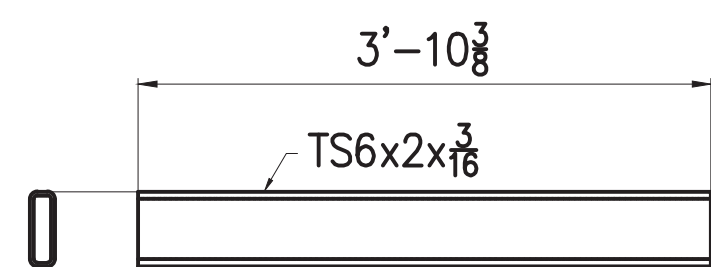


2 ea. ~ HEADER TUBE ~ 2G

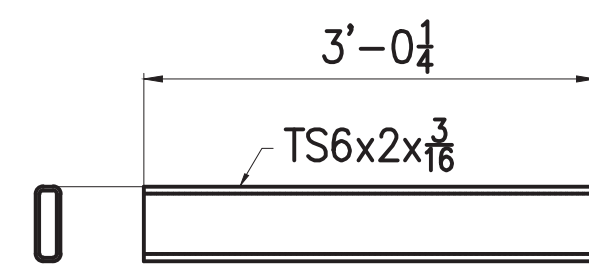


2 ea. ~ WINDOW TUBE ~ 2J

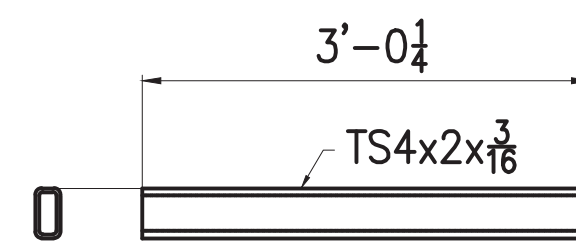

2 ea. ~ WINDOW TUBE ~ 2L

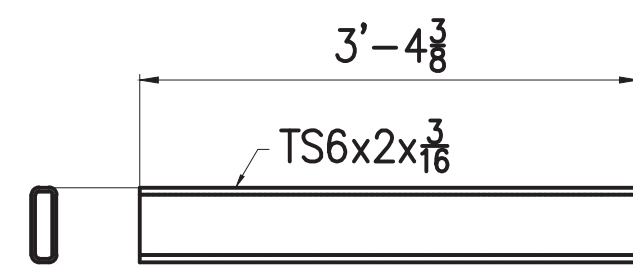

2 ea. ~ HEADER TUBE ~ 2H

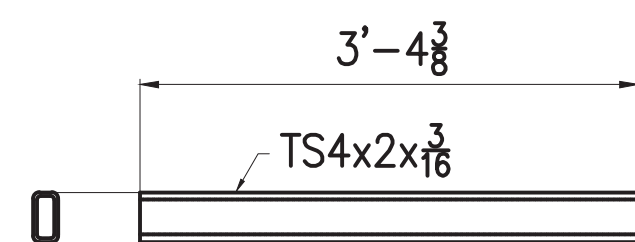

ONE ~ HEADER TUBE ~ 2K


APPROVED
 APPROVED WITH CORRECTIONS NOTED
 REJECTED
 REVISE AND RESUBMIT
 SUBMIT SPECIFIED ITEM
 Submittal review is only for ascertaining general conformance with the Contract Documents. Approval does not relieve the Contractor of responsibility for full compliance with the Contract Documents.
 By: *[Signature]* Date: **1-7-19**
 Gray Stassel Engineering, Inc.
 PO Box 111405
 Anchorage, AK
 P (907) 349-0100
 F (907) 349-8001

1	1/4/19	DWH	REVISED 2A, 2D, 2L
0	12/28/18	DWH	ISSUED FOR APPROVAL
REV. No.	DATE	BY	DESCRIPTION



WEONA CORPORATION
 10501 OLIVE LANE ANCHORAGE, AK 99515
 PHONE: (907) 344-1921 FAX: (907) 344-8244

CLEANING PAINT	BLAST & PAINT PER SPECS.	PROJECT	CLARKS POINT POWER SYSTEM UPGRADE	CUSTOMER	ALASKA ENERGY AUTHORITY
WELDS	3/16" FILLET U.N.O.	DATE	12/22/18	JOB No.	
OPEN HOLES	13/16" U.N.O.	DATE	12/22/18	DWG. NO.	D2


Structural Detailing Services of Alaska 907-336-2220 Fax: 907-336-2220 dholland@pci.net

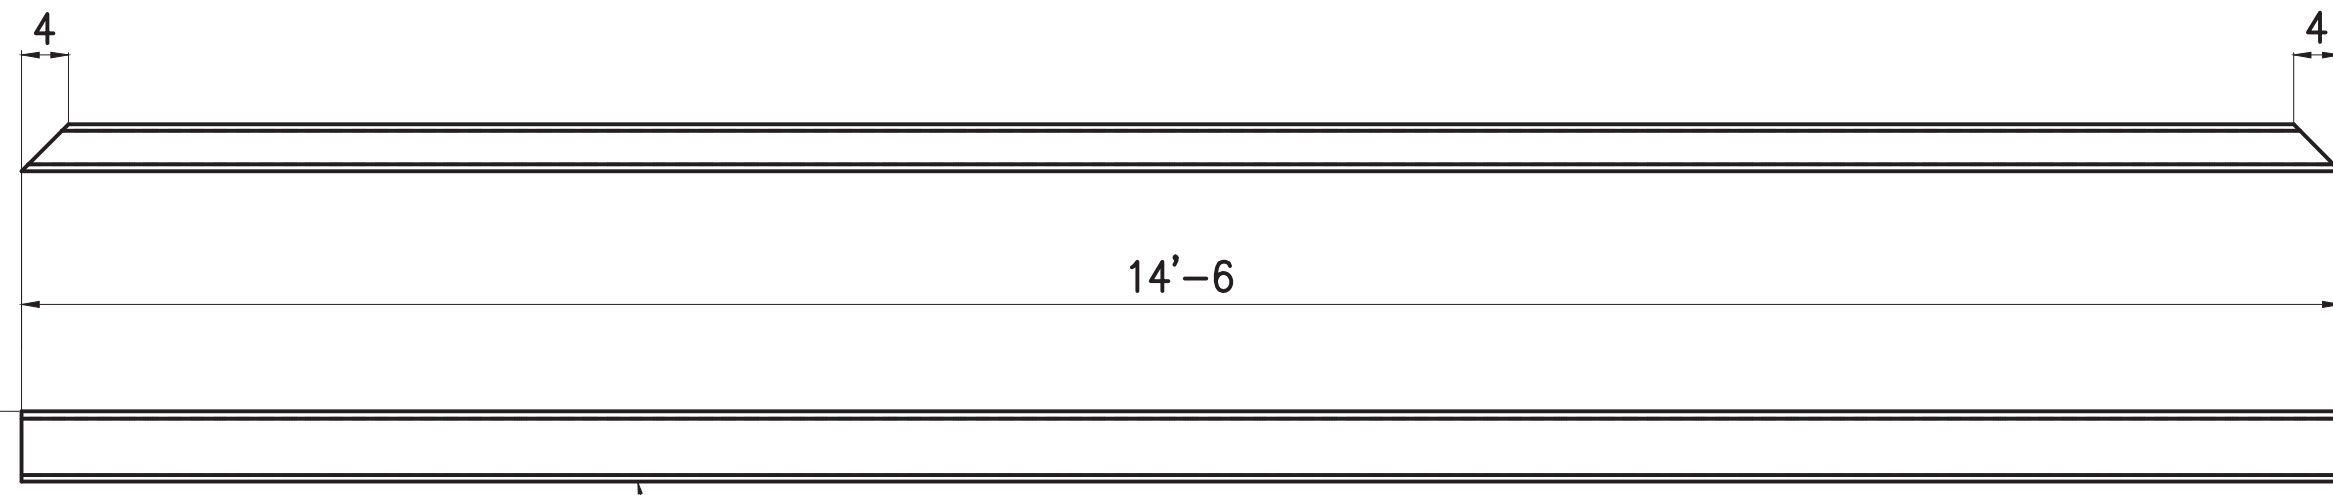


TS6x4x $\frac{1}{4}$
2 ea. ~ CEILING TUBE ~ 3C

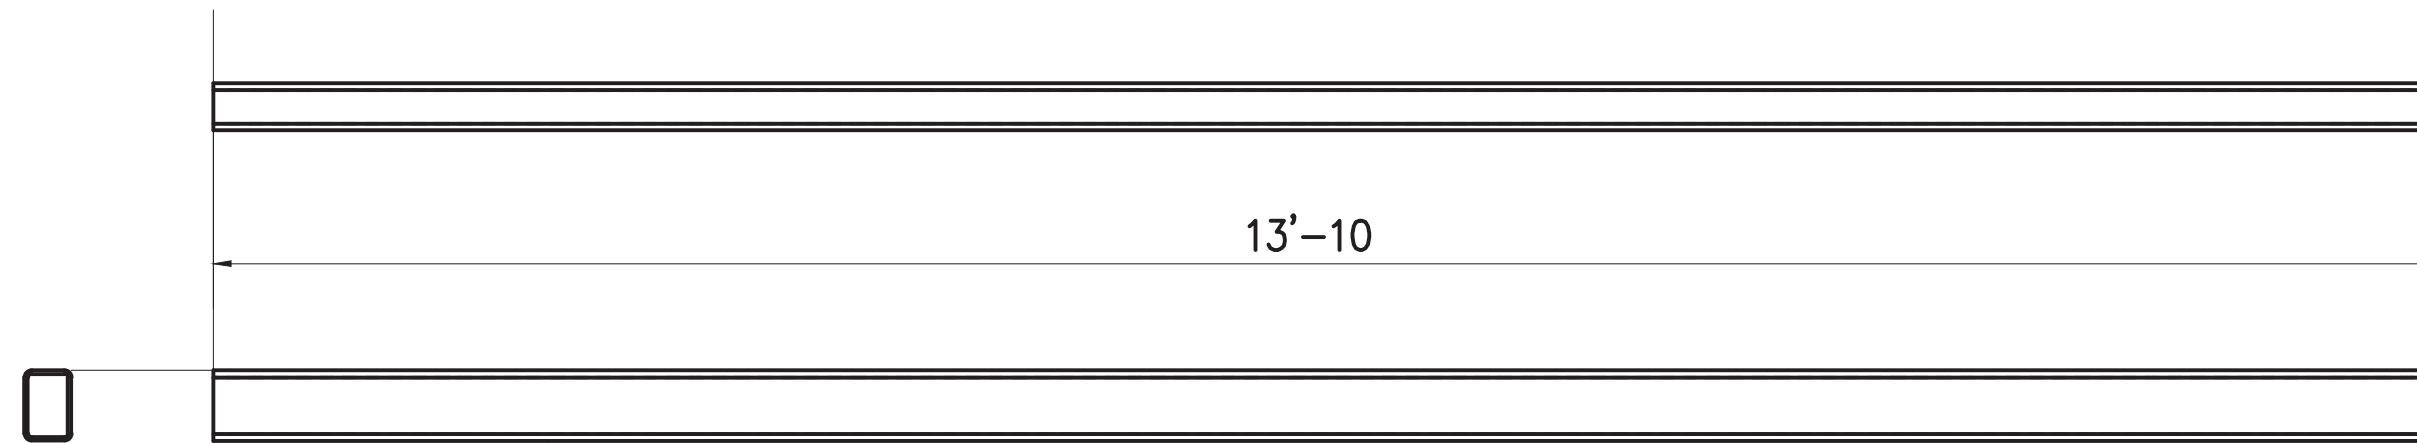


TS6x4x $\frac{1}{4}$
ONE ~ CEILING TUBE ~ 3D

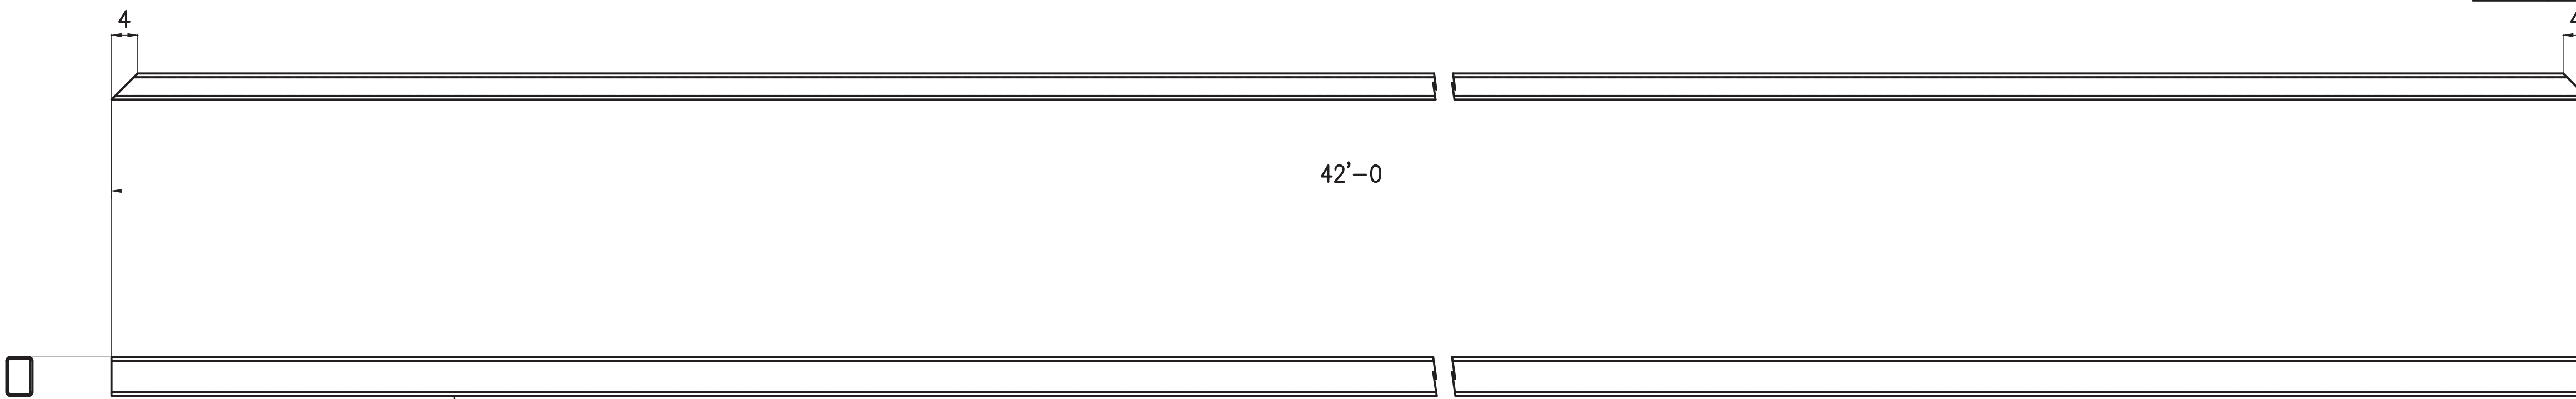


TS6x4x $\frac{1}{4}$
ONE ~ CEILING TUBE ~ 3A

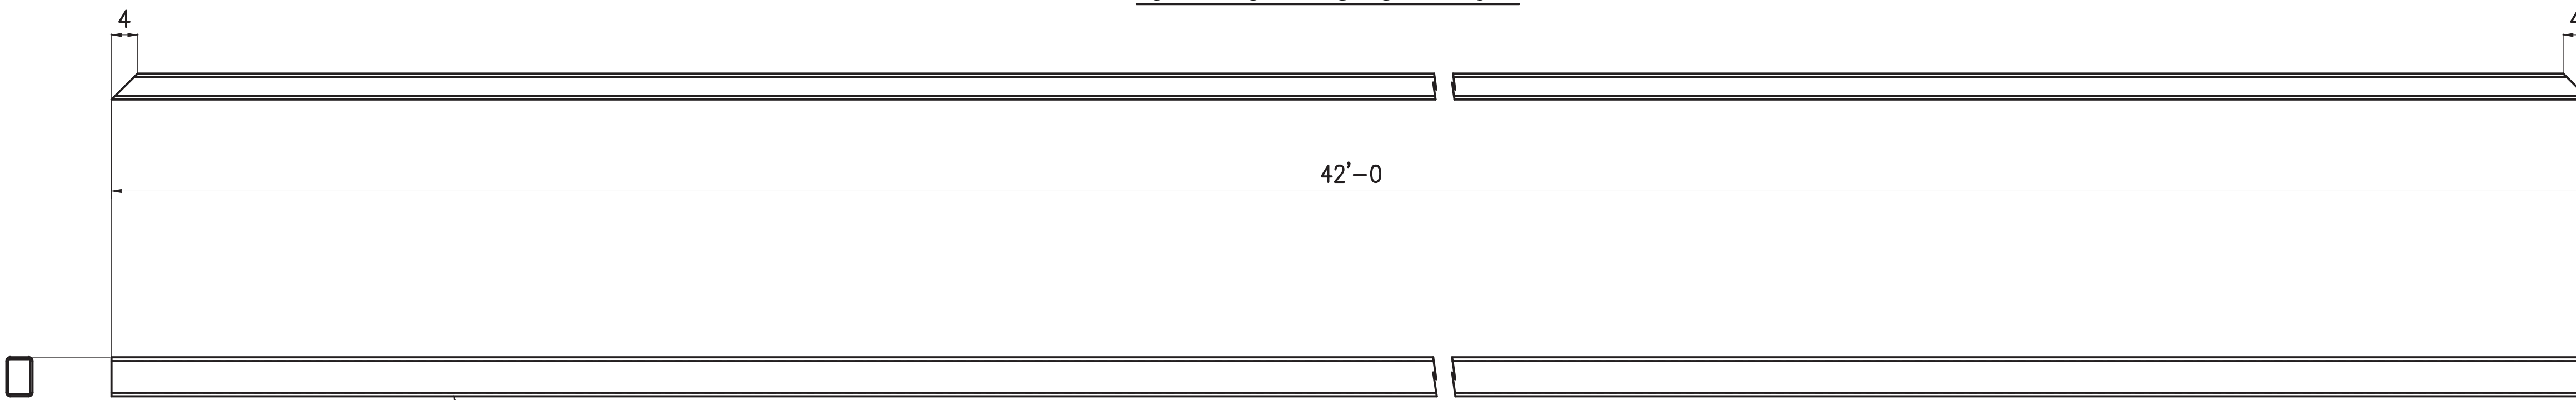

TS6x4x $\frac{1}{4}$
ONE ~ CEILING TUBE ~ 3B

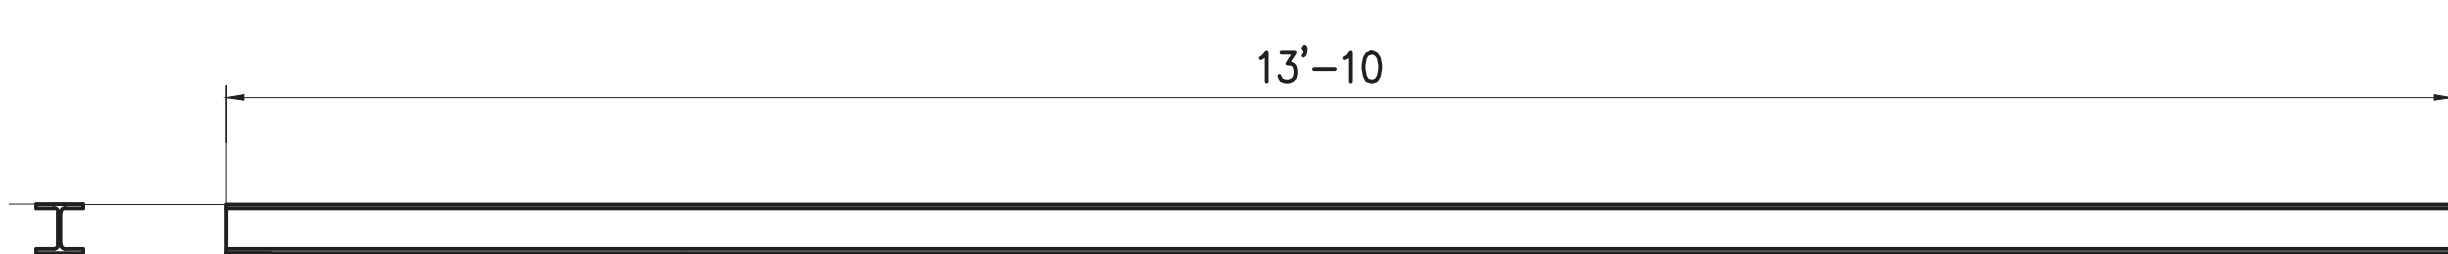

W4x13
6 ea. ~ CEILING BEAM ~ 3F



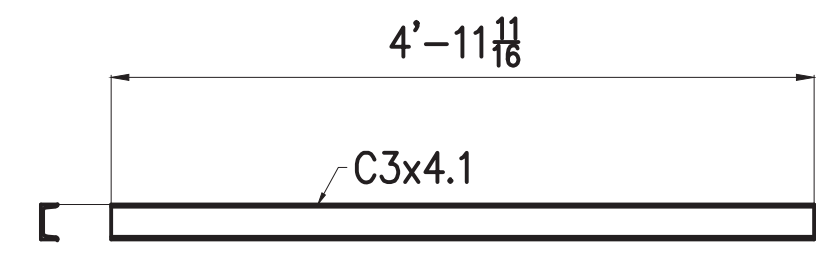


C3x4.1
6 ea. ~ CHANNELS ~ 3BB

APPROVED
 APPROVED WITH CORRECTIONS NOTED
 REJECTED
 REVISE AND RESUBMIT
 SUBMIT SPECIFIED ITEM
 Submittal review is only for ascertaining general conformance with the Contract Documents. Approval does not relieve the Contractor of responsibility for full compliance with the Contract Documents.
 By: *[Signature]* Date: 1-7-19
 Gray Stassel Engineering, Inc.
 PO Box 111405
 Anchorage, AK
 P (907) 349-0100
 F (907) 349-8001

BILL OF MATERIAL

FIELD MARK	SHOP MARK	NO. PCS	SECTION	LENGTH	REMARKS	WT
3A		ONE	CEILING TUBE			
	3A	ONE	TS6 x 4 x $\frac{1}{4}$	42'-0	MC2E	
3B		ONE	CEILING TUBE			
	3B	ONE	TS6 x 4 x $\frac{1}{4}$	42'-0	MC2E	
3C		2	CEILING TUBE			
	3C	2	TS6 x 4 x $\frac{1}{4}$	14'-6	MC2E	
3D		ONE	CEILING TUBE			
	3D	ONE	TS6 x 4 x $\frac{1}{4}$	13'-10		
3F		6	CEILING BEAM			
	3F	6	W4 x 13	13'-10		
			SUPPORT ANGLES			
	3AA	14	L1 $\frac{1}{2}$ x 1 $\frac{1}{2}$ x $\frac{3}{8}$	4'-11 $\frac{11}{16}$	COPE 2 ENDS	
	3AB	8	L1 $\frac{1}{2}$ x 1 $\frac{1}{2}$ x $\frac{3}{8}$	5'-7 $\frac{13}{16}$	COPE 1 END	
	3AC	4	L1 $\frac{1}{2}$ x 1 $\frac{1}{2}$ x $\frac{3}{8}$	4'-7 $\frac{13}{16}$	COPE 1 END	
	3AD	4	L1 $\frac{1}{2}$ x 1 $\frac{1}{2}$ x $\frac{3}{8}$	4'-11 $\frac{13}{16}$	COPE 1 END	
			SUPPORT CHANNEL			
	3BB	6	C3 x 4.1	4'-11 $\frac{11}{16}$		

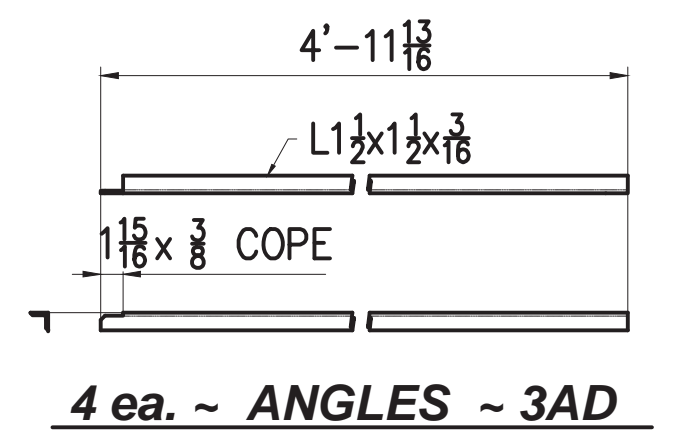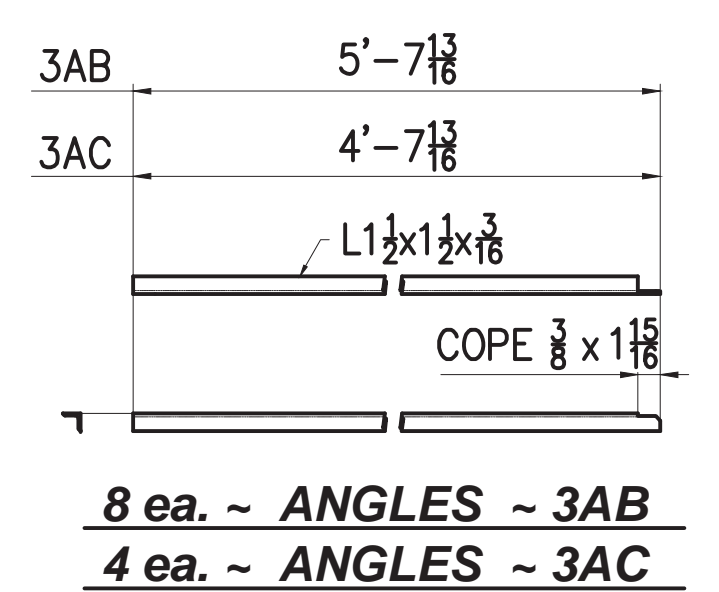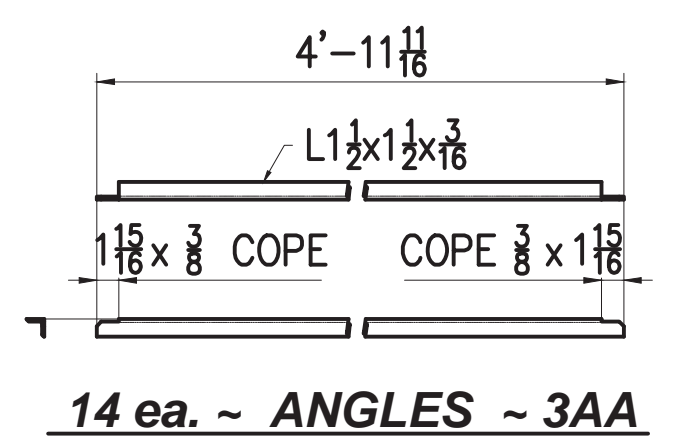


0	12/28/18	DWH	ISSUED FOR APPROVAL
REV. No.	DATE	BY	DESCRIPTION

WEONA CORPORATION
 10501 OLIVE LANE ANCHORAGE, AK 99515
 PHONE: (907) 344-1921 FAX: (907) 344-8244


CLEANING PAINT	BLAST & PAINT PER SPECS.
WELDS	3/16" FILLET U.N.O.
OPEN HOLES	13/16" U.N.O.

PROJECT	CLARKS POINT POWER SYSTEM UPGRADE	CUSTOMER	ALASKA ENERGY AUTHORITY
CEILING TUBE DETAILS		DATE	12/22/18
		JOB No.	
		DWG. NO.	D3


Structural Detailing Services of Alaska 907-336-2220 Fax: 907-336-2231 dholand@pci.net

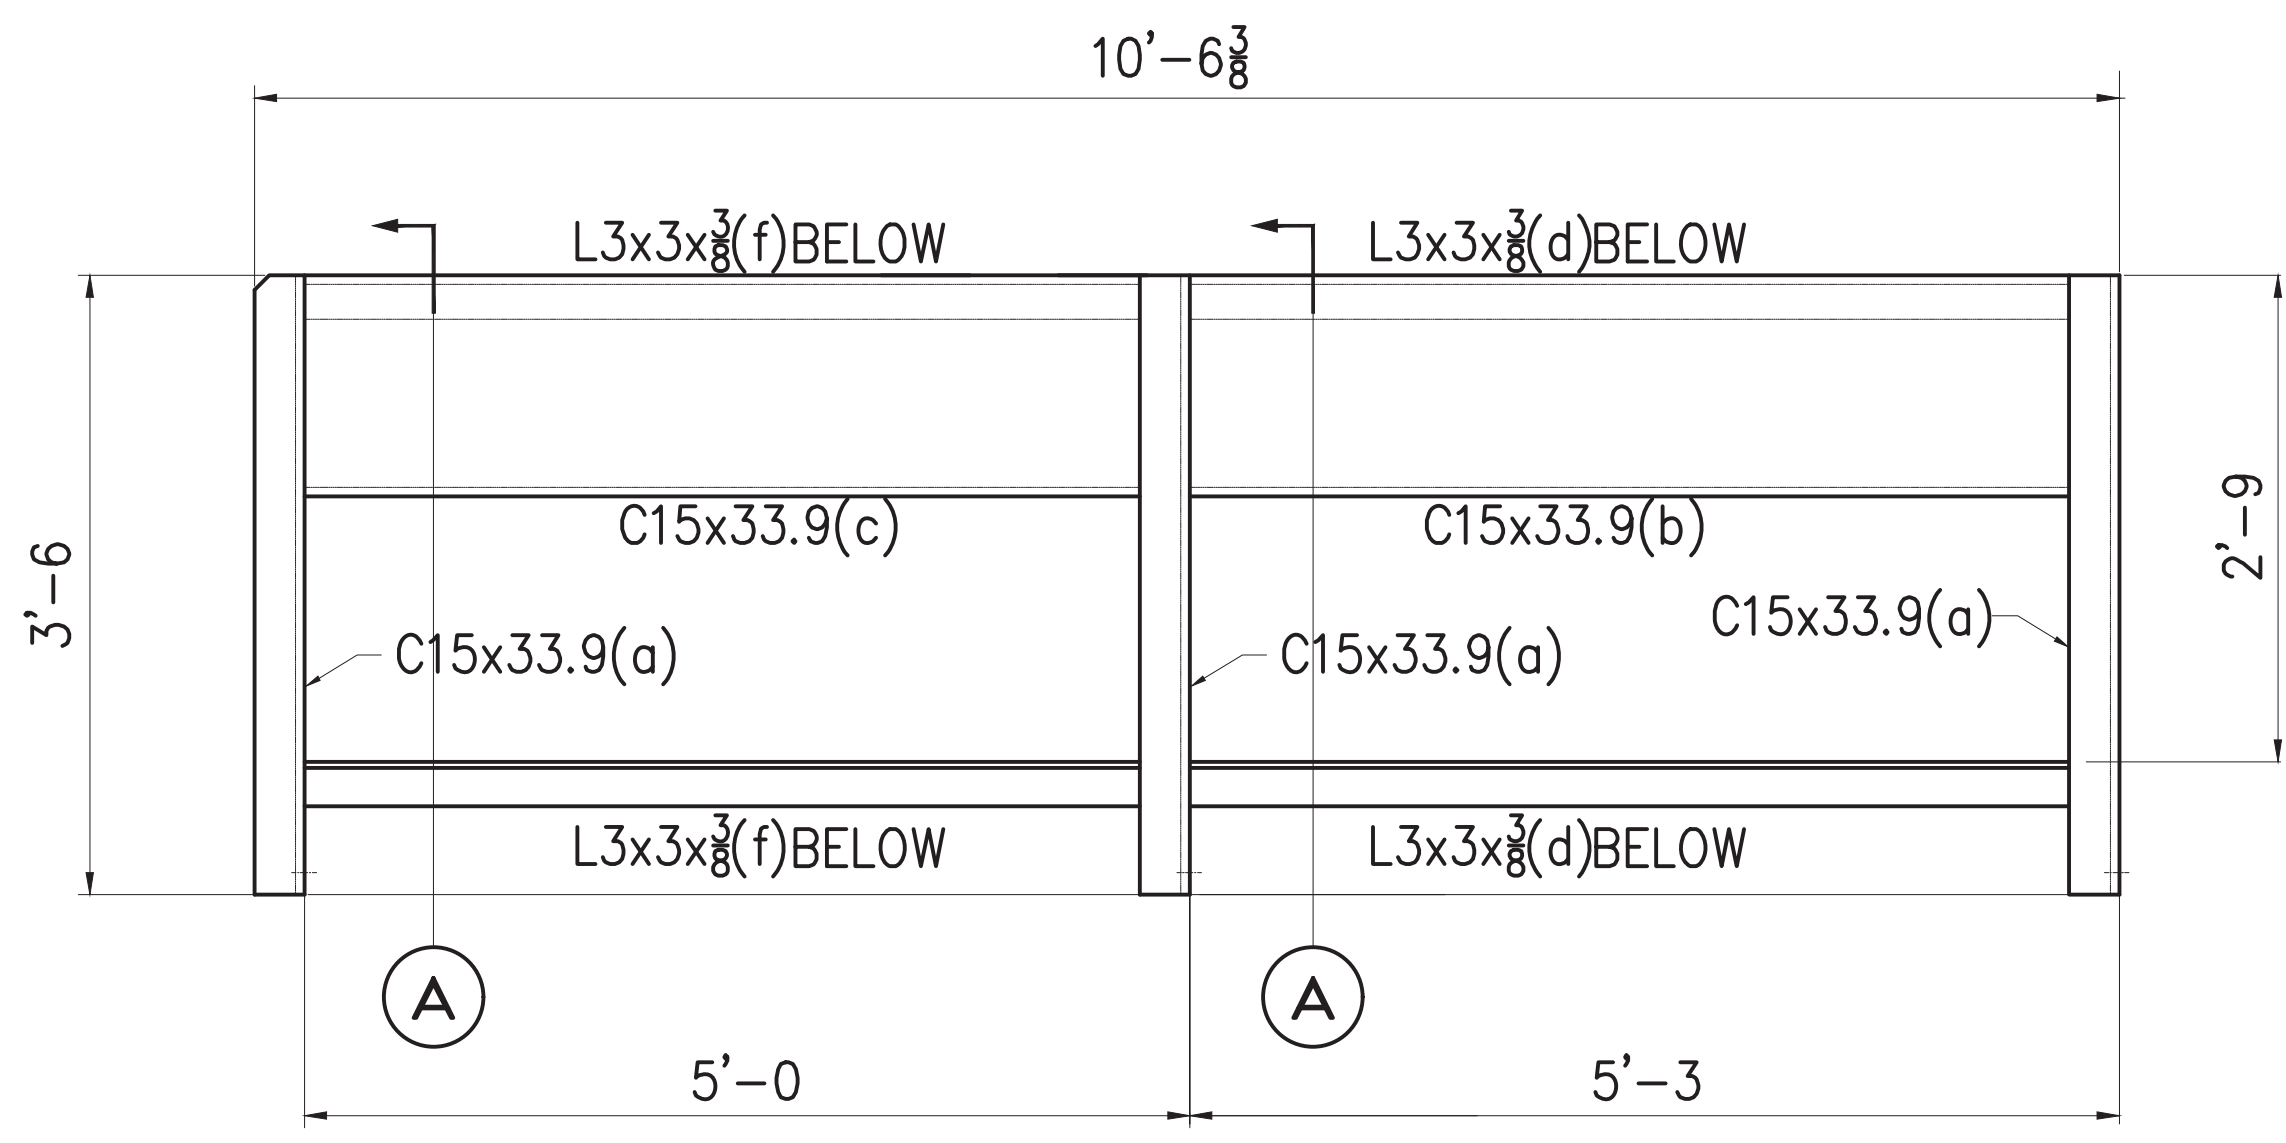


ONE ~ RADIATOR SUPPORT FRAME ~ 4A

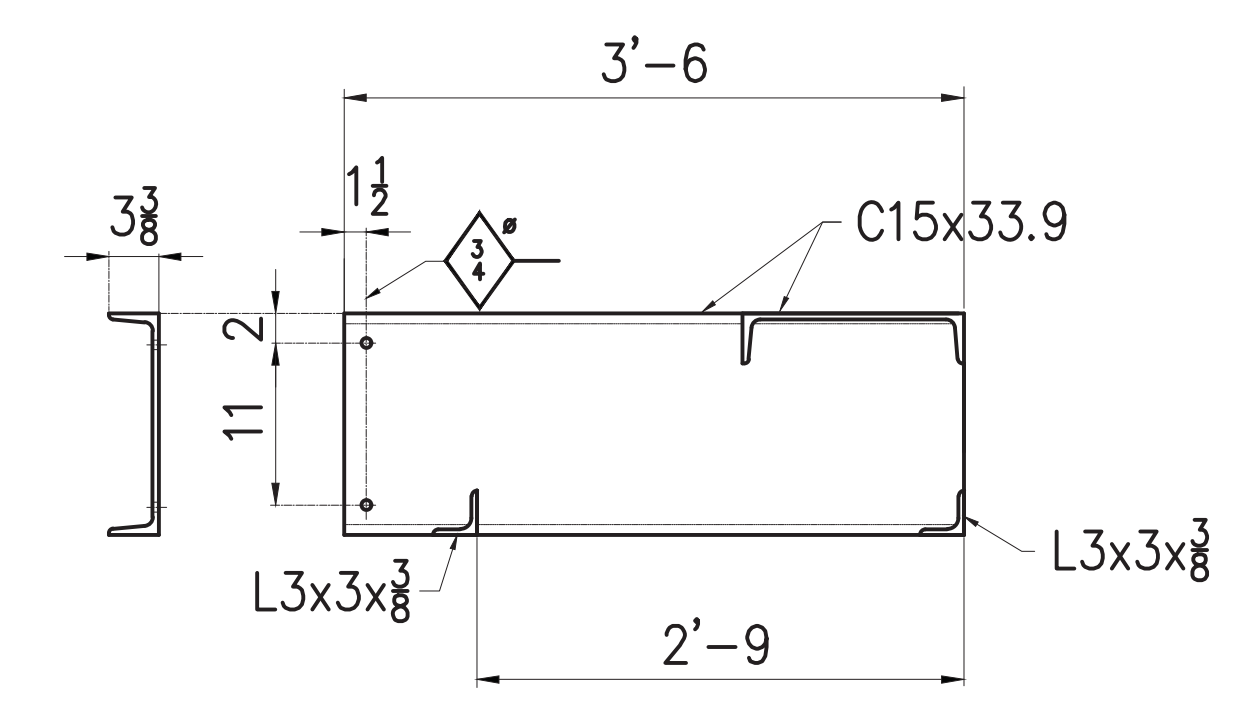


SECTION A

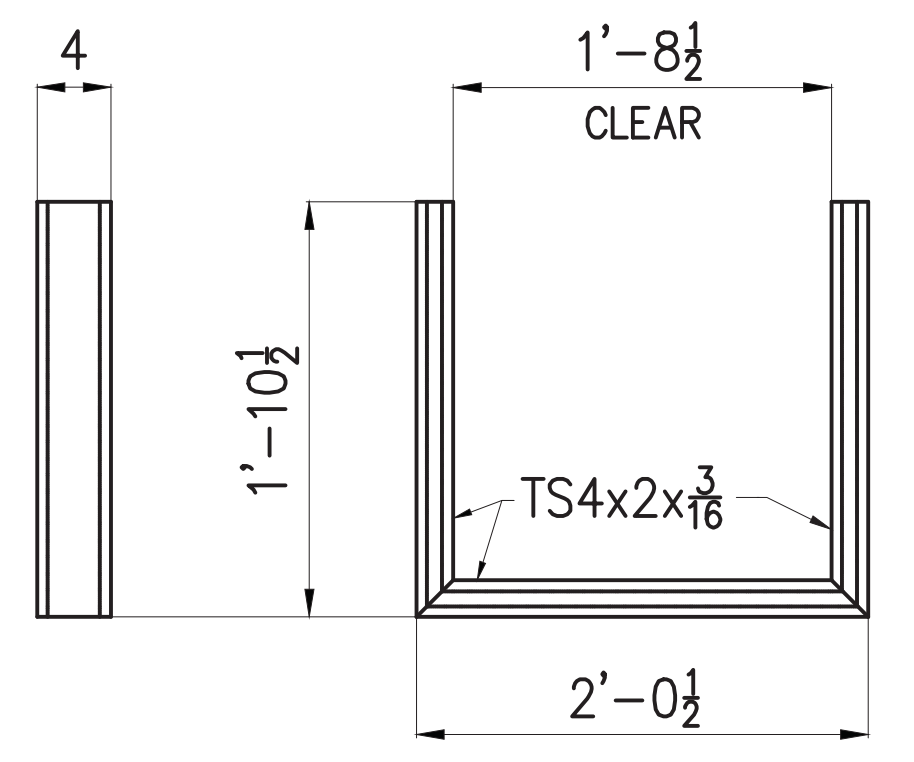


2 ea. ~ WALL FRAMES ~ 4B

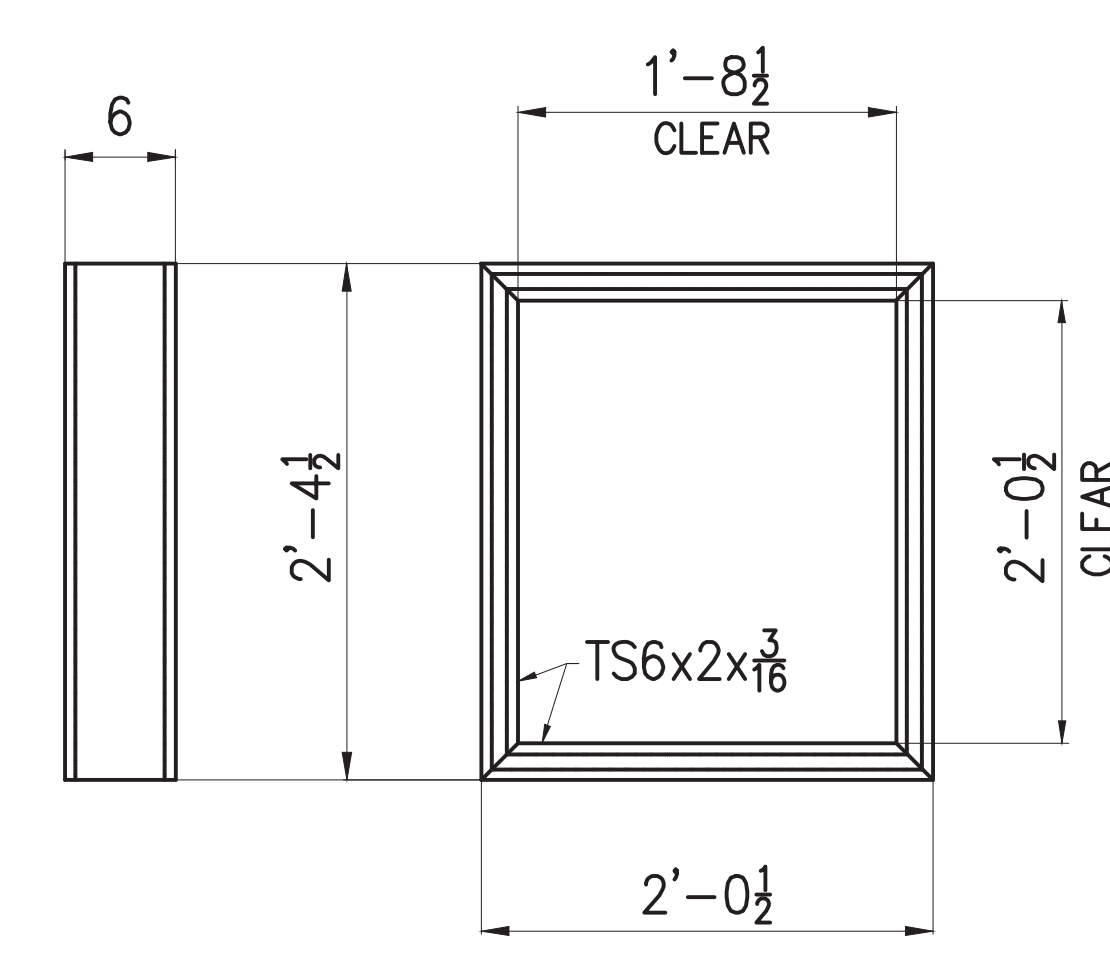

3 ea. ~ CEILING FRAMES ~ 4C

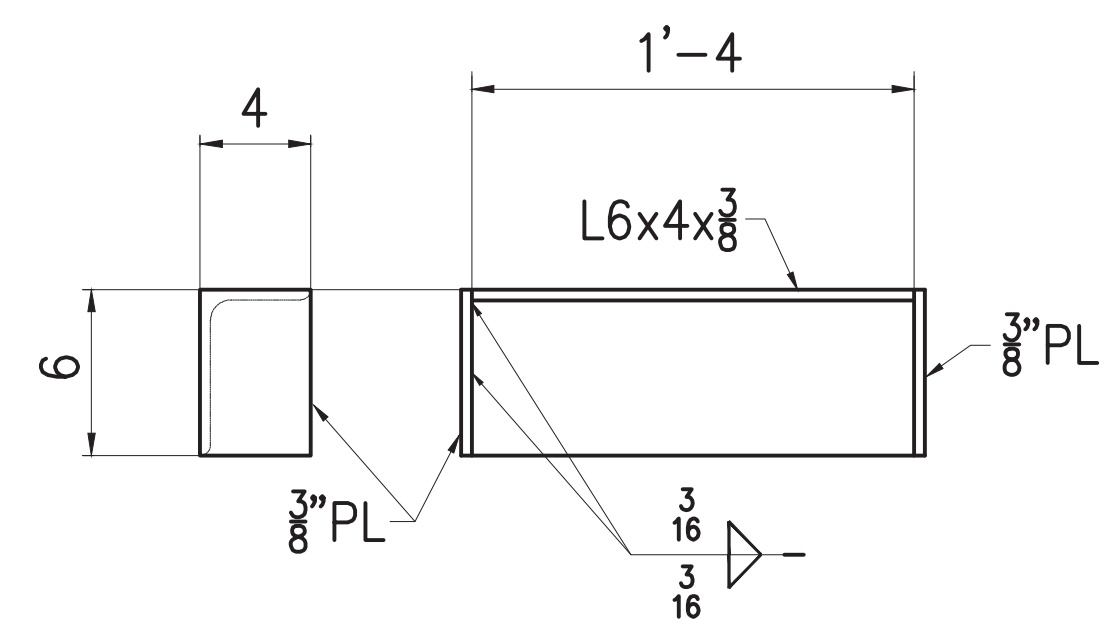

12 ea. ~ ANGLE MOUNTS ~ 4D

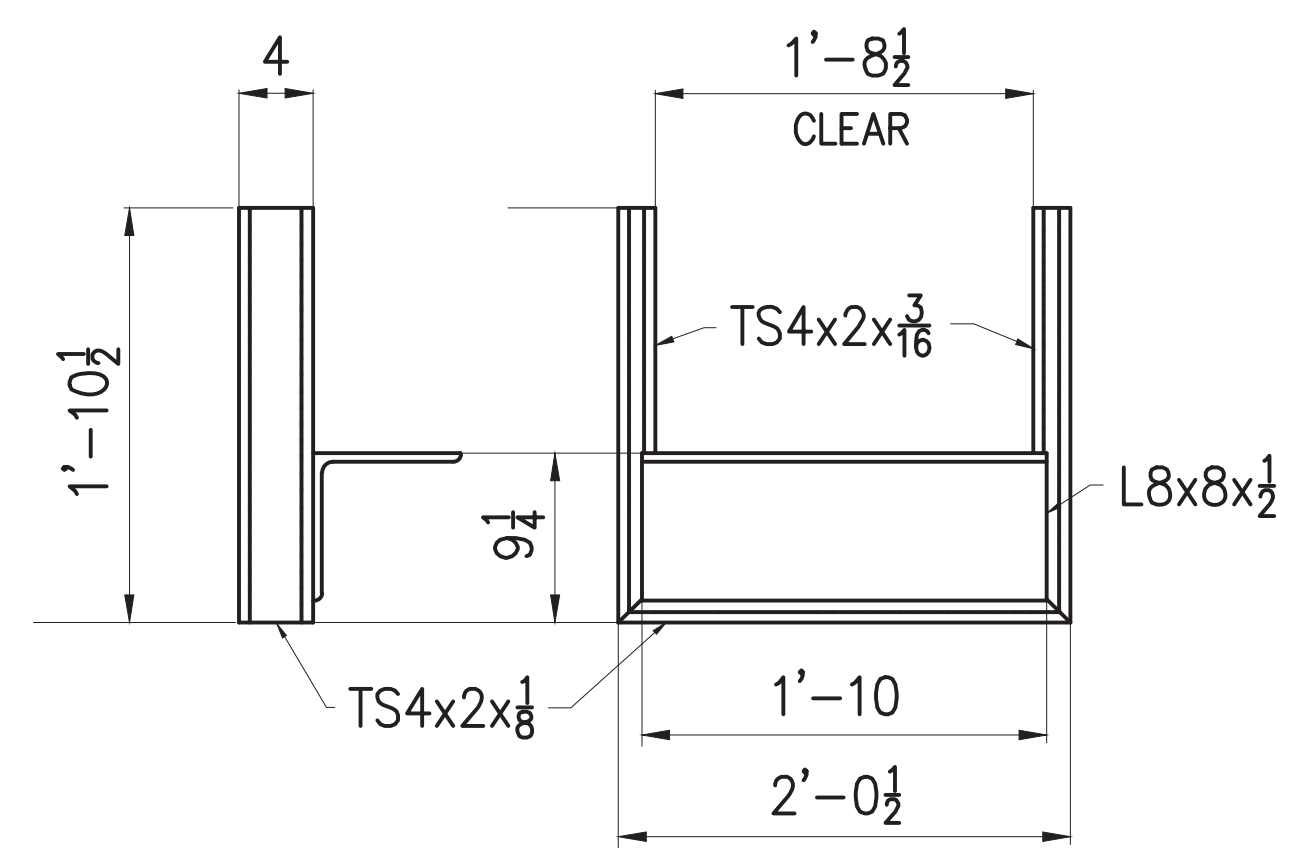

3 ea. ~ WALL FRAMES ~ 4F

SHOP NOTES:
 1.) FABRICATE RADIATOR FRAME WITH MITERED CORNERS AND FULL PENETRATION GROOVE WELDS.
 2.) GRIND OUT INSIDE OF MITERED CORNERS OF WALL & CEILING FRAMES TO PROVIDE FULL CLEAR OPENING.

BILL OF MATERIAL

FIELD MARK	SHOP MARK	NO. PCS	SECTION	LENGTH	REMARKS	WT
4A		ONE	RADIATOR SUPPORT			
	a	3	C15 x 33.9	3'-6"		
	b	ONE	C15 x 33.9	5'-2 5/8"	COPE 1 END	
	c	ONE	C15 x 33.9	4'-11 5/8"	COPE 1 END	
	d	2	L3 x 3 x 3/8	5'-2 5/8"	COPE 1 END	
	f	2	L3 x 3 x 3/8	4'-11 5/8"	COPE 1 END	
4B		2	WALL FRAMES			
		4	TS4 x 2 x 3/16	1'-10 1/2"	MC1E	
		2	TS4 x 2 x 3/16	2'-0 1/2"	MC2E	
4C		3	CEILING FRAMES			
		6	TS6 x 2 x 3/16	2'-0 1/2"	MC2E	
		6	TS6 x 2 x 3/16	2'-4 1/2"	MC2E	
4D		12	ANGLE MOUNTS			
		12	L6 x 4 x 3/8	1'-4"		
		24	PL 3/8" x 4"	6"		
4F		3	WALL FRAMES			
		6	TS4 x 2 x 3/16	1'-10 1/2"	MC1E	
		3	TS4 x 2 x 3/16	2'-0 1/2"	MC2E	
		3	L8 x 8 x 1/2	1'-10"		

APPROVED
 APPROVED WITH CORRECTIONS NOTED
 REJECTED
 REVISE AND RESUBMIT
 SUBMIT SPECIFIED ITEM
 Submittal review is only for ascertaining general conformance with the Contract Documents. Approval does not relieve the Contractor of responsibility for full compliance with the Contract Documents.
 By: *[Signature]* Date: 1-7-19
 Gray Stassel Engineering, Inc. PO Box 111405 Anchorage, AK P (907) 349-0100 F (907) 349-8001


REV. No.	DATE	BY	DESCRIPTION
0	12/28/18	DWH	ISSUED FOR APPROVAL

WEONA CORPORATION
 10501 OLIVE LANE ANCHORAGE, AK 99515
 PHONE: (907) 344-1921 FAX: (907) 344-8244


CLEANING PAINT	BLAST & PAINT PER SPECS.	PROJECT	CLARKS POINT POWER SYSTEM UPGRADE	CUSTOMER	ALASKA ENERGY AUTHORITY
WELDS	3/16" FILLET U.N.O.	MISCELLANEOUS DETAILS	12/22/18	DATE	JOB No.
OPEN HOLES	13/16" U.N.O.				DWG. NO. D4

BILL OF MATERIAL


FIELD MARK	SHOP MARK	NO. PCS	SECTION	LENGTH	REMARKS	WT
5A		2	STAIR ASSEMBLY			
	a _h	4	C10 x 15.3	3'-5 1/4"	2 LEFT/2 RIGHT	
	b _h	4	C10 x 15.3	4'-2"	2 LEFT/2 RIGHT	
	c	2	C10 x 15.3	3'-5 1/4"		
	d	4	L3 x 3 x 3/8	1'-2 5/8"		
	f	4	PL 3/8" x 5	5		
	g	4	PL 1/2" x 2 5/8"	6		
	h	4	L3 x 3 x 3/8	3		
			GRIP STRUT		GALVANIZED	
		14	2"x12ga.x11 1/2"	3'-0"	TREAD	

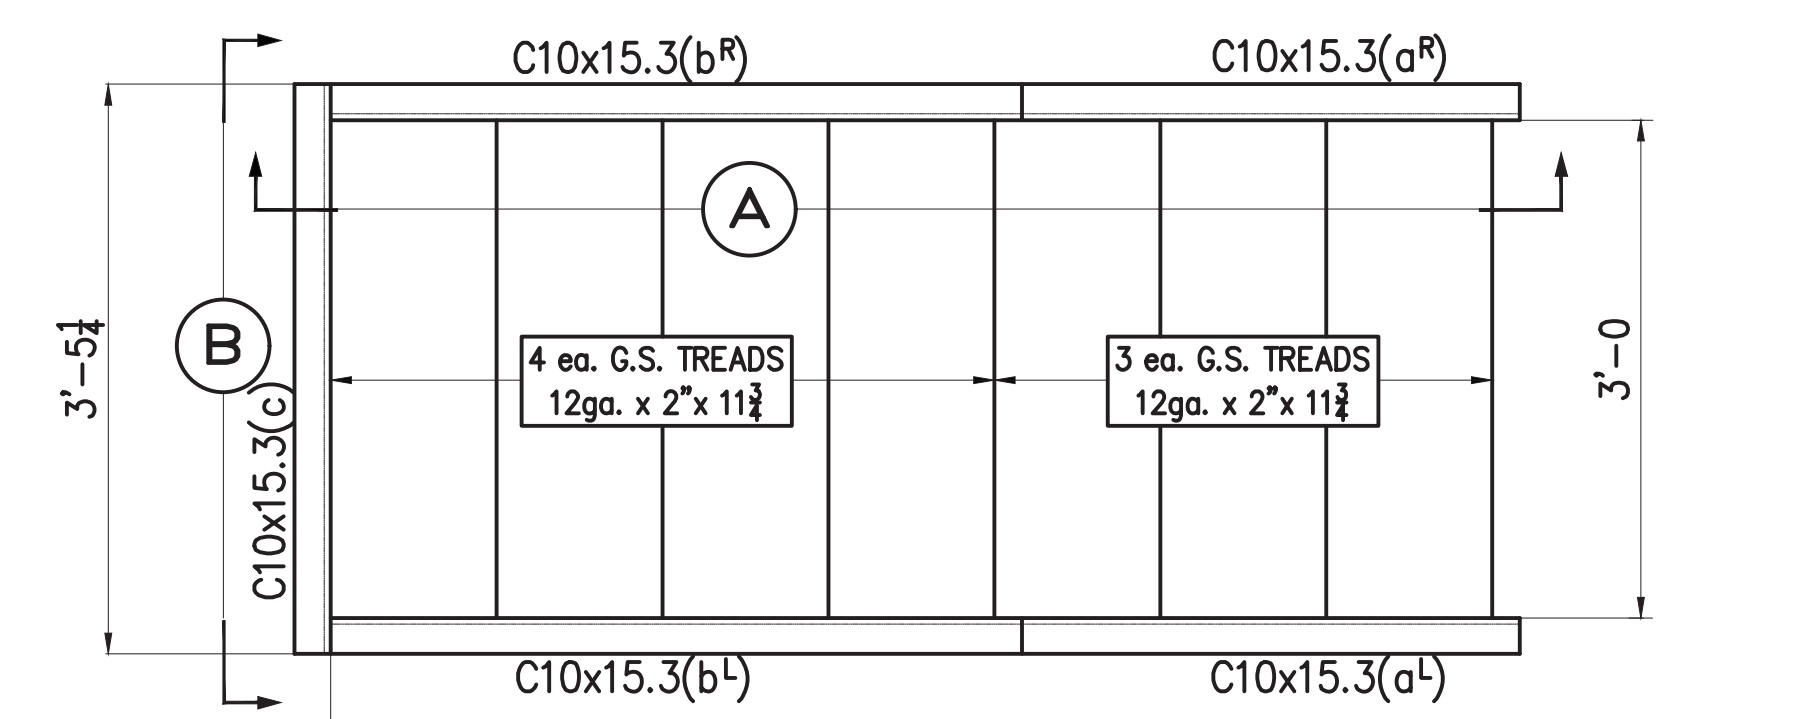

2 ea. ~ STAIR ASSEMBLIES ~ 5A

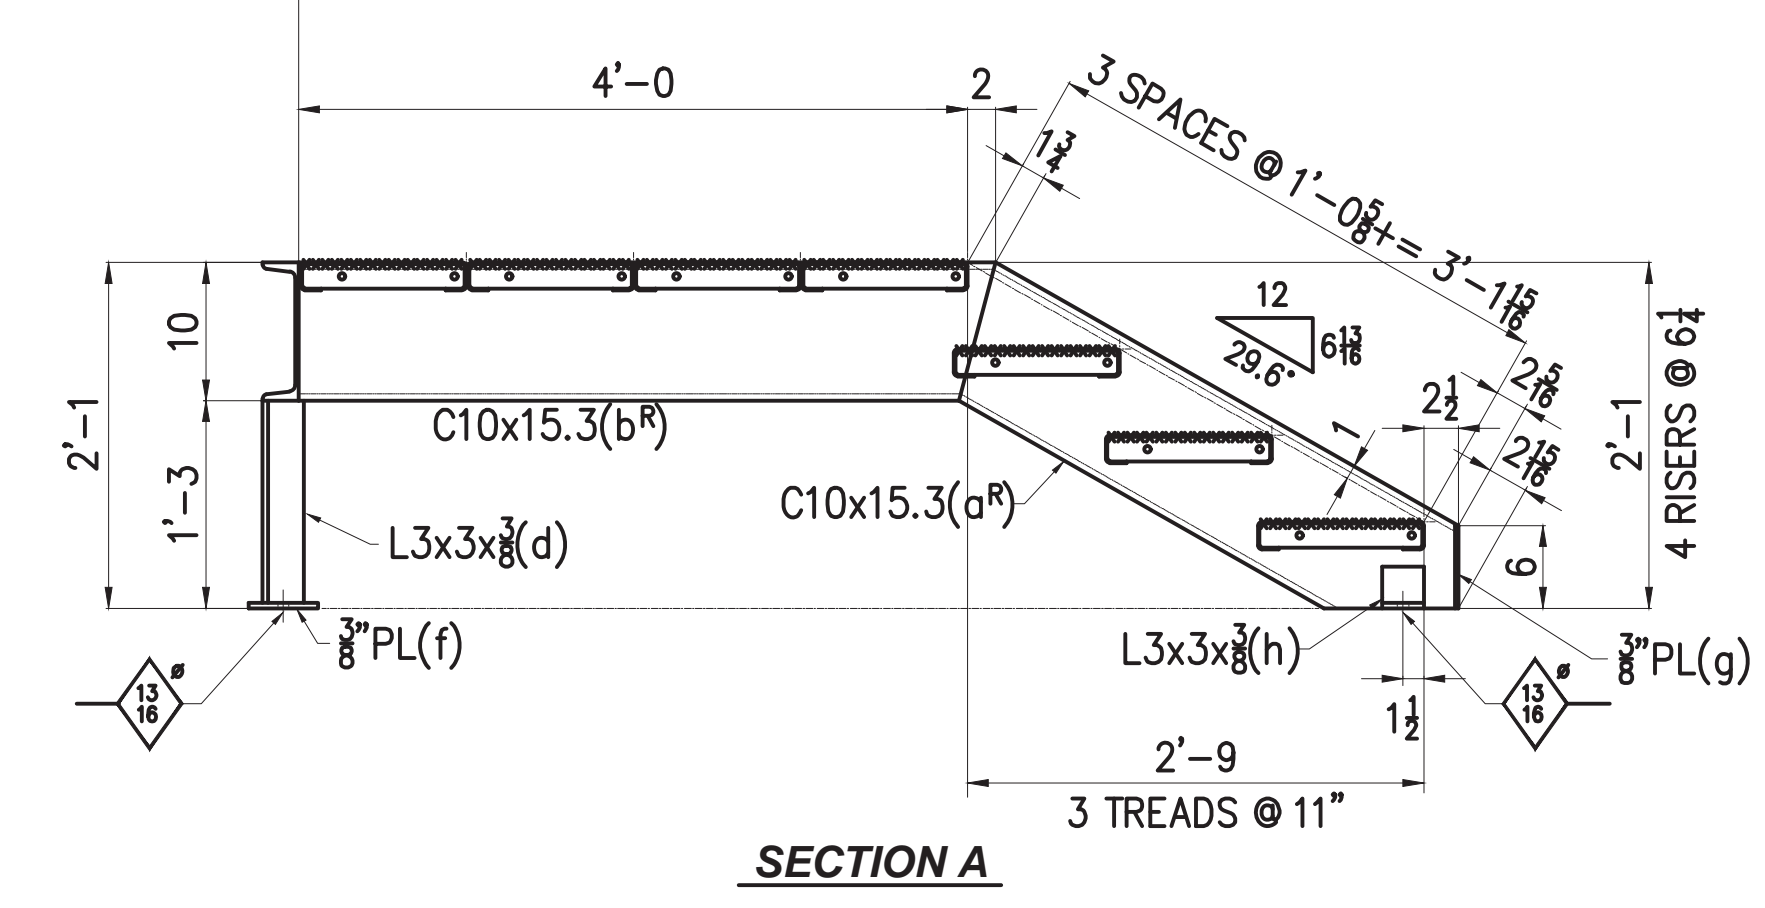

SECTION A

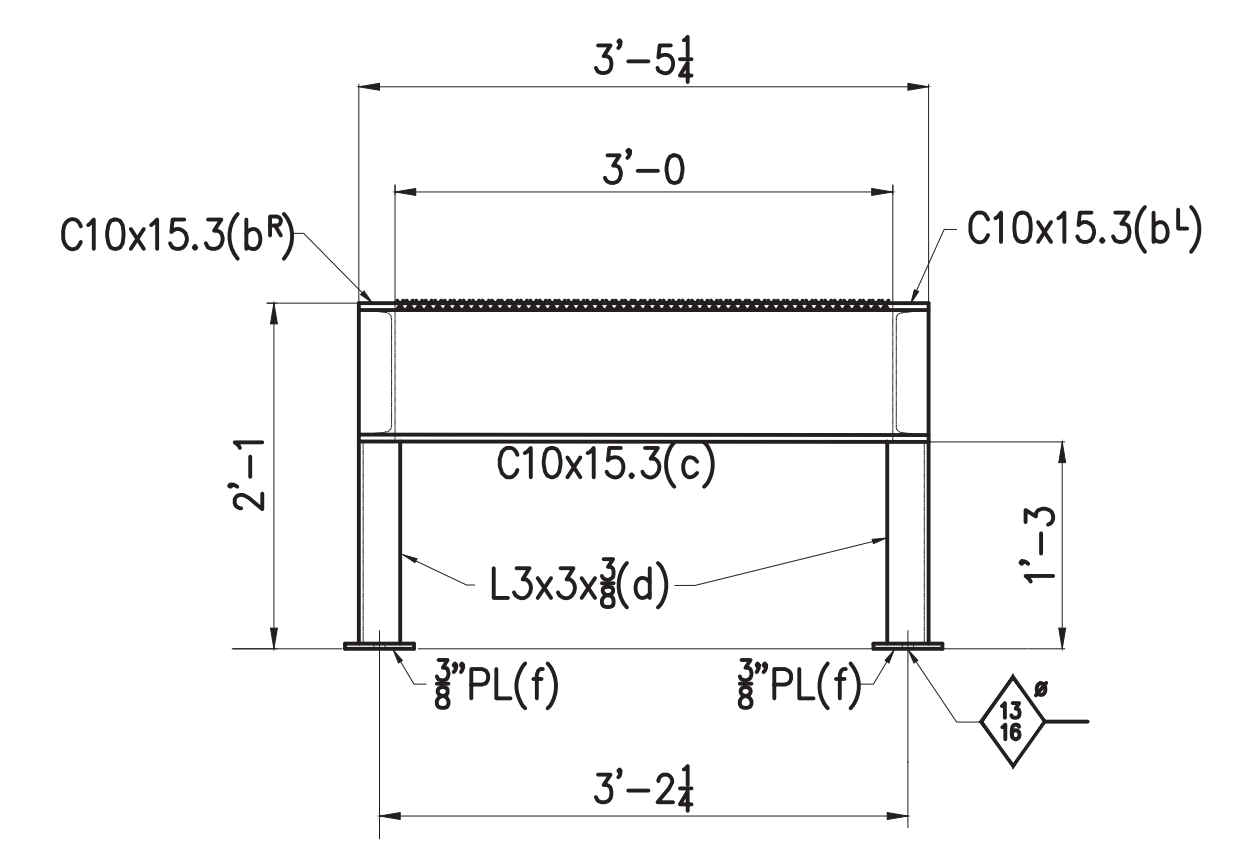

SECTION B

APPROVED
 APPROVED WITH CORRECTIONS NOTED
 REJECTED
 REVISE AND RESUBMIT
 SUBMIT SPECIFIED ITEM
 Submittal review is only for ascertaining general conformance with the Contract Documents. Approval does not relieve the Contractor of responsibility for full compliance with the Contract Documents.

By: *[Signature]* Date: 1-7-19
 Gray Stussel Engineering, Inc.
 PO Box 111405
 Anchorage, AK
 P (907) 349-0100
 F (907) 349-8001

REV. No.	DATE	BY	DESCRIPTION
1	1/4/19	DWH	DELETED RAILINGS
0	12/28/18	DWH	ISSUED FOR APPROVAL


WEONA CORPORATION
 10501 OLIVE LANE ANCHORAGE, AK 99515
 PHONE:(907)344-1921 FAX:(907)344-8244

CLEANING PAINT	HOT DIP GALVANIZE AFTER FAB.	PROJECT	PORT HEIDEN POWER SYSTEM UPGRADE		
WELDS	3/16" FILLET U.N.O.	CUSTOMER	ALASKA ENERGY AUTHORITY		
OPEN HOLES	13/16" U.N.O.	DATE	12/22/18	JOB No.	D5