



**ALASKA INDUSTRIAL DEVELOPMENT AND EXPORT AUTHORITY**  
**SKAGWAY ORE TERMINAL**  
**SHIP LOADER STRUCTURAL INSPECTION**  
**November 11, 12 and 13, 2013**



**R&M Consultants, Inc.**



December 17, 2013

## **Executive Summary**

R&M Consultants, Inc. with sub-consultants Extreme Access Inc., performed a detailed visual inspection of the structural elements of the Skagway Ore Terminal Ship Loader November 11 through 13, 2013. The structural inspection was performed concurrently with the Spout Recertification Inspection performed by Crane Repair Services. The ship loader was found to be in need of extensive remedial repairs to bring the structural elements to a safe and usable condition that would allow use in loading ships for the near future until either a new ship loader is installed or the existing unit is completely rehabilitated for long term use.

The present structural condition is marginal and the facility should not be used for ship loading until remedial repairs are made to critical structural elements in the boom and guide towers.

## TABLE OF CONTENTS

<u>Description</u>	<u>Page No.</u>
Introduction .....	1
Facility Description .....	1
Scope of inspection .....	2
Inspection Methods .....	2
Inspection Activity.....	3
November 11, 2013 .....	3
November 12, 2013 .....	3
November 13, 2013 .....	4
November 14, 2013 .....	4
INSPECTION DETAILS AND RESULTS.....	5
Data Recording and Photographs .....	5
Ship Loader Boom Structure .....	5
Conveyor Shuttle Support Beams .....	6
Ship Loader Guide Towers .....	7
Guide Tower Base .....	8
Findings .....	8
Discussion .....	9
Recommendations .....	10
Closure .....	10

### TABLES

**Table 1A North Tower** – Occurrence of various Condition Status Levels for Tower frame joints

**Table 1B South Tower** – Occurrence of various Condition Status Levels for Tower frame joints

### APPENDICIES

**Appendix 1** – Condition State Guidelines and East Elevation View of Ship Loader showing portion of remedial work areas

**Appendix 2** - General Views of Ore Dock, SOT and Ship Loader and Condition State Guideline

**Appendix 3** – Ship Loader Boom Inspection Photos and Notes

**Appendix 4** – Ship Loader North Guide Tower Inspection Photos and Notes

**Appendix 5** - Ship Loader South Guide Tower Inspection Photos and Notes

**Appendix 6** – Ship Loader Reference Drawings

## Introduction

R&M Consultants Inc. (R&M) was engaged by AIDEA to perform a detailed structural condition inspection of the Skagway Ore Terminal Ship Loader (SOT). This inspection was performed the week of November 11, 2013 and was done by a special inspection team formed by R&M with sub-consultant Extreme Access Inc. (EAI). The R&M team personnel included certified steel bridge inspections from EAI who are also technical climbers. The R&M team personnel included John K. Magee, P.E. of R&M (overall team leader), Scott Hibbs, P.E. of EAI (lead inspector), Peter Fralick of EAI (senior inspector) and John Gonzales of EAI (inspector).

The on-site inspection was performed November 11, 12 and 13, 2013 during a weather window in which temperatures were generally just above freezing, wind was sporadic and in the 3 to 5 mph range and no significant precipitation occurred. The climbing inspection by R&M/EAI was done concurrently with the spout certification inspection by Lance Gyldenege of Crane Repair Services (CRS), the Certified Spout Inspector who was under separate contract to AIDEA. Close coordination between R&M/EAI climber/inspectors and Mr. Gyldenege was maintained throughout the inspection which ensured the maximum inspection effectiveness and efficiency could be maintained. The weather deteriorated significantly on November 14th but the field inspection had been completed and the combined inspection team departed Skagway.

## Facility Description

The ship loader is installed on a pile supported foundation comprising a reinforced concrete base slab/pile cap supported in turn by steel pipe piling driven into the harbor bottom. See **Appendix 2** for general views of the ore dock and ship loader. The Skagway Ore Terminal comprises a Concentrate Storage Building, truck unloading facility, reclaim, transfer, and ship loading conveyors and support facilities including equipment wash facility, laboratory building, two MCC's, vehicle repair/maintenance shop and office/lunch room/ shower and locker room. Electric power to operate the motors, controls and lights on the ship loader originate in the main MCC.



**Aerial view of the Skagway Ore Terminal looking East**

The ship loading conveyor is mounted on a shuttle frame that runs on I-beam runways at the tail and head of the conveyor and on carrier wheels supported by structural members within the plate girder boom. The boom is mounted in a hoisting cage frame that is raised and lowered to follow the hatch coaming as ship draft and tide levels change during ship load out. The hoisting cage is attached by cable to counterweights in the north and south guide towers and hoisting winches and guide sheaves are set on top of a hoisting equipment bridge spanning across the tops of the two guide towers and lower sheaves are mounted on the concrete base of the ship loader.



**Ore Dock and SOT Ship Loader viewed from the water**

Reference drawings of original construction of the ship loader facilities are included in **Appendix 6**.

## Scope of inspection

The structural inspection scope included inspecting and evaluating the ship loader boom structure and hoist support tower structural members and reporting on the condition of the facility. The inspection was visual and included welded joints, bolted joints and tower column base plates and ancillary elements. No non-destructive testing/examination was done. Inspection of operating mechanical features was performed and report of findings was prepared by Crane Repair Services under separate contract with AIDEA.

## Inspection Methods

Inspectors accessed the North and South hoist tower columns and frame panel points using rope and technical climbing equipment and techniques. This approach was adopted due to the flexibility of access for the inspectors. Use of bucket truck(s) or man lifts is not consistent with the flexible access needed due to the lack of access for equipment all around the ship loader due to condition of the ore dock and the need for inspectors to view areas not easily accessed by man lift or bucket truck.

Each element inspected was “scored” using structural Condition State (CS) descriptions based on accepted steel structure Condition State Descriptions for painted steel structures from the 2009 Oregon Department of Transportation Bridge Inspection Coding Guide. This Guide provides narrative descriptions and reference photographs of various coating and steel corrosion conditions and assigns a

number from CS1 (best) to CS5 (worst) along with notes on possible actions to be taken to remediate the condition. A copy of the reference table is included as **Appendix 1-1 and Appendix 1-2** shows a view of the East face of the Ship Loader with many of the structural joints with deficiencies indicated.

Each panel point/node in the structural system was examined and if the condition state was less than CS2 photographs were not taken. If the condition state was higher (more severe) the element was closely inspected by scraping away any loose paint, dirt, residual concentrate, rust scale, etc. and visually evaluating the structural material section loss, condition of metal surfaces, etc. Photos were then taken of the particular element and the condition logged with comments. The notes and accompanying photographs are included in **Appendices 3, 4 and 5**.

## Inspection Activity

Inspection activities were as follows by date indicated:

### November 11, 2013

Weather was fair, 39 degrees F, calm, clear and sunny with occasional light wind.

The R&M team arrived in Skagway by State Ferry mid-day November 11, 2013 where we were joined by the spout inspector. The combined inspection team (R&M/EAI/CRS) spent the afternoon assessing the structures to be inspected from the standpoint of access and safe work practices and reviewing and discussing the job safety plan and work plan with Dave Hunz and Gene Lindfors of MSI. This included operation of the ship loader boom luffing and hoist systems for spout inspection and to facilitate access by EAI personnel for safe inspection of the structural systems. The combined inspection team inspection visited the MCC with Dave Hunz to discuss LOTO to ensure the ship loader could be isolated from energy sources, “walked” the transfer conveyor to the ship loader cage platform, walked around the ship loader towers and looked at the hoisting system with MSI.

### November 12, 2013

Weather was fair with temperatures around 39 degrees F all with moderate wind (4 to 10 mph) (wind chill 30 to 38 degrees F) all day and overcast.

The combined inspection team met with Dave Hunz and Gene Lindfors of MSI at about 0800 to get the pre-job safety and operation briefing and visitor passes from MSI. The safety plan was reviewed and the energy source for the ship loader and conveyor motors was locked out and tagged out (LOTO). At the safety meeting it was decided that while Lance Gyldenege was performing his initial inspection of the ship loader with the boom raised and parked, the EAI climbers would drop their climbing ropes down tower corners and the underside of the ship loader boom (bottom facing east) and would inspect the tower structures and boom girders and framing with the boom raised and parked as that would provide the best visibility of the structural members and joint connections in the boom. EAI assignments were Scott Hibbs on the boom, John Gonzales on the South Tower and Peter Fralick on the North Tower. John Magee walked the transfer and reclaim conveyors to perform an overall condition survey of the condition of the conveyors. Gene Lindfors, MSI was safety watch on the dock.

The gangway handling jib boom/hoist attached to the NE leg of the North Tower was found to be failed at the hinged connection bracket and with only one bolt still securing the assembly. MSI was notified and a man lift was moved to the SOT ship loader at the end of the climbing inspection for the day. MSI removed the hoist and jib boom. The mounting bracket assembly remaining on the column was removed by EAI the next day. Inspection of the NE column of the North Tower was not able to be done until this bracket was totally removed as it was not fastened to the column, presenting a hazard to personnel below.

### **November 13, 2013**

Weather was around 32 degrees F all with moderate wind (3 to 5 mph) (wind chill 27 to 28 deg F) in morning and mostly cloudy to overcast, light snow cover from snow in the early morning, water on tower base and structure was frozen.

A safety meeting was held at 0800 in the facility lunch room and the work plan for the day was reviewed with all of the combined team including Dave Hunz. The work plan included the operation of the ship loader hoists and boom luffing system by CRS and the LOTO considerations on energy sources for protection of workers on the ship loader and tower. During the time the ship loader was being operated, EAI personnel would suspend their inspection and be off the ship loader and towers. CRS operating inspection would be done as soon as EAI had cleared any ropes and other climbing safety gear from boom structure in the raised and parked position. After the CRS operating inspection and re-establishment of the LOTO in energy sources, the EAI inspection of the boom and towers could resume with the boom in the lowered position. At the conclusion of the EAI climbing inspection, the ship loader boom would be raised and placed in the parked position.

After the safety meeting, the combined team returned to their inspection of the ship loader. Climber's ropes and gear were cleared from the boom and the LOTO was removed around 0900. The ship loader boom was raised by MSI and CRS commenced the operational inspection/evaluation of the ship loader. No operating (run) test of the ship loader conveyor was done due to possibility of discharging remnant concentrates to Skagway Harbor. Video of the operating ship loading conveyor is to be made by MSI at the next ship load-out and provided to AIDEA and CRS.

At the conclusion of the ship loader operational inspection, the LOTO was re-established and EAI completed their inspection of the ship loader boom structure and the north and south towers.

An exit meeting was held with MSI at the end of the day (around 1630) and the preliminary results of the overall inspection were reviewed with MSI. EAI collected their climbing equipment and the combined team began demobilization, arrangements were made to fly from Skagway to Juneau and onward to team member's respective home bases on Thursday 14 November.

### **November 14, 2013**

Weather deteriorated overnight and by Thursday morning the wind was blowing around 34 mph with gusts to around 50 mph. Temperature was in the 40's and overcast with rain at Skagway. Haines winds were very turbulent. Juneau flights left on time but flights to Anchorage were diverted to Fairbanks for 7.5 hours to wait out freezing fog in Anchorage.

## INSPECTION DETAILS AND RESULTS

### Data Recording and Photographs

Inspectors recorded and photographed the condition of all elements and connections in the towers and ship loader boom system. Inspection of the mechanical equipment and hoisting system components was not in the R&M scope and is reported on separately by Crane Repair Services. Photographs are sorted by North Tower, South Tower and Ship Loader Boom and are present in tables with transcribed field notes to document the condition of the structural elements and connections. Each tower was inspected by a specific individual and photographs are in sets sorted by individual/date and location. The sets of photographs keyed to inspection notes are included in **Appendices 3, 4 and 5**.

Each photograph is identified by

- Main Component of the Ship Loader,
- Inspector/photographer-date-photo number-facility-main structure
- Location,
- Description - including transcribed notes by inspector relative to the photograph. Condition State, and any specific details noted.

The structure Condition State determinations were guided by the State of Oregon DOT Painted Steel Structures Condition State Descriptions, see **Appendix 2**.

### Ship Loader Boom Structure

At welded joints between girders and lateral framing at the bottom plane of the ship loader boom, dirt, flaking paint and rust scale were removed using a glazers knife as a scraper and the condition of the underlying steel was visually evaluated. Each structural joint was assigned a condition state to define the extent of deterioration of the coating and steel elements. See photographs in **Appendix 3** for Boom inspection notes and record photographs.



**Example of extreme CS5 deteriorated condition in boom conveyor support framing**

It was found that virtually all of the 29 frame joints containing a diagonal frame element are **CS5** and frame joints where members that are in a horizontal position (when the boom is raised and parked)



including framing between the main girders of the boom and between the main girders and I-beam shuttle track/runway were all found to be **CS4/5** to **CS 5** condition in some portion of the element based on material loss in the structural materials. The extensive corrosion encountered could be explained by the boom being luffed up to a vertical position for parking/storage between uses. This position allows water, dirt and residual concentrates to accumulate in the pocket formed by the joint when in a vertical boom position which promoted failure of coatings and corrosion of the steel elements.

***In short, the structural framing joints throughout the ship loader boom structural system are CS5 and require extensive remedial repairs for the equipment to operate safely.***

### **Conveyor Shuttle Support Beams**

The head chute/drive end of the ship loader conveyor is supported by steel wheels that run on the bottom inside of the I-beam flange. The wheels have a truncated cone shape and this induces a level of lateral thrust to the I-beam runway/track that supports the head chute assembly. The I-beam is laterally supported by the boom girder by way of transverse “blocking” provided by short sections of steel I-beam. Diagonal structural Tee members provide additional lateral support and essentially form a horizontal truss to maintain the left and right runway/track members in relationship one to the other and prevent change in gage that would allow the shuttle to drop through the open area of the spout shuttle slot at the outboard end of the ship loader boom. The right hand (south) shuttle runway track has reduced lateral support due to extreme deterioration and loss of steel section in some of the lateral support blocking and diagonal Tees. This has allowed the gage to increase so the shuttle has less bearing area to support the steel wheels. Also, the left half of the lower flange of the runway/track beam has been bent downward 5/8-inches and the right hand set of wheels on the head chute/drive end of the shuttle has less bearing than the design.



**Right hand spout shuttle wheel, runway/track beam and failing lateral support.**

***The conveyor head chute/drive end shuttle needs urgent remedial repairs to restore the runway/track beams back to correct gage to maintain safe operating condition for the shuttle and head chute.***

## Ship Loader Guide Towers

The structural joints where the lateral framing members between the load bearing columns of the North and South Guide Towers of the Ship Loader are configured to catch and hold water, dirt and residual concentrate were found to have significant coating loss and steel corrosion in and around the joints; this is primarily framing in the West and East faces of the towers. This is caused by water, dirt and residual concentrates being trapped in pockets formed in the joints by structural member orientation in joints. In some cases joints forming pockets were provided with drain holes which greatly reduced the corrosion problem if the drain holes were large enough and were kept clear of material plugging the hole. **However, in the two towers of the 44 joints of concern at least 23 are classed as CS4/5 or CS5. Another 28 are classed as CS 3/4 or CS 4.**

**Table 1A North Tower – Occurrence of various Condition Status Levels for Tower frame joints**  
See photographs in Appendix 4.

North tower						
CS2	CS2/3	CS3	CS3/4	CS4	CS4/5	CS5
14	2	10	8	16	7	0

**Table 1B South Tower – Occurrence of various Condition Status Levels for Tower frame joints**  
See photographs in Appendix 5.

South tower						
CS2	CS2/3	CS3	CS3/4	CS4	CS4/5	CS5
4	1	2	5	6	9	7

From the tabulations in Tables 1A and 1B it can be seen that in the lateral load resisting framing of the two guide towers, there are 7 occurrences of CS5, 16 occurrences of CS4/5 and 22 occurrences of CS4. The total number of frame joints requiring urgent remedial repairs is at least 23 (CS5 and CS4/5) and a portion of the CS22 joint conditions also are urgent to repair.



**Typical tower frame joint of configuration that pools water; CS5.**

Column base plates and bolted splices in the columns and diagonal bracing members need very close examination after removing the rust, coating and any deleterious materials down to bare metal. One concern is that the column-to-base plate welds are still competent based on visual examination. If there is doubt, magnetic particle and dye penetrant methods could be used to determine if there is lack of fusion and/or cracking in the welds. Missing bolts in splices and bolted connections need to be replaced and some existing bolting should be removed and replaced with new bolts.

***Guide Tower structural elements urgently need remedial repairs and all joints where water can collect need drain hole of sufficient size to prevent pooling of water.***

## Guide Tower Base

The base plates of Guide Tower columns and all static and operating elements anchored to the pile cap/base slab need close attention to ensuring grounding strap cables are intact and providing competent ground. In at least one instance the ground cable has broken strands and is in marginal condition at the point it emerges from the base slab.



**Example of partially failed ground strap at column base; CS5**

***Detailed inspection of the Grounding System was not done as part of this inspection, but, incidental observations indicate the system needs attention by qualified person(s).***

## Findings

Findings of the inspection and evaluation of the ship loader based on the November 11, 2013 through November 13, 2013 inspection are as follows; see Appendix 1-1 for Condition State guidelines and Appendix 1-2 for a view of the East face of the ship loader with boom parked and indication of the locations of urgent repairs for many of the deficiencies:

1. Structural elements and connections within the ship loader boom are in an advanced state of deterioration. Virtually all 29 welded structural connection points between beams and lateral support framing members that are configured to hold water and detritus when the boom is parked are regarded as in Condition State 5 (CS5) and urgently require rehabilitation and/or replacement before the next use of the facility in loading ships.

2. Approximately fifty two percent of welded structural connections between columns and lateral support framing members in the East and West frames of the ship loader towers are deemed as in Condition State 5 (CS5) and urgently require rehabilitation and/or replacement before the next use in loading ships.
3. Safety handrails on the ship loader boom have corroded at the base of posts/balusters and need replacement/rehabilitation to ensure safety of personnel.
4. Wire rope and sheaves need replacement and rehabilitation in accordance with the Crane Repair Services report.

## Discussion

The findings of this inspection indicate little attention to structural maintenance has been done since 2007. The ship loader structural systems have deteriorated to the extent that critical connections must be rehabilitated/repared. If this is done to allow loading ships beginning sometime in February, the critical connections will require attention over the next 45 days or so. To accomplish this, a welding/fabrication contractor would need to be engaged essentially immediately to perform the work needed to the critical connections and elements in the boom needing remediation.

The repair work can be done with the boom down or in the vertical parked position. If in the vertical position, scaffolding would need to be erected on the water side (east side) of the ship loader to allow access to the areas needing rehabilitation. A material hoisting system would need to be established to move structural materials to the point of installation. With the boom up in the parked position marine traffic along the ore dock would be minimally affected.

If done with the boom in the lowered (down) position, access to the work area would be from above and hanging scaffolding would need to be installed. With the boom down, marine traffic along the ore dock would be significantly affected.

Repair/rehabilitation will include removal of defective materials and replacement with new materials cut to fit and welded in place. Patching, flange and web reinforcement including stiffeners and gusset plates to reinforce weakened areas and provide a load path for structural loads will be used to remediate deficient areas. All remedial work will be coated with suitable field applied durable coating material.

To ensure minimal loss of time in effecting repairs, a full time structural engineer/inspector would need to be employed at the job site to be able to assess any problems encountered and establish a repair procedure working with the welding contractor.

## Recommendations

Based on the results of this inspection, it is recommended that:

1. The ship loader NOT be operated to load ships until remedial work is done on the structural systems of the ship loader guide towers and the ship loader boom and ship loader conveyor (conveyor #3) shuttle support runway/track system; this includes any remedial work required to the tail roller section of the shuttle as well as the shuttle support beams (these support the carrier rollers for the conveyor shuttle frame) running from the tail end of the conveyor to the head chute.
2. Prepare a rehabilitation action plan that includes continuous inspection of the structural rehabilitation to ensure the remedial structural work is consistent with structural requirements and any hidden conditions can be addressed as they are discovered.
3. The electrical grounding system for the ship loader structure be closely inspected and tested and any broken, damaged or ground straps not in compliance with grounding requirements be replaced.
4. Ship Loader safety features such as hand rails and chains across openings be upgraded including re-securing hand rail posts/balusters to the deck beams of the ship loader.
5. Sand or grit blast the ship loader and boom structures and recoat with a suitable hi-tech coating system.
6. Perform remedial work on the ship loader described in the spout certification inspection report by Crane Repair Services.
7. Re-inspect the ship loader after completion of the work under the certification report and structural rehabilitation/remedial work is completed.






## Closure

The results and findings of this inspection indicate the ship loader is in marginal condition at best but, can likely be repaired to provide a safe operating unit for the short term. It is very important to either replace the ship loader with new, modern equipment or perform major repairs and replacement to the present ship loader.

R&M Consultants, Inc. are available at your convenience to review this report and discuss possible means of accomplishing repairs to the facility to allow continuing support of load-out of concentrates.

# **Appendix 1**

**Condition State Guidelines and East Elevation View of Ship Loader showing  
portion of remedial work areas**

<b>Oregon DOT Painted Steel Structure Condition State Descriptions</b>	
<p><b>Condition State Descriptions and Feasible Actions</b> (<i>Work Candidate Action in parentheses</i>) Note: Use % for each condition state.</p>	<p><b>Note:</b> The primary function of the Paint System is to be a protective coating. Therefore, galvanizing and concrete cover on a Concrete Encased Steel Member are considered to be protective coating systems. <b>Analysis required if Section Loss &gt; 10 % of plate thickness in critical load area.</b></p>
<p><b>1. There is no evidence of corrosion and any paint systems are sound and functioning as intended to protect the metal surface.</b> Do Nothing; Surface Clean (<i>Pr Maint</i>)</p>	 <p style="text-align: center;"><b>CS1</b></p>
<p><b>2. There is little or no active corrosion. Surface or freckled rust may have formed or is forming. The paint system may be chalking, peeling, curling, or showing other early evidence of paint system distress, but there is no exposure of metal.</b> Do Nothing; Surface Clean (<i>Pr Maint</i>); Clean And Paint (<i>Min Repair</i>)</p>	 <p style="text-align: center;"><b>CS2</b></p>
<p><b>3. Surface or freckled rust is moderate to heavy. There may be exposed metal, but there is no measurable loss of section.</b> Do Nothing; Spot Blast, Clean And Paint (<i>Part Paint</i>)</p>	 <p style="text-align: center;"><b>CS3</b></p>
<p><b>4. The paint system has failed. Corrosion may be present but any section loss due to active corrosion does not yet warrant a structural analysis of the element or the bridge.</b> Do Nothing; Spot Blast, Clean And Paint (<i>Part Paint</i>); Replace Paint System (<i>Repl Paint</i>)</p>	 <p style="text-align: center;"><b>CS4</b></p>
<p><b>5. Corrosion has caused section loss and is sufficient to warrant structural analysis to ascertain the impact on the ultimate strength and/or serviceability of either the element or the bridge.</b> Do Nothing; Rehab The Unit (<i>Rehab Elem</i>); Replace The Unit (<i>Repl Elem</i>)</p>	 <p style="text-align: center;"><b>CS5</b></p>

EAST FACE OF SHIP LOADER WITH BOOM IN PARKED POSITION – RED DOTS INDICATE SOME OF THE JOINTS REQUIRING URGENT REPAIR;  
NOTE THAT NOT ALL POINTS REQUIRING REPAIR ARE VISIBLE IN THIS PHOTOGRAPH





## **Appendix 2**

### **General Views of Ore Dock, SOT and Ship Loader**



SH-111213-00

LOCATION: SKAGWAY ORE DOCK

DESCRIPTION: STEEL STRUCTURE INSPECTORS FROM EXTREME ACCESS INC.

L TO R – PETER FRALICK, JOHN GONZALES



JM-111113-IMGP0281-

LOCATION: SKAGWAY ORE TERMINAL


DESCRIPTION: SHIP LOADER - VIEWED FROM WATER SIDE, BOOM RAISED AND PARKED. TOWER BRIDGE WITH HOISTING EQUIPMENT, BOOM PARKED, OPERATOR CAB AT RIGHT (NORTH) DISCHARGE SPOUT SHUTTLE SLOT VIEWED FROM BOTTOM OF STRUCTURE.



JM-111113-IMGP0280

LOCATION: SKAGWAY ORE TERMINAL

DESCRIPTION: SHIP LOADER - VIEWED FROM WATER SIDE, BOOM RAISED AND PARKED. TOWER BRIDGE NORTH END, NORTH TOWER AND HOISTING CAGE WITH BOTTOM OF CONVEYOR SHUTTLE (DUST PAN) SHOWING.

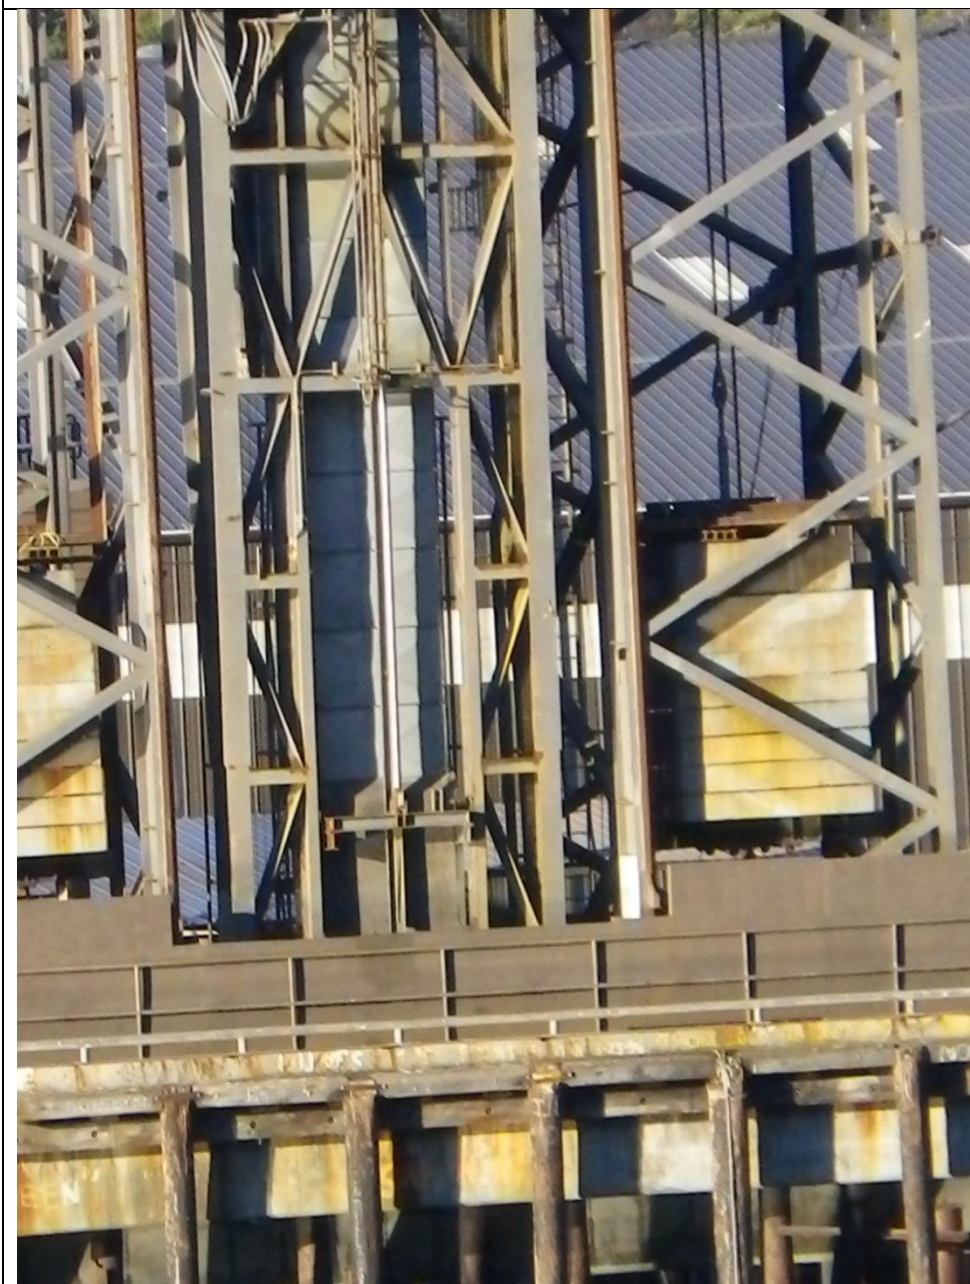

JM-111113-IMGP0279

LOCATION: SKAGWAY ORE TERMINAL

DESCRIPTION: SHIP LOADER - VIEWED FROM WATER SIDE, BOOM RAISED AND PARKED. BOTTOM OF TOWERS, BOOM PARKED, NORTH AND SOUTH TOWER BOOM HOIST COUNTERWEIGHTS AND BOTTOM OF SHIP LOADING CONVEYOR (SHOWING DUST PANS)



JM-111113-IMGP0278

LOCATION: SKAGWAY ORE TERMINAL

DESCRIPTION: SHIP LOADER - VIEWED FROM WATER SIDE, BOOM RAISED AND PARKED. BOTTOM OF SOUTH TOWER SHOWING BOOM HOIST COUNTER WEIGHT.



JM-111113-IMGP0277

LOCATION: SKAGWAY ORE TERMINAL

DESCRIPTION: SHIP LOADER - VIEWED FROM WATER SIDE, BOOM RAISED AND PARKED. SOUTH TOWER, TRANSFER CONVEYOR GALLERY IN BACKGROUND.



JM-111113-IMGP0276

LOCATION: SKAGWAY ORE TERMINAL

DESCRIPTION: SHIP LOADER - OVERALL VIEW FROM THE WATER OF SHIP LOADER WITH BOOM RAISED AND PARKED, HOISTING CAGE, , SMECHANICAL HOISTING EQUIPMENT BRIDGE BETWEEN TOWERS, SPOUT SHUTTLE DISCHARGE SLOT, TRANSFER CONVEYOR IN BACKGROUND.



JM-111113-IMGP0275

LOCATION: SKAGWAY ORE TERMINAL

DESCRIPTION: SHIP LOADER - BOTTOM PORTIION OF SHIP LOADER TOWERS AND FOUNDATION PLATFORM.



JM-111113-IMGP0272

LOCATION: SKAGWAY ORE TERMINAL

DESCRIPTION: SHIP LOADER - OVERALL VIEW OF SHIP LOADER, TRANSFER CONVEYOR, MIDSPAN DRIVE TOWER AND CSB IN BACKGROUND.



JM-111113-IMGP0271

LOCATION: SKAGWAY ORE TERMINAL


DESCRIPTION: SHIP LOADER - OVERALL VIEW OF SHIP LOADER, TRANSFER CONVEYOR, MIDSPAN DRIVE TOWER AND CSB IN BACKGROUND.



**JM-111113-IMG0270**  
**LOCATION: SKAGWAY ORE TERMINAL**  
**DESCRIPTION: VIEW OF SOT AND SHIP LOADER FROM THE WATER (STATE FERRY)**



**JM-111113-IMG0269**  
**LOCATION: SKAGWAY ORE TERMINAL AND SHIP LOADER**  
**DESCRIPTION: DESCRIPTION: VIEW OF SOT AND SHIP LOADER FROM THE WATER (STATE FERRY)**

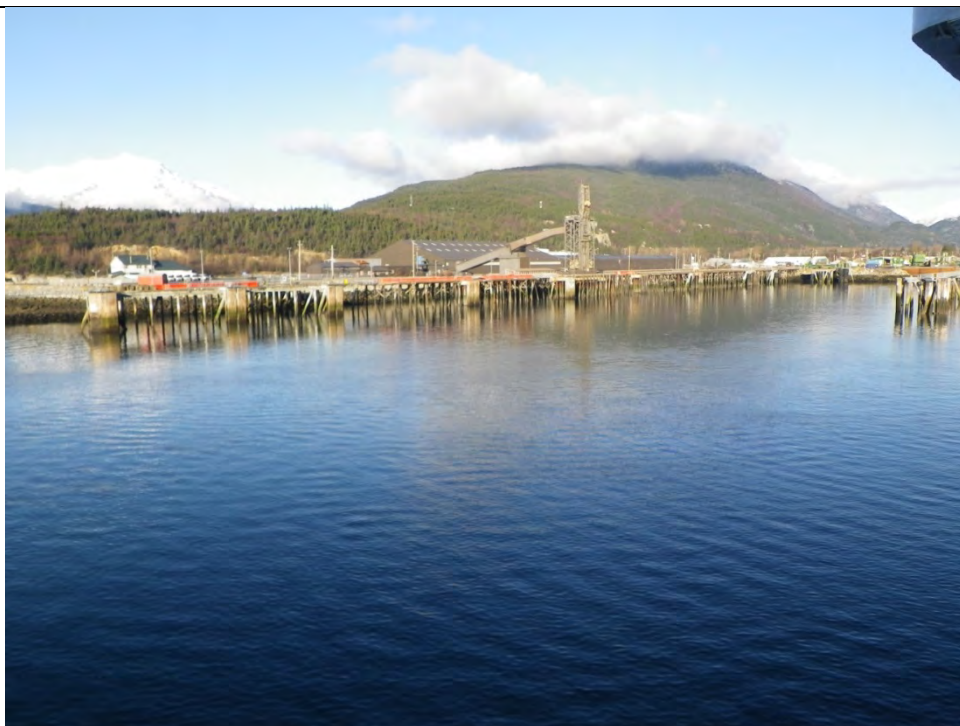

**JM-111113-IMG0268**  
**LOCATION: SKAGWAY ORE TERMINAL**  
**DESCRIPTION: DESCRIPTION: VIEW OF ORE DOCK, SOT AND SHIP LOADER FROM THE WATER (STATE FERRY).**



**JKM-111213-IMG0290**  
**LOCATION: SKAGWAY ORE TERMINAL SHIP LOADER**  
**DESCRIPTION: SHIP LOADER WITH NO. 3 CONVEYOR ON BOOM IN PARKED POSITION (RAISED). INSPECTORS VISIBLE JUST BELOW TRANSFER CONVEYOR ON WEST SIDE OF TOWERS.**



**JKM-111213-IMG0291**  
**LOCATION: SKAGWAY ORE TERMINAL SHIP LOADER**  
**DESCRIPTION: TRANSFER CONVEYOR AND MIDSPAN TOWER/DRIVE TOWER.**



**JKM-111213-IMG0288**  
**LOCATION: SKAGWAY ORE TERMINAL SHIP LOADER**  
**DESCRIPTION: CLOSEUP VIEW (LOOKING NORTH) OF SOUTH SIDE OF SHIP LOADER WITH NO. 3 CONVEYOR ON BOOM IN PARKED POSITION (RAISED). INSPECTOR VISIBLE AT TOP OF SOUTH TOWER ON WEST SIDE.**






**JKM-111213-IMG0287**  
**LOCATION: SKAGWAY ORE TERMINAL SHIP LOADER**  
**DESCRIPTION: CLOSEUP VIEW OF INSPECTOR AT TOP OF SW COLUMN OF SOUTH TOWER. HYDRAULIC EQUIPMENT HOUSE AT LEFT.**



**JKM-111213-IMG0286**  
**LOCATION: SKAGWAY ORE TERMINAL SHIP LOADER**  
**DESCRIPTION: INSPECTOR AT TOP OF SW COLUMN OF SOUTH TOWER. HYDRAULIC EQUIPMENT HOUSE AT LEFT.**




**JKM-111213-IMG0285**  
**LOCATION: SKAGWAY ORE TERMINAL SHIP LOADER**  
**DESCRIPTION: CLOSEUP VIEW (LOOKING SOUTH) OF NORTH SIDE OF SHIP LOADER WITH NO. 3 CONVEYOR ON BOOM IN PARKED POSITION (RAISED). INSPECTOR VISIBLE NEAR TOP OF TOWER.**

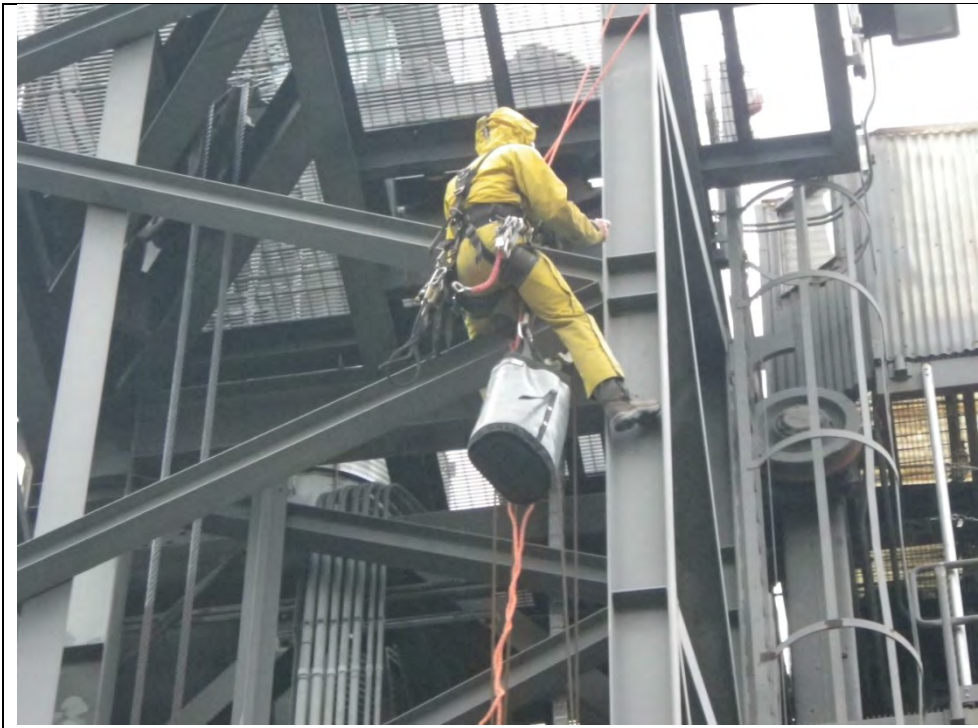

**JKM-111213-IMG0284**  
**LOCATION: SKAGWAY ORE TERMINAL SHIP LOADER**  
**DESCRIPTION: INSPECTOR AT NW COLUMN OF NORTH TOWER**



**JKM-111213-IMG0283**  
**LOCATION: SKAGWAY ORE TERMINAL SHIP LOADER**  
**DESCRIPTION: INSPECTOR RIGGED OFF OF SHIP LOADER BOOM CROSS FRAME BEGINNING BOOM STRUCTURAL INSPECTION.**

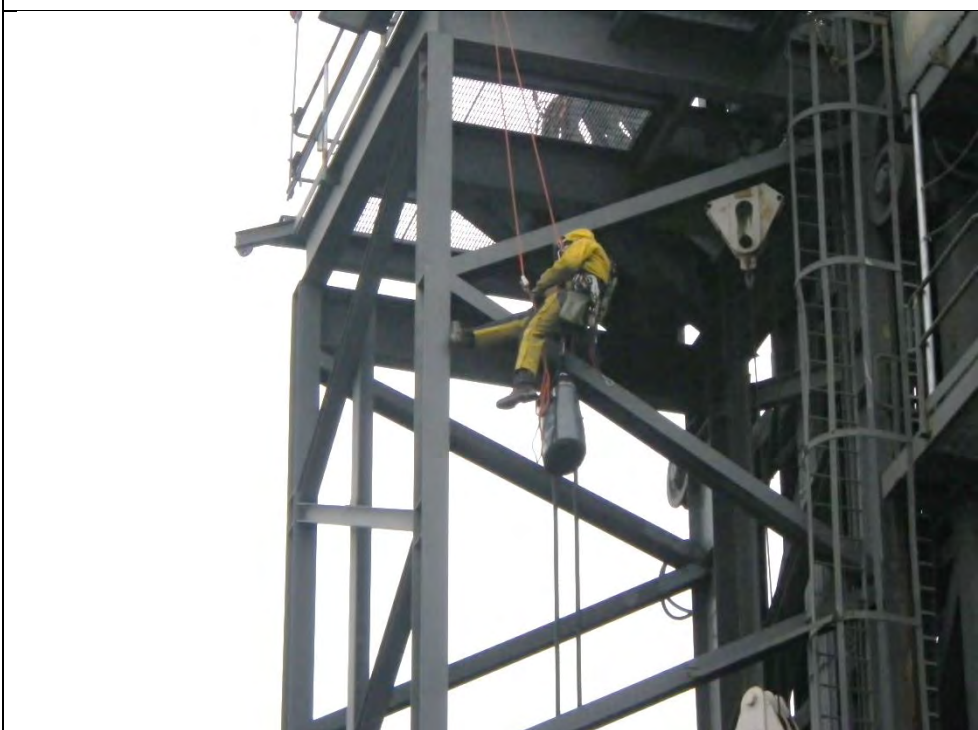

**JKM-111213-IMG0282**  
**LOCATION: SKAGWAY ORE TERMINAL SHIP LOADER**  
**DESCRIPTION: INSPECTOR NEAR TOP OF NORTH TOWER AT NW CORNER COLUMN**



**JKM-111213-IMG0291**  
**LOCATION: SKAGWAY ORE TERMINAL SHIP LOADER**  
**DESCRIPTION: MID SPAN TOWER.TRANSFER CONVEYOR DRIVE TOWER; SIDING HAS BEEN REPLACED SINCE MAY 2013**



**JKM-111213-IMG0434**  
**LOCATION: SKAGWAY ORE TERMINAL SHIP LOADER**  
**DESCRIPTION: INSPECTOR ON CONVEYOR BOOM AT LEFT (NORTH) GIRDER**



**JKM-111213-IMG0433**  
**LOCATION: SKAGWAY ORE TERMINAL ORE DOCK**  
**DESCRIPTION: TRACTOR TUG "ANNA T" LYING ALONGSIDE ORE DOCK**



**JKM-111213-IMG0432**  
**LOCATION: SKAGWAY ORE TERMINAL ORE DOCK**  
**DESCRIPTION: ORE DOCK AS VIEWED FROM ACROSS HARBOR**



**JKM-111213-IMG0431**  
**LOCATION: SKAGWAY ORE TERMINAL ORE DOCK AND SHIP LOADER**  
**DESCRIPTION: ORE DOCK AND SHIP LOADER GENERAL VIEW, INSPECTORS VISIBLE ON SHIP LOADER**




**JKM-111213-IMG0430**  
**LOCATION: SKAGWAY ORE TERMINAL ORE DOCK AND SHIP LOADER**  
**DESCRIPTION: GENERAL VIEW OF SHIP LOADER FROM ACROSS HARBOE, INSPECTORS VISIBLE ON SHIP LOADER**



**JKM-111213-IMG0429**  
**LOCATION: SKAGWAY ORE TERMINAL ORE DOCK**  
**DESCRIPTION: ORE DOCK TO SOUTH OF SHIP LOADER AS VIEWED FROM ACROSS HARBOR**



**JKM-111213-IMG0428**  
**LOCATION: SKAGWAY ORE TERMINAL SHIP LOADER**  
**DESCRIPTION: INSPECTOR ON SOUTH FACE OF SOUTH TOWER, INSPECTING STEEL MEMBERS AND CONNECTIONS**

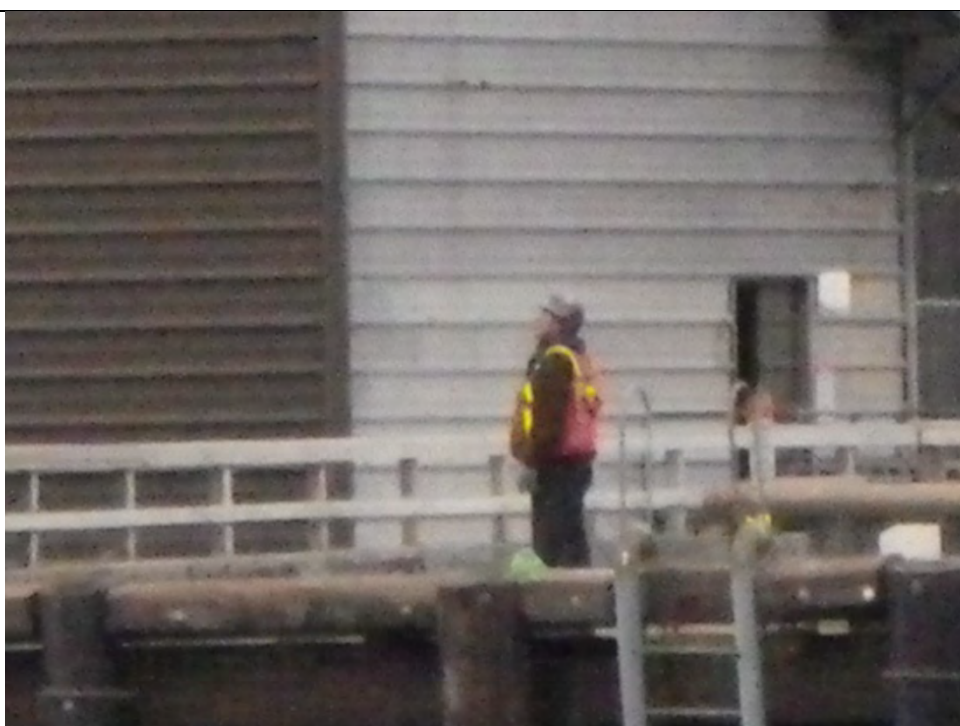

**JKM-111213-IMG0427**  
**LOCATION: SKAGWAY ORE TERMINAL SHIP LOADER**  
**DESCRIPTION: MSI OBSERVER, GENE LINDFORS, ON DOCK, AS SAFETY WATCH OF CLIMBER/INSPECTORS.**



**JKM-111213-IMG0426**  
**LOCATION: SKAGWAY ORE TERRMINAL SHIP LOADER**  
  
**DESCRIPTION: INSPECTOR AT NW COLUMN OF NORTH TOWER, INSPECTING STEEL MEMBERS AND CONNECTIONS;**  
**NOTE HOIST ON JIB BOOM, THE ENTIRE BOOM AND HIOIST INSTALLATION WAS REMOVED BY MSI WHEN CLIMBERS DISCOVERED ATTACHMENT TO NE COLUMN OF NORTH TOWER WAS FAULTY AND ABOUT TO FAIL. INSPECTION OF THE NE TOWER COLUMN COULD NOT BE SAFELY PERFORMED WITH JIB BOOM IN PLACE. SEE PHOTO JKM-111313-IMG0446 OF FAILED BRACKET.**



**JKM-111213-IMG0425**  
**LOCATION: SKAGWAY ORE TERRMINAL SHIP LOADER**  
  
**DESCRIPTION: INSPECTOR AT LEFT (NORTH) GIRDER OF THE SHIP LOADER BOOM, BOOM RAISED, INSPECTING STRUCTURAL MEMBERS AND CONNECTIONS.**



**JKM-111213-IMG0424**  
**LOCATION: SKAGWAY ORE TERMINAL SKAGWAY ORE TERMINAL**  
  
**DESCRIPTION: INSPECTOR AT LEFT (NORTH) GIRDER OF THE SHIP LOADER BOOM, BOOM RAISED, INSPECTING STRUCTURAL MEMBERS AND CONNECTIONS. INSPECTOR IN SAME LOCATION AS IN PHOTO JKM-111213-IMG0425 .**



**JKM-111213-IMGP0423**  
**LOCATION: SKAGWAY ORE TERMINAL SHIP LOADER**  
**DESCRIPTION: AS VIEWED FROM ACROSS HARBOR; NOTE INSPECTORS ON THE SOUTH TOWER, BOOM AND NORTH TOWER (YELLOW SPECS).**



**JKM-111213-IMGP0422**  
**LOCATION: SKAGWAY ORE TERMINAL SHIP LOADER**  
**DESCRIPTION: INSPECTOR ON SOUTH FACE OF SOUTH TOWER**



**JKM-111213-IMGP0421**  
**LOCATION: SKAGWAY ORE TERMINAL SHIP LOADER**  
**DESCRIPTION: INSPECTOR AT NE COLUMN OF NORTH TOWER; JIB BOOM AND HOIST USED FOR GANGWAYS IS ABOVE INSPECTOR.**  
**NOTE FAILED JIB BOOM HINGE BRACKET INDICATED BY RED ARROW. BOOM, HOIST AND BRACKET ULTIMATELY REMOVED BY MSI TO ALLOW SAFE INSPECTION OF TOWER COLUMN.**



**JKM-111213-IMG0420**  
**LOCATION: SKAGWAY ORE TERMINAL SHIP LOADER**  
**DESCRIPTION: INSPECTOR AT NORTH (LEFT) GIRDER OF SHIP LOADER BOOM.**



**JKM-111213-IMG0419**  
**LOCATION: SKAGWAY ORE TERMINAL SHIP LOADER**  
**DESCRIPTION: INSPECTOR HIGHER ON SHIP LOADER NORTH (LEFT) BOOM GIRDER**



**JKM-111213-IMG0418**  
**LOCATION: SKAGWAY ORE TERMINAL SHIP LOADER**  
**DESCRIPTION: INSPECTOR AT NE COLUMN OF NORTH TOWER OF SHIP LOADER.**  
**NOTE JIB BOOM WITH HOIST SUSPENDED FROM THE NE COLUMN OF NORTH TOWER WAS FOUND TO HAVE FAILED CONNECTION TO THE TOWER COLUMN AND WAS REMOVED AFTER THIS PHOTO TAKEN.**





**JKM-111213-IMG0417**  
**LOCATION: SKAGWAY ORE TERMINAL SKAGWAY ORE TERMINAL**  
**DESCRIPTION: INSPECTOR AT NE COLUMN OF NORTH TOWER OF SHIP LOADER**



**JKM-111213-IMG0416**  
**LOCATION: SKAGWAY ORE TERMINAL SHIP LOADER**  
**DESCRIPTION: INSPECTORS ON NORTH TOWER AND BOOM**



**JKM-111213-IMG0415**  
**LOCATION: SKAGWAY ORE TERMINAL SHIP LOADER**  
**DESCRIPTION: COUNTER WEIGHT DOWNHAUL CABLE CONNECTION.**



**JKM-111213-IMG0414**

**LOCATION: SKAGWAY ORE TERMINAL SHIP LOADER**

**DESCRIPTION: COUNTER WEIGHT DOWNHAUL CABLE CONNECTION.**



**JKM-111213-IMG0412**

**LOCATION: SKAGWAY ORE TERMINAL SHIP LOADER**

**DESCRIPTION: HOIST AND DOWNHAUL SHEAVE AT SHIP LOADER BASE**



**JKM-111213-IMG0412**

**LOCATION: SKAGWAY ORE TERMINAL SHIP LOADER**

**DESCRIPTION: BASE OF SW COLUMN OF NORTH TOWER OF SHIP LOADER**



**JKM-111213-IMG0411**  
**LOCATION: SKAGWAY ORE TERMINAL SHIP LOADER**  
**DESCRIPTION: BASE OF SW COLUMN OF NORTH TOWER OF SHIP LOADER**



**JKM-111213-IMG0410**  
**LOCATION: SKAGWAY ORE TERMINAL SHIP LOADER**  
**DESCRIPTION: BASE OF SW COLUMN OF NORTH TOWER OF SHIP LOADER**



**JKM-111213-IMG0409**  
**LOCATION: SKAGWAY ORE TERMINAL SHIP LOADER**  
**DESCRIPTION: FRAME CONNECTION AT BASE OF WEST FACE OF NORTH TOWER OF SHIP LOADER; NOTE DRAIN HOLE IN "POCKET" FORMED BY WF FLANGES**



**JKM-111213-IMG0408**  
**LOCATION: SKAGWAY ORE TERMINAL SHIP LOADER**  
  
**DESCRIPTION: FRAME CONNECTION AT BASE OF WEST FACE OF NORTH TOWER OF SHIP LOADER; NOTE DRAIN HOLE IN "POCKET" FORMED BY WF FLANGES; THIS IS SAME AS PHOTO JKM-111213-IMG0409 EXCEPT ROPE REMOVED FOR VISIBILITY.**



**JKM-111213-IMG0407**  
**LOCATION: SKAGWAY ORE TERMINAL SHIP LOADER**  
  
**DESCRIPTION: COUNTER WEIGHT RIGGING SHEAVES, BASE OF NORTH TOWER.**



**JKM-111213-IMG0406**  
**LOCATION: SKAGWAY ORE TERMINAL SHIP LOADER**  
  
**DESCRIPTION: COUNTER WEIGHT RIGGING SHEAVES, BASE OF NORTH TOWER.**



**JKM-111213-IMG0405**  
**LOCATION: SKAGWAY ORE TERMINAL SHIP LOADER**  
**DESCRIPTION: NORTH TOWER BASE SE COLUMN, FRAMING AND BASE PLATE**



**JKM-111213-IMG0404**  
**LOCATION: SKAGWAY ORE TERMINAL SHIP LOADER**  
**DESCRIPTION: BASE OF SE COLUMN NORTH TOWER**



**JKM-111213-IMG0403**  
**LOCATION: SKAGWAY ORE TERMINAL SHIP LOADER**  
**DESCRIPTION: TOWER FRAME CONNECTION, NOTE DRAIN HOLE**



**JKM-111213-IMGP0402**  
**LOCATION: SKAGWAY ORE TERMINAL SHIP LOADER**  
**DESCRIPTION: CLOSE UP OF DRAIN HOLE IN JOINT SHOWN IN PHOTO JKM-111213-IMGP0403**



**JKM-111213-IMGP0401**  
**LOCATION: SKAGWAY ORE TERMINAL SHIP LOADER**  
**DESCRIPTION: NORTH TOWER NE BASE FRAMING**



**JKM-111213-IMGP0400**  
**LOCATION: SKAGWAY ORE TERMINAL SHIP LOADER**  
**DESCRIPTION: NORTH TOWER NE BASE**



**JKM-111213-IMG0399**  
**LOCATION: SKAGWAY ORE TERMINAL SHIP LOADER**  
**DESCRIPTION: NORTH TOWER COUNTER BALANCE RIGGING SHEAVES; SOUTH TOWER SHEAVES VSIBLE IN BACKGROUND.**



**JKM-111213-IMG0398**  
**LOCATION: SKAGWAY ORE TERMINAL SHIP LOADER**  
**DESCRIPTION: COUNTER WEIGHT SHEAVES**



**JKM-111213-IMG0397**  
**LOCATION: SKAGWAY ORE TERMINAL SKAGWAY ORE TERMINAL**  
**DESCRIPTION: NORTH TOWER SW COLUMN BASE AND ACCESS LADDER**



**JKM-111213-IMG0396**  
**LOCATION: SKAGWAY ORE TERMINAL SHIP LOADER**  
**DESCRIPTION: NORTH TOWER SW COLUMN BASE**



**JKM-111213-IMG0395**  
**LOCATION: SKAGWAY ORE TERMINAL SHIP LOADER**  
**DESCRIPTION: SW COLUMN BASE NORTH TOWER**



**JKM-111213-IMG0394**  
**LOCATION: SKAGWAY ORE TERMINAL SHIP LOADER**  
**DESCRIPTION:**





**JKM-111213-IMG0393**  
**LOCATION: SKAGWAY ORE TERMINAL SHIP LOADER**  
**DESCRIPTION:**



**JKM-111213-IMG0392**  
**LOCATION: SKAGWAY ORE TERMINAL SHIP LOADER**  
**DESCRIPTION: NE COLUMN SOUTH TOWER BASE CONVEYOR BOOM PARKING LIMIT SWITCH**



**JKM-111213-IMG0391**  
**LOCATION: SKAGWAY ORE TERMINAL SHIP LOADER**  
**DESCRIPTION: SOUTH COUNTER WEIGHT DOWN HAUL CABLE CONNECTION**



**JKM-111213-IMG0390**  
**LOCATION: SKAGWAY ORE TERMINAL SHIP LOADER**  
**DESCRIPTION: SOUTH COUNTER WEIGHT DOWN HAUL CABLE CONNECTION**



**JKM-111213-IMG0389**  
**LOCATION: SKAGWAY ORE TERMINAL SHIP LOADER**  
**DESCRIPTION: SOUTH COUNTER WEIGHT DOWN HAUL CABLE CONNECTION**



**JKM-111213-IMG0388**  
**LOCATION: SKAGWAY ORE TERMINAL SHIP LOADER**  
**DESCRIPTION: SOUTH COUNTER WEIGHT DOWN HAUL CABLE CONNECTION; CABLE AND SOCKET CLEVIS**



**JKM-111213-IMG0387**  
**LOCATION: SKAGWAY ORE TERMINAL SHIP LOADER**  
**DESCRIPTION: SOUTH COUNTER WEIGHT DOWN HAUL CABLE CONNECTION; CLEVIS AND CONNECTION TO COPUNTER WEIGHT BOTTOM**



**JKM-111213-IMG0386**  
**LOCATION: SKAGWAY ORE TERMINAL SHIP LOADER**  
**DESCRIPTION: NORTH TOWER BASE FRAME CONNECTION**



**JKM-111213-IMG0385**  
**LOCATION: SKAGWAY ORE TERMINAL SHIP LOADER**  
**DESCRIPTION: SHIP LOADER BOOM PARKING STOOL AT BASE OF TOWER**



**JKM-111213-IMG0384**  
**LOCATION: SKAGWAY ORE TERMINAL SHIP LOADER**  
**DESCRIPTION: TOWER COLUMN BASE**



**JKM-111213-IMG0383**  
**LOCATION: SKAGWAY ORE TERMINAL SHIP LOADER**  
**DESCRIPTION: TOWER BASE FRMING, NOTE FLAME CUT DRAIN HOLE**



**JKM-111213-IMG0382**  
**LOCATION: SKAGWAY ORE TERMINAL SKAGWAY ORE TERMINAL**  
**DESCRIPTION: TOWER COLUMN BASE, NOTER CORROSION AT COLUMN TO BASE PLATE JOINT**



**JKM-111213-IMG0381**  
**LOCATION: SKAGWAY ORE TERMINAL SHIP LOADER**  
**DESCRIPTION: TOWER BASE FRAMING**



**JKM-111213-IMG0380**  
**LOCATION: SKAGWAY ORE TERMINAL SHIP LOADER**  
**DESCRIPTION: SOUTH TOWER SE COLUMN BASE FRAMING??**



**JKM-111213-IMG0379**  
**LOCATION: SKAGWAY ORE TERMINAL SHIP LOADER**  
**DESCRIPTION: SOUTH TOWER SE COLUMN AT BASE**



**JKM-111213-IMG0378**

**LOCATION: SKAGWAY ORE TERMINAL SHIP LOADER**

**DESCRIPTION: SOUTH TOWER COUNTER WEIGHT  
HOIST/DOWN HAUL SHEAVES**



**JKM-111213-IMG0377**

**LOCATION: SKAGWAY ORE TERMINAL SHIP LOADER**

**DESCRIPTION: SOUTH TOWER COUNTER WEIGHT  
HOIST/DOWN HAUL SHEAVES AND NE COLUMN OF SOUTH  
TOWER**



**JKM-111213-IMG0376**

**LOCATION: SKAGWAY ORE TERMINAL SHIP LOADER**

**DESCRIPTION: SOUTH TOWER SOUTH SIDE OF SW COLUMN  
BASE**



**JKM-111213-IMG0375**  
**LOCATION: SKAGWAY ORE TERMINAL SHIP LOADER**  
**DESCRIPTION: SOUTH TOWER NORTH SIDE OF SW COLUMN BASE**



**JKM-111213-IMG0374**  
**LOCATION: SKAGWAY ORE TERMINAL SHIP LOADER**  
**DESCRIPTION: SW COLUMN OF SOUTH TOWER; SHOWING WATER TRA IN WF CONNECTION WITH DRAIN HOLE; AIR MONITOR UNIT IN BACK LEFT OF PHOTO**



**JKM-111213-IMG0373**  
**LOCATION: SKAGWAY ORE TERMINAL SHIP LOADER**  
**DESCRIPTION: SW COLUMN OF SOUTH TOWER; SHOWING WATER TRA IN WF CONNECTION WITH DRAIN HOLE; AIR MONITOR UNIT IN BACK LEFT OF PHOTO**



**JKM-111213-IMG0372**  
**LOCATION: SKAGWAY ORE TERMINAL SKAGWAY ORE TERMINAL**  
**DESCRIPTION: SOUTH TOWER NW COLUMN FRAMING IN NORTH FACE OF TOWER**



**JKM-111213-IMG0371**  
**LOCATION: SKAGWAY ORE TERMINAL SHIP LOADER**  
**DESCRIPTION: SOUTH TOWER NW COLUMN AND FRAMING CONNECTION**



**JKM-111213-IMG0370**  
**LOCATION: SKAGWAY ORE TERMINAL SHIP LOADER**  
**DESCRIPTION: SOUTH TOWER NW COLUMN BASE SOUTH FACE**






**JKM-111213-IMG0369**

**LOCATION: SKAGWAY ORE TERMINAL SHIP LOADER**

**DESCRIPTION: SOUTH TOWER NW COLUMN BASE NORTH FACE**

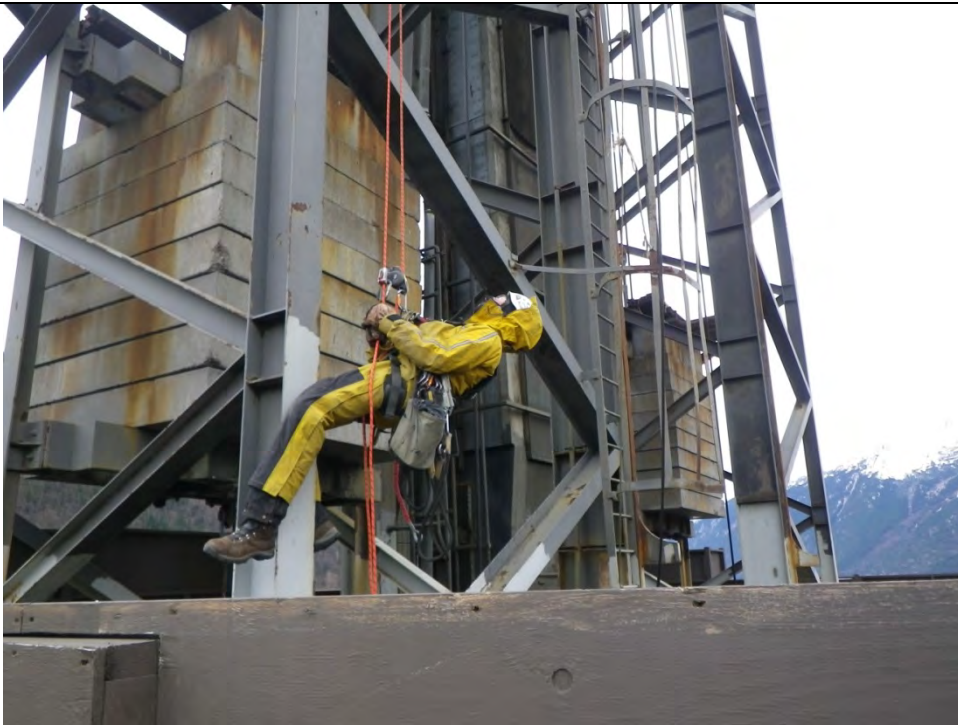

**JKM-111213-IMG0435**

**LOCATION: SKAGWAY ORE TERMINAL SHIP LOADER**

**DESCRIPTION: INSPECTOR SUSPENDED AT BOTTOM OF NORTH TOWER NW COLUMN AFTER INSPECTION DESCENT**



**JKM-111313-IMG0480**

**LOCATION: SKAGWAY ORE TERMINAL SHIP LOADER**

**DESCRIPTION: SHIP LOADER SHUTTLE BEAM LATERAL SUPPORT FROM GIRDER**



**JKM-111313-IMG0479**

**LOCATION: SKAGWAY ORE TERMINAL SHIP LOADER**

**DESCRIPTION: SHIP LOADER BOOM SHUTTLE BEAM TO GIRDER FRAMING**



**JKM-111313-IMG0478**

**LOCATION: SKAGWAY ORE TERMINAL SHIP LOADER BOOM**

**DESCRIPTION: SHUTTLE OPERATING RAM AND BOTTOM VIEW OF BOOM STRUCTURE AT THE TAIL END AS VIEWED FROM SHIP LOADER BASE WITH BOOM IN LOWEST OPERATING POSITION. SHUTTLE TRACK/RUNWAY BEAMS FRAMED TO BOOM GIRDERS. CONVEYOR DUST PANELS VISIBLE ABOVE THE HYDRAULIC RAM.**



**JKM-111313-IMG0477**

**LOCATION: SKAGWAY ORE TERMINAL SHIP LOADER LOADER BOOM**

**DESCRIPTION: UNDERSIDE OF BOOM AND CONVEYOR SHUTTLE LOOKING TOWARD DISCHARGE END OF CONVEYOR; NOT DAMAGED DUST CONTAINMENT PANELS.**



**JKM-111313-IMG0476**

**LOCATION: SKAGWAY ORE TERMINAL SHIP LOADER BOOM**

**DESCRIPTION: LOOKING ALONG RIGHT GIRDER AND SHUTTLE SUPPORT BEAM AT HEAD END**



**JKM-111313-IMG0475**

**LOCATION: SKAGWAY ORE TERMINAL SHIP LOADER SHIP LOADER BOOM**

**DESCRIPTION:**



**JKM-111313-IMGP0474**

**LOCATION: SKAGWAY ORE TERMINAL SHIP LOADER**


**DESCRIPTION: INSPECTOR ON SOUTH TOWER SE COLUMN**



**JKM-111313-IMGP0473**

**LOCATION: SKAGWAY ORE TERMINAL SHIP LOADER**

**DESCRIPTION: SPOUT INSPECTOR EXAMINING DOWN HAUL CABLE ON NORTH TOWER COUNTER WEIGHT**

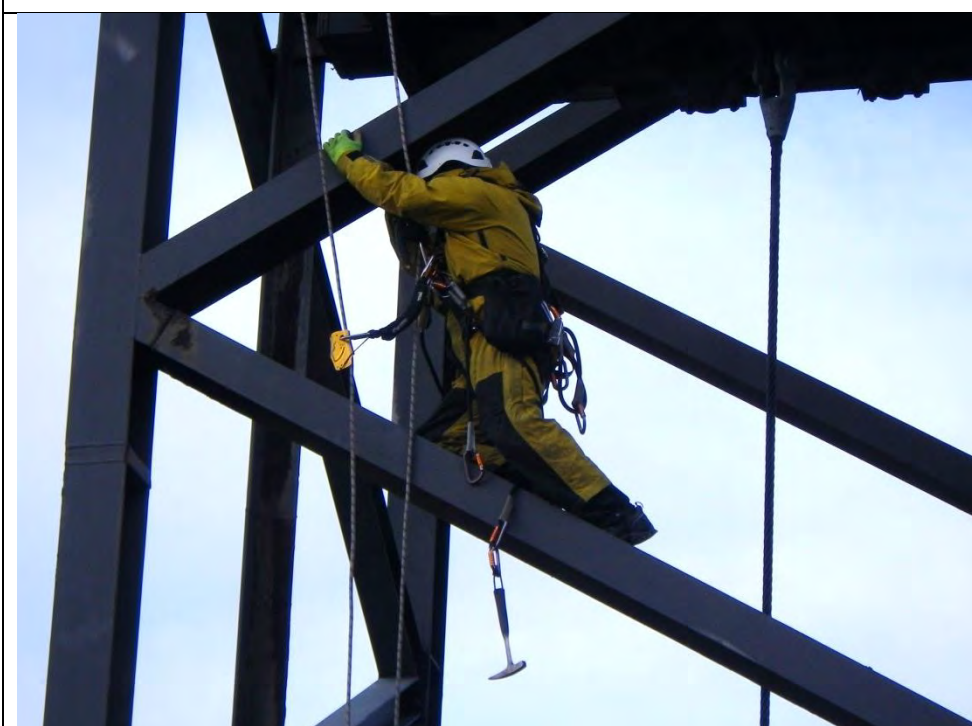


**JKM-111313-IMGP0472**

**LOCATION: SKAGWAY ORE TERMINAL SHIP LOADER**


**DESCRIPTION: INSPECTOR ON SOUTH TOWER SE COLUMN AREA**




**JKM-111313-IMGP0471**  
**LOCATION: SKAGWAY ORE TERMINAL SHIP LOADER BOOM**  
  
**DESCRIPTION: LATERAL SUPPORT FROM RIGHT (SOUTH) BOOM GIRDER TO RIGHT SHUTTLE SUPPORT BEAM/RUNWAY**

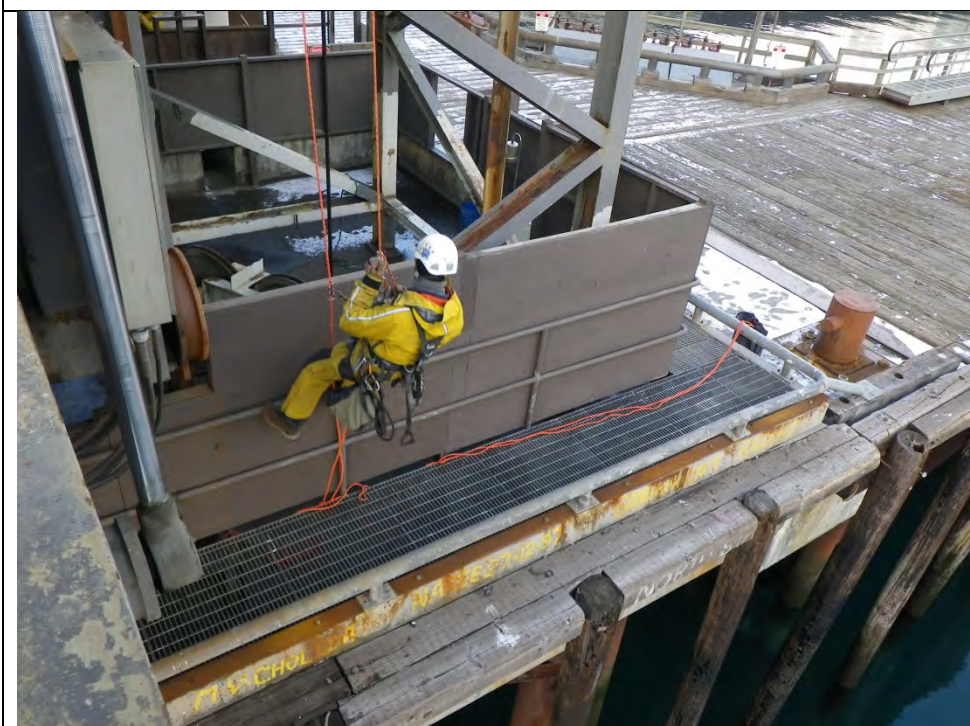

**JKM-111313-IMGP0470**  
**LOCATION: SKAGWAY ORE TERMINAL SHIP LOADER**  
  
**DESCRIPTION: INSPECTOR ON EAST FACE OF NORTH TOWER, SHIP LOADER CONVEYOR BOOM HOISTING CAGE VISIBLE AT LEFT**

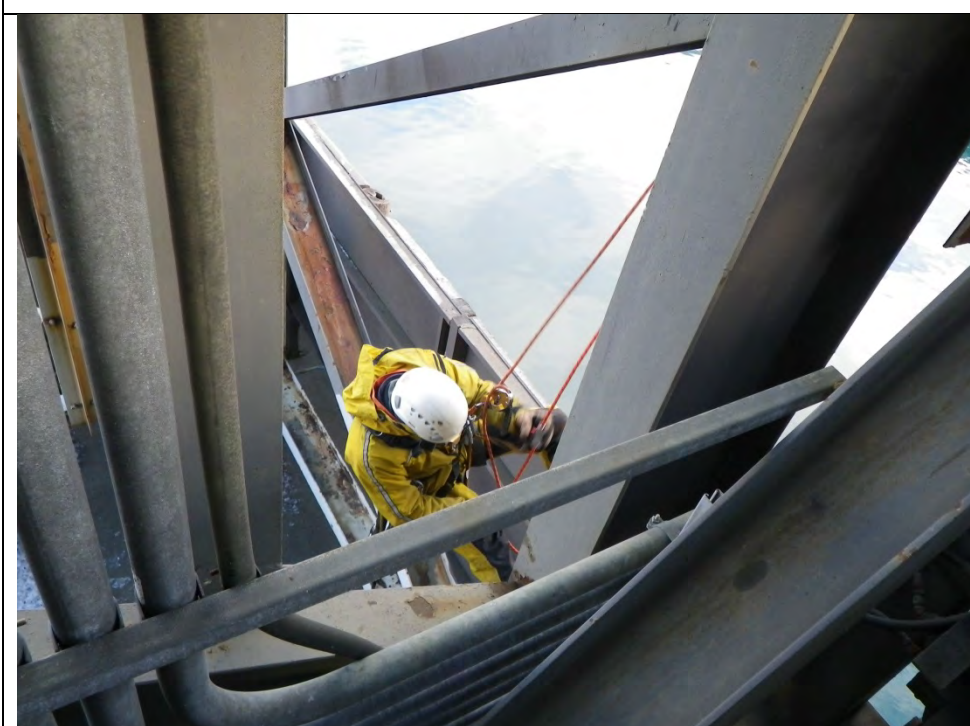

**JKM-111313-IMGP0469**  
**LOCATION: SKAGWAY ORE TERMINAL SHIP LOADER**  
  
**DESCRIPTION: INSPECTOR ON SE COLUMN OF NORTH TOWER AS VIEWED FROM SHIP LOADER BOOM**

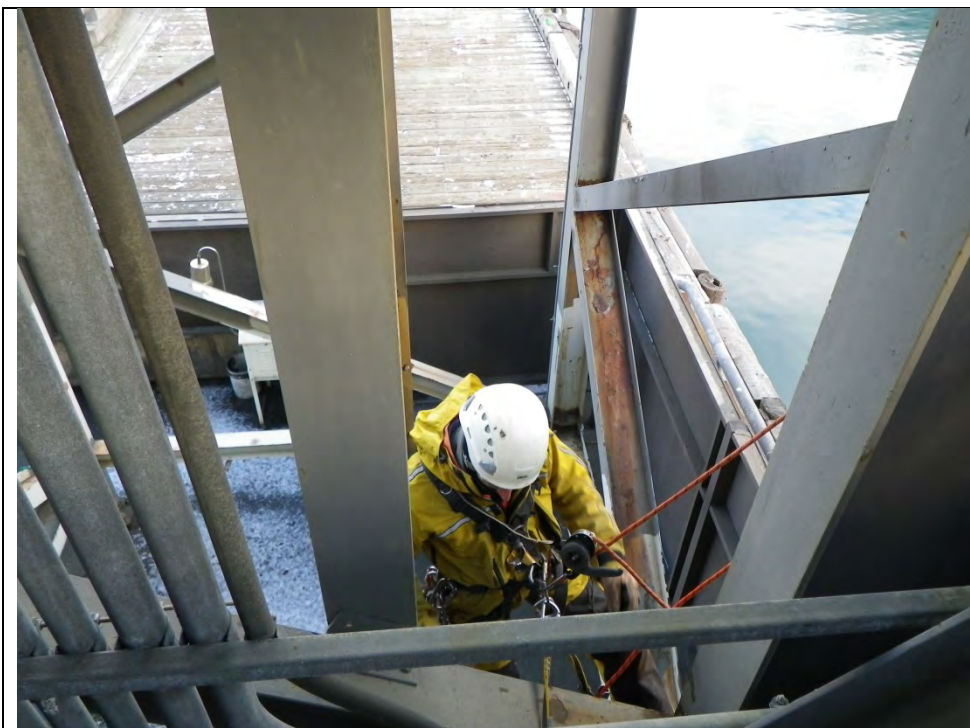

**JKM-111313-IMG0468**

**LOCATION: SKAGWAY ORE TERMINAL SHIP LOADER**

**DESCRIPTION: INSPECTOR ON SE COLUMN OF NORTH TOWER AS VIEWED FROM SHIP LOADER BOOM; NE COLUMN IN BACKGROUND**



**JKM-111313-IMG0467**

**LOCATION: SKAGWAY ORE TERMINAL SHIP LOADER BOOM**

**DESCRIPTION: RIGHT (SOUTH) SHUTTLE CARRIER WHEEL AND SHUTTLE SUPPORT BEAM AND RUNWAY. NOTE GAP BETWEEN WHEEL FLANGE AND RUNWAY BEAM FLANGE**



**JKM-111313-IMG0466**

**LOCATION: SKAGWAY ORE TERMINAL SHIP LOADER BOOM**

**DESCRIPTION: RIGHT (SOUTH) SHUTTLE CARRIER WHEEL AND SHUTTLE SUPPORT BEAM AND RUNWAY. NOTE GAP BETWEEN WHEEL FLANGE AND RUNWAY BEAM FLANGE**



**JKM-111313-IMGP0465**

**LOCATION: SKAGWAY ORE TERMINAL SHIP LOADER BOOM**

**DESCRIPTION: SHUTTLE RUNWAY AND SUPPORT BEAM  
LATERAL SUPPORT TO BOOM GIRDER**



**JKM-111313-IMGP0464**

**LOCATION: SKAGWAY ORE TERMINAL SHIP LOADER BOOM**

**DESCRIPTION: SHUTTLE RUNWAY AND SUPPORT BEAM AT  
STIFFENER INBOARD FROM SHUTTLE CARRIER WHEEL  
LOCATION**



**JKM-111313-IMGP0463**

**LOCATION: SKAGWAY ORE TERMINAL SHIP LOADER BOOM**

**DESCRIPTION: SHUTTLE RUNWAY AND SUPPORT BEAM  
LATERAL SUPPORT TO BOOM GIRDER**



**JKM-111313-IMG0462**

**LOCATION: SKAGWAY ORE TERMINAL SHIP LOADER BOOM**

**DESCRIPTION: LEFT SIDE SHUTTLE RUNWAY AND SUPPORT BEAM AND HANDRAIL; LEFT CARRIER WHEEL VISIBLE INSIDE CARRIER BEAM/RUNWAY**



**JKM-111313-IMG0461**

**LOCATION: SKAGWAY ORE TERMINAL SHIP LOADER BOOM**

**DESCRIPTION: RIGHT SIDE SHUTTLE SUPPORT BEAM; RIGHT CARRIER WHEEL VISIBLE INSIDE CARRIER BEAM RUNWAY; NOTE WEAR ON BEAM FLANGE AND FLANGE BENT DOWNWARD TO SLOPE OF SHUTTLE WHEEL "TREAD"; FLANGE TO WHEEL FLANGE GAP EXCESSIVE.**




**JKM-111313-IMG0460**


**LOCATION: SKAGWAY ORE TERMINAL SHIP LOADER BOOM**

**DESCRIPTION: RIGHT SIDE SHUTTLE SUPPORT BEAM; RIGHT CARRIER WHEEL VISIBLE INSIDE CARRIER BEAM RUNWAY; NOTE WEAR ON BEAM FLANGE AND FLANGE BENT DOWNWARD TO SLOPE OF SHUTTLE WHEEL "TREAD"; FLANGE TO WHEEL FLANGE GAP EXCESSIVE.**



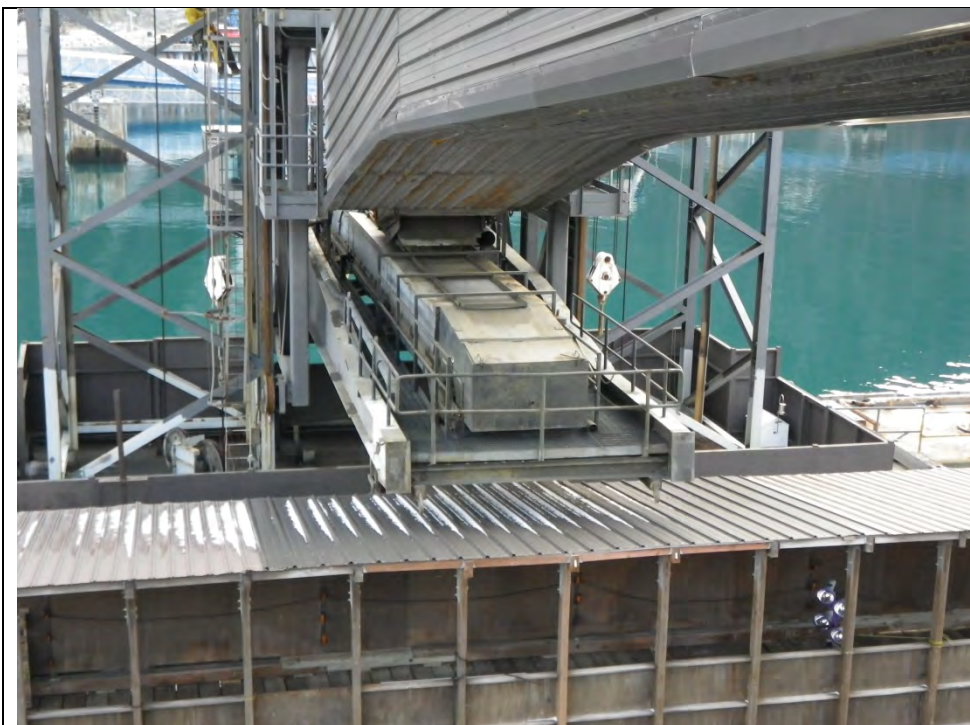

**JKM-111313-IMGP0459**  
**LOCATION: SKAGWAY ORE TERMINAL SHIP LOADERSHIP LOADER BOOM AND TRANSFER CONVEYOR**  
**DESCRIPTION: BACK END OF SHIP LOADER AND CONVEYOR SHUTTLE WITH SHIPLOADER LOWERED TO LOWEST LEVEL. LEFT TOWER IS NORTH TOWER (INSHORE TOWER), RIGHT TOWER IS SOUTH TOWER (OFFSHORE TOWER); INSPECTOR AT SE COLUMN OF NORTH TOWER.**

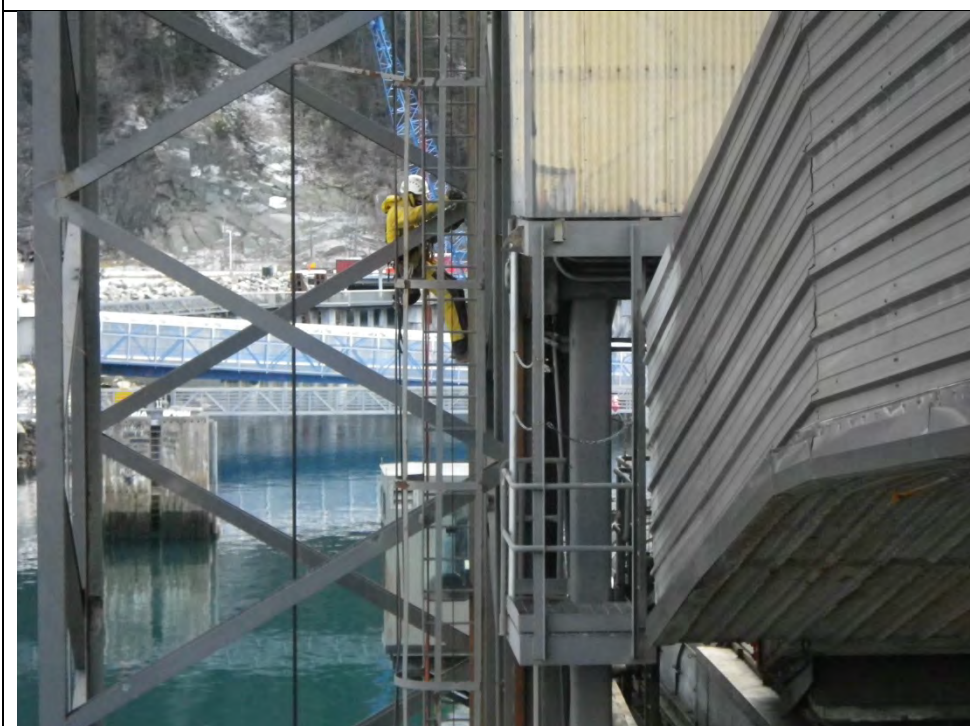

**JKM-111313-IMGP0458**  
**LOCATION: SKAGWAY ORE TERMINAL SHIP LOADER SHIP LOADER NORTH TOWER (INSHORE TOWER)**  
**DESCRIPTION: EAI INSPECTOR EXAMINING TOWER FRAME MEMBERS AND CONNECTIONS.**



**JKM-111313-IMGP0457**  
**LOCATION: SKAGWAY ORE TERMINAL SHIP LOADER BOOM**  
**DESCRIPTION: SOUTH (RIGHTHAND) GIRDER AT EYE-BAR STAY CONNECTION AND BOOM SPLICE (BOLTED PLATES); DROP IN PROFILE OF GIRDER IS BEGINNING OF DISCHARGE END OF SHUTTLE AND DRIVE END OF CONVEYOR.**



**JKM-111313-IMGP0456**

**LOCATION: SKAGWAY ORE TERMINAL SHIP LOADER**

**DESCRIPTION: SHIP LOADER WITH BOOM DEPLOYED BUT RAISED TO TOP LEVEL OF RANGE; SOUTH SIDE (OFFSHORE) ELEVATION VIEW OF SHIPLOADER. EAI INSPECTORS VIEWING OPERATION OF SHIPLOADER BY SPOUT INSPECTOR FROM GANGWAY USED A BRIDGE ACROSS DAMAGE/MISSING SECTION OF ORE DOCK.**



**JKM-111313-IMGP0455**

**LOCATION: SKAGWAY ORE TERMINAL SHIP LOADER**

**DESCRIPTION: VIEW OF BASE OF SHIP LOADER AND ACCESS BRIDGE ACROSS DESTROYED SECTION OF ORE DOCK SOUTH OF SHIP LOADER.**



**JKM-111313-IMGP0454**

**LOCATION: SKAGWAY ORE TERMINAL SHIP LOADER BOOM**

**DESCRIPTION: BOTTOM FLANGE SPLICE PLATES ON NORTH (LEFT) GIRDER; FRAMING BETWEEN BOOM GIRDERS VISIBLE.**



**JKM-111313-IMGP0453**  
**LOCATION: SKAGWAY ORE TERMINAL SHIP LOADER SHIP LOADER BOOM**  
**DESCRIPTION: SPLICE PLATES ON NORTH (LEFT) GIRDER AND EYE BAR STAYS OF SHIP LOADER BOOM**



**JKM-111313-IMGP0452**  
**LOCATION: SKAGWAY ORE TERMINAL SHIP LOADER**  
**DESCRIPTION: SHIP LOADER BOOM HOISTING CAGE AND CONNECTION POINT OF TRANSFER CONVEYOR TO SHIP LOADER BOOM; HYDRAULIC LUFFING RAMS AND EYE BAR STAYS ALSO VISIBLE. SHIP LOADER BOOM AT LOWEST DEPLOYED POSITION**



**JKM-111313-IMGP0451**  
**LOCATION: SKAGWAY ORE TERMINAL SHIP LOADER**  
**DESCRIPTION: VIEW OF NORTH SIDE OF TRANSFER CONVEYOR AND MIDSPAN SUPPORT AND DRIVE TOWER.**



**JKM-111313-IMGP0450**

**LOCATION: SKAGWAY ORE TERMINAL SHIP LOADER**

**DESCRIPTION: VIEW OF NORTH SIDE OF SHIP LOADER, TRANSFER CONVEYOR, MIDSPAN SUPPORT AND DRIVE TOWER.**



**JKM-111313-IMGP0449**

**LOCATION: SKAGWAY ORE TERMINAL SHIP LOADER**

**DESCRIPTION: VIEW OF NORTH SIDE OF SHIP LOADER AND TRANSFER CONVEYOR**



**JKM-111313-IMGP0448**

**LOCATION: SKAGWAY ORE TERMINAL SHIP LOADER**

**DESCRIPTION: GANGWAY HANDLING JIB CRANE FAILED BOOM BRACKET**



**JKM-111313-IMGP0447**

**LOCATION: SKAGWAY ORE TERMINAL SHIP LOADER**


**DESCRIPTION: GANGWAY HANDLING JIB CRANE FAILED BOOM BRACKET**



**JKM-111313-IMGP0446**

**LOCATION: SKAGWAY ORE TERMINAL SHIP LOADER**

**DESCRIPTION: GANGWAY HANDLING JIB CRANE FAILED BOOM BRACKET**

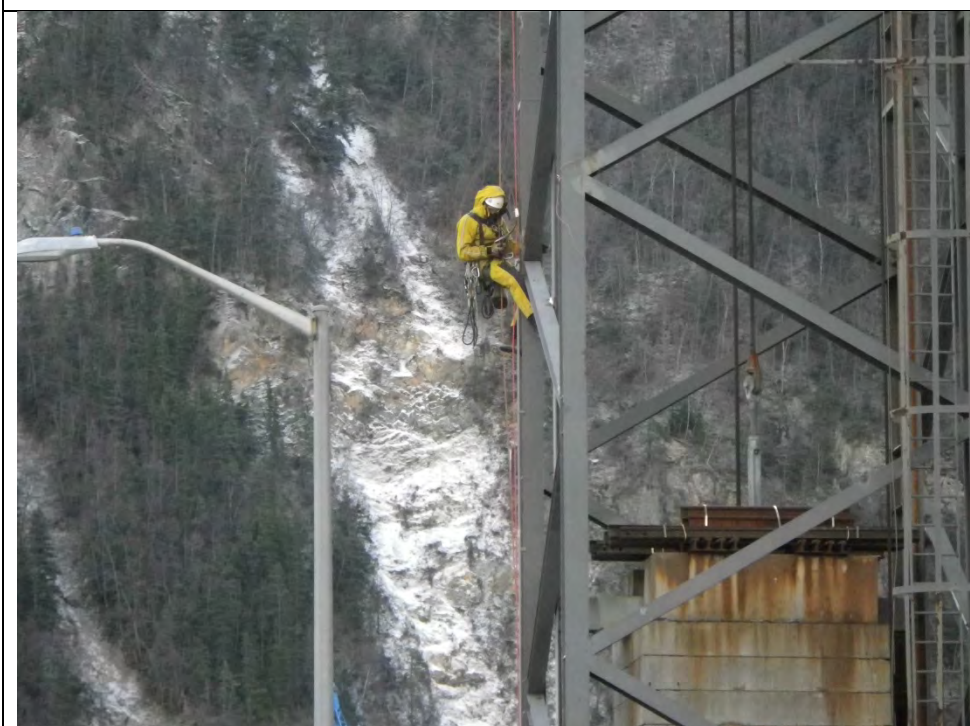

**JKM-111313-IMGP0445**

**LOCATION: SKAGWAY ORE TERMINAL SHIP LOADER**

**DESCRIPTION: INSPECTOR AT NW COLUMN OF NORTH TOWER; NOTE GANGWAY BOOM AND HOIST REMOVED.**



**JKM-111313-IMG0444**

**LOCATION: SKAGWAY ORE TERMINAL SHIP LOADER**

**DESCRIPTION: WEST SIDE OF SHIP LOADER INSPECTOR ON SE COLUMN OF NORTH TOWER. SHIP LOADER BOOM PARKED.**



**JKM-111313-IMG0443**

**LOCATION: SKAGWAY ORE TERMINAL SHIP LOADER**

**DESCRIPTION: WEST SIDE OF SHIP LOADER INSPECTOR ON SE COLUMN OF NORTH TOWER. SHIP LOADER BOOM PARKED.**



**JKM-111313-IMG0442**  
**LOCATION: SKAGWAY ORE TERMINAL SHIP LOADER**  
**DESCRIPTION: INSPECTOR ON SE COLUMN OF NORTH TOWER**



**JKM-111313-IMG0441**  
**LOCATION: SKAGWAY ORE TERMINAL SHIP LOADER**  
**DESCRIPTION: SHIP LOADER POWER DISCONNECT IN MAIN MCC (MCC NO. 1) LOCKED OUT/TAGGED OUT**



**JKM-111313-IMGP0440**  
**LOCATION: SKAGWAY ORE TERMINAL SHIP LOADER**  
**DESCRIPTION: INSPECTOR ENTERING DOOR AT BASE OF TRANSFER CONVEYOR MID-SPAN SUPPORT AND DRIVE TOWER**



**JKM-111313-IMGP0439**  
**LOCATION: SKAGWAY ORE TERMINAL SHIP LOADER**  
**DESCRIPTION: SHIP LOADER AND TRANSFER CONVEYOR VIEWED FROM SHORE TO WEST OF THE ORE DOCK; INSPECTOR DESCENDING STAIWAY FROM DRIVE DECK TO BASE OF SUPPORT TOWER.**



**JKM-111313-IMGP0438**  
**LOCATION: SKAGWAY ORE TERMINAL SHIP LOADER**  
**DESCRIPTION: FRESH SNOW AT BASE OF SHIP LOADER; VIEW FROM NORTH TOWER TO SOUTH TOWER ALONG WEST SIDE OF SHIPLOADER TOWERS**





**JKM-111313-IMG0437**

**LOCATION: SKAGWAY ORE TERMINAL SHIP LOADER**

**DESCRIPTION: NORTH SIDE OF NORTH TOWER (LOOKING SOUTH); BOOM PARKED. NOTE GUIDE WHEELS OF BOOM CAGE AT LEFT.**



**JKM-111313-IMG0436**

**LOCATION: SKAGWAY ORE TERMINAL SHIP LOADER**

**DESCRIPTION: EAI INSPECTOR LOOKING DOWN FROM NORTH END OF HOIST DECK ON TOP OF SHIP LOADER TOWERS**

# **Appendix 3**

## **Ship Loader Boom Inspection Photos and Notes**



**SH-111213-29 SKAGWAY ORE TERMINAL SHIP LOADER**  
**LOCATION: SHIP LOADER BOOM 12 SOUTH**  
**DESCRIPTION: DIAGONAL DOWN TO 1/8-INCH THICK. 1/32-INCH SECTION LOSS TO MAIN WEB ALONG DIAGONAL WELD. SAME CONDITION AT 12 NORTH.**  
**CONDITION STATE CS5**



**SH-111213-28 SKAGWAY ORE TERMINAL SHIP LOADER**  
**LOCATION: SHIP LOADER BOOM 11 SOUTH V-BRACE**  
**DESCRIPTION: DIAGONAL RUSTED THROUGH. SAME ON NORTH V-BRACE.**  
**CONDITION STATE CS5**



**SH-111213-27 SKAGWAY ORE TERMINAL SHIP LOADER**  
**LOCATION: SHIP LOADER BOOM 11 SOUTH INTERIOR**  
**DESCRIPTION: BOTH WEBS HAVE 1/16-INCH LOSS AREA 8"X2" EACH**  
**CONDITION STATE CS5**



SH-111213-26 SKAGWAY ORE TERMINAL SHIP LOADER

LOCATION: SHIP LOADER BOOM 10 NORTH INTERIOR

DESCRIPTION: DIAGONAL WEB HAS 1/16-INCH REMAINING SECTION. MAIN GIRDER WEB HAS SECTION LOSS TO 1/8-INCH 10" TALL X 4" WIDE. TRANSVERSE WEB HAS SECTION LOSS TO 1/8-INCH 6"X6".

CONDITION STATE CS5



SH-111213-25 SKAGWAY ORE TERMINAL SHIP LOADER

LOCATION: SHIP LOADER BOOM 10 SOUTH INTERIOR

DESCRIPTION: DIAGONAL WEB HAS 3/16-INCH REMAINING SECTION. MAIN GIRDER WEB & TRANSVERSE WEB HAS 1/16-INCH SECTION LOSS 4"X4" EACH.

CONDITION STATE CS5



SH-111213-24 SKAGWAY ORE TERMINAL SHIP LOADER

LOCATION: SHIP LOADER BOOM 9 NORTH INTERIOR

DESCRIPTION: DIAGONAL SECTION LOSS TO 1/8-INCH 4"X4" AREA. MAIN WEB SECTION LOSS TO 1/8-INCH 5"X5" AREA.

CONDITION STATE CS5



**SH-111213-23 SKAGWAY ORE TERMINAL SHIP LOADER**

**LOCATION: SHIP LOADER BOOM 9 SOUTH INTERIOR**

**DESCRIPTION: DIAGONAL & MAIN GIRDER WEBS WITH SECTION LOSS TO 1/16-INCH IN 2 AREAS EACH 1"X5".**

**CONDITION STATE CS5**



**SH-111213-22 SKAGWAY ORE TERMINAL SHIP LOADER**

**LOCATION: SHIP LOADER BOOM 8 SOUTH INTERIOR**

**DESCRIPTION: DIAGONAL RUSTED THROUGH. MAIN GIRDER WEB WITH SECTION LOSS TO 1/8-INCH | AREA 2"x6". REMAINING WEB SECTION ON THE NORTH SIDE DIAGONAL IS 1/16-INCH (NOT RUSTED ALL THE WAY THROUGH)**

**CONDITION STATE CS5**



**SH-111213-21 SKAGWAY ORE TERMINAL SHIP LOADER**

**LOCATION: SHIP LOADER BOOM 7 SOUTH**

**DESCRIPTION: SECTION LOSS TO 1/16-INCH IN AREA 8"x8" IN WEB OF BOTH GIRDERS.**

**CONDITION STATE CS5**



**SH-111213-20 SKAGWAY ORE TERMINAL SHIP LOADER**  
**LOCATION: SHIP LOADER BOOM STIFFENER 1-FOOT TOWARD WATER FROM SPLICE.**

**DESCRIPTION: HEAVY SECTION LOSS AT TRIAXIAL WELD TO 3/16-INCH IN AREA 2"X2".**

**CONDITION STATE CS5**



**SH-111213-19 SKAGWAY ORE TERMINAL SHIP LOADER**  
**LOCATION: SHIP LOADER BOOM STIFFENER 1-FOOT TOWARD WATER FROM SPLICE.**

**DESCRIPTION: HEAVY SECTION LOSS AT TRIAXIAL WELD TO 3/16-INCH IN AREA 2"X2".**

**CONDITION STATE CS5**



**SH-111213-18 SKAGWAY ORE TERMINAL SHIP LOADER**  
**LOCATION: SHIP LOADER BOOM SPLICE PLATE BETWEEN 6 & 7 NORTH EXTERIOR**

**DESCRIPTION: PACK RUST TO 7/8-INCH ON BOTTOM NEAR FLANGE ON WATER SIDE. MINIMAL ON DOCK/SHORE SIDE.**

**CONDITION STATE CS5**

	<p><b>SH-111213-17 SKAGWAY ORE TERMINAL SHIP LOADER</b></p> <p><b>LOCATION: SHIP LOADER BOOM SPLICE PLATE BETWEEN 6 &amp; 7 NORTH INTERIOR</b></p> <p><b>DESCRIPTION: PACK RUST TO 7/8-INCH ON BOTTOM NEAR FLANGE ON WATER SIDE. MINIMAL ON DOCK/SHORE SIDE.</b></p> <p><b>CONDITION STATE CS4</b></p>
	<p><b>SH-111213-16 SKAGWAY ORE TERMINAL SHIP LOADER</b></p> <p><b>LOCATION: SHIP LOADER BOOM AT 7 NORTH</b></p> <p><b>DESCRIPTION: TRANSVERSE GIRDER &amp; AIN GIRDE SECTION LOSS TO 1/16-INCH OVER AREA 6"x6" TRANSVERSE GIRDERS &amp; 4"x4" MAIN FLANGE</b></p> <p><b>CONDITION STATE CS5</b></p>
	<p><b>SH-111213-15 SKAGWAY ORE TERMINAL SHIP LOADER</b></p> <p><b>LOCATION: SHIP LOADER BOOM SPLICE PLATE BETWEEN 6&amp;7 NORTH</b></p> <p><b>DESCRIPTION: EXTERIOR BOTTOM FLANGE HAS PACK RUST FORMING.</b></p> <p><b>CONDITION STATE CS4</b></p>



**SH-111213-14 SKAGWAY ORE TERMINAL SHIP LOADER**  
**LOCATION: SHIP LOADER BOOM SPLICE PLATE BETWEEN 6&7 NORTH**  
  
**DESCRIPTION: EXTERIOR BOTTOM FLANGE HAS PACK RUST FORMING.**  
  
**CONDITION STATE CS4**



**SH-111213-13 SKAGWAY ORE TERMINAL SHIP LOADER**  
**LOCATION: SHIP LOADER BOOM SPLICE PLATE BETWEEN 6&7 NORTH**  
  
**DESCRIPTION: INTERIOR NUTS RUSTED THROUGHOUT.**  
  
**CONDITION STATE CS4**



**SH-111213-12 SKAGWAY ORE TERMINAL SHIP LOADER**  
**LOCATION: SHIP LOADER BOOM SPLICE PLATE BETWEEN 6&7 NORTH**  
  
**DESCRIPTION: INTERIOR NUTS RUSTED THROUGHOUT.**  
  
**CONDITION STATE CS4**





**SH-111213-11 SKAGWAY ORE TERMINAL SHIP LOADER**  
**LOCATION: SHIP LOADER BOOM SPLICE PLATE BETWEEN 6&7 NORTH**  
**DESCRIPTION: INTERIOR NUTS RUSTED THROUGHOUT.**  
**CONDITION STATE CS4**



**SH-111213-10 SKAGWAY ORE TERMINAL SHIP LOADER**  
**LOCATION: SHIP LOADER BOOM SPLICE PLATE BETWEEN 6&7 NORTH**  
**DESCRIPTION: PACK RUST TO 1-INCH ON BOTTOM OF SPLICE PLATE BOTH SIDES (STORE WATER SIDE WHEN DOWN. CAN'T MEASURE SECTION LOSS BUT LIKELY TO BE 1/12<sup>TH</sup> OF PACK THICKNESS. SIMILAR PACK RUST OUTBOARD WEB BUT ONLY ON SHORE SIDE!**  
**CONDITION STATE CS4**



**SH-111213-09 SKAGWAY ORE TERMINAL SHIP LOADER**  
**LOCATION: SHIP LOADER BOOM SPLICE PLATE BETWEEN 6&7 NORTH**  
**DESCRIPTION: PACK RUST TO 1-INCH ON BOTTOM OF SPLICE PLATE BOTH SIDES (STORE WATER SIDE WHEN DOWN. CAN'T MEASURE SECTION LOSS BUT LIKELY TO BE 1/12<sup>TH</sup> OF PACK THICKNESS. SIMILAR PACK RUST OUTBOARD WEB BUT ONLY ON SHORE SIDE!**  
**CONDITION STATE CS4**



**SH-111213-08 SKAGWAY ORE TERMINAL SHIP LOADER**  
**LOCATION: 6 CENTER**  
**DESCRIPTION: 3/16-INCH LOSS TO V-BRACE WEBS, 3/32-INCH SECTION LOSS AT TRANSVERSE BRACE FLANGE FOR 36-INCH LENGTH.**  
**CONDITION STATE CS5**



**SH-111213-07 SKAGWAY ORE TERMINAL SHIP LOADER**  
**LOCATION: 6 CENTER**  
**DESCRIPTION: 3/16-INCH LOSS TO V-BRACE WEBS, 3/32-INCH SECTION LOSS AT TRANSVERSE BRACE FLANGE FOR 36-INCH LENGTH.**  
**CONDITION STATE CS5**



**SH-111213-06 SKAGWAY ORE TERMINAL SHIP LOADER**  
**LOCATION: 6 SOUTH**  
**DESCRIPTION: CS5 3/16 INCH SECTION LOSS IN AREA OF INTERSECTING WELDS, 12"x12" AREA TO 1/8-INCH LOSS IN AREA 8"x8", LOCATION 6 IS JUST ABOVE SPLICE PLATE (ACTUALLY WITH BOOM DOWN THIS WOULD BE JUST OUTBOARD FROM SPLICE PLATE).**  
**CONDITION STATE CS5**



**SH-111213-05 SKAGWAY ORE TERMINAL SHIP LOADER**

**LOCATION: 5 SOUTH UNDERSIDE CHUTE**

**DESCRIPTION: CS4-5, HEAVY SECTION LOSS, HOLES THROUGHOUT.**

**CONDITION STATE CS4/5**



**SH-111213-04 SKAGWAY ORE TERMINAL SHIP LOADER**

**LOCATION: 5 SOUTH**

**DESCRIPTION: SECTION LOSS 3/16-INCH OVER AREA 8"X8". STIFFENER KNIFE EDGE NEAR FLANGE, SECTION LOSS TO STIFFENER, FLANGE & WEB. TYPICAL AT 3 & 4 & 5, NORTH SIDE AT 3, 4 & 5 SECTION LOSS ONLY 1/16-INCH TO 1/8-INCH**

**CONDITION STATE CS5**



**SH-111213-03 SKAGWAY ORE TERMINAL SHIP LOADER**

**LOCATION: 5 SOUTH**

**DESCRIPTION: SECTION LOSS 3/16-INCH OVER AREA 8"X8". STIFFENER KNIFE EDGE NEAR FLANGE, SECTION LOSS TO STIFFENER, FLANGE & WEB. TYPICAL AT 3 & 4 & 5, NORTH SIDE AT 3, 4 & 5 SECTION LOSS ONLY 1/16-INCH TO 1/8-INCH**

**CONDITION STATE CS4/5**



**SH-111213-02 SKAGWAY ORE TERMINAL SHIP LOADER**  
**LOCATION: 2 SOUTH**  
**DESCRIPTION: CS 4 OR 5. SECTION LOSS 1/16-INCH TO 1/8-INCH IN AREA 6'X6". TYPICAL OF ALL INTERSECTIONS NORTH AND SOUTH SIDES. LOADER STORED IN UPRIGHT POSITION RESULTS IN TRAPPED WATER AT JOINTS.**  
**CONDITION STATE CS3/4**



**SH-111213-01 SKAGWAY ORE TERMINAL SHIP LOADER**  
**LOCATION: 20-INCHES BELOW TOP OF BEAM ON SOUTH SIDE OF BOOM**  
**DESCRIPTION: LOWER FLANGE OF BEAM/RUNWAY BENT 5/8-INCH OUT OF PLANE DUE TO ROLLER AT HEAD CHUTE (DISCHARGE END) OF SHIP LOADING CONVEYOR (TYPICAL).**  
**CONDITION STATE CS3/4**



**LG-111213-01 SKAGWAY ORE TERMINAL SHIP LOADER**  
**LOCATION: SKAGWAY ORE TERMINAL SHIP LOADER BOOM**  
**DESCRIPTION: SHUTTLE DISCHARGE SPOUT CARRIER RUNWAY/TRACK. NOTE BENT FLANGE IN I-BEAM TRACK AND COATING LOSS UNDER WHEEL.**



**LG-111213-02 SKAGWAY ORE TERMINAL SHIP LOADER**  
**LOCATION: SKAGWAY ORE TERMINAL SHIP LOADER BOOM**

**DESCRIPTION: SHUTTLE SLOT IN SHIP LOADER BOOM FOR DISCHARGE SPOUT. NOTE CARRIER RUNWAY/TRACK I-BEAM EACH SIDE OF SLOT. NOTE WEAR ON NORTH I- BEAM TRACK AND COATING LOSS UNDER WHEEL.**



**LG-111213-03 SKAGWAY ORE TERMINAL SHIP LOADER**  
**LOCATION: SKAGWAY ORE TERMINAL SHIP LOADER BOOM**

**DESCRIPTION: SHUTTLE SLOT IN SHIP LOADER BOOM FOR DISCHARGE SPOUT. NORTH CARRIER RUNWAY/TRACK I-BEAM, NOTE WEAR OF I- BEAM FLANGE (TRACK) AND WEB AND COATING LOSS ON TOP FLANGE, INSIDE BOTTOM FLANGE AND WEB.**



**SH-111313-18 SKAGWAY ORE TERMINAL SHIP LOADER**  
**LOCATION: SHIP LOADER TOWER S/NE FOOTING AREA**  
**GROUNDING CABLE**

**DESCRIPTION: 4 OF 7 STRANDS BROKEN. 3 OF 7 STRANDS BROKEN ON NW FOOTING.**

**CONDITION STATE CS5**



**SH-111313-17 SKAGWAY ORE TERMINAL SHIP LOADER**  
**LOCATION: SHIP LOADER TOWER S/NW FOOTING**

**DESCRIPTION: FOOTING PLATE & WEB & FLANGES CS3 UNDER FAILED PAINT. HOLD DOWN BOLTS TOO SHORT FOR LOCK NUT.**

**CONDITION STATE CS3**



**SH-111313-16 SKAGWAY ORE TERMINAL SHIP LOADER**  
**LOCATION: SHIP LOADER TOWER N BOOM STOP/PARKING STOOL**

**DESCRIPTION: HOLD DOWN NUTS WITH 95% SECTION LOSS! SOUTH BOOM STOP/PARKING STOOL IN SIMILAR CONDITION WITH 75% SECTION LOSS.**

**CONDITION STATE CS4/5**



SH-111313-15 SKAGWAY ORE TERMINAL SHIP LOADER

LOCATION: SHIP LOADER TOWER N/SW FOOTING

DESCRIPTION: WEB CS4 IN 4"X4" AREA

CONDITION STATE CS4



SH-111313-14 SKAGWAY ORE TERMINAL SHIP LOADER

LOCATION: SHIP LOADER TOWER N/NE FOOTING

DESCRIPTION: HOLDOWN NUT NW IS CS4. PLATE IS CS3. N/NW HOLD DOWN (BASE) PLATE IS IN CS4 WITH FAILED JOINT AND SECTION LOSS 1/16-INCH.

CONDITION STATE CS3/4



SH-111313-13 SKAGWAY ORE TERMINAL SHIP LOADER

LOCATION: SHIP LOADER BOOM SPLICE SOUTH EXTERIOR & TOP OF BOTTOM FLANGE,

DESCRIPTION: VIEW OF SPLICE PLATE CS2 SAVE FOR PACK RUST NEAR BOTTOM FLANGE NOTED IN PHOTOS 11/12/13,


CONDITION STATE CS2



**SH-111313-12 SKAGWAY ORE TERMINAL SHIP LOADER**  
**LOCATION: SHIP LOADER BOOM GIRDER SPLICE TOP OF TOP FLANGE**  
**DESCRIPTION: VIEW OF SPLICE PLATE CS2**  
**CONDITION STATE CS2**



**SH-111313-11 SKAGWAY ORE TERMINAL SHIP LOADER**  
**LOCATION: SHIP LOADER BOOM SPLICE SOUTH INTERIOR**  
**DESCRIPTION: VIEW OF SPLICE PLATE CS2 EXCEPT FOR PACK RUST NEAR LOWER FLANGE. SEE PHOTOS 11/12/13**  
**CONDITION STATE CS2/3**

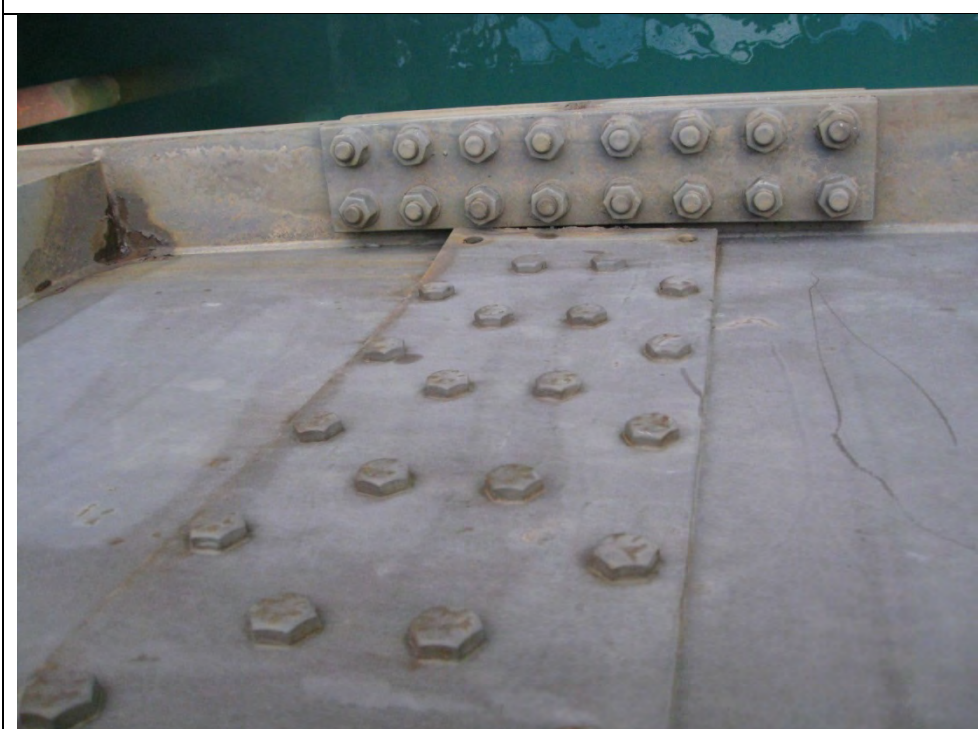

**SH-111313-10 SKAGWAY ORE TERMINAL SHIP LOADER**  
**LOCATION: SHIP LOADER BOOM SPLICE NORTH EXTERIOR OF WEB AND TOP OF BOTTOM FLANGE**  
**DESCRIPTION: VIEW OF SPLICE PLATES. CS2 EXCEPT FOR PACK RUST NEAR LOWER FLANGE. SEE PHOTOS 11/12/13**  
**CONDITION STATE CS2/3**





SH-111313-09 SKAGWAY ORE TERMINAL SHIP LOADER

LOCATION: SHIP LOADER BOOM SPLICE NORTH TOP

DESCRIPTION:VIEW OF GIRDER FLANGE SPLICE PLATE. CS2.

CONDITION STATE CS2



SH-111313-08 SKAGWAY ORE TERMINAL SHIP LOADER

LOCATION: SHIP LOADER BOOM SPLICE NORTH INTERIOR

DESCRIPTION:VIEW OF SPLICE PLATE , CS2 EXCEPT FOR PACK RUST NEAR LOWER FLANGE, SEE PHOTOS FROM 11/12/13.

CONDITION STATE CS2/3



SH-111313-07 SKAGWAY ORE TERMINAL SHIP LOADER

LOCATION: SHIP LOADER BOOM 2 NORTH INTERIOR

DESCRIPTION: HAND RAIL BASE HAS RUSTED THROUGH. VERY COMMON, 25% OF BASES ON BOOM HANDRAILS HAVE SIMILAR FAILURES. RUSTED FLANGE AT BOTTOM OF BEAM IS SHUTTLE RUNWAY AND RUSTED WEB IS WHERE SHUTTLE CARRIER WHEEL RUBS ON WEB.

CONDITION STATE CS3 SHUTTLE WHEEL RUNWAY

CONDITION STATE CS5 HANDRAIL



**SH-111313-06 SKAGWAY ORE TERMINAL SHIP LOADER**  
**LOCATION: SHIP LOADER 1 NORTH INTERIOR**

**DESCRIPTION: V-BRACE WEBS WITH REMAINING SECTION = 1/8-INCH AT WELD LINE**

**CONDITION STATE CS2/3**

**VIDEO**

**SH-111313-06 SKAGWAY ORE TERMINAL SHIP LOADER**  
**LOCATION: SHIP LOADER BOOM LOWERING MOVIE**



**SH-111313-04 SKAGWAY ORE TERMINAL SHIP LOADER**  
**LOCATION: SHIP LOADER WITH BOOM PARKED**

**DESCRIPTION: TOWERS WEST FACE**



**SH-111313-03 SKAGWAY ORE TERMINAL SHIP LOADER**  
**LOCATION: SHIP LOADER BOOM 14 SOUTH OUTBOARD**

**DESCRIPTION: WEB OF DIAGONAL (CS5) IS 1/16-INCH REAR TOE OR BOTTOM OF WEB. 14 NORTH IS 3/16-INCH IN SAME LOCATION. MAIN GIRDER WEB & TRANSVERSE WEB BOTH HAVE SECTION LOSS TO 1/32-INCH GENERALLY (CS4)**

**CONDITION STATE CS 5**

	<p><b>SH-111313-02 SKAGWAY ORE TERMINAL SHIP LOADER</b></p> <p><b>LOCATION: SHIP LOADER BOOM 13 NORTH INBOARD</b></p> <p><b>DESCRIPTION: WEB OF DIAGONAL BRACE SO THIN AS TO BE FUNCTIONALLY NON-EXISTENT. SAME ON 13 SOUTH INBOARD. CS5</b></p> <p><b>CONDITION STATE CS5</b></p>
	<p><b>SH-111313-01 SKAGWAY ORE TERMINAL SHIP LOADER</b></p> <p><b>LOCATION: SHIP LOADER BOOM 13 SOUTH OUTBOARD</b></p> <p><b>DESCRIPTION: TRANSVERSE &amp; MAIN GIRDERS HAVE 1/16-INCH SECTION LOSS IN AREAS 2"X9" ALONG WELD SIMILAR BUT ONLY 1/32 TO 1/16-INCH LOSS ON 13 NORTH CS4/5</b></p> <p><b>CONDITION STATE CS4/5</b></p>

# **Appendix 4**

## **Ship Loader North Guide Tower Inspection Photos and Notes**



PF-111213-35 SKAGWAY ORE TERMINAL SHIP LOADER  
LOCATION: NORTH SHIP LOADER TOWER SW LEG WEST FACE  
#10 N/SW/W #10  
  
DESCRIPTION: NSD  
  
CONDITION STATE CS2



PF-111213-34 SKAGWAY ORE TERMINAL SHIP LOADER  
LOCATION: NORTH SHIP LOADER TOWER SW LEG SOUTH FACE  
#9 N/SW/S #9  
  
DESCRIPTION: LIGHT PAINT FAILURE, LIGHT SURFACE RUST,  
NSD  
  
CONDITION STATE CS2



PF-111213-33 SKAGWAY ORE TERMINAL SHIP LOADER  
LOCATION: NORTH SHIP LOADER TOWER SW LEG WEST FACE  
#8 N/SW/W #8  
  
DESCRIPTION: POOLING WATER, LAMINAR RUST ABOUT 2/4-  
INCH, MINOR SECTION LOSS VISABLE ALONG EDGES ABOUT  
1/8-INCH.  
  
CONDITION STATE CS4/5



PF-111213-32 SKAGWAY ORE TERMINAL SHIP LOADER  
LOCATION: NORTH SHIP LOADER TOWER SW LEG SOUTH FACE #7 N/SW/S #7  
DESCRIPTION: NSD  
CONDITION STATE CS2



PF-111213-31 SKAGWAY ORE TERMINAL SHIP LOADER  
LOCATION: NORTH SHIP LOADER TOWER SW LEG WEST FACE #6 N/SW/W #6  
DESCRIPTION: PSC 4 SMALL AREA RUST SCALE ABOUT 1/4-INCH AREAS ( MARKED IN PHOTO) WITH SECTION LOSS TO LEG WEB + FLANGE ABOUT 1/8-INCH 4"X8"  
CONDITION STATE CS4



PF-111213-30 SKAGWAY ORE TERMINAL SHIP LOADER  
LOCATION: NORTH SHIP LOADER TOWER SW LEG WEST FACE #5 WEB STIFFENER N/SW/S #5  
DESCRIPTION: PACK RUST ABOUT 3/8 INCH BETWEEN STIFFENER AND UNISTRUT  
CONDITION STATE CS4



**PF-111213-29 SKAGWAY ORE TERMINAL SHIP LOADER**  
**LOCATION: NORTH SHIP LOADER TOWER SW LEG SOUTH FACE #5 N/SW/S #5**  
**DESCRIPTION: LOWER DIAGONAL HAS OUT OF PLANE BOND AT LEG CONNECTION ABOUT ½-INCH**  
**CONDITION STATE CS4**



**PF-111213-28 SKAGWAY ORE TERMINAL SHIP LOADER**  
**LOCATION: NORTH SHIP LOADER TOWER SW LEG WEST FACE #4 N/SW/W/#4**  
**DESCRIPTION: POOLING WATER – PCS 4 MODERATE RUST SCALE ABOUT 1/8-INCH IN AREA OF POOLING WATER. UNISTRUT FOR ELECTRICAL CONDUIT RUSTING OFF.**  
**CONDITION STATE CS4/5**



**PF-111213-27 SKAGWAY ORE TERMINAL SHIP LOADER**  
**LOCATION: NORTH SHIP LOADER TOWER SW LEG SOUTH FACE #3 N/SW/S #3**  
**DESCRIPTION: NSD AT DIAGONALS WEB STIFFENER ON LEG HAS PAINT FAILURE LIGHT SURFACE RUST.**  
**CONDITION STATE CS3**



PF-111213-26 SKAGWAY ORE TERMINAL SHIP LOADER  
LOCATION: NORTH SHIP LOADER TOWER SW LEG WEST FACE #2 N/SW/W #2  
DESCRIPTION: PCS 4 LOCALIZED TO WHERE WATER POOLS, MODERATE RUST SCALE ABOUT 1/8 INCH 2" TO 4" TALL 10" TO 12" LONG  
  
CONDITION STATE CS4/5



PF-111213-25 SKAGWAY ORE TERMINAL SHIP LOADER  
LOCATION: NORTH SHIP LOADER TOWER SW LEG WEST FACE #0 N/SW/W #0  
DESCRIPTION: PCS 3 ON HORIZONTAL RUST STAINING THROUGHOUT.  
  
CONDITION STATE CS3



PF-111213-24 SKAGWAY ORE TERMINAL SHIP LOADER  
LOCATION: NORTH SHIP LOADER TOWER NW LEG WEST FACE #1  
DESCRIPTION: VIEW BETWEEN DIAGONAL AND HORIZONTAL PCS 4 MODERATE RUST SCALE FLANGE + WEB  
  
CONDITION STATE CS4/5





PF-111213-23 SKAGWAY ORE TERMINAL SHIP LOADER  
LOCATION: NORTH SHIP LOADER TOWER NW LEG WEST FACE #1 N/NW/W #1  
DESCRIPTION: TOP SURFACE OF DIAGONAL WITH ADDED "FISH PLATE" VISIBLE PCS 3  
CONDITION STATE CS3/4



PF-111213-22 SKAGWAY ORE TERMINAL SHIP LOADER  
LOCATION: NORTH SHIP LOADER TOWER NW LEG N FACE #2 INBOARD N/NW/W #2  
DESCRIPTION: VIEW OF AREA OF SECTION LOSS TO FLANGE OF LEG ABOUT 2"X3"X1/8-INCH WITH RUST SCALE ABOUT 1/8-INCH.  
CONDITION STATE CS4



PF-111213-21 SKAGWAY ORE TERMINAL SHIP LOADER  
LOCATION: NORTH SHIP LOADER TOWER NW LEG N FACE #2 INBOARD N/NW/W #2  
DESCRIPTION: VIEW OF INBOARD SIDE #2 SMALL AREAS OF PCS 4 GENERAL PAINT FAILURE.  
CONDITION STATE CS4



**PF-111213-20 SKAGWAY ORE TERMINAL SHIP LOADER**  
**LOCATION: NORTH SHIP LOADER TOWER NW LEG WEST FACE #3 FROM ABOVE N/NW/W #3**  
**DESCRIPTION: DRAIN HOLE PLUGGED WITH RUST AND PAINT DEBRIS, RUST SCALE ABOUT 1/8-INCH WEB AND FLANGES OF LEG AND DING 2" TO 5" HIGH.**  
**CONDITION STATE CS4/5**



**PF-111213-19 SKAGWAY ORE TERMINAL SHIP LOADER**  
**LOCATION: NORTH SHIP LOADER TOWER NW LEG NORTH FACE #4 INBOARD N/NW/N #4**  
**DESCRIPTION: VIEW OF LEG INBOARD AT LOWER WEB STIFFENER PCS4, SOME RUST SCALE**  
**CONDITION STATE CS4**



**PF-111213-18 SKAGWAY ORE TERMINAL SHIP LOADER**  
**LOCATION: NORTH SHIP LOADER TOWER NW LEG NORTH FACE #4 INBOARD N/NW/N #4**  
**DESCRIPTION: PCS 4 TO WEB + WEB STIFFENER. EXPOSED BASE METAL, SMALL AREAS OF MODERATE RUST SCALE ON INSIDE OF LEG ABOUT 3/16-INCH.**  
**CONDITION STATE CS4**



**PF-111213-17 SKAGWAY ORE TERMINAL SHIP LOADER**  
**LOCATION: NORTH SHIP LOADER TOWER NW LEG WEST FACE #5 FROM BELOW DIAGONAL ON LEG N/NW/W #5**  
**DESCRIPTION: PCS 4 EXPOSED BASE METAL ON WEB OF LEG, MODERATE SURFACE RUST**  
**CONDITION STATE CS4**



**PF-111213-16 SKAGWAY ORE TERMINAL SHIP LOADER**  
**LOCATION: NORTH SHIP LOADER TOWER NW LEG WEST FACE #5 LOWER DIAGONAL**  
**DESCRIPTION: VIEW OF SPLICE FROM BELOW PCS 4 SECTION LOSS TO BOLTS + NUTS AT SPLICE, LOCALIZED MODERATE SURFACE RUST ON WEB OF LOWER DIAGONAL.**  
**CONDITION STATE CS4**



**PF-111213-15 SKAGWAY ORE TERMINAL SHIP LOADER**  
**LOCATION: NORTH SHIP LOADER TOWER NW LEG WEST FACE #5 N/NW/W #5**  
**DESCRIPTION: POOLONG WATER BELOW SPLICE ON BASE OF DIAGONAL, RUST SCALE ABOUT ¼-INCH TO AREAS ON DIAGONAL WEB + FLANGE, NUTS +BOLT ENDS AT SPLICE, FLANGE AT SPLICE ON OUTBOARD SIDES APPEARS TO BE WIDER.**  
**CONDITION STATE CS4/5**



**PF-111213-14 SKAGWAY ORE TERMINAL SHIP LOADER**  
**LOCATION: NORTH SHIP LOADER TOWER NW LEG NORTH FACE INBOARD LEG SPLICE**  
**DESCRIPTION: PCS 4 LIGHT SURFACE RUST, LIGHT PITTING BOLT HEADS AND SPLICE PLATE**  
**CONDITION STATE CS4**



**PF-111213-13 SKAGWAY ORE TERMINAL SHIP LOADER**  
**LOCATION: NORTH SHIP LOADER TOWER NW LEG NORTH FACE #6 SOUTH SIDE N/NW/N #6**  
**DESCRIPTION: LOCALIZED PCS 4 AREASS OF EXPOSED BASE METAL AREAS ABOUT 4"X6", LIGHT SURFACE RUST**  
**CONDITION STATE CS4**



**PF-111213-12 SKAGWAY ORE TERMINAL SHIP LOADER**  
**LOCATION: NORTH SHIP LOADER TOWER NW LEG NORTH FACE #6 N/NW/N #6 SEE ALSO PHOTO F-111213-11 BELOW**  
**DESCRIPTION: VIEW OF INBOARD SIDE OF LEG. MODERATE RUST SCALE ABOUT 3/16 INCH ON LEG FLANGES + WEB STIFFENER. LEG SPLICE JUST BELOW THIS LOCATION, UPPER DIAGONAL WELDED ON WEB AND TOP FLANGE ONLY, LOWER DIAGONAL HAS 2 BOLTS FOR CONNECTION.**  
**CONDITION STATE CS4**



**PF-111213-11 SKAGWAY ORE TERMINAL SHIP LOADER**  
**LOCATION: NORTH SHIP LOADER TOWER NW LEG NORTH FACE #6 N/NW/N #6**  
**DESCRIPTION: VIEW OF INBOARD SIDE OF LEG. MODERATE RUST SCALE ABOUT 3/16 INCH ON LEG FLANGES + WEB STIFFENER. LEG SPLICE JUST BELOW THIS LOCATION, UPPER DIAGONAL WELDED ON WEB AND TOP FLANGE ONLY, LOWER DIAGONAL HAS 2 BOLTS FOR CONNECTION.**  
**CONDITION STATE CS4**



**PF-111213-10 SKAGWAY ORE TERMINAL SHIP LOADER**  
**LOCATION: NORTH SHIP LOADER TOWER NW LEG WEST FACE #7**  
**DESCRIPTION: POOLING WATER (DRASIN HOLES IN WEBS CLOSED FROM BELOW) PCS 4 MODERATE SURFACE RUST AT WATER CONTACTING RUST SCALE ABOUT 3/16 INCH THICK.**  
**CONDITION STATE CS4/5**



**PF-111213-09 SKAGWAY ORE TERMINAL SHIP LOADER**  
**LOCATION: NORTH SHIP LOADER TOWER NW LEG SOUTH FACE INBOARD #8 N/NW #8**  
**DESCRIPTION: LOCAL AREAS OF EXPOSED BASE METAL, LIGHT SURFACE RUST, PCS 4 AREA ABOUT 6-INCHES x 10 INCHES.**  
**CONDITION STATE CS4**



**PF-111213-08 SKAGWAY ORE TERMINAL SHIP LOADER**  
**LOCATION: NORTH SHIP LOADER TOWER NW LEG NORTH FACE #8 N/NW/N #8**  
**DESCRIPTION: SMALL AREA OF PAINT FAILURE ON TOP SURFACE OF LOWER DIAGONAL, NOTE THAT OUTBOARD WEB STIFFENER ONLY WELDED ON TWO EDGES (INBOARD WELDED ON ALL THREE EDGES!)**  
**CONDITION STATE CS2**



**PF-111213-07 SKAGWAY ORE TERMINAL SHIP LOADER**  
**LOCATION: NORTH SHIP LOADER TOWER NW LEG WEST FACE #9 N/NW/W #9**  
**DESCRIPTION:VIEW OF INTERSECTING DIAGONALS, UPPER HAS LOCALIZED DCS 3 9"X24", LIGHT SURFACE RUST.**  
**CONDITION STATE CS3**



**PF-111213-06 SKAGWAY ORE TERMINAL SHIP LOADER**  
**LOCATION: NORTH SHIP LOADER TOWER NW LEG NORTH FACE #9**  
**DESCRIPTION: VIEW OF IMPACT DAMAGE TO FLANGE OF LEG AT WEB STIFFENER,OUT OF PLAIN ABOUT 5/8-INCH X 2 INCHES.**  
**CONDITION STATE CS1**



**PF-111213-05 SKAGWAY ORE TERMINAL SHIP LOADER**  
**LOCATION: NORTH SHIP LOADER TOWER NORTH WEST LEG WEST FACE #9 N/NW/W #9**  
**DESCRIPTION: PCS 3, NOEXPOSED BASE METAL, RUST BLEED TYHROUGH, DRAIN HOLES ON EACH SIDE OF WEB, EAST SIDE PLUGGED)**  
  
**CONDITION STATE CS3**



**PF-111213-04 SKAGWAY ORE TERMINAL SHIP LOADER**  
**LOCATION: NORTH SHIP LOADER TOWER NORTH WEST LEG NORTH FACE #10 N/NW/N #10**  
**DESCRIPTION: SOME FLAKING PAINT (PCS 3) LIGHT SURFACE RUST (ON SOUTH SIDE OF LEG)**  
  
**CONDITION STATE CS3**



**PF-111213-03 SKAGWAY ORE TERMINAL SHIP LOADER**  
**LOCATION: NORTH SHIP LOADER TOWER NORTHWEST LEG WEST FACE N/NW/W**  
**DESCRIPTION: PAINT CONDITION 3, LOCALIZED PAINT FAILURE EXPOSED BASE METAL, MODERATE SURFACE CORROSION**  
  
**CONDITION STATE CS3**



**PF-111213-02 SKAGWAY ORE TERMINAL SHIP LOADER**  
**LOCATION: NORTH SHIP LOADER TOWER MACHINE DECK**  
**DESCRIPTION: HOISTING EQUIPMENT COUNTERWEIGHT ROPE SHEAVES**

**CONDITION STATE CS N/A**



**PF-111213-01 SKAGWAY ORE TERMINAL SHIP LOADER**  
**LOCATION: NORTH SHIP LOADER TOWER MACHINE DECK**  
**DESCRIPTION: CREW PHOTO AND HOISTING EQUIPMENT**

**CONDITION STATE CS N/A**





**PF-111313-31 SKAGWAY ORE TERMINAL SHIP LOADER**  
**LOCATION: NORTH SHIP LOADER TOWER WITH BOOM DEPLOYED**  
  
**DESCRIPTION: VIEW LOOKING SOUTH ALONG ORE DOCK, TRANSFER CONVEYOR ARTICULATED SECTION AT RIGHT (WEST) OF SHIP LOADER TOWER.**  
  
**CONDITION STATE CS N/A**



**PF-111313-30 SKAGWAY ORE TERMINAL SHIP LOADER**  
**LOCATION: NORTH SHIP LOADER TOWER SW LEG EAST SIDE #1 N/SW/S #1**  
  
**DESCRIPTION: PCS 3 LIGHT SURFACE RUST. RUST STAINING.**  
  
**CONDITION STATE CS3**



**PF-111313-29 SKAGWAY ORE TERMINAL SHIP LOADER**  
**LOCATION: NORTH SHIP LOADER TOWER SE LEG EAST SIDE #1 N/SE/S #1**  
  
**DESCRIPTION: RUST STAINING, DRAIN HOLE OPEN, "FISH PLATE" VISIBLE ON DIAGONAL WEB, MINOR OUT OF PLANE BEND INBOARD FLANGE OF DIAGONAL.**  
  
**CONDITION STATE CS3**



PF-111313-28 SKAGWAY ORE TERMINAL SHIP LOADER  
LOCATION: NORTH SHIP LOADER TOWER NE LEG AT BASE

DESCRIPTION: NUTS AT NW CORNER LAMINAR RUST, MINOR SECTION LOSS

CONDITION STATE CS2/3



PF-111313-27 SKAGWAY ORE TERMINAL SHIP LOADER  
LOCATION: NORTH SHIP LOADER TOWER NE LEG NORTH SIDE #1 N/NE/N #1

DESCRIPTION: OUT OF PLANE BEND IN CROSS BRACE OF BOTTOM FLANGE ABOUT 1 1/2-INCH X 8 INCHES LONG.

CONDITION STATE CS2



PF-111313-26 SKAGWAY ORE TERMINAL SHIP LOADER  
LOCATION: NORTH SHIP LOADER TOWER SE LEG SOUTH SIDE #2 N/SE/S #2

DESCRIPTION: LAMINAR RUST 4"X6" ABOUT 1/8-INCH THICK, MINOR SECTION LOSS TO FLANGE OF DIAGONAL

CONDITION STATE CS3



**PF-111313-25 SKAGWAY ORE TERMINAL SHIP LOADER**  
**LOCATION: NORTH SHIP LOADER TOWER SE LEG EAST FACE #3 N/SE/S #3**  
  
**DESCRIPTION: LAMINAR RUST ABOUT ¼-INCH WEB + FLANGES. INBOARD FLANGE DIAGONAL GOING TO KNIFE EDGE, ONE DRAIN HOLE PRESSOUT AND CLEAR**  
  
**CONDITION STATE CS3/4**



**PF-111313-24 SKAGWAY ORE TERMINAL SHIP LOADER**  
**LOCATION: NORTH SHIP LOADER TOWER SE LEG SOUTH SIDE #4 N/SE/S #4**  
  
**DESCRIPTION: INBOARD WEB STIFFENER ON LEG HAS LAMINAR RUST ABOUT ¼-INCH THICK ON LEG WEB + FLANGE, DIAGONAL AT #4 NSD.**  
  
**CONDITION STATE CS3**

**PF-111313-23 IS A VIDEO OF SE LEG SOUTH SIDE #4**



**PF-111313-22 SKAGWAY ORE TERMINAL SHIP LOADER**  
**LOCATION: NORTH SHIP LOADER TOWER SE LEG EAST SIDE #5 N/SE/S #5**  
  
**DESCRIPTION: VIEW AFTER LAMINAR RUST REMOVAL. FLANGE TO A KNIFE EDGE BELOW SPLICE, WEB SOUNDS PAPER THIN**  
  
**CONDITION STATE CS4/5**



PF-111313-21 SKAGWAY ORE TERMINAL SHIP LOADER  
LOCATION: NORTH SHIP LOADER TOWER SE LEG EAST SIDE #5  
N/SE/S #5

DESCRIPTION: POOLING WATE, LAMINAR RUST ABOUT 3/8 =-  
INCH THICK ON FLANGE OF DIAGONAL

CONDITION STATE CS4/5



PF-111313-20 SKAGWAY ORE TERMINAL SHIP LOADER  
LOCATION: NORTH SHIP LOADER TOWER SE LEG MID HEIGHT  
SPLICE INBOARD SIDE N/SE/S MID LEG SPLICE

DESCRIPTION: PAINT FAILURE AND LAMINAR RUST ON PLATE  
OF SPLICE, RUST ABOUT 1/8 INCH THICK

CONDITION STATE CS3/4



PF-111313-19 SKAGWAY ORE TERMINAL SHIP LOADER  
LOCATION: NORTH SHIP LOADER TOWER SE LEG SOUTH FACE  
#6 N/SE/S #6

DESCRIPTION: MINOR PAINT FAILURE, LIGHT SURFACE RUST.

CONDITION STATE CS3



PF-111313-18 SKAGWAY ORE TERMINAL SHIP LOADER  
LOCATION: NORTH SHIP LOADER TOWER SE LEG EAST FACE #7  
N/SE/E #7  
  
DESCRIPTION: LAMINAR RUST ABOUT 3/8-INCH THICK OVER  
10"X12" AREA. WEB + FLANGE IS OF BOTH LEG AND  
DIAGONAL  
  
3/4  
  
CONDITION STATE CS



PF-111313-17 SKAGWAY ORE TERMINAL SHIP LOADER  
LOCATION: NORTH SHIP LOADER TOWER SE LEG SOUTH FACE  
#8 N/SE/S #8  
  
DESCRIPTION: PCS 2 NSD  
  
CONDITION STATE CS2



PF-111313-16 SKAGWAY ORE TERMINAL SHIP LOADER  
LOCATION: NORTH SHIP LOADER TOWER SE LEG EAST FACE  
AT #9 N/SE/E #9  
  
DESCRIPTION: LAMINAR RUST ABOUT 3/8-INCH TO WEB OF  
LEG AND FLANGE AT DIAGONAL.  
  
CONDITION STATE CS3/4



**PF-111313-15 SKAGWAY ORE TERMINAL SHIP LOADER**  
**LOCATION: NORTH SHIP LOADER TOWER SE LEG EAST FACE AT LEG TOP N/SE/E**

**DESCRIPTION: PACK RUST AABOUT 3/8-INCH BETWEEN LEG FLANGE AND ROLLER STOP (BOTH SIDES)**

**CONDITION STATE CS3/4**



**PF-111313-14 SKAGWAY ORE TERMINAL SHIP LOADER**

**LOCATION: NORTH SHIP LOADER TOWER NE LEG EAST FACE #2 N/NE/N #2**

**DESCRIPTION: FROZEN POOLING WATER IN JOINT. PAINT CS4, LAMINAR RUST FORMING.**

**CONDITION STATE CS4**



**PF-111313-13 SKAGWAY ORE TERMINAL SHIP LOADER**

**LOCATION: NORTH SHIP LOADER TOWER NE LEG NORTH FACE #3 N/NE/N #3**

**DESCRIPTION: SMALL AREAS OF PAINT FAILURE, LIGHT SURFACE RUST.**

**CONDITION STATE CS2**



**PF-111313-12 SKAGWAY ORE TERMINAL SHIP LOADER**  
**LOCATION: NORTH SHIP LOADER TOWER NE LEG EAST FACE #4 N/NE/E #4**

**DESCRIPTION: TWO TORCH-CUT DRAIN HOLES ABOUT 3/8 INCH DIAM IN WEB, LAMINAR RUST FORMING UNDER COATING, RUST STAINING.**


**CONDITION STATE CS2**



**PF-111313-11 SKAGWAY ORE TERMINAL SHIP LOADER**  
**LOCATION: NORTH SHIP LOADER TOWER NE LEG NORTH FACE #5 N/NE/N #5**

**DESCRIPTION: MINOR SECTION LOSS BOUT 1/16 INCH X 1/2-INCH ON EDGE OF FLANGE FROM GANG WAY HANDLING JIB BOOM HOIST MOUNTING BRACKET (REMOVED) SMALL, AREA OF PAINT FAILURE, LIGHT SURFACE RUST.**

**CONDITION STATE CS2/3**

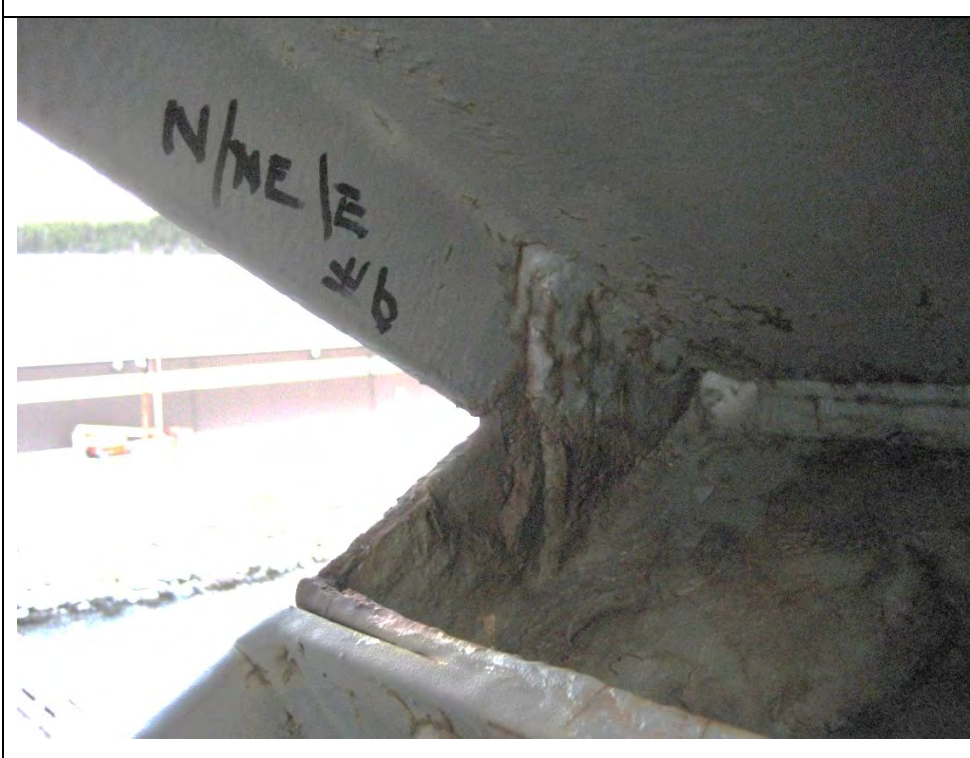

**PF-111313-10 SKAGWAY ORE TERMINAL SHIP LOADER**  
**LOCATION: NORTH SHIP LOADER TOWER NE LEG EAST FACE #6 N/NE/E #6**

**DESCRIPTION: LAMINAR RUST FORMING ON LOWER DIAGONAL ABOVE SPLICE. RUST STAINING.**

**CONDITION STATE CS3/4**



**PF-111313-09 SKAGWAY ORE TERMINAL SHIP LOADER**  
**LOCATION: NORTH SHIP LOADER TOWER NE LEG EAST FACE #6 N/NE/N #6**

**DESCRIPTION: DRAIN HOLES CLEAR, MINOR PAINT FAILURE, SOME RUST STAINING.**

**CONDITION STATE CS2**



**PF-111313-08 SKAGWAY ORE TERMINAL SHIP LOADER**  
**LOCATION: NORTH SHIP LOADER TOWER NE LEG #7 N/NE/N #7**

**DESCRIPTION: TORCHED HOLES IN LEG FLANGES BETWEEN WEB STIFFENERS ABOUT 2-INCH X 1-INCH EACH. LIGHT SURFATE RUST AROUND HOLES.**

**CONDITION STATE CS3/4**



**PF-111313-07 SKAGWAY ORE TERMINAL SHIP LOADER**  
**LOCATION: NORTH SHIP LOADER TOWER NE LEG NORTH FACE #7**

**DESCRIPTION: MINOR PAINT FAILURE, SOME RUST BLEED THROUGH**

**CONDITION STATE CS2.**





PF-111313-06 SKAGWAY ORE TERMINAL SHIP LOADER  
LOCATION: NORTH SHIP LOADER TOWER NE LEG EAST FACE  
#8 – N/NE/E #8

DESCRIPTION: NO DRAIN HOLES. LAMINAR RUST ABOUT  
3/16-INCH 2-INCHES HIGH 18-INCHES LONG WEB AND  
FLANGES OF LEG, LIGHT SURFACE RUST VISIBLE.

CONDITION STATE CS3



PF-111313-05 SKAGWAY ORE TERMINAL SHIP LOADER  
LOCATION: NORTH SHIP LOADER TOWER NE LEG NORTH FACE  
#9 –N/NE/N #9

DESCRIPTION:OUT OF PLAN BENDING ON FLANGE OF LEG  
BETWEEN WEB STIFFENERS ABOUT 5/8-INCH X 6-INCHES

CONDITION STATE CS2



PF-111313-04 SKAGWAY ORE TERMINAL SHIP LOADER  
LOCATION: NORTH SHIP LOADER TOWER NE LEG NORTH FACE  
#9

DESCRIPTION: FLAKING PAINT PCS3 EXPOSES BASE METAL  
LIGHT SURFACE RUST (ON INBOARD SURFACES)

CONDITION STATE CS2



**PF-111313-03 SKAGWAY ORE TERMINAL SHIP LOADER**  
**LOCATION: NORTH SHIP LOADER TOWER NE LEG EAST FACE TOP OF LEG**

**DESCRIPTION: PACK RUST ABOUT ¼-INCH BETWEEN TOP OF LEG AND FLOOR BEAM OF WORK DECK.**

**CONDITION STATE CS2**



**PF-111313-02 SKAGWAY ORE TERMINAL SHIP LOADER**  
**LOCATION: NORTH SHIP LOADER TOWER NE LEG – N/NE/E #10**

**DESCRIPTION: EAST FACE #10 RUST BLEED THROUGH NSD**

**CONDITION STATE CS2**



**PF-111313-01 SKAGWAY ORE TERMINAL SHIP LOADER**  
**LOCATION: NORTH SHIP LOADER TOWER NE LEG - N/NE/N #10**

**DESCRIPTION: TOP END OF LEG (COLUMN) NORTH SIDE SOME FLAKING PAINT, RUST BLEED THROUGH. NSD**

**CONDITION STATE CS2**

# Appendix 5

## Ship Loader South Guide Tower Inspection Photos and Notes



**JG-111213-25 SKAGWAY ORE TERMINAL SHIP LOADER**  
**LOCATION: SOUTH SHIP LOADER TOWER W FACE AT SW CORNER PP# 3**  
**DESCRIPTION: 2-INCHES WATER POOLING MODERATE TO HEAVY LSMINSR RUST FORMING UNDER FLAKING/PEELING PAINT. WAS ABLE TO CLEAN CEBRIS AND UNCLOG DRAIN.**  
**CONDITION STATE CS4/5**



**JG-111213-24 SKAGWAY ORE TERMINAL SHIP LOADER**  
**LOCATION: SOUTH SHIP LOADER TOWER COUNTER WEIGHT CABLE**  
**DESCRIPTION: CABLE AT TURNBUCKLE, RUST BLEED OCCURING UNDER CABLE GREASE.**  
**CONDITION STATE CS5**



**JG-111213-23 SKAGWAY ORE TERMINAL SHIP LOADER**  
**LOCATION: SOUTH SHIP LOADER TOWER COUNTER WEIGHT CABLE**  
**DESCRIPTION: CABLE AT TURNBUCKLE, RUST BLEED OCCURING UNDER CABLE GREASE.**  
**CONDITION STATE CS4/5**

	<p><b>JG-111213-22 SKAGWAY ORE TERMINAL SHIP LOADER</b></p> <p><b>LOCATION: SOUTH SHIP LOADER TOWER COUNTER WEIGHT CABLE</b></p> <p><b>DESCRIPTION: CABLE AT TURNBUCKLE, RUST BLEED OCCURING UNDER CABLE GREASE.</b></p> <p><b>CONDITION STATE CS4/5</b></p>
	<p><b>JG-111213-21 SKAGWAY ORE TERMINAL SHIP LOADER</b></p> <p><b>LOCATION: SOUTH SHIP LOADER TOWER S FACE AT SW CORNER PP#4</b></p> <p><b>DESCRIPTION: NSD</b></p> <p><b>CONDITION STATE CS2</b></p>
	<p><b>JG-111213-20 SKAGWAY ORE TERMINAL SHIP LOADER</b></p> <p><b>LOCATION: SOUTH SHIP LOADER TOWER W FACE AT SW CORNER PP# 5</b></p> <p><b>DESCRIPTION: TOP VIEW NO DRAINING HOLE AT THIS LOCATION, HEAVY LAMINAR RUST FORMING UNDER PAINT (TYPICAL AT THESE LOCATIONS)</b></p> <p><b>CONDITION STATE CS3/4</b></p>



**JG-111213-19 SKAGWAY ORE TERMINAL SHIP LOADER**  
**LOCATION: SOUTH SHIP LOADER TOWER S FACE AT SW CORNER PP#6**  
**DESCRIPTION: LOWER DIAGONAL BRACE IS BOLTED TO LEG. BOTH DIAGONAL BRACES HAVE RUST FORMING AROUND JOINT FACES AND WELDS (COMMON).**  
**-MISSING BOLT**  
**CONDITION STATE CS3**



**JG-111213-18 SKAGWAY ORE TERMINAL SHIP LOADER**  
**LOCATION: SOUTH SHIP LOADER TOWER W FACE AT SW CORNER PP# 7**  
**DESCRIPTION: VIEW OF TORCH-CUT DRAINS AND COMMON SO FAR TO FIND MODERATE RUST FORMING UNDER PAINT AT THESE LOCATIONS.**  
**CONDITION STATE CS3/4**



**JG-111213-17 SKAGWAY ORE TERMINAL SHIP LOADER**  
**LOCATION: SOUTH SHIP LOADER TOWER SW FACE PP#7**  
**DESCRIPTION: DEBRIS BUILT UP, PAINT IS CRACKING AND PEELING AWAY FROM STEEL WITH MODERATE RUST FORMING UNDER (TYPICAL)**  
**CONDITION STATE CS3/4**



**JG-111213-16 SKAGWAY ORE TERMINAL SHIP LOADER**  
**LOCATION: SOUTH SHIP LOADER TOWER SW CORNER LEG**  
**DESCRIPTION: INBOARD JUST ABOVE S PANEL POINT #8**  
**PAINT IS BUBBLED WITH HEAVY LAMINAR RUST FORMING UNDER.**  
**CONDITION STATE CS4**



**JG-111213-15 SKAGWAY ORE TERMINAL SHIP LOADER**  
**LOCATION: SOUTH SHIP LOADER TOWER S FACE PANEL POINT #8**  
**DESCRIPTION: MODERATE RUST FORMED ON WELDS, NSD**  
**CONDITION STATE CS2**



**JG-111213-14 SKAGWAY ORE TERMINAL SHIP LOADER**  
**LOCATION: SOUTH SHIP LOADER TOWER SW FACE DIAGONAL BRACE BETWEEN PP 10 AND 9.**  
**DESCRIPTION: COMMON TO FIND MODERATE RUST AND PAINT PEELING ALONG INBOARD FLANGES ON DIAGONALS.**  
**CONDITION STATE CS2**



**JG-111213-13 SKAGWAY ORE TERMINAL SHIP LOADER**  
**LOCATION: SOUTH SHIP LOADER TOWER SW PANEL POINT 10**  
**DESCRIPTION:VIEW OF LIGHT LAMINAR RUST FORMING AT CONNECTION TO TOWER LEG.**  
**CONDITION STATE CS2/3**



**JG-111213-12 SKAGWAY ORE TERMINAL SHIP LOADER**  
**LOCATION: SOUTH SHIP LOADER TOWER SW PANEL POINT #10 SW FACE PP#10**  
**DESCRIPTION:TOP SIDE OF DIAGONAL CONNECTION DIRT AND DEBRIS BUILTUP 8\"/>
**CONDITION STATE CS3/4****



**JG-111213-11**  
**LOCATION: SOUTH SHIP LOADER TOWER SW PANEL POINT #10 SW FACE PP#10 (INCORRECTLY MARKED NW FACE)**  
**DESCRIPTION:TOP SIDE OF DIAGONAL CONNECTION DIRT AND DEBRIS BUILTUP 8\"/>
**CONDITION STATE CS3/4****





**JG-111213-10** SKAGWAY ORE TERMINAL SHIP LOADER  
**LOCATION:** SOUTH SHIP LOADER TOWER S PANEL POINT #11  
**DESCRIPTION:** 1-INCH LONG AREA ALONG TOP WELD HAS MODERATE LAMINAR RUST FORMING UNDER PAINT AND LIGHT PITTING STARTING TO FORM. ELEMENT MISMARKED AS NT FACE)  
**CONDITION STATE CS4**



**JG-111213-09** SKAGWAY ORE TERMINAL SHIP LOADER  
**LOCATION:** SOUTH SHIP LOADER TOWER S PANEL POINT #11  
**DESCRIPTION:** 1-INCH LONG AREA ALONG TOP WELD HAS MODERATE LAMINAR RUST FORMING UNDER PAINT AND LIGHT PITTING STARTING TO FORM. ELEMENT MISMARKED AS NT)  
**CONDITION STATE CS4**



**JG-111213-08** SKAGWAY ORE TERMINAL SHIP LOADER  
**LOCATION:** SOUTH SHIP LOADER TOWER S PANEL POINT #11  
**DESCRIPTION:** 1-INCH LONG AREA ALONG TOP WELD HAS MODERATE LAMINAR RUST FORMING UNDER PAINT AND LIGHT PITTING STARTING TO FORM. ELEMENT MISMARKED AS NT)  
**CONDITION STATE CS4**

	<p><b>JG-111213-07</b> SKAGWAY ORE TERMINAL SHIP LOADER</p> <p><b>LOCATION:</b> SOUTH SHIP LOADER TOWER SW CORNER FACE OF MOTOR PLATFORM FLANGE (PHOTO MISMARKED AS NW FACE)</p> <p><b>DESCRIPTION:</b>WEST FACE TOP SIDE PLATFORM TOP SIDE OF FLANGE HAS 4"X12" AREA WITH PAINT PEELED AWAY AND MODERATE SURFACE RUST FORMING ON EXPOSED STEEL.</p> <p><b>CONDITION STATE CS3</b></p>
	<p><b>JG-111213-06</b> SKAGWAY ORE TERMINAL SHIP LOADER</p> <p><b>LOCATION:</b> SOUTH SHIP LOADER TOWER SHIP LOADER BOOM IN RAISE POSITION AS VIEWED FROM SOUTH TOWER.</p> <p><b>DESCRIPTION:</b> BOOM INSPECTOR RIGGING UP FOR BOOM INSPECTION</p> <p><b>CONDITION STATE CS N/A</b></p>
	<p><b>JG-111213-05</b> SKAGWAY ORE TERMINAL SHIP LOADER</p> <p><b>LOCATION:</b> SOUTH SHIP LOADER TOWER BOOM PARKED</p> <p><b>DESCRIPTION:</b> SOUTH FACE OF BOOM GIRDER SHOWING SHUTTLE SLOT FOR SPOUT, BOOM INSPECTOR RIGGING UP FOR BOOM INSPECTION</p> <p><b>CONDITION STATE CS N/A</b></p>
	<p><b>JG-111213-01 THRU 04</b> ARE GENERAL SCENERY PHOTOS, NOT INCLUDED IN CONDITION PHOTOS</p>



**JG-111313-19 SKAGWAY ORE TERMINAL SHIP LOADER**  
**LOCATION: SOUTH SHIP LOADER TOWER EAST FACE AT PP#1**

**DESCRIPTION: FISH PLATE IN DIAGONAL TO STRENGTHEN WEB (HEAVY SECTION LOSS) DRAIN HOLE IS CLEAR, PAINT CS 4 WITH 1/64-INCH SECTION LOSS TO WEB AND FLANGES.**

**CONDITION STATE CS4**



**JG-111313-18 SKAGWAY ORE TERMINAL SHIP LOADER**  
**LOCATION: SOUTH SHIP LOADER TOWER EAST FACE AT PP#5**

**DESCRIPTION: VIEW OF UNDERSIDE OF WEB. 6"X3" HOLE.**

**CONDITION STATE CS5**



**JG-111313-17 SKAGWAY ORE TERMINAL SHIP LOADER**  
**LOCATION: SOUTH SHIP LOADER TOWER EAST FACE AT PP# 5**

**DESCRIPTION: DIAGONAL BRACE AT SPLICE 3-INCHES OFF WATER POOLED ON TOP SIDE IN BOARD FLANGE HAS HEAVY LAMINAR RUST WITH SECTION LOSS UP TO 1/8-INCH. WEB BETWEEN TOWER AND SPLICE HAS 6"X3" AREA WITH 100% SECTION LOSS.**

**CONDITION STATE CS5**



**JG-111313-16 SKAGWAY ORE TERMINAL SHIP LOADER**  
**LOCATION: SOUTH SHIP LOADER TOWER EAST FACE AT PP# 5**

**DESCRIPTION: DIAGONAL BRACE AT SPLICE 3-INCHES OFF WATER POOLED ON TOP SIDE INBOARD FLANGE HAS HEAVY LAMINAR RUST WITH SECTION LOSS UP TO 1/8-INCH. WEB BETWEEN TOWER AND SPLICE HAS 6"X3" AREA WITH 100% SECTION LOSS.**

**CONDITION STATE CS5**



**JG-111313-15 SKAGWAY ORE TERMINAL SHIP LOADER**  
**LOCATION: SOUTH SHIP LOADER TOWER EAST FACE AT PP# 7**

**DESCRIPTION: WATER POOLING ON TOP SIDE OF DIAGONAL, HEAVY SECTION LOSS TO FLANGE ON INBOARD UP TO 1/8-INCH (COMMON TO FIND THIS TYPE CORROSION AT THESE LOCATIONS)**

**CONDITION STATE CS4/5**



**JG-111313-14 SKAGWAY ORE TERMINAL SHIP LOADER**  
**LOCATION: SOUTH SHIP LOADER TOWER EAST FACE AT PP# 7**

**DESCRIPTION: WATER POOLING ON TOP SIDE OF DIAGONAL, HEAVY SECTION LOSS TO FLANGE ON INBOARD UP TO 1/8-INCH (COMMON TO FIND THIS TYPE CORROSION AT THESE LOCATIONS)**

**CONDITION STATE CS4/5**



**JG-111313-13 SKAGWAY ORE TERMINAL SHIP LOADER**  
**LOCATION: SOUTH SHIP LOADER TOWER EAST FACE AT PP#6**

**DESCRIPTION: PACK RUST FORMING BETWEEN SEAM AT BOLTED CONNECTION. WATER POOLING ABOVE JOINT DUE TO NO DRAIN HOLE. HEAVY SECTION LOSS TO DIAGONAL FLANGES, UP TO 1/8 INCH.**

**CONDITION STATE CS4/5**



**JG-111313-12 SKAGWAY ORE TERMINAL SHIP LOADER**  
**LOCATION: SOUTH SHIP LOADER TOWER EAST FACE AT PP# 8**

**DESCRIPTION: OUTBOARD VERTICAL TOWER FLANGE IS BENT OUT OF PLANE UP TO ¼-INCH.**

**CONDITION STATE CS4**



**JG-111313-11 SKAGWAY ORE TERMINAL SHIP LOADER**  
**LOCATION: SOUTH SHIP LOADER TOWER SOUTH FACE AT SE CORNER PP#9**

**DESCRIPTION: DIAGONAL BRACE BETWEEN PP#9 AND PP#? 3 FEET FROM PP#9 BOTTOM OUTBOARD FLANGE IS BENT OUT OF PLANE ½-INCH.**

**CONDITION STATE CS2**



**JG-111313-10 SKAGWAY ORE TERMINAL SHIP LOADER**  
**LOCATION: SOUTH SHIP LOADER TOWEREAST FACE GIRDER BETWEEN NE AND SE TOWER LEGS**

**DESCRIPTION: MID SPSN 3'X2' AREA WITH HEAVY LAMINAR RUST FORMING BEHIND FAILED PAINT.**


**CONDITION STATE CS3**



**JG-111313-09 SKAGWAY ORE TERMINAL SHIP LOADER**  
**LOCATION: SHIP LOADER BOOM VIEWED FROM ABOVE ON SOUTH TOWER**

**DESCRIPTION: BOOM STRUCTURE INSPECTION AT SHUTTLE SPOUT SLOT.**

**CONDITION STATE CS N/A**

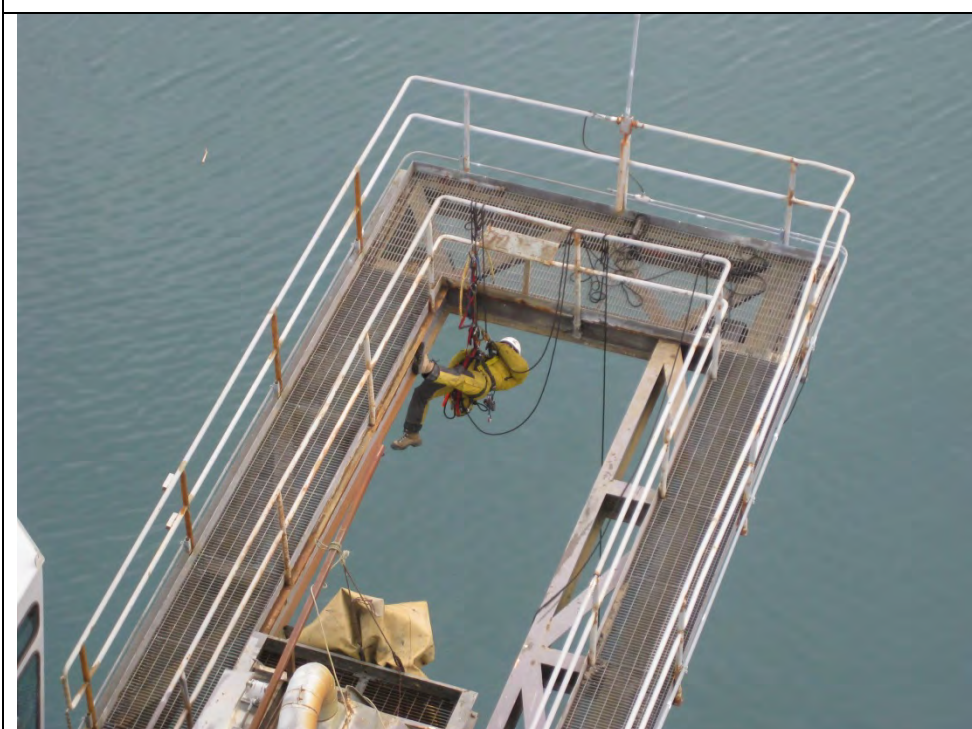

**JG-111313-08 SKAGWAY ORE TERMINAL SHIP LOADER**  
**LOCATION: SHIP LOADER BOOM VIEWED FROM ABOVE ON SOUTH TOWER**

**DESCRIPTION: BOOM STRUCTURE INSPECTION AT SHUTTLE SPOUT SLOT. NOTE RUSTED FLANGE AND WEB ON LEFT OF OPENING THAT IS CAUSED BY SHUTTLE WHEEL RUBBING.**

**CONDITION STATE CS N/A**



**JG-111313-07 SKAGWAY ORE TERMINAL SHIP LOADER**  
**LOCATION: SOUTH SHIP LOADER TOWER COUNTER WEIGHT LIFT CABLE CONNECTION TO PULLEY AT TOP PLATFORM**

**DESCRIPTION: HEAVY CORROSION WITH SECTION LOSS AT THIMBLE.**

**CONDITION STATE CS5**



**JG-111313-06 SKAGWAY ORE TERMINAL SHIP LOADER**  
**LOCATION: SOUTH SHIP LOADER TOWER COUNTER WEIGHT LIFT CABLE CONNECTION TO PULLEY AT TOP PLATFORM**

**DESCRIPTION: HEAVY CORROSION WITH SECTION LOSS AT THIMBLE.**

**CONDITION STATE CS5**



**JG-111313-05 SKAGWAY ORE TERMINAL SHIP LOADER**  
**LOCATION: SOUTH SHIP LOADER TOWER W FACE AT NW CORNER PP#2**

**DESCRIPTION: HEAVY LAMINAR RUST WITH SECTION LOSS TO INBOARD FLANGE UP TO 1/8-INCH (COMMON TO FIND CORROSION AT THESE LOCATIONS)**

**CONDITION STATE CS4/5**



**JG-111313-04 SKAGWAY ORE TERMINAL SHIP LOADER**  
**LOCATION: SOUTH SHIP LOADER TOWER W FACE AT NW CORNER AT PP#8**

**DESCRIPTION: WATER IS POOLING ON TOP[SIDE OF DIAGONAL BRACE. SECTION LOSS TO WEN ON TOWER UP TO 1/16-INCH. 12-INCH OUT FROM TOWER FLANGESS HAVE UP TO 3/4-INCH SECTION LOSS. HEAVY CORROSION AT THIS PANEL POINT.**

**CONDITION STATE CS4/5**



**JG-111313-03 SKAGWAY ORE TERMINAL SHIP LOADER**  
**LOCATION: SOUTH SHIP LOADER TOWER WEST FACE AT NW CORNER**

**DESCRIPTION: CABLES CONNECTED TO BOOM HOIST PLATFORM HAS HEAVY CORROSION WITH BROKEN STRANDS JUST UNDER THIMBLE SOCKET FITTING.**

**CONDITION STATE CS5**



**JG-111313-02 SKAGWAY ORE TERMINAL SHIP LOADER**  
**LOCATION: SOUTH SHIP LOADER TOWER W FACE AT NW CORNER LEG PP# 10**

**DESCRIPTION: HEAVY RUST SCALE/LAMINAR RUST AT WELDS AND BOLTED CONNECTIONS 1/4-INCH OF PACK RUST FORMING BETWEEN BOLTED CONNECTIONS.**

**CONDITION STATE CS4/5**





**JG-111313-01 SKAGWAY ORE TERMINAL SHIP LOADER**

**LOCATION: SOUTH SHIP LOADER TOWER W FACE AT NW CORNER LEG**


**DESCRIPTION: WEB ABOVE NW LEG HAS A 1 FOOT BY 2 FOOT AREA WITH 100% PAINT FAILURE WITH HEAVY LAMINAR RUST FORMING AND SECTION LOSS TO WEB.**

**CONDITION STATE CS4/5**

# **Appendix 6**

## **Ship Loader Reference Drawings**

PLAN NORTH

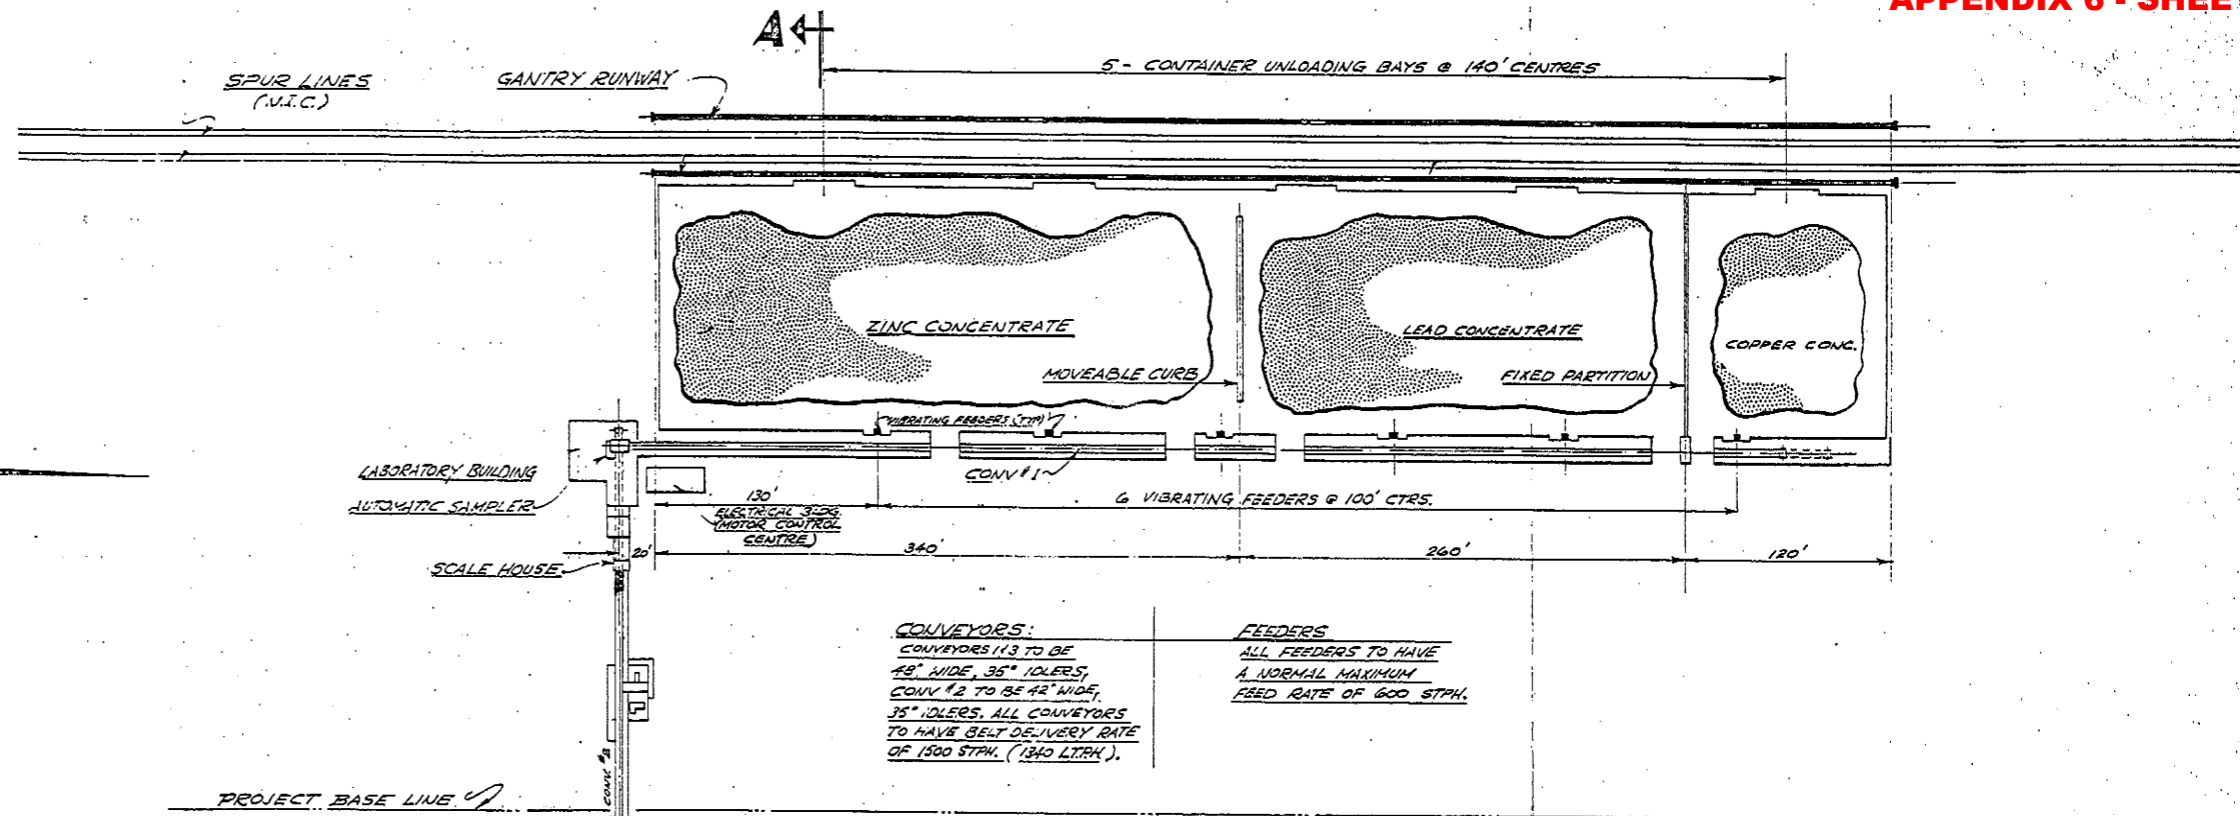

**CONVEYORS:**  
 CONVEYOR #1 TO BE 48" WIDE, 35" IDLERS;  
 CONVEYOR #2 TO BE 42" WIDE, 35" IDLERS. ALL CONVEYORS TO HAVE BELT DELIVERY RATE OF 1500 STPH. (1340 LTRH).


**FEEDERS:**  
 ALL FEEDERS TO HAVE A NORMAL MAXIMUM FEED RATE OF 600 STPH.

TIDE DATA AT SKAGWAY

EXTREME HIGH WATER*	23.4'
M.H.H.W.	16.7'
M.H.W.	15.75'
M.S.L.	8.7'
M.L.W.	1.65'
M.L.L.W.	0.0'
EXTREME LOW WATER*	-6.0'

\* HIGHEST & LOWEST RECORDED

PLAN  
 SCALE = 1" = 50'-0"

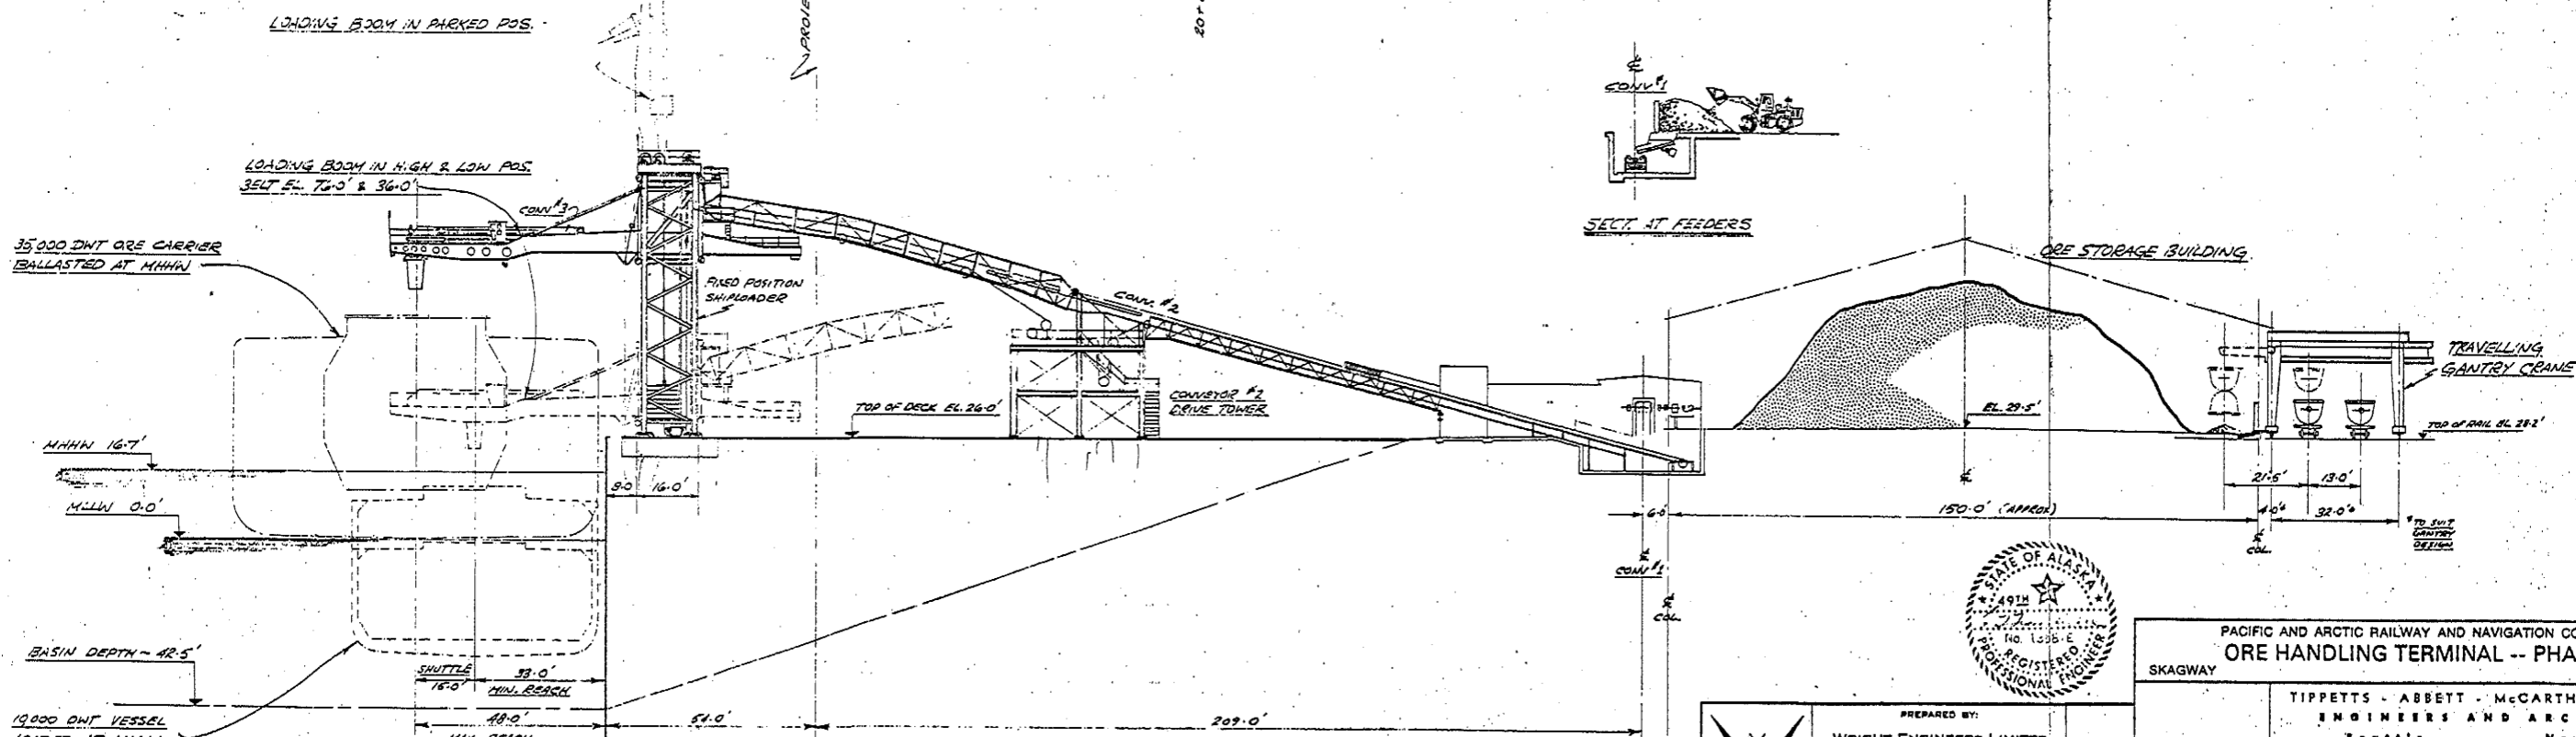

ELEVATION & SECTION A-A  
 SCALE = 1" = 20'-0"



PREPARED BY:	WRIGHT ENGINEERS LIMITED
VANCOUVER	CANADA
REFERENCE:	528 100 101
NO.	BY DATE
DESIGNED BY:	HEWITT
CHECKED BY:	HEWITT

PACIFIC AND ARCTIC RAILWAY AND NAVIGATION COMPANY  
**ORE HANDLING TERMINAL -- PHASE II**  
 SKAGWAY ALASKA


TIPPETTS - ABBETT - MCCARTHY - STRATTON  
 ENGINEERS AND ARCHITECTS  
 Seattle New York

**SITE PLAN & ELEVATION**

DATE MAY 1968  
 SCALE AS NOTED


DRAWING REDUCED TO 45% OF ORIGINAL SIZE  
 SOT03-1969-AB-2555-GL-1, Site Plan & Elevation

1265/2013

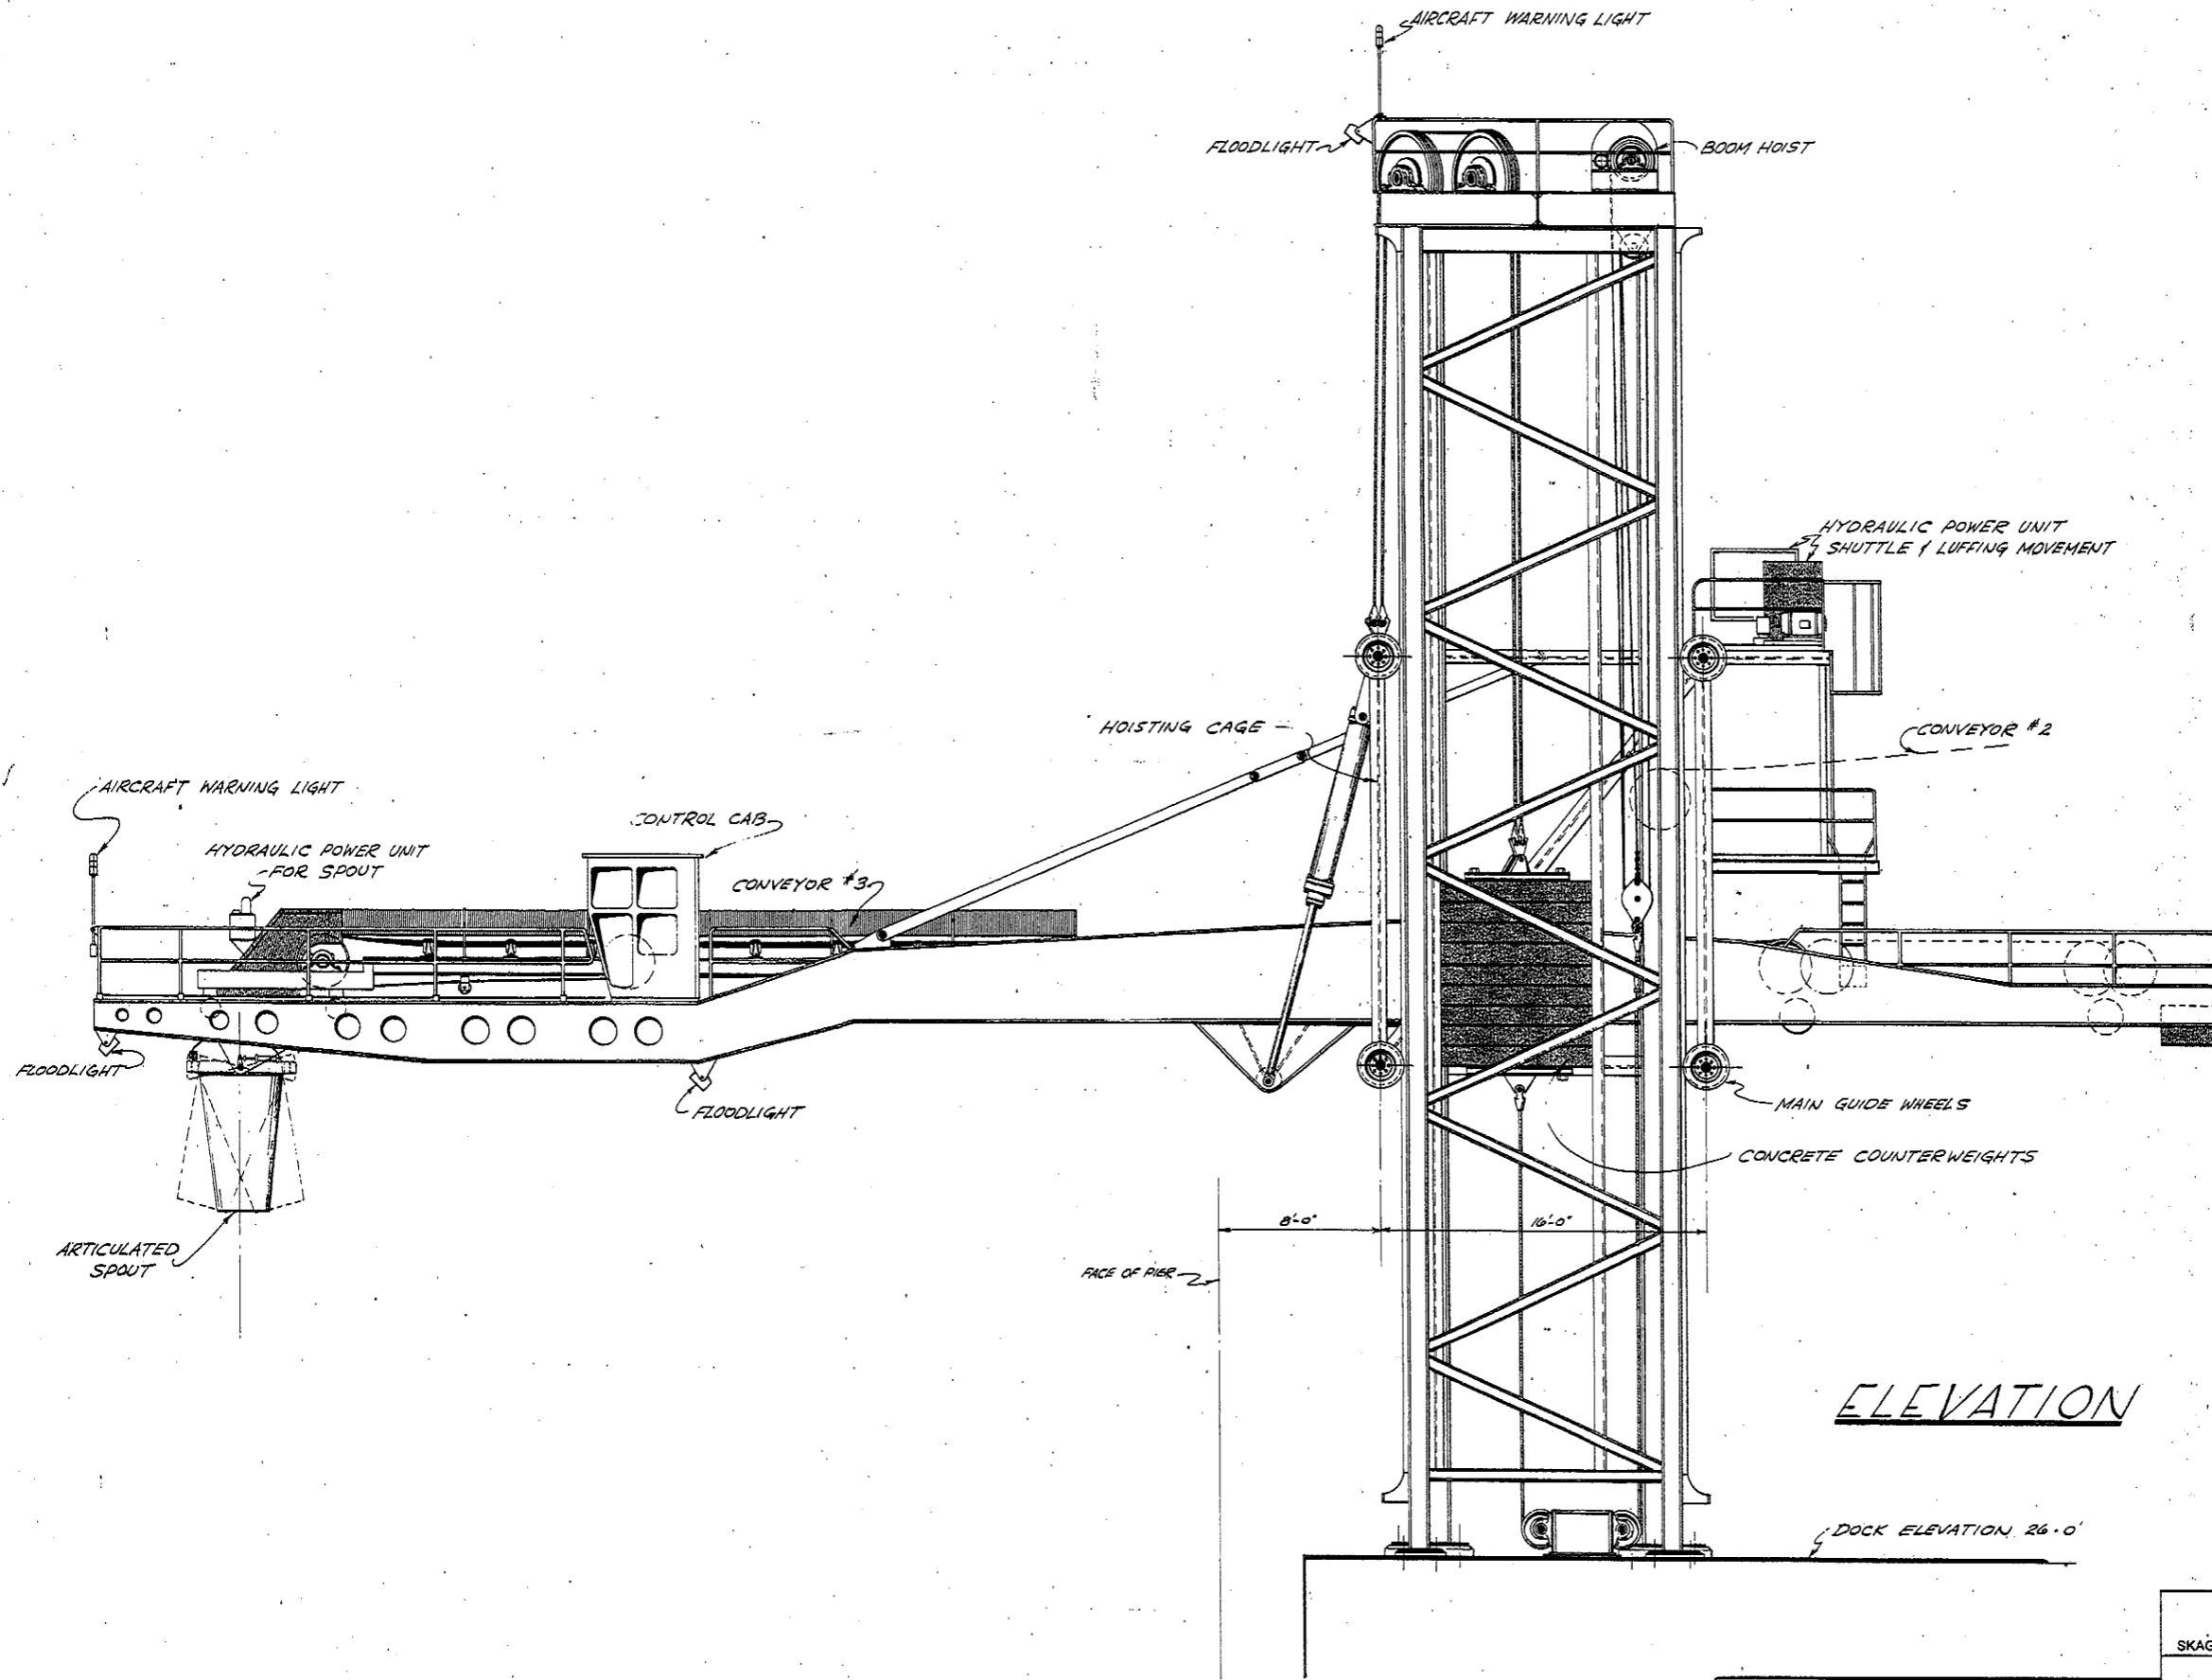

DRAWING REDUCED TO  
45% OF ORIGINAL SIZE

SOT03-1969-AB-2555-GL-2, Shiploader  
General Arrangement Side Elevation

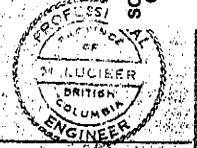

**ELEVATION**

DOCK ELEVATION 26'-0"

PACIFIC AND ARCTIC RAILWAY AND NAVIGATION COMPANY  
ORE HANDLING TERMINAL - PHASE II  
SKAGWAY ALASKA

TIPPETTS - ABBETT - McCARTHY - STRATTON  
ENGINEERS AND ARCHITECTS  
Seattle New York


PREPARED BY: <b>WRIGHT ENGINEERS LIMITED</b> VANCOUVER - CANADA	
REFERENCE:	528 480 101
NO. BY DATE	REVISION

DESIGNED BY *WJ*  
CHECKED BY *RHT*

**SHIPOADER**  
GENERAL ARRANGEMENT  
SIDE ELEVATION


DRAWN BY *HBT*  
DATE MAY 1968  
SCALE 1/8" = 1'-0"


12566/2013

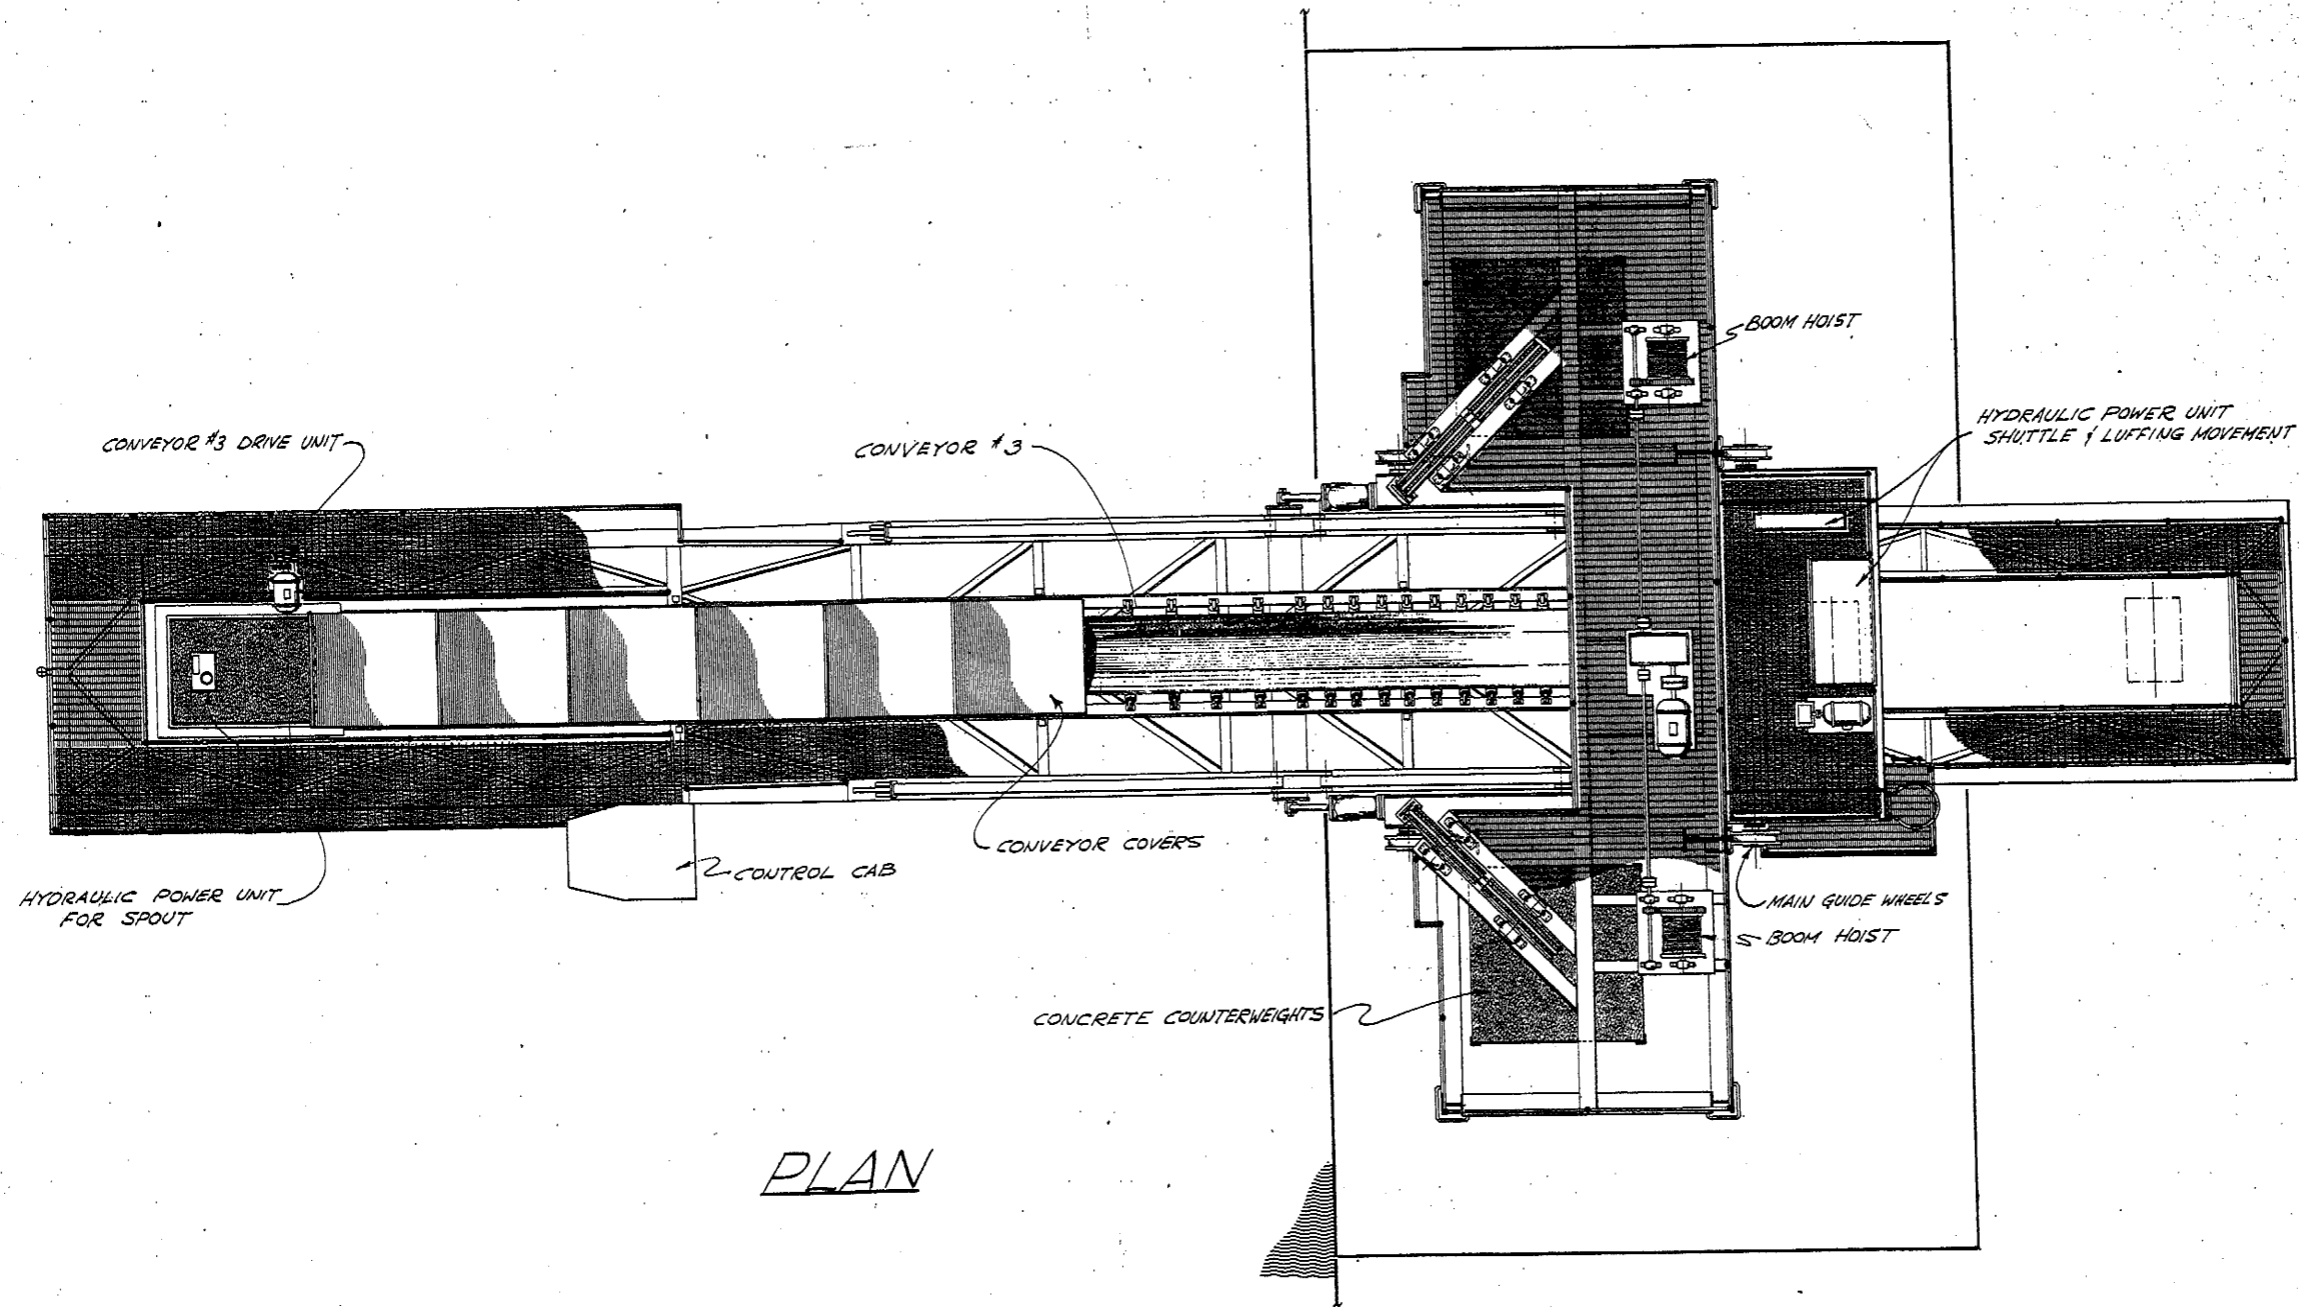


PLAN

DRAWING REDUCED TO 45% OF ORIGINAL SIZE  
SOT03-1969-AB-2555-GL-3, Shiploader - General Arrangement Plan

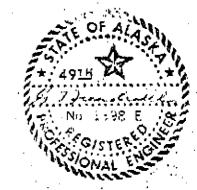

 PREPARED BY: <b>WRIGHT ENGINEERS LIMITED</b> VANCOUVER - CANADA		PACIFIC AND ARCTIC RAILWAY AND NAVIGATION COMPANY <b>ORE HANDLING TERMINAL - PHASE II</b> SKAGWAY ALASKA	
		TIPPETTS - ABBETT - MCCARTHY - STRATTON ENGINEERS AND ARCHITECTS Seattle New York	
REFERENCE: 528 480 102	DRAWN BY: HGT DATE: MAY 1968	<b>SHIPLOADER</b> GENERAL ARRANGEMENT PLAN	
NO. BY DATE REVISION	DESIGNED BY: LCN CHECKED BY: TME	SCALE: 1/4" = 1'-0" 12162013	

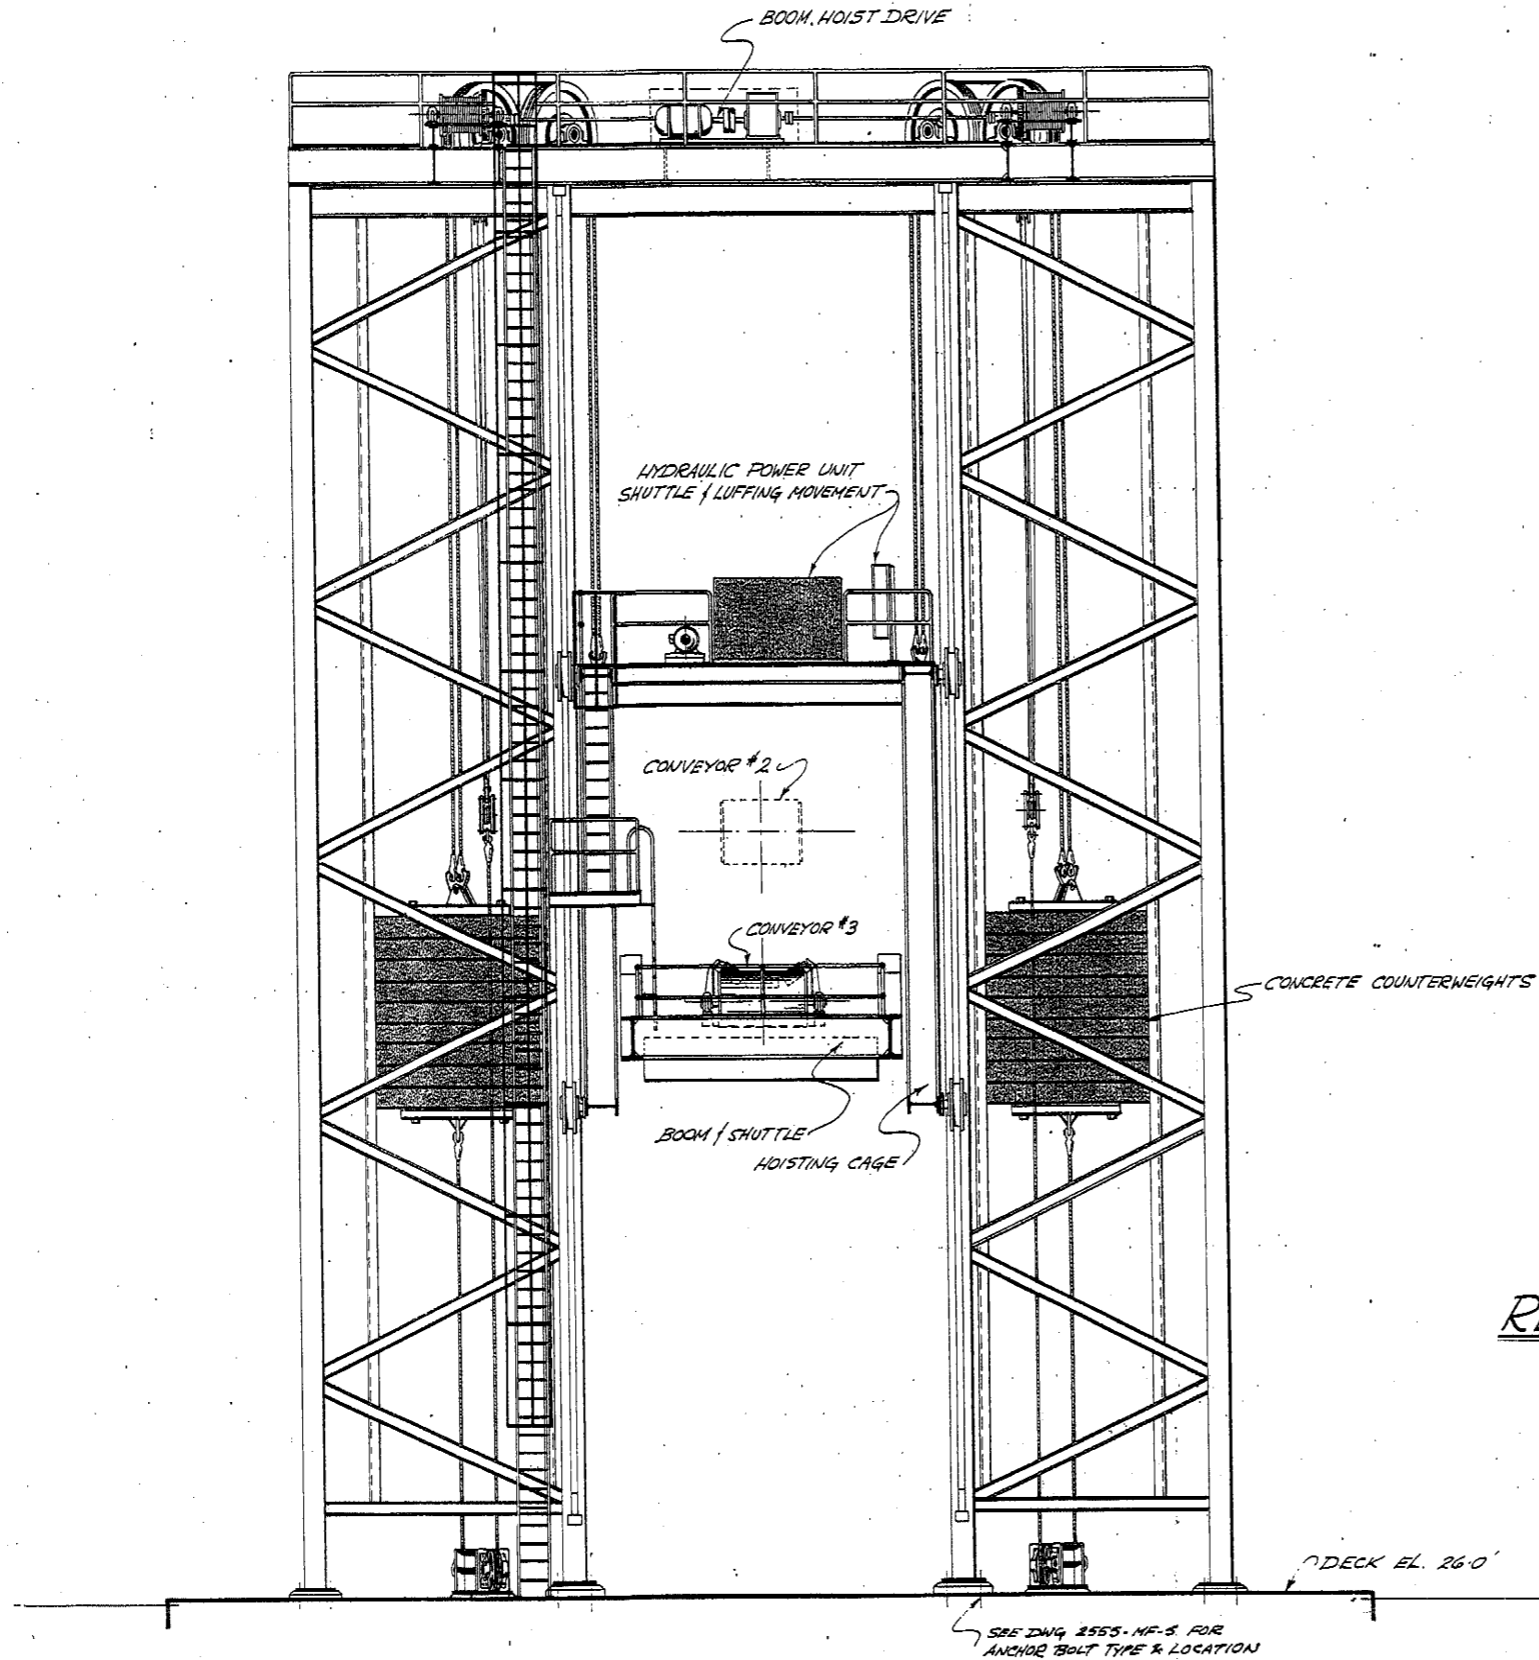

REAR ELEVATION

DRAWING REDUCED TO 45% OF ORIGINAL SIZE  
 SOT03-1989-AB-2555-GL-4, Shiploader - General Arrangement Rear Elevation




SEE DWG 2555-NF-5 FOR ANCHOR BOLT TYPE & LOCATION

PACIFIC AND ARCTIC RAILWAY AND NAVIGATION COMPANY	
ORE HANDLING TERMINAL -- PHASE II	
SKAGWAY	ALASKA
TIPPETTS - ABBETT - MCCARTHY - STRATTON ENGINEERS AND ARCHITECTS Seattle New York	
DESIGNED BY <i>LCW</i>	DRAWN BY <i>464</i>
CHECKED BY <i>PHF</i>	DATE: MAY 1968
SCALE: 1/4" = 1'-0"	
SHIPLOADER GENERAL ARRANGEMENT REAR ELEVATION	
12516/2043	

PREPARED BY:	
WRIGHT ENGINEERS LIMITED	
VANCOUVER CANADA	
REFERENCE:	528 480 103
NO.	BY DATE REVISION



LOCATION MAP

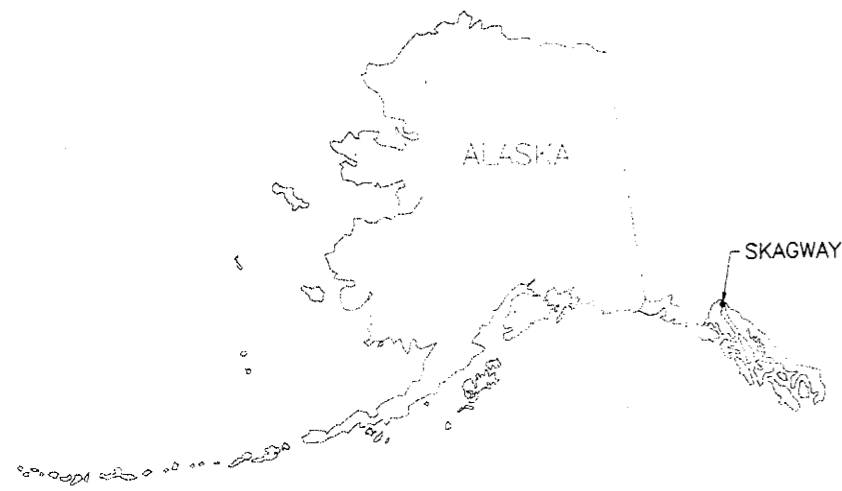

INDEX



S1	COVER SHEET
S2	LOCATION/VICINITY MAP SHEET INDEX ABBREVIATIONS GENERAL NOTES
S3	EXISTING LAYOUT
S4	DEMO PLAN
S5	PILE LAYOUT PLAN
S6	LOADER PLATFORM - PLAN & SECTIONS
S7	LOADER PLATFORM - DETAILS
S8	CONVEYOR PLATFORM - PLAN & SECTIONS
S9	CONVEYOR PLATFORM DETAILS
S10	STRUCTURAL DETAILS
S11	STRUCTURAL DETAILS
S12	TIMBER DOCK - PLAN & SECTIONS
CP1	CATHODIC PROTECTION
A1	AS-BUILT SHIP LOADER ACCESS, PEDESTRIAN BRIDGE
A2	AS-BUILT SHIP LOADER DETAILS
T1	TEST HOLE NO. 1
T2	TEST HOLE NO. 2
T3	MAY, 1967 SUBSURFACE DATA BORING LOGS

GENERAL NOTES

- A. CONCRETE
- MIXING AND PLACING OF CONCRETE AND SELECTION OF MATERIALS SHALL BE IN ACCORDANCE WITH THE AMERICAN CONCRETE INSTITUTE 318-89.
  - ALL REINFORCING STEEL SHALL BE NEW BILLET STOCK. ASTM A-615. GRADE 60. UNLESS OTHERWISE NOTED.
  - MINIMUM CLEAR COVER FOR REINFORCEMENT SHALL BE 2 INCHES FOR BARS UP TO #7, AND 2 1/2" FOR #8 OR LARGER UNLESS OTHERWISE NOTED.
  - CAST IN PLACE PROPERTIES
 

28 DAY COMPRESSIVE STRENGTH	3500 PSI
MAXIMUM AGGREGATE SIZE	3/4"
SLUMP	1-4
- B. TENDONS
- MAINTAIN STRESS SYMMETRY DURING JACKING.  
 JACKING STRESS 0.94(0.95)FPY = 205 KSI (5% ASSUMED ANCHOR FRICTION)  
 LONG TERM LOSSES = 25.0 KSI  
 FINAL PRESTRESS REQUIRED AT MIDSPAN
- |                      |             |
|----------------------|-------------|
| SHIP LOADER PLATFORM |             |
| ROW NO. 1            | = 1140 KIPS |
| ROW NO. 2            | = 315 KIPS  |
| CONVEYOR PLATFORM    |             |
| ROW NO. 1            | = 500 KIPS  |
- C. STRANDS
- ALL PRESTRESSING STRANDS SHALL HAVE A CROSS-SECTIONAL AREA OF 0.153 IN.<sup>2</sup>

VICINITY MAP

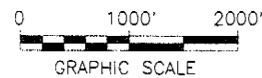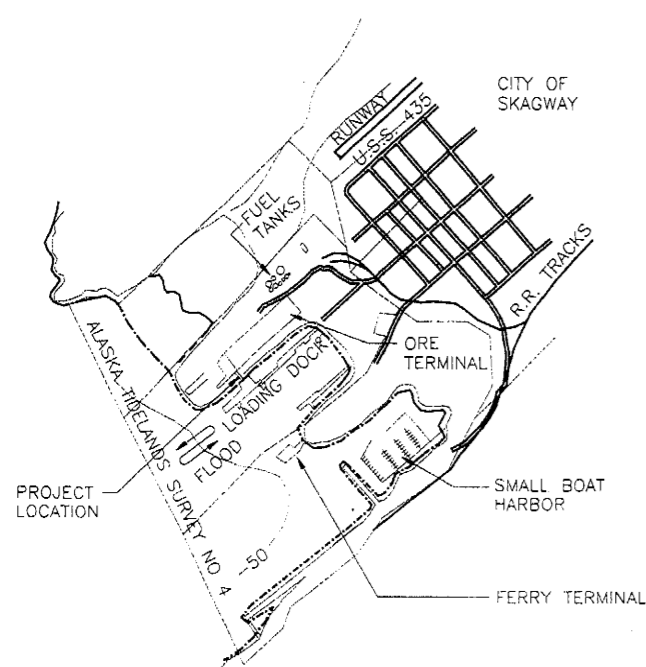


ABBREVIATIONS

BOT.	BOTTOM
C.G.	CENTER OF GRAVITY
CLR	CLEAR
Ⓞ	CENTERLINE
CONC.	CONCRETE
CONT.	CONTINUOUS
DTL.	DETAIL
EA.	EACH
E.W.	EACH WAY
EXIST.	EXISTING
F.S.	FAR SIDE
HORIZ	HORIZONTAL
MAX.	MAXIMUM
M.L.L.W.	MEAN LOWER LOW WATER
M.I.	MALLABLE IRON
NO.	NUMBER
N.S.	NEAR SIDE
O.C.	ON CENTER
REINF	REINFORCEMENT
PL	PLATE
SP.	SPACE
STA.	STATION
STL.	STEEL
TEN.	TENSION OR TENSIONING
TYP.	TYPICAL
WWM	WELDED WIRE MESH

DESIGN	BE
DRAWN	CW
CHECK	DHA
APPROVED	GCF

**R&M ENGINEERING, INC.**  
 6205 GLACIER HIGHWAY  
 P.O. BOX 34278  
 JUNEAU, ALASKA 99803  
 PH: (907) 780-6060

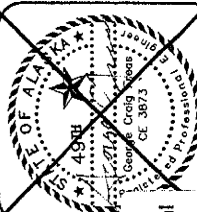

SOT03-1991-AB-S2, Location/Vicinity Map, Sheet Index, Abbreviation, General Notes

ALASKA INDUSTRIAL DEVELOPMENT & EXPORT AUTHORITY  
 SKAGWAY ORE TERMINAL STRUCTURAL REPAIRS  
 SKAGWAY, ALASKA

**LOCATION/VICINITY MAP**  
**INDEX, ABBREV., GEN. NOTES**



AS-BUILT

DATE: DEC. 6, 1991  
 R&M NO. 901362.03  
 SCALE: AS NOTED


**S2**

12/16/2013  
 2 OF 18

STRUCTURAL  
 E: 05169-S2, 1=1, 12/05/91 at 10:13

DESIGN	GCF
DRAWN	MKA
CHECK	DHA
APPROVED	GCF

**R&M ENGINEERING, INC.**  
 6205 GLACIER HIGHWAY  
 P.O. BOX 34278  
 JUNEAU, ALASKA 99803  
 PH: (907) 780-6060

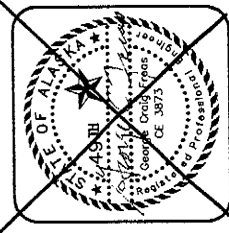


SOT03-1991-AB-S3, Existing Layout

ALASKA INDUSTRIAL DEVELOPMENT & EXPORT AUTHORITY  
 SKAGWAY ORE TERMINAL STRUCTURAL REPAIRS  
 SKAGWAY, ALASKA

DATE: DEC. 6, 1991  
 R&M NO. 901362.03  
 SCALE: AS NOTED

**S3**  
 SHEET 3 OF 18

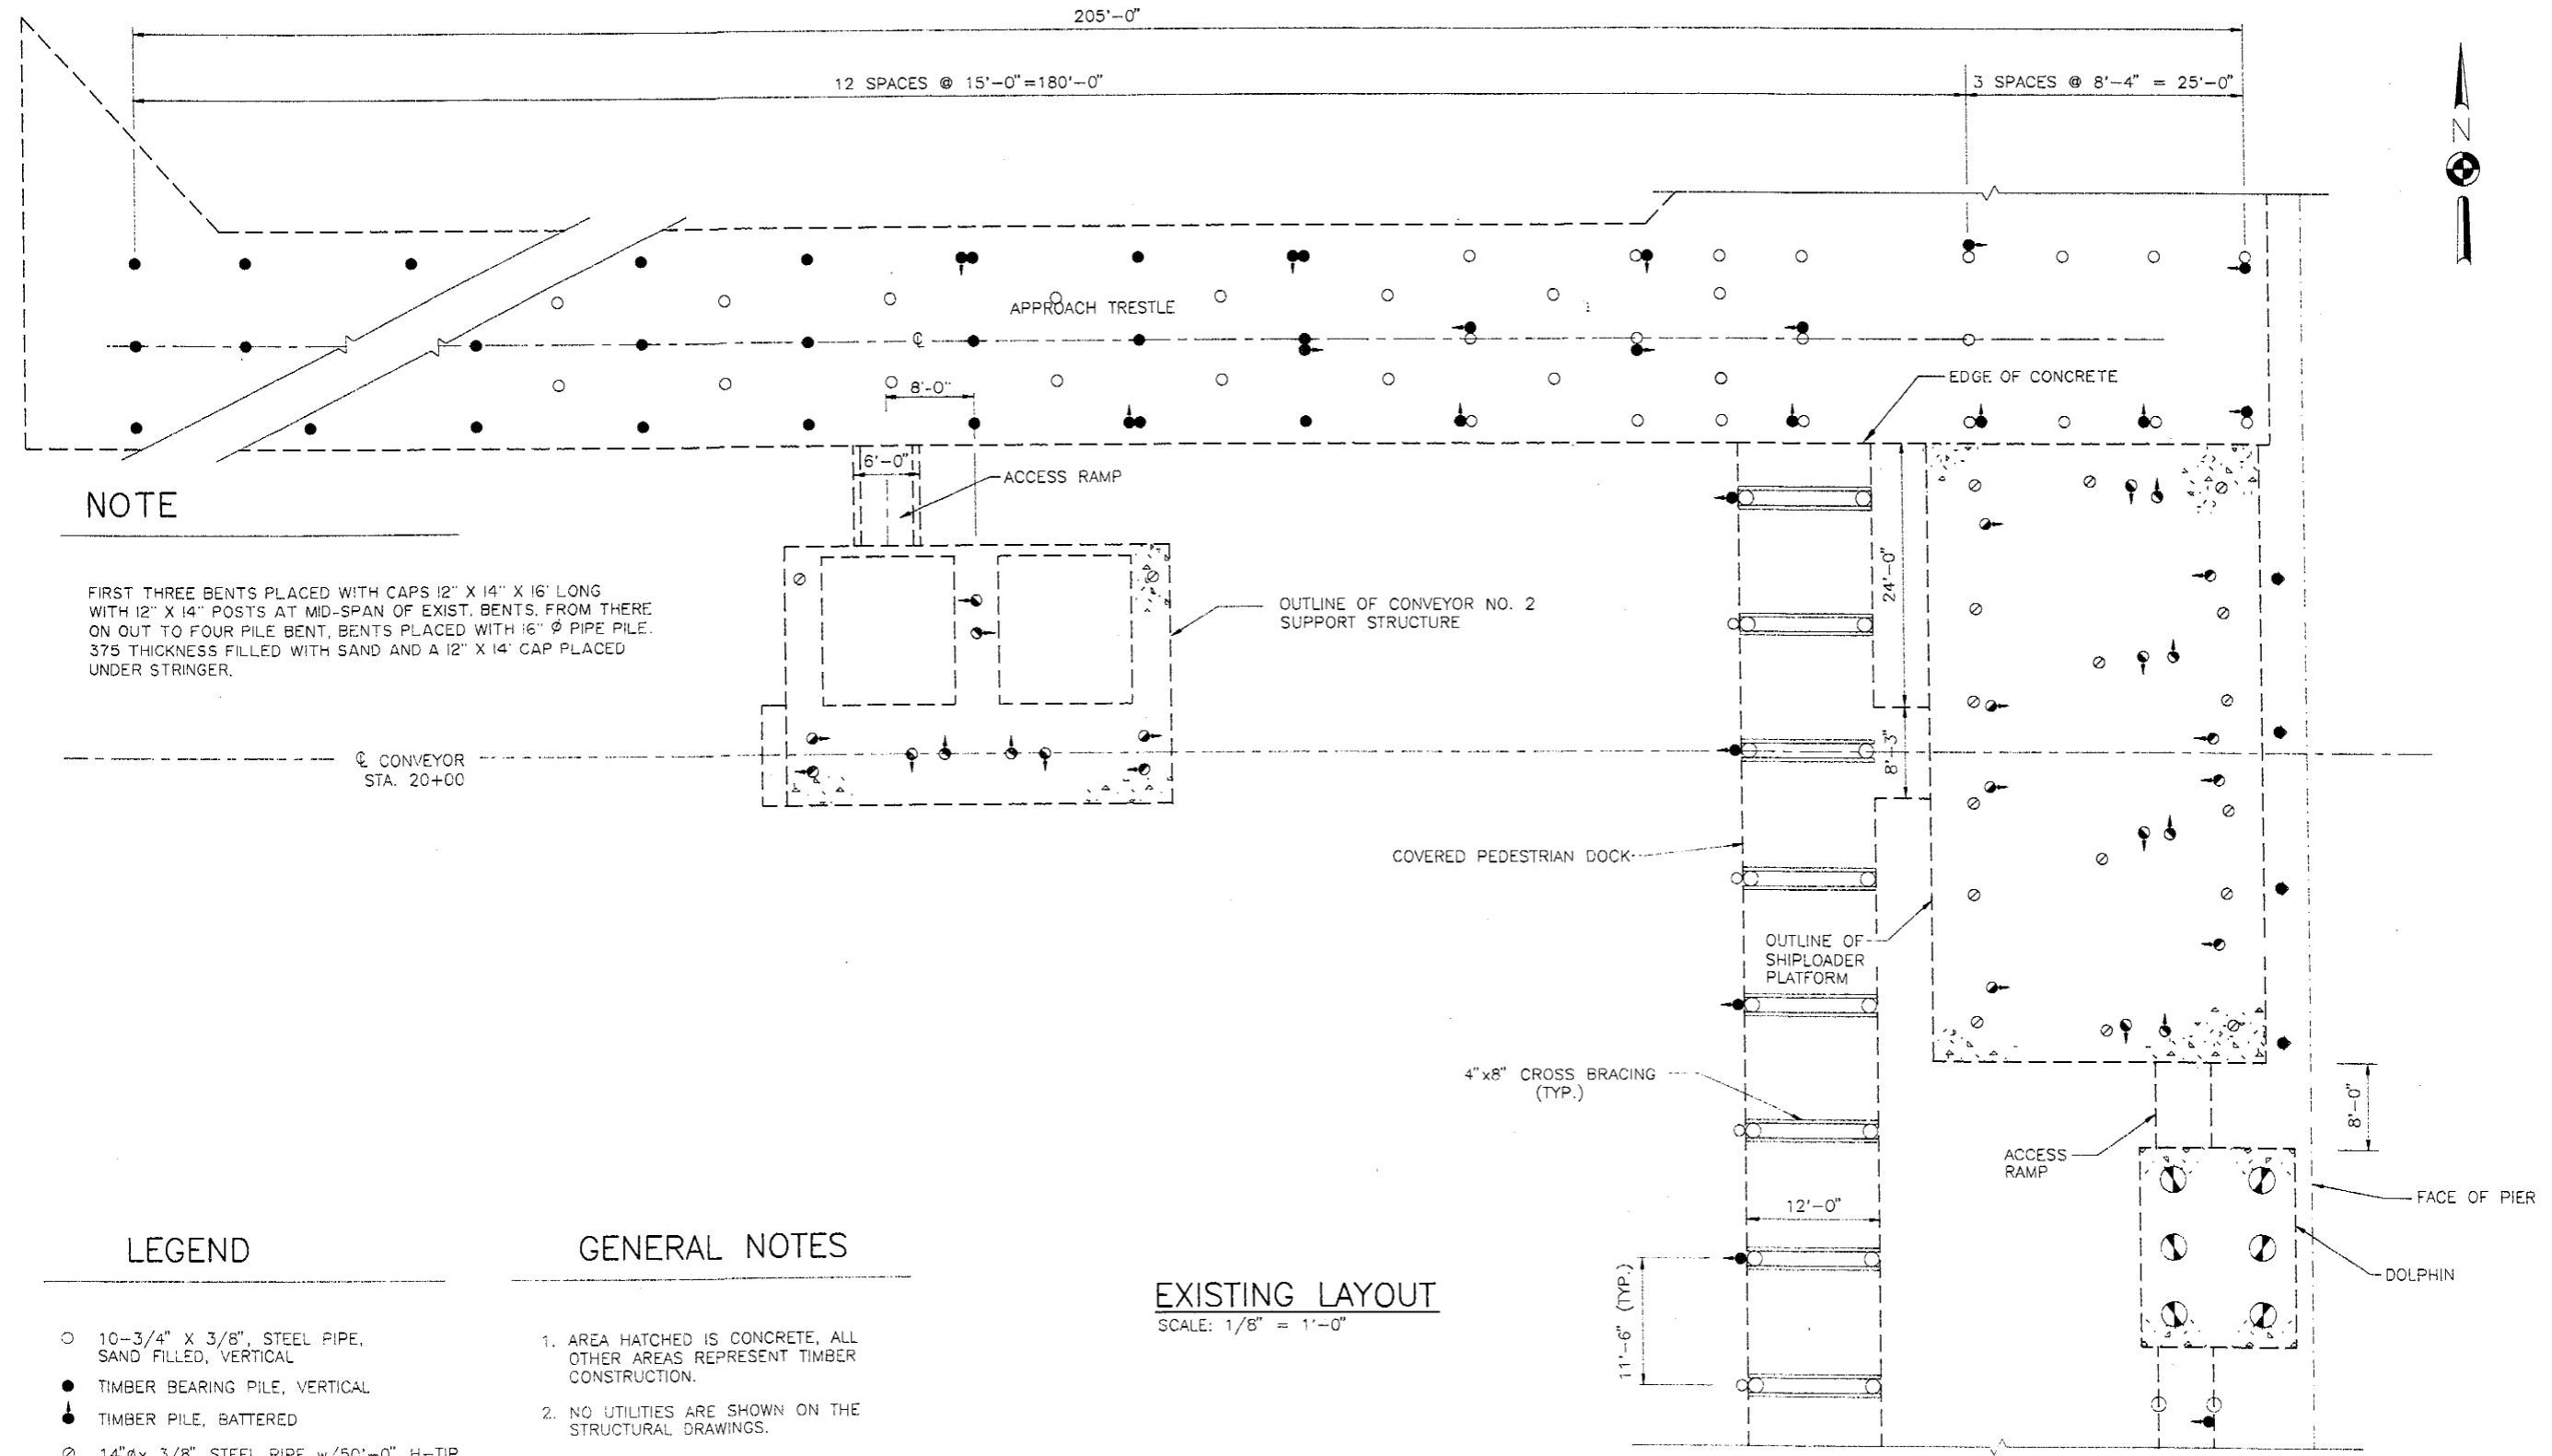

**NOTE**

FIRST THREE BENTS PLACED WITH CAPS 12" X 14" X 16' LONG WITH 12" X 14" POSTS AT MID-SPAN OF EXIST. BENTS. FROM THERE ON OUT TO FOUR PILE BENT, BENTS PLACED WITH 16" Ø PIPE PILE. 375 THICKNESS FILLED WITH SAND AND A 12" X 14" CAP PLACED UNDER STRINGER.

CONVEYOR STA. 20+00

**LEGEND**

- 10-3/4" X 3/8", STEEL PIPE, SAND FILLED, VERTICAL
- TIMBER BEARING PILE, VERTICAL
- ⬮ TIMBER PILE, BATTERED
- ⊙ 14"Ø X 3/8" STEEL PIPE W/50'-0" H-TIP, VERTICAL
- ⬮ 14"Ø X 3/8" STEEL PIPE W/50'-0" H-TIP, BATTERED
- ◆ TIMBER FENDER
- ⊙ 28"Ø STL. PIPE PILES

**GENERAL NOTES**


1. AREA HATCHED IS CONCRETE, ALL OTHER AREAS REPRESENT TIMBER CONSTRUCTION.
2. NO UTILITIES ARE SHOWN ON THE STRUCTURAL DRAWINGS.

**EXISTING LAYOUT**

SCALE: 1/8" = 1'-0"



**AS-BUILT**

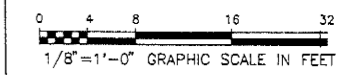


e: 05169-s3, 1=96, 12/05/91 at 09:09



DESIGN	GCF
DRAWN	MKA
CHECK	DHA
APPROVED	GCF

**R&M ENGINEERING, INC.**  
 8205 GLACIER HIGHWAY  
 P.O. BOX 34278  
 JUNEAU, ALASKA 99803  
 PH. (907) 780-6060

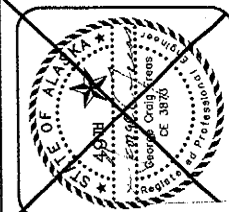

SOT03-1991-AB-S4, Demo Plan


ALASKA INDUSTRIAL DEVELOPMENT & EXPORT AUTHORITY  
 SKAGWAY ORE TERMINAL STRUCTURAL REPAIRS  
 SKAGWAY, ALASKA

**DEMOLITION PLAN**


DATE: DEC. 6, 1991  
 R&M NO. 901362.03  
 SCALE: AS NOTED

**S4**

SHEET 4 OF 18

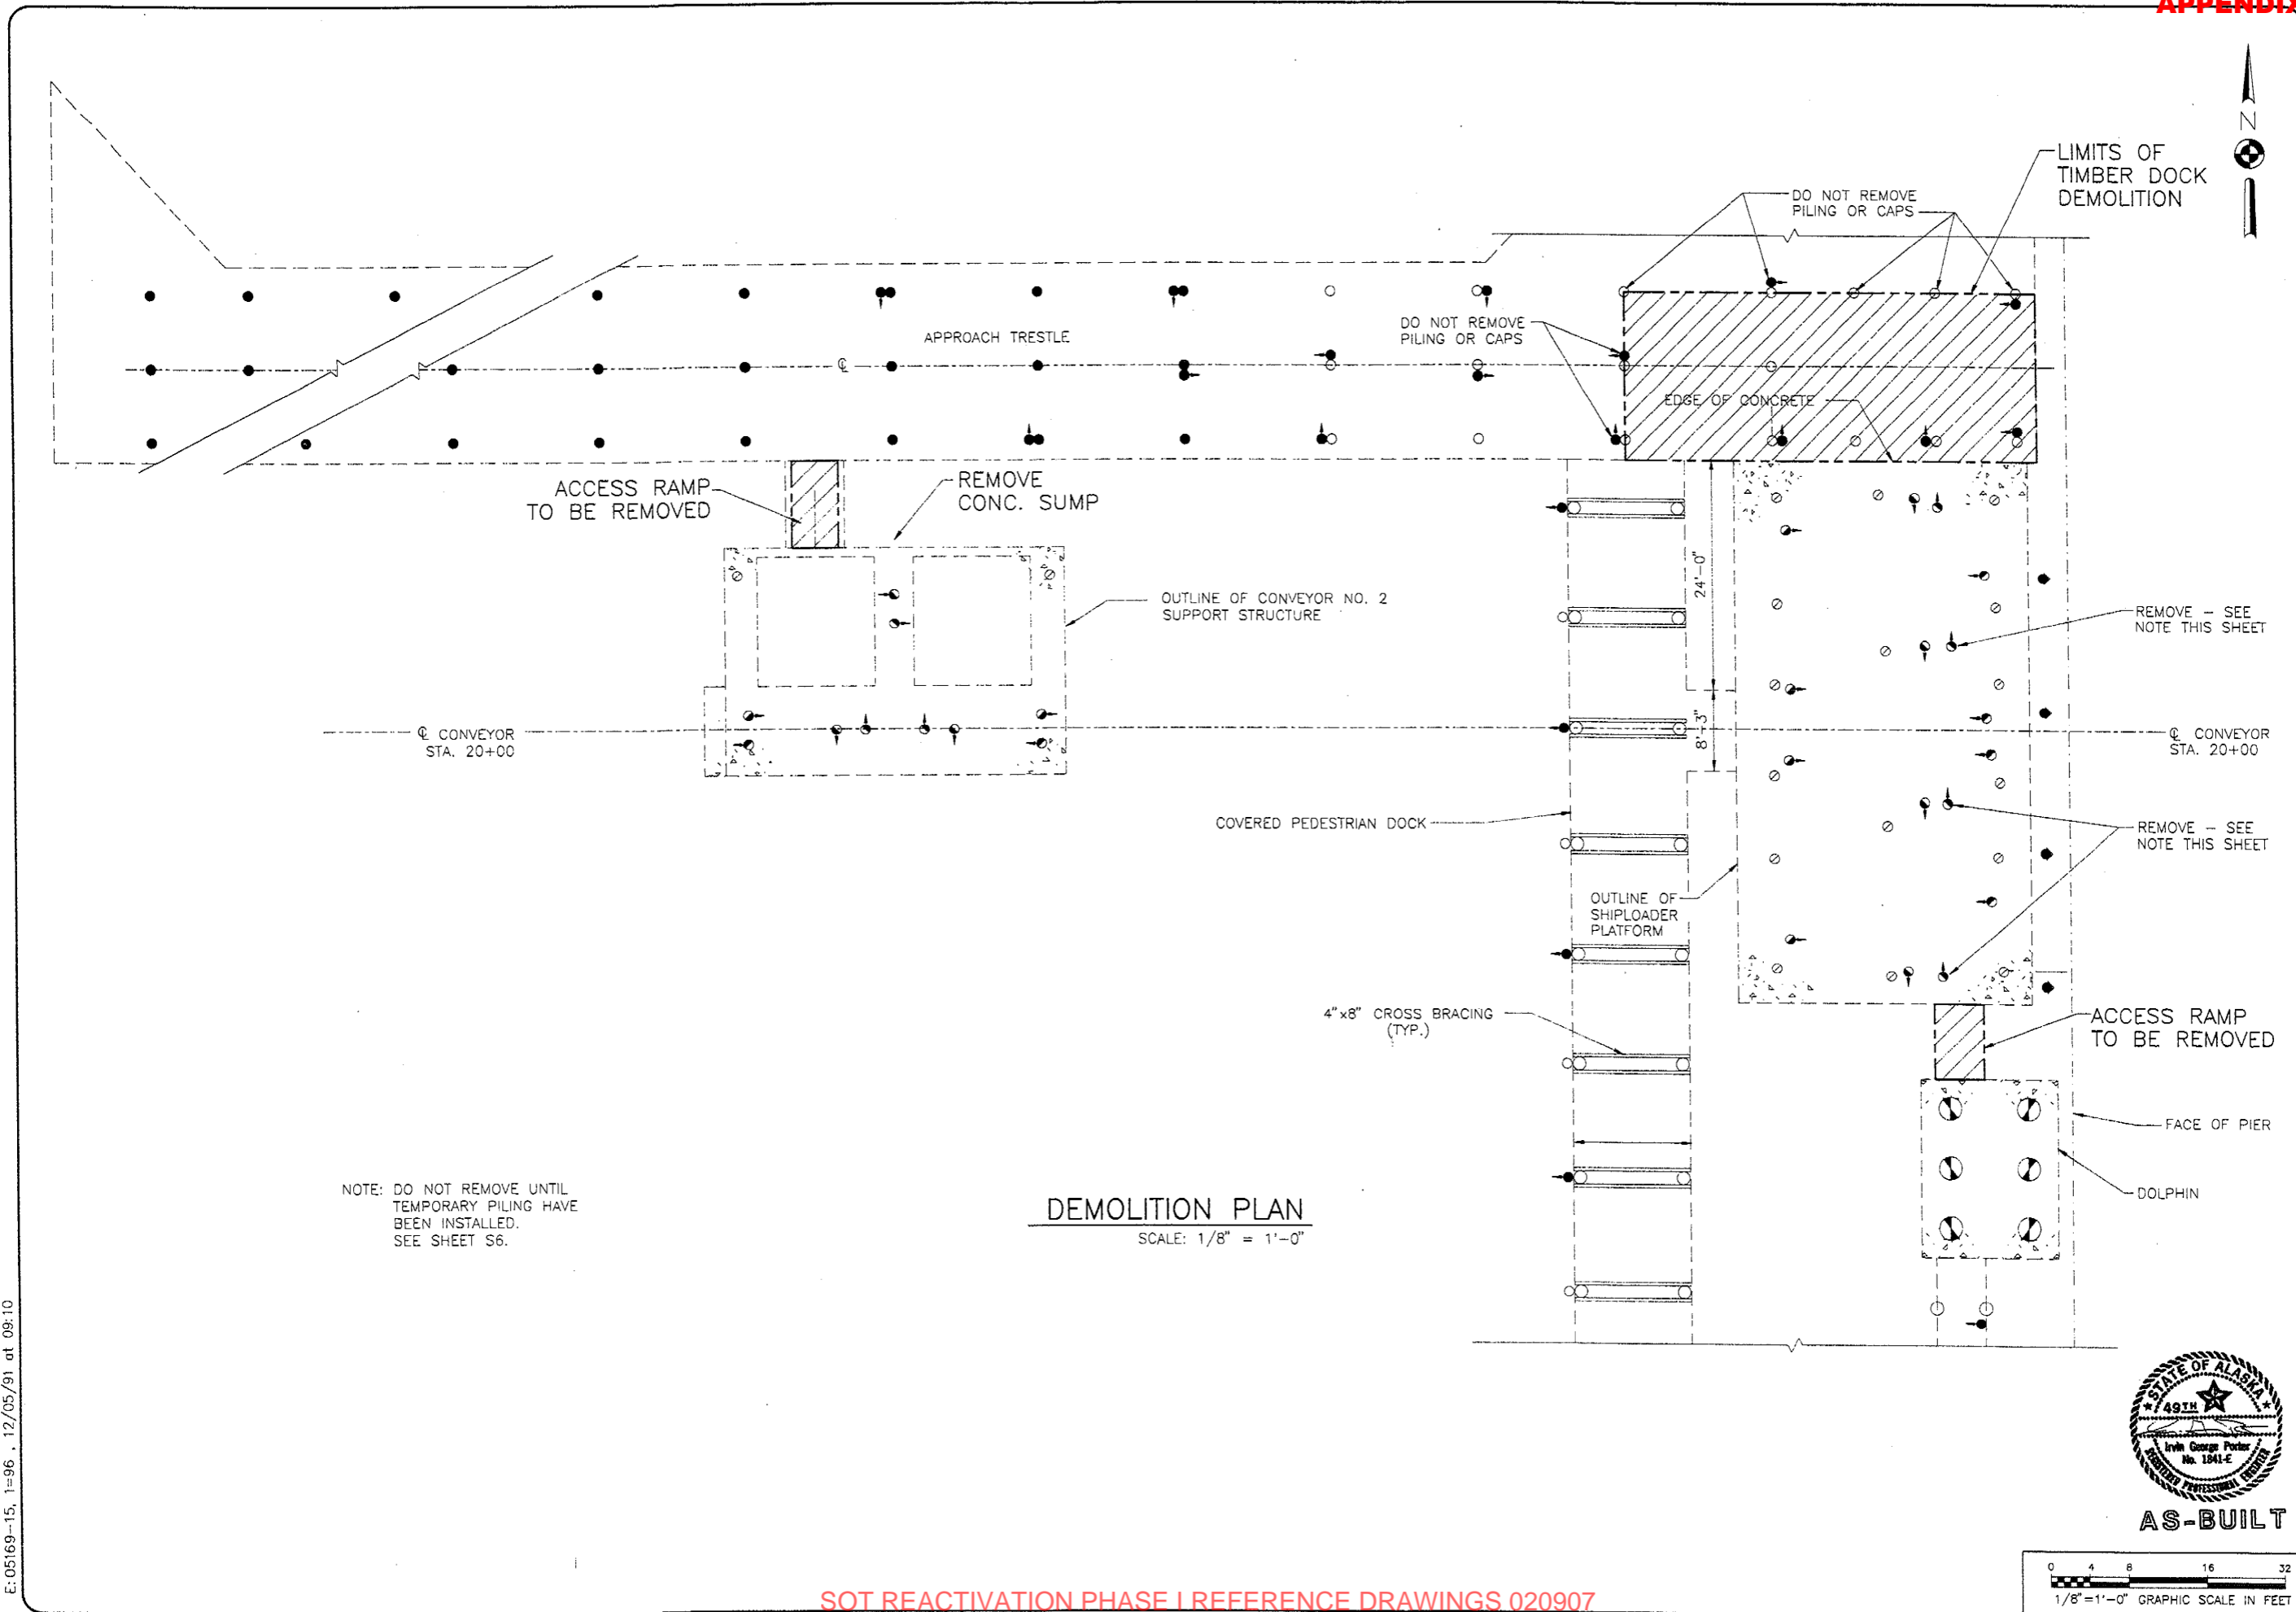


**AS-BUILT**

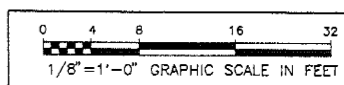

E: 05169-15, 1=96 . 12/05/91 at 09:10

DESIGN GCF  
DRAWN MKA  
CHECK DHA  
APPROVED GCF

**R&M ENGINEERING, INC.**  
6205 GLACIER HIGHWAY  
P.O. BOX 34278  
JUNEAU, ALASKA 99803  
PH: (907) 780-6080

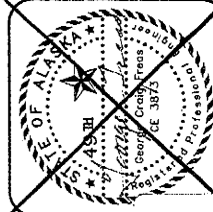

ALASKA INDUSTRIAL DEVELOPMENT & EXPORT AUTHORITY  
SKAGWAY ORE TERMINAL STRUCTURAL REPAIRS  
SKAGWAY, ALASKA

ALASKA INDUSTRIAL DEVELOPMENT & EXPORT AUTHORITY  
SKAGWAY ORE TERMINAL STRUCTURAL REPAIRS  
SKAGWAY, ALASKA


DATE: DEC. 6, 1991  
R&M NO. 901362.03  
SCALE: AS NOTED

**S5**  
SHEET 5 OF 18

205'-0"

12 SPACES @ 15'-0" = 180'-0"

3 SPACES @ 8'-4" = 25'-0"

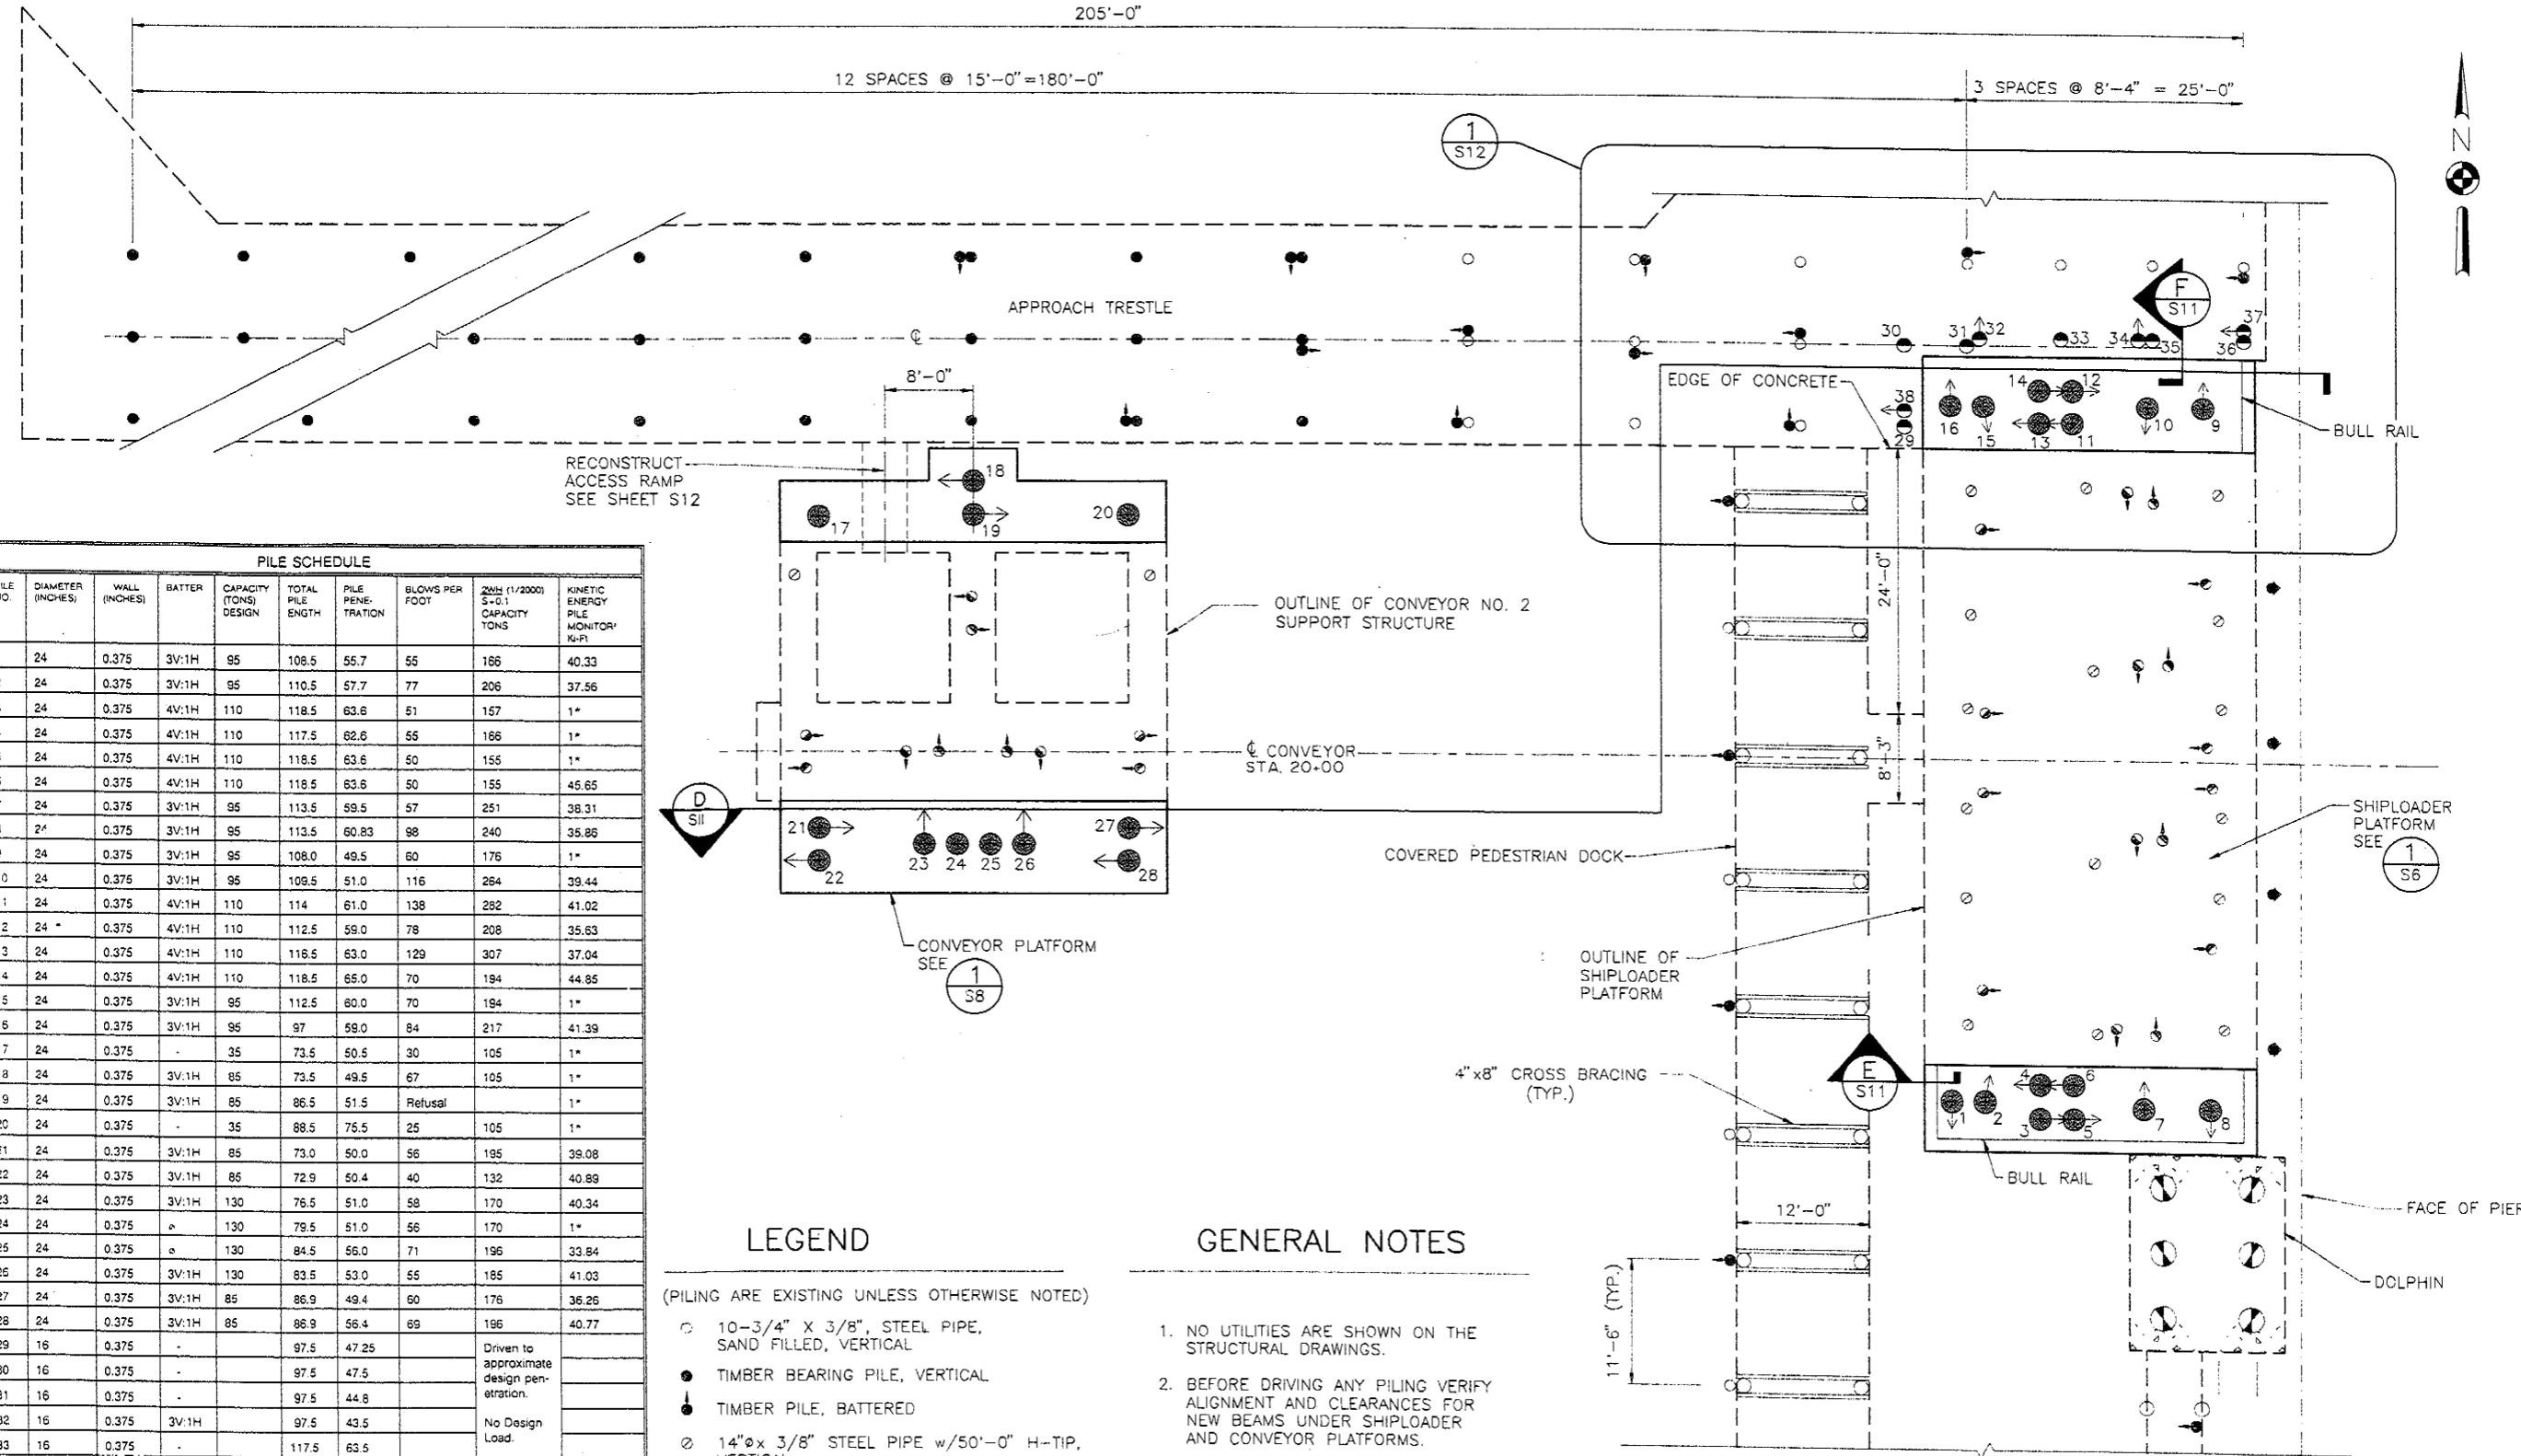


PILE SCHEDULE									
PILE NO.	DIAMETER (INCHES)	WALL (INCHES)	BATTER	CAPACITY (TONS) DESIGN	TOTAL PILE LENGTH	PILE PENETRATION	BLOWS PER FOOT	2000 (1/2000) S-V-1 CAPACITY TONS	KINETIC ENERGY PILE MONITOR KI-FI
1	24	0.375	3V:1H	95	108.5	55.7	55	186	40.33
2	24	0.375	3V:1H	95	110.5	57.7	77	206	37.56
3	24	0.375	4V:1H	110	118.5	63.6	51	157	1*
4	24	0.375	4V:1H	110	117.5	62.6	55	186	1*
5	24	0.375	4V:1H	110	118.5	63.6	50	155	1*
6	24	0.375	4V:1H	110	118.5	63.6	50	155	46.65
7	24	0.375	3V:1H	95	113.5	59.5	57	251	38.31
8	24	0.375	3V:1H	95	113.5	60.83	98	240	35.86
9	24	0.375	3V:1H	95	108.0	49.5	60	176	1*
10	24	0.375	3V:1H	95	109.5	51.0	116	264	39.44
11	24	0.375	4V:1H	110	114	61.0	138	282	41.02
12	24	0.375	4V:1H	110	112.5	59.0	78	208	35.63
13	24	0.375	4V:1H	110	116.5	63.0	129	307	37.04
14	24	0.375	4V:1H	110	118.5	65.0	70	194	44.85
15	24	0.375	3V:1H	95	112.5	60.0	70	194	1*
16	24	0.375	3V:1H	95	97	59.0	84	217	41.39
17	24	0.375	-	35	73.5	50.5	30	105	1*
18	24	0.375	3V:1H	85	73.5	49.5	67	105	1*
19	24	0.375	3V:1H	85	86.5	51.5	Refusal		1*
20	24	0.375	-	35	88.5	75.5	25	105	1*
21	24	0.375	3V:1H	85	73.0	50.0	56	195	39.08
22	24	0.375	3V:1H	85	72.9	50.4	40	132	40.89
23	24	0.375	3V:1H	130	76.5	51.0	58	170	40.34
24	24	0.375	e	130	79.5	51.0	56	170	1*
25	24	0.375	e	130	84.5	56.0	71	196	33.84
26	24	0.375	3V:1H	130	83.5	53.0	55	185	41.03
27	24	0.375	3V:1H	85	86.9	49.4	60	176	36.26
28	24	0.375	3V:1H	85	86.9	56.4	69	196	40.77
29	16	0.375	-		97.5	47.25		Driven to approximate design penetration.	
30	16	0.375	-		97.5	47.5		No Design Load.	
31	16	0.375	-		97.5	44.8			
32	16	0.375	3V:1H		97.5	43.5			
33	16	0.375	-		117.5	63.5			
34	16	0.375	3V:1H		92.5	34.0			
35	16	0.375	-		107.5	49.0			
36	16	0.375	-		117.5	59.0			
37	16	0.375	3V:1H		112.5	54.0			
38	16	0.375	3V:1H		87.5	37.5			


- LEGEND**
- 10-3/4" X 3/8", STEEL PIPE, SAND FILLED, VERTICAL
  - TIMBER BEARING PILE, VERTICAL
  - ⤴ TIMBER PILE, BATTERED
  - ⊗ 14"Ø x 3/8" STEEL PIPE w/50'-0" H-TIP, VERTICAL
  - ⤴ 14"Ø x 3/8" STEEL PIPE w/50'-0" H-TIP, BATTERED
  - TIMBER FENDER
  - ⊗ 28"Ø STL. PIPE PILES
  - NEW 24"Ø STL. PIPE PILES
  - 12 PILE NUMBER
  - NEW 16"Ø X 3/8" STEEL PIPE PILES, FILL VERT. PILING W/SAND

- GENERAL NOTES**
1. NO UTILITIES ARE SHOWN ON THE STRUCTURAL DRAWINGS.
  2. BEFORE DRIVING ANY PILING VERIFY ALIGNMENT AND CLEARANCES FOR NEW BEAMS UNDER SHIPLOADER AND CONVEYOR PLATFORMS.
  3. BATTER PILES MAY BE ROTATED UP TO 10 DEGREES IN EITHER DIRECTION FROM PLAN TO CLEAR OBSTRUCTIONS.


**PILE LAYOUT**  
SCALE: 1/8" = 1'-0"

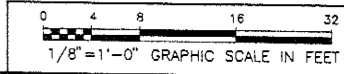


e: 05169-S5, 1=96, 12/06/91 at 10:43

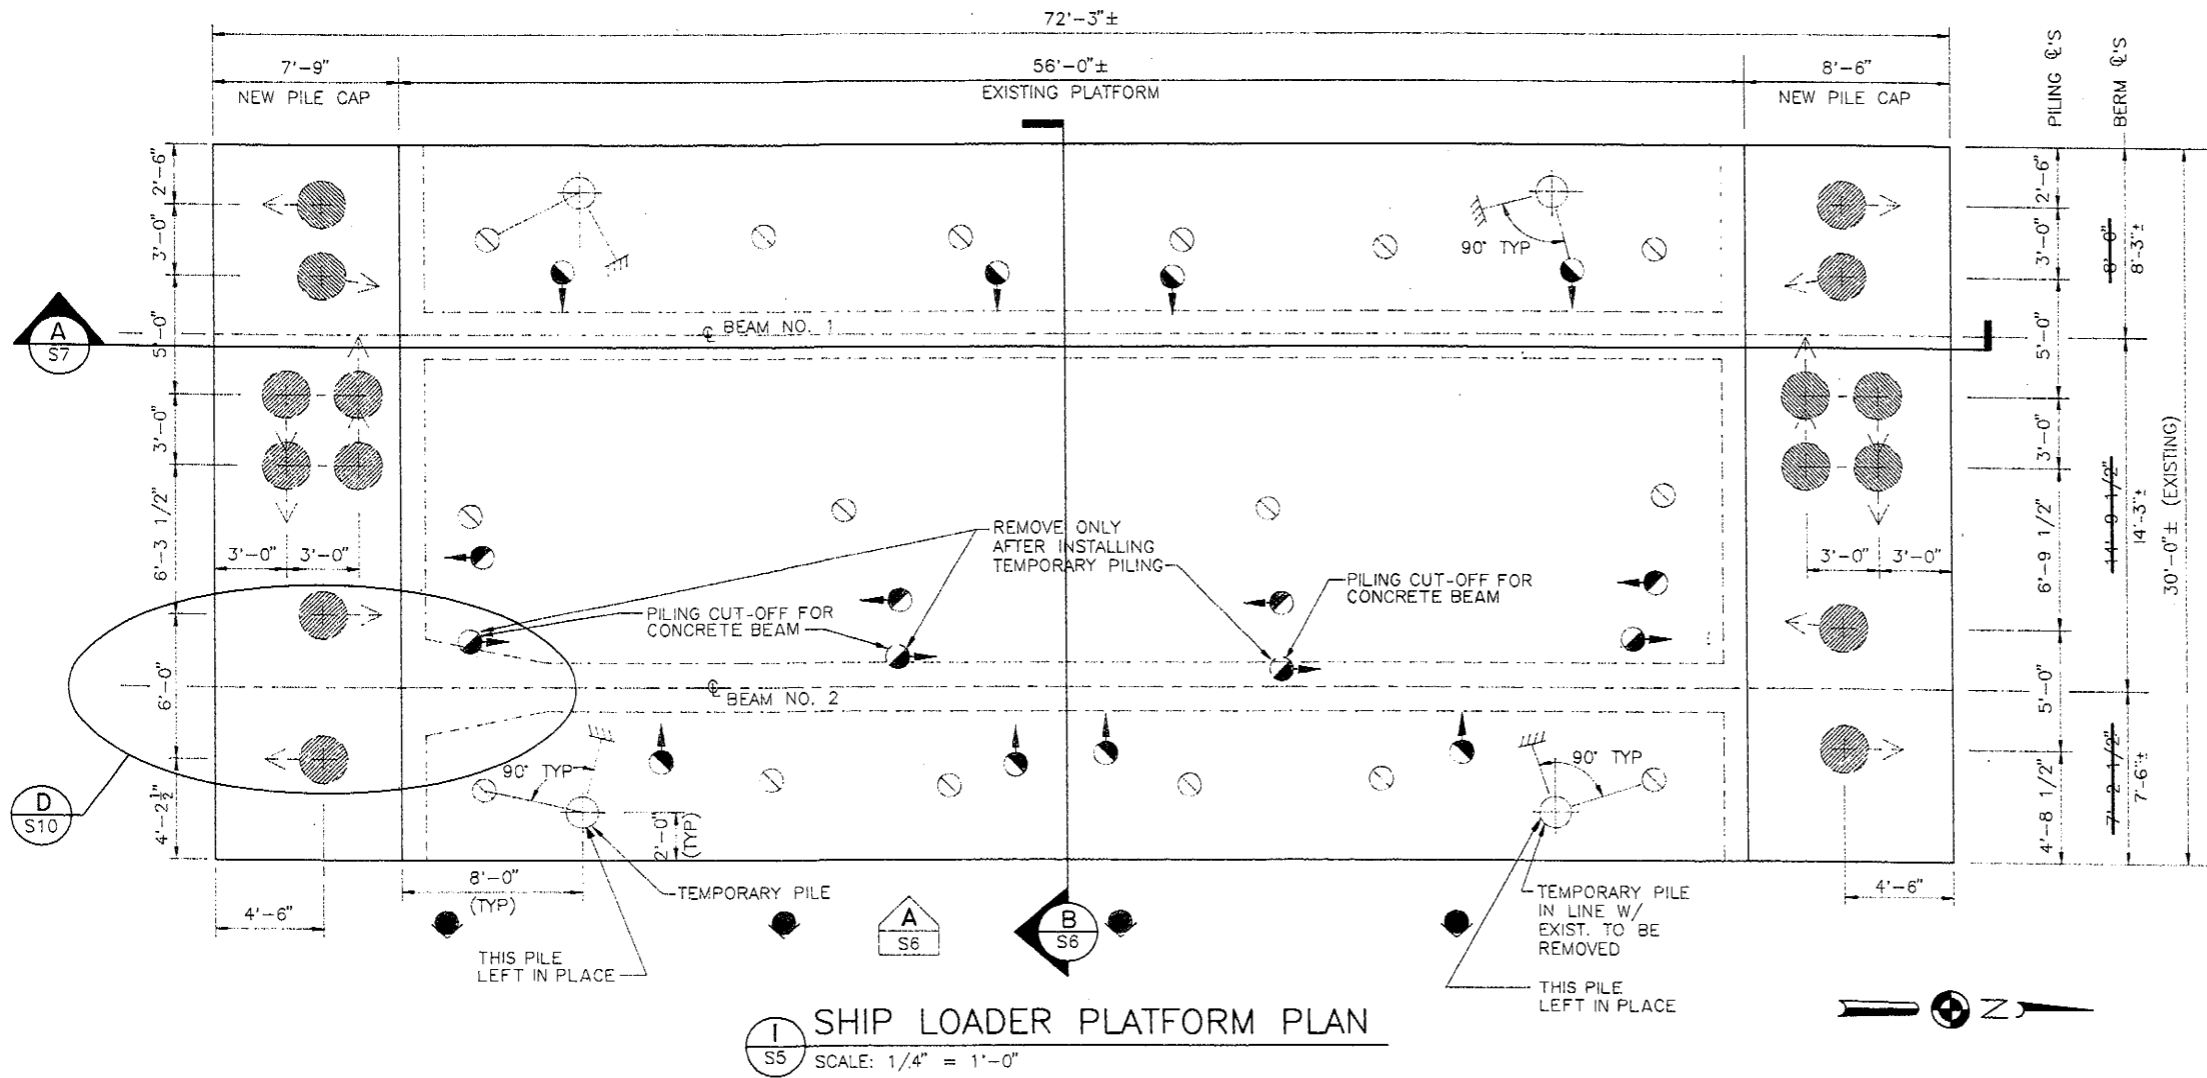

**S5** SHIP LOADER PLATFORM PLAN  
SCALE: 1/4" = 1'-0"

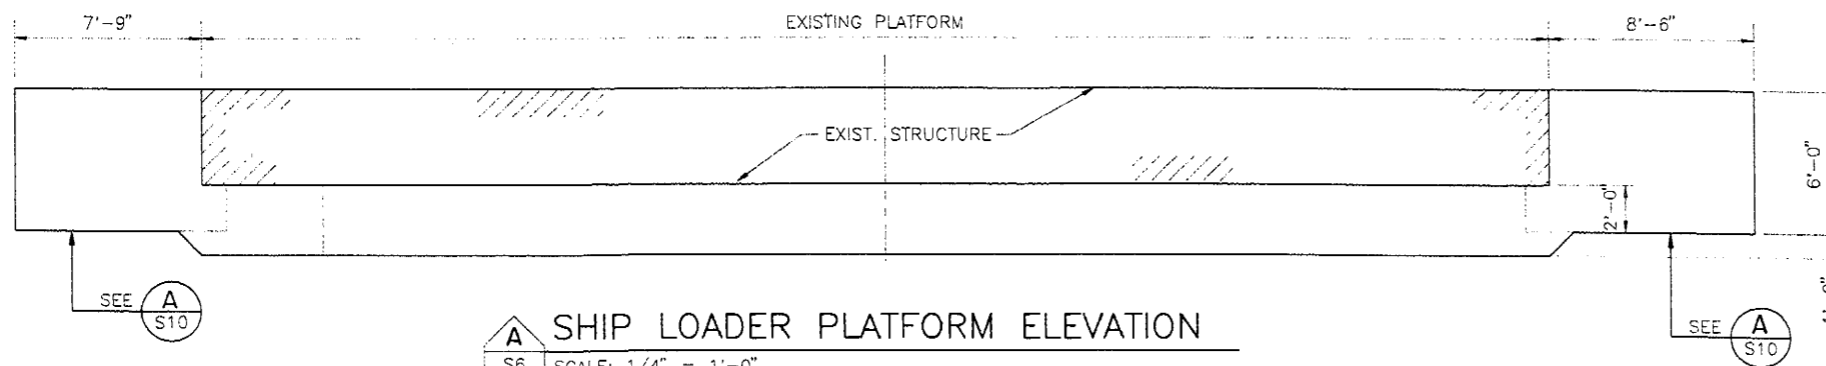

**S6** SHIP LOADER PLATFORM ELEVATION  
SCALE: 1/4" = 1'-0"

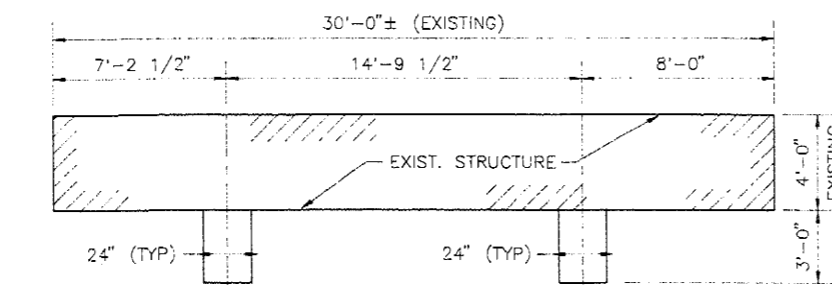


**S6** SHIP LOADER PLATFORM SECTION  
SCALE: 1/4" = 1'-0"

- NOTES**
- BATTER NORTH-SOUTH PILING 3V:1H, AND EAST-WEST PILING 4V:1H.
  - BULL RAIL ON NEW CAPS NOT SHOWN.
  - LOADER TOWER AND OTHER FEATURES ON EXIST. PLATFORM NOT SHOWN.
  - TEMPORARY PILING:
    - TEMPORARY PILING ARE TO BE INSTALLED ONLY IF IT IS NECESSARY TO REMOVE EXISTING PILING IN ORDER TO CONSTRUCT NEW BEAMS UNDER THE SHIPLOADER PLATFORM.
    - FOR EACH PILE REMOVED PROVIDE ONE 18" DIAMETER X 0.375" WALL TEMPORARY PILE.
    - DRIVE TEMPORARY PILES TO A 30 TON WORKING CAPACITY, BUT NO LESS THAN 50 FT. PENETRATION.
    - CUT OFF TEMPORARY PILING AT AN ELEVATION SUFFICIENT TO ALLOW INSTALLATION OF 30 TON JACKS.
    - BRACE THE TOP OF TEMPORARY PILING AGAINST ADJACENT PILING OR THE UNDERSIDE OF THE LOADER PLATFORM WITH A MINIMUM OF TWO BRACES POSITIONED AT APPROXIMATELY 90° TO ONE ANOTHER. THE CONTRACTOR SHALL BE RESPONSIBLE FOR DESIGNING THE BRACES AND PROVIDING AN INSTALLATION PLAN TO THE ENGINEER.
    - WELD A MINIMUM 1" THICK PLATE TO THE TOP OF THE TEMPORARY PILING AND PLACE A BEARING PLATE BETWEEN THE 30 TON JACKS AND THE LOADER PLATFORM. THE BEARING PLATE SHALL BE 1" THICK AND HAVE A BEARING AREA OF NOT LESS THAN 1" SQUARE FOOT.
    - LOAD AND MAINTAIN EACH OF THE JACKS AT 20 TONS. LOAD THE JACKS SEQUENTIALLY IN 4 TON INCREMENTS.
    - THE CONTRACTOR MAY INSTALL ADDITIONAL TEMPORARY PILING.
    - REMOVE TEMPORARY PILING AND BRACING FOLLOWING POST-TENSIONING OF BEAMS NOL. 1 AND NO. 2.
    - TEMPORARY PILING NEED NOT BE GALVANIZED.
  - DO NOT REMOVE FORMS OR SHORING FOR BEAMS NO. 1 AND NO. 2 UNTIL CONCRETE REACHES SUFFICIENT STRENGTH TO TRANSFER WEIGHT OF BEAMS TO #7 DOWELS IN VENT HOLES.

DESIGN	GCF
DRAWN	NRY
CHECK	DHA
APPROVED	GCF

**R&M ENGINEERING, INC.**  
 8205 GLACIER HIGHWAY  
 P.O. BOX 34278  
 JUNEAU, ALASKA 99803  
 PH: (907) 780-6060

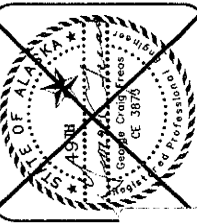

SOT03-1991-AB-S6, Loader Platform - Plan & Sections

ALASKA INDUSTRIAL DEVELOPMENT & EXPORT AUTHORITY  
 SKAGWAY ORE TERMINAL STRUCTURAL REPAIRS  
 SKAGWAY, ALASKA


**LOADER PLATFORM  
 PLAN & SECTIONS**



**AS-BUILT**


DATE: DEC. 6, 1991  
 R&M NO. 901362.03  
 SCALE: AS NOTED

**S6**  
 6 of 18

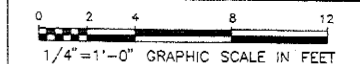


E: 05189-S6, 1=48, 12/06/91 at 14:35


12/16/2013

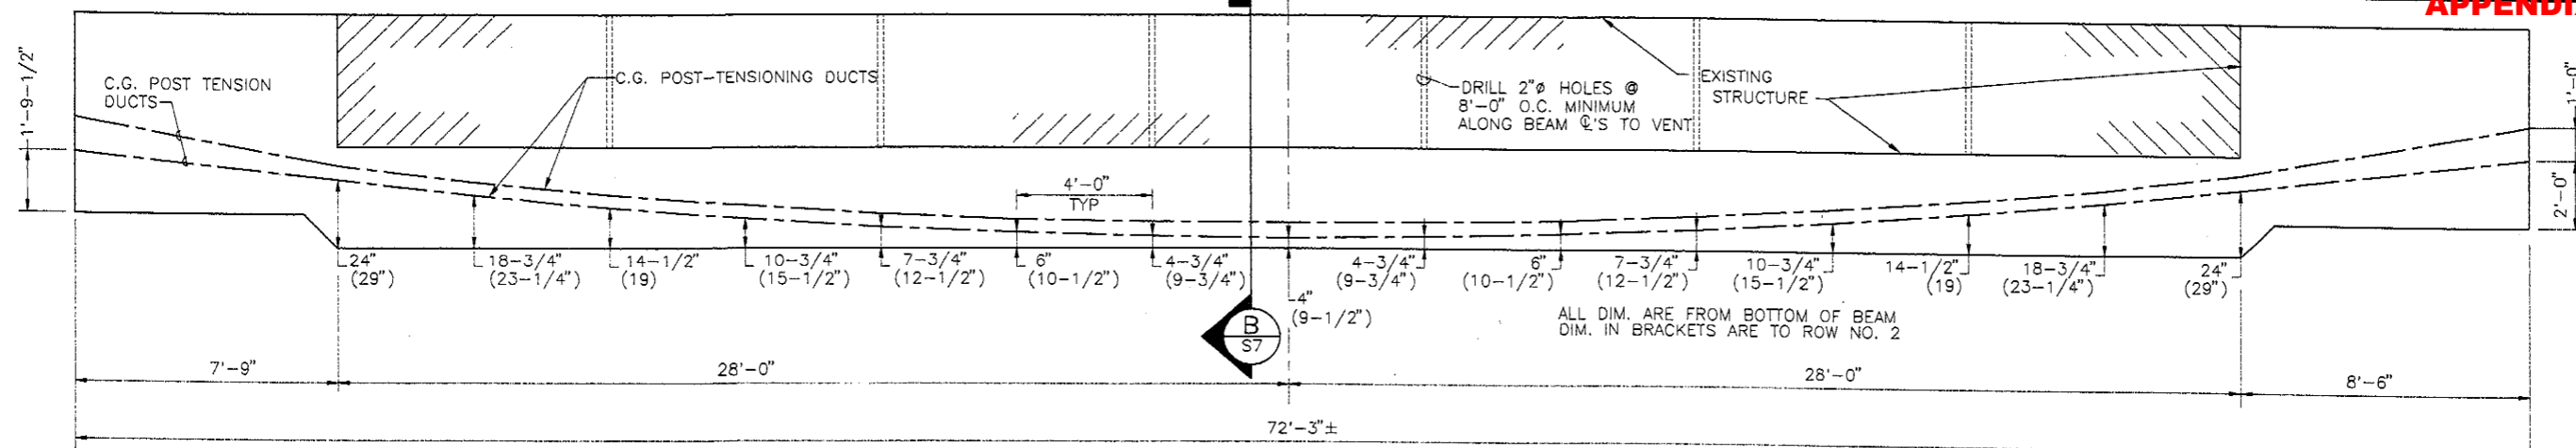


**A SHIP LOADER PLATFORM POST-TENSIONING PROFILES**  
 SCALE: 3/8" = 1'-0" (BEAM NO. 1, BEAM NO. 2 SIMILAR)

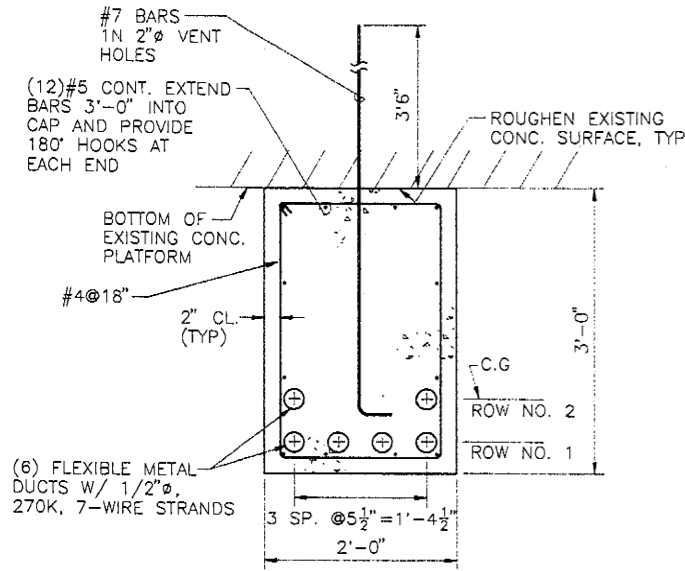


**B BEAM SECTION**  
 SCALE: 1" = 1'-0"

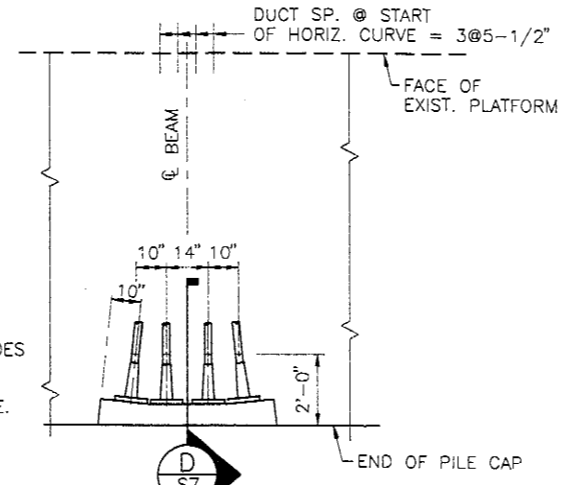


**C RECESS FOR POST-TEN. ANCHORAGES - PLAN**  
 SCALE: 3/8" = 1'-0"  
 3 REQUIRED NORTH & SOUTH ENDS BEAM NO. 1 NORTH END BEAM NO. 2

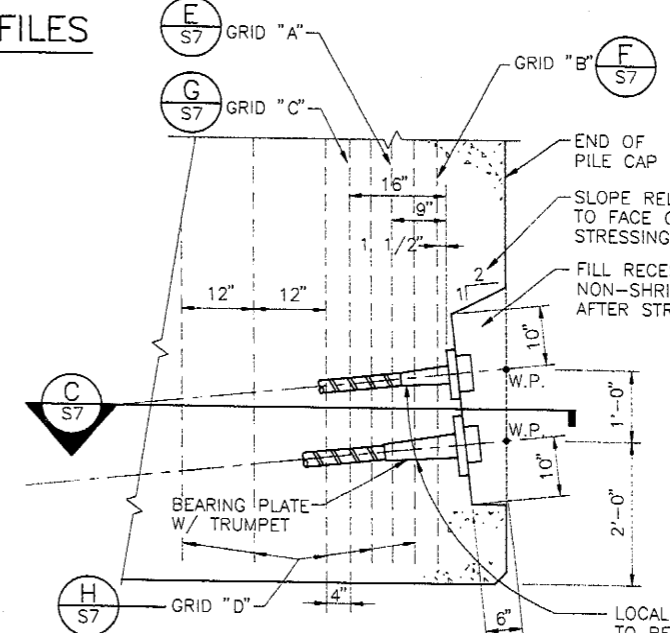


**D RECESS FOR STRESSING ANCHORAGE - NORTH END'S**  
 SCALE: 3/4" = 1'-0" (SOUTH END BEAM NO. 1 SIMILAR)

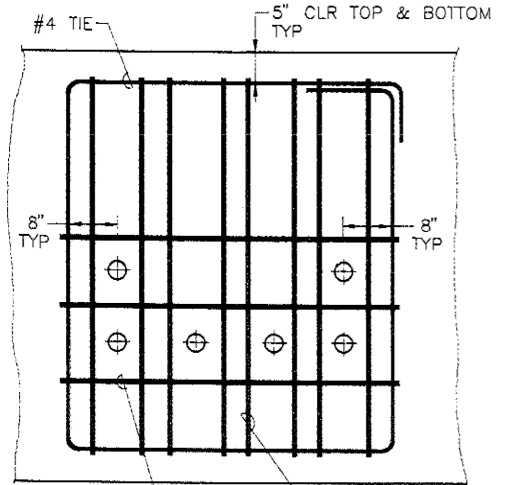


**E GRID "A"**  
 SCALE: 3/4" = 1'-0"

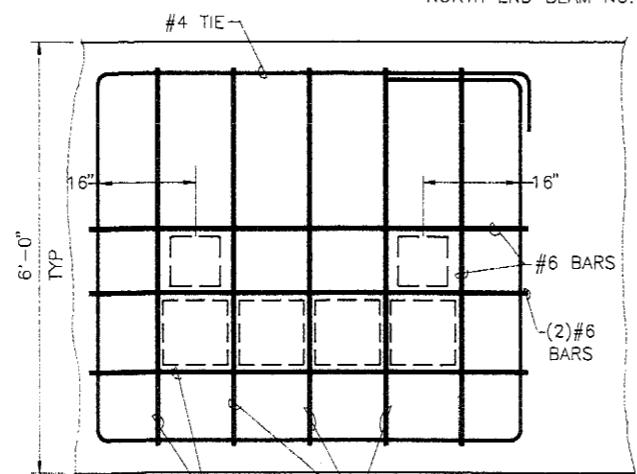

**F GRID "B"**  
 SCALE: 3/4" = 1'-0"


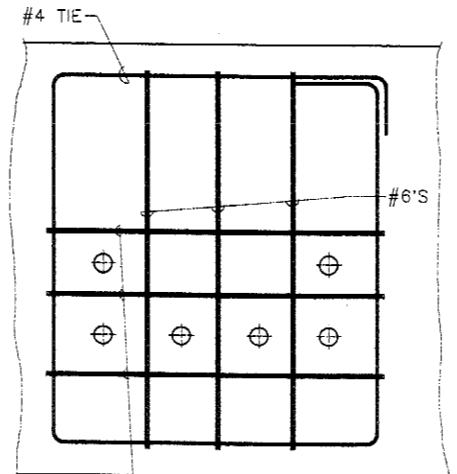


**G GRID "C"**  
 SCALE: 3/4" = 1'-0"

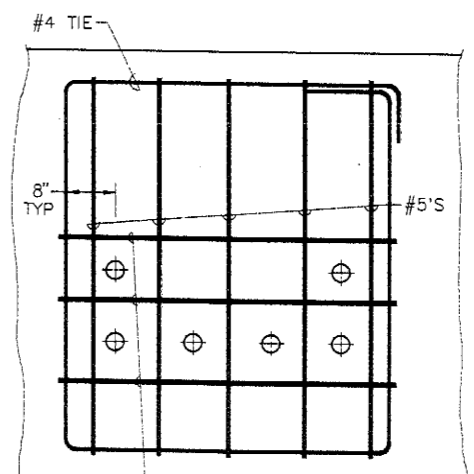


**H GRID "D"**  
 SCALE: 3/4" = 1'-0"

NOTE: PROVIDE 180° HOOKS ON BOTH ENDS OF #5 & #6 BARS IN GRIDS "A" THRU "D".

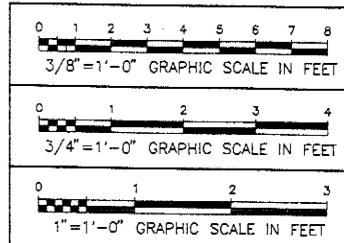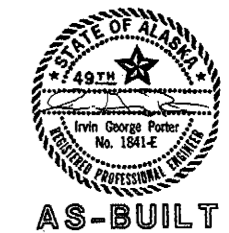

DESIGN	GCF
DRAWN	NBY
CHECK	DHA
APPROVED	GCF

**R&M ENGINEERING, INC.**  
 9205 GLACIER HIGHWAY  
 P.O. BOX 34278  
 JUNEAU, ALASKA 99803  
 PH: (907) 780-6080

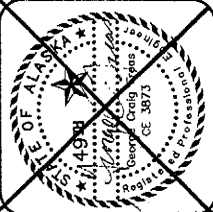

SOT103-1991-AB-S7, Loader Platform - Details

ALASKA INDUSTRIAL DEVELOPMENT & EXPORT AUTHORITY  
 SKAGWAY ORE TERMINAL STRUCTURAL REPAIRS  
 SKAGWAY, ALASKA


**LOADER PLATFORM DETAILS**

DATE: DEC. 6, 1991  
 R&M NO. 901362.03  
 SCALE: AS NOTED


**S7**

12/16/2013  
 SHEET 7 OF 18


E:05169-10, 1=32, 12/06/91 at 11:05

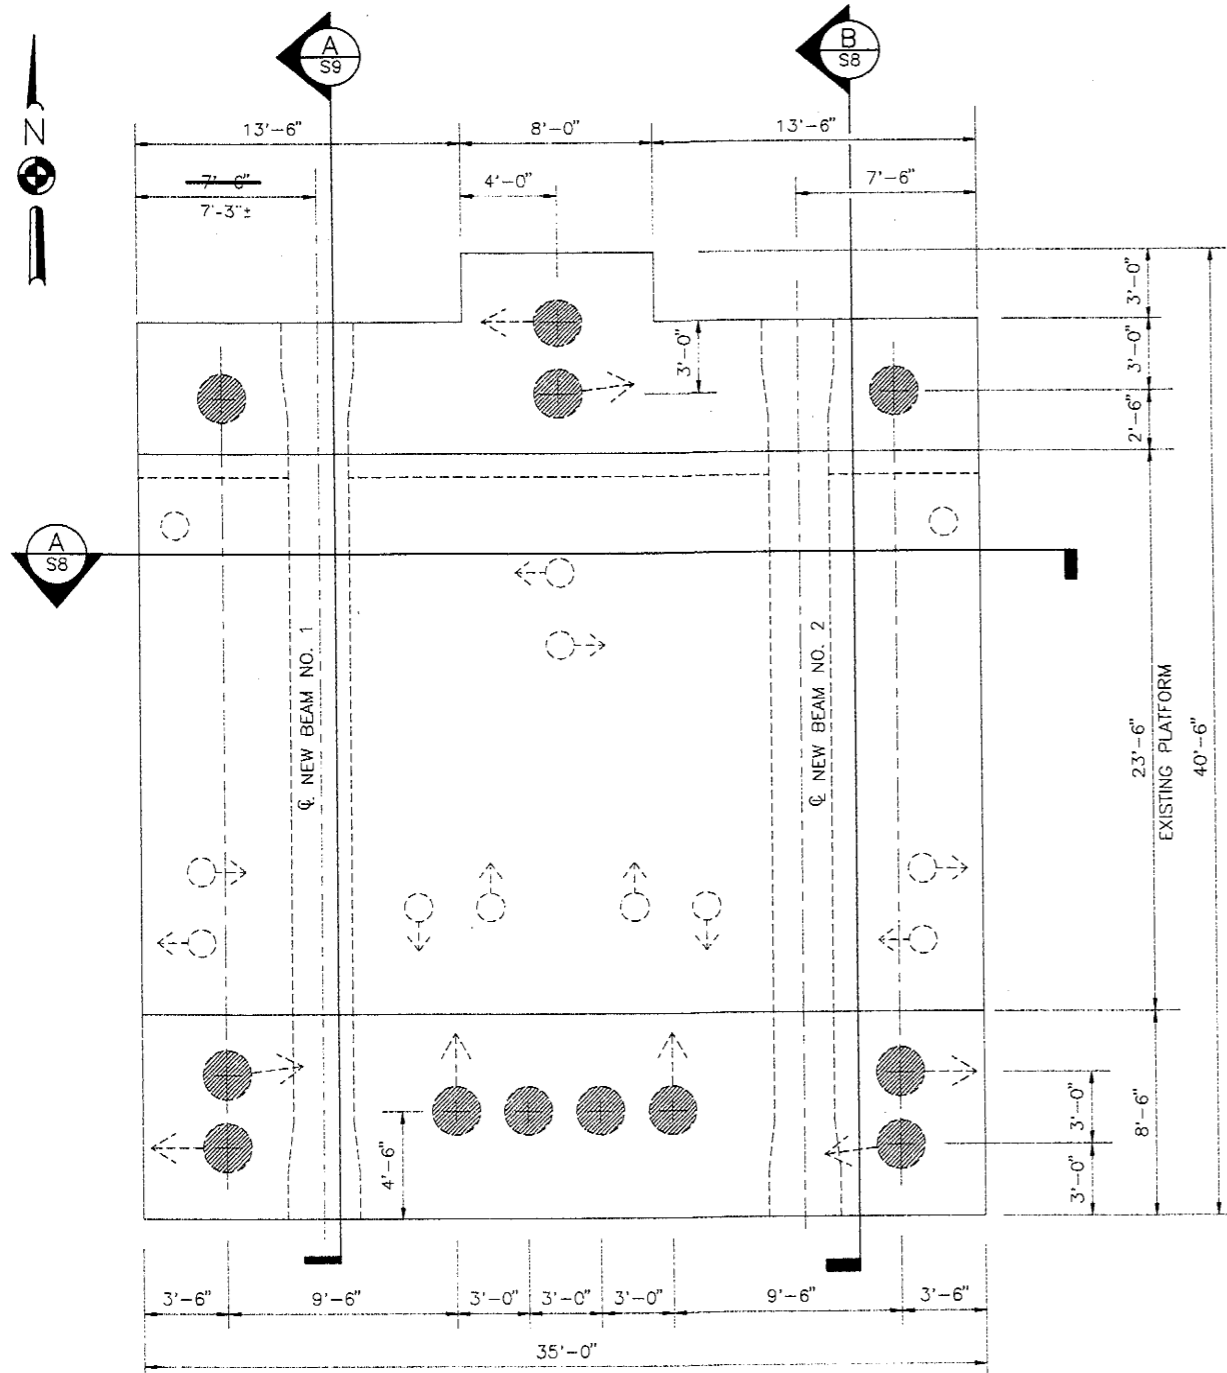


**1** CONVEYOR NO. 2 SUPPORT STRUCTURE  
SCALE: 1/4" = 1'-0"

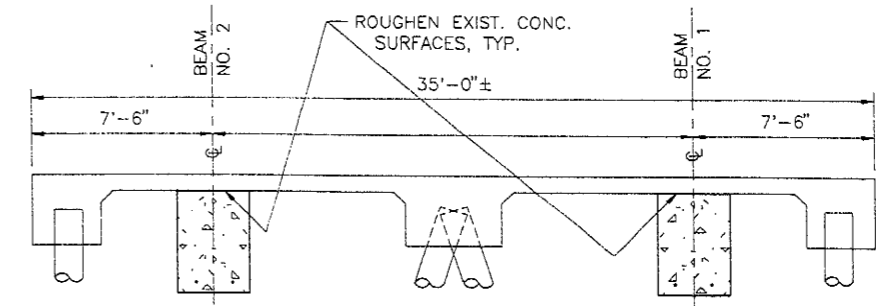

**A** CONVEYOR NO.2 SUPPORT SECTION  
SCALE: 1/4" = 1'-0"

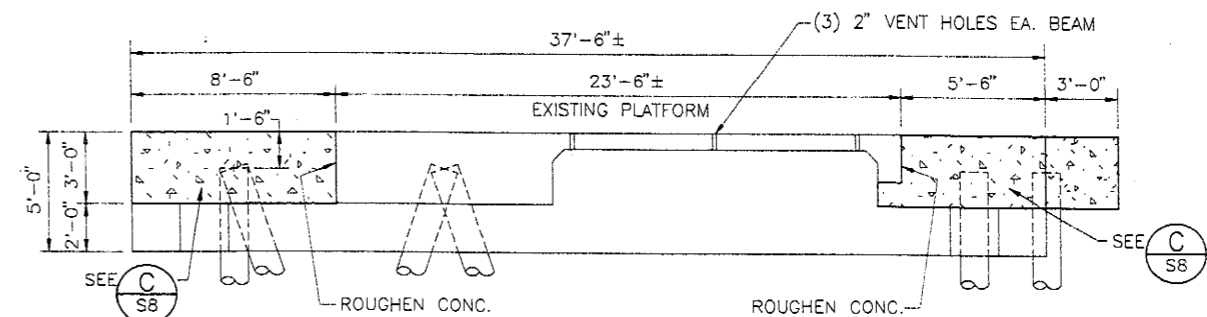


**B** CONVEYOR NO.2 SUPPORT SECTION  
SCALE: 1/4" = 1'-0"

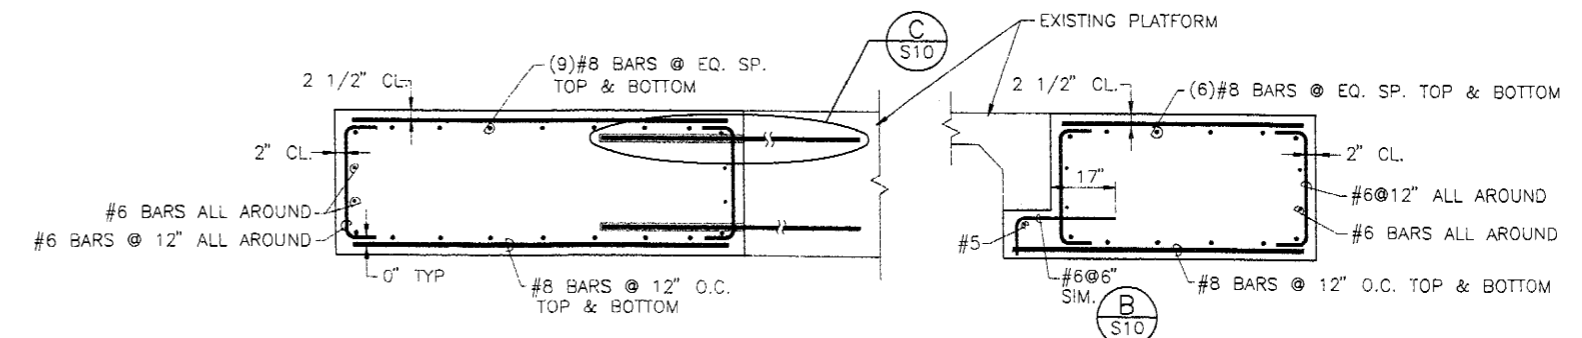

**C** SECTION  
SCALE: 1/2" = 1'-0"




AS-BUILT

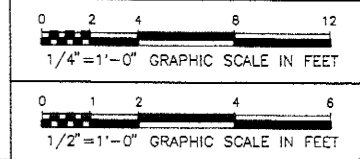

DESIGN GCF  
DRAWN MRY  
CHECK DHA  
APPROVED GCF

**R&M ENGINEERING, INC.**  
6205 GLACIER HIGHWAY  
P.O. BOX 34278  
JUNEAU, ALASKA 99803  
PH. (907) 780-8060

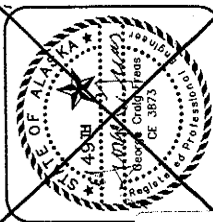


SOT03-1991-AB-S8, Conveyor Platform  
- Plan & Sections

ALASKA INDUSTRIAL DEVELOPMENT & EXPORT AUTHORITY  
SKAGWAY ORE TERMINAL STRUCTURAL REPAIRS  
SKAGWAY, ALASKA  
**CONVEYOR PLATFORM  
PLAN & SECTIONS**


DATE: DEC. 6, 1991  
R&M NO. 901362.03  
SCALE: 1/4"=1'-0"

**S8**  
12/16/2013  
8 OF 18


E: 05169-S7, 1=48, 12/05/91 at 08:13

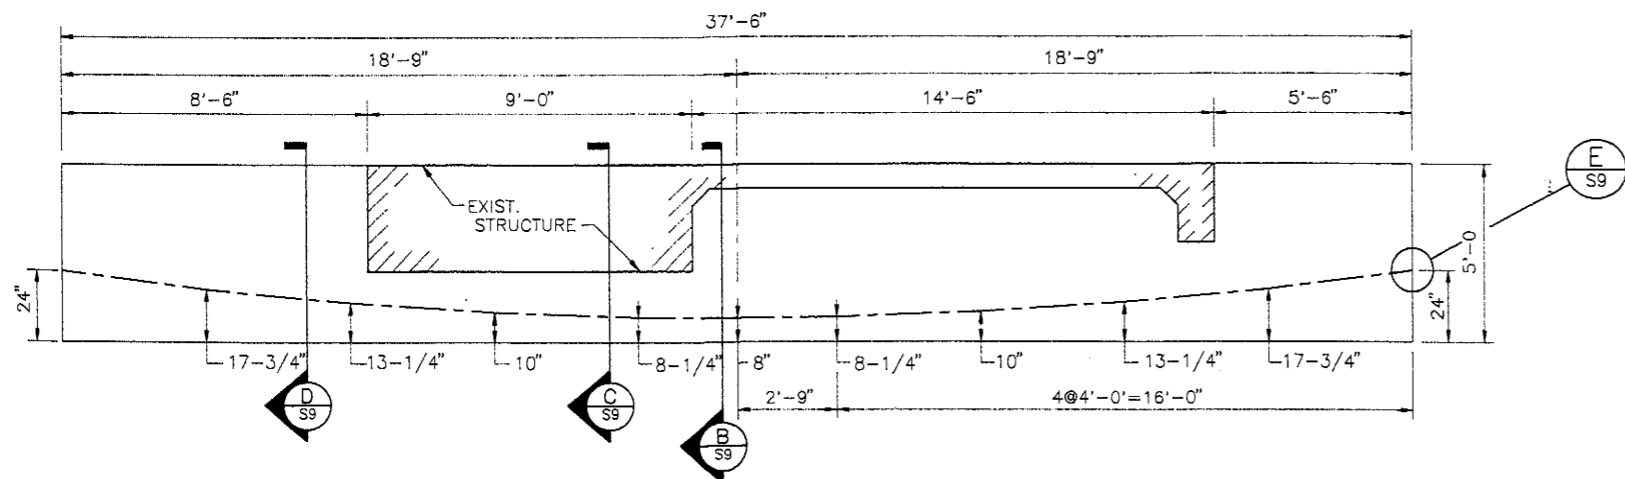


**A** CONVEYOR NO. 2 SUPPORT POST-TENSIONING PROFILE  
SCALE: 3/8"=1'-0"

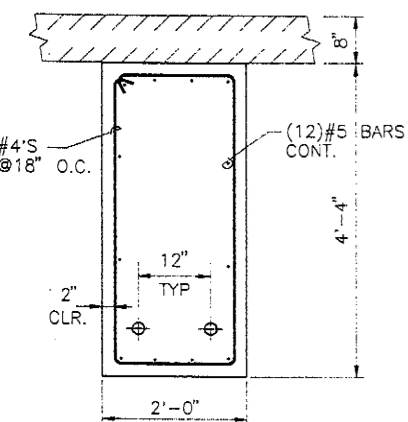


**B** SECTION  
SCALE: 3/4"=1'-0"

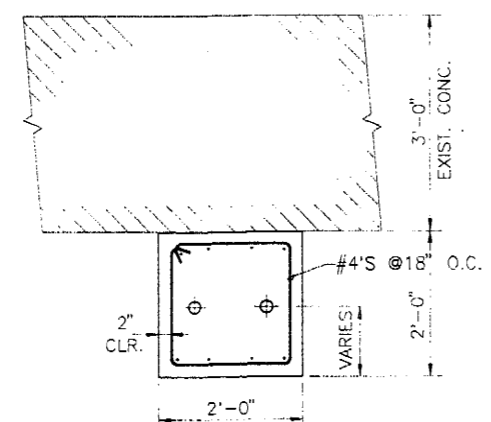

**C** SECTION  
SCALE: 3/4"=1'-0"

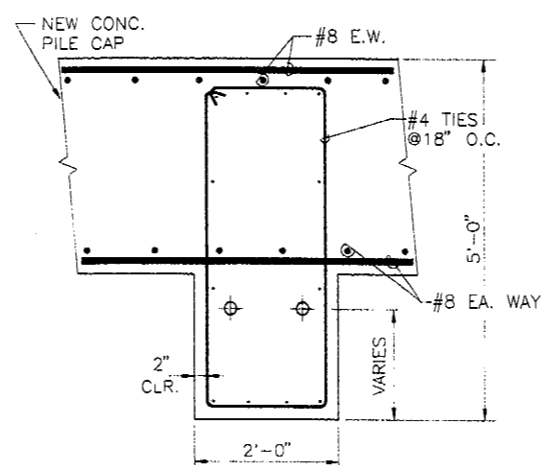


**D** SECTION  
SCALE: 3/4"=1'-0"

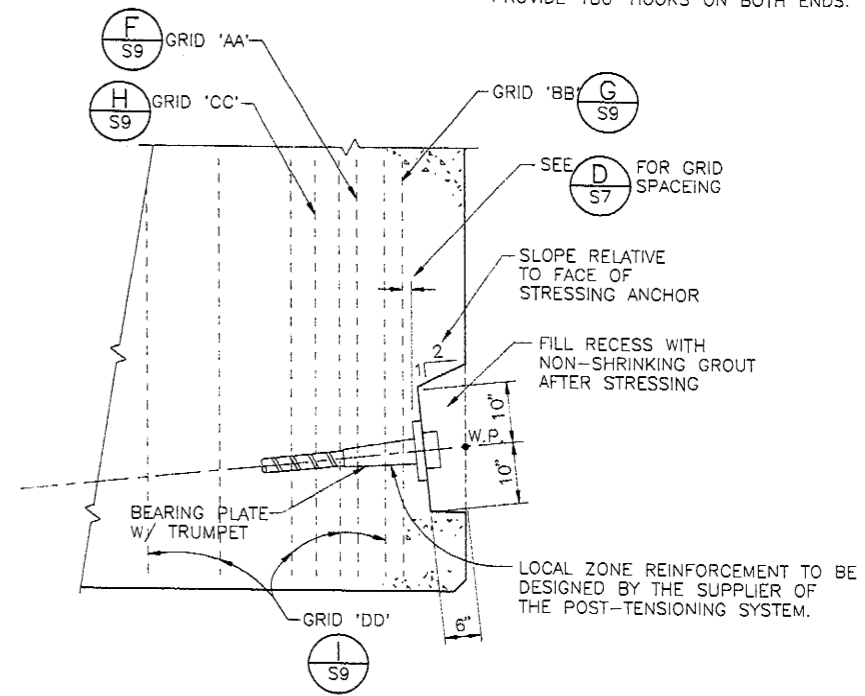


**E** RECESS FOR STRESSING ANCHORAGE - TYP  
SCALE: 3/4"=1'-0"


NOTE: FLAIR SIDES OF RECESS 1:3 RELATIVE TO FACE OF STRESSING ANCHOR. PROVIDE 2 EXTRA #6 BARS (NOT SHOWN) ON FOUR SIDES OF ANCHOR RECESS. WHERE SPACE ALLOWS, EXTEND BARS 12" BEYOND EDGE OF RECESS AND PROVIDE 180° HOOKS ON BOTH ENDS.

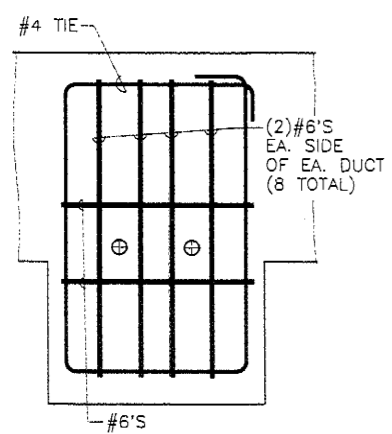


**F** GRID "AA"  
SCALE: 3/4"=1'-0"

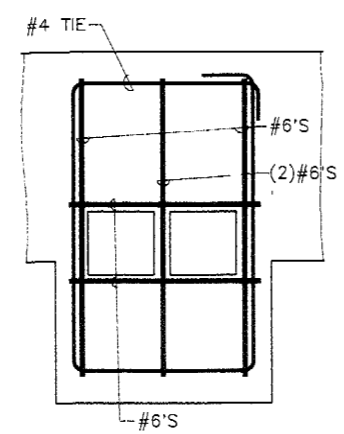

**G** GRID "BB"  
SCALE: 3/4"=1'-0"

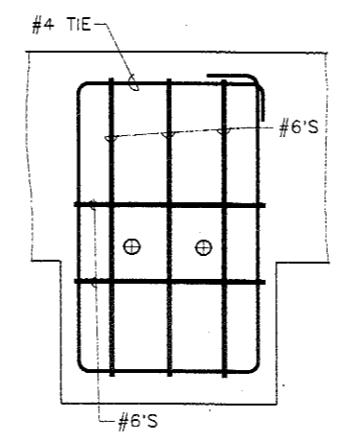

**H** GRID "CC"  
SCALE: 3/4"=1'-0"


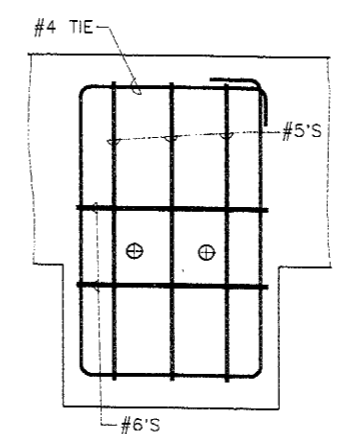


**I** GRID "DD"  
SCALE: 3/4"=1'-0"

NOTE: PROVIDE 180° HOOKS ON BOTH ENDS OF #5 & #6 BARS IN GRIDS "AA" THRU "DD".



AS-BUILT

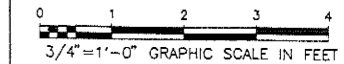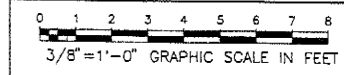

DESIGN	WAR
DRAWN	MAS
CHECK	DHA
APPROVED	GCF

**R&M ENGINEERING, INC.**  
6205 GLACIER HIGHWAY  
P.O. BOX 34278  
JUNEAU, ALASKA 99803  
PH: (907) 780-6060




SOT03-1991-AB-S9, Conveyor Platform Details

ALASKA INDUSTRIAL DEVELOPMENT & EXPORT AUTHORITY  
SKAGWAY ORE TERMINAL STRUCTURAL REPAIRS  
SKAGWAY, ALASKA


**CONVEYOR PLATFORM DETAILS**

DATE: DEC. 6, 1991  
R&M NO. 901362.03  
SCALE: AS NOTED


E:05169-09, 1=16, 12/05/91 at 09:16

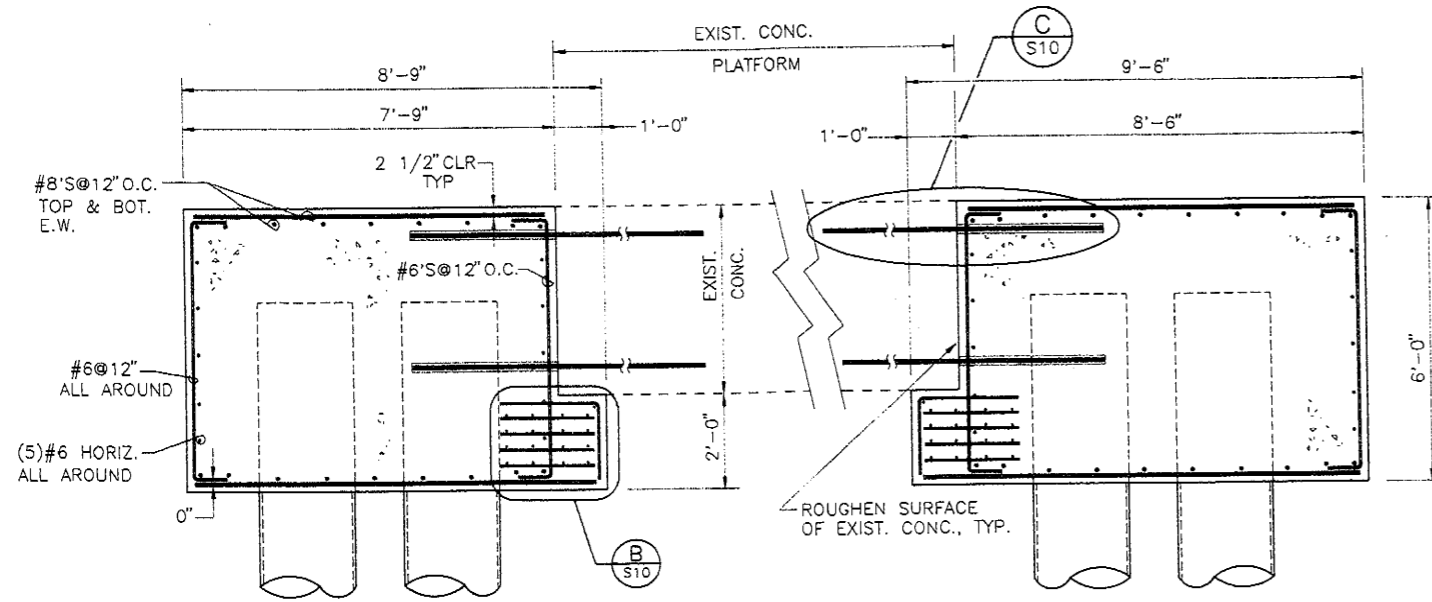


**A** SECTION  
S6 SCALE: 1/2" = 1'-0"

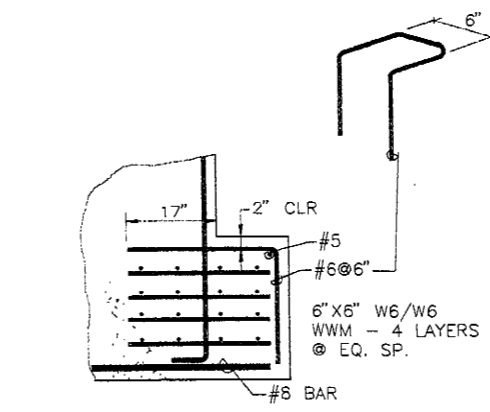


**B** MAIN TEN. REINF.  
S10 SCALE: 3/4" = 1'-0"

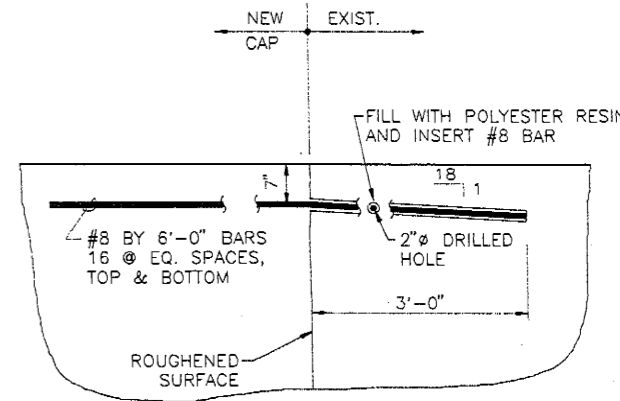




**C** DOWEL DETAIL  
S10 SCALE: 3/4" = 1'-0"

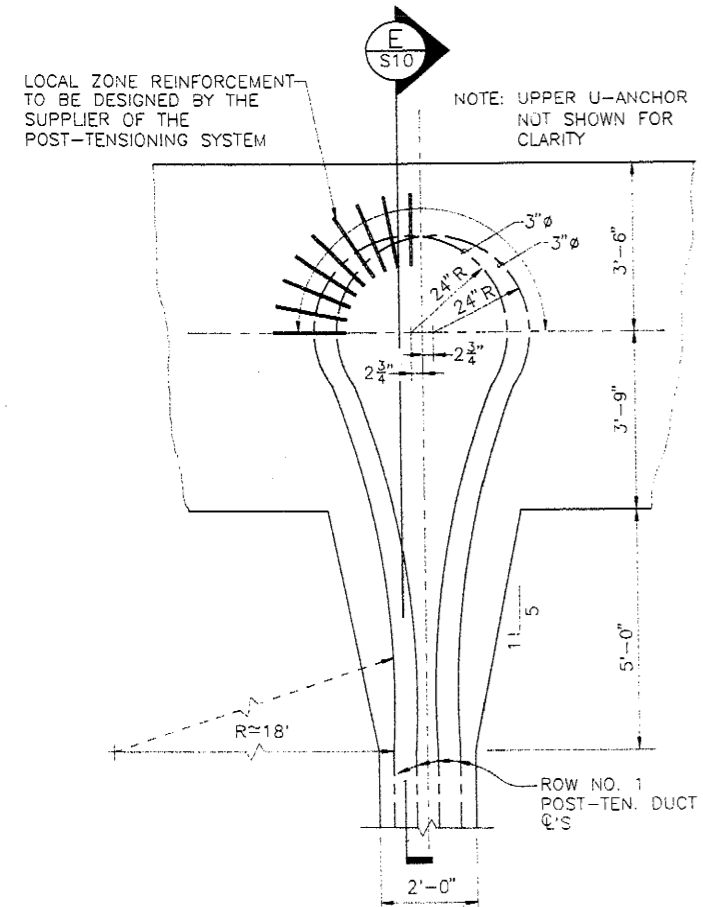

**D** PLAN DEAD-END ANCHOR  
S6 SOUTH END BEAM NO. 2 ONLY SHIPLOADER PLATFORM SCALE: 1/2" = 1'-0"

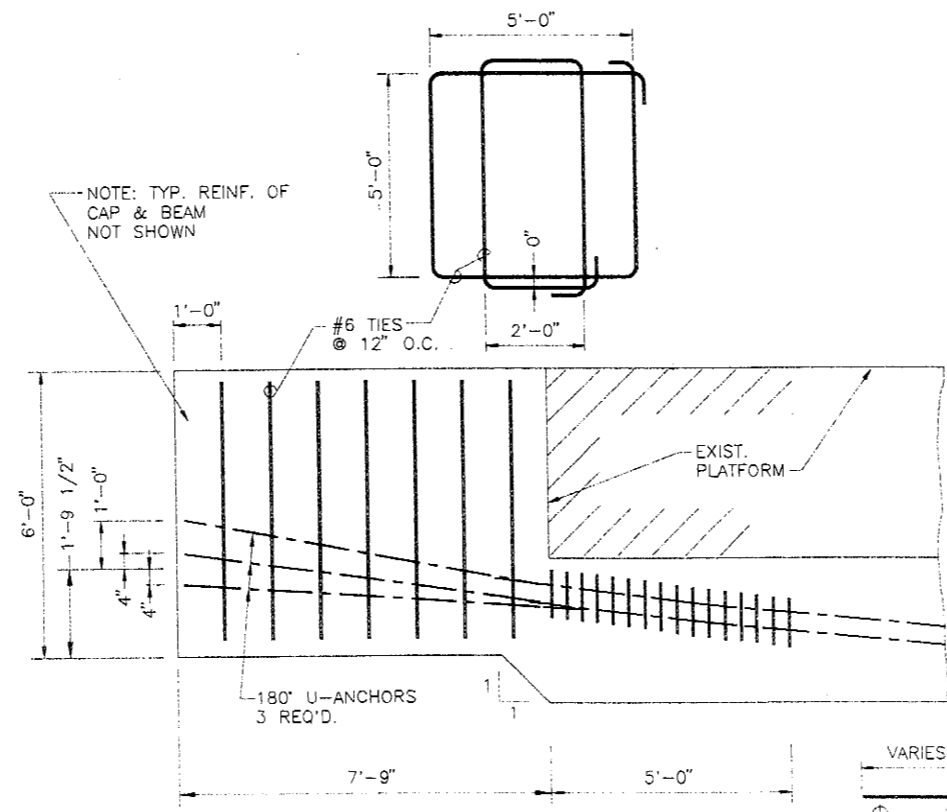


**E** SECTION  
S10 SOUTH END BEAM NO. 2 SHIPLOADER PLATFORM SCALE: 1/2" = 1'-0"

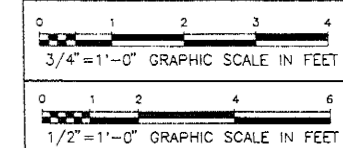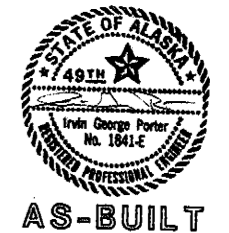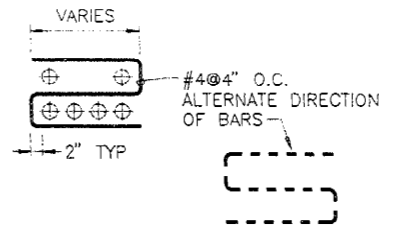

DESIGN	WAR
DRAWN	MAS
CHECK	DHA
APPROVED	GCF

**R&M ENGINEERING, INC.**  
6205 GLACIER HIGHWAY  
P.O. BOX 34278  
JUNEAU ALASKA 99803  
PH: (907) 780-6080

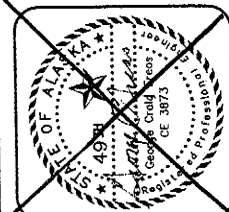

SOT03-1991-AB-S10, Structural Details


ALASKA INDUSTRIAL DEVELOPMENT & EXPORT AUTHORITY  
SKAGWAY ORE TERMINAL STRUCTURAL REPAIRS  
SKAGWAY, ALASKA

**STRUCTURAL DETAILS**


DATE: DEC. 6, 1991  
R&M NO. 901362.03  
SCALE: AS NOTED

**S10**  
12/16/2013  
10 OF 18


E: 05169-13, 1=16, 12/06/91 at 12:40

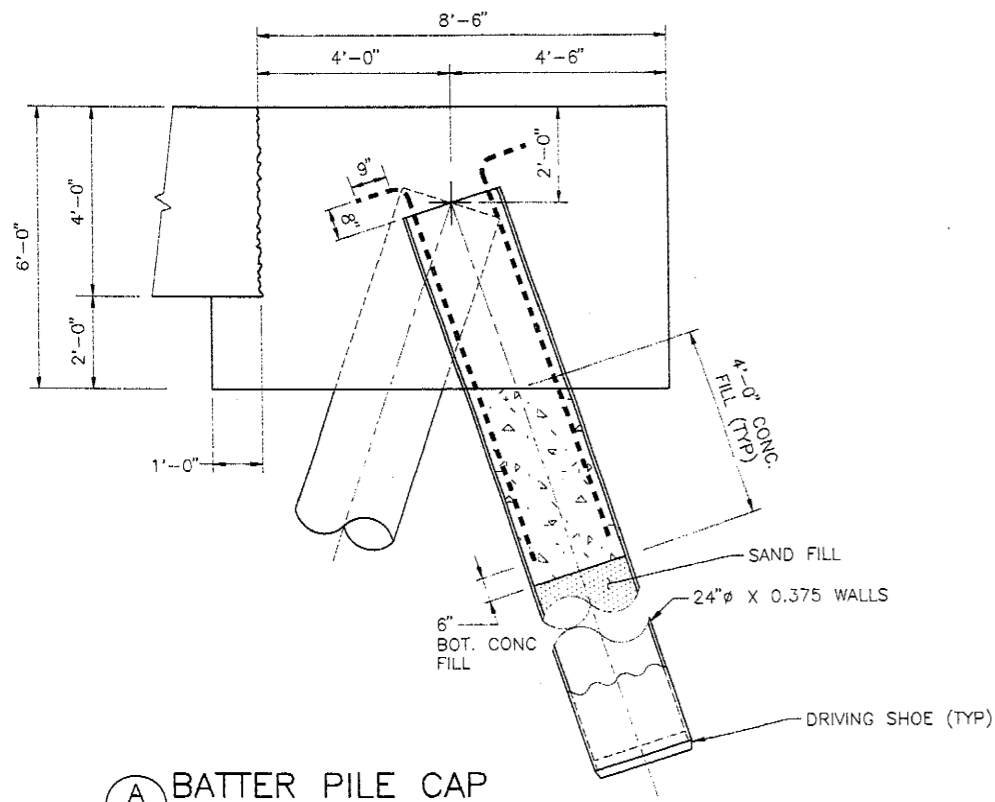

**A BATTER PILE CAP**  
TYP SCALE: 1/2" = 1'-0"

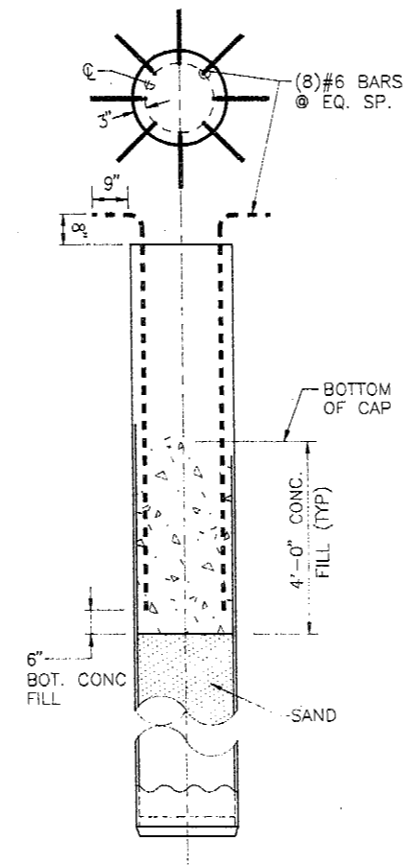


**B PILE DETAIL**  
TYP SCALE: 1/2" = 1'-0"

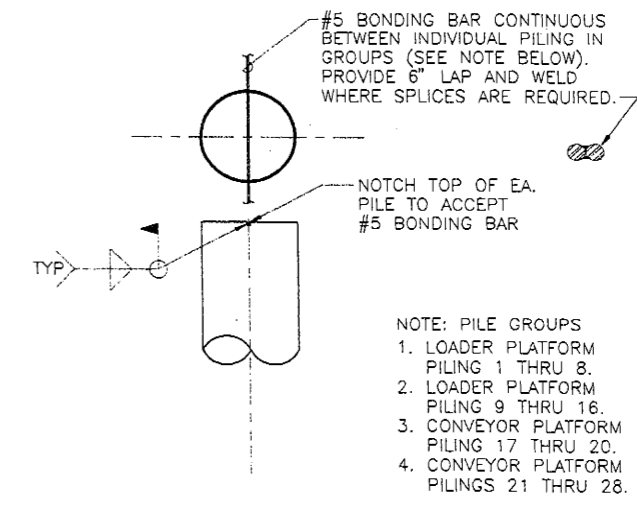


**C BONDING BAR DETAIL**  
SCALE: 1/2" = 1'-0"

- NOTE: PILE GROUPS
1. LOADER PLATFORM PILING 1 THRU 8.
  2. LOADER PLATFORM PILING 9 THRU 16.
  3. CONVEYOR PLATFORM PILING 17 THRU 20.
  4. CONVEYOR PLATFORM PILING 21 THRU 28.

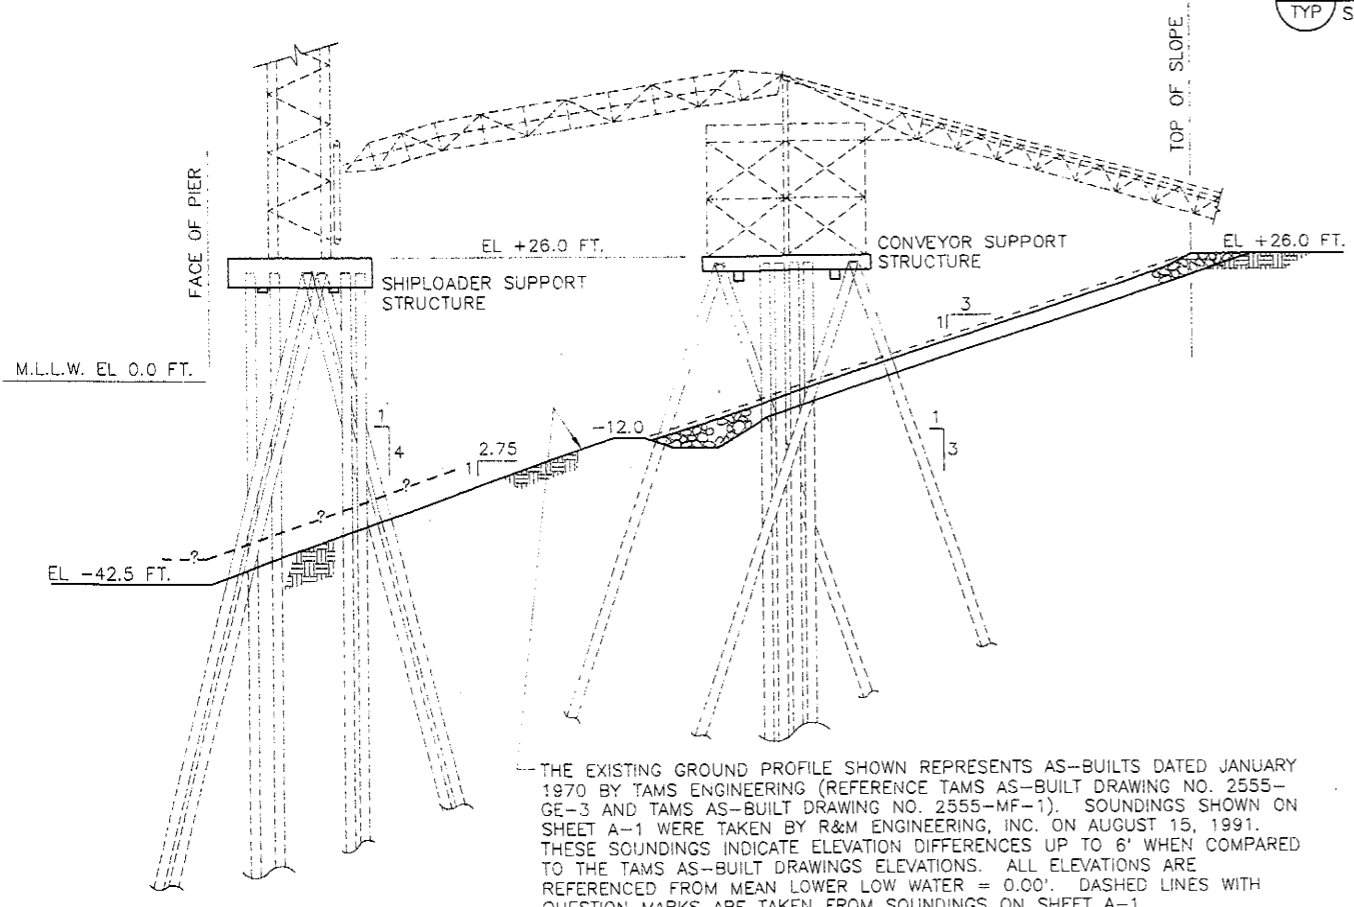


**D SECTION @ NEW CONSTRUCTION**  
SCALE: 1" = 20'



THE EXISTING GROUND PROFILE SHOWN REPRESENTS AS-BUILTS DATED JANUARY 1970 BY TAMS ENGINEERING (REFERENCE TAMS AS-BUILT DRAWING NO. 2555-GE-3 AND TAMS AS-BUILT DRAWING NO. 2555-MF-1). SOUNDINGS SHOWN ON SHEET A-1 WERE TAKEN BY R&M ENGINEERING, INC. ON AUGUST 15, 1991. THESE SOUNDINGS INDICATE ELEVATION DIFFERENCES UP TO 6' WHEN COMPARED TO THE TAMS AS-BUILT DRAWINGS ELEVATIONS. ALL ELEVATIONS ARE REFERENCED FROM MEAN LOWER LOW WATER = 0.00'. DASHED LINES WITH QUESTION MARKS ARE TAKEN FROM SOUNDINGS ON SHEET A-1.

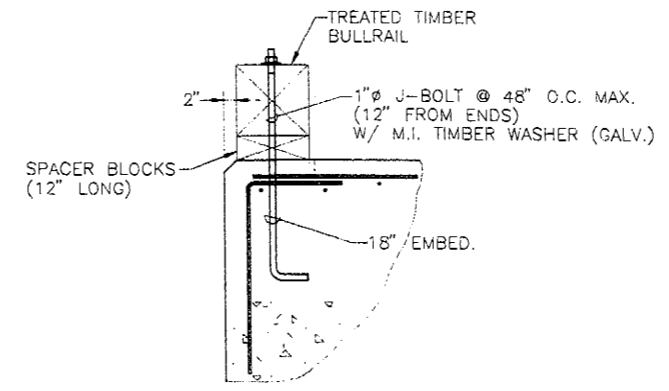

**E DECK-BULLRAIL DTL.**  
SCALE: 3/4" = 1'-0"

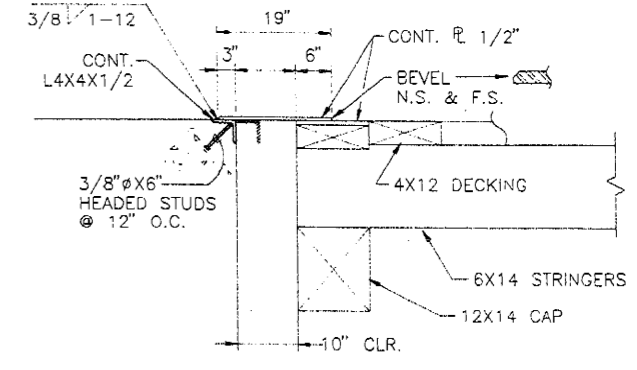


**F DECK-PLATE DTL**  
SCALE: 3/4" = 1'-0"

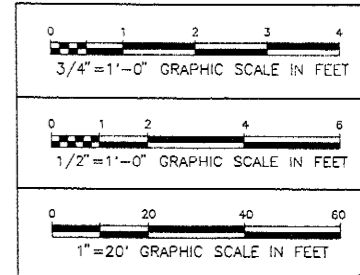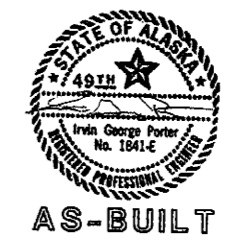

DESIGN	GCF
DRAWN	NRV
CHECK	DHA
APPROVED	GCF

**R&M ENGINEERING, INC.**  
6205 GLACIER HIGHWAY  
P.O. BOX 34278  
JUNEAU, ALASKA 99803  
PH: (907) 780-6060

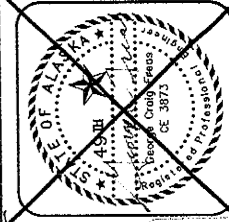

SOT03-1991-AB-S11, Structural Details

ALASKA INDUSTRIAL DEVELOPMENT & EXPORT AUTHORITY  
SKAGWAY ORE TERMINAL STRUCTURAL REPAIRS  
SKAGWAY, ALASKA

**STRUCTURAL DETAILS**


DATE: DEC. 6, 1991  
R&M NO. 901362.03  
SCALE: AS NOTED

**S11**


SHEET 11 OF 18

E:05189-11, 1=24, 12/05/91 at 13:16




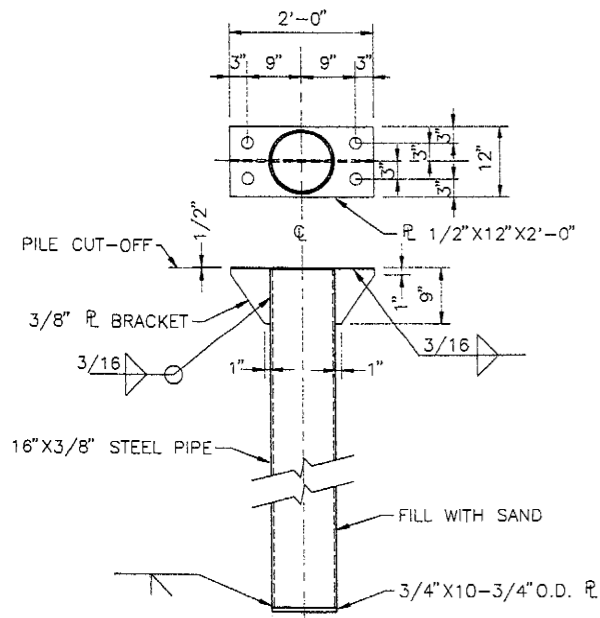

**(A) PILE DETAIL-TYP**  
SCALE: 3/4" = 1'-0"

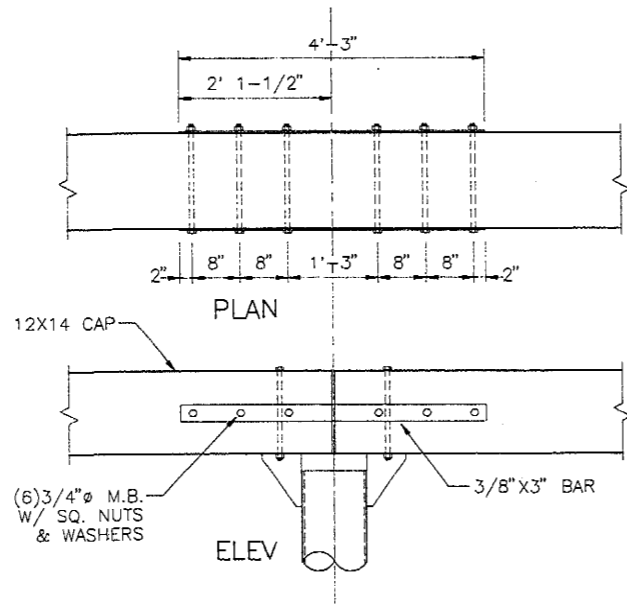


**(B) CAP BEAM SPLICE DETAIL-TYP**  
SCALE: 3/4" = 1'-0"

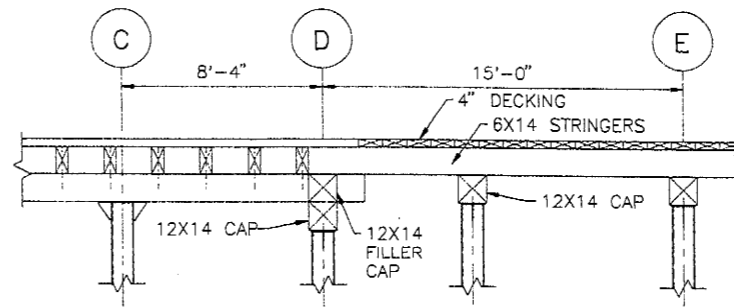


**(C) DECK SECTION**  
SCALE: 1/4" = 1'-0"

GENERAL NOTES


NOTE: IT IS INTENDED TO RECONSTRUCT THE TIMBER DOCK EMPLOYING MATERIALS AND METHODS SIMILAR TO THOSE USED IN THE EXISTING STRUCTURE, UNLESS OTHERWISE NOTED.

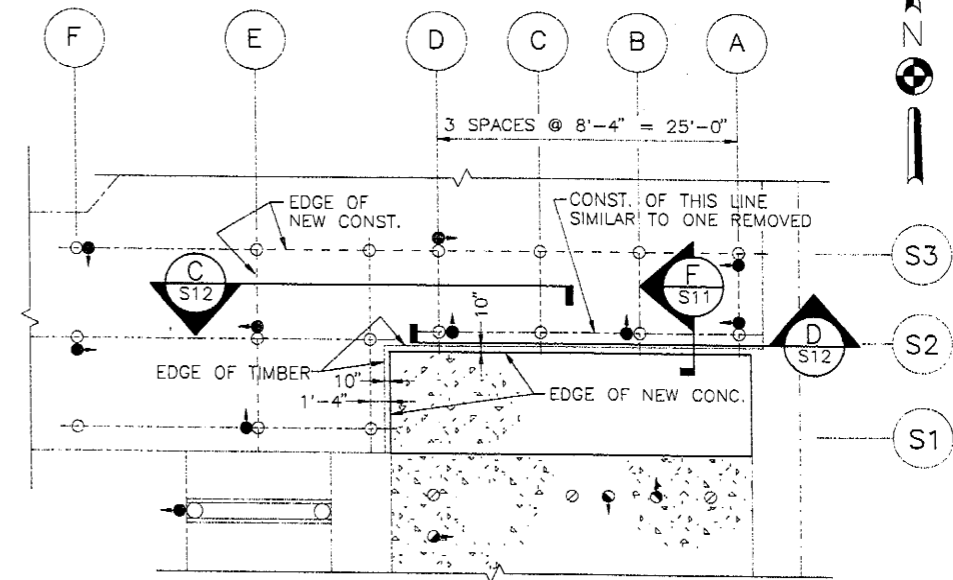

**(1) TIMBER DOCK RECONSTRUCTION PLAN**  
SCALE: 1/8" = 1'-0"

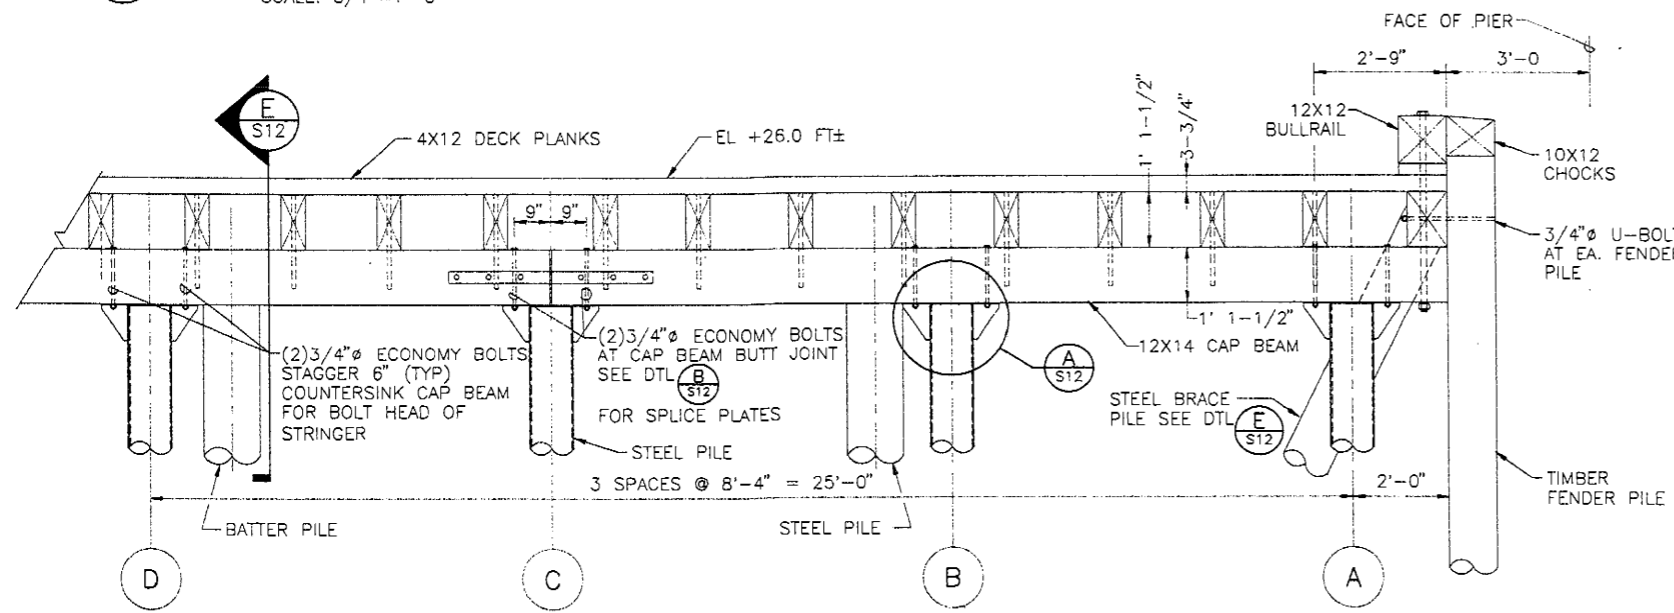


**(D) DECK SECTION**  
SCALE: 1/2" = 1'-0"

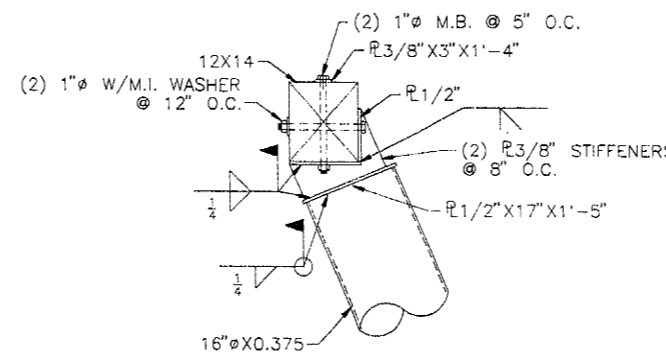

**(E) LONGITUDINAL BRACE PILE-TYPE DETAIL-TYP**  
SCALE: 3/4" = 1'-0"




AS-BUILT

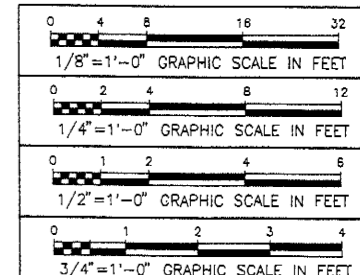

DESIGN	GCF
DRAWN	MAS
CHECK	DHA
APPROVED	GCF

**R&M ENGINEERING, INC.**  
6205 GLACIER HIGHWAY  
P.O. BOX 34278  
JUNEAU, ALASKA 99803  
PH: (907) 780-8080

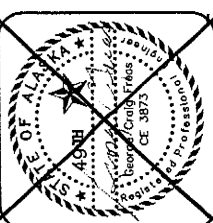


SOT03-1991-AB-S12, Timber Dock - Plan & Sections

ALASKA INDUSTRIAL DEVELOPMENT & EXPORT AUTHORITY  
SKAGWAY ORE TERMINAL STRUCTURAL REPAIRS  
SKAGWAY, ALASKA  
**TIMBER DOCK**  
PLAN & SECTIONS


DATE: DEC. 6, 1991  
R&M NO. 901362.03  
SCALE: AS NOTED

**S12**  
12 OF 18

E:05169-12, 1=16, 12/05/91 of 13:11

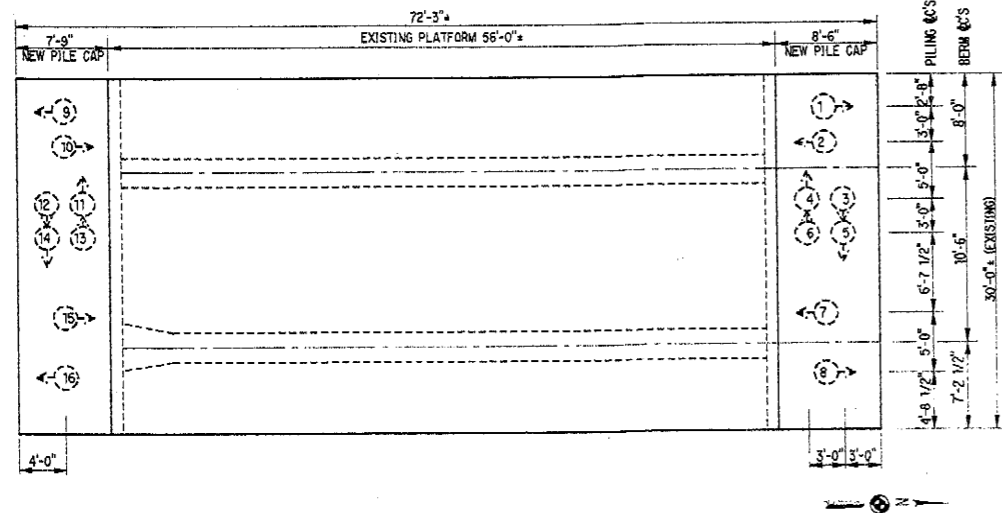


SHIP LOADER PLATFORM PLAN 1  
SCALE: 1/8" = 1'-0"

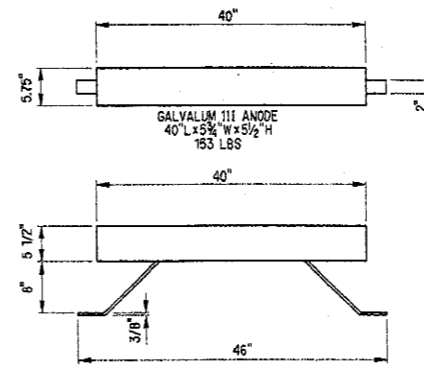


ANODE SPECIFICATION:  
TOTAL WEIGHT: 153 LBS  
GALVALUM III WEIGHT: 140 LBS  
CORE WEIGHT: 13 LBS  
STANDOFF: 2" WIDE x 3/8" THICK  
ANODE LENGTH: 40"  
ANODE HEIGHT: 5 1/2"  
ANODE WIDTH: 5 1/2"  
STANDOFF MOUNT: 8"

ANODE DETAIL 3  
NTS

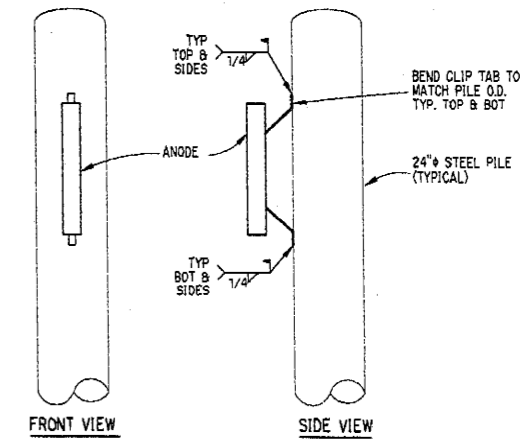

ANODE ATTACHMENT DETAIL 4  
NTS

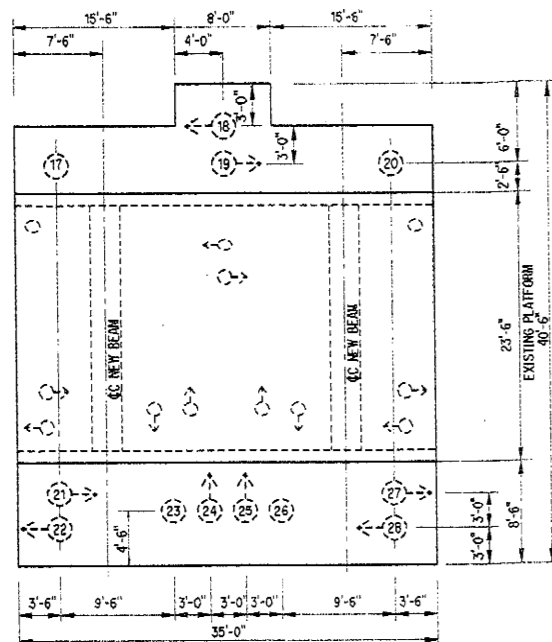

CONVEYOR NO. 2 SUPPORT STRUCTURE 2  
SCALE: 1/8" = 1'-0"

Pile Number	Piles	Anodes
1	1	2
2	1	2
17	1	0
18	1	0
19	1	0
20	1	6
21	1	0
22	1	0
23	1	0
24	1	0
25	1	4
26	1	4
27	1	6
28	1	6


Total Piles = 28  
Total Anodes = 56

ANODE PLACEMENT DETAIL 5

- ANODE INSTALLATION NOTES
1. INSTALL ANODES ON PILES AS SPECIFIED. USE 120° (3 ANODES PER ROW) MINIMUM SPACING.
  2. INSTALL ANODES AT OR WITHIN ONE (1) FOOT OF MIDLINE. INSTALL ADDITIONAL ANODE(S) ROW(S) BELOW MIDLINE, SPACE VERTICALLY AS REQUIRED FOR CLEARANCE.
  3. INSTALL ANODES SO THAT THEY REMAIN SUBMERGED AT ALL TIMES.

DESIGN D. M. W.  
DRAWN D. J. W.  
CHECK  
APPROVED

**R&M ENGINEERING, INC.**  
6295 GLACIER HIGHWAY  
P.O. BOX 34278  
JUNEAU, ALASKA 99803  
PH: (907) 780-6860

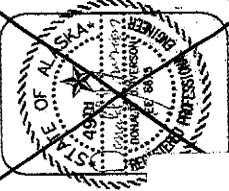

SOT03-1991-AB-CP1, Cathodic Protection

ALASKA INDUSTRIAL DEVELOPMENT & EXPORT AUTHORITY  
SKAGWAY ORE TERMINAL STRUCTURAL REPAIRS  
SKAGWAY, ALASKA  
**LOADER & CONVEYOR PLATFORMS CATHODIC PROTECTION DETAILS**



DATE: DEC. 6, 1991  
R&M NO.  
SCALE: AS SHOWN


CP-1

SHEET 12/16/2013

AS-BUILT

DESIGN	I.G.P.
DRAWN	I.G.P.
CHECK	I.G.P.
APPROVED	I.G.P.

**R&M ENGINEERING, INC.**  
 ENGINEERS  
 SURVEYORS  
 6205 GLACIER HIGHWAY  
 P.O. BOX 34278  
 JUNEAU, ALASKA 99803  
 PH: (907) 780-6060

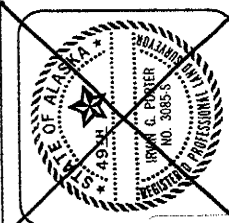

SOT03-1991-AB-A1, As-Built Ship Loader Access, Pedestrian Bridge


ALASKA INDUSTRIAL DEVELOPMENT & EXPORT AUTHORITY  
 SKAGWAY ORE TERMINAL STRUCTURAL REPAIRS  
 SKAGWAY, ALASKA  
**AS-BUILT**  
**SHIP LOADER ACCESS**  
**PEDESTRIAN BRIDGE**

DATE: OCT., 1991  
 R&M NO. 901314.03  
 SCALE:

A-1  
 SHEET  
**12/16/2013**  
 OF

NOTES:

- The pump pad at the intermediate tower is to be relocated to the approximate location shown on Plan Sheet A-1. The contractor will coordinate with the owner the exact location of the relocated pump pad. The relocation includes moving the pump and pump support and constructing a new concrete sump attached to the intermediate tower. The relocation includes moving the necessary electrical service and relocating the 4" poly pipe connection to the 4" poly pipe attached to the access dock. All electrical work shall conform to the 1990 NEC. The work also includes modifying the existing tower enclosure as necessary so that the sludge can be drained to the sump pump.
- All poly pipe seams to be butt welded. Solvent seams are not acceptable. Mechanical joints are permissible only at the sump pump connections. Ninety degree bends on the poly pipe attached to the access dock are not to be used. Bends on this part of the poly pipe systems should not exceed 30 degrees at a time.
- Existing electrical conduit and services on the existing wooden dock are to be maintained in service during construction and rerouted as necessary to accommodate the new work. All work shall conform to the 1990 NEC.
- All existing service panels located on the dock are to remain and if necessary to be relocated to accommodate the new work. The owner shall approve any relocation of existing panels. All work shall conform to the 1990 NEC.
- Existing lights on the dock are to remain in place. If necessary the owner shall approve any relocation.
- Existing timber and chicken wire railing on the access dock shown on Drawing A-1 is to be replaced. Railing to be constructed of pressure treated lumber not less than 2x4 in dimension. All fasteners to be galvanized. All wire to be galvanized. Railing to be the same height as the existing railing. Railing to be replaced on both sides of the approach dock. On the southerly side of the dock the railing is to be replaced in its total length. On the northerly side of the approach dock the railing is to be replaced from the beginning at the shore to the location of the 3" galvanized hose bid. If the contractor damages the rail in any other area it shall be repaired as directed by the engineer.
- The existing approach dock planking is 1 1/2"x4" finished. Existing bents are 12"x12" creosote timbers. Outside stringers are 10"x13" creosote timbers. Interior stringers are 6"x13 1/2" creosote timbers. Railing on both sides consists of 2.4 framing with chicken wire, railing 30" high with posts at 4'-6" c-c.

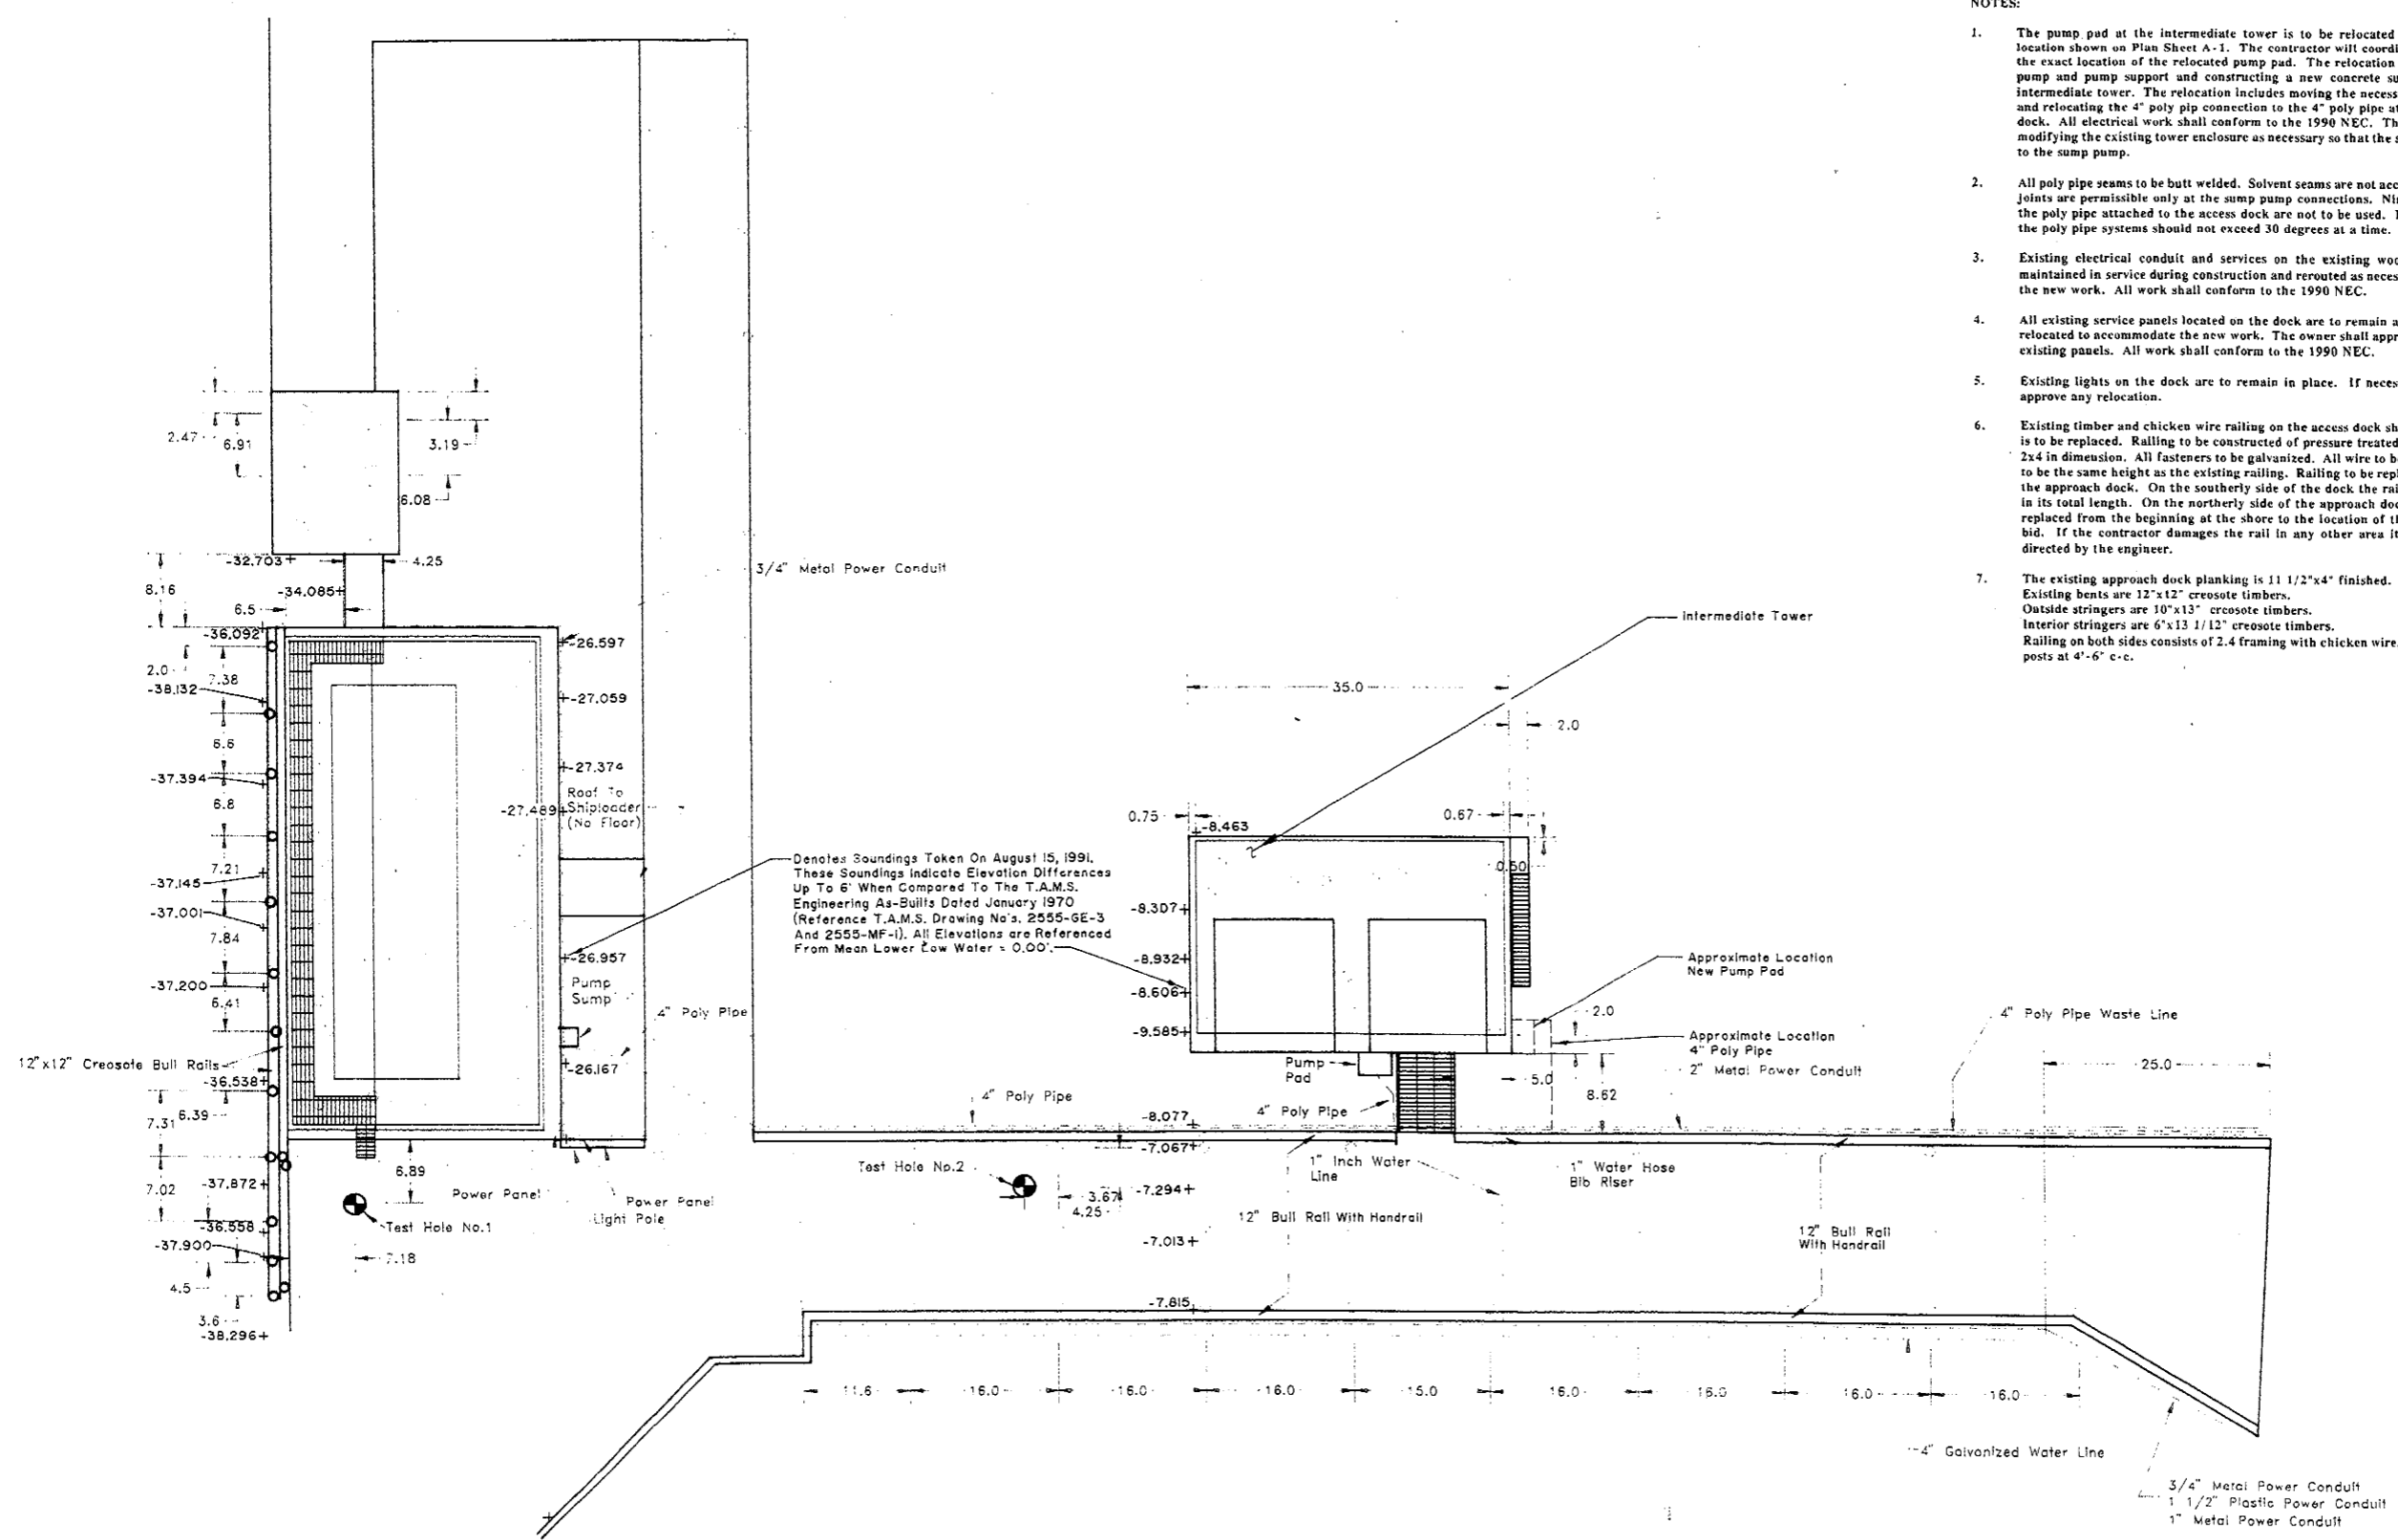

AS-BUILT SHIP LOADER, DOCK ACCESS, PEDESTRIAN BRIDGE







Scale 1" = 10'

SOT REACTIVATION PHASE I REFERENCE DRAWINGS 020907




**AS-BUILT**

E: 05169-S1, 1=1, 08/16/91 at 08:46

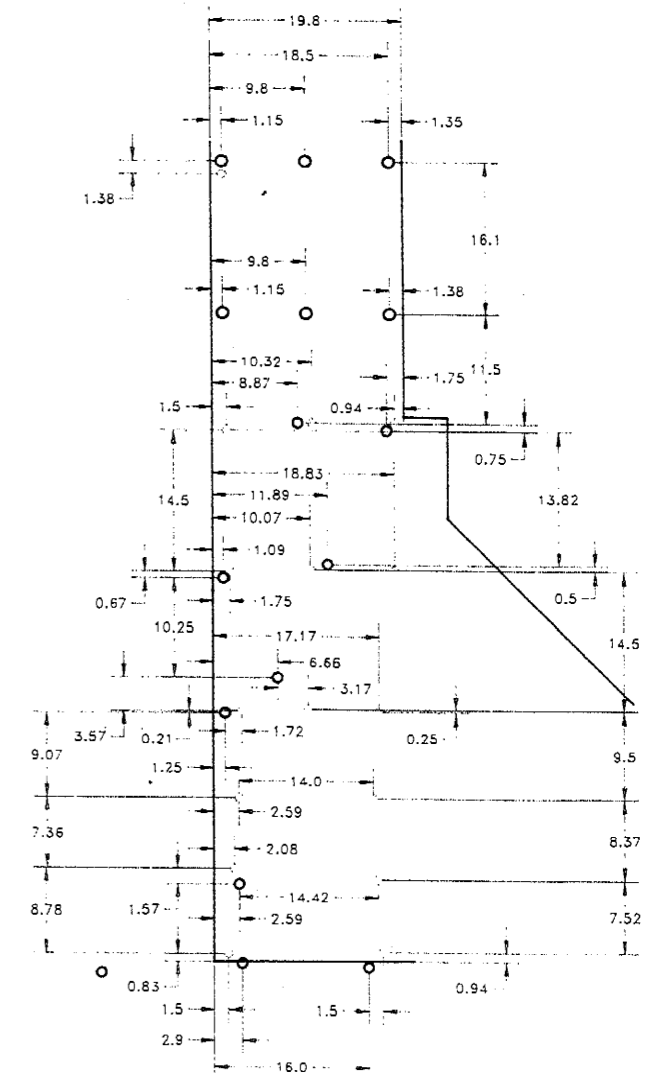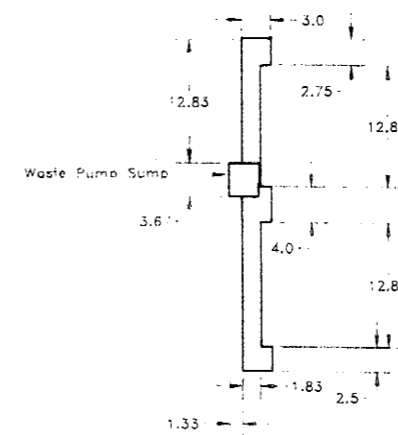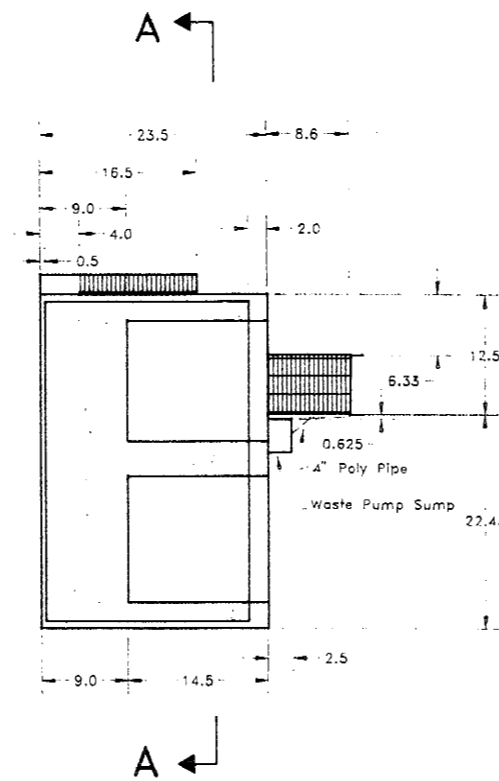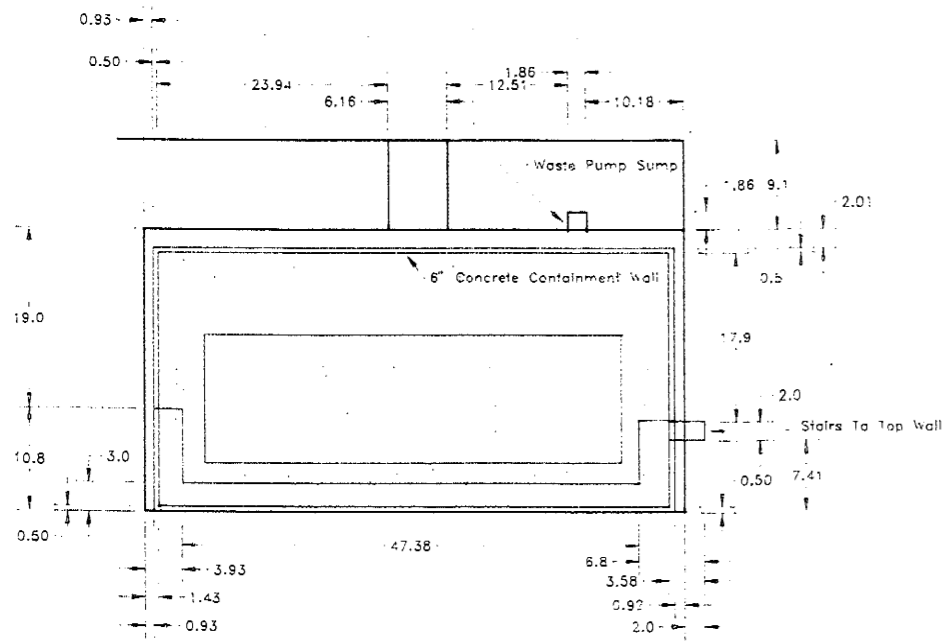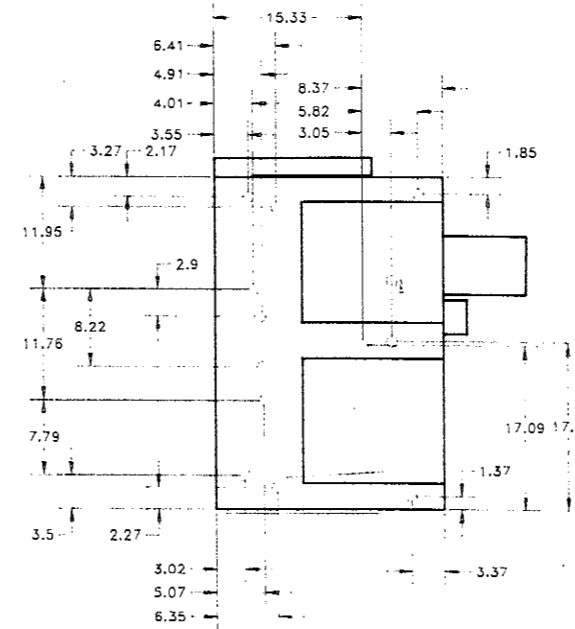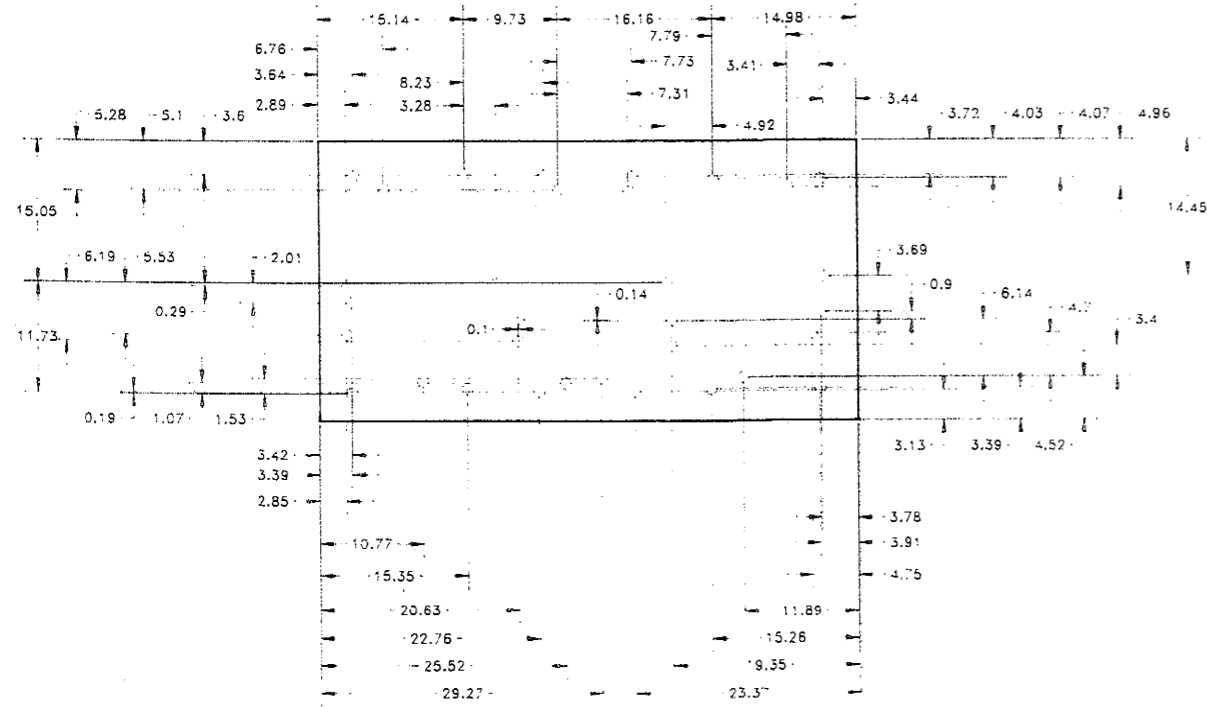

DESIGN	I.G.P.
DRAWN	I.G.P.
CHECK	I.G.P.
APPROVED	I.G.P.

**R & M ENGINEERING, INC.**  
 ENGINEERS SURVEYORS  
 6205 GLACIER HIGHWAY  
 JUNEAU, ALASKA 99803  
 PH: (907) 780-6060

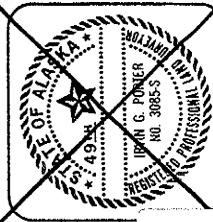

SOT03-1991-AB-A2, As-Built Ship Loader Details


ALASKA INDUSTRIAL DEVELOPMENT & EXPORT AUTHORITY  
 SKAGWAY ORE TERMINAL STRUCTURAL REPAIRS  
 SKAGWAY, ALASKA  
**AS-BUILT SHIP LOADER DETAILS**

DATE: OCT., 1991  
 R&M NO. 901314.03  
 SCALE:

E:05169-S1, 1=1, 08/16/91 at 08:46



TEST HOLE NO. 1

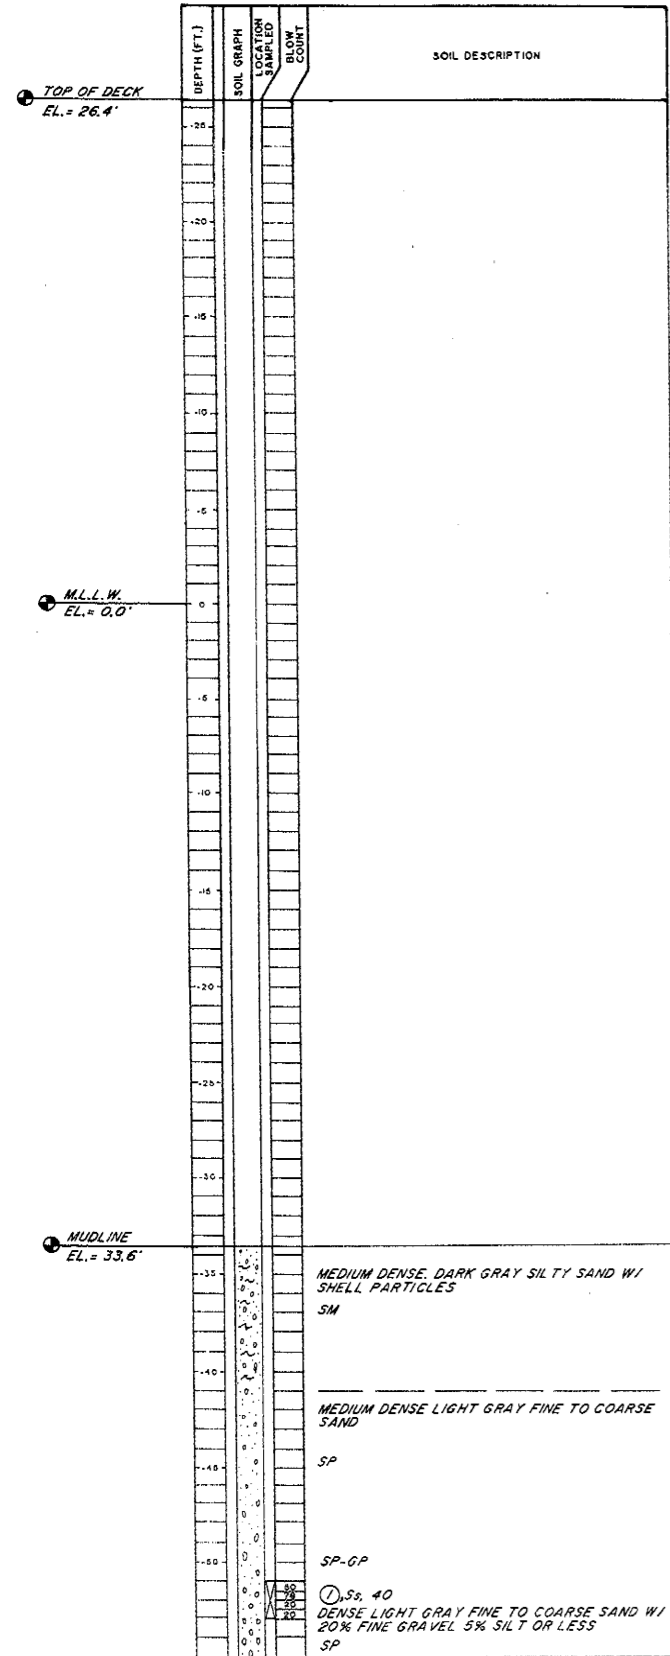

**EXPLANATION**



	ORGANIC MATERIAL		GRAVEL
	CLAY		COBBLES & BOULDERS
	SILT		BEDROCK
	SAND		ICE, MASSIVE

**TYPICAL SOILS LOG**

1. 14" SPLIT SPOON WITH 140 LB HAMMER  
 2. 14" SPLIT SPOON WITH 340 LB HAMMER  
 3. 2.5" SPLIT SPOON WITH 340 LB HAMMER  
 4. 2" SPLIT SPOON, PUSHED  
 5. AUGER SAMPLE  
 6. SHELBY TUBE  
 7. MODIFIED SHELBY TUBE  
 8. POLE SAMPLE

**SAMPLER TYPE SYMBOLS**


1. OPENED STRAIGHT CHAMBER  
 2. BEDROCK

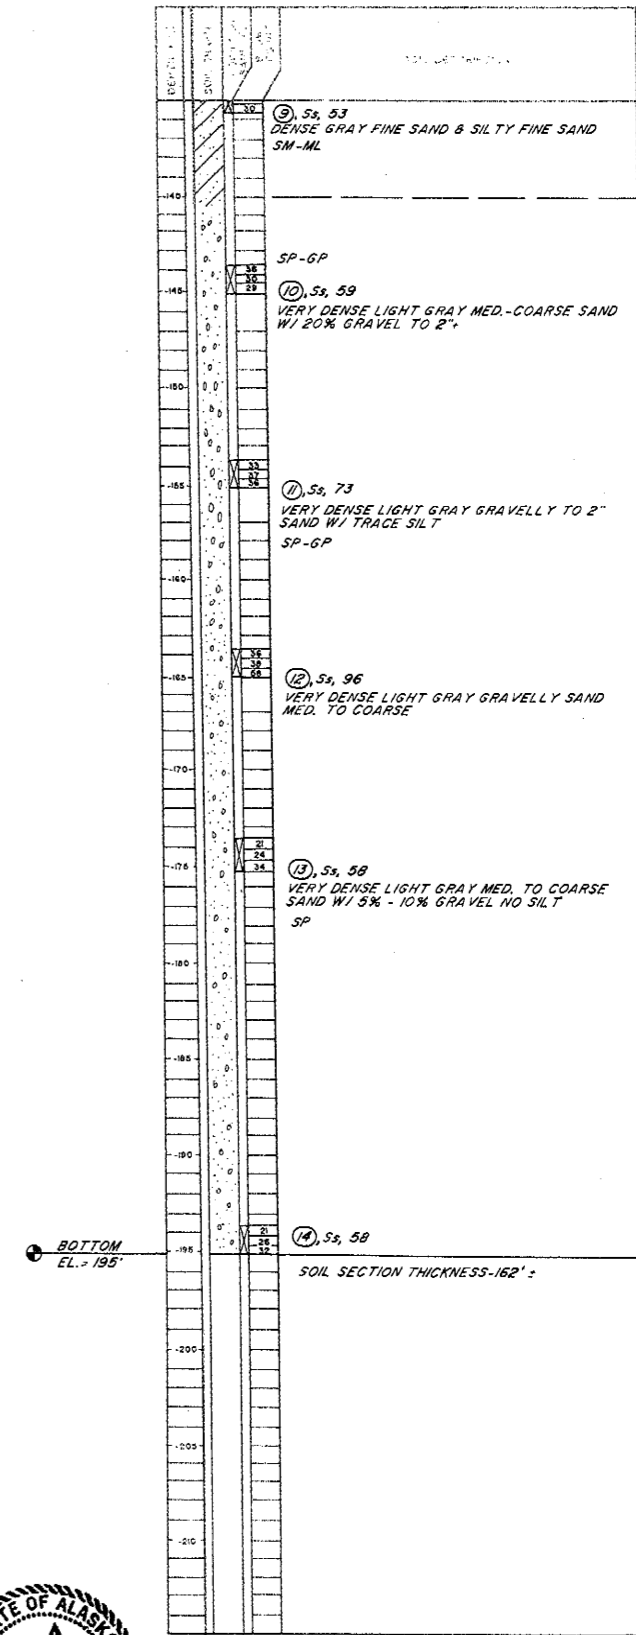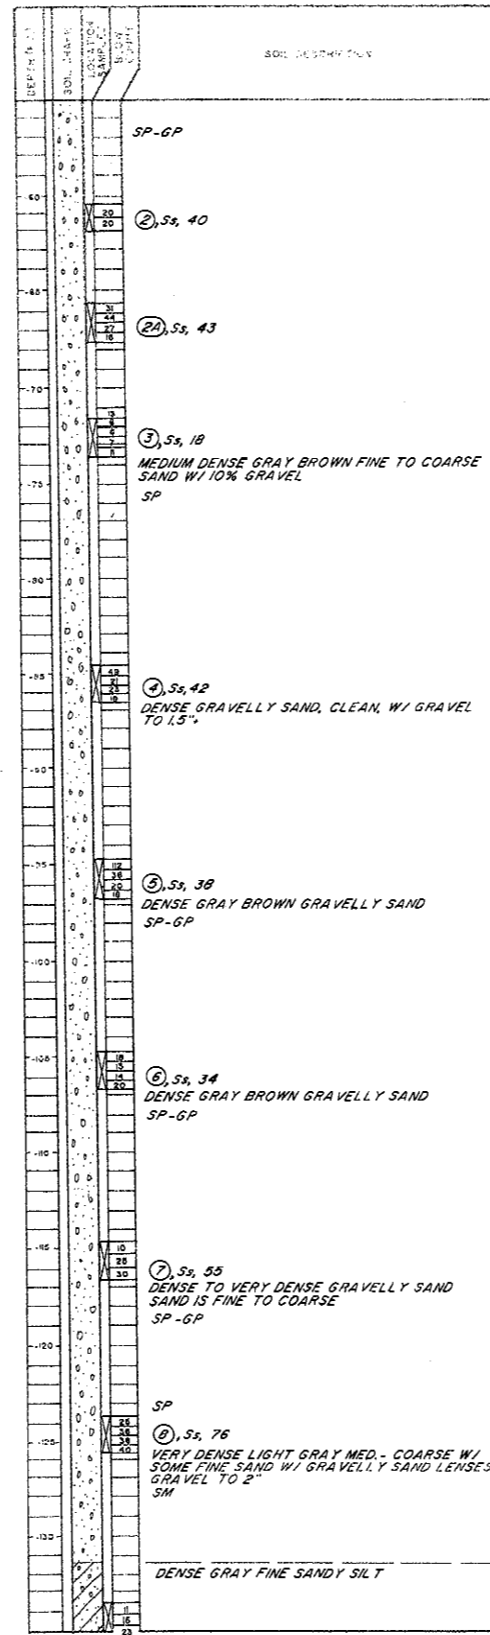

AS-BUILT

DESIGN	J.C.
DRAWN	F.M.
CHECK	J.C.
APPROVED	M.A.M.

**R&M ENGINEERING, INC.**  
 ENGINEERS  
 6205 GLACIER HIGHWAY  
 P.O. BOX 54278  
 JUNEAU, ALASKA 99803  
 PH: (907) 780-6060

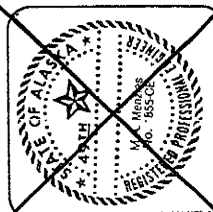

SOT03-1991-AB-T1, Test Hole No. 1

ALASKA INDUSTRIAL DEVELOPMENT & EXPORT AUTHORITY  
 SKAGWAY ORE TERMINAL STRUCTURAL REPAIRS  
 SKAGWAY, ALASKA  
**AUGUST, 1991**  
**TEST HOLE NO. 1**

DATE: OCT, 1991  
 R&M NO. 901314.03  
 SCALE:

T-1  
 SHEET 12/16/2013  
 OF

DESIGN J.C.  
 DRAWN F.M.  
 CHECK J.C.  
 APPROVED M.A.M.

**R & M ENGINEERING, INC.**  
 ENGINEERS SURVEYORS  
 6205 GLACIER HIGHWAY  
 P.O. BOX 34278  
 JUNEAU, ALASKA 99803  
 PH.: (907) 780-6060




SOT03-1991-AB-T2, Test Hole No. 2

ALASKA INDUSTRIAL DEVELOPMENT & EXPORT AUTHORITY  
 SKAGWAY ORE TERMINAL STRUCTURAL REPAIRS  
 SKAGWAY, ALASKA  
**AUGUST, 1991**  
**TEST HOLE NO. 2**

DATE: OCT., 1991  
 R&M NO. 901314.03  
 SCALE:

T-2

TEST HOLE NO. 2

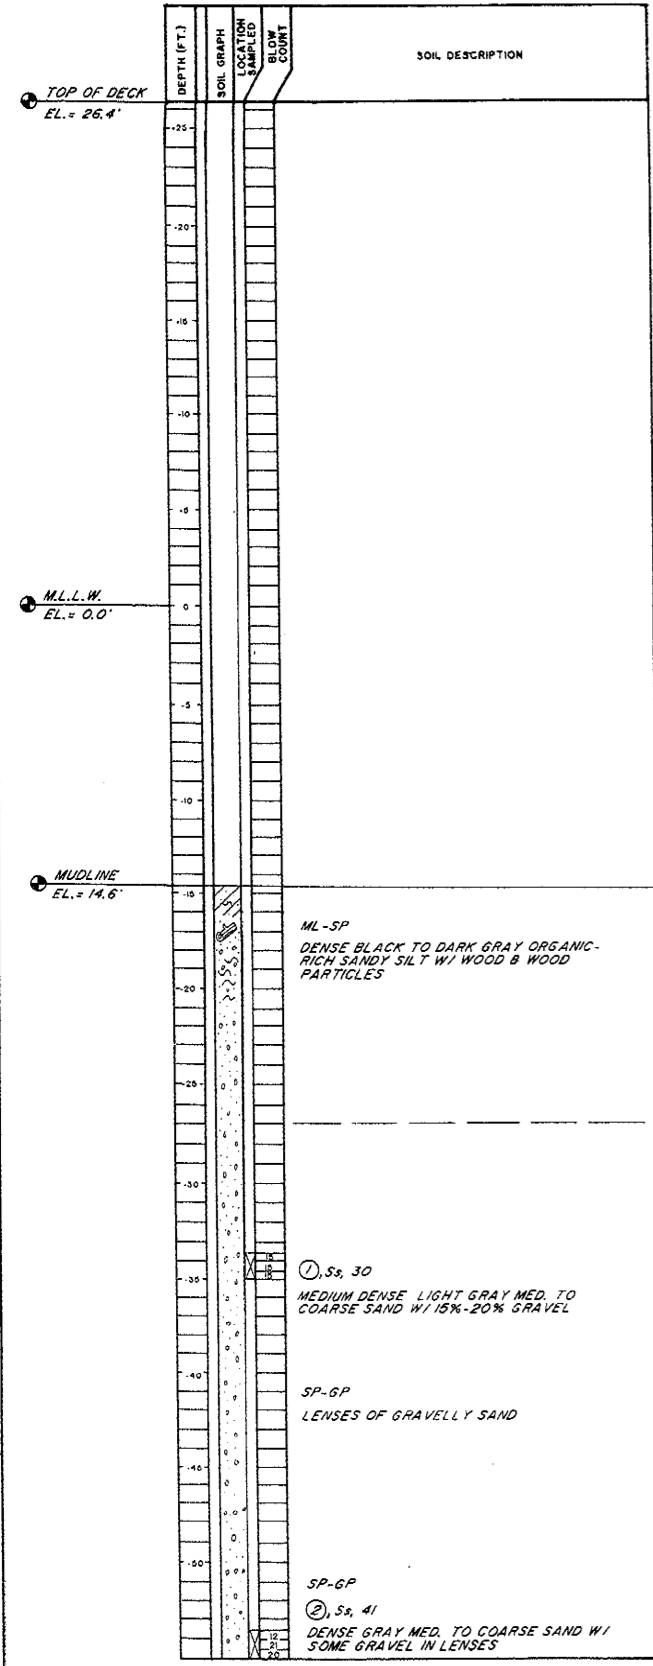

**EXPLANATION**

UNSATURATED ZONE  
 ORGANIC MATERIAL  
 LITTLE VISIBLICE 0-10%  
 W.B. ICE DESCRIPTION  
 SAMPLE NUMBER  
 WATER CONTENT  
 BLOW/FOOT  
 SAMPLER TYPE  
 NO. WATER TABLE  
 SANDWICH STRATA CHANGE  
 BEDROCK  
 FROZEN GROUND  
 W-D WHOLE OR LOGS  
 A-A AFTER BORING



**TYPICAL SOILS LOG**

- 1" SPLIT SPOON WITH 140 LB HAMMER
- 1" SPLIT SPOON WITH 340 LB HAMMER
- 2" SPLIT SPOON WITH 340 LB HAMMER
- 3" SPLIT SPOON, PUSHED
- AUGER SAMPLE
- SHOULDER TUBE
- MODIFIED SHOULDER TUBE
- BULK SAMPLE


**SAMPLER TYPE SYMBOLS**

- ORGANIC MATERIAL
- CLAY
- SILT
- SAND
- GRAVEL
- COBBLES & BOULDERS
- BEDROCK
- ICE, MASSIVE


**SOIL SYMBOLS**

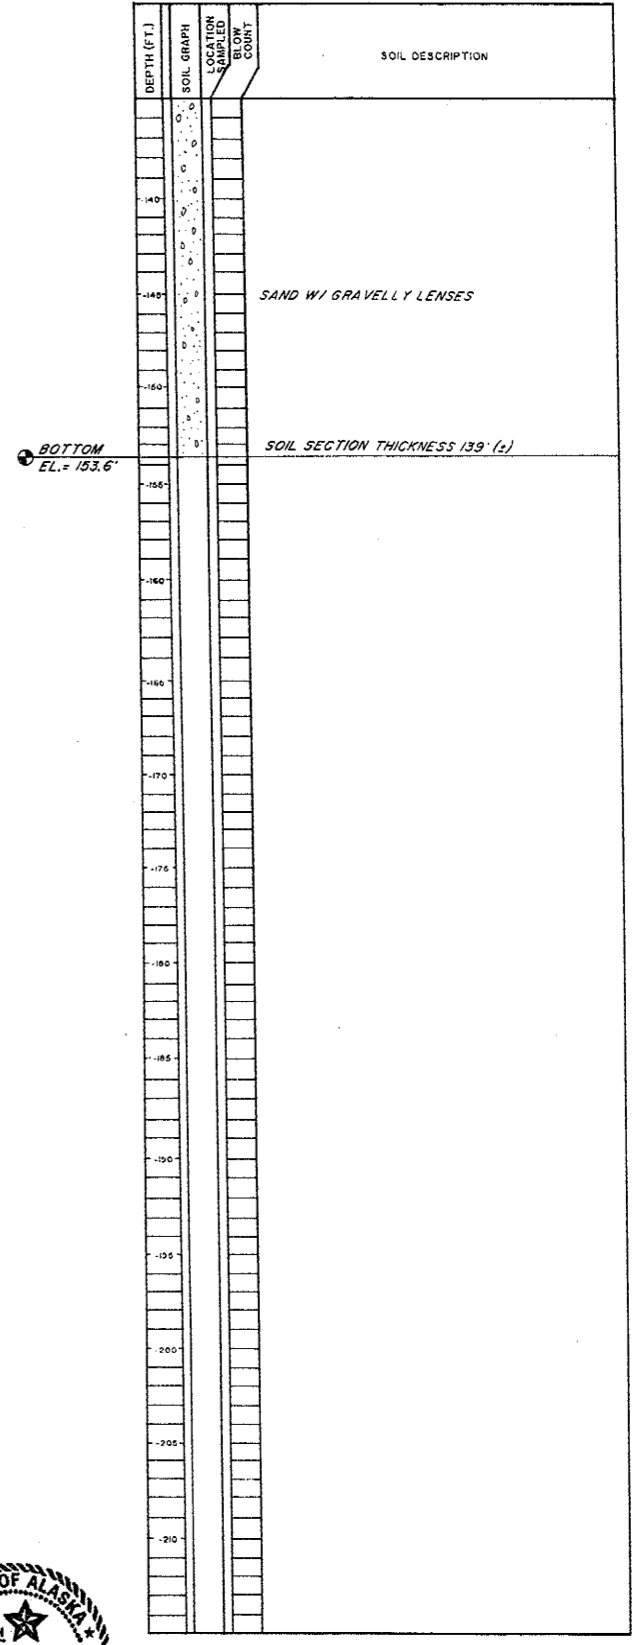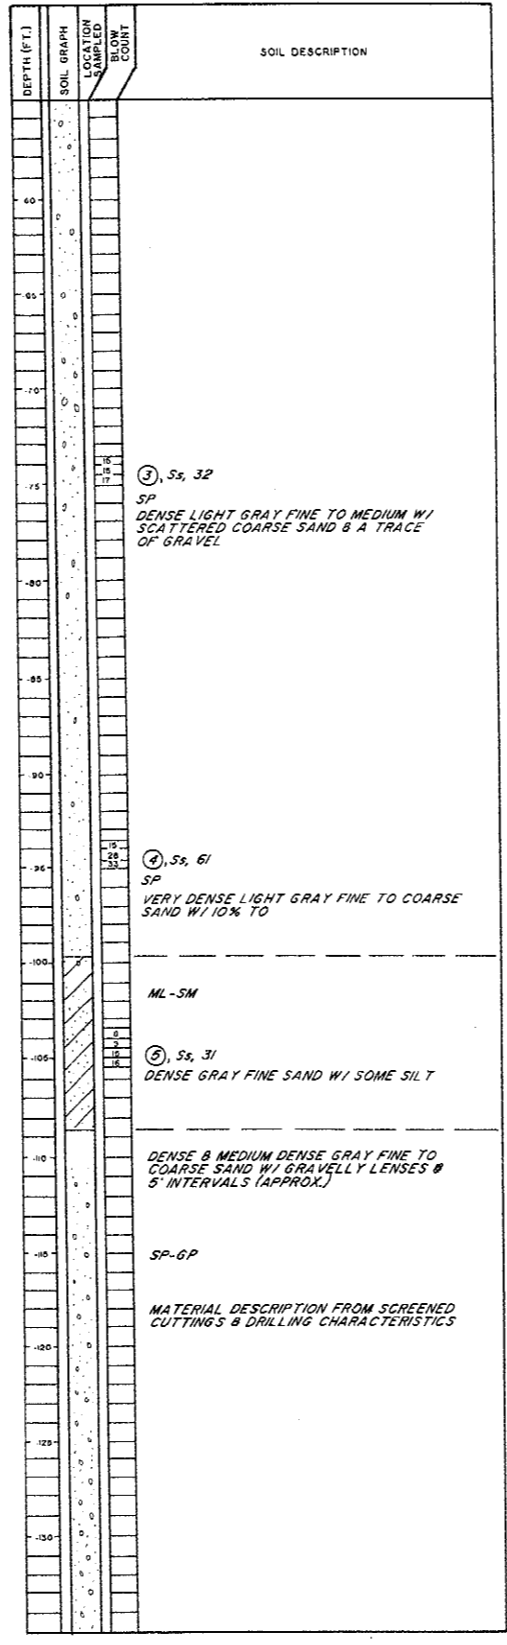

AS-BUILT

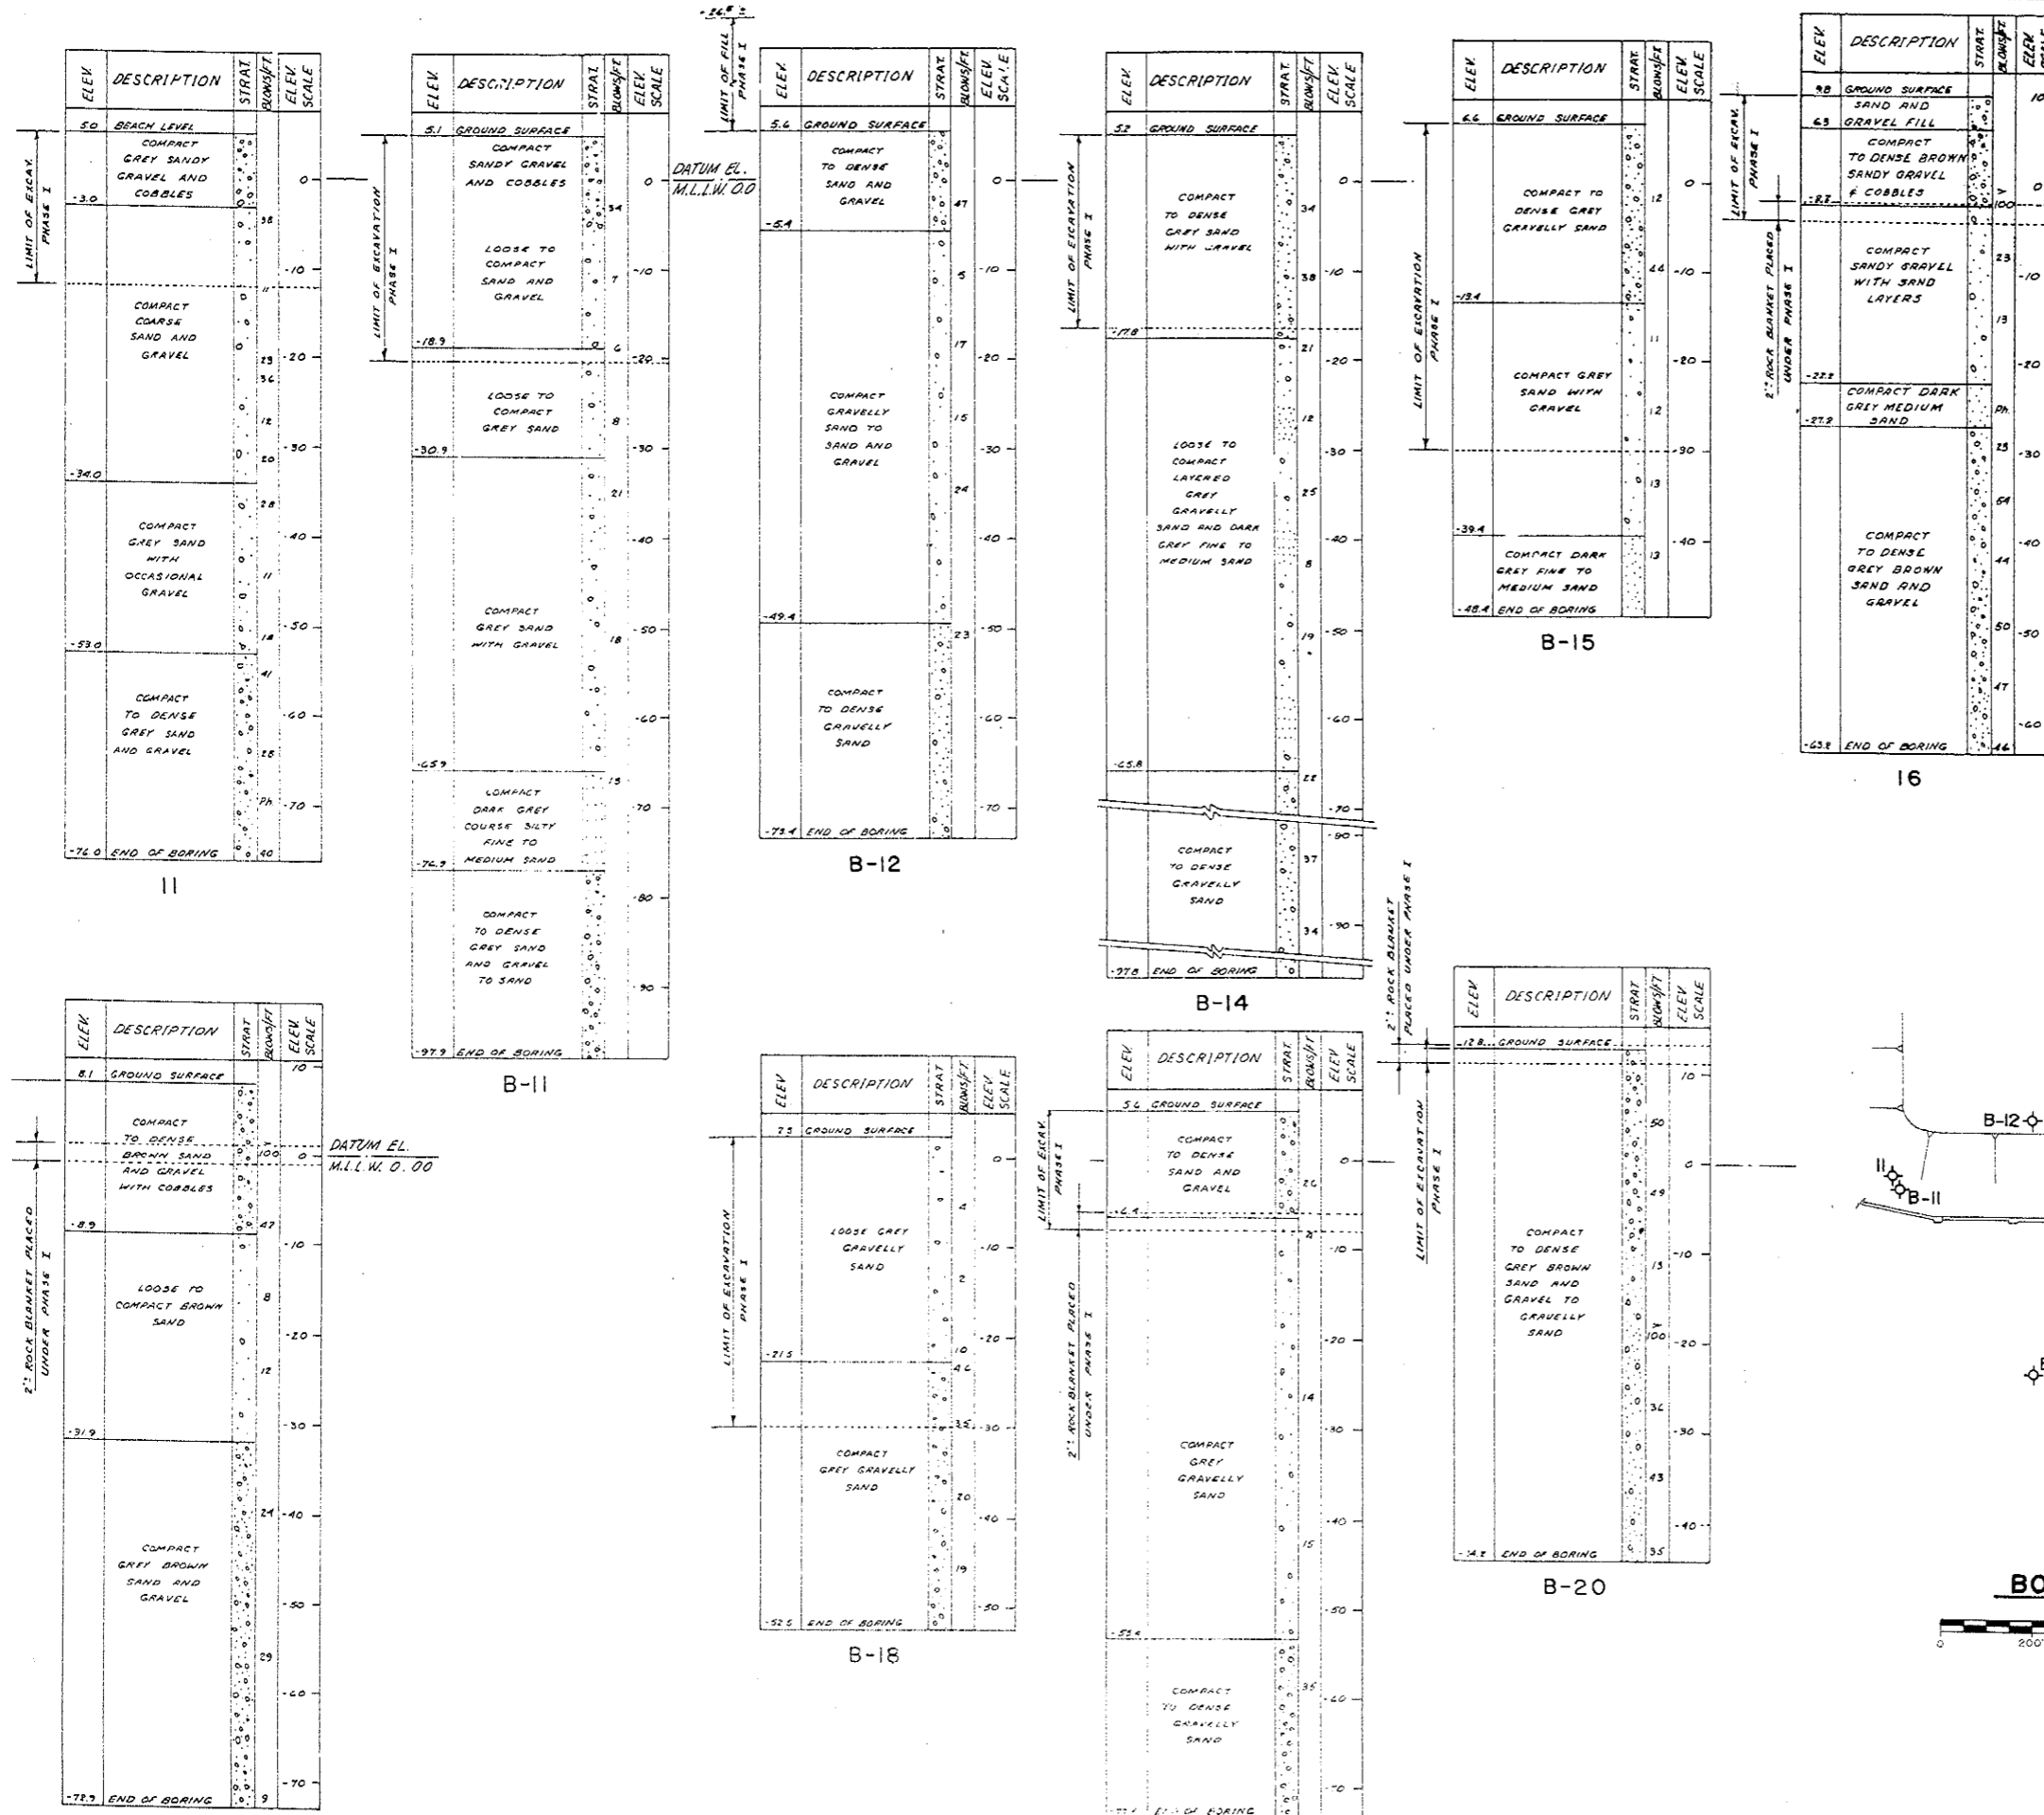


- BORING NOTES**
- BORING LOGS ARE TAKEN FROM SOILS REPORT ENTITLED "SOIL INVESTIGATION, PROPOSED ORE TERMINAL, WHITE PASS AND YUKON ROUTE, SKAGWAY, ALASKA," BY GOLDER, BRANNER AND ASSOCIATES, LTD., VANCOUVER, B.C., DATED MAY 1967.
  - THE SUBSURFACE INFORMATION AND DATA HEREIN ARE NOT INTENDED AS REPRESENTATIONS OR WARRANTIES, BUT ARE FURNISHED FOR INFORMATION ONLY. IT IS EXPRESSLY UNDERSTOOD THAT THE OWNER AND ENGINEER, OR EITHER, WILL NOT BE RESPONSIBLE FOR THE ACCURACY THEREOF OR FOR ANY DEDUCTION, INTERPRETATION, OR CONCLUSION DRAWN THEREFROM BY THE CONTRACTOR. THE INFORMATION IS MADE AVAILABLE IN ORDER THAT THE CONTRACTOR MAY HAVE READY ACCESS TO THE SAME INFORMATION AVAILABLE TO THE OWNER AND ENGINEER, OR EITHER, AND IS NOT A PART OF THIS CONTRACT. (SEE SPECIAL PROVISIONS.)
  - ALL ELEVATIONS REFER TO THE PLANE OF MEAN LOWER LOW WATER (M.L.L.W. = 0.00 FEET).
  - SEE GENERAL PLAN, DRAWING NUMBER 2555-GE-3, FOR BORING LOCATIONS.
  - LEGEND:  
Ph: SAMPLER ADVANCED BY HYDRAULIC PRESSURE  
>: GREATER THAN
  - "GROUND SURFACE" SHOWN ON THESE BORINGS REFER TO ORIGINAL GROUND ELEVATIONS ON DATE WHEN BORINGS WERE TAKEN, PRIOR TO DREDGING AND HYDRAULIC FILL OPERATION CONDUCTED UNDER PHASE I PROJECT. "LIMIT OF EXCAVATION - PHASE I" AND "LIMIT OF FILL - PHASE I" INDICATED ON THESE BORING LOGS, DOES NOT PURPORT TO BE "AS-BUILT" CONSTRUCTION COMPLETED UNDER PHASE I AT THE TIME OF AWARD OF THIS CONTRACT.

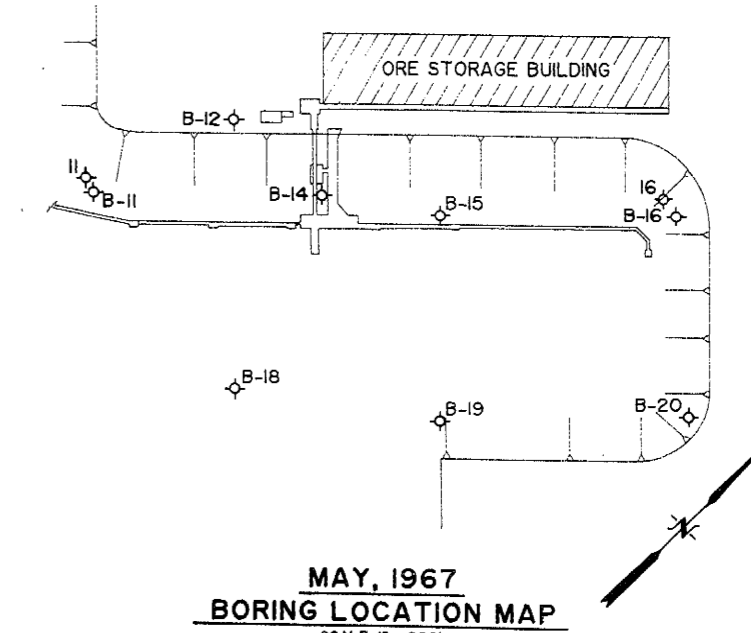

DESIGN J.C.  
DRAWN F.M.  
CHECK J.C.  
APPROVED M.A.M.

**R&M ENGINEERING, INC.**  
ENGINEERS SURVEYORS  
6205 GLACIER HIGHWAY  
P.O. BOX 34278  
JUNEAU, ALASKA 99803  
PH: (907) 760-6060

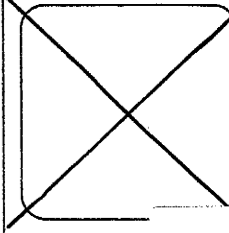

SOT03-1991-AB-T3, May, 1967  
Subsurface Data Boring Logs


ALASKA INDUSTRIAL DEVELOPMENT & EXPORT AUTHORITY  
SKAGWAY ORE TERMINAL STRUCTURAL REPAIRS  
SKAGWAY, ALASKA  
MAY, 1967  
SUBSURFACE DATA  
BORING LOGS

DATE: OCT., 1991  
R&M NO. 90314.03  
SCALE:

T-3  
12/16/2013  
OF




AS-BUILT

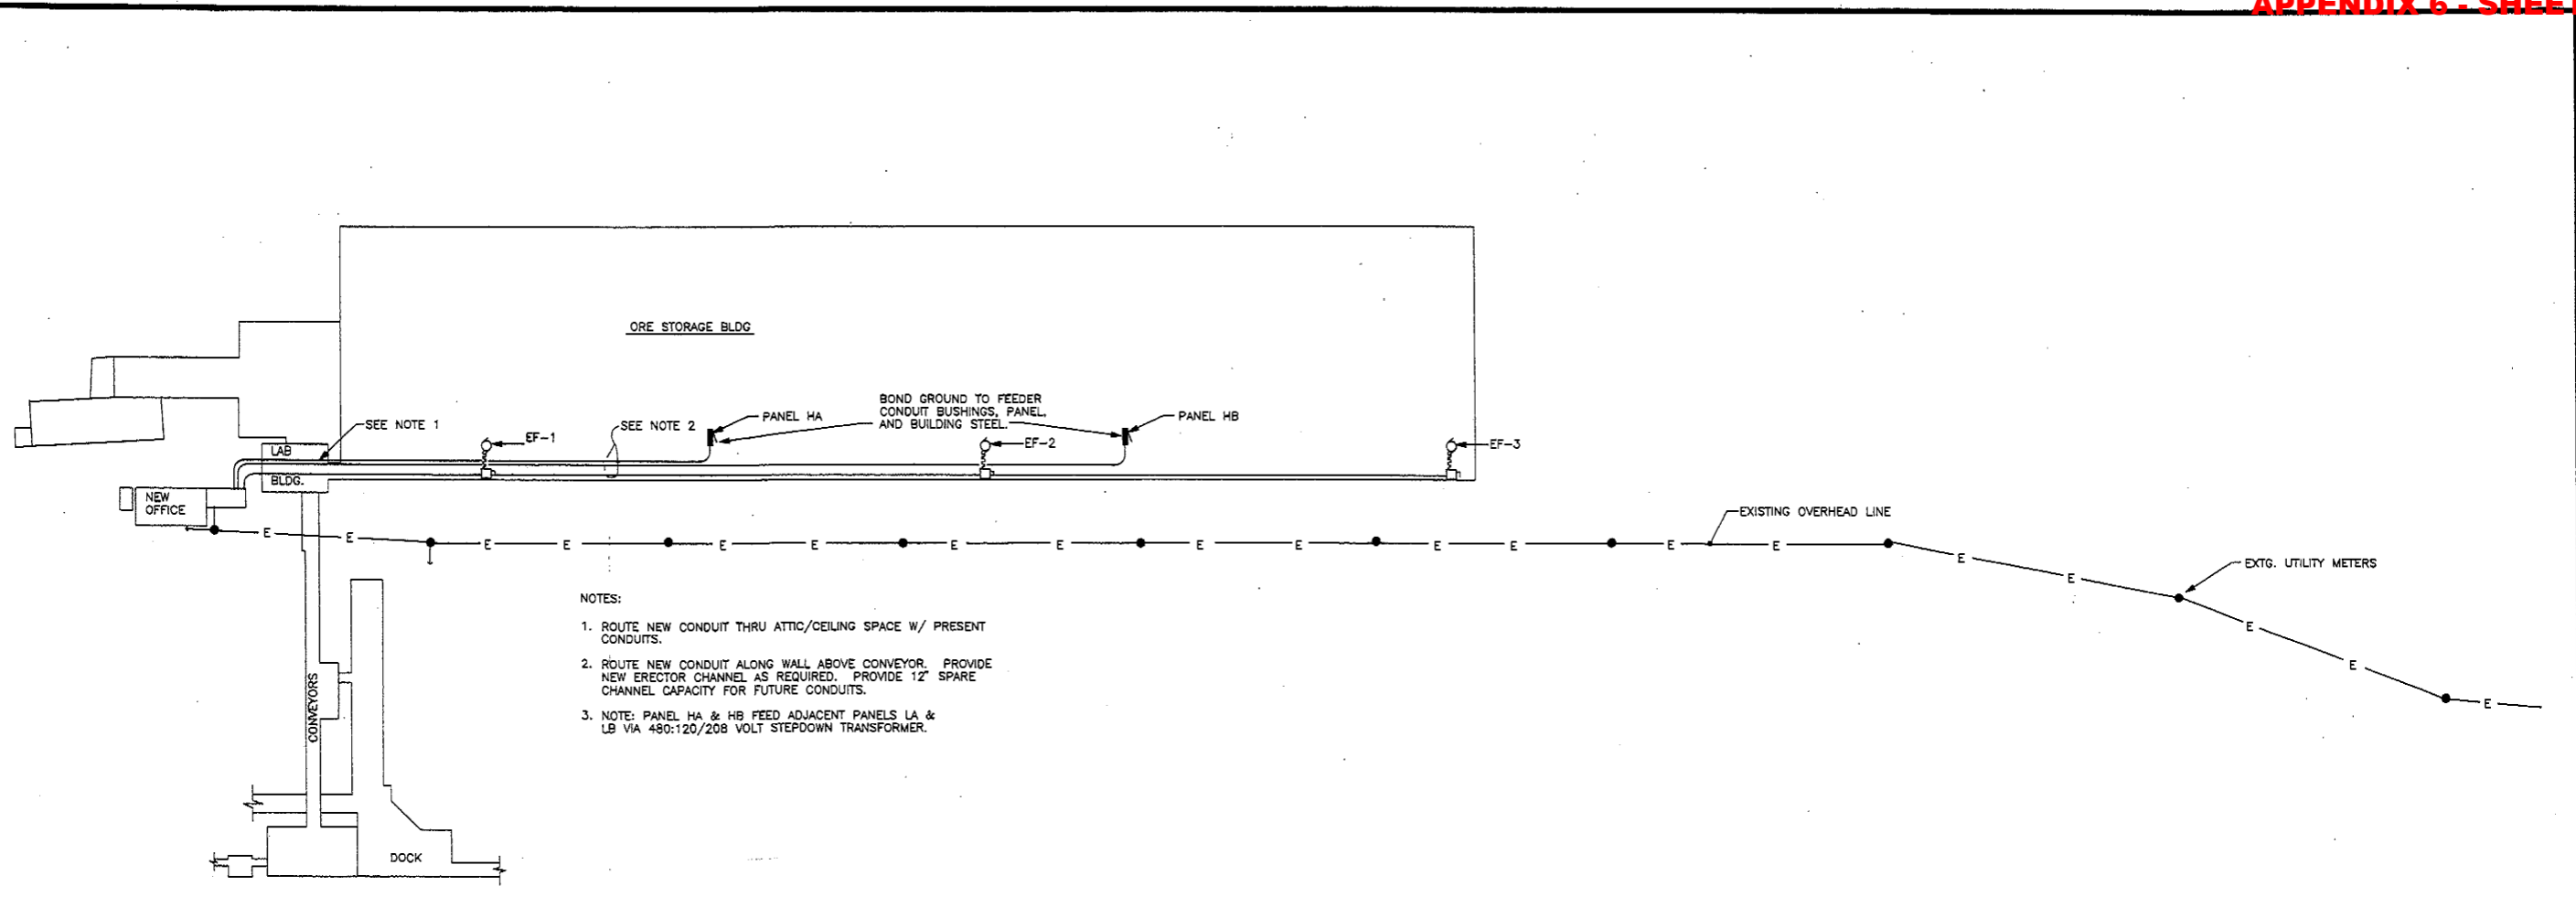

- NOTES:
1. ROUTE NEW CONDUIT THRU ATTIC/CEILING SPACE W/ PRESENT CONDUITS.
  2. ROUTE NEW CONDUIT ALONG WALL ABOVE CONVEYOR. PROVIDE NEW ERECTOR CHANNEL AS REQUIRED. PROVIDE 12" SPARE CHANNEL CAPACITY FOR FUTURE CONDUITS.
  3. NOTE: PANEL HA & HB FEED ADJACENT PANELS LA & LB VIA 480:120/208 VOLT STEPDOWN TRANSFORMER.

**SITE PLAN**  
SCALE: 1"=50'

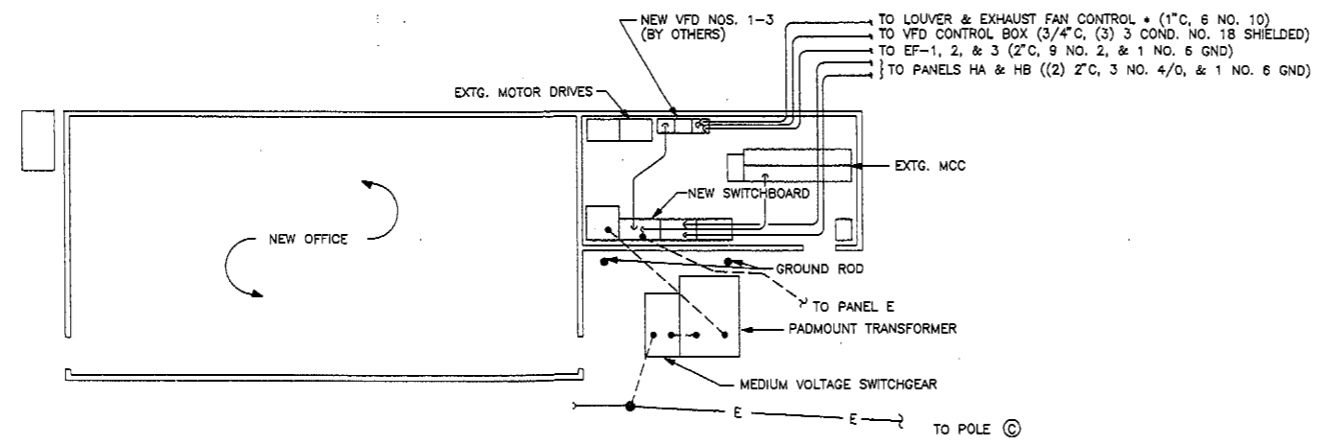

**ELECTRICAL BUILDING**  
SCALE: 1/8"=1'0"

NOTE:  
• EXTG EXHAUST FAN CONTROL NOT CONNECTED PER DIRECTION OF CRAIG BOWER.




DRAWING REDUCED TO 45% OF ORIGINAL SIZE  
SOT03-1991-AB-23/29, Electrical Site Plan / Details

<i>AS-BUILT</i>			
1	10/91	AS-BUILTS	PEL BCH
REV	DATE	ACTION	DESCRIPTION BY APVD
<b>B.C. Haight</b> Consulting Engineers 418 Harris Street, Juneau, Alaska (907) 586-9788			
<b>R &amp; M ENGINEERS, INC.</b> Skagway Ore Handling Terminal Skagway Alaska			
<b>SITE PLAN / DETAILS</b>			
PROJECT NUMBER		Scale: AS NOTED	Sheet No
128-06		Date: 29-OCT-90	<b>E-1</b>
Drawn: CRH/PEL	Design: BCH	Apvd: BCH	







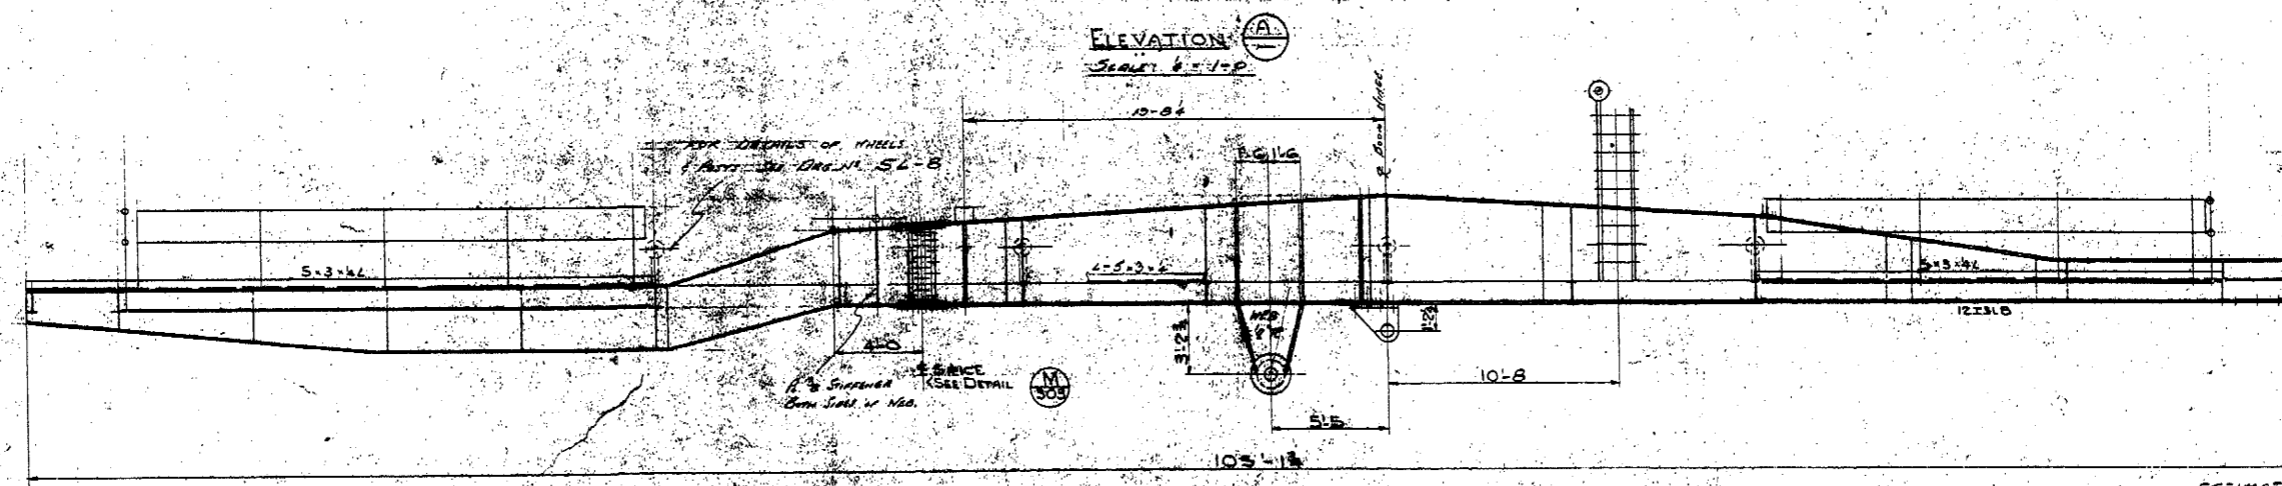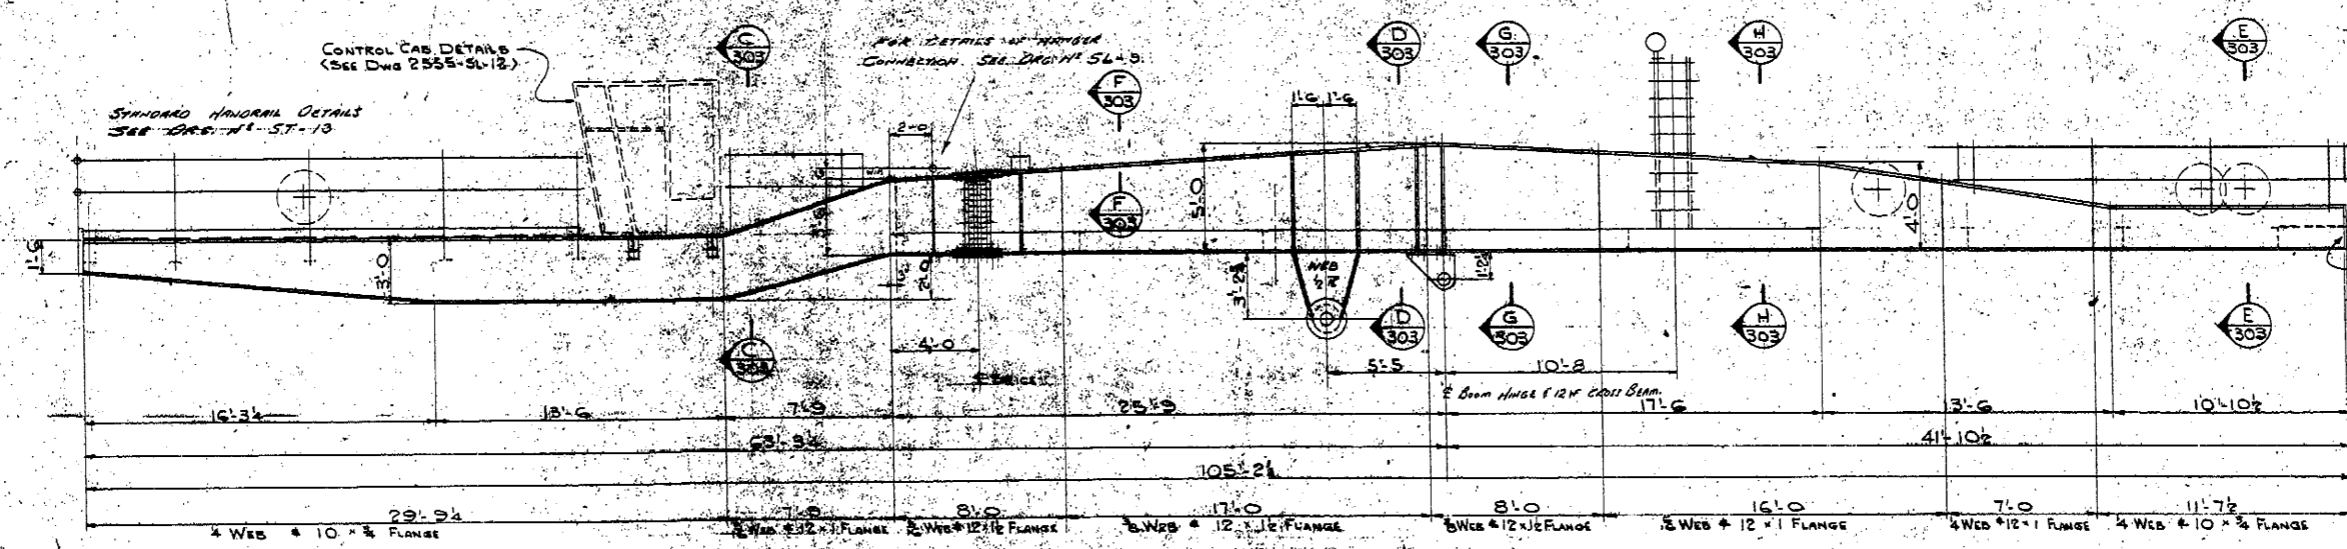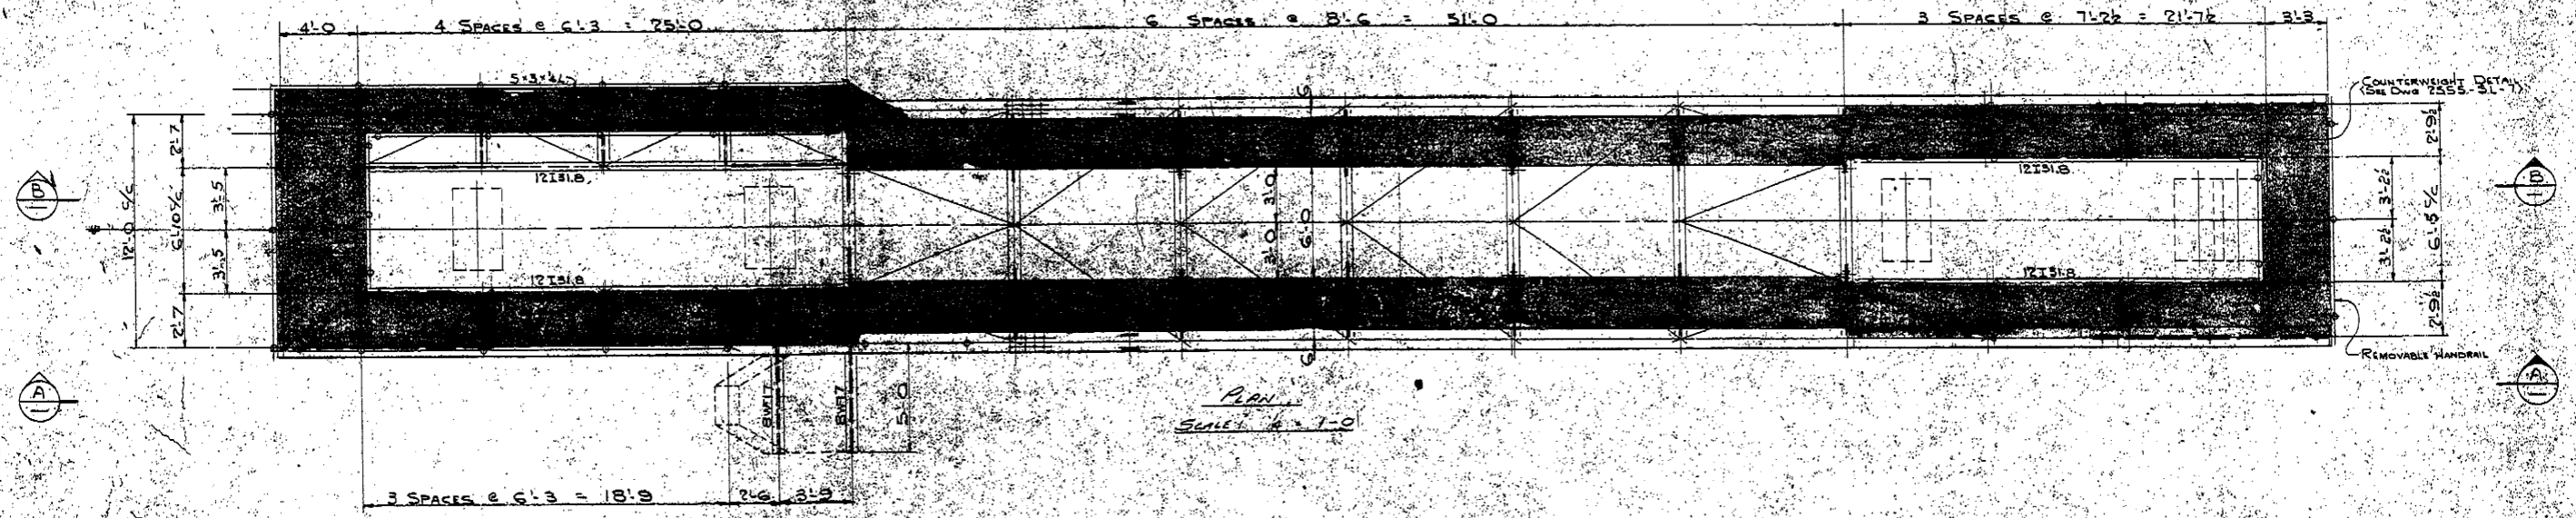


- NOTES:**
- BEAMS - 12WF27 1/2 NOTED
  - BRACING GST13.5 FLUSH WITH TOP OF 12\"/>
  - H/RAIL FIXED 1/2 NOTED
  - RAILS - 1 1/2\"/>
  - POSTS - 1 1/2\"/>
  - SOCKETS - 2\"/>
  - DENOTES GRATING WC-19-4 (1\"/>

ESTIMATED STEELWEIGHT OF BOOM: 52,000


DRAWING REDUCED TO 45% OF ORIGINAL SIZE

SOT03-1989-AB-2555-SL-2 Loading Boom - Plan & Elevations


	PREPARED BY: <b>WRIGHT ENGINEERS LIMITED</b> VANCOUVER CANADA	PACIFIC AND ARCTIC RAILWAY AND NAVIGATION COMPANY <b>ORE HANDLING TERMINAL -- PHASE II</b> SKAGWAY ALASKA
	REFERENCE: 528 480 302	TIPPETTS - ABBETT - MCCARTHY - STRATTON ENGINEERS AND ARCHITECTS Seattle New York
DESIGNED BY: J.M.H. CHECKED BY:		DRAWN BY: G. GUAN DATE: AUG-68 SCALE: AS NOTED SHIPLOADER LOADING BOOM PLAN & ELEVATIONS: 12-16-2013

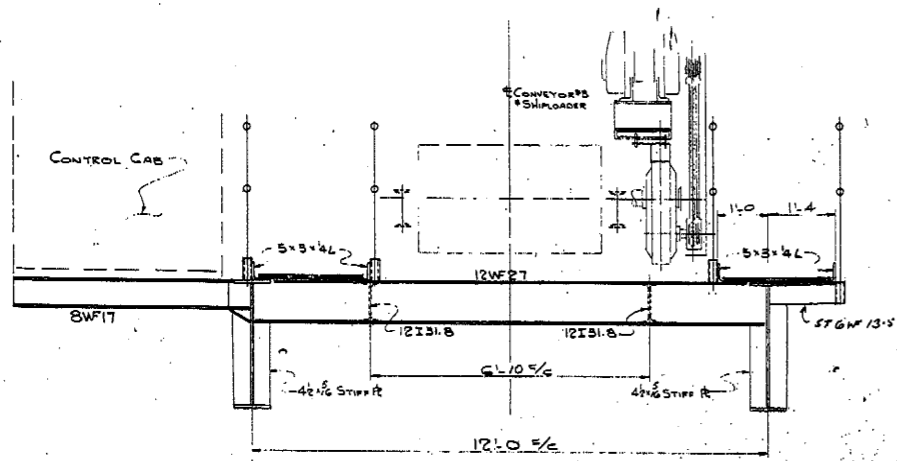


SECTION C  
Scale: 1/2" = 1'-0"

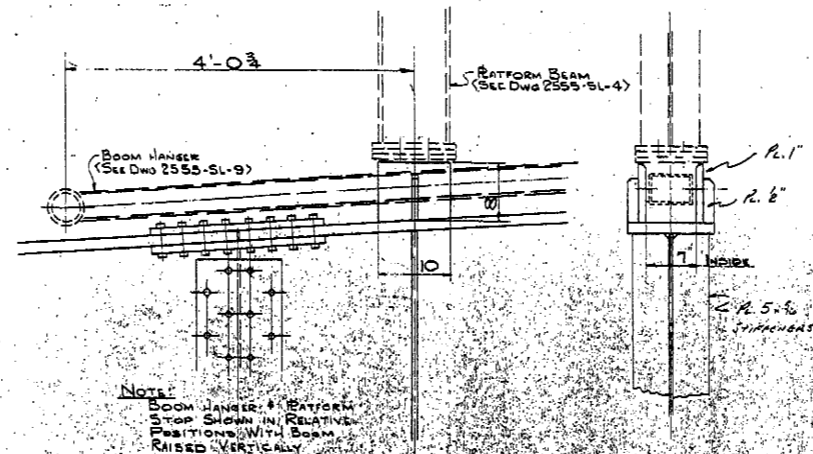


SECTION F  
Scale: 1/2" = 1'-0"

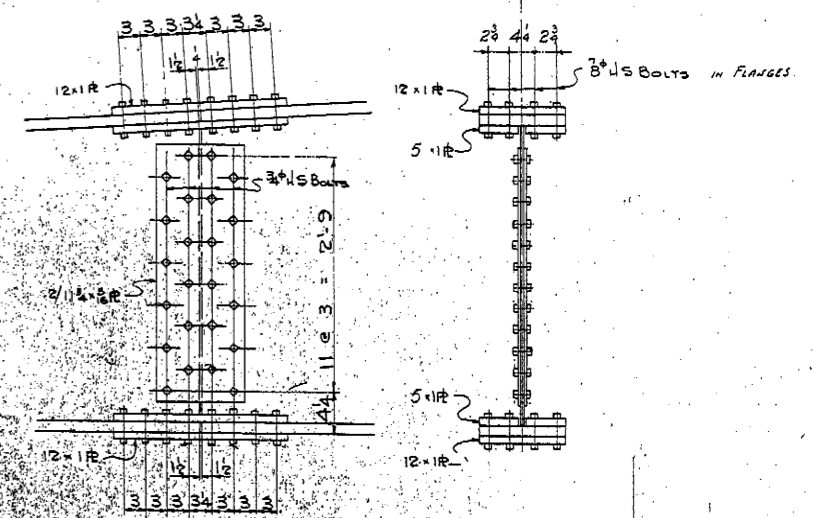


DETAIL M  
Scale: 1/2" = 1'-0"

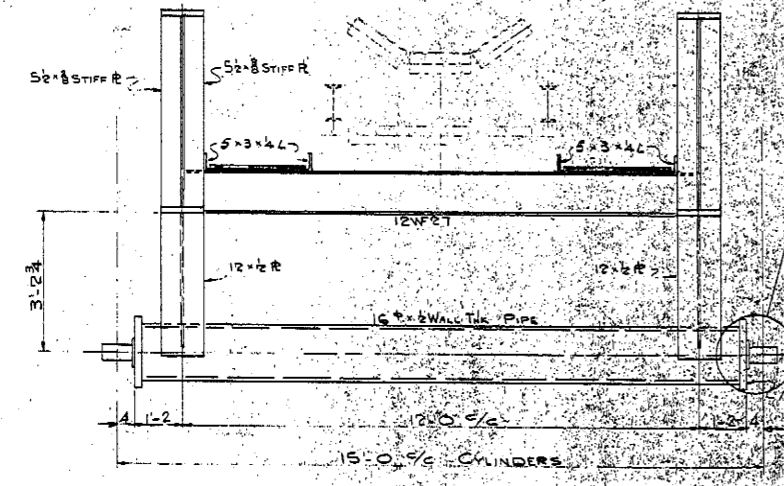


SECTION D  
Scale: 1/2" = 1'-0"

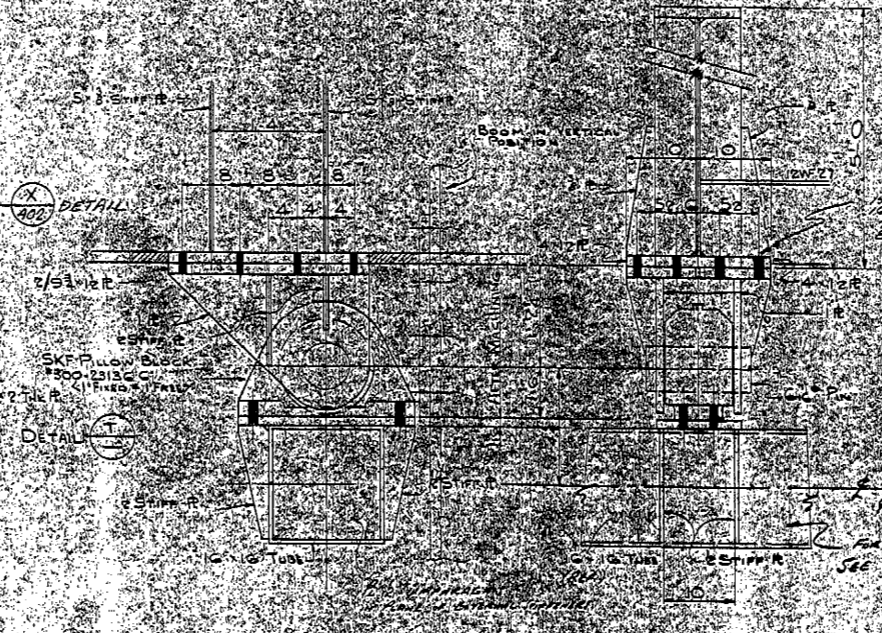


SECTION G  
Scale: 1/2" = 1'-0"

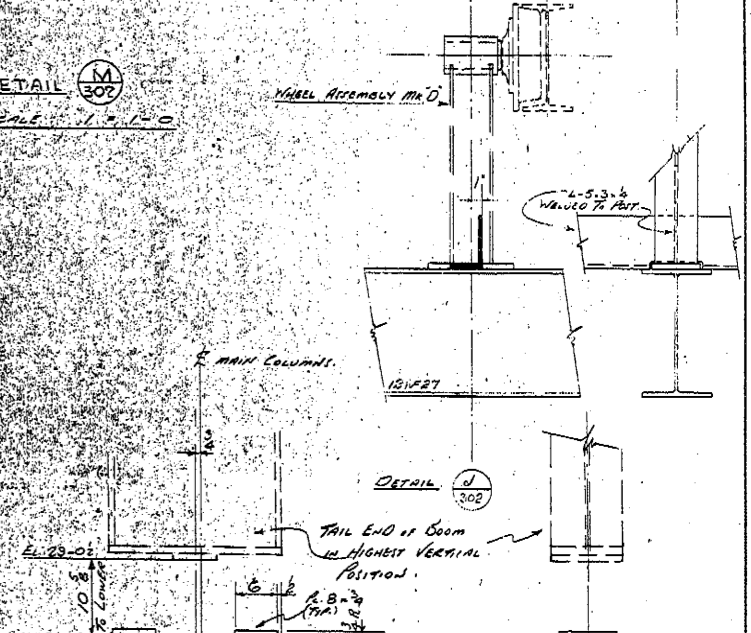


DETAIL J  
Scale: 1/2" = 1'-0"

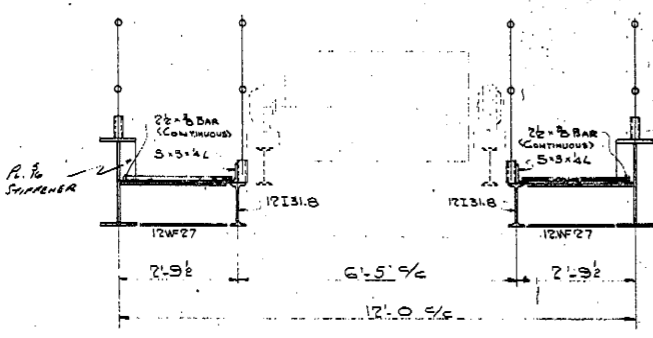


SECTION E  
Scale: 1/2" = 1'-0"

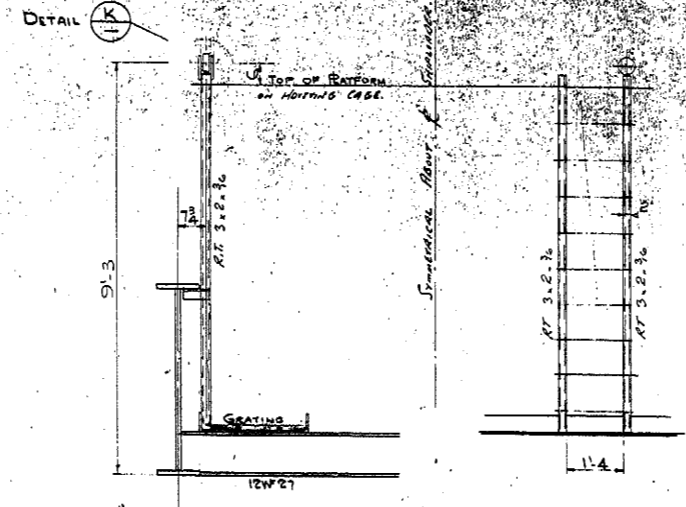

SECTION H  
Scale: 1/2" = 1'-0"




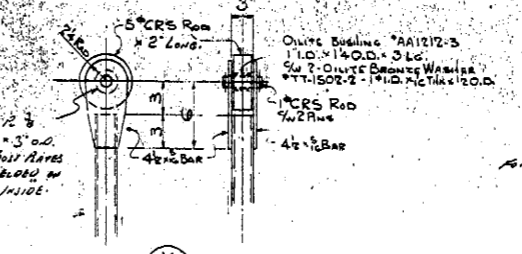


DETAIL K  
Scale: 1/2" = 1'-0"

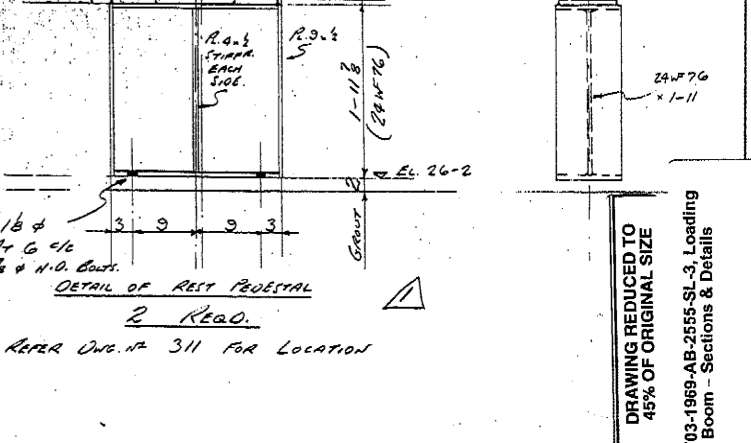

DETAIL L  
Scale: 1/2" = 1'-0"

	PREPARED BY: <b>WRIGHT ENGINEERS LIMITED</b> VANCOUVER - CANADA	PACIFIC AND ARCTIC RAILWAY AND NAVIGATION COMPANY <b>ORE HANDLING TERMINAL -- PHASE II</b> SKAGWAY ALASKA
	REFERENCE: 1528 480 303	TIPPETTS - ABBETT - MCCARTHY - STRATTON ENGINEERS AND ARCHITECTS Seattle New York
DRAWING REDUCED TO 45% OF ORIGINAL SIZE SOT03-1969-AB-2555-SL-3, Loading Boom - Sections & Details		DRAWN BY G. QUAN DATE AUG. - 68 12/16/2013

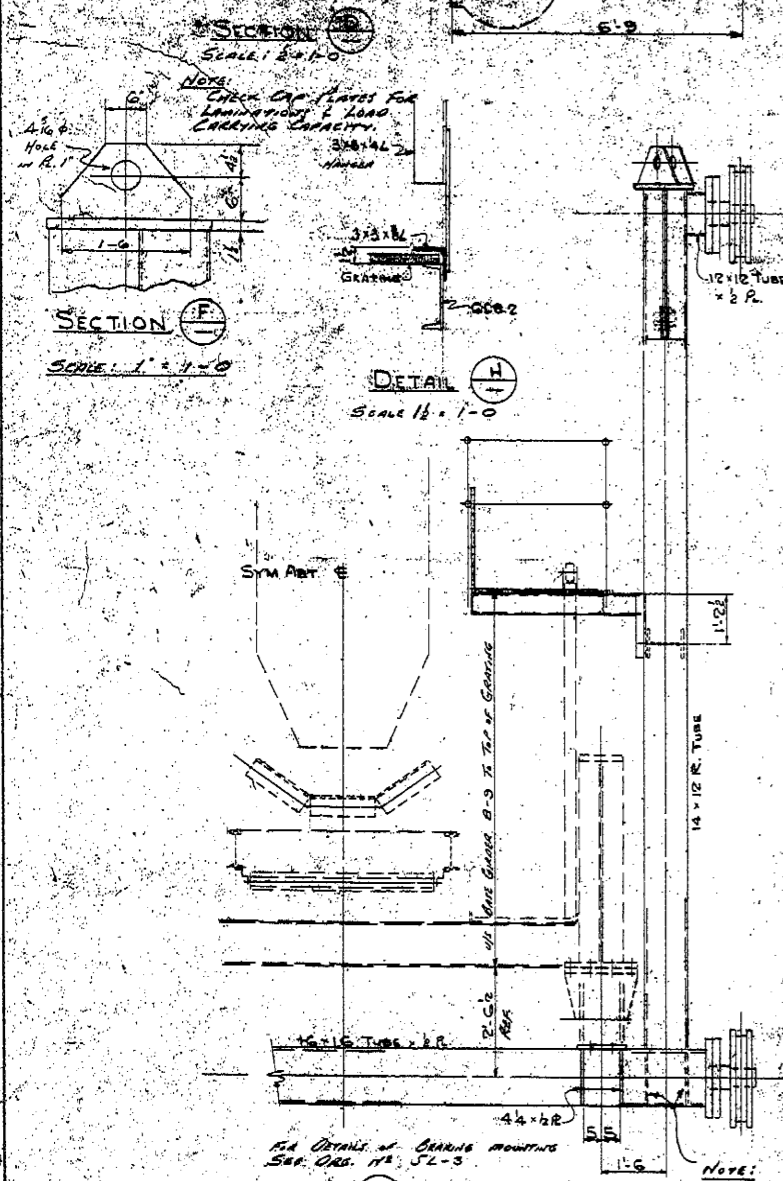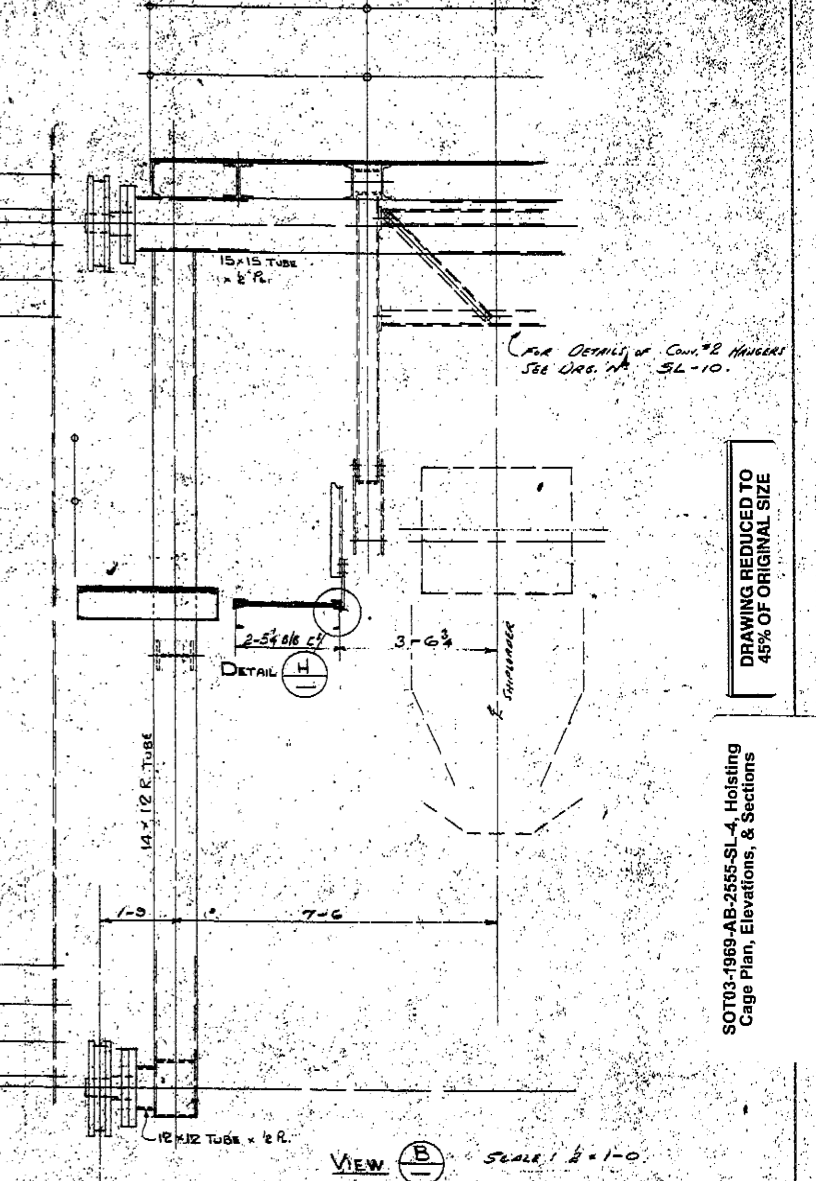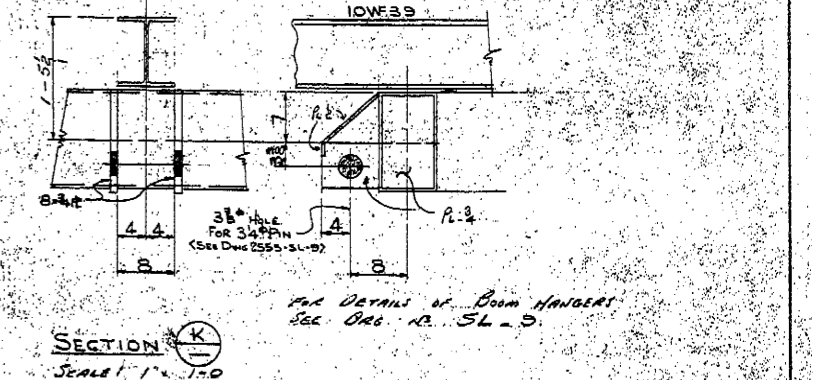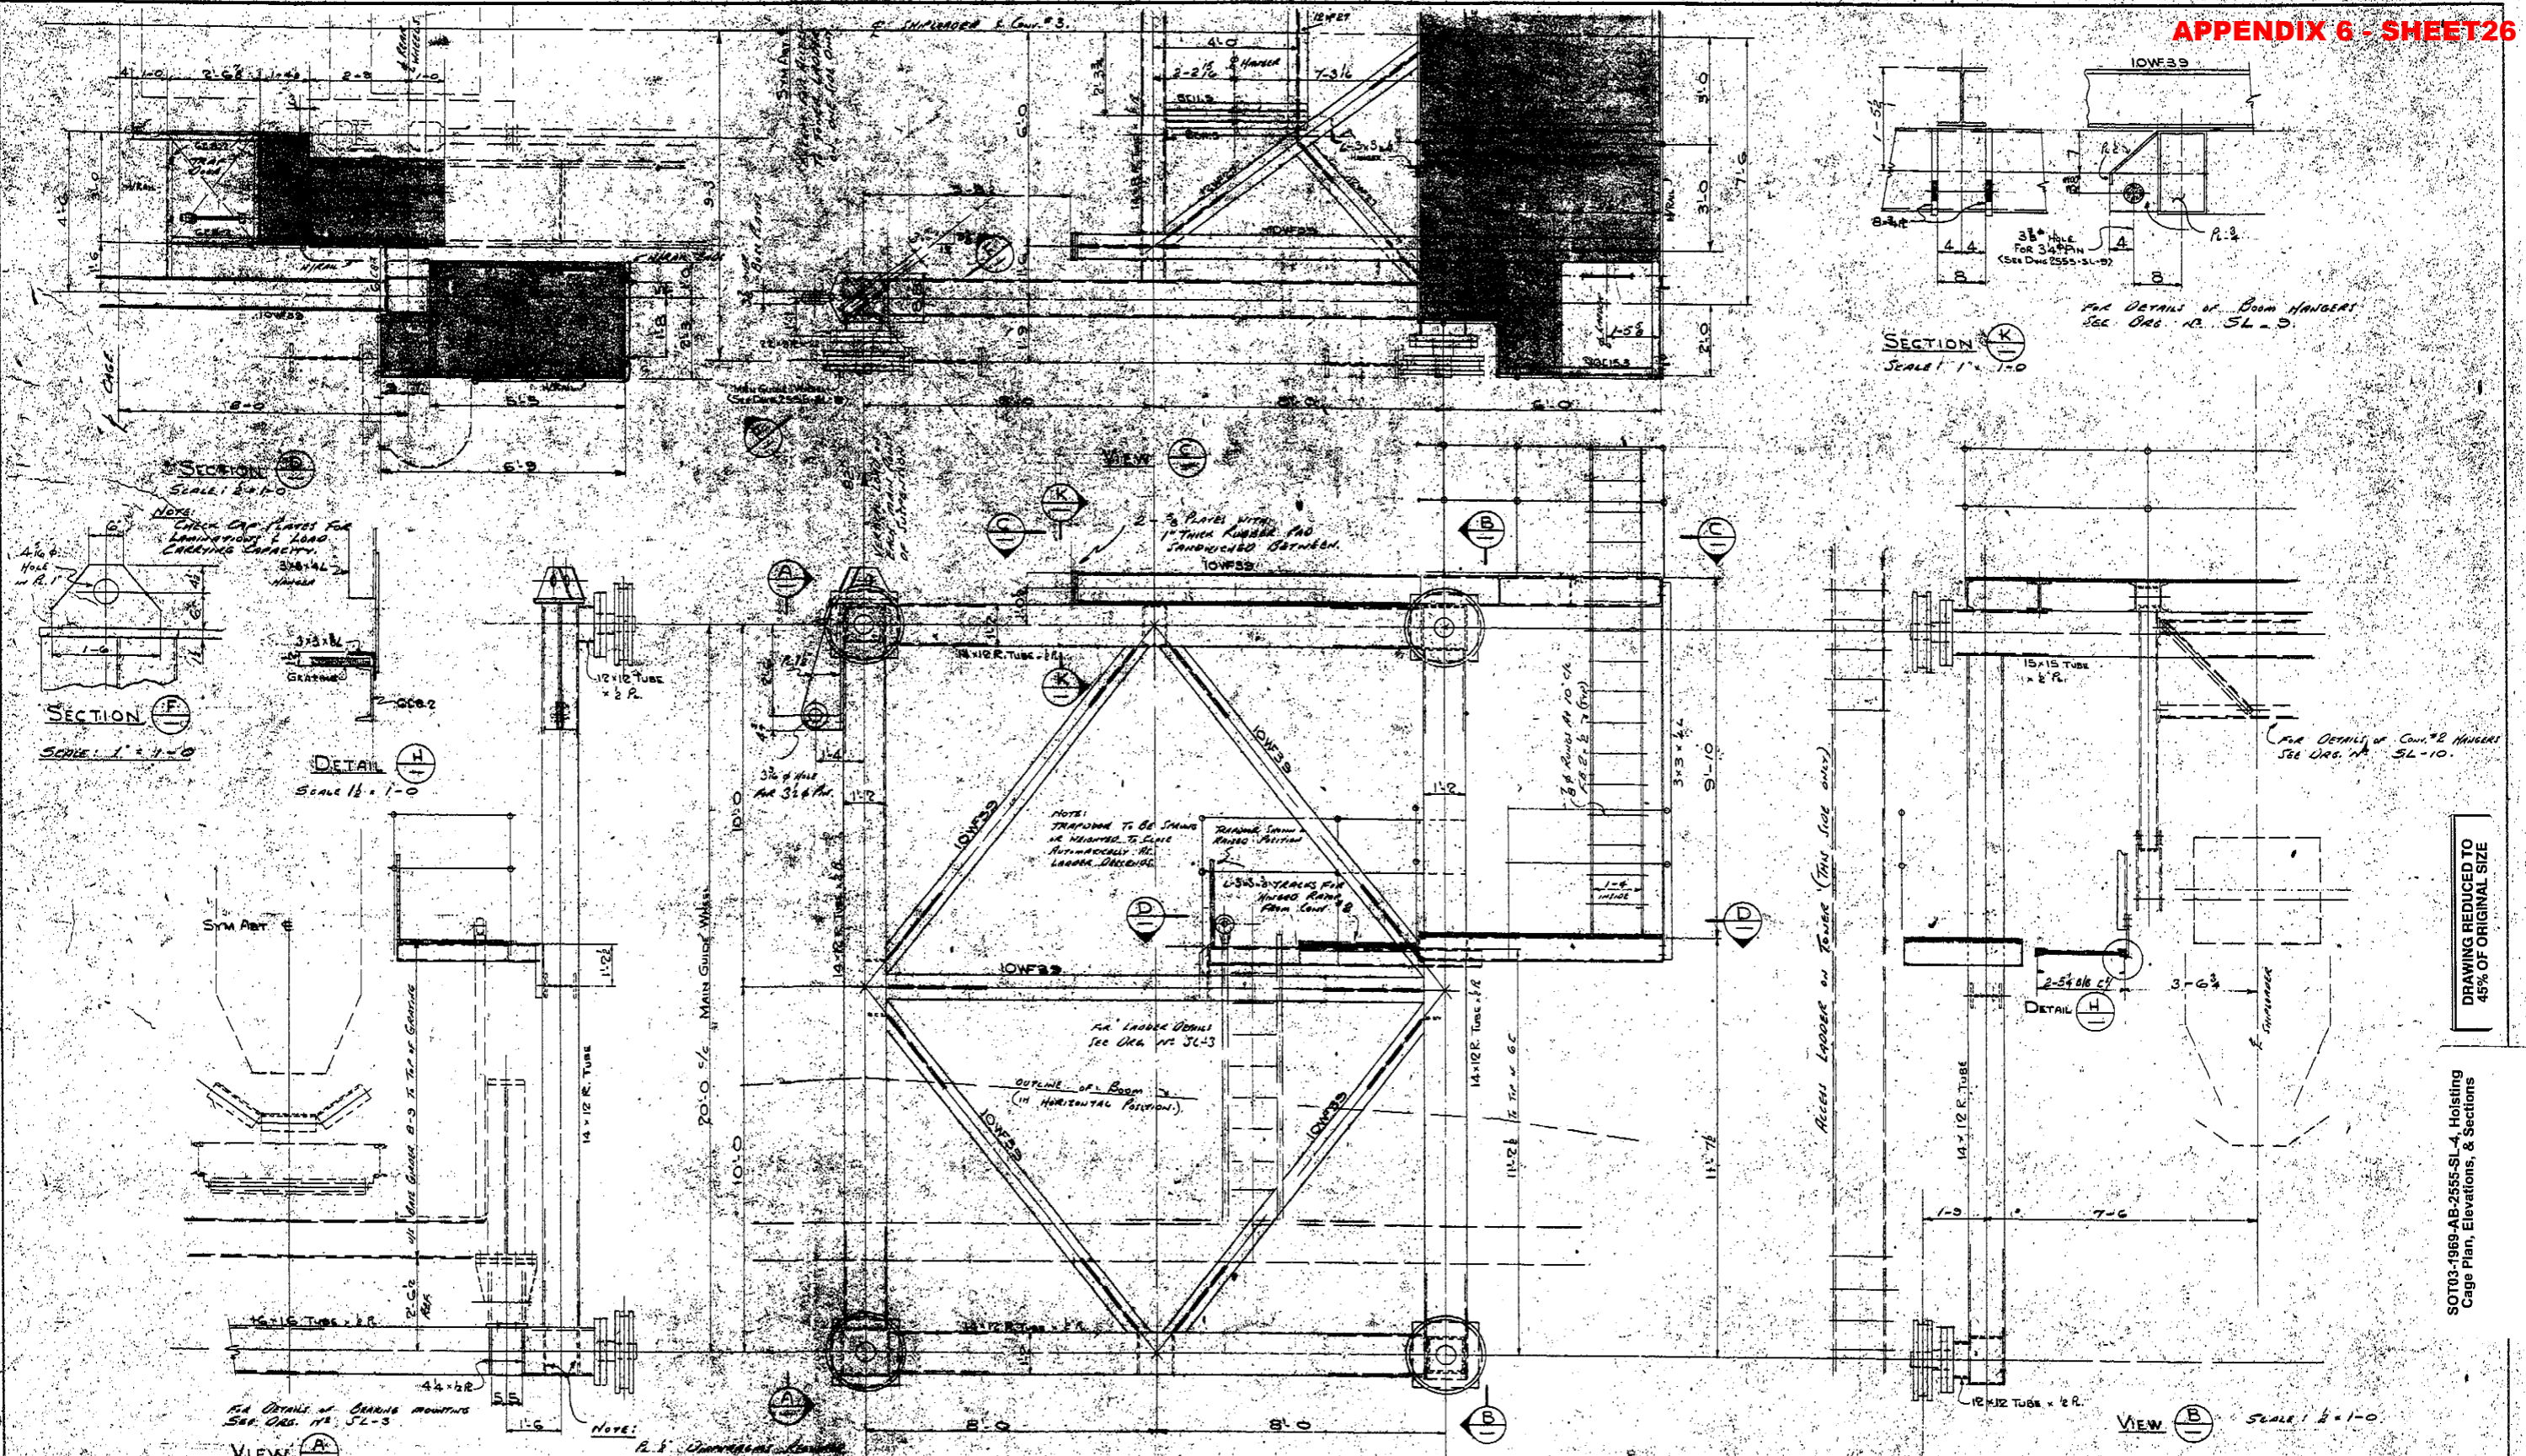

NOTE: R. & Dimensions Here 1" = 1'-0" unless otherwise indicated. See Section 1A of Drawing.

SCALE: 1/2" = 1'-0"

Notes: All dimensions given for reference. See outside dimensions.





- W/RAIL: Fixed
- RAILS: 1/4" SCH 40 PIPE
- POSTS: 1/4" SCH 40 PIPE
- SOCKETS: 2" SCH 80 PIPE
- WHEELS: GRAY IRON (1/2" DIA.)

ESTIMATED WEIGHT OF STRUCTURAL STEELWORK ON THIS DEG. (EXCLUDING WHEELS) 34,000

<p>PREPARED BY: <b>WRIGHT ENGINEERS LIMITED</b> VANCOUVER - CANADA</p> <p>REFERENCE: 528 1480 304</p>	<p>PACIFIC AND ARCTIC RAILWAY AND NAVIGATION COMPANY <b>ORE HANDLING TERMINAL -- PHASE II</b></p>	
	<p>ALASKA SKAGWAY</p>	<p>TIPPETTS - ABBETT - MCCARTHY - STRATTON ENGINEERS AND ARCHITECTS Seattle New York</p>
<p>SHIPLOADER HOISTING CAGE PLAN, ELEVATIONS, &amp; SECTIONS</p>		<p>DRAWN BY G. GUAN DATE AUG - 68 SCALE AS NOTED DRAWING NUMBER 2555-SI-4</p>

DRAWING REDUCED TO 45% OF ORIGINAL SIZE


SOT03-1989-AB-2555-SI-4 Hoisting Cage Plan, Elevations, & Sections

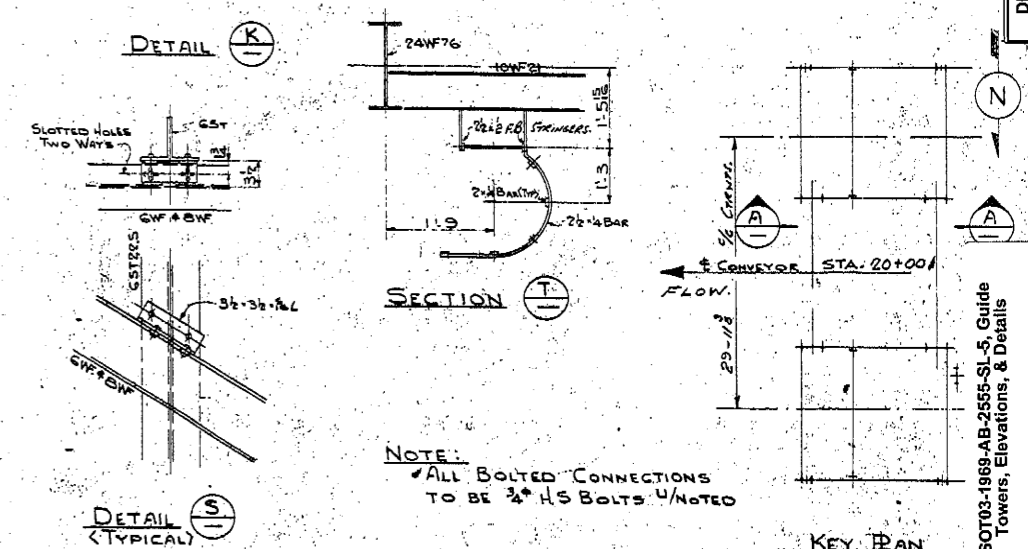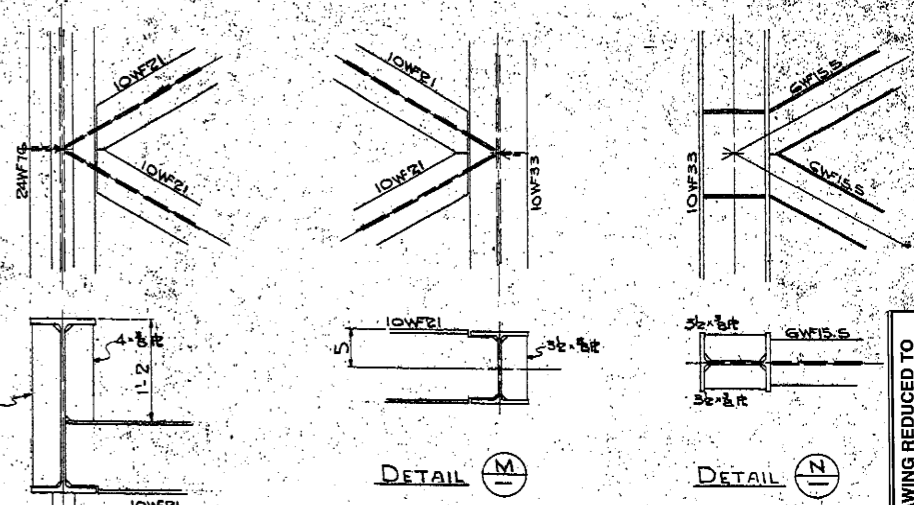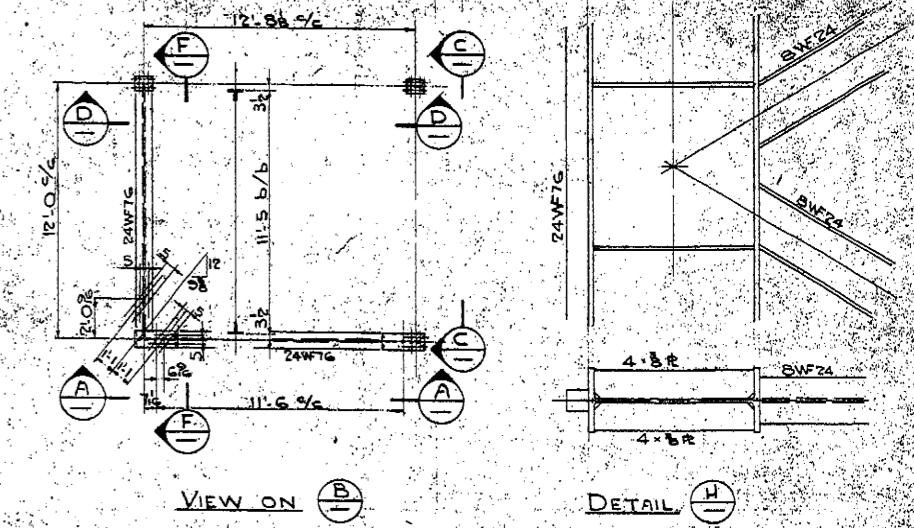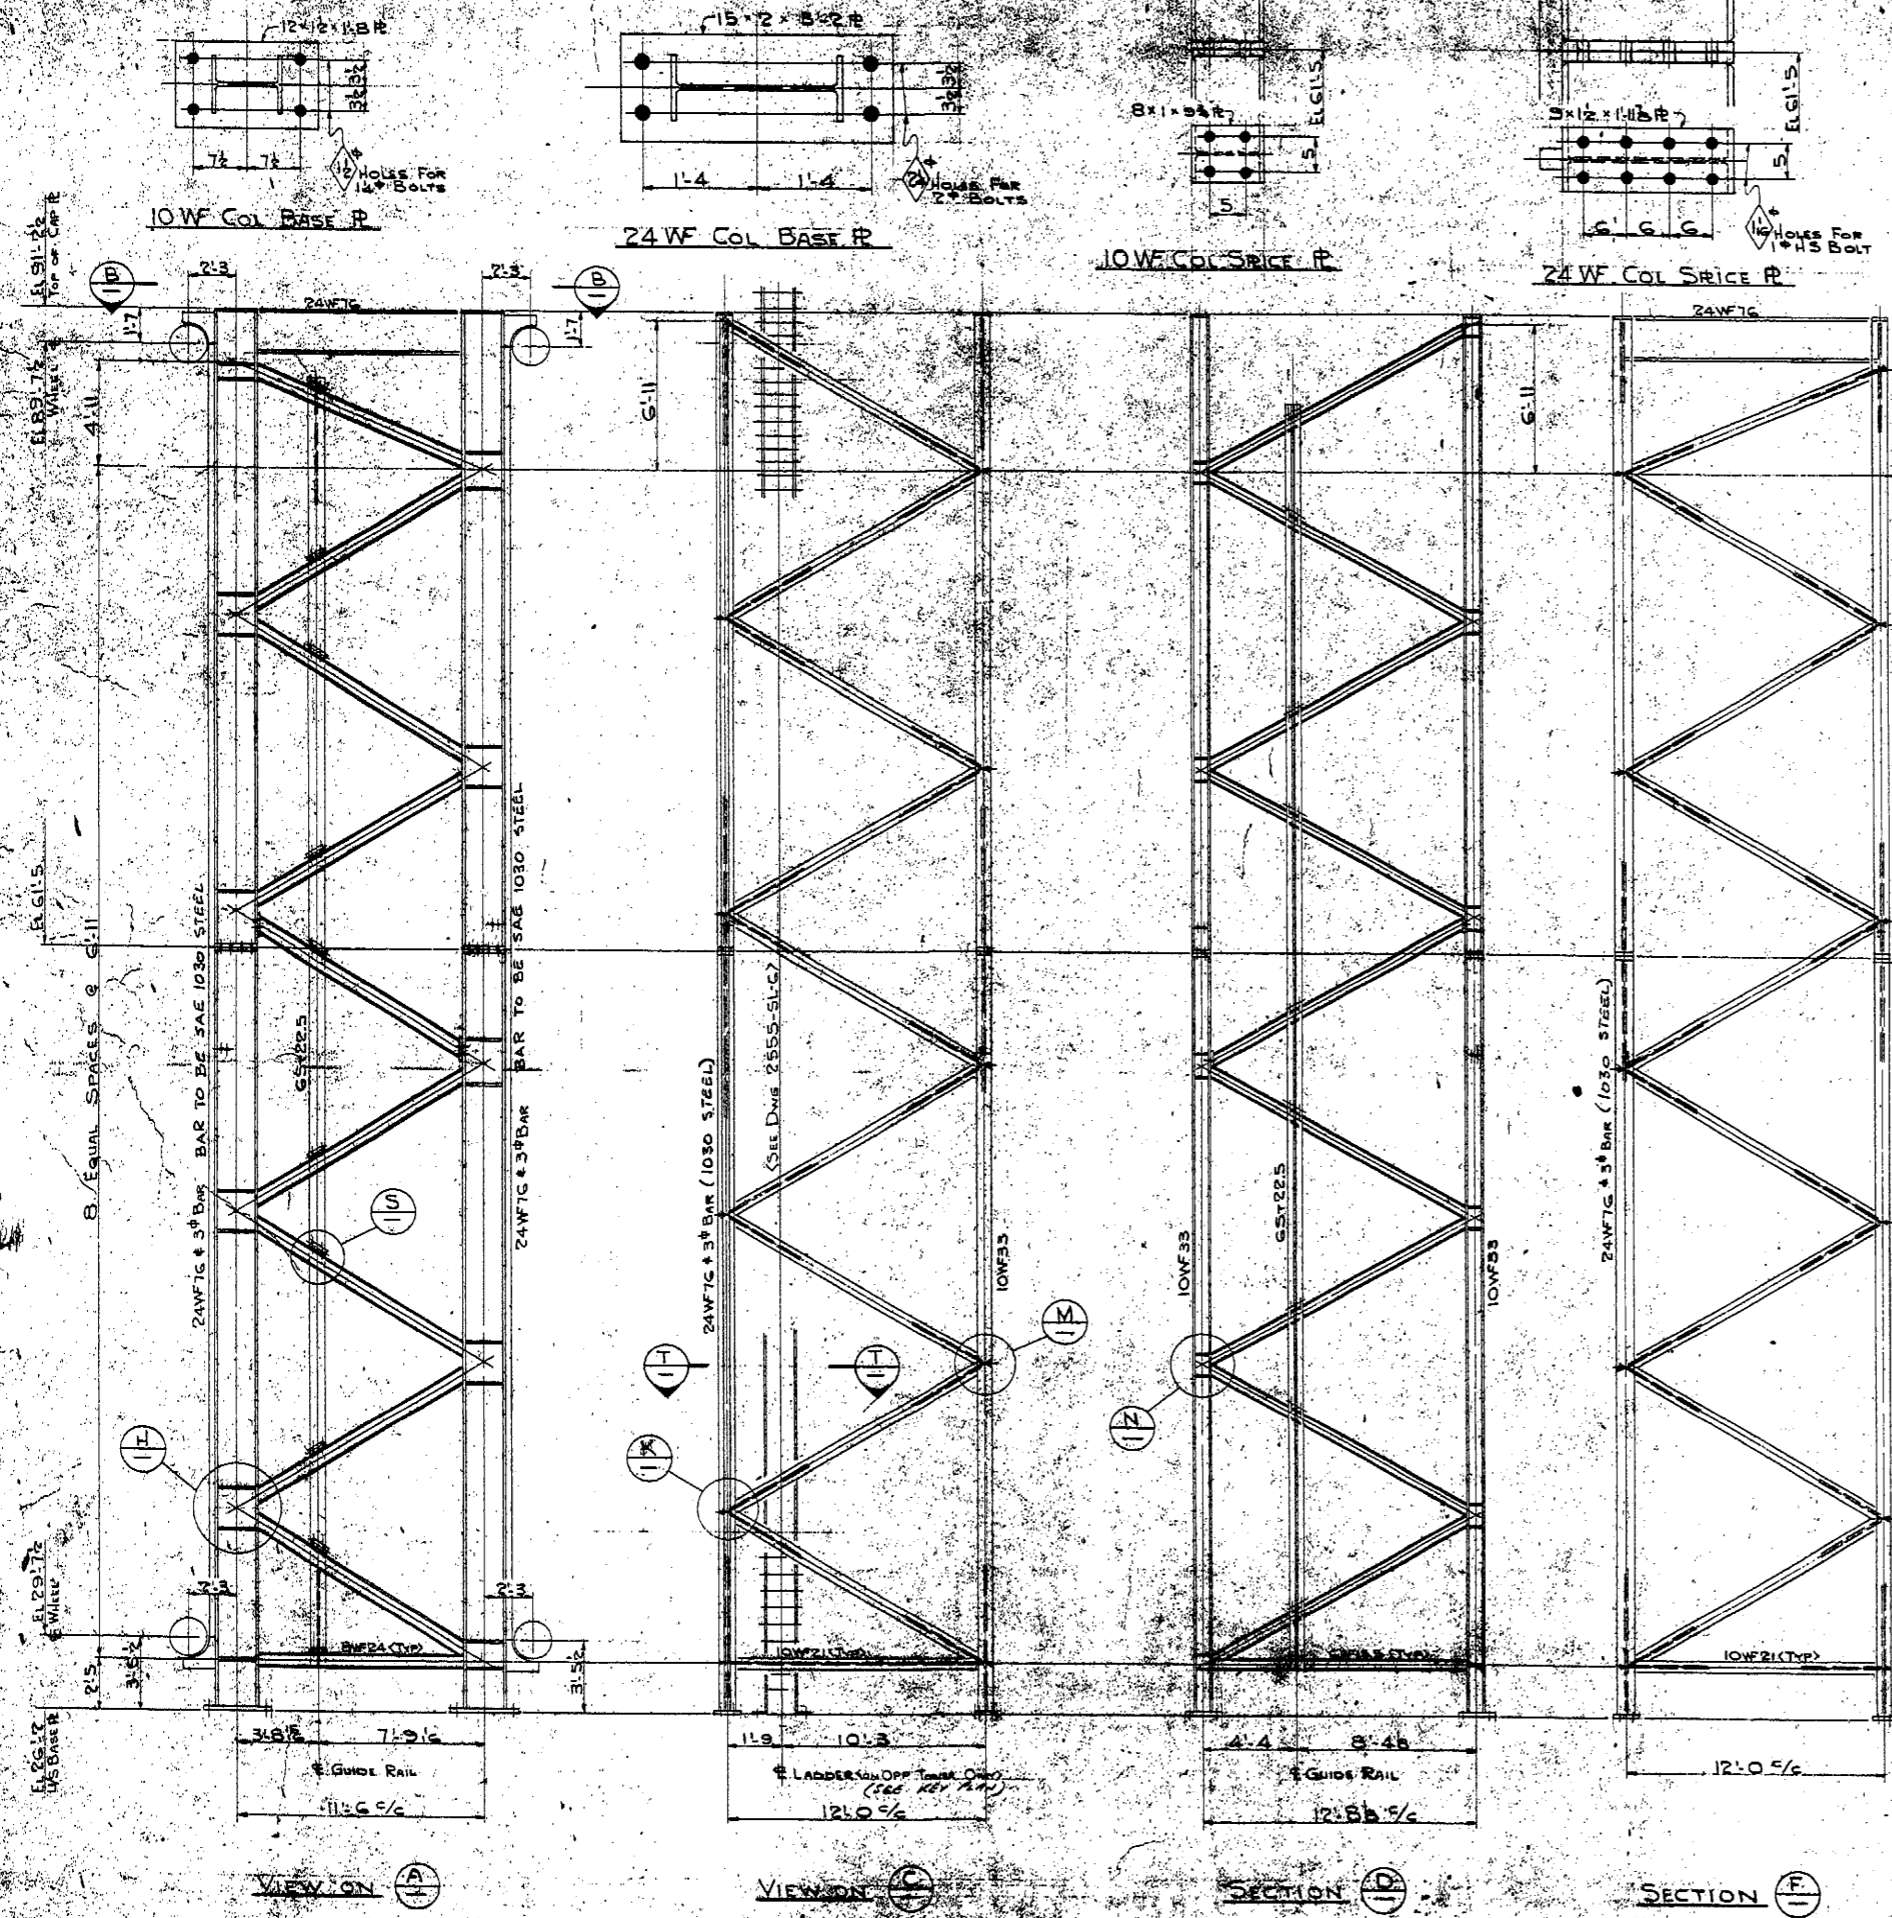


NOTE: ALL BOLTED CONNECTIONS TO BE 3/4\"/>

ESTIMATED STEELWORK FOR GUIDE TOWERS: 75,000 LBS.

	PREPARED BY: <b>WRIGHT ENGINEERS LIMITED</b> VANCOUVER - CANADA	PACIFIC AND ARCTIC RAILWAY AND NAVIGATION COMPANY <b>ORE HANDLING TERMINAL - PHASE II</b> SKAGWAY ALASKA
	REFERENCE: <b>528 480 305</b>	TIPPETTS - ABBETT - McARTHUR - STRATTON ENGINEERS AND ARCHITECTS Seattle New York
DRAWN BY: <b>G. QUAN</b> DATE: <b>AUG. 68</b>		<b>SHIPLOADER</b> GUIDE TOWERS, ELEVATIONS & DETAILS

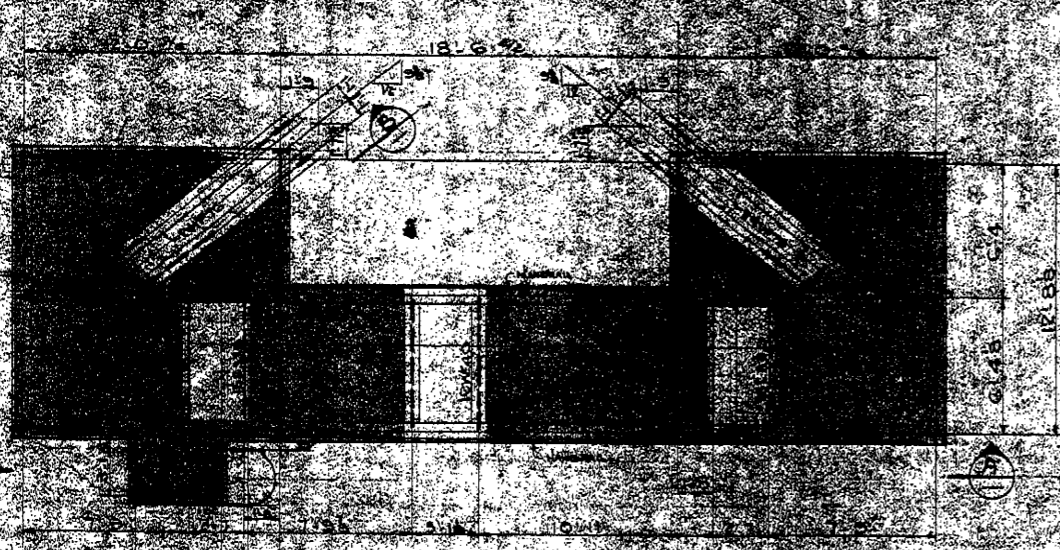




TOP OF STEEL - E. 93.73  
SCALE 3/4" = 1'-0"

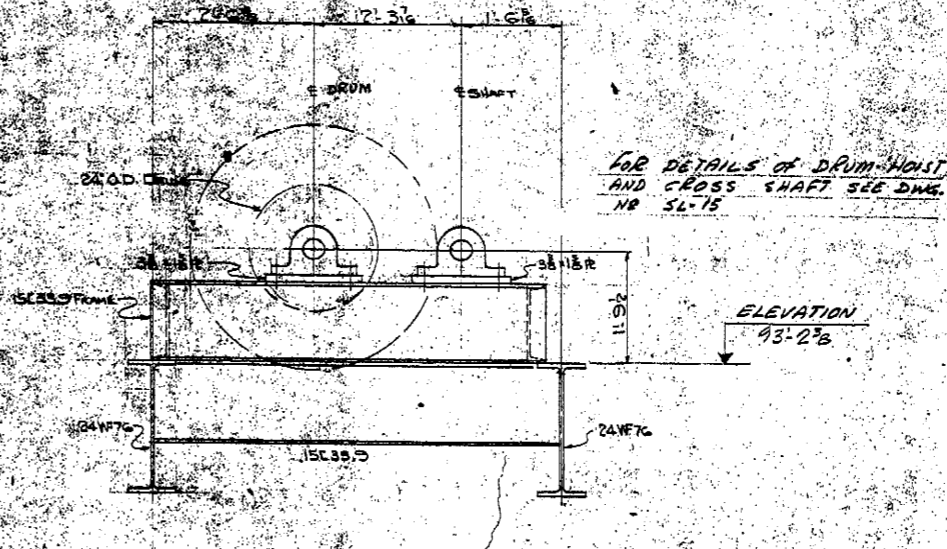

FOR DETAILS OF DRUM HOIST AND CROSS SHAFT SEE DWG. NO. SL-15

ELEVATION 93.28

SECTION C SCALE 3/8" = 1'-0"

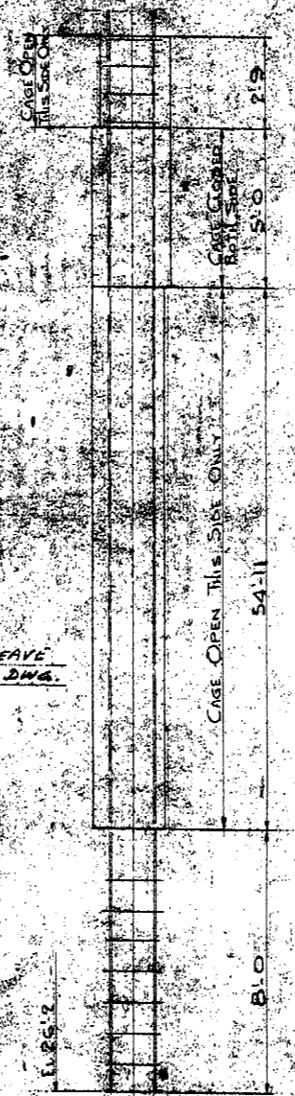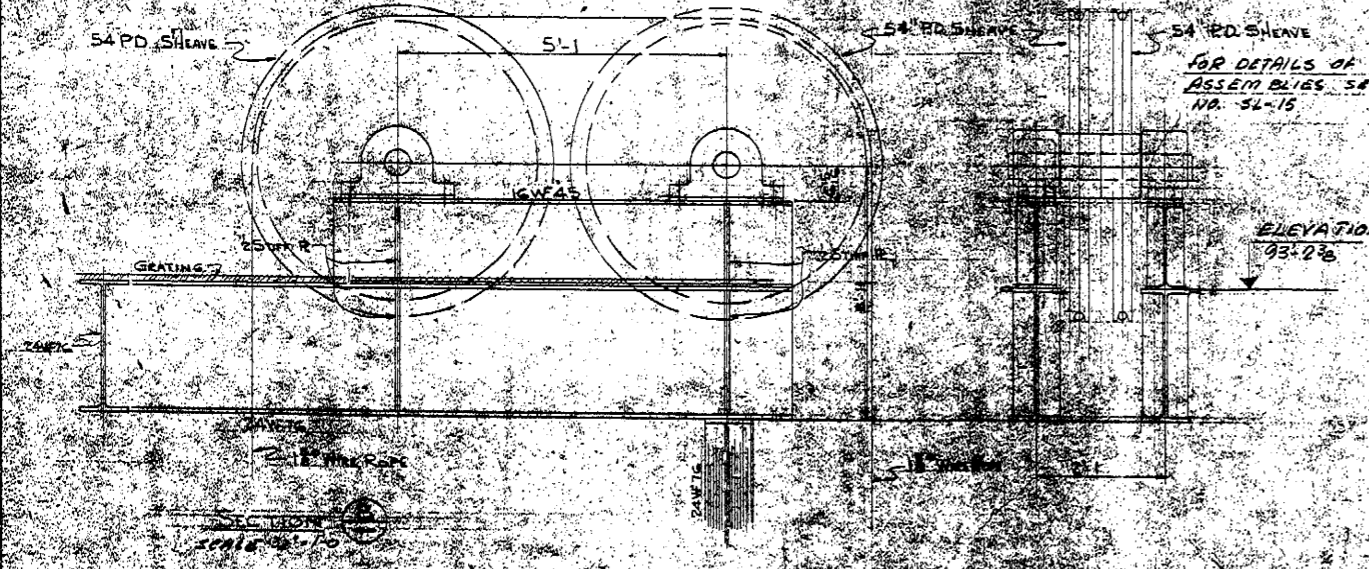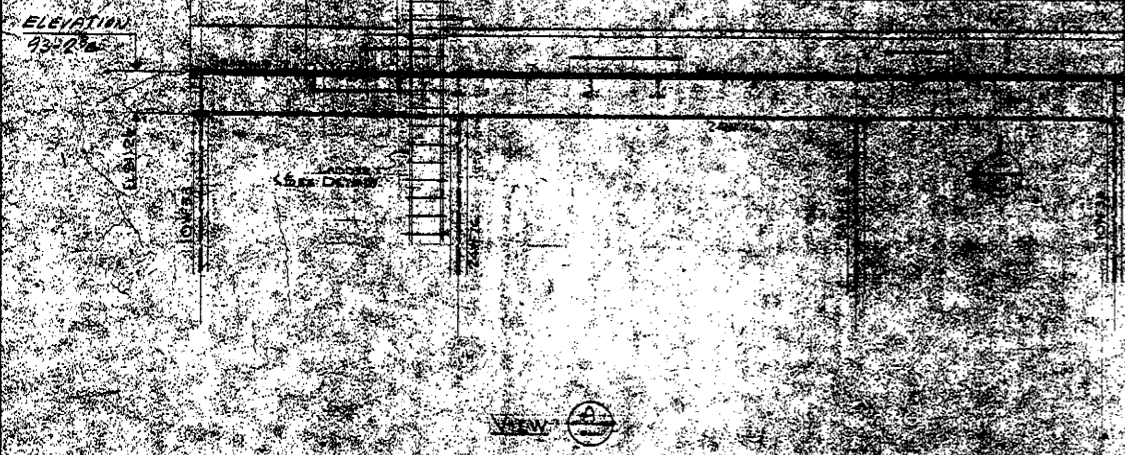


LADDER CASE DETAIL

NOTE:  
HANDRAIL - FIXED  
SOCKETS - 2" SCH 80 PIPE x 6  
POSTS - 12" SCH 40 PIPE  
RAILS - 1 1/2" SCH 40 PIPE  
■ DENOTES GRATING WC-19-4 (12" x 82)


	PREPARED BY <b>WRIGHT ENGINEERS LIMITED</b> VANCOUVER - CANADA	PACIFIC AND ARCTIC RAILWAY AND NAVIGATION COMPANY <b>ORE HANDLING TERMINAL - PHASE II</b> SKAGWAY - ALASKA
	REFERENCED: <b>528 480 306</b>	<b>TIPPETTS - ABBETT - MCCARTHY - STRATTON</b> ENGINEERS AND ARCHITECTS Seattle - New York
	DRAWN BY G. QUAN DATE: AUG 68 SCALE: AS SHOWN	<b>SHIPLOADER</b> <b>HOISTING BRIDGE</b> <b>PLAN &amp; SECTIONS</b>

DRAWING REDUCED TO 45% OF ORIGINAL SIZE

SOT03-1985-AB-2555-SL-6, Hoisting Bridge Plan & Sections

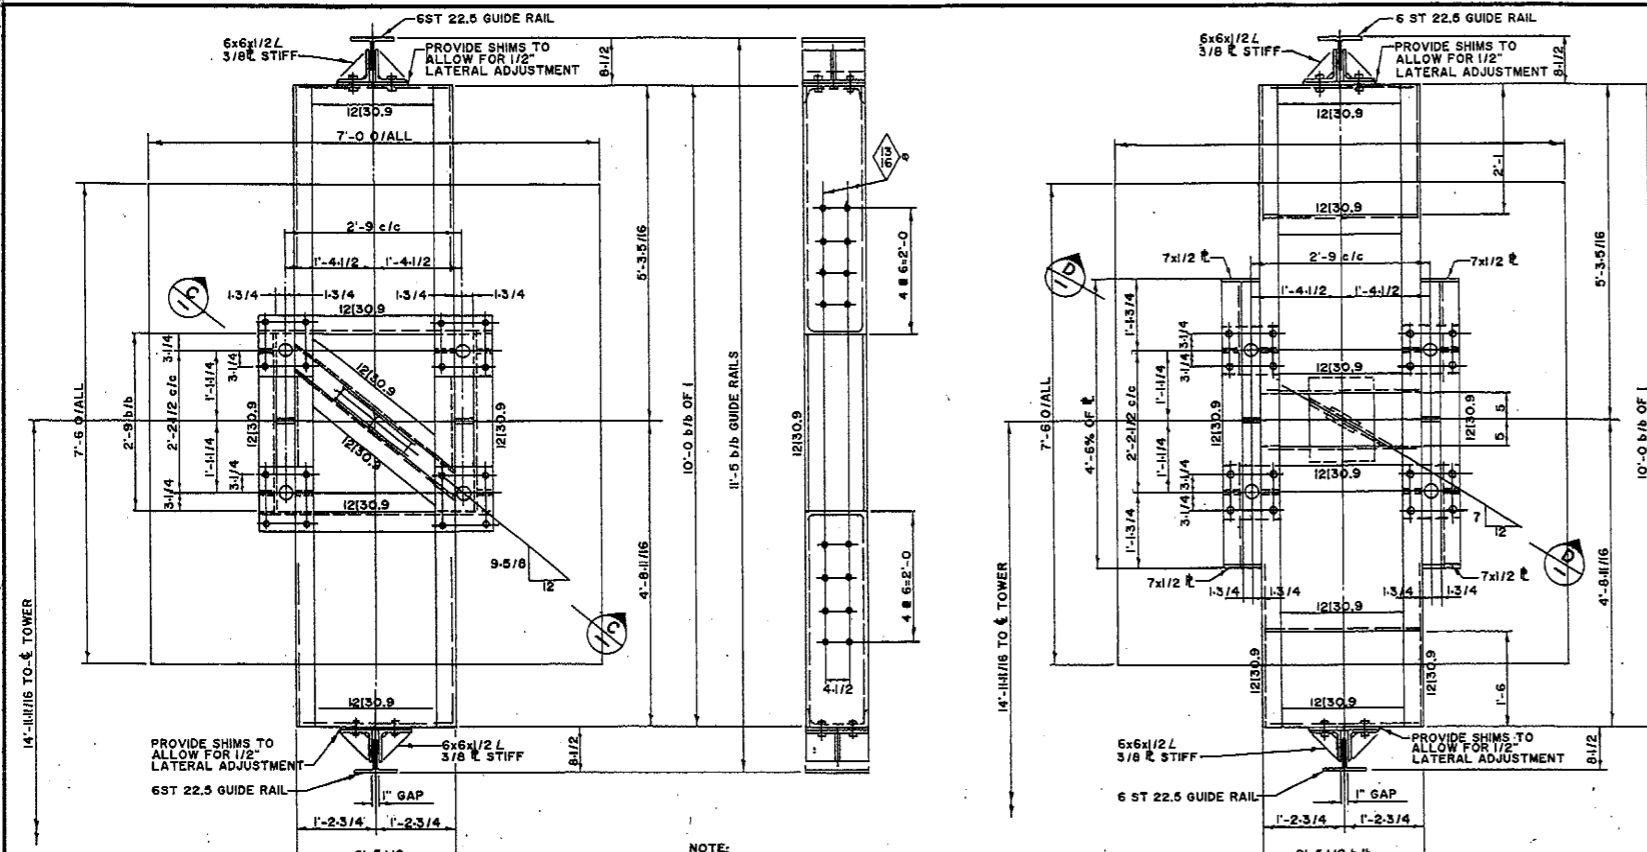


NOTE:  
THE CENTRE OF GRAVITY OF ALL SLABS SHALL COINCIDE WITH THE GEOMETRICAL C. OF G. TO ELIMINATE BINDING OF COUNTERWEIGHT FRAMES IN GUIDES. WEIGHT OF EACH SLAB TO BE 7,600 LBS.

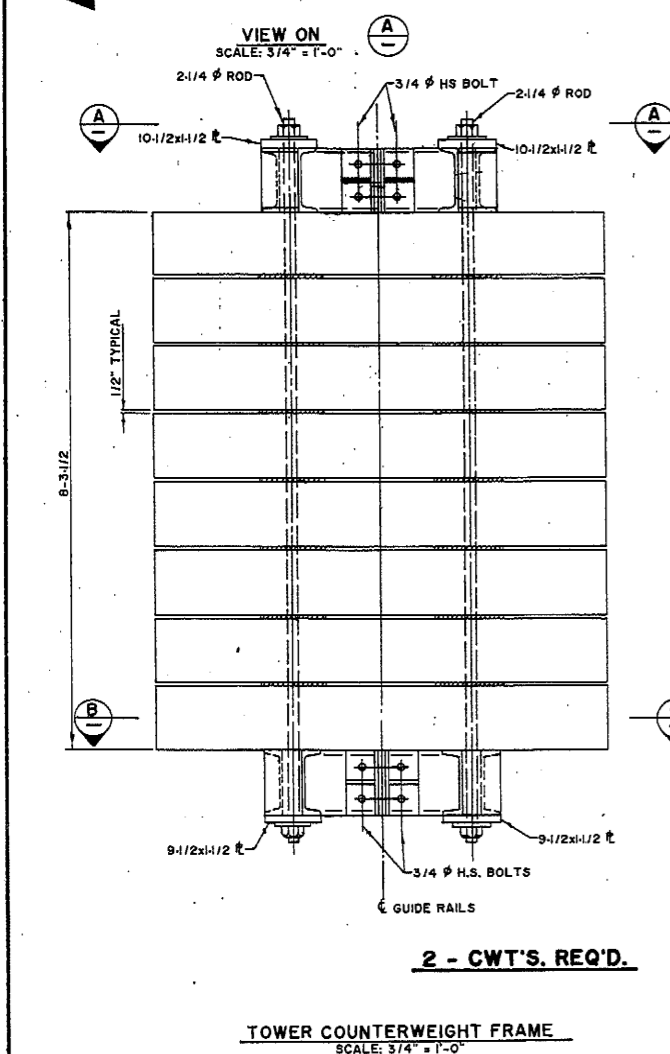


2 - CWT'S. REQ'D.

TOWER COUNTERWEIGHT FRAME  
SCALE: 3/4" = 1'-0"

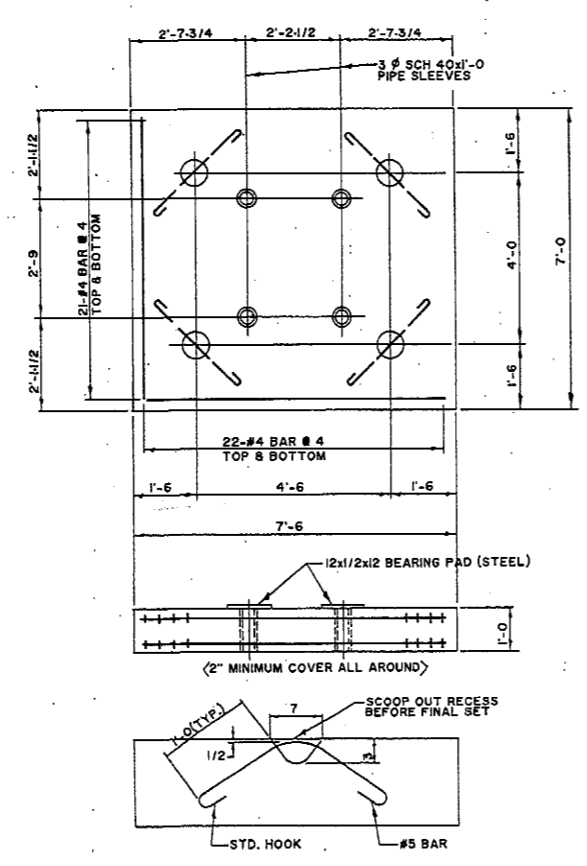


DETAIL OF LIFTING BAR

TOWER COUNTERWEIGHT  
DETAIL OF TYPICAL SLAB  
SCALE: 1/2" = 1'-0"

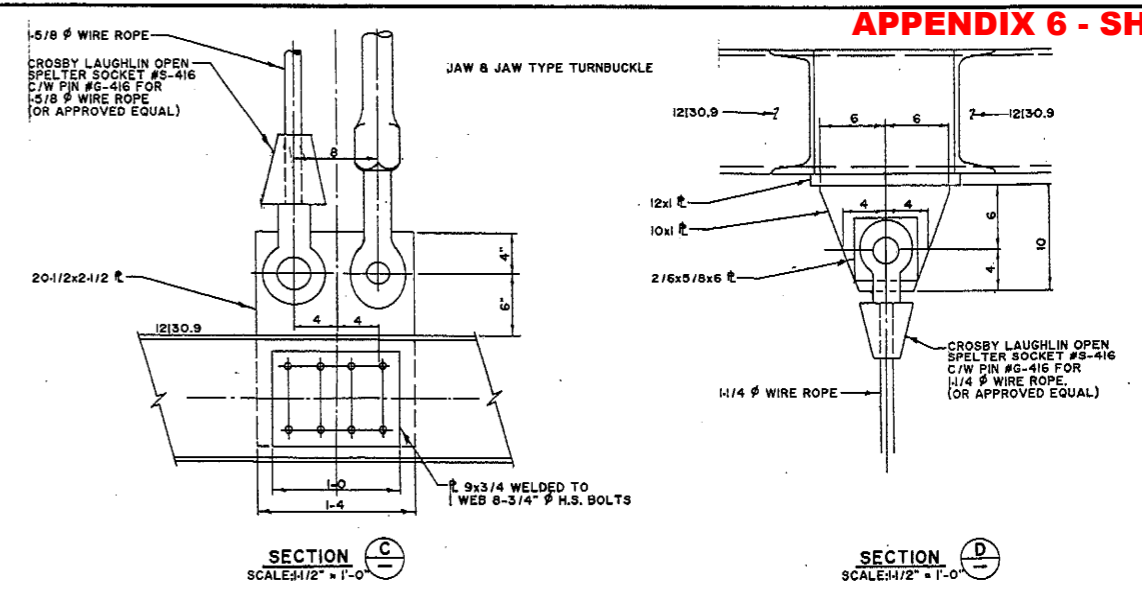

SECTION C  
SCALE: 3/4" = 1'-0"

SECTION D  
SCALE: 1/2" = 1'-0"

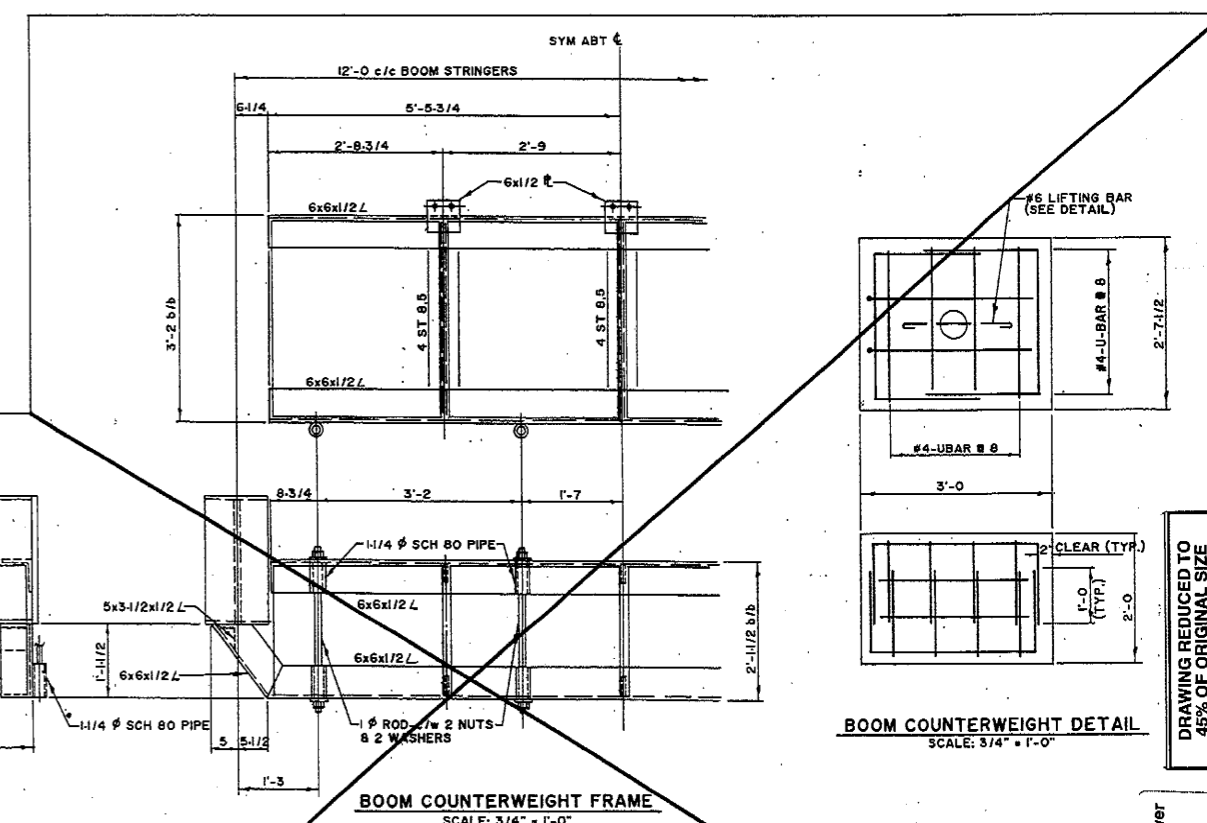

BOOM COUNTERWEIGHT FRAME  
SCALE: 3/4" = 1'-0"

BOOM COUNTERWEIGHT DETAIL  
SCALE: 3/4" = 1'-0"

BOOM CWT.  
NOT REQ'D.

NOTE:  
ALL BOLTED CONNECTIONS TO BE 7/8\"/>

NOTE:  
THIS DRAWING IS A COPY MADE BY R&M ENGINEERING, INC. OF JUNEAU, ALASKA, TO REPLACE A DRAWING WHICH COULD NOT BE REPRODUCED THAT WAS MADE BY WRIGHT ENGINEERS LIMITED. COPYING APPROVED BY LYNDEN INCORPORATED ON BEHALF OF THEIR CLIENT, CURRAGH RESOURCES.


	PREPARED BY: <b>WRIGHT ENGINEERS LIMITED</b> VANCOUVER CANADA REFERENCE: 528   480   307	PACIFIC AND ARCTIC RAILWAY AND NAVIGATION COMPANY <b>ORE HANDLING TERMINAL -- PHASE II</b> SKAGWAY ALASKA	
	NO. BY DATE REVISION	TIPPETTS - ABBETT - MCCARTHY - STRATTON ENGINEERS AND ARCHITECTS Seattle New York	
DESIGNED BY J.W.H. CHECKED BY		SHIPLOADER GUIDE TOWER & BOOM COUNTERWEIGHT & FRAMES	
DRAWN BY G. QUAN DATE AUG 16 1968 SCALE AS NOTED		12/16/2013	

SOT03-1969-AB-2555-SL-7, Guide Tower & Boom - Counterweight & Frames

DRAWING REDUCED TO 45% OF ORIGINAL SIZE

WHEEL ASSEMBLY MK. A

8- REQ'D

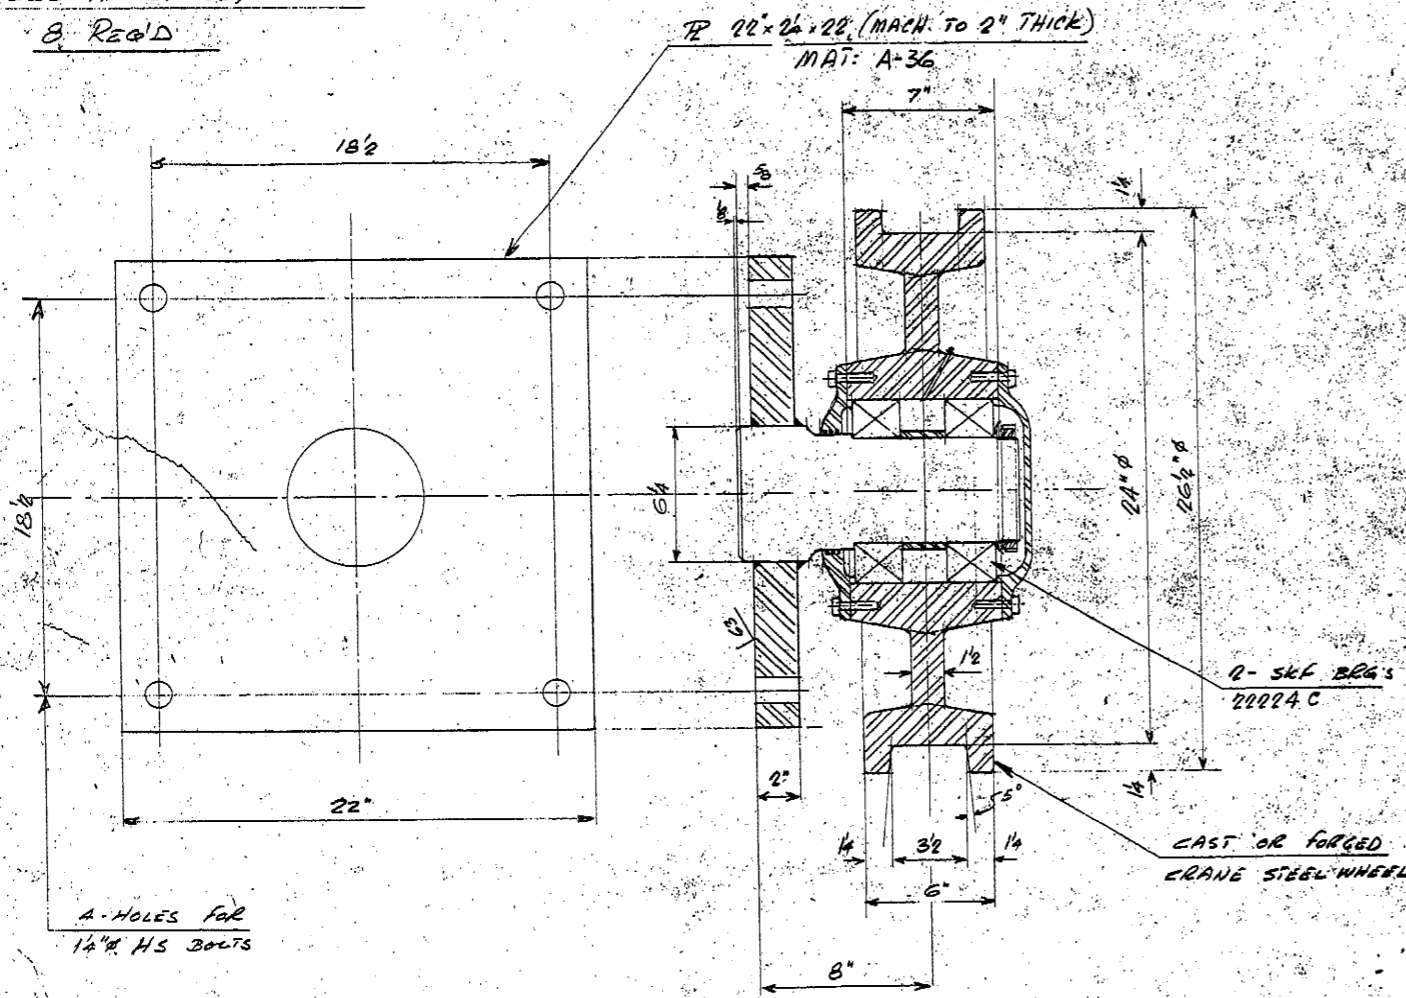


A-HOLES for  
1/2" HS BOLTS

CAST OR FORGED  
CRANE STEEL WHEEL

WHEEL ASSEMBLIES MK. B & C

8- REQ'D

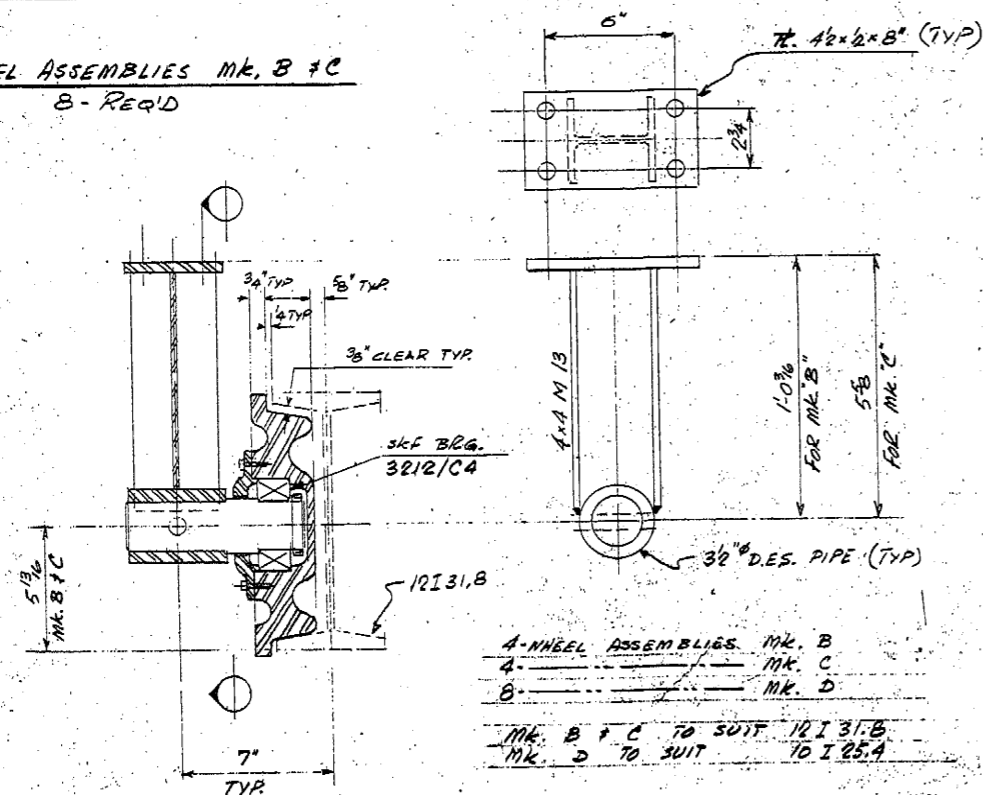


A-WHEEL ASSEMBLIES MK. B  
4- MK. C  
8- MK. D

MK. B & C TO SUIT 12I 31.8  
MK. D TO SUIT 10I 25.4

SHAFT & BRG. ASSEMBLY SAME ON B, C & D

WHEEL ASSEMBLY, MK. D

8- REQ'D

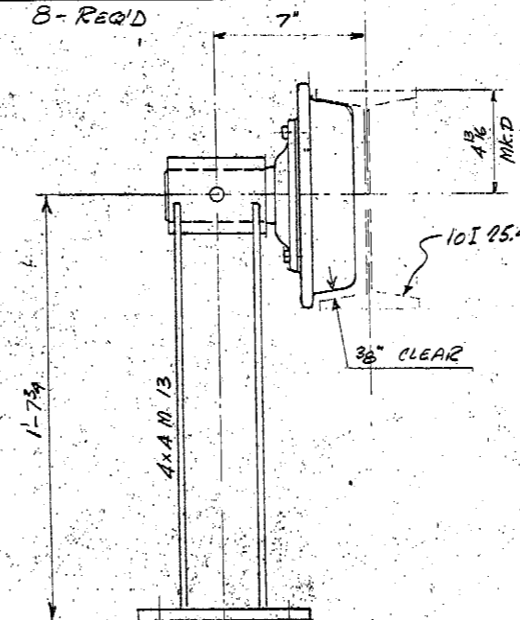


	PREPARED BY: <b>WRIGHT ENGINEERS LIMITED</b> VANCOUVER - CANADA	PACIFIC AND ARCTIC RAILWAY AND NAVIGATION COMPANY <b>ORE HANDLING TERMINAL -- PHASE II</b> SKAGWAY - ALASKA	
	REFERENCE: 52B, 480, 308	TIPPETTS - ABBETT - MCCARTHY - STRATTON ENGINEERS AND ARCHITECTS Seattle - New York	
DRAWN BY: <i>GN</i>		DATE: <i>Aug. 68</i>	
DESIGNED BY: <i>GN</i>		SCALE: 3" = 1'-0"	
CHECKED BY:		WHEEL ASSEMBLIES <b>12-16-2013</b>	
NO.	BY	DATE	REVISION

DRAWING REDUCED TO  
45% OF ORIGINAL SIZE


SOT03-1969-AB-2555-SL-8, Wheel  
Assemblies



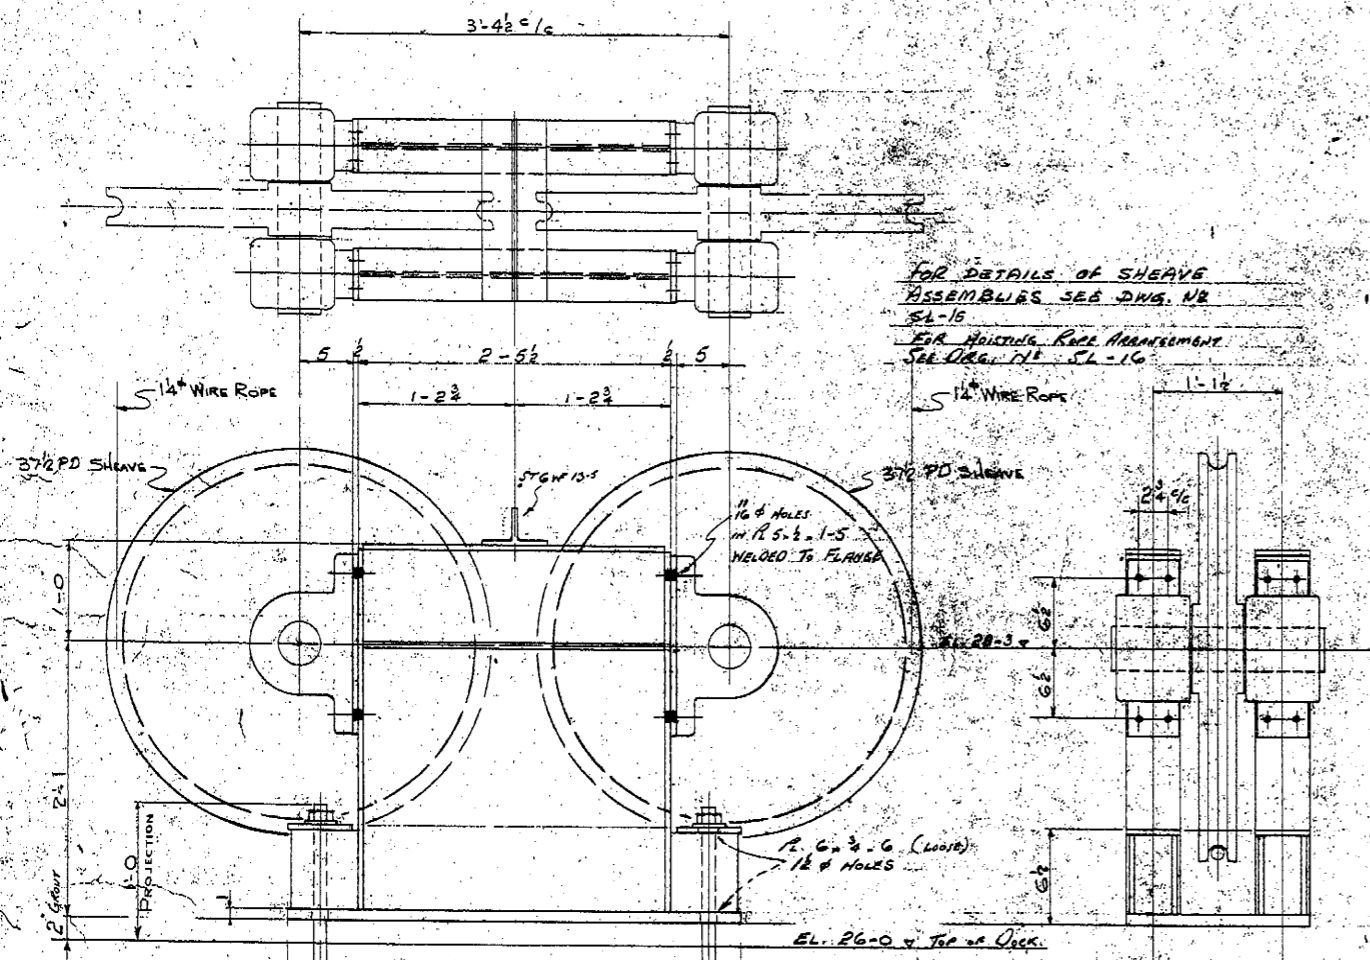


FOR DETAILS OF SHEAVE ASSEMBLIES SEE DWS. NR SL-15 FOR HOISTING RACE ARRANGEMENT SEE DETAIL (A) SL-16


LOWER SHEAVE BRACKET SCALE 1/2" = 1'-0"

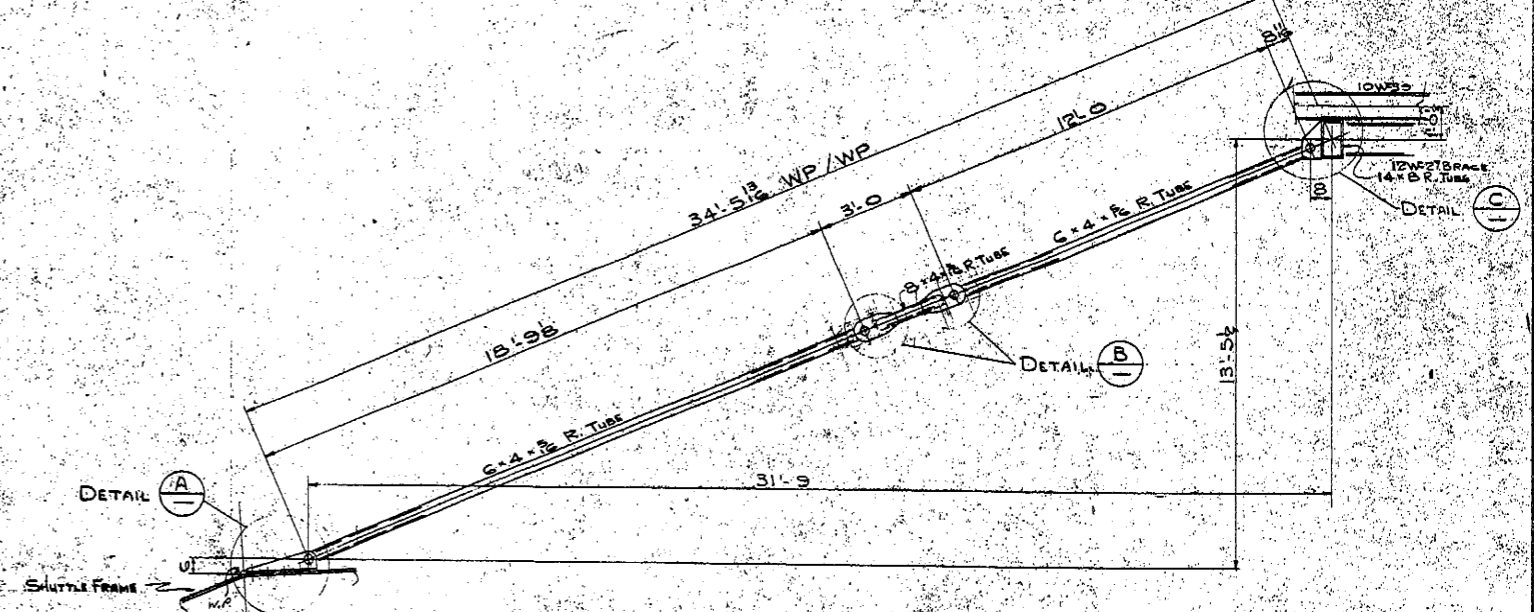


BOOM HANGER SCALE 3/8" = 1'-0"

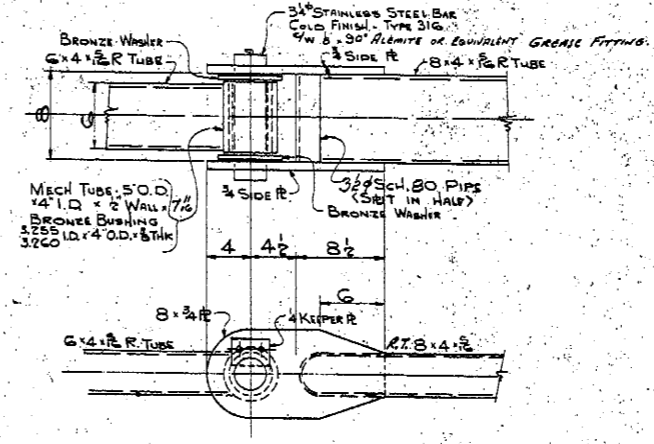

DETAIL (A) SCALE 1/2" = 1'-0"

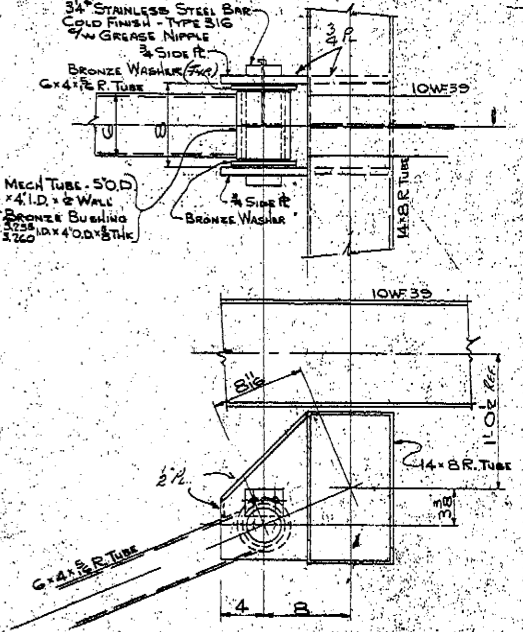










DETAIL (B) SCALE 1/2" = 1'-0"

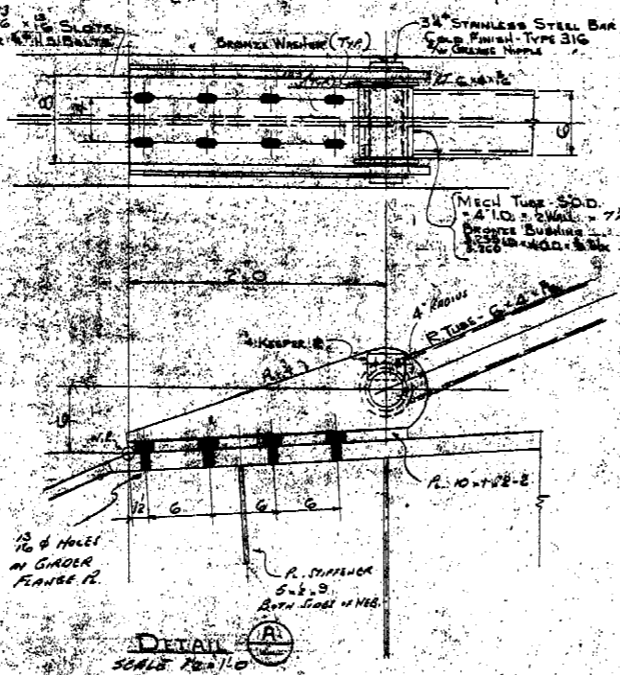

DETAIL (C) SCALE 1/2" = 1'-0"

DRAWING REDUCED TO 45% OF ORIGINAL SIZE  
SOT03-1989-AB-2555-SL-9, Boom Hangers & Lower Sheave Bracket

	PREPARED BY: <b>WRIGHT ENGINEERS LIMITED</b> VANCOUVER CANADA	PACIFIC AND ARCTIC RAILWAY AND NAVIGATION COMPANY <b>ORE HANDLING TERMINAL -- PHASE II</b> SKAGWAY ALASKA
	REFERENCE:	TIPPETTS - ABBETT - McARTHUR - STRATTON ENGINEERS AND ARCHITECTS Seattle New York
DESIGNED BY: <b>d.w.h.</b> CHECKED BY:		DRAWN BY: <b>G. QUAN</b> DATE: <b>AUG-68</b> SCALE: <b>AS NOTED</b> DRAWING NUMBER:
NO. BY DATE REVISION	NO. BY DATE REVISION	SHIPLOADER BOOM HANGERS & LOWER SHEAVE BRACKET

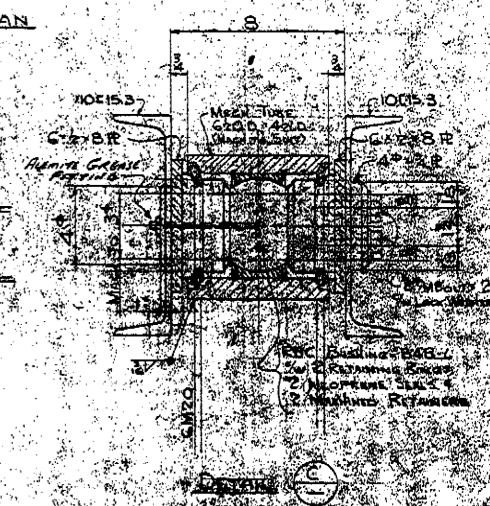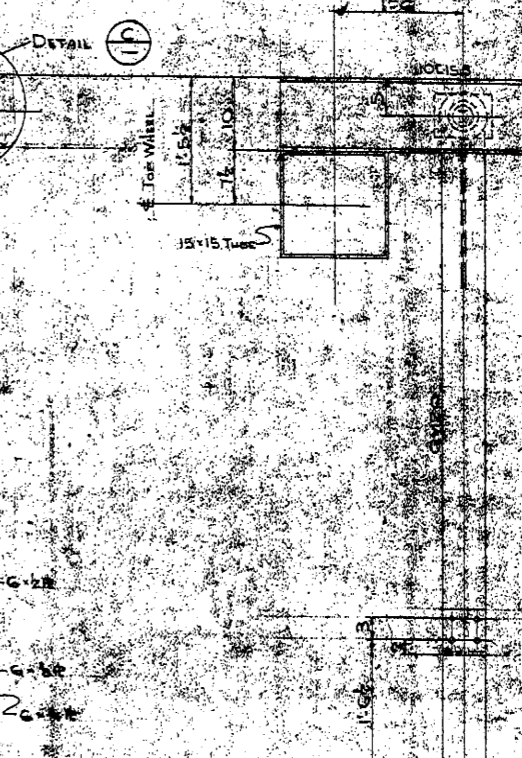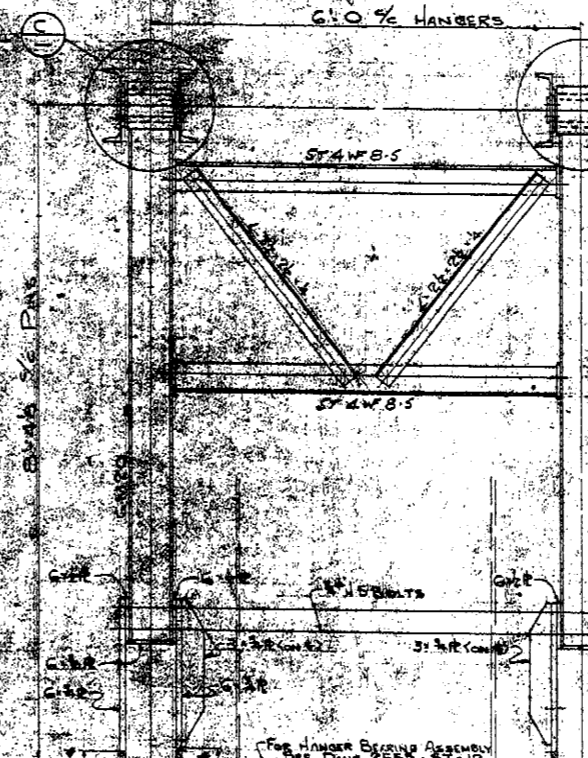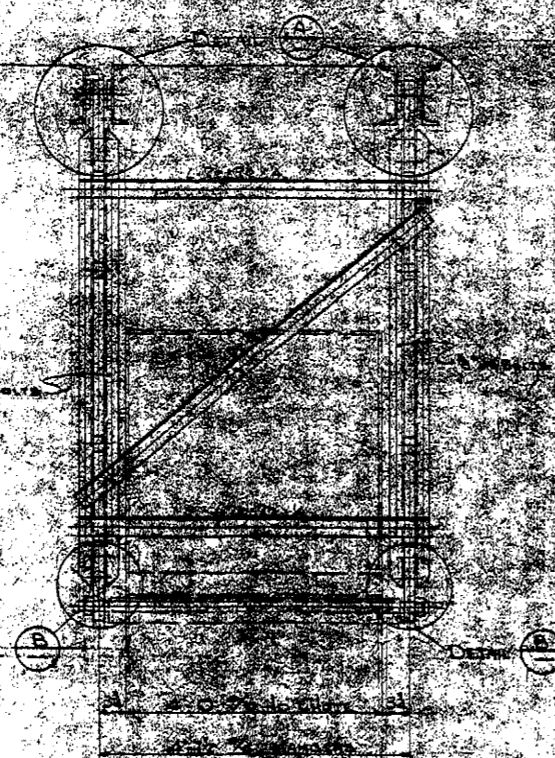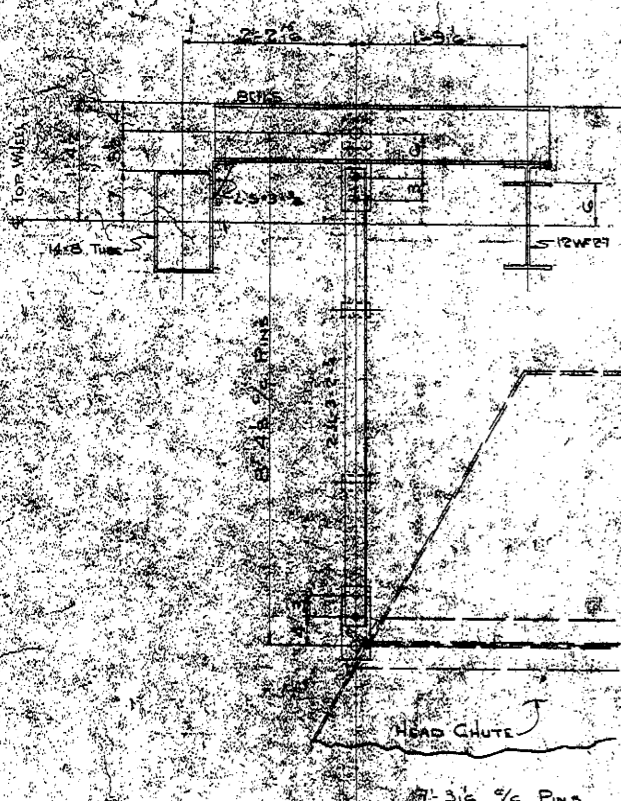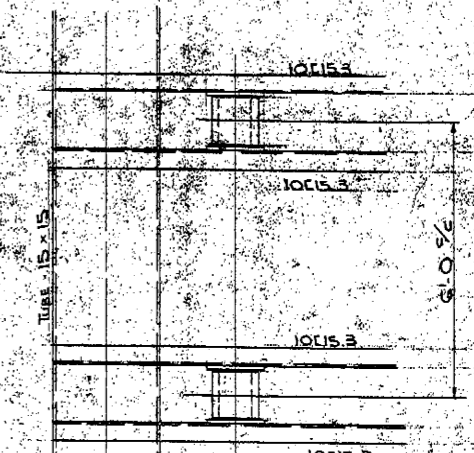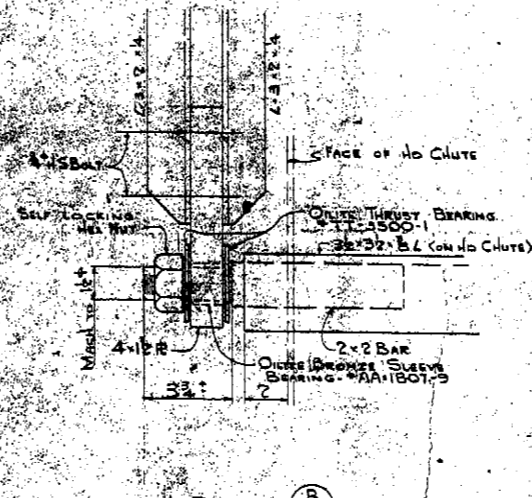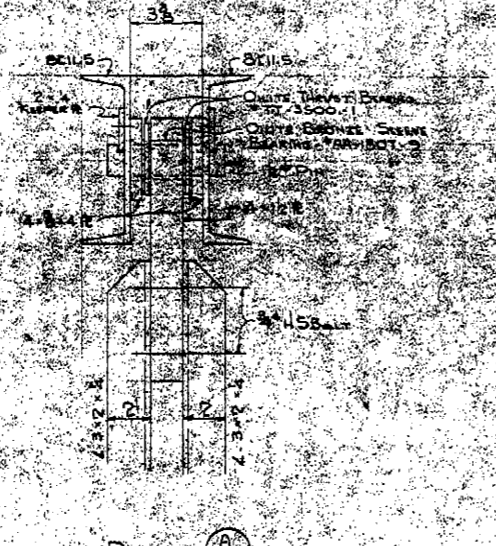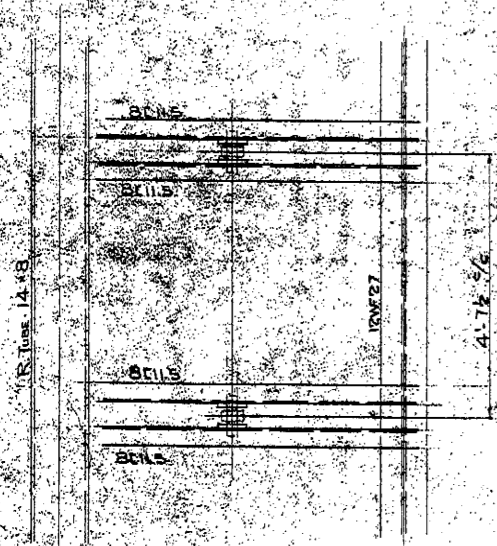

CONV. #2 HEAD CHUTE HANGER  
1-REQ'D

CONV. #2 HANGER  
1-REQ'D

<p>WRIGHT ENGINEERS LIMITED VANCOUVER - CANADA</p>	<p>PREPARED BY WRIGHT ENGINEERS LIMITED VANCOUVER - CANADA</p>	<p>PACIFIC AND ARCTIC RAILWAY AND ALASKA COASTLAND COMPANY ORE HANDLING TERMINAL - PHASE II SKAGWAY - ALASKA</p>
	<p>REFERENCE: 528 480 310</p>	<p>TIPPETTS - ABBETT - MCCARTHY - STRATTON ENGINEERS AND ARCHITECTS SUITE 1000 - 1000 - 1000 VANCOUVER - B.C.</p>
<p>DATE: AUG 68</p>	<p>DESIGNED BY: [Signature]</p>	<p>DRAWN BY: [Signature]</p>


DRAWING REDUCED TO  
45% OF ORIGINAL SIZE  
SOT03-989-AB-2555-SL-10, Conveyor  
No. 2 - Hanger Details

REACTIONS ON BASES  
DESIGN LOADING CONDITIONS

- I - DEAD LOAD + LIVE LOAD (MAT. ON BELT) + WIND LOAD AT 57 FT. (BASIC)
- II - DEAD LOAD + LIVE LOAD + RUB-UP IN TRIMMER + WIND LOAD AT 57 FT. (BASIC)
- III - DEAD LOAD IN PARKED POSITION + FULL WIND AT 207 FT. (BASIC)

HORIZONTAL WIND SHEAR ACTING INTO S' & S' ON BASES A, B, C, D, E, F, G, H, I, J, K	LOADING CONDITION	BASE LOADS - KIIPS											DIRECTION OF WIND	
		A	B	C	D	E	F	G	H	I	J	K		
2.0" PER BASE	I	+168	+12	+42	+43	+50	+192	+12	+18	+19	+50	+19	+50	N to S
Do	II	+186	+21	+42	+43	+50	+210	+31	+18	+19	+50	+19	+50	N to S
8.0" PER BASE	III	+210	+3	+18	+19	+50	+180	+27	+42	+43	+50	+19	+50	N to S
6.0" TOTAL		+123	+152	+17	+16	+50	+29	+57	+18	+18	+50	+19	+50	S to N

SIGN CONVENTION:  
+ve INDICATES LOAD ACTING VERTICALLY DOWNWARD ON THE BASE

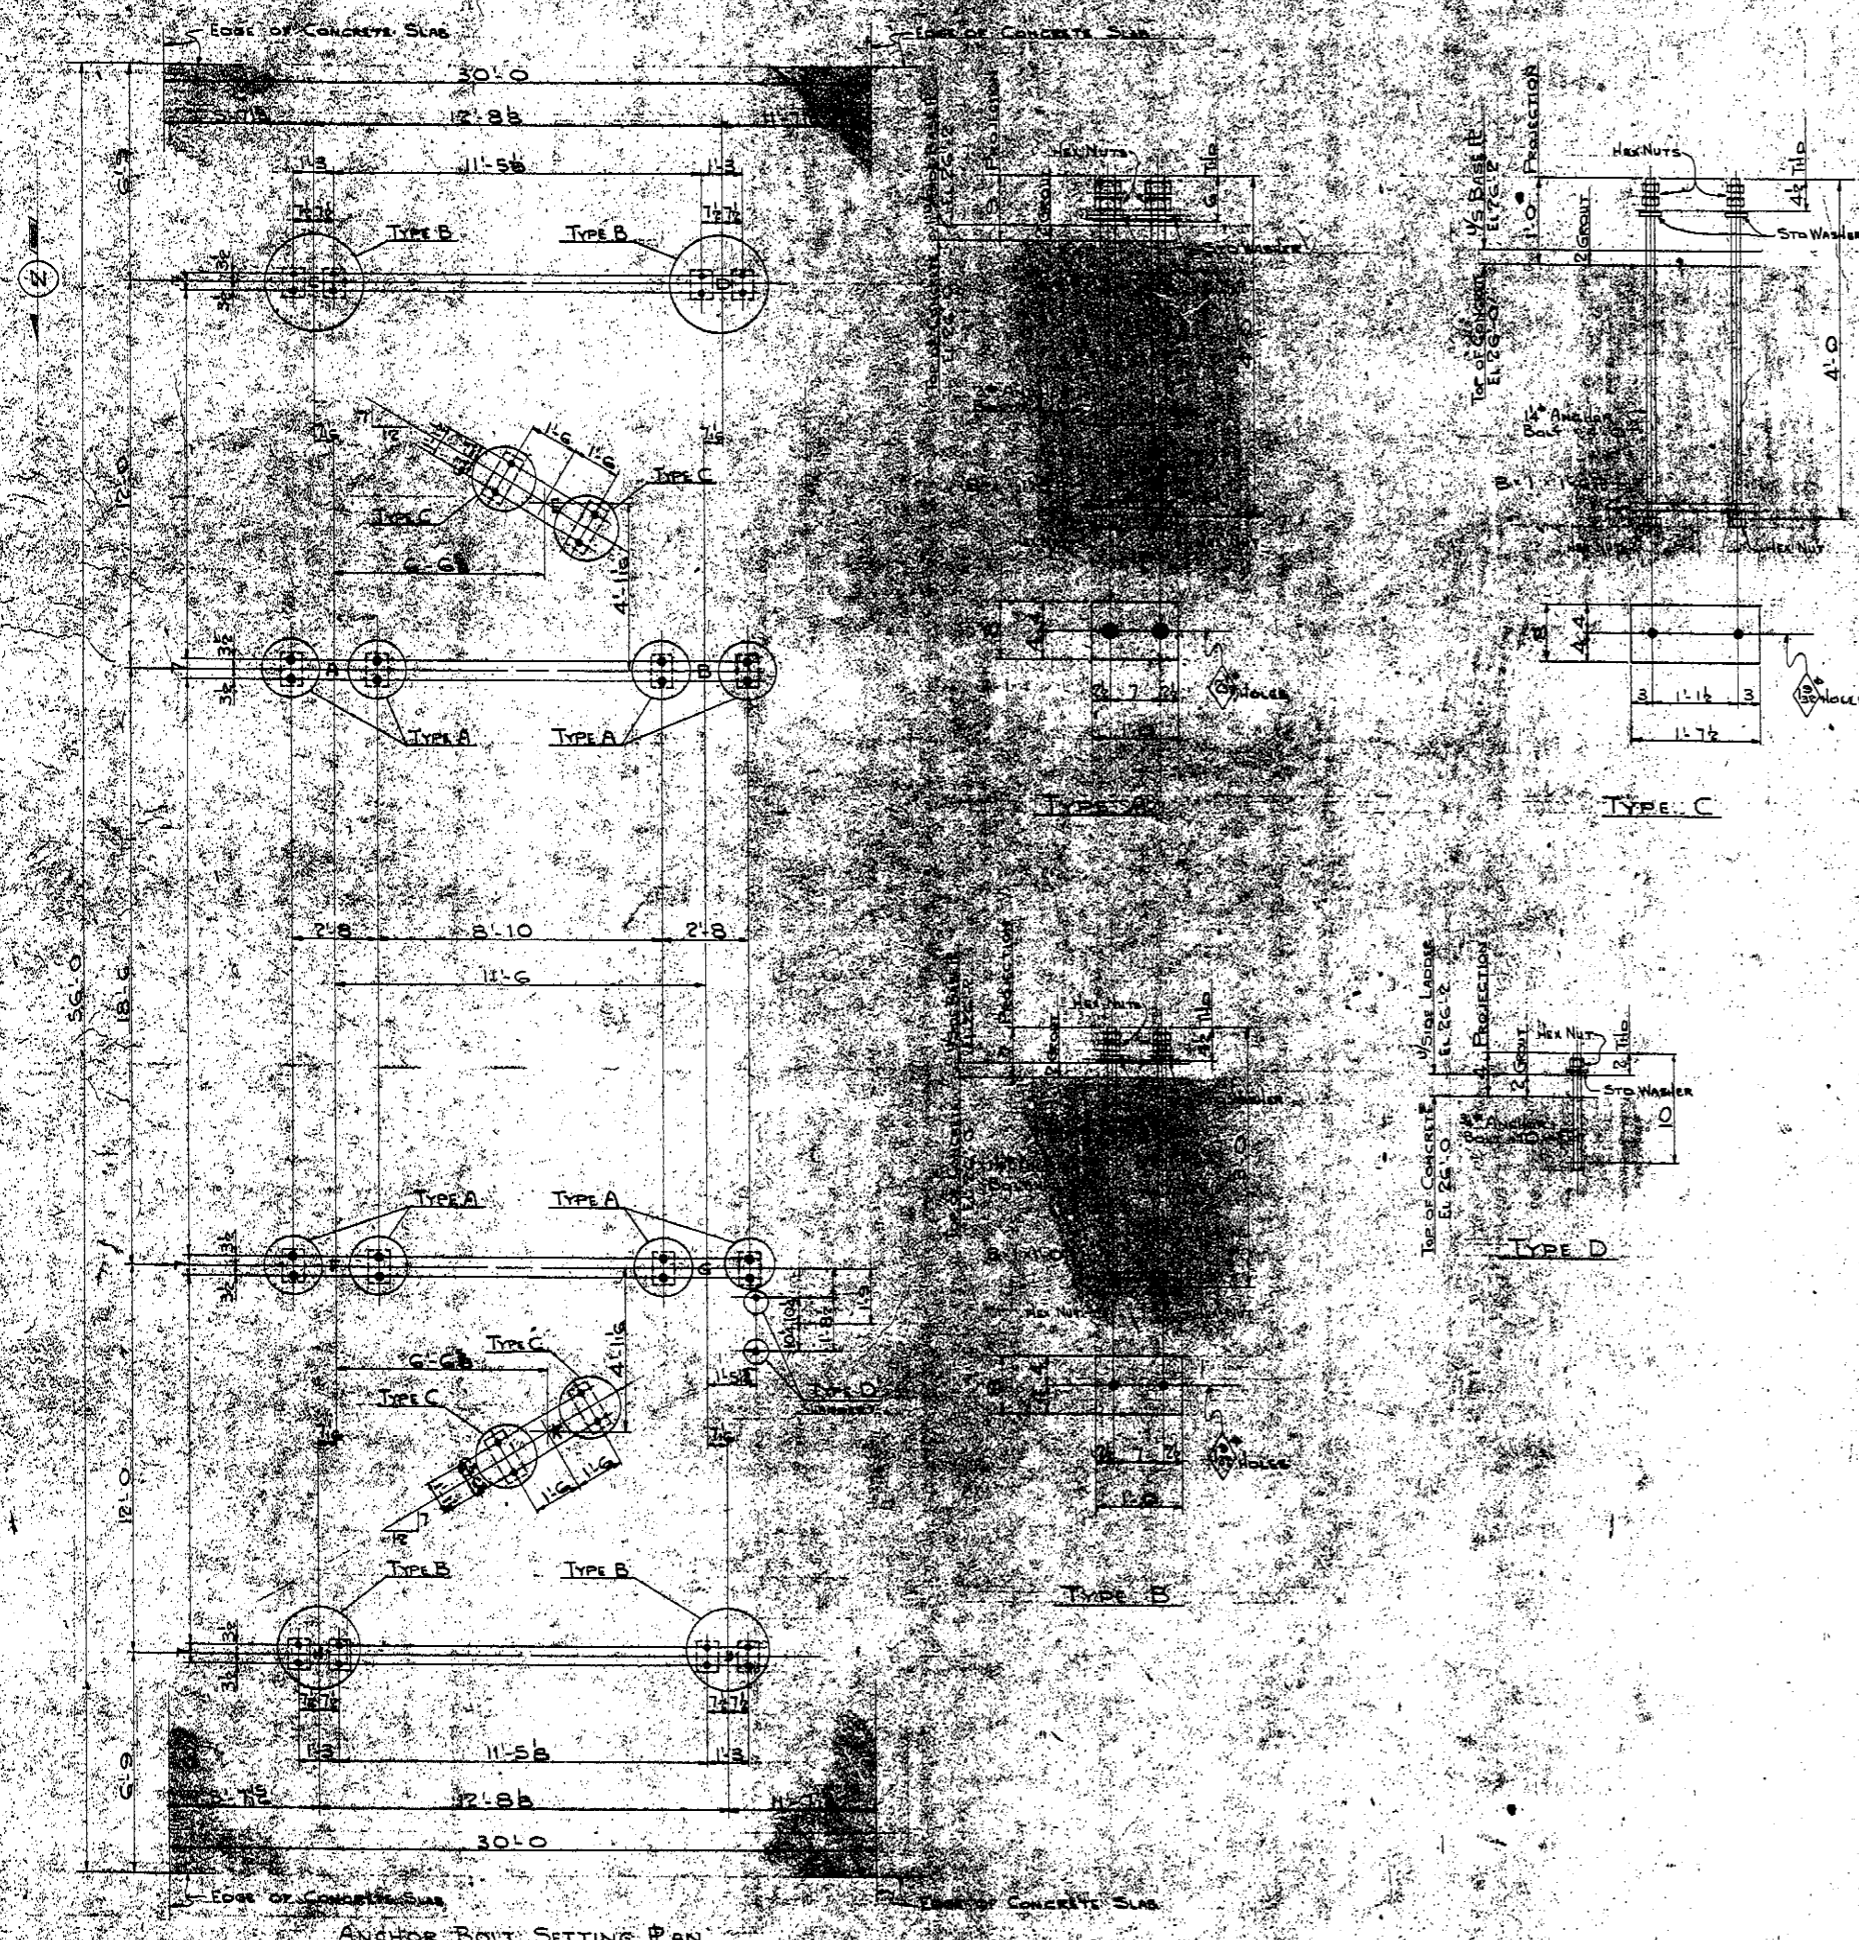


DRAWING REDUCED TO 45% OF ORIGINAL SIZE


NOTE:  
ALL BOLT EXCEPT FOR LADDER TO BE SET IN STEEL TEMPLATE

SOT102-1989-AB-2585-SL-11, Anchor Bolt Setting Plan & Details


	PREPARED BY: <b>WRIGHT ENGINEERS LIMITED</b> VANCOUVER CANADA	PACIFIC AND ARCTIC RAILWAY AND NAVIGATION COMPANY <b>ORE HANDLING TERMINAL - PHASE II</b> SKAGWAY ALASKA
	REFERENCE: 528, 480, 311	RIPPETTS - ABBETT - MCCARTHY - STRATTON ENGINEERS AND ARCHITECTS SCOTLAND NEW YORK
DRAWN BY: G. QUINN DATE: 10/27/68 SCALE:		DESIGNED BY: J.C.H. CHECKED BY:
SHIPLOADER ANCHOR BOLT SETTING PLAN & DETAILS		DRAWING NUMBER: 1216/2013

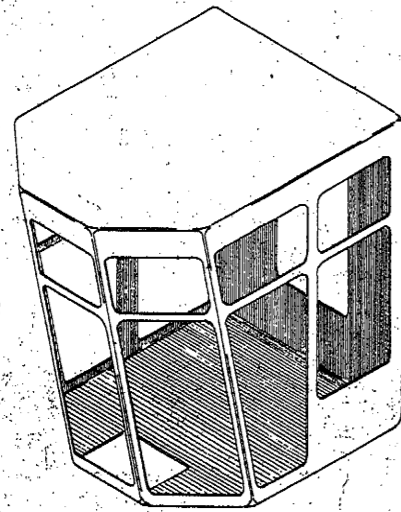


ISOMETRIC 1/2" = 1'-0"

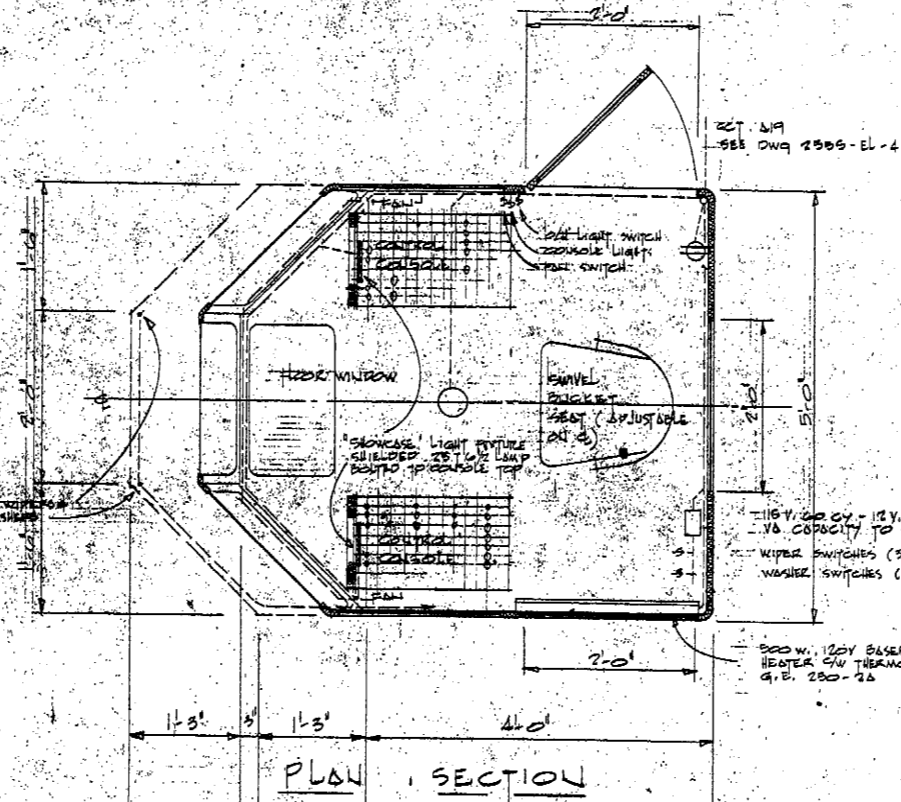


PLAN SECTION

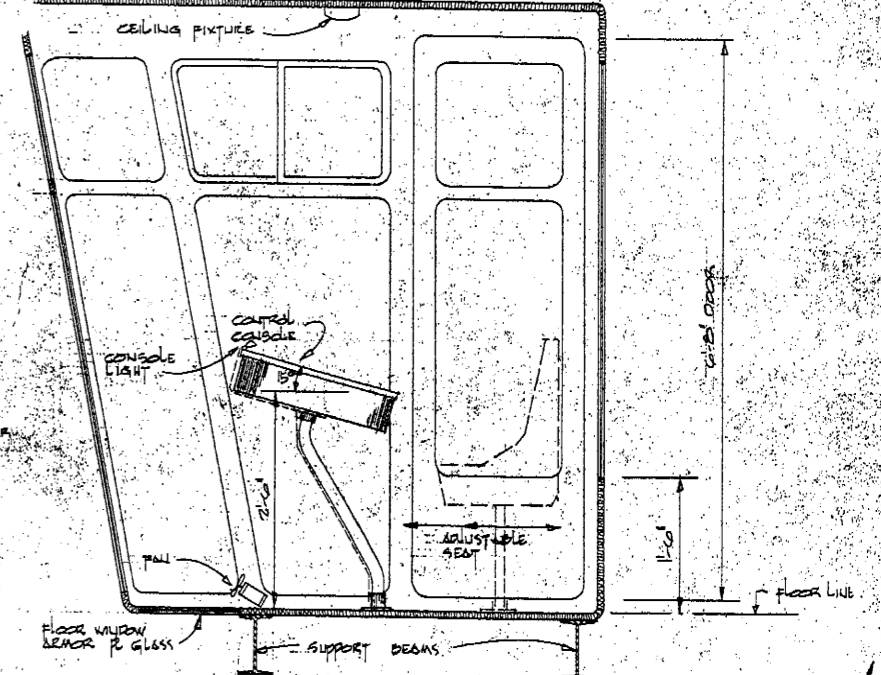


SECTION

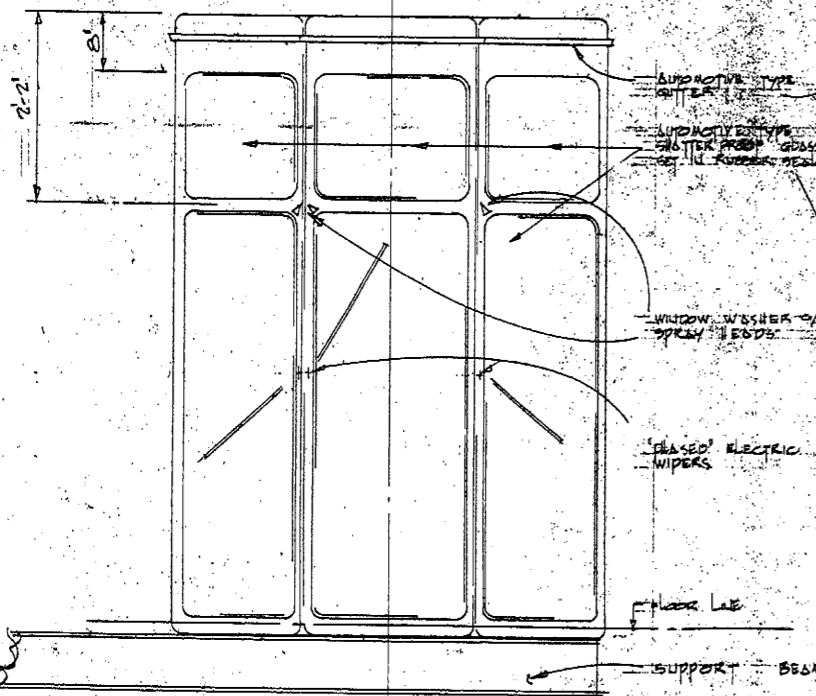

FRONT VIEW

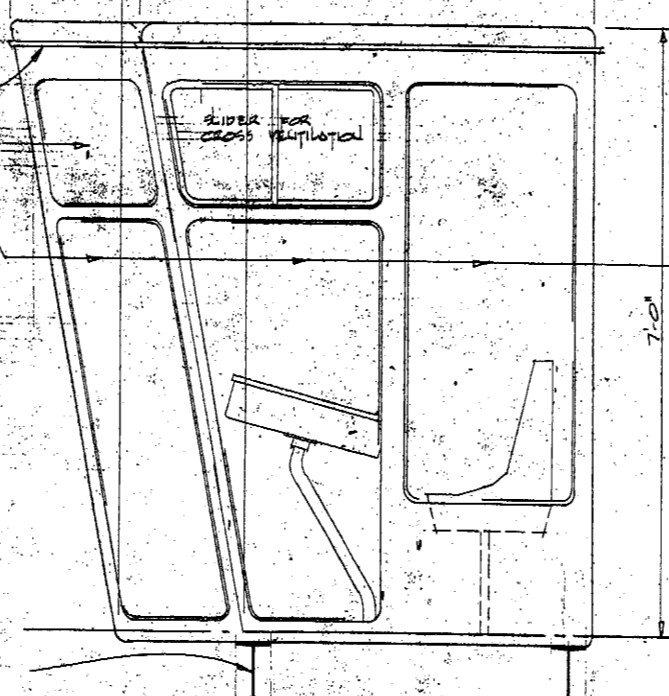

SIDE VIEW

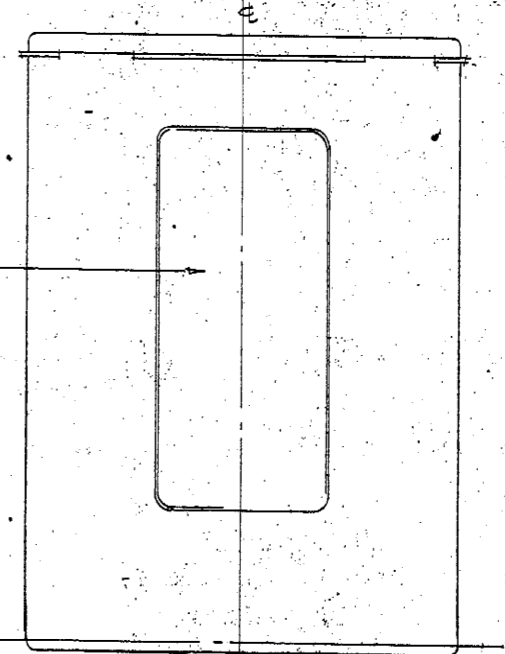

REAR VIEW

DRAWING REDUCED TO 45% OF ORIGINAL SIZE

SOT03-1989-AB-2555-SL-12, Control Cab






	PREPARED BY: <b>WRIGHT ENGINEERS LIMITED</b> VANCOUVER - CANADA	PACIFIC AND ARCTIC RAILWAY AND NAVIGATION COMPANY <b>ORE HANDLING TERMINAL -- PHASE II</b> SKAGWAY ALASKA	
	REFERENCE: 528 480 312	TIPPETTS - ABBETT - MCCARTHY - STRATTON ENGINEERS AND ARCHITECTS SEATTLE - NEW YORK	
	NO. BY DATE REVISION	SHIPLOADER CONTROL CAB	

DRAWN BY LKW  
DATE AUG-68  
SCALE 1/2" = 1'-0"

DESIGNED BY LKW  
CHECKED BY LKW

12/16/2013



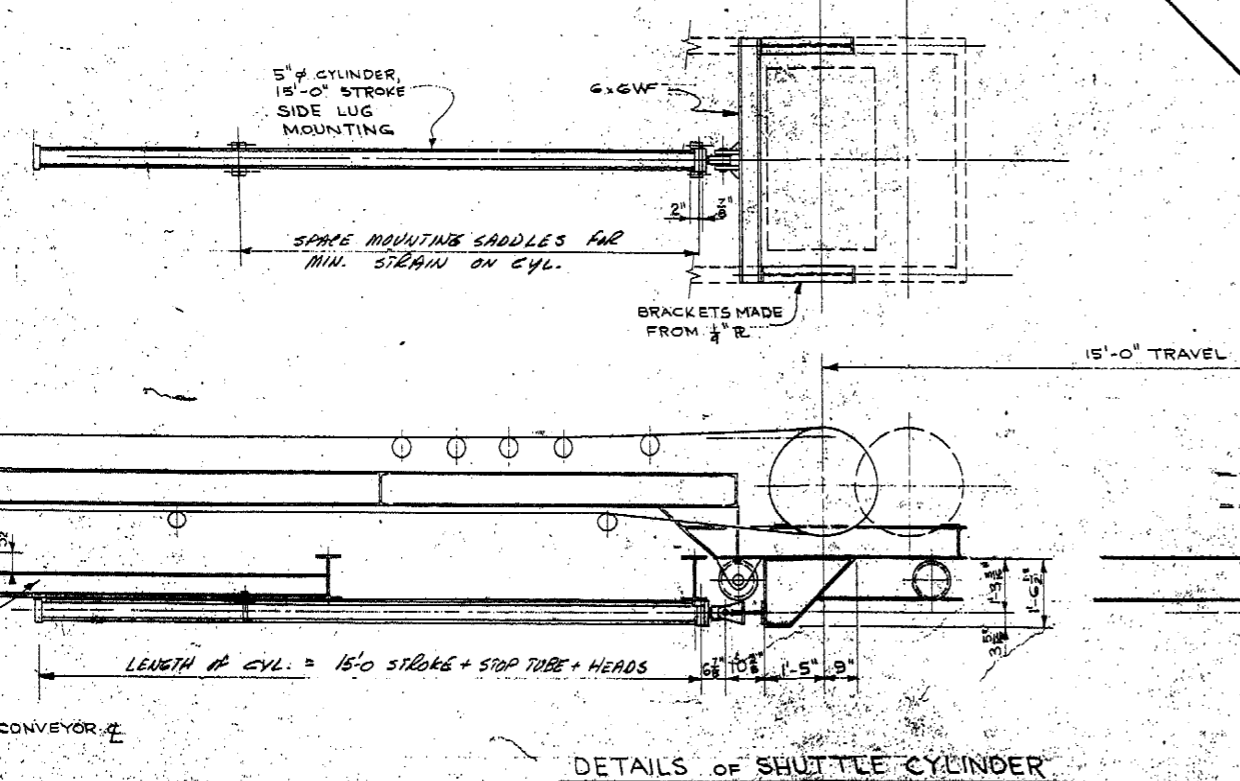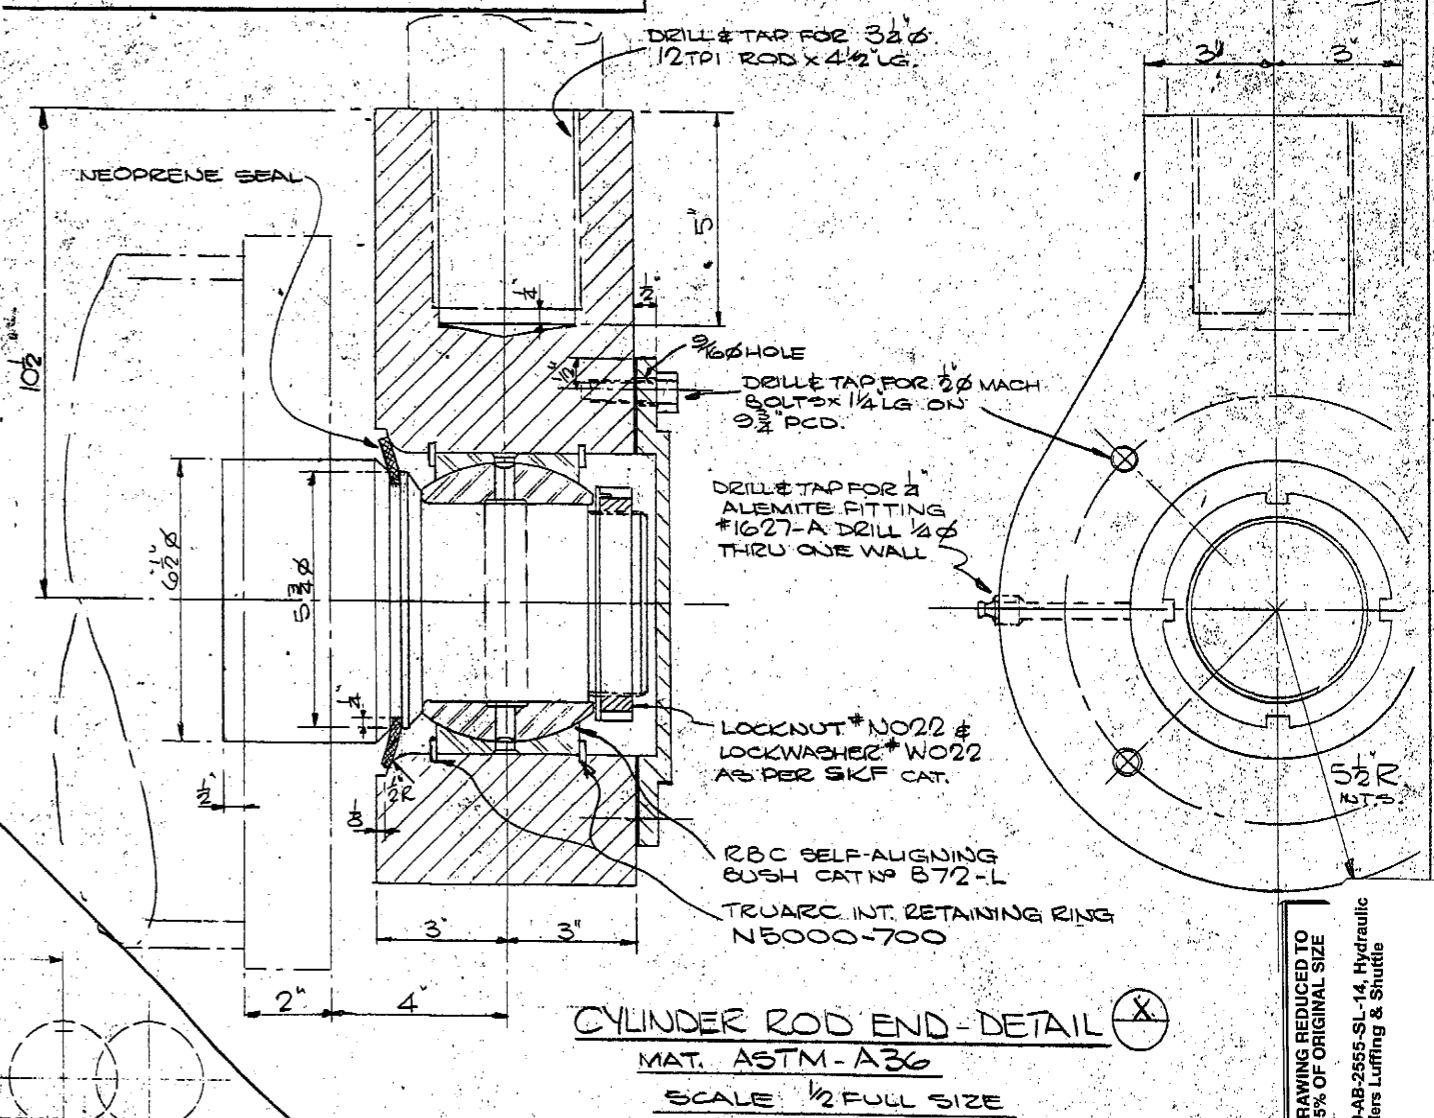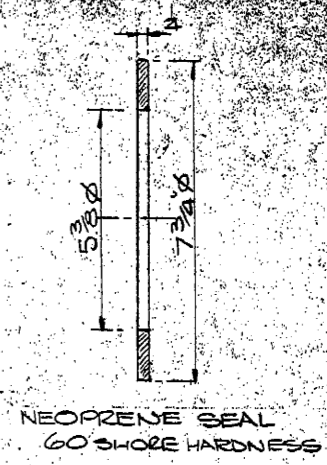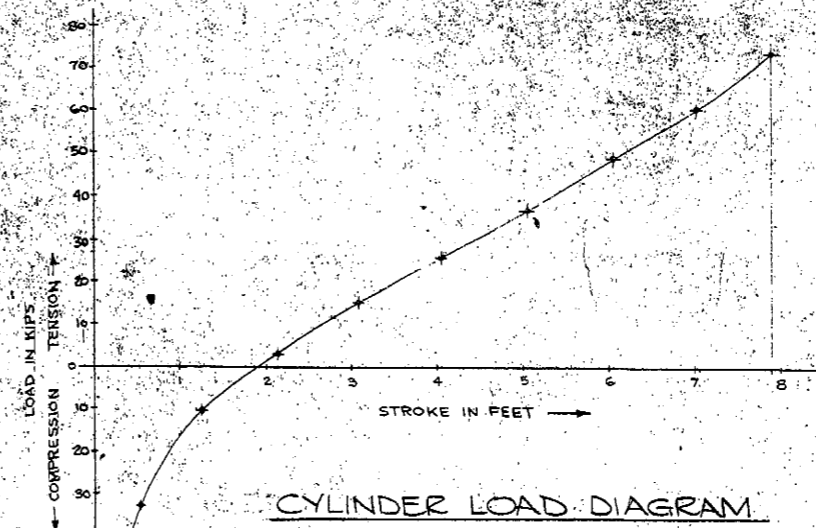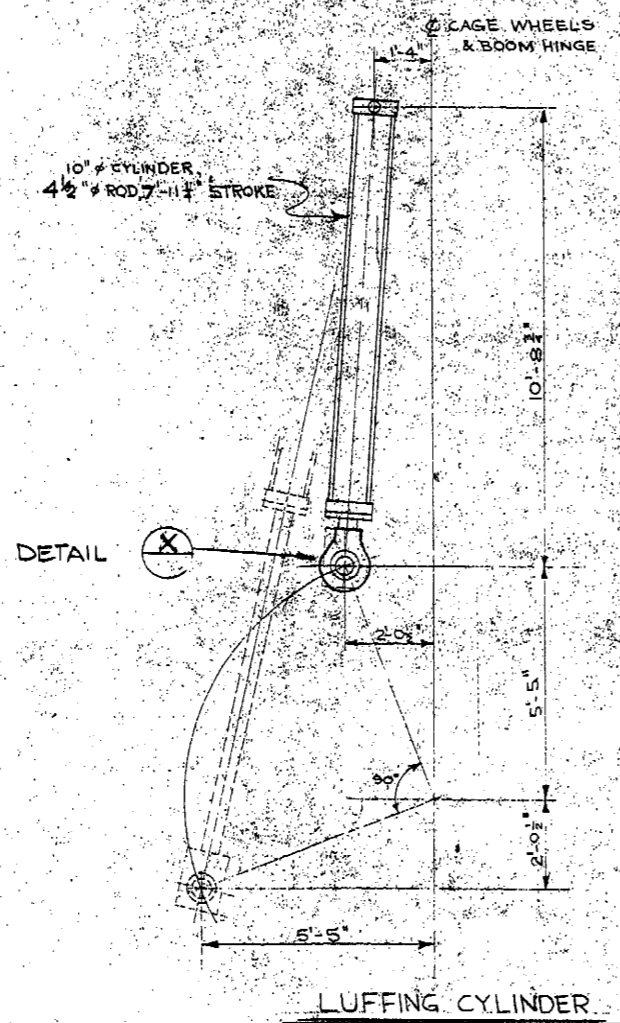


DRAWING REDUCED TO 45% OF ORIGINAL SIZE

SOT03-1989-AB-2555-SL-14, Hydraulic Cylinders Luffing & Shuttle


	PREPARED BY: <b>WRIGHT ENGINEERS LIMITED</b> VANCOUVER CANADA	PACIFIC AND ARCTIC RAILWAY AND NAVIGATION COMPANY <b>ORE HANDLING TERMINAL -- PHASE II</b> SKAGWAY ALASKA
	REFERENCE: 528 480 402	TIPPETTS, ABBETT, McCARTHY, STRATTON ENGINEERS AND ARCHITECTS Seattle, New York
NO. BY DATE	REVISION	DRAWN BY: R DATE: AUG 26 1989 DESIGNED BY: J.W.H. CHECKED BY:
SHIPLOADER HYDRAULIC CYLINDER LUFFING & SHUTTLE		DRAWING NUMBER: 2555-SL-14

SOT REACTIVATION PHASE I REFERENCE DRAWINGS 020907




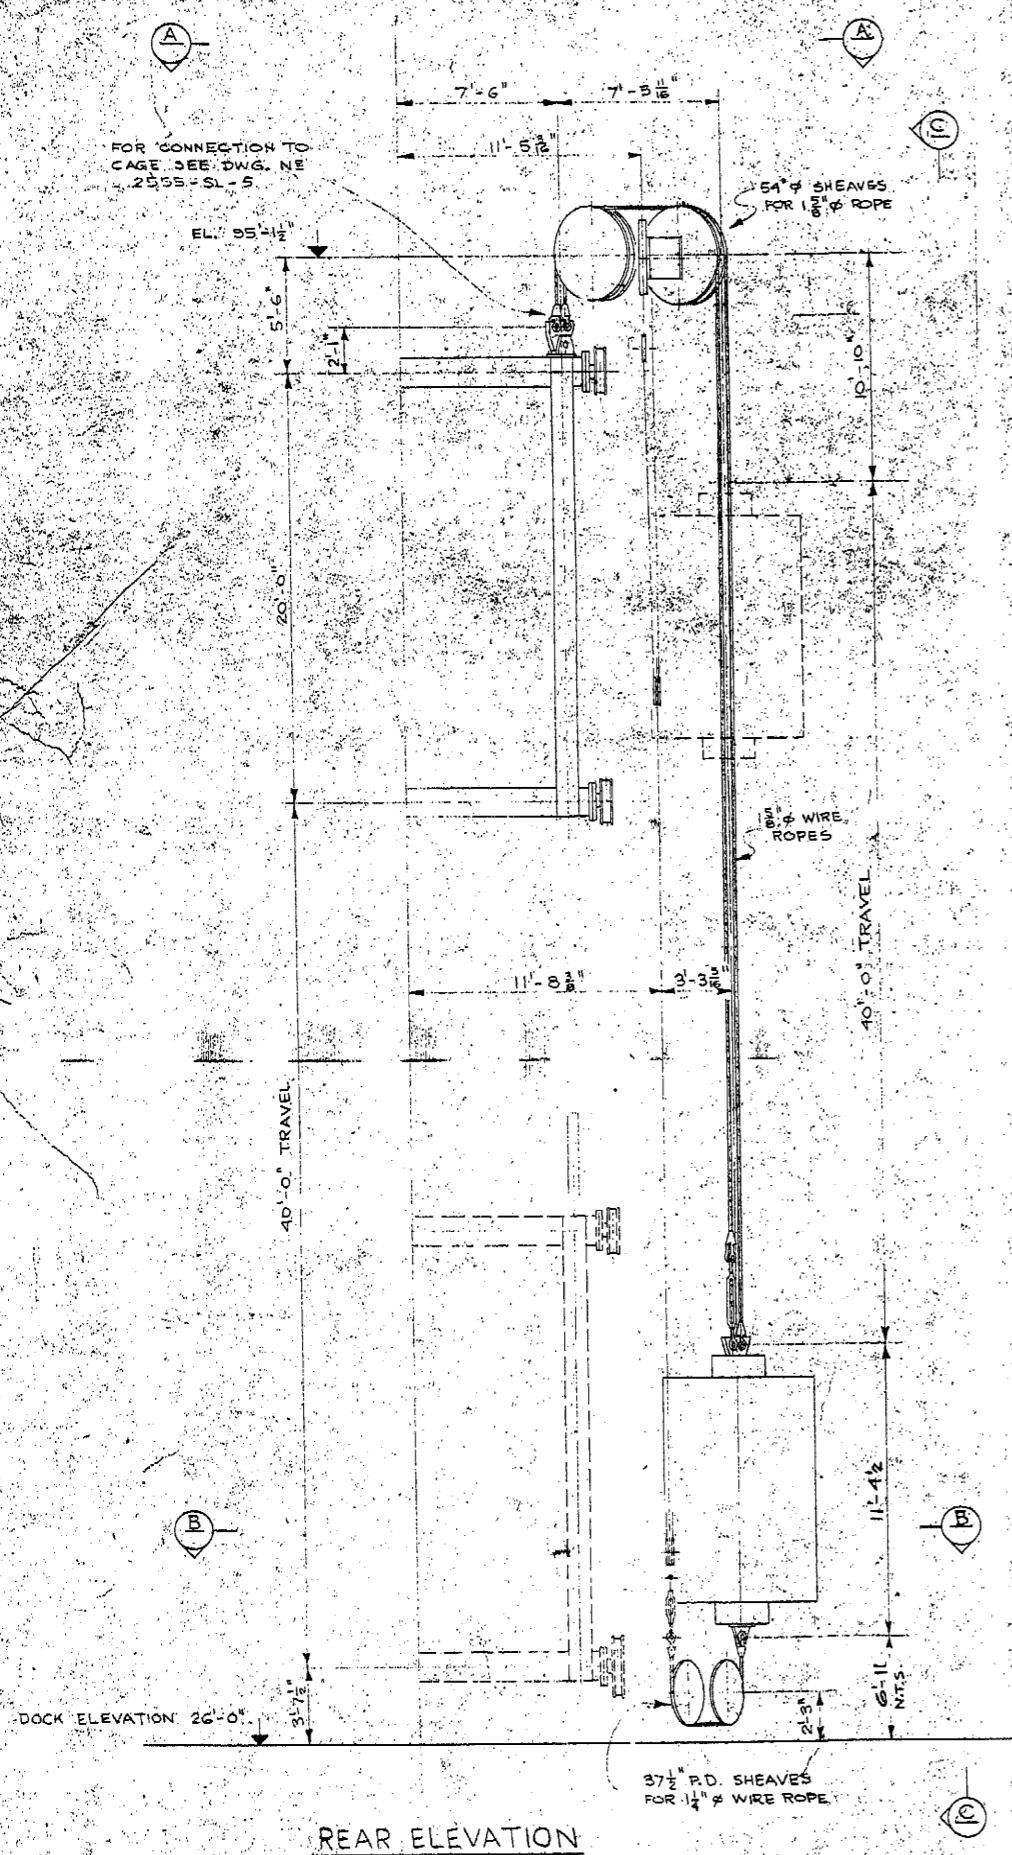


REAR ELEVATION

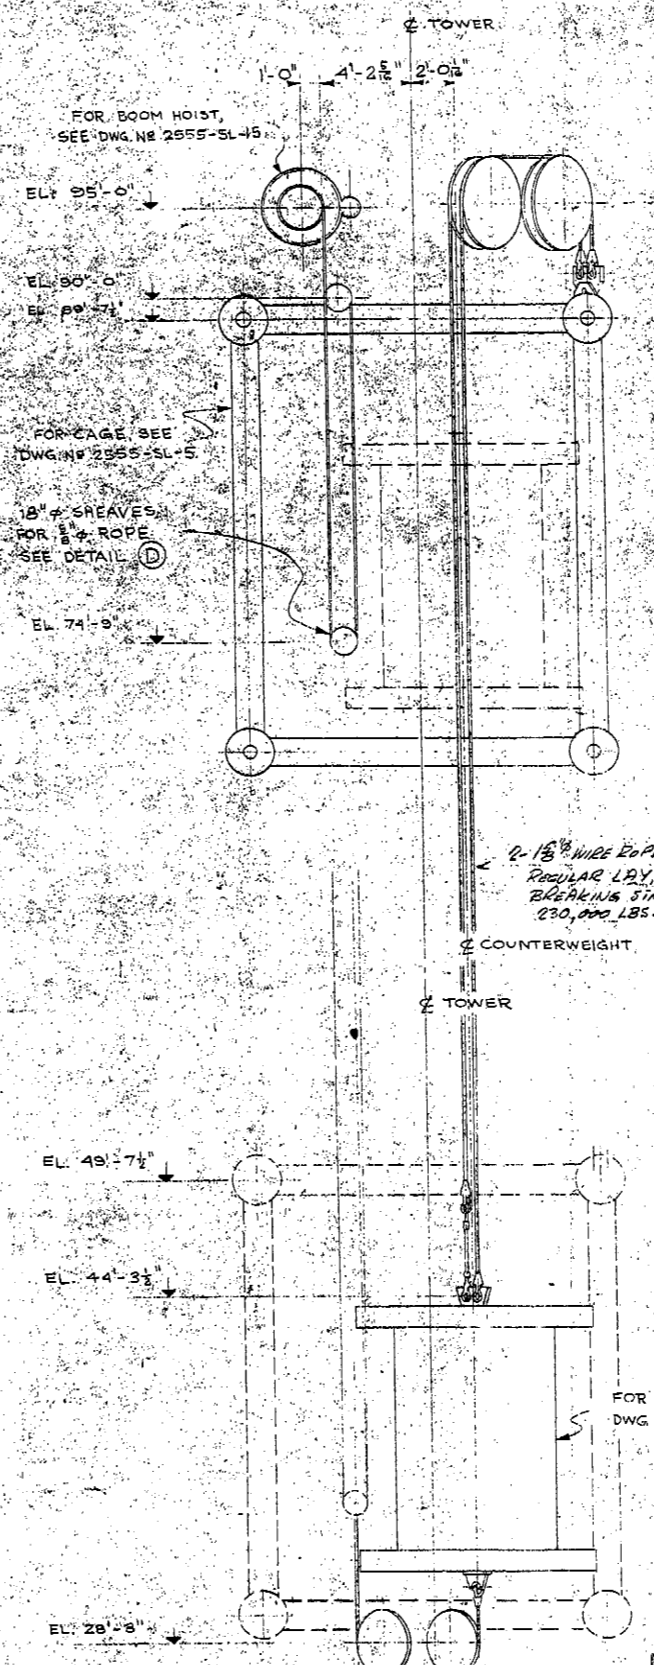

ELEVATION C

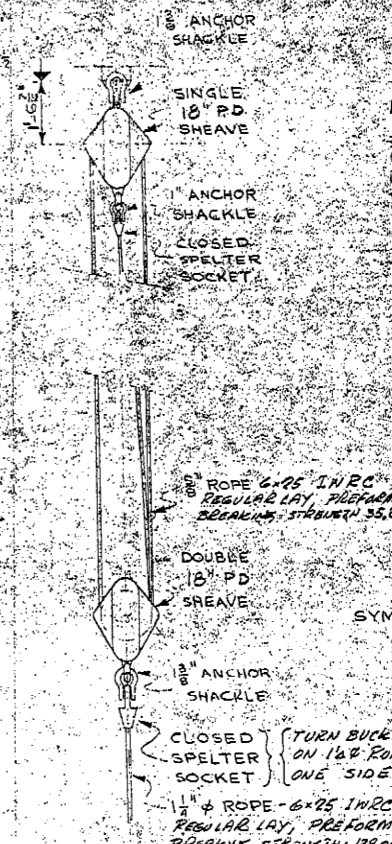

DETAIL D

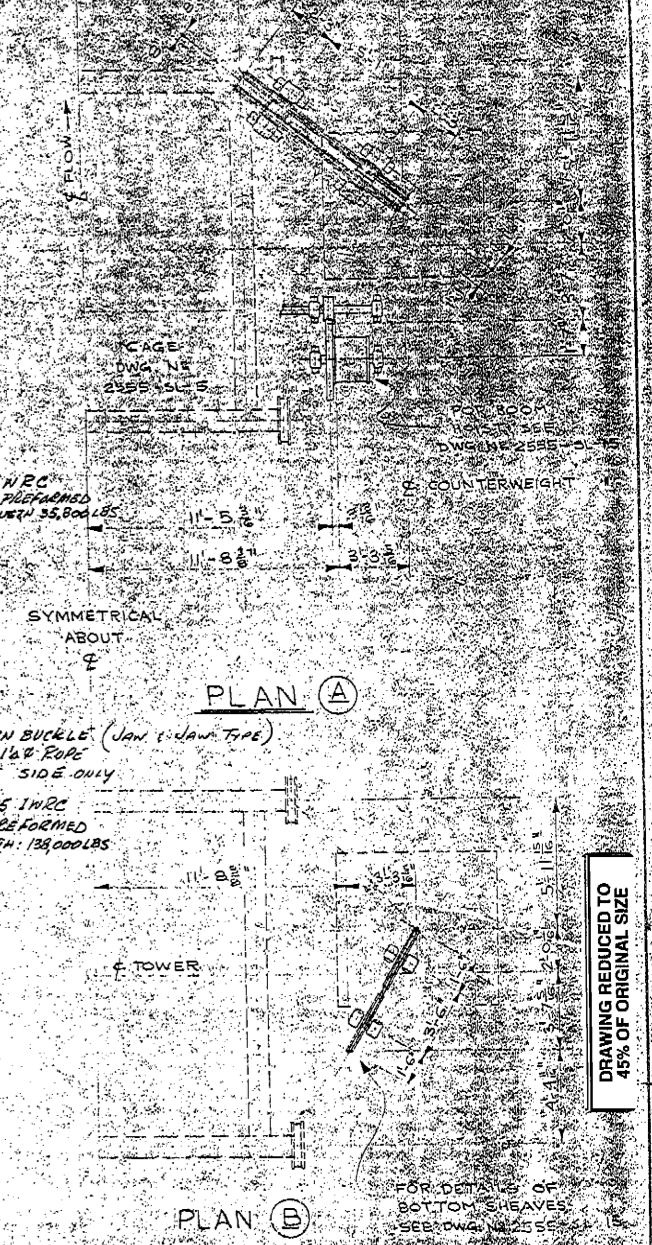

ALL WIRE ROPES TO BE PRE-STRETCHED TO 50% OF THE BREAKING STRENGTH.


















DRAWING REDUCED TO 45% OF ORIGINAL SIZE

SOT03-1969-AB-2555-SL-16, Boom Hoisting Arrangement

	PREPARED BY: <b>WRIGHT ENGINEERS LIMITED</b> VANCOUVER CANADA	PACIFIC AND ARCTIC RAILWAY AND NAVIGATION COMPANY <b>ORE HANDLING TERMINAL - PHASE II</b> SKAGWAY ALASKA	
	REFERENCE NO: 525 420 404	TIPPETTS, ABBETT, McCARTHY, STRATTON ENGINEERS AND ARCHITECTS Seattle New York	
DESIGNED BY J.W.H. CHECKED BY		SHIPLOADER BOOM HOISTING ARRANGEMENT	
NO. BY DATE REVISION		DRAWN BY E DATE AUG-66 SCALE 1/2" = 1'-0" DRAWING NUMBER 12162013	





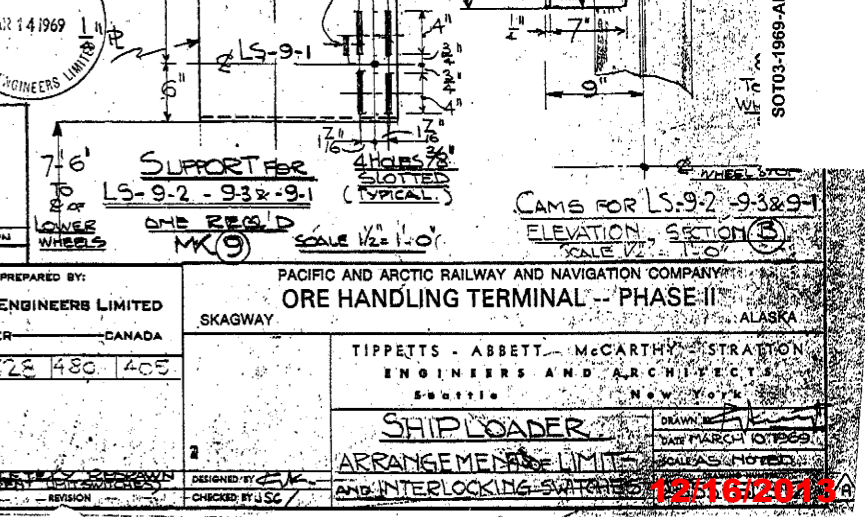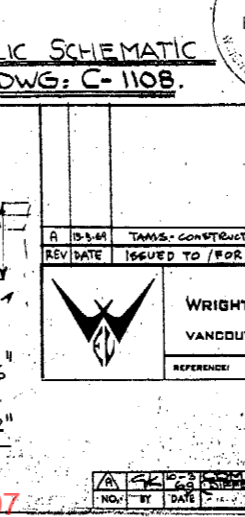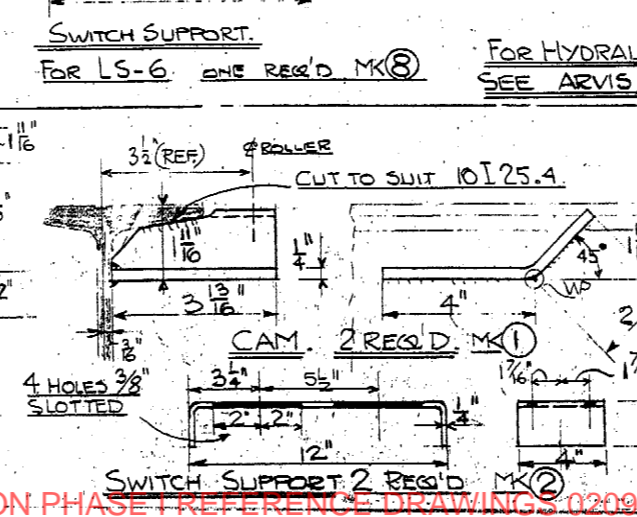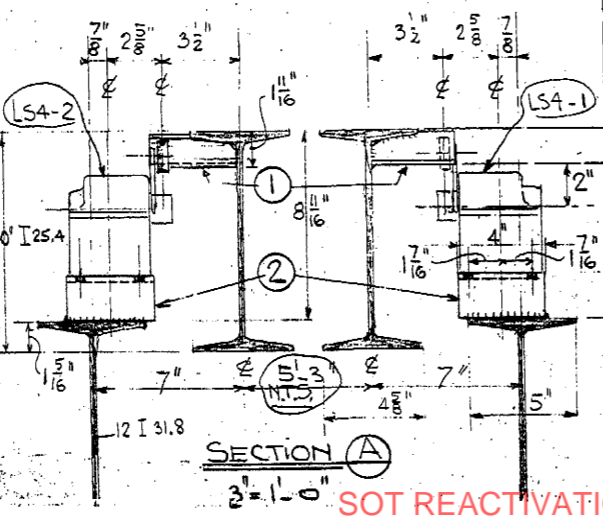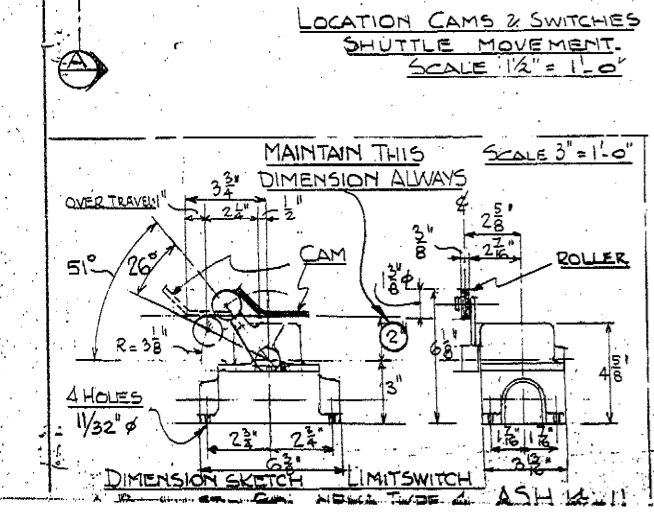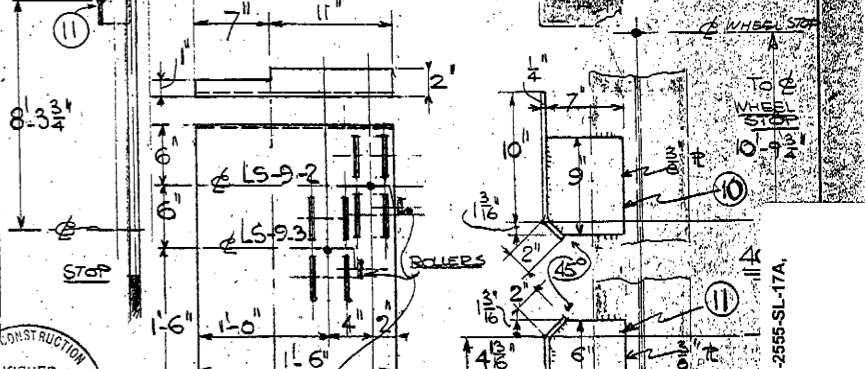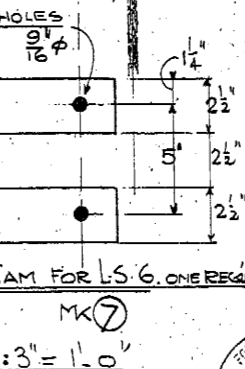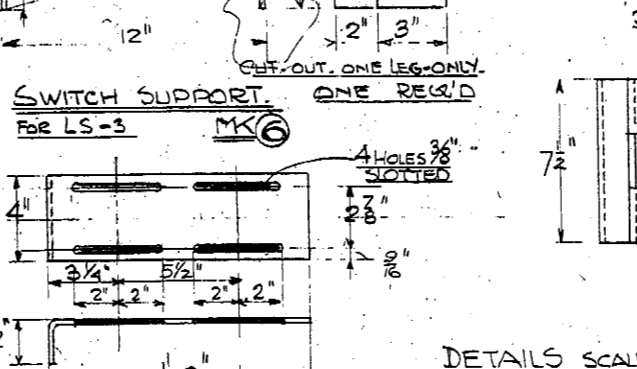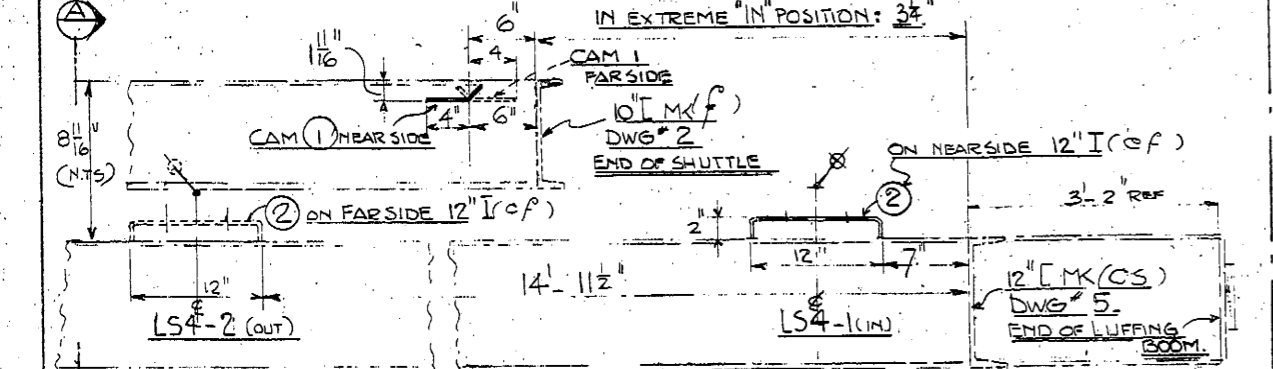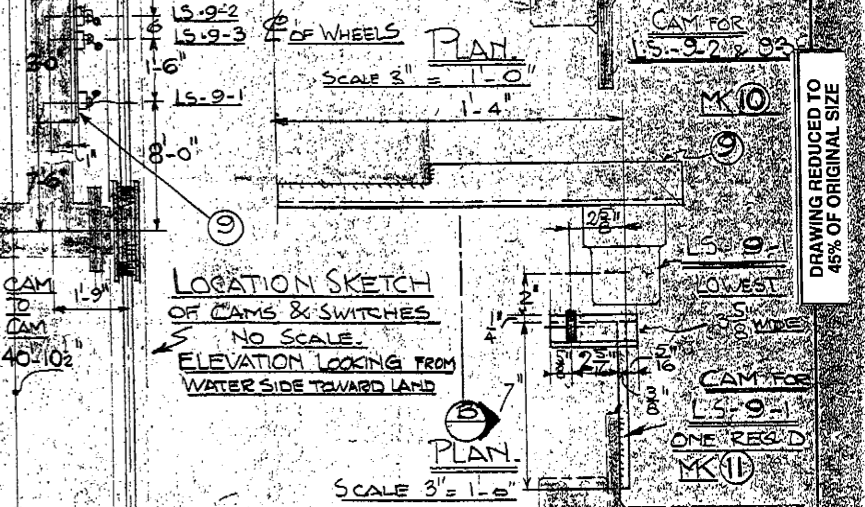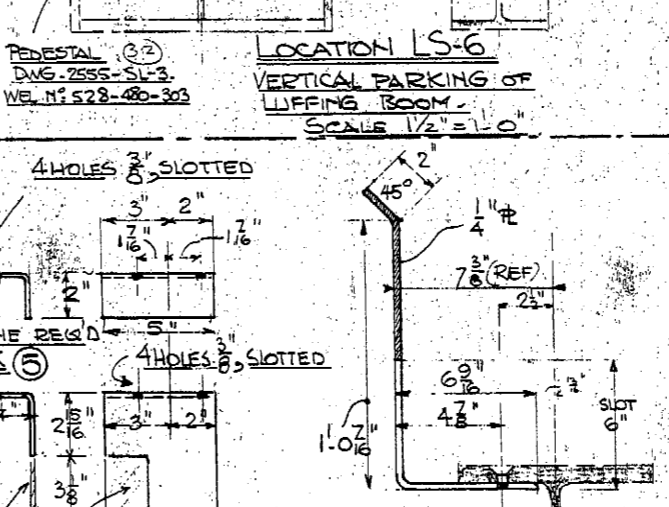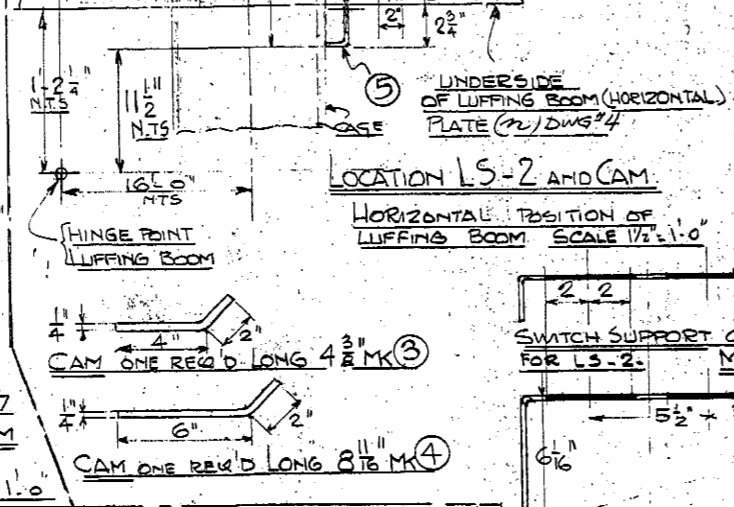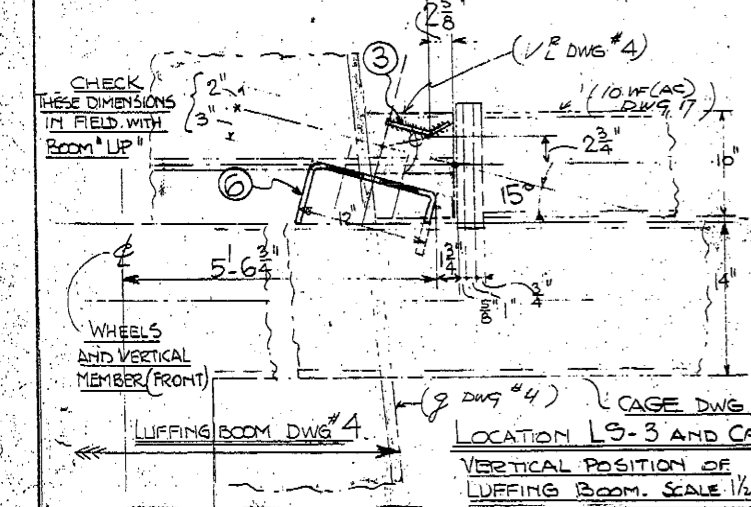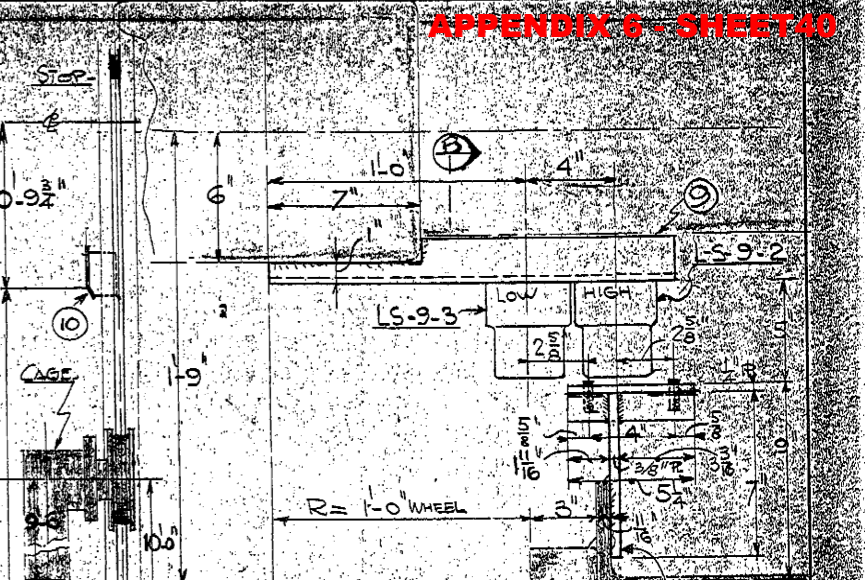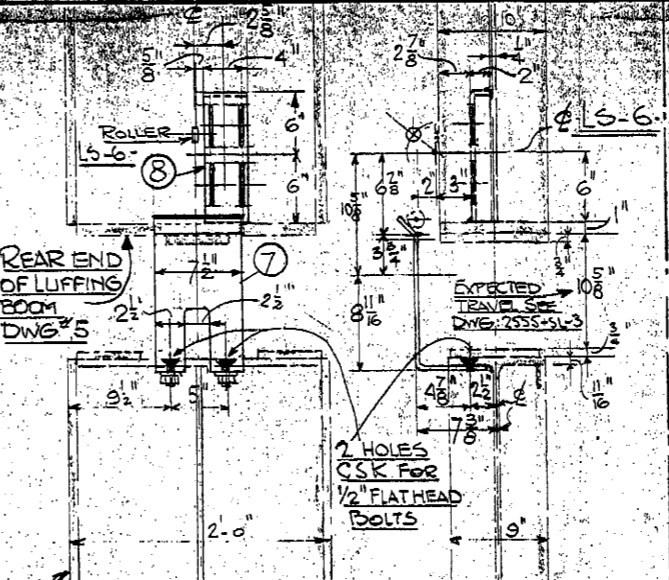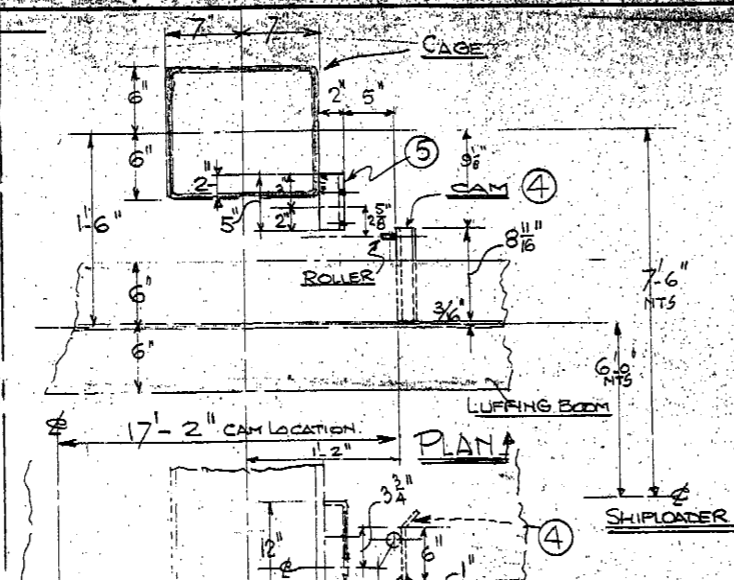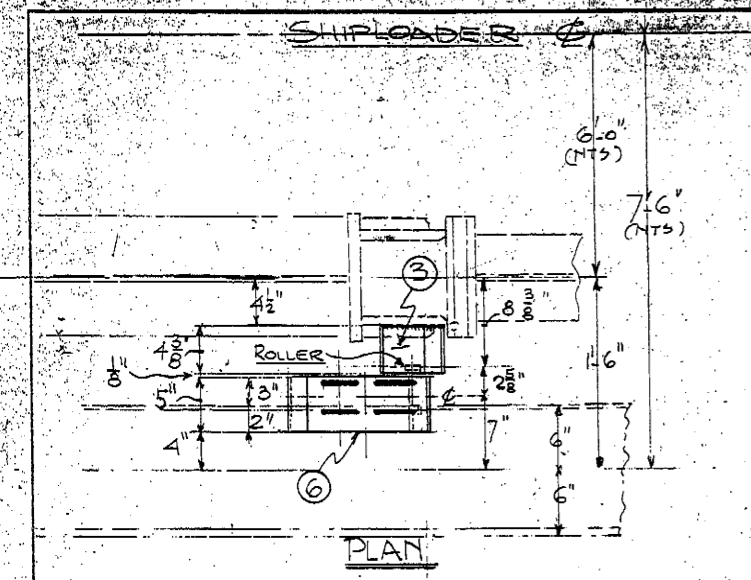

FOR CONSTRUCTION ISSUED FEB 14 1969 WRIGHT ENGINEERS LIMITED

PREPARED BY: WRIGHT ENGINEERS LIMITED VANCOUVER CANADA

PACIFIC AND ARCTIC RAILWAY AND NAVIGATION COMPANY ORE HANDLING TERMINAL - PHASE II SKAGWAY ALASKA





SHIPLOADER ARRANGEMENTS AND INTERLOCKING SWITCHES


DRAWING REDUCED TO 45% OF ORIGINAL SIZE

SOT03-1969-AB-2555-SL-17A


# CONVEYOR DATA

DATA	WIDTH	48"	WEIGHT
	BELT SPEED	350 F.P.M.	
	DESIGN CAPACITY	1500 S.T.P.H.	
	MATERIAL SIZE	CONCENTRATE	
	MAT'L WT. / FT. <sup>2</sup>	90 TO 140 LBS.	
	AVG. MECH. LD. / FT.		
HEAD PULLEY	MAT'L LOAD / FT.	143 LBS.	
	DIAM. & FACE	30" $\phi$ x 31" CF.	
	WRAP, DEGREES	180°	
	LAGGING THICK.	1/2" DIAMOND LAGG.	
SHAFT BEARINGS	DIAM.	4 3/4" C.F.S. (NECK TO 4 3/8")	
	MAKE & TYPE	4 BOLT	
	NUMBER		
TAIL PULLEY	DIAM. & FACE		
	DIAM.		
	MAKE & TYPE		
TAKE-UP	TYPE	SCREW	
	WEIGHT		
	TRAVEL	2'-0"	
PULLEY	DIAM. & FACE	30" $\phi$ x 31" CF.	
	DIAM.	3 3/4" $\phi$ C.F.S.	
	MAKE & TYPE	4 BOLT	
SNUB PULLEY	DIAM. & FACE		
	DIAM.		
	MAKE & TYPE		
TURN PULLEYS	NUMBER OF		
	DIAM. & FACE		
	DIAM.		
SHAFT(S) BEARINGS	MAKE & TYPE		
	NUMBER		
	DIAM.		
DRIVE PULLEY	NUMBER OF		
	LAGGING THICK.		
	DIAM. & FACE		
SHAFTS BEARINGS	DIAM.		
	MAKE & TYPE		
	NUMBER		
IDLERS - IMPACT	NUMBER OF		
	DIAM. ROLLS		
	MAKE, TYPE & HAND		
IDLERS - CARRYING	NUMBER OF	27	
	DIAM. ROLLS	5" $\phi$ x 35°	
	MAKE, TYPE & HAND	(LH)	
IDLERS - CARRYING - TRAINING	NUMBER OF		
	DIAM. ROLLS	5" $\phi$ x 35°	
	MAKE, TYPE & HAND	(LH)	
IDLERS - RETURN	NUMBER OF	6	
	DIAM. ROLLS	5" $\phi$ DISC	
	MAKE, TYPE & HAND	(LH)	
IDLERS - RETURN - TRAINING	NUMBER OF		
	DIAM. ROLLS	5" $\phi$ DISC	
	MAKE, TYPE & HAND	(LH)	
IDLERS - SPIRAL OR DISC	NUMBER OF		
	DIAM. ROLLS		
	MAKE, TYPE & HAND		
IDLERS - TRANSITION	NUMBER OF	2	
	DIAM. ROLLS	5" $\phi$ x 20°	
	MAKE, TYPE & HAND	(LH)	
BELT CLEANER	R.P.M.	43.1	
	MOTOR/HEAD PULLEY	40.6 TO 1	
	H.P.	20	
COUPLING - HIGH SPEED	R.P.M.	1750	
	FRAME		
	VOLTS/PH./CYCLE	480/3/60	
REDUCER	MAKE & SIZE		
	REDUCER BORE		
	MOTOR BORE		
COUPLING - LOW SPEED	TYPE	SHAFT MOUNT	
	MAKE		
	SIZE & ASSEMBLY RATIO	24.62 TO 1	
FINAL DRIVE DRIVER	MAKE & SIZE		
	BORES		
	BELT OR CHAIN	V-BELT	
DRIVEN	DIAMETER	5.2" P.D.	
	HUB TYPE & BORE		
	DIAMETER	8.6" P.D.	
CHAIN OR BELT	HUB TYPE & BORE		
	TYPE & NUMBER OF	B' SECTION - 6 BEAD	
	LENGTH & NUMBER		
RATIO OF DRIVE	LENGTH WITHOUT SPACES	150'-0"	
	PLY & TYPE	6 PLY 48oz. CN	
	TOP & BTM. COVER	1/8" x 1/2"	

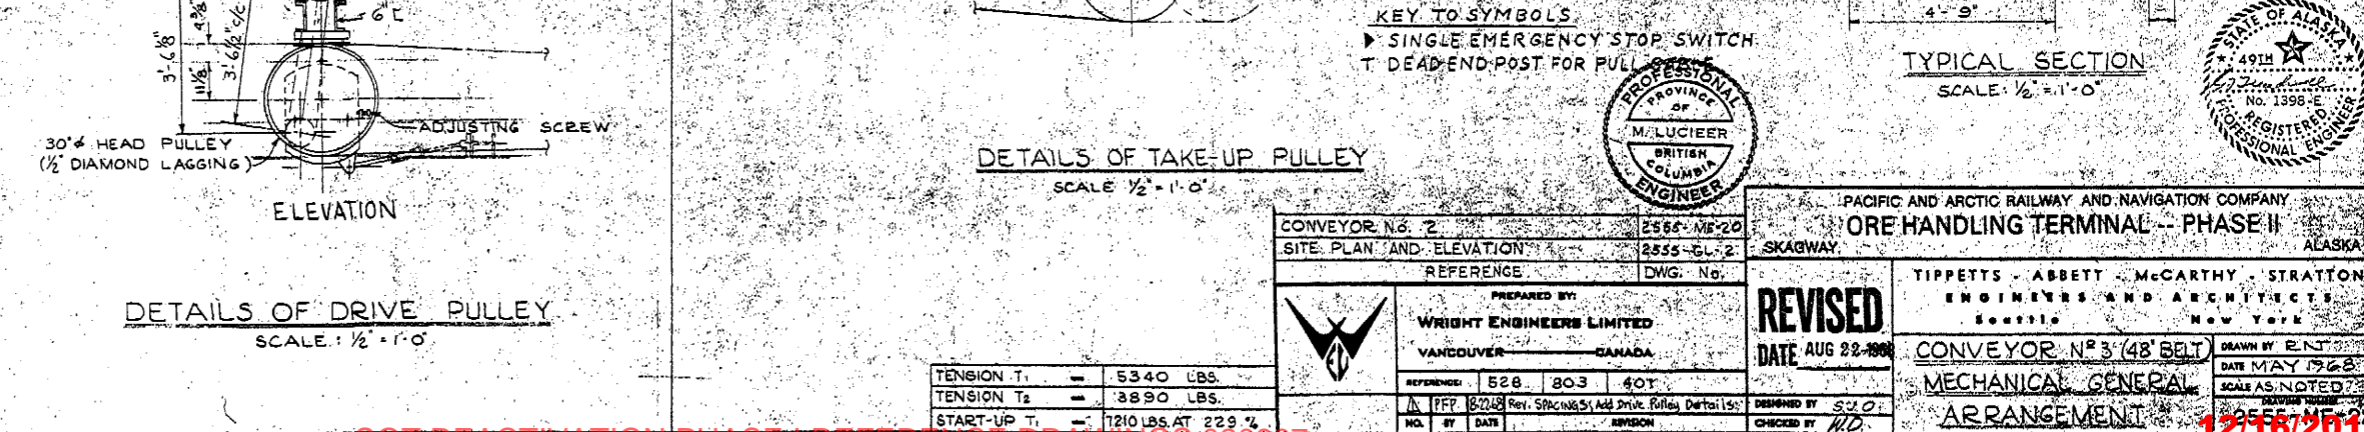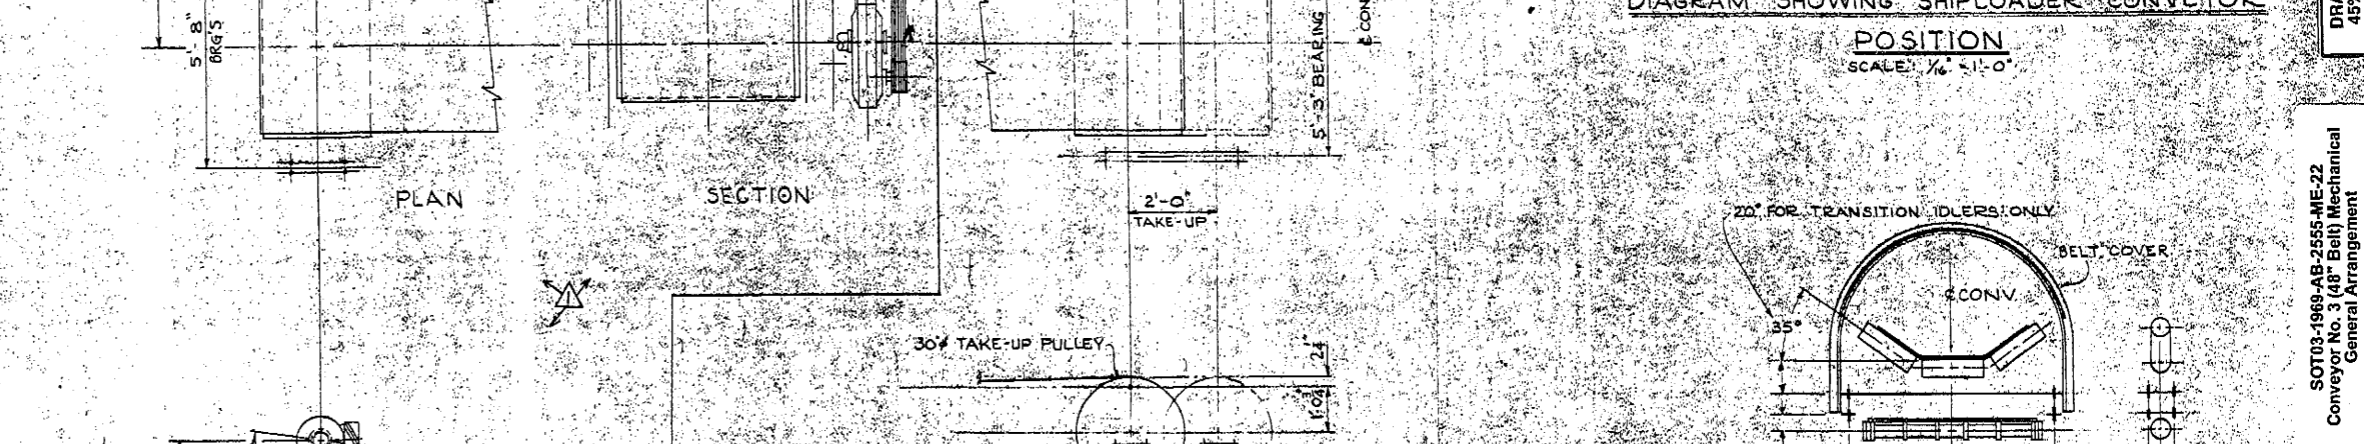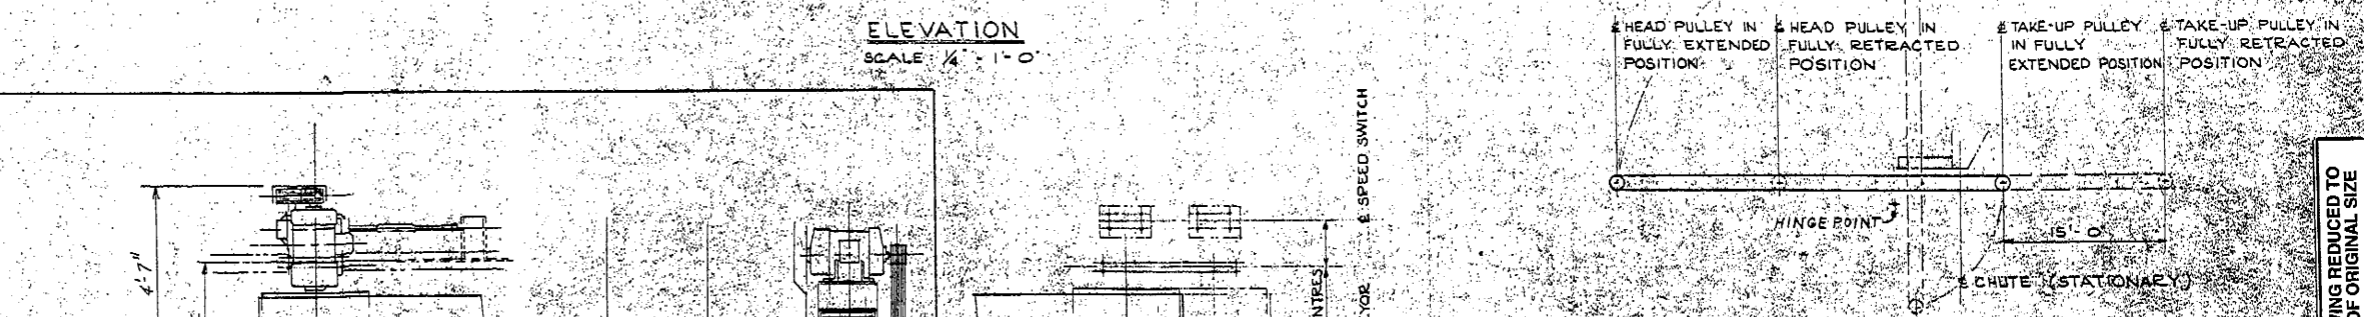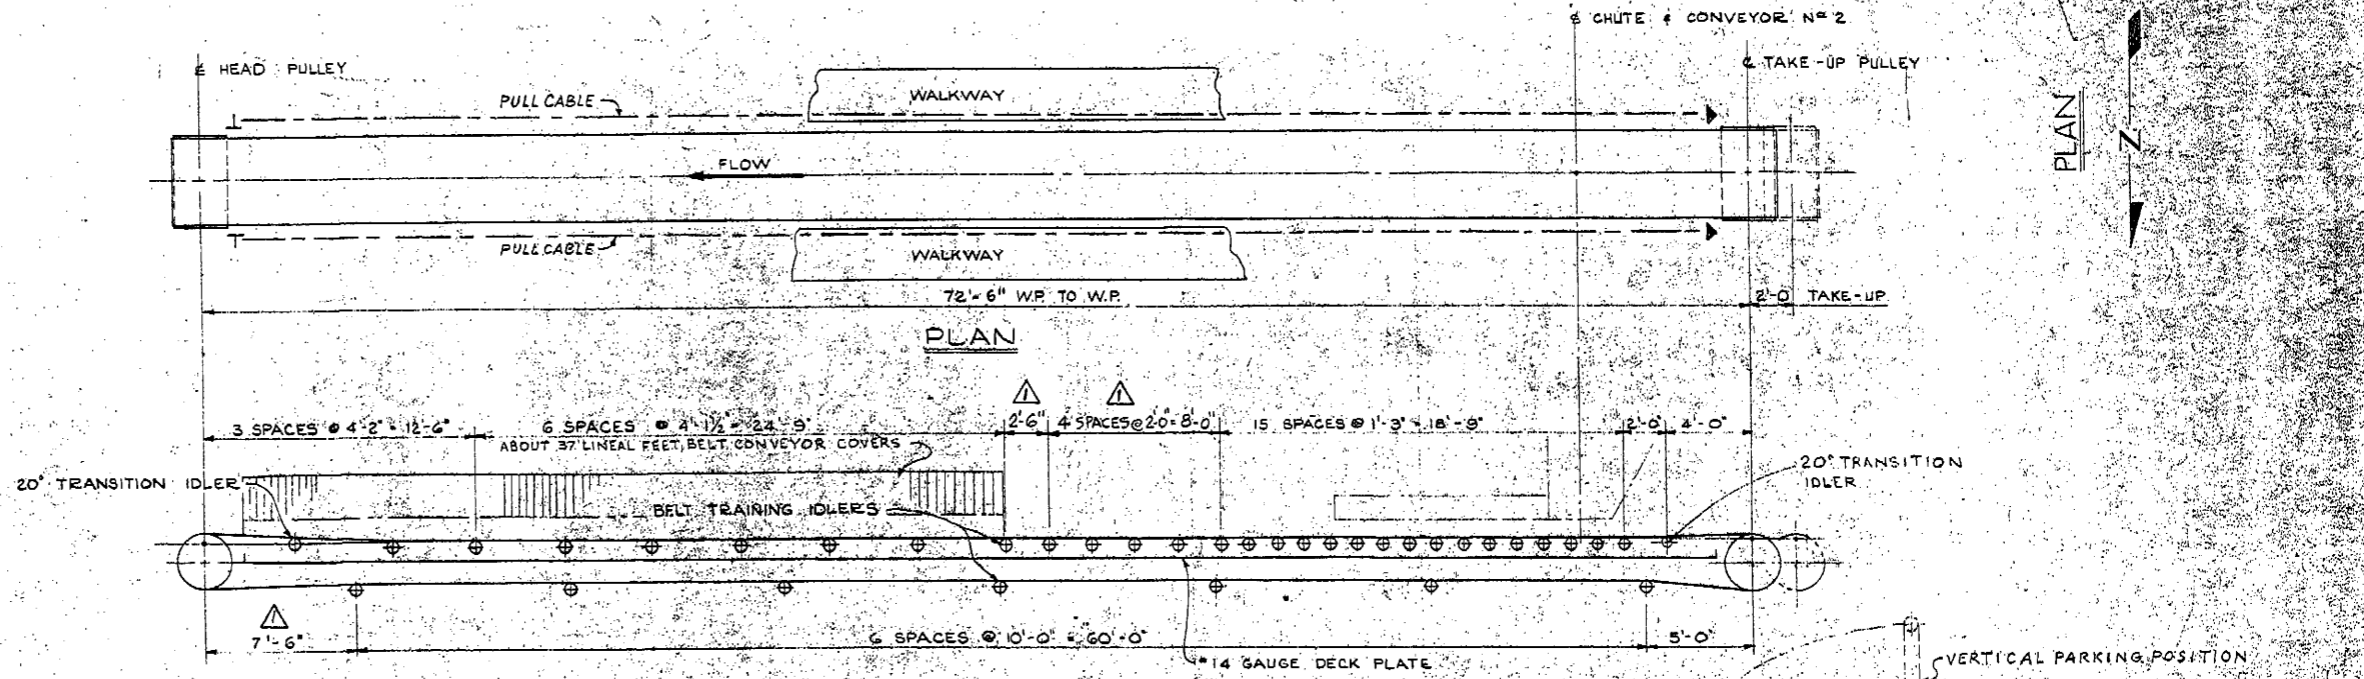

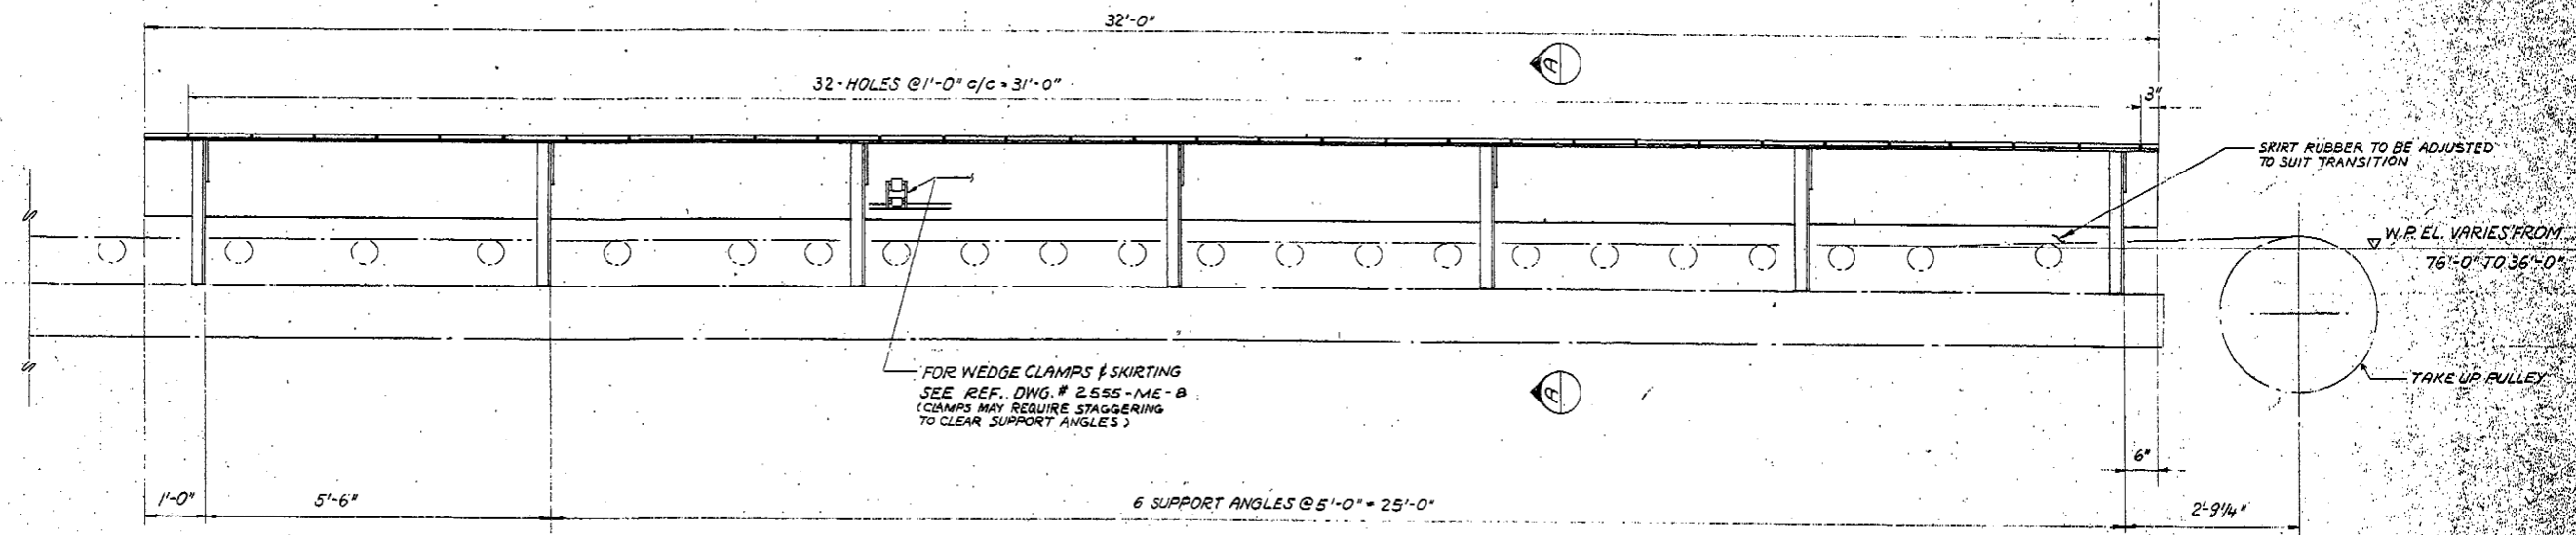


CONVEYOR #3 SKIRTING  
SCALE: 3/4" = 1'-0"

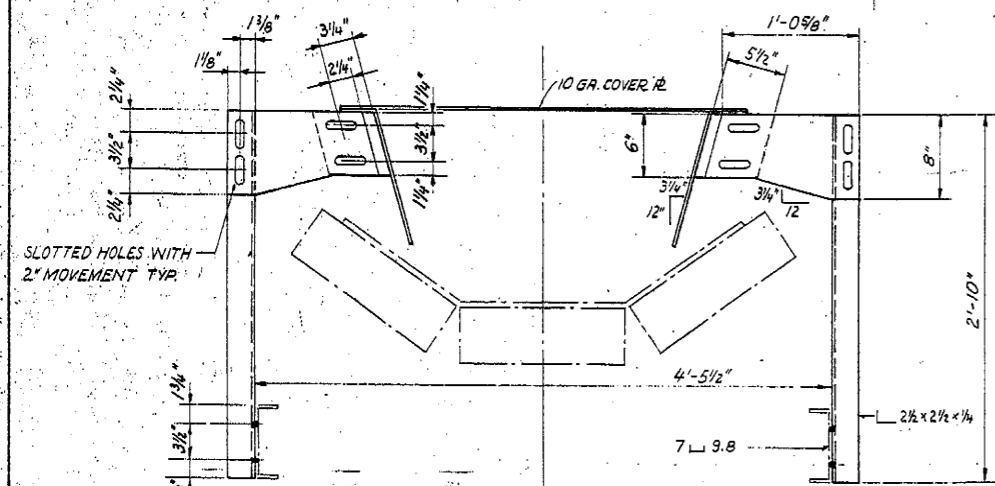


SECTION B  
SCALE: 1 1/2" = 1'-0"

FOR FRONT CURTAIN SEE REF. DWG. # 2555-ME-B

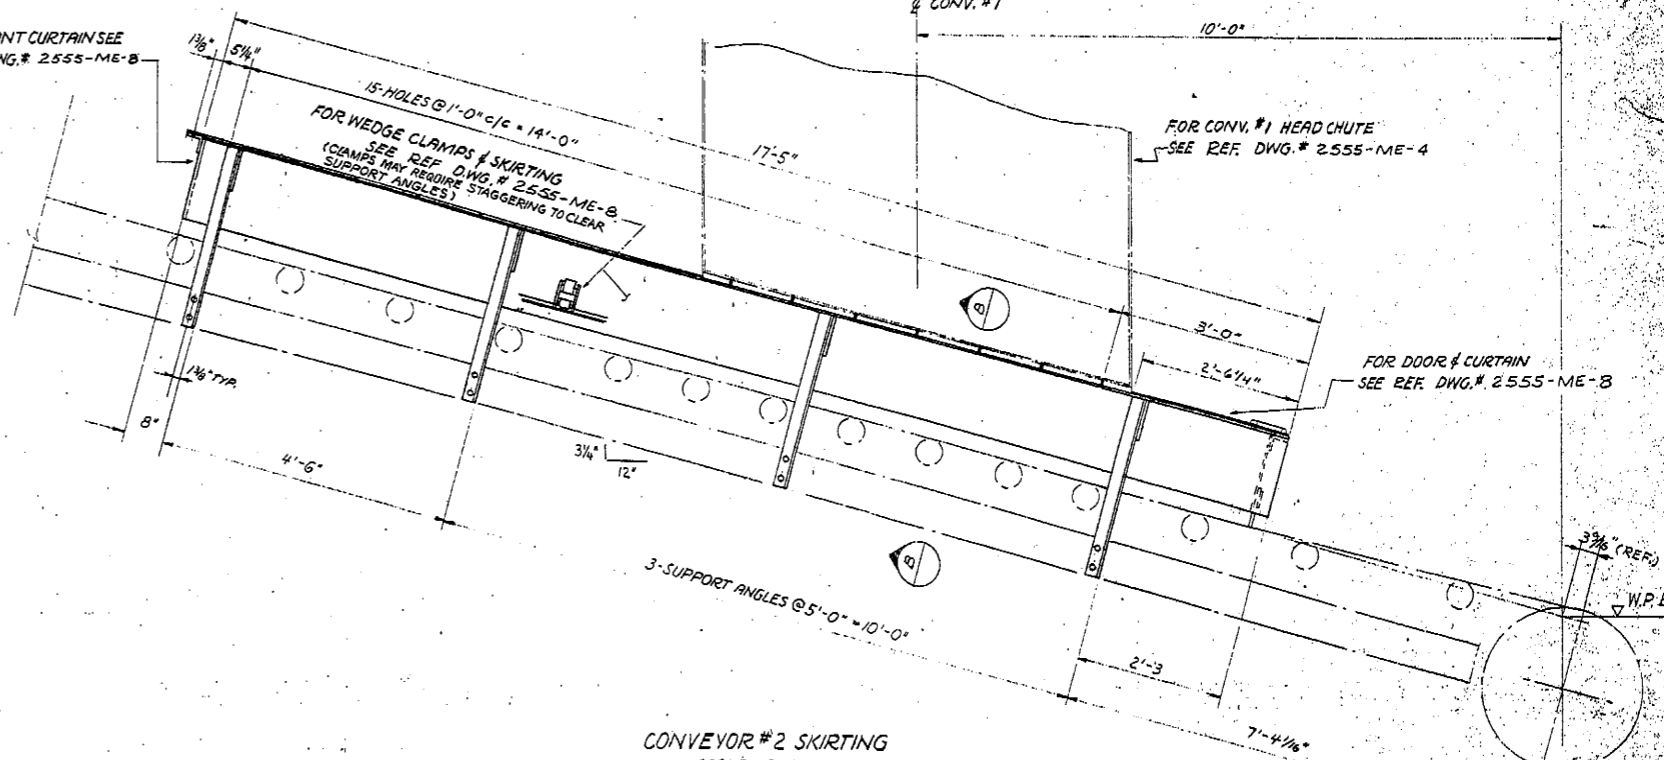

CONVEYOR #2 SKIRTING  
SCALE: 3/4" = 1'-0"

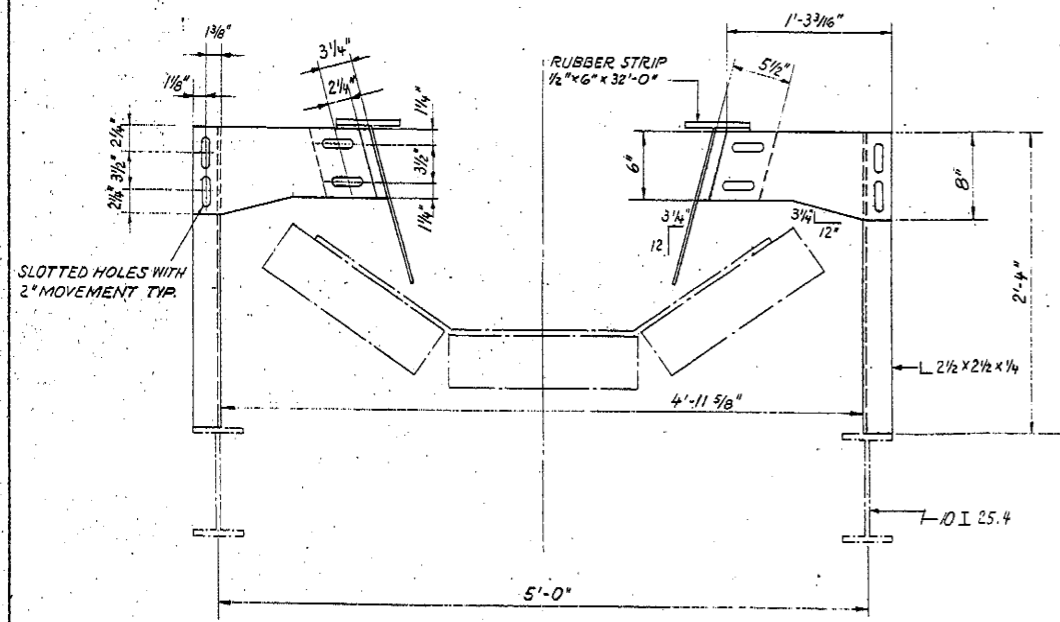


SECTION A  
SCALE: 1 1/2" = 1'-0"


NOTES:  
UNLESS OTHERWISE STATED,  
ALL CONSTRUCTION, WELDING & PAINTING SHALL COMPLY WITH DIVISION II SPECIFICATIONS.  
ALL CONSTRUCTION SHALL BE WELDED.  
ALL PLATES TO BE 1/4" THICK M/S.  
ALL HOLES TO BE 1/16" Ø FOR 5/8" Ø BOLTS.

DRAWING REDUCED TO 45% OF ORIGINAL SIZE


SOT03-1989-AB-2555-ME-7, Conveyor Nos. 2 & 3 - Skirting

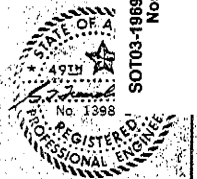


SKIRTING STANDARDS		2555-ME-B	PACIFIC AND ARCTIC RAILWAY AND NAVIGATION COMPANY ORE HANDLING TERMINAL -- PHASE II SKAGWAY ALASKA
CONV. #3 MECH. G.A.		2555-ME-22	
CONV. #2 MECH. G.A.		2555-ME-20	
REFERENCE		DWG. NO.	TIPPETTS - ABBETT - MCCARTHY - STRATTON ENGINEERS AND ARCHITECTS Seattle New York
PREPARED BY: WRIGHT ENGINEERS LIMITED VANCOUVER CANADA			DRAWN BY L.K. DATE MAY 1968 SCALE AS NOTED
DESIGNED BY L.K. CHECKED BY GCH.			
CONVEYOR # 2 & 3 SKIRTING		DRAWING NUMBER 12556/2013	

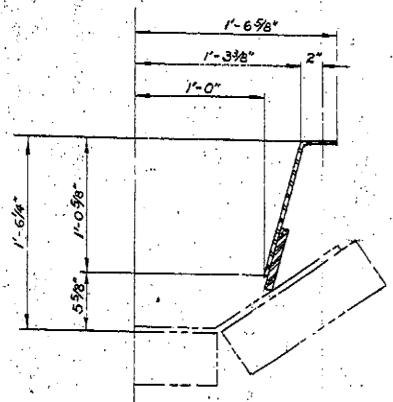




SKIRTING FOR 42" CONVEYOR  
(35° IDLER)  
SCALE: 1/2" = 1'-0"

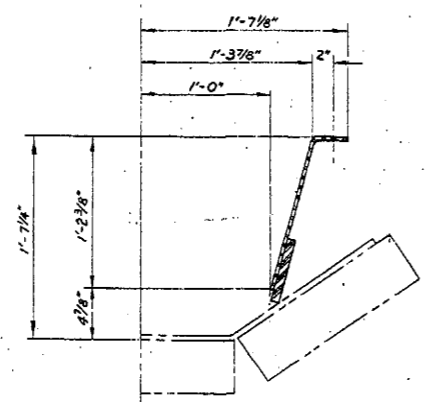


SKIRTING FOR 48" CONVEYOR  
(35° IDLER)  
SCALE: 1/2" = 1'-0"

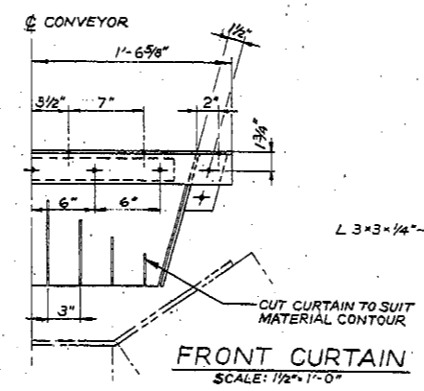


FRONT CURTAIN  
SCALE: 1/2" = 1'-0"

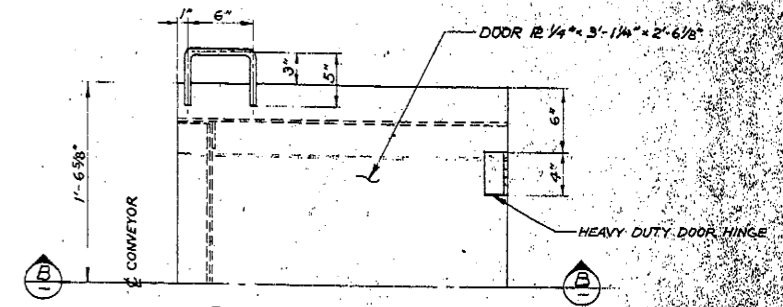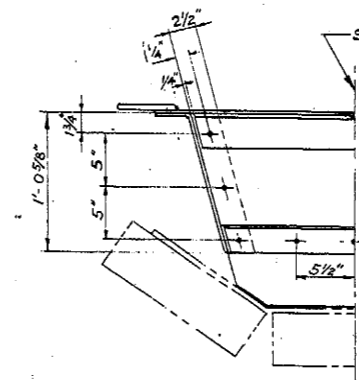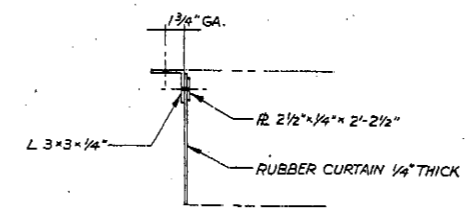

REAR DOOR & CURTAIN  
PLAN  
SCALE: 1/2" = 1'-0"

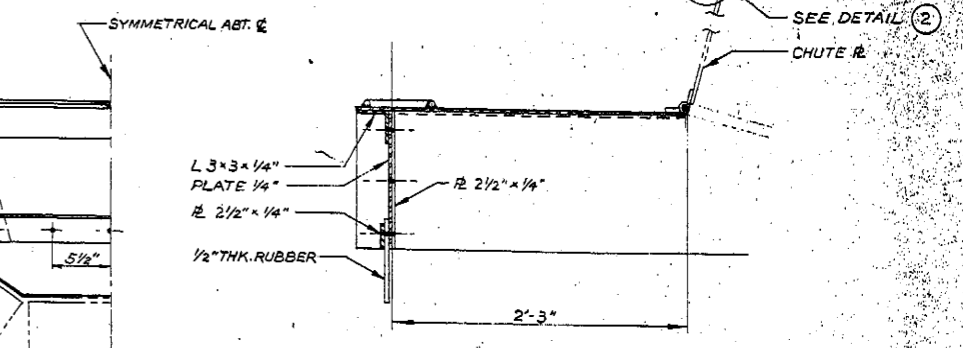


SECTION B-B

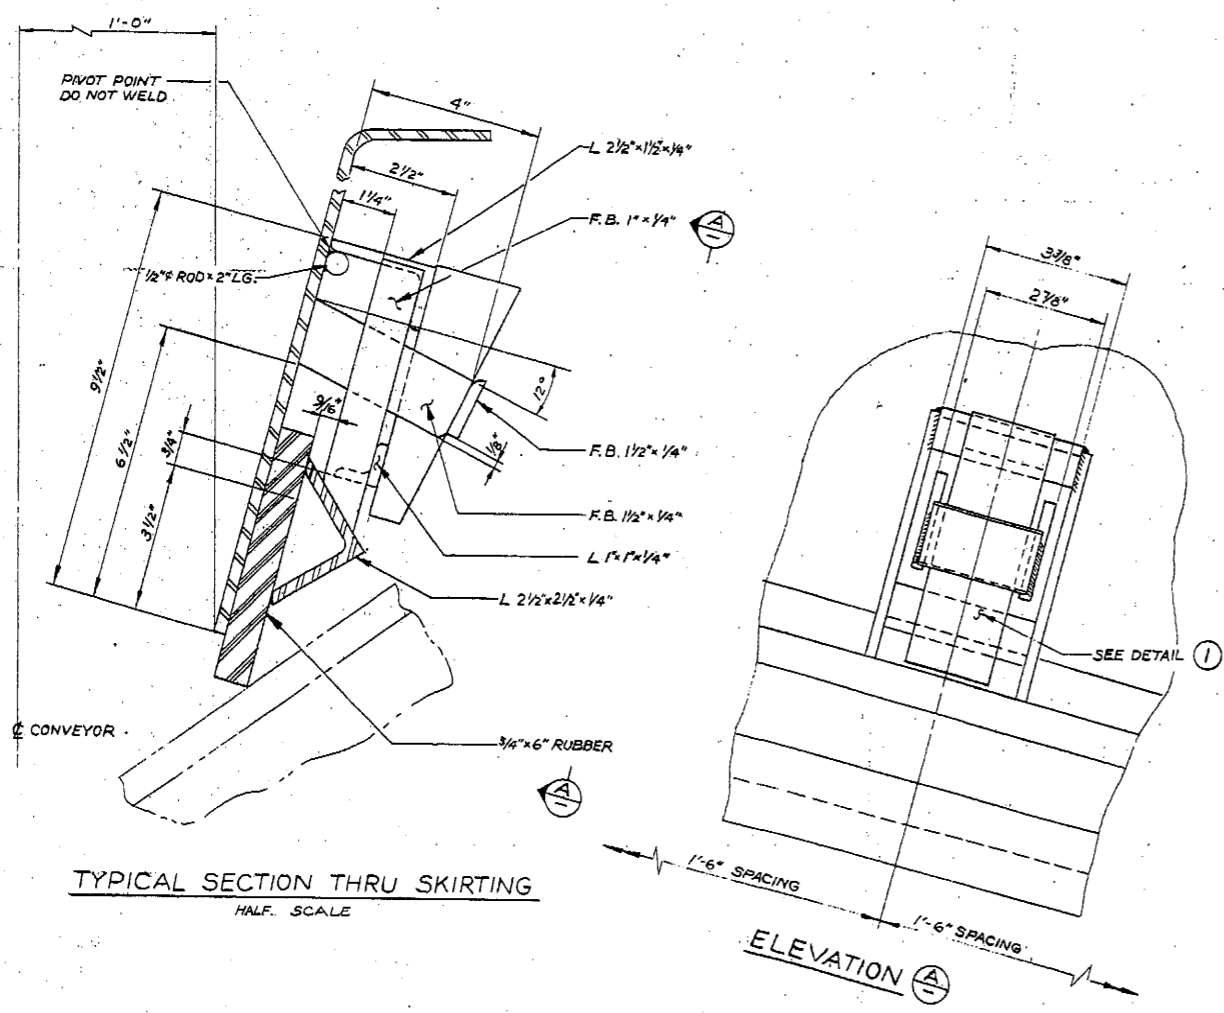


TYPICAL SECTION THRU SKIRTING  
HALF SCALE


ELEVATION A-A

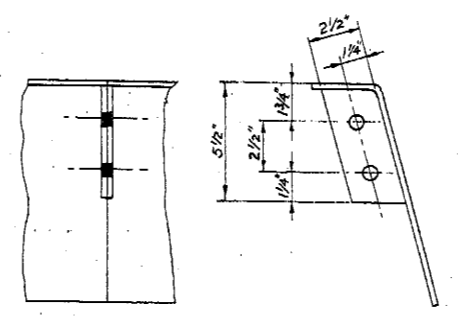

TYPICAL SKIRT JOINT DETAILS  
FOR 42" AND 48" CONVEYORS  
SCALE: 3" = 1'-0"

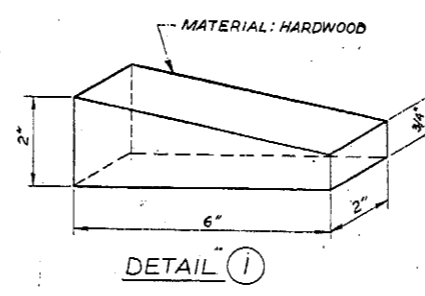


DETAIL 1

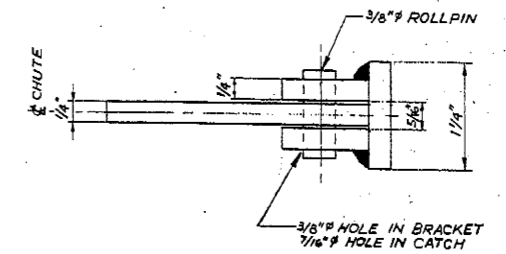

DETAIL 2  
FULL SCALE

- NOTES: (UNLESS OTHERWISE STATED)
1. ALL CONSTRUCTION, WELDING & PAINTING SHALL COMPLY WITH DIVISION II SPECIFICATIONS.
  2. ALL CONSTRUCTION SHALL BE WELDED.
  3. ALL PLATES TO BE 1/4" THICK MILD STEEL.
  4. ALL BOLT HOLES TO BE 1/16" Ø FOR 3/8" Ø BOLTS.

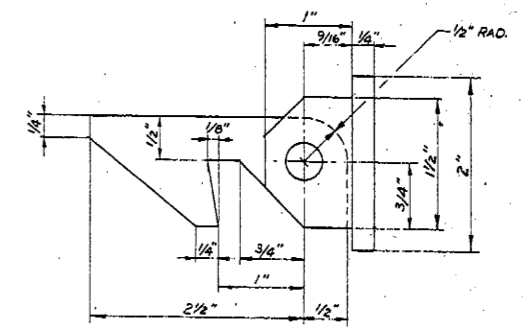

DETAIL 2  
FULL SCALE

DRAWING REDUCED TO 45% OF ORIGINAL SIZE

SOT03-1969-AB-2585-ME-8, Conveyors Standard Skirting Details



	PREPARED BY: <b>WRIGHT ENGINEERS LIMITED</b> VANCOUVER CANADA	PACIFIC AND ARCTIC RAILWAY AND NAVIGATION COMPANY <b>ORE HANDLING TERMINAL -- PHASE II</b> SKAGWAY ALASKA
	REFERENCE: 528 710 408 NO. BY DATE REVISION CHECKED BY GGA	TIPPETTS - ABBETT - MCCARTHY - STRATTON ENGINEERS AND ARCHITECTS Seattle New York
CONVEYORS STANDARD SKIRTING DETAILS		DRAWN BY E.K. DATE MAY 1968 SCALE AS NOTED DRAWING NUMBER 1216/2013