

FFY17-18 DERA PROJECT - ITB 20053

CHIGNIK LAKE DERA PROJECT DESIGN DRAWINGS:

M1	PROJECT DESCRIPTION, SCHEDULE OF DRAWINGS, & MECHANICAL WORK PLANS
M2	GENSET #1 & #4 INSTALLATION DETAILS
M3	GENERATOR FABRICATION DETAILS
E1	ELECTRICAL WORK PLANS & EQUIPMENT SCHEDULE
E2	ELECTRICAL DETAILS
E3.1	SWITCHGEAR MODIFICATIONS
E3.2	24V ENGINE WIRING JUNCTION BOX

CIRCLE DERA PROJECT DESIGN DRAWINGS


M1.1	PROJECT DESCRIPTION, SCHEDULE OF DRAWINGS, & MECHANICAL WORK PLAN
M1.2	MECHANICAL WALL PENETRATIONS & VENTILATION DETAILS
M2.1	GENSET #1 & #2 INSTALLATION DETAILS
M2.2	FUEL PIPING PLAN, DETAILS, & GENSET #3 INSTALLATION
M2.3	EXHAUST & CRANK VENT INSTALLATION DETAILS
M3	GENSET FABRICATION DETAILS
M4.1	PIPING & EQUIPMENT INSTALLATION PLAN, ELEVATION, & DETAILS
M4.2	COOLANT PIPING ISOMETRIC & DETAILS
M4.3	COOLANT PIPING DETAILS
E1	ELECTRICAL WORK PLAN & EQUIPMENT SCHEDULE
E2.1	TYPICAL GENERATION BAY SECTION & DETAILS
E2.2	DETAILS & GENSET #3 SECTION
E3.1	SWITCHGEAR LAYOUT, ONE-LINE, & SCHEMATICS
E3.2	GENSET #1 & #2 24V ENGINE WIRING JUNCTION BOX

TAKOTNA DERA PROJECT DESIGN DRAWINGS:

M1	PROJECT DESCRIPTION, SCHEDULE OF DRAWINGS, & MECHANICAL WORK PLANS
M2	GENSET #2 & #4 INSTALLATION DETAILS
M3	GENSET FABRICATION DETAILS
E1	ELECTRICAL WORK PLANS & EQUIPMENT SCHEDULE
E2	ELECTRICAL DETAILS
E3.1	SWITCHGEAR MODIFICATIONS
E3.2	24V ENGINE WIRING JUNCTION BOX

SWITCHGEAR REFERENCE DRAWINGS

CHIGNIK LAKE SWITCHGEAR ORIGINAL DRAWINGS (28 SHEETS TOTAL)
TAKOTNA SWITCHGEAR ORIGINAL DRAWINGS (32 SHEETS TOTAL)
CROOKED CREEK SWITCHGEAR UPGRADE DRAWINGS (25 SHEETS TOTAL)


PROJECT: FFY17-18 DERA PROJECT		
TITLE: SCHEDULE OF DRAWINGS,		
 P.O. 111405, Anchorage, AK 99511 (907)349-0100	DRAWN BY: BCG	SCALE: AS NOTED
	DESIGNED BY: BCG	DATE: 3/18/20
	FILE NAME: FFY17-18 G1-3	SHEET:
	PROJECT NUMBER:	G1 OF 1

PROJECT DESCRIPTION

1. THE EXISTING CHIGNIK LAKE POWER PLANT WAS ORIGINALLY CONSTRUCTED IN 2003. SEVERAL MODIFICATIONS HAVE BEEN MADE SINCE ORIGINAL CONSTRUCTION. THE PLANT PRESENTLY HAS MULTIPLE MECHANICAL AND ELECTRICAL DEFICIENCIES REQUIRING UPGRADES TO PROVIDE RELIABLE PRIME POWER SERVICE FOR THE COMMUNITY.
2. THE PRIMARY PURPOSE OF THIS PROJECT IS TO INSTALL TWO NEW TIER 3 MARINE DIESEL ENGINE-GENERATOR SETS (GENSETS) AND TO RESTORE FULL MANUAL AND AUTOMATIC PARALLELING CONTROL OF THE NEW AND THE EXISTING GENSETS.
3. EXISTING GENSETS #1 AND #4 WILL BE REMOVED AND REPLACED WITH NEW COMPLETE SKID MOUNTED GENSETS.
4. EXISTING GENSETS #2 & #3 WILL RECEIVE NEW SENSORS, VOLTAGE REGULATORS AND ENGINE CONTROL WIRING JUNCTION BOXES.
5. THE EXISTING SWITCHGEAR WILL BE RETROFIT WITH NEW CONTROLS.
6. IN ADDITION, MINOR MODIFICATIONS WILL BE MADE TO THE PLANT MECHANICAL AND ELECTRICAL SYSTEMS AS INDICATED.


SCHEDULE OF DRAWINGS:

- M1 PROJECT DESCRIPTION, SCHEDULE OF DRAWINGS, & MECHANICAL WORK PLANS
- M2 GENSET #1 & #4 INSTALLATION DETAILS
- M3 GENERATOR FABRICATION DETAILS
- E1 ELECTRICAL WORK PLANS & EQUIPMENT SCHEDULE
- E2 ELECTRICAL DETAILS
- E3.1 SWITCHGEAR MODIFICATIONS
- E3.2 24V ENGINE WIRING JUNCTION BOX

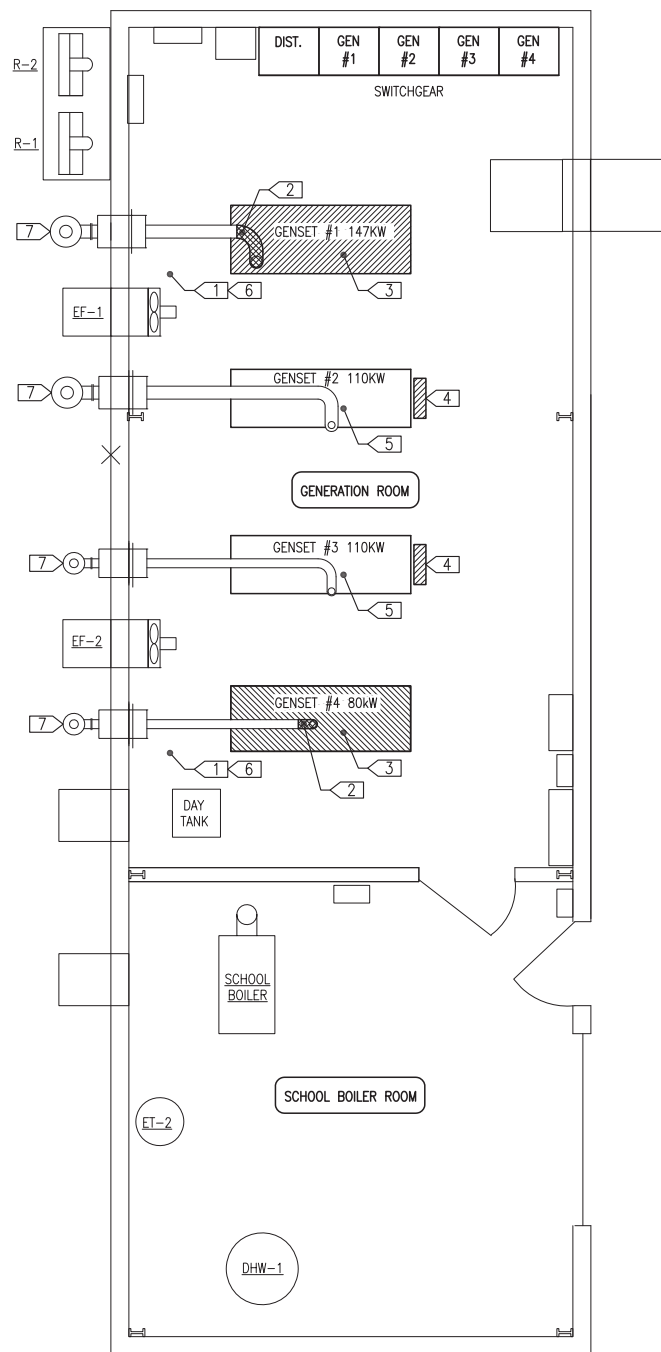

- DEMOLITION GENERAL NOTES:**
1. EXISTING EQUIPMENT AND PIPING TO BE REMOVED INDICATED BY HATCHING
 2. TAKE ALL PRECAUTIONS TO MINIMIZE DAMAGE TO GENERATION EQUIPMENT BEING REMOVED DURING DEMOLITION. TARP GENERATOR ENDS AND SEAL ALL EXPOSED CONNECTIONS PRIOR TO REMOVING FROM PLANT. TURN ALL REMOVED EQUIPMENT OVER TO THE UTILITY FOR FINAL DISPOSITION.
 3. DRAIN GENSETS #1 AND #4 OF ALL FLUIDS AND RENDER UNUSABLE (SEE NOTE 4). SAVE ANY REMAINING GLYCOL AND DIESEL FUEL FOR RE-USE IN NEW SYSTEMS. TURN USED OIL OVER TO THE UTILITY FOR FINAL DISPOSITION
 4. ENGINE BLOCKS FOR GENSETS #1 & #4 MUST BE RENDERED UNUSABLE BY CUTTING A MINIMUM 3"x3" HOLE IN ENGINE BLOCK. PROVIDE PHOTOGRAPHIC DOCUMENTATION OF HOLE AND ASSOCIATED ENGINE NAMEPLATE. COMPLETE DERA CERTIFICATE OF ENGINE DESTRUCTION.
 5. SEE ELECTRICAL PLANS FOR ADDITIONAL DEMOLITION.

- DEMOLITION SPECIFIC NOTES:**
- 1 REMOVE ALL HOSES FOR ENGINE COOLANT & FUEL.
 - 2 CUT OFF EXISTING 6" EXHAUST PIPE (GENSET #1) AND 4" EXHAUST PIPE (GENSET #4) JUST BEFORE ELBOW DOWN AND SAVE FLANGED EXHAUST RISER FOR REUSE ON REPLACEMENT GENSETS.
 - 3 REMOVE EXISTING GENSETS #1 AND #4 IN THEIR ENTIRETY. SEE ELECTRICAL FOR ADDITIONAL DEMOLITION NOTES.
 - 4 SEE ELECTRICAL.
 - 5 GENSETS #2 & #3 TO REMAIN, SEE NEW WORK PLAN FOR INSTRUMENTATION UPGRADES.
 - 6 REMOVE EXISTING 12V BATTERY CHARGER & BATTERIES IN PREPARATION FOR REPLACEMENT, SEE ELECTRICAL.
 - 7 REMOVE EXISTING RAIN CAP FROM EXISTING EXHAUST PIPE RISER.
 - 8 SEE ELECTRICAL.

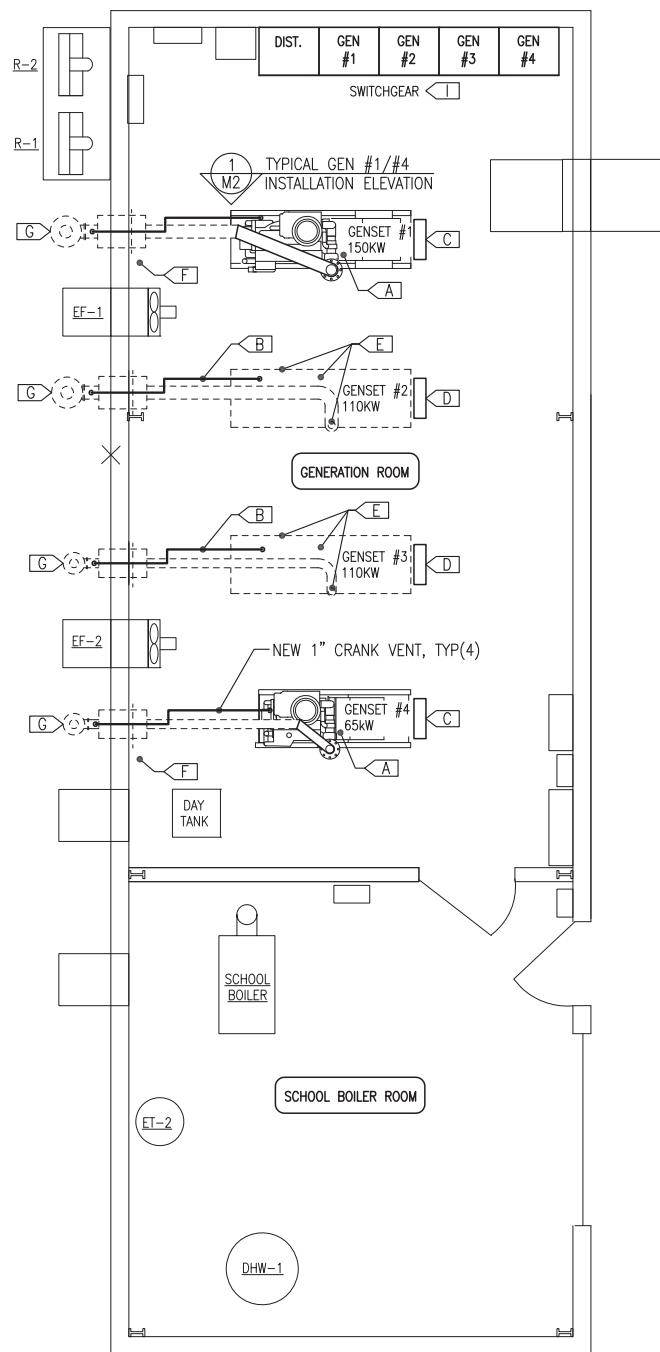

- NEW WORK GENERAL NOTES:**
1. EXISTING EQUIPMENT AND PIPING TO REMAIN IN SERVICE SHOWN WITH LIGHT DASHED LINES.
 2. NEW EQUIPMENT AND PIPING TO BE INSTALLED SHOWN WITH DARK SOLID LINES.
- NEW WORK SPECIFIC NOTES:**
- A INSTALL NEW GENSETS #1 & #4 INCLUDING COOLANT, FUEL, EXHAUST, & CRANK VENT CONNECTIONS. SEE TYPICAL INSTALLATION ELEVATION 1/M2. SEE ELECTRICAL FOR ADDITIONAL INSTALLATION DETAILS.
 - B FURNISH & INSTALL NEW CRANK VENT SYSTEM ON EXISTING GENSETS #2 & #3. SEE TYPICAL INSTALLATION ELEVATION 1/M2, SIMILAR.
 - C INSTALL NEW 24V ENGINE WIRING J-BOX ON GENSETS #1 & #4, SEE ELECTRICAL.
 - D REVISE WIRING CONNECTIONS ON EXISTING 12V ENGINE WIRING J-BOX ON GENSETS #2 & #3, SEE ELECTRICAL.
 - E FURNISH & INSTALL NEW SENSORS ON EXISTING ENGINE IN ACCORDANCE WITH SPECIFICATIONS. WELD 1/4" FPT COUPLING TO EXISTING 4" STEEL EXHAUST PIPE IN ACCESSIBLE LOCATION FOR INSTALLATION OF EXHAUST GAS TEMPERATURE SENSOR. TAP EXISTING AIR INTAKE FOR INSTALLATION OF AIR FILTER VACUUM SENSOR. INSTALL OIL LEVEL SITE GAUGE/SWITCH IN ACCORDANCE WITH DETAIL 4/M3. SEE ELECTRICAL FOR ADDITIONAL DETAIL.
 - F INSTALL NEW 24V BATTERY CHARGER & BATTERIES. SEE ELECTRICAL.
 - G INSTALL NEW STAINLESS STEEL RAIN CAP ON EXISTING EXHAUST PIPE RISER, 6" IRON PIPE SIZE ON GENSETS #1 & #2, 4" IRON PIPE SIZE ON GENSETS #3 & #4.
 - H SEE ELECTRICAL.
 - I MODIFY SWITCHGEAR. SEE ELECTRICAL.

1 M1 DEMOLITION PLAN
1/4"=1'-0"


2 M1 NEW WORK PLAN
1/4"=1'-0"

ISSUED FOR CONSTRUCTION
FEB 2020




PROJECT:	FFY17-18 DERA PROJECT CHIGNIK LAKE POWER PLANT UPGRADE		
TITLE:	PROJECT DESCRIPTION, SCHEDULE OF DRAWINGS, & MECHANICAL WORK PLANS		
DRAWN BY: JTD	SCALE: AS NOTED	DESIGNED BY: BCG	DATE: 3/18/20
FILE NAME: CLAKDERA M1-3	SHEET: M1	PROJECT NUMBER:	OF 3



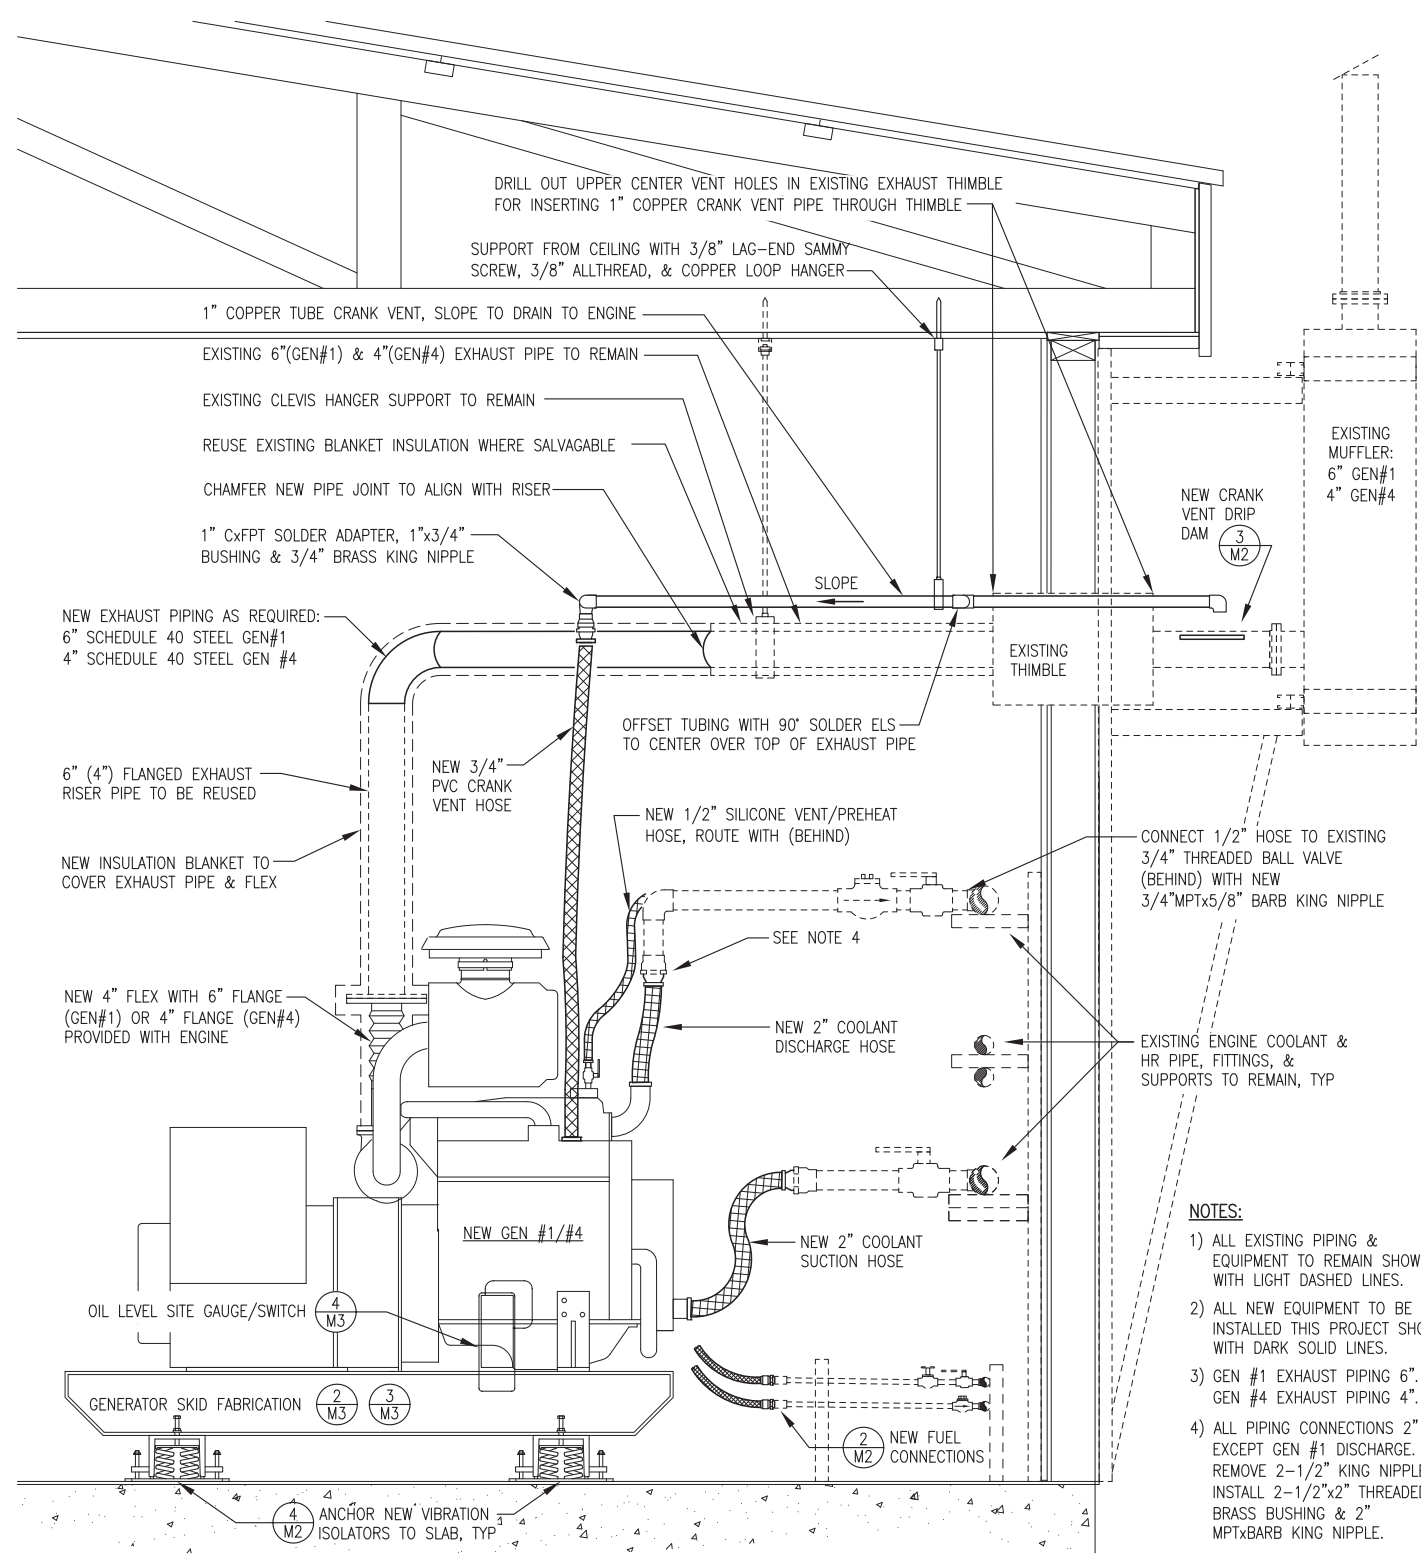


1 GEN #1/#4 INSTALLATION ELEVATION (GEN #2/#3 MODS SIMILAR)
1"=1'-0"

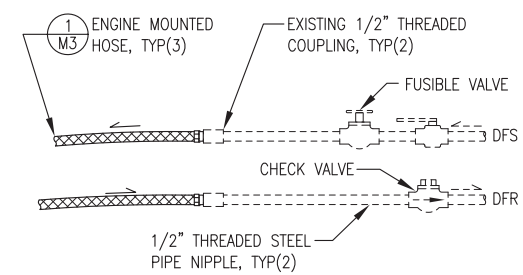


- NOTES:**
- 1) EXISTING PIPING & VALVES 1/2" THREADED.
 - 2) FIELD CUT NEW ENGINE MOUNTED HOSES TO LENGTH & REINSTALL JIC FITTINGS.

2 TYPICAL FUEL PIPING CONNECTIONS
NO SCALE

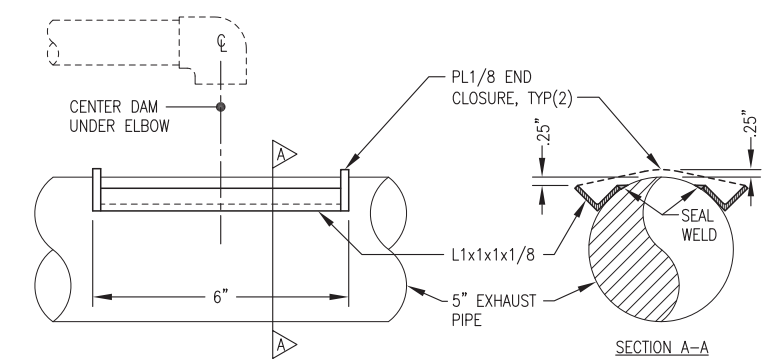

3 CRANKCASE DRIP DAM FABRICATION DETAIL
NO SCALE

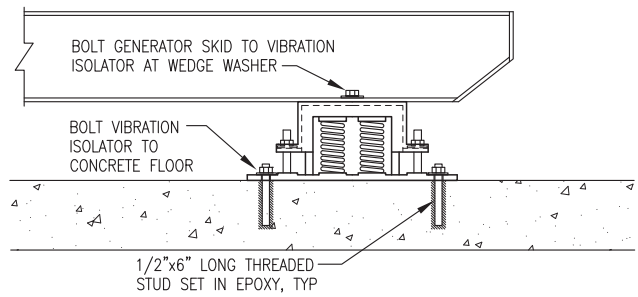

NOTE: AFTER INSTALLATION ADJUST SPRING VIBRATION ISOLATOR LEVELING BOLTS TO ACHIEVE A UNIFORM INSTALLATION HEIGHT OF APPROXIMATELY 5-3/4" THEN TIGHTEN LOCKING NUTS. ADJUST NUTS ON STABILIZER BOLTS TO ACHIEVE A UNIFORM CLEARANCE OF APPROXIMATELY 1/8" THEN TIGHTEN LOCKING NUTS. VERIFY UNIT MOVES FREELY ON ISOLATORS.

4 TYPICAL GENERATOR VIBRATION ISOLATOR INSTALLATION
NO SCALE

NOTES:

- 1) ALL EXISTING PIPING & EQUIPMENT TO REMAIN SHOWN WITH LIGHT DASHED LINES.
- 2) ALL NEW EQUIPMENT TO BE INSTALLED THIS PROJECT SHOWN WITH DARK SOLID LINES.
- 3) GEN #1 EXHAUST PIPING 6". GEN #4 EXHAUST PIPING 4".
- 4) ALL PIPING CONNECTIONS 2" EXCEPT GEN #1 DISCHARGE. REMOVE 2-1/2" KING NIPPLE & INSTALL 2-1/2"x2" THREADED BRASS BUSHING & 2" MPTxBARB KING NIPPLE.

ISSUED FOR CONSTRUCTION
FEB 2020




PROJECT: FFY17-18 DERA PROJECT CHIGNIK LAKE POWER PLANT UPGRADE	
TITLE: GENSET #1 & #4 INSTALLATION DETAILS	
DRAWN BY: JTD	SCALE: AS NOTED
DESIGNED BY: BCG	DATE: 3/18/20
FILE NAME: CLAKDERA M1-3	SHEET: M2 OF 3
PROJECT NUMBER:	




MINIMUM HOSE SIZE SCHEDULE		
FUEL SUPPLY	FUEL RETURN	USED OIL
#8	#8	N/A


NOTE:
ON 4045'S GROUP HOSES
ON LEFT SKID AS SHOWN
TO COORDINATE WITH
COOLANT HOSES.

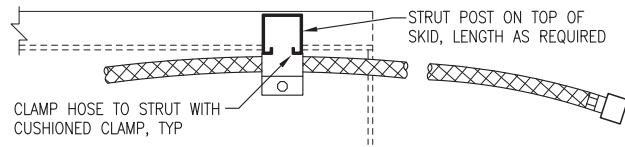

LEFT SKID PLAN (TOP) VIEW

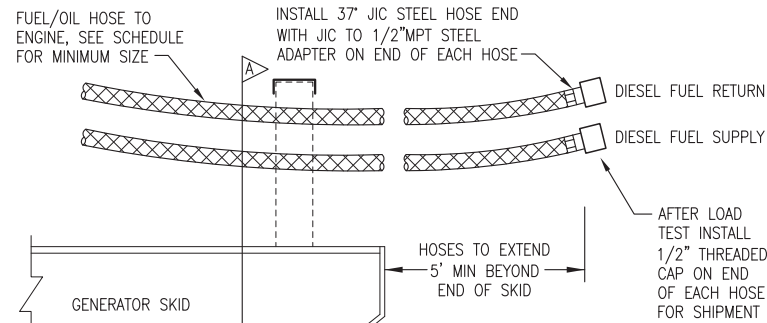


ELEVATION (SIDE) VIEW

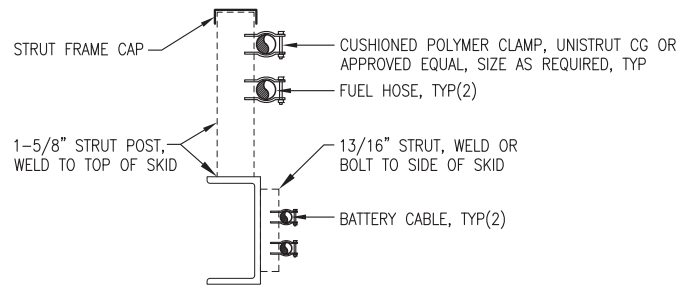


SECTION A-A


1 FUEL/OIL HOSE & BATTERY CABLE INSTALLATION ON SKID
M3 NO SCALE

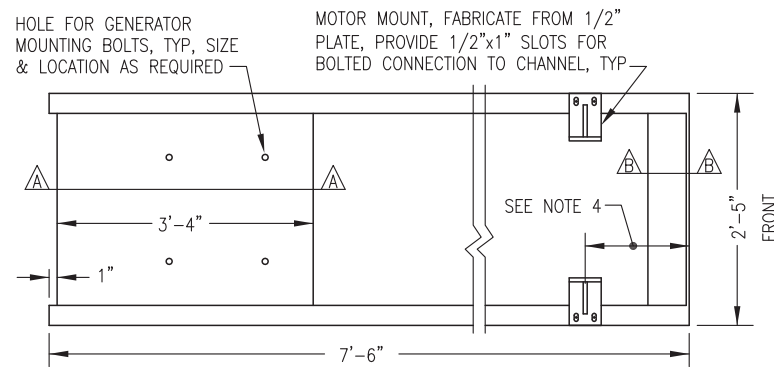


PLAN (TOP) VIEW

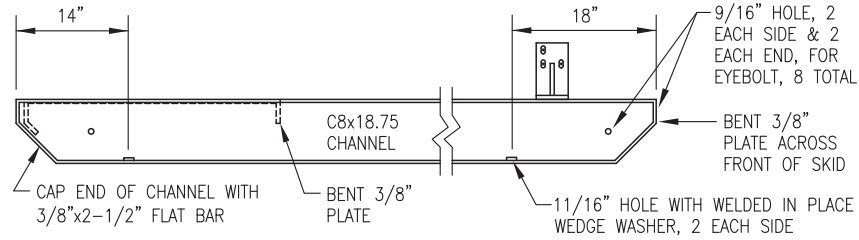

ELEVATION (SIDE) VIEW

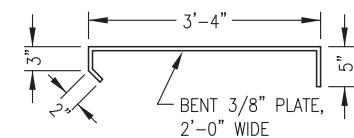

SECTION A-A

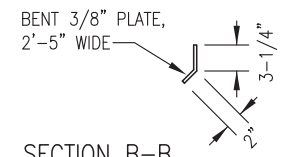


SECTION B-B


NOTES:

- 1) FABRICATE FROM ASTM A-36 STEEL. BEND PLATES & CUT ENDS OF CHANNELS AT 90° & 45° AS SHOWN.
- 2) EXCEPT WHERE INDICATED AS BOLTED MAKE ALL CONNECTIONS WITH CONTINUOUS WELDS (FILLET OR FULL-PENETRATION GROOVE AS REQUIRED) IN ACCORDANCE WITH CURRENT AWS STANDARD CODE.
- 3) ROUND ALL CORNERS & GRIND WELDS SMOOTH AFTER FABRICATION. PAINT TO MATCH ENGINE-GENERATOR.
- 4) PLACE UNIT ON SKID SO THAT THE EXHAUST RISER CENTERLINE IS 4'-2" FROM THE FRONT OF THE SKID.


2 GENSET #1 (6068) SKID FABRICATION
M3 NO SCALE

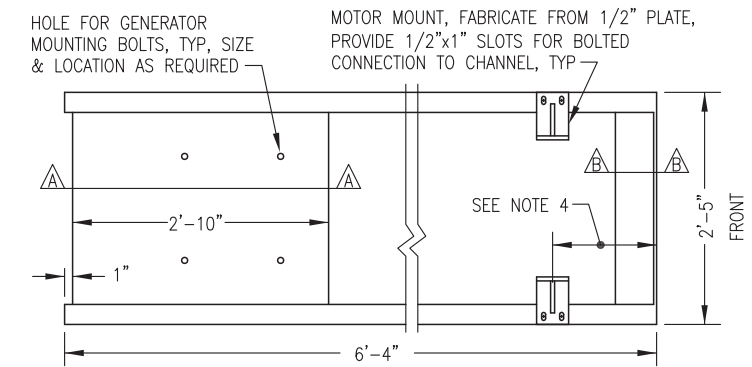


PLAN (TOP) VIEW

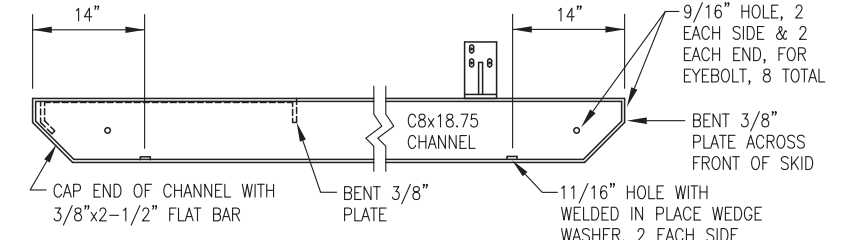

ELEVATION (SIDE) VIEW

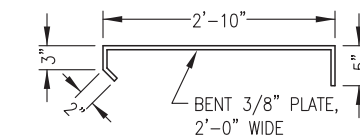

SECTION A-A

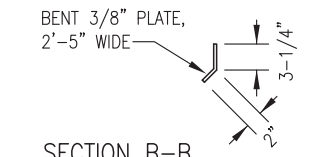


SECTION B-B

NOTES:

- 1) FABRICATE FROM ASTM A-36 STEEL. BEND PLATES & CUT ENDS OF CHANNELS AT 90° & 45° AS SHOWN.
- 2) EXCEPT WHERE INDICATED AS BOLTED MAKE ALL CONNECTIONS WITH CONTINUOUS WELDS (FILLET OR FULL-PENETRATION GROOVE AS REQUIRED) IN ACCORDANCE WITH CURRENT AWS STANDARD CODE.
- 3) ROUND ALL CORNERS & GRIND WELDS SMOOTH AFTER FABRICATION. PAINT TO MATCH ENGINE-GENERATOR.
- 4) PLACE UNIT ON SKID SO THAT THE EXHAUST RISER CENTERLINE IS 3'-3" FROM THE FRONT OF THE SKID.

3 GENSET #4 (4045) SKID FABRICATION
M3 NO SCALE

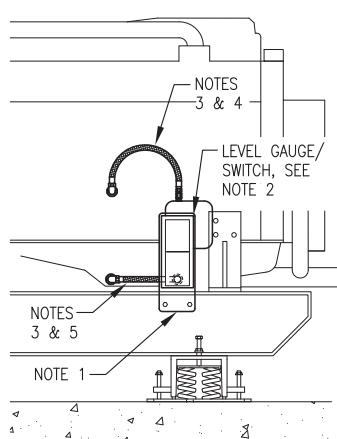

NOTES:

- 1) 1/4" STEEL SUPPORT PLATE PRE-DRILLED TO MATCH GAUGE/SWITCH MOUNTS, CHANNEL SKID HOLES AND BOTTOM HOSE ENTRANCE. BOLT TO INSIDE (BACK) OF CHANNEL SKID AT HEIGHT AS REQUIRED TO CENTER GAUGE AT NORMAL FULL OIL LEVEL. ADJUST SWITCH CONTACTS 1/2" ABOVE & BELOW.
- 2) SEE ENGINE GENERATOR SPECIFICATIONS FOR LEVEL/GUAGE SWITCH. MOUNT TO STEEL SUPPORT PLATE WITH RUBBER SHOCK MOUNTS.
- 3) #8 HOSE WITH 1/2" OR 3/8" NPT JIC SWIVEL ENDS AS REQUIRED.
- 4) CONNECT TOP (VENT) PORT TO ENGINE CRANK CASE WITH HOSE. ROUTE UPPER HOSE TO AVOID LOW POINT TRAPS.
- 5) CONNECT BOTTOM PORT TO ENGINE OIL PAN WITH HOSE. DO NOT TEE INTO OIL DRAIN LINE. ROUTE LOWER HOSE BACK THROUGH PRE-DRILLED HOLE IN STEEL PLATE.

4 TYPICAL OIL LEVEL GAUGE/SWITCH INSTALLATION
M3 NO SCALE


ISSUED FOR
CONSTRUCTION
FEB 2020



PROJECT:	FFY17-18 DERA PROJECT CHIGNIK LAKE POWER PLANT UPGRADE	
TITLE:	GENERATOR FABRICATION DETAILS	
DRAWN BY: JTD	SCALE: AS NOTED	
DESIGNED BY: BCG	DATE: 3/18/20	
FILE NAME: CLAKDERA M1-3	SHEET:	M3 OF 3
PROJECT NUMBER:		

- DEMOLITION GENERAL NOTES:**
- EXISTING EQUIPMENT AND PIPING TO BE REMOVED INDICATED BY HATCHING
 - THIS PLANT PROVIDES PRIME POWER TO THE COMMUNITY OF CHIGNIK LAKE AND TO THE SCHOOL COMPLEX. KEEP OUTAGES TO A MINIMUM AND COORDINATE ALL REQUIRED OUTAGES WITH THE UTILITY AND SCHOOL.
 - ALL ITEMS TO REMAIN UNLESS SPECIFICALLY INDICATED FOR REMOVAL.
 - ENSURE ALL EQUIPMENT AND CIRCUITS TO BE REMOVED ARE DE-ENERGIZED PRIOR TO BEGINNING DEMOLITION. LOCK AND TAG OUT ALL AFFECTED CIRCUIT BREAKERS AND DISCONNECTS.
 - TAKE ALL PRECAUTIONS TO MINIMIZE DAMAGE TO ELECTRICAL EQUIPMENT AND CONDUCTORS BEING SALVAGED FOR REUSE. TURN ALL REMOVED MATERIALS AND EQUIPMENT OVER TO THE UTILITY FOR FINAL DISPOSITION IF NOT REUSED.

- DEMOLITION SPECIFIC NOTES:**
- SEE MECHANICAL.
 - SEE MECHANICAL.
 - REMOVE EXISTING GENSETS #1 & #4 IN THEIR ENTIRETY. EXISTING POWER & CONTROL CONDUCTORS & ASSOCIATED CONDUIT & FITTINGS TO REMAIN IN PLACE FOR RECONNECTION TO NEW GENSETS. CAREFULLY SEPARATE EXISTING MUGULS & FITTINGS FROM GENERATOR ENCLOSURES & DISCONNECT ALL CONDUCTORS. TAPE ENDS & COIL CONDUCTORS IN SECURE LOCATION TO PROTECT FROM DAMAGE DURING GENSET REPLACEMENT.
 - EXISTING GENSET #2 & #3 12V ENGINE WIRING J-BOXES TO REMAIN. SEE NEW WORK PLAN FOR WIRING CHANGES.
 - EXISTING GENSETS #2 & #3 TO REMAIN. SEE NEW WORK PLAN FOR INSTRUMENTATION UPGRADES.
 - REMOVE EXISTING 12V BATTERY CHARGERS & BATTERIES FROM GENSETS #1 & #4.
 - SEE MECHANICAL
 - ALL EXISTING GENERATOR WIREWAY, CONDUIT, POWER CONDUCTORS, & CONTROL WIRING TO REMAIN.

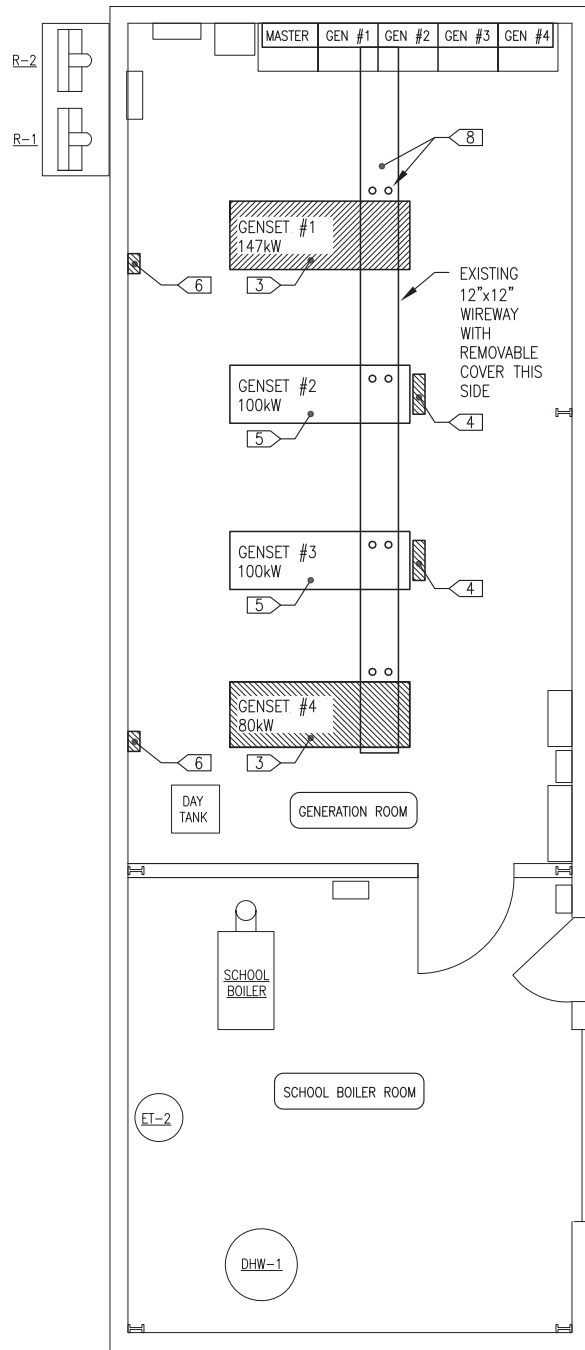

1
E1 DEMOLITION PLAN
1/4"=1'-0"

- NEW WORK GENERAL NOTES:**
- EXISTING EQUIPMENT TO REMAIN IN SERVICE SHOWN WITH LIGHT DASHED LINES.
 - NEW EQUIPMENT TO BE INSTALLED SHOWN WITH DARK SOLID LINES.
 - RECONNECT EXISTING POWER & CONTROL CONDUCTORS & ASSOCIATED CONDUIT & FITTINGS TO TO NEW GENSETS AS INDICATED.

- NEW WORK SPECIFIC NOTES:**
- A** CONNECT EXISTING POWER CONDUCTORS TO NEW GENSET & GROUND GENERATOR FRAME. SEE ELEVATION 1/E2. SEE MECHANICAL FOR ADDITIONAL INSTALLATION DETAILS
 - B** SEE MECHANICAL
 - C** INSTALL NEW 24V ENGINE WIRING J-BOX ON GENSETS #1 & #4, SEE ELEVATION 1/E2. REUSE EXISTING CONTROL CONDUCTORS FROM GENERATOR TO SWITCHGEAR & ADD NEW #18 SHIELDED PAIRS ADDED AS REQUIRED. TERMINATE ALL ACTIVE CONTROL CONDUCTORS AS SHOWN ON SHEET E3.2. TAPE ENDS AND NEATLY COIL UNUSED CONDUCTORS IN J-BOX.
 - D** REVISE ENGINE SENSING AND CONTROL WIRING TERMINATIONS IN EXISTING 12V ENGINE WIRING J-BOX ON GENSETS #2 & #3 TO MATCH 24V ENGINE WIRING J-BOX TERMINATIONS, SEE SHEET E3.2. ADD NEW INSTRUMENTATION CONNECTIONS PER NOTE E. NOTE THAT EXISTING VOLTAGE REGULATOR & ASSOCIATED WIRING TO REMAIN UNCHANGED EXCEPT FOR BIAS CONNECTIONS TO TERMINATE ON TERMINALS 25 & 26 TO MATCH 24V ENGINE WIRING.
 - E** INSTALL NEW SENSORS ON EXISTING GENSETS #2 & #3 AS INDICATED BELOW. SEE SPECIFICATIONS & MECHANICAL FOR ADDITIONAL DETAIL. ROUTE #18 SHIELDED PAIR FROM EACH DEVICE TO EXISTING ENGINE WIRING J-BOX. CONNECT EXISTING GENERATOR CONTROL WIRING FROM SWITCHGEAR TO TERMINALS IN J-BOX.
 - EXHAUST GAS TEMPERATURE SENSOR
 - AIR FILTER VACUUM SENSOR
 - OIL LEVEL SITE GAUGE/SWITCH
 - F** INSTALL NEW 24V BATTERY CHARGER, TWO NEW BATTERIES & STARTER CABLES FOR NEW GENSETS #1 & #4. SEE DETAIL 3/E2.
 - G** SEE MECHANICAL.
 - H** INSTALL NEW 4 PAIR #18 SHIELDED FROM SWITCHGEAR TO EACH ENGINE WIRING J-BOX FOR ECU SPEED, EXHAUST TEMP, VOLTAGE BIAS, & J1939 CANBUS. SEE SHEET E3.2. 16 PAIRS TOTAL.
 - I** MODIFY SWITCHGEAR FOR AUTOMATIC PARALLELING OPERATION UPGRADE FOR NEW & EXISTING GENSETS, SEE SHEET E3.1 & SPECIFICATIONS.


ELECTRICAL EQUIPMENT/DEVICE SCHEDULE

SYMBOL	SERVICE	DESCRIPTION	MANUFACTURER/MODEL
1	BATTERY CHARGER	12/24-VOLT SOLID STATE 20-AMP AUTO-EQUALIZING BATTERY CHARGER FOR 120 VAC INPUT, WITH OPTIONAL HIGH/LOW VOLTAGE, AC POWER FAILURE, & REMOTE SUMMARY ALARM RELAYS	SENS NRG22-20-RCLS OR EQUAL

ELECTRICAL CONDUCTOR SCHEDULE

SERVICE/FUNCTION	DESCRIPTION	MANUFACTURER/MODEL	NOTES:
GENERAL USE CONDUCTORS	CLASS B CONCENTRIC STRANDED, SOFT DRAWN COPPER, TYPE XHHW INSULATION, 600V AND 75C RATED.		
SHIELDED/TWISTED INSTRUMENT & CONTROL & CONDUCTORS	#18 AWG STRANDED TINNED COPPER CONDUCTORS, 600V POLYETHYLENE INSULATION, 100% COVERAGE ALUMINUM FOIL-POLYESTER TAPE SHIELD WITH STRANDED TINNED COPPER DRAIN WIRE & PVC OUTER JACKET	BELDEN PART #'S SINGLE PAIR: #1120A FOUR PAIR: #1049A SINGLE TRIAD: #1121A	GROUND SHIELD DRAIN WIRE AT PANEL END ONLY.


- COLOR CODING - UNLESS SPECIFICALLY INDICATED OTHERWISE COLOR CODE CONDUCTORS AS FOLLOWS:**
- 480-VOLT POWER CONDUCTORS
 - PHASE A - BROWN
 - PHASE B - ORANGE
 - PHASE C - YELLOW
 - NEUTRAL - WHITE WITH YELLOW STRIPE
 - 120/208-VOLT POWER CONDUCTORS
 - PHASE A - BLACK
 - PHASE B - RED
 - PHASE C - BLUE
 - NEUTRAL - WHITE
 - 24 VOLT DC CONDUCTORS
 - +24VDC - RED or RED WITH GRAY STRIPE
 - 24VDC - BLACK or BLACK WITH GRAY STRIPE
 - CONTROL & INSTRUMENT CONDUCTORS
 - COLOR CODED PER MANUFACTURER'S STANDARD
- NOTES:**
- FOR NO. 6 AWG AND SMALLER CONDUCTORS COLOR CODING SHALL BE PROVIDED BY USING CONDUCTORS WITH CONTINUOUS COLOR EMBEDDED IN THE INSULATION. FOR ALL CONDUCTORS LARGER THAN NO. 6 SCOTCH 35 MARKING TAPE OR EQUIVALENT MAY BE USED TO COLOR CODE THE CABLE. WHERE MARKING TAPE IS USED THE CABLE SHALL BE IDENTIFIED AT EVERY ACCESSIBLE LOCATION. PROVIDE A MINIMUM OF 2 INCHES OF TAPE AT EACH LOCATION.
 - GROUNDING - PROVIDE A SEPARATE EQUIPMENT GROUNDING CONDUCTOR IN EACH RACEWAY. DO NOT USE THE CONDUIT AS AN EQUIPMENT GROUNDING CONDUCTOR. EQUIPMENT GROUNDING CONDUCTORS SHALL BE OF THE SAME TYPE AS THE PHASE CONDUCTORS AND SHALL BE SIZED AS INDICATED ON THE DRAWINGS. CONDUCTORS NOT INDICATED SHALL BE SIZED IN ACCORDANCE WITH THE NATIONAL ELECTRICAL CODE.

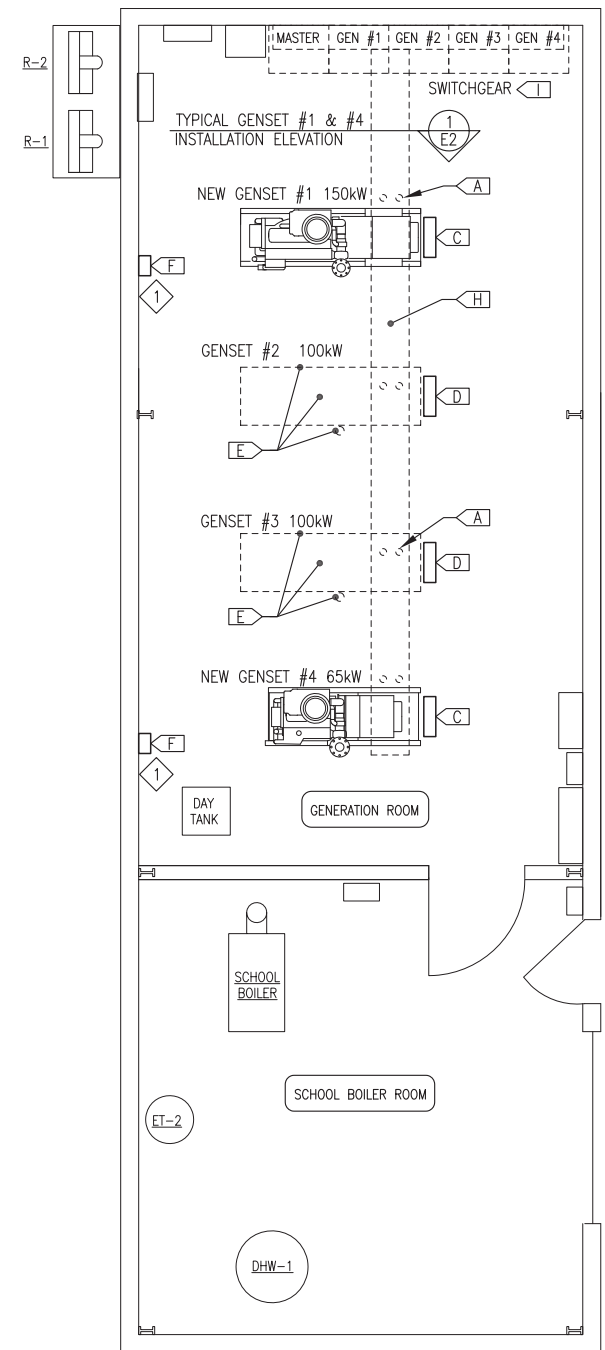

2
E1 NEW WORK PLAN
1/4"=1'-0"



PROJECT: FFY17-18 DERA PROJECT CHIGNIK LAKE POWER PLANT UPGRADE	
TITLE: ELECTRICAL WORK PLANS & SCHEDULES	
DRAWN BY: JTD	SCALE: AS NOTED
DESIGNED BY: CWV/BCG	DATE: 3/18/20
FILE NAME: CLAKDERA E1-3	SHEET: E1 OF 3
PROJECT NUMBER:	
P.O. 111405, Anchorage, AK 99511 (907)349-0100	


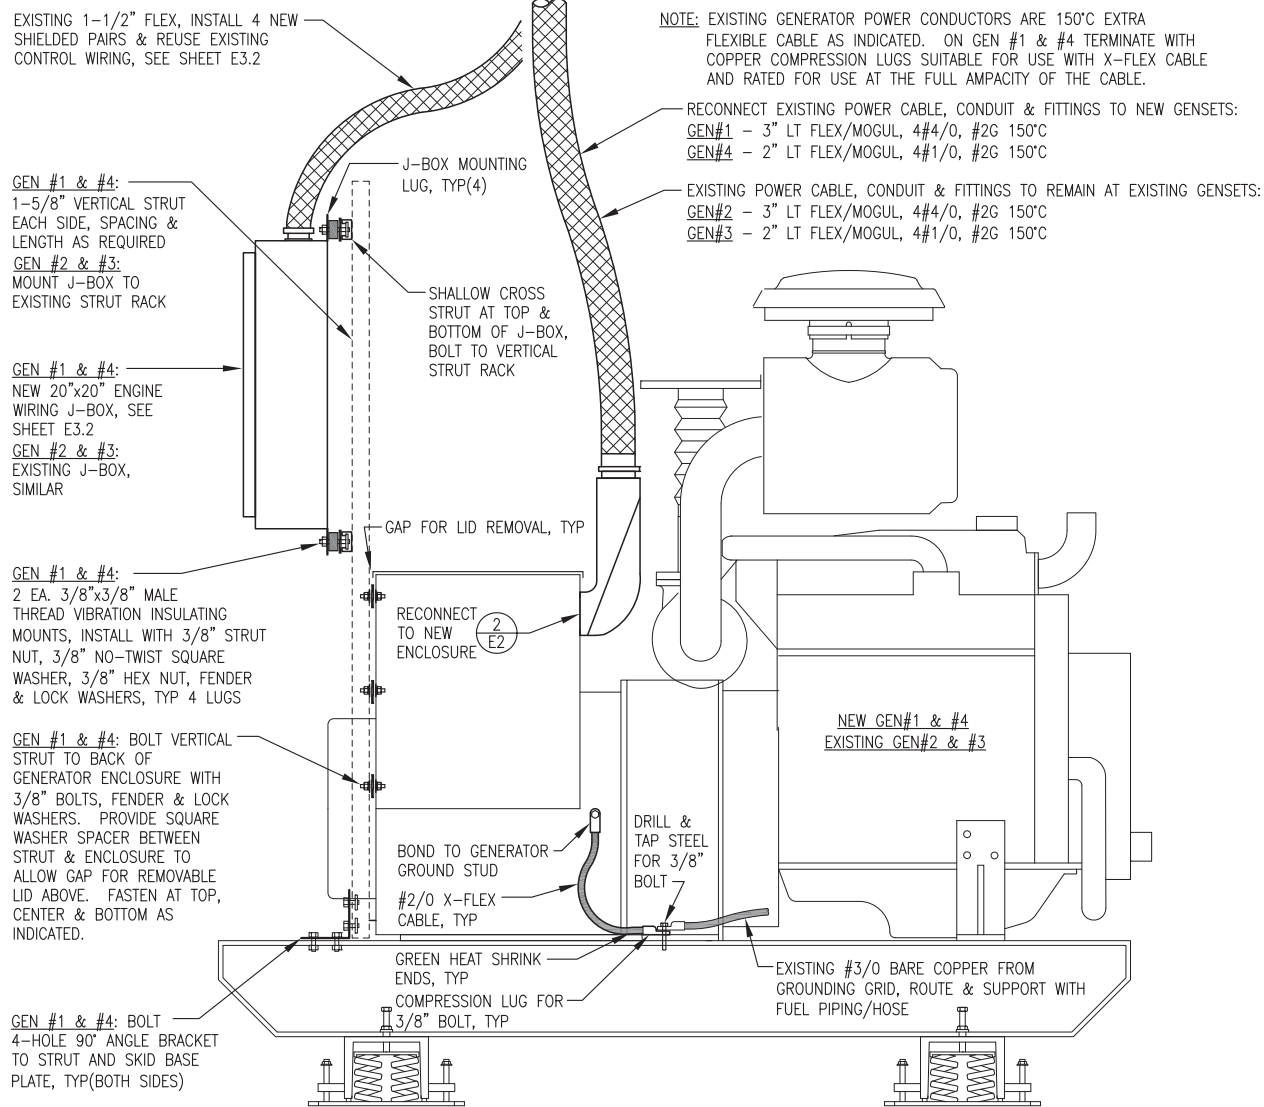


NOTE: EXISTING GENERATOR POWER CONDUCTORS ARE 150°C EXTRA FLEXIBLE CABLE AS INDICATED. ON GEN #1 & #4 TERMINATE WITH COPPER COMPRESSION LUGS SUITABLE FOR USE WITH X-FLEX CABLE AND RATED FOR USE AT THE FULL AMPACITY OF THE CABLE.

RECONNECT EXISTING POWER CABLE, CONDUIT & FITTINGS TO NEW GENSETS:
 GEN#1 - 3" LT FLEX/MOGUL, 4#4/0, #2G 150°C
 GEN#4 - 2" LT FLEX/MOGUL, 4#1/0, #2G 150°C

EXISTING POWER CABLE, CONDUIT & FITTINGS TO REMAIN AT EXISTING GENSETS:
 GEN#2 - 3" LT FLEX/MOGUL, 4#4/0, #2G 150°C
 GEN#3 - 2" LT FLEX/MOGUL, 4#1/0, #2G 150°C

- NOTES:
- 1) THIS DETAIL APPLIES TO CONNECTIONS TO WIREWAY, GENERATOR ENCLOSURES, SWITCHGEAR, AND PANELS.
 - 2) AT A MINIMUM INSTALL GROUNDING BUSHING ON ALL GENERATOR POWER CONDUIT, COMMUNITY FEEDER CONDUIT, STATION SERVICE FEEDERS, AND WHERE OTHERWISE INDICATED OR REQUIRED. BOND GROUNDING BUSHING TO EQUIPMENT GROUNDING CONDUCTOR.
 - 3) INSTALL PLASTIC BUSHING WHERE GROUNDING BUSHING IS NOT REQUIRED.
 - 4) ON GENERATOR ENCLOSURES MAKE ALL CONNECTIONS AS TIGHT AS POSSIBLE.

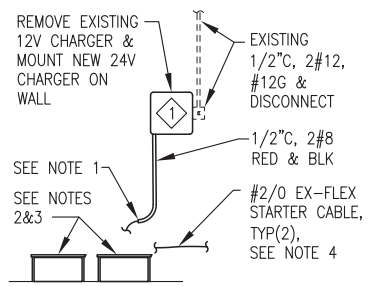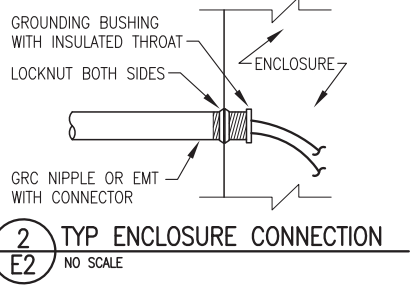

- NOTES:
1. INSTALL BUSHING IN END OF EMT & ROUTE 2#8 CHARGING LEADS TO BATTERY.
 2. PROVIDE TWO EACH MINIMUM 800 COLD CRANK AMP 12-VOLT STARTING BATTERIES FOR EACH GENERATOR. BATTERIES SHALL BE SEALED MAINTENANCE FREE, OPTIMA RED TOP NAPA PART# BAT N993478RED OR APPROVED EQUAL. PLACE BATTERIES OUT OF TRAFFIC AREA IN CONVENIENT LOCATION NEAR BACK WALL.
 3. INSTALL EACH BATTERY IN A RACK SIZED TO SECURELY HOLD THE BATTERY.
 4. #2/0 EX-FLEX BATTERY CABLES PROVIDED WITH GENSETS. MAKE BATTERY CONNECTIONS WITH STRAIGHT CRIMP BATTERY TERMINAL FITTING AND TOP MOUNT TERMINAL COVERS, POLAR WIRE OR EQUAL. ROUTE CABLES WITH FUEL PIPING ALONG WALL TO GENSET BRANCH CONNECTION. ROUTE TO GENSET SKID DIRECTLY BELOW FUEL HOSE. TYWRAP CABLES TO FUEL PIPING AND HOSE AS REQUIRED. SEE SHEET M3.3 FOR STARTER CABLE SUPPORT FROM GENSET SKID.

3 BATTERY CHARGER, BATTERIES AND STARTER CABLE INSTALLATION
 E2 NO SCALE


- NOTES:
- 1) GEN #1 & #4 ARE COMPLETELY NEW INSTALLATIONS WITH ALL WORK AS INDICATED.
 - 2) GEN #2 & #3 ARE EXISTING SIMILAR INSTALLATION WITH NEW WORK LIMITED TO CONTROL WIRING REVISIONS & GROUNDING.
 - 3) ON GEN #1 & #4 INSTALL NEW ENGINE WIRING J-BOX INCLUDING ALL MOUNTING HARDWARE & STRUT AS INDICATED. RECONNECT EXISTING CONDUIT, EXISTING CONDUCTORS, & NEW CONDUCTORS AS INDICATED.
 - 4) ON GEN #2 & #3 THE ENGINE WIRING J-BOX IS EXISTING. REVISE TERMINATIONS OF EXISTING CONTROL CONDUCTORS & TERMINATE NEW CONTROL CONDUCTORS. SEE SHEET E3.2.

1 TYPICAL GENERATOR INSTALLATION
 E2 1-1/2"=1'-0"

ISSUED FOR CONSTRUCTION
 FEB 2020




PROJECT: FFY17-18 DERA PROJECT CHIGNIK LAKE POWER PLANT UPGRADE	
TITLE: ELECTRICAL DETAILS	
DRAWN BY: JTD	SCALE: NO SCALE
DESIGNED BY: CWV/BCG	DATE: 3/18/20
FILE NAME: CLAKDERA E1-3	SHEET: E2 OF 3
PROJECT NUMBER:	
P.O. 111405, Anchorage, AK 99511 (907)349-0100	

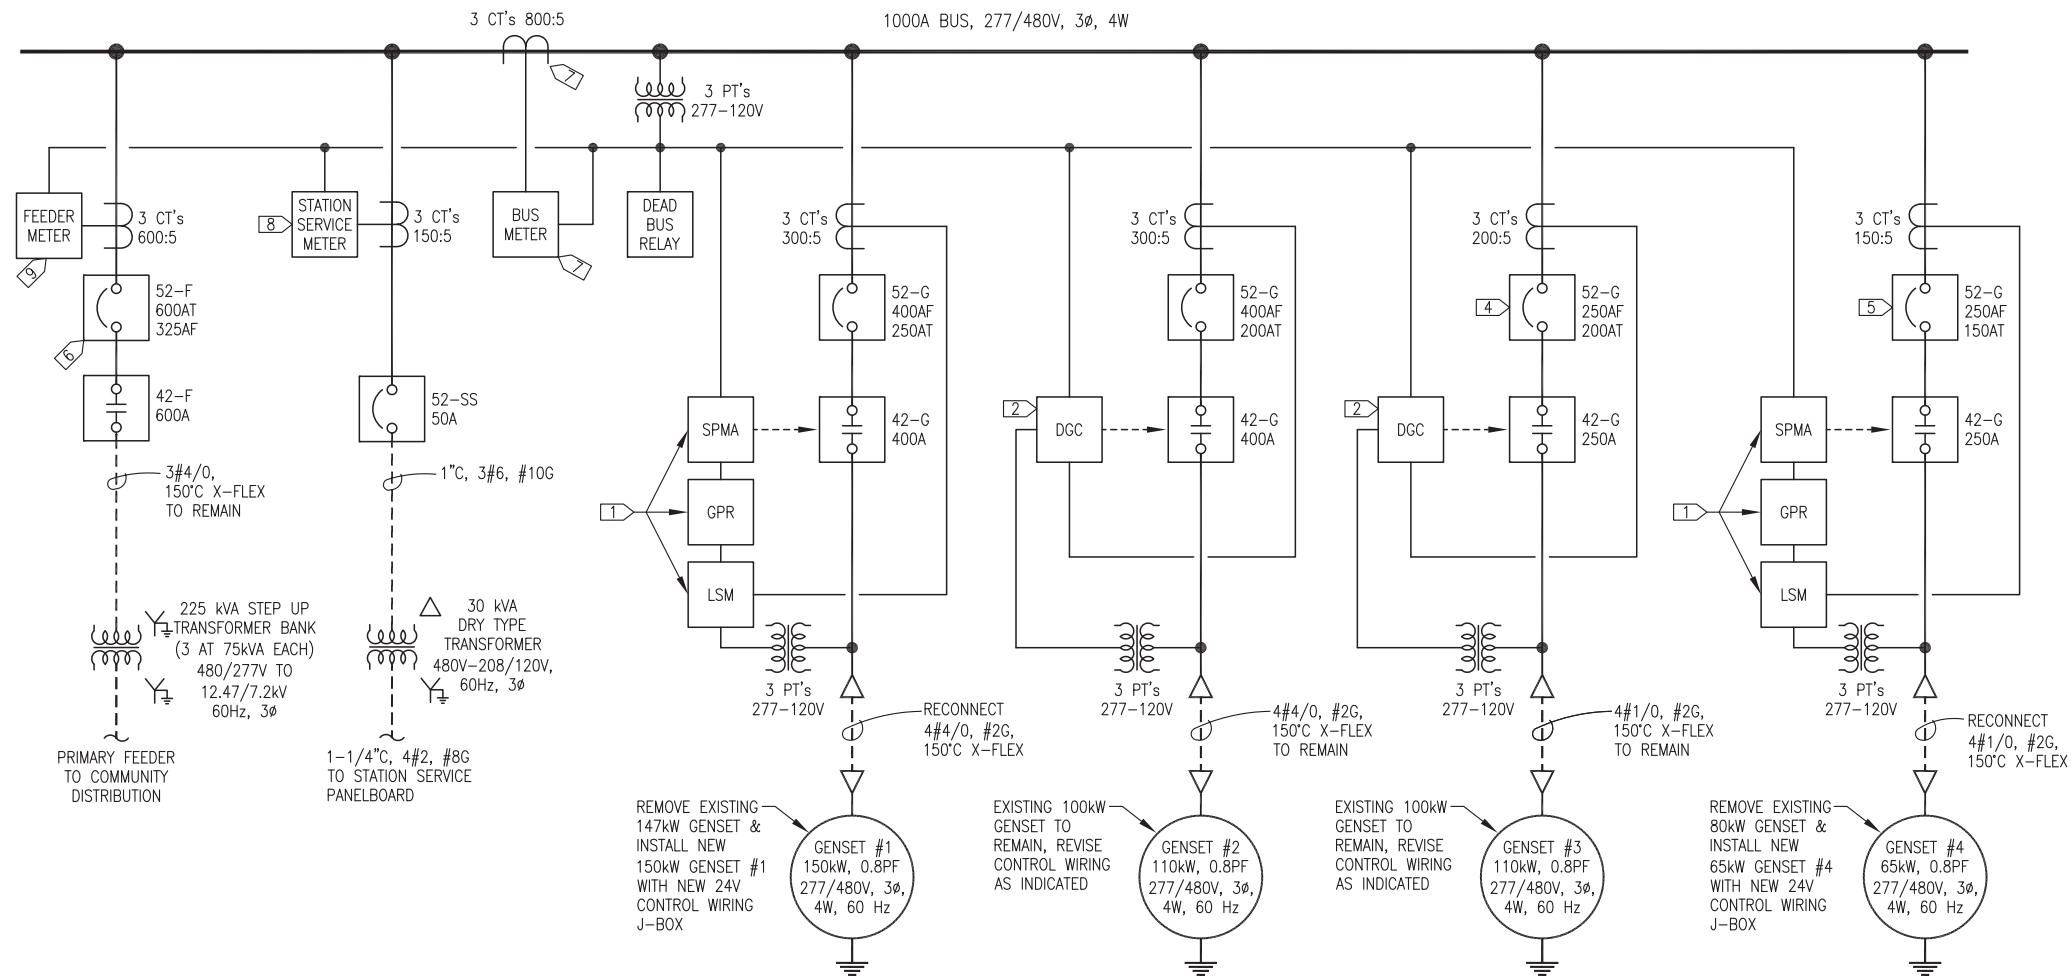


- SWITCHGEAR MODIFICATION GENERAL NOTES:**
- 1) ALL ITEMS TO REMAIN UNLESS SPECIFICALLY INDICATED FOR REMOVAL OR REPLACEMENT.
 - 2) ENSURE ALL EQUIPMENT AND CIRCUITS TO BE REMOVED ARE DE-ENERGIZED PRIOR TO BEGINNING DEMOLITION. LOCK AND TAG OUT ALL AFFECTED CIRCUIT BREAKERS AND DISCONNECTS.
 - 3) SEE SPECIFICATIONS FOR DETAIL ON NEW DEVICES AND EQUIPMENT.

- SWITCHGEAR MODIFICATION SPECIFIC NOTES:**
- 1) REMOVE EXISTING ENGINE-GENERATOR CONTROL DEVICES INCLUDING METERS, SWITCHES, POTENTIOMETERS, SYNCHRONIZER, GENERATOR PROTECTIVE RELAY, & LOAD SHARE MODULE. REPLACE WITH NEW EASYGEN & DEVICES, SEE NOTE 3. ANNUNCIATION LIGHTS TO REMAIN.
 - 2) REMOVE EXISTING ENGINE-GENERATOR CONTROL DEVICES INCLUDING METERS, SWITCHES, POTENTIOMETERS, & BASLER DIGITAL GENSET CONTROLLER. REPLACE WITH NEW EASYGEN & DEVICES, SEE NOTE 3. ANNUNCIATION LIGHTS TO REMAIN.
 - 3) INSTALL MINIMUM 22"Wx30"H BLANK PLATE OVER DOOR FACE TO COVER OPENINGS FROM DEMOLITION. INSTALL EASYGEN, GENERATOR LOCKOUT SWITCH, AND CONTACTOR CLOSED/OPEN ANNUNCIATION LIGHTS IN NEW PLATE.
 - 4) REMOVE EXISTING 150A TRIP PLUG AND SAVE FOR REINSTALLATION IN GEN #4 SECTION. INSTALL NEW 200A TRIP PLUG. EXISTING BREAKER IS A G.E. SPECTRA RMS CAT. # SFHA36AT0250.
 - 5) REMOVE EXISTING 90A TRIP PLUG AND INSTALL 150A TRIP PLUG SALVAGED FROM GEN #3 SECTION.
 - 6) REMOVE EXISTING 600A TRIP PLUG AND INSTALL NEW 325A TRIP PLUG. EXISTING BREAKER IS A G.E. SPECTRA RMS CAT. # SGHA36AT0600.
 - 7) REMOVE EXISTING BUS METER AND ASSOCIATED WIRING AND SHORT OUT TERMINALS ON CT'S.
 - 8) REMOVE EXISTING STATION SERVICE METER AND INSTALL MINIMUM 6"Wx6"H BLANK PLATE OVER DOOR FACE. INSTALL NEW STATION SERVICE METER IN NEW MASTER DOOR COVER PLATE, SEE NOTE 11.
 - 9) REMOVE EXISTING FEEDER METER AND INSTALL NEW FEEDER METER IN NEW MASTER DOOR COVER PLATE, SEE NOTE 11.
 - 10) REMOVE EXISTING MASTER SECTION VOLTAGE & FREQUENCY METERS, OIU, & SYNCH SCOPE. REPLACE WITH NEW OIU & METERS, SEE NOTE 11. ANNUNCIATION LIGHTS TO REMAIN.
 - 11) INSTALL MINIMUM 24"Wx24"H BLANK PLATE OVER DOOR FACE TO COVER OPENINGS FROM DEMOLITION. INSTALL NEW STATION SERVICE METER, FEEDER METER, & OIU IN NEW PLATE.
 - 12) REMOVE EXISTING PLC & ASSOCIATED DEVICES (NOT SHOWN) FROM MASTER SECTION & REPLACE WITH NEW.


1 SWITCHGEAR MODIFICATION ONE-LINE DIAGRAM
E3.1 NO SCALE

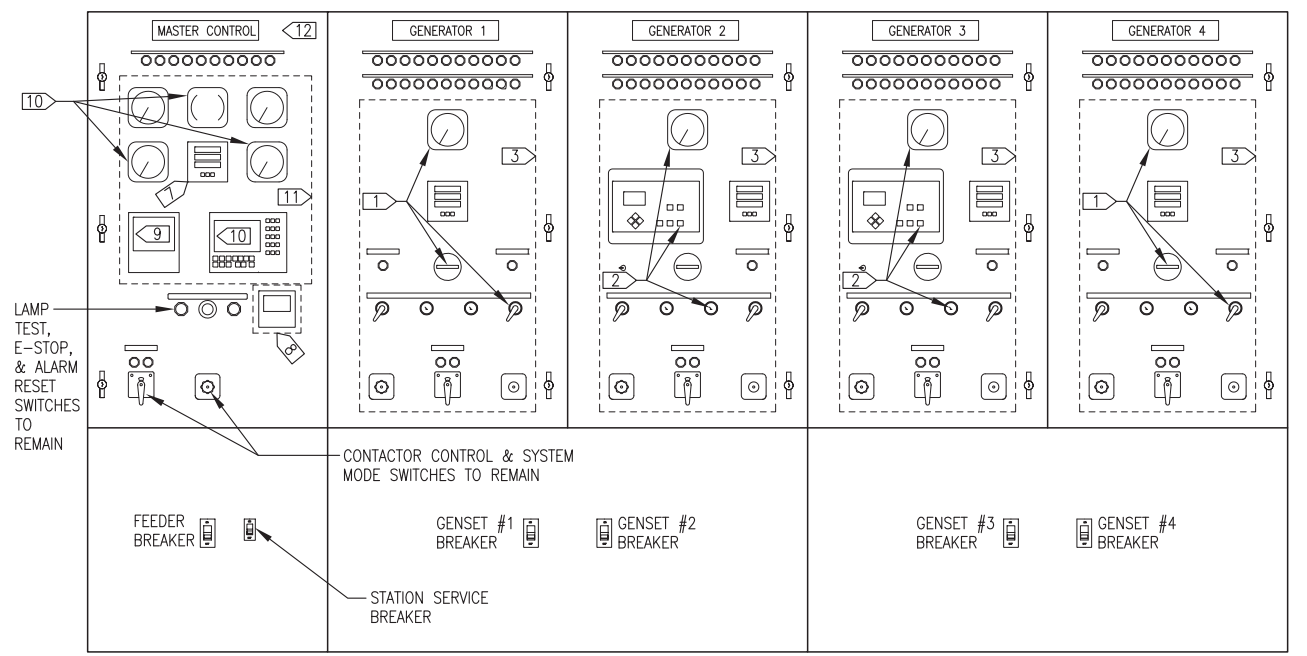

2 EXISTING SWITCHGEAR MODIFICATION ELEVATION
E3.1 NO SCALE

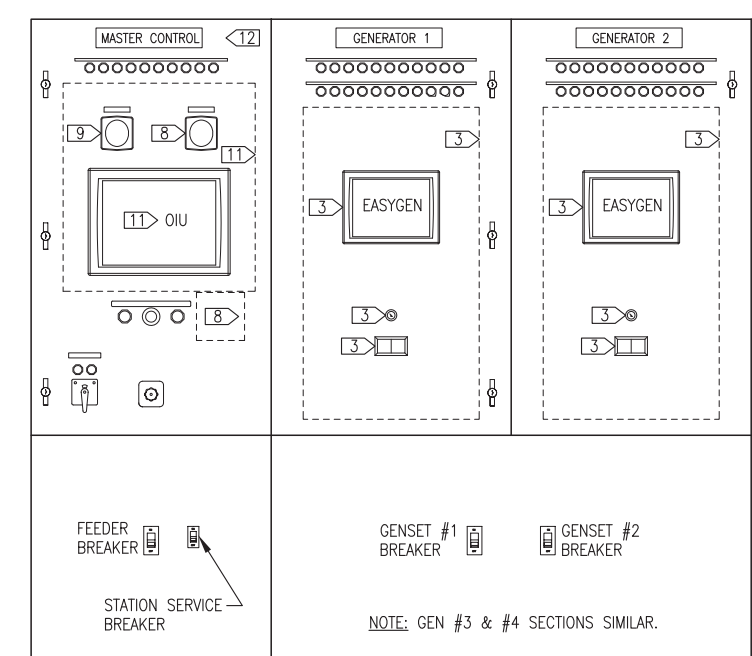

3 SWITCHGEAR NEW FACEPLATES PARTIAL ELEVATION
E3.1 NO SCALE

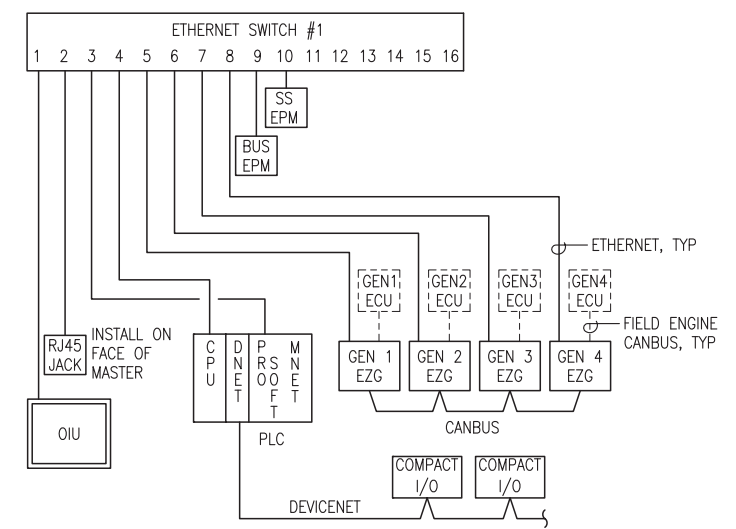


4 COMMUNICATION SCHEMATIC
E3.1 NO SCALE


ISSUED FOR CONSTRUCTION
FEB 2020





PROJECT:	FFY17-18 DERA PROJECT CHIGNIK LAKE POWER PLANT UPGRADE		
TITLE:	SWITCHGEAR MODIFICATIONS		
DRAWN BY:	JTD	SCALE:	NO SCALE
DESIGNED BY:	CWV/BCG	DATE:	3/18/20
FILE NAME:	CLAKDERA E1-3	SHEET:	E3.1 OF 3
PROJECT NUMBER:	P.O. 111405, Anchorage, AK 99511 (907)349-0100		

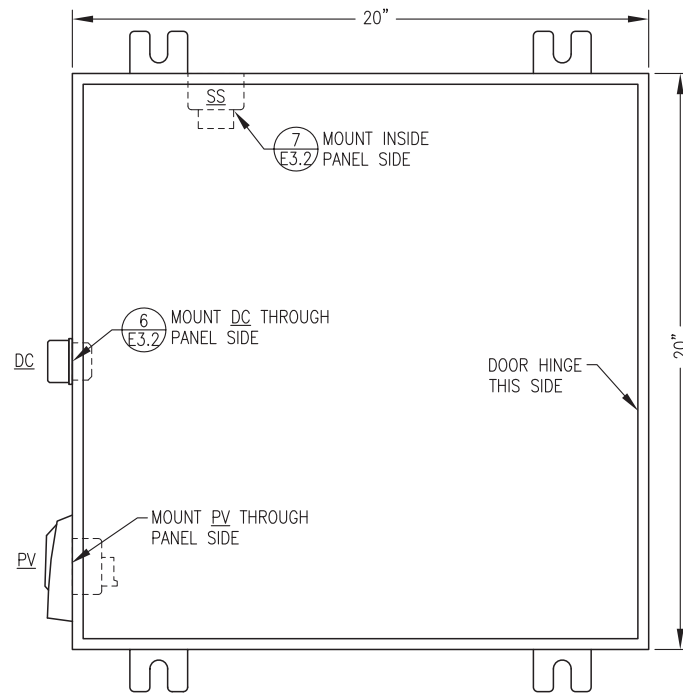


1 JUNCTION BOX FRONT PANEL LAYOUT
E4 NO SCALE

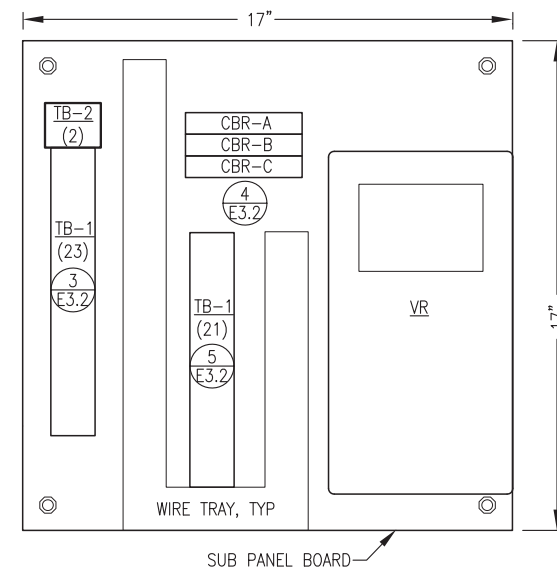

2 JUNCTION BOX SUB PANEL LAYOUT
E4 NO SCALE

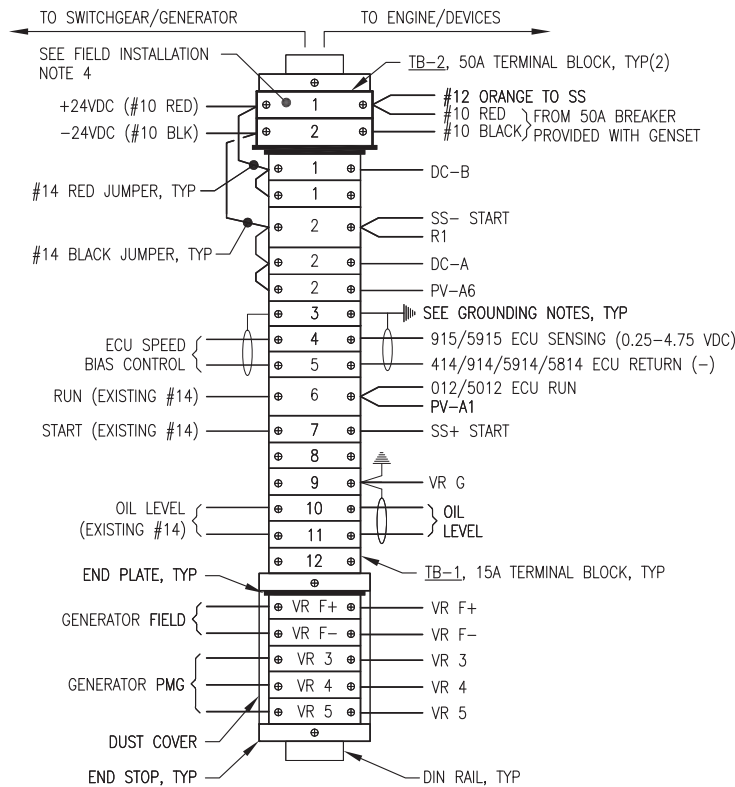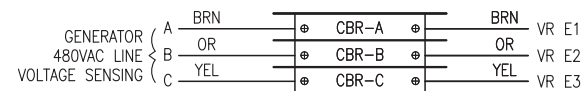

3 TERMINAL STRIP CONNECTIONS
E3.2 NO SCALE

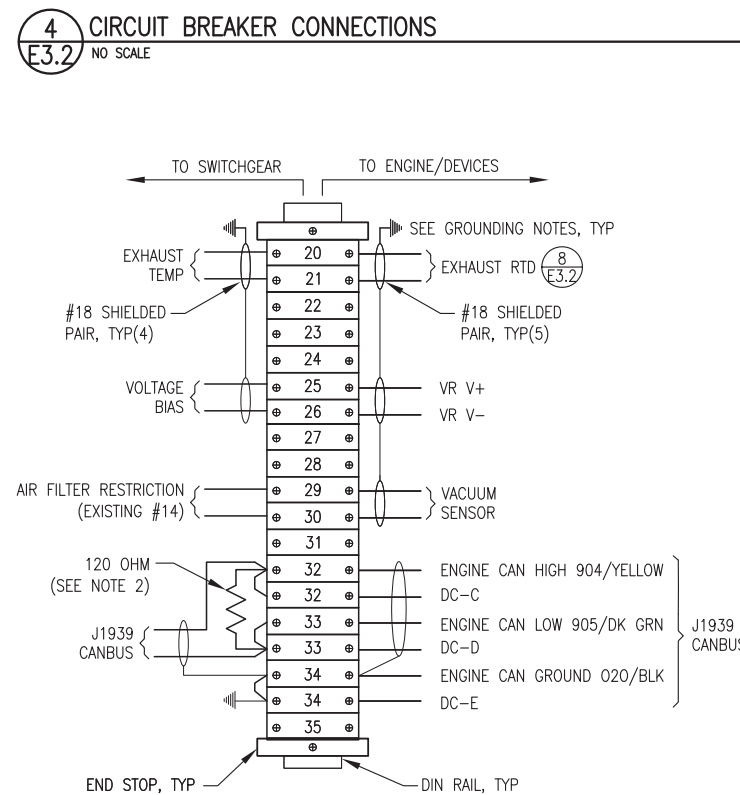

NOTES: 1) ALL RESISTORS 0.25W.
2) REMOVE RESISTOR IF ENGINE WIRING HARNESS HAS 120 OHM END OF LINE RESISTOR.

5 TERMINAL STRIP CONNECTIONS
E3.2 NO SCALE

BILL OF MATERIALS			
TAG	MANUFACTURER	MODEL	DESCRIPTION
ENCL.	HOFFMAN	A20H20ALP	20x20x8" NEMA 12
	HOFFMAN	A20P20	BACK PANEL
VR	BASLER	DECS-150 5NS1V1N1S	DIGITAL VOLTAGE REGULATOR
CBR	ALLEN-BRADLEY	1489-M1-C010	RAIL MOUNT CIRCUIT BREAKER, 1-POLE, 1A
DC	JOHN DEERE	57M7919	DIAGNOSTIC CONNECTOR, 9-PIN, CAN-BUS
	DEUTSCH	HD18-009	CONNECTOR STRAIN RELIEF
	DEUTSCH	HDC16-9	CONNECTOR PROTECTIVE DUST CAP
	DEUTSCH	HD10-9-GKT	CONNECTOR GASKET
	DEUTSCH	JDL062397	CONNECTOR LANYARD
PV	MURPHY	PV101-C-MSTD	POWER VIEW W/HARNESS
SS	CATERPILLAR	9X-8124	STARTER AUXILIARY SOLENOID, 24V
TB-1	IDEC	BNH15LW	15A DIN RAIL-MOUNT TERMINAL BLOCK
TB-2	IDEC	BNH50W	50A DIN RAIL-MOUNT TERMINAL BLOCK


NOTE: SPECIFIC PARTS MANUFACTURER AND MODEL SELECTED NOT ONLY TO MEET PERFORMANCE FUNCTION BUT ALSO TO COORDINATE AND INTERFACE WITH OTHER DEVICES AND SYSTEMS. APPROVED EQUAL SUBSTITUTIONS WILL BE ALLOWED ONLY BY ENGINEER'S APPROVAL. TO OBTAIN APPROVAL, SUBMITTALS MUST CLEARLY DEMONSTRATE HOW SUBSTITUTE ITEM MEETS OR EXCEEDS SPECIFIED ITEM QUALITY AND PERFORMANCE CHARACTERISTICS AND ALSO COMPLIES WITH MECHANICAL AND/OR ELECTRICAL CONNECTIONS AND PHYSICAL LAYOUT REQUIREMENTS.

SHOP FABRICATION NOTES:


- 1) PROVIDE ASSEMBLY WITH ALL DEVICES AND WIRING INDICATED.
- 2) INSTALL IN A NEMA 12 ENCLOSURE WITH MOUNTING FLANGES AT BACK, A MIN 14 GAUGE INTERIOR BACK PANEL AND HINGED LOCKABLE DOOR. SIZE AS INDICATED.
- 3) PROVIDE DIN RAIL, TERMINAL END PLATES, TERMINAL END STOPS, TERMINAL DUST COVERS AND OTHER MISCELLANEOUS HARDWARE AS REQUIRED TO MATCH TERMINALS. LABEL ALL TERMINALS EXACTLY AS INDICATED ON THE DETAILS.
- 4) ALL WIRE #14AWG EXCEPT WHERE SPECIFICALLY INDICATED OTHERWISE. LABEL BOTH ENDS OF ALL JUMPERS WITH THE ENGINE PANEL TERMINAL NUMBER.
- 5) PROVIDE MECHANICAL GROUND LUGS FASTENED TO BACK PANEL AND GROUNDED TO ENGINE-GENERATOR. GROUND ALL SHIELD DRAIN WIRES TO LUGS AT PANEL END ONLY.
- 6) PROVIDE WIRING HARNESSSES FOR CONNECTION TO GENERATOR AND TO ENGINE. INSTALL WIRES IN LIQUID TIGHT FLEX OR FLEXIBLE PLASTIC WIRE LOOM AND PROVIDE SERVICE LOOPS IN ACCORDANCE WITH SPECIFICATIONS.
- 7) SHOP TEST EACH NEW ENGINE-GENERATOR WITH ASSOCIATED JUNCTION BOX PERMANENTLY CONNECTED. UPON COMPLETION OF TESTING, COIL WIRING HARNESSSES AND SECURE JUNCTION BOX TO GENERATOR FOR SHIPPING.

FIELD INSTALLATION NOTES:


- 1) PERFORM ALL FIELD WIRING IN ACCORDANCE WITH SPECIFICATIONS.
- 2) GEN #1 & #4 TO BE FURNISHED WITH NEW J-BOXES SHOP CONNECTED TO GENSET AS INDICATED & SPECIFIED.
- 3) GEN #2 & #3 J-BOXES TO BE FIELD REVISED TO MATCH TERMINATION NUMBERS ON THIS SHEET & TO CONNECT TO NEW INSTRUMENTATION DEVICES.
- 4) ON SHIELDED CONDUCTORS GROUND ALL SHIELD DRAIN WIRES TO LUGS AT PANEL END ONLY.
- 5) #10 & #14 CONDUCTORS FROM GENERATOR TO SWITCHGEAR ARE EXISTING. TAPE ENDS AND NEATLY COIL UNUSED CONDUCTORS IN J-BOX. INSTALL NEW 4 PAIR #18 SHIELDED FOR CONTROL & INSTRUMENTATION AS INDICATED.
- 6) RELABEL ALL TERMINALS IN SWITCHGEAR TO MATCH NEW J-BOX TERMINAL NUMBERS. LABEL BOTH ENDS OF ALL FIELD WIRING WITH THE ENGINE PANEL TERMINAL NUMBER.

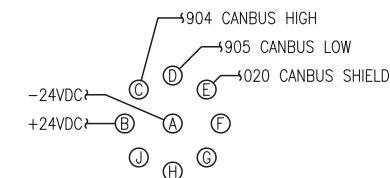

6 DIAGNOSTIC CONNECTOR WIRING
E3.2 NO SCALE

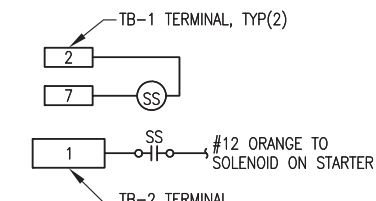

7 STARTER AUX SOLENOID SS WIRING
E3.2 NO SCALE

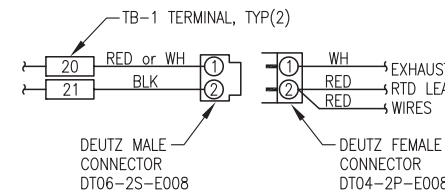

8 EXHAUST RTD CONNECTOR
E3.2 NO SCALE

ISSUED FOR CONSTRUCTION
FEB 2020



PROJECT:	FFY17-18 DERA PROJECT CHIGNIK LAKE POWER PLANT UPGRADE	
TITLE:	24V ENGINE WIRING JUNCTION BOX	
DRAWN BY:	JTD	SCALE: NO SCALE
DESIGNED BY:	CWV/BCG	DATE: 3/18/20
FILE NAME:	CLAKDERA E1-3	SHEET: E3.2 OF 3
PROJECT NUMBER:		


Gray Stassel Engineering, Inc.
P.O. 111405, Anchorage, AK 99511 (907)349-0100

PROJECT DESCRIPTION

1. THE CIRCLE ELECTRIC UTILITY HAS CONSTRUCTED A NEW ADDITION TO THE WEST OF THE EXISTING BUILDING. THE NEW ADDITION WILL SERVE AS THE GENERATION BAY AND WILL HOUSE ALL GENERATORS AND SWITCHGEAR. THE EXISTING BUILDING WILL SERVE AS A SHOP BAY.
2. THE PRIMARY PURPOSES OF THIS DERA PROJECT ARE TO:
 - INSTALL TWO NEW TIER 3 MARINE DIESEL ENGINE-GENERATOR SETS (GENSETS #1 & #2) WITH FULL AUTOMATIC PARALLELING CONTROL.
 - RELOCATE EXISTING GENSET #3 AS INDICATED.
 - INSTALL NEW SWITCHGEAR WITH FULL AUTOMATIC PARALLELING CONTROL FOR GENSETS #1 & #2 PRIME POWER AND MANUAL ON/OFF CONTROL FOR GENSET #3 BACKUP OPERATION.
3. IN ADDITION, MINOR MODIFICATIONS WILL BE MADE TO THE PLANT MECHANICAL AND ELECTRICAL SYSTEMS AS INDICATED.
4. THE DESIGN SHOWS CONSTRUCTION OF A NEW HYDRONIC ENGINE COOLING SYSTEM WITH REMOTE RADIATORS AND NEW SHOP BAY UNIT HEATER. ALL ENGINE COOLING AND HYDRONIC WORK SHOWN ON THESE DRAWINGS IS FOR INFORMATIONAL PURPOSES ONLY. ALL HYDRONIC EQUIPMENT IS TO BE FURNISHED AND INSTALLED BY THE UTILITY. THE SCOPE OF THE DERA PROJECT COOLING SYSTEM IS LIMITED TO HOSES AND FITTINGS AS NOTED ON DETAILS.

SCHEDULE OF DRAWINGS:

- M1.1 PROJECT DESCRIPTION, SCHEDULE OF DRAWINGS, & MECHANICAL WORK PLAN
- M1.2 MECHANICAL WALL PENETRATIONS & VENTILATION DETAILS
- M2.1 GENSET #1 & #2 INSTALLATION DETAILS
- M2.2 FUEL PIPING PLAN, DETAILS, & GENSET #3 INSTALLATION
- M2.3 EXHAUST & CRANK VENT INSTALLATION DETAILS
- M3 GENSET FABRICATION DETAILS
- M4.1 PIPING & EQUIPMENT INSTALLATION PLAN, ELEVATION, & DETAILS
- M4.2 COOLANT PIPING ISOMETRIC & DETAILS
- M4.3 COOLANT PIPING DETAILS
- E1 ELECTRICAL WORK PLAN & EQUIPMENT SCHEDULE
- E2.1 TYPICAL GENERATION BAY SECTION & DETAILS
- E2.2 DETAILS & GENSET #3 SECTION
- E3.1 SWITCHGEAR LAYOUT, ONE-LINE, & SCHEMATICS
- E3.2 GENSET #1 & #2 24V ENGINE WIRING JUNCTION BOX

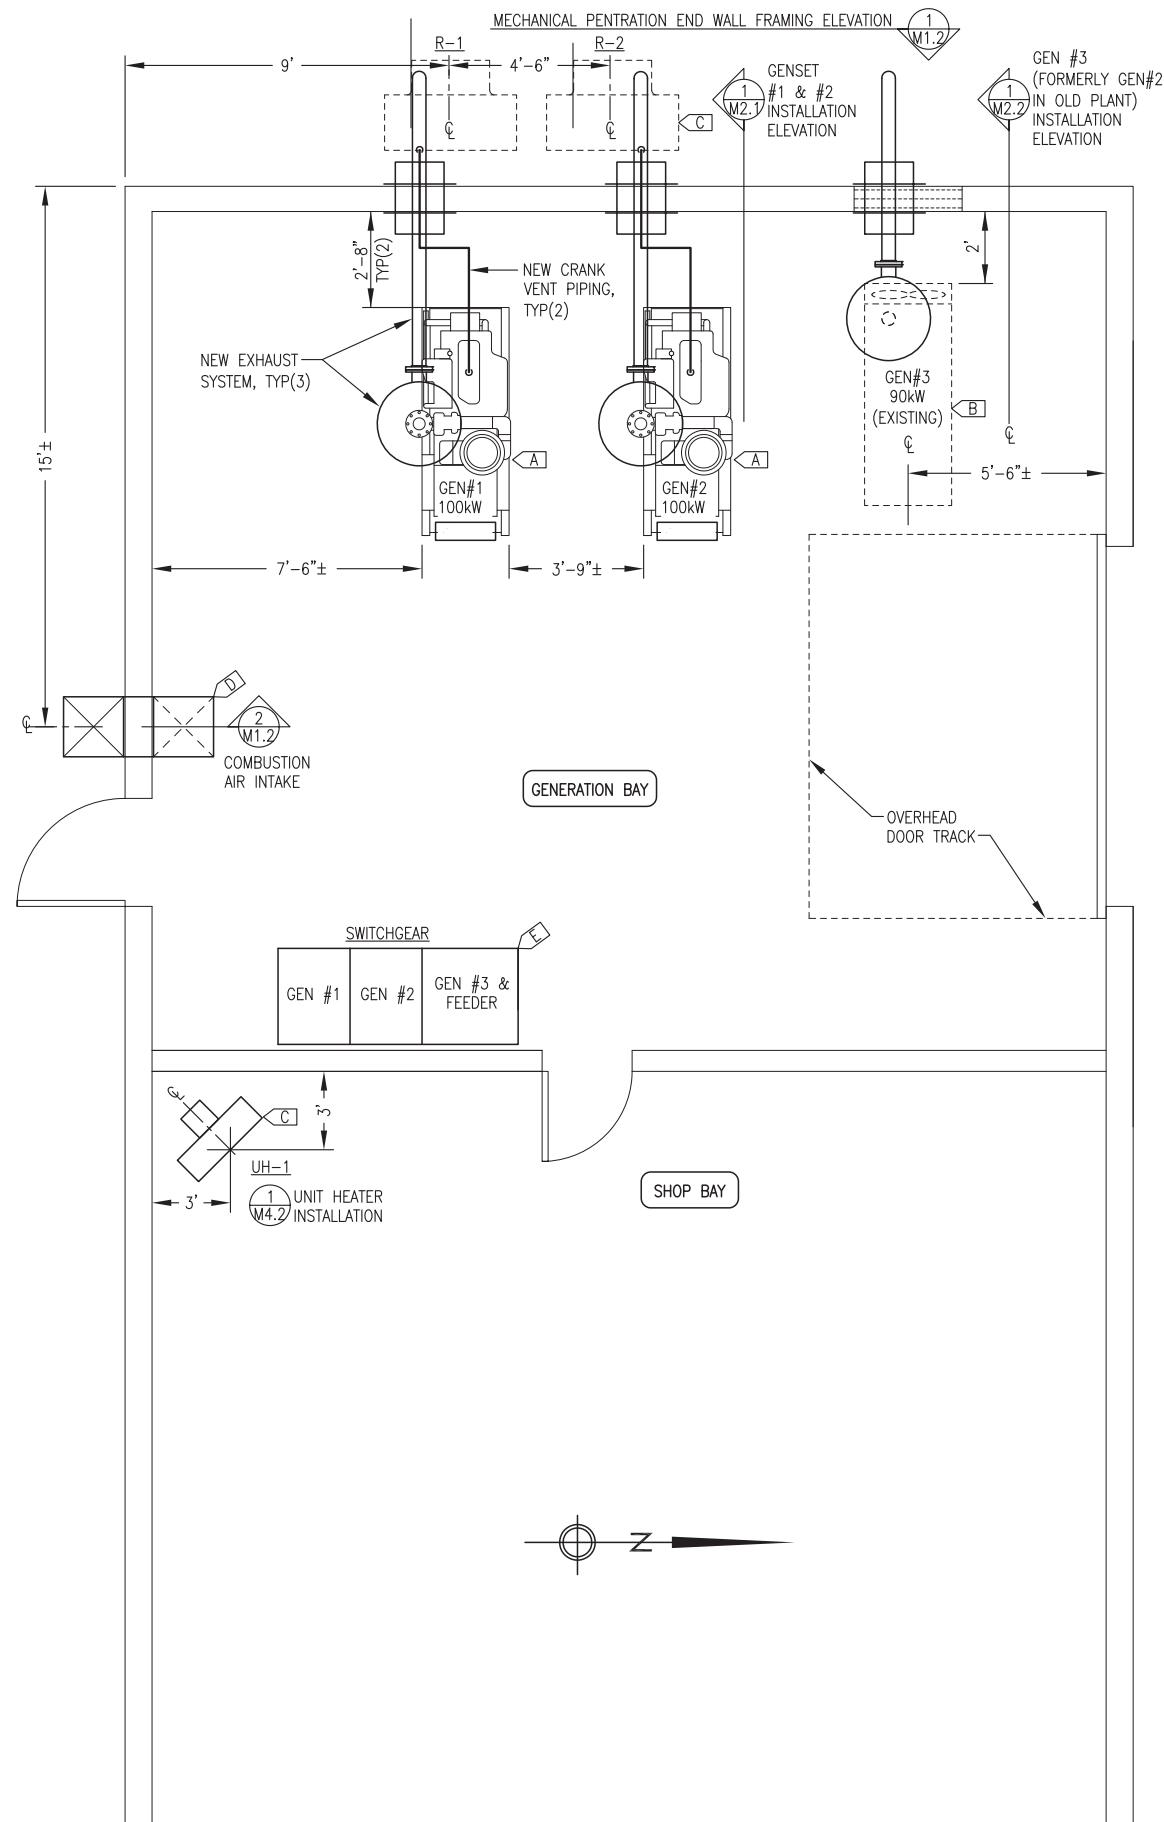

GENERAL NOTES:

1. EXISTING EQUIPMENT TO BE RELOCATED AND REMAIN IN SERVICE SHOWN WITH LIGHT DASHED LINES.
2. NEW EQUIPMENT TO BE INSTALLED SHOWN WITH DARK SOLID LINES.

SPECIFIC NOTES:

- [A] INSTALL NEW GENSETS #1 & #2 INCLUDING COOLANT, FUEL, EXHAUST, & CRANK VENT CONNECTIONS. SEE ELECTRICAL FOR ADDITIONAL INSTALLATION DETAILS.
- [B] RELOCATE EXISTING GENSET #3 & INSTALL FUEL & EXHAUST CONNECTIONS. SEE ELECTRICAL FOR ADDITIONAL INSTALLATION DETAILS.
- [C] ENGINE COOLANT & HYDRONIC PIPING & EQUIPMENT SHOWN FOR INFORMATIONAL PURPOSES ONLY & IS NOT IN DERA PROJECT SCOPE. AS PART OF DERA PROJECT FURNISH & INSTALL COOLANT HOSES, KING NIPPLES, & CLAMPS AS INDICATED.
- [D] INSTALL NEW COMBUSTION AIR INTAKE DUCT, SEE SHEET M1.2
- [E] SEE ELECTRICAL.

ENGINE COOLING & HYDRONIC SYSTEM EQUIPMENT SCHEDULE

SYMBOL	SERVICE/FUNCTION	DESCRIPTION	MANUFACTURER/MODEL
R-1 R-2	GLYCOL RADIATOR	HORIZONTAL DISCHARGE HOT WATER UNIT HEATER, 358 MBH AT 37 GPM 200F EWT & 60F EAT, 1-1/2HP, 240V, 3ø	MODINE PT-500
ET-1	GEN COOLANT EXPANSION TANK	24 GALLON CAPACITY TANK, 12.75" O.D x 48" LONG FABRICATED STEEL TANK, SEE FABRICATION DETAIL	CUSTOM FABRICATION
HP-EC	ENGINE COOLANT FILL HAND PUMP	DOUBLE ACTION PISTON HAND PUMP, ALUM HOUSING, SS PISTON SHAFT & LINER, BUNA-N SEALS, ANTI-SIPHONING VALVE.	GPI MODEL HP-100
P-UH1	SHOP HEAT	15 GPM AT 15' TDH, 1/12HP, 115V, 1ø. PROVIDE WITH 1-1/4" SOLDER SHUTOFF FLANGES, GASKETS, & BOLTS.	GRUNDFOS UP 26-64F
UH-1	SHOP HEAT	HORIZONTAL DISCHARGE UNIT HEATER, 143 MBH AT 15 GPM, 200F EWT & 60F EAT, 1/3HP, 120V, 1ø	MODINE HC-193

NOTE: ALL ENGINE COOLING AND HYDRONIC EQUIPMENT IS TO BE FURNISHED AND INSTALLED BY THE UTILITY AND ARE SHOWN HERE FOR INFORMATIONAL PURPOSES ONLY.

PIPE/TUBING STRUT CLAMP SCHEDULE

COPPER TUBE	CLAMP #	STEEL PIPE	CLAMP #	NOTES:
1/2" COPPER	B2026	1/2" STEEL	B2008	1) ALL CLAMP NUMBERS ARE B-LINE. EQUIVALENT EQUALS ACCEPTABLE. 2) ALL COPPER CLAMPS COPPER PLATED. ALL STEEL CLAMPS ZINC PLATED. 3) WRAP ALL COPPER TUBING WITH VINYL PIPE WRAP TAPE AT CLAMPS TO ISOLATE FROM GALV STRUT. 4) SEE PLANS, ELEVATIONS, ISOMETRICS, AND DETAILS FOR ACTUAL PIPE SIZES.
3/4" COPPER	B2028	3/4" STEEL	B2009	
1" COPPER	B2030	1" STEEL	B2010	
1-1/4" COPPER	B2032	1-1/4" STEEL	B2011	
1-1/2" COPPER	B2034	1-1/2" STEEL	B2012	
2" COPPER	B2038	2" STEEL	B2013	
2-1/2" COPPER	B2042	3" STEEL	B2015	


EXCLUSIONS: SEE NOTES THIS SHEET AND ON MECHANICAL SHEETS WHICH FOLLOW FOR WORK TO BE PERFORMED BY UTILITY THAT IS NOT PART OF THE DERA PROJECT CONTRACTOR SCOPE.

ISSUED FOR CONSTRUCTION
FEB 2020




PROJECT:	FFY17-18 DERA PROJECT CIRCLE POWER PLANT UPGRADE		
TITLE:	PROJECT DESCRIPTION, SCHEDULE OF DRAWINGS, & MECHANICAL WORK PLAN		
DRAWN BY:	JTD	SCALE:	AS NOTED
DESIGNED BY:	BCG	DATE:	3/18/20
FILE NAME:	CIRDERA M1-4	SHEET:	M1.1 OF 4
PROJECT NUMBER:			


1 M1.1 EQUIPMENT LAYOUT & MECHANICAL WORK PLAN
3/8"=1'-0"

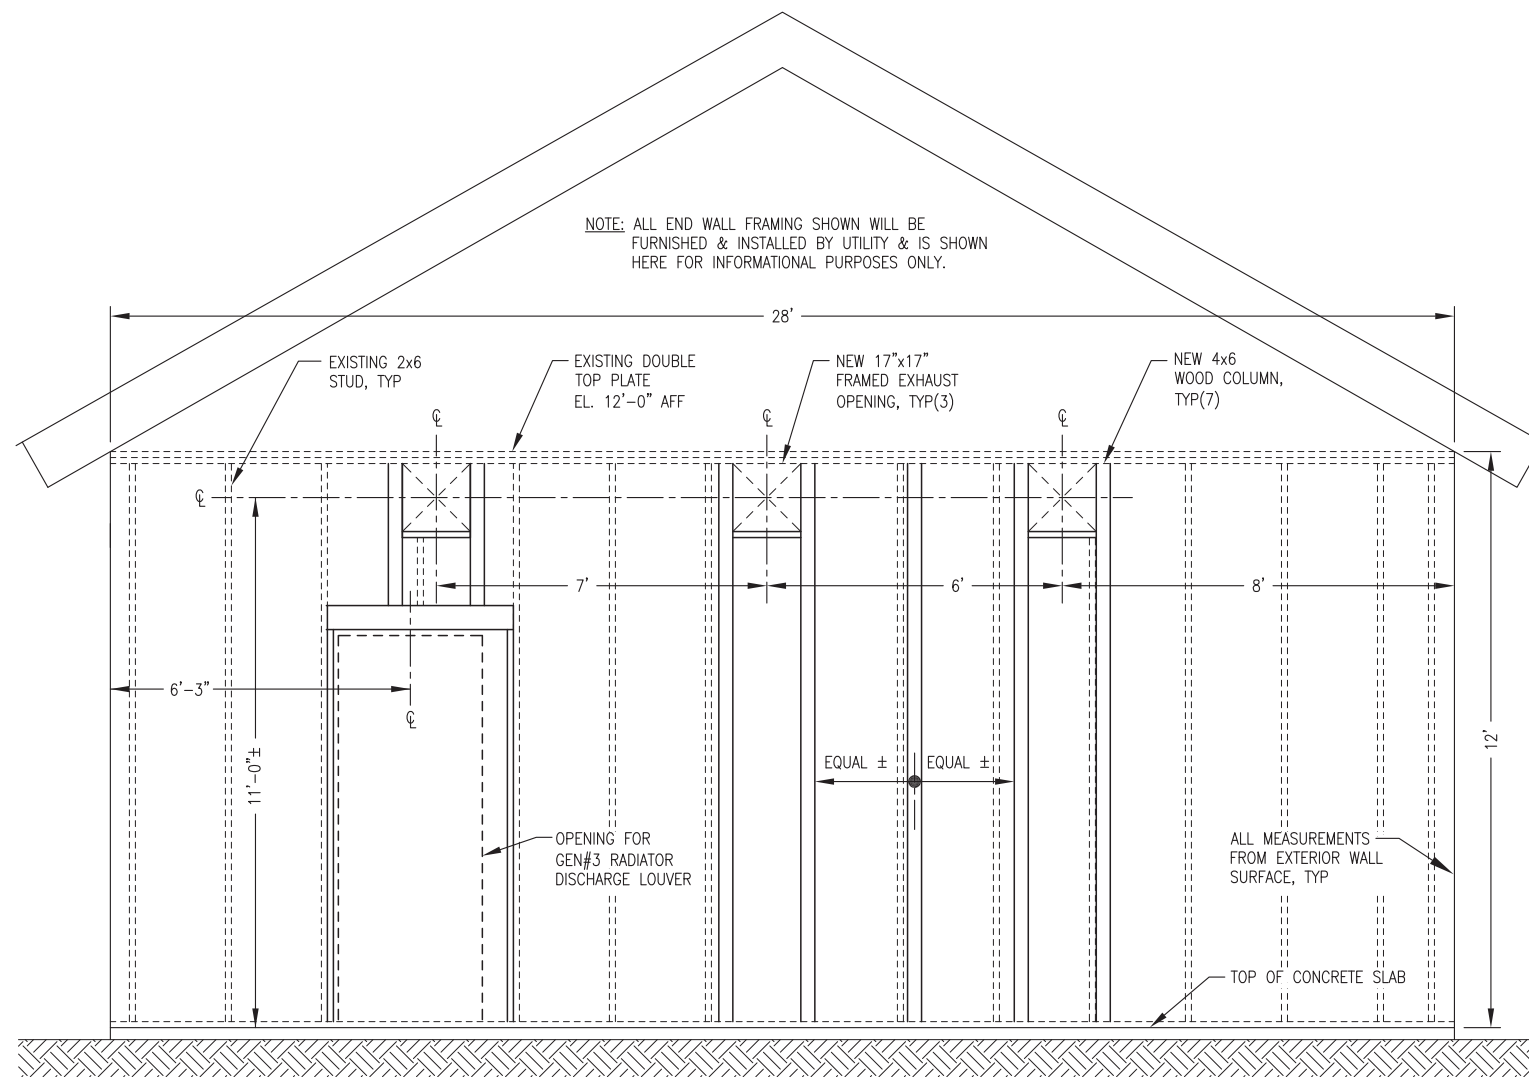


1 MECHANICAL PENETRATION END WALL FRAMING ELEVATION (EXTERIOR VIEW)
M1.2 1/2"=1'-0"

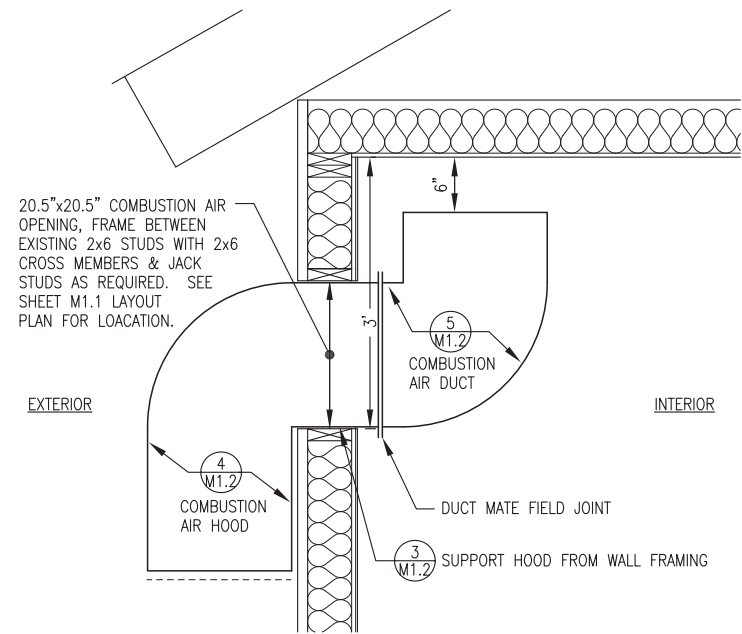

2 COMBUSTION AIR DUCT INSTALLATION
M1.2 1"=1'-0"

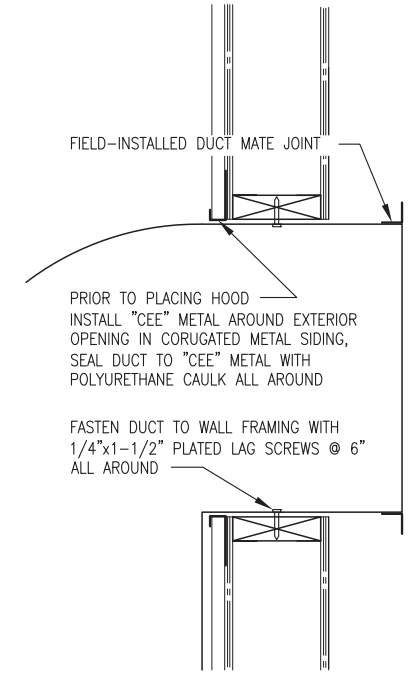


3 COMBUSTION AIR HOOD SUPPORT
M1.2 2"=1'-0"

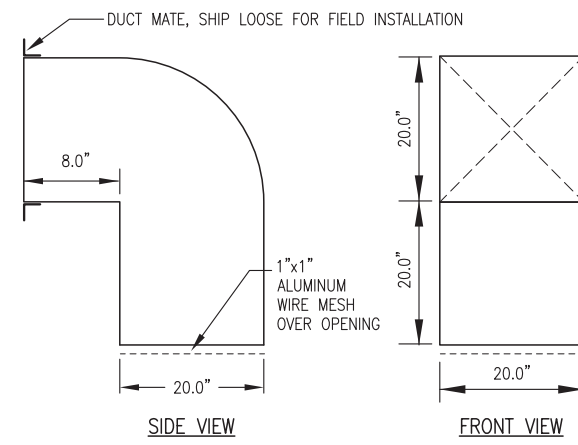

NOTE: FABRICATE FROM 20 GAUGE GALV. SHEET METAL.

4 COMBUSTION AIR HOOD FABRICATION
M1.2 1"=1'-0"

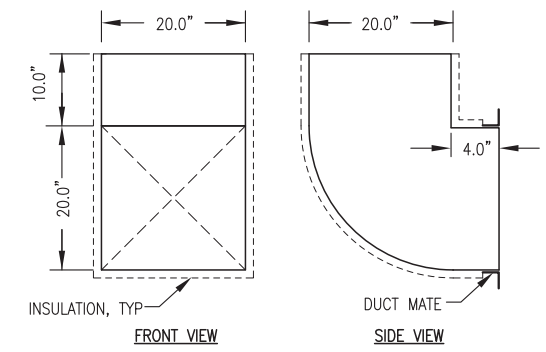

- NOTES:
- FABRICATE 1 EA. ASSEMBLY.
 - FABRICATE FROM MIN 20 GAUGE GALV. SHEET METAL, WELD ALL SEAMS.
 - INSULATE WITH 1" THICK RIGID FOIL-BACK INSULATION AND SEAL WITH FOIL TAPE


5 COMBUSTION AIR DUCT FABRICATION
M1.2 1"=1'-0"

EXCLUSIONS: END WALL FRAMING AS INDICATED.


ISSUED FOR CONSTRUCTION
 FEB 2020



PROJECT: FFY17-18 DERA PROJECT CIRCLE POWER PLANT UPGRADE	
TITLE: MECHANICAL WALL PENETRATIONS & VENTILATION DETAILS	
DRAWN BY: JTD	SCALE: AS NOTED
DESIGNED BY: BCG	DATE: 3/18/20
FILE NAME: CIRDERA M1-4	SHEET: M1.2 OF 4
PROJECT NUMBER:	
P.O. 111405, Anchorage, AK 99511 (907)349-0100	

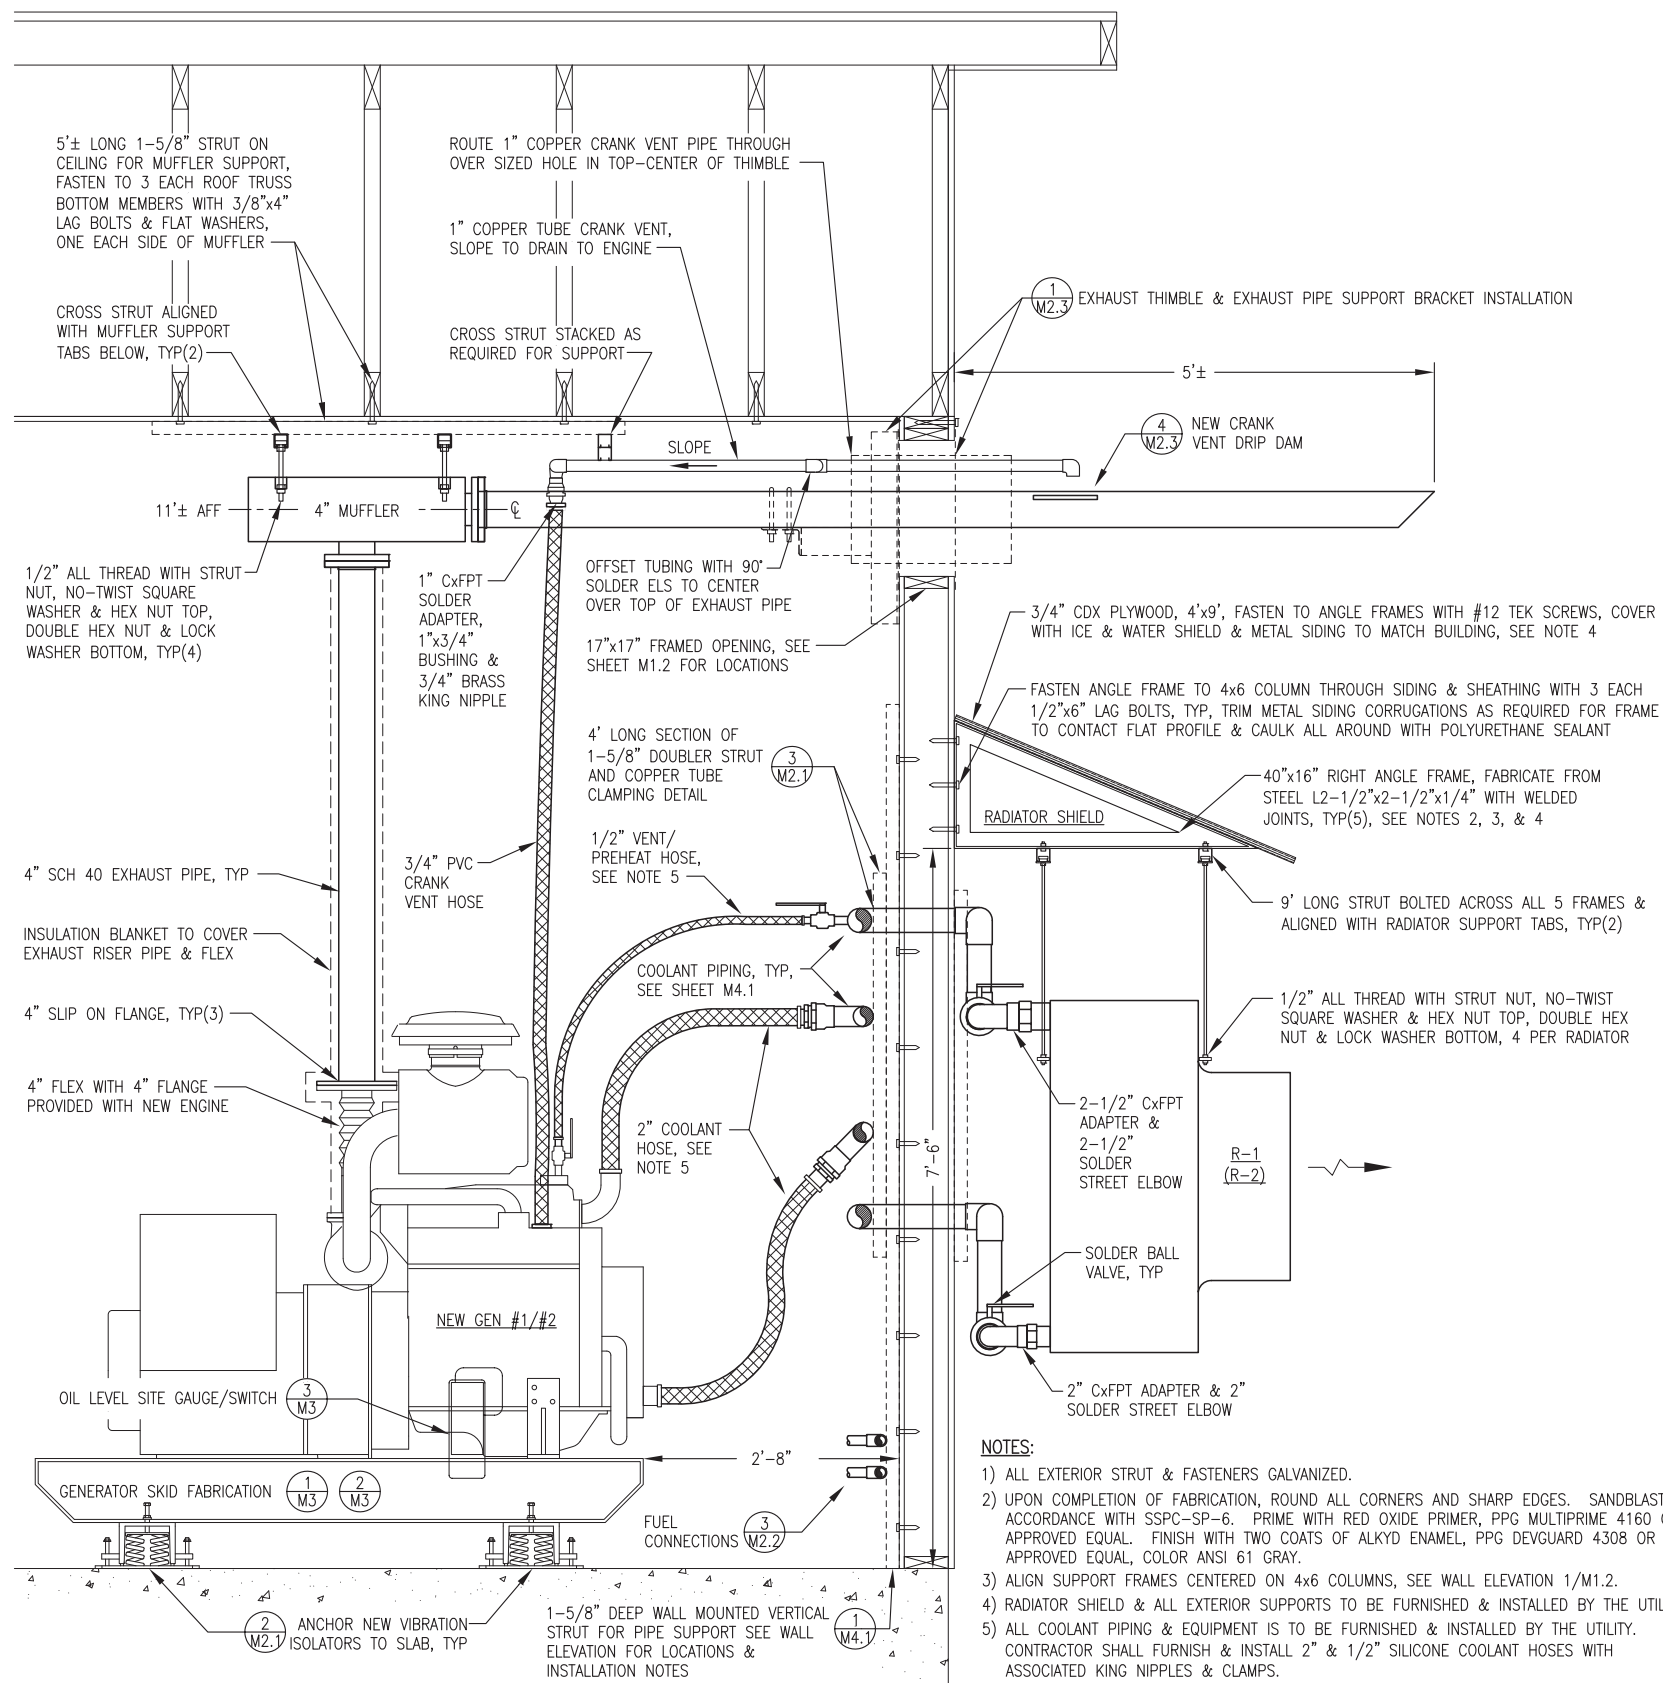


1 NEW GENSET #1 & #2 INSTALLATION ELEVATION
 M2.1 1"=1'-0"

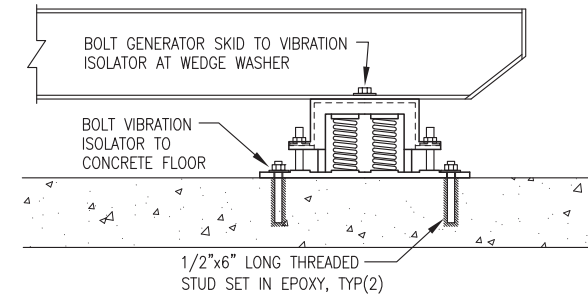

NOTES:

- 1) GENSET #1 & #2: VIBRATION ISOLATORS SPECIFIED TO BE FURNISHED WITH GENSETS. FOR GENSET #3 FURNISH 4 NEW VIBRATION ISOLATORS IDENTICAL TO THOSE FURNISHED FOR GENSET #1 & #2.
- 2) AFTER INSTALLATION ADJUST SPRING VIBRATION ISOLATOR LEVELING BOLTS TO ACHIEVE A UNIFORM INSTALLATION HEIGHT OF APPROXIMATELY 5-3/4" THEN TIGHTEN LOCKING NUTS. ADJUST NUTS ON STABILIZER BOLTS TO ACHIEVE A UNIFORM CLEARANCE OF APPROXIMATELY 1/8" THEN TIGHTEN LOCKING NUTS. VERIFY UNIT MOVES FREELY ON ISOLATORS

2 GENERATOR VIBRATION ISOLATOR INSTALLATION
 M2.1 NO SCALE

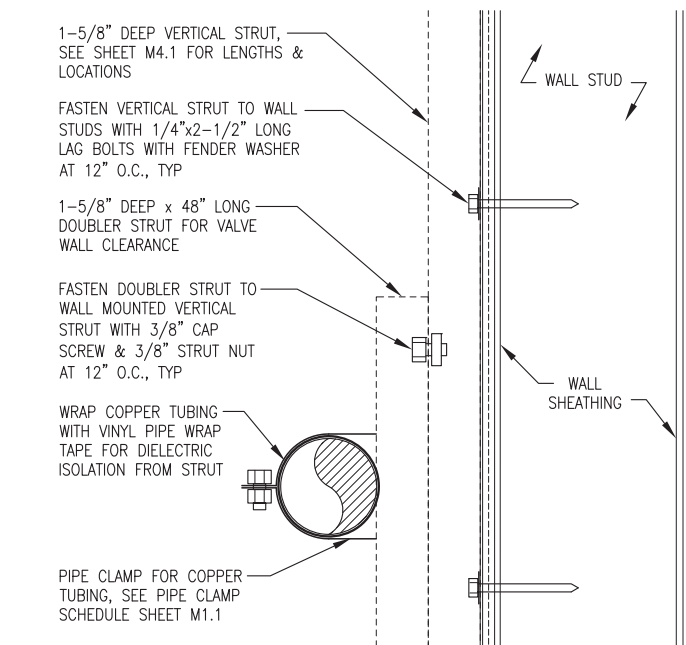

3 DOUBLER STRUT & COPPER TUBE CLAMPING DETAIL
 M2.1 NO SCALE

NOTES:


- 1) ALL EXTERIOR STRUT & FASTENERS GALVANIZED.
- 2) UPON COMPLETION OF FABRICATION, ROUND ALL CORNERS AND SHARP EDGES. SANDBLAST IN ACCORDANCE WITH SSPC-SP-6. PRIME WITH RED OXIDE PRIMER, PPG MULTIPRIME 4160 OR APPROVED EQUAL. FINISH WITH TWO COATS OF ALKYD ENAMEL, PPG DEVGUARD 4308 OR APPROVED EQUAL, COLOR ANSI 61 GRAY.
- 3) ALIGN SUPPORT FRAMES CENTERED ON 4x6 COLUMNS, SEE WALL ELEVATION 1/M1.2.
- 4) RADIATOR SHIELD & ALL EXTERIOR SUPPORTS TO BE FURNISHED & INSTALLED BY THE UTILITY.
- 5) ALL COOLANT PIPING & EQUIPMENT IS TO BE FURNISHED & INSTALLED BY THE UTILITY. CONTRACTOR SHALL FURNISH & INSTALL 2" & 1/2" SILICONE COOLANT HOSES WITH ASSOCIATED KING NIPPLES & CLAMPS.

EXCLUSIONS: COOLANT PIPING, EQUIPMENT, AND SUPPORTS AS INDICATED.


ISSUED FOR
 CONSTRUCTION
 FEB 2020




PROJECT:	FFY17-18 DERA PROJECT CIRCLE POWER PLANT UPGRADE		
TITLE:	GENSET #1 & #2 INSTALLATION DETAILS		
DRAWN BY: JTD	SCALE: AS NOTED	DESIGNED BY: BCG	DATE: 3/18/20
FILE NAME: CIRDERA M1-4	SHEET:	PROJECT NUMBER:	
		M2.1 OF 4	

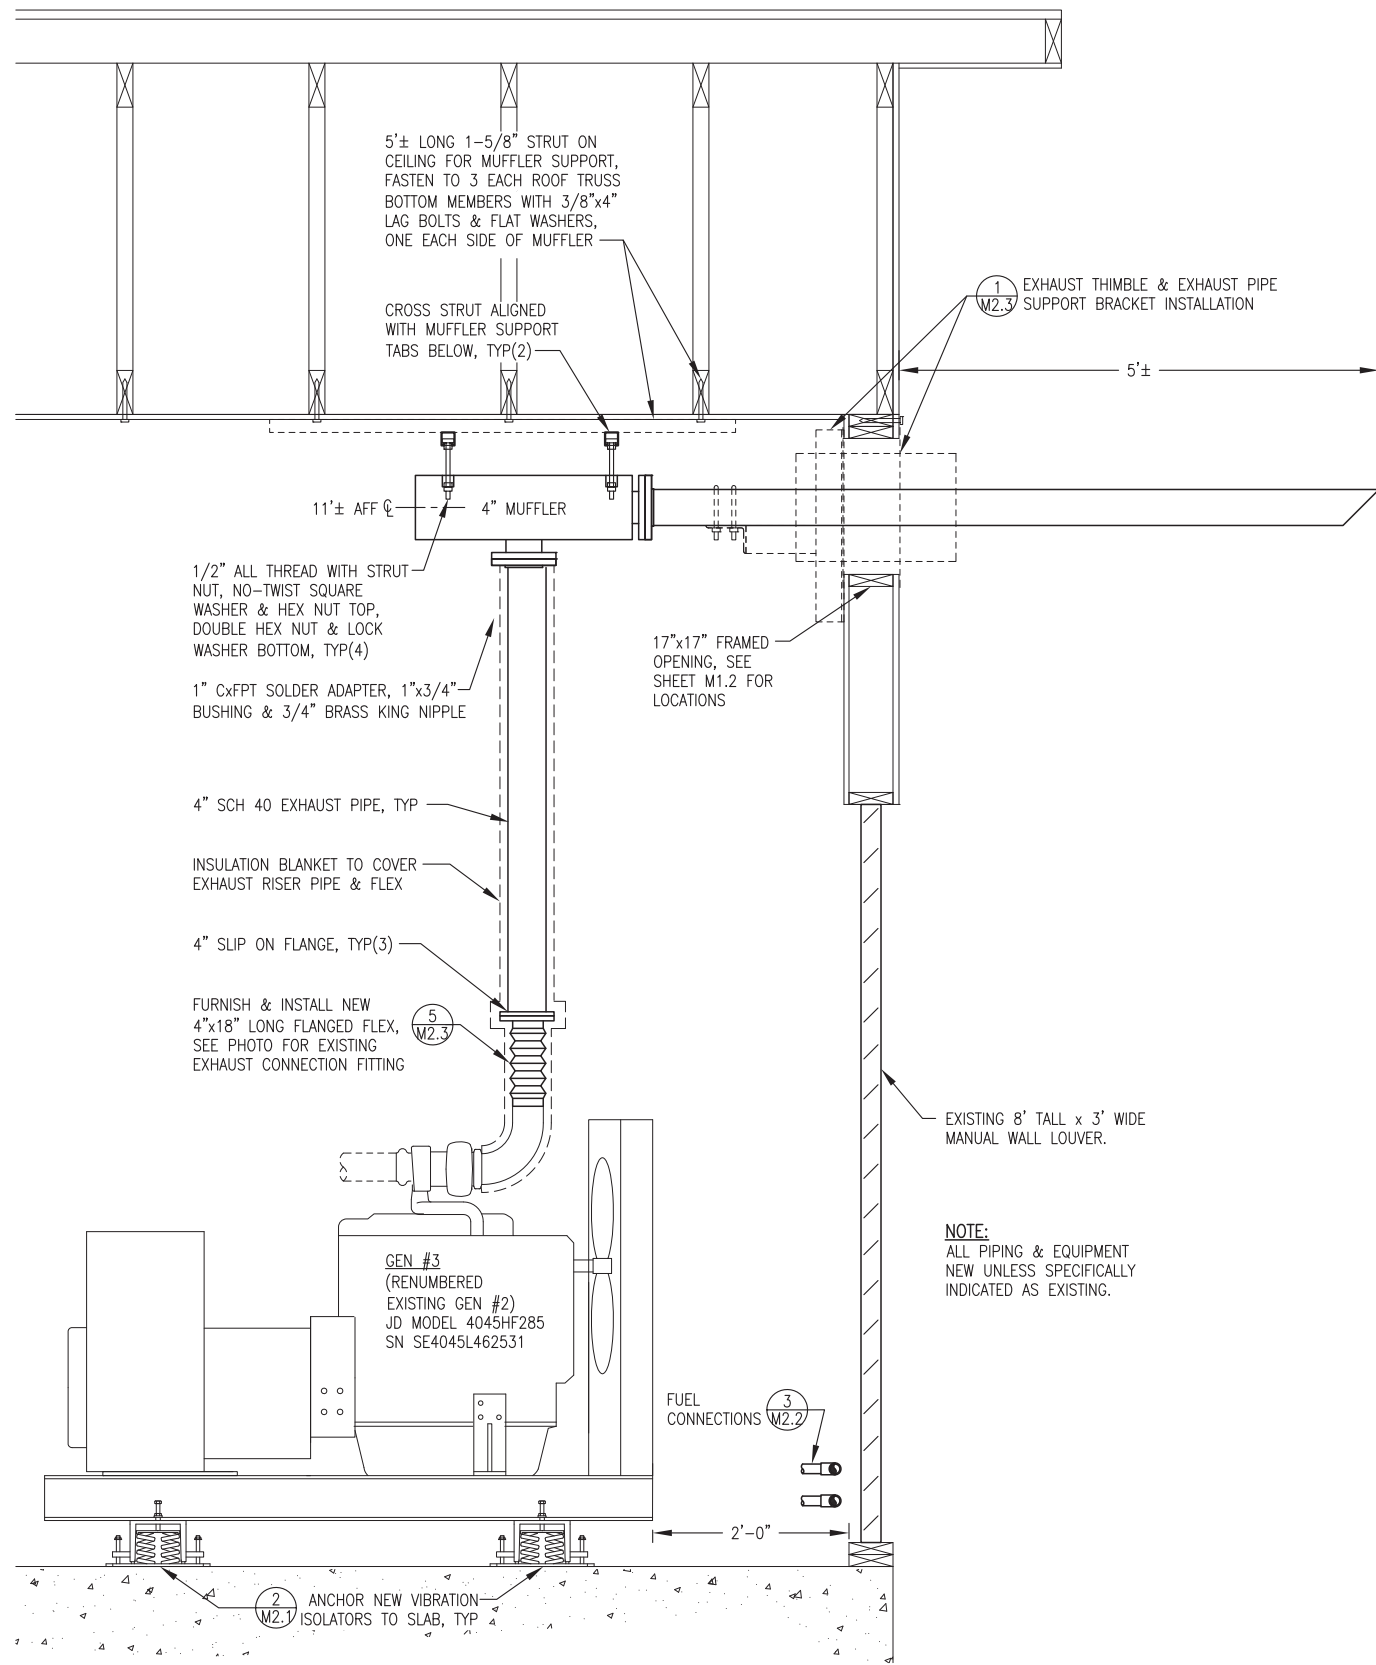

1 GENSET #3 (RENUMBERED EXISTING GENSET #2) REINSTALLATION ELEVATION
M2.2 1"=1'-0"

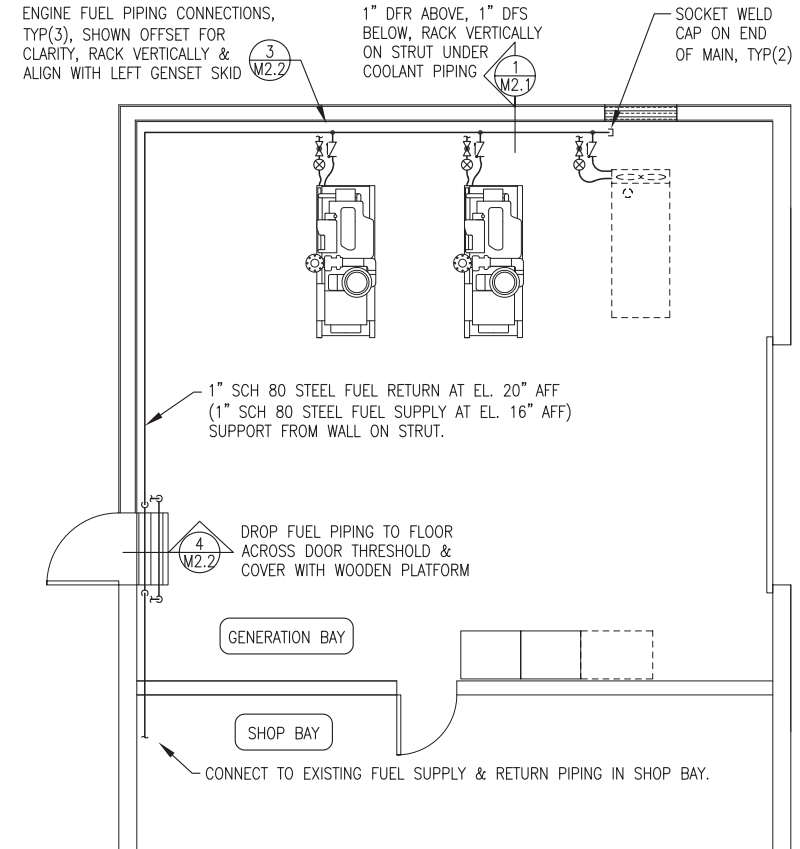


2 FUEL PIPING PLAN
M2.2 1/4"=1'-0"

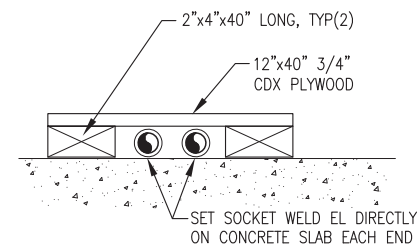

4 PIPING COVER AT DOOR
M2.2 NO SCALE

NOTES:

- GENSET #1 & #2: HOSES PROVIDED WITH ENGINE, SIZE VARIES PER ENGINE & PRODUCT, SEE SHEET M3. ALL EQUIPPED WITH JIC SWIVELS & 1/2" MPT ADAPTERS. CUT TO LENGTH & RE-INSTALL ENDS.
- GENSET #3 (FORMERLY GEN #2): FURNISH & INSTALL NEW #8 HOSE FOR DFS/DFR. FURNISH WITH JIC SWIVELS & FIELD CUT TO LENGTH. PROVIDE 1/2" MPT ADAPTERS FOR VALVE CONNECTIONS. PROVIDE ADAPTERS AS REQUIRED FOR ENGINE FUEL SYSTEM CONNECTIONS.
- ALL PIPING & NIPPLES SCH 80. ALL VALVES 1/2" SIZE, THREADED BODY.

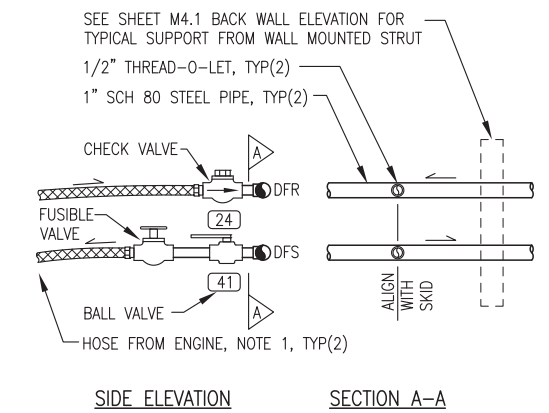


3 TYPICAL FUEL PIPING CONNECTION DETAIL
M2.2 NO SCALE


ISSUED FOR CONSTRUCTION
FEB 2020



PROJECT:	FFY17-18 DERA PROJECT CIRCLE POWER PLANT UPGRADE		
TITLE:	FUEL PIPING PLAN, DETAILS, & GENSET #3 INSTALLATION,		
DRAWN BY: JTD	DESIGNED BY: BCG	DATE: 3/18/20	SCALE: AS NOTED
FILE NAME: CIRDERA M1-4	PROJECT NUMBER:	SHEET:	M2.2 OF 4
P.O. 111405, Anchorage, AK 99511 (907)349-0100			

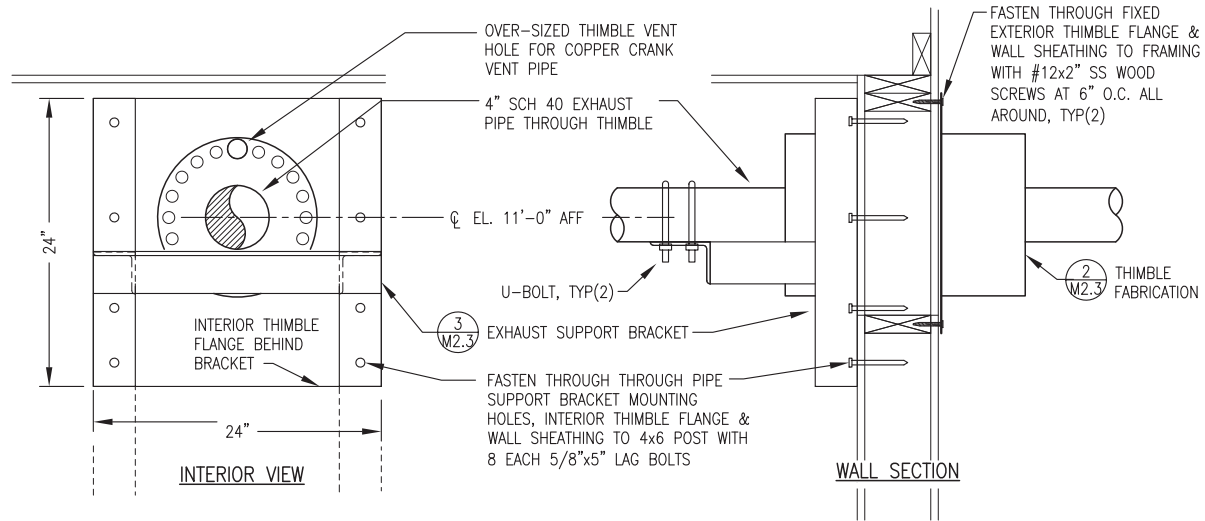


1 EXHAUST THIMBLE & EXHAUST PIPE SUPPORT BRACKET INSTALLATION
 M2.3 1-1/2"=1'-0"

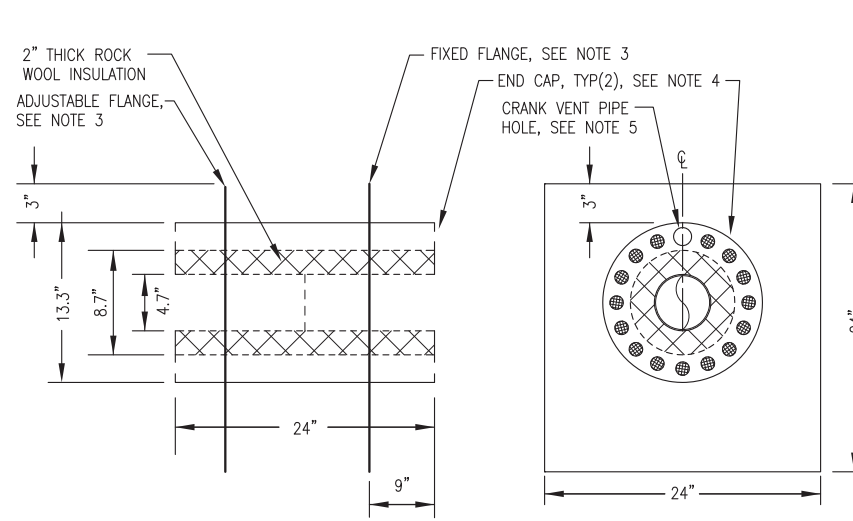


2 EXHAUST PIPE THIMBLE FABRICATION
 M2.3 NO SCALE

- NOTES:
1. FABRICATE 3 EACH IDENTICAL THIMBLES.
 2. FABRICATE ENTIRE ASSEMBLY FROM MINIMUM 16 GAUGE TYPE 304 STAINLESS STEEL WITH ALL JOINTS SEAL WELDED.
 3. FABRICATE TWO IDENTICAL SQUARE FLANGES. SEAL WELD FIXED FLANGE TO OUTER SHELL. ADJUSTABLE FLANGE TO SHIP LOOSE FOR FIELD INSTALLATION.
 4. SEAL WELD END CAPS TO INNER & OUTER SHELLS. PROVIDE 16 EACH 1" Ø VENT HOLES INTO UNINSULATED SPACE BOTH ENDS, EQUALLY SPACED. ON EXTERIOR (FIXED FLANGE) END INSTALL 1/8" STAINLESS STEEL BUG SCREEN.
 5. AT TOP-CENTER LOCATION EACH END PROVIDE 1.5" Ø HOLE WITHOUT SCREEN FOR CRANK VENT PIPE INSTALLATION.

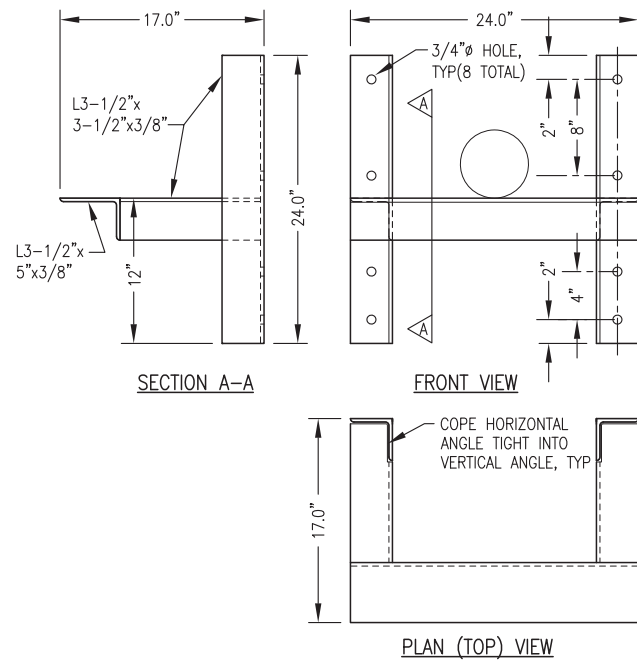

- NOTES:
1. FABRICATE 3 EACH IDENTICAL BRACKETS.
 2. MAKE ALL JOINTS WITH CONTINUOUS FULL PENETRATION WELDS.
 3. AFTER COMPLETION GRIND EDGES AND ROUND SHARP CORNERS, SANDBLAST ENTIRE ASSEMBLY, AND FINISH WITH TWO COATS OF EPOXY, SHERWIN WILLIAMS MACROPOXY 646, NO SUBSTITUTES, COLOR STRUCTURAL GRAY 4031.

3 EXHAUST SUPPORT BRACKET FABRICATION
 M2.3 NO SCALE

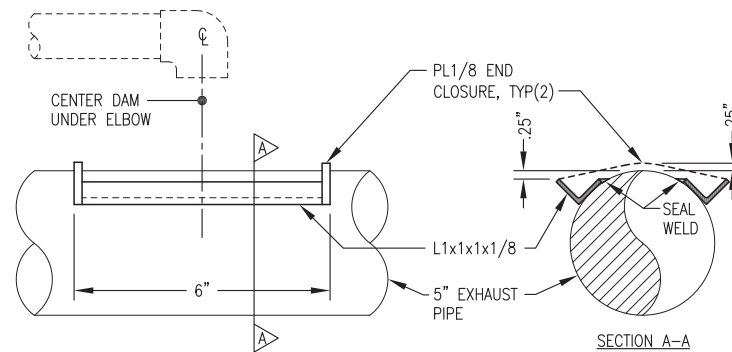

4 CRANKCASE DRIP DAM FABRICATION DETAIL
 M2.3 NO SCALE



PROVIDE 4" FLANGED X 18" LONG ENGINE EXHAUST FLEX WITH COUPLING TO MATCH EXISTING EXHAUST CONNECTION

5 EXISTING E-GEN EXHAUST CONNECTION FITTING
 M2.3 NO SCALE

ISSUED FOR
 CONSTRUCTION
 FEB 2020




PROJECT: FFY17-18 DERA PROJECT CIRCLE POWER PLANT UPGRADE	
TITLE: EXHAUST & CRANK VENT INSTALLATION DETAILS	
DRAWN BY: JTD	SCALE: AS NOTED
DESIGNED BY: BCG	DATE: 3/18/20
FILE NAME: CIRDERA M1-4	SHEET: M2.3 OF 4
PROJECT NUMBER:	


Gray Stassel Engineering, Inc.
 P.O. 111405, Anchorage, AK 99511 (907)349-0100

MINIMUM HOSE SIZE SCHEDULE		
FUEL SUPPLY	FUEL RETURN	USED OIL
#8	#8	N/A


NOTE:
ON 4045'S GROUP HOSES
ON LEFT SKID AS SHOWN
TO COORDINATE WITH
COOLANT HOSES.

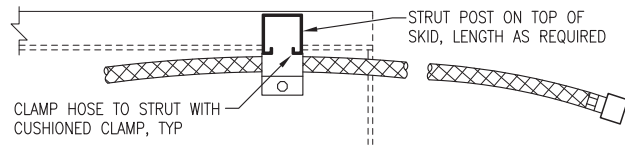

LEFT SKID PLAN (TOP) VIEW

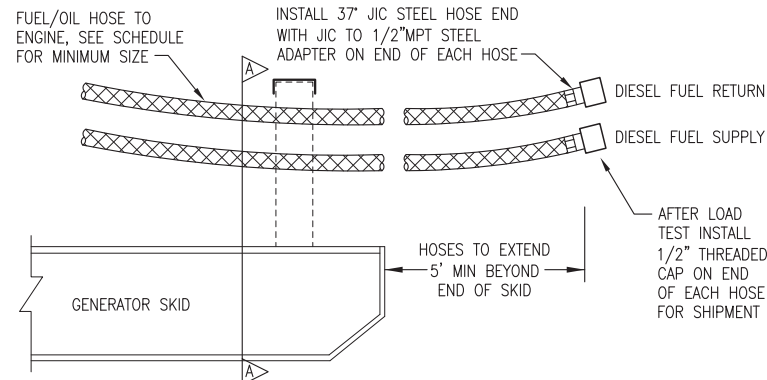


ELEVATION (SIDE) VIEW

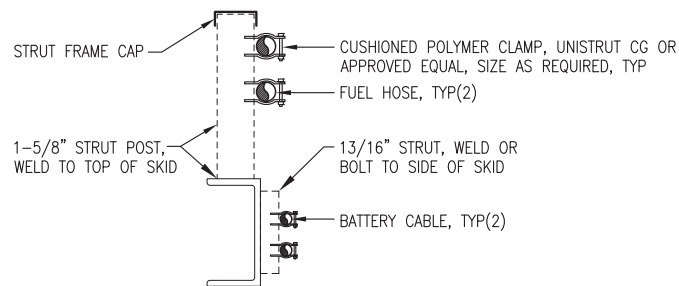


SECTION A-A


1 FUEL/OIL HOSE & BATTERY CABLE INSTALLATION ON SKID
M3 NO SCALE

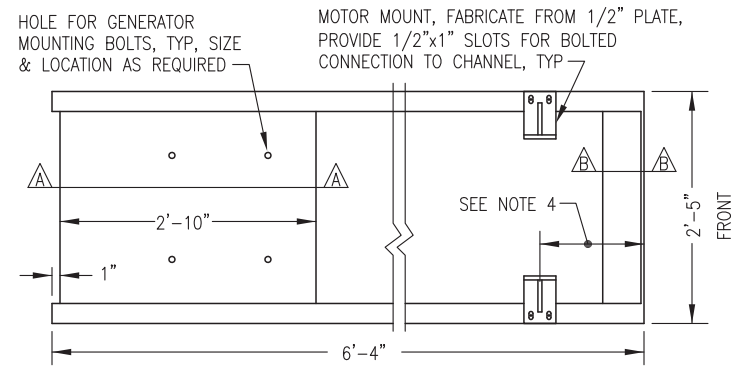


PLAN (TOP) VIEW

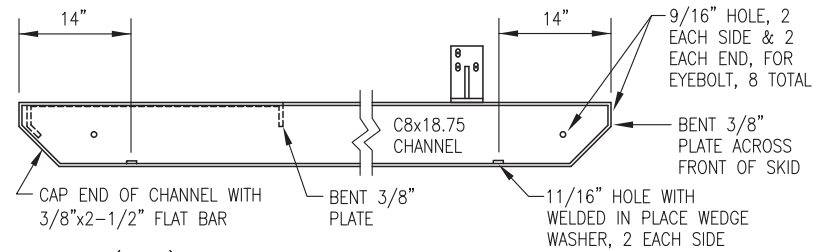

ELEVATION (SIDE) VIEW

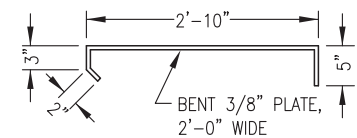

SECTION A-A

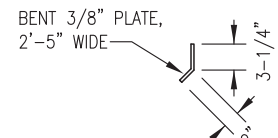


SECTION B-B

NOTES:

- 1) FABRICATE FROM ASTM A-36 STEEL. BEND PLATES & CUT ENDS OF CHANNELS AT 90° & 45° AS SHOWN.
- 2) EXCEPT WHERE INDICATED AS BOLTED MAKE ALL CONNECTIONS WITH CONTINUOUS WELDS (FILLET OR FULL-PENETRATION GROOVE AS REQUIRED) IN ACCORDANCE WITH CURRENT AWS STANDARD CODE.
- 3) ROUND ALL CORNERS & GRIND WELDS SMOOTH AFTER FABRICATION. PAINT TO MATCH ENGINE-GENERATOR.
- 4) PLACE UNIT ON SKID SO THAT THE EXHAUST RISER CENTERLINE IS 3'-3" FROM THE FRONT OF THE SKID.

2 TYPICAL GENERATOR SKID FABRICATION
M3 NO SCALE

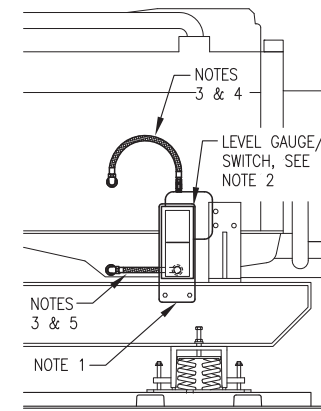

3 TYPICAL OIL LEVEL GAUGE/SWITCH INSTALLATION
M3 NO SCALE

NOTES:


- 1) 1/4" STEEL SUPPORT PLATE PRE-DRILLED TO MATCH GAUGE/SWITCH MOUNTS, CHANNEL SKID HOLES AND BOTTOM HOSE ENTRANCE. BOLT TO INSIDE (BACK) OF CHANNEL SKID AT HEIGHT AS REQUIRED TO CENTER GAUGE AT NORMAL FULL OIL LEVEL. ADJUST SWITCH CONTACTS 1/2" ABOVE & BELOW.
- 2) SEE ENGINE GENERATOR SPECIFICATIONS FOR LEVEL/GUAGE SWITCH. MOUNT TO STEEL SUPPORT PLATE WITH RUBBER SHOCK MOUNTS.
- 3) #8 HOSE WITH 1/2" OR 3/8" NPT JIC SWIVEL ENDS AS REQUIRED.
- 4) CONNECT TOP (VENT) PORT TO ENGINE CRANK CASE WITH HOSE. ROUTE UPPER HOSE TO AVOID LOW POINT TRAPS.
- 5) CONNECT BOTTOM PORT TO ENGINE OIL PAN WITH HOSE. DO NOT TEE INTO OIL DRAIN LINE. ROUTE LOWER HOSE BACK THROUGH PRE-DRILLED HOLE IN STEEL PLATE.

ISSUED FOR
CONSTRUCTION
FEB 2020




PROJECT:	FFY17-18 DERA PROJECT CIRCLE POWER PLANT UPGRADE	
TITLE:	GENSET FABRICATION DETAILS	
DRAWN BY: JTD	SCALE: AS NOTED	
DESIGNED BY: BCG	DATE: 3/18/20	
FILE NAME: CIRDERA M1-4	SHEET:	M3 OF 4
PROJECT NUMBER:		

Gray
Stassel
Engineering, Inc.
P.O. 111405, Anchorage, AK 99511 (907)349-0100

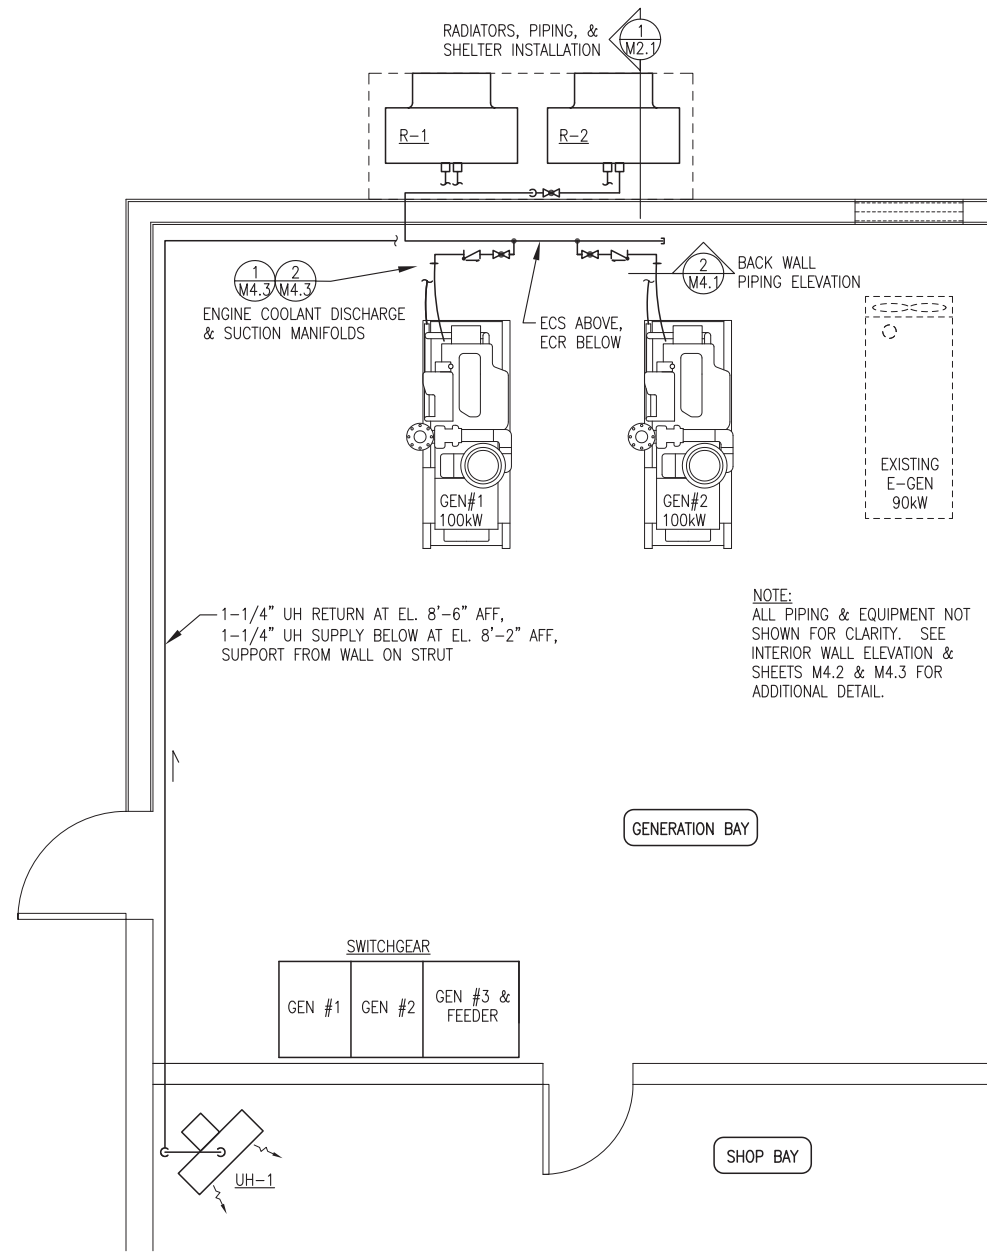


1 COOLANT PIPING PLAN
M4.1 3/8"=1'-0"

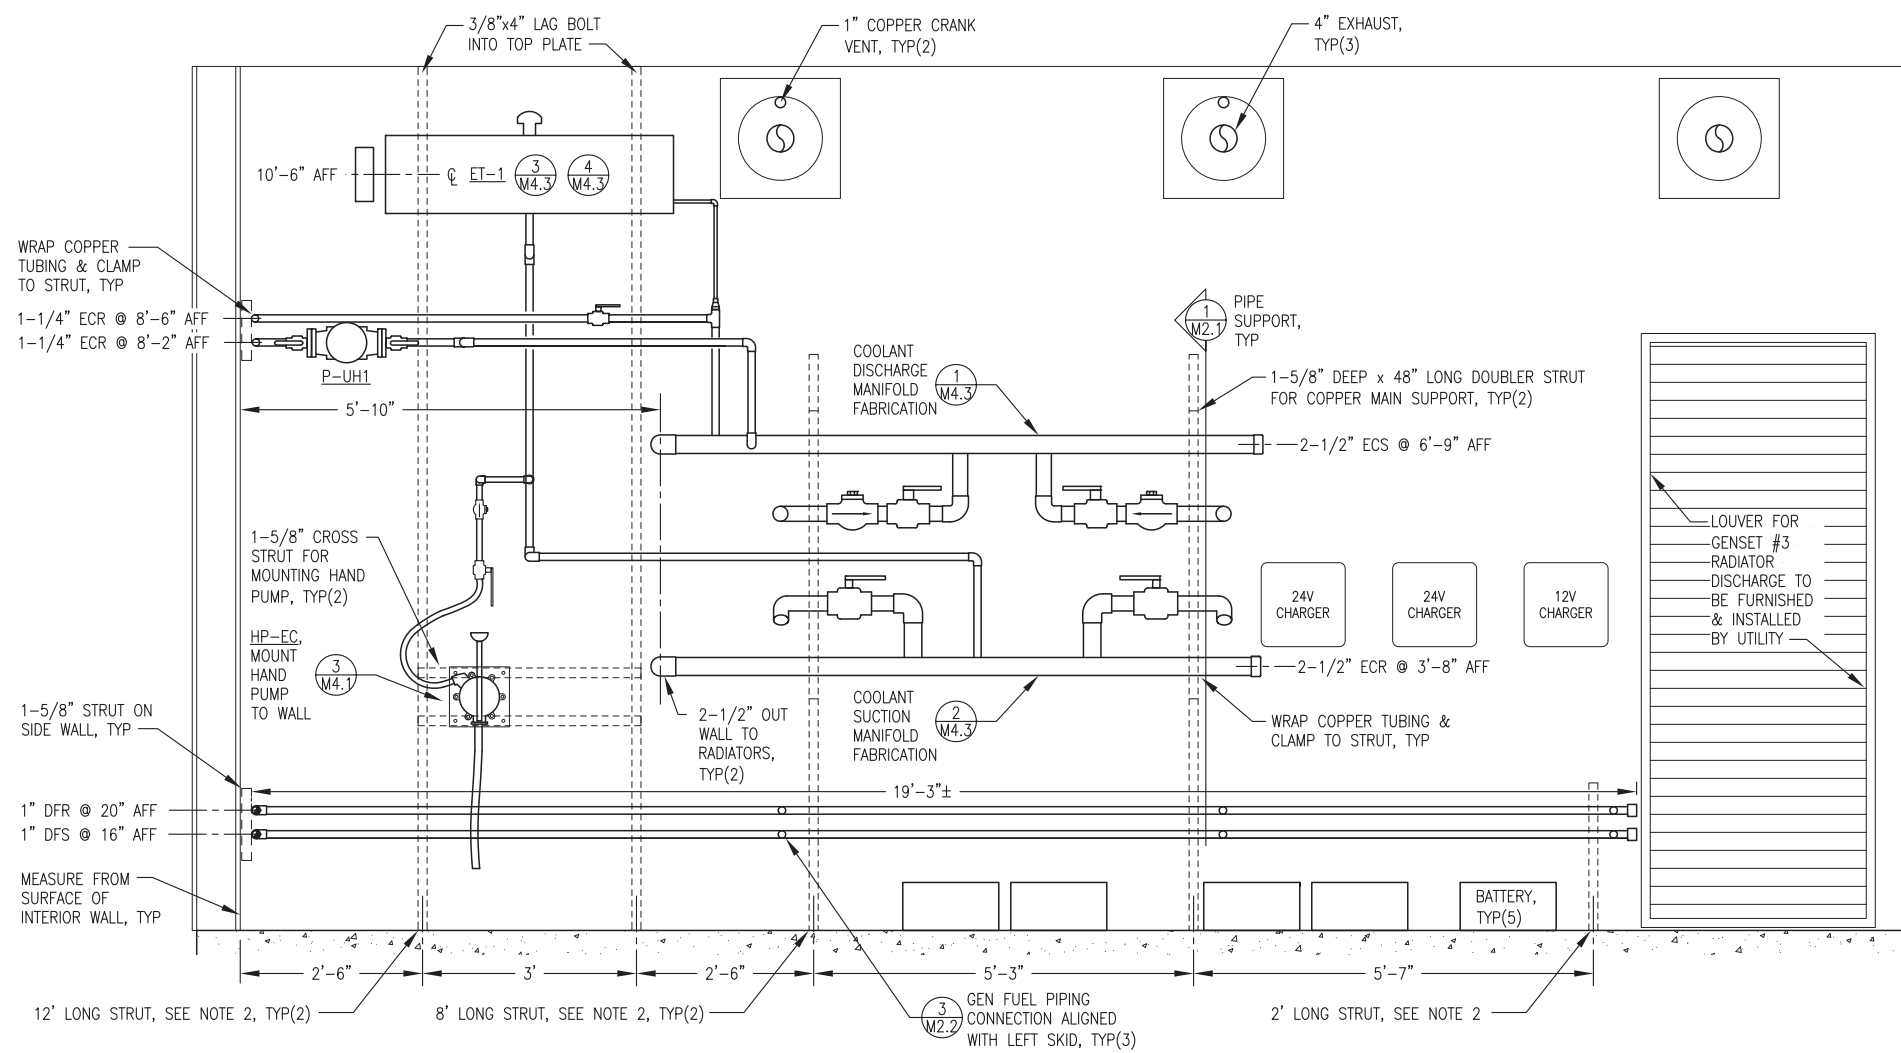

2 BACK WALL PIPING ELEVATION
M4.1 3/4"=1'-0"

NOTES:
1) NOT ALL PIPING & DEVICES SHOWN THIS ELEVATION FOR CLARITY. SEE ISOMETRIC 1/M4.2 FOR ADDITIONAL DETAIL.
2) ALL VERTICAL STRUT THIS WALL 1-5/8" DEEP STRUT WITH DOUBLER STRUT WHERE INDICATED. FASTEN TO WALL SHEATHING WITH 1/4"x2-1/2" LAG BOLTS & FENDER WASHERS AT 12"O.C.

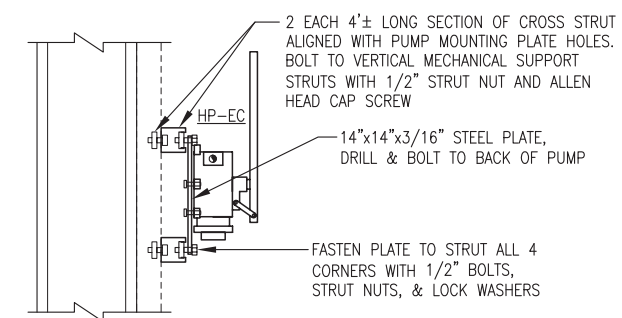


3 HAND PUMP HP-EC SUPPORT
M4.1 NO SCALE

EXCLUSIONS: COOLANT PIPING, EQUIPMENT, AND LOUVERED OPENING AS INDICATED.

ISSUED FOR CONSTRUCTION
FEB 2020




PROJECT:	FFY17-18 DERA PROJECT CIRCLE POWER PLANT UPGRADE		
TITLE:	PIPING & EQUIPMENT INSTALLATION PLAN, ELEVATION, & DETAILS		
DRAWN BY:	JTD	SCALE:	AS NOTED
DESIGNED BY:	BGG	DATE:	3/18/20
FILE NAME:	CIRDERA M1-4	SHEET:	M4.1 OF 4
PROJECT NUMBER:	P.O. 111405, Anchorage, AK 99511 (907)349-0100		

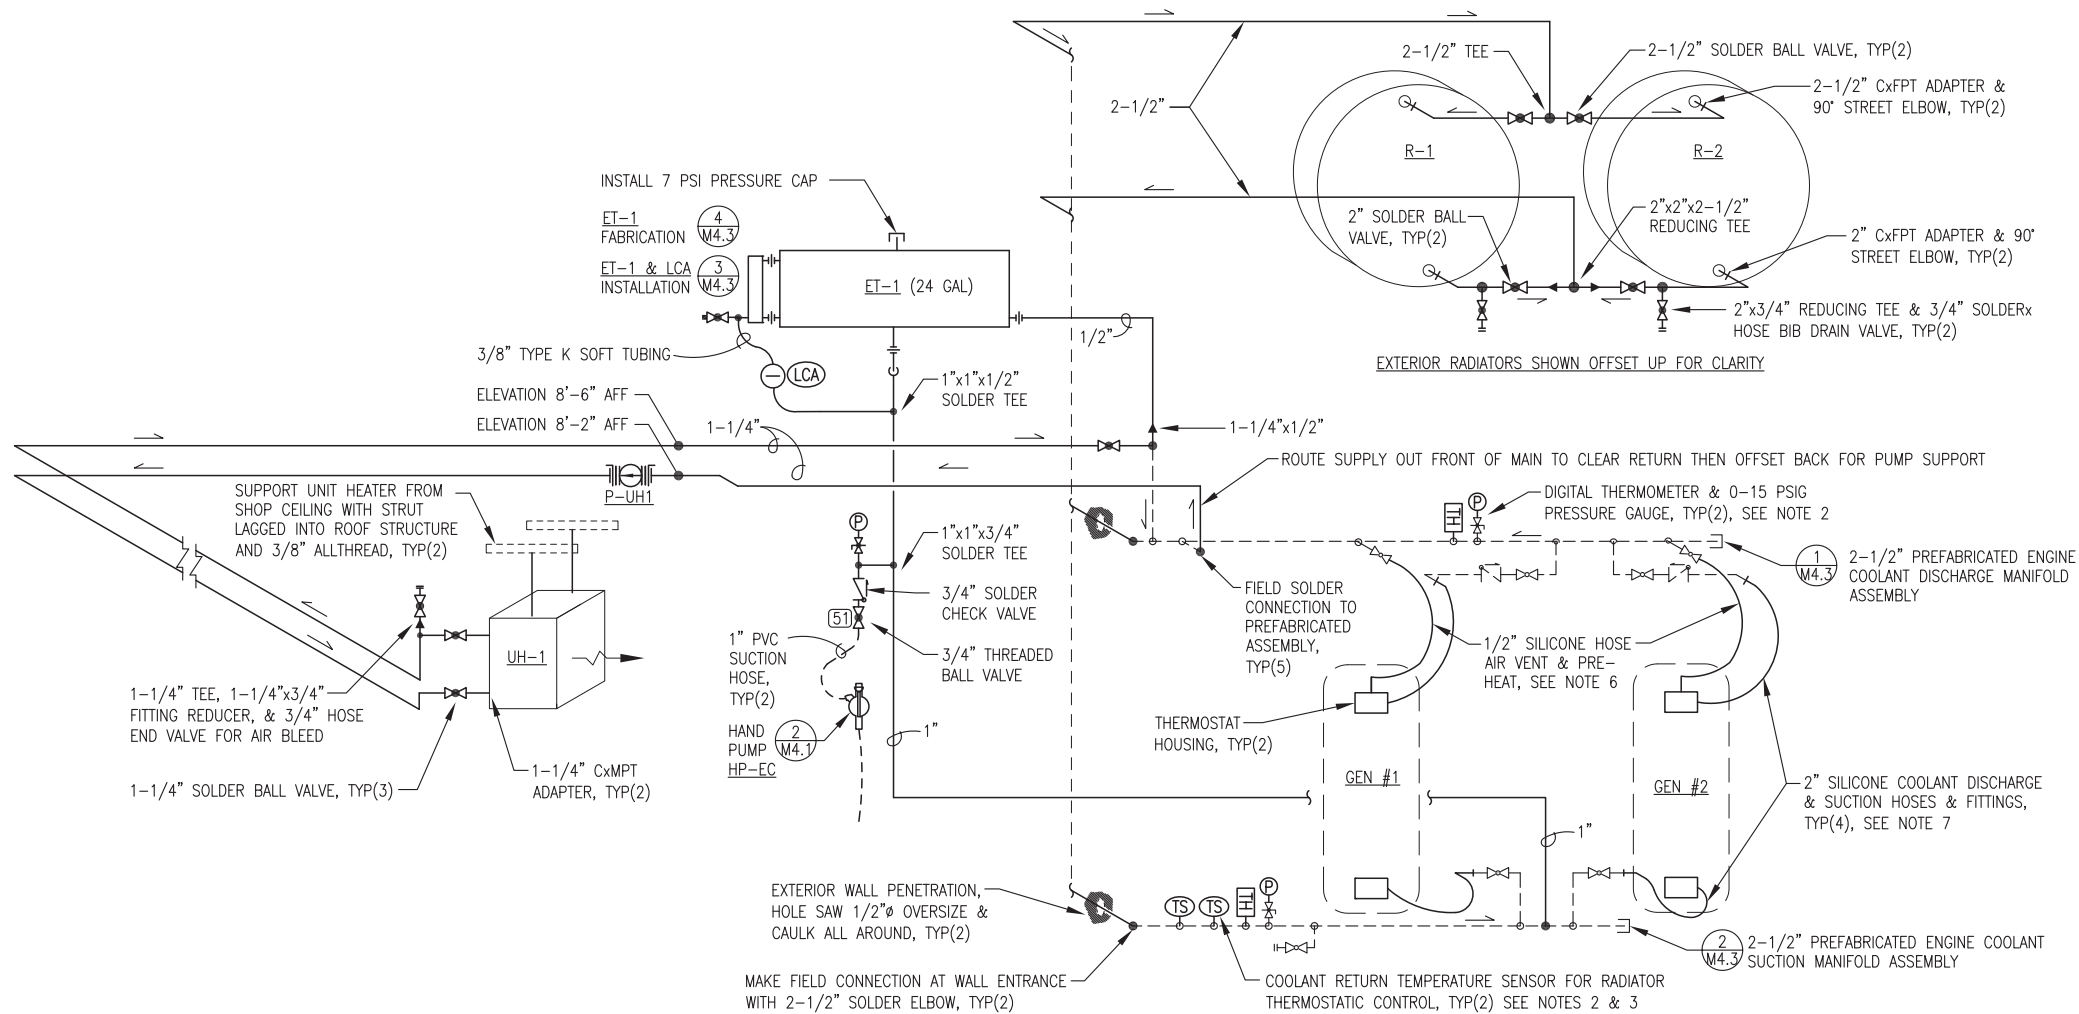

COOLING SYSTEM ISOMETRIC NOTES:

1. ALL PIPING SHOWN THIS ISOMETRIC TYPE "L" COPPER WITH SOLDER JOINTS, 2-1/2"Ø EXCEPT WHERE SPECIFICALLY INDICATED OTHERWISE. FIELD INSTALLED PIPING SHOWN WITH DARK SOLID LINES AND PREFABRICATED SHOP ASSEMBLES SHOWN WITH LIGHT DASHED LINES.
2. MAKE ALL CONNECTIONS FOR INSTRUMENTATION WITH AS SHOWN ON DETAIL 2/M4.2.
3. SEE ELECTRICAL INSTRUMENTATION SCHEDULE FOR TEMPERATURE SENSORS.
4. UPON COMPLETION OF FABRICATION VALVE OFF CABINET UNIT HEATER AND FLUSH PIPING TO REMOVE ALL DEBRIS, SEE SPECIFICATIONS.
5. ALL PIPING NOT INSULATED.
6. AS PART OF DERA PROJECT FURNISH AND INSTALL 3/4" MPTx5/8" BARB BRASS KING NIPPLE, 1/2" SILICONE HOSE AND HOSE CLAMPS FOR ENGINE VENT & PRE-HEAT.
7. AS PART OF DERA PROJECT FURNISH AND INSTALL 2" MPTx2" BARB BRASS KING NIPPLE, 2" SILICONE HOSE AND HOSE CLAMPS FOR ENGINE COOLING.

1 COOLING SYSTEM PIPING ISOMETRIC
M4.2 NO SCALE

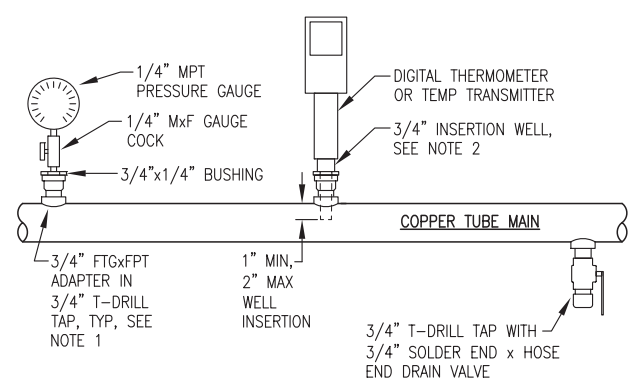

- NOTES:**
- 1) USE T-DRILL TAPS AS SHOWN FOR INSTALLATIONS IN 1-1/4" AND LARGER COPPER MAINS. USE LINE SIZE TEE FITTINGS FOR INSTALLING INSTRUMENTATION IN 1" AND SMALLER MAINS.
 - 2) TEMPERATURE TRANSMITTER INSTALLATION SIMILAR TO THERMOMETER EXCEPT USE 3/4"x1/2" BUSHING.
 - 3) FOR MAINS SMALLER THAN 2" USE COPPER TUBE RISER AS SHOWN, LENGTH AS REQUIRED FOR 1" TO 2" WELL INSERTION INTO MAIN. FOR LARGER PIPES OMIT RISER AND INSERT 3/4" FTGxFPT ADAPTER INTO T-DRILL TAP.

2 TYPICAL INSTRUMENT INSTALLATION
M4.2 NO SCALE


EXCLUSIONS: ALL WORK THIS SHEET.

ISSUED FOR CONSTRUCTION
FEB 2020




PROJECT:	FFY17-18 DERA PROJECT CIRCLE POWER PLANT UPGRADE	
TITLE:	COOLANT PIPING ISOMETRIC & DETAILS	
DRAWN BY: JTD	SCALE: AS NOTED	
DESIGNED BY: BCG	DATE: 3/18/20	
FILE NAME: CIRDERA M1-4	SHEET:	M4.2 OF 4
PROJECT NUMBER:		



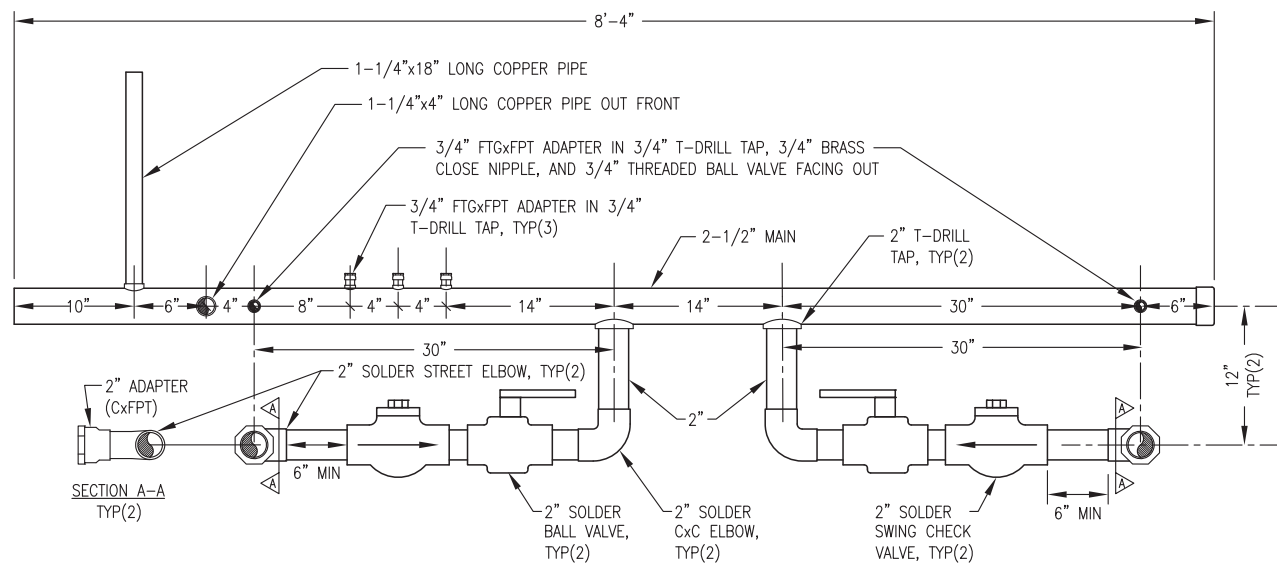


- NOTES:
- 1) ALL PIPING TYPE L COPPER TUBE, SIZE AS INDICATED.
 - 2) MAKE ALL MAIN & INSTRUMENTATION BRANCH CONNECTIONS WITH BRAZED T-DRILL TAPS.

1 PREFABRICATED COOLANT DISCHARGE MANIFOLD
M4.3 1-1/2"=1'-0"

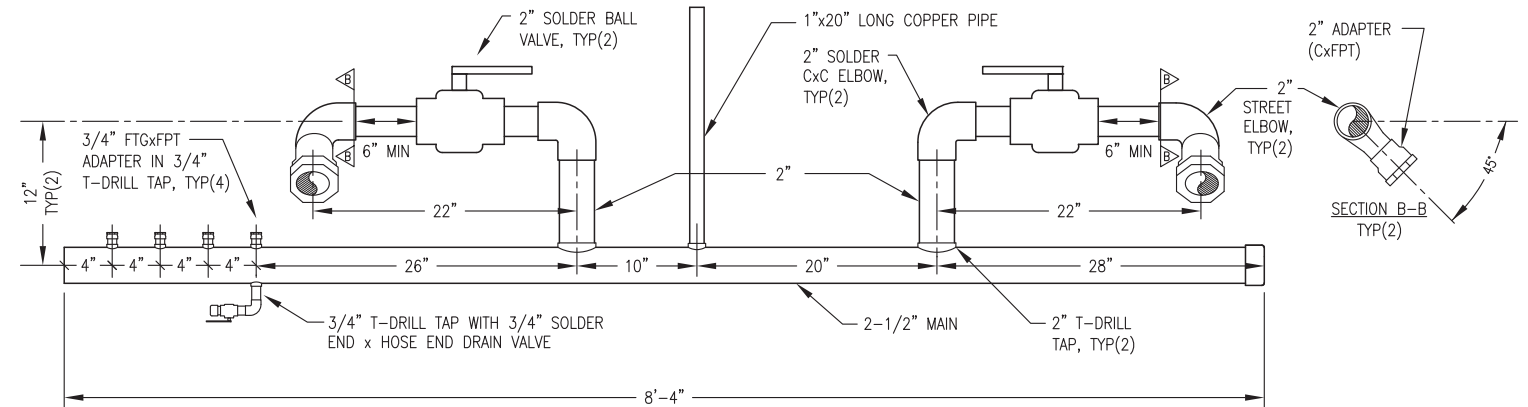


- NOTES:
- 1) ALL PIPING TYPE L COPPER TUBE, SIZE AS INDICATED.
 - 2) MAKE ALL BRANCH CONNECTIONS WITH BRAZED T-DRILL TAPS.

2 PREFABRICATED COOLANT SUCTION MANIFOLD
M4.3 1-1/2"=1'-0"

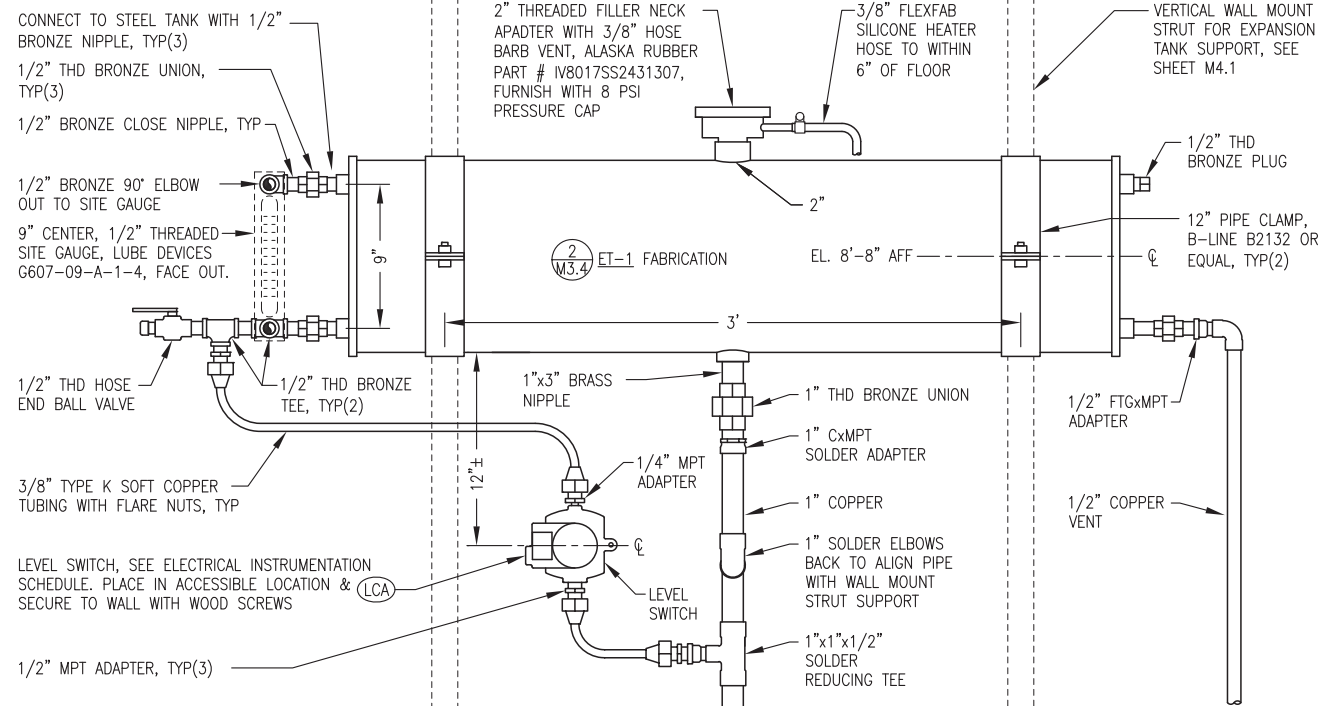

3 24 GAL EXPANSION TANK ET-1 INSTALLATION
M4.3 NO SCALE

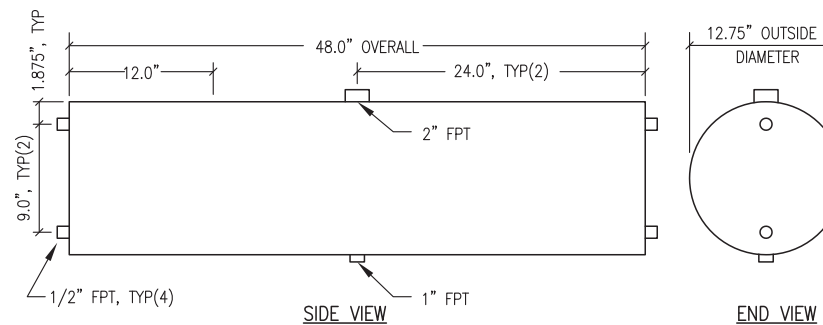

4 24 GALLON GLYCOL EXPANSION TANK ET-1 FABRICATION
M4.3 1-1/2"=1'-0"

EXPANSION TANK GENERAL NOTES:

1. FABRICATE SINGLE WALL 24 GALLON NOMINAL CAPACITY GLYCOL EXPANSION TANK.
2. FABRICATE SHELL FROM MINIMUM 10 GAUGE ASTM A-36 PLATE STEEL ROLLED AND WELDED OR SCHEDULE 5 LIGHTWALL ASTM A53 STEEL PIPE. FABRICATE HEADS FROM 3/16" THICK ASTM A-36 PLATE STEEL. MAKE ALL JOINTS WITH CONTINUOUS FULL-PENETRATION WELDS.
3. PROVIDE WITH ALL OPENINGS INDICATED USING MINIMUM 3000# FORGED STEEL PIPE HALF COUPLINGS IN ACCORDANCE WITH U.L 142 FIGURE 7.1 #2.
4. PRESSURE TEST COMPLETED ASSEMBLY TO 15 PSIG MINIMUM.
5. UPON COMPLETION OF FABRICATION, ROUND ALL CORNERS AND SHARP EDGES. SANDBLAST TANK EXTERIOR AND ALL ATTACHMENTS IN ACCORDANCE WITH SSPC-SP-6. PRIME WITH RED OXIDE PRIMER, PPG MULTIPRIME 4160 OR APPROVED EQUAL. FINISH WITH TWO COATS OF ALKYD ENAMEL, PPG DEVGUARD 4308 OR APPROVED EQUAL, COLOR ANSI 61 GRAY.
6. UPON COMPLETION FLUSH INTERIOR OF TANK TO REMOVE ALL DIRT AND DEBRIS, AIR DRY INTERIOR, AND SEAL ALL TANK OPENINGS WITH PLASTIC PLUGS.


EXCLUSIONS: ALL WORK THIS SHEET.

ISSUED FOR
CONSTRUCTION
FEB 2020




PROJECT:	FFY17-18 DERA PROJECT CIRCLE POWER PLANT UPGRADE	
TITLE:	COOLANT PIPING DETAILS	
DRAWN BY:	JTD	SCALE: AS NOTED
DESIGNED BY:	BCG	DATE: 3/18/20
FILE NAME:	CIRDERA M1-4	SHEET:
PROJECT NUMBER:		M4.3 OF 4

Gray
Stassel
Engineering, Inc.
P.O. 111405, Anchorage, AK 99511 (907)349-0100

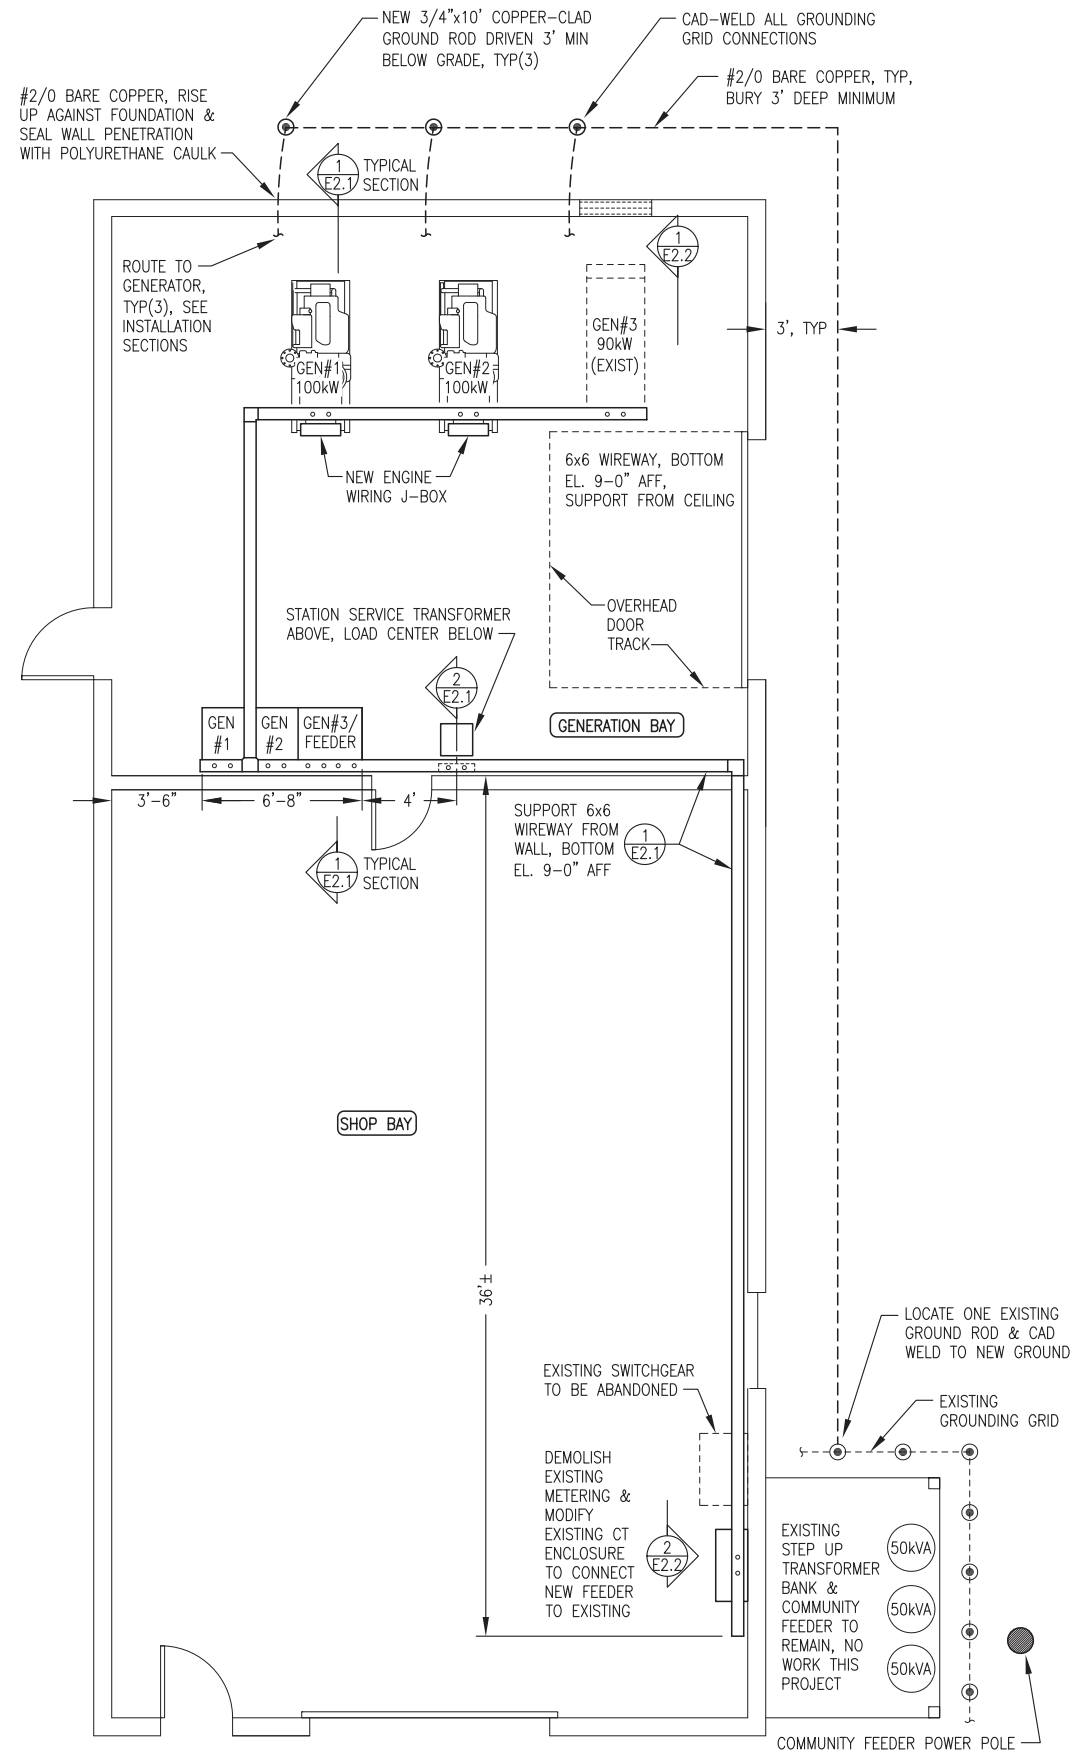

1 WIREWAY, POWER, AND GROUNDING PLAN
1/4"=1'-0"

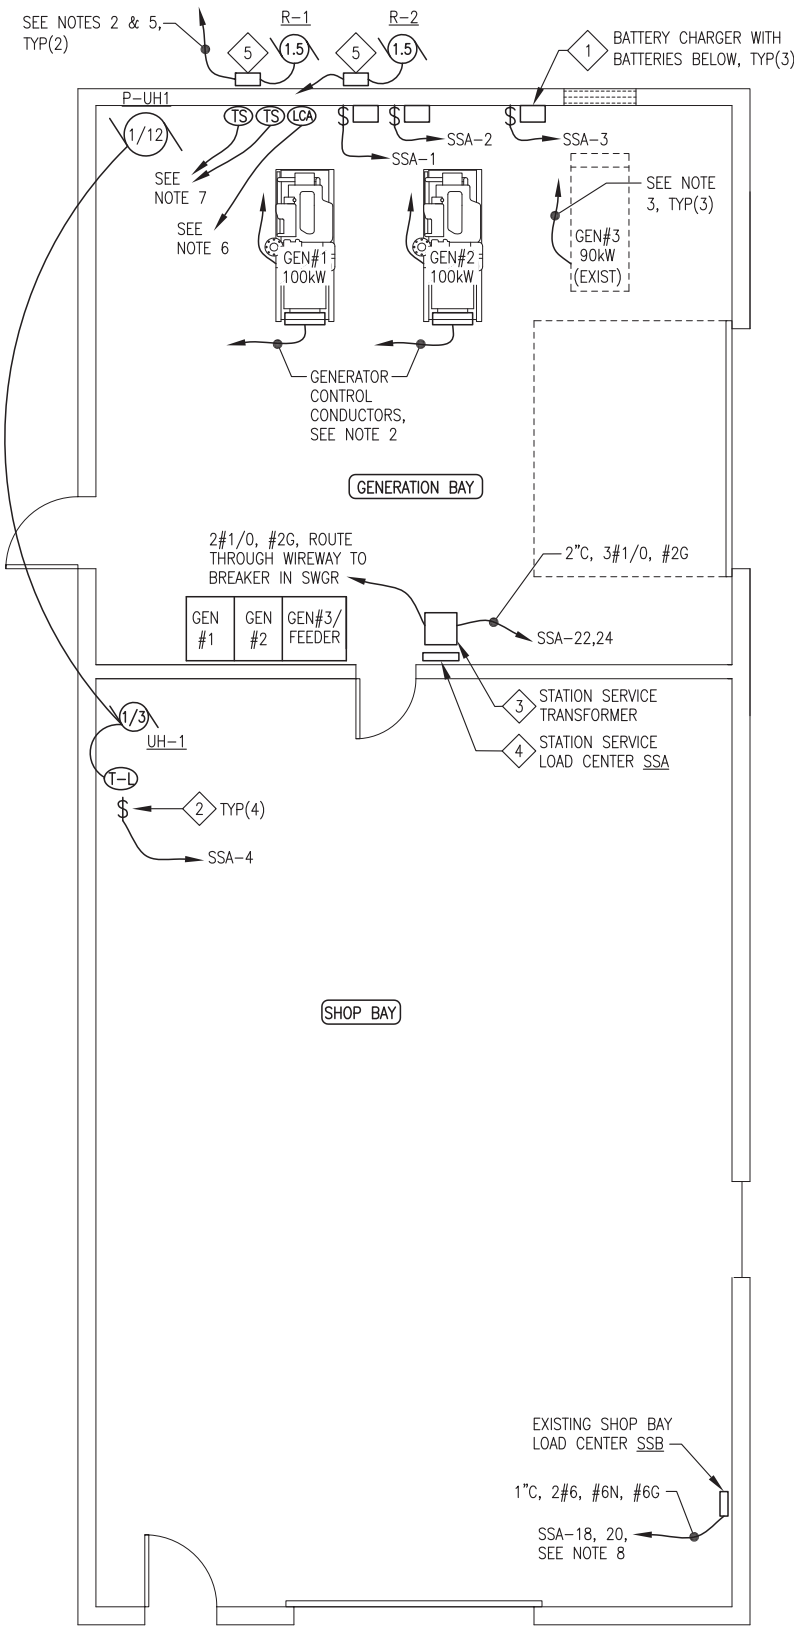

2 STATION SERVICE & INSTRUMENTATION PLAN
1/4"=1'-0"

GENERAL NOTES:

- EXISTING EQUIPMENT TO BE RELOCATED AND REMAIN IN SERVICE SHOWN WITH LIGHT DASHED LINES.
- NEW EQUIPMENT TO BE INSTALLED SHOWN WITH DARK SOLID LINES.

STATION SERVICE NOTES:

- ALL WIRING RUNS 2#12, #12G UNLESS SPECIFICALLY NOTED OTHERWISE.
- SEE SWITCHGEAR SHOP DRAWINGS FOR TERMINATION OF ALL POWER AND CONTROL WIRING.
- ROUTE EXTRA-FLEX BATTERY CABLES FROM SKID TO BATTERIES, SEE INSTALLATION SECTIONS.
- MOUNT BATTERY CHARGER TO WALL AND BATTERIES IN RACK BELOW, SEE DETAIL 3/E2.2.
- 3/4"C, 3#12, #12G RADIATOR POWER CONDUCTORS, ROUTE THROUGH WIREWAY TO SWITCHGEAR.
- INSTALL LOW COOLANT LEVEL ALARM SWITCH WHERE SHOWN ON DETAIL 3/M4.3. CONNECT TO N.C. SWITCH (WHITE & RED) AND ROUTE 2#14 IN WIREWAY TO SWITCHGEAR. SEE NOTE 2.
- INSTALL SENSORS FOR RADIATOR THERMOSTATIC CONTROL WHERE SHOWN ON PIPING ISOMETRIC 1/M4.2. ROUTE #18 SHIELDED PAIR FROM EACH TO SWITCHGEAR THROUGH WIREWAY. SEE NOTE 2.
- EXISTING 240V, SINGLE PHASE SHOP BAY LOAD CENTER SSB TO BE SUB-FED FROM 60A 2-POLE BREAKER IN NEW GENERATION BAY LOAD CENTER SSB. ROUTE CONDUCTORS IN WIREWAY WITH FEEDER CONDUCTORS.

ELECTRICAL EQUIPMENT/DEVICE SCHEDULE

SYMBOL	SERVICE	DESCRIPTION	MANUFACTURER/MODEL
1	BATTERY CHARGER	12/24-VOLT SOLID STATE 20-AMP AUTO-EQUALIZING BATTERY CHARGER FOR 120 VAC INPUT, WITH OPTIONAL HIGH/LOW VOLTAGE, AC POWER FAILURE, & REMOTE SUMMARY ALARM RELAYS	SENS NRG22-20-RCLS
2	1Ø SMALL MOTOR DISCONNECT	SINGLE POLE SNAP SWITCH WITH RED PILOT LIGHT, 120V, 20A, 1-1/2HP RATED, INSTALL IN 4"x4" STEEL BOX WITH METAL COVER	HUBBELL 1221-PL
3	STATION SERVICE TRANSFORMER	DRY TYPE, ENCLOSURE TYPE 3R WITH INTEGRAL WALL MOUNT BRACKETS, SINGLE PHASE, 25kVA, HV 240X480, LV 120/240	HAMMOND HPS SENTINEL G SG3N0025LE
4	STATION SERVICE PANELBOARD	COPPER BUS, SINGLE PHASE, SURFACE MOUNT, NEMA 1, 3-WIRE, 120/240V, 100A, 24 CIRCUITS, PLUG-IN BREAKERS QUANTITY & RATING AS INDICATED ON DETAIL	SIEMENS P2424B1100SCU
5	RADIATOR MOTOR DISCONNECT	NON-FUSED LOCKABLE SAFETY SWITCH, NEMA 3R ENCLOSURE, 3PST, 240V, 30A, 3HP RATED	SIEMENS GNF321

ELECTRICAL INSTRUMENTATION SCHEDULE


SYMBOL	SERVICE	DESCRIPTION	MANUFACTURER/MODEL
TS	TEMPERATURE SENSOR	PTC TEMPERATURE PROBE FOR PENN CONTROLLER IN SWITCHGEAR WITH 2.0 METER LONG PVC JACKETED CABLE & 1/2" NPT WELL	PENN A99BA-200C SENSOR PENN WEL11A-601R WELL
LCA	GLYCOL TANK LOW COOLANT ALARM	LOW COOLANT LEVEL ALARM FLOAT SWITCH, SEE MECHANICAL FOR INSTALLATION DETAILS	MURPHY EL-150-K1
T-L	LINE VOLTAGE THERMOSTAT	HEATING/COOLING THERMOSTAT, 16 FLA @ 120V, SPDT, 50F TO 80F RANGE.	DAYTON 1UHH2

EQUIPMENT REQUIREMENTS FOR APPROVED EQUALS (APPLIES ALL SCHEDULES):
SPECIFIC PARTS MANUFACTURER AND MODEL SELECTED NOT ONLY TO MEET PERFORMANCE FUNCTION BUT ALSO TO COORDINATE AND INTERFACE WITH OTHER DEVICES AND SYSTEMS. APPROVED EQUAL SUBSTITUTIONS WILL BE ALLOWED ONLY BY ENGINEER'S APPROVAL. TO OBTAIN APPROVAL, SUBMITTALS MUST CLEARLY DEMONSTRATE HOW SUBSTITUTE ITEM MEETS OR EXCEEDS SPECIFIED ITEM QUALITY AND PERFORMANCE CHARACTERISTICS AND ALSO COMPLIES WITH MECHANICAL AND/OR ELECTRICAL CONNECTIONS AND PHYSICAL LAYOUT REQUIREMENTS.


ISSUED FOR
CONSTRUCTION
FEB 2020




PROJECT:	FFY17-18 DERA PROJECT CIRCLE POWER PLANT UPGRADE		
TITLE:	ELECTRICAL WORK PLAN & EQUIPMENT SCHEDULE		
DRAWN BY: JTD	DESIGNED BY: CWV/BCG	SCALE: AS NOTED	DATE: 3/18/20
FILE NAME: CIRDERA E1-3	PROJECT NUMBER:	SHEET: E1 OF 3	
P.O. 111405, Anchorage, AK 99511 (907)349-0100			

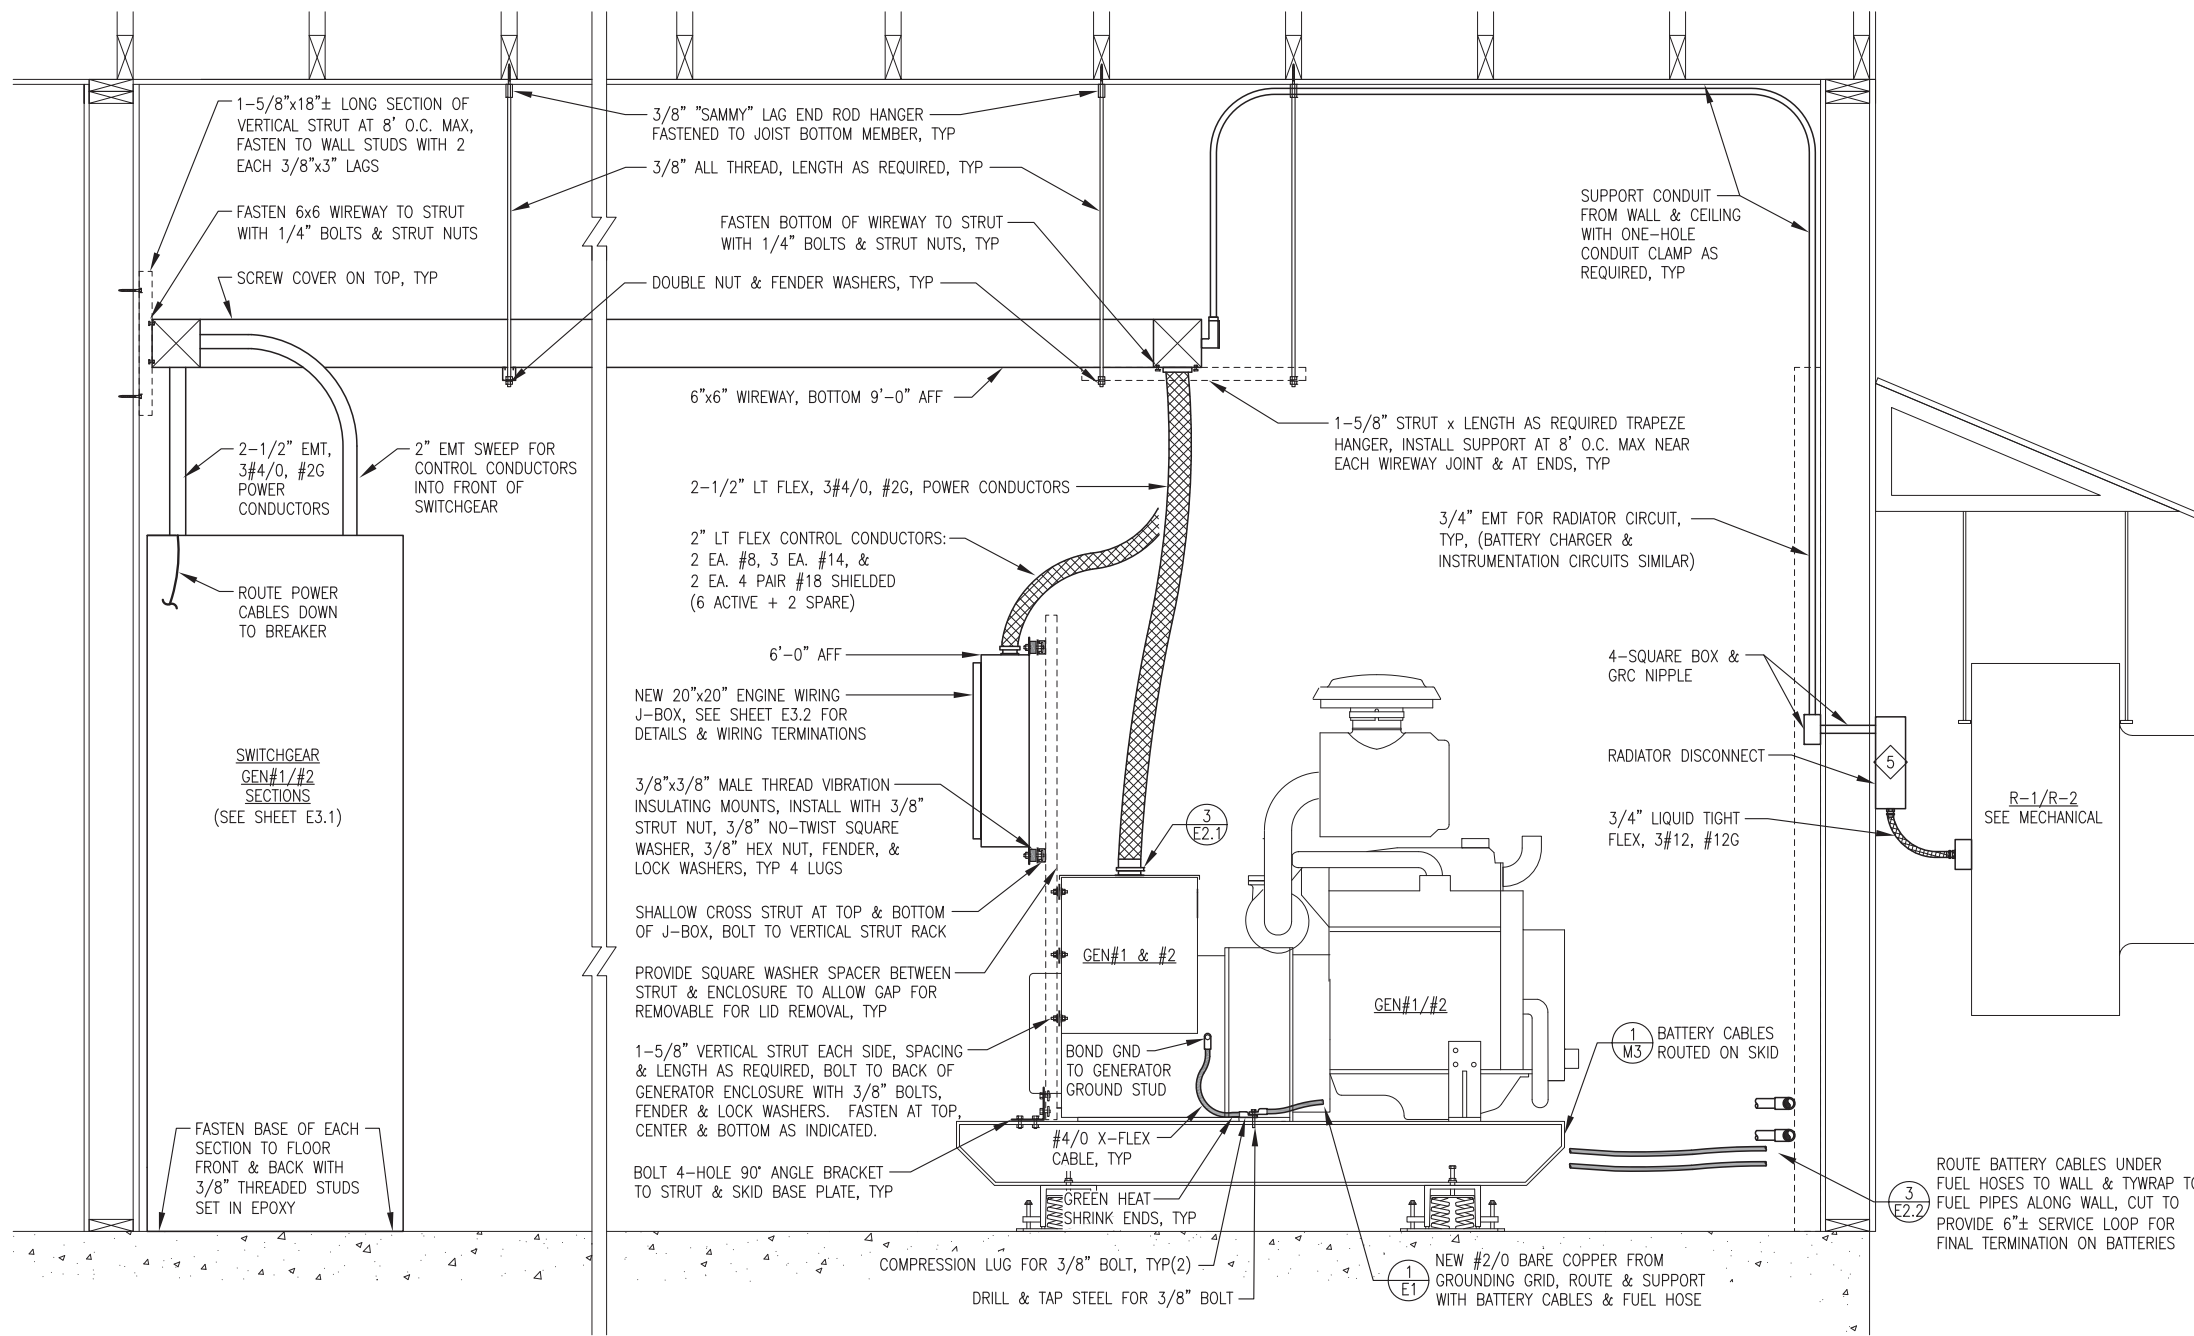

1 TYPICAL GENERATION BAY SECTION
E2.1 1"=1'-0"

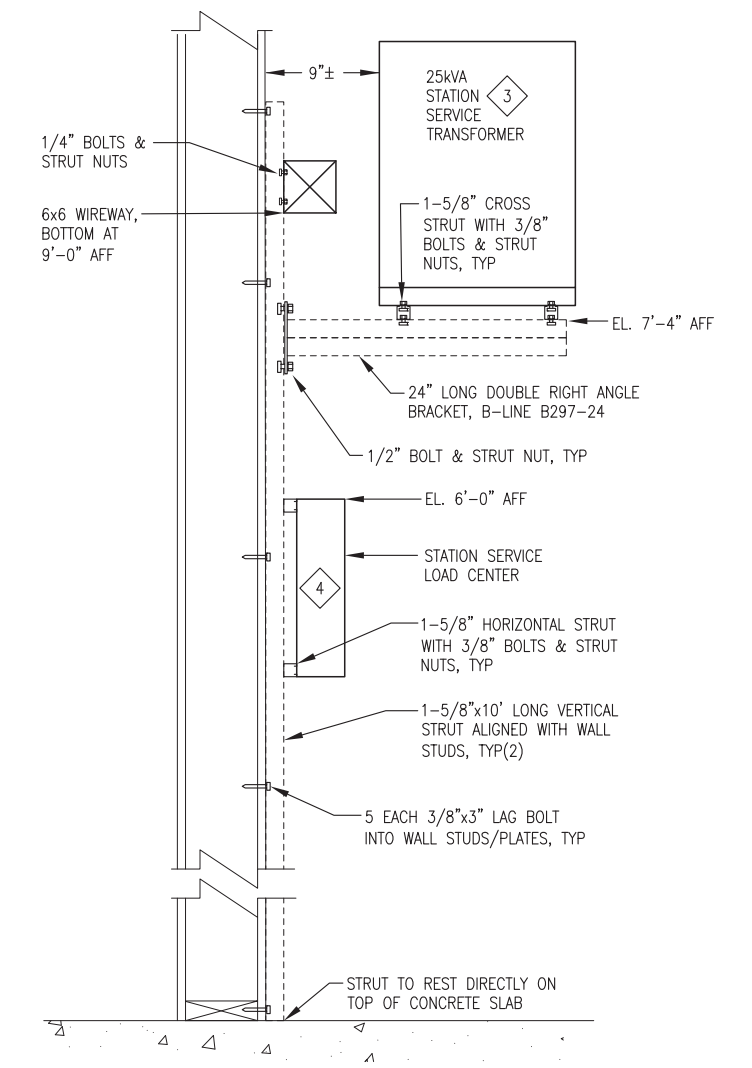

2 STATION SERVICE TRANSFORMER & LOAD CENTER SUPPORT
E2.1 NO SCALE

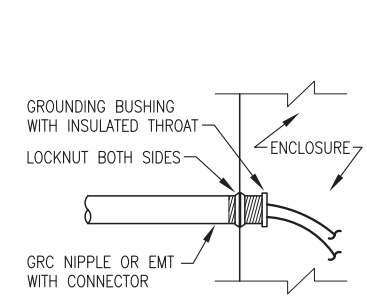


3 TYP ENCLOSURE CONNECTION
E2.1 NO SCALE


- NOTES:**
- 1) THIS DETAIL APPLIES TO CONNECTIONS TO WIREWAY, GENERATOR ENCLOSURES, SWITCHGEAR, AND PANELS.
 - 2) AT A MINIMUM INSTALL GROUNDING BUSHING ON ALL GENERATOR POWER CONDUIT, COMMUNITY FEEDER CONDUIT, STATION SERVICE FEEDERS, AND WHERE OTHERWISE INDICATED OR REQUIRED. BOND GROUNDING BUSHING TO EQUIPMENT GROUNDING CONDUCTOR.
 - 3) INSTALL PLASTIC BUSHING WHERE GROUNDING BUSHING IS NOT REQUIRED.
 - 4) ON GENERATOR ENCLOSURES MAKE ALL CONNECTIONS AS TIGHT AS POSSIBLE.



PROJECT: FFY17-18 DERA PROJECT CIRCLE POWER PLANT UPGRADE		
TITLE: TYPICAL GENERATION BAY SECTION & DETAILS		
DRAWN BY: JTD	SCALE: NO SCALE	DATE: 3/18/20
DESIGNED BY: CWV/BCG	FILE NAME: CIRDERA E1-3	SHEET: E2.1 OF 3
PROJECT NUMBER:		

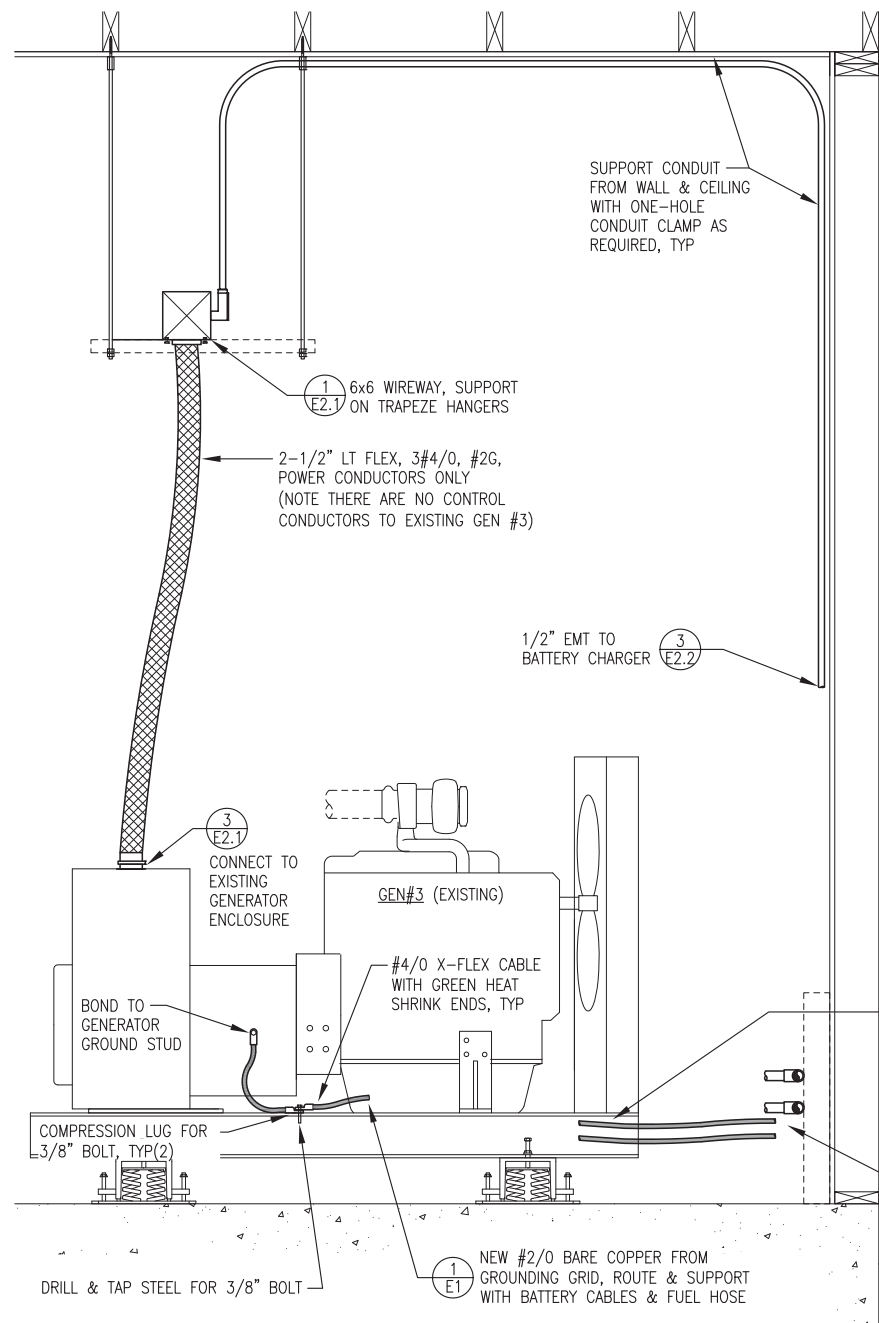

1 GENSET #3 SECTION
E2.2 1"=1'-0"

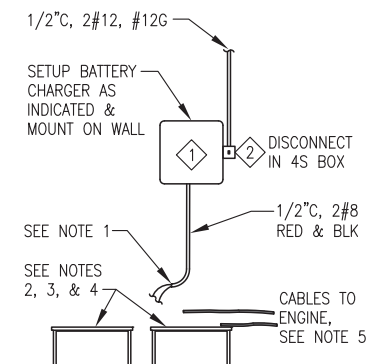


3 BATTERIES, CHARGER, & CABLE INSTALLATION
E2.2 NO SCALE

BATTERY INSTALLATION NOTES:


- INSTALL BUSHING IN END OF EMT & ROUTE 2#8 CHARGING LEADS TO BATTERY.
- GENSETS #1 & #2 (24V): PROVIDE TWO EACH MINIMUM 800 COLD CRANK AMP 12-VOLT STARTING BATTERIES FOR EACH GENERATOR. BATTERIES SHALL BE SEALED MAINTENANCE FREE, OPTIMA RED TOP NAPA PART# BAT N993478RED OR APPROVED EQUAL. PLACE BATTERIES OUT OF TRAFFIC AREA IN CONVENIENT LOCATION NEAR BACK WALL.
- GENSET #3 (12V): IDENTICAL TO GENSETS #1 & #2 EXCEPT ONLY ONE BATTERY FOR EXISTING 12V ENGINE.
- INSTALL EACH BATTERY IN A RACK SIZED TO SECURELY HOLD THE BATTERY.
- X-FLEX BATTERY CABLES TO GENSET, SEE INSTALLATION SECTIONS FOR SIZE, ROUTING, AND SUPPORT.

BATTERY CHARGER SETUP NOTES:


- MAKE THE FOLLOWING SETTINGS PRIOR TO ENERGIZING:
- AC LINE VOLTAGE SWITCH TO "115V".
 - AUTO BOOST JUMPER TO "NORM".
 - FLOAT VOLTAGE JUMPER TO "13.50/27.00" (FOR GEL CELL).
 - BATTERY RANGE JUMPER TO "24V" (FOR GENSETS #1 & #2).
 - BATTERY RANGE JUMPER TO "12V" (FOR GENSET #3).

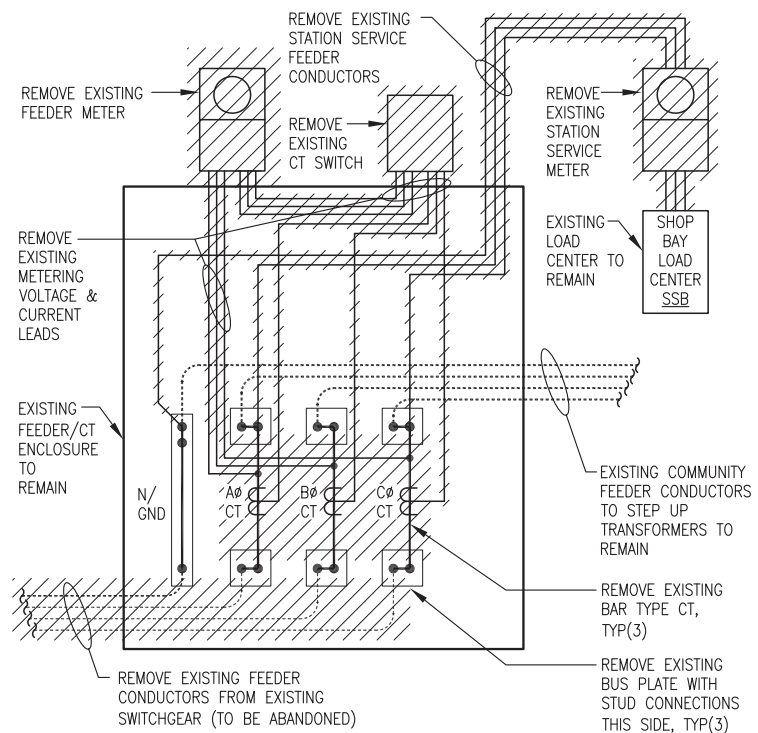

2 EXISTING FEEDER/CT ENCLOSURE 3-LINE MODIFICATION SCHEMATIC
E2.2 NO SCALE

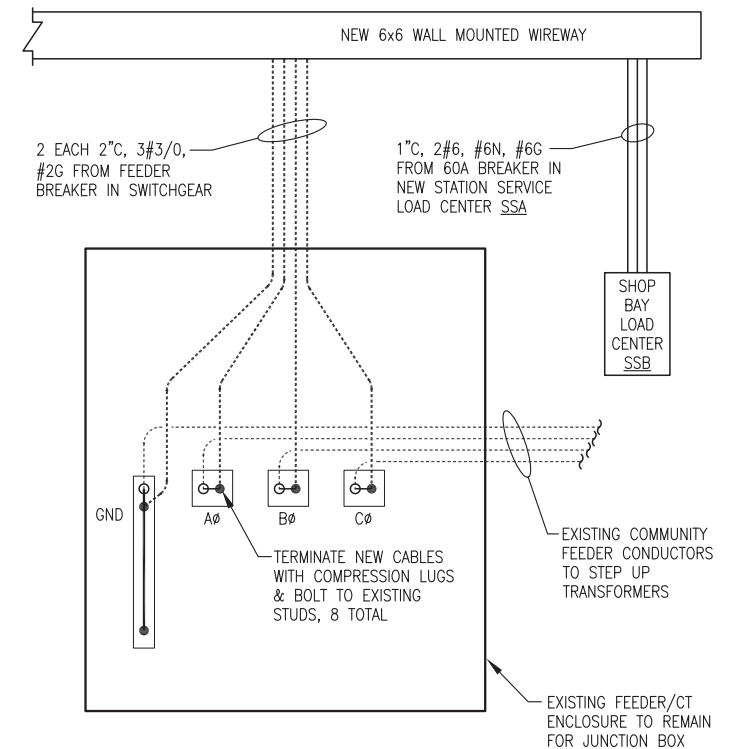

NEW WORK SCHEMATIC

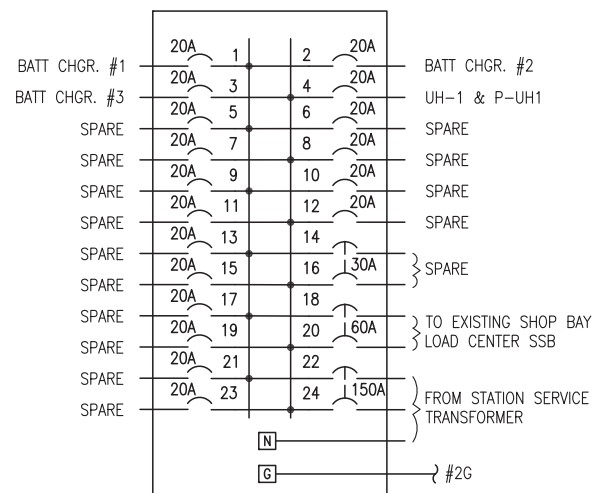



4 NEW LOAD CENTER "SSA"
E2.2 NO SCALE

ISSUED FOR CONSTRUCTION
FEB 2020



PROJECT:	FFY17-18 DERA PROJECT CIRCLE POWER PLANT UPGRADE		
TITLE:	DETAILS & GENSET #3 SECTION		
DRAWN BY: JTD	SCALE: NO SCALE	DESIGNED BY: CWV/BCG	DATE: 3/18/20
FILE NAME: CIRDERA E1-3	SHEET: E2.2	PROJECT NUMBER:	OF 3

Gray Stassel Engineering, Inc.
P.O. 111405, Anchorage, AK 99511 (907)349-0100

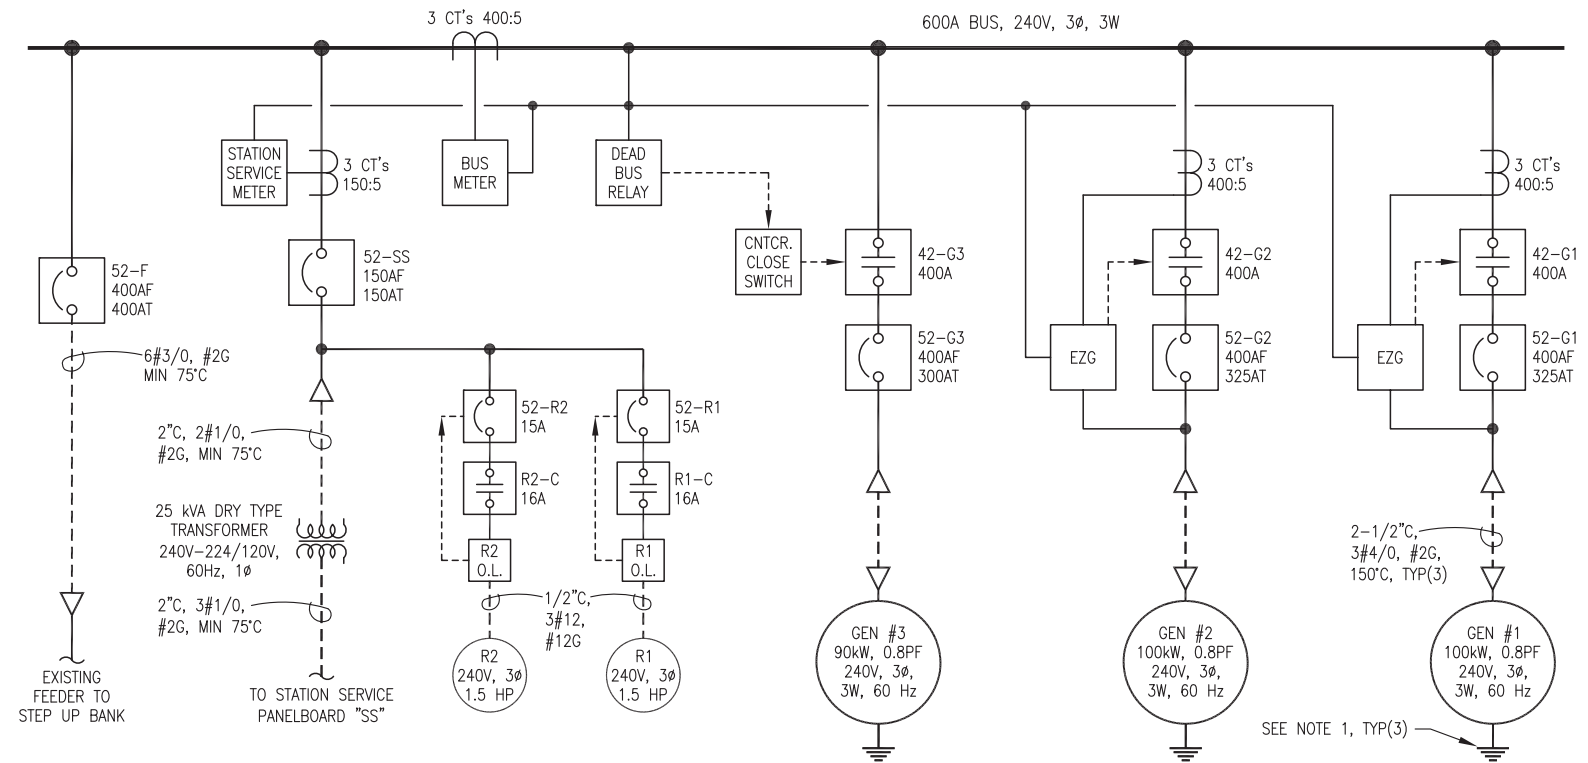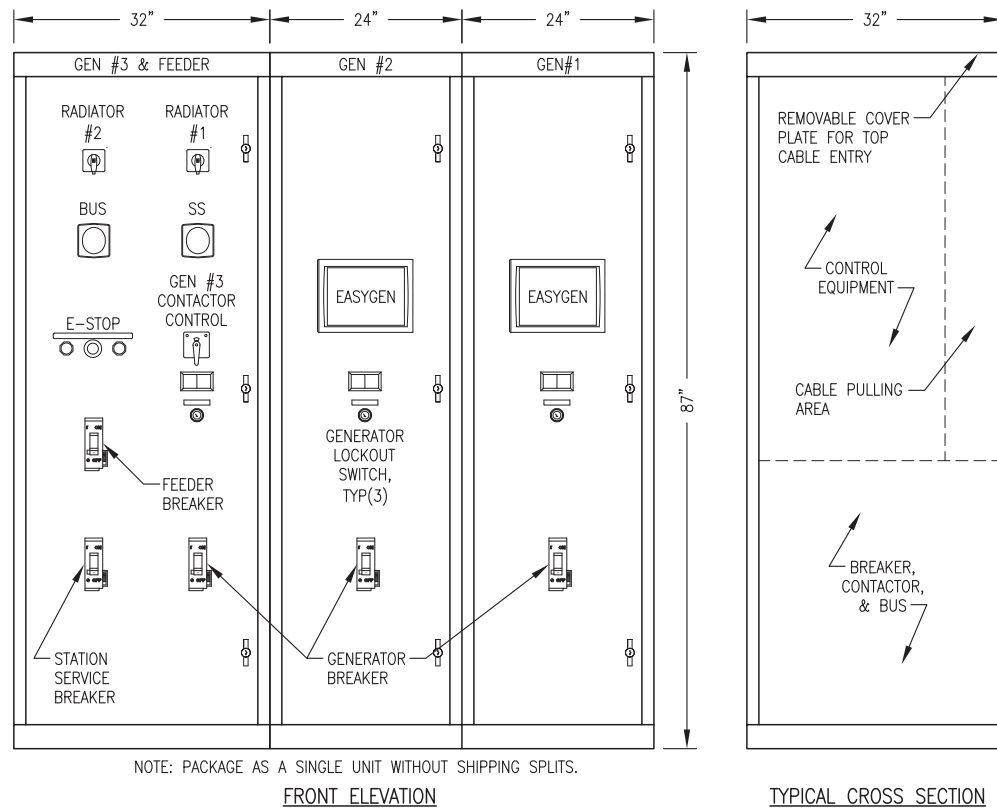

NOTES:

- CONNECT EACH GENERATOR 3 PHASE 240V DELTA. INDEPENDENTLY GROUND EACH GENERATOR FRAME TO SWITCHGEAR GROUND BUS & PROVIDE SECOND GROUND DIRECTLY TO GROUND GRID.
- ALL GENERATOR POWER CONDUCTORS 150°C CABLE. TERMINATE WITH COPPER COMPRESSION LUGS RATED FOR THE FULL AMPACITY OF THE CABLE AT RATED TEMPERATURE. ALL FEEDER AND STATION SERVICE CONDUCTORS MINIMUM 75°C.

1 SWITCHGEAR ENCLOSURE LAYOUT
E3.1 NO SCALE




2 SWITCHGEAR ONE-LINE DIAGRAM
E3.1 NO SCALE

RADIATOR R1 SETTINGS:


175F = ON
165F = OFF
AFTER SELECTING VALUES INSTALL JUMPER FOR RESTRICTED MODE

RADIATOR R2 SETTINGS:

180F = ON
170F = OFF

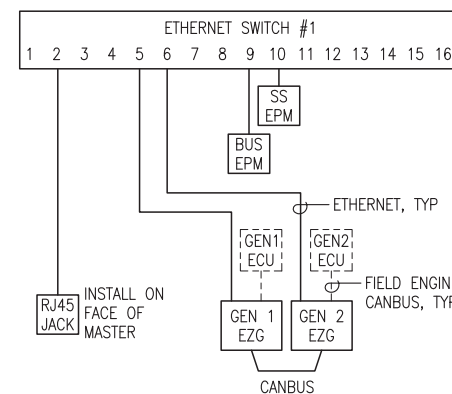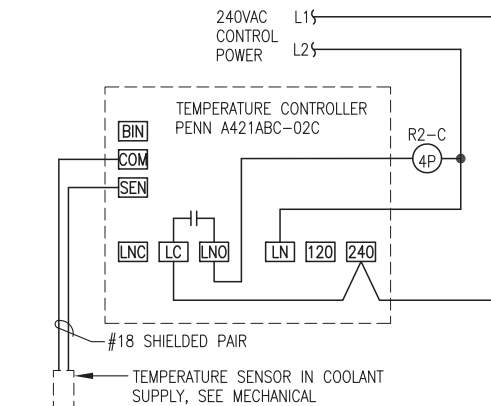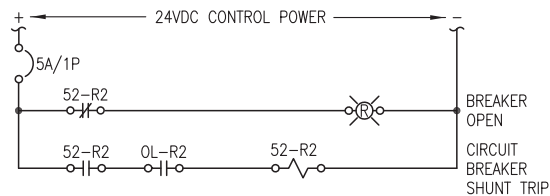

SWITCHGEAR SYMBOL LEGEND

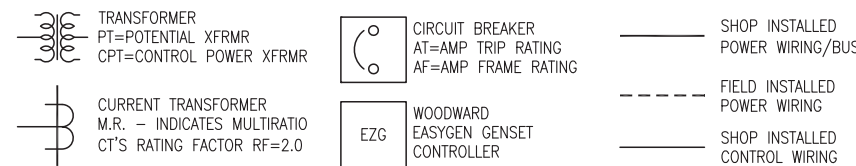

ELECTRICAL CONDUCTOR SCHEDULE

SERVICE/FUNCTION	DESCRIPTION	MANUFACTURER/MODEL	NOTES:	COLOR CODING - UNLESS SPECIFICALLY INDICATED OTHERWISE COLOR CODE CONDUCTORS AS FOLLOWS: 120/240 VOLT POWER CONDUCTORS PHASE A - BLACK PHASE B - RED PHASE C - BLUE NEUTRAL - WHITE 24 VOLT DC CONDUCTORS +24VDC - RED -24VDC - BLACK CONTROL & INSTRUMENT CONDUCTORS COLOR CODED PER MANUFACTURER'S STANDARD
GENERATOR LEADS & FEEDERS (480V) & ENGINE STARTER CABLES (24VDC)	HIGH TEMPERATURE, EXTRA FLEXIBLE CABLE, TIN COATED COPPER CONDUCTOR. THERMOSET EPDM INSULATION, UL 3340/3374, MINIMUM 600V, LISTED 150°C FOR NON-FLEXING	COBRA CABLE, BELDEN, OR OMNI	TERMINATE WITH COPPER COMPRESSION LUGS RATED FOR THE FULL AMPACITY OF THE CABLE AT 150°C.	
GENERAL USE CONDUCTORS	CLASS B CONCENTRIC STRANDED, SOFT DRAWN COPPER, TYPE XHHW INSULATION, 600V AND 75C RATED.			
SHIELDED/TWISTED INSTRUMENT & CONTROL & CANBUS CONDUCTORS	#18 AWG STRANDED TINNED COPPER CONDUCTORS, 600V POLYETHYLENE INSULATION, 100% COVERAGE ALUMINUM FOIL-POLYESTER TAPE SHIELD WITH STRANDED TINNED COPPER DRAIN WIRE & PVC OUTER JACKET	BELDEN PART #'S SINGLE PAIR: #1120A FOUR PAIR: #1049A SINGLE TRIAD: #1121A	GROUND SHIELD DRAIN WIRE AT PANEL END ONLY.	

NOTES:

- FOR NO. 6 AWG AND SMALLER CONDUCTORS COLOR CODING SHALL BE PROVIDED BY USING CONDUCTORS WITH CONTINUOUS COLOR EMBEDDED IN THE INSULATION. FOR ALL CONDUCTORS LARGER THAN NO. 6 SCOTCH 35 MARKING TAPE OR EQUIVALENT MAY BE USED TO COLOR CODE THE CABLE. WHERE MARKING TAPE IS USED THE CABLE SHALL BE IDENTIFIED AT EVERY ACCESSIBLE LOCATION. PROVIDE A MINIMUM OF 2 INCHES OF TAPE AT EACH LOCATION.
- GROUNDING - PROVIDE A SEPARATE EQUIPMENT GROUNDING CONDUCTOR IN EACH RACEWAY. DO NOT USE THE CONDUIT AS AN EQUIPMENT GROUNDING CONDUCTOR. EQUIPMENT GROUNDING CONDUCTORS SHALL BE OF THE SAME TYPE AS THE PHASE CONDUCTORS AND SHALL BE SIZED AS INDICATED ON THE DRAWINGS. CONDUCTORS NOT INDICATED SHALL BE SIZED IN ACCORDANCE WITH THE NATIONAL ELECTRICAL CODE.

3 TYPICAL RADIATOR CONTROL LOGIC DIAGRAM
E3.1 NO SCALE


4 COMMUNICATION SCHEMATIC
E3.1 NO SCALE

ISSUED FOR CONSTRUCTION
FEB 2020




PROJECT:	FFY17-18 DERA PROJECT CIRLE POWER PLANT UPGRADE		
TITLE:	SWITCHGEAR LAYOUT, ONE-LINE, SCHEMATICS, & CONDUCTOR SCHEDULE		
DRAWN BY:	JTD	SCALE:	NO SCALE
DESIGNED BY:	CWV/BCG	DATE:	3/18/20
FILE NAME:	CIRDERA E1-3	SHEET:	E3.1 OF 3
PROJECT NUMBER:			



Gray Stassel Engineering, Inc.
P.O. 111405, Anchorage, AK 99511 (907)349-0100

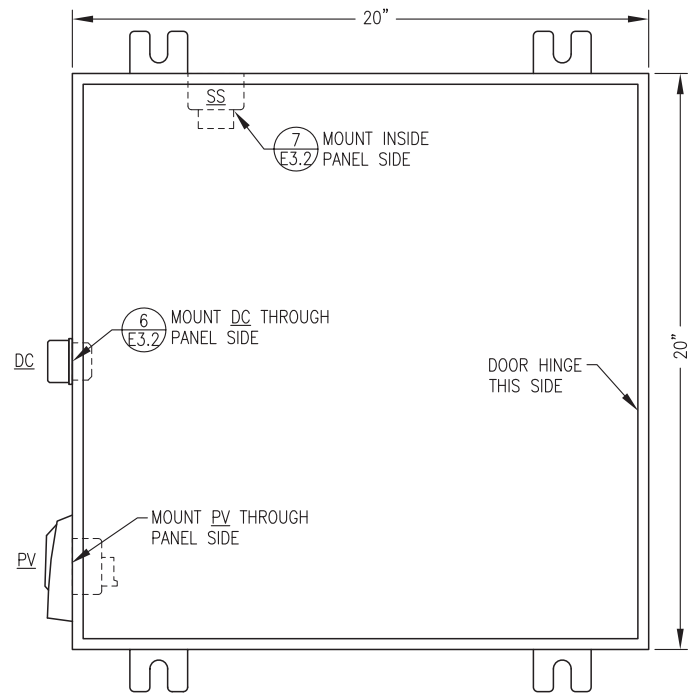

1 JUNCTION BOX FRONT PANEL LAYOUT
E3.2 NO SCALE

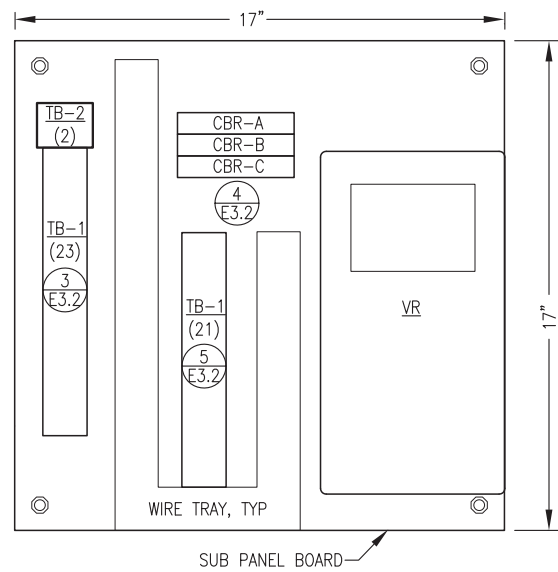


2 JUNCTION BOX SUB PANEL LAYOUT
E3.2 NO SCALE

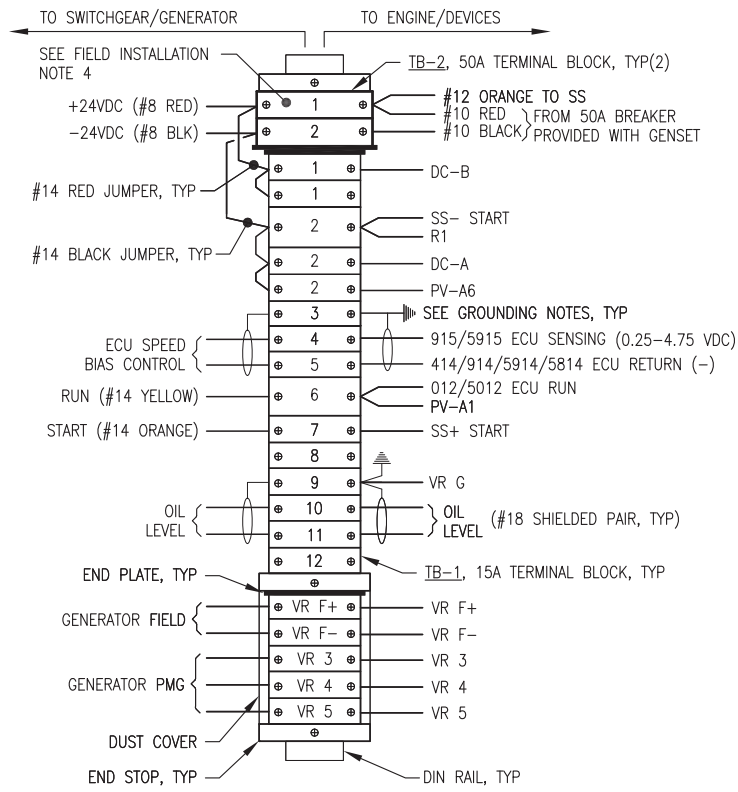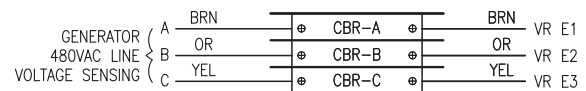

3 TERMINAL STRIP CONNECTIONS
E3.2 NO SCALE

NOTE: TYPICAL JOHN DEERE ECU CONNECTION NUMBERS SHOWN. SEE WIRING HARNESS FOR EACH ENGINE FOR ACTUAL ECU CONNECTIONS.

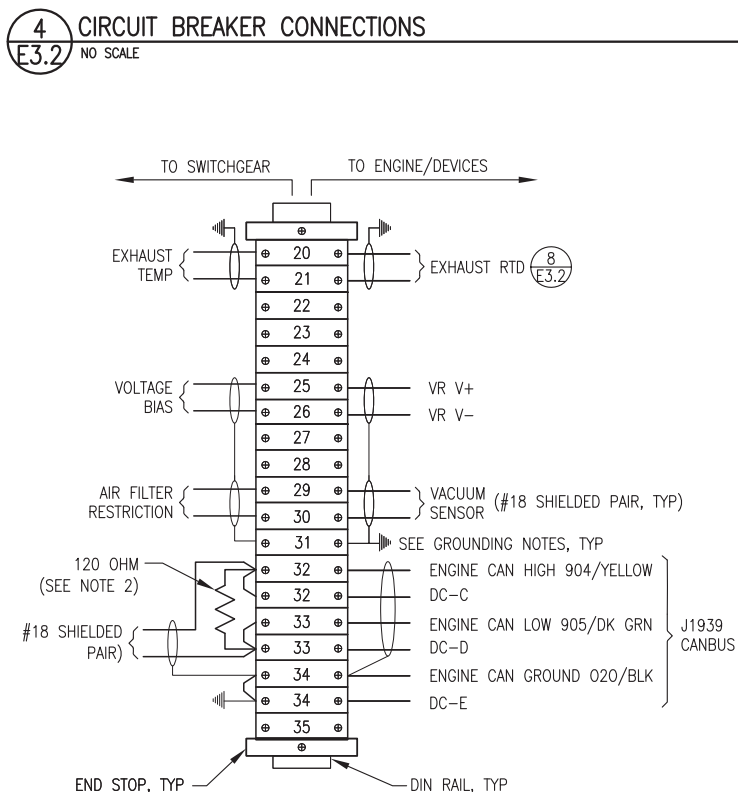

4 CIRCUIT BREAKER CONNECTIONS
E3.2 NO SCALE

NOTES: 1) ALL RESISTORS 0.25W.
2) REMOVE RESISTOR IF ENGINE WIRING HARNESS HAS 120 OHM END OF LINE RESISTOR.

TAG	MANUFACTURER	MODEL	DESCRIPTION
ENCL.	HOFFMAN	A20H20ALP	20x20x8" NEMA 12 BACK PANEL
VR	HOFFMAN	A20P20	DIGITAL VOLTAGE REGULATOR
CBR	BASLER	DECS-150 5NS1V1N1S	RAIL MOUNT CIRCUIT BREAKER, 1-POLE, 1A
DC	ALLEN-BRADLEY	1489-M1-C010	DIAGNOSTIC CONNECTOR, 9-PIN, CAN-BUS
	JOHN DEERE	57M7919	CONNECTOR STRAIN RELIEF
	DEUTSCH	HD18-009	CONNECTOR PROTECTIVE DUST CAP
	DEUTSCH	HDC16-9	CONNECTOR GASKET
	DEUTSCH	HD10-9-GKT	CONNECTOR LANYARD
	DEUTSCH	JDL062397	CONNECTOR GASKET
PV	MURPHY	PV101-C-MSTD	POWER VIEW W/HARNESS
SS	CATERPILLAR	9X-8124	STARTER AUXILIARY SOLENOID, 24V
TB-1	IDEC	BNH15LW	15A DIN RAIL-MOUNT TERMINAL BLOCK
TB-2	IDEC	BNH50W	50A DIN RAIL-MOUNT TERMINAL BLOCK


NOTE: SPECIFIC PARTS MANUFACTURER AND MODEL SELECTED NOT ONLY TO MEET PERFORMANCE FUNCTION BUT ALSO TO COORDINATE AND INTERFACE WITH OTHER DEVICES AND SYSTEMS. APPROVED EQUAL SUBSTITUTIONS WILL BE ALLOWED ONLY BY ENGINEER'S APPROVAL. TO OBTAIN APPROVAL, SUBMITTALS MUST CLEARLY DEMONSTRATE HOW SUBSTITUTE ITEM MEETS OR EXCEEDS SPECIFIED ITEM QUALITY AND PERFORMANCE CHARACTERISTICS AND ALSO COMPLIES WITH MECHANICAL AND/OR ELECTRICAL CONNECTIONS AND PHYSICAL LAYOUT REQUIREMENTS.

SHOP FABRICATION NOTES:


- 1) PROVIDE ASSEMBLY WITH ALL DEVICES AND WIRING INDICATED.
- 2) INSTALL IN A NEMA 12 ENCLOSURE WITH MOUNTING FLANGES AT BACK, A MIN 14 GAUGE INTERIOR BACK PANEL AND HINGED LOCKABLE DOOR. SIZE AS INDICATED.
- 3) PROVIDE DIN RAIL, TERMINAL END PLATES, TERMINAL END STOPS, TERMINAL DUST COVERS AND OTHER MISCELLANEOUS HARDWARE AS REQUIRED TO MATCH TERMINALS. LABEL ALL TERMINALS EXACTLY AS INDICATED ON THE DETAILS.
- 4) ALL WIRE #14AWG EXCEPT WHERE SPECIFICALLY INDICATED OTHERWISE. LABEL BOTH ENDS OF ALL JUMPERS WITH THE ENGINE PANEL TERMINAL NUMBER.
- 5) PROVIDE MECHANICAL GROUND LUGS FASTENED TO BACK PANEL AND GROUNDED TO ENGINE-GENERATOR. GROUND ALL SHIELD DRAIN WIRES TO LUGS AT PANEL END ONLY.
- 6) PROVIDE WIRING HARNESSES FOR CONNECTION TO GENERATOR AND TO ENGINE. INSTALL WIRES IN LIQUID TIGHT FLEX OR FLEXIBLE PLASTIC WIRE LOOM AND PROVIDE SERVICE LOOPS IN ACCORDANCE WITH SPECIFICATIONS.
- 7) SHOP TEST EACH ENGINE-GENERATOR WITH ASSOCIATED JUNCTION BOX PERMANENTLY CONNECTED. UPON COMPLETION OF TESTING, COIL WIRING HARNESSES AND SECURE JUNCTION BOX TO GENERATOR FOR SHIPPING.

FIELD INSTALLATION NOTES:


- 1) PERFORM ALL FIELD WIRING IN ACCORDANCE WITH SPECIFICATIONS. LABEL BOTH ENDS OF ALL FIELD WIRING WITH THE ENGINE PANEL TERMINAL NUMBER.
- 2) ON SHIELDED CONDUCTORS GROUND ALL SHIELD DRAIN WIRES TO LUGS AT PANEL END ONLY.
- 3) FIELD CONDUCTORS FROM GENERATOR TO SWITCHGEAR ARE EXISTING. USE EXISTING UNUSED SHIELDED TRIADS TO SERVE AS SHIELDED PAIRS AND PULL ADDITIONAL #18 SHIELDED PAIRS AS REQUIRED. FOR ALL UNUSED CONDUCTORS COIL, TAPE ENDS, & LEAVE IN PLACE.
- 4) RELABEL ALL TERMINALS IN SWITCHGEAR TO MATCH NEW J-BOX TERMINAL NUMBERS

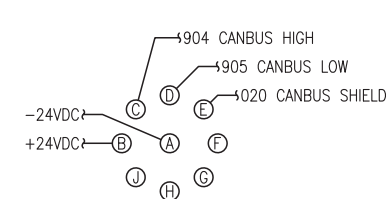

6 DIAGNOSTIC CONNECTOR WIRING
E3.2 NO SCALE

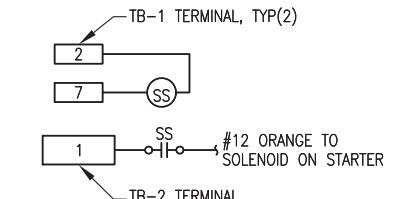

7 STARTER AUX SOLENOID SS WIRING
E3.2 NO SCALE

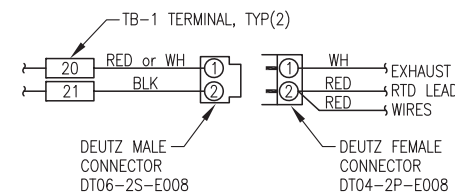

8 EXHAUST RTD CONNECTOR
E3.2 NO SCALE

ISSUED FOR CONSTRUCTION
FEB 2020



PROJECT:	FFY17-18 DERA PROJECT CIRCLE POWER PLANT UPGRADE		
TITLE:	GENSET #1 & #2 24V ENGINE WIRING JUNCTION BOX		
DRAWN BY:	JTD	SCALE:	NO SCALE
DESIGNED BY:	CWV/BCG	DATE:	3/18/20
FILE NAME:	CIRDERA E1-3	SHEET:	E3.2 OF 3
PROJECT NUMBER:	P.O. 111405, Anchorage, AK 99511 (907)349-0100		

PROJECT DESCRIPTION

1. THE EXISTING TAKOTNA POWER PLANT WAS ORIGINALLY CONSTRUCTED IN 2006. SEVERAL MODIFICATIONS HAVE BEEN MADE SINCE ORIGINAL CONSTRUCTION. THE PLANT PRESENTLY HAS MULTIPLE MECHANICAL AND ELECTRICAL DEFICIENCIES REQUIRING UPGRADES TO PROVIDE RELIABLE PRIME POWER SERVICE FOR THE COMMUNITY.
2. THE PRIMARY PURPOSE OF THIS PROJECT IS TO INSTALL TWO NEW TIER 3 MARINE DIESEL ENGINE-GENERATOR SETS (GENSETS) AND TO RESTORE FULL MANUAL AND AUTOMATIC PARALLELING CONTROL OF THE NEW AND THE EXISTING GENSETS.


3. THE SEPARATE ENGINE-GENERATOR DESIGNATED AS "E-GEN" IS CAPABLE OF OPERATING THROUGH THE SWITCHGEAR OR ALTERNATELY THROUGH A MANUAL TRANSFER SWITCH. COORDINATE WITH THE LOCAL UTILITY OPERATORS TO OPERATE ON THE E-GEN AS REQUIRED TO MAINTAIN COMMUNITY POWER WHILE WORKING ON THE SWITCHGEAR AND THE OTHER GENSETS.
4. EXISTING GENSETS #2 AND #4 WILL BE REMOVED AND REPLACED WITH NEW COMPLETE SKID MOUNTED GENSETS.

5. THE EXISTING SWITCHGEAR WILL BE RETROFIT WITH NEW CONTROLS.
6. IN ADDITION, MINOR MODIFICATIONS WILL BE MADE TO THE PLANT MECHANICAL AND ELECTRICAL SYSTEMS AS INDICATED.

SCHEDULE OF DRAWINGS

- M1 PROJECT DESCRIPTION, SCHEDULE OF DRAWINGS, & MECHANICAL WORK PLANS
- M2 GENSET #2 & #4 INSTALLATION DETAILS
- M3 GENSET FABRICATION DETAILS

- E1 ELECTRICAL WORK PLANS & EQUIPMENT SCHEDULE
- E2 ELECTRICAL DETAILS
- E3.1 SWITCHGEAR MODIFICATIONS
- E3.2 24V ENGINE WIRING JUNCTION BOX

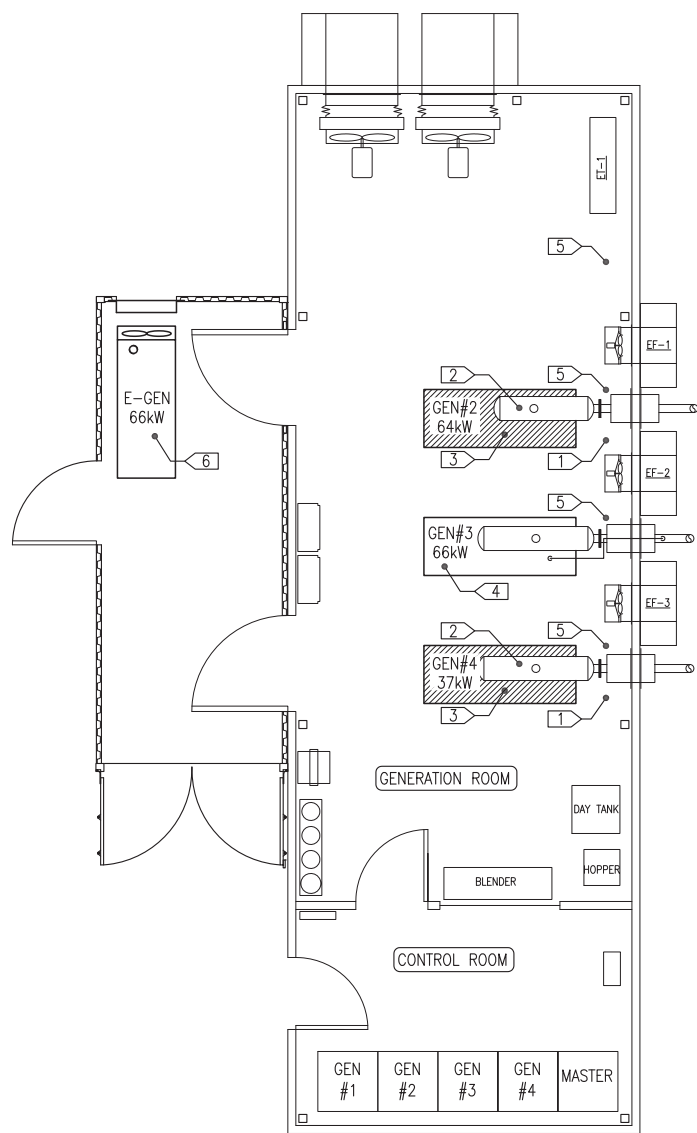


DEMOLITION GENERAL NOTES:

1. EXISTING EQUIPMENT AND PIPING TO BE REMOVED INDICATED BY HATCHING
2. TAKE ALL PRECAUTIONS TO MINIMIZE DAMAGE TO GENERATION EQUIPMENT BEING REMOVED DURING DEMOLITION. TARP GENERATOR ENDS AND SEAL ALL EXPOSED CONNECTIONS PRIOR TO REMOVING FROM PLANT. TURN ALL REMOVED EQUIPMENT OVER TO THE UTILITY FOR FINAL DISPOSITION.
3. GENS #2 AND #4 WERE SCHEDULED TO BE DECOMMISSIONED AND DRAINED OF ALL FLUIDS AS PART OF A PREVIOUS PROJECT. IN ORDER TO COMPLY WITH THE APPROVED DERA WORKPLAN, CONFIRM THAT THE REMOVED GENSET ENGINES HAVE BEEN DRAINED AND ARE RENDERED UNUSABLE (SEE NOTE 4). SAVE ANY REMAINING GLYCOL AND DIESEL FUEL FOR RE-USE IN NEW SYSTEMS. TURN USED OIL OVER TO THE UTILITY FOR FINAL DISPOSITION
4. ENGINE BLOCKS FOR GENSET #2 & #4 MUST BE RENDERED UNUSABLE BY CUTTING A MINIMUM 3"x3" HOLE IN ENGINE BLOCK. PROVIDE PHOTOGRAPHIC DOCUMENTATION OF HOLE & ASSOCIATED ENGINE NAMEPLATE. COMPLETE DERA CERTIFICATE OF ENGINE DESTRUCTION.
5. SEE ELECTRICAL PLANS FOR ADDITIONAL DEMOLITION.

DEMOLITION SPECIFIC NOTES:

- ON GENSET #2 & #4 REMOVE ALL REMAINING HOSES FOR ENGINE COOLANT, FUEL, & OIL.
- ON GENSET #2 & #4 REMOVE FLANGED EXHAUST RISERS FROM ENGINE TO MUFFLER. MUFFLERS AND DISCHARGE EXHAUST PIPING TO REMAIN.
- REMOVE EXISTING GENSET #2 & #4 IN THEIR ENTIRETY. SEE ELECTRICAL FOR ADDITIONAL DEMOLITION NOTES.
- REMOVE CONTROLLER. SEE ELECTRICAL.
- REMOVE RETURN TEMPERATURE SENSOR FROM ENGINE BRANCH PIPING & PLUG OPENING WITH 3/4" THREADED PIPE PLUG.
- E-GEN TO REMAIN AS IS WITHOUT MODIFICATION THIS PROJECT.

1
M1 DEMOLITION PLAN
1/4"=1'-0"

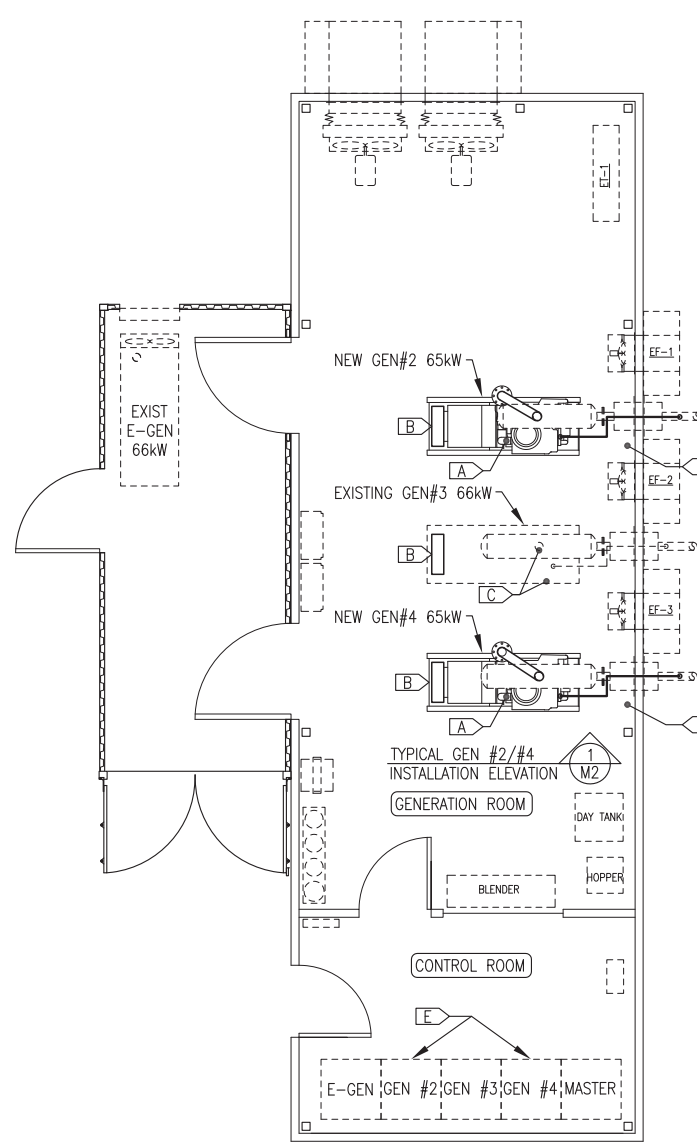

NEW WORK GENERAL NOTES:

1. EXISTING EQUIPMENT AND PIPING TO REMAIN IN SERVICE SHOWN WITH LIGHT DASHED LINES.
2. NEW EQUIPMENT AND PIPING TO BE INSTALLED SHOWN WITH DARK SOLID LINES.

NEW WORK SPECIFIC NOTES:

- A) INSTALL NEW COMPLETE SKID MOUNTED GENSETS #2 & #4 INCLUDING COOLANT, EXHAUST, & CRANK VENT CONNECTIONS. SEE TYPICAL INSTALLATION ELEVATION 1/M2. SEE ELECTRICAL FOR ADDITIONAL DETAIL.
- B) INSTALL NEW ENGINE WIRING JUNCTION BOX, SEE ELECTRICAL.
- C) FURNISH & INSTALL NEW SENSORS ON EXISTING ENGINE IN ACCORDANCE WITH SPECIFICATIONS. WELD 1/4" FPT COUPLING TO EXISTING 4" STEEL EXHAUST PIPE IN ACCESSIBLE LOCATION FOR INSTALLATION OF EXHAUST GAS TEMPERATURE SENSOR. TAP EXISTING AIR INTAKE FOR INSTALLATION OF AIR FILTER VACUUM SENSOR. INSTALL OIL LEVEL SITE GAUGE/SWITCH IN ACCORDANCE WITH DETAIL 3/M3. SEE ELECTRICAL FOR ADDITIONAL DETAIL.
- D) INSTALL NEW BATTERY CHARGER & BATTERIES FOR GENSETS #2 & #4. SEE ELECTRICAL
- E) MODIFY SWITCHGEAR. SEE ELECTRICAL

2
M1 NEW WORK PLAN
1/4"=1'-0"

ISSUED FOR CONSTRUCTION
FEB 2020




PROJECT:	FFY17-18 DERA PROJECT TAKOTNA POWER PLANT UPGRADE		
TITLE:	PROJECT DESCRIPTION, SCHEDULE OF DRAWINGS, & MECHANICAL WORK PLANS		
DRAWN BY:	JTD	SCALE:	AS NOTED
DESIGNED BY:	BCG	DATE:	3/18/20
FILE NAME:	TAKDERA M1-M3	SHEET:	M1 OF 3
PROJECT NUMBER:	P.O. 111405, Anchorage, AK 99511 (907)349-0100		




NOTES:

1. ALL EXISTING PIPING & EQUIPMENT TO REMAIN SHOWN WITH LIGHT DASHED LINES.
2. ALL NEW EQUIPMENT TO BE INSTALLED THIS PROJECT SHOWN WITH DARK SOLID LINES.
3. AFTER INSTALLATION ADJUST SPRING VIBRATION ISOLATOR LEVELING BOLTS TO ACHIEVE A UNIFORM INSTALLATION HEIGHT OF APPROXIMATELY 5-3/4" THEN TIGHTEN LOCKING NUTS. ADJUST NUTS ON STABILIZER BOLTS TO ACHIEVE A UNIFORM CLEARANCE OF APPROXIMATELY 1/8" THEN TIGHTEN LOCKING NUTS. VERIFY UNIT MOVES FREELY ON ISOLATORS.

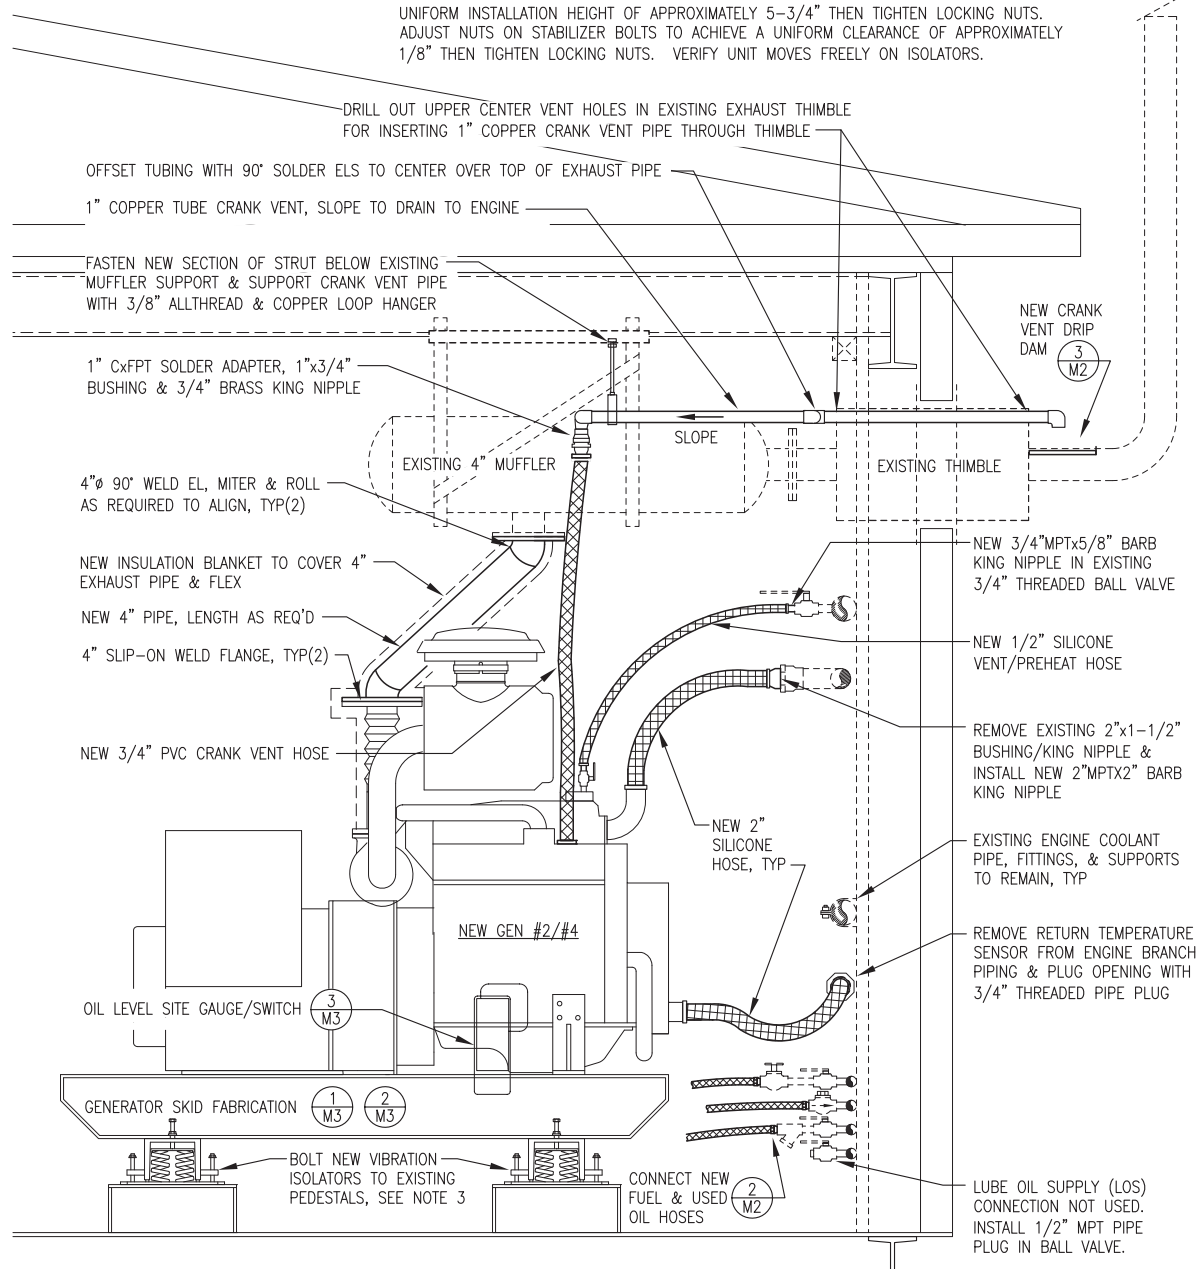


1
M2 GENSET #2 & #4 INSTALLATION ELEVATION
1"=1'-0"

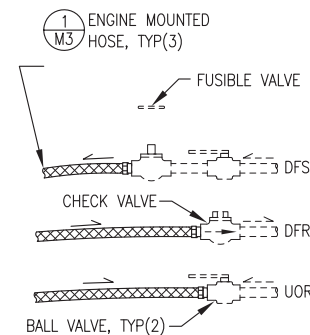

2
M2 GENSET #3 FUEL/USED OIL PIPING CONNECTIONS
NO SCALE

NOTES:

- 1) EXISTING PIPING & VALVES 1/2" THREADED.
- 2) FIELD CUT NEW ENGINE MOUNTED HOSES TO LENGTH & REINSTALL JIC FITTINGS.

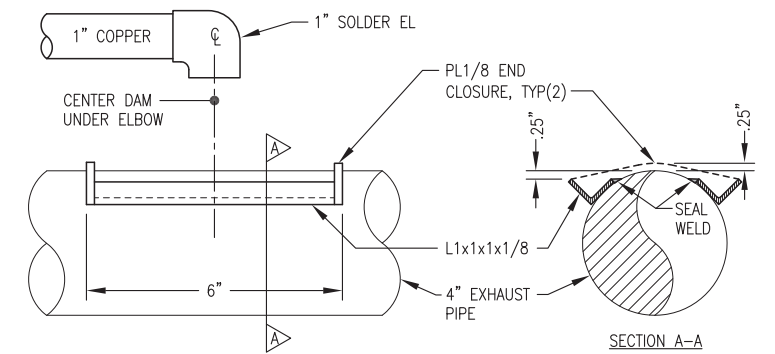

3
M2 CRANKCASE DRIP DAM FABRICATION DETAIL
NO SCALE


ISSUED FOR
CONSTRUCTION
FEB 2020




PROJECT: FFY17-18 DERA PROJECT TAKOTNA POWER PLANT UPGRADE	
TITLE: GENSET #2 & #4 INSTALLATION DETAILS	
DRAWN BY: JTD	SCALE: AS NOTED
DESIGNED BY: BCG	DATE: 3/18/20
FILE NAME: TAKDERA M1-M3	SHEET: M2 OF 3
PROJECT NUMBER: P.O. 111405, Anchorage, AK 99511 (907)349-0100	

MINIMUM HOSE SIZE SCHEDULE		
FUEL SUPPLY	FUEL RETURN	USED OIL
#8	#8	#10


NOTE:
ON 4045'S GROUP HOSES
ON LEFT SKID AS SHOWN
TO COORDINATE WITH
COOLANT HOSES.

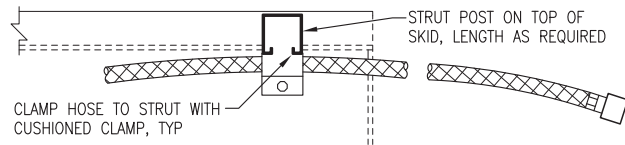

LEFT SKID PLAN (TOP) VIEW

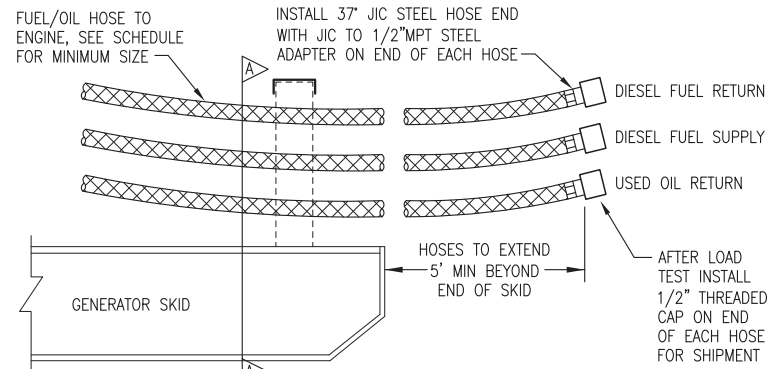


ELEVATION (SIDE) VIEW

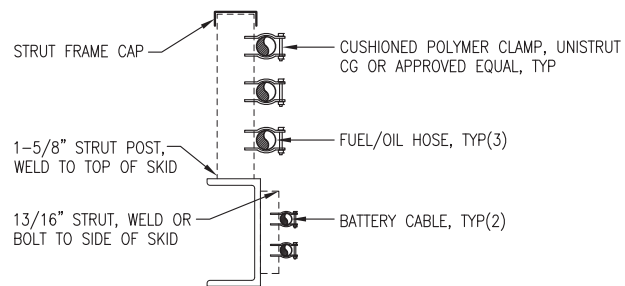


SECTION A-A


1 FUEL/OIL HOSE & BATTERY CABLE INSTALLATION ON SKID
M3 NO SCALE

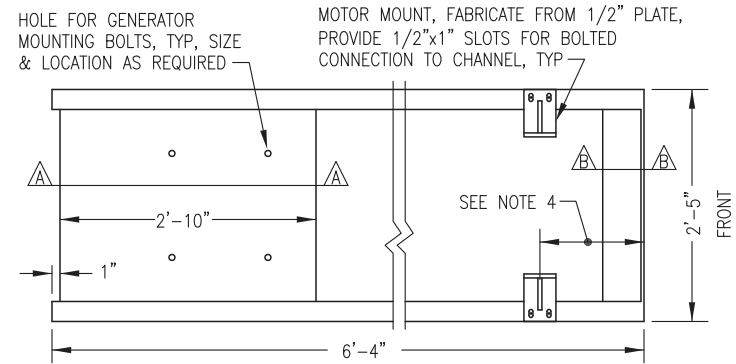


PLAN (TOP) VIEW

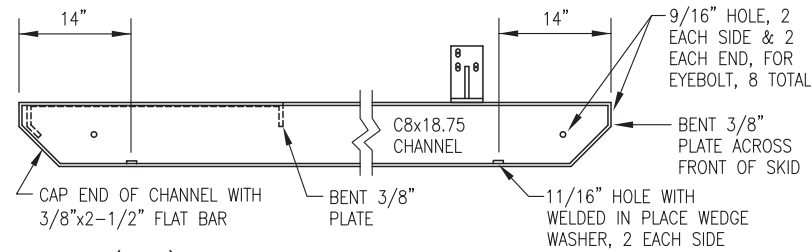

ELEVATION (SIDE) VIEW

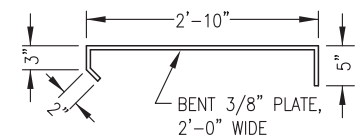

SECTION A-A

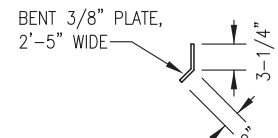


SECTION B-B

NOTES:

- 1) FABRICATE FROM ASTM A-36 STEEL. BEND PLATES & CUT ENDS OF CHANNELS AT 90° & 45° AS SHOWN.
- 2) EXCEPT WHERE INDICATED AS BOLTED MAKE ALL CONNECTIONS WITH CONTINUOUS WELDS (FILLET OR FULL-PENETRATION GROOVE AS REQUIRED) IN ACCORDANCE WITH CURRENT AWS STANDARD CODE.
- 3) ROUND ALL CORNERS & GRIND WELDS SMOOTH AFTER FABRICATION. PAINT TO MATCH ENGINE-GENERATOR.
- 4) PLACE UNIT ON SKID SO THAT THE EXHAUST RISER CENTERLINE IS 3'-3" FROM THE FRONT OF THE SKID.

2 GENSET #2 & #4 (4045) SKID FABRICATION
M3 NO SCALE

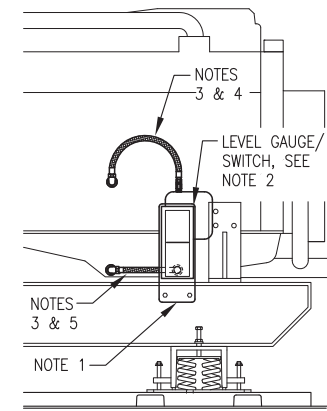

3 TYPICAL OIL LEVEL GAUGE/SWITCH INSTALLATION
M3 NO SCALE

NOTES:

- 1) 1/4" STEEL SUPPORT PLATE PRE-DRILLED TO MATCH GAUGE/SWITCH MOUNTS, CHANNEL SKID HOLES AND BOTTOM HOSE ENTRANCE. BOLT TO INSIDE (BACK) OF CHANNEL SKID AT HEIGHT AS REQUIRED TO CENTER GAUGE AT NORMAL FULL OIL LEVEL. ADJUST SWITCH CONTACTS 1/2" ABOVE & BELOW.
- 2) SEE ENGINE GENERATOR SPECIFICATIONS FOR LEVEL/GUAGE SWITCH. MOUNT TO STEEL SUPPORT PLATE WITH RUBBER SHOCK MOUNTS.
- 3) #8 HOSE WITH 1/2" OR 3/8" NPT JIC SWIVEL ENDS AS REQUIRED.
- 4) CONNECT TOP (VENT) PORT TO ENGINE CRANK CASE WITH HOSE. ROUTE UPPER HOSE TO AVOID LOW POINT TRAPS.
- 5) CONNECT BOTTOM PORT TO ENGINE OIL PAN WITH HOSE. DO NOT TEE INTO OIL DRAIN LINE. ROUTE LOWER HOSE BACK THROUGH PRE-DRILLED HOLE IN STEEL PLATE.

ISSUED FOR
CONSTRUCTION
FEB 2020



PROJECT:	FFY17-18 DERA PROJECT TAKOTNA POWER PLANT UPGRADE	
TITLE:	GENSET FABRICATION DETAILS	
DRAWN BY: JTD	SCALE: AS NOTED	
DESIGNED BY: BCG	DATE: 3/18/20	
FILE NAME: TAKDERA M1-M3	SHEET:	
PROJECT NUMBER:	M3	OF 3

Gray Stassel Engineering, Inc.
P.O. 111405, Anchorage, AK 99511 (907)349-0100

PRIME POWER COORDINATION REQUIREMENTS:

1. THIS PLANT PROVIDES PRIME POWER TO THE COMMUNITY OF TAKOTNA. KEEP OUTAGES TO A MINIMUM AND COORDINATE ALL REQUIRED OUTAGES WITH THE UTILITY.
2. THE ENGINE-GENERATOR DESIGNATED AS "E-GEN" IS OPERATED BY AN ENGINE-MOUNTED CONTROLLER. IT CAN RUN THROUGH THE SWITCHGEAR OR ALTERNATELY THROUGH A MANUAL TRANSFER SWITCH. THERE ARE TWO OPTIONS FOR POWERING THE COMMUNITY WITH THE E-GEN. COORDINATE WITH THE UTILITY TO MAINTAIN COMMUNITY POWER WHILE WORKING ON THE SYSTEM.

OPTION 1:
A TRANSFER SWITCH LOCATED ON THE EXTERIOR OF THE POWER PLANT MAY BE USED TO CONNECT THE E-GEN DIRECTLY TO THE STEP UP TRANSFORMER (GRID). THIS OPTION COMPLETELY ISOLATES THE MODULE FROM THE GRID, RESULTING IN LOSS OF POWER METERING AND STATION SERVICE POWER. THIS OPTION SHOULD BE USED WHEN REQUIRED FOR WORKING ON THE SWITCHGEAR.

OPTION 2:
A MANUAL CONTACTOR OPEN/CLOSE SWITCH IS LOCATED ON THE OLD GEN #1 (E-GEN) SWITCHGEAR SECTION. THIS SWITCH WILL FUNCTION ONLY AGAINST A DEAD BUS AND IS LOCKED OUT IF ANY OTHER GENERATOR IS ON LINE. CONNECTING THE E-GEN TO THE GRID USING THIS SWITCH WILL ENERGIZE THE SWITCHGEAR BUS PROVIDING POWER METERING AND STATION SERVICE POWER. GENSETS AND OTHER EQUIPMENT WILL NEED TO BE LOCKED OUT AND TAGGED OUT.


ELECTRICAL EQUIPMENT/DEVICE SCHEDULE

SYMBOL	SERVICE	DESCRIPTION	MANUFACTURER/MODEL
⬠	BATTERY CHARGER	12/24-VOLT SOLID STATE 20-AMP AUTO-EQUALIZING BATTERY CHARGER FOR 120 VAC INPUT, WITH OPTIONAL HIGH/LOW VOLTAGE, AC POWER FAILURE, & REMOTE SUMMARY ALARM RELAYS	SENS NRG22-20-RCLS OR EQUAL

ELECTRICAL CONDUCTOR SCHEDULE

COLOR CODING - UNLESS SPECIFICALLY INDICATED OTHERWISE COLOR CODE CONDUCTORS AS FOLLOWS:
 480-VOLT POWER CONDUCTORS
 PHASE A - BROWN
 PHASE B - ORANGE
 PHASE C - YELLOW
 NEUTRAL - WHITE WITH YELLOW STRIPE
 120/208-VOLT POWER CONDUCTORS
 PHASE A - BLACK
 PHASE B - RED
 PHASE C - BLUE
 NEUTRAL - WHITE
 24 VOLT DC CONDUCTORS
 +24VDC - RED or RED WITH GRAY STRIPE
 -24VDC - BLACK or BLACK WITH GRAY STRIPE
 CONTROL & INSTRUMENT CONDUCTORS COLOR CODED PER MANUFACTURER'S STANDARD

- NOTES:**
- 1) FOR NO. 6 AWG AND SMALLER CONDUCTORS COLOR CODING SHALL BE PROVIDED BY USING CONDUCTORS WITH CONTINUOUS COLOR EMBEDDED IN THE INSULATION. FOR ALL CONDUCTORS LARGER THAN NO. 6 SCOTCH 35 MARKING TAPE OR EQUIVALENT MAY BE USED TO COLOR CODE THE CABLE. WHERE MARKING TAPE IS USED THE CABLE SHALL BE IDENTIFIED AT EVERY ACCESSIBLE LOCATION. PROVIDE A MINIMUM OF 2 INCHES OF TAPE AT EACH LOCATION.
 - 2) GROUNDING - PROVIDE A SEPARATE EQUIPMENT GROUNDING CONDUCTOR IN EACH RACEWAY. DO NOT USE THE CONDUIT AS AN EQUIPMENT GROUNDING CONDUCTOR. EQUIPMENT GROUNDING CONDUCTORS SHALL BE OF THE SAME TYPE AS THE PHASE CONDUCTORS AND SHALL BE SIZED AS INDICATED ON THE DRAWINGS. CONDUCTORS NOT INDICATED SHALL BE SIZED IN ACCORDANCE WITH THE NATIONAL ELECTRICAL CODE.

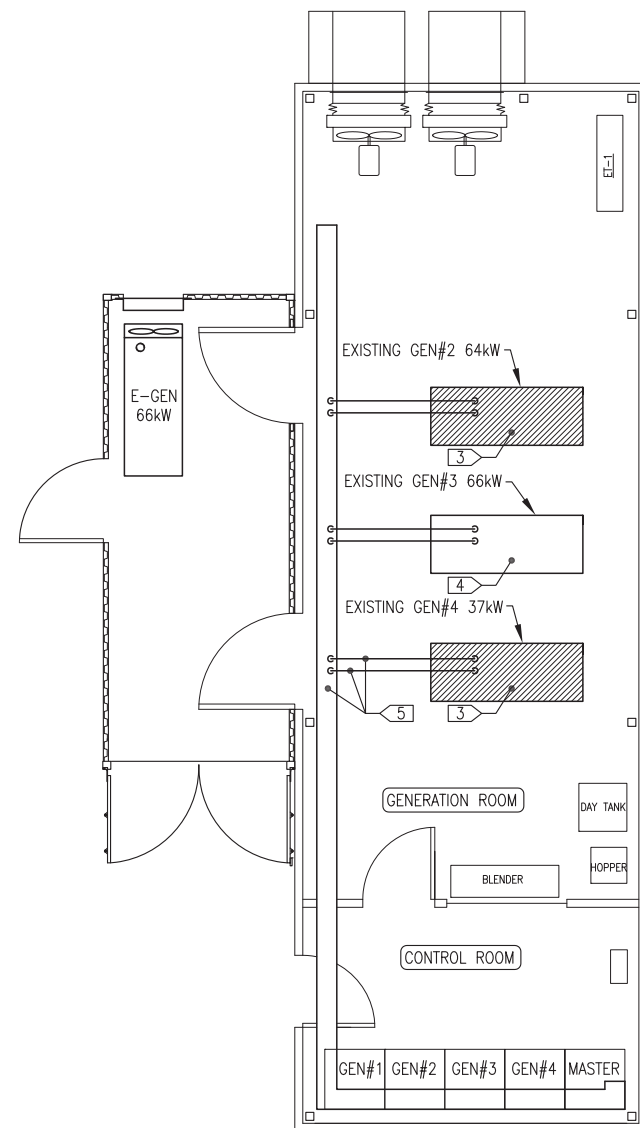


DEMOLITION GENERAL NOTES:

- 1) ALL ITEMS TO REMAIN UNLESS SPECIFICALLY INDICATED FOR REMOVAL.
- 2) ENSURE ALL EQUIPMENT AND CIRCUITS TO BE REMOVED ARE DE-ENERGIZED PRIOR TO BEGINNING DEMOLITION. LOCK AND TAG OUT ALL AFFECTED CIRCUIT BREAKERS AND DISCONNECTS.
- 3) TAKE ALL PRECAUTIONS TO MINIMIZE DAMAGE TO ELECTRICAL EQUIPMENT AND CONDUCTORS BEING SALVAGED FOR REUSE. TURN ALL REMOVED MATERIALS AND EQUIPMENT OVER TO THE UTILITY FOR FINAL DISPOSITION IF NOT REUSED.

DEMOLITION SPECIFIC NOTES:

- 1) SEE MECHANICAL.
- 2) SEE MECHANICAL.
- 3) REMOVE EXISTING GENSET #2 & #4 IN THEIR ENTIRETY. EXISTING POWER & CONTROL CONDUCTORS & ASSOCIATED CONDUIT & FITTINGS TO REMAIN IN SERVICE FOR RECONNECTION TO NEW GENSETS. CAREFULLY SEPARATE EXISTING MUGULS & FITTINGS FROM GENERATOR ENCLOSURES & DISCONNECT ALL CONDUCTORS. COIL CONDUCTORS IN SECURE LOCATION TO PROTECT FROM DAMAGE DURING GENSET REPLACEMENT. SEE TYPICAL GENSET INSTALLATION ELEVATION FOR MODIFICATIONS TO CONTROL CONDUIT & NEW CONNECTIONS TO NEW ENGINE WIRING J-BOXES.
- 4) REMOVE EXISTING ENGINE MOUNTED CONTROLLER & VOLTAGE REGULATOR FROM GENSET #3 IN PREPARATION FOR INSTALLATION OF NEW ENGINE WIRING J-BOX & RECONNECTION OF CONTROL WIRING TO SWITCHGEAR.
- 5) ALL EXISTING GENERATOR WIREWAY, CONDUIT, POWER CONDUCTORS, & CONTROL WIRING TO REMAIN EXCEPT FOR TYPE J THERMOCOUPLE WIRING TO BE REMOVED. SEE SHEET E3.2 FIELD INSTALLATION NOTES.
- 6) E-GEN TO REMAIN AS IS WITHOUT MODIFICATION THIS PROJECT.

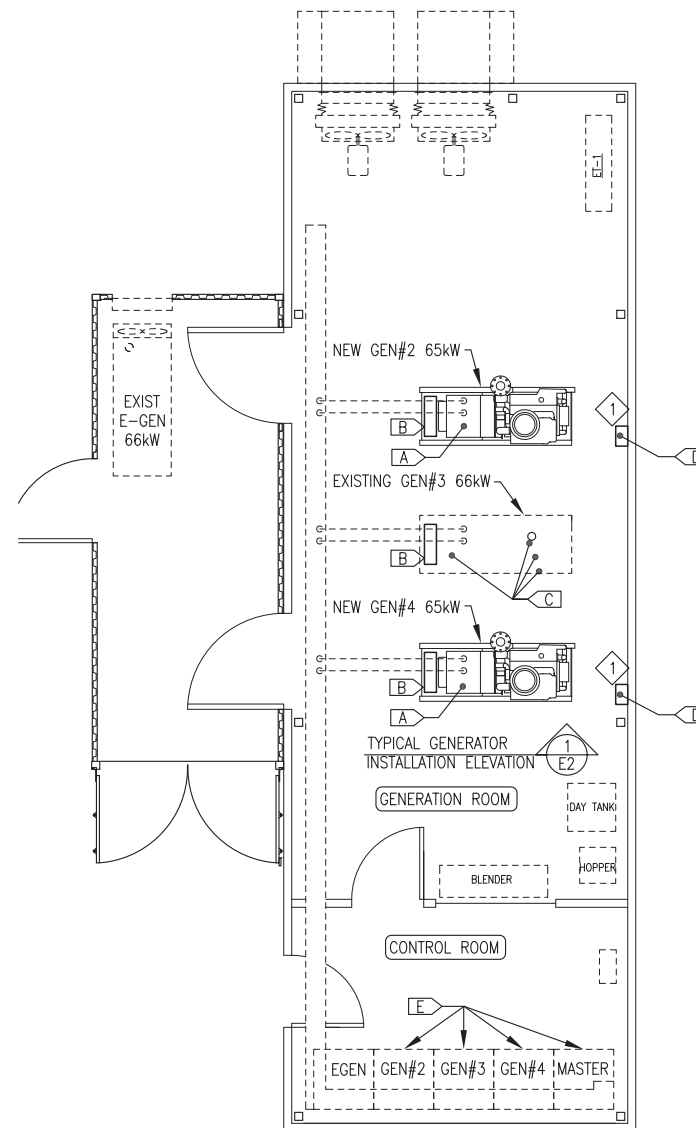

NEW WORK GENERAL NOTES:

1. EXISTING EQUIPMENT TO REMAIN IN SERVICE SHOWN WITH LIGHT DASHED LINES.
2. NEW EQUIPMENT TO BE INSTALLED SHOWN WITH DARK SOLID LINES.
3. RECONNECT EXISTING POWER & CONTROL CONDUCTORS & ASSOCIATED CONDUIT & FITTINGS TO NEW GENSETS AS INDICATED.

NEW WORK SPECIFIC NOTES:

- A) CONNECT EXISTING POWER CONDUCTORS TO NEW GENSET. SEE ELEVATION 1/E2.
- B) INSTALL NEW ENGINE WIRING JUNCTION BOX AND TERMINATE EXISTING CONTROL WIRES AS REQUIRED. REUSE EXISTING CONTROL CONDUCTORS FROM GENERATOR TO SWITCHGEAR. SEE ELEVATION 1/E2 FOR J-BOX INSTALLATION AND SHEET E3.2 FOR WIRING TERMINATION DETAILS.
- C) INSTALL NEW SENSORS ON EXISTING GENSET #3 AS INDICATED BELOW. SEE SPECIFICATIONS & MECHANICAL FOR ADDITIONAL DETAIL. ROUTE #18 SHIELDED PAIR FROM EACH DEVICE TO NEW ENGINE WIRING J-BOX. CONNECT EXISTING GENERATOR CONTROL WIRING SHIELDED PAIRS FROM SWITCHGEAR TO TERMINALS IN J-BOX.
 - EXHAUST GAS TEMPERATURE SENSOR
 - AIR FILTER VACUUM SENSOR
 - OIL LEVEL SITE GAUGE/SWITCH
- D) REMOVE EXISTING 12V BATTERY CHARGER & BATTERY. INSTALL NEW 24V BATTERY CHARGER & TWO NEW BATTERIES. SEE DETAIL 3/E2.
- E) MODIFY SWITCHGEAR FOR AUTOMATIC PARALLELING OPERATION, SEE SHEET E3.1 AND SPECIFICATIONS.

1 DEMOLITION PLAN
E1 1/4"=1'-0"


2 NEW WORK PLAN
E1 1/4"=1'-0"

ISSUED FOR CONSTRUCTION
FEB 2020




PROJECT:	FFY17-18 DERA PROJECT TAKOTNA POWER PLANT UPGRADE		
TITLE:	ELECTRICAL WORK PLANS & SCHEDULES		
DRAWN BY: JTD	SCALE: AS NOTED	DESIGNED BY: CWV/BCG	DATE: 3/18/20
FILE NAME: TAKDERA E1-E3	SHEET: E1	PROJECT NUMBER:	OF 3

Gray Stassel Engineering, Inc.
P.O. 111405, Anchorage, AK 99511 (907)349-0100

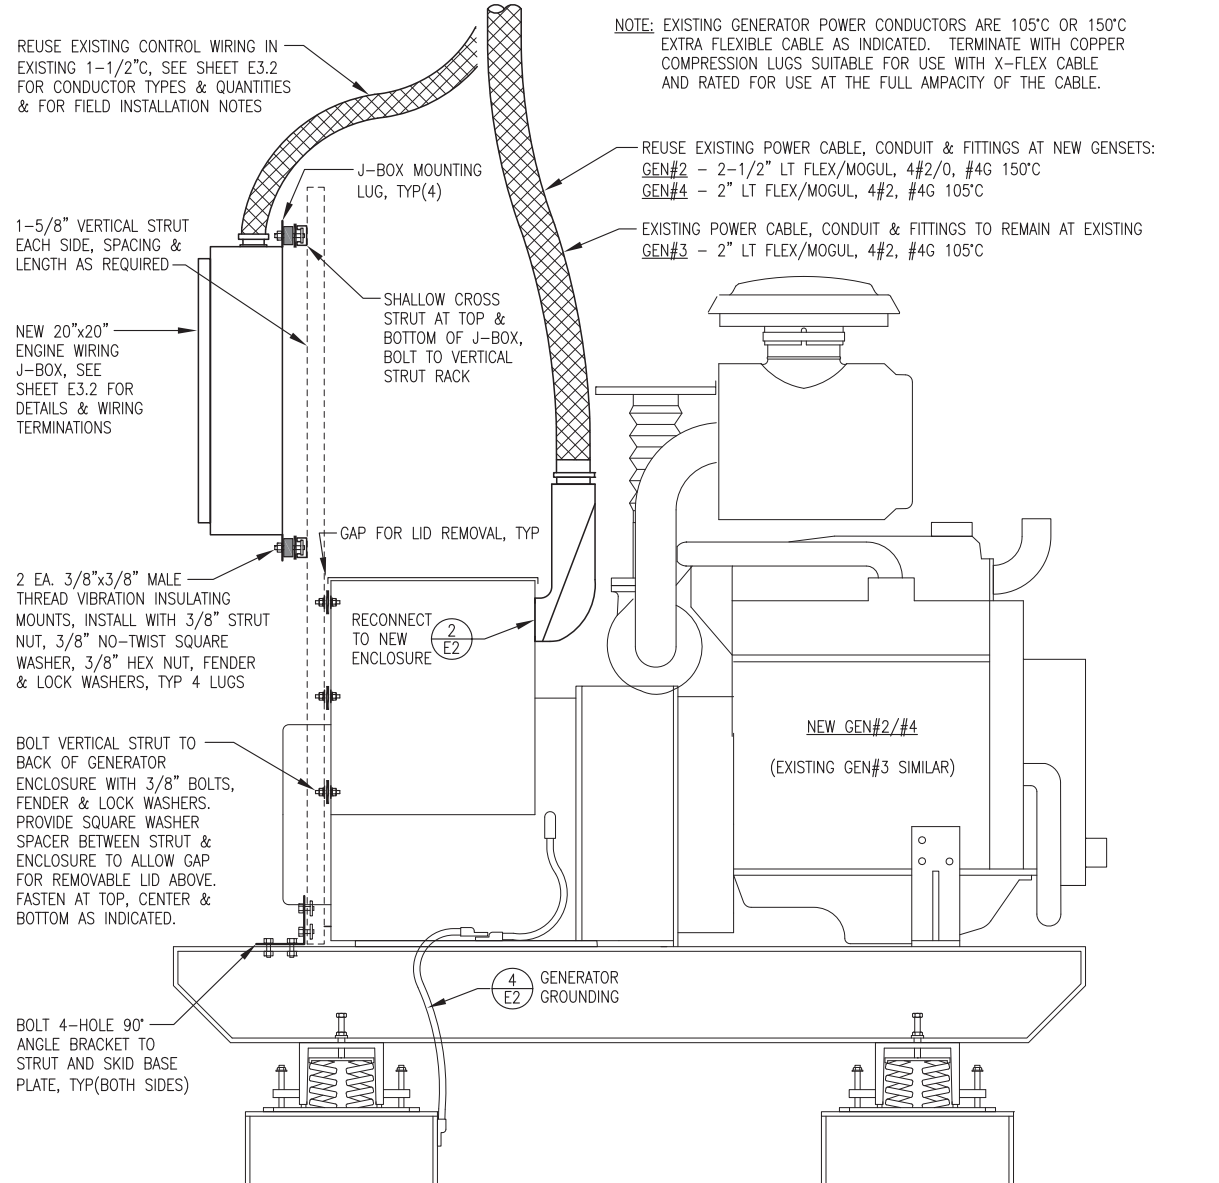


NOTE: EXISTING GENERATOR POWER CONDUCTORS ARE 105°C OR 150°C EXTRA FLEXIBLE CABLE AS INDICATED. TERMINATE WITH COPPER COMPRESSION LUGS SUITABLE FOR USE WITH X-FLEX CABLE AND RATED FOR USE AT THE FULL AMPACITY OF THE CABLE.

- NOTES:**
- 1) THIS DETAIL APPLIES TO CONNECTIONS TO WIREWAY, GENERATOR ENCLOSURES, SWITCHGEAR, AND PANELS.
 - 2) AT A MINIMUM INSTALL GROUNDING BUSHING ON ALL GENERATOR POWER CONDUIT, COMMUNITY FEEDER CONDUIT, STATION SERVICE FEEDERS, AND WHERE OTHERWISE INDICATED OR REQUIRED. BOND GROUNDING BUSHING TO EQUIPMENT GROUNDING CONDUCTOR.
 - 3) INSTALL PLASTIC BUSHING WHERE GROUNDING BUSHING IS NOT REQUIRED.
 - 4) ON GENERATOR ENCLOSURES MAKE ALL CONNECTIONS AS TIGHT AS POSSIBLE.

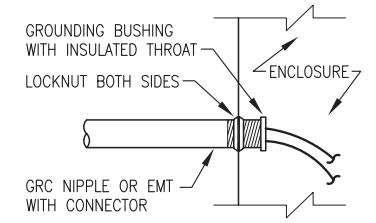


3 TYP ENCLOSURE CONNECTION
E2 NO SCALE

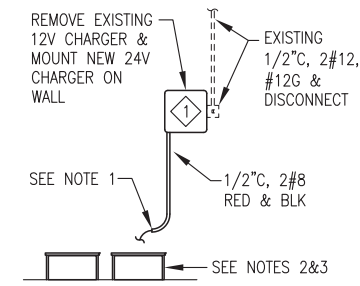

- NOTES:**
1. INSTALL BUSHING IN END OF EMT & ROUTE 2#8 CHARGING LEADS TO BATTERY.
 2. PROVIDE TWO EACH MINIMUM 800 COLD CRANK AMP 12-VOLT STARTING BATTERIES FOR EACH GENERATOR. BATTERIES SHALL BE SEALED MAINTENANCE FREE, OPTIMA RED TOP NAPA PART# BAT N993478RED OR APPROVED EQUAL.
 3. INSTALL EACH BATTERY IN A RACK SIZED TO SECURELY HOLD THE BATTERY.

3 BATTERY CHARGER INSTALLATION
E2 NO SCALE

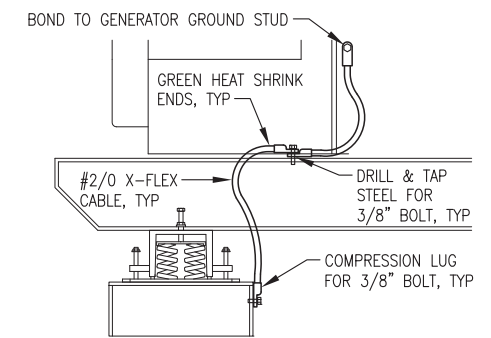

4 GENERATOR GROUNDING
E2 NO SCALE


1 TYPICAL GENERATOR INSTALLATION
E2 1-1/2"=1'-0"

ISSUED FOR CONSTRUCTION
FEB 2020



PROJECT: FFY17-18 DERA PROJECT TAKOTNA POWER PLANT UPGRADE	
TITLE: ELECTRICAL DETAILS	
DRAWN BY: JTD	SCALE: NO SCALE
DESIGNED BY: CWV/BCG	DATE: 3/18/20
FILE NAME: TAKDERA E1-E3	SHEET: E2 OF 3
PROJECT NUMBER:	
P.O. 111405, Anchorage, AK 99511 (907)349-0100	




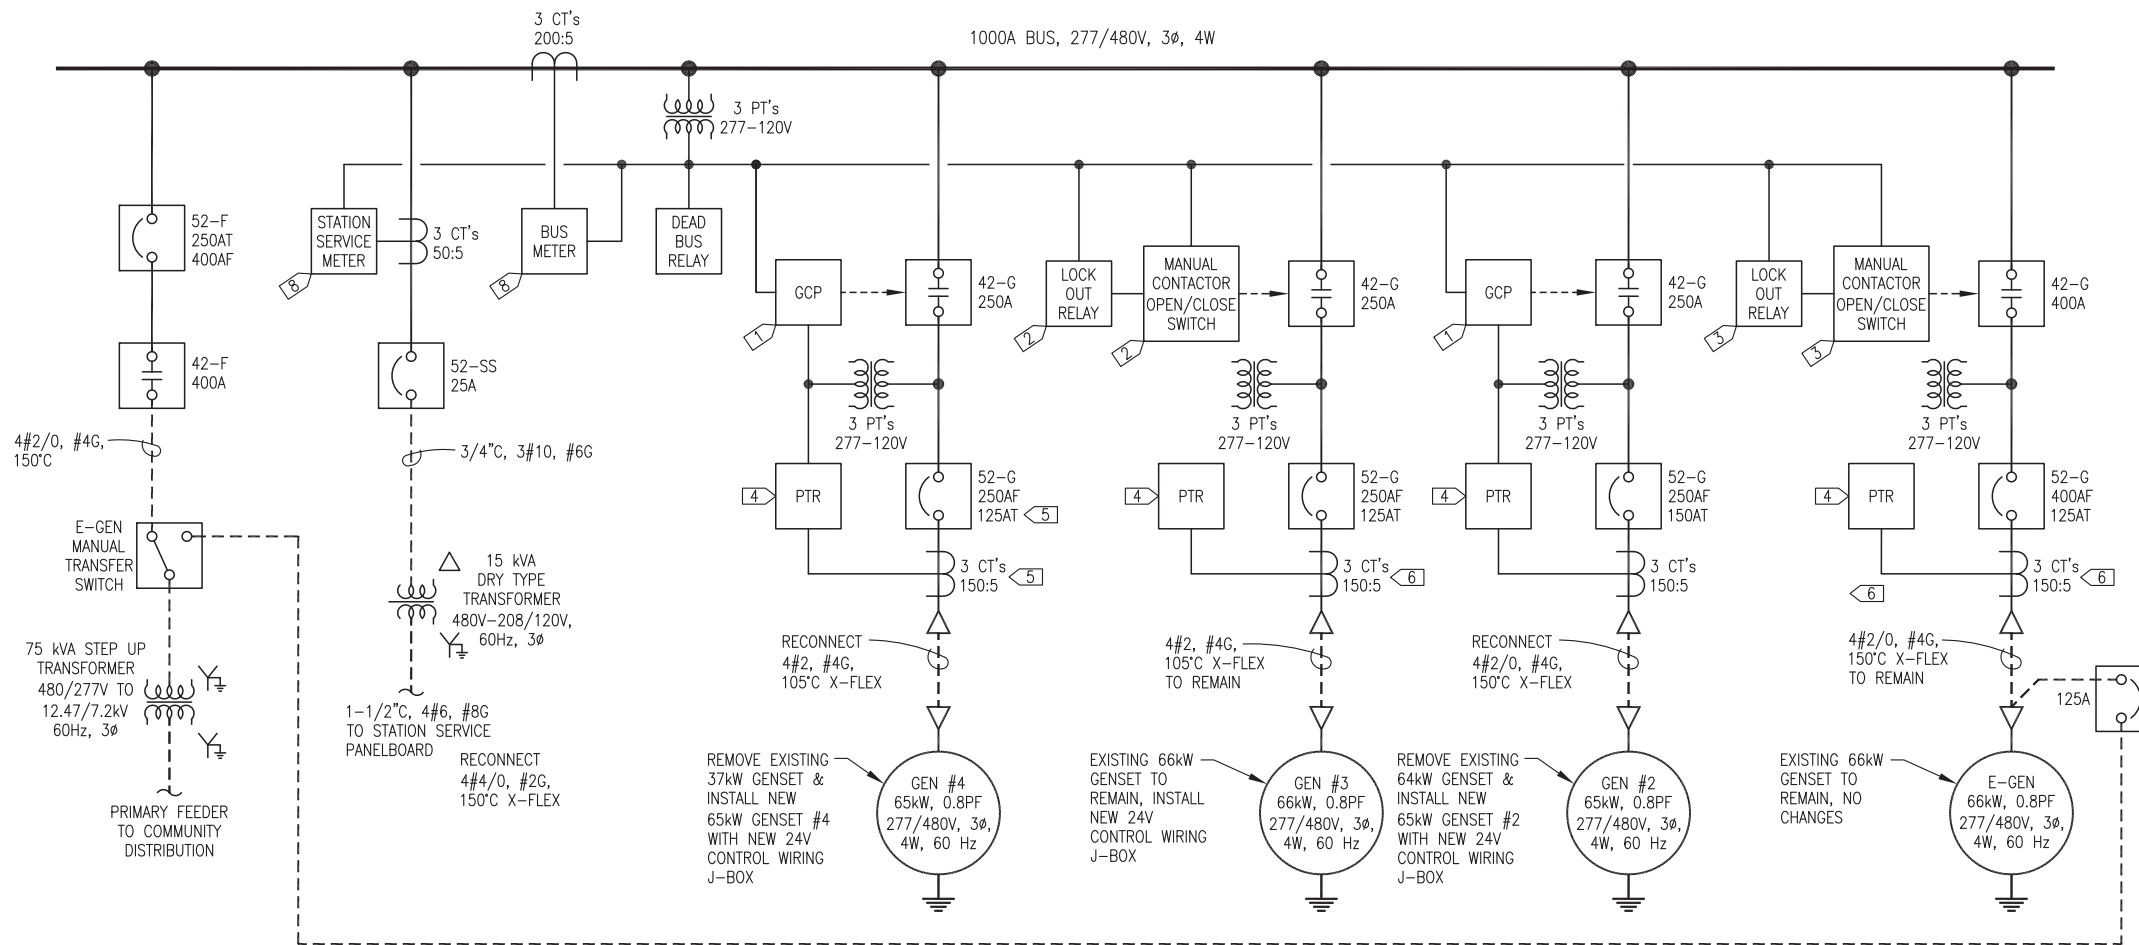


- SWITCHGEAR MODIFICATION GENERAL NOTES:**
- 1) ALL ITEMS TO REMAIN UNLESS SPECIFICALLY INDICATED FOR REMOVAL OR REPLACEMENT.
 - 2) ENSURE ALL EQUIPMENT AND CIRCUITS TO BE REMOVED ARE DE-ENERGIZED PRIOR TO BEGINNING DEMOLITION. LOCK AND TAG OUT ALL AFFECTED CIRCUIT BREAKERS AND DISCONNECTS.
 - 3) SEE SPECIFICATION FOR DETAIL ON NEW DEVICES AND EQUIPMENT.

- SWITCHGEAR MODIFICATION SPECIFIC NOTES:**
- 1) REMOVE EXISTING GCP & REPLACE WITH NEW EASYGEN.
 - 2) REMOVE EXISTING MANUAL CONTACTOR OPEN/CLOSE SWITCH & LOCK OUT RELAY & REPLACE WITH NEW EASYGEN.
 - 3) EXISTING MANUAL CONTACTOR OPEN/CLOSE SWITCH & LOCK OUT RELAY TO REMAIN FOR E-GEN.
 - 4) REMOVE EXISTING PROTECTIVE TRIP RELAY & ALL ASSOCIATED WIRING & INSTALL BLANK COVER PLATE.
 - 5) REMOVE EXISTING 90A TRIP PLUG AND INSTALL NEW 125A TRIP PLUG. EXISTING BREAKER IS A G.E. SPECTRA RMS CAT. # SGHA36AT0250. REMOVE EXISTING 75.5 CT'S AND INSTALL NEW 150:5 CT'S.
 - 6) REMOVE EXISTING 75:5 CT'S FROM GEN #3 SECTION. REMOVE EXISTING 150:5 CT'S FROM E-GEN SECTION AND INSTALL IN GEN #3 SECTION.
 - 7) REMOVE EXISTING PLC, OPERATOR INTERFACE UNIT, & ASSOCIATED DEVICES & REPLACE WITH NEW.
 - 8) EXISTING BUS & STATION SERVICE METERS WERE RECENTLY REPLACED & ARE TO REMAIN.
 - 9) REMOVE EXISTING kW RATING PLACARD & REPLACE WITH NEW "65 kW" PLACARD.
 - 10) REMOVE EXISTING kW RATING PLACARD & REPLACE WITH NEW "66 kW" PLACARD.
 - 11) REMOVE EXISTING "GENERATOR #1" PLACARD & REPLACE WITH NEW "E-GEN" PLACARD.

1 SWITCHGEAR MODIFICATION ONE-LINE DIAGRAM
E3.1 NO SCALE

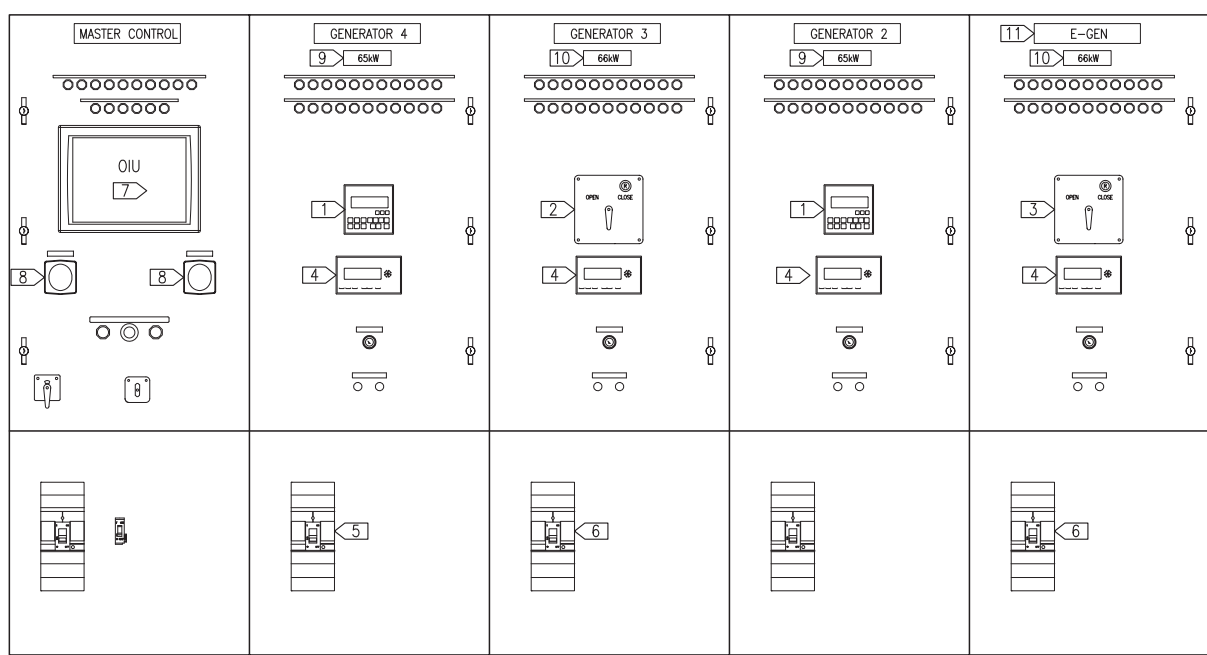

2 SWITCHGEAR MODIFICATION ELEVATION
E3.1 NO SCALE

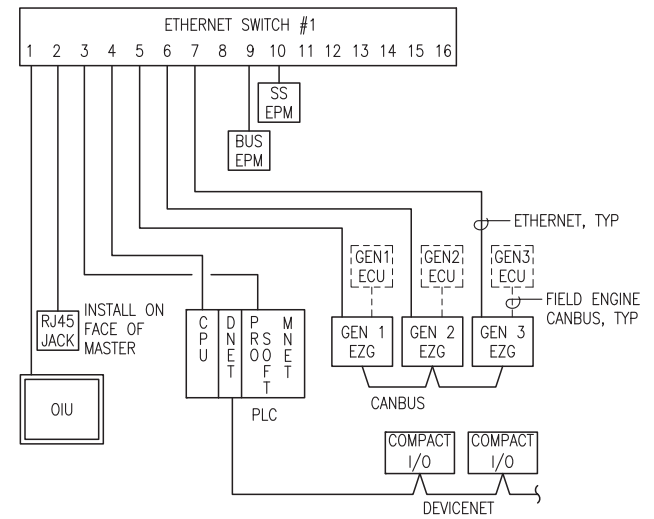


3 COMMUNICATION SCHEMATIC
E3.1 NO SCALE

ISSUED FOR CONSTRUCTION
FEB 2020




PROJECT:	FFY17-18 DERA PROJECT TAKOTNA POWER PLANT UPGRADE		
TITLE:	SWITCHGEAR MODIFICATIONS		
DRAWN BY:	JTD	SCALE:	NO SCALE
DESIGNED BY:	CWV/BCG	DATE:	3/18/20
FILE NAME:	TAKDERA E1-E3	SHEET:	E3.1 OF 3
PROJECT NUMBER:			




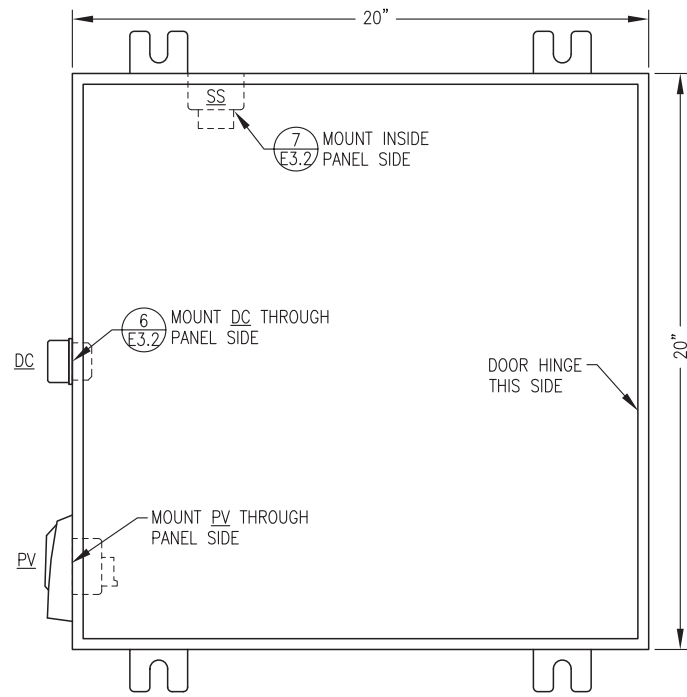


1 JUNCTION BOX FRONT PANEL LAYOUT
E4 NO SCALE

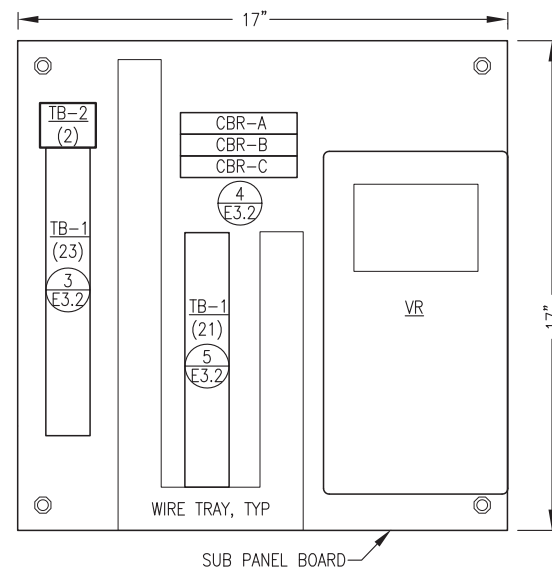

2 JUNCTION BOX SUB PANEL LAYOUT
E4 NO SCALE

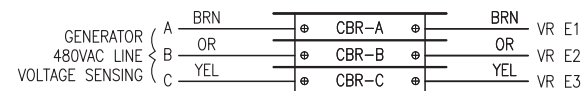


4 CIRCUIT BREAKER CONNECTIONS
E3.2 NO SCALE

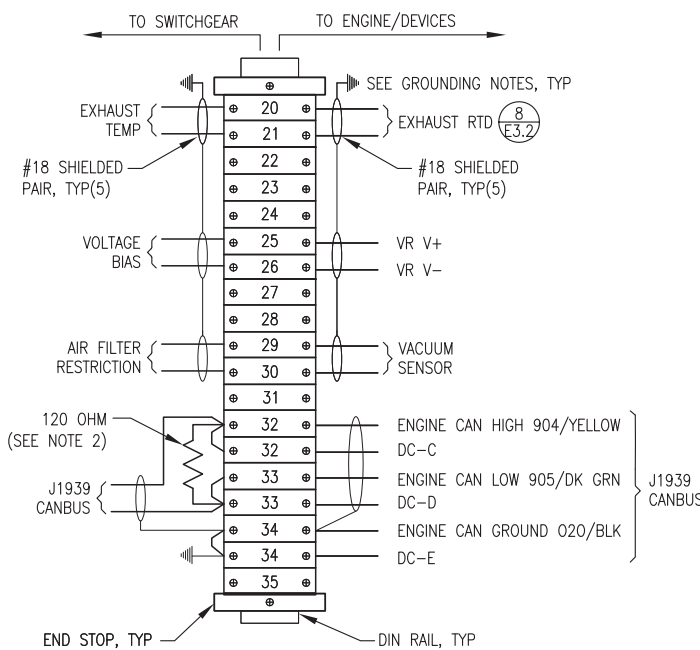

NOTES: 1) ALL RESISTORS 0.25W.
2) REMOVE RESISTOR IF ENGINE WIRING HARNESS HAS 120 OHM END OF LINE RESISTOR.

5 TERMINAL STRIP CONNECTIONS
E3.2 NO SCALE

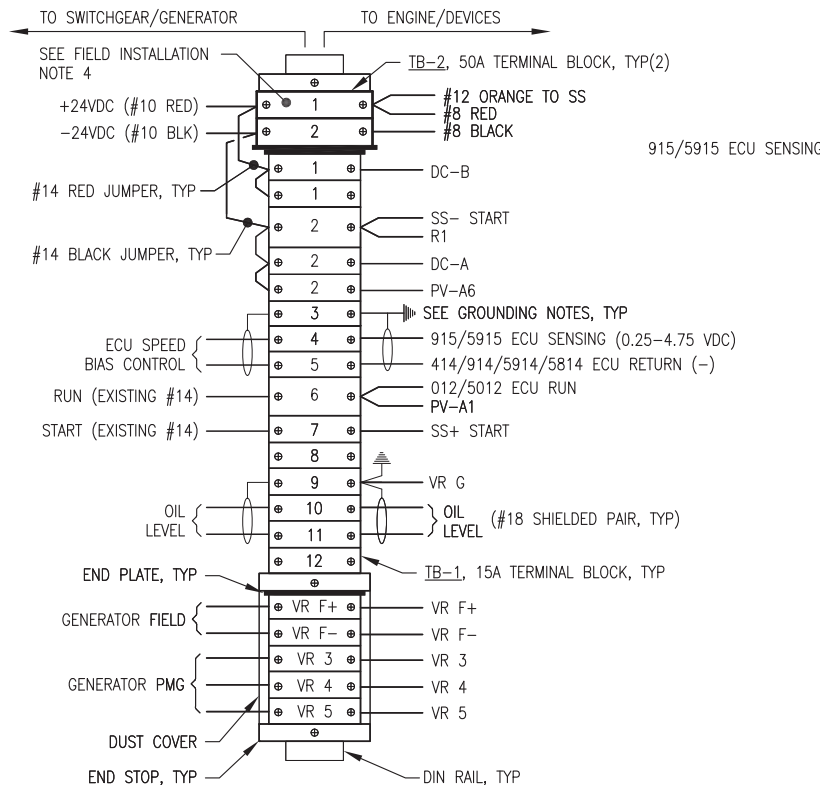

NOTE: TYPICAL JOHN DEERE ECU CONNECTION NUMBERS SHOWN. SEE WIRING HARNESS FOR EACH ENGINE FOR ACTUAL ECU CONNECTIONS.

3 TERMINAL STRIP CONNECTIONS
E3.2 NO SCALE

TAG	MANUFACTURER	MODEL	DESCRIPTION
ENCL.	HOFFMAN	A20H20ALP	20x20x8" NEMA 12 BACK PANEL
VR	HOFFMAN	A20P20	DIGITAL VOLTAGE REGULATOR
CBR	BASLER	DECS-150 5NS1V1N1S	RAIL MOUNT CIRCUIT BREAKER, 1-POLE, 1A
DC	ALLEN-BRADLEY	1489-M1-C010	DIAGNOSTIC CONNECTOR, 9-PIN, CAN-BUS
	JOHN DEERE	57M7919	CONNECTOR STRAIN RELIEF
	DEUTSCH	HDC16-9	CONNECTOR PROTECTIVE DUST CAP
	DEUTSCH	HD18-009	CONNECTOR GASKET
	DEUTSCH	JDL062397	CONNECTOR LANYARD
PV	MURPHY	PV101-C-MSTD	POWER VIEW W/HARNESS
SS	CATERPILLAR	9X-8124	STARTER AUXILIARY SOLENOID, 24V
TB-1	IDEC	BNH15LW	15A DIN RAIL-MOUNT TERMINAL BLOCK
TB-2	IDEC	BNH50W	50A DIN RAIL-MOUNT TERMINAL BLOCK


NOTE: SPECIFIC PARTS MANUFACTURER AND MODEL SELECTED NOT ONLY TO MEET PERFORMANCE FUNCTION BUT ALSO TO COORDINATE AND INTERFACE WITH OTHER DEVICES AND SYSTEMS. APPROVED EQUAL SUBSTITUTIONS WILL BE ALLOWED ONLY BY ENGINEER'S APPROVAL. TO OBTAIN APPROVAL, SUBMITTALS MUST CLEARLY DEMONSTRATE HOW SUBSTITUTE ITEM MEETS OR EXCEEDS SPECIFIED ITEM QUALITY AND PERFORMANCE CHARACTERISTICS AND ALSO COMPLIES WITH MECHANICAL AND/OR ELECTRICAL CONNECTIONS AND PHYSICAL LAYOUT REQUIREMENTS.

SHOP FABRICATION NOTES:


- 1) PROVIDE ASSEMBLY WITH ALL DEVICES AND WIRING INDICATED.
- 2) INSTALL IN A NEMA 12 ENCLOSURE WITH MOUNTING FLANGES AT BACK, A MIN 14 GAUGE INTERIOR BACK PANEL AND HINGED LOCKABLE DOOR. SIZE AS INDICATED.
- 3) PROVIDE DIN RAIL, TERMINAL END PLATES, TERMINAL END STOPS, TERMINAL DUST COVERS AND OTHER MISCELLANEOUS HARDWARE AS REQUIRED TO MATCH TERMINALS. LABEL ALL TERMINALS EXACTLY AS INDICATED ON THE DETAILS.
- 4) ALL WIRE #14AWG EXCEPT WHERE SPECIFICALLY INDICATED OTHERWISE. LABEL BOTH ENDS OF ALL JUMPERS WITH THE ENGINE PANEL TERMINAL NUMBER.
- 5) PROVIDE MECHANICAL GROUND LUGS FASTENED TO BACK PANEL AND GROUNDED TO ENGINE-GENERATOR. GROUND ALL SHIELD DRAIN WIRES TO LUGS AT PANEL END ONLY.
- 6) PROVIDE WIRING HARNESSSES FOR CONNECTION TO GENERATOR AND TO ENGINE. INSTALL WIRES IN LIQUID TIGHT FLEX OR FLEXIBLE PLASTIC WIRE LOOM AND PROVIDE SERVICE LOOPS IN ACCORDANCE WITH SPECIFICATIONS.
- 7) SHOP TEST EACH NEW ENGINE-GENERATOR WITH ASSOCIATED JUNCTION BOX PERMANENTLY CONNECTED. UPON COMPLETION OF TESTING, COIL WIRING HARNESSSES AND SECURE JUNCTION BOX TO GENERATOR FOR SHIPPING.

FIELD INSTALLATION NOTES:


- 1) PERFORM ALL FIELD WIRING IN ACCORDANCE WITH SPECIFICATIONS.
- 2) GEN #2 & #4 J-BOXES SHOP CONNECTED TO GENSET AS INDICATED. GEN #3 J-BOX TO BE FIELD CONNECTED TO EXISTING GENSET & NEW INSTRUMENTATION DEVICES.
- 3) ON SHIELDED CONDUCTORS GROUND ALL SHIELD DRAIN WIRES TO LUGS AT PANEL END ONLY.
- 4) FIELD CONDUCTORS FROM GENERATOR TO SWITCHGEAR ARE EXISTING. USE EXISTING UNUSED SHIELDED TRIAD TO SERVE AS SHIELDED PAIR IF NECESSARY. REMOVE ALL TYPE J THERMOCOUPLE WIRE AND DISCARD. FOR ALL UNUSED CONDUCTORS COIL, TAPE ENDS, & LEAVE IN PLACE.
- 5) RELABEL ALL TERMINALS IN SWITCHGEAR TO MATCH NEW J-BOX TERMINAL NUMBERS. LABEL BOTH ENDS OF ALL FIELD WIRING WITH THE ENGINE PANEL TERMINAL NUMBER.

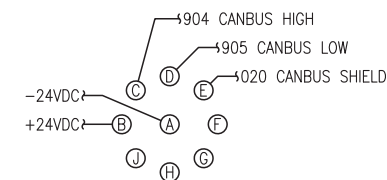

6 DIAGNOSTIC CONNECTOR WIRING
E3.2 NO SCALE

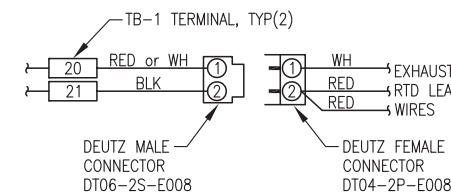

8 EXHAUST RTD CONNECTOR
E3.2 NO SCALE

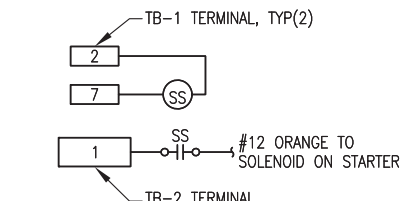

7 STARTER AUX SOLENOID SS WIRING
E3.2 NO SCALE

ISSUED FOR CONSTRUCTION
FEB 2020



PROJECT:	FFY17-18 DERA PROJECT TAKOTNA POWER PLANT UPGRADE	
TITLE:	24V ENGINE WIRING JUNCTION BOX	
DRAWN BY:	JTD	SCALE: NO SCALE
DESIGNED BY:	CWV/BCG	DATE: 3/18/20
FILE NAME:	TAKDERA E1-E3	SHEET: E3.2 OF 3
PROJECT NUMBER:	P.O. 111405, Anchorage, AK 99511 (907)349-0100	




The Lake and Peninsula School District

CHIGNIK LAKE
THE LAKE AND PENINSULA SCHOOL DISTRICT PURCHASE ORDER No. 7086
CONTROLLED POWER, INC. JOB No. 5354

<u>DRAWING No.</u>	<u>DRAWING TITLE</u>
11230CS	COVER SHEET
11231	SCHEMATIC SYMBOL LEGEND AND NOTES
11232	GENERATOR SWITCHGEAR, OUTLINE DIAGRAM
11233	METAL WORK, ASSEMBLY DETAIL
11234	METAL WORK, ASSEMBLY DETAIL
11235	SINGLE LINE, SCHEMATIC DIAGRAM
11236-1	GENERATOR 1 AC THREE LINE, SCHEMATIC DIAGRAM
11236-2	GENERATOR 2 AC THREE LINE, SCHEMATIC DIAGRAM
11236-3	GENERATOR 3 AC THREE LINE, SCHEMATIC DIAGRAM
11236-4	GENERATOR 4 AC THREE LINE, SCHEMATIC DIAGRAM
11237	MASTER AC THREE LINE, SCHEMATIC DIAGRAM
11238-1	GENERATOR 1 DC CONTROL, SCHEMATIC DIAGRAM
11238-2	GENERATOR 2 DC CONTROL, SCHEMATIC DIAGRAM
11238-3	GENERATOR 3 DC CONTROL, SCHEMATIC DIAGRAM
11238-4	GENERATOR 4 DC CONTROL, SCHEMATIC DIAGRAM
11239-1	GENERATOR 1 PLC INPUTS & OUTPUTS, SCHEMATIC DIAGRAM
11239-2	GENERATOR 2 PLC INPUTS & OUTPUTS, SCHEMATIC DIAGRAM
11239-3	GENERATOR 3 PLC INPUTS & OUTPUTS, SCHEMATIC DIAGRAM
11239-4	GENERATOR 4 PLC INPUTS & OUTPUTS, SCHEMATIC DIAGRAM
11240	MASTER DC CONTROL, PLC INPUTS, SCHEMATIC DIAGRAM
11241	MASTER PLC INPUTS & OUTPUTS, BACKUP PLC, SCHEMATIC DIAGRAM
11242	HEATER & LIGHTING CONTROL, SCHEMATIC DIAGRAM
11243	FUEL FLOW SYSTEM, SCHEMATIC DIAGRAM
11244	PLC COMMUNICATION, SCHEMATIC DIAGRAM
11245	EPM & FUEL MONITORING COMMUNICATION, SCHEMATIC DIAGRAM
11246	NAMEPLATE ENGRAVING SCHEDULE, FABRICATION DETAIL
11247	CONTROL SWITCH DEVELOPMENTS, FABRICATION DETAIL
11248	FIELD CONNECTION DIAGRAM

CHIGNIK LAKE SWITCHGEAR SHOP DRAWINGS, 28 SHEETS TOTAL. NOTE THAT THESE DRAWINGS SHOW THE SHOP AS BUILT FROM THE ORIGINAL INSALLATION IN 2003. THEY HAVE NOT BEEN VERIFIED FOR PRESENT AS BUILT CONDITIONS.

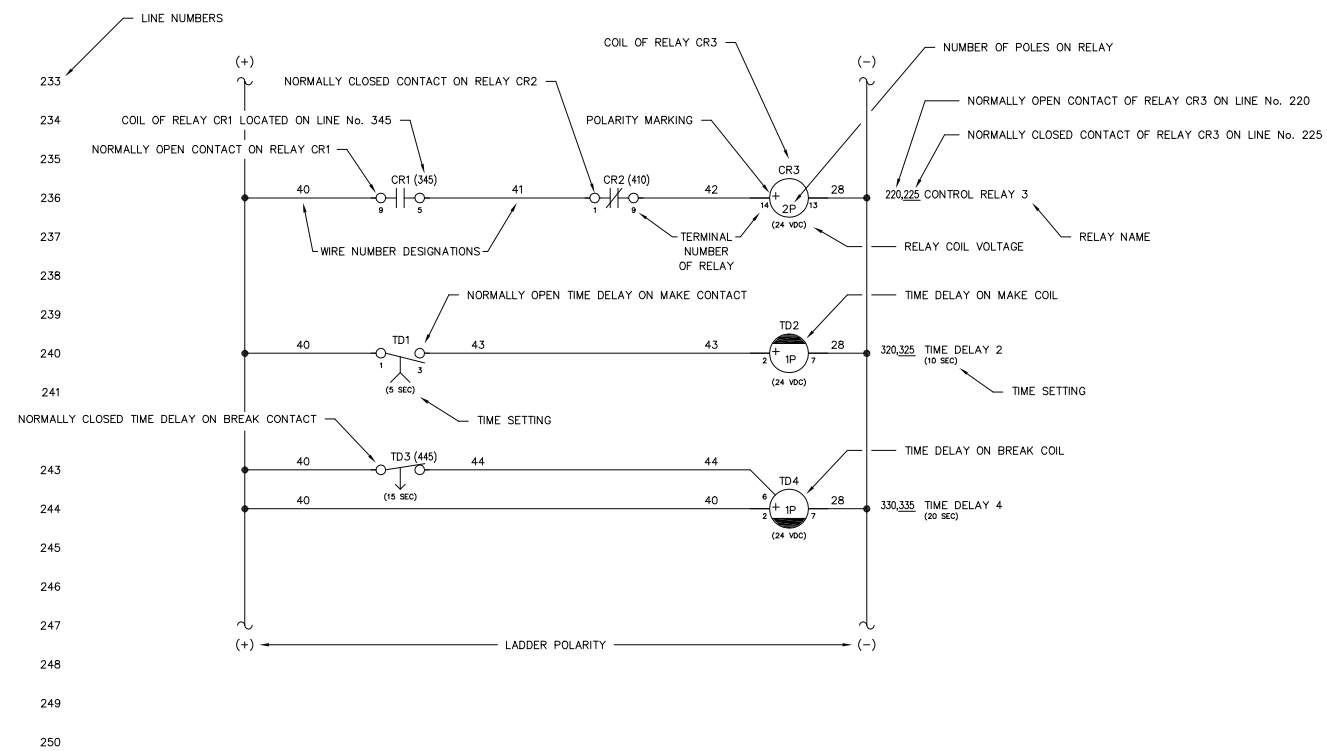








TERMINAL LEGEND

SYMBOL DESCRIPTION

- ⊕ INDICATES GENERATOR FIELD CONNECTION TERMINALS.
- ⊙ INDICATES MASTER FIELD CONNECTION TERMINALS.
- ⊗ INDICATES GENERATOR SECTION INTERCONNECT TERMINALS.
- ⊘ INDICATES MASTER SECTION INTERCONNECT TERMINALS.

SCHEMATIC NOTES:

1. SCHEMATIC IS SHOWN AS FOLLOWS:
 - ALL AC AND DC POWER REMOVED
 - ALL RELAY CONTACTS DE-ENERGIZED
 - ALL CIRCUIT BREAKERS IN THE OPEN/RESET POSITION
 - ALL EMERGENCY STOP SWITCHES IN THE "NORMAL" POSITION
 - ALL PRESSURE SWITCHES SHOWN WITHOUT FLUID PRESENT
 - ALL LEVEL SWITCHES SHOWN WITHOUT FLUID PRESENT
 - ALL TEMPERATURE SWITCHES SHOWN AT AMBIENT
2. - INDICATES FIELD WIRING BY OTHERS
3. ALL CONTROL WIRING TO BE No. 14 AWG, 600 VOLT, TYPE SIS EXCEPT AS NOTED. CURRENT TRANSFORMER WIRING TO BE No. 12 AWG.
4. SHIELDED WIRING TO BE No. 18 AWG, 300 VOLT, TWISTED LINE WITH 100% FOIL COVERAGE

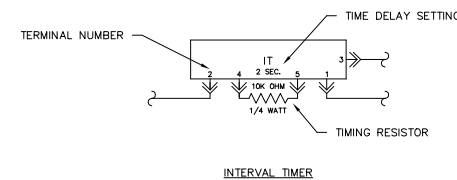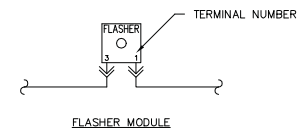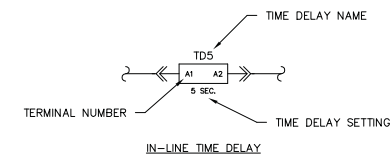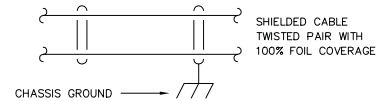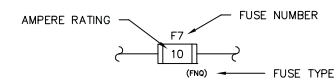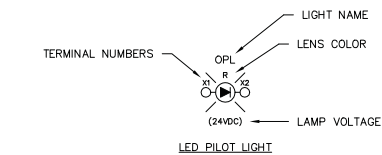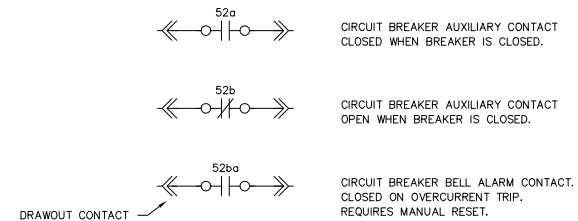


B	09-05-03	SHOP AS BUILT	CMD
A	06-10-03	SUBMITTAL	CMD
REV.	DATE	DESCRIPTION	BY
PURCHASE ORDER No. 7086		CONTROLLED POWER JOB No. 5354	
TITLE: SCHEMATIC SYMBOL LEGEND AND NOTES			
CPI DWG No. 11231			
SCALE: NONE	DATE: 06-10-03	DWN. BY: CMD	
DWG. No: 11231	SHEET: 1 OF 1	CKD. BY: JMD	
JOB: CHIGNIK LAKE			


NOTICE
 THE DRAWINGS, INFORMATION AND SUBJECT MATTER HEREOF ARE THE CONFIDENTIAL SOLE AND EXCLUSIVE PROPERTY OF CONTROLLED POWER, INC., AND ARE NOT TO BE COPIED, REPRODUCED OR USED IN ANY MANNER FOR ANY PURPOSE WHATSOEVER WITHOUT WRITTEN CONSENT OR DIRECTION.




The Lake and Peninsula School District
 101 Jensen Drive
 P.O. Box 498
 King Salmon, Alaska 99613
 Phone (907) 246-4280/Fax (907) 246-4473

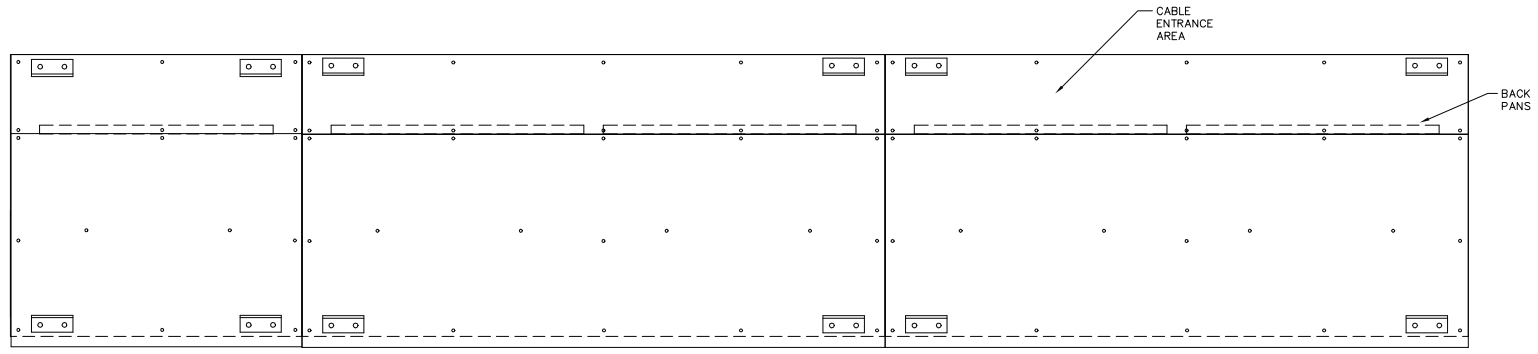


GENERATOR SWITCHGEAR – TOP VIEW

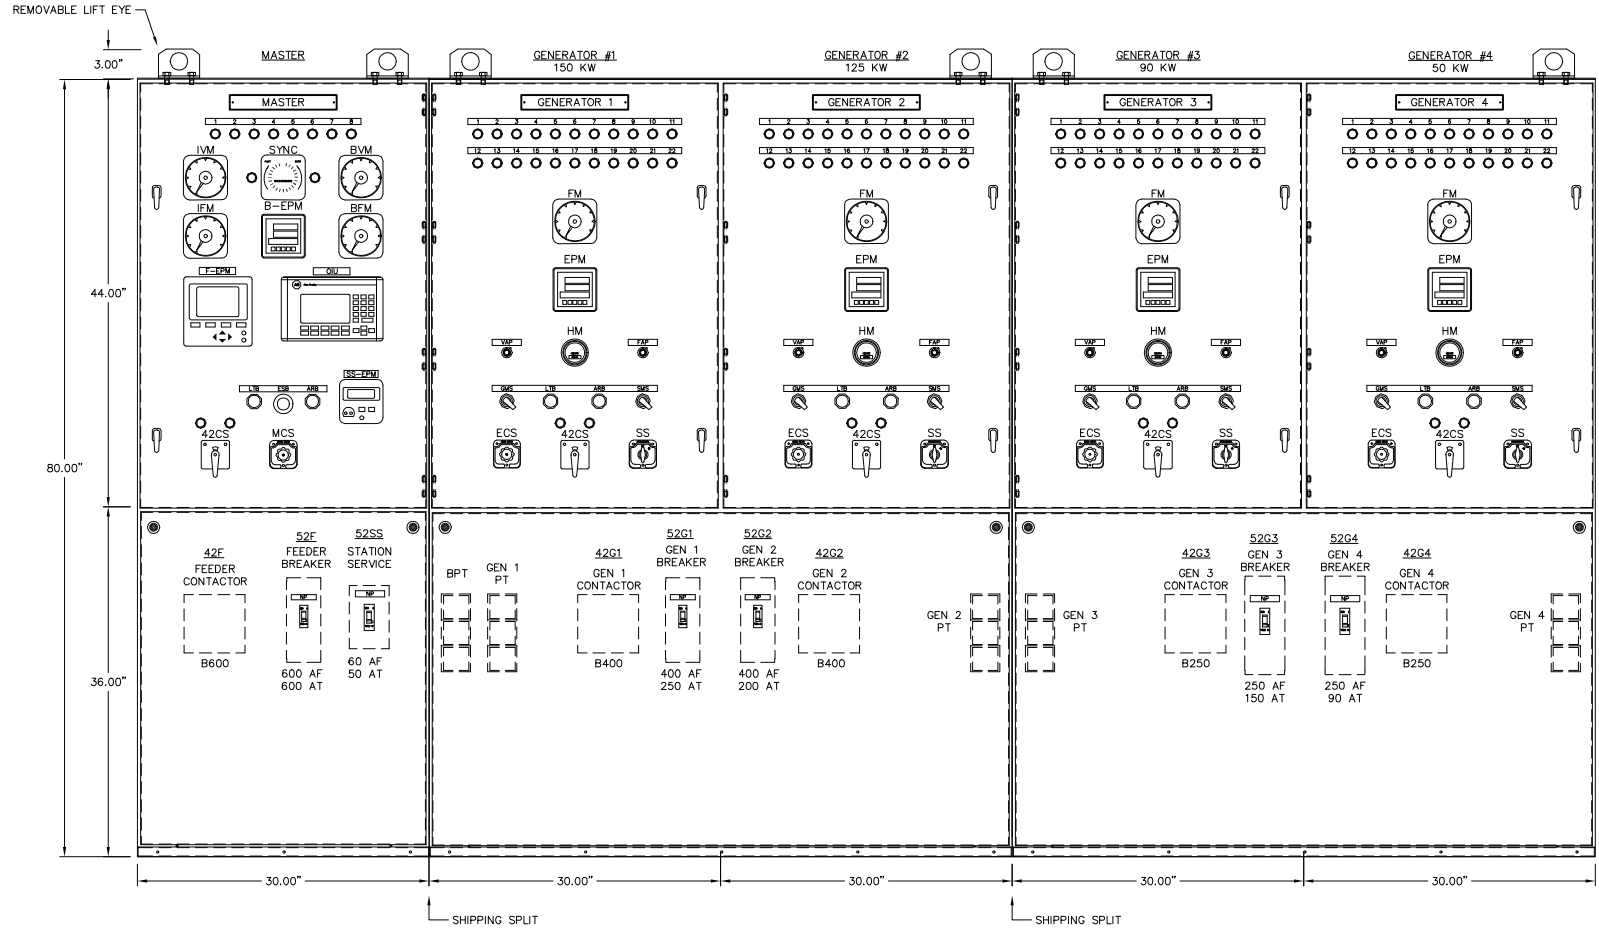

GENERATOR SWITCHGEAR – FRONT VIEW

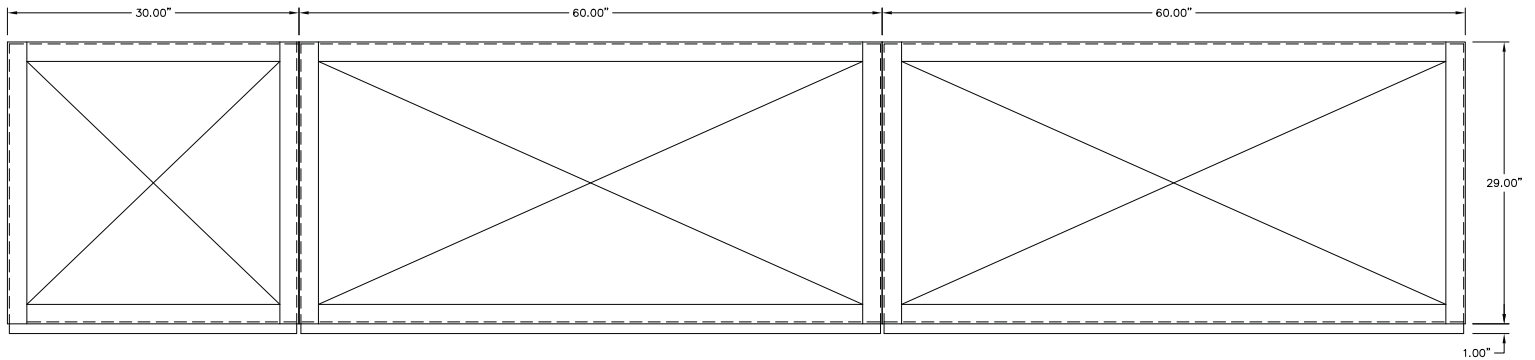

GENERATOR SWITCHGEAR – PLAN VIEW

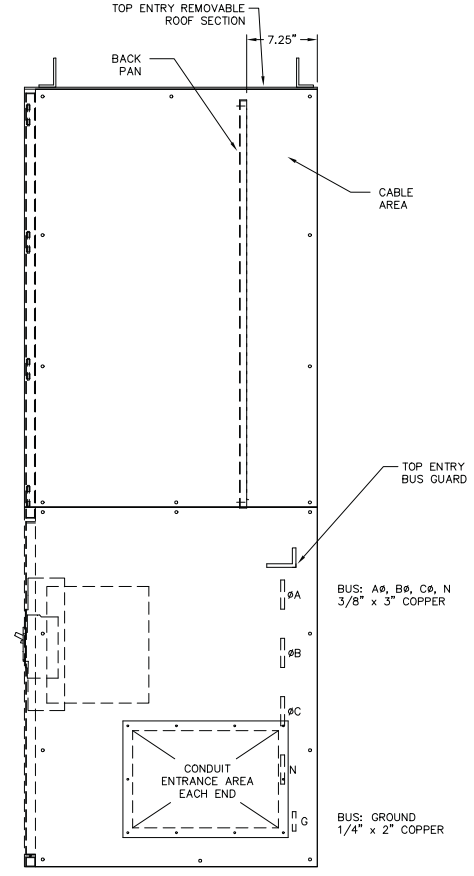


GENERATOR SWITCHGEAR – SIDE VIEW

- MASTER ANNUNCIATOR LEGEND:**
1. FIRE ALARM LIGHT
 2. EMERGENCY STOP LIGHT
 3. SYSTEM LOW WATER LEVEL LIGHT
 4. BUS UNDER/OVER VOLTAGE LIGHT
 5. BUS UNDER/OVER FREQUENCY LIGHT
 6. PRIMARY PLC FAILURE
 7. OPERATING ON BACKUP PLC
 8. BACKUP PLC FAILURE
 9. CONTACTOR OPEN
 10. CONTACTOR CLOSED

- GENERATOR ANNUNCIATOR LEGEND:**
1. ENGINE RUN
 2. ENGINE IDLE
 3. LOW OIL PRESSURE
 4. HIGH WATER TEMPERATURE
 5. OVERCRANK
 6. OVERSPEED
 7. ENGINE ALARM
 8. COOLDOWN/LOCKOUT
 9. LOW OIL LEVEL
 10. BATTERY CHARGER FAILURE
 11. REVERSE POWER
 12. FAIL TO SYNCHRONIZE
 13. NORMAL STOP
 14. OVERCURRENT
 15. UNDER VOLTAGE
 16. OVER VOLTAGE
 17. UNDER FREQUENCY
 18. OVER FREQUENCY
 19. NOT IN AUTO
 20. GENERATOR BREAKER OPEN
 21. LOSS OF EXCITATION
 22. PHASE BALANCE

SYMBOL	NOMENCLATURE	DESCRIPTION
ARB	ALARM RESET BUTTON	
B-EPM	TOTALIZING POWER METER	
BFM	BUS FREQUENCY METER	
BVM	BUS VOLTMETER	
ECS	ENGINE CONTROL SWITCH	
EPM	ELECTRONIC POWER METER	
ESB	EMERGENCY STOP BUTTON	
F-EPM	FEEDER ELECTRONIC POWER METER	
FAP	FREQUENCY ADJUST POTENTIOMETER	
FM	FREQUENCY METER	
GMS	GOVERNOR MODE SWITCH	
HM	HOURLY METER	
IFM	INCOMING FREQUENCY METER	
IVM	INCOMING VOLT METER	
LTB	LAMP TEST BUTTON	
MCS	SYSTEM MODE SWITCH	
OIU	OPERATOR INTERFACE UNIT	
SMS	SYNCH MODE SWITCH	
SS	SYNCHROSCOPE SWITCH	
SS-EPM	STATION SERVICE ELECTRONIC POWER METER	
SYNC	SYNCHROSCOPE	
VAP	VOLTAGE ADJUST POTENTIOMETER	
42xx	CONTACTOR	
42CS	CONTACTOR CONTROL SWITCH	
52xx	CIRCUIT BREAKER	

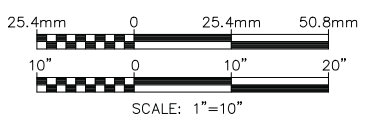

NOTICE
 THE DRAWINGS, INFORMATION AND SUBJECT MATTER HEREOF ARE THE CONFIDENTIAL SOLE AND EXCLUSIVE PROPERTY OF CONTROLLED POWER, INC., AND ARE NOT TO BE COPIED, REPRODUCED OR USED IN ANY MANNER FOR ANY PURPOSE WHATSOEVER WITHOUT WRITTEN CONSENT OR DIRECTION.

B	09-05-03	SHOP AS BUILT	CMD
A	06-10-03	SUBMITTAL	CMD
REV.	DATE	DESCRIPTION	BY


PURCHASE ORDER No. 7086 CONTROLLED POWER JOB No. 5354
 TITLE: GENERATOR SWITCHGEAR, OUTLINE DIAGRAM
 CPI DWG No. 11232

SCALE: NONE	DATE: 06-10-03	DWN. BY: CMD
DWG. No: 11232	SHEET: 1 OF 1	CKD. BY: JMD


JOB: CHIGNIK LAKE




The Lake and Peninsula School District
 101 Jensen Drive
 P.O. Box 498
 King Salmon, Alaska 99613
 Phone (907) 246-4280/Fax (907) 246-4473

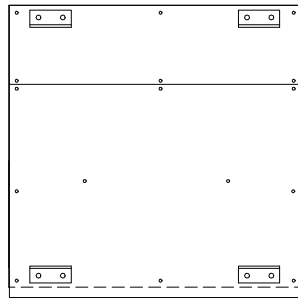


MASTER SECTION - TOP VIEW

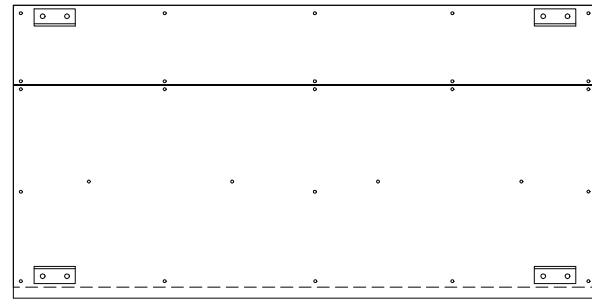


GENERATOR SECTIONS 1 & 2 - TOP VIEW

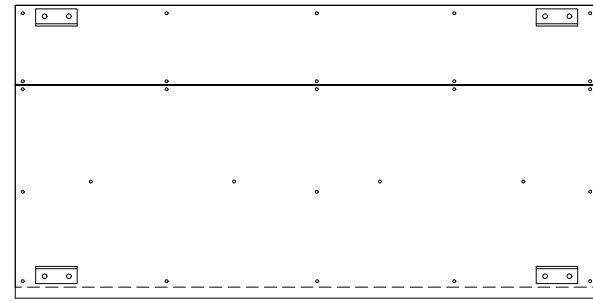


GENERATOR SECTIONS 3 & 4 - TOP VIEW

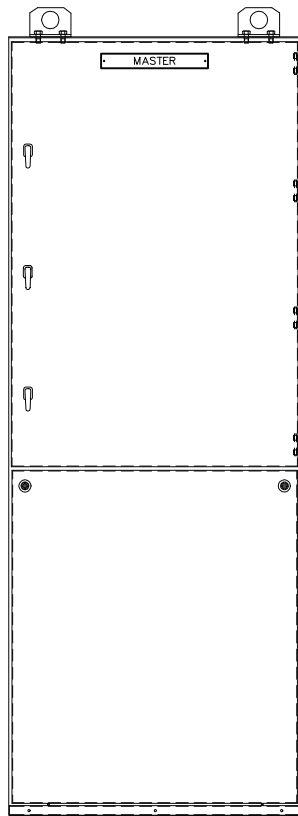


MASTER SECTION - FRONT VIEW

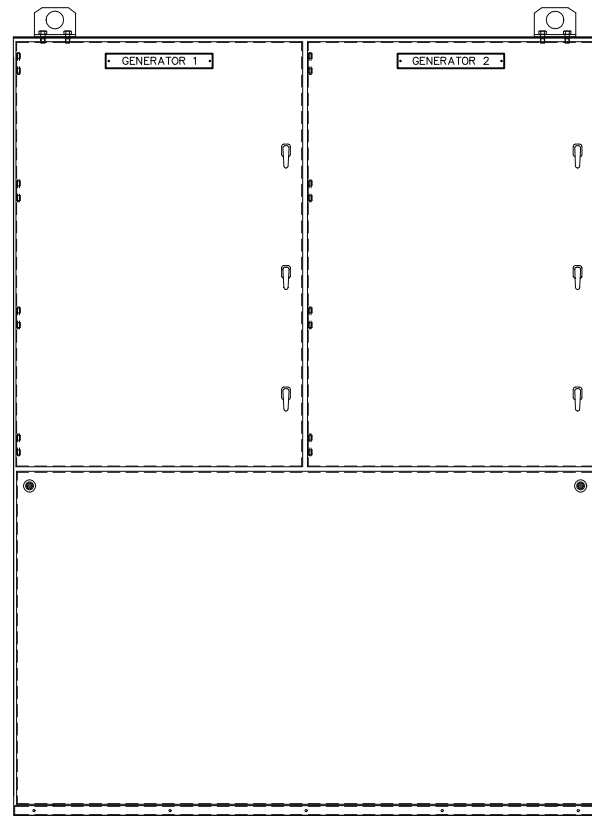


GENERATOR SECTIONS 1 & 2 - FRONT VIEW

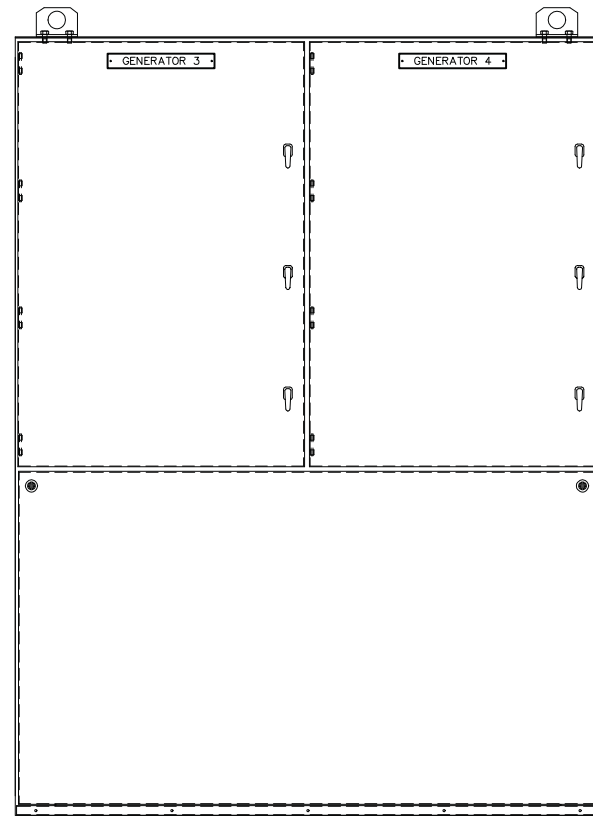


GENERATOR SECTIONS 3 & 4 - FRONT VIEW

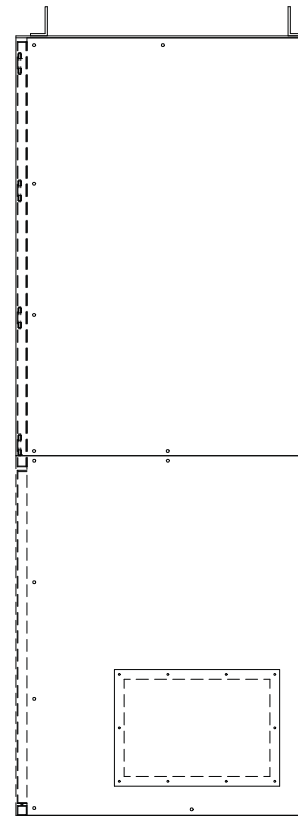

TYPICAL SIDE VIEW

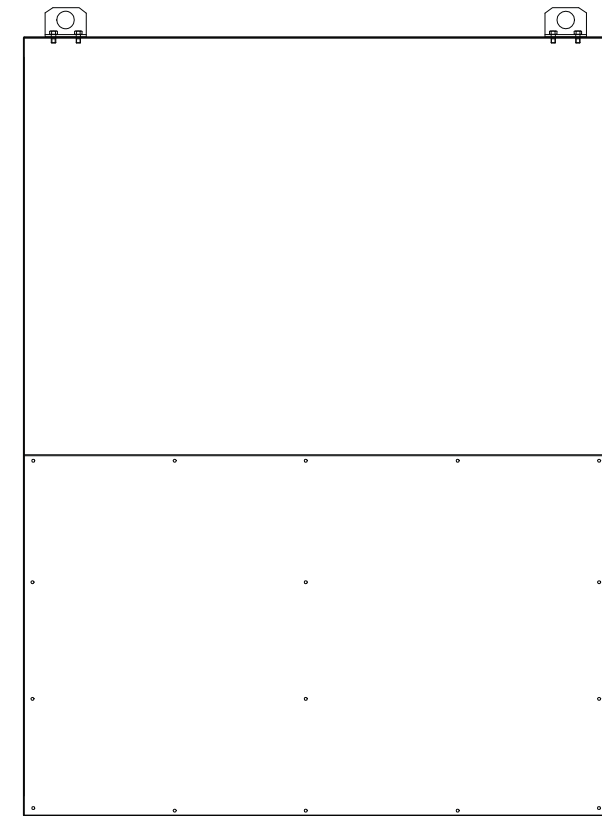

GENERATOR SECTIONS 1 & 2 - 3 & 4 - REAR VIEW

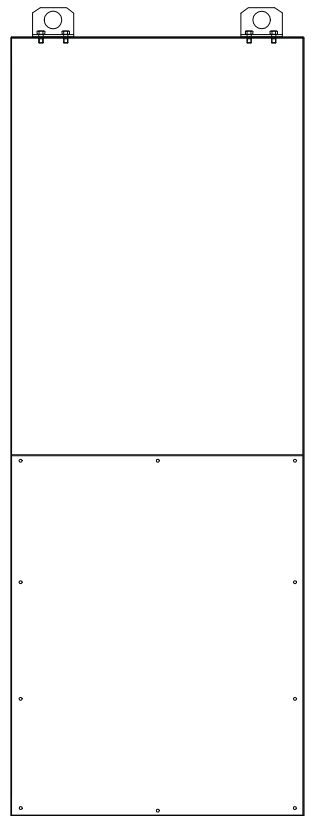

MASTER SECTION REAR VIEW

PAINT SPECIFICATION:

1. ALL PARTS TO BE CLEANED PHOSPHATE WASHED AND PRIMED TO MDFT 1-2 MILS.
2. ALL PARTS TO BE FINISHED ONE COAT ELECTROSTATIC PROCESS MDFT 2-4 MILS.
3. ALL PARTS TO BE FINISHED ONE COAT ELECTROSTATIC PROCESS MDFT 2-4 MILS ANSI 61 GRAY EXCEPT HORIZONTAL BARRIERS, PT PANS, BACK PANS & SIDE PANS TO BE PAINTED WHITE.

PROCEDURES FOR SANDBLASTED PARTS

1. BLAST PARTS TO CUSTOMER SPECIFICATION.
2. HANG AND BLOW EXCESS GRIT AND DUST FROM PART. MAY NEED TO PRE BAKE.
3. APPLY POWDER TO SPECIFIED MILL THICKNESS.
4. BAKE POWDER AT MANUFACTURERS TIME AND TEMPERATURE RATING.

PRIMED PARTS


1. BLASTING AND PREPARATION SAME AS ABOVE.
2. APPLY SPECIFIED PRIMER AND CURE PER MANUFACTURERS RECOMMENDATION.
3. POWER APPLICATION AND CURING FINAL COAT SAME AS ABOVE.

PAINT PROCEDURE

1. PARTS ARE RUN THROUGH A 5 STAGE PHOSPHATE LINE THE TANKS ARE AS FOLLOWS.
2. CLEANER TANK OAKITE GARDOCLEAN 338 U.
3. RINSE TANK WATER.
4. PHOSPHATE TANK OAKITE CRYSCOAT 2147.
5. RINSE TANK WATER.
6. SEALER OAKITE CRYSCOAT ULTRA SEAL.

STRUCTURE SPECIFICATION:

1. ALL STEEL ASTM A366
2. FRAME: 2" x 2 x 3/16" STRUCTURAL HOT ROLLED ANGLE.
3. FRONT PANELS, BACK AND END SKINS, 14 GA. PICKLED IN OIL.
4. FRONT CONTROL DOORS AND ROOF SECTIONS 12 GA. PICKLED IN OIL.

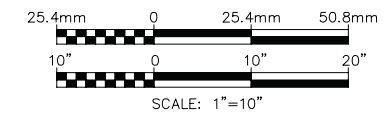


NOTICE
 THE DRAWINGS, INFORMATION AND SUBJECT MATTER HEREOF ARE THE CONFIDENTIAL SOLE AND EXCLUSIVE PROPERTY OF CONTROLLED POWER, INC., AND ARE NOT TO BE COPIED, REPRODUCED OR USED IN ANY MANNER FOR ANY PURPOSE WHATSOEVER WITHOUT WRITTEN CONSENT OR DIRECTION.


REV.	DATE	DESCRIPTION	BY
B	09-05-03	SHOP AS BUILT	CMD
A	06-10-03	SUBMITTAL	CMD
PURCHASE ORDER No. 03-01 (5354)		CONTROLLED POWER JOB No. 5354	
TITLE: GENERATOR SWITCHGEAR, OUTLINE DIAGRAM			
SCALE: 1/10		DATE: 06-10-03	CPI DWG No. 11233
DWN. BY: CMD		DWG. No: 11233	
SHEET: 1 OF 1		CKD. BY: JMD	
JOB: CHIGNIK LAKE			




The Lake and Peninsula School District
 101 Jensen Drive
 P.O. Box 498
 King Salmon, Alaska 99613
 Phone (907) 246-4280/Fax (907) 246-4473

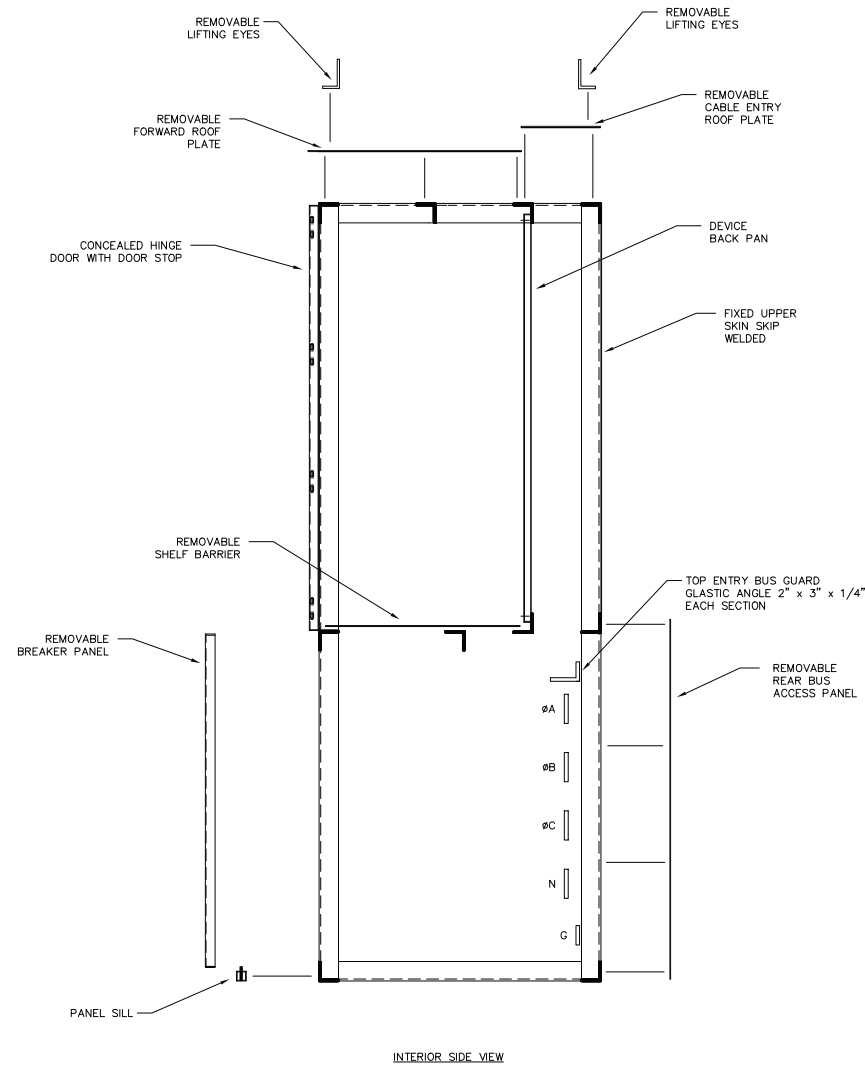






- STRUCTURE SPECIFICATION:**
1. ALL STEEL ASTM A366
 2. FRAME: 2" x 2 x 3/16" STRUCTURAL HOT ROLLED ANGLE.
 3. FRONT PANELS, BACK AND END SKINS, 14 GA. PICKLED IN OIL.
 4. FRONT CONTROL DOORS AND ROOF SECTIONS 12 GA. PICKLED IN OIL.
- PAINT SPECIFICATION:**
1. ALL PARTS TO BE CLEANED PHOSPHATE WASHED AND PRIMED TO MDFT 1-2 MILS.
 2. ALL PARTS TO BE FINISHED ONE COAT ELECTROSTATIC PROCESS MDFT 2-4 MILS.
 3. ALL PARTS TO BE FINISHED ONE COAT ELECTROSTATIC PROCESS MDFT 2-4 MILS ANSI 61 GRAY EXCEPT HORIZONTAL BARRIERS, PT PANS, BACK PANS & SIDE PANS TO BE PAINTED WHITE.

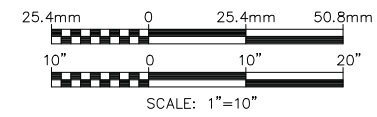

NOTICE
 THE DRAWINGS, INFORMATION AND SUBJECT MATTER HEREOF ARE THE CONFIDENTIAL SOLE AND EXCLUSIVE PROPERTY OF CONTROLLED POWER, INC., AND ARE NOT TO BE COPIED, REPRODUCED OR USED IN ANY MANNER FOR ANY PURPOSE WHATSOEVER WITHOUT WRITTEN CONSENT OR DIRECTION.

REV.	DATE	DESCRIPTION	BY
B	09-05-03	SHOP AS BUILT	CMD
A	06-10-03	SUBMITTAL	CMD
PURCHASE ORDER No. 7086 CONTROLLED POWER JOB No. 5354			
TITLE: GENERATOR SWITCHGEAR, ASSEMBLY DIAGRAM			
CPI DWG No. 11234			
SCALE: 1/10	DATE: 06-10-03	DWN. BY: CMD	
DWG. No: 11234	SHEET: 1 OF 1	CKD. BY: JMD	
JOB: CHIGNIK LAKE			
		The Lake and Peninsula School District 101 Jensen Drive P.O. Box 498 King Salmon, Alaska 99613 Phone (907) 246-4280/Fax (907) 246-4473	

MAIN BUS 3ø, 4W, 22 KAIC, 1000 A, COPPER BUS

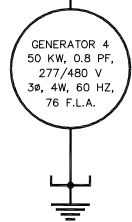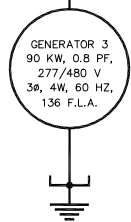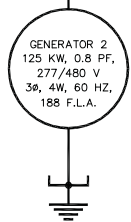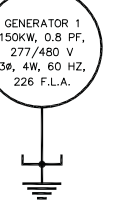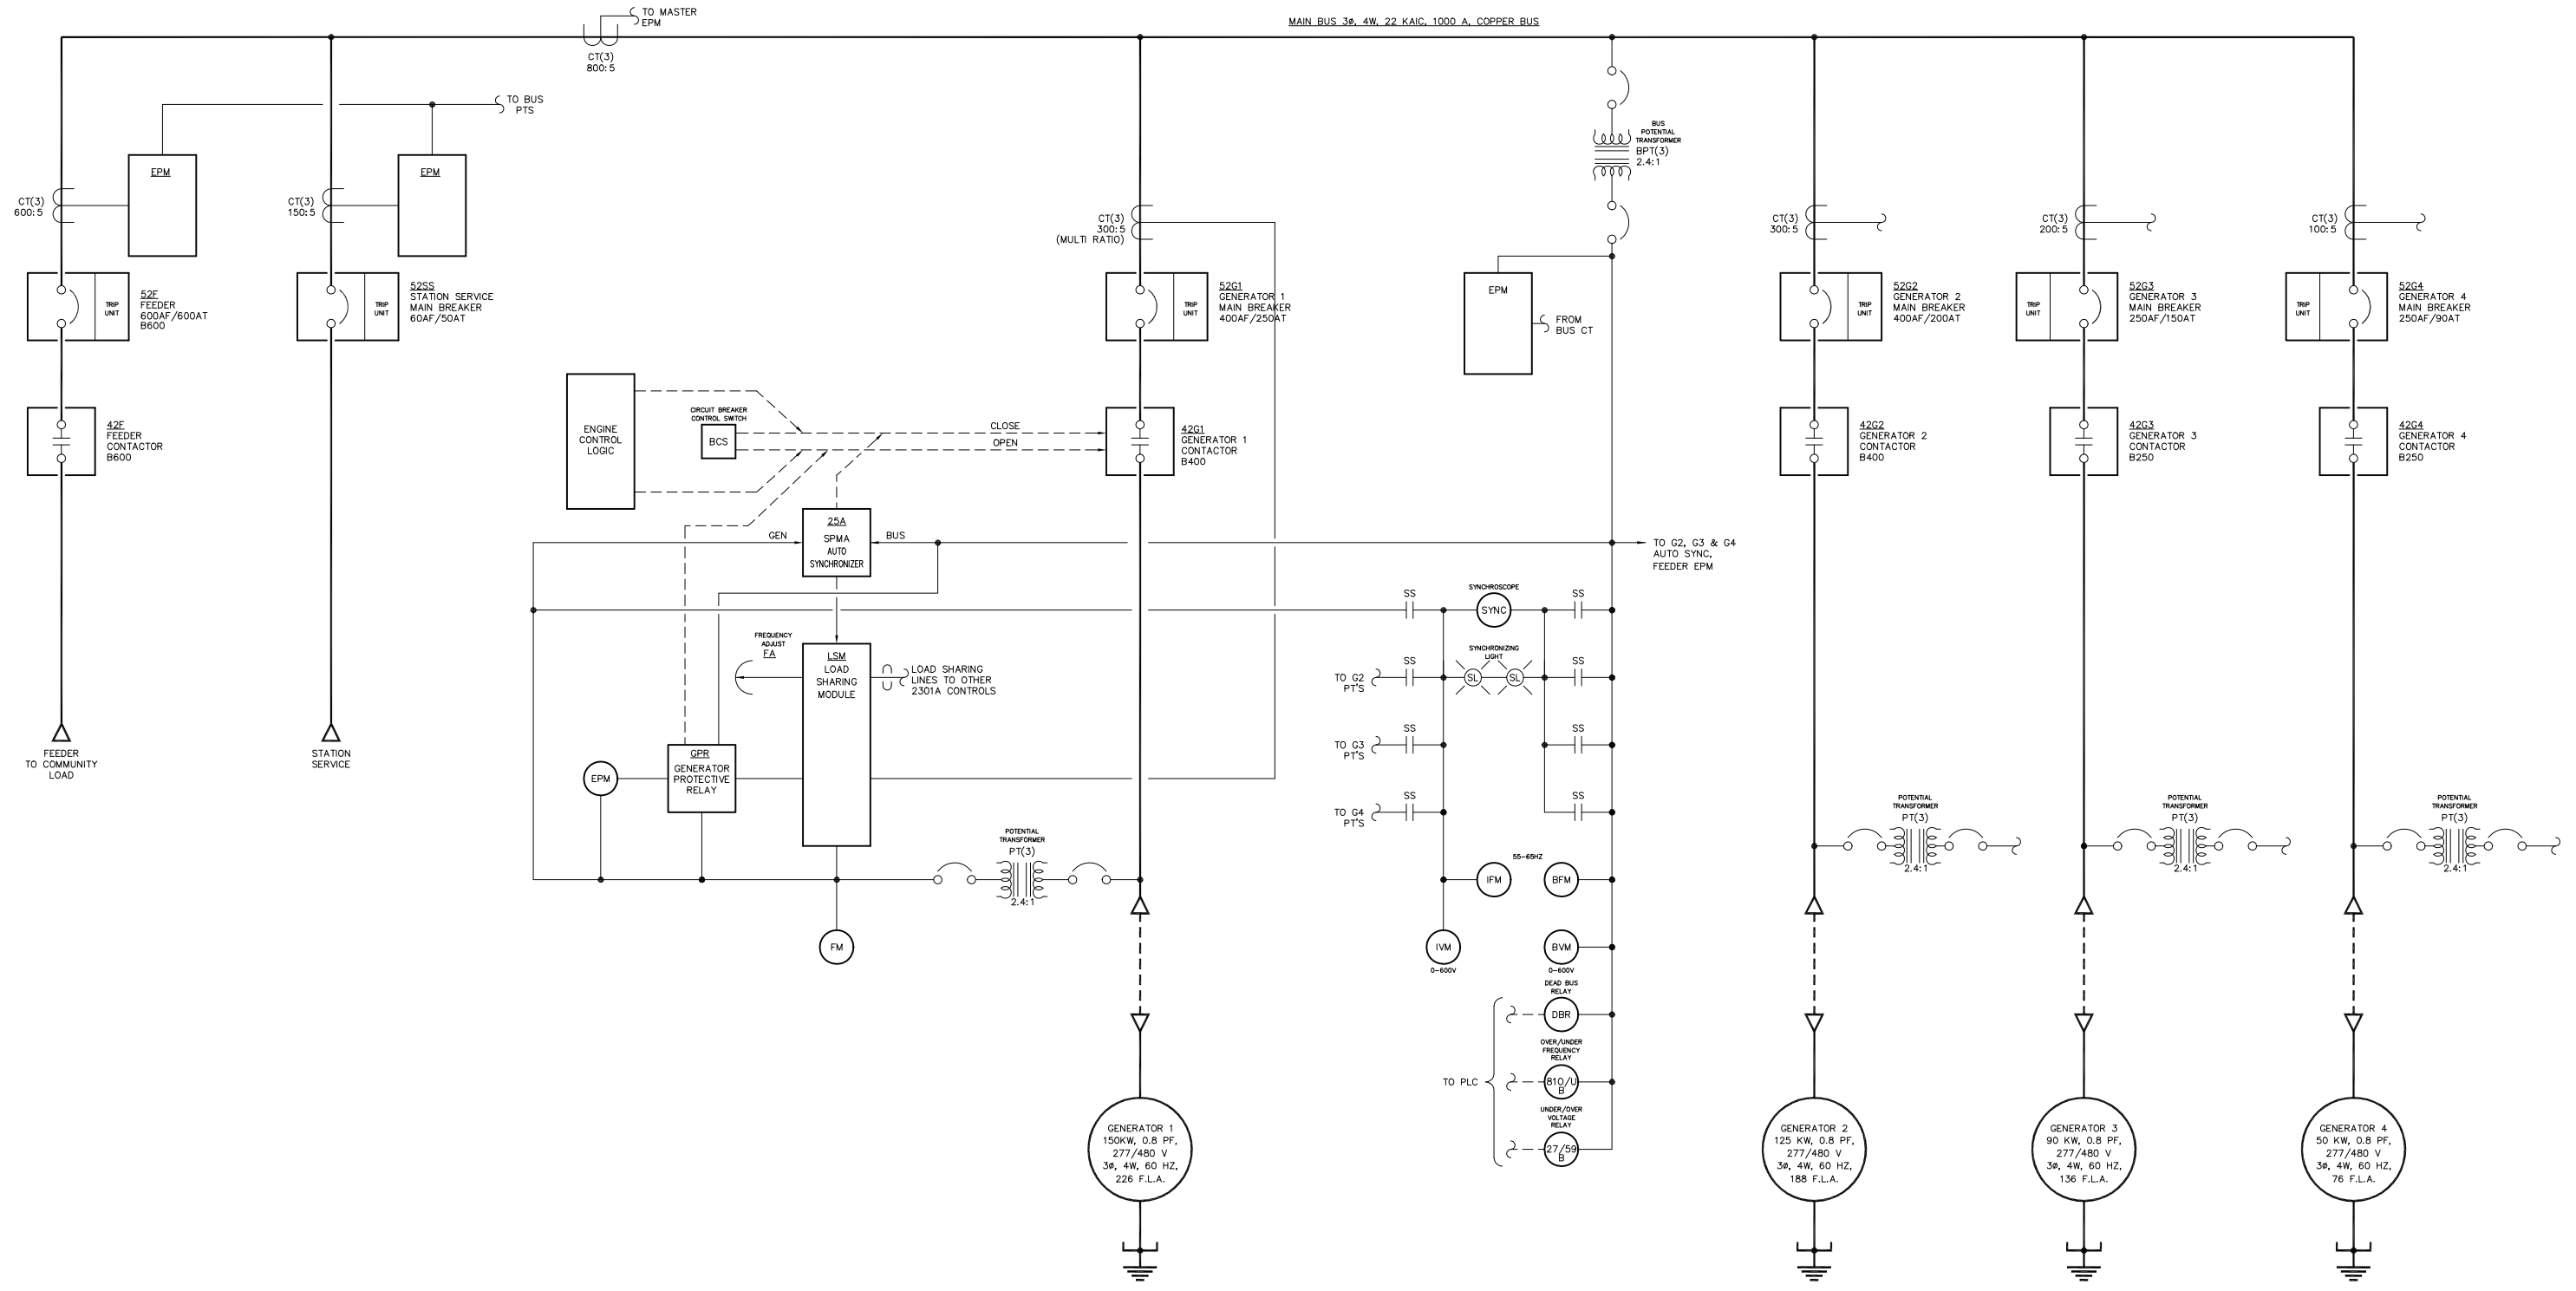

- NOTES:
1. ALL BREAKERS ARE MANUALLY OPERATED NON-DRAWOUT TYPE
 2. ALL BREAKERS ARE G.E. SPECTRA TYPE, LOW VOLTAGE MOLDED CASE CIRCUIT BREAKERS.
 3. GENERATORS 2 , 3 & 4 SIMILAR TO GENERATOR 1

NOTICE
 THE DRAWINGS, INFORMATION AND SUBJECT MATTER HEREOF ARE THE CONFIDENTIAL SOLE AND EXCLUSIVE PROPERTY OF CONTROLLED POWER, INC., AND ARE NOT TO BE COPIED, REPRODUCED OR USED IN ANY MANNER FOR ANY PURPOSE WHATSOEVER WITHOUT WRITTEN CONSENT OR DIRECTION.

B	09-05-03	SHOP AS BUILT	CMD
A	06-10-03	SUBMITTAL	CMD
REV.	DATE	DESCRIPTION	BY

PURCHASE ORDER No. 7086 CONTROLLED POWER JOB No. 5354

TITLE: SINGLE LINE, SCHEMATIC DIAGRAM

CPI DWG No. 11235


SCALE: NONE DATE: 06-10-03 DWN. BY: CMD

DWG. No: 11235 SHEET: 1 OF 1 CKD. BY: JMD

JOB: CHIGNIK LAKE



The Lake and Peninsula School District
 101 Jensen Drive
 P.O. Box 498
 King Salmon, Alaska 99613
 Phone (907) 246-4280/Fax (907) 246-4473

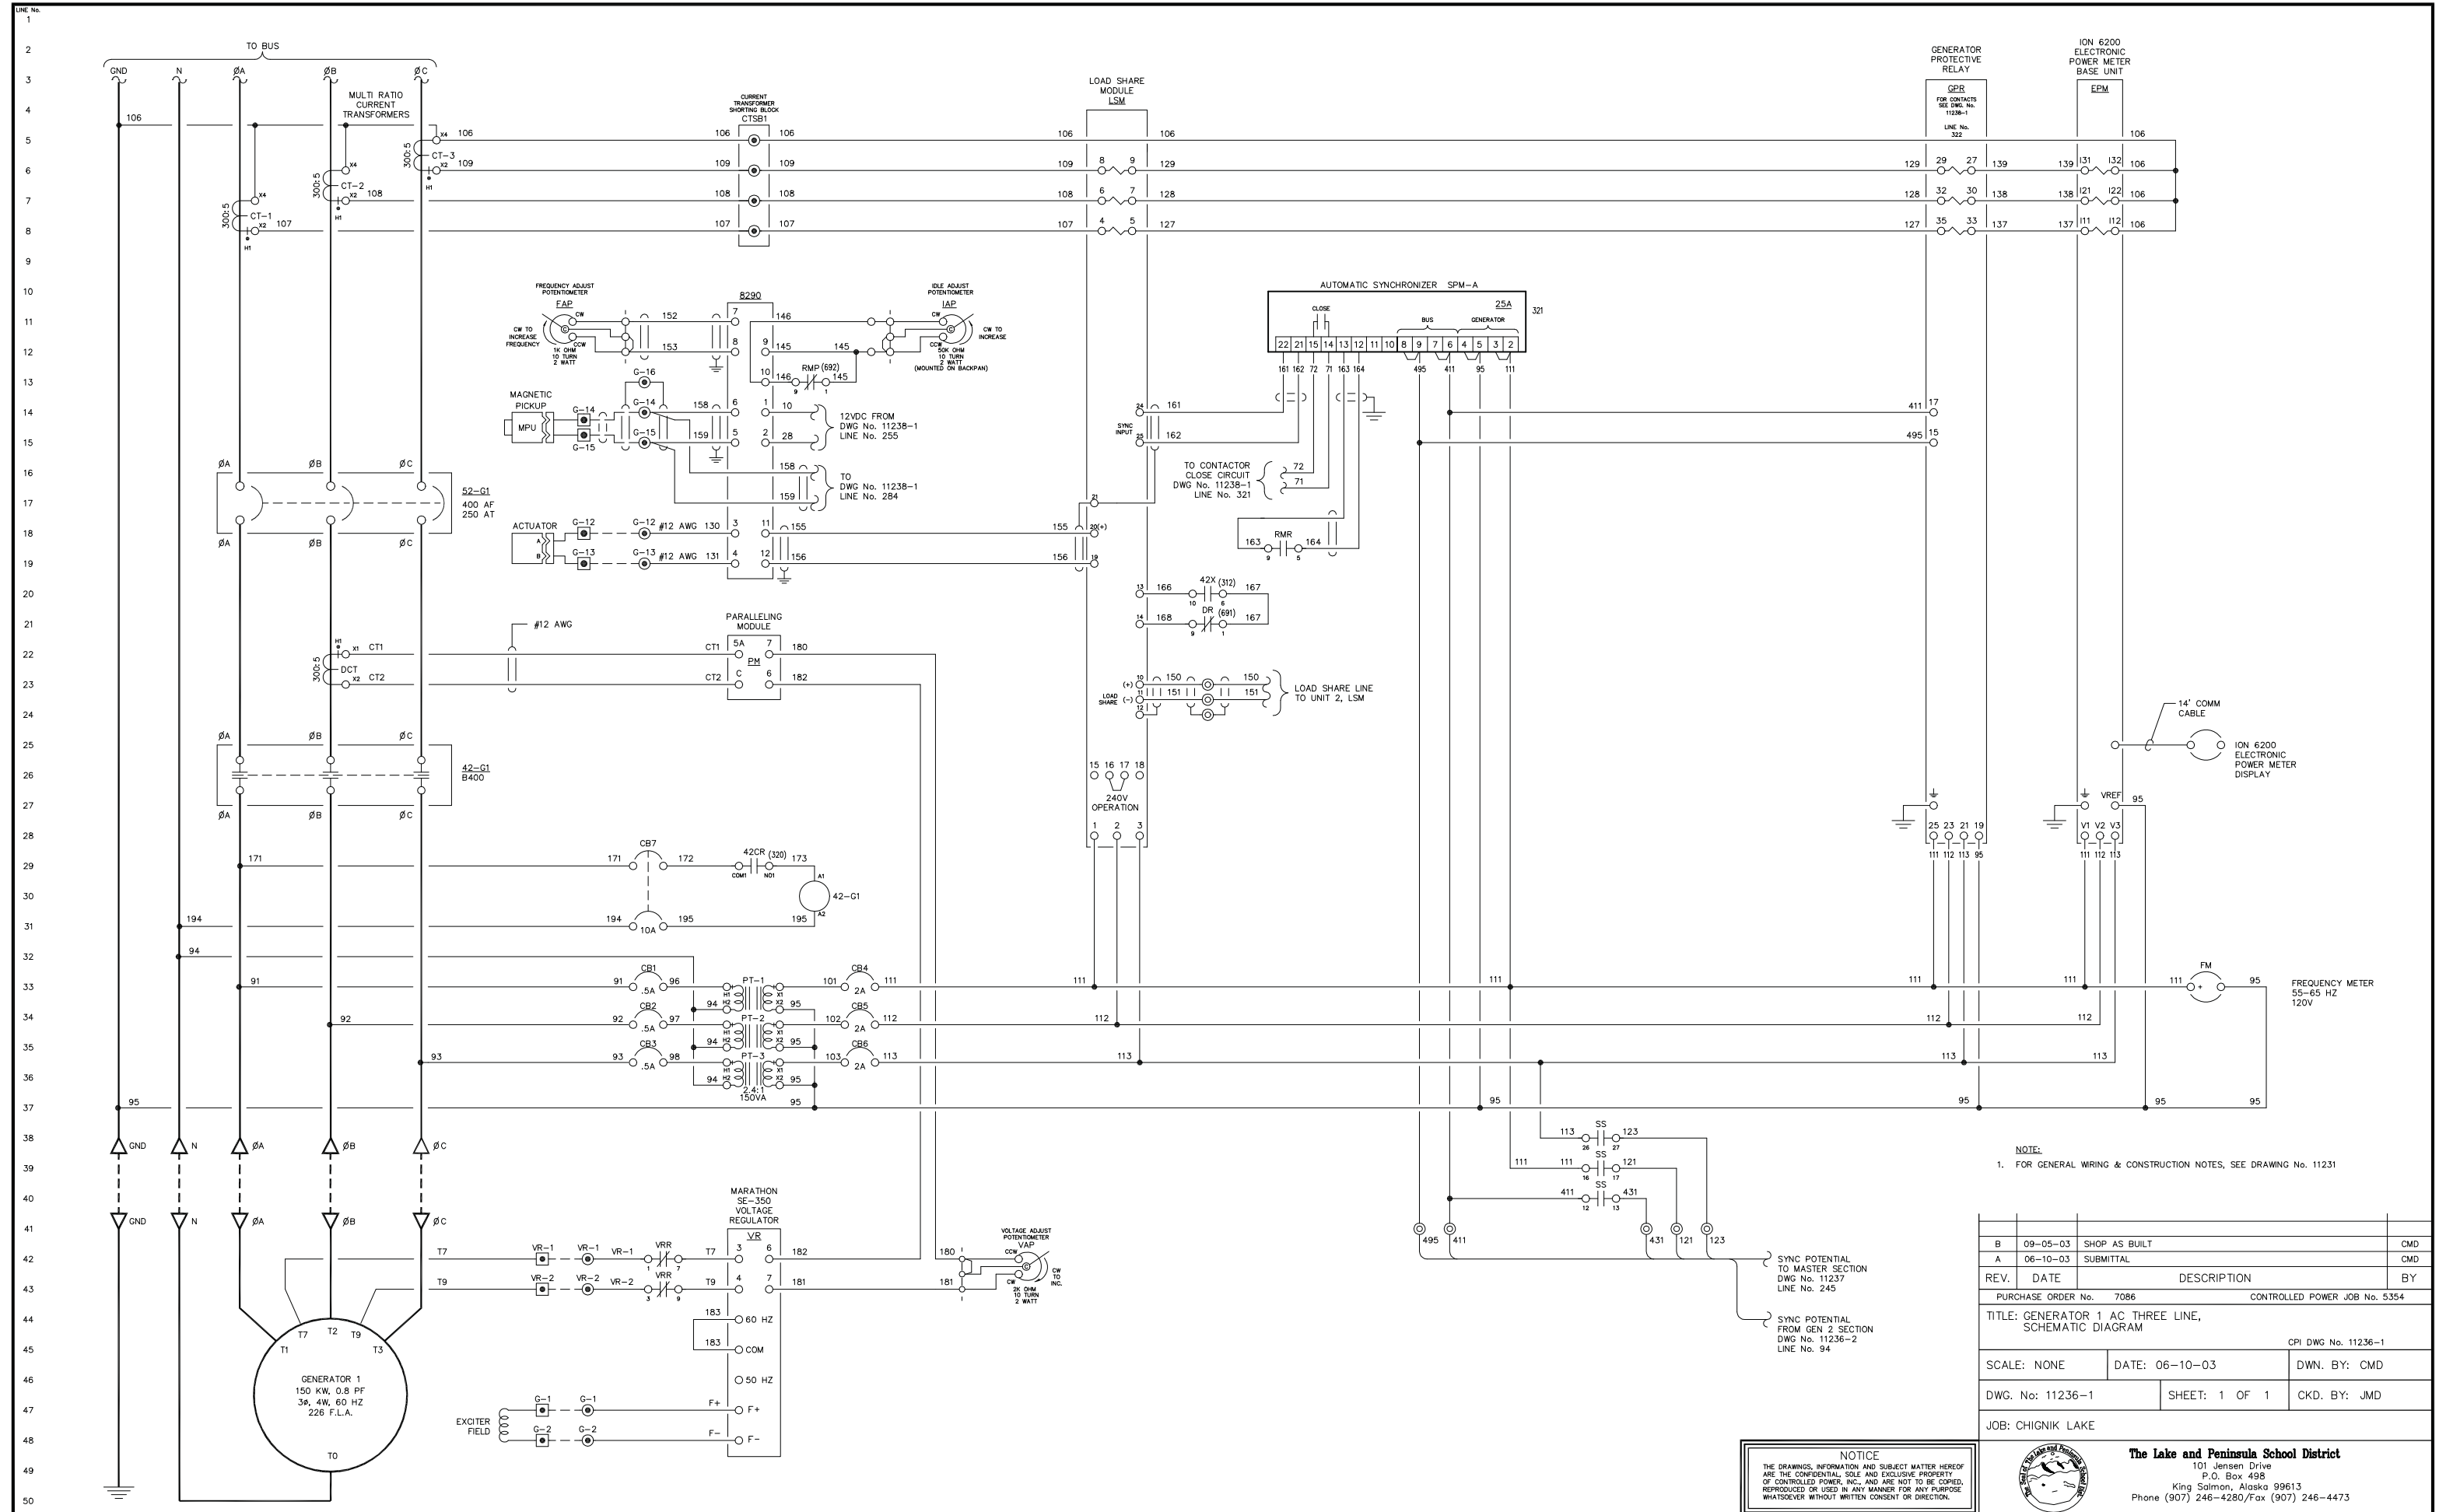

NOTE:
 1. FOR GENERAL WRING & CONSTRUCTION NOTES, SEE DRAWING No. 11231


SYNC POTENTIAL TO MASTER SECTION DWG No. 11237 LINE No. 245
 SYNC POTENTIAL FROM GEN 2 SECTION DWG No. 11236-2 LINE No. 94

B	09-05-03	SHOP AS BUILT	CMD
A	06-10-03	SUBMITTAL	CMD
REV.	DATE	DESCRIPTION	BY
PURCHASE ORDER No. 7086		CONTROLLED POWER JOB No. 5354	
TITLE: GENERATOR 1 AC THREE LINE, SCHEMATIC DIAGRAM			
SCALE: NONE		DATE: 06-10-03	DWN. BY: CMD
DWG. No: 11236-1		SHEET: 1 OF 1	CKD. BY: JMD
JOB: CHIGNIK LAKE			

NOTICE
 THE DRAWINGS, INFORMATION AND SUBJECT MATTER HEREOF ARE THE CONFIDENTIAL SOLE AND EXCLUSIVE PROPERTY OF CONTROLLED POWER, INC. AND ARE NOT TO BE COPIED, REPRODUCED OR USED IN ANY MANNER FOR ANY PURPOSE WHATSOEVER WITHOUT WRITTEN CONSENT OR DIRECTION.



The Lake and Peninsula School District
 101 Jensen Drive
 P.O. Box 498
 King Salmon, Alaska 99613
 Phone (907) 246-4280/Fax (907) 246-4473

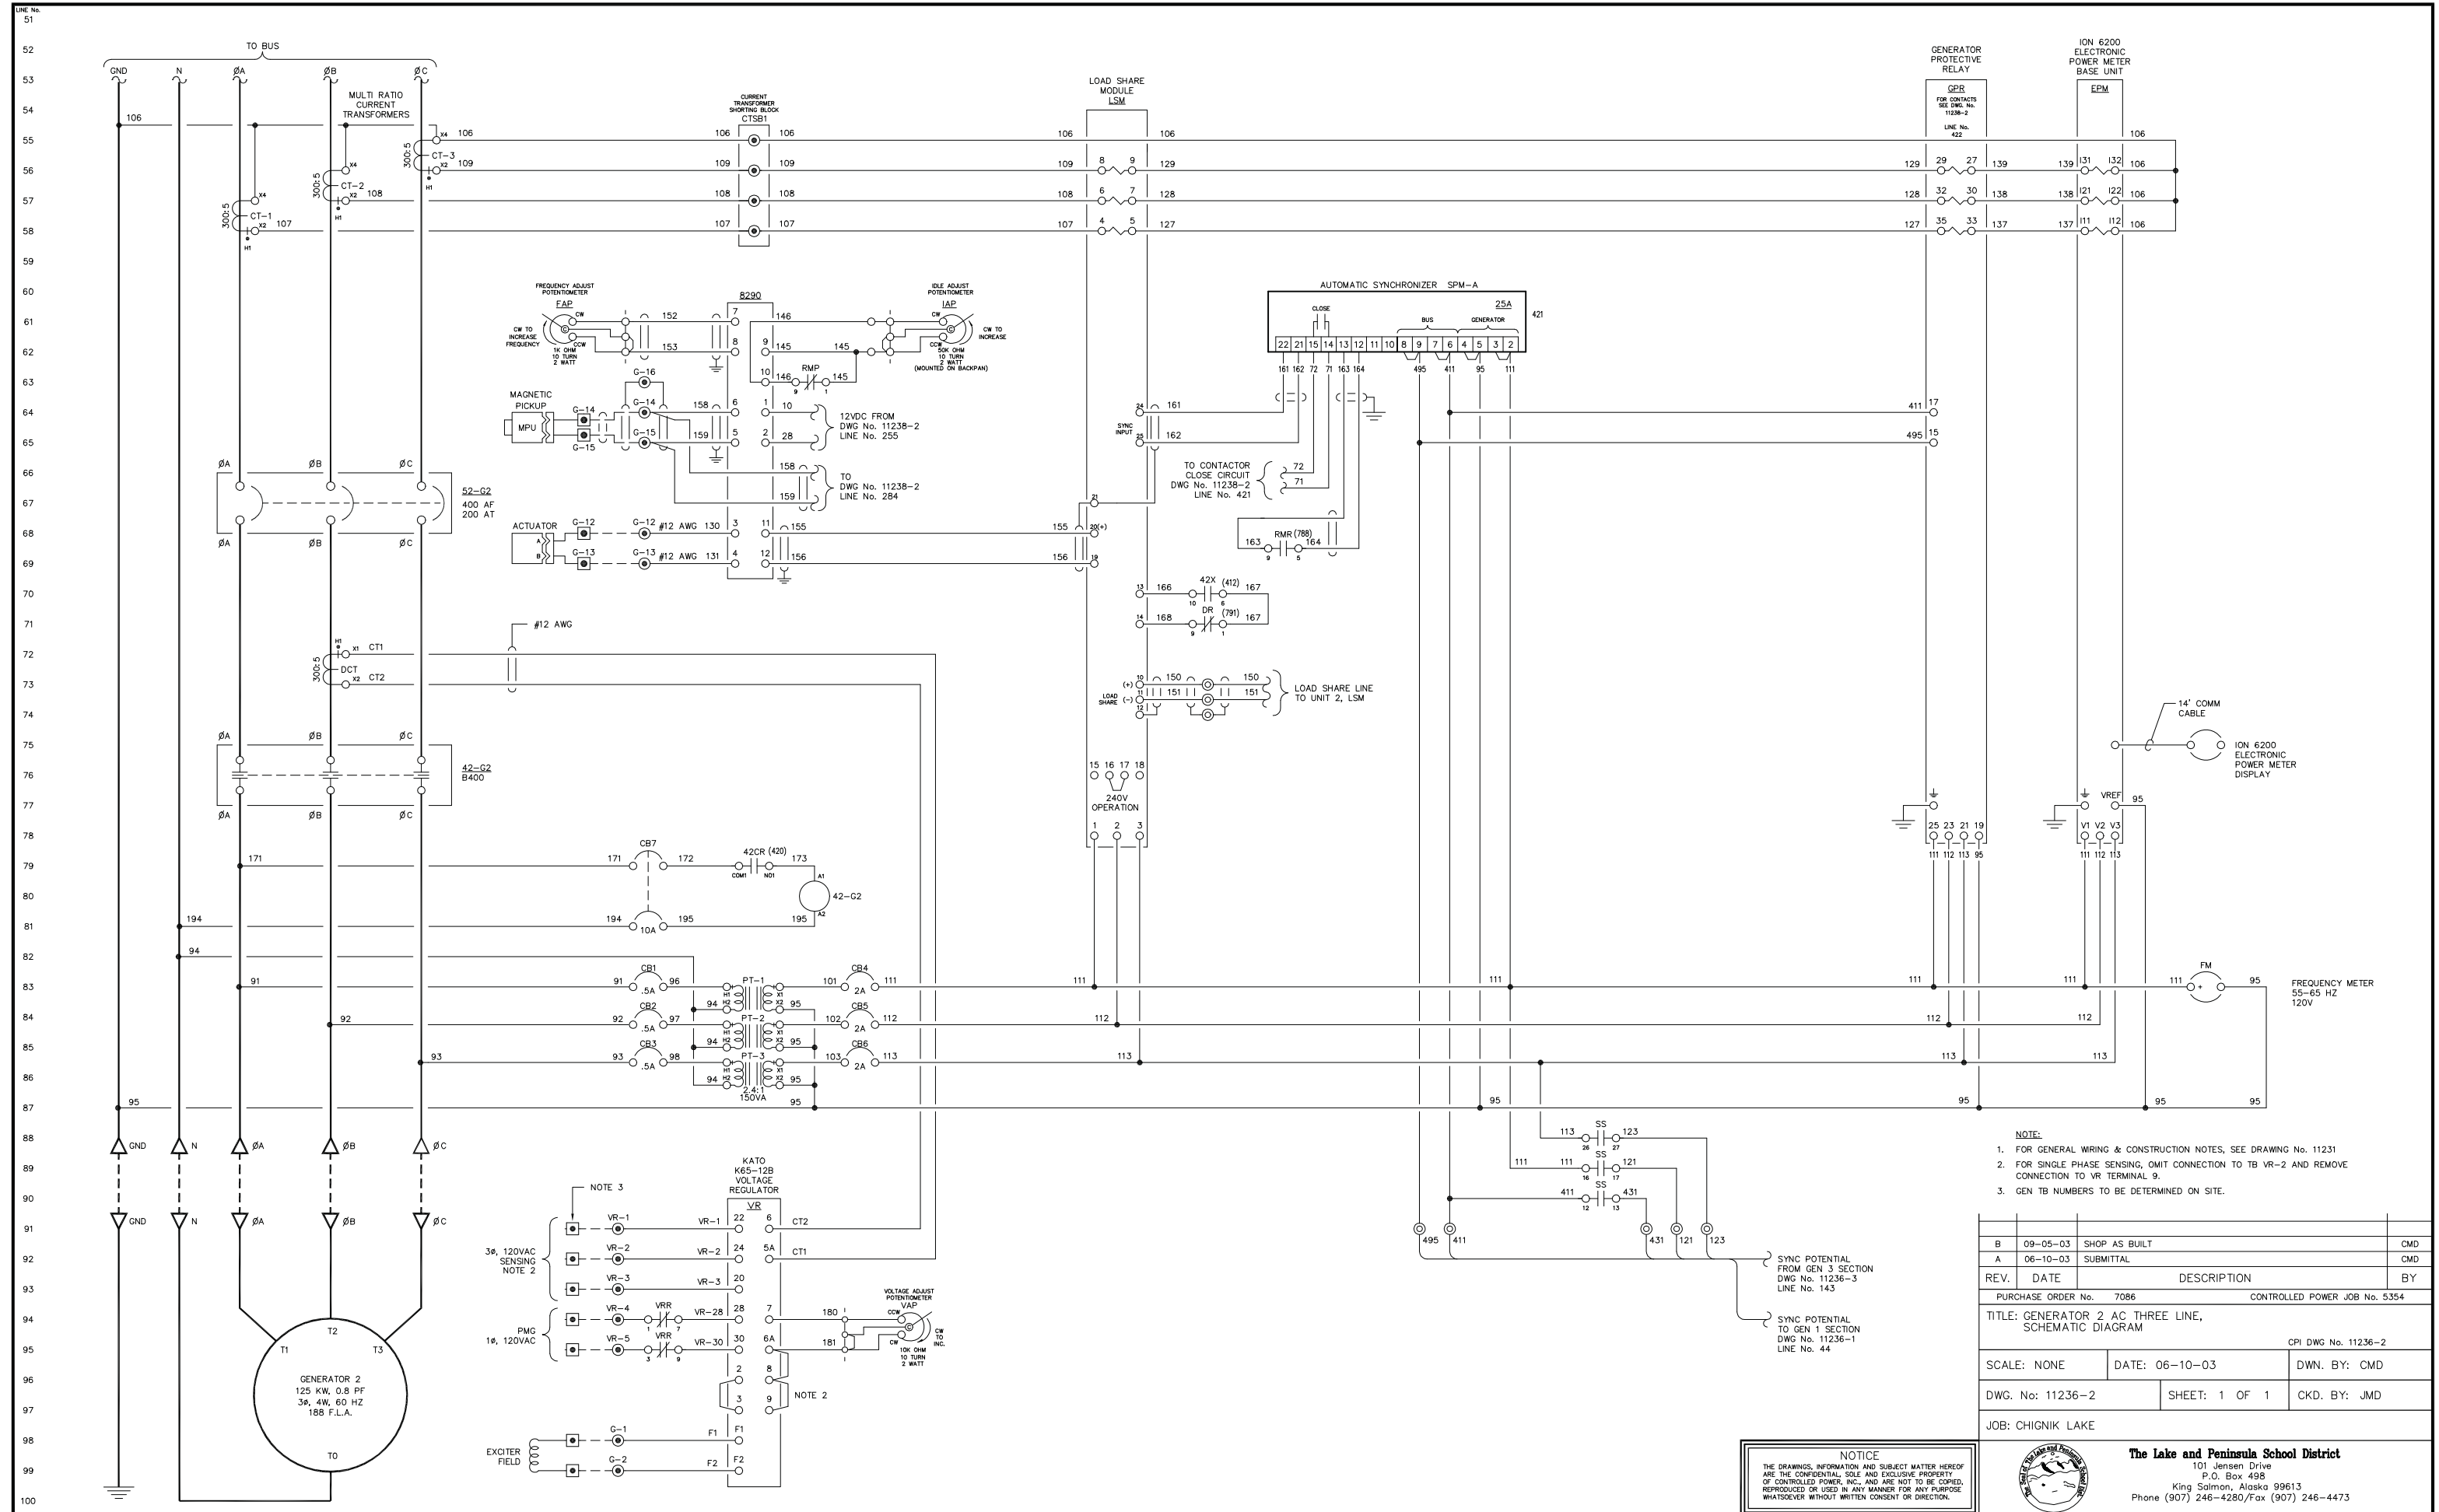


- NOTE:
- FOR GENERAL WIRING & CONSTRUCTION NOTES, SEE DRAWING No. 11231
 - FOR SINGLE PHASE SENSING, OMIT CONNECTION TO TB VR-2 AND REMOVE CONNECTION TO VR TERMINAL 9.
 - GEN TB NUMBERS TO BE DETERMINED ON SITE.

B	09-05-03	SHOP AS BUILT	CMD
A	06-10-03	SUBMITTAL	CMD
REV.	DATE	DESCRIPTION	BY
PURCHASE ORDER No. 7086		CONTROLLED POWER JOB No. 5354	
TITLE: GENERATOR 2 AC THREE LINE, SCHEMATIC DIAGRAM			
SCALE: NONE		DATE: 06-10-03	DWN. BY: CMD
DWG. No: 11236-2		SHEET: 1 OF 1	CKD. BY: JMD
JOB: CHIGNIK LAKE			

NOTICE
 THE DRAWINGS, INFORMATION AND SUBJECT MATTER HEREOF ARE THE CONFIDENTIAL SOLE AND EXCLUSIVE PROPERTY OF CONTROLLED POWER, INC. AND ARE NOT TO BE COPIED, REPRODUCED OR USED IN ANY MANNER FOR ANY PURPOSE WHATSOEVER WITHOUT WRITTEN CONSENT OR DIRECTION.



The Lake and Peninsula School District
 101 Jensen Drive
 P.O. Box 498
 King Salmon, Alaska 99613
 Phone (907) 246-4280/Fax (907) 246-4473

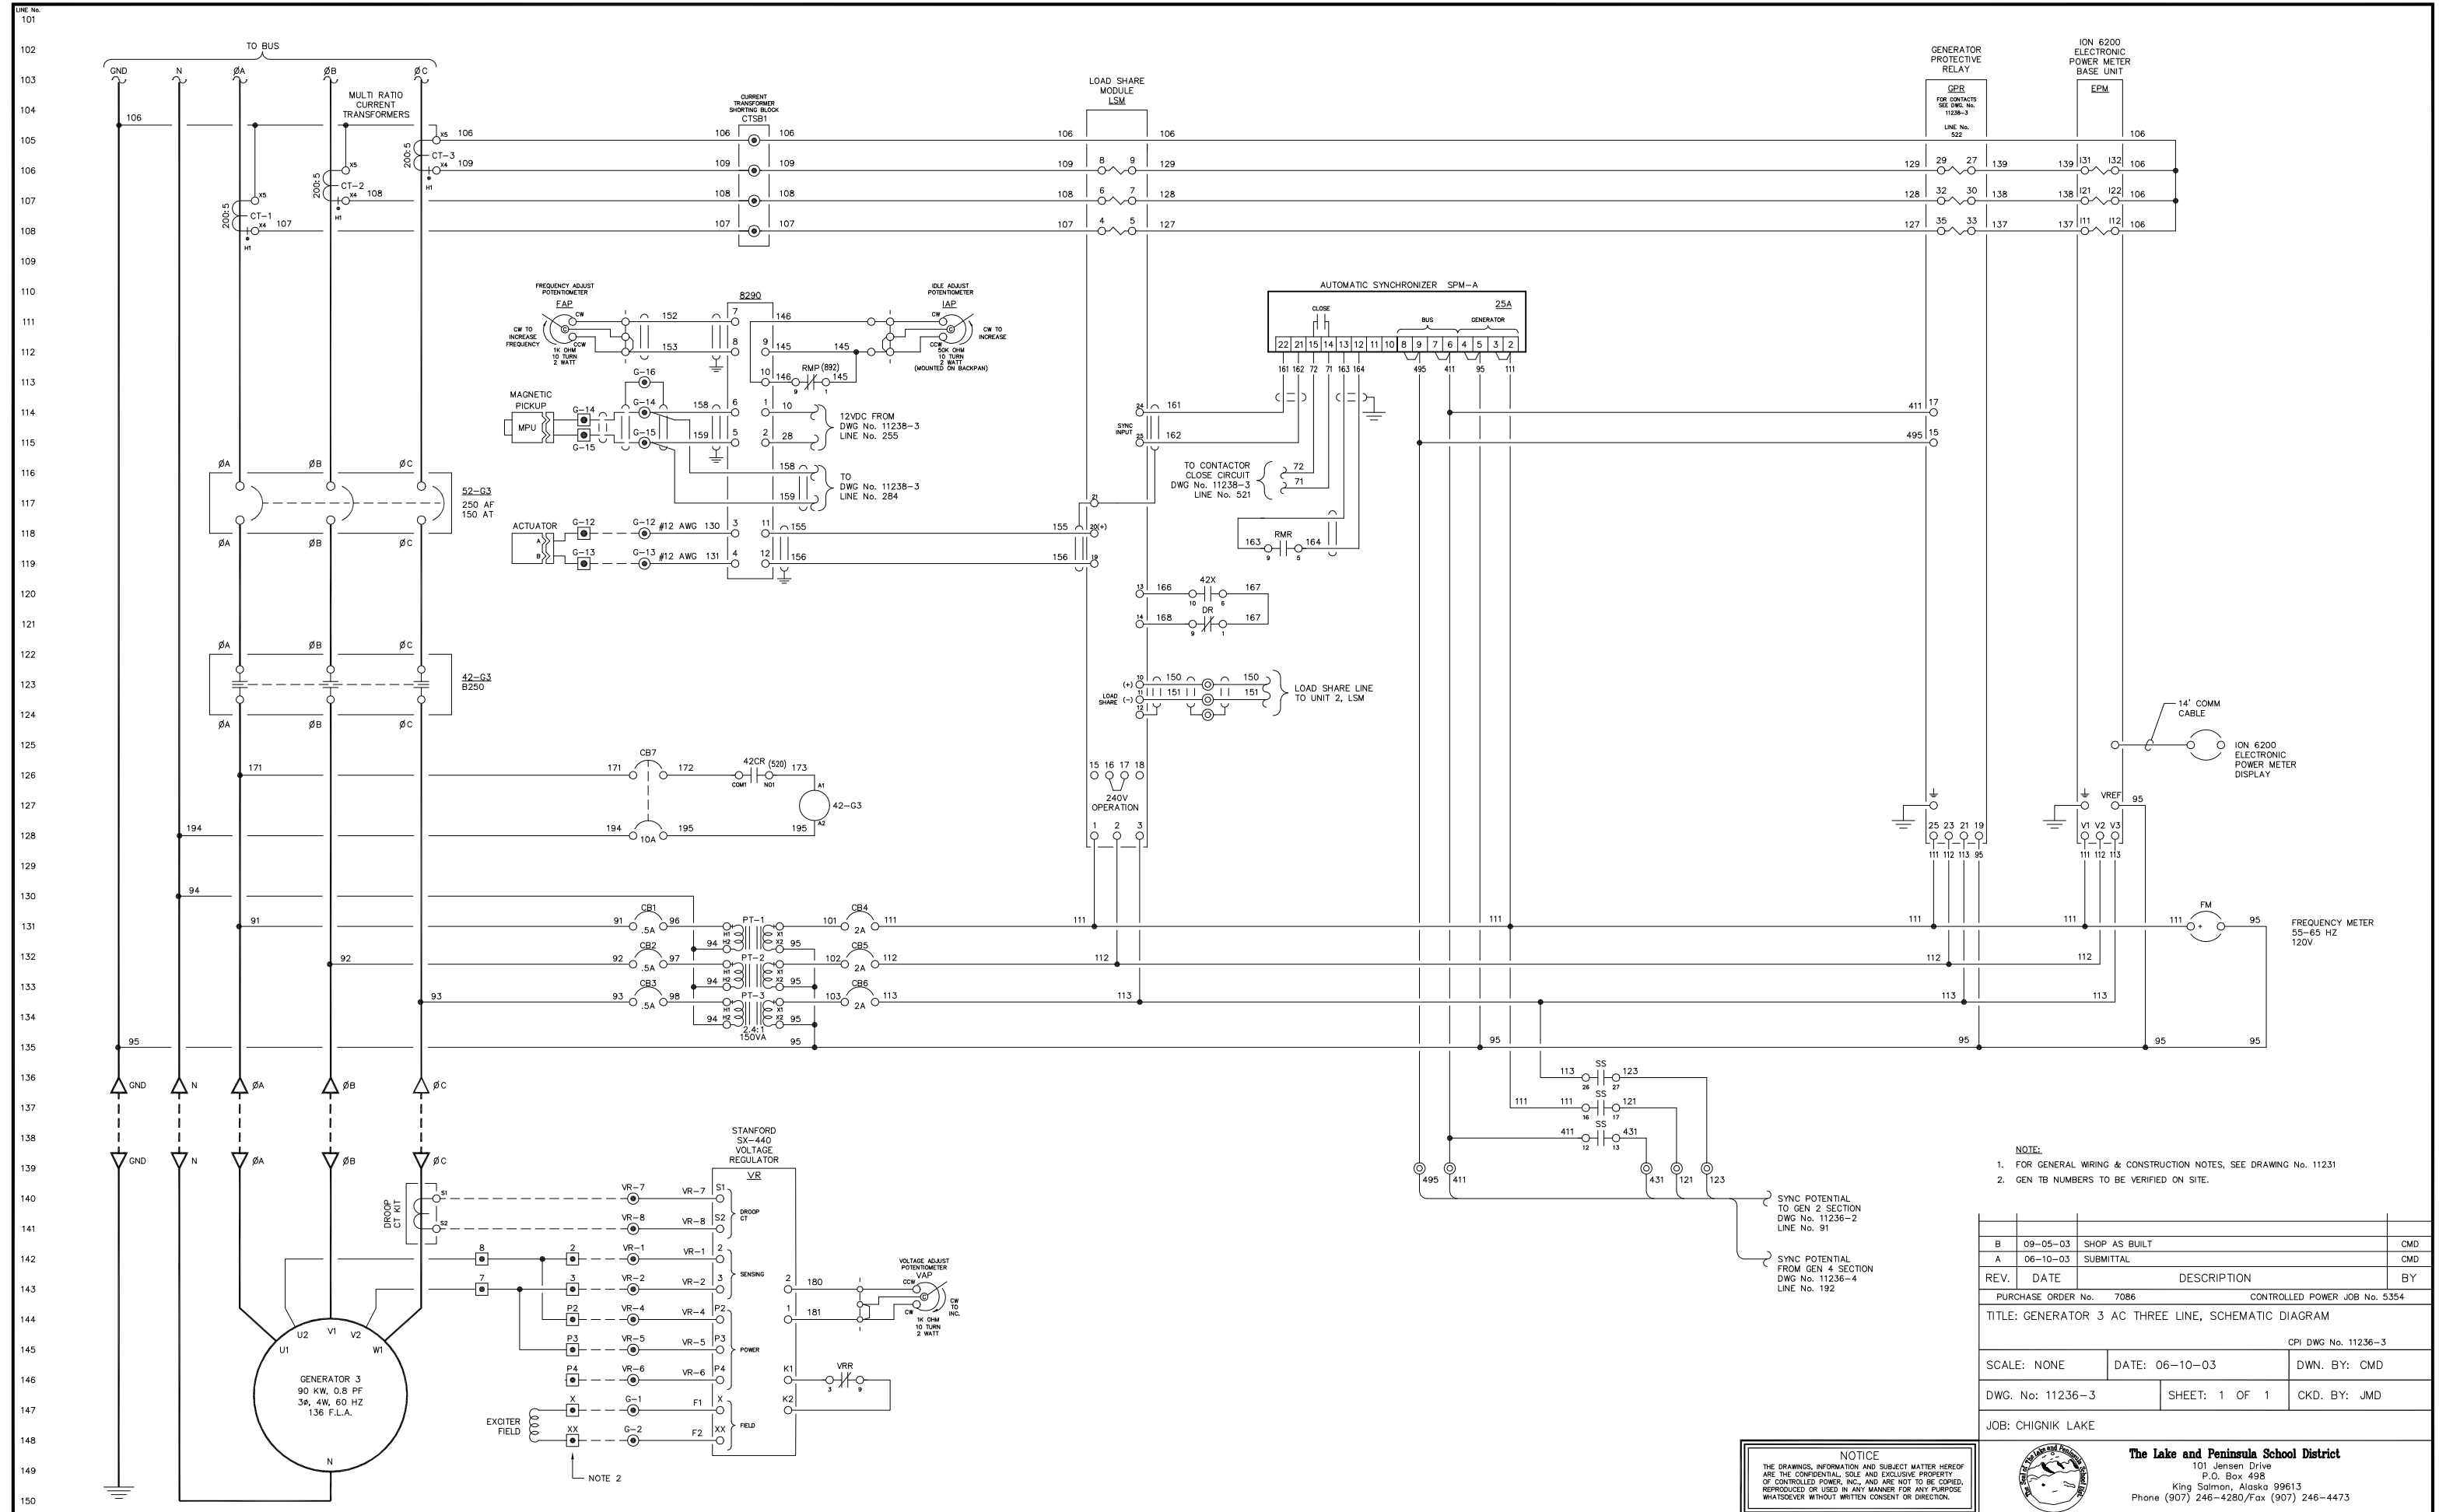


- NOTE:
- FOR GENERAL WRING & CONSTRUCTION NOTES, SEE DRAWING No. 11231
 - GEN TB NUMBERS TO BE VERIFIED ON SITE.

B	09-05-03	SHOP AS BUILT	CMD
A	06-10-03	SUBMITTAL	CMD
REV.	DATE	DESCRIPTION	BY
PURCHASE ORDER No. 7086		CONTROLLED POWER JOB No. 5354	
TITLE: GENERATOR 3 AC THREE LINE, SCHEMATIC DIAGRAM			
CPI DWG No. 11236-3			
SCALE: NONE	DATE: 06-10-03	DWN. BY: CMD	
DWG. No: 11236-3	SHEET: 1 OF 1	CKD. BY: JMD	
JOB: CHIGNIK LAKE			

NOTICE
 THE DRAWINGS, INFORMATION AND SUBJECT MATTER HEREOF ARE THE CONFIDENTIAL SOLE AND EXCLUSIVE PROPERTY OF CONTROLLED POWER, INC., AND ARE NOT TO BE COPIED, REPRODUCED OR USED IN ANY MANNER FOR ANY PURPOSE WHATSOEVER WITHOUT WRITTEN CONSENT OR DIRECTION.



The Lake and Peninsula School District
 101 Jensen Drive
 P.O. Box 498
 King Salmon, Alaska 99613
 Phone (907) 246-4280/Fax (907) 246-4473

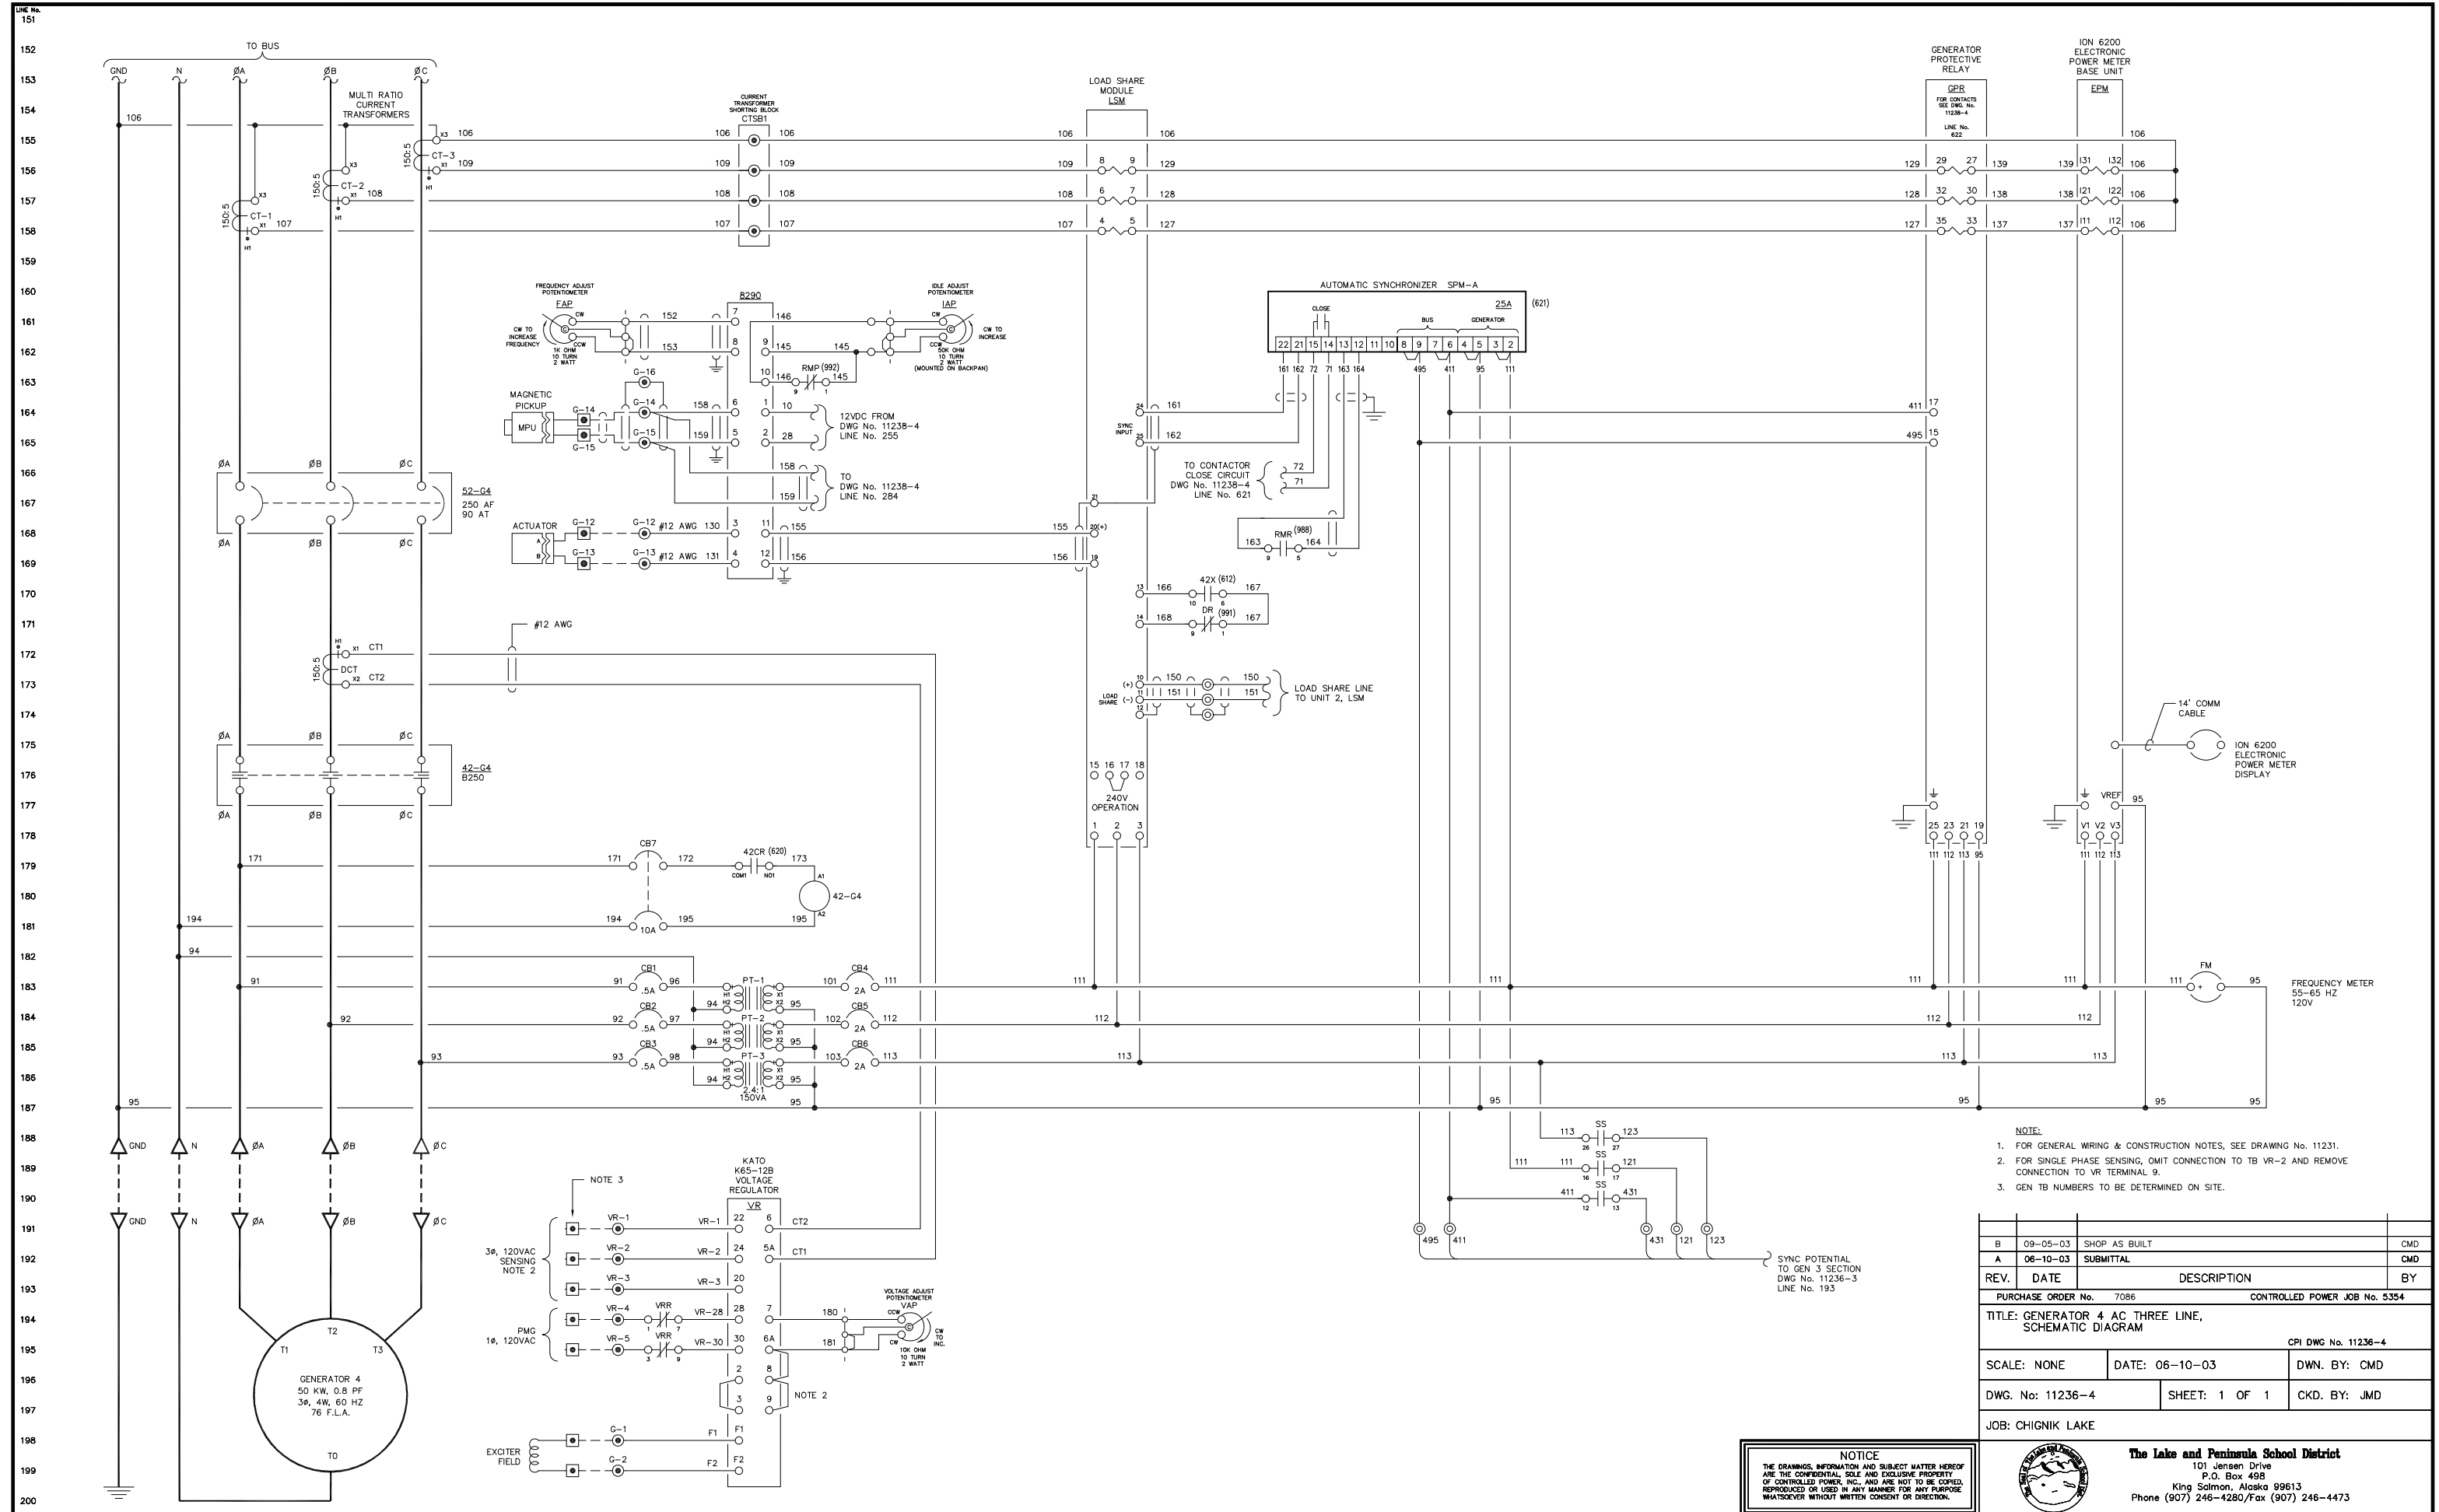


- NOTE:
- FOR GENERAL WIRING & CONSTRUCTION NOTES, SEE DRAWING No. 11231.
 - FOR SINGLE PHASE SENSING, OMIT CONNECTION TO TB VR-2 AND REMOVE CONNECTION TO VR TERMINAL 9.
 - GEN TB NUMBERS TO BE DETERMINED ON SITE.

B	09-05-03	SHOP AS BUILT	CMD
A	06-10-03	SUBMITTAL	CMD
REV.	DATE	DESCRIPTION	BY
PURCHASE ORDER No. 7086		CONTROLLED POWER JOB No. 5354	
TITLE: GENERATOR 4 AC THREE LINE, SCHEMATIC DIAGRAM			
SCALE: NONE		DATE: 06-10-03	DWN. BY: CMD
DWG. No: 11236-4		SHEET: 1 OF 1	CKD. BY: JMD
JOB: CHIGNIK LAKE			

NOTICE
 THE DRAWINGS, INFORMATION AND SUBJECT MATTER HEREOF ARE THE CONFIDENTIAL SOLE AND EXCLUSIVE PROPERTY OF CONTROLLED POWER, INC. AND ARE NOT TO BE COPIED, REPRODUCED OR USED IN ANY MANNER FOR ANY PURPOSE WHATSOEVER WITHOUT WRITTEN CONSENT OR DIRECTION.

The Lake and Peninsula School District
 101 Jensen Drive
 P.O. Box 498
 King Salmon, Alaska 99613
 Phone (907) 246-4280/Fax (907) 246-4473

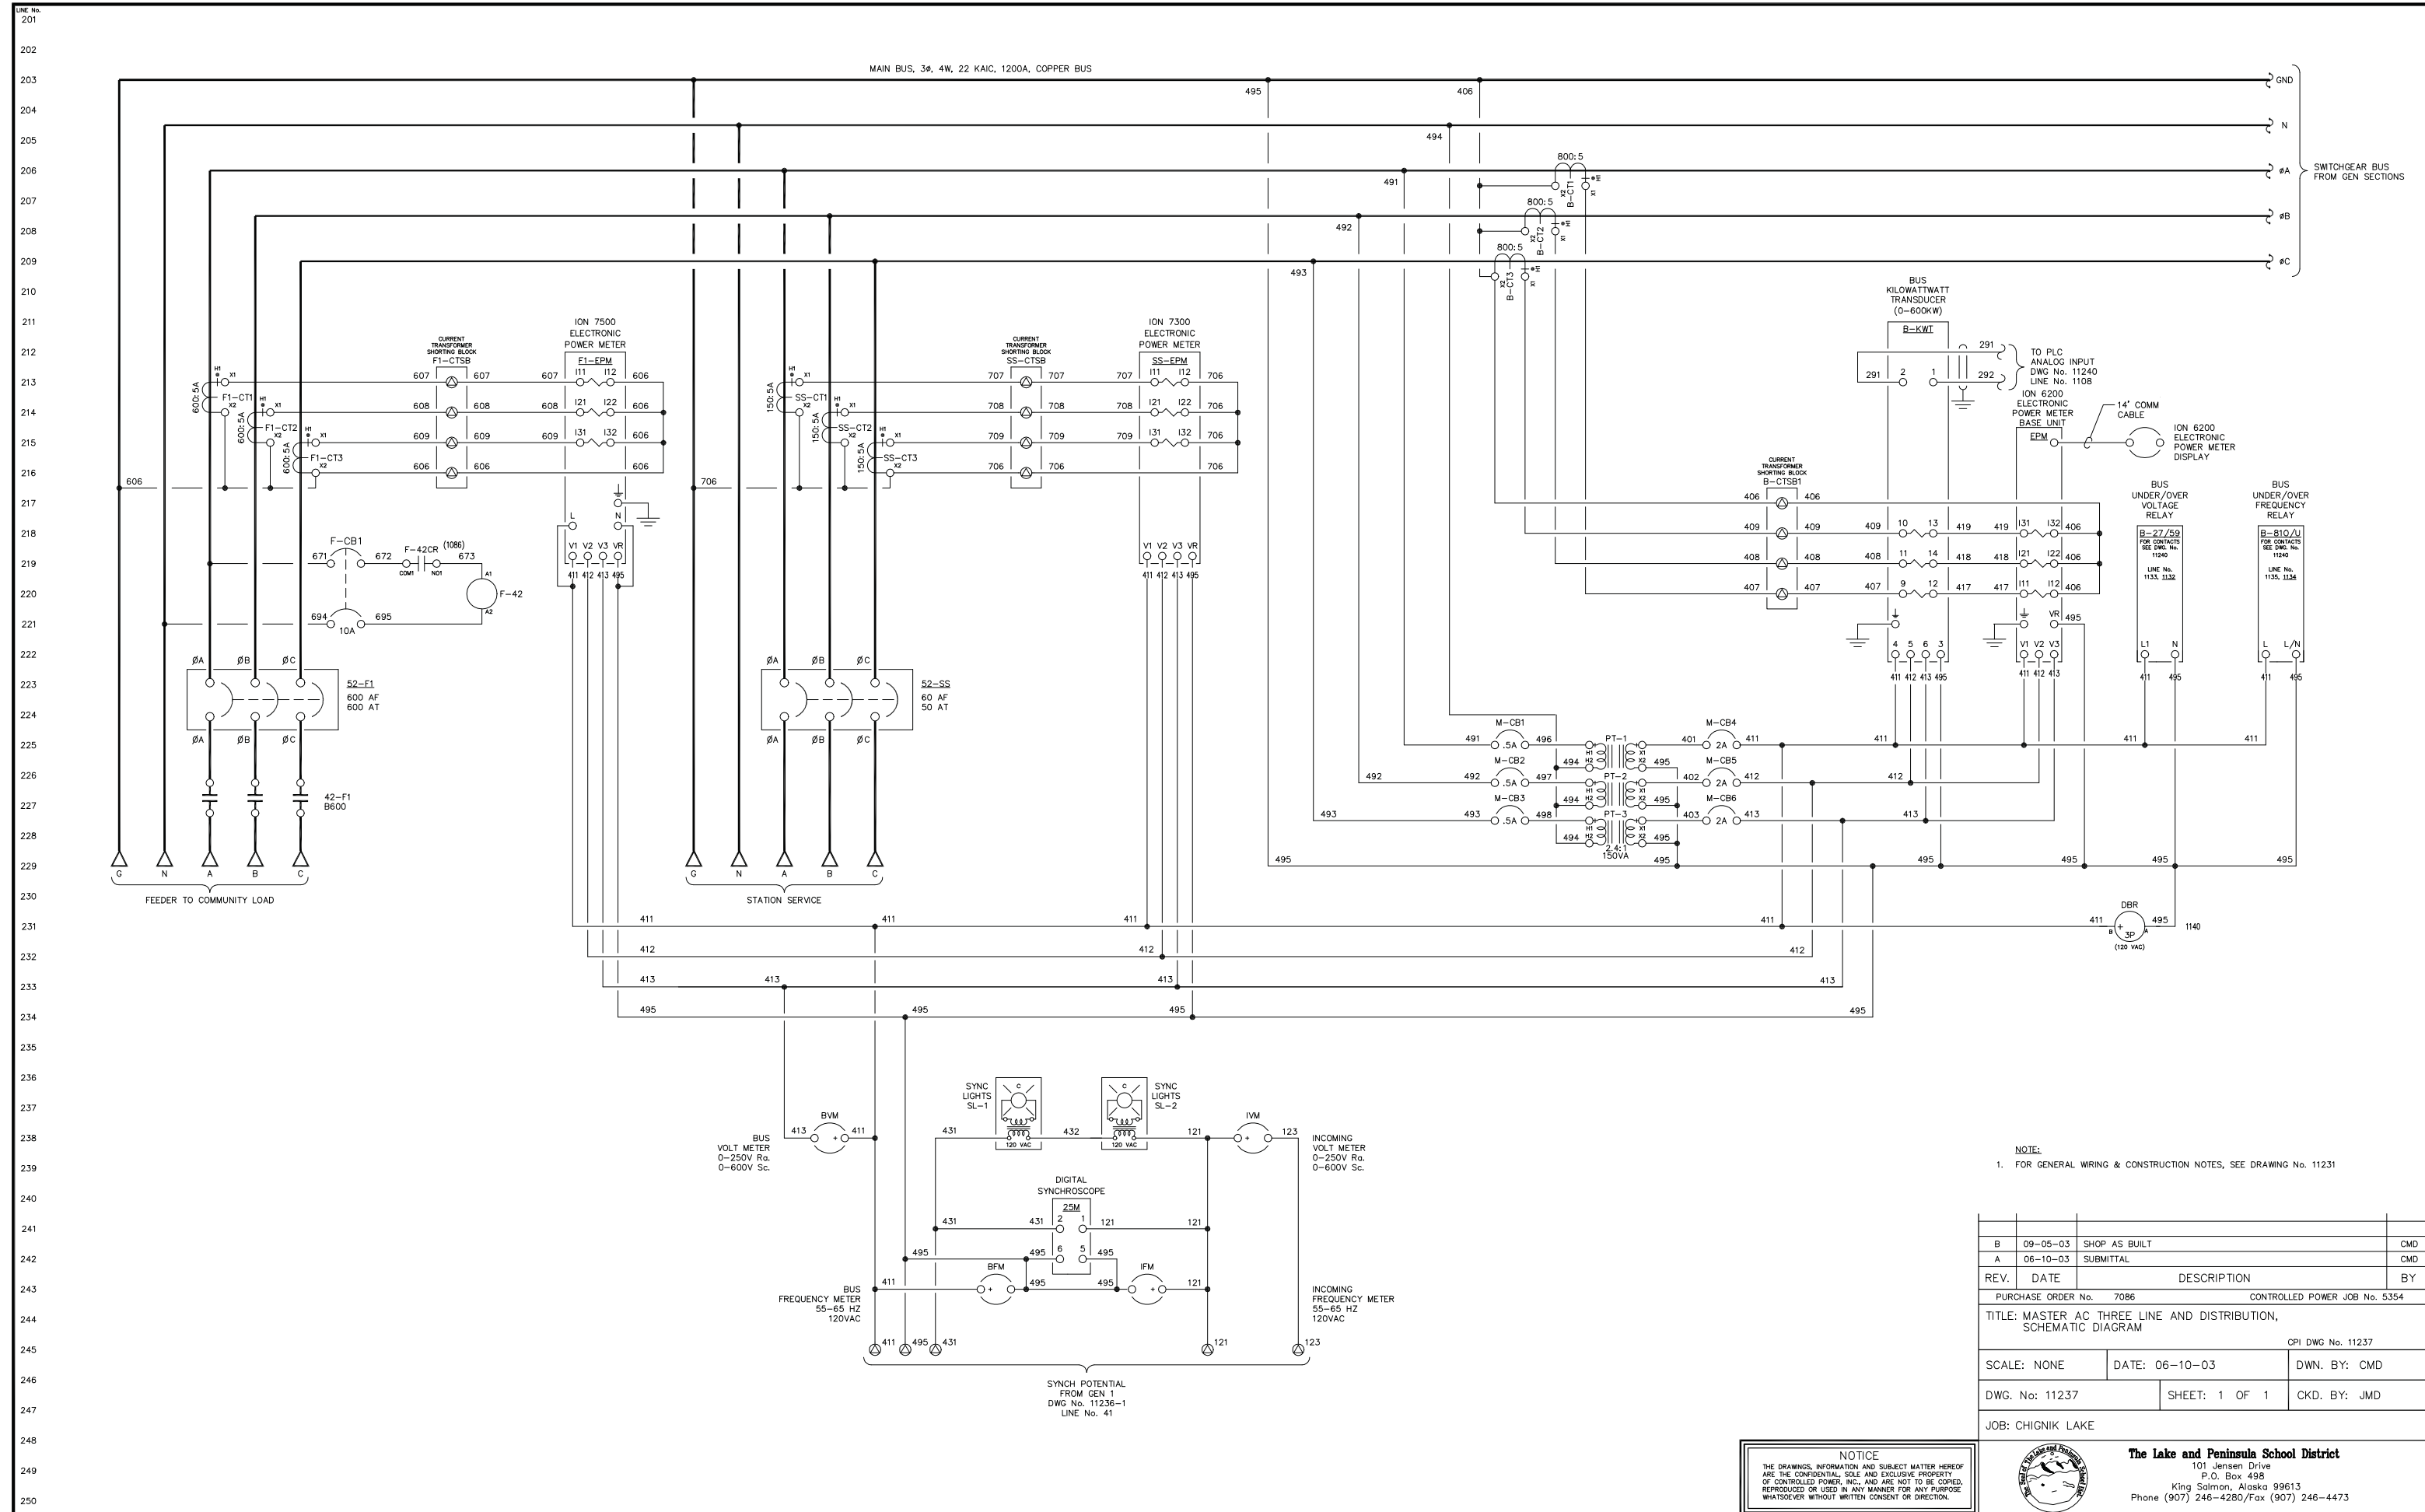



NOTE:
1. FOR GENERAL WIRING & CONSTRUCTION NOTES, SEE DRAWING No. 11231

B	09-05-03	SHOP AS BUILT	CMD
A	06-10-03	SUBMITTAL	CMD
REV.	DATE	DESCRIPTION	BY
PURCHASE ORDER No. 7086		CONTROLLED POWER JOB No. 5354	
TITLE: MASTER AC THREE LINE AND DISTRIBUTION, SCHEMATIC DIAGRAM			
CPI DWG No. 11237			
SCALE: NONE	DATE: 06-10-03	DWN. BY: CMD	
DWG. No: 11237	SHEET: 1 OF 1	CKD. BY: JMD	
JOB: CHIGNIK LAKE			



NOTICE
THE DRAWINGS, INFORMATION AND SUBJECT MATTER HEREOF ARE THE CONFIDENTIAL SOLE AND EXCLUSIVE PROPERTY OF CONTROLLED POWER, INC. AND ARE NOT TO BE COPIED, REPRODUCED OR USED IN ANY MANNER FOR ANY PURPOSE WHATSOEVER WITHOUT WRITTEN CONSENT OR DIRECTION.







The Lake and Peninsula School District
101 Jensen Drive
P.O. Box 498
King Salmon, Alaska 99613
Phone (907) 246-4280/Fax (907) 246-4473

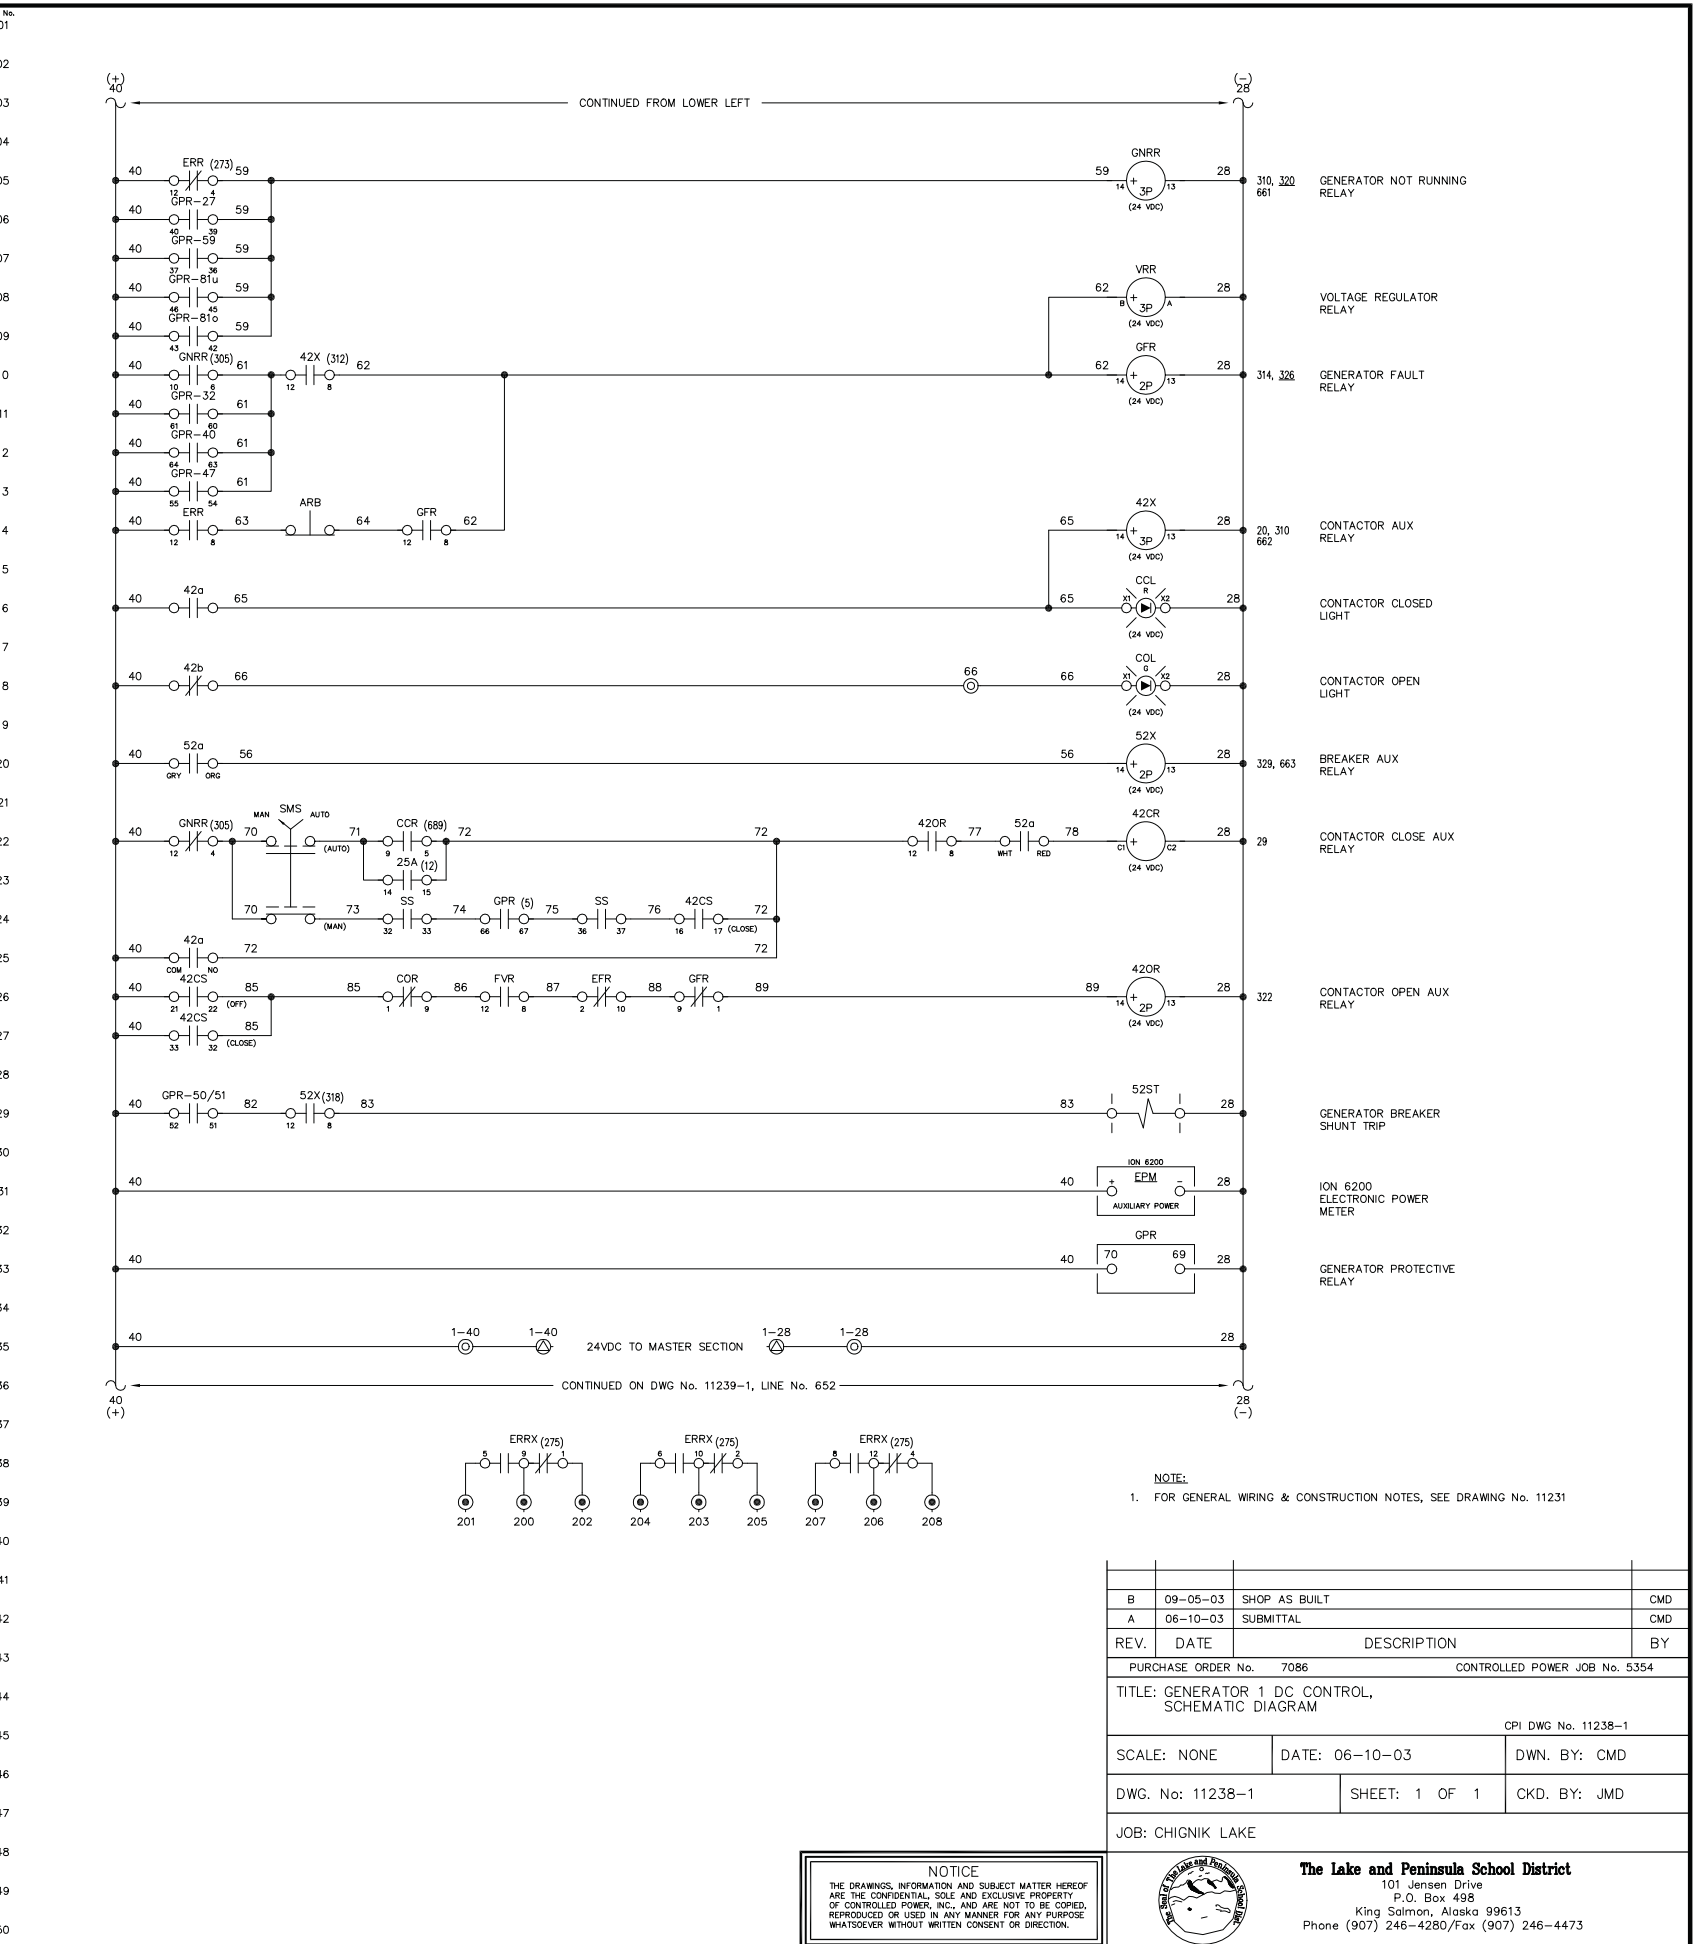
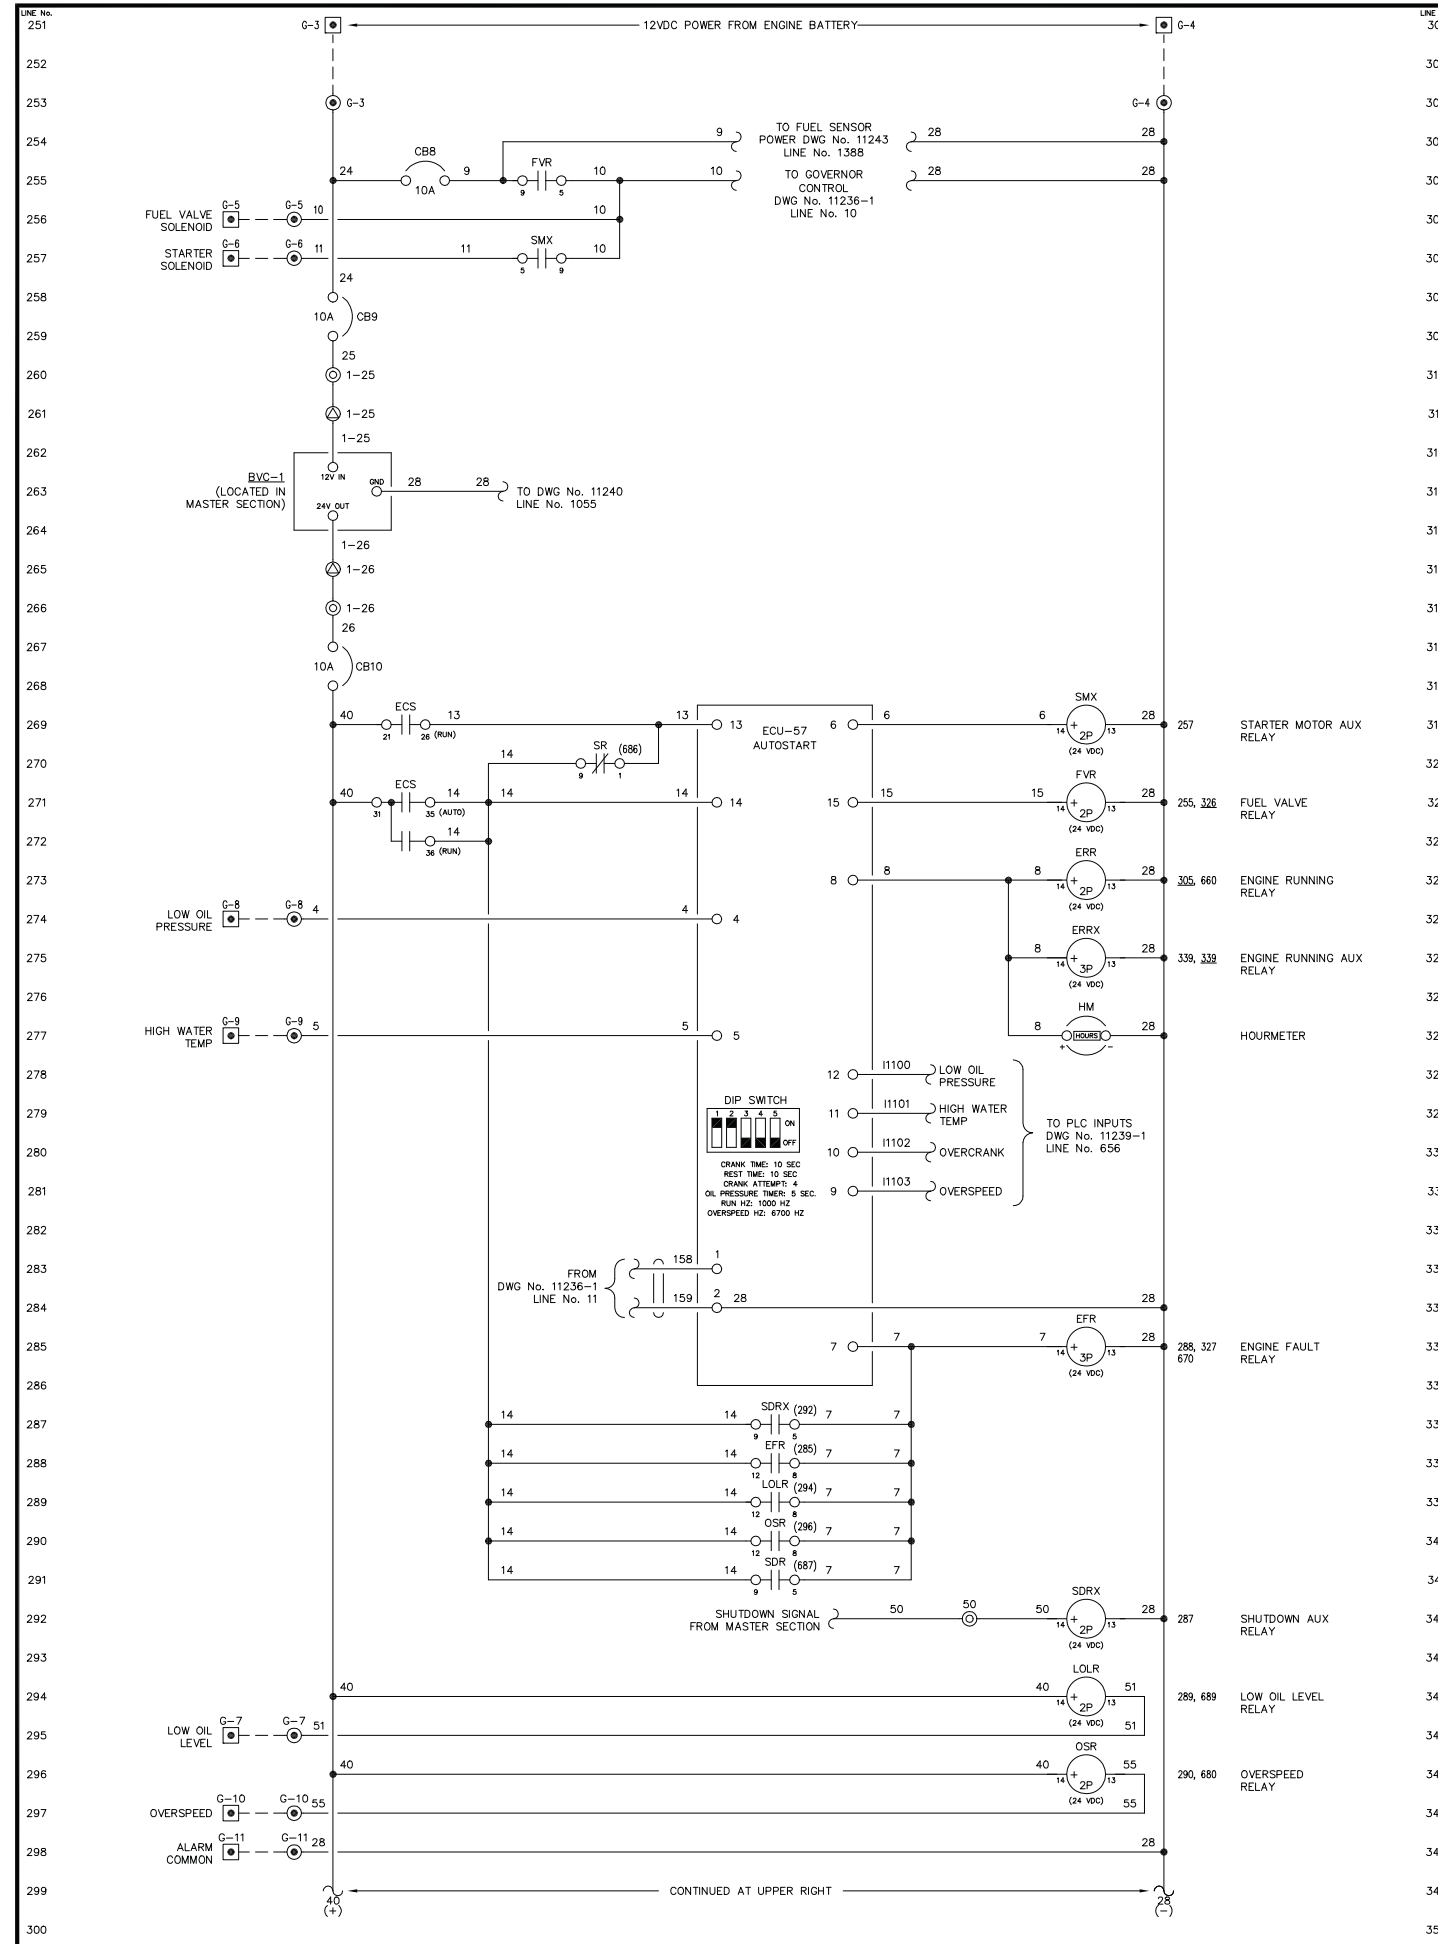





B	09-05-03	SHOP AS BUILT	CMD
A	06-10-03	SUBMITTAL	CMD
REV.	DATE	DESCRIPTION	BY
PURCHASE ORDER No. 7086		CONTROLLED POWER JOB No. 5354	
TITLE: GENERATOR 1 DC CONTROL, SCHEMATIC DIAGRAM			
SCALE: NONE		DATE: 06-10-03	DWN. BY: CMD
DWG. No: 11238-1		SHEET: 1 OF 1	CKD. BY: JMD
JOB: CHIGNIK LAKE			
		The Lake and Peninsula School District 101 Jensen Drive P.O. Box 498 King Salmon, Alaska 99613 Phone (907) 246-4280/Fax (907) 246-4473	
		Plot date: 2003/9/17 - 10:01	

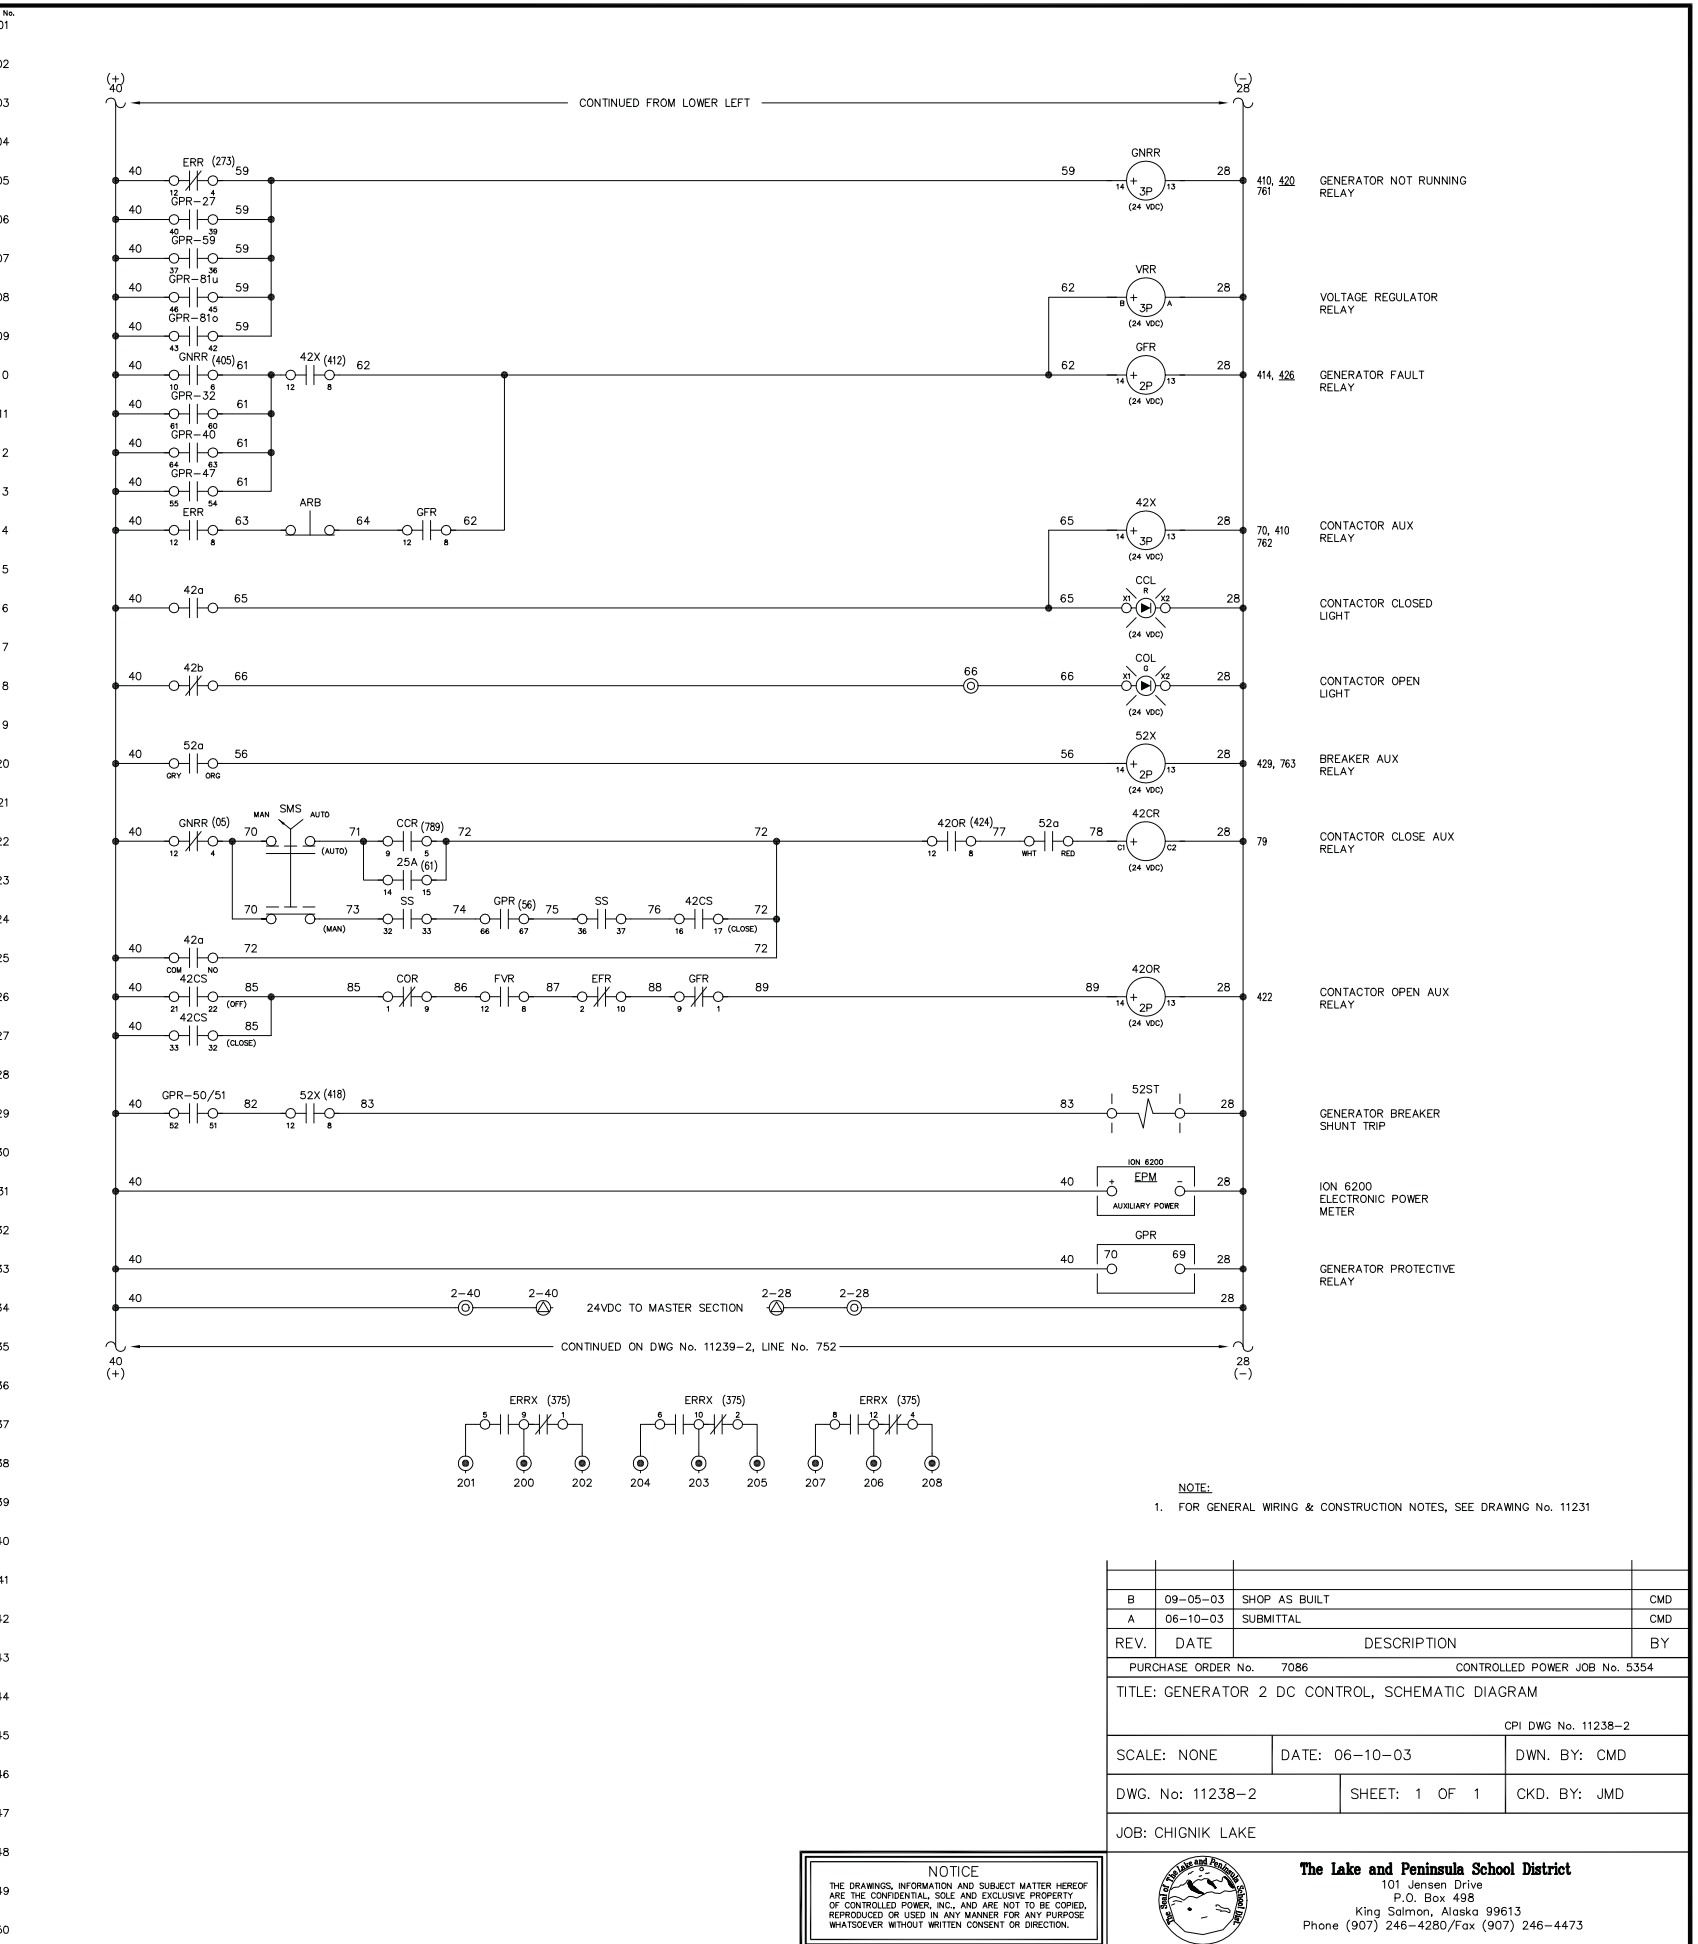
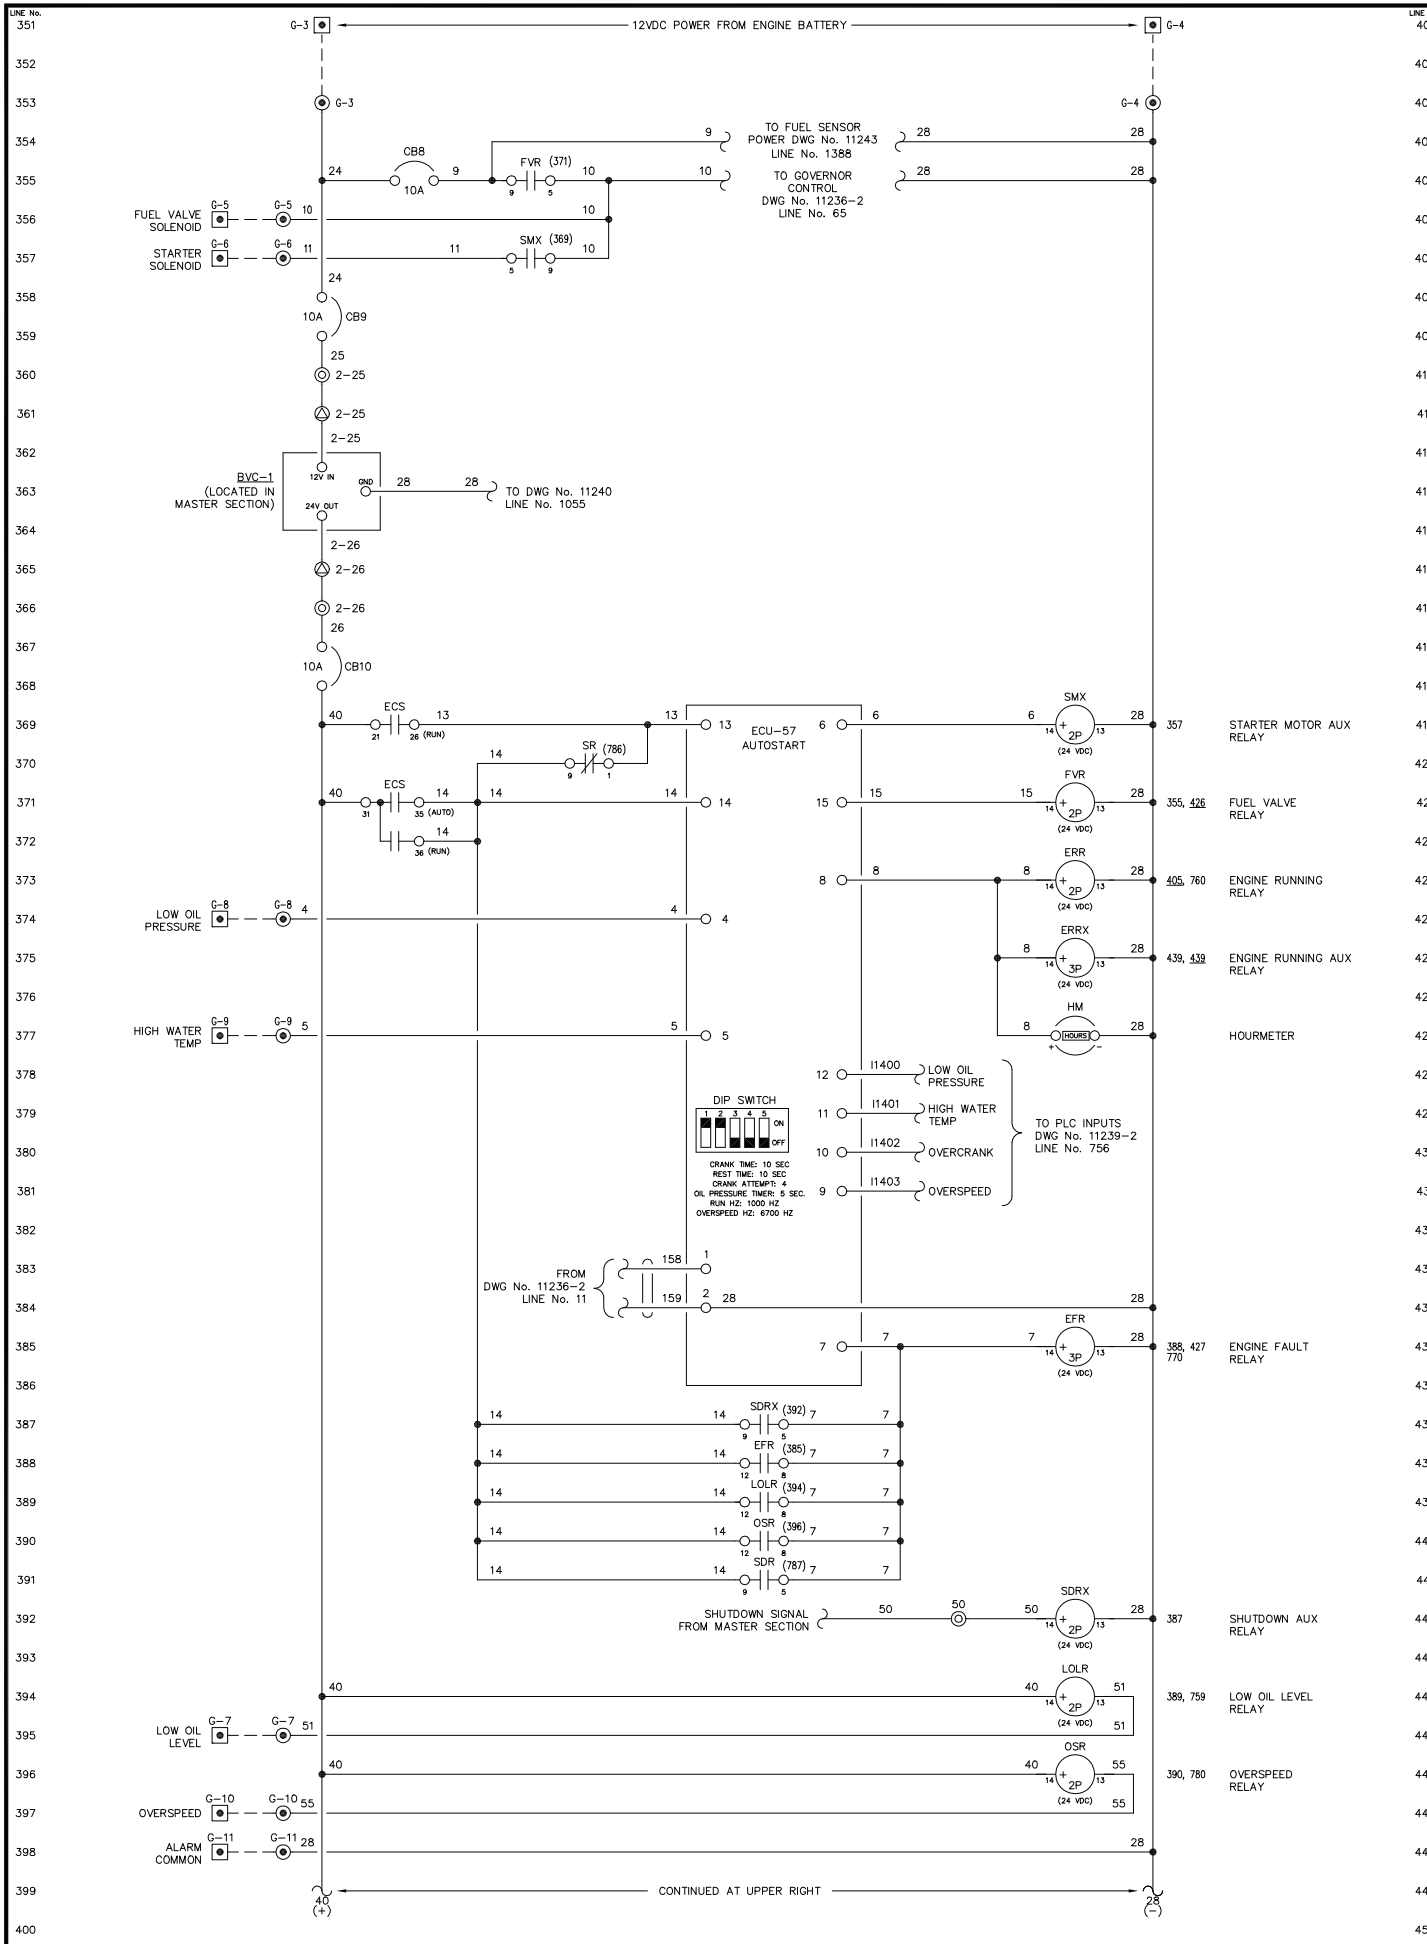


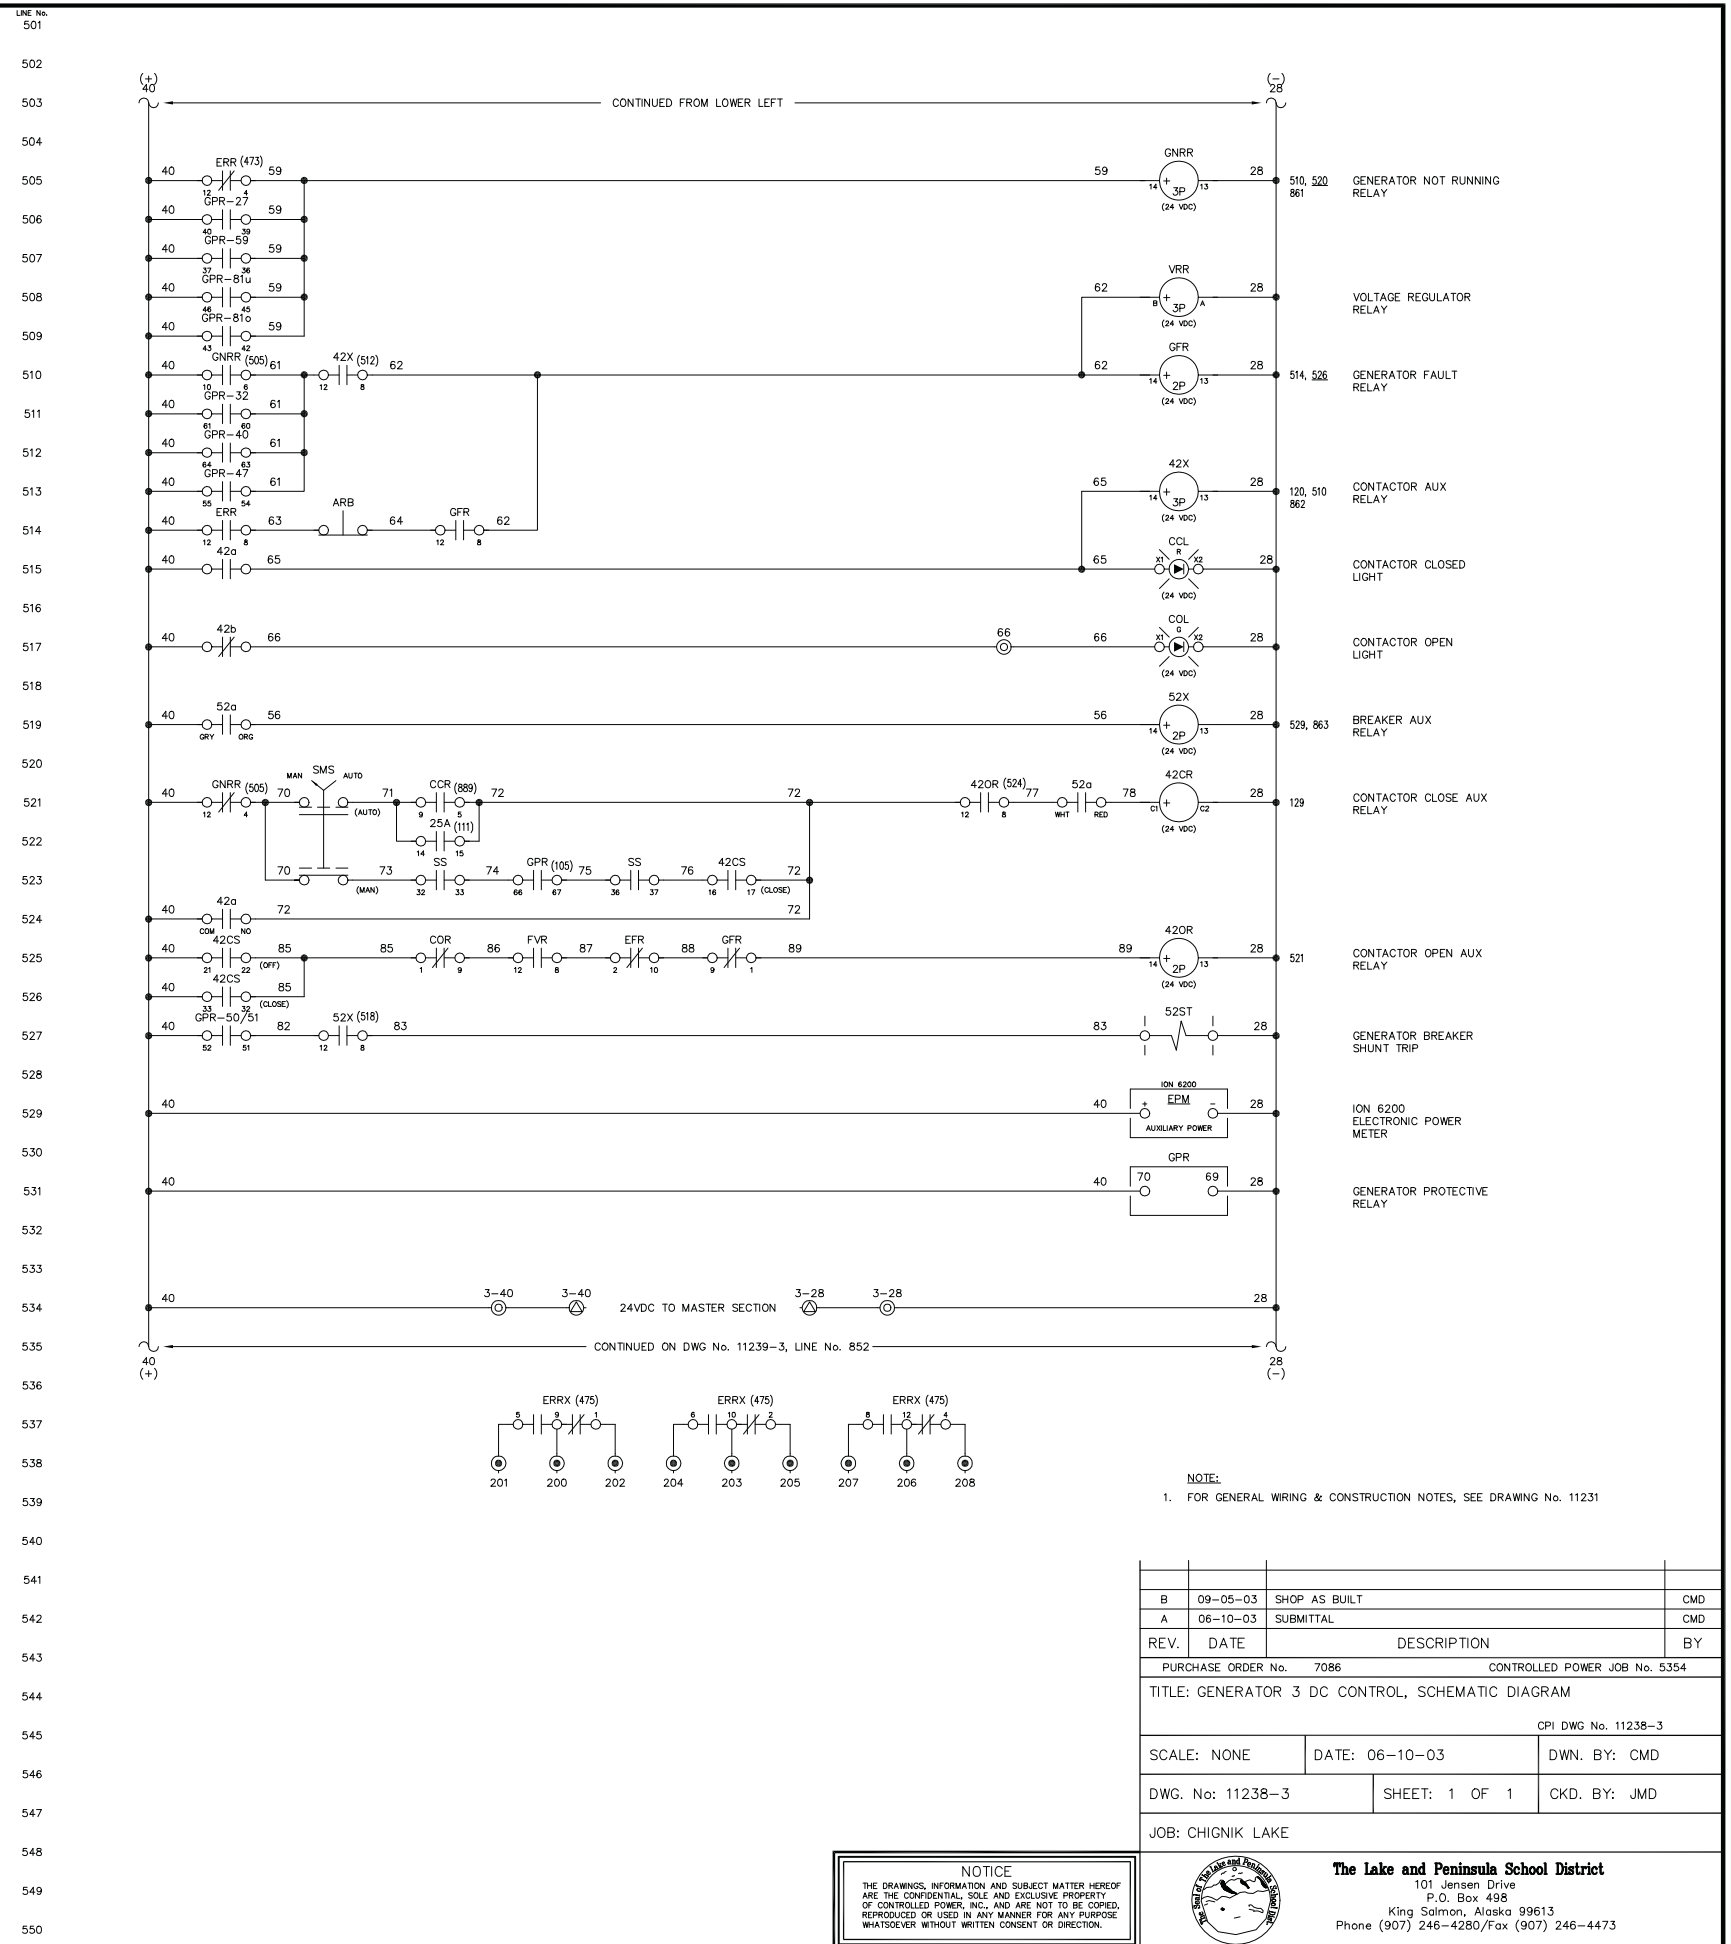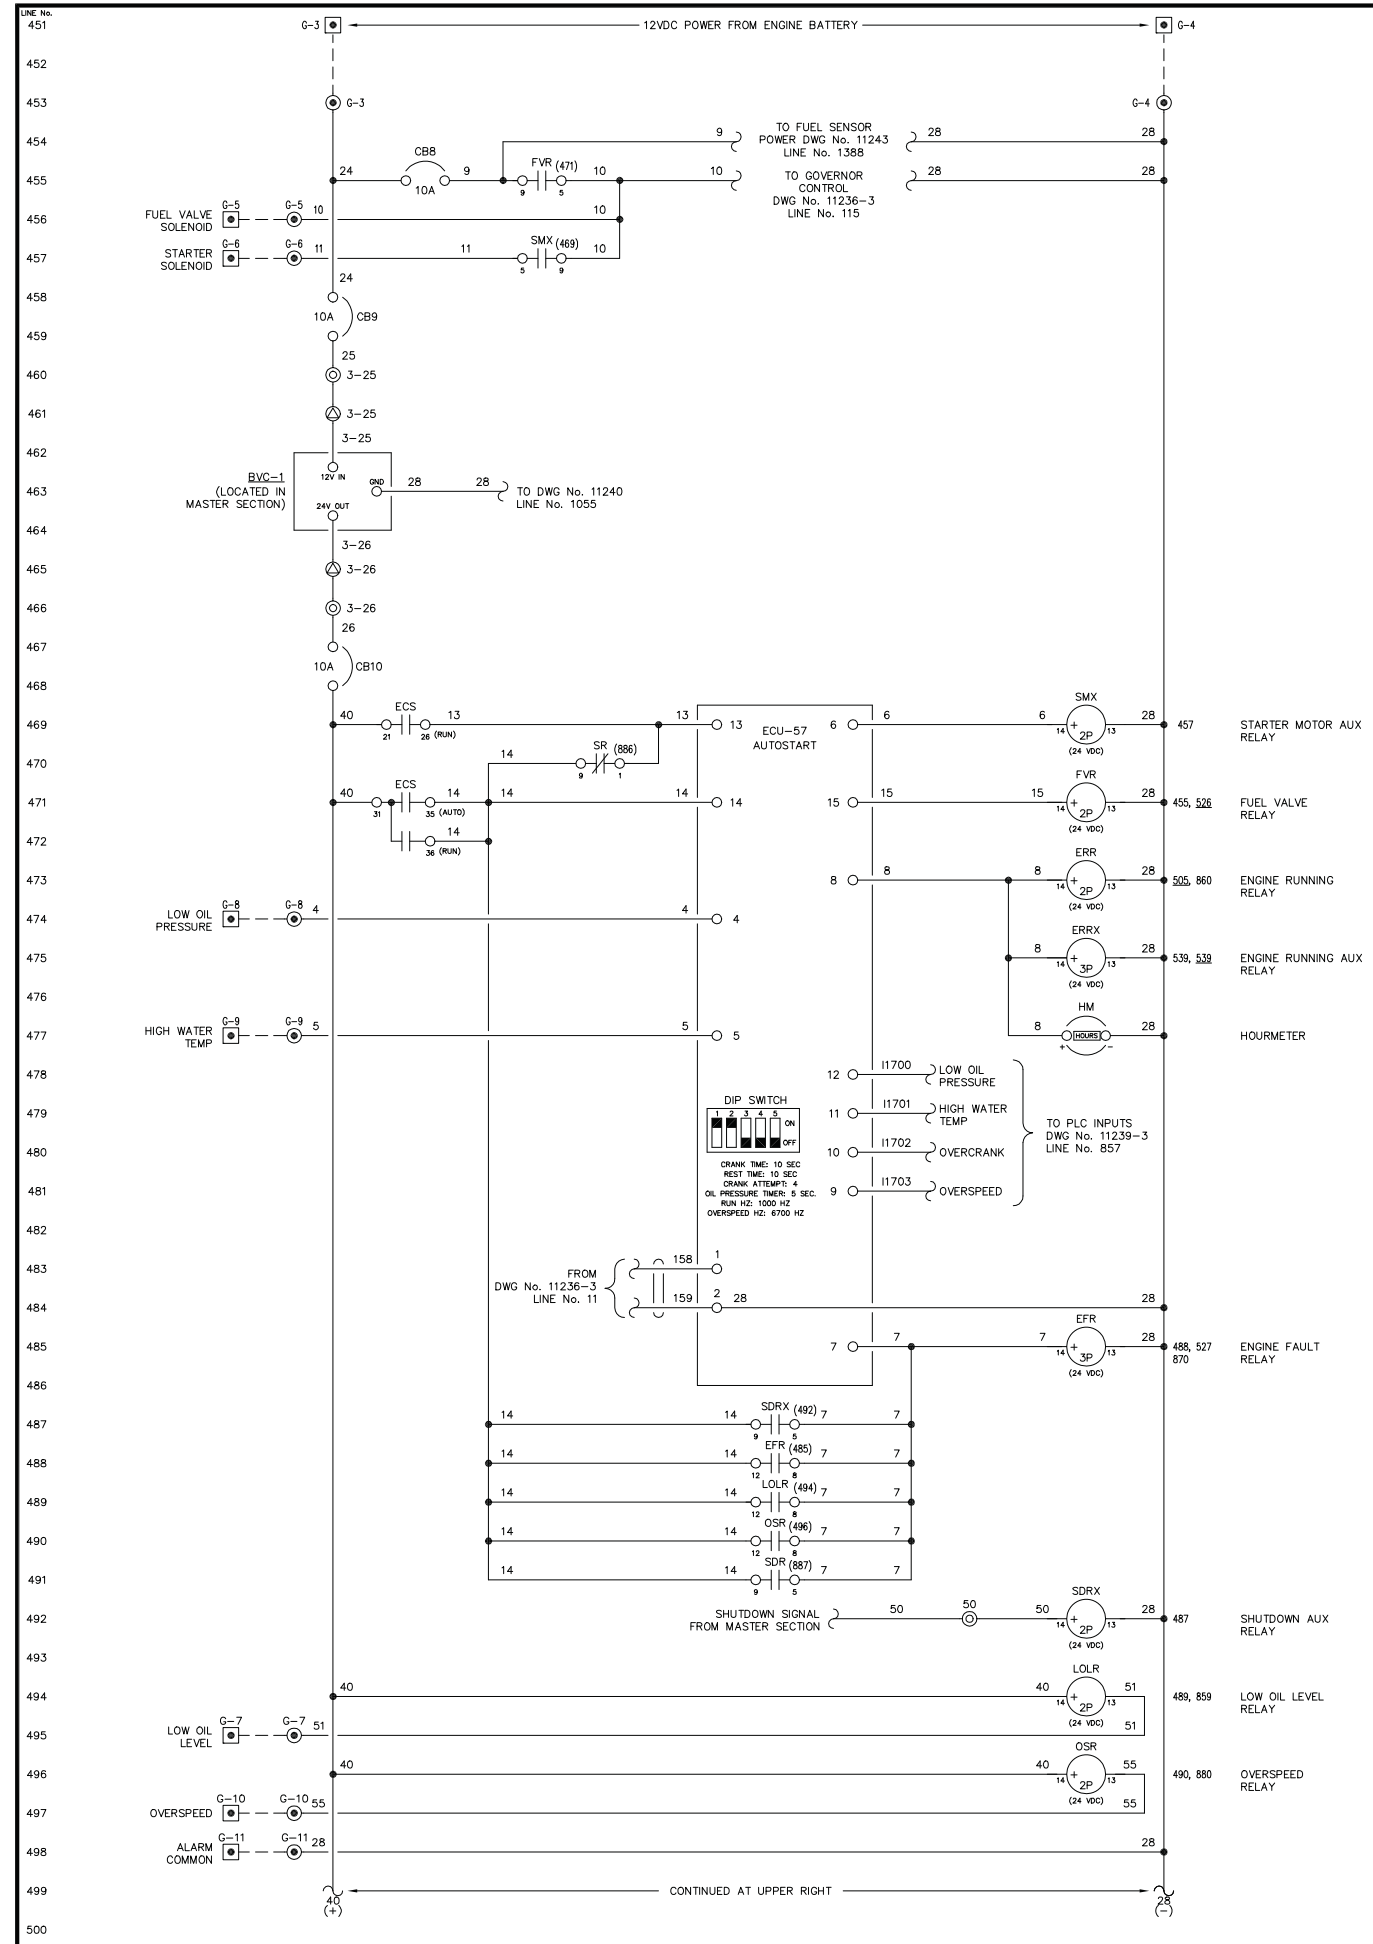

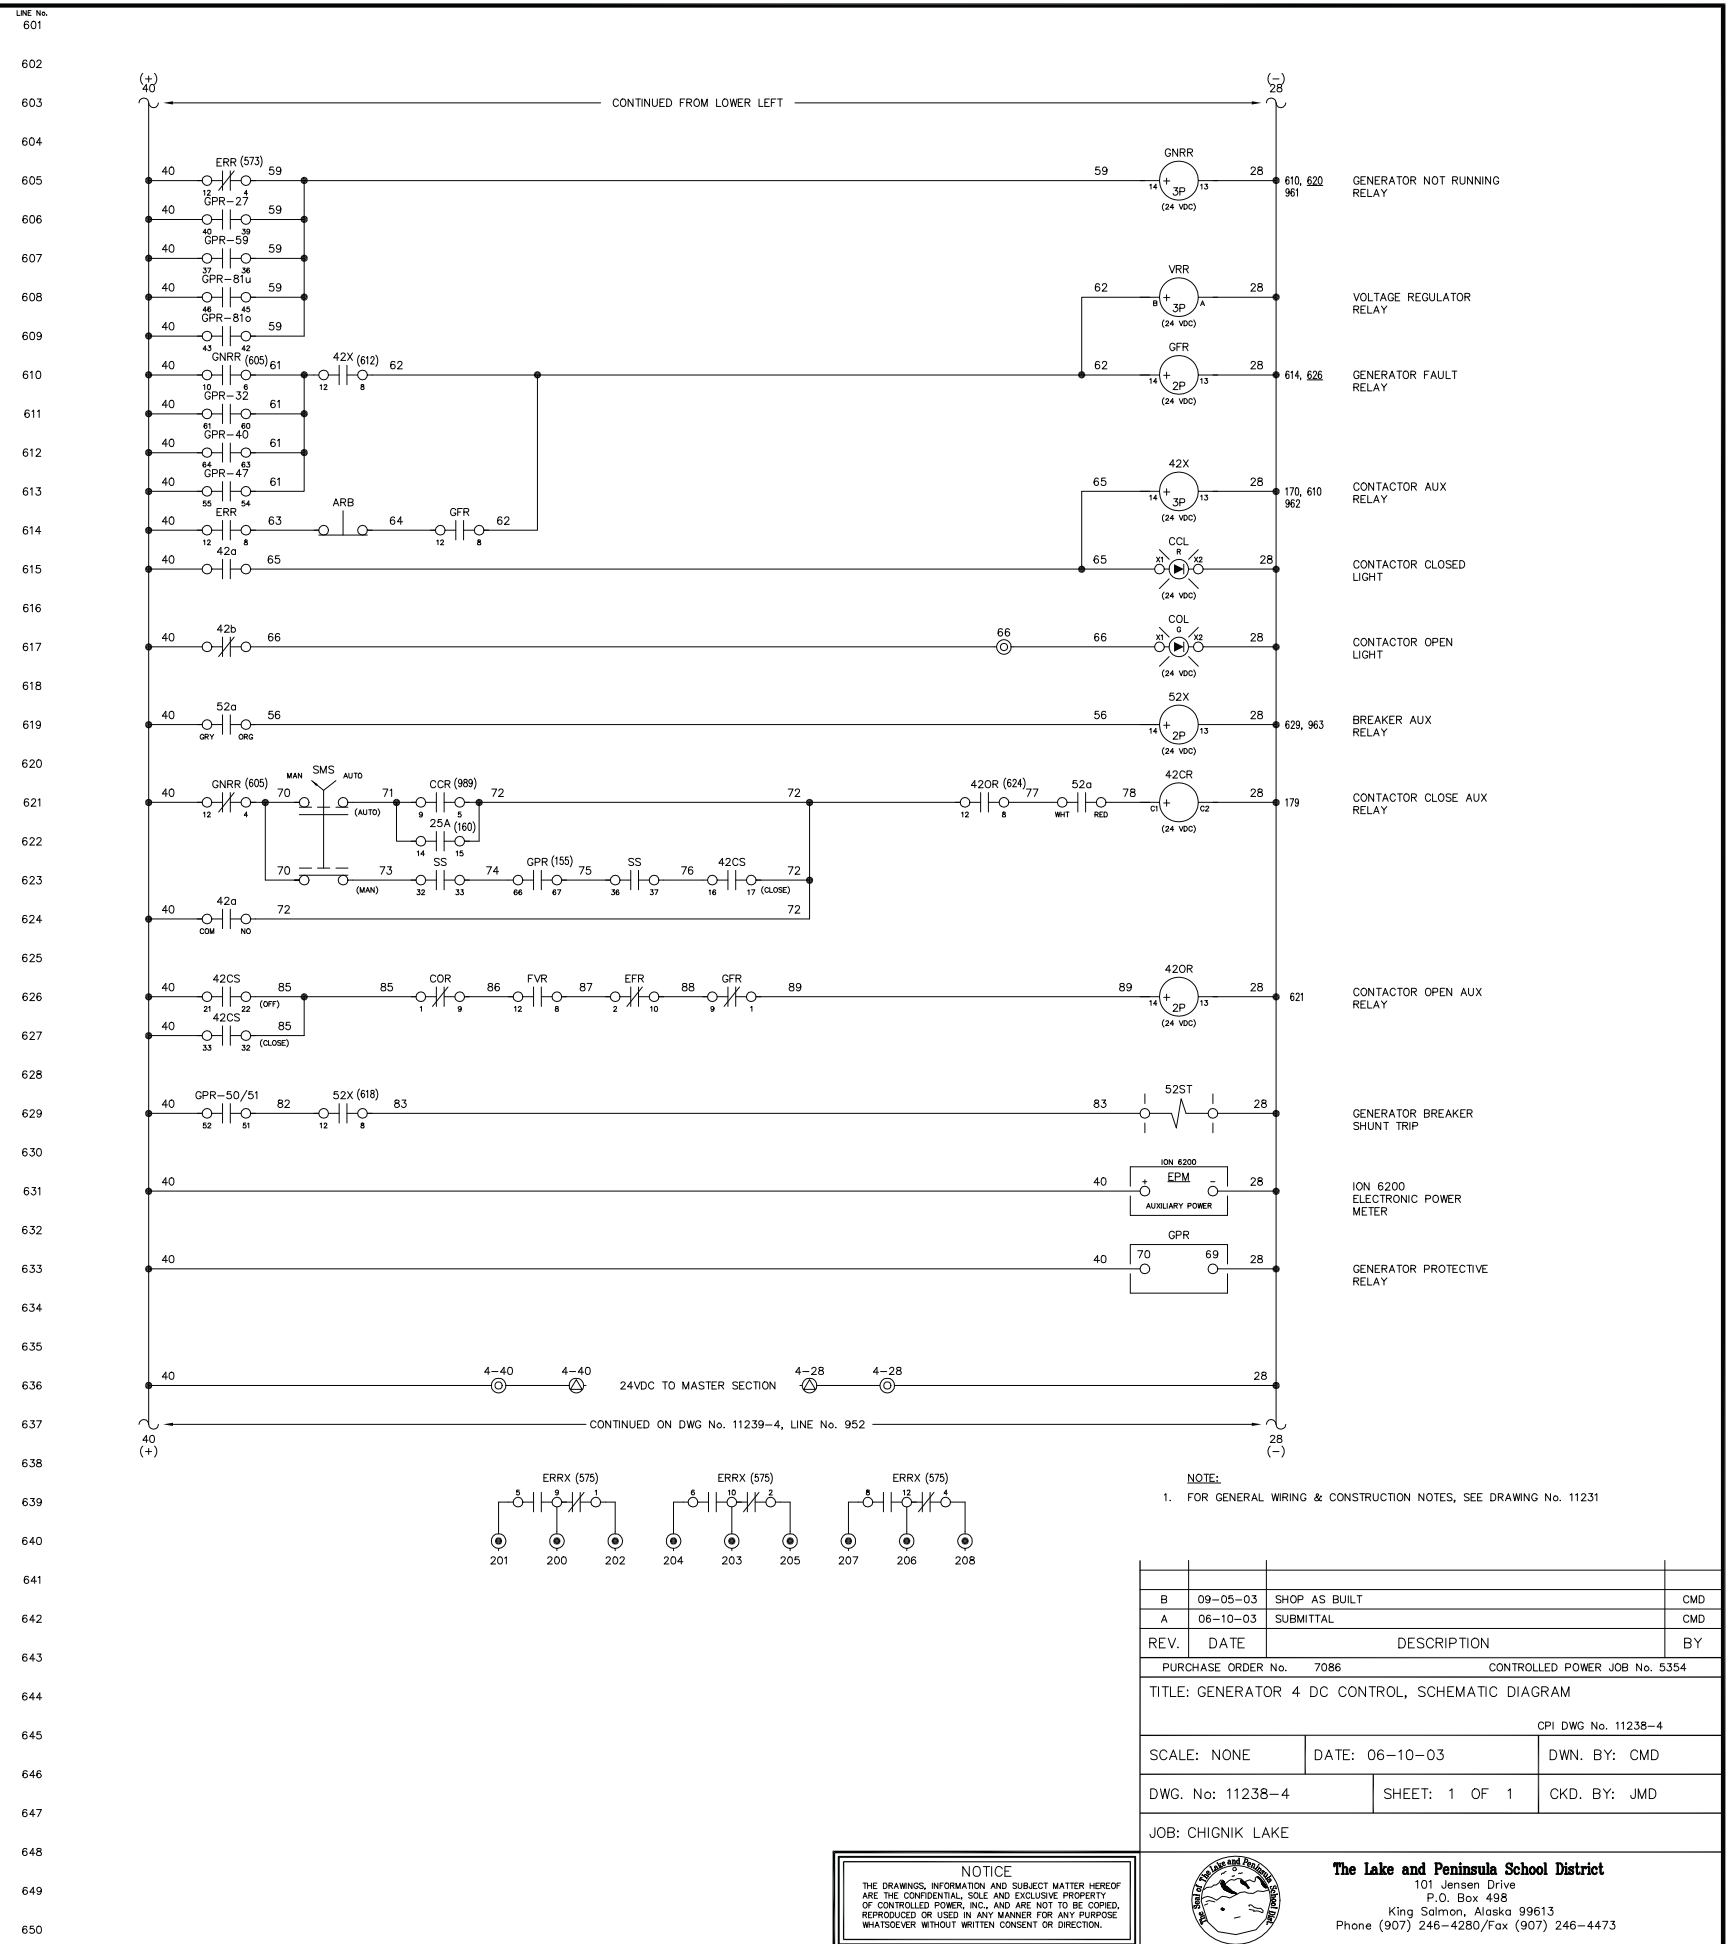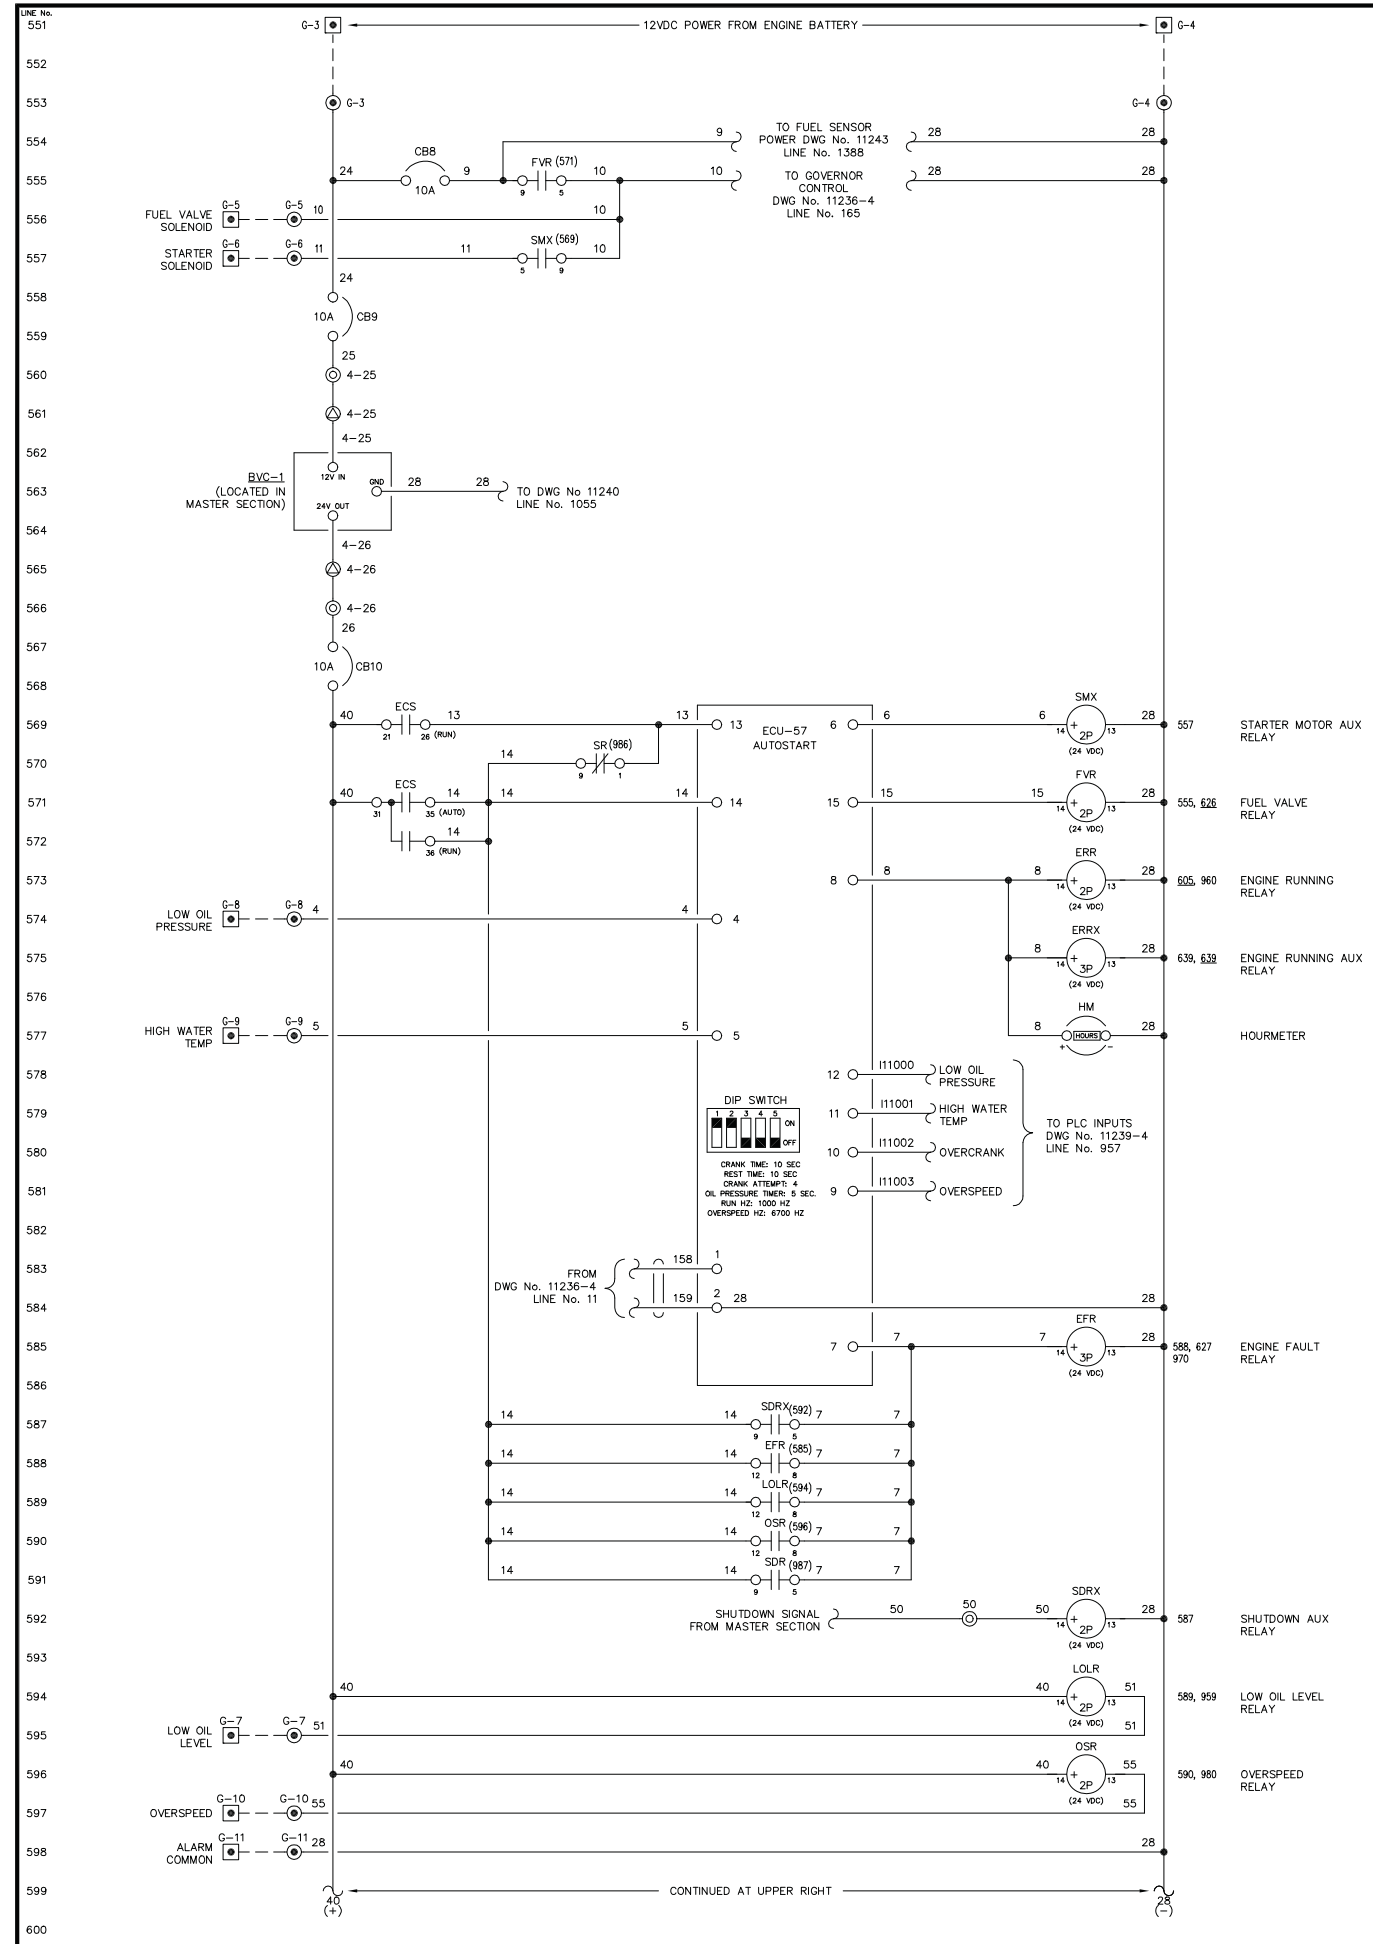

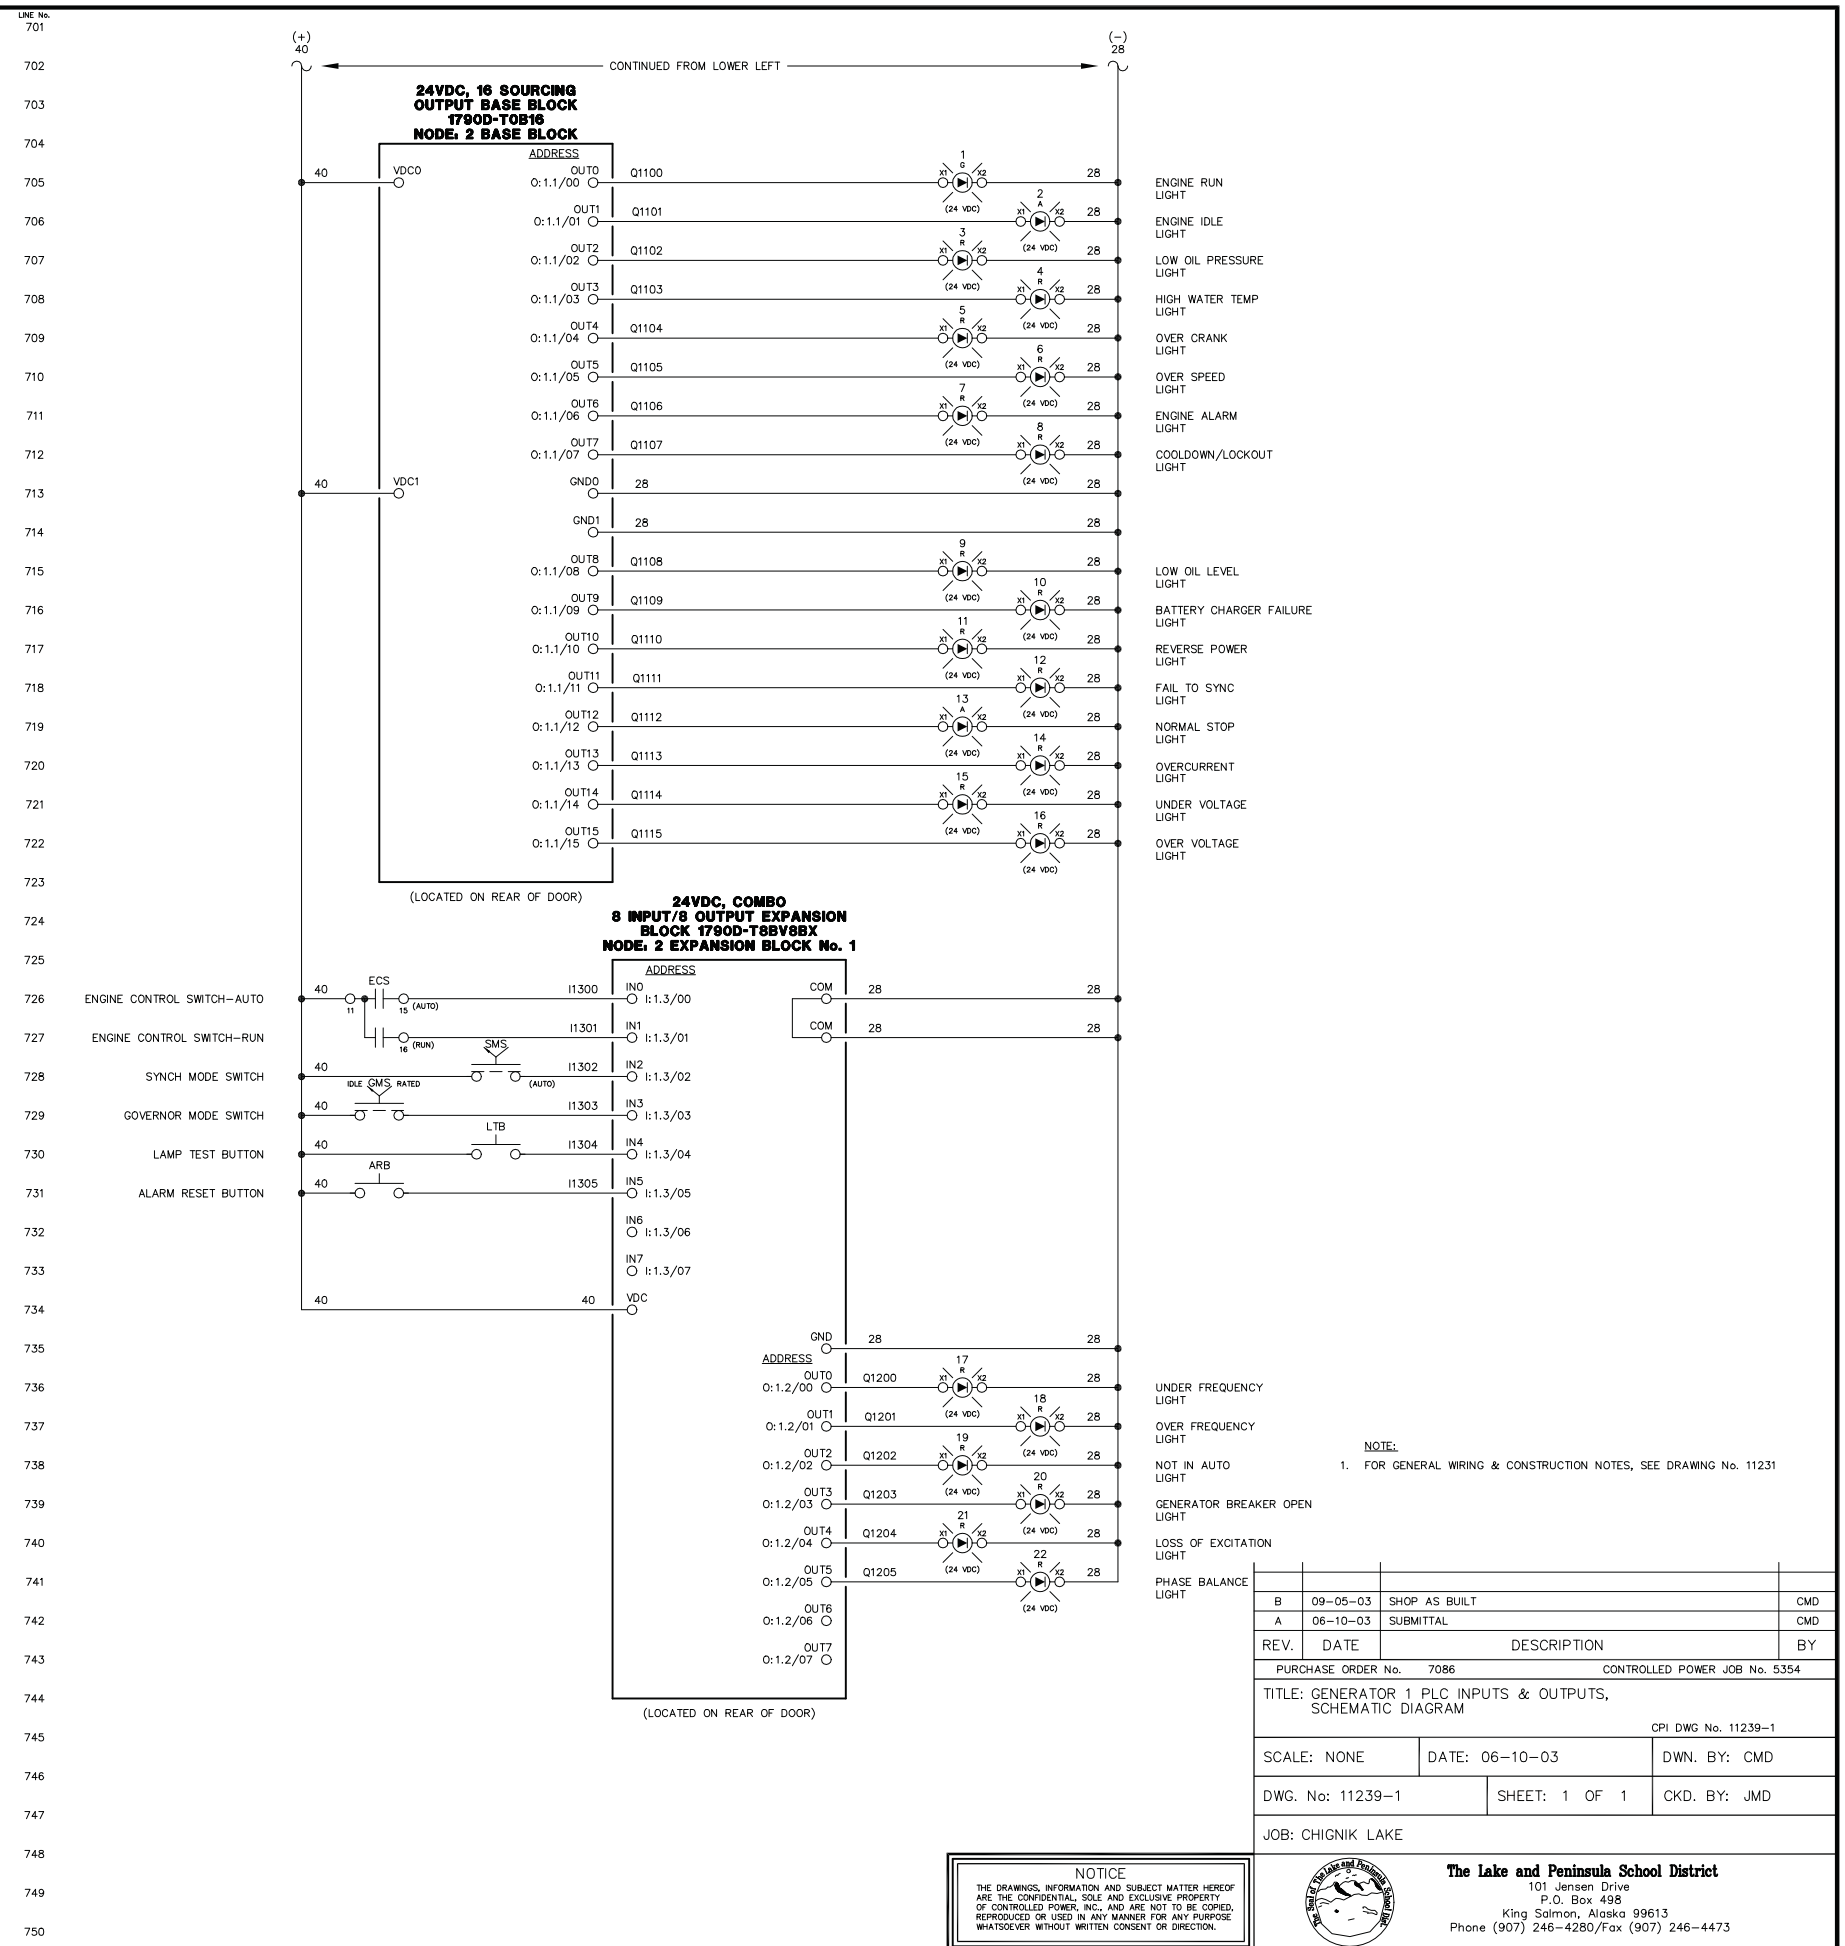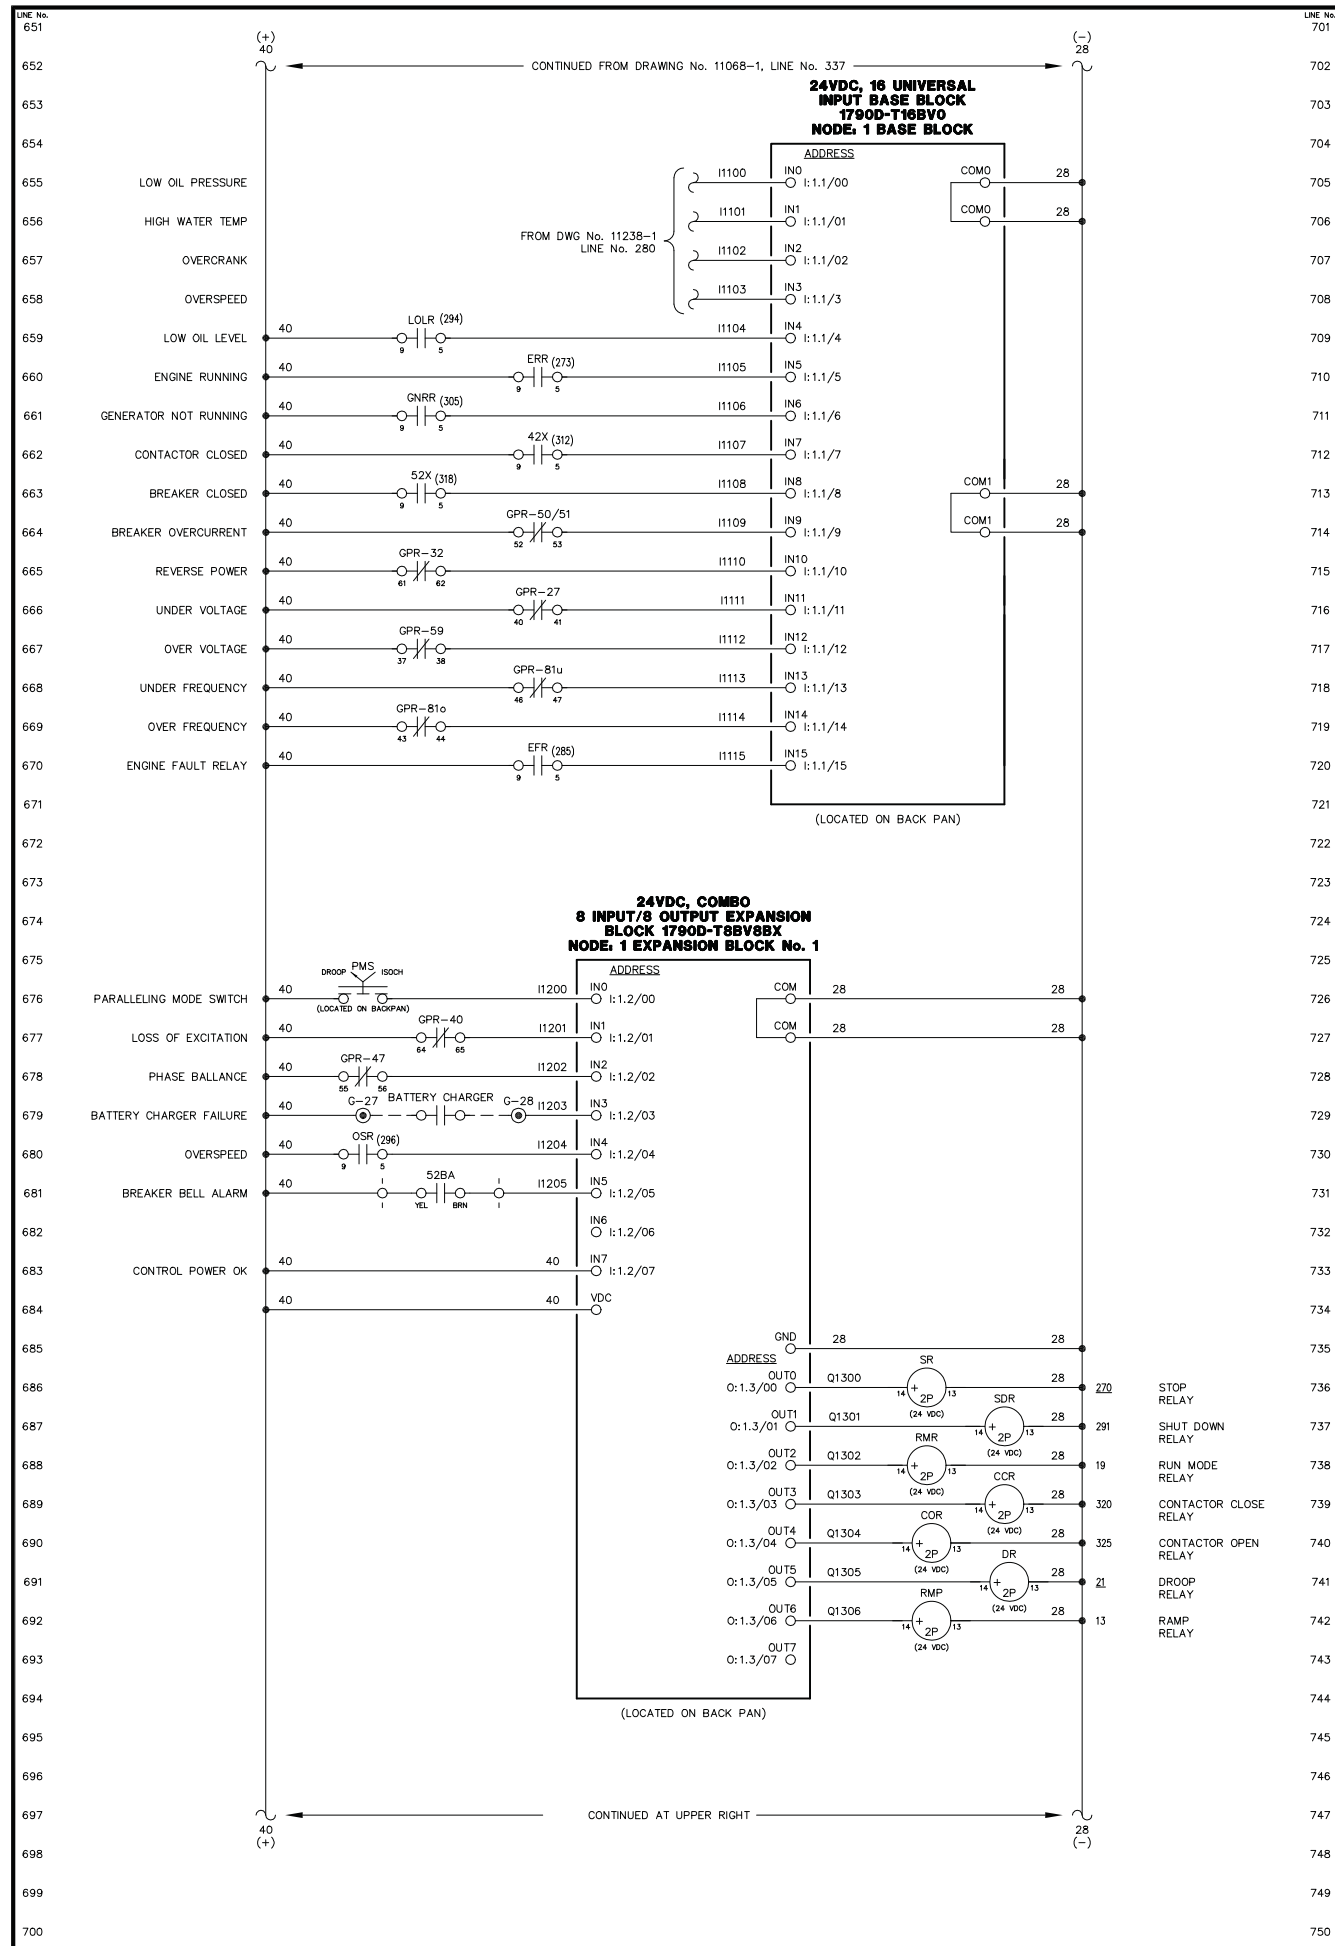

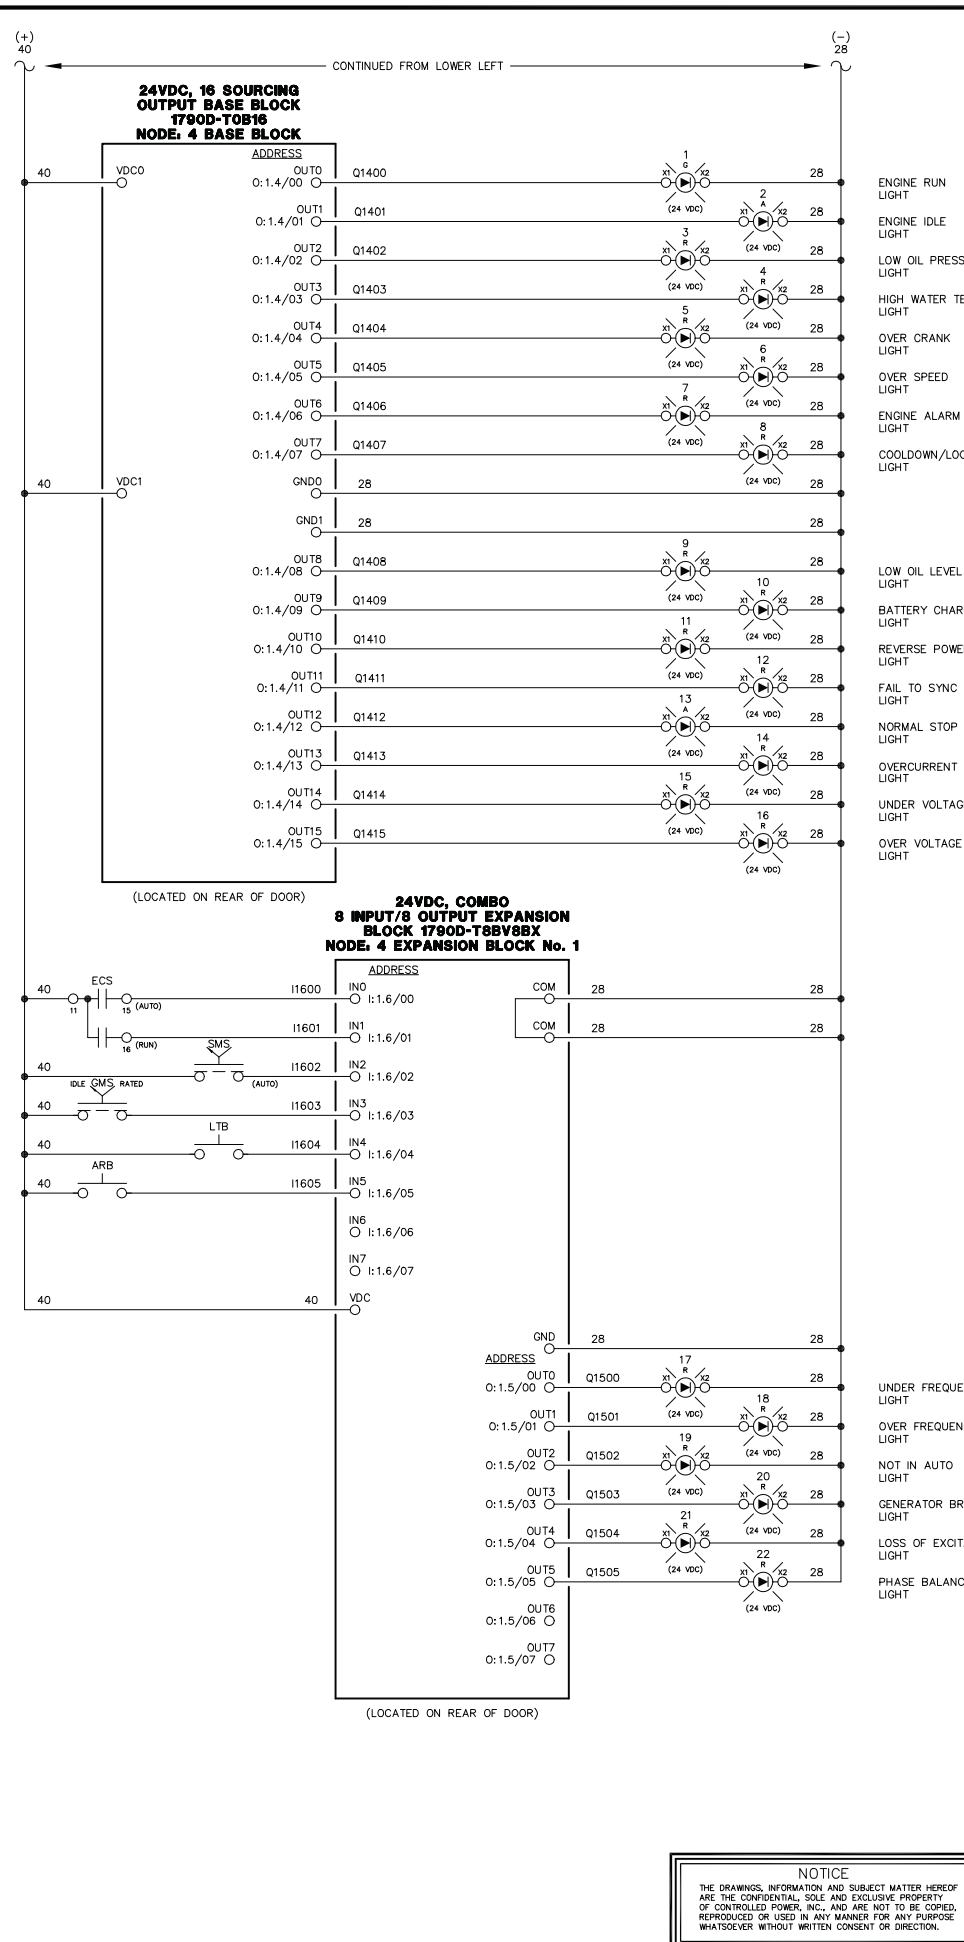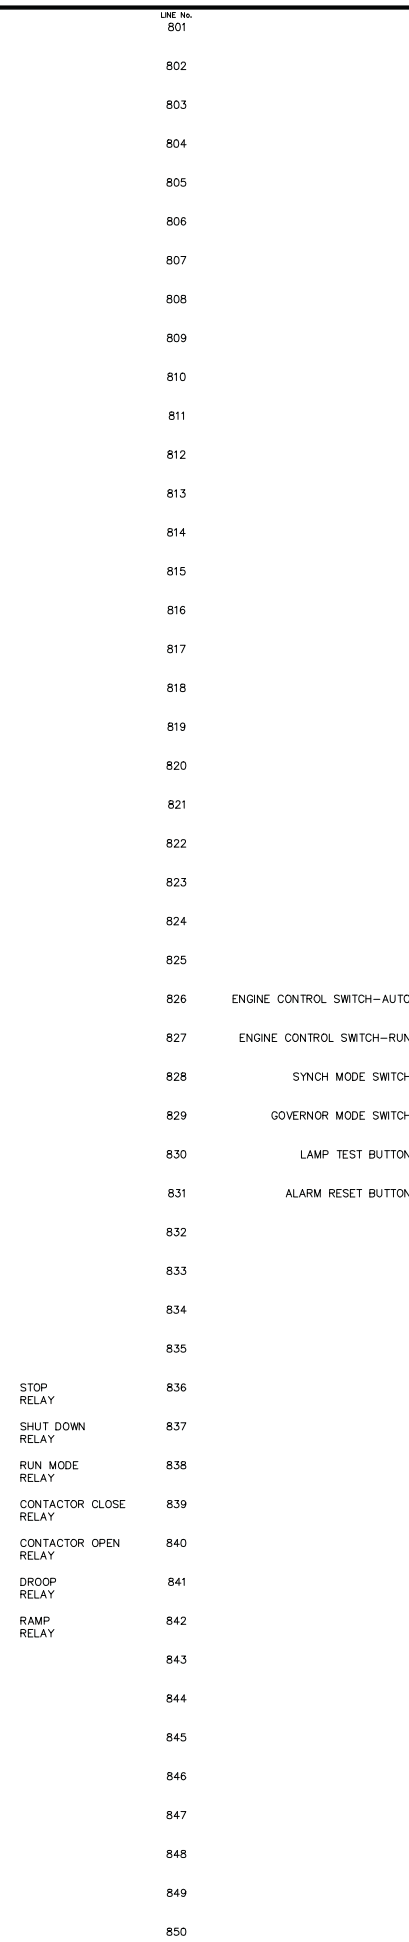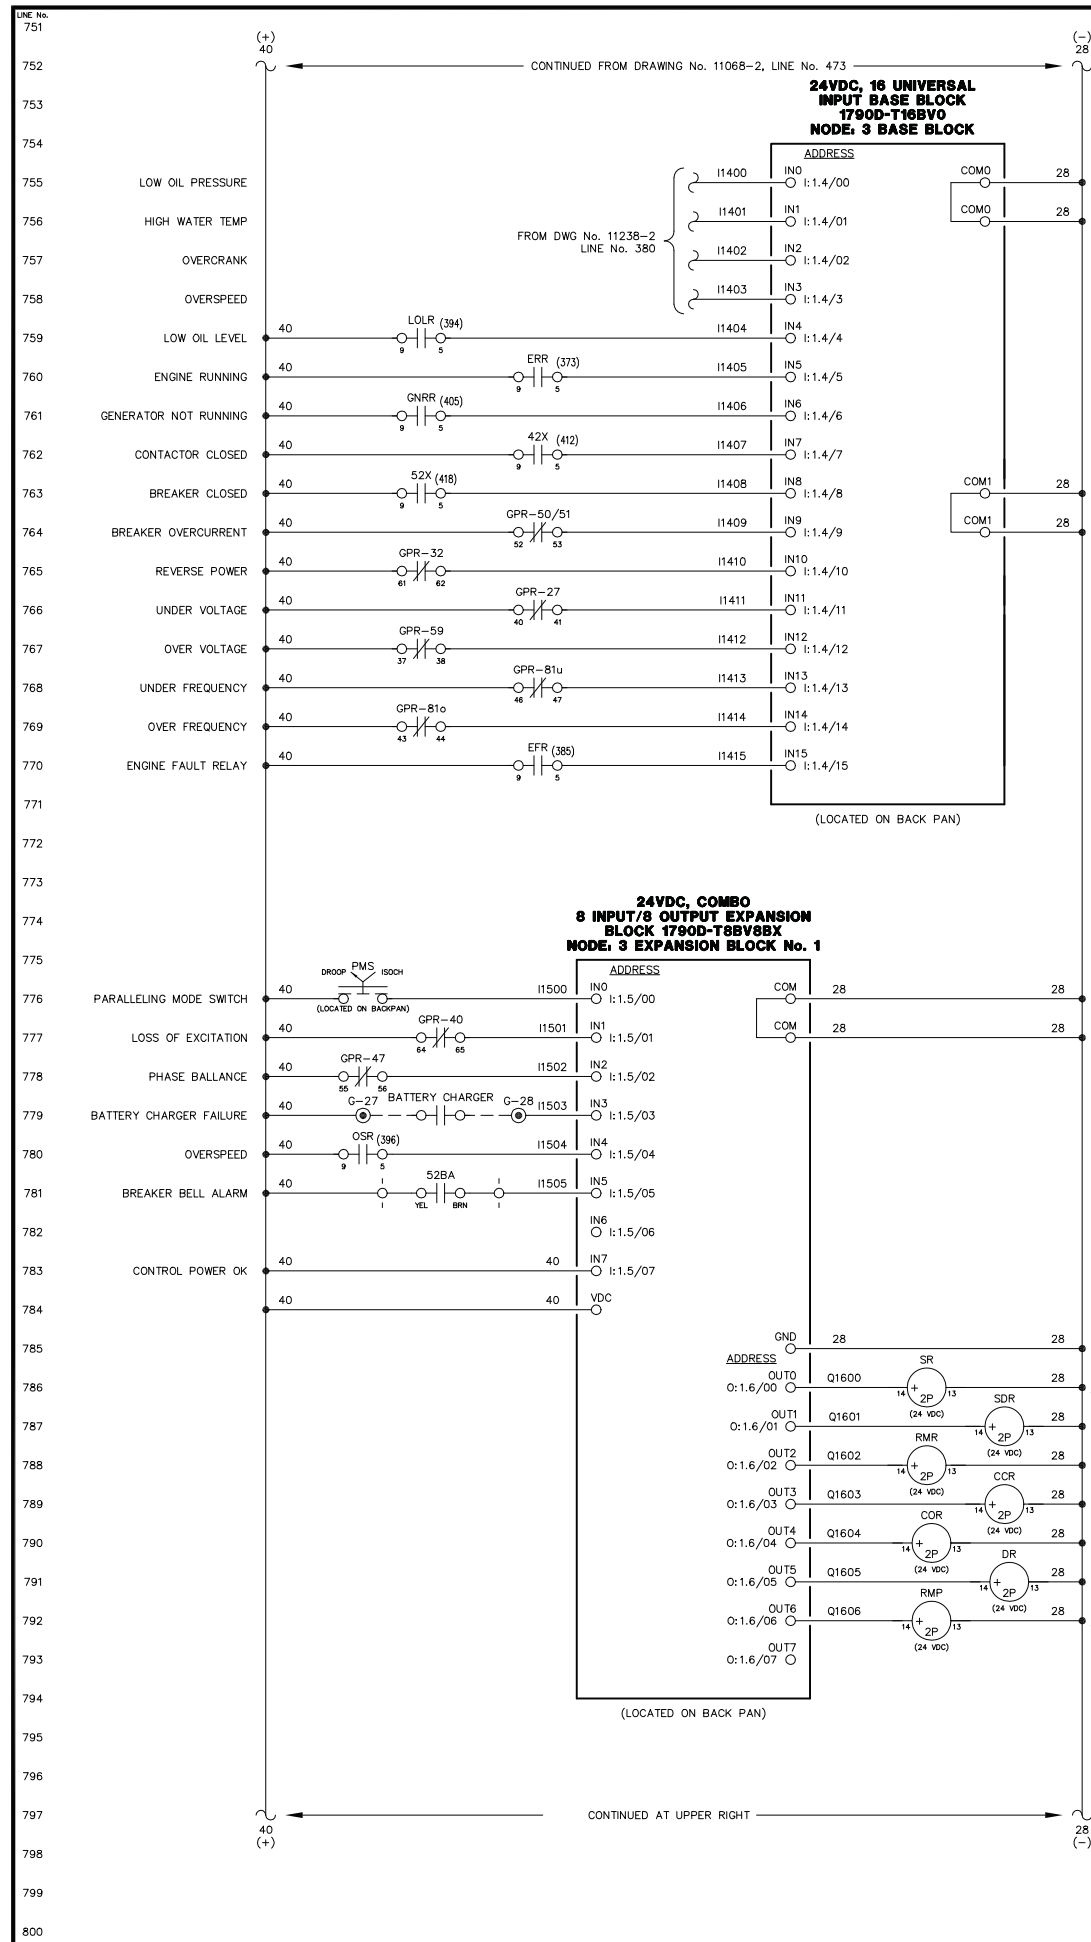

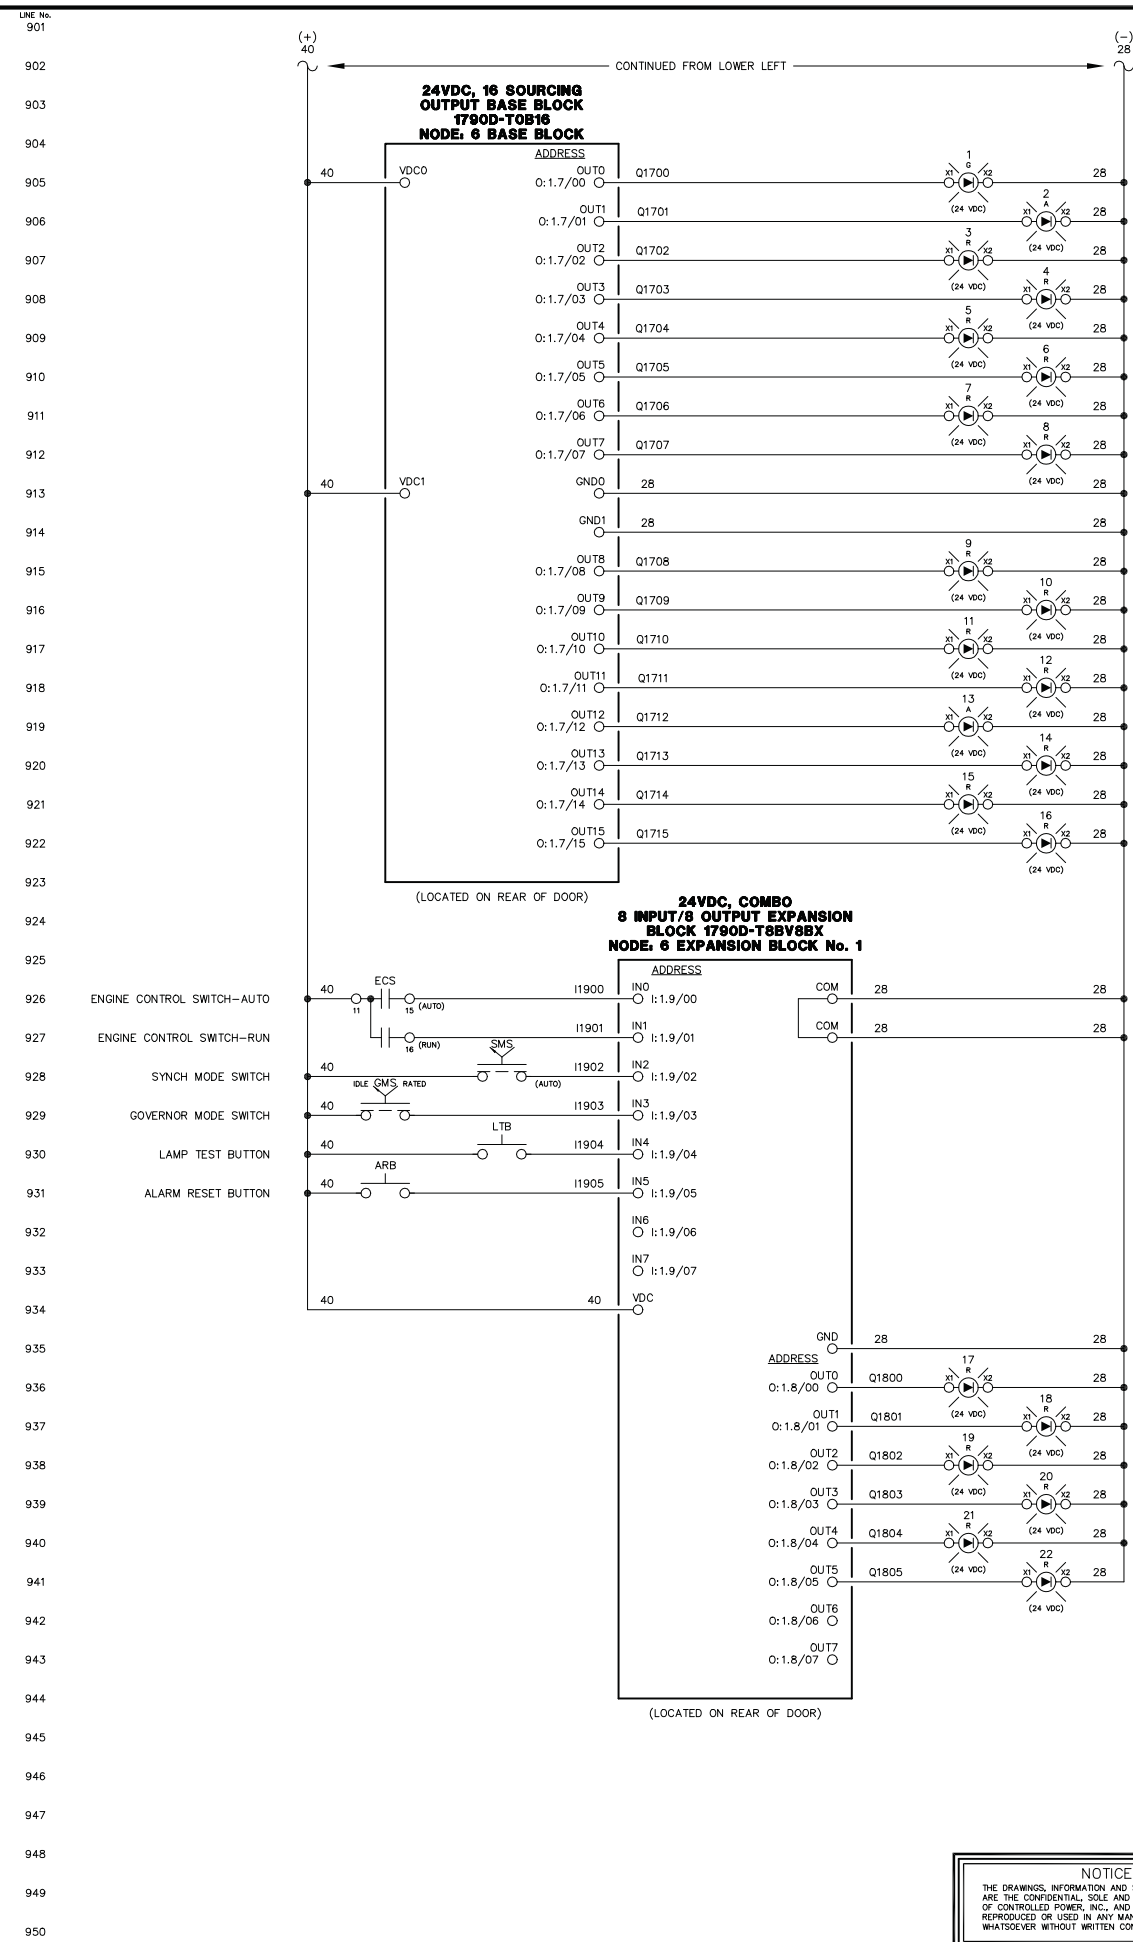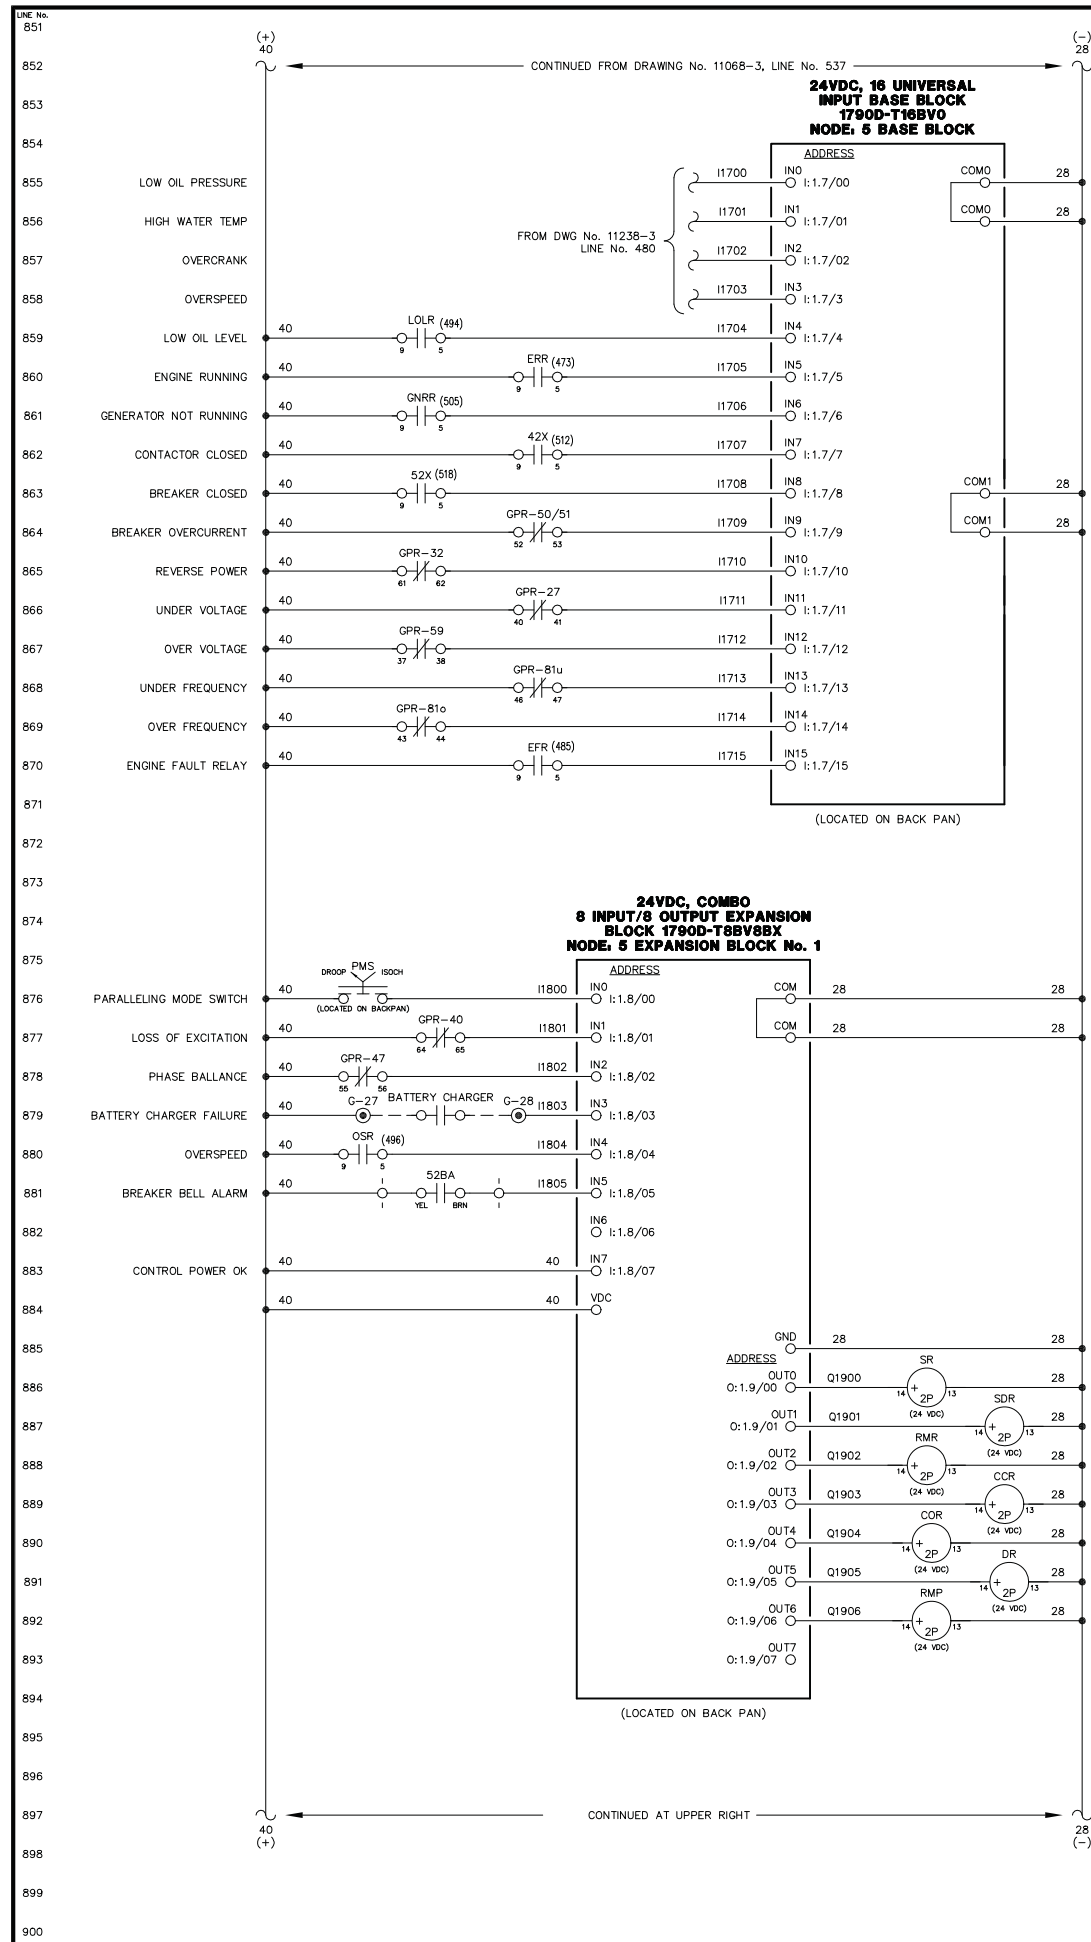

ENGINE RUN LIGHT
ENGINE IDLE LIGHT
LOW OIL PRESSURE LIGHT
HIGH WATER TEMP LIGHT
OVER CRANK LIGHT
OVER SPEED LIGHT
ENGINE ALARM LIGHT
COOLDOWN/LOCKOUT LIGHT
LOW OIL LEVEL LIGHT
BATTERY CHARGER FAILURE LIGHT
REVERSE POWER LIGHT
FAIL TO SYNC LIGHT
NORMAL STOP LIGHT
OVERCURRENT LIGHT
UNDER VOLTAGE LIGHT
OVER VOLTAGE LIGHT

UNDER FREQUENCY LIGHT
OVER FREQUENCY LIGHT
NOT IN AUTO LIGHT
GENERATOR BREAKER OPEN LIGHT
LOSS OF EXCITATION LIGHT
PHASE BALLANCE LIGHT



NOTE:
1. FOR GENERAL WIRING & CONSTRUCTION NOTES, SEE DRAWING No. 11231


B	09-05-03	SHOP AS BUILT	CMD
A	06-10-03	SUBMITTAL	CMD
REV.	DATE	DESCRIPTION	BY
PURCHASE ORDER No. 7086		CONTROLLED POWER JOB No. 5354	
TITLE: GENERATOR 3 PLC INPUTS & OUTPUTS, SCHEMATIC DIAGRAM			
CPI DWG No. 11239-3			
SCALE: NONE	DATE: 06-10-03	DWN. BY: CMD	
DWG. No: 11239-3	SHEET: 1 OF 1	CKD. BY: JMD	
JOB: CHIGNIK LAKE			

NOTICE
THE DRAWINGS, INFORMATION AND SUBJECT MATTER HEREOF ARE THE CONFIDENTIAL SOLE AND EXCLUSIVE PROPERTY OF CONTROLLED POWER, INC. AND ARE NOT TO BE COPIED, REPRODUCED OR USED IN ANY MANNER FOR ANY PURPOSE WHATSOEVER WITHOUT WRITTEN CONSENT OR DIRECTION.




The Lake and Peninsula School District
101 Jensen Drive
P.O. Box 498
King Salmon, Alaska 99613
Phone (907) 246-4280/Fax (907) 246-4473

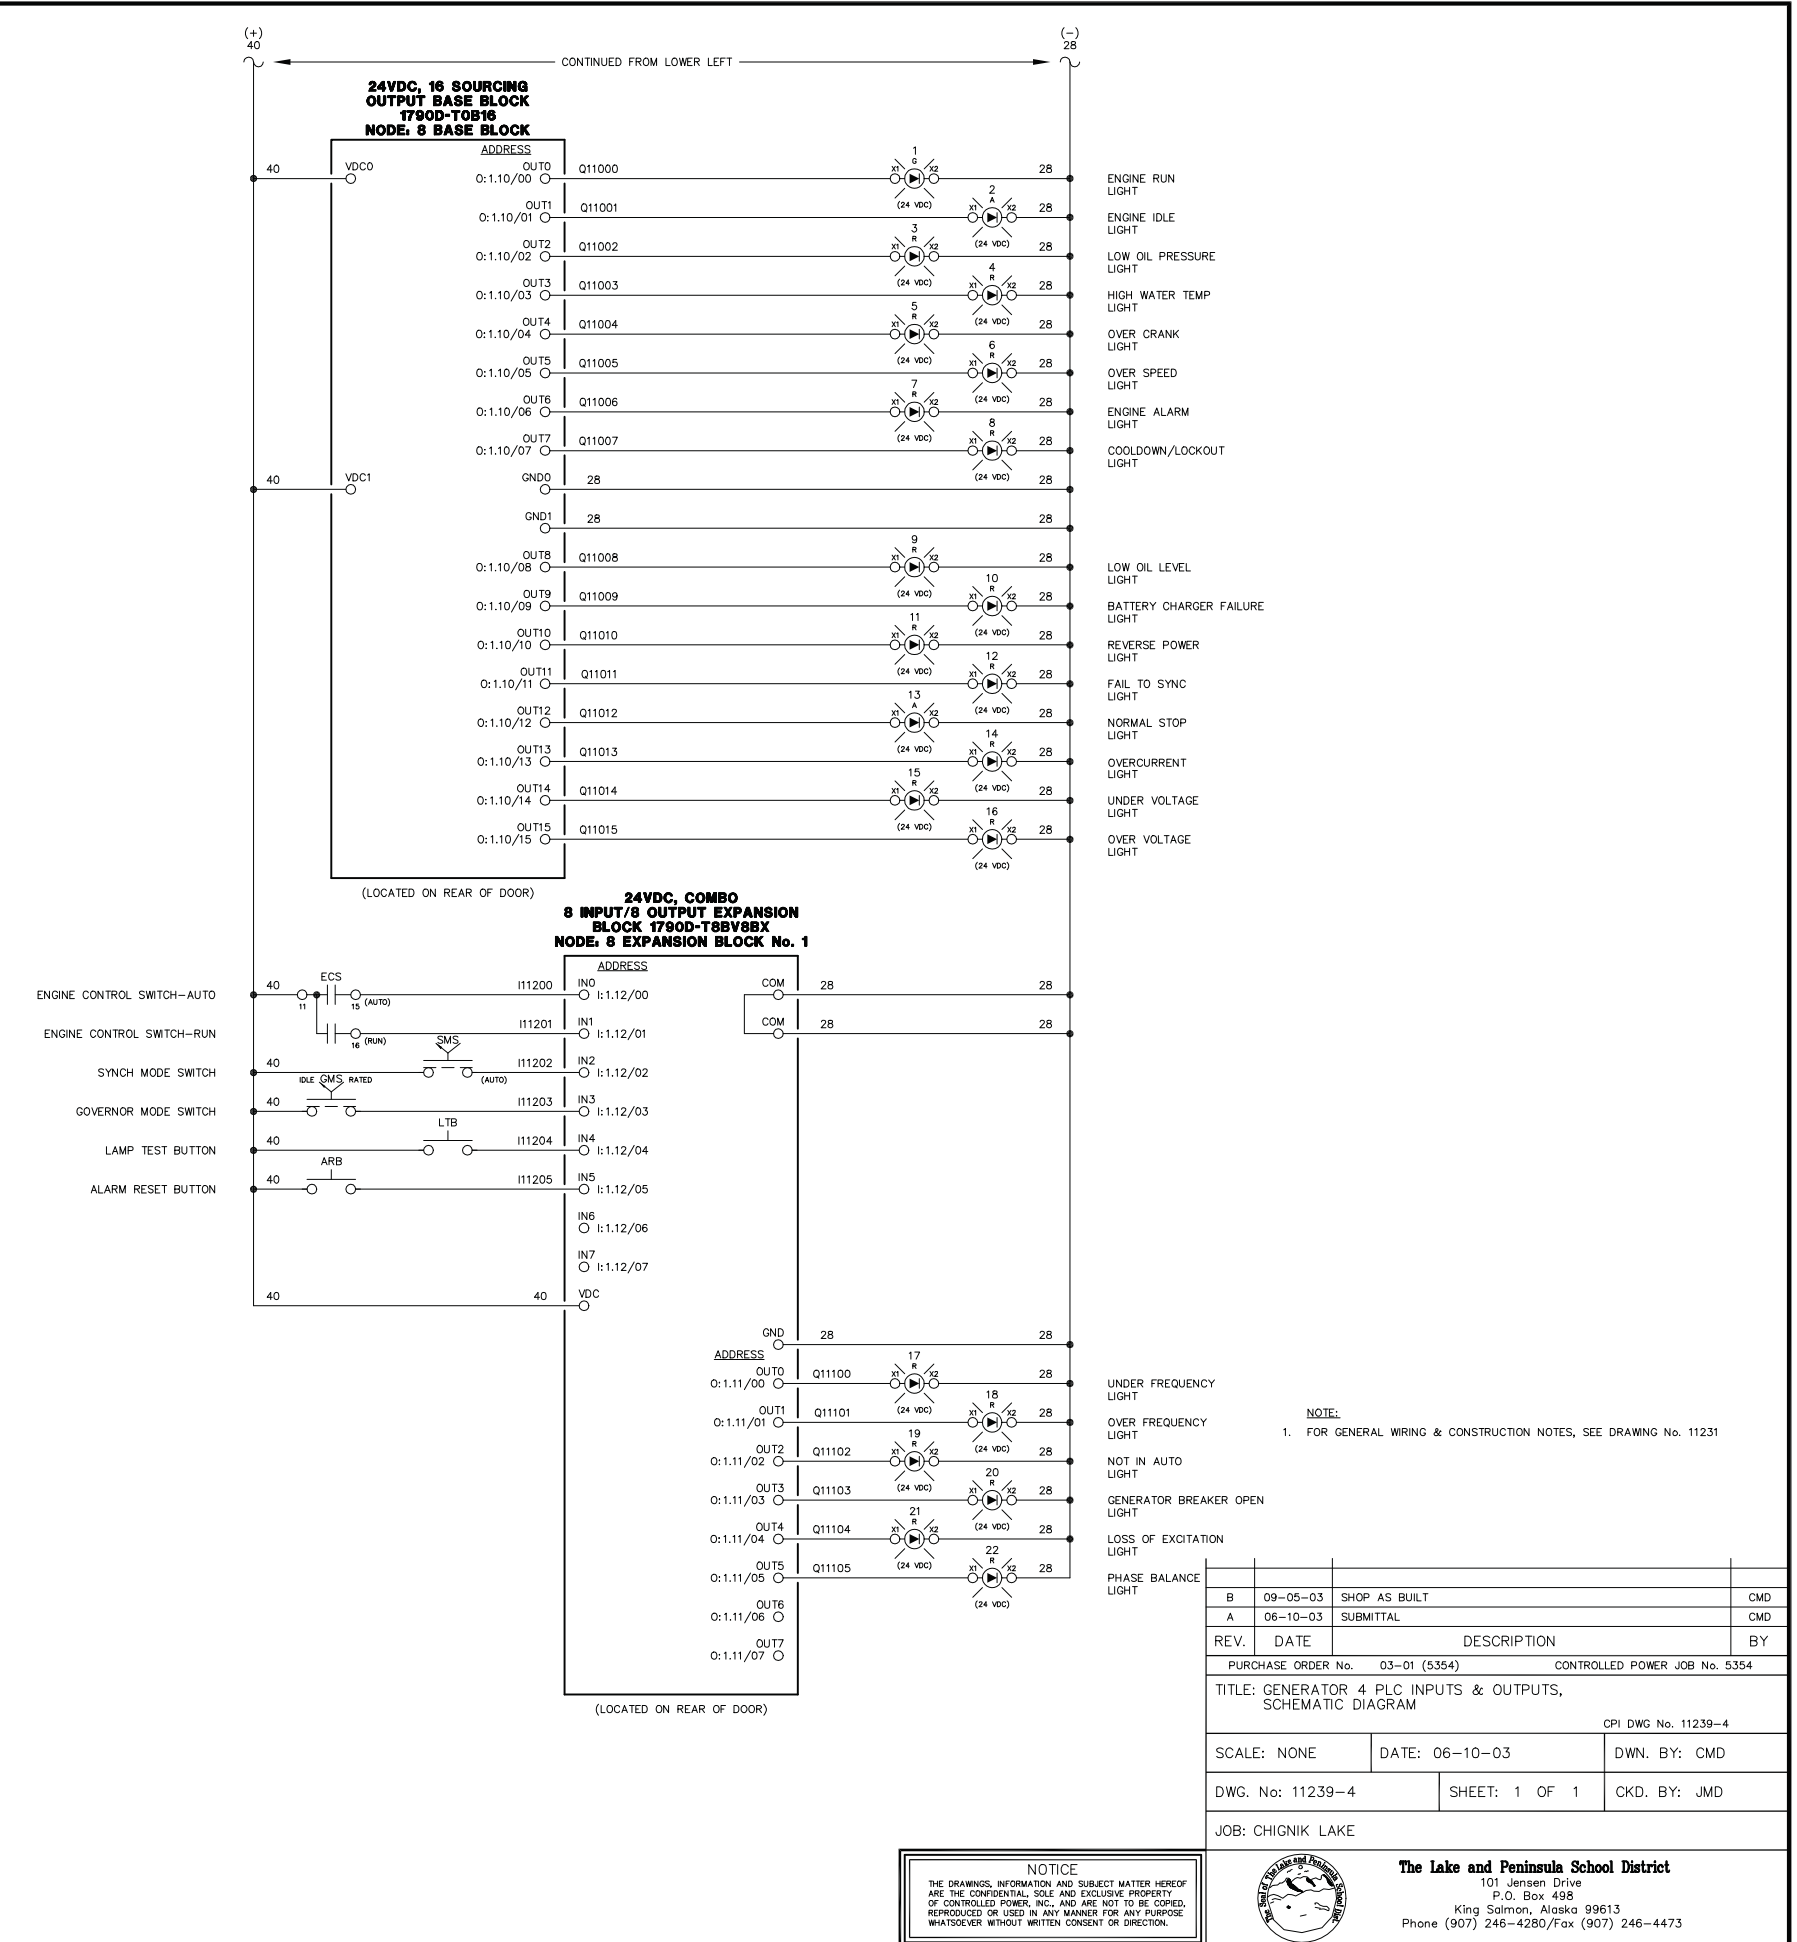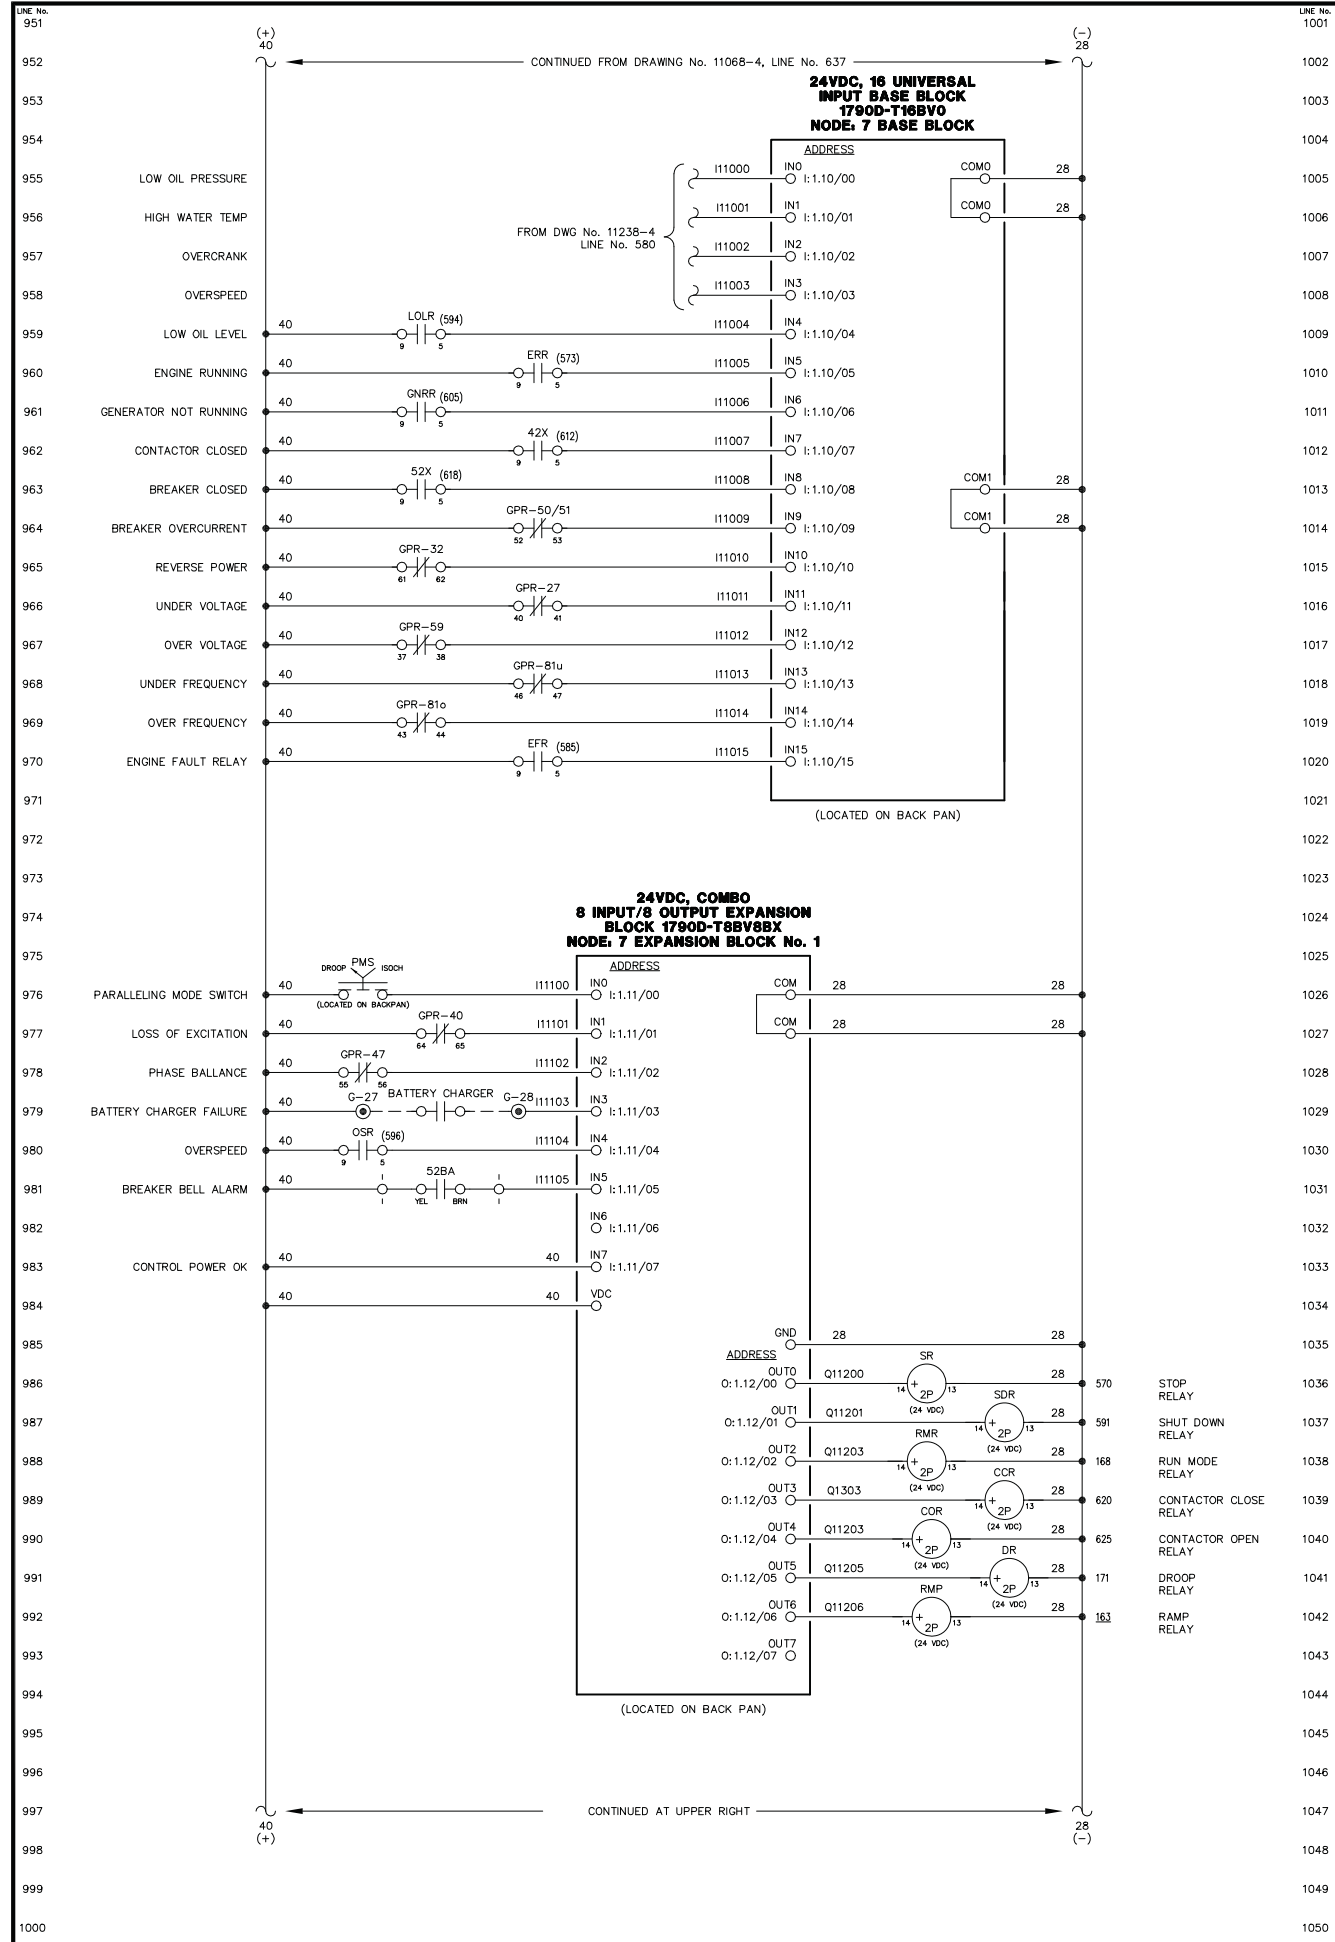

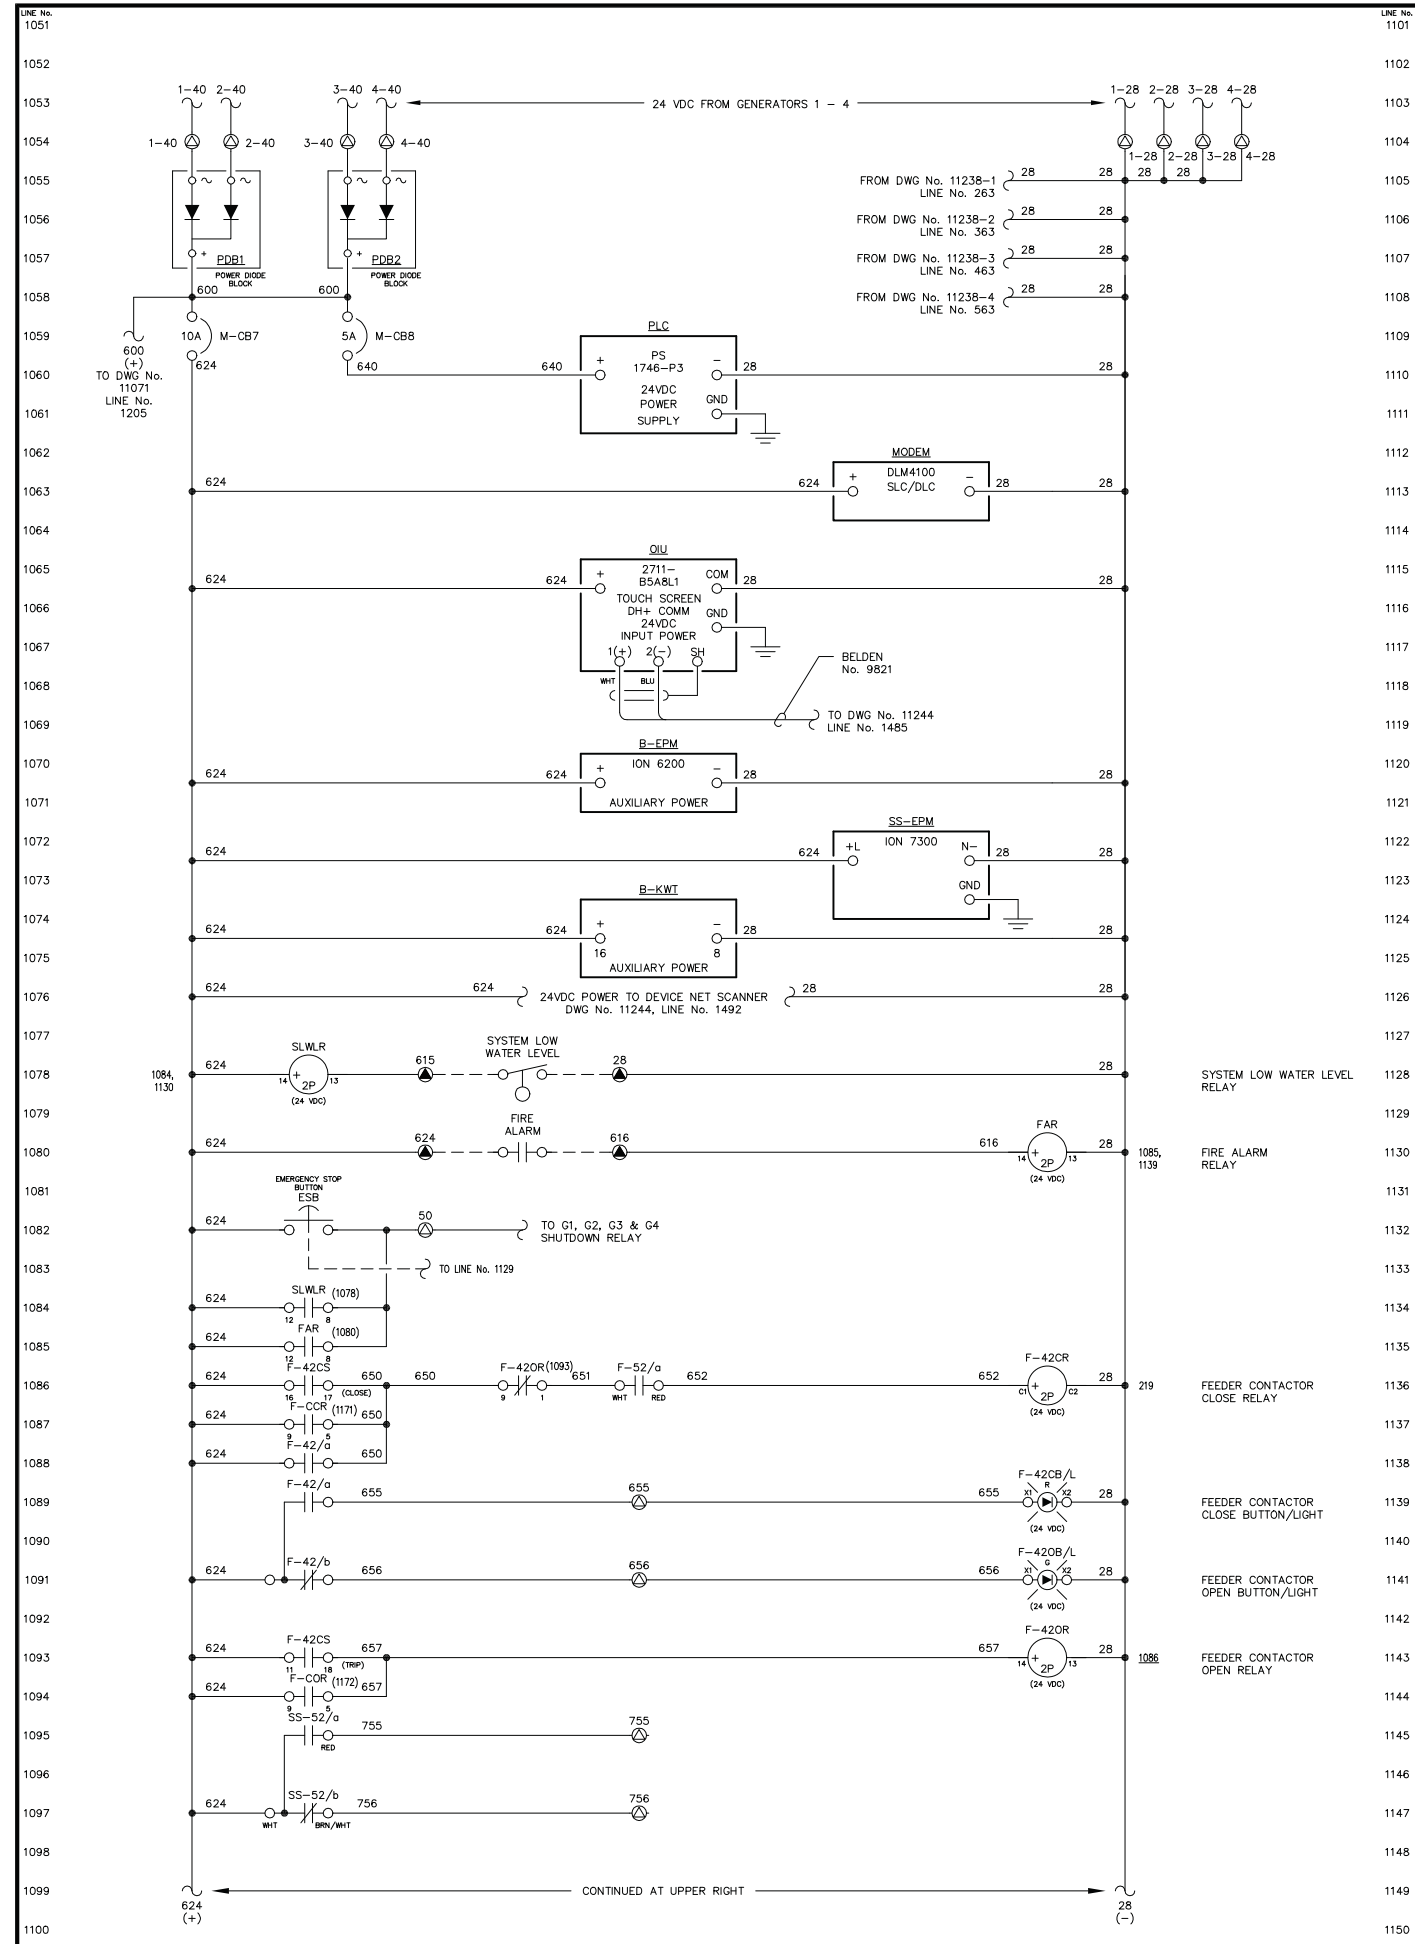

LINE No. 1101
1102
1103
1104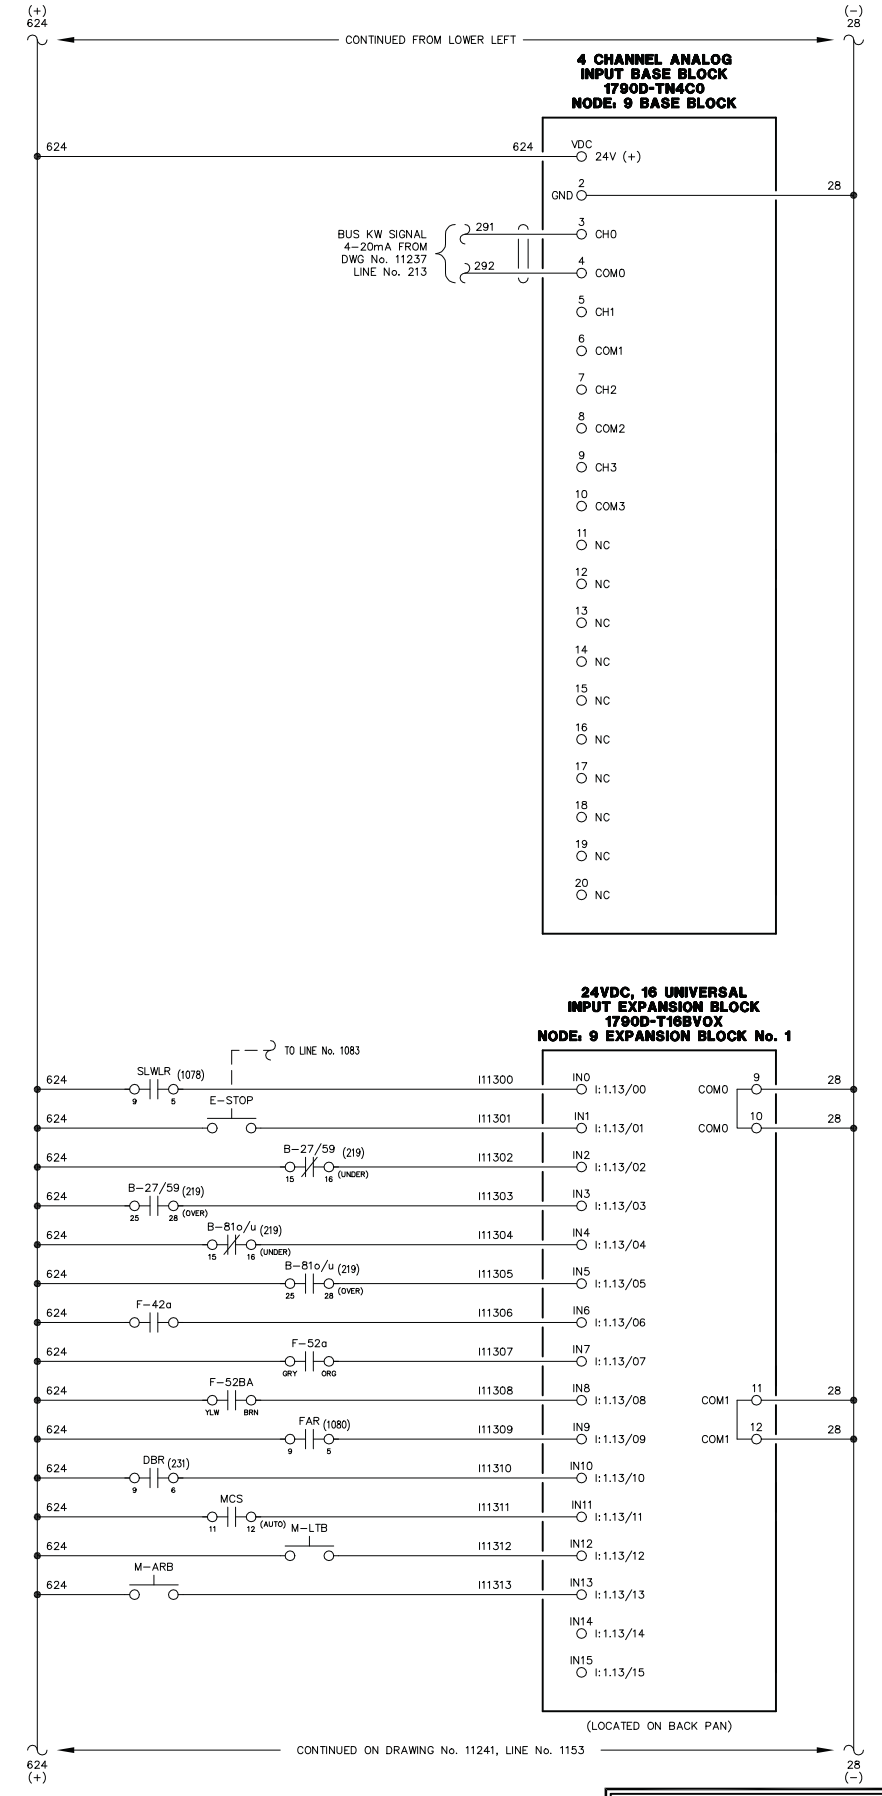
NOTE:
1. FOR GENERAL WIRING & CONSTRUCTION NOTES, SEE DRAWING No. 11231

B	09-05-03	SHOP AS BUILT	CMD
A	06-10-03	SUBMITTAL	CMD
REV.	DATE	DESCRIPTION	BY
PURCHASE ORDER No. 7086		CONTROLLED POWER JOB No. 5354	
TITLE: MASTER PLC INPUTS & OUTPUTS, SCHEMATIC DIAGRAM			
CPI DWG No. 11240			
SCALE: NONE	DATE: 06-10-03	DWN. BY: CMD	
DWG. No: 11240	SHEET: 1 OF 1	CKD. BY: JMD	
JOB: CHIGNIK LAKE			


NOTICE
THE DRAWINGS, INFORMATION AND SUBJECT MATTER HEREOF ARE THE CONFIDENTIAL, SOLE AND EXCLUSIVE PROPERTY OF CONTROLLED POWER, INC., AND ARE NOT TO BE COPIED, REPRODUCED OR USED IN ANY MANNER FOR ANY PURPOSE WHATSOEVER WITHOUT WRITTEN CONSENT OR DIRECTION.



The Lake and Peninsula School District
101 Jensen Drive
P.O. Box 498
King Salmon, Alaska 99613
Phone (907) 246-4280/Fax (907) 246-4473

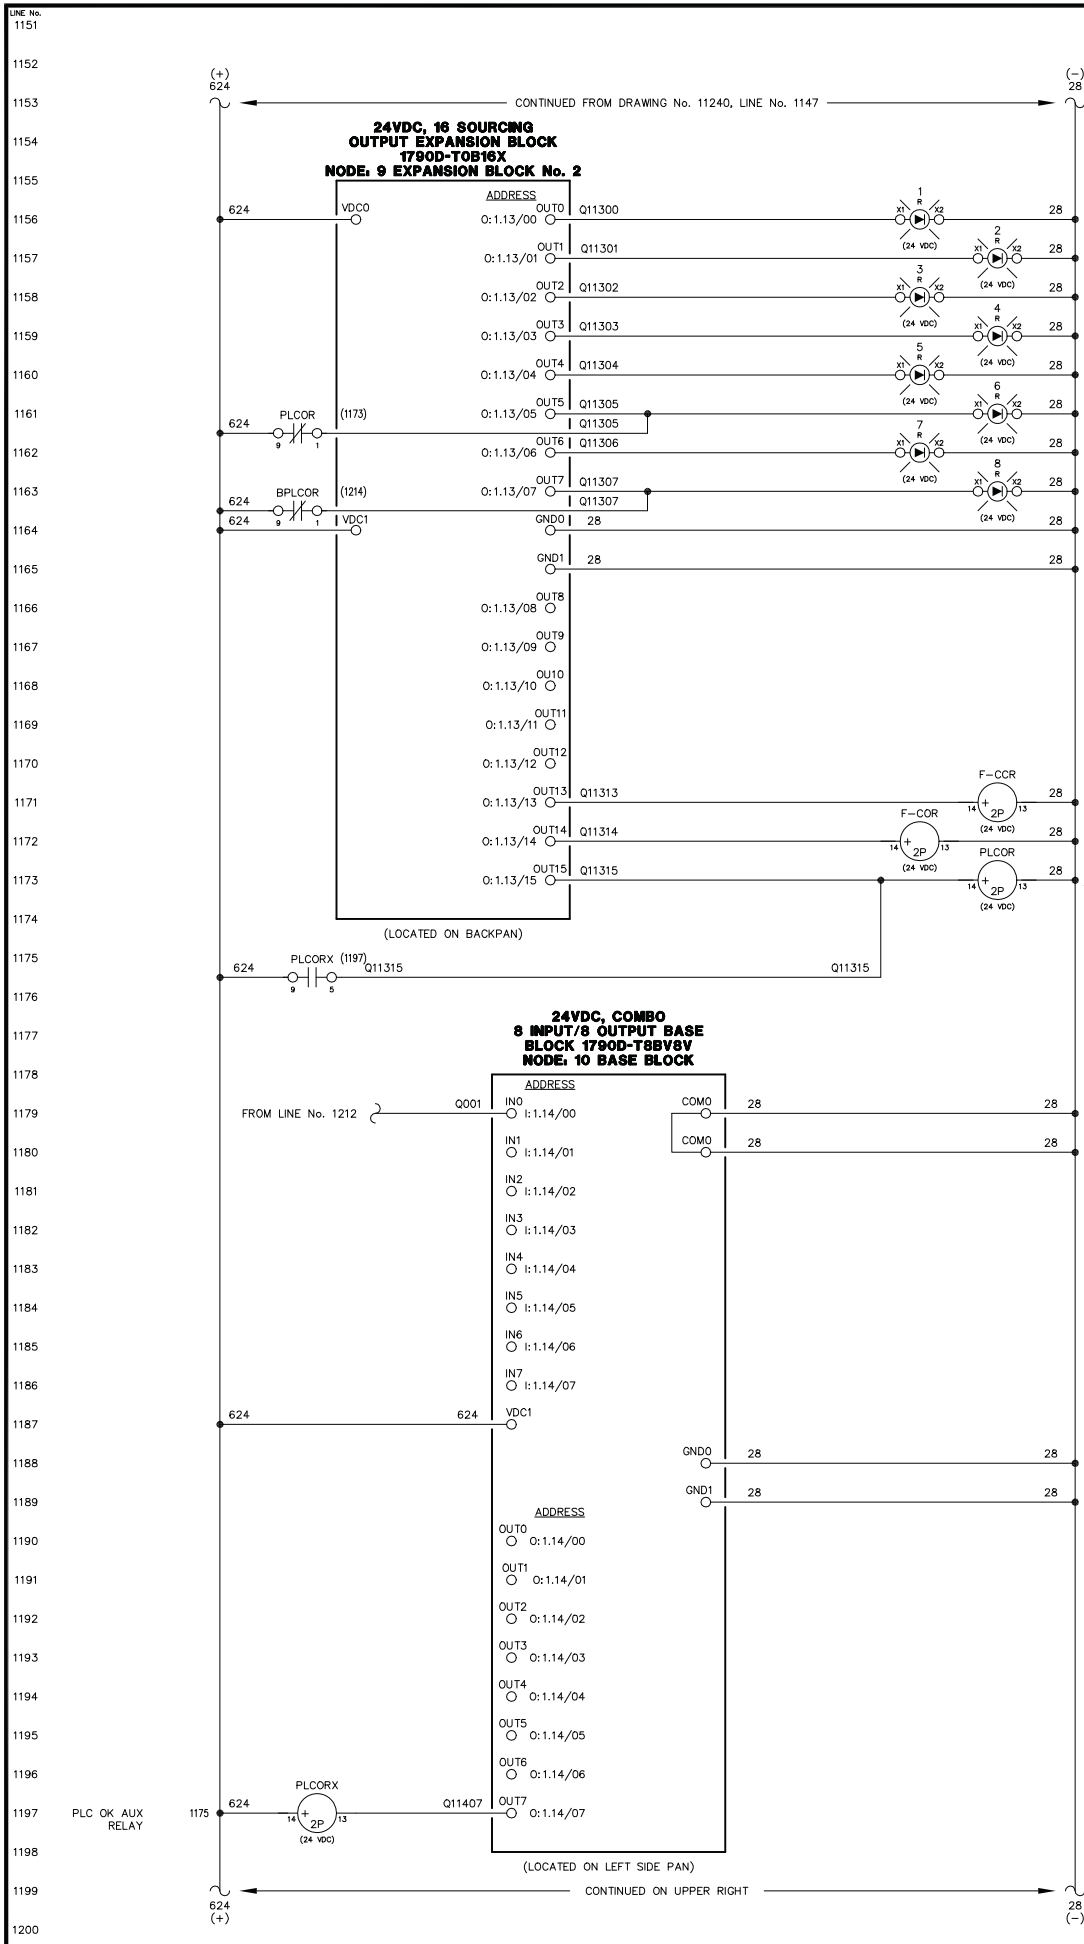

- FIRE ALARM LIGHT
- EMERGENCY STOP LIGHT
- SYSTEM LOW WATER LEVEL LIGHT
- BUS UNDER/OVER VOLTAGE LIGHT
- BUS UNDER/OVER FREQUENCY LIGHT
- PRIMARY PLC FAILURE LIGHT
- OPERATING ON BACKUP PLC LIGHT
- BACKUP PLC FAILURE LIGHT
- F-COR 1087
- F-COR 1094
- PLCOR 1161, 1209
- FEEDER CONTACTOR CLOSE RELAY
- FEEDER CONTACTOR OPEN RELAY
- PLC OK RELAY

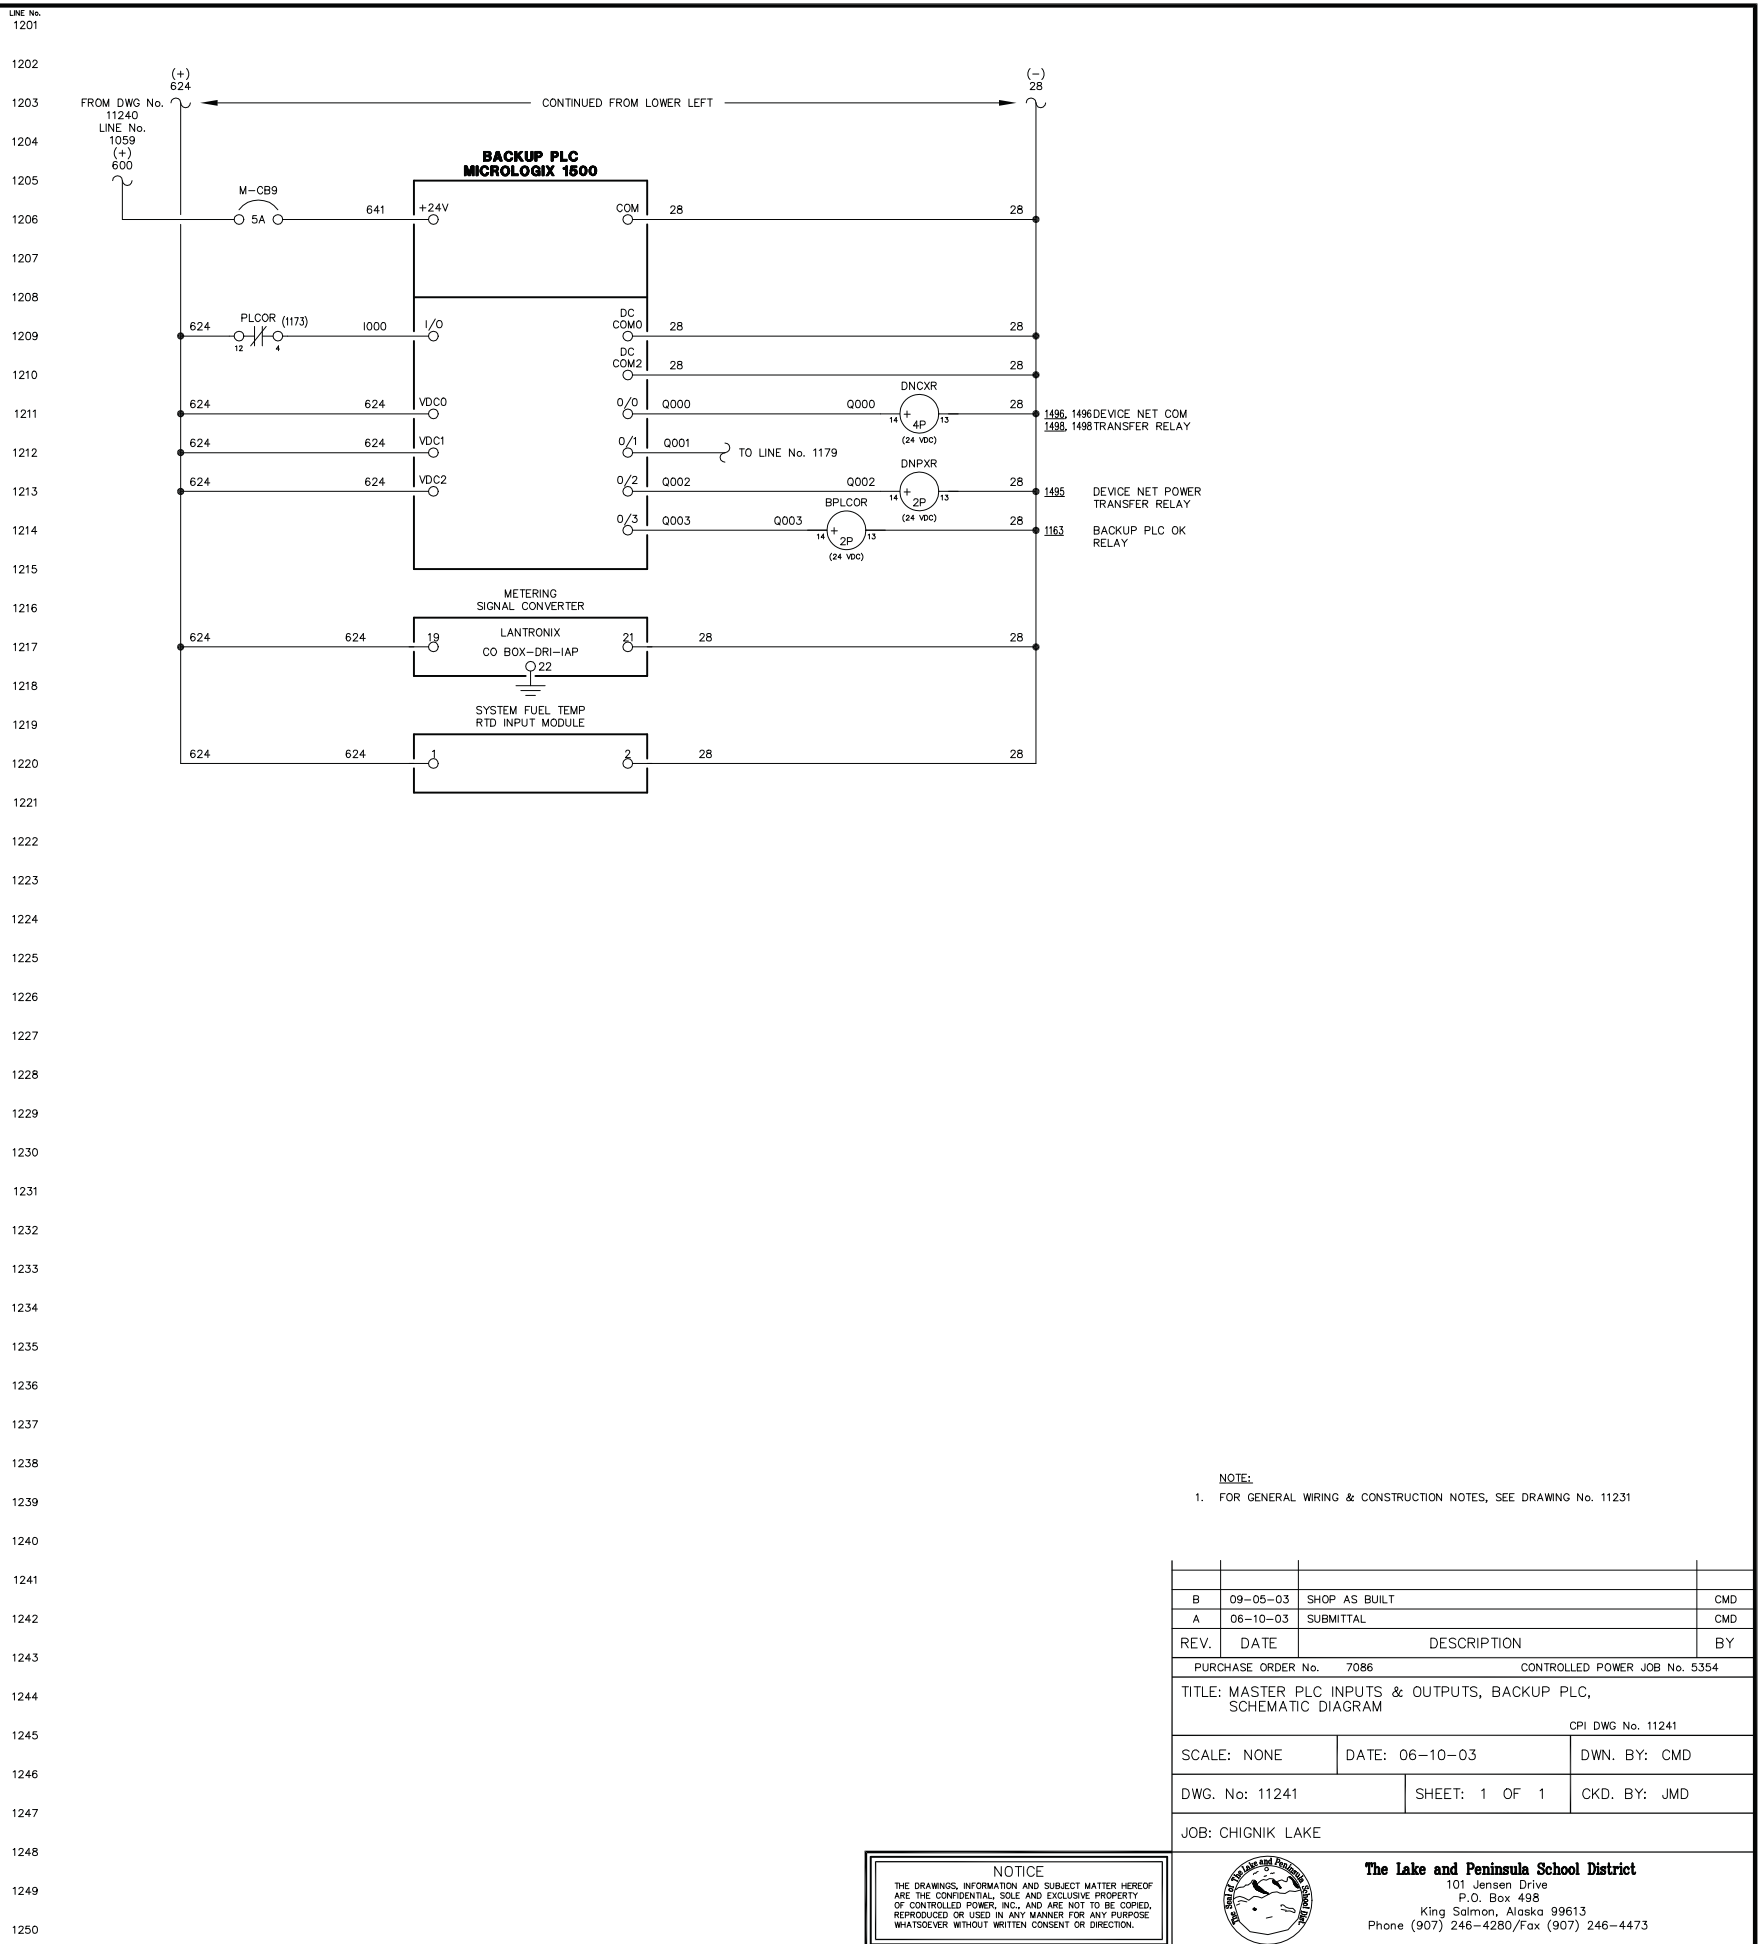

NOTE:
1. FOR GENERAL WIRING & CONSTRUCTION NOTES, SEE DRAWING No. 11231

B	09-05-03	SHOP AS BUILT	CMD
A	06-10-03	SUBMITTAL	CMD
REV.	DATE	DESCRIPTION	BY
PURCHASE ORDER No. 7086		CONTROLLED POWER JOB No. 5354	
TITLE: MASTER PLC INPUTS & OUTPUTS, BACKUP PLC, SCHEMATIC DIAGRAM			
CPI DWG No. 11241			
SCALE: NONE	DATE: 06-10-03	DWN. BY: CMD	
DWG. No: 11241	SHEET: 1 OF 1	CKD. BY: JMD	
JOB: CHIGNIK LAKE			


NOTICE
THE DRAWINGS, INFORMATION AND SUBJECT MATTER HEREOF ARE THE CONFIDENTIAL SOLE AND EXCLUSIVE PROPERTY OF CONTROLLED POWER, INC., AND ARE NOT TO BE COPIED, REPRODUCED OR USED IN ANY MANNER FOR ANY PURPOSE WHATSOEVER WITHOUT WRITTEN CONSENT OR DIRECTION.



The Lake and Peninsula School District
101 Jensen Drive
P.O. Box 498
King Salmon, Alaska 99613
Phone (907) 246-4280/Fax (907) 246-4473

LINE No.
1251
1252
1253
LINE No.
1301
1302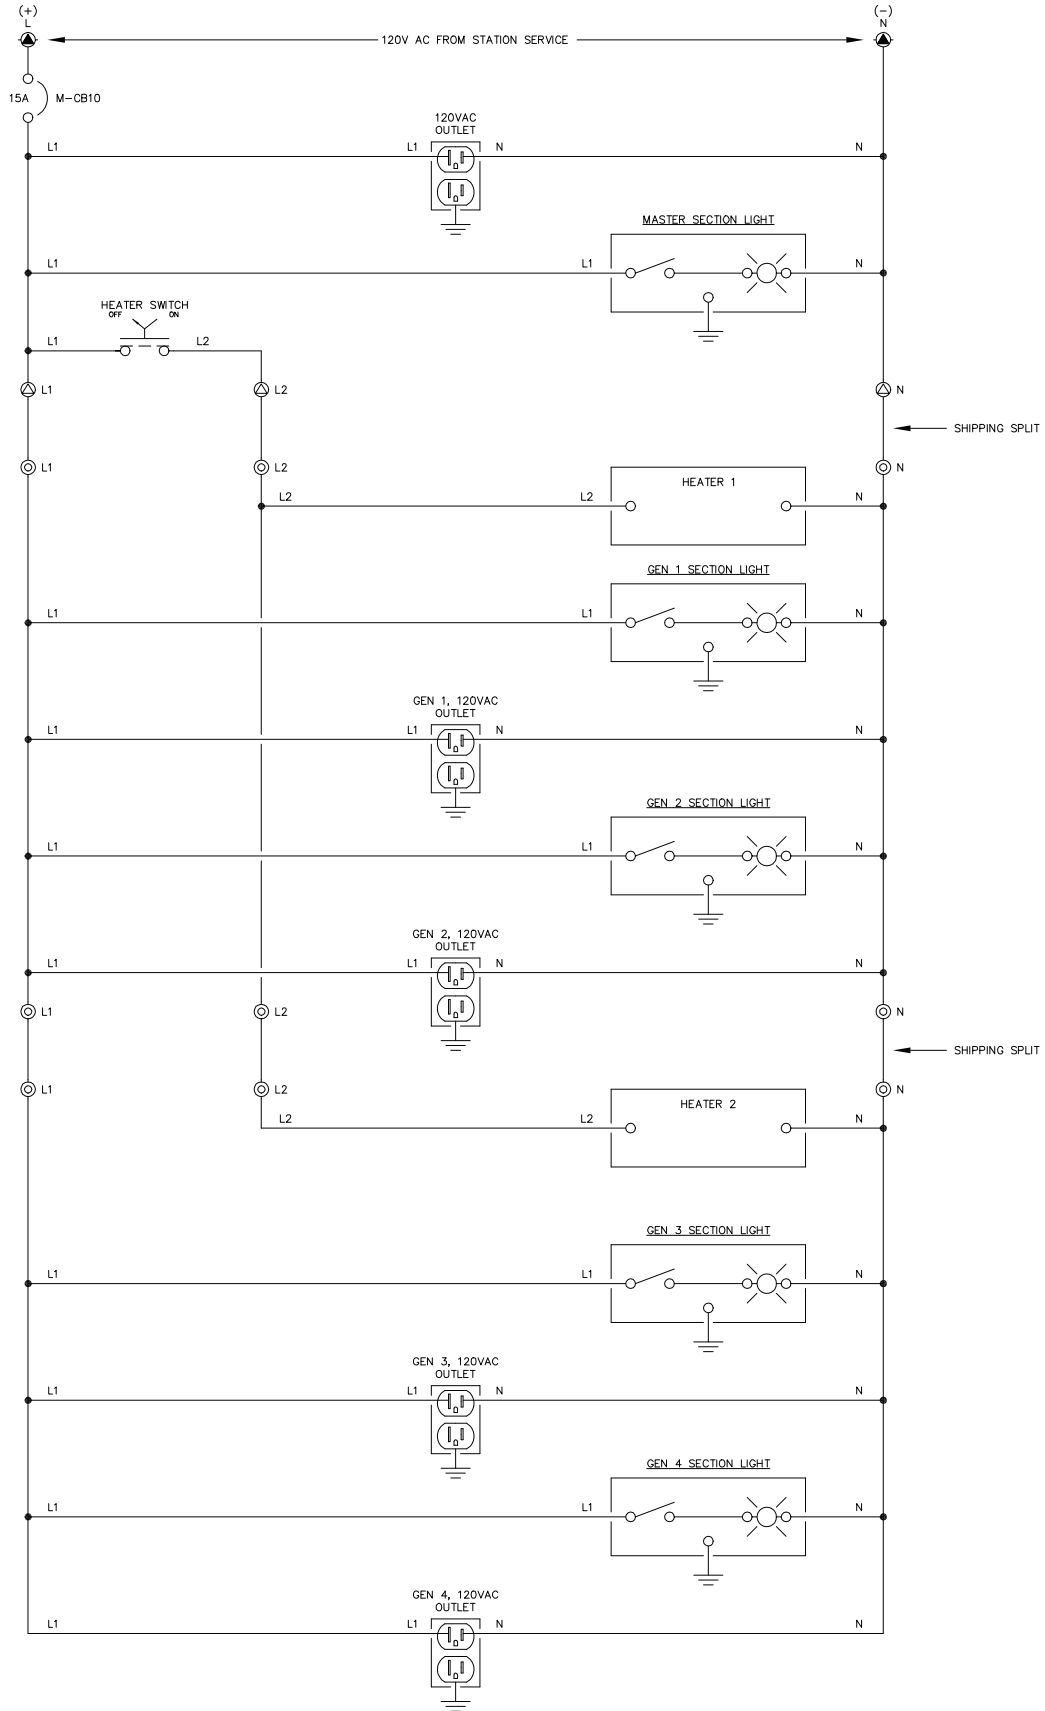
NOTE:
1. FOR GENERAL WIRING & CONSTRUCTION NOTES, SEE DRAWING No. 11231

REV.	DATE	DESCRIPTION	BY
B	09-05-03	SHOP AS BUILT	CMD
A	06-10-03	SUBMITTAL	CMD
PURCHASE ORDER No. 7086		CONTROLLED POWER JOB No. 5354	
TITLE: HEATER & LIGHTING CONTROL, SCHEMATIC DIAGRAM			
SCALE: NONE		DATE: 06-10-03	DWN. BY: CMD
DWG. No: 11242		SHEET: 1 OF 1	CKD. BY: JMD
JOB: CHIGNIK LAKE			

NOTICE
THE DRAWINGS, INFORMATION AND SUBJECT MATTER HEREOF ARE THE CONFIDENTIAL SOLE AND EXCLUSIVE PROPERTY OF CONTROLLED POWER, INC., AND ARE NOT TO BE COPIED, REPRODUCED OR USED IN ANY MANNER FOR ANY PURPOSE WHATSOEVER WITHOUT WRITTEN CONSENT OR DIRECTION.



The Lake and Peninsula School District
101 Jensen Drive
P.O. Box 498
King Salmon, Alaska 99613
Phone (907) 246-4280/Fax (907) 246-4473

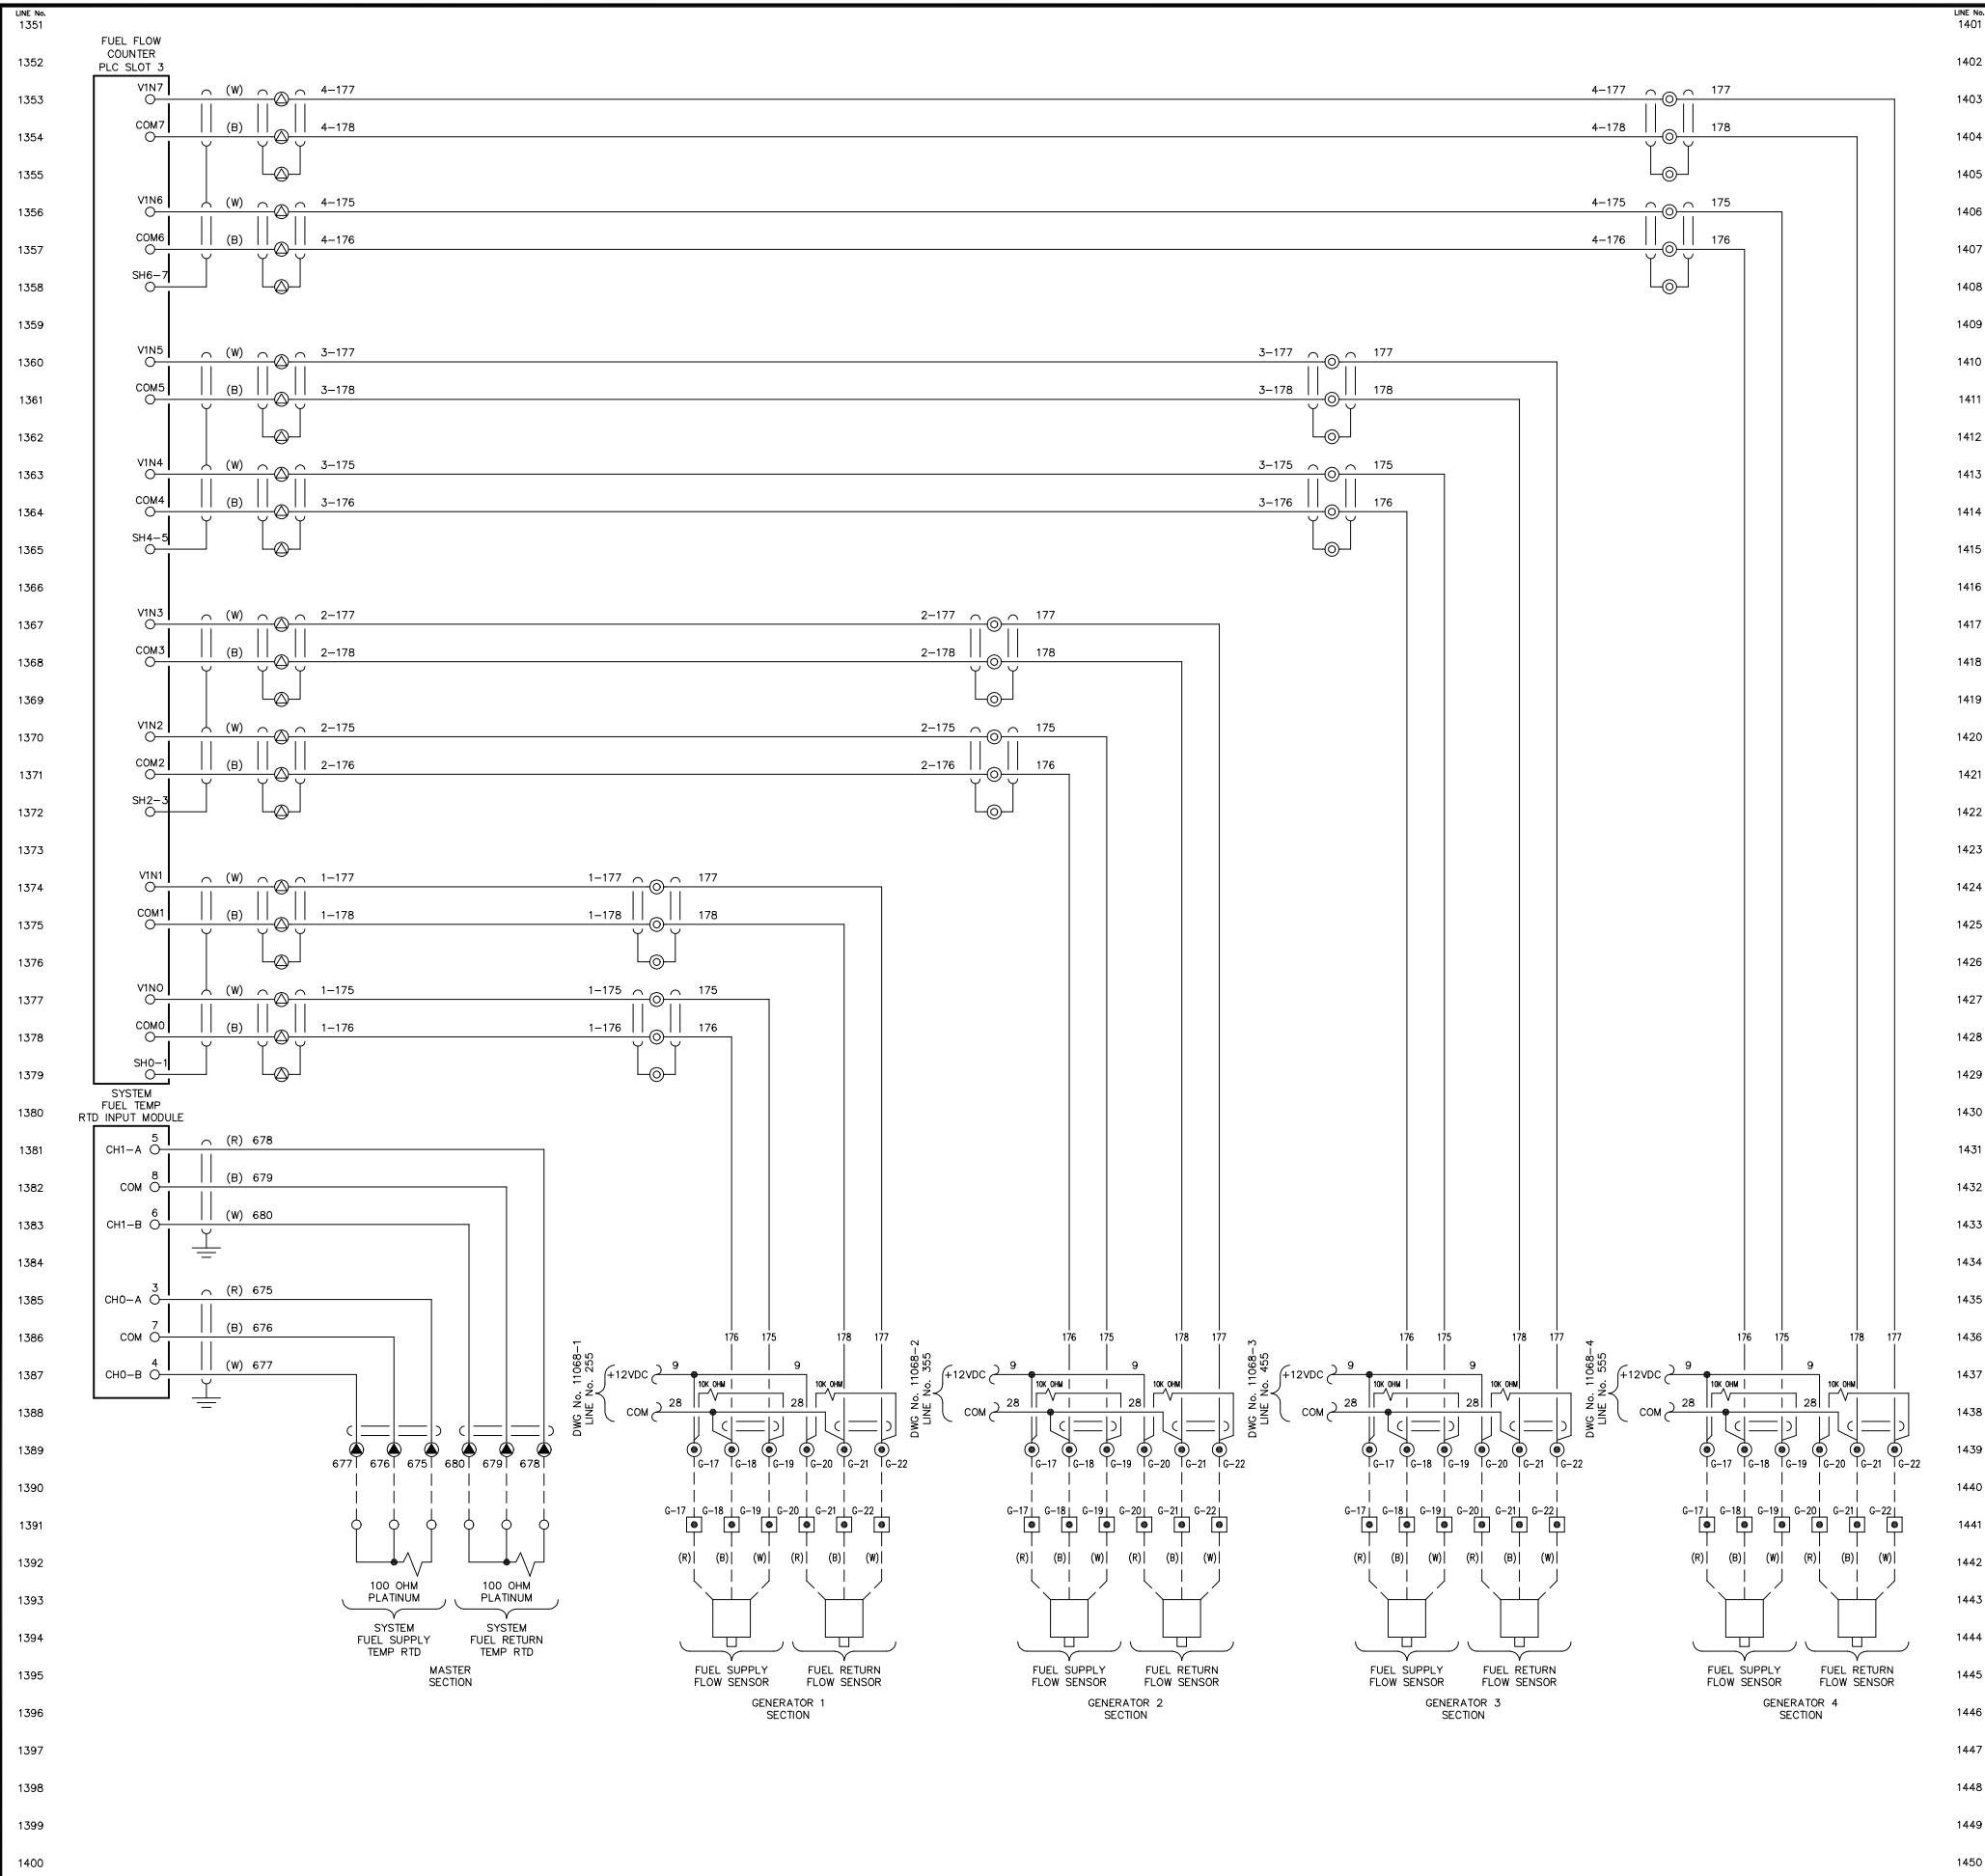

LINE No. 1401
1402
1403
1404
NOTE:
1. FOR GENERAL WIRING & CONSTRUCTION NOTES, SEE DRAWING No. 11231

B	09-05-03	SHOP AS BUILT	CMD
A	06-10-03	SUBMITTAL	CMD
REV.	DATE	DESCRIPTION	BY
PURCHASE ORDER No. 7086		CONTROLLED POWER JOB No. 5354	
TITLE: FUEL FLOW SYSTEM WIRING, SCHEMATIC DIAGRAM			CPI DWG No. 11243
SCALE: NONE	DATE: 06-10-03	DWN. BY: CMD	
DWG. No: 11243	SHEET: 1 OF 1	CKD. BY: JMD	
JOB: CHIGNIK LAKE			

NOTICE
THE DRAWINGS, INFORMATION AND SUBJECT MATTER HEREOF ARE THE CONFIDENTIAL SOLE AND EXCLUSIVE PROPERTY OF CONTROLLED POWER, INC. AND ARE NOT TO BE COPIED, REPRODUCED OR USED IN ANY MANNER FOR ANY PURPOSE WHATSOEVER WITHOUT WRITTEN CONSENT OR DIRECTION.



The Lake and Peninsula School District
101 Jensen Drive
P.O. Box 498
King Salmon, Alaska 99613
Phone (907) 246-4280/Fax (907) 246-4473

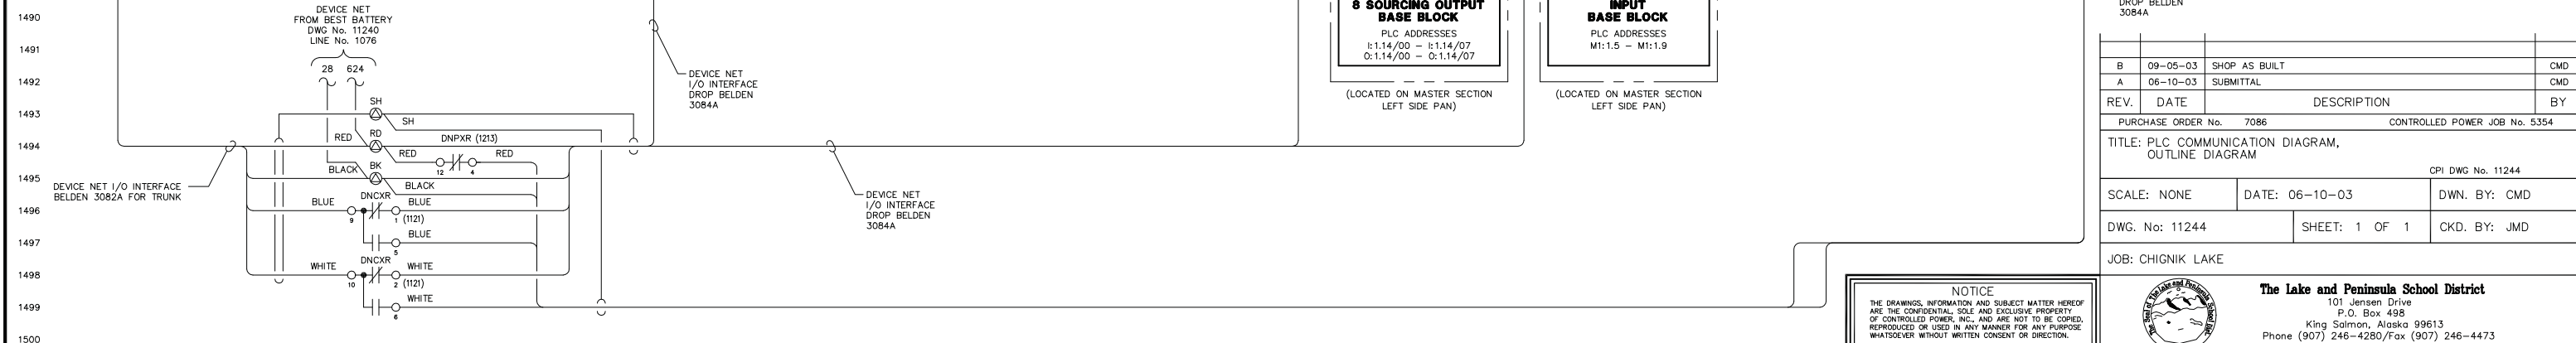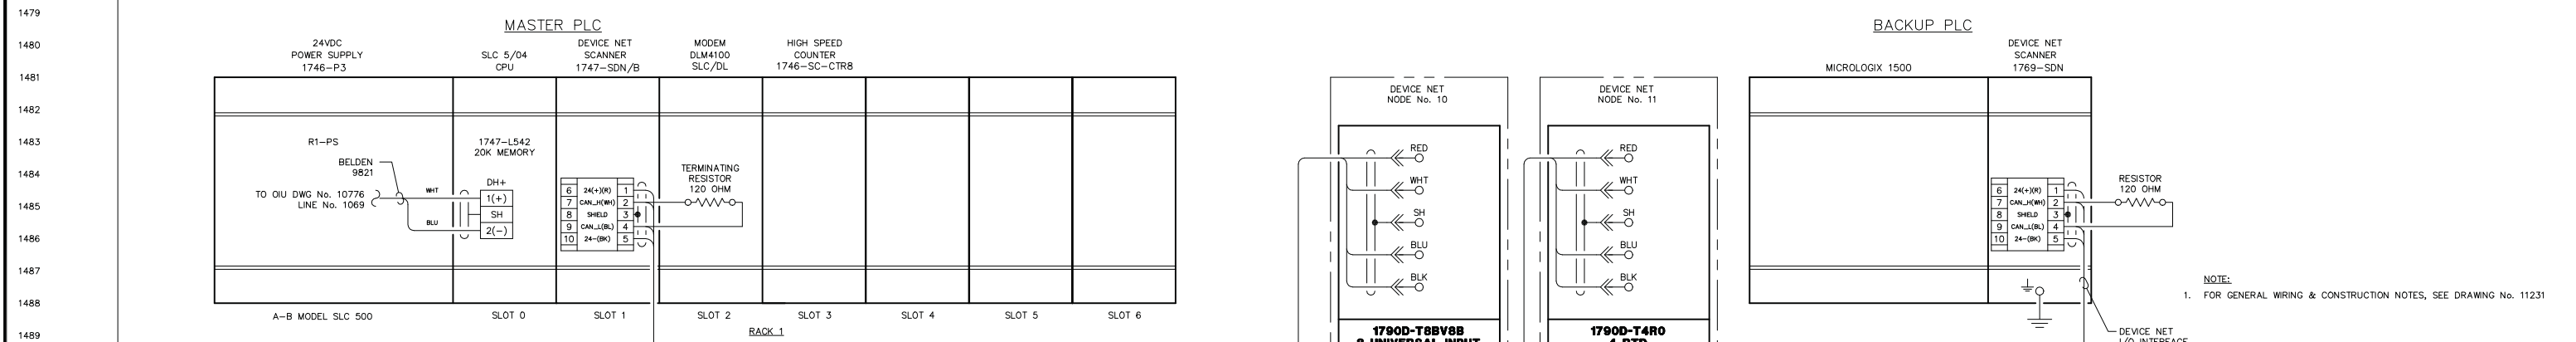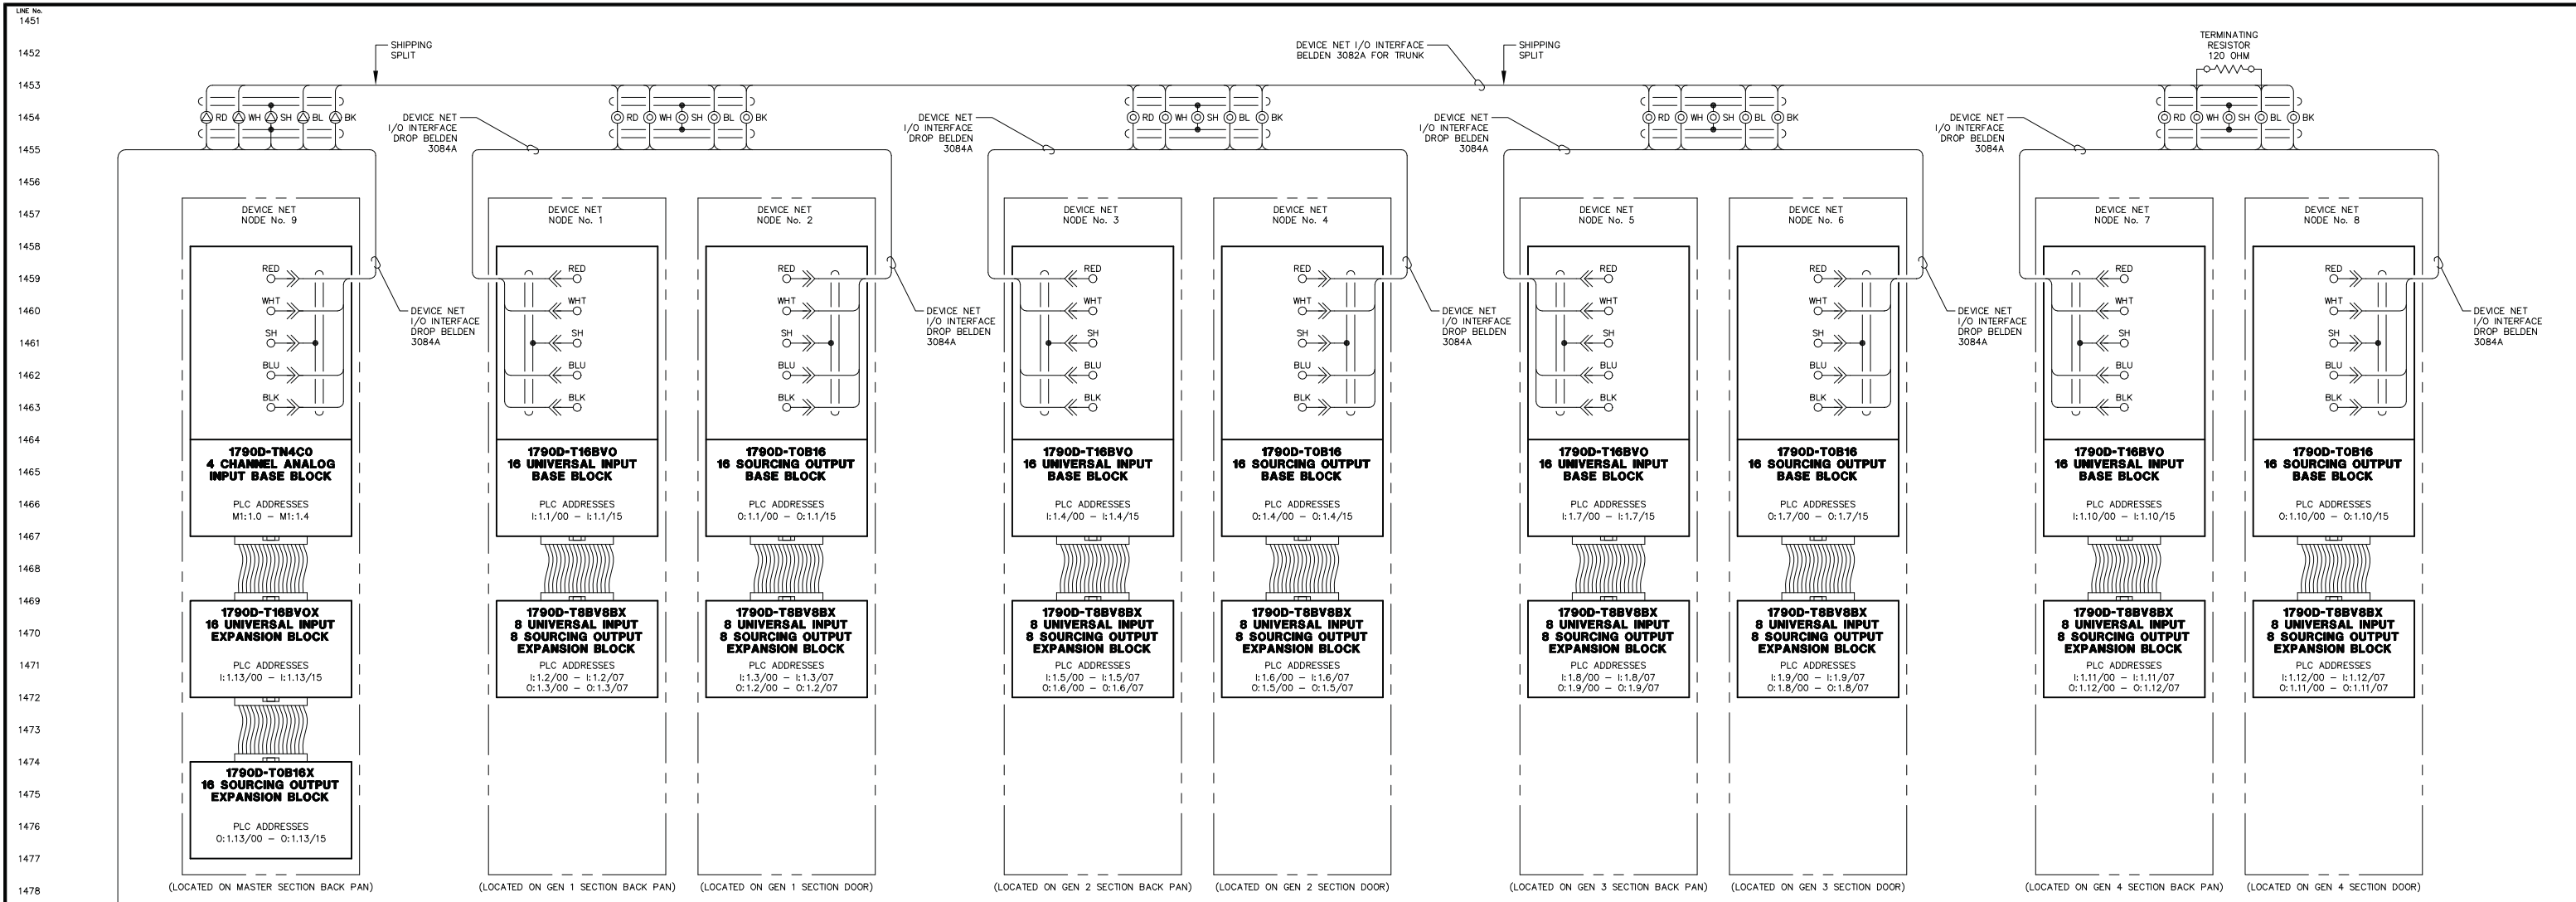

REV.	DATE	DESCRIPTION	BY
B	09-05-03	SHOP AS BUILT	CMD
A	06-10-03	SUBMITTAL	CMD

PURCHASE ORDER No. 7086 CONTROLLED POWER JOB No. 5354

TITLE: PLC COMMUNICATION DIAGRAM, OUTLINE DIAGRAM

SCALE: NONE DATE: 06-10-03 DWN. BY: CMD

DWG. No: 11244 SHEET: 1 OF 1 CKD. BY: JMD


JOB: CHIGNIK LAKE

The Lake and Peninsula School District
 101 Jensen Drive
 P.O. Box 498
 King Salmon, Alaska 99613
 Phone (907) 246-4280/Fax (907) 246-4473

NOTICE: THE DRAWINGS, INFORMATION AND SUBJECT MATTER HEREOF ARE THE CONFIDENTIAL, SOLE AND EXCLUSIVE PROPERTY OF CONTROLLED POWER, INC. AND ARE NOT TO BE COPIED, REPRODUCED OR USED IN ANY MANNER FOR ANY PURPOSE WHATSOEVER WITHOUT WRITTEN CONSENT OR DIRECTION.

Plot date: 2003/9/17 - 10:23

LINE No.
1501
1502
1503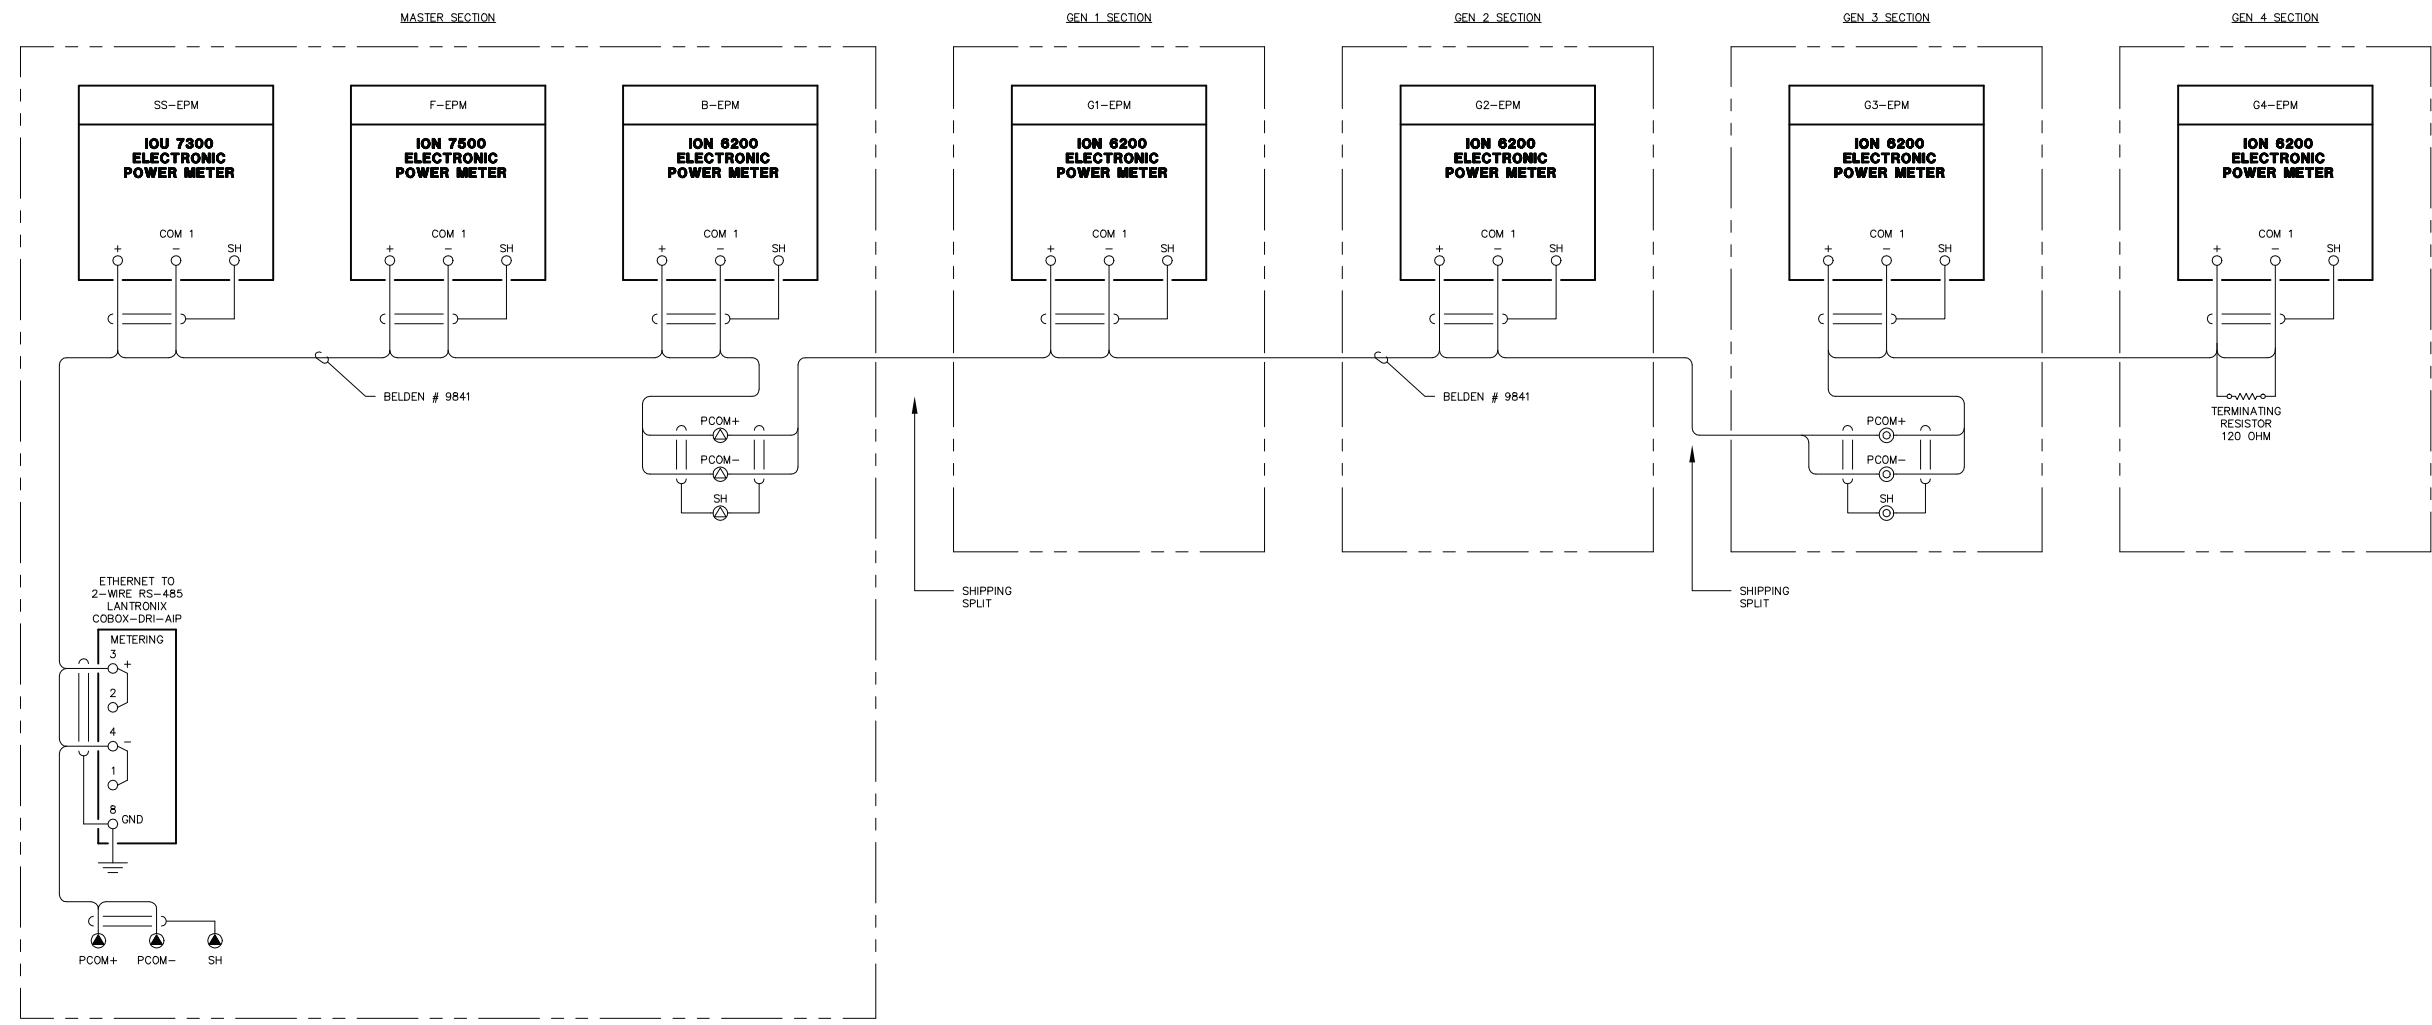
NOTE:
1. FOR GENERAL WIRING & CONSTRUCTION NOTES, SEE DRAWING No. 11231

B	09-05-03	SHOP AS BUILT	CMD
A	06-10-03	SUBMITTAL	CMD
REV.	DATE	DESCRIPTION	BY
PURCHASE ORDER No. 7086		CONTROLLED POWER JOB No. 5354	
TITLE: EPM FUEL MONITORING, COMMUNICATION DIAGRAM			CPI DWG No. 11245
SCALE: NONE	DATE: 06-10-03	DWN. BY: CMD	
DWG. No: 11245	SHEET: 1 OF 1	CKD. BY: JMD	
JOB: CHIGNIK LAKE			

NOTICE
THE DRAWINGS, INFORMATION AND SUBJECT MATTER HEREOF ARE THE CONFIDENTIAL SOLE AND EXCLUSIVE PROPERTY OF CONTROLLED POWER, INC., AND ARE NOT TO BE COPIED, REPRODUCED OR USED IN ANY MANNER FOR ANY PURPOSE WHATSOEVER WITHOUT WRITTEN CONSENT OR DIRECTION.




The Lake and Peninsula School District
101 Jensen Drive
P.O. Box 498
King Salmon, Alaska 99613
Phone (907) 246-4280/Fax (907) 246-4473

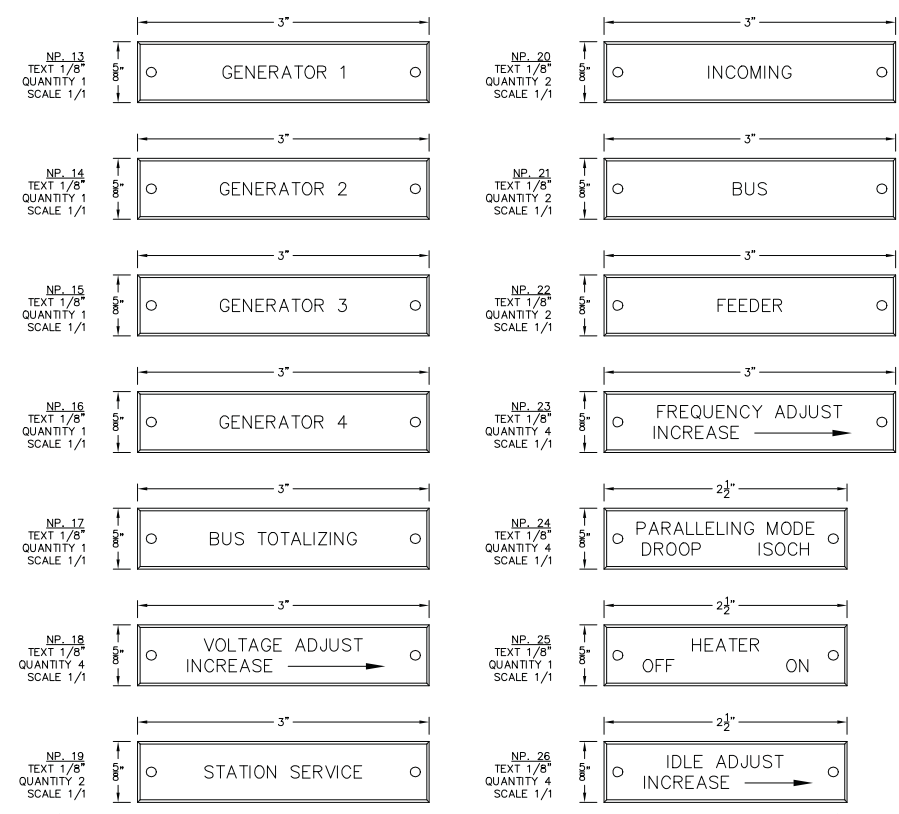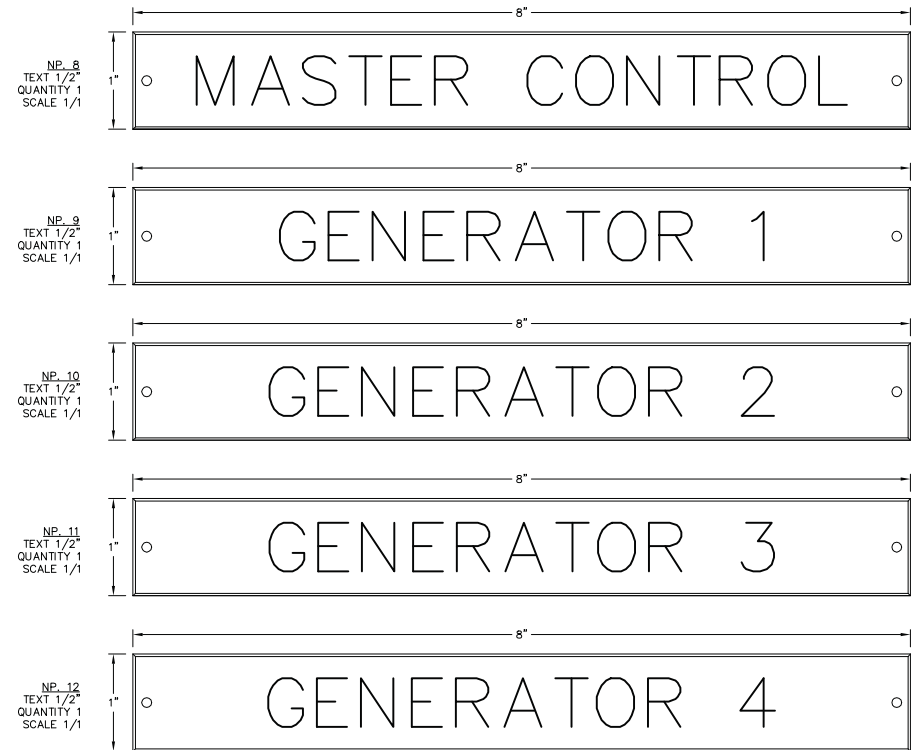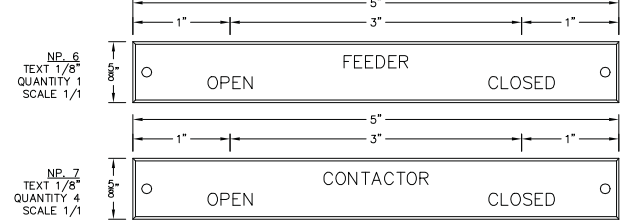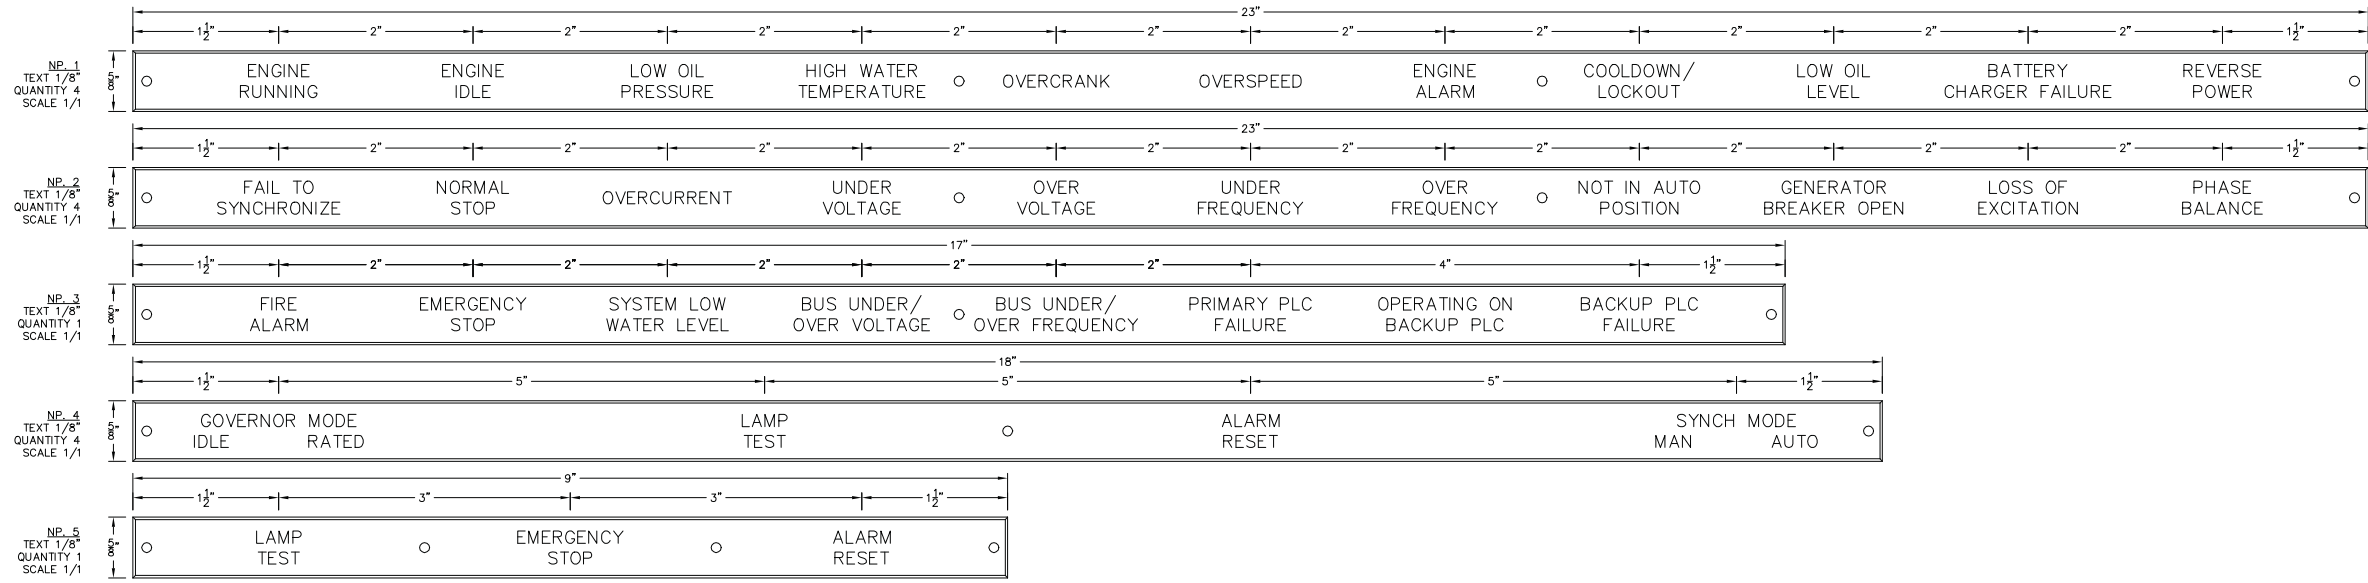

NP-27
TEXT 1/4"
QUANTITY 1
SCALE 1/1
SEE NOTE 4

MANUFACTURED BY:
CONTROLLED POWER, INC.
17909 BOTHELL EVERETT HWY., S.E. #102
BOTHELL, WA. 98012
(425)-485-1778
SERIAL NUMBER: 5354

- NOTES:
- ALL NAMEPLATES SHALL BE BLACK FACE WITH WHITE LETTERS EXCEPT AS NOTED.
 - ALL NAMEPLATES SHALL HAVE PRESSURE SENSITIVE ADHESIVE ON BACK, 100 % COVERAGE.
 - ALL NAMEPLATES SHALL HAVE MOUNTING HOLES DRILLED, (1) EACH END.
- INDICATES THAT NAMEPLATE SHALL BE BRUSHED ALUMINUM WITH BLACK ENGRAVED LETTERS.
- NOTE:
- FOR GENERAL WIRING & CONSTRUCTION NOTES, SEE DRAWING No. 11231.

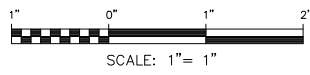


NOTICE
THE DRAWINGS, INFORMATION AND SUBJECT MATTER HEREOF ARE THE CONFIDENTIAL SOLE AND EXCLUSIVE PROPERTY OF CONTROLLED POWER, INC. AND ARE NOT TO BE COPIED, REPRODUCED OR USED IN ANY MANNER FOR ANY PURPOSE WHATSOEVER WITHOUT WRITTEN CONSENT OR DIRECTION.

B	09-05-03	SHOP AS BUILT	CMD
A	06-10-03	SUBMITTAL	CMD
REV.	DATE	DESCRIPTION	BY
PURCHASE ORDER No. 7086		CONTROLLED POWER JOB No. 5354	
TITLE: NAMEPLATE ENGRAVING SCHEDULE FABRICATION DIAGRAM			
SCALE: NONE		DATE: 06-10-03	CPI DWG No. 11246
DWN. BY: CMD		DWG. No: 11246	
SHEET: 1 OF 1		CKD. BY: JMD	
JOB: CHIGNIK LAKE			



The Lake and Peninsula School District
101 Jensen Drive
P.O. Box 498
King Salmon, Alaska 99613
Phone (907) 246-4280/Fax (907) 246-4473


ENGINE CONTROL SWITCH - ECS

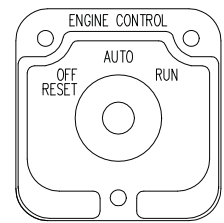

(ELECTROSWITCH 24304C-S)
ROUND KNURLED HANDLE
QTY 4

DECK	CONTACTS	POS.			
		OFF	AUTO	RUN	
1	11	X	X		
	14			X	X
	15			X	X
2	21	X	X		
	24			X	X
	25			X	X
3	31	X	X		
	34			X	X
	35			X	X
4	41	X	X		
	44			X	X
	45			X	X


MASTER CONTROL SWITCH - MCS

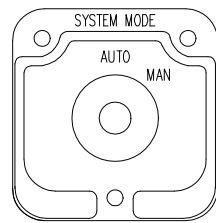

(ELECTROSWITCH 24201C)
KNURLED HANDLE
QTY 1

DECK	CONTACTS	POS.	
		AUTO	MAN
1	12	X	X
	13		X
	15		X
16	16	X	X
	17		X


SYNCHRONIZING SWITCH - SS

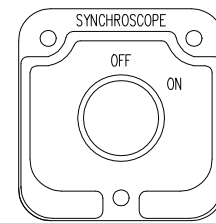

(ELECTROSWITCH 2424E)
OVAL HANDLE
QTY 4

DECK	CONTACTS	POS.	
		OFF	ON
1	12	X	X
	16		X
	22		X
2	26	X	X
	27		X
	32		X
3	36	X	X
	37		X


CONTACTOR CONTROL SWITCH - F-42CS

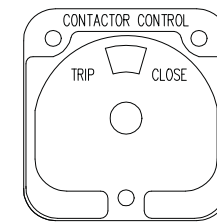

(ELECTROSWITCH 2438D)
PISTOL GRIP HANDLE
SPRING RETURN TO CENTER
QTY 1


DECK	CONTACTS	POS.	
		TRIP	CLOSE
1	11	X	X
	16		X

SYNCHRONIZING MODE SWITCH - SMS

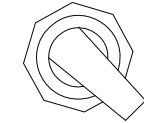


(MAINTAINED POSITION)

POS	SMS	
	MAN	AUTO
MAN	X	
AUTO		X

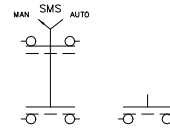

GOVERNOR MODE SWITCH - GMS

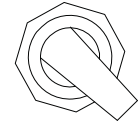


(MAINTAINED POSITION)

POS	GMS	
	IDLE	RATED
IDLE	X	
RATED		X



PARALLELING MODE SWITCH - PMS

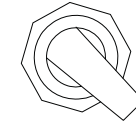


(MAINTAINED POSITION)
LOCATED ON BACK PAN

POS	PMS	
	DROOP	ISOCH
DROOP	X	
ISOCH		X



HEATER CONTROL SWITCH - HCS

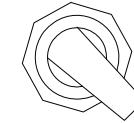


(MAINTAINED POSITION)
LOCATED ON MASTER BACK PAN

POS	HCS	
	OFF	ON
OFF	X	
ON		X



CONTACTOR CONTROL SWITCH - G1, G2, G3 & G4-42CS

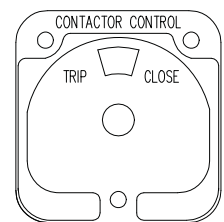

(ELECTROSWITCH 2444D)
PISTOL GRIP HANDLE
SPRING RETURN TO CENTER
QTY 4

DECK	CONTACTS	POS.		
		TRIP	NAT	CLOSE
1	11	X		
	16			X
2	21	X	X	
	25			X
3	32	X	X	
	36			X

NOTE:


- FOR GENERAL WIRING & CONSTRUCTION NOTES, SEE DRAWING No. 11231

B	09-05-03	SHOP AS BUILT	CMD
A	06-10-03	SUBMITTAL	CMD
REV.	DATE	DESCRIPTION	BY
PURCHASE ORDER No. 7086		CONTROLLED POWER JOB No. 5354	
TITLE: CONTROL SWITCH TARGET DIAGRAM			
CPI DWG No. 11247			
SCALE: NONE	DATE: 06-10-03	DWN. BY: CMD	
DWG. No: 11247	SHEET: 1 OF 1	CKD. BY: JMD	
JOB: CHIGNIK LAKE			

NOTICE
THE DRAWINGS, INFORMATION AND SUBJECT MATTER HEREOF ARE THE CONFIDENTIAL SOLE AND EXCLUSIVE PROPERTY OF CONTROLLED POWER, INC., AND ARE NOT TO BE COPIED, REPRODUCED OR USED IN ANY MANNER FOR ANY PURPOSE WHATSOEVER WITHOUT WRITTEN CONSENT OR DIRECTION.



The Lake and Peninsula School District
101 Jensen Drive
P.O. Box 498
King Salmon, Alaska 99613
Phone (907) 246-4280/Fax (907) 246-4473

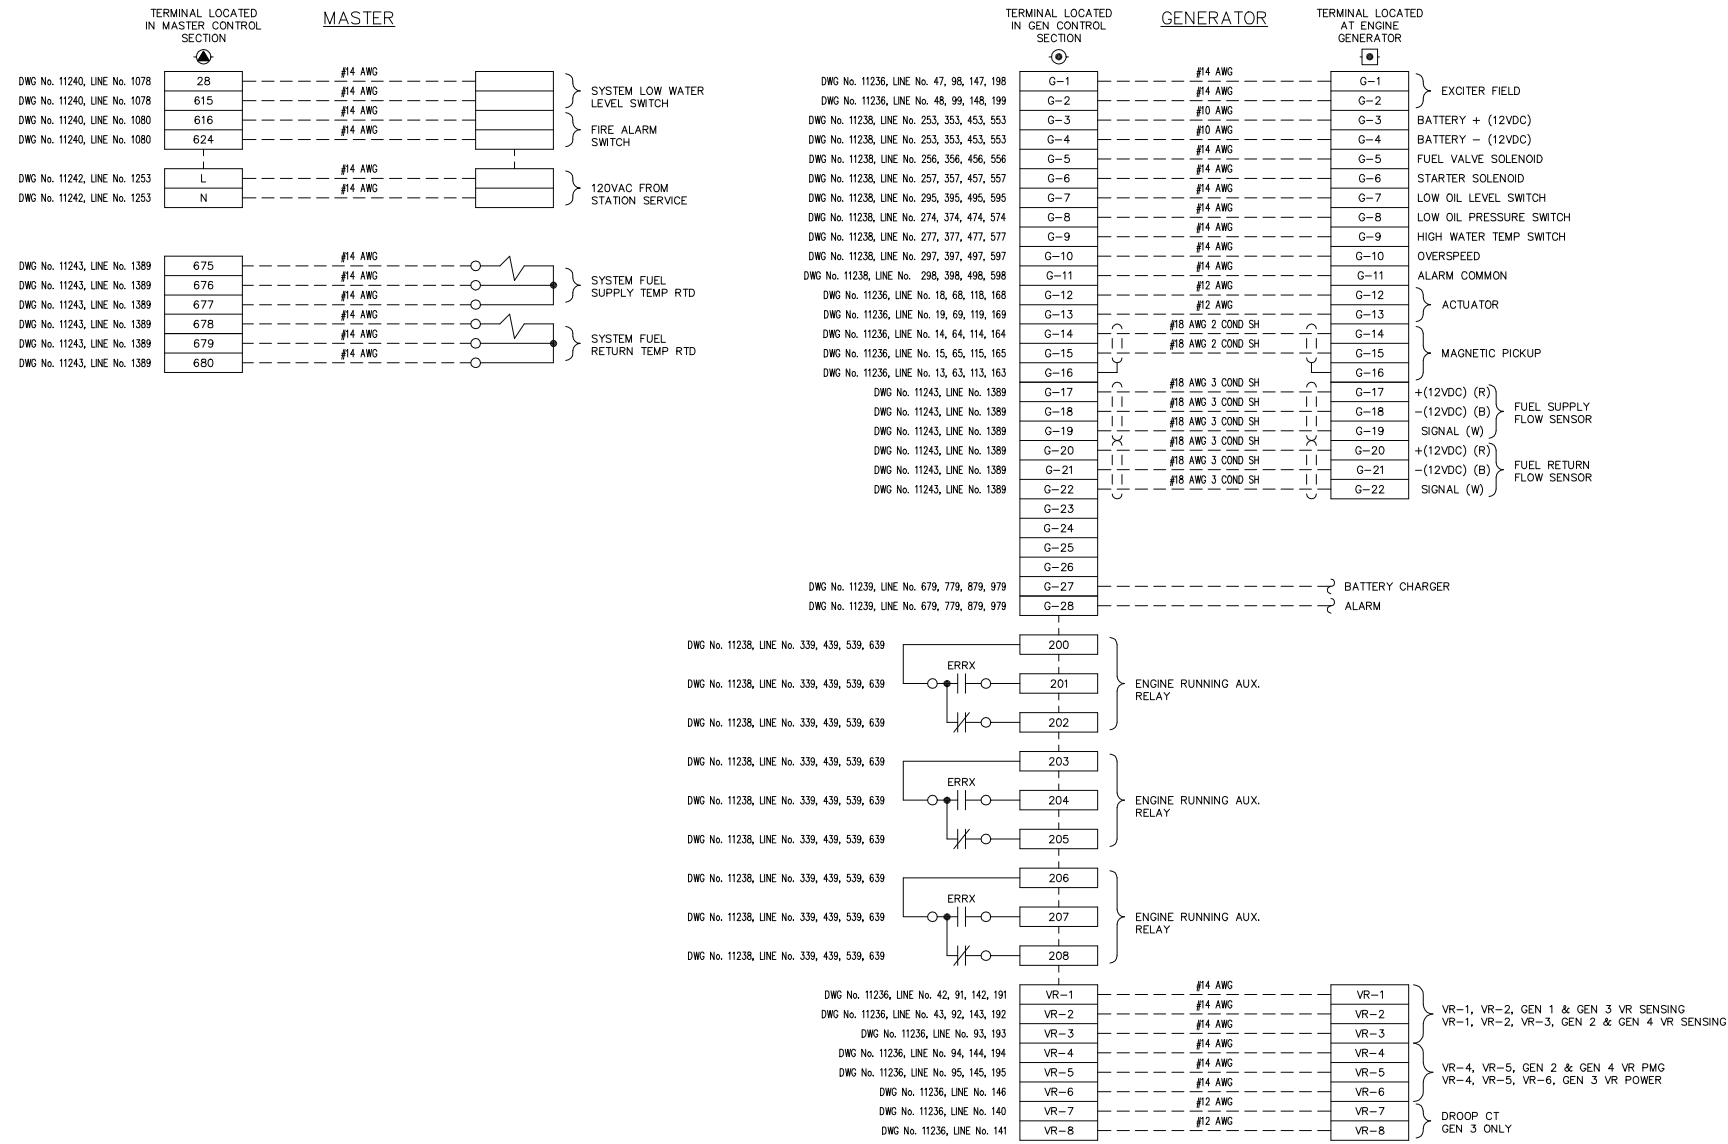


NOTE:
 1. FOR GENERAL WIRING & CONSTRUCTION NOTES, SEE DRAWING No. 11231

REV.	DATE	DESCRIPTION	BY
B	09-05-03	SHOP AS BUILT	CMD
A	06-10-03	SUBMITTAL	CMD
PURCHASE ORDER No. 7086 CONTROLLED POWER JOB No. 5354			
TITLE: FIELD CONNECTION DIAGRAM			
CPI DWG No. 11248			
SCALE: NONE	DATE: 06-10-03	DWN. BY: CMD	
DWG. No: 11248	SHEET: 1 OF 1	CKD. BY: JMD	
JOB: CHIGNIK LAKE			

NOTICE
 THE DRAWINGS, INFORMATION AND SUBJECT MATTER HEREOF ARE THE CONFIDENTIAL SOLE AND EXCLUSIVE PROPERTY OF CONTROLLED POWER, INC., AND ARE NOT TO BE COPIED, REPRODUCED OR USED IN ANY MANNER FOR ANY PURPOSE WHATSOEVER WITHOUT WRITTEN CONSENT OR DIRECTION.



The Lake and Peninsula School District
 101 Jensen Drive
 P.O. Box 498
 King Salmon, Alaska 99613
 Phone (907) 246-4280/Fax (907) 246-4473

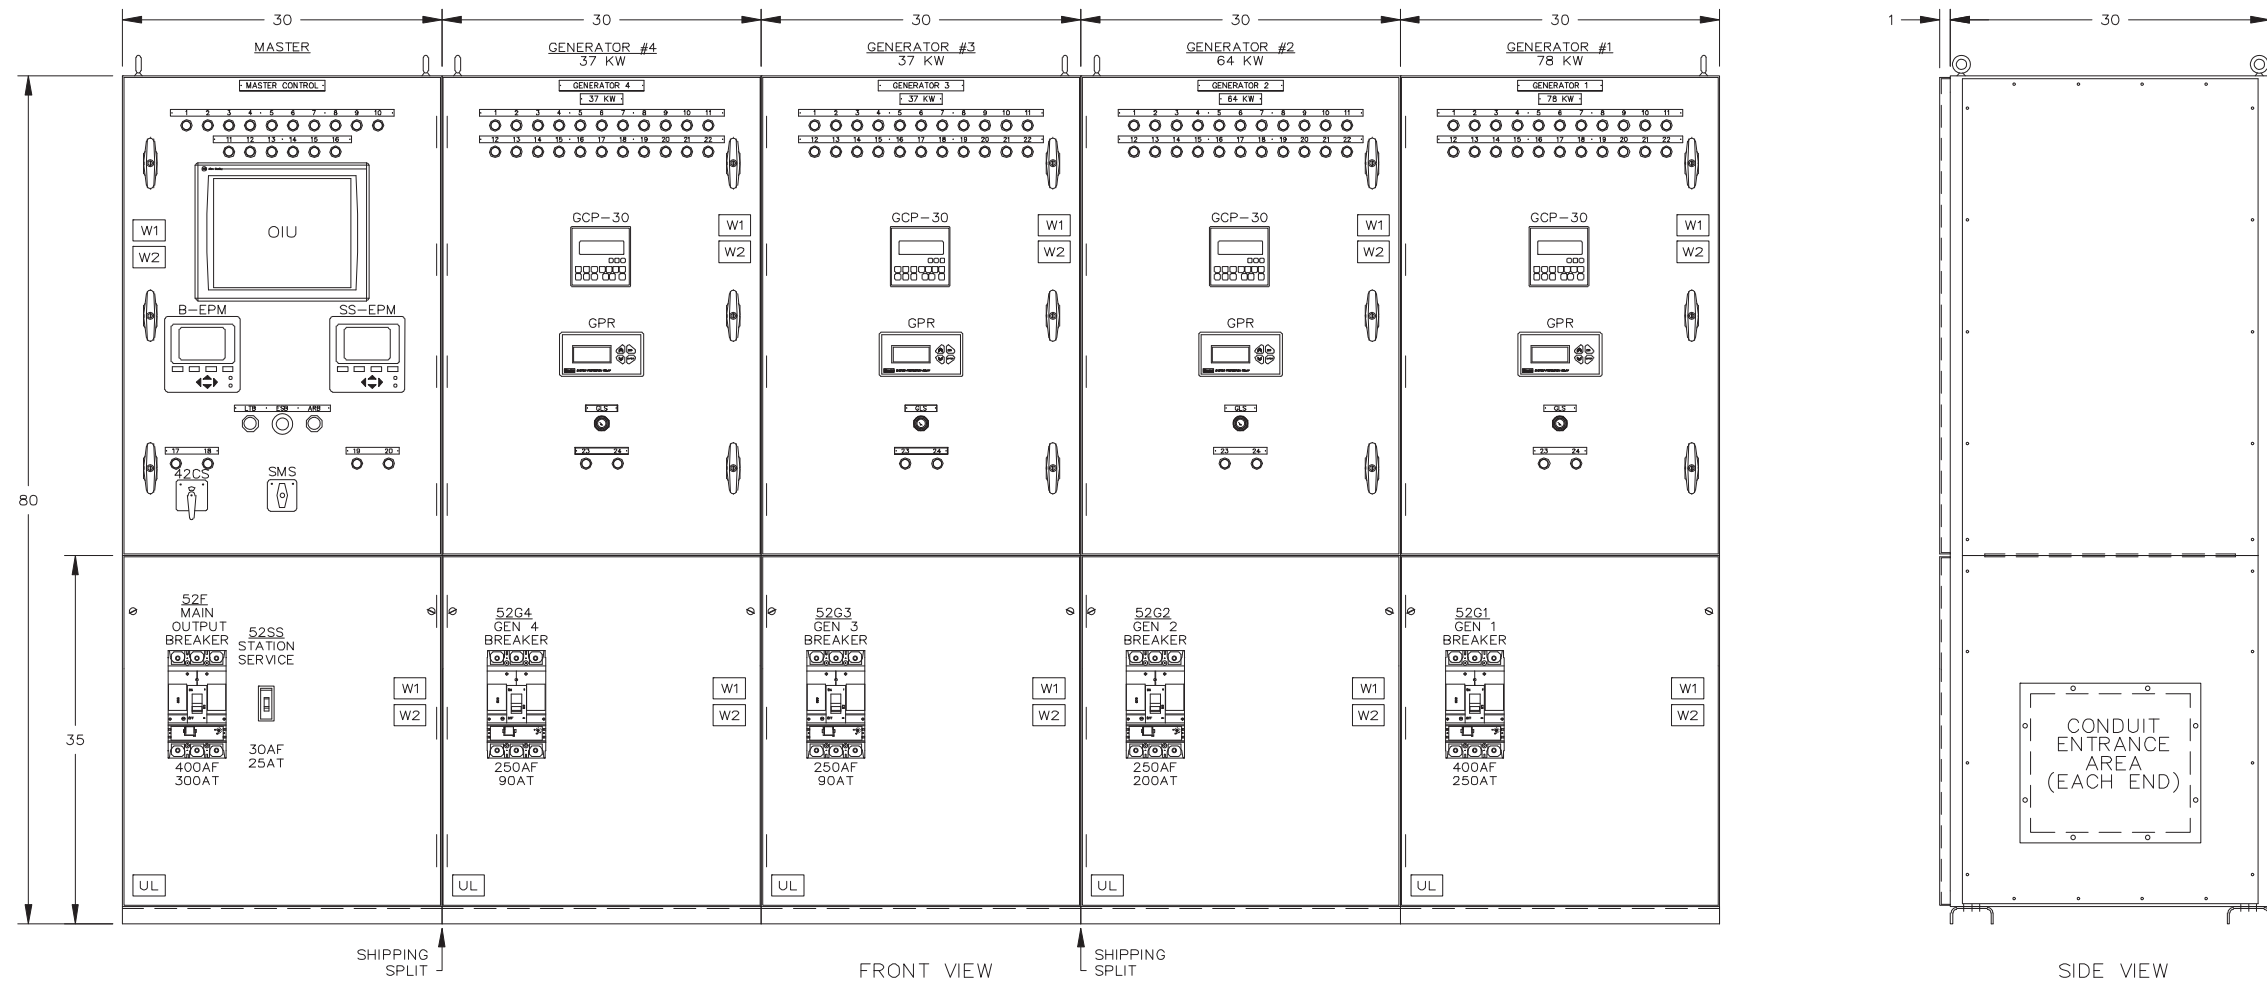

DEVICE LEGEND	
ARB	ALARM RESET BUTTON
B-EPM	BUS ELECTRONIC POWER METER - 765010N
ESB	EMERGENCY STOP BUTTON
GCP	GENERATOR CONTROL PACKAGE
GLS	GENERATOR LOCKOUT SWITCH
GPR	GENERATOR PROTECTIVE RELAY
OIU	OPERATOR INTERFACE UNIT
LTB	LAMP TEST BUTTON
SMS	MASTER CONTROL SWITCH (AUTO-MANUAL)
SS-EPM	STATION SERVICE POWER METER - 755010N
42xx	CONTACTOR
42CS	CONTACTOR CONTROL SWITCH
52xx	CIRCUIT BREAKER

GENERATOR ANNUNCIATOR LEGEND:			
1	ENGINE RUN	13	NOT IN AUTO POSITION
2	ENGINE IDLE	14	GENERATOR BREAKER OPEN
3	ENGINE ALARM	15	FAIL TO SYNCHRONIZE
4	LOW OIL PRESSURE	16	OVERCURRENT
5	LOW OIL LEVEL	17	UNDER VOLTAGE
6	HIGH OIL TEMPERATURE	18	OVER VOLTAGE
7	HIGH WATER TEMPERATURE	19	UNDER FREQUENCY
8	OVERSPEED	20	OVER FREQUENCY
9	OVERCRANK	21	LOSS OF EXCITATION
10	COOLDOWN/LOCKOUT	22	REVERSE POWER
11	BATTERY CHARGER FAILURE	23	CONTACTOR OPEN
12	NORMAL STOP	24	CONTACTOR CLOSED

MASTER ANNUNCIATOR LEGEND:			
1	FIRE ALARM LIGHT	11	HEAT RECOVERY NO LOAD
2	EMERGENCY STOP LIGHT	12	HEAT RECOVERY LOSS OF PRESSURE
3	SYSTEM LOW WATER LEVEL LIGHT	13	HEAT RECOVERY LOSS OF FLOW
4	LOW FUEL LEVEL LIGHT	14	SPARE 1
5	BUS UNDER/OVER VOLTAGE LIGHT	15	SPARE 2
6	BUS UNDER/OVER FREQUENCY LIGHT	16	SPARE 3
7	FEEDER BREAKER OVERCURRENT LIGHT	17	FEEDER BREAKER OPEN
8	PRIMARY PLC FAILURE	18	FEEDER BREAKER CLOSED
9	OPERATING ON BACKUP PLC	19	STATION SERVICE BREAKER OPEN
10	BACKUP PLC FAILURE	20	STATION SERVICE BREAKER CLOSED

DRAWING LEGEND	
1	PHYSICAL LAYOUT
2	SINGLE LINE DIAGRAM
3	BLANK
4A	GENERATOR 1 AC SCHEMATIC
4B	GENERATOR 2 AC SCHEMATIC
4C	GENERATOR 3 AC SCHEMATIC
4D	GENERATOR 4 AC SCHEMATIC
5	MASTER AC & DISTRIBUTION SCHEMATIC
6A	GENERATOR 1 DC CONTROL SCHEMATIC
6B	GENERATOR 2 DC CONTROL SCHEMATIC
6C	GENERATOR 3 DC CONTROL SCHEMATIC
6D	GENERATOR 4 DC CONTROL SCHEMATIC
7A	GENERATOR 1 DC CONTROL SCHEMATIC
7B	GENERATOR 2 DC CONTROL SCHEMATIC
7C	GENERATOR 3 DC CONTROL SCHEMATIC
7D	GENERATOR 4 DC CONTROL SCHEMATIC
8A	GENERATOR 1 DC CONTROL SCHEMATIC
8B	GENERATOR 2 DC CONTROL SCHEMATIC
8C	GENERATOR 3 DC CONTROL SCHEMATIC
8D	GENERATOR 4 DC CONTROL SCHEMATIC

DRAWING LEGEND	
9	MASTER DC CONTROL SCHEMATIC
10	MASTER DC CONTROL SCHEMATIC
11	MASTER DC CONTROL SCHEMATIC
12	BLANK
13	BLANK
14	PLC COMMUNICATION DIAGRAM
15	COMMUNICATION NETWORK DIAGRAM
16	EPM MONITORING & SYSTEM COMMUNICATION DIAGRAM
17	HEATER & LIGHTING CONTROL SCHEMATIC
18	CONTROL SWITCH TARGET DIAGRAM
19	NAMEPLATE DETAILS
20	INTERCONNECTION DIAGRAM

NOTES	
1	WIRE MARKERS: HEATSHRINK TYPE C/W INDELIBLE INK MARKINGS
2	WIRE TYPE: ALL CONNECTIONS TO BUS AND BREAKERS TO BE #14AWG SIS. WIRING THAT IS TO BE PROVIDED AS PART OF OR IS AN INTEGRAL PART OF SUPERVISORY CONTROL EQUIPMENT SHALL BE #18-14AWG SIS. CT WIRING TO BE #10AWG SIS MIN.
3	WIRING COLOR CODED: NO WIRE NUMBERS TO MATCH TERMINAL NUMBERS UNLESS NOTED
4	LOAD BUS TO BE 1000A 3PH 4W TIN PLATED COPPER BRACED AT 35KA.
5	ENCLOSURE TYPE NEMA 1 BUILT TO UL891.
6	PAINT ASA #61 GREY EXTERIOR, WHITE MOUNTING PAN
7	ENCLOSURE SUPPLIED IN THREE PIECES
8	FULL LENGTH COPPER GROUND BUS 0.25" X 2.5" C/W (6) #6-250MCM GROUND LUGS
9	POWER CABLES: UTILITY FROM BOTTOM; GEN & LOAD TOP. FRONT AND REAR ACCESS REQUIRED.
10	LAMICODS WHITE C/W BLACK LETTERS, MECHANICALLY ATTACHED
11	CABLE LUG SIZES: GEN 1, 2: (1) #8 - 600MCM Cu/AL PER PHASE GEN 3, 4: (1) #8 - 350MCM Cu/AL PER PHASE LOAD: (1) #8 - 600MCM Cu/AL PER PHASE SS: (1) #12 - 3/0 Cu/AL PER PHASE

GCP READOUT	
* INCLUDES, BUT IS NOT LIMITED TO THE FOLLOWING LIST OF METERING, STATUS, AND ALARMS.	
METERING LEGEND	
1.	VOLTS: Aφ, Bφ, Cφ L-N, L-L
2.	AMPS: Aφ, Bφ, Cφ
3.	KW
4.	PF
5.	KWH
ALARM LEGEND	
1.	LOW OIL PRESSURE ALARM
2.	LOW OIL PRESSURE SHUTDOWN
3.	HIGH WATER TEMPERATURE ALARM
4.	HIGH WATER TEMPERATURE SHUTDOWN
5.	OVERCRANK
6.	OVERSPEED
7.	LOW OIL LEVEL
ANALOG INPUT LEGEND	
1.	OIL PRESSURE (PSI)
2.	WATER TEMP (F)
MISC. LEGEND	
1.	ENGINE HOURS
2.	ENGINE START COUNTER
3.	MAINTENANCE CALL
GPR FUNCTIONS	
* INCLUDES, BUT NOT LIMITED TO: 27/59, 81 o/u, 32, 50/51, 40, 47	

TAKOTNA SWITCHGEAR SHOP DRAWINGS, 32 SHEETS TOTAL. NOTE THAT THESE DRAWINGS SHOW THE SHOP AS BUILT FROM THE ORIGINAL INSALLATION IN 2003. THEY HAVE NOT BEEN VERIFIED FOR PRESENT AS BUILT CONDITIONS.

REFER TO SHEET # _____

APPROVED FOR CONSTRUCTION
 MASTER COPY REFERENCE COPY _____ OF _____
 MULTIPLE UNIT WORK ORDER
 RELEASED FOR INFORMATION
 AUTH. BY: _____ DATE: _____


DRAWING No.	REFERENCE DRAWINGS	No.	REVISIONS	BY	AUTH	DATE
2	AS BUILT			BM	RH	05-05-06
1	APPROVAL MOD'S			BM	RH	05-03-16



AS BUILT

GENERATOR CONTROL PANEL
 MODEL GCS 2200
 PHYSICAL LAYOUT
 MIDDLE KUSKOKWIM REGIONAL ENERGY - TAKOTNA

CUSTOMER ALASKA ENERGY AUTHORITY			
CUSTOMER ORDER No. C-022623	WORK ORDER No. W-030032	DATE 05-03-03	REV 2
DRAWN BY LR	AUTH BY RH	DRAWING/FILE No. W-030032-01	SHEET 1

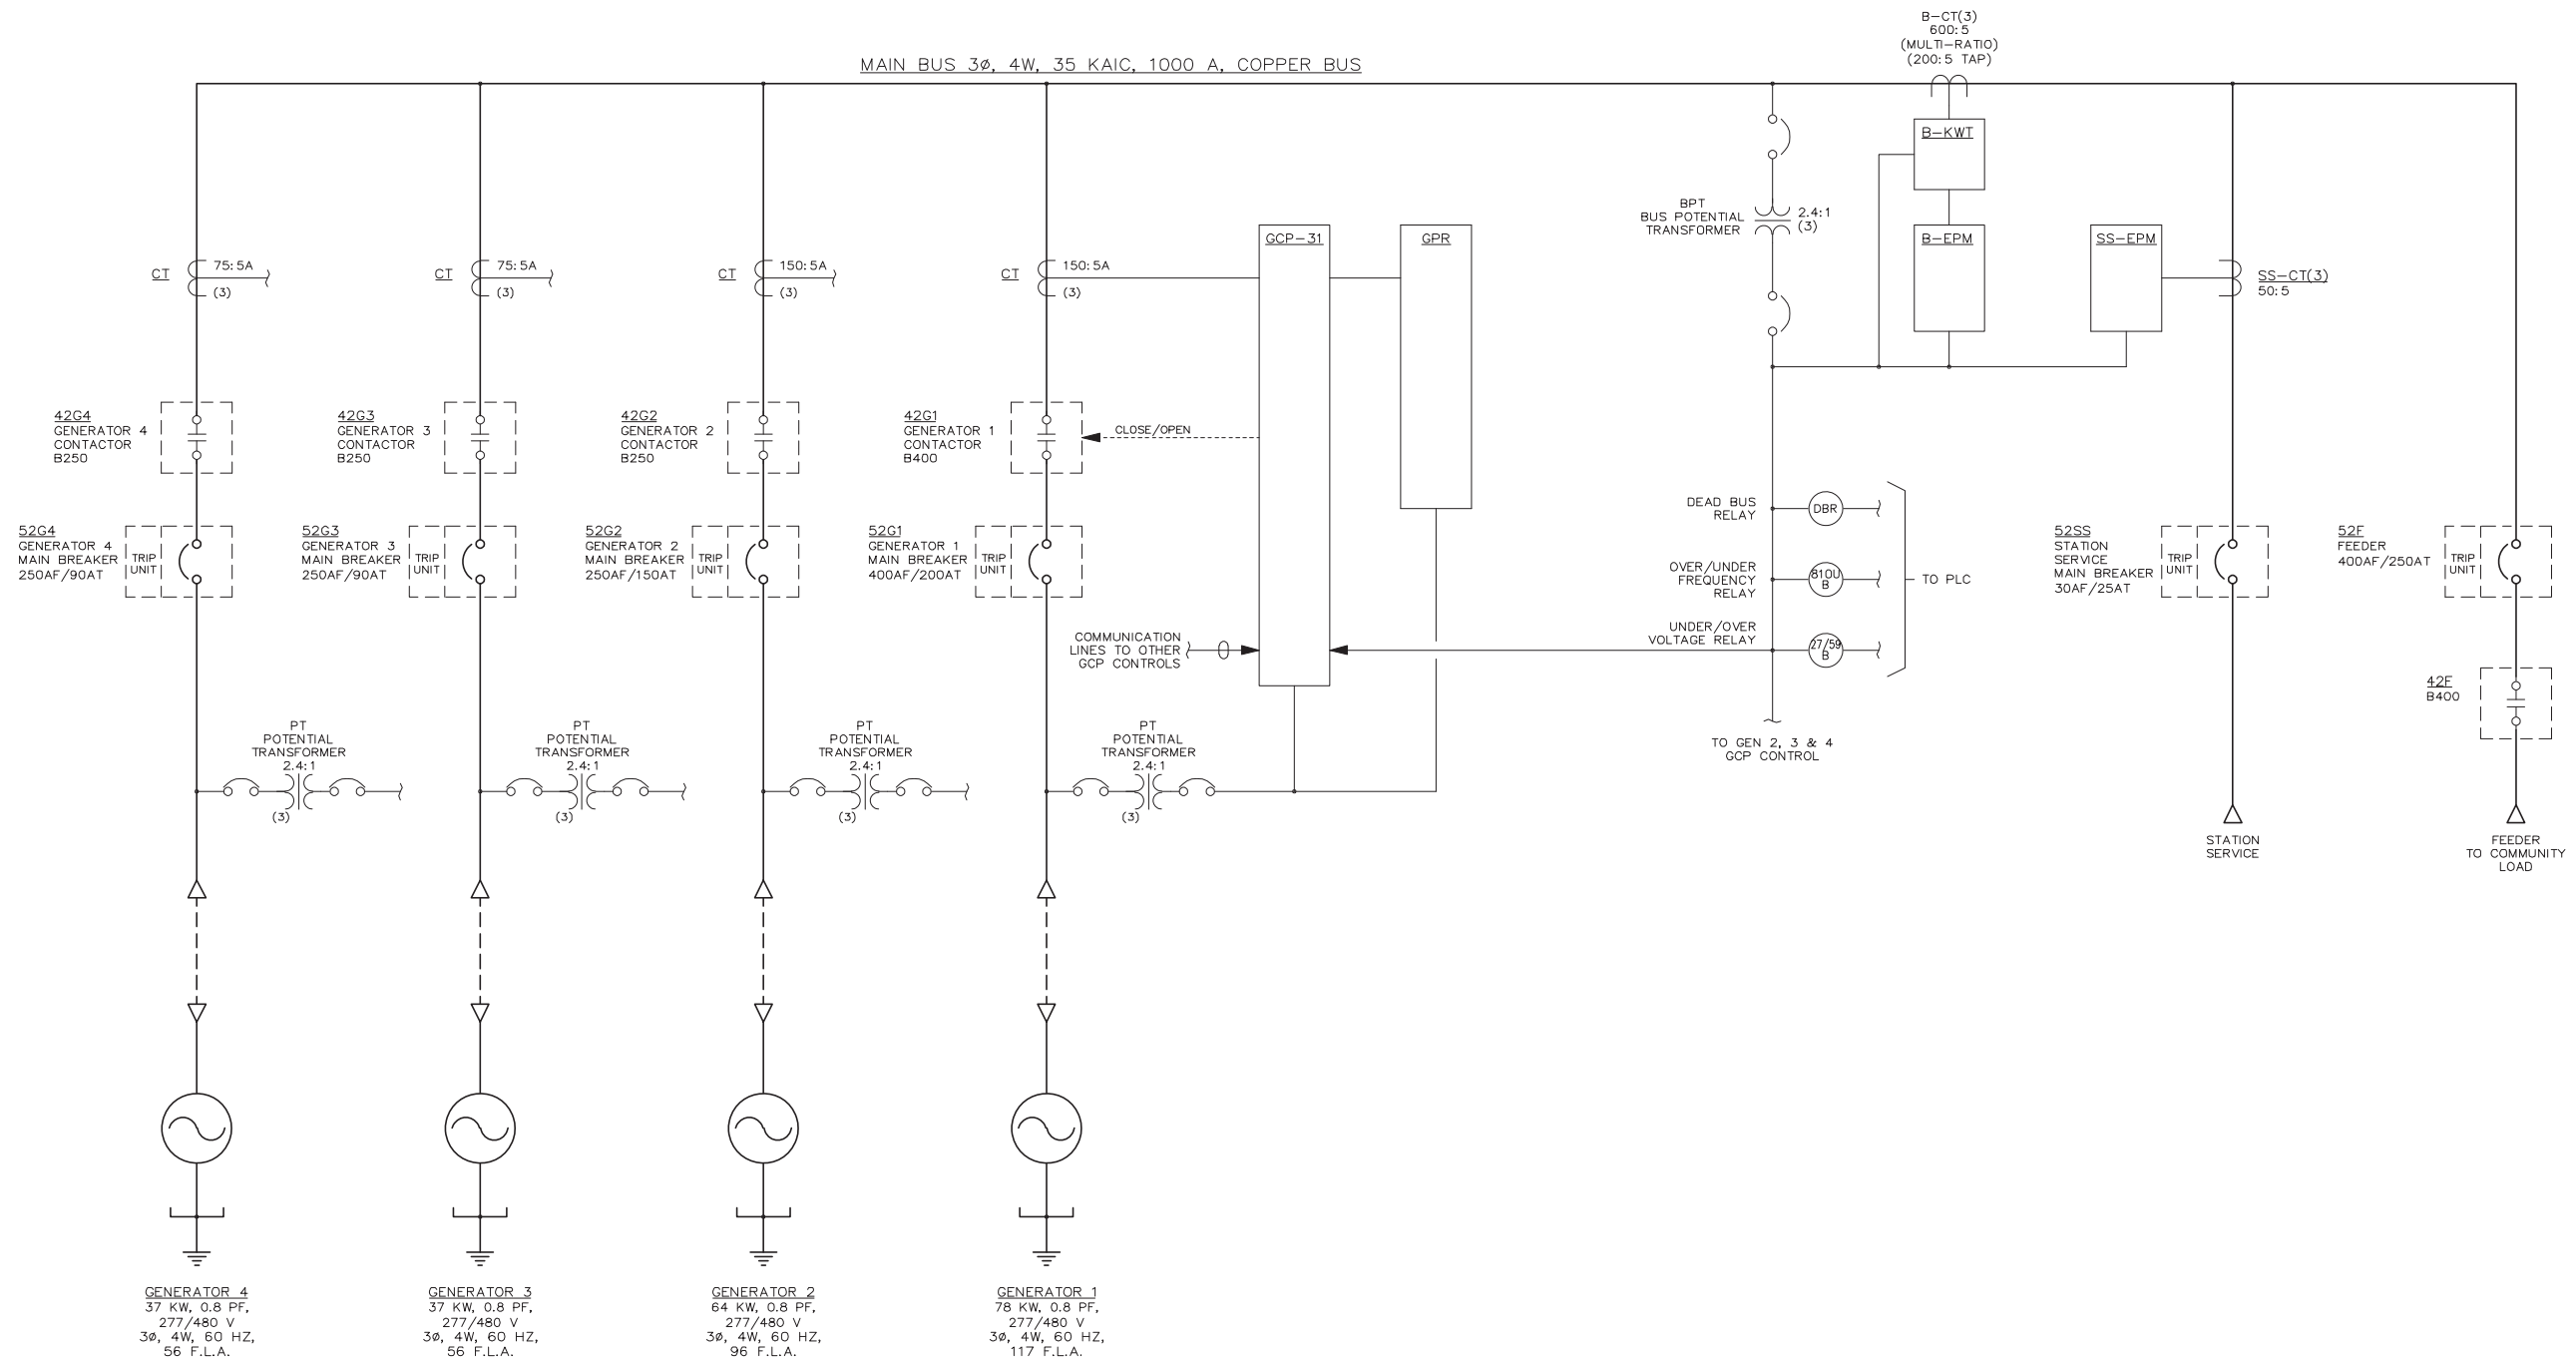

NOTE:
GENERATORS 2, 3 & 4 SIMILAR TO GENERATOR 1.

REFER TO SHEET #

AS BUILT

DRAWINGS AND/OR OTHER TECHNICAL INFORMATION SUPPLIED BY THOMSON TECHNOLOGY AS A PART OF A SALE OF EQUIPMENT ARE FOR THE PURCHASER'S USE SOLELY IN CONJUNCTION WITH THAT EQUIPMENT, UNLESS SPECIFICALLY AGREED TO OTHERWISE AS A PART OF THE TERMS OF SALE.

APPROVED FOR CONSTRUCTION
 MASTER COPY REFERENCE COPY OF _____
 MULTIPLE UNIT WORK ORDER
 RELEASED FOR INFORMATION
 AUTH. BY: _____ DATE: _____

DRAWING No.	REFERENCE DRAWINGS	No.	REVISIONS	BY	AUTH	DATE
1	AS BUILT			BM	RH	05-05-06



GENERATOR CONTROL PANEL
 MODEL GCS 2200
 SINGLE LINE DIAGRAM
 MIDDLE KUSKOKWIM REGIONAL ENERGY - TAKOTNA

CUSTOMER ALASKA ENERGY AUTHORITY	
CUSTOMER ORDER No. C-022623	WORK ORDER No. W-030032
DRAWN BY LR	AUTH BY RH
DATE 05-03-03	REV 1
DRAWING/FILE No. W-030032-02	SHEET 2

13/1
13/2
13/3
13/82

REFER TO SHEET #

APPROVED FOR CONSTRUCTION
 MASTER COPY REFERENCE COPY OF _____
 MULTIPLE UNIT WORK ORDER
 RELEASED FOR INFORMATION
 AUTH. BY: _____ DATE: _____

DRAWING No.	REFERENCE DRAWINGS	No.	REVISIONS	BY	AUTH	DATE
		1	AS BUILT	BM	RH	05-05-06




GENERATOR CONTROL PANEL
 MODEL GCS 2200
 BLANK SHEET
 MIDDLE KUSKOKWIM REGIONAL ENERGY - TAKOTNA

AS BUILT

DRAWINGS AND/OR OTHER TECHNICAL INFORMATION SUPPLIED BY THOMSON TECHNOLOGY AS A PART OF A SALE OF EQUIPMENT ARE FOR THE PURCHASER'S USE SOLELY IN CONJUNCTION WITH THAT EQUIPMENT, UNLESS SPECIFICALLY AGREED TO OTHERWISE AS A PART OF THE TERMS OF SALE.

CUSTOMER ALASKA ENERGY AUTHORITY			
CUSTOMER ORDER No. C-022623	WORK ORDER No. W-030032		
DRAWN BY LR	AUTH BY RH	DATE 05-03-03	REV 1
DRAWING/FILE No. W-030032-03			SHEET 3

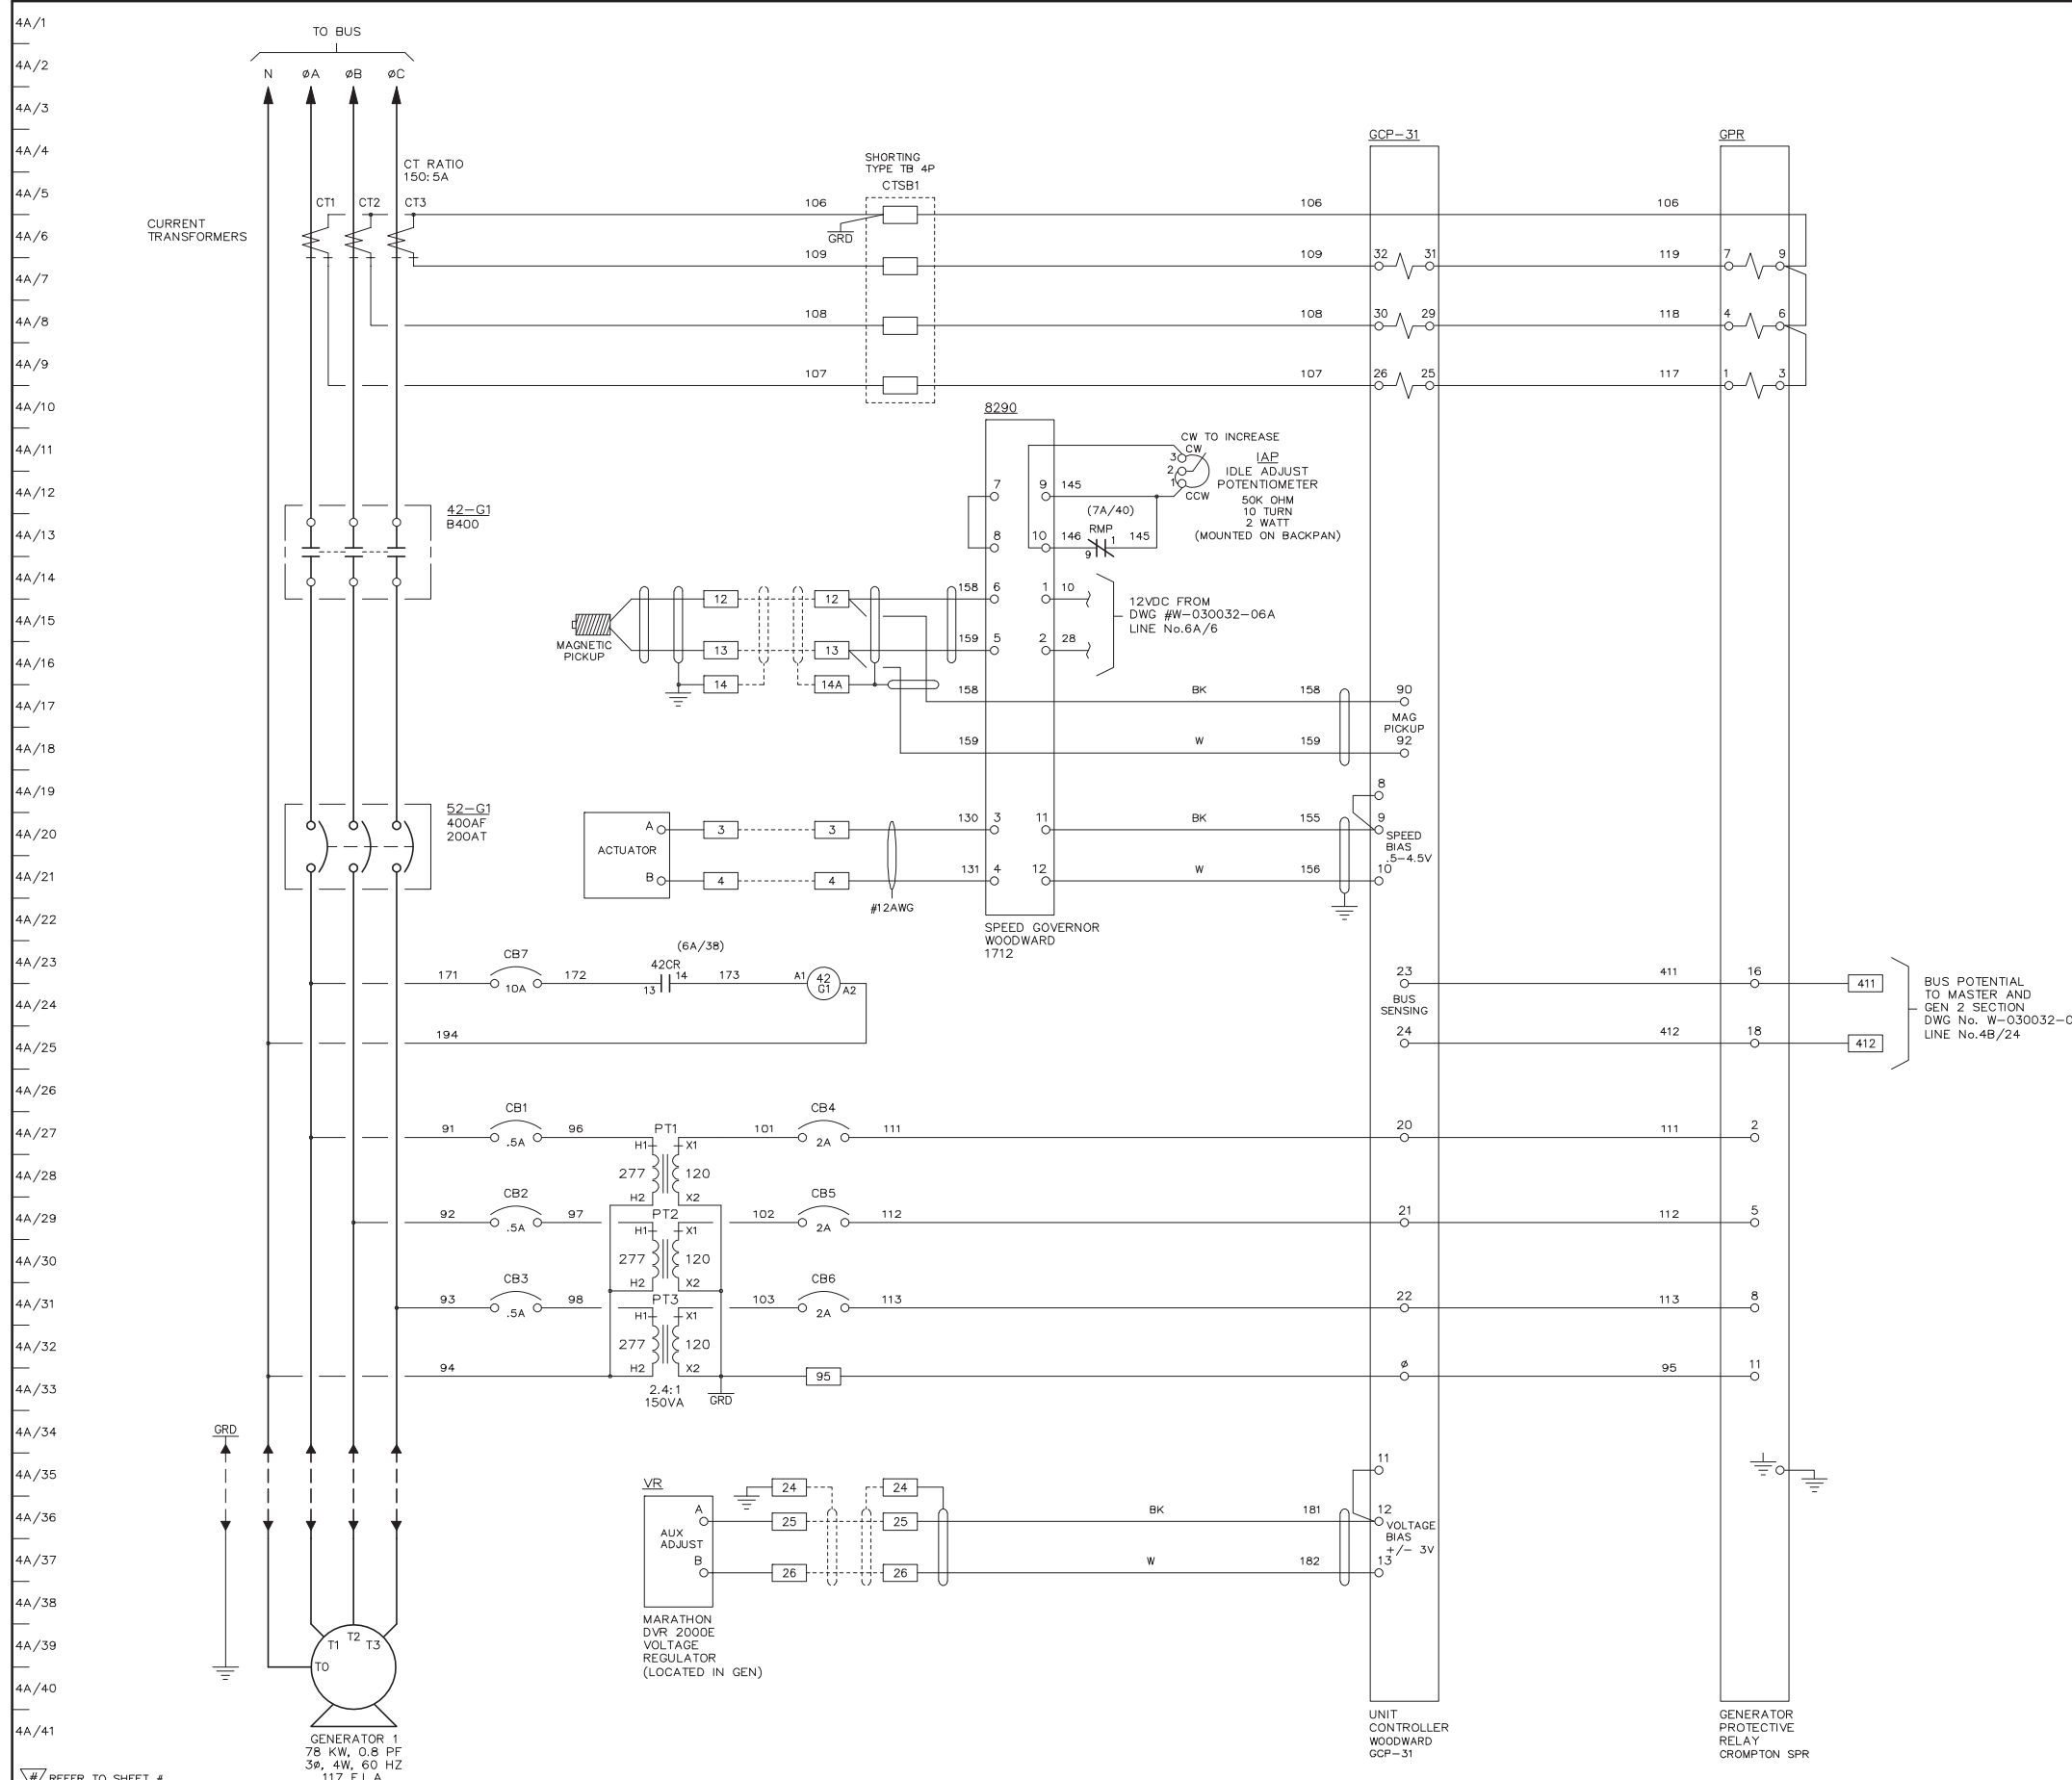

4A/1
4A/2
4A/3
4A/41

SECTION #5

AS BUILT


REFER TO SHEET #
 APPROVED FOR CONSTRUCTION
 MASTER COPY REFERENCE COPY OF _____
 MULTIPLE UNIT WORK ORDER
 RELEASED FOR INFORMATION
 AUTH. BY: _____ DATE: _____

DRAWING No.	REFERENCE DRAWINGS	No.	REVISIONS	BY	AUTH	DATE
		1	AS BUILT	BM	RH	05-05-06



GENERATOR CONTROL PANEL
 MODEL GCS 2200
 GENERATOR #1 AC SCHEMATIC
 MIDDLE KUSKOKWIM REGIONAL ENERGY - TAKOTNA

CUSTOMER ALASKA ENERGY AUTHORITY			
CUSTOMER ORDER No. C-022623	WORK ORDER No. W-030032		
DRAWN BY LR	AUTH BY RH	DATE 05-03-03	REV 1
DRAWING/FILE No. W-030032-04A			SHEET 4A

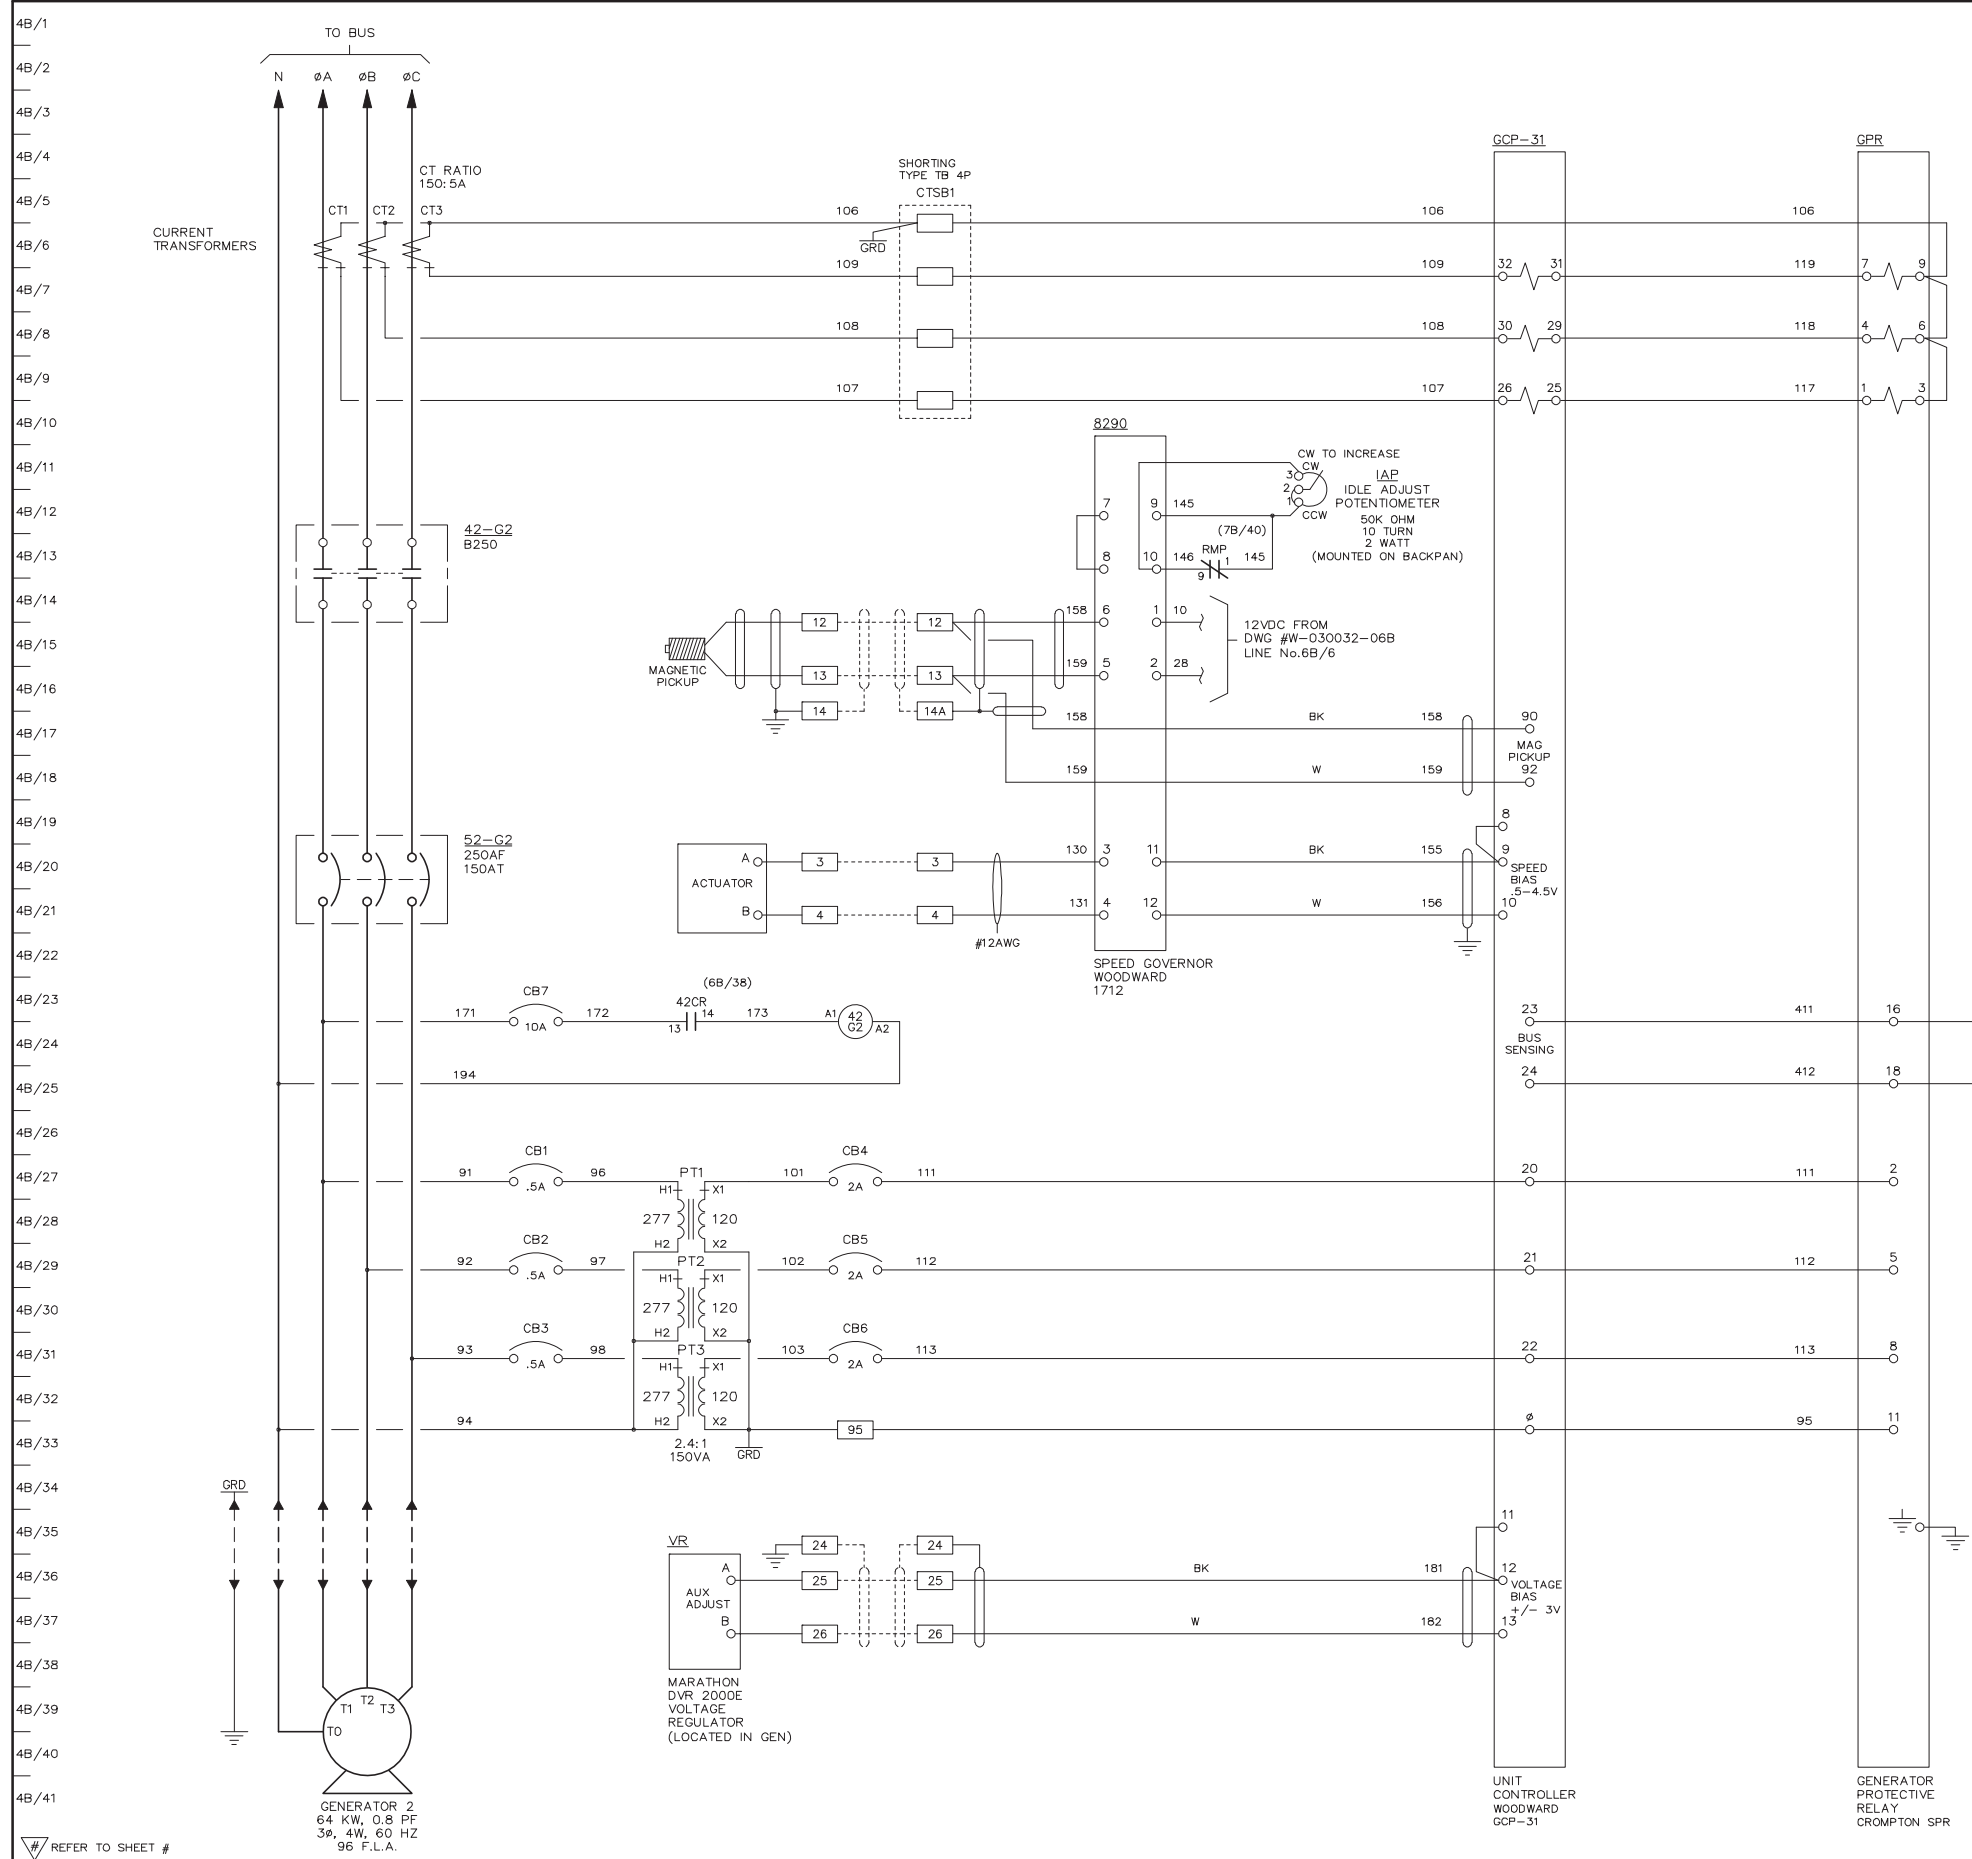

BUS POTENTIAL TO SECTION GEN 1 & 3 DWG No. W-030032-04A, 04C LINE No. 4A/24, 4C/24

SECTION #4

AS BUILT


APPROVED FOR CONSTRUCTION
 MASTER COPY REFERENCE COPY OF _____
 MULTIPLE UNIT WORK ORDER
 RELEASED FOR INFORMATION
 AUTH. BY: _____ DATE: _____

DRAWING No.	REFERENCE DRAWINGS	No.	AS BUILT	REVISIONS	BY	AUTH	DATE
		1	AS BUILT		BM	RH	05-05-06



GENERATOR CONTROL PANEL
 MODEL GCS 2200
 GENERATOR #2 AC SCHEMATIC
 MIDDLE KUSKOKWIM REGIONAL ENERGY - TAKOTNA

CUSTOMER ALASKA ENERGY AUTHORITY			
CUSTOMER ORDER No. C-022623	WORK ORDER No. W-030032		
DRAWN BY LR	AUTH BY RH	DATE 05-03-03	REV 1
DRAWING/FILE No. W-030032-04B			SHEET 4B

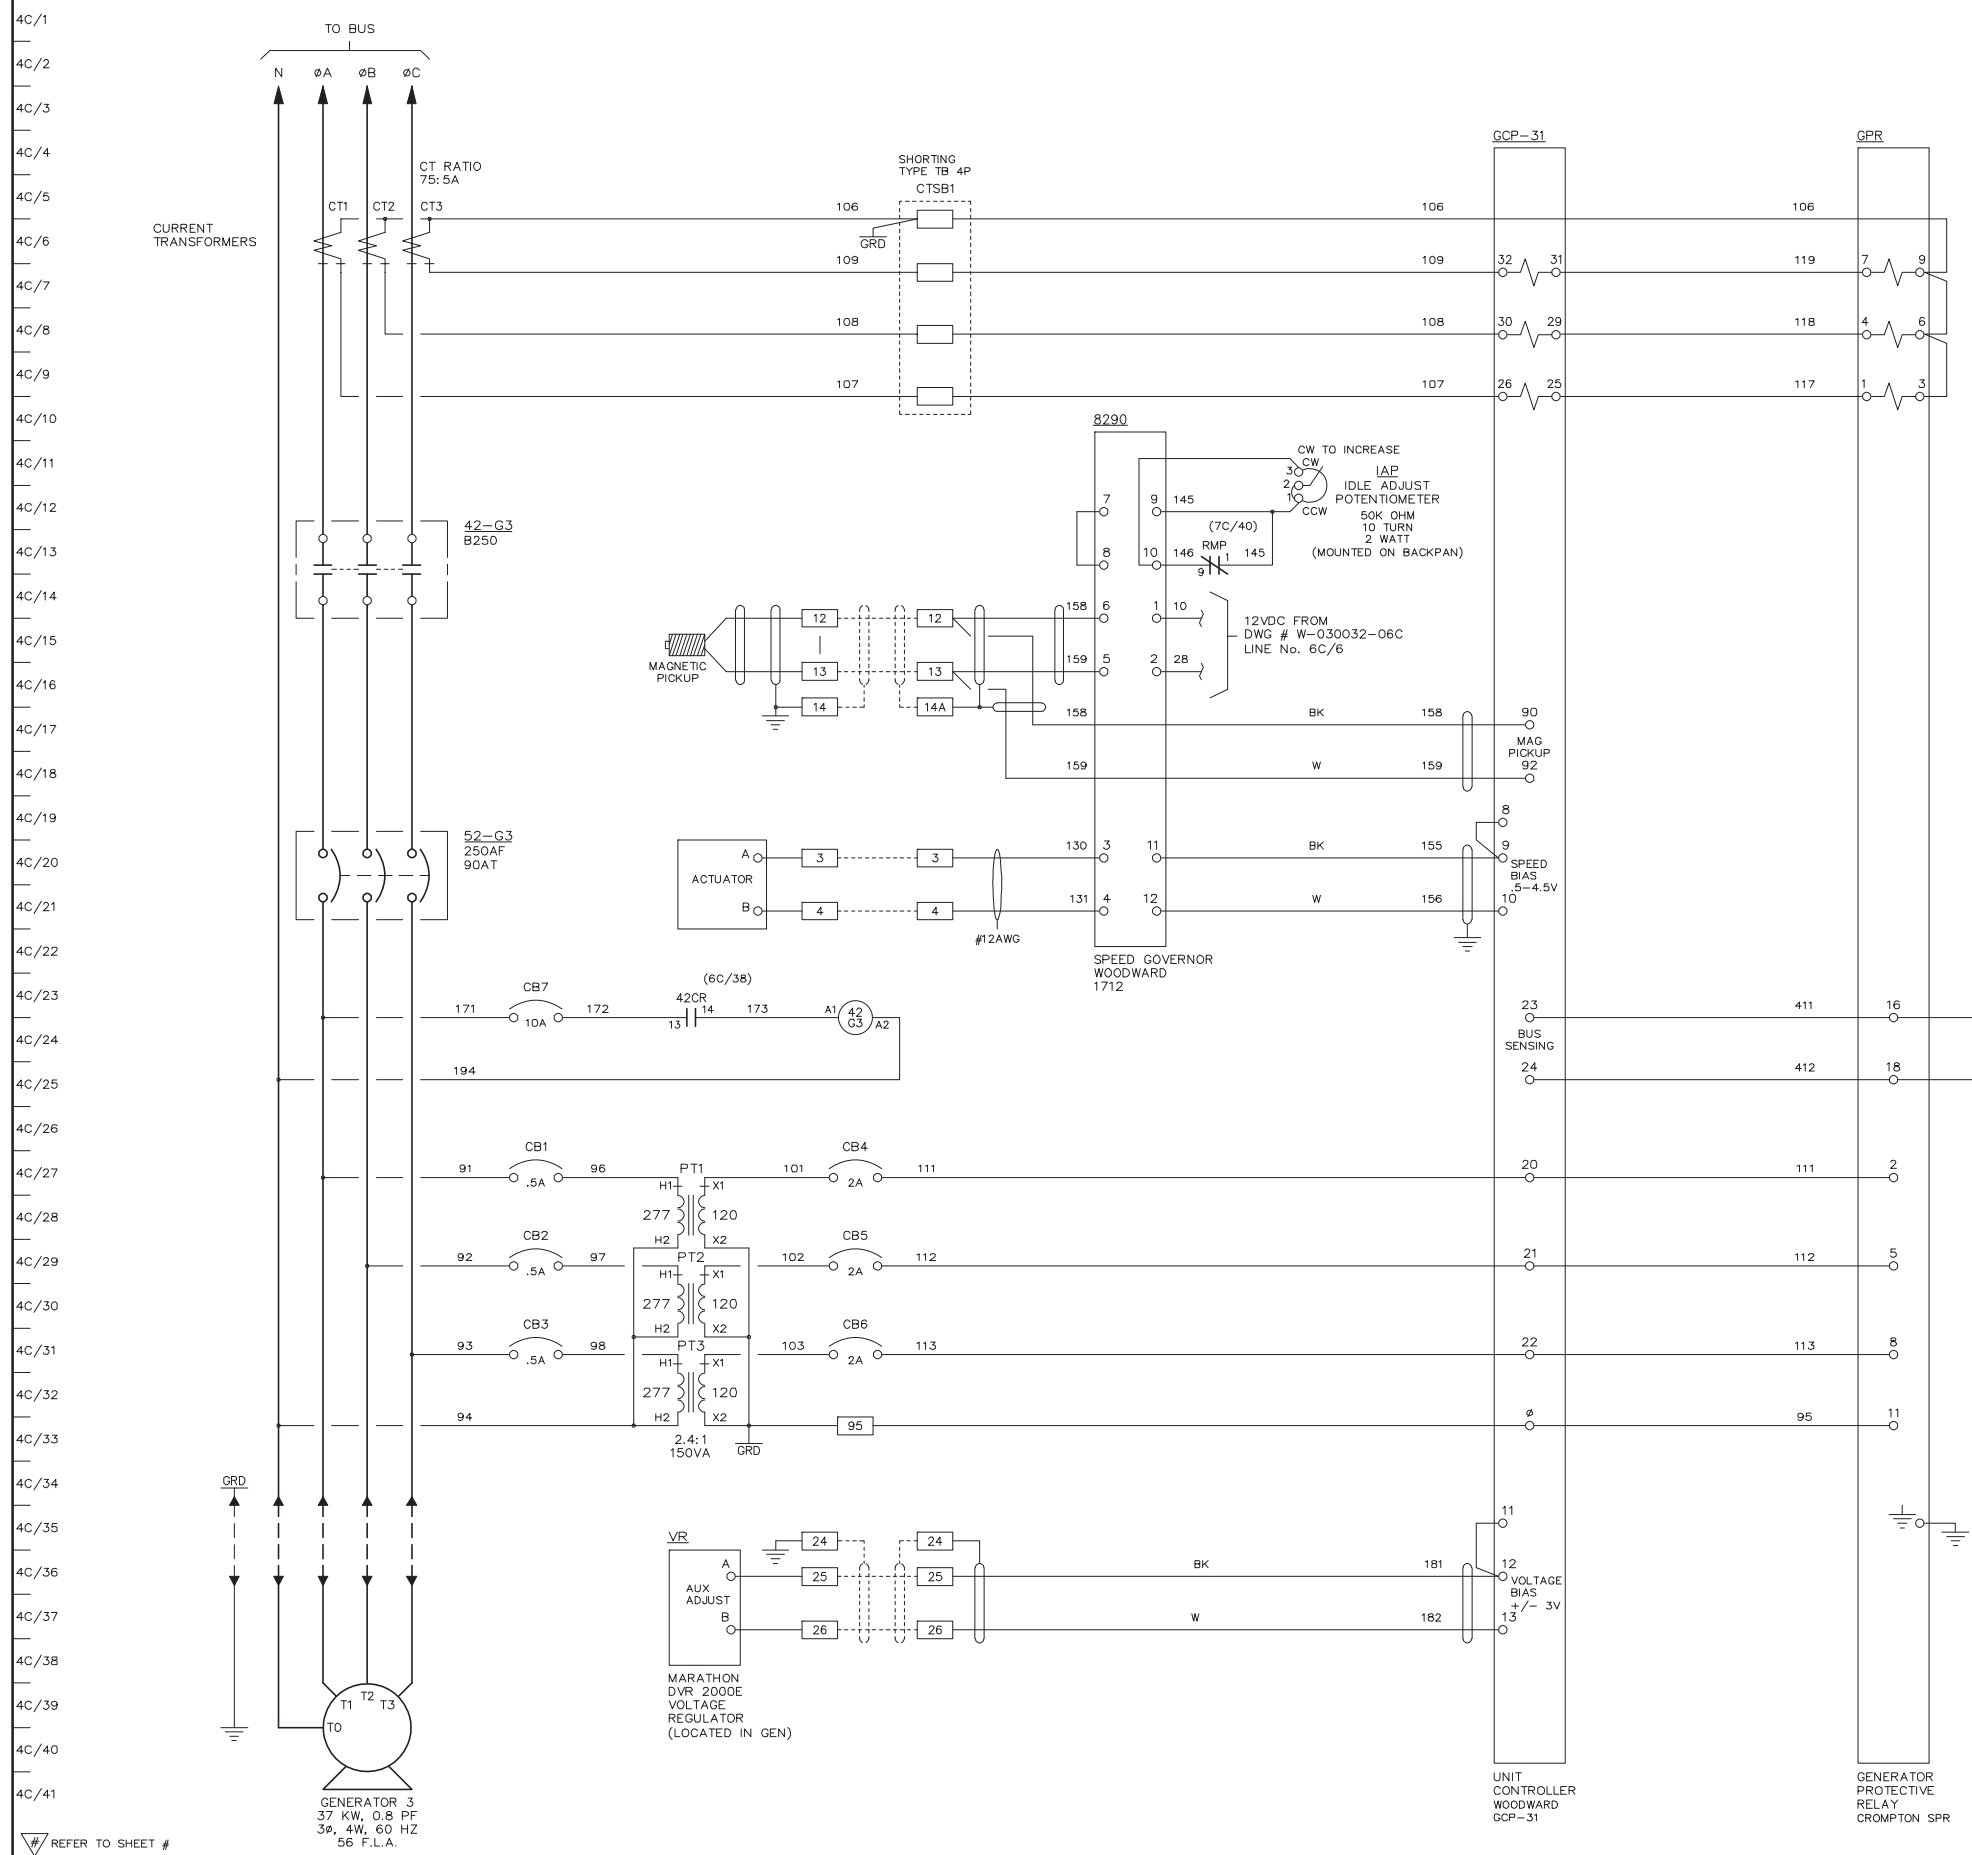

BUS POTENTIAL TO SECTION GEN 2 & 4 DWG No. W-030032-04B, 04D LINE No. 4B/24, 4D/24

SECTION #3

AS BUILT


APPROVED FOR CONSTRUCTION
 MASTER COPY REFERENCE COPY OF _____
 MULTIPLE UNIT WORK ORDER
 RELEASED FOR INFORMATION
 AUTH. BY: _____ DATE: _____

DRAWING No.	REFERENCE DRAWINGS	No.	AS BUILT	REVISIONS	BY	AUTH	DATE
		1	AS BUILT		BM	RH	05-05-06



GENERATOR CONTROL PANEL
 MODEL GCS 2200
 GENERATOR #3 AC SCHEMATIC
 MIDDLE KUSKOKWIM REGIONAL ENERGY - TAKOTNA

CUSTOMER ALASKA ENERGY AUTHORITY			
CUSTOMER ORDER No. C-022623	WORK ORDER No. W-030032		
DRAWN BY LR	AUTH BY RH	DATE 05-03-03	REV 1
DRAWING/FILE No. W-030032-04C			SHEET 4C

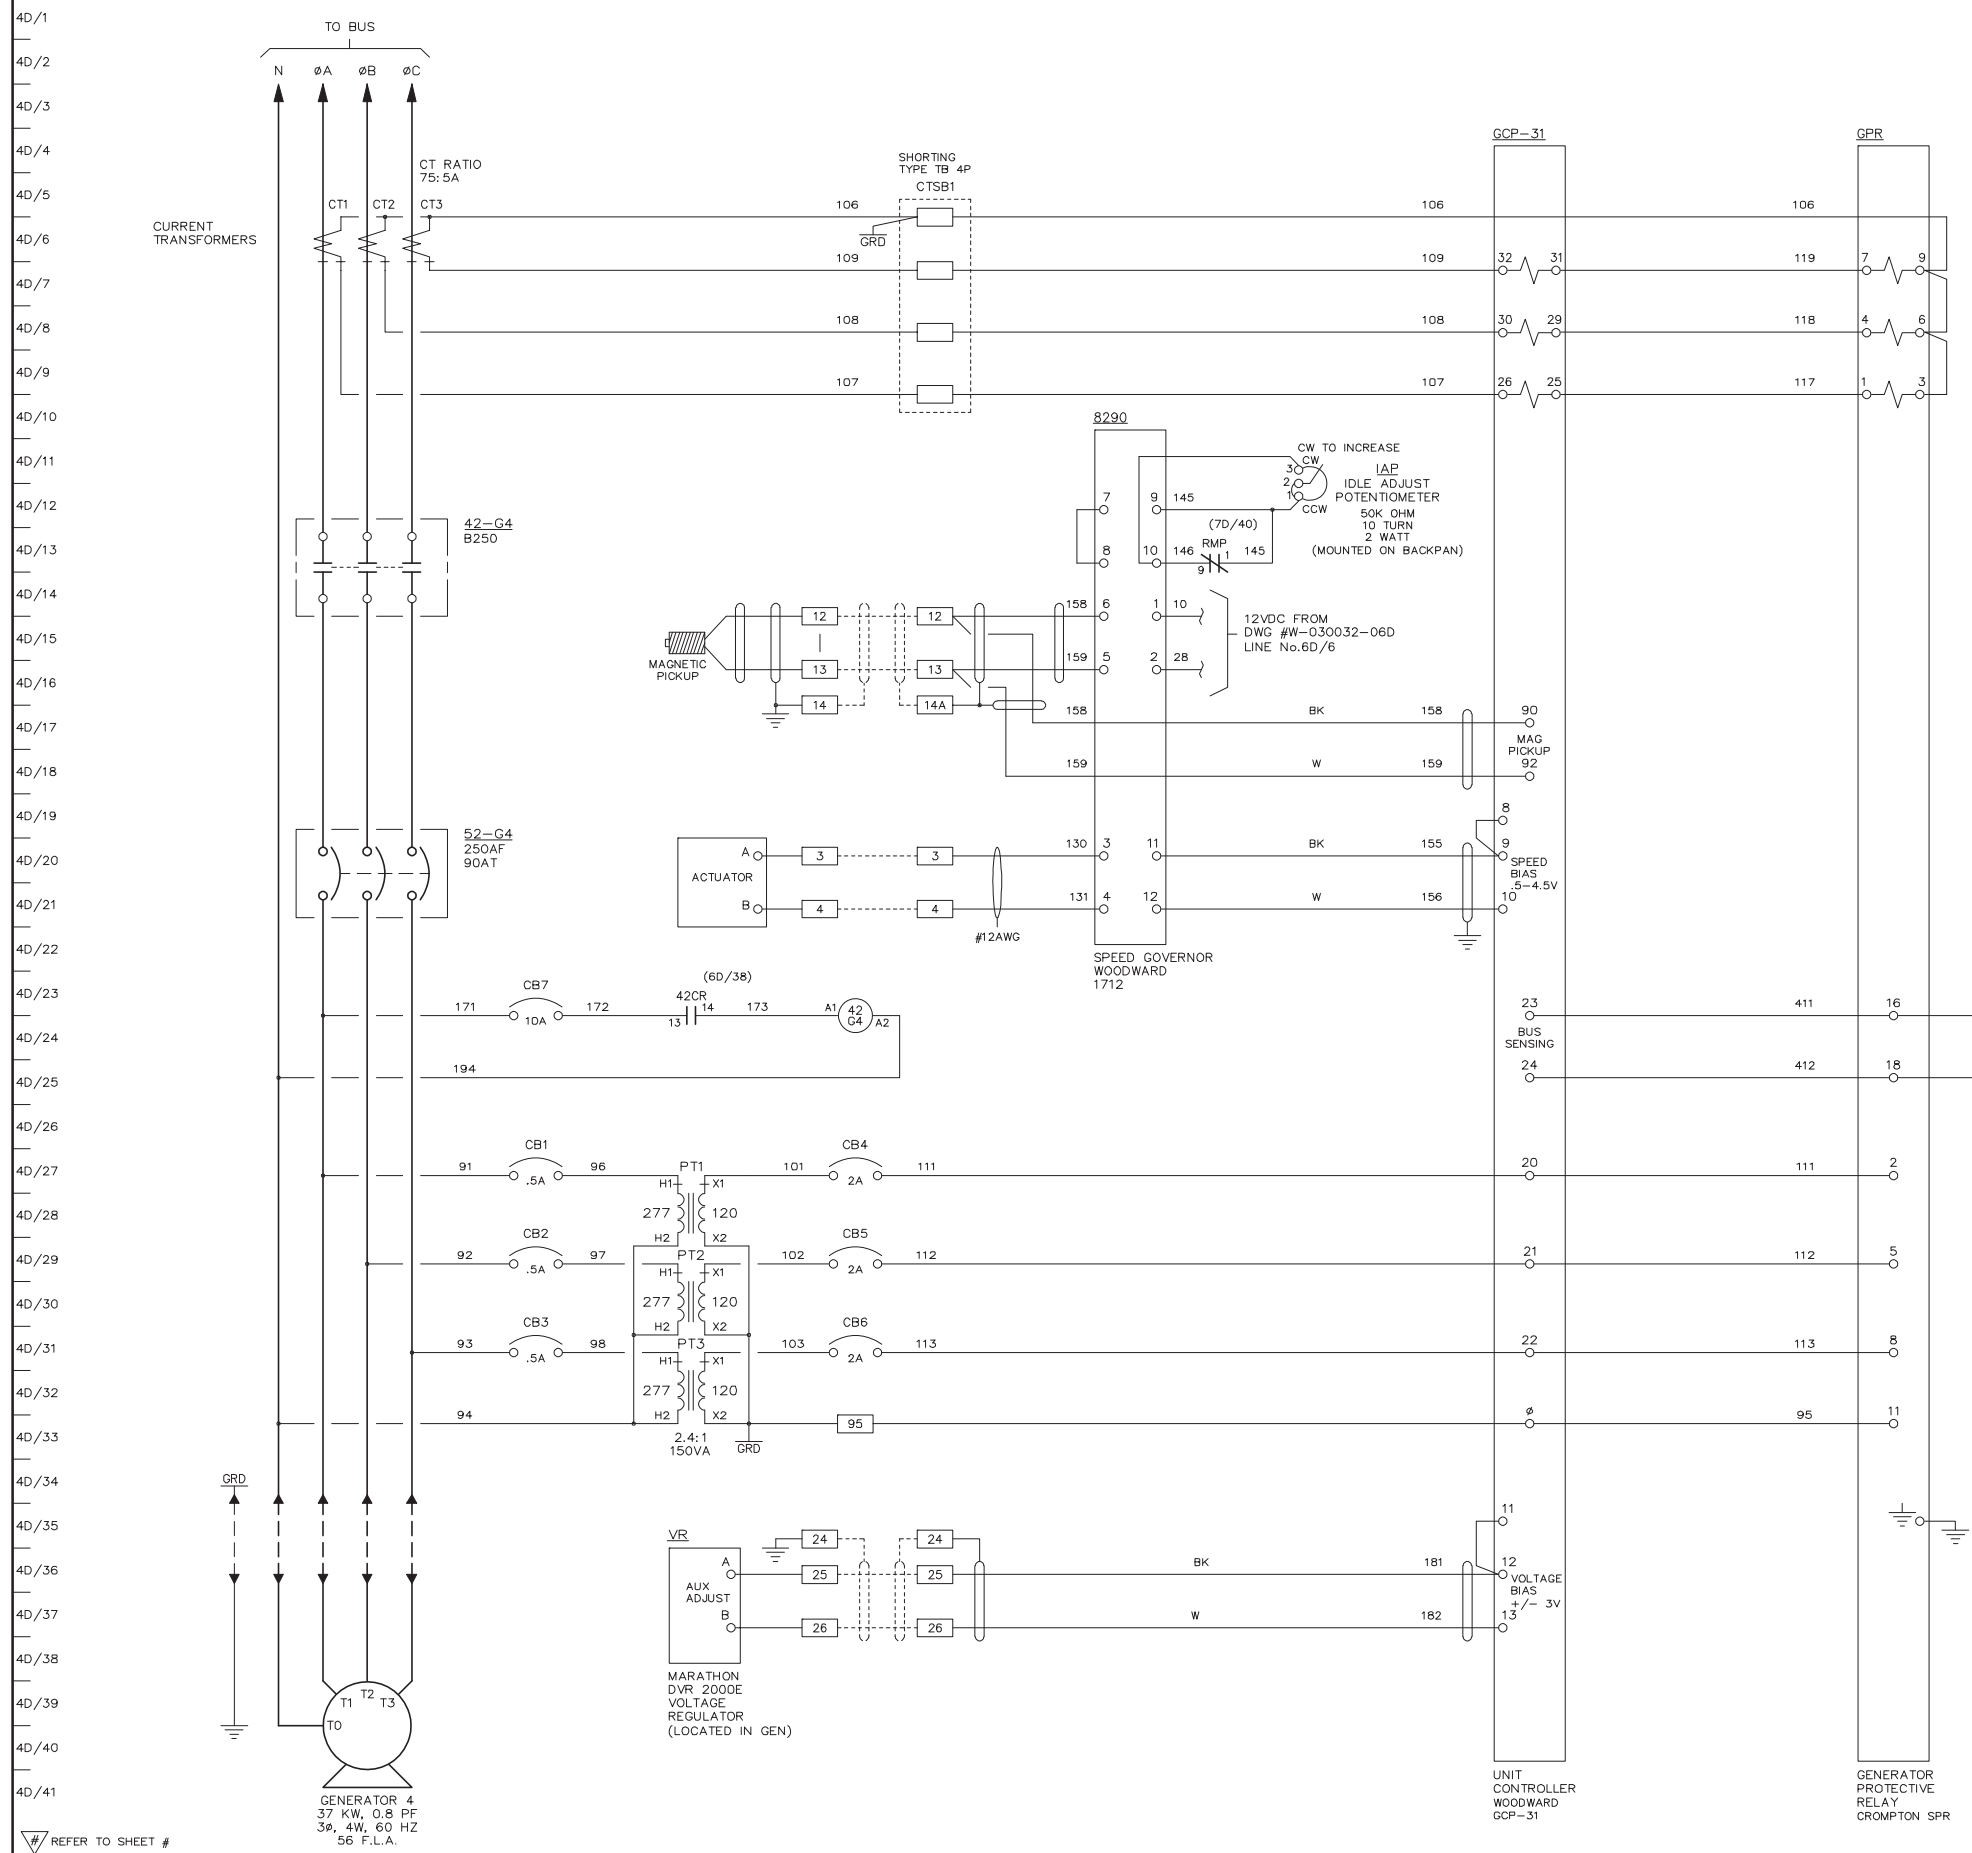

SECTION #2

AS BUILT

DRAWINGS AND/OR OTHER TECHNICAL INFORMATION SUPPLIED BY THOMSON TECHNOLOGY AS A PART OF A SALE OF EQUIPMENT ARE FOR THE PURCHASER'S USE SOLELY IN CONJUNCTION WITH THAT EQUIPMENT, UNLESS SPECIFICALLY AGREED TO OTHERWISE AS A PART OF THE TERMS OF SALE.

APPROVED FOR CONSTRUCTION
 MASTER COPY REFERENCE COPY _____ OF _____
 MULTIPLE UNIT WORK ORDER
 RELEASED FOR INFORMATION
 AUTH. BY: _____ DATE: _____


DRAWING No.	REFERENCE DRAWINGS	No.	AS BUILT	REVISIONS	BY	AUTH	DATE
		1	AS BUILT		BM	RH	05-05-06



GENERATOR CONTROL PANEL
 MODEL GCS 2200
 GENERATOR #4 AC SCHEMATIC
 MIDDLE KUSKOKWIM REGIONAL ENERGY - TAKOTNA

CUSTOMER ALASKA ENERGY AUTHORITY			
CUSTOMER ORDER No. C-022623	WORK ORDER No. W-030032		
DRAWN BY LR	AUTH BY RH	DATE 05-03-03	REV 1
DRAWING/FILE No. W-030032-04D			SHEET 4D

5/1
5/2
5/3
5/41

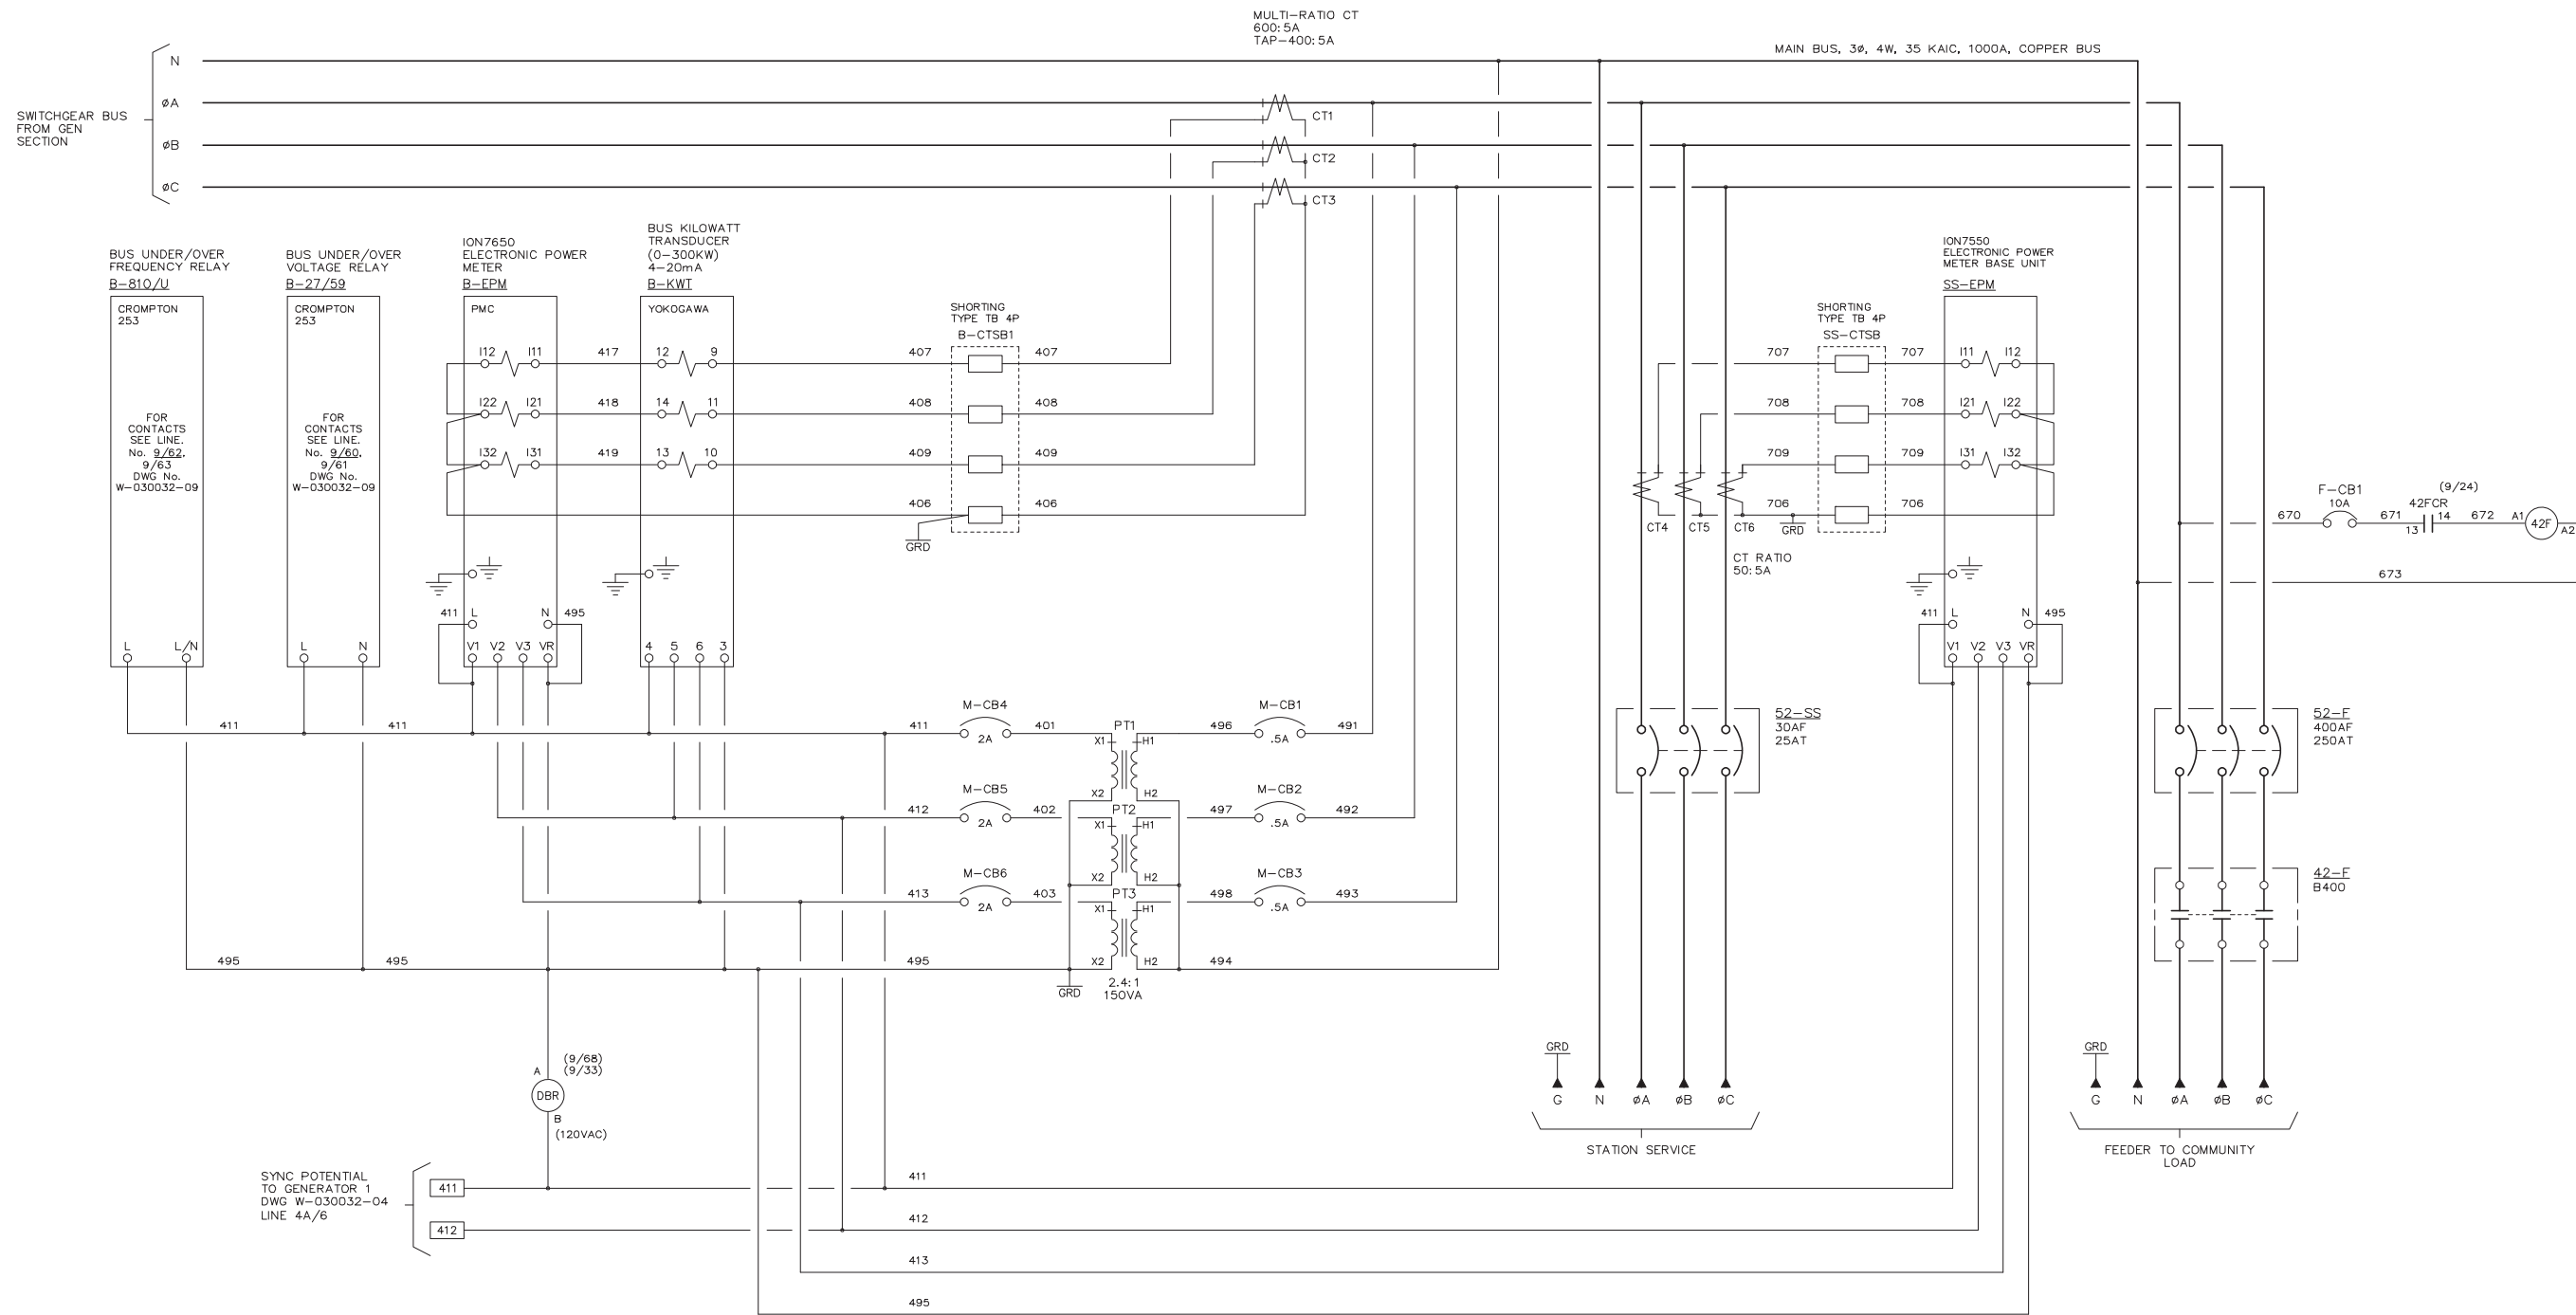

SECTION #1

AS BUILT

DRAWINGS AND/OR OTHER TECHNICAL INFORMATION SUPPLIED BY THOMSON TECHNOLOGY AS A PART OF A SALE OF EQUIPMENT ARE FOR THE PURCHASER'S USE SOLELY IN CONJUNCTION WITH THAT EQUIPMENT, UNLESS SPECIFICALLY AGREED TO OTHERWISE AS A PART OF THE TERMS OF SALE.



APPROVED FOR CONSTRUCTION
 MASTER COPY REFERENCE COPY OF _____
 MULTIPLE UNIT WORK ORDER
 RELEASED FOR INFORMATION
 AUTH. BY: _____ DATE: _____

DRAWING No.	REFERENCE DRAWINGS	No.	REVISIONS	BY	AUTH	DATE
1			AS BUILT	BM	RH	05-05-06



GENERATOR CONTROL PANEL
 MODEL GCS 2200
 MASTER AC & DISTRIBUTION SCHEMATIC
 MIDDLE KUSKOKWIM REGIONAL ENERGY - TAKOTNA

CUSTOMER ALASKA ENERGY AUTHORITY			
CUSTOMER ORDER No. C-022623	WORK ORDER No. W-030032		
DRAWN BY LR	AUTH BY RH	DATE 05-03-03	REV 1
DRAWING/FILE No. W-030032-05			SHEET 5

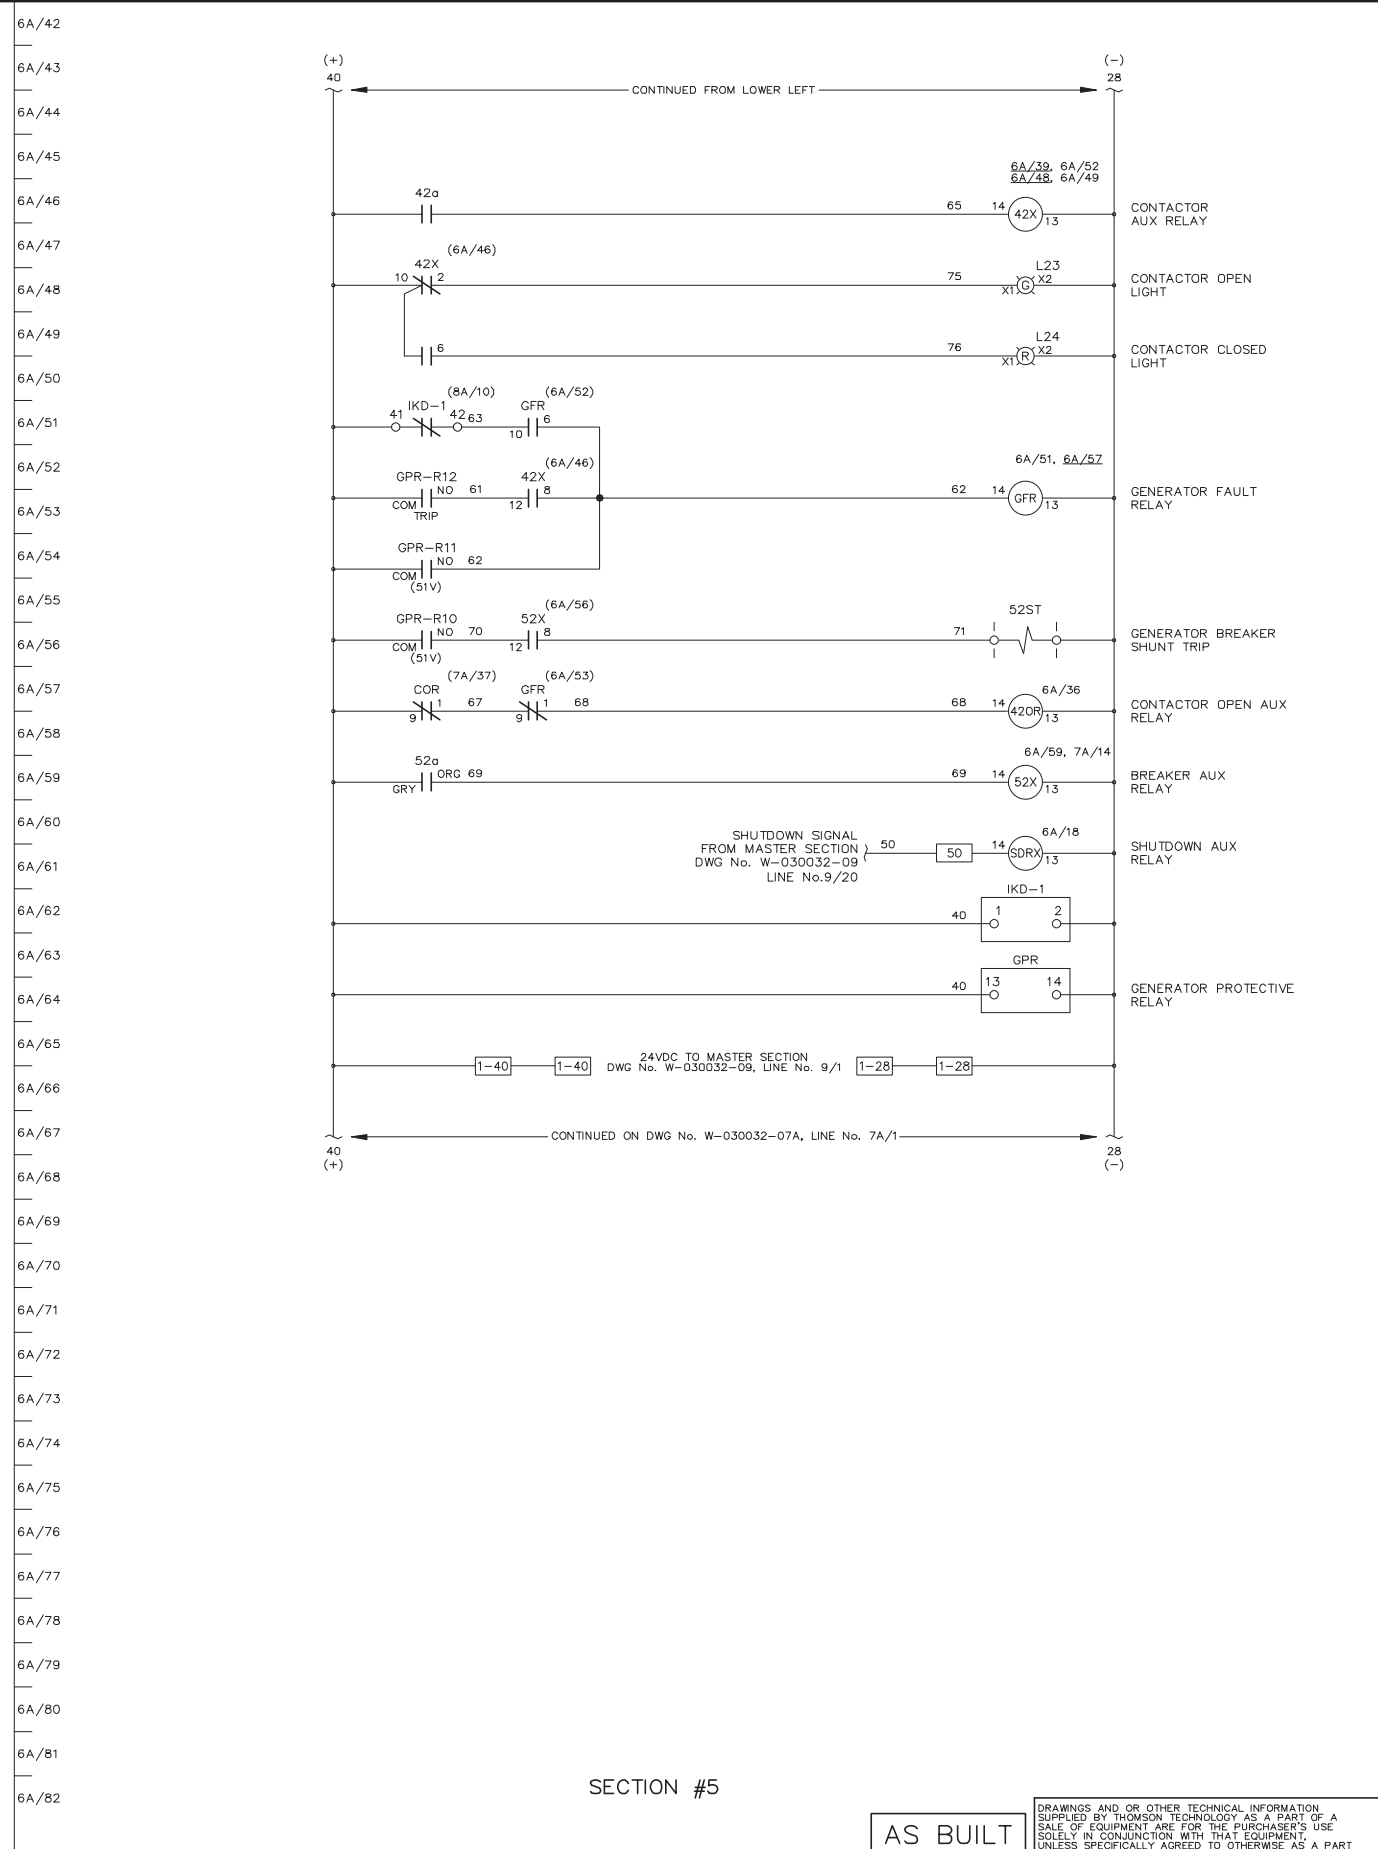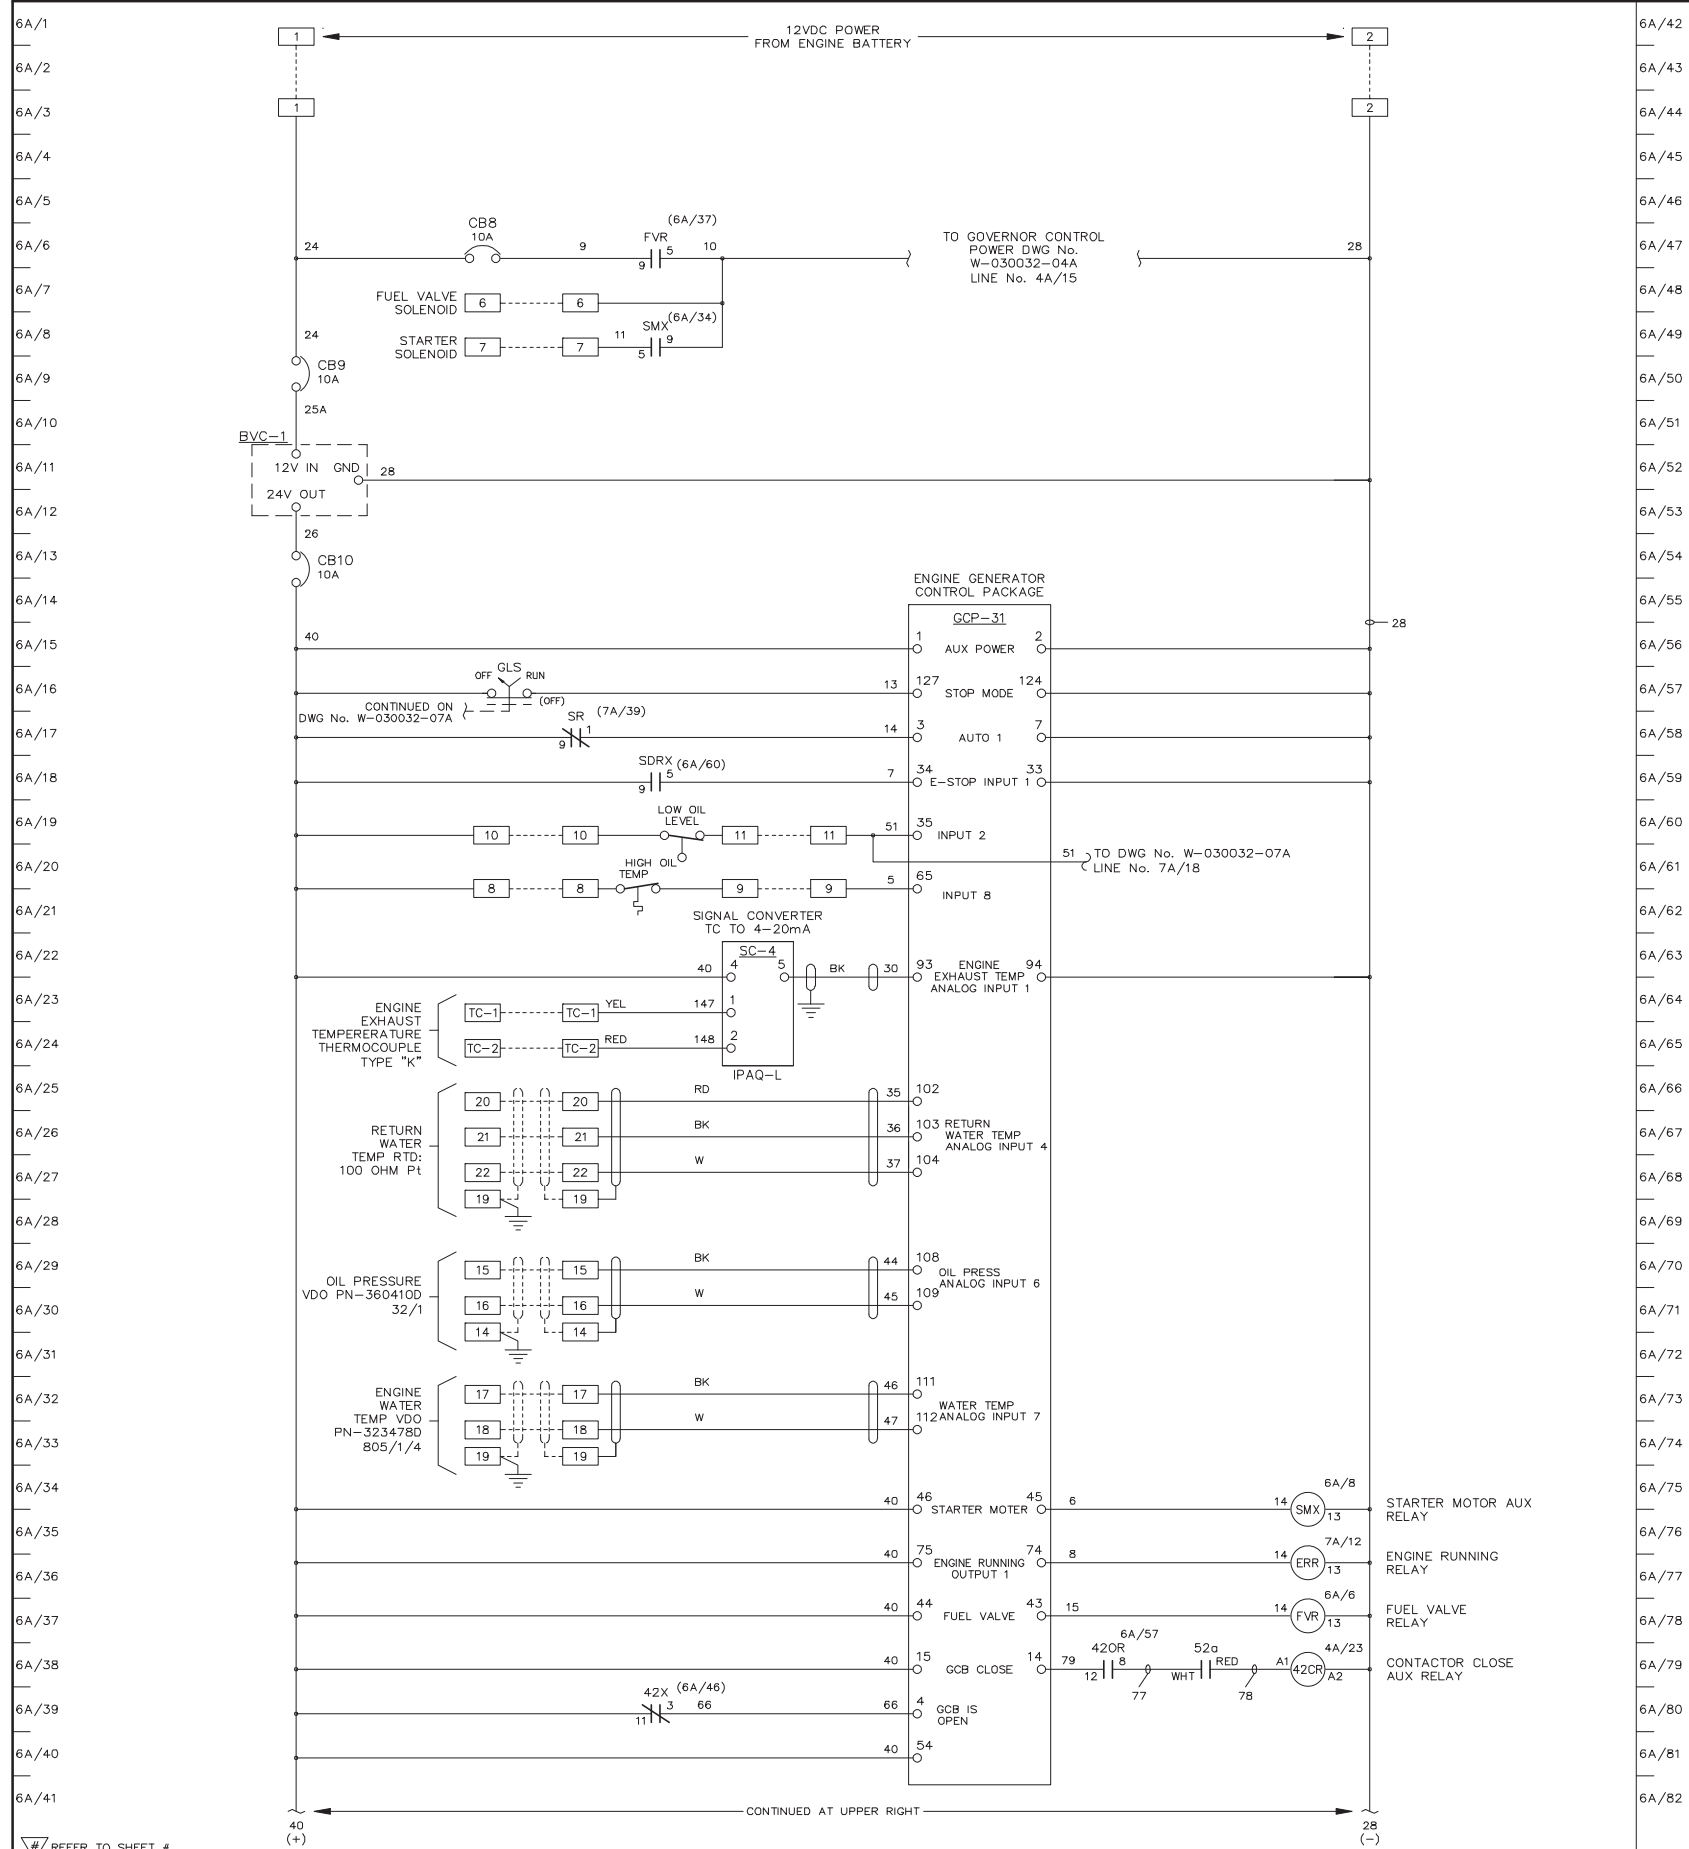

SECTION #5

AS BUILT

DRAWINGS AND/OR OTHER TECHNICAL INFORMATION SUPPLIED BY THOMSON TECHNOLOGY AS A PART OF A SALE OF EQUIPMENT ARE FOR THE PURCHASER'S USE SOLELY IN CONJUNCTION WITH THAT EQUIPMENT, UNLESS SPECIFICALLY AGREED TO OTHERWISE AS A PART OF THE TERMS OF SALE.



APPROVED FOR CONSTRUCTION
 MASTER COPY REFERENCE COPY OF
 MULTIPLE UNIT WORK ORDER
 RELEASED FOR INFORMATION
 AUTH. BY: _____ DATE: _____

DRAWING No.	REFERENCE DRAWINGS	REVISIONS	BY	AUTH	DATE
1	AS BUILT		BM	RH	05-05-06



GENERATOR CONTROL PANEL
 MODEL GCS 2200
 GENERATOR 1 DC CONTROL SCHEMATIC
 MIDDLE KUSKOKWIM REGIONAL ENERGY - TAKOTNA

CUSTOMER ALASKA ENERGY AUTHORITY			
CUSTOMER ORDER No. C-022623	WORK ORDER No. W-030032	DATE 05-03-03	REV 1
DRAWN BY LR	AUTH BY RH	DATE 05-03-03	REV 1
DRAWING/FILE No. W-030032-06A			SHEET 6A

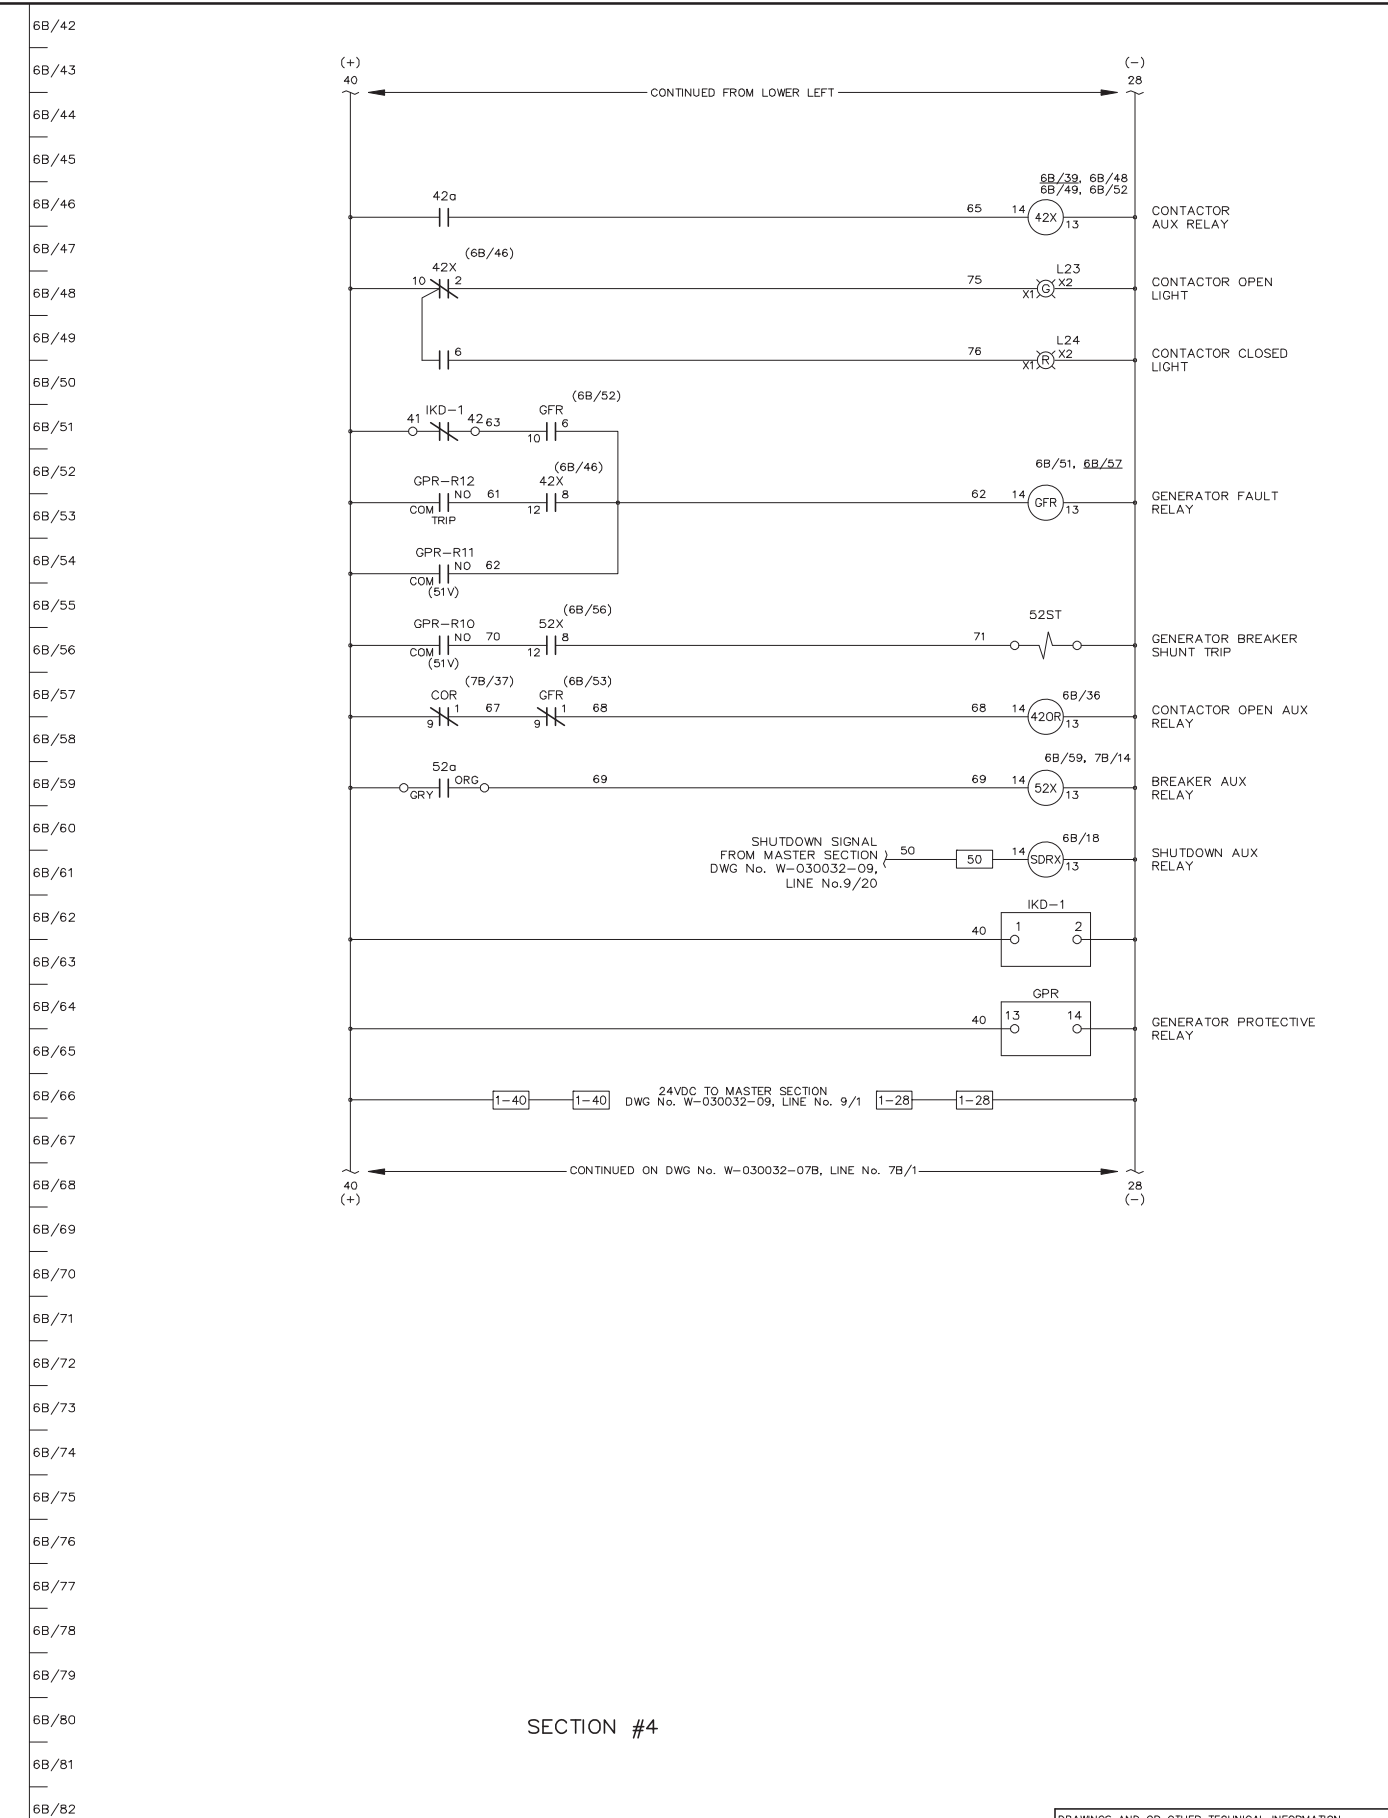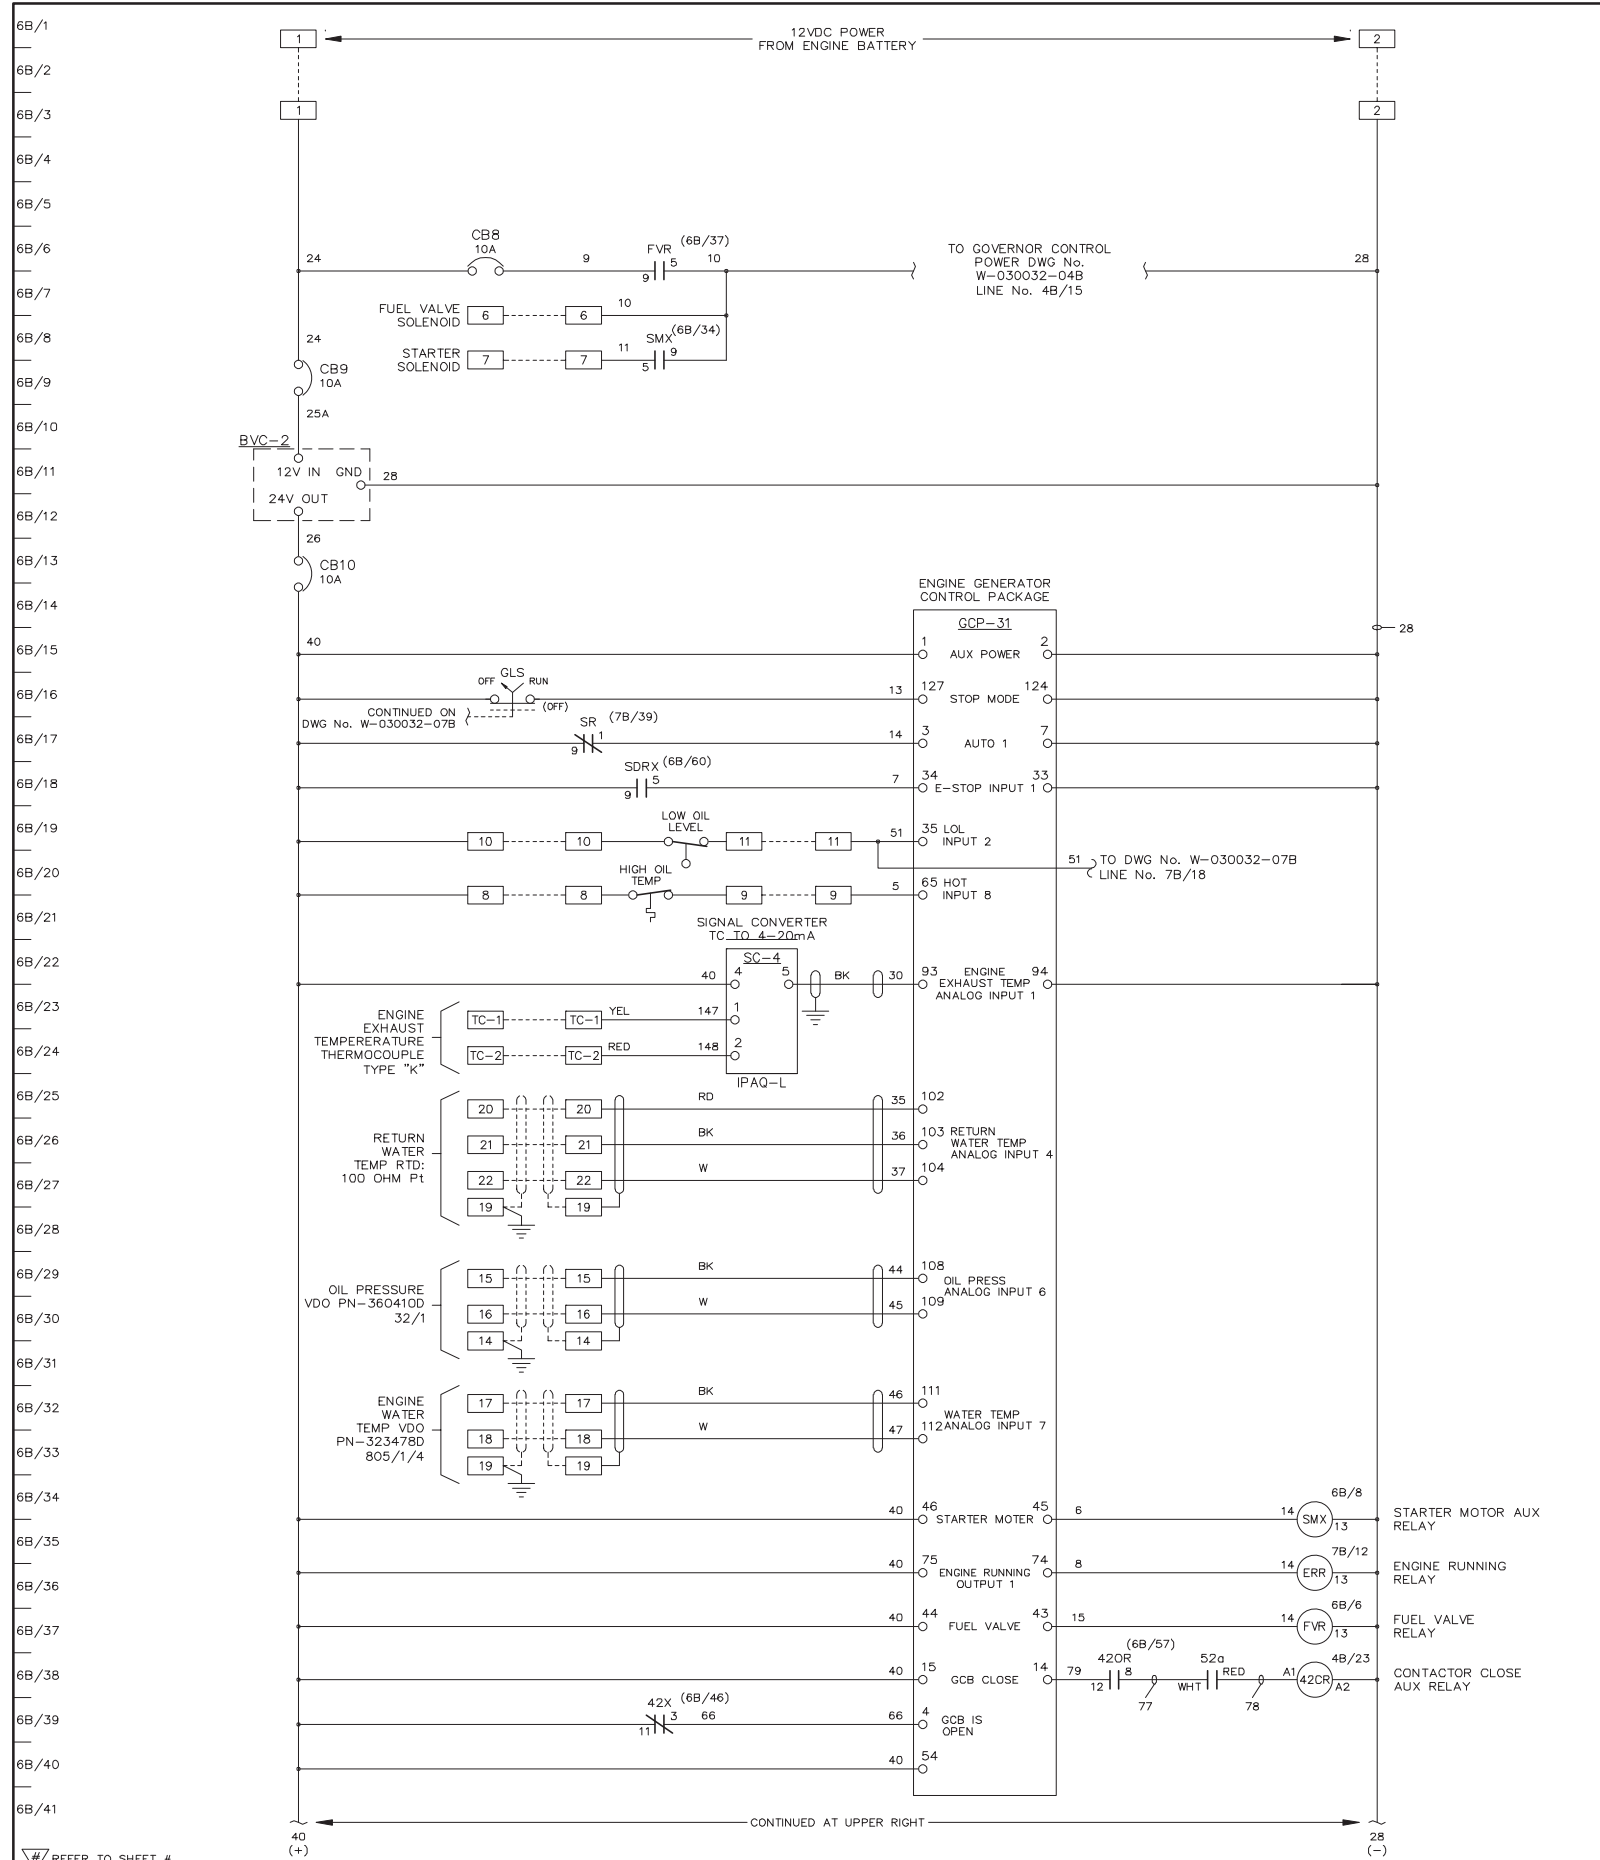

REFER TO SHEET #

APPROVED FOR CONSTRUCTION

MASTER COPY REFERENCE COPY OF

MULTIPLE UNIT WORK ORDER

RELEASED FOR INFORMATION

AUTH. BY: DATE:

DRAWING No.	REFERENCE DRAWINGS	No.	REVISIONS	BY	AUTH	DATE
2	AS BUILT			BM	RH	05-05-06
1	APPROVAL MOD'S			BM	RH	05-03-16





GENERATOR CONTROL PANEL
MODEL GCS 2200
GENERATOR 2 DC CONTROL SCHEMATIC
MIDDLE KUSKOKWIM REGIONAL ENERGY - TAKOTNA

AS BUILT

DRAWINGS AND/OR OTHER TECHNICAL INFORMATION SUPPLIED BY THOMSON TECHNOLOGY AS A PART OF A SALE OF EQUIPMENT ARE FOR THE PURCHASER'S USE SOLELY IN CONJUNCTION WITH THAT EQUIPMENT, UNLESS SPECIFICALLY AGREED TO OTHERWISE AS A PART OF THE TERMS OF SALE.

CUSTOMER ALASKA ENERGY AUTHORITY			
CUSTOMER ORDER No. C-022623	WORK ORDER No. W-030032		
DRAWN BY LR	AUTH BY RH	DATE 05-03-03	REV 2
DRAWING/FILE No. W-030032-06B			SHEET 6B

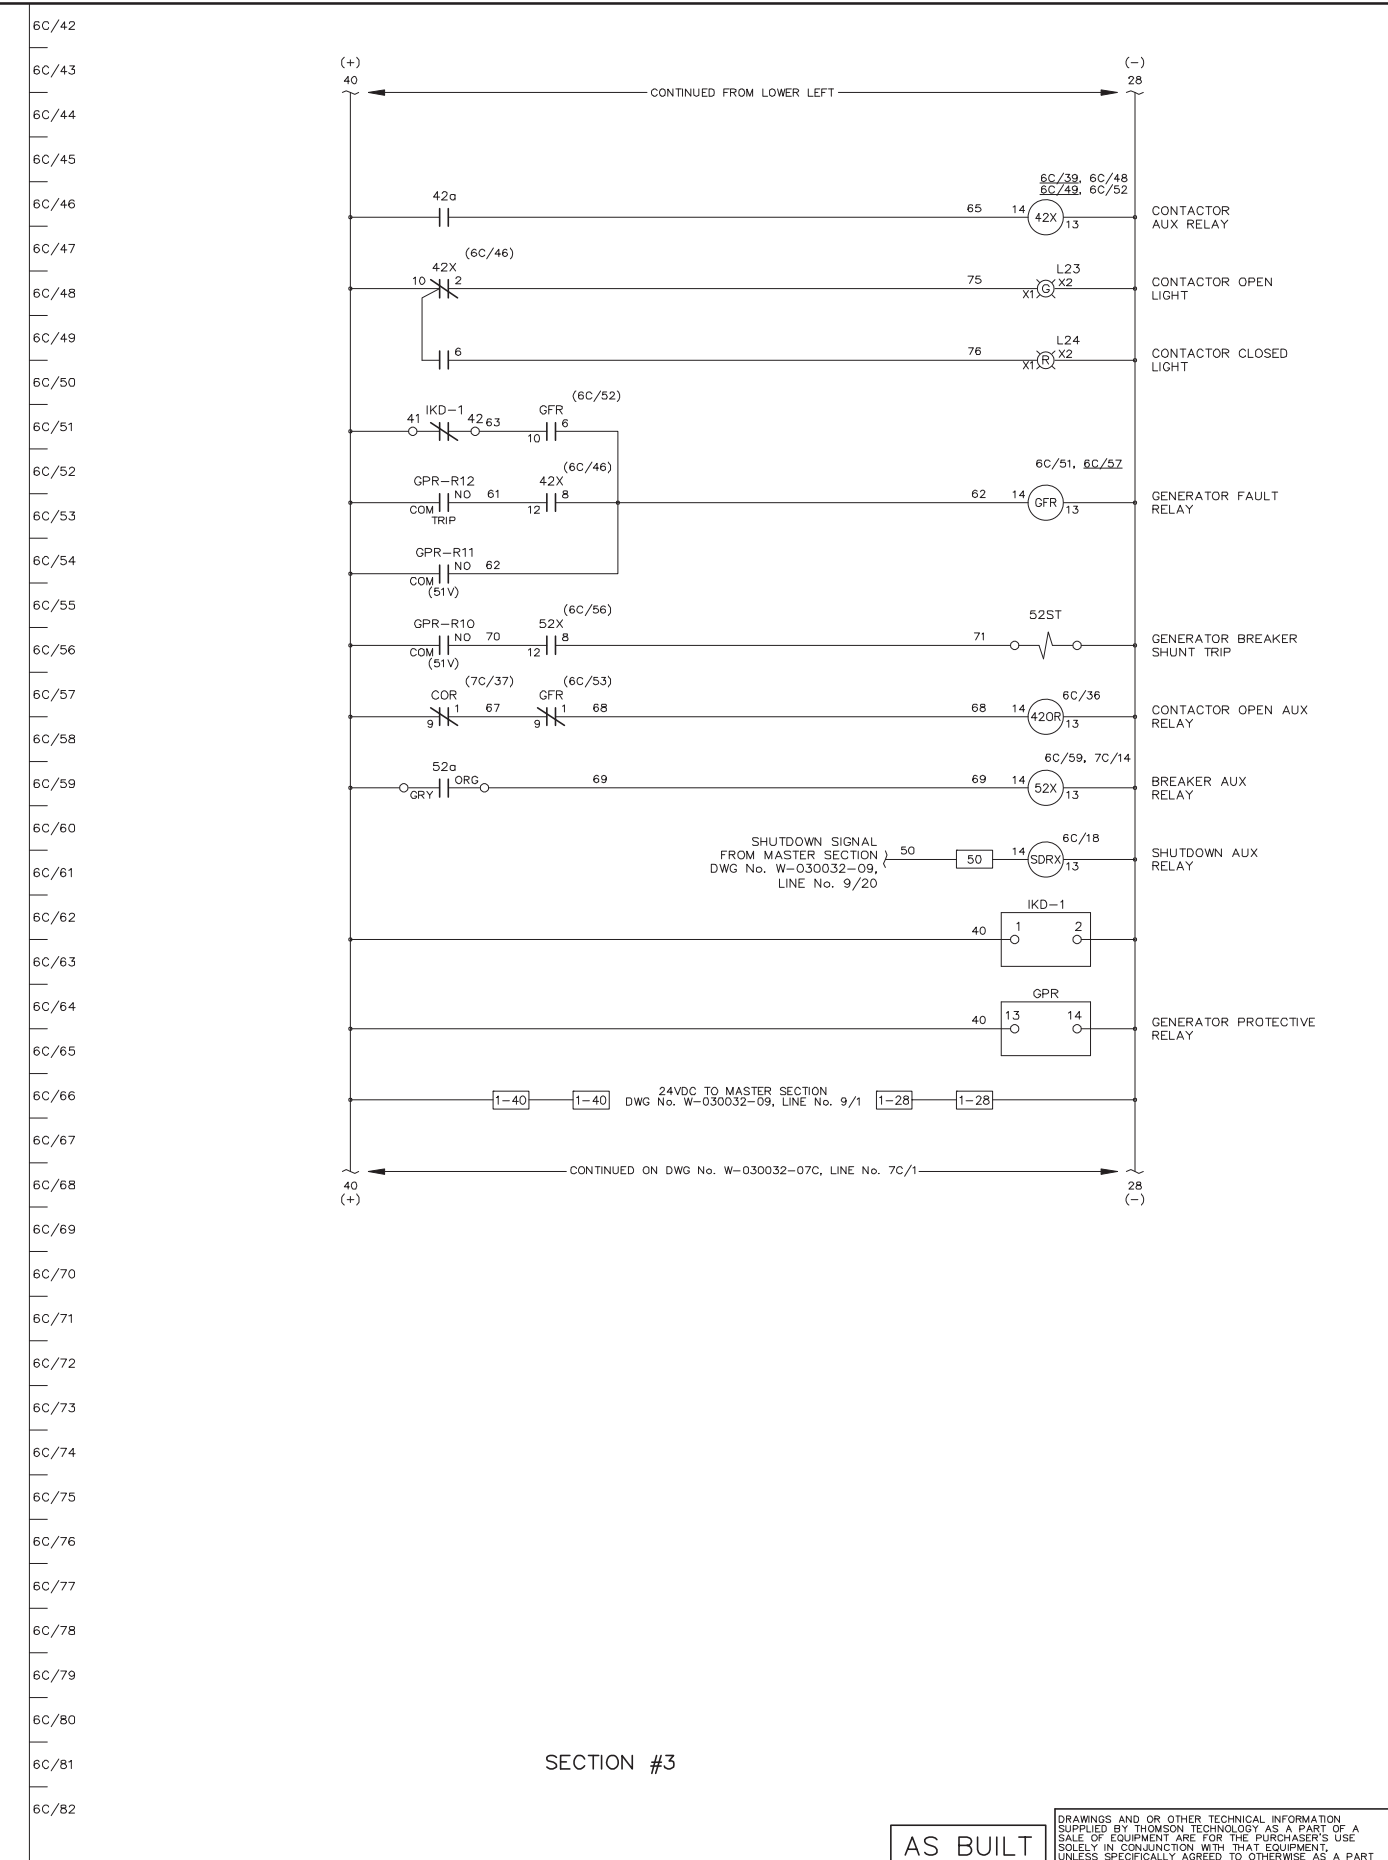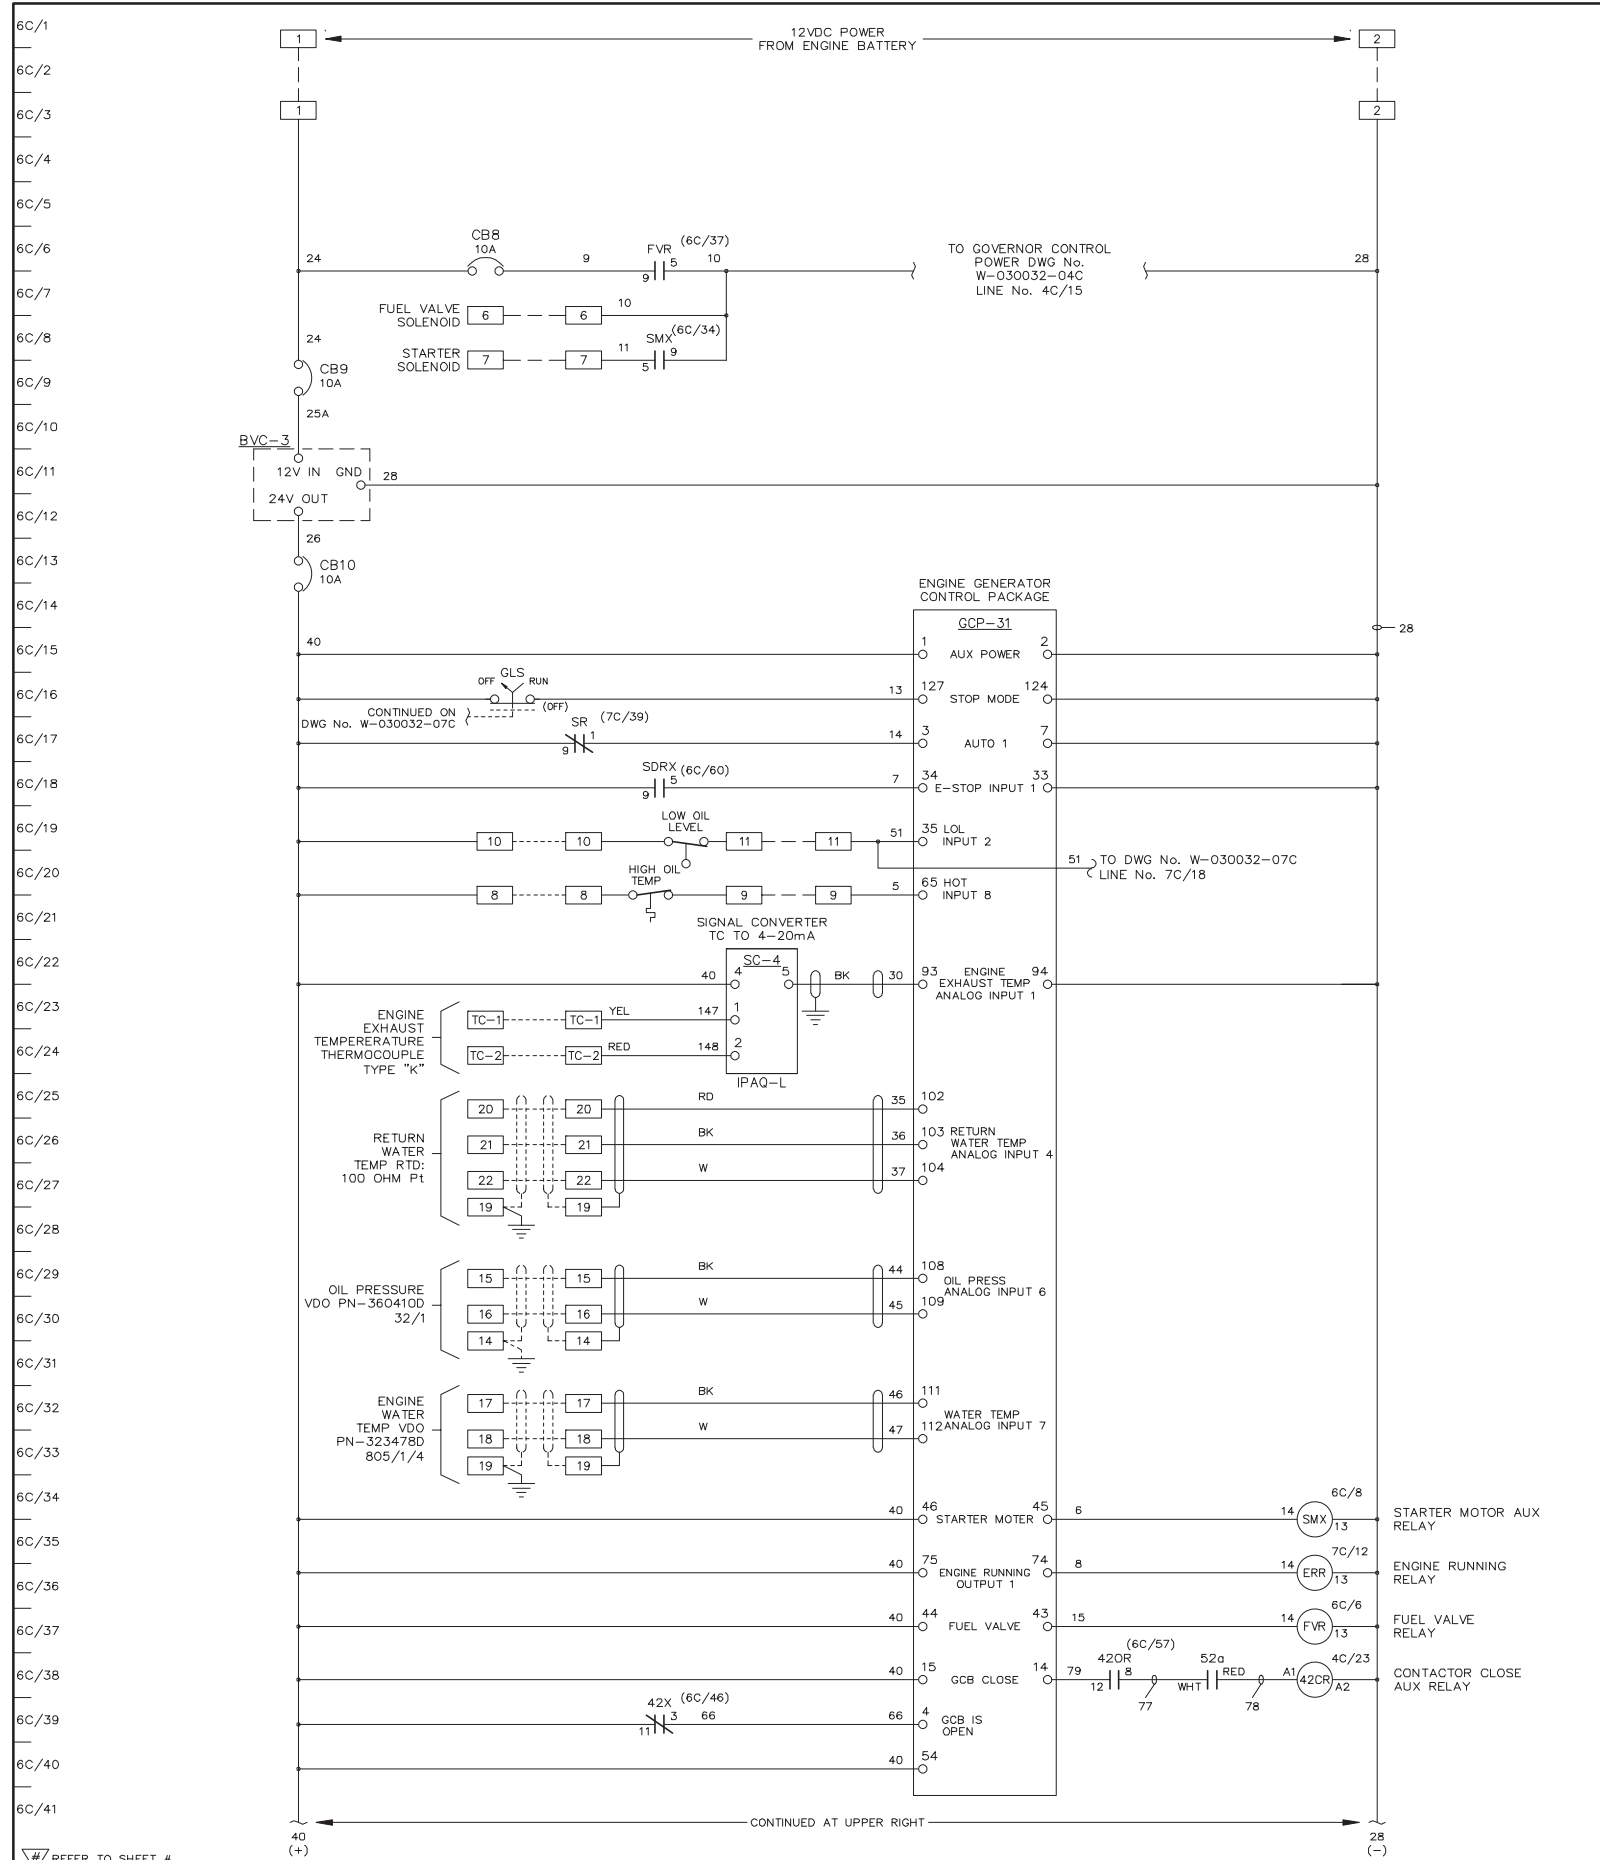

REFER TO SHEET #

APPROVED FOR CONSTRUCTION


MASTER COPY REFERENCE COPY OF

MULTIPLE UNIT WORK ORDER

RELEASED FOR INFORMATION



AUTH. BY: DATE:

DRAWING No.	REFERENCE DRAWINGS	No.	REVISIONS	BY	AUTH	DATE
2	AS BUILT			BM	RH	05-05-06
1	APPROVAL MOD'S			BM	RH	05-03-16

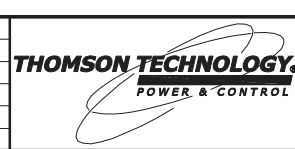

GENERATOR CONTROL PANEL
MODEL GCS 2200
GENERATOR 3 DC CONTROL SCHEMATIC
MIDDLE KUSKOKWIM REGIONAL ENERGY - TAKOTNA

CUSTOMER ALASKA ENERGY AUTHORITY			
CUSTOMER ORDER No. C-022623	WORK ORDER No. W-030032		
DRAWN BY LR	AUTH BY RH	DATE 05-03-03	REV 2
DRAWING/FILE No. W-030032-06C			SHEET 6C

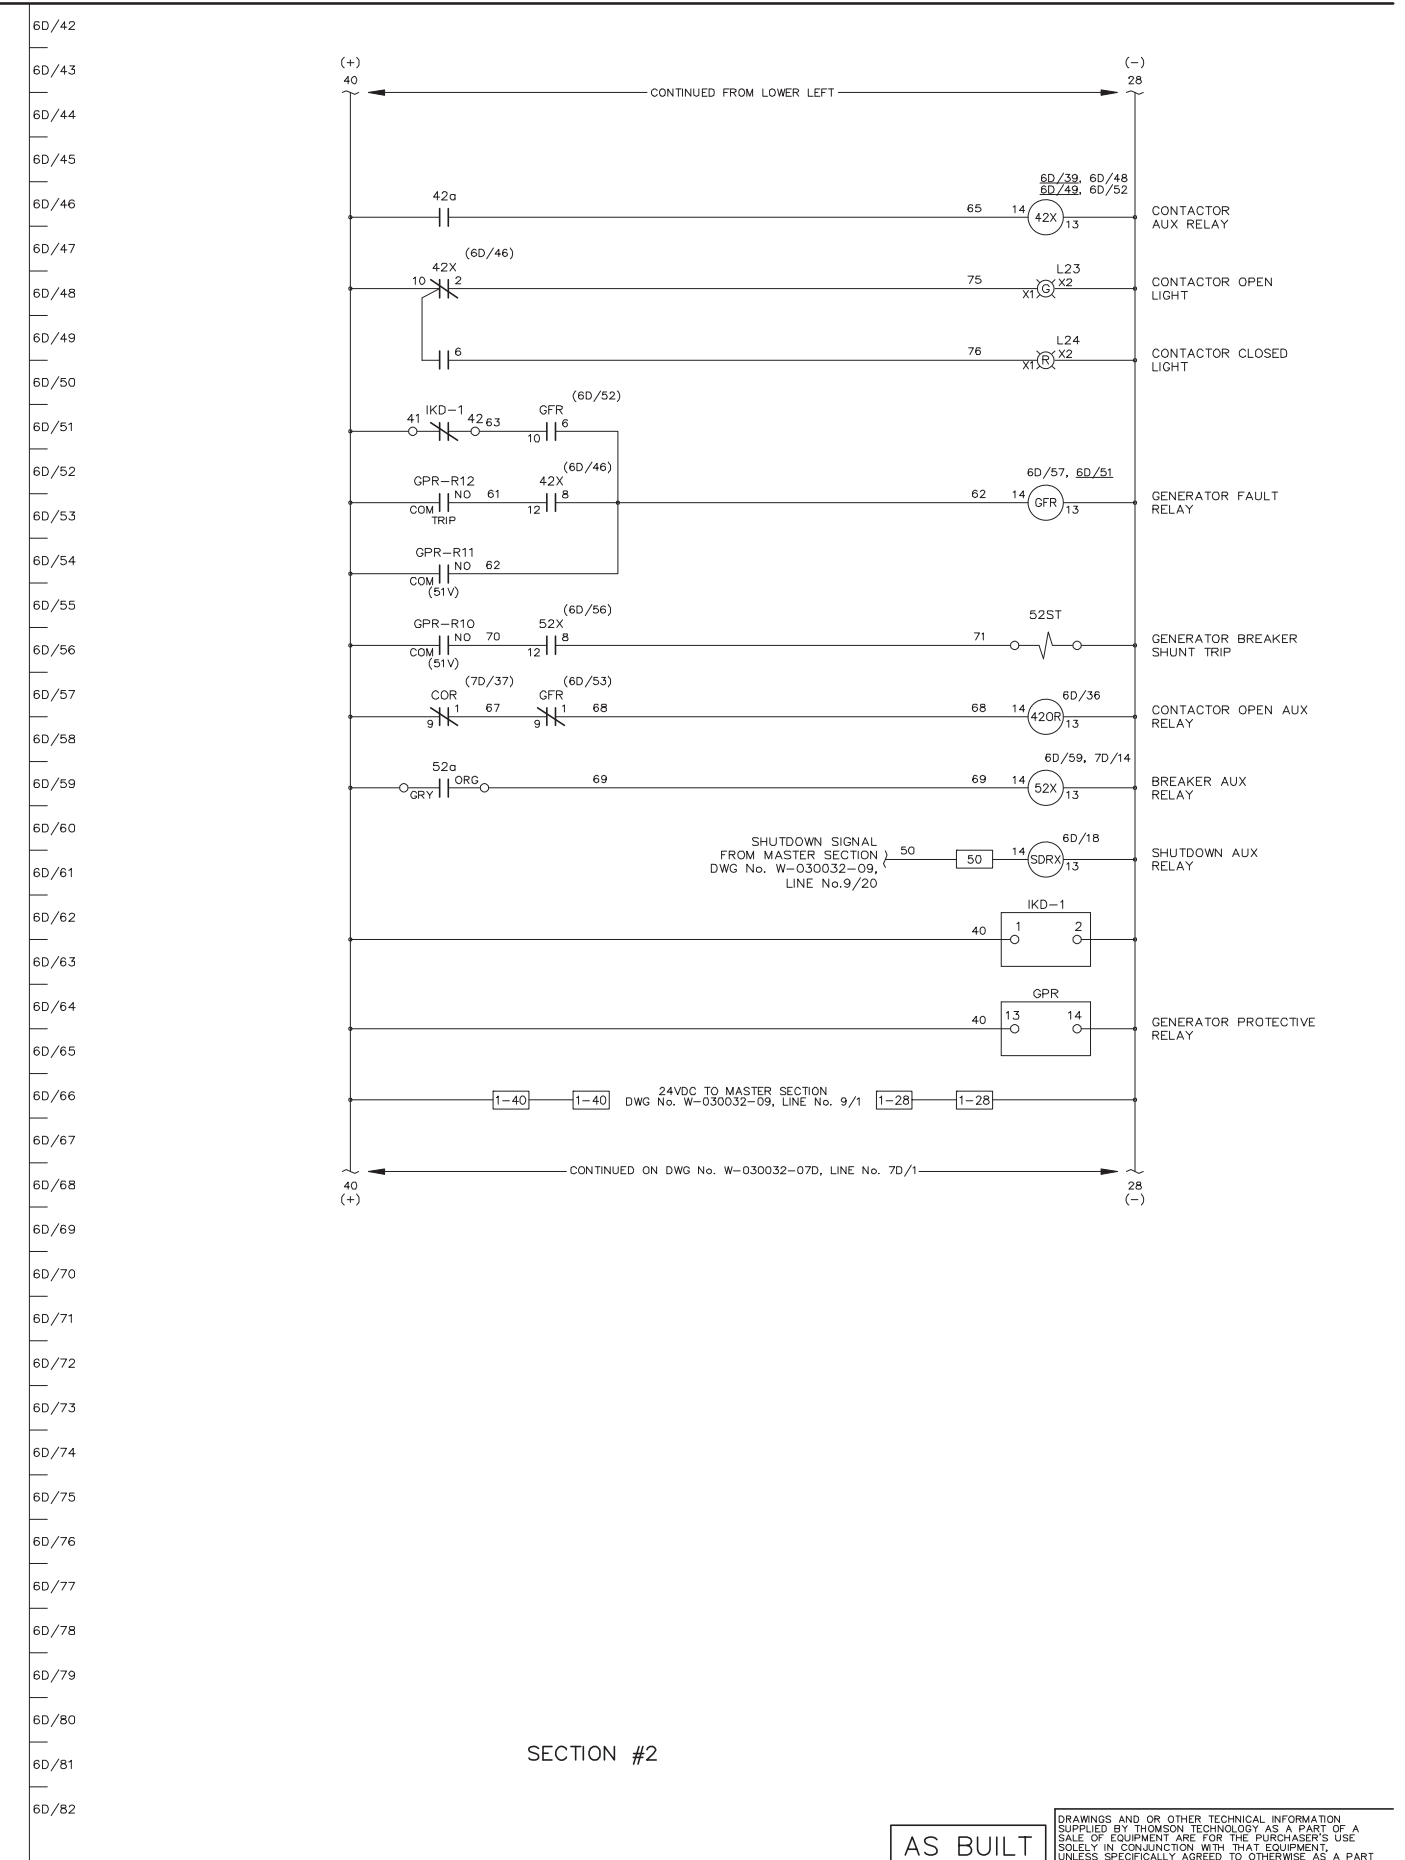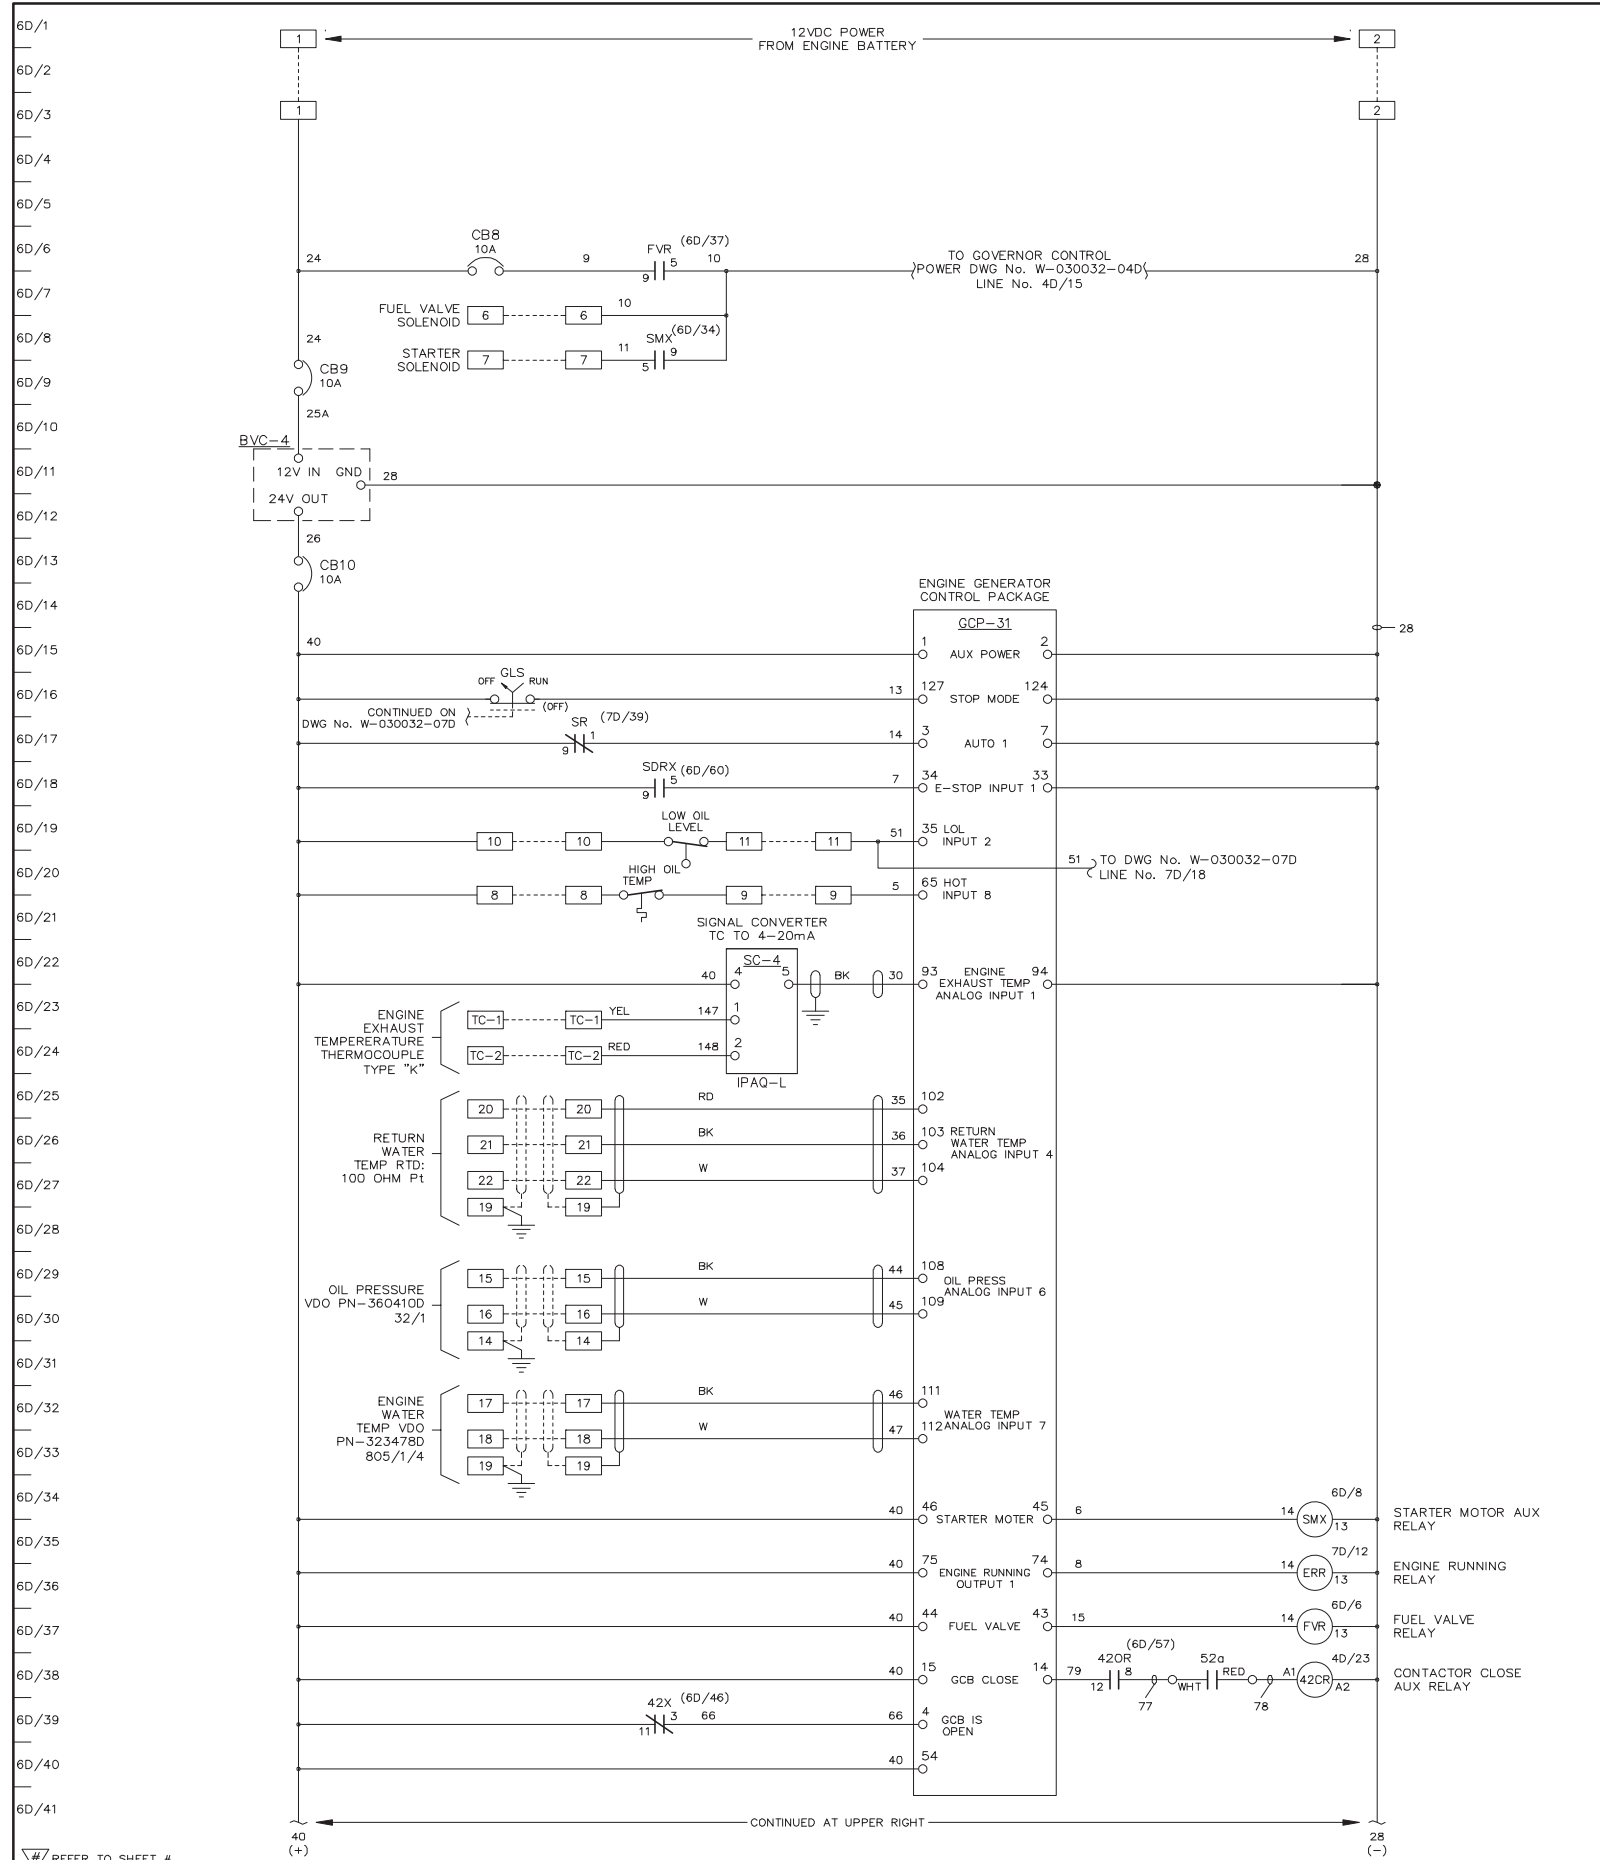

SECTION #2

AS BUILT



APPROVED FOR CONSTRUCTION
 MASTER COPY REFERENCE COPY OF
 MULTIPLE UNIT WORK ORDER
 RELEASED FOR INFORMATION
 AUTH. BY: _____ DATE: _____

DRAWING No.	REFERENCE DRAWINGS	No.	REVISIONS	BY	AUTH	DATE
2	AS BUILT			BM	RH	05-05-06
1	APPROVAL MOD'S			BM	RH	05-03-16



GENERATOR CONTROL PANEL
 MODEL GCS 2200
 GENERATOR 4 DC CONTROL SCHEMATIC
 MIDDLE KUSKOKWIM REGIONAL ENERGY - TAKOTNA

CUSTOMER ALASKA ENERGY AUTHORITY			
CUSTOMER ORDER No. C-022623	WORK ORDER No. W-030032	DATE 05-03-03	REV 2
DRAWN BY LR	AUTH BY RH	DATE 05-03-03	REV 2
DRAWING/FILE No. W-030032-06D			SHEET 6D

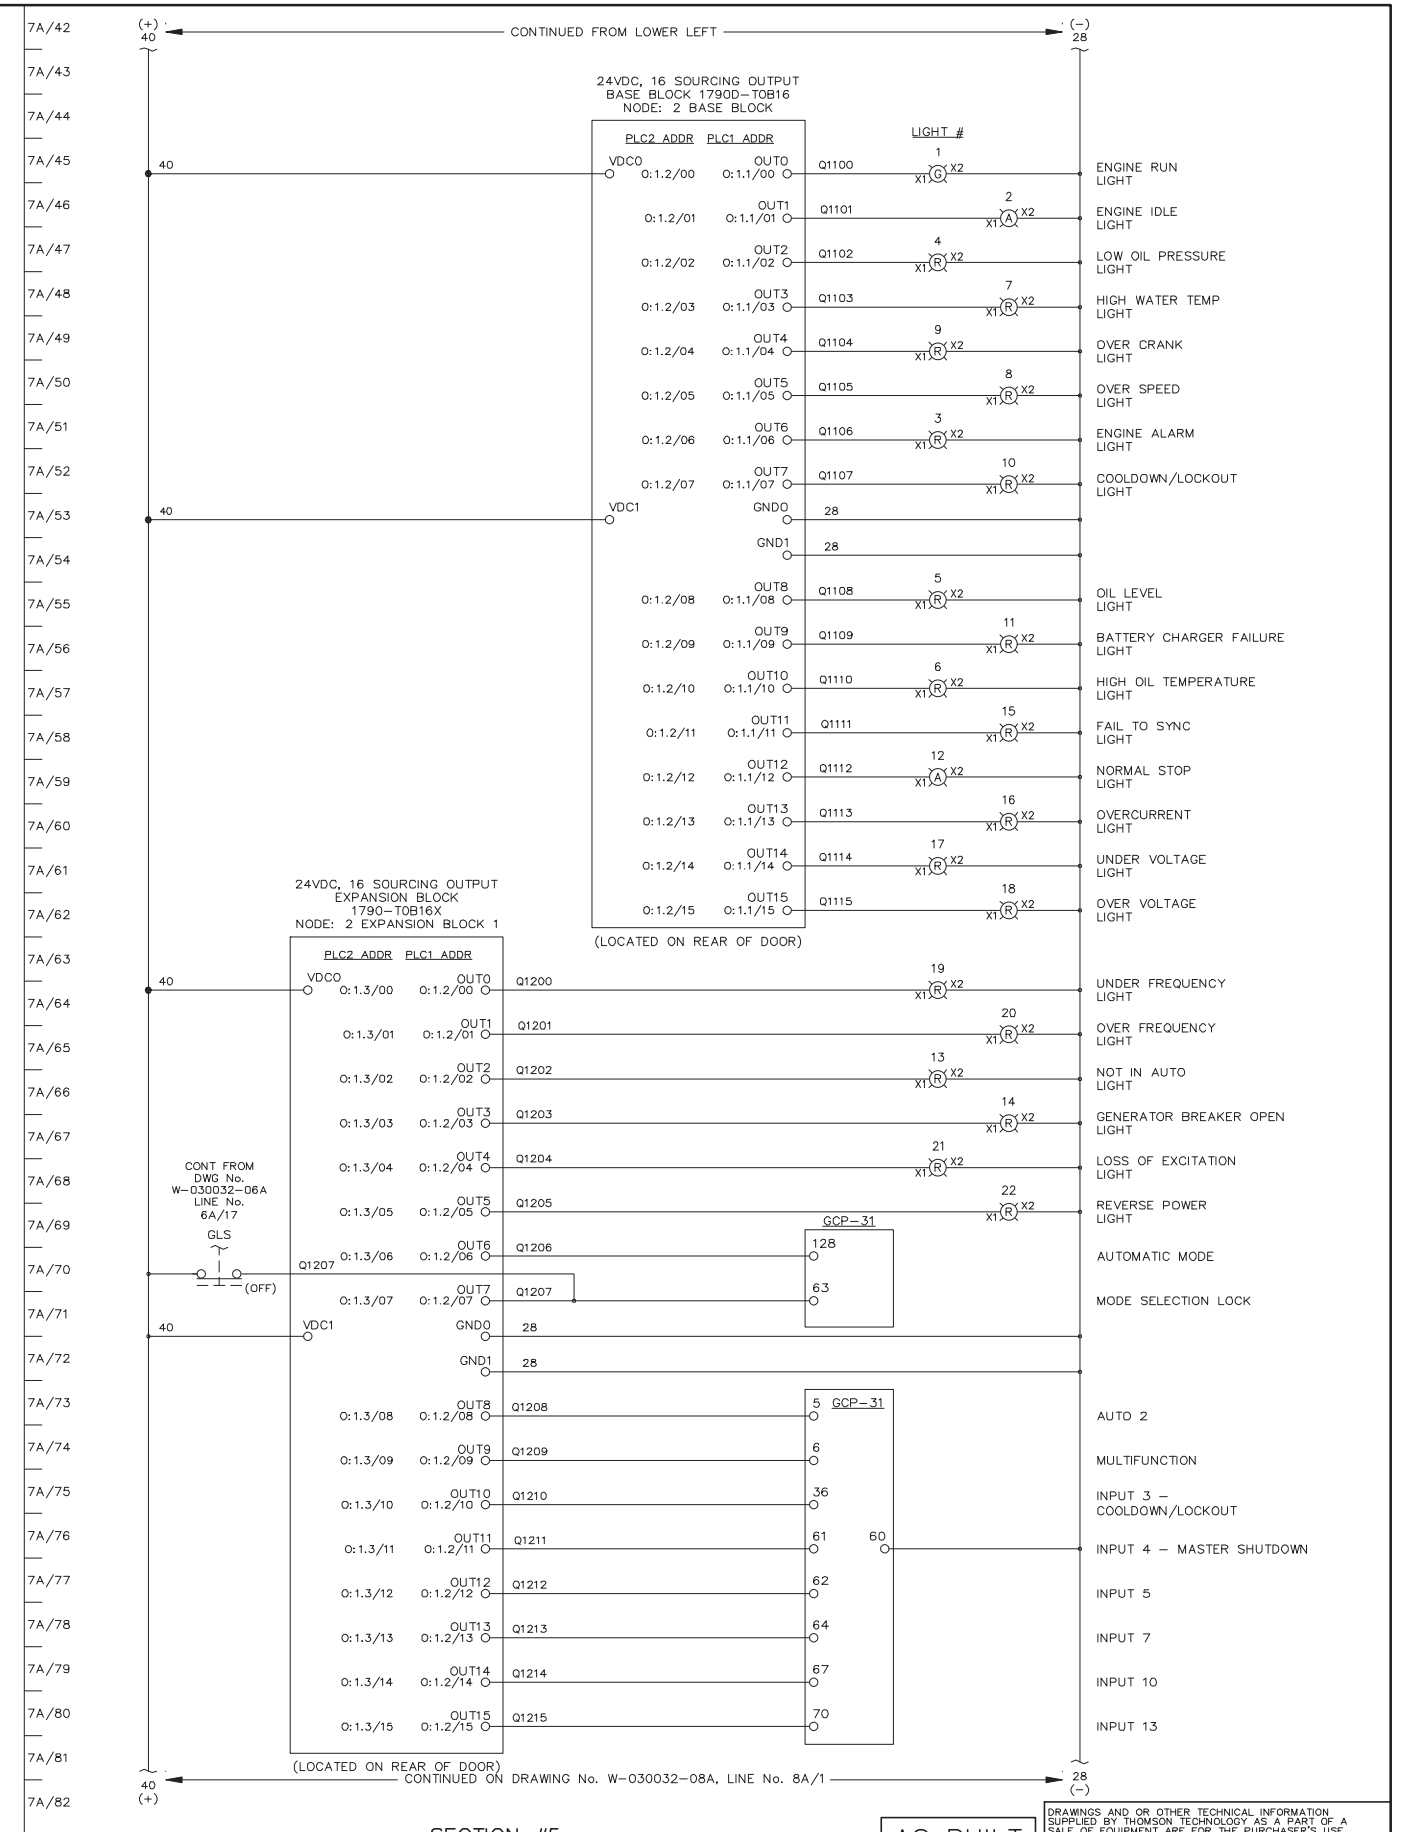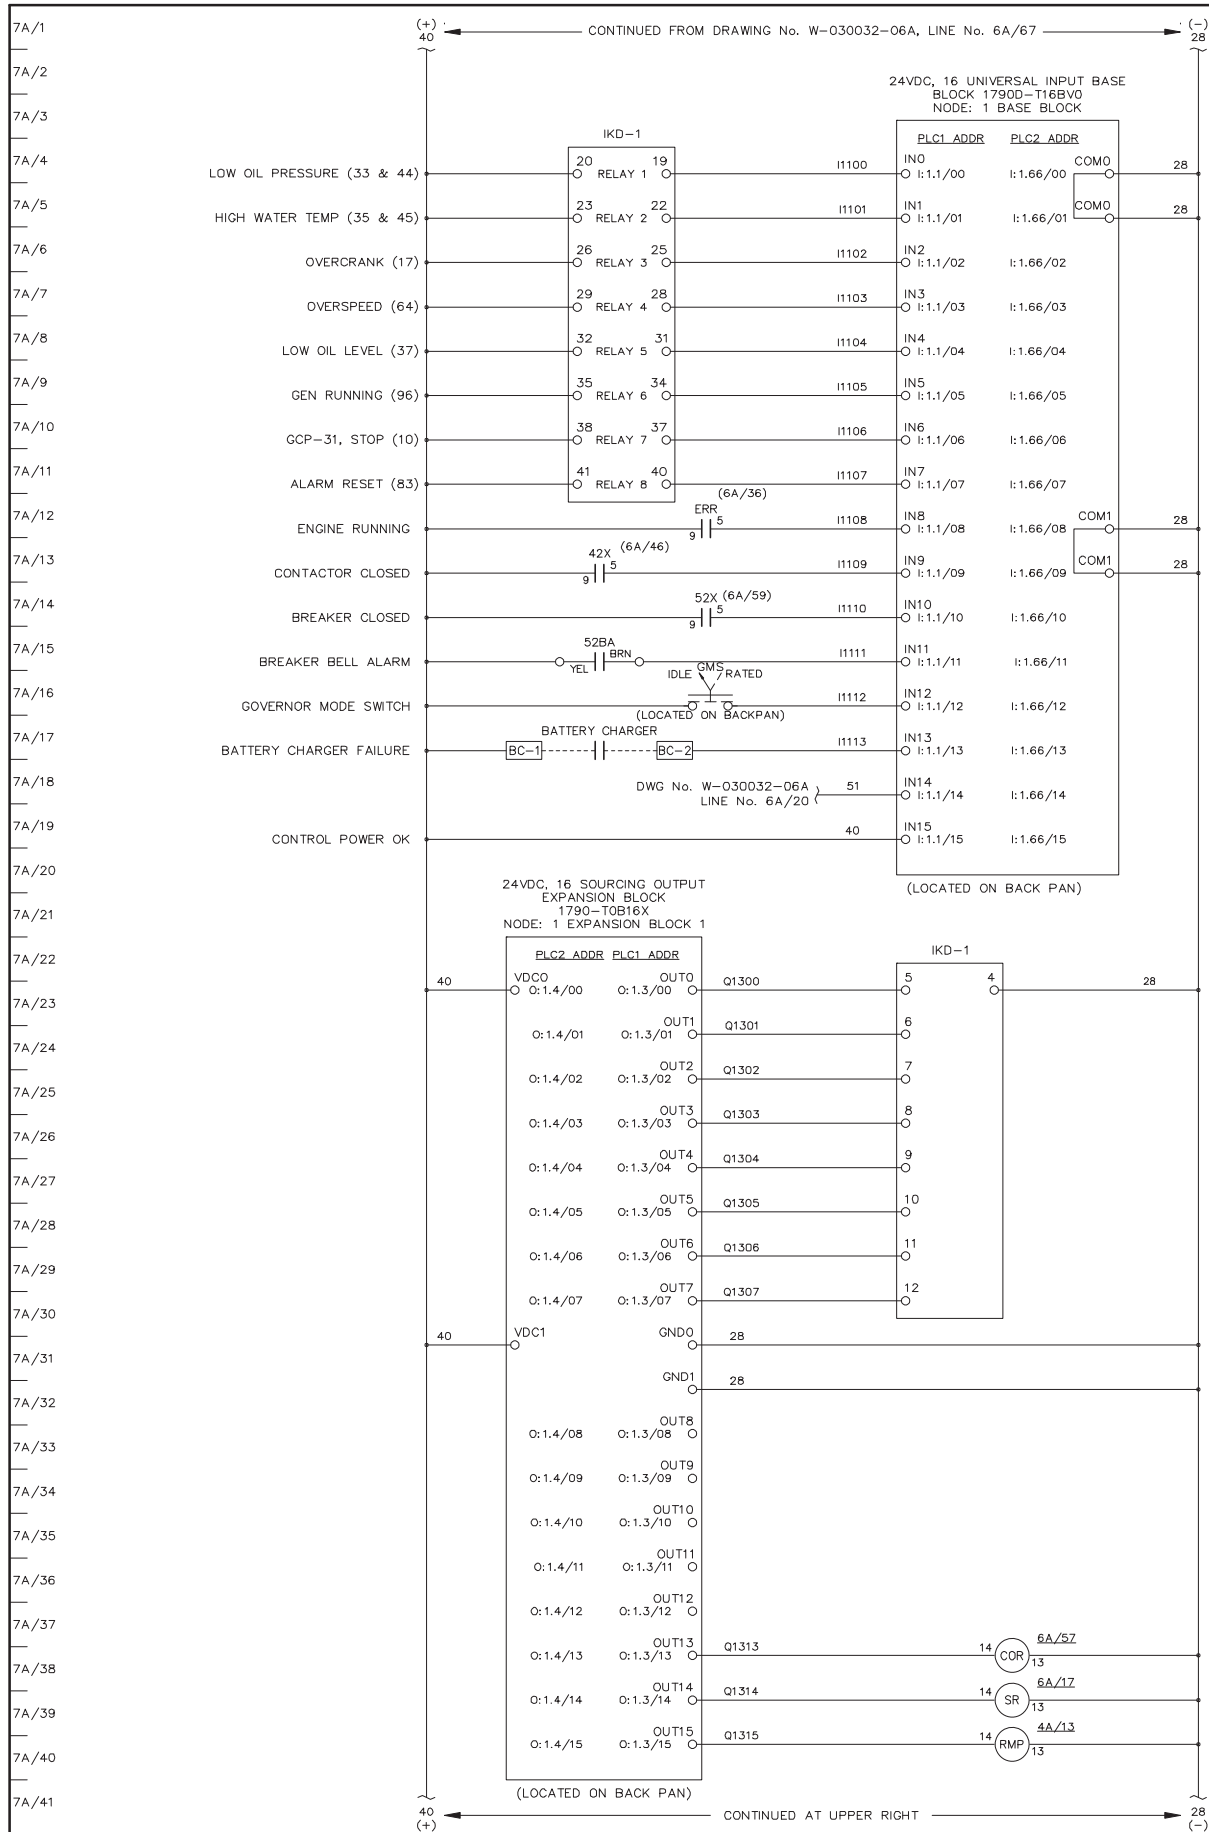

REFER TO SHEET #

APPROVED FOR CONSTRUCTION
 MASTER COPY REFERENCE COPY OF
 MULTIPLE UNIT WORK ORDER
 RELEASED FOR INFORMATION
 AUTH. BY: _____ DATE: _____

DRAWING No.	REFERENCE DRAWINGS	No.	REVISIONS	BY	AUTH	DATE
		2	AS BUILT	BM	RH	05-05-06
		1	APPROVAL MOD'S	BM	RH	05-03-16

THOMSON TECHNOLOGY
POWER & CONTROL



SECTION #5

AS BUILT

GENERATOR CONTROL PANEL
MODEL GCS 2200
GENERATOR 1 DC CONTROL SCHEMATIC
MIDDLE KUSKOKWIM REGIONAL ENERGY - TAKOTNA

CUSTOMER ALASKA ENERGY AUTHORITY			
CUSTOMER ORDER No. C-022623	WORK ORDER No. W-030032	DATE 05-03-03	REV 2
DRAWN BY LR	AUTH BY RH	DATE 05-03-03	REV 2
DRAWING/FILE No. W-030032-07A	SHEET 7A		

© THE INFORMATION ON THIS DRAWING IS THE PROPERTY OF THOMSON TECHNOLOGY. IT IS NOT TO BE USED DETRIMENTALLY TO OUR INTERESTS.

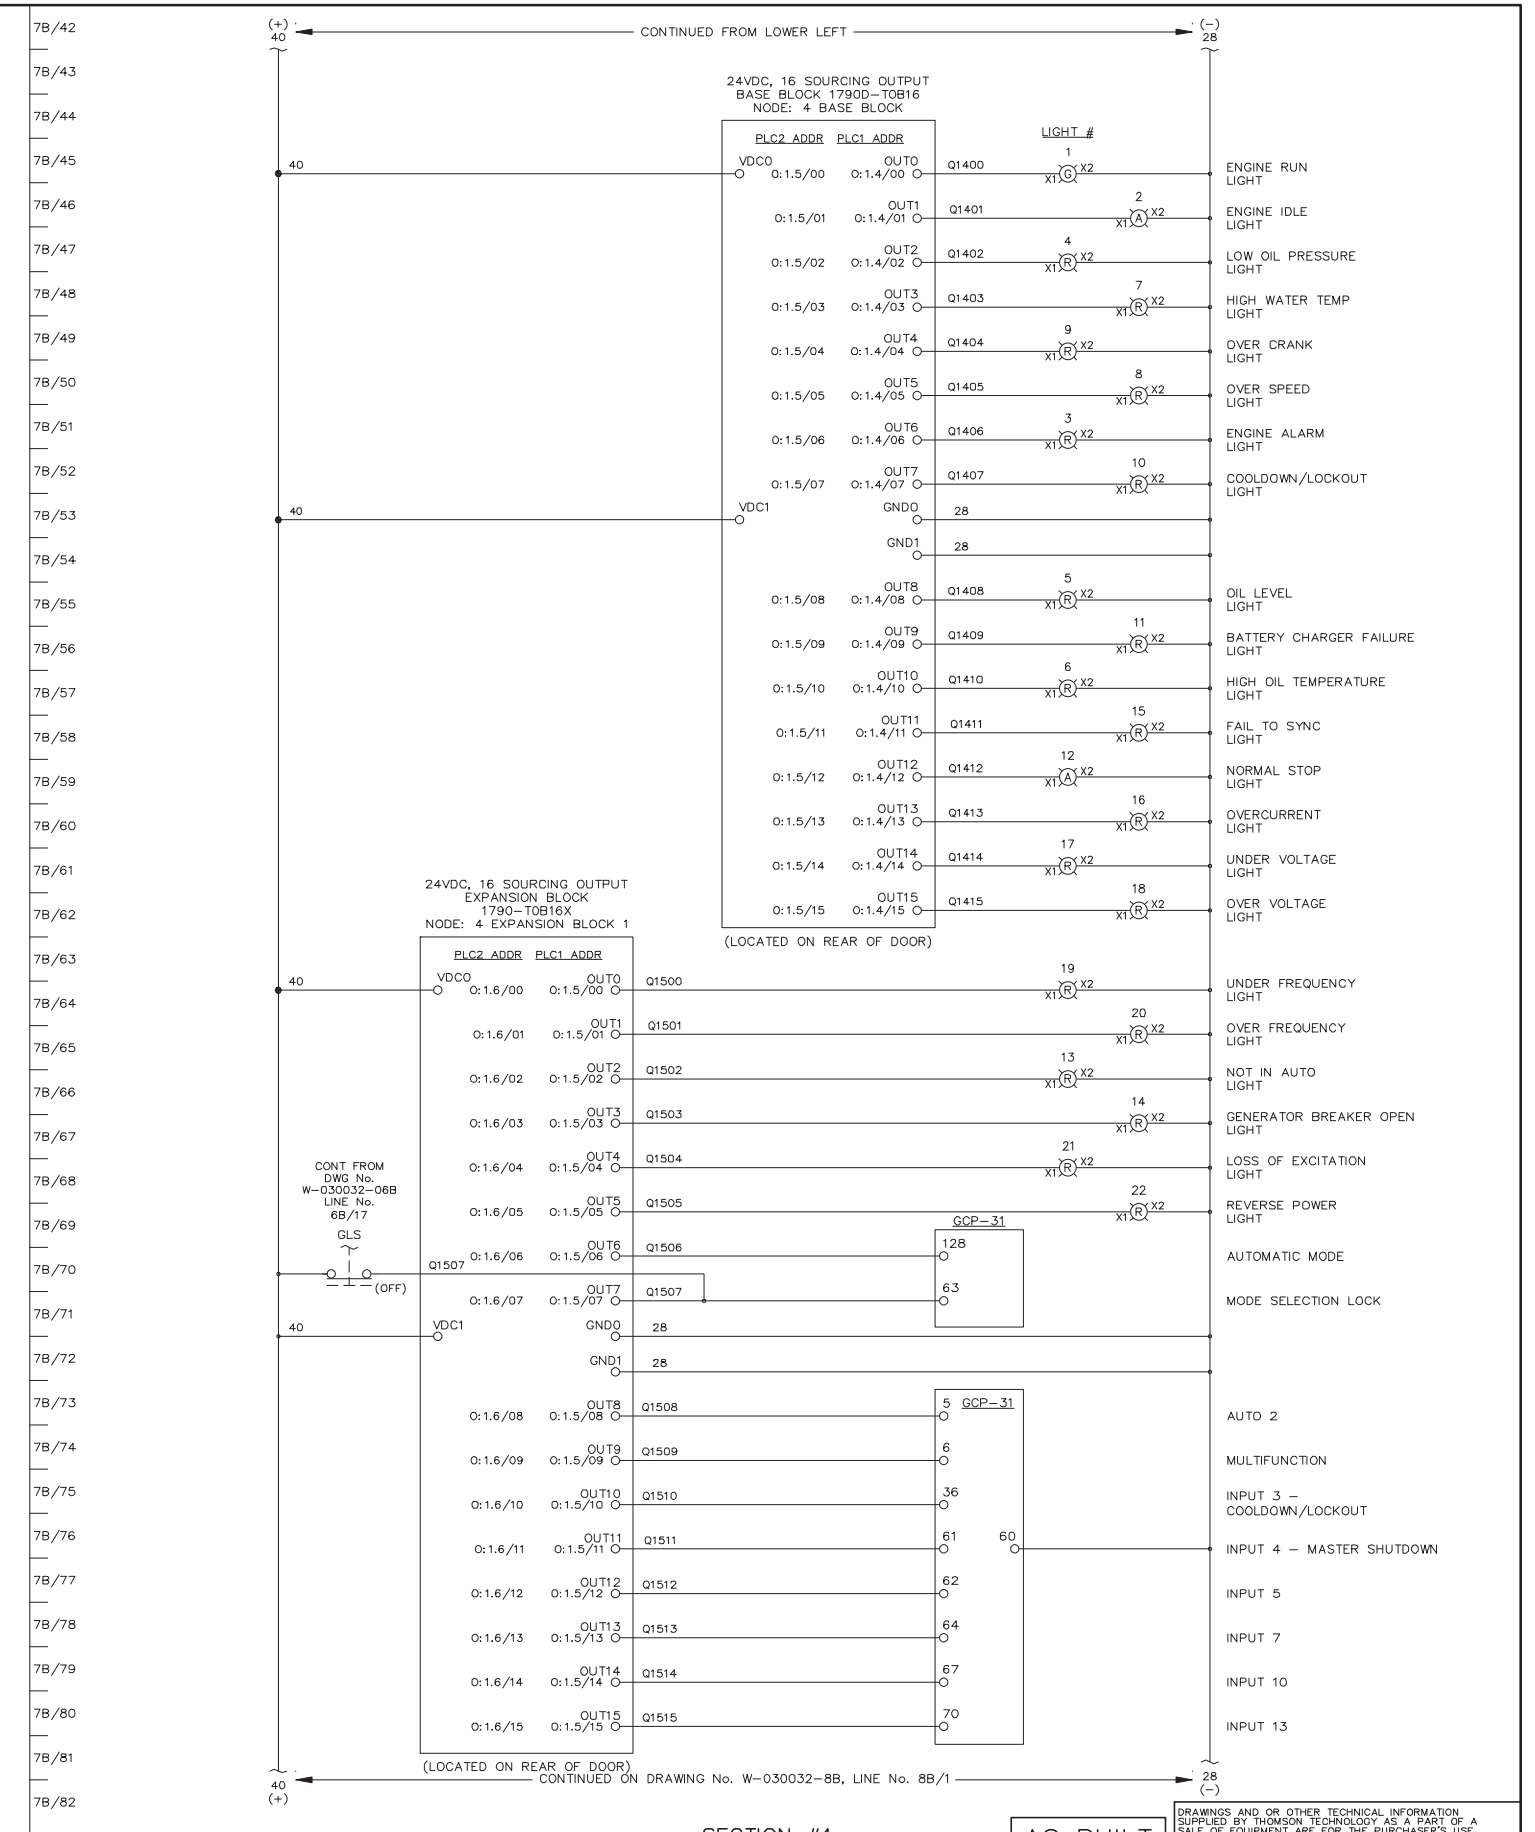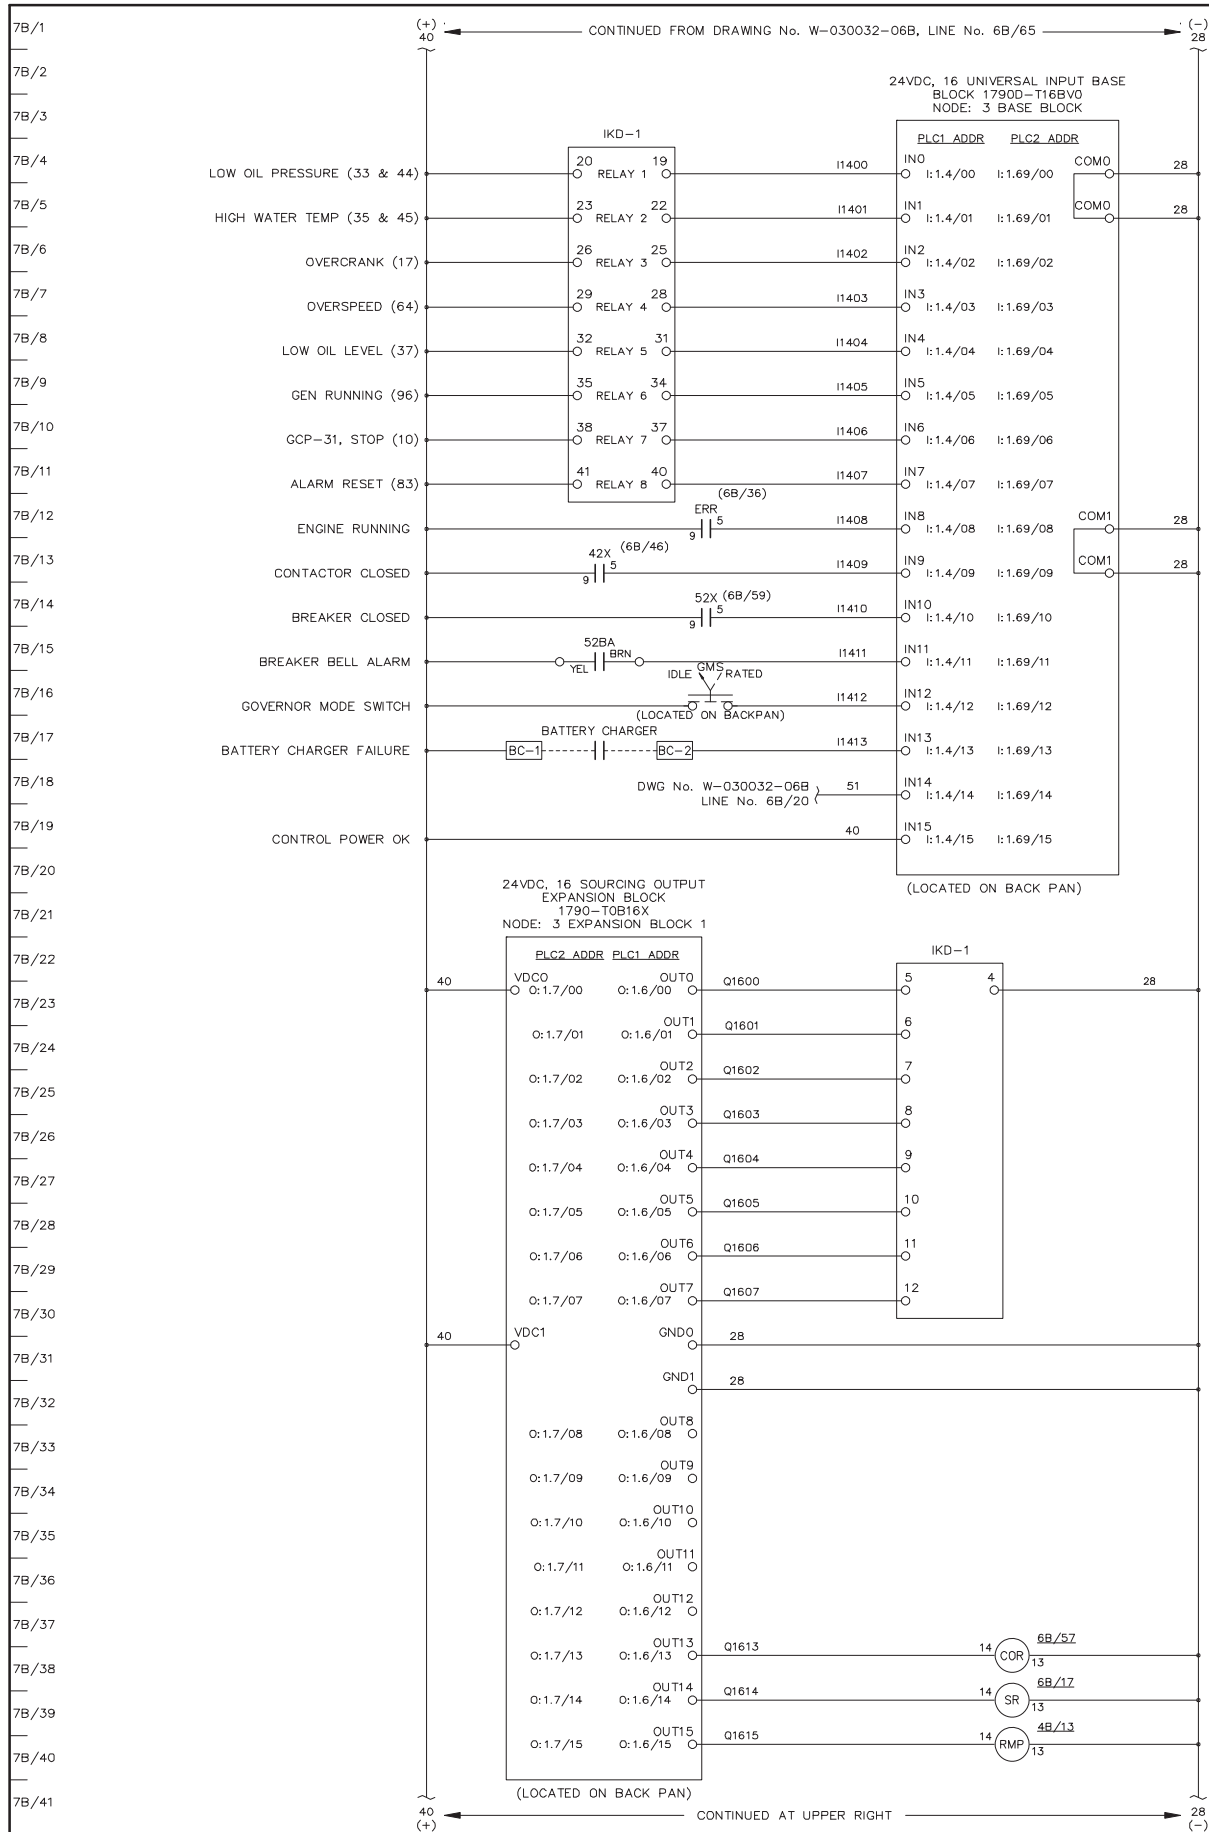

SECTION #4

AS BUILT

DRAWINGS AND/OR OTHER TECHNICAL INFORMATION SUPPLIED BY THOMSON TECHNOLOGY AS A PART OF A SALE OF EQUIPMENT ARE FOR THE PURCHASER'S USE SOLELY IN CONJUNCTION WITH THAT EQUIPMENT, UNLESS SPECIFICALLY AGREED TO OTHERWISE AS A PART OF THE TERMS OF SALE.

REFER TO SHEET #



APPROVED FOR CONSTRUCTION
 MASTER COPY REFERENCE COPY OF
 MULTIPLE UNIT WORK ORDER
 RELEASED FOR INFORMATION
 AUTH. BY: _____ DATE: _____

DRAWING No.	REFERENCE DRAWINGS	No.	REVISIONS	BY	AUTH	DATE
2	AS BUILT			BM	RH	05-05-06
1	APPROVAL MOD'S			BM	RH	05-03-16



GENERATOR CONTROL PANEL
 MODEL GCS 2200
 GENERATOR 2 DC CONTROL SCHEMATIC
 MIDDLE KUSKOKWIM REGIONAL ENERGY - TAKOTNA

CUSTOMER ALASKA ENERGY AUTHORITY	
CUSTOMER ORDER No. C-022623	WORK ORDER No. W-030032
DRAWN BY LR	AUTH BY RH
DATE 05-03-03	REV 2
DRAWING/FILE No. W-030032-07B	SHEET 7B

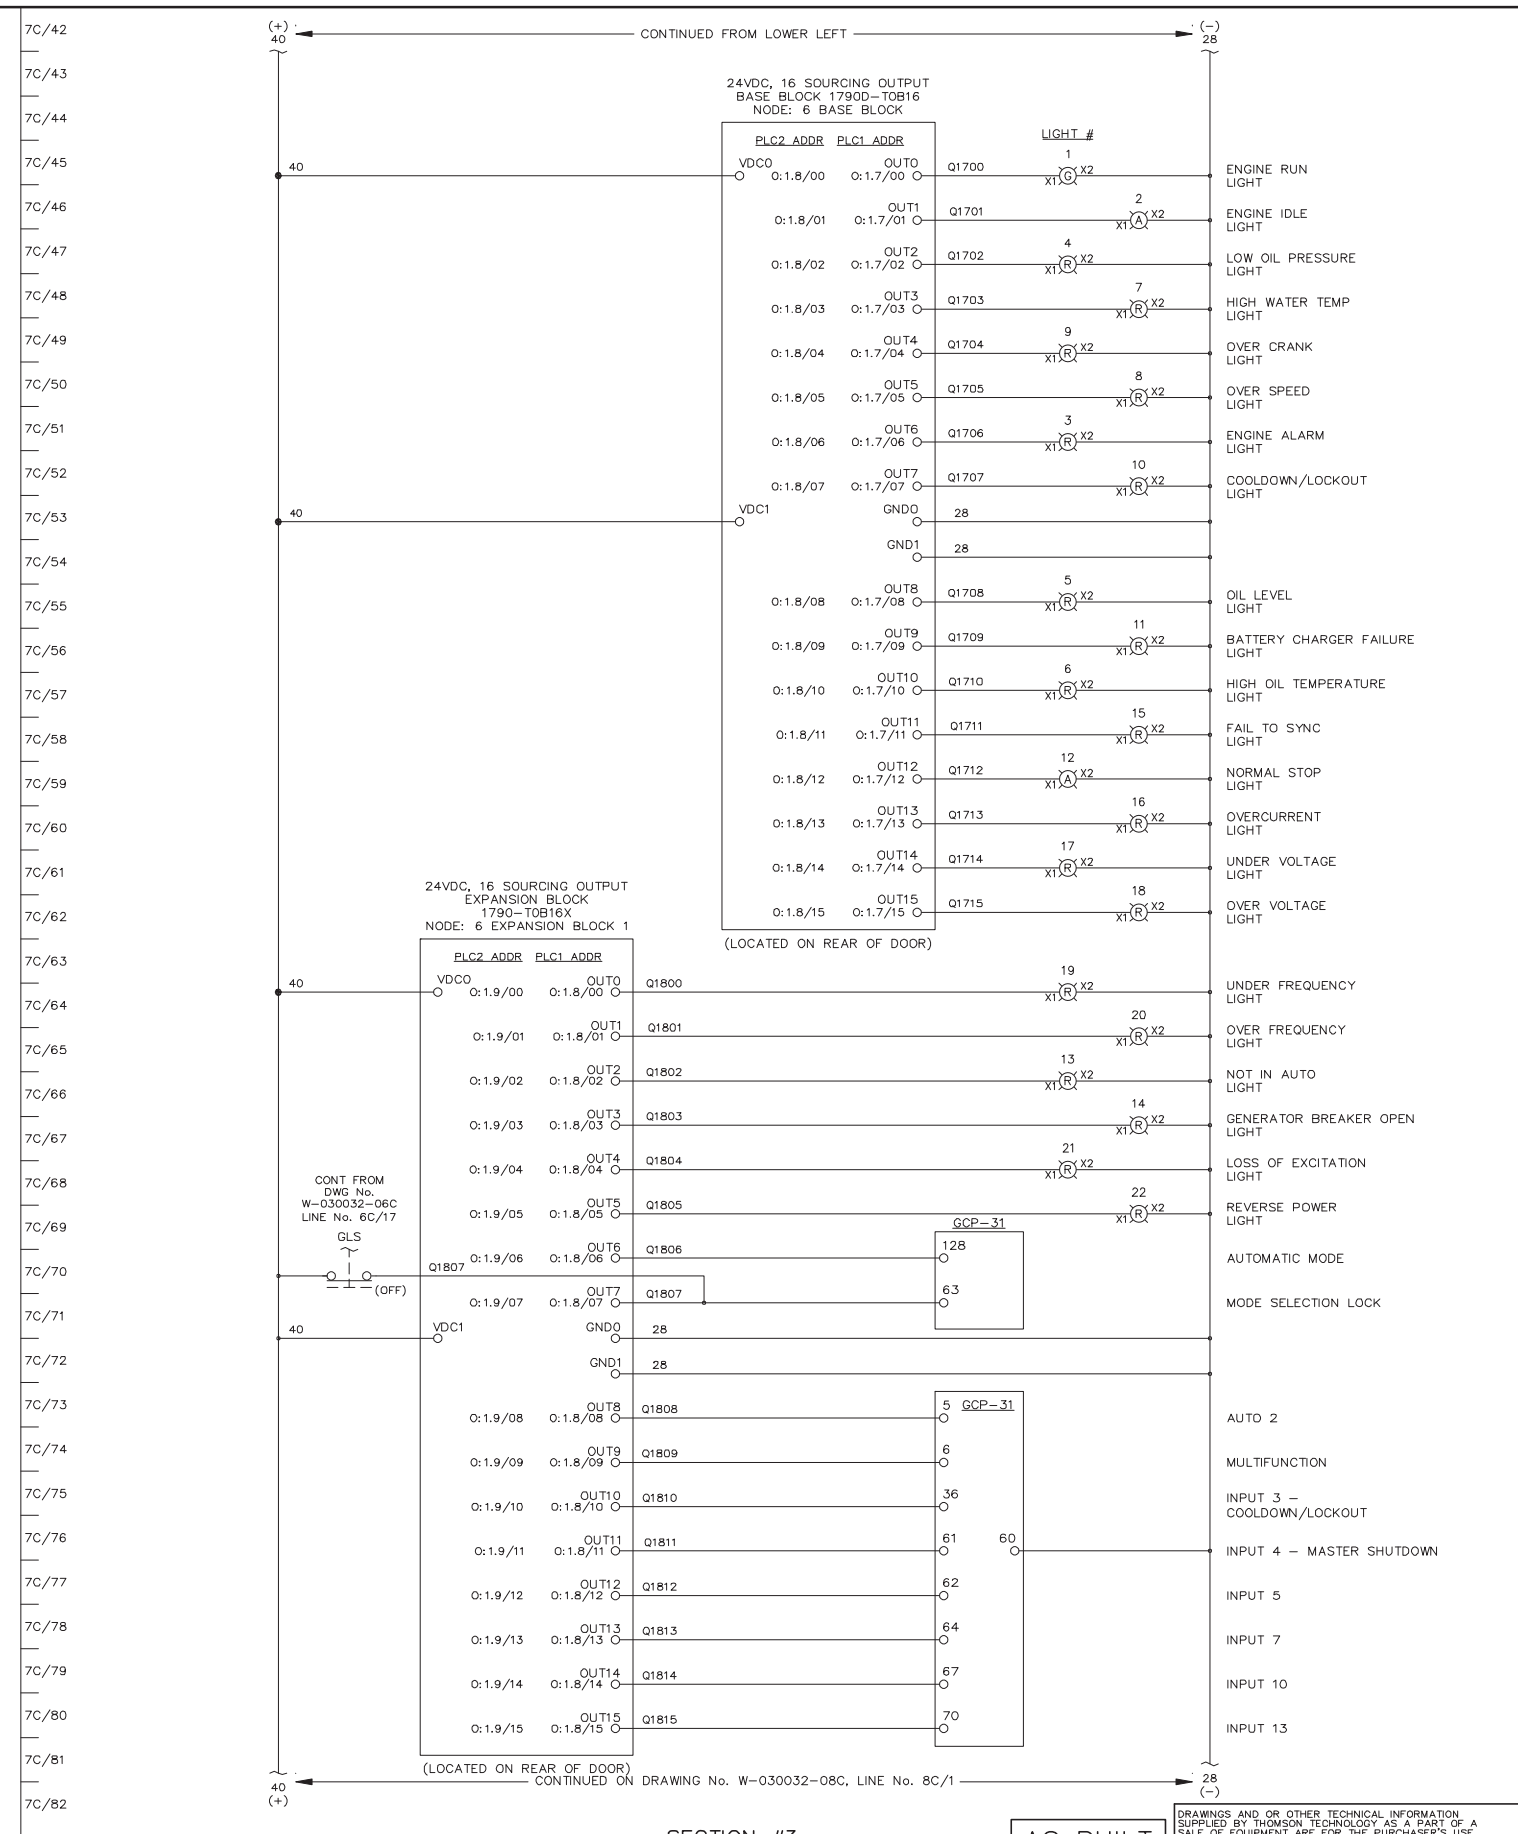
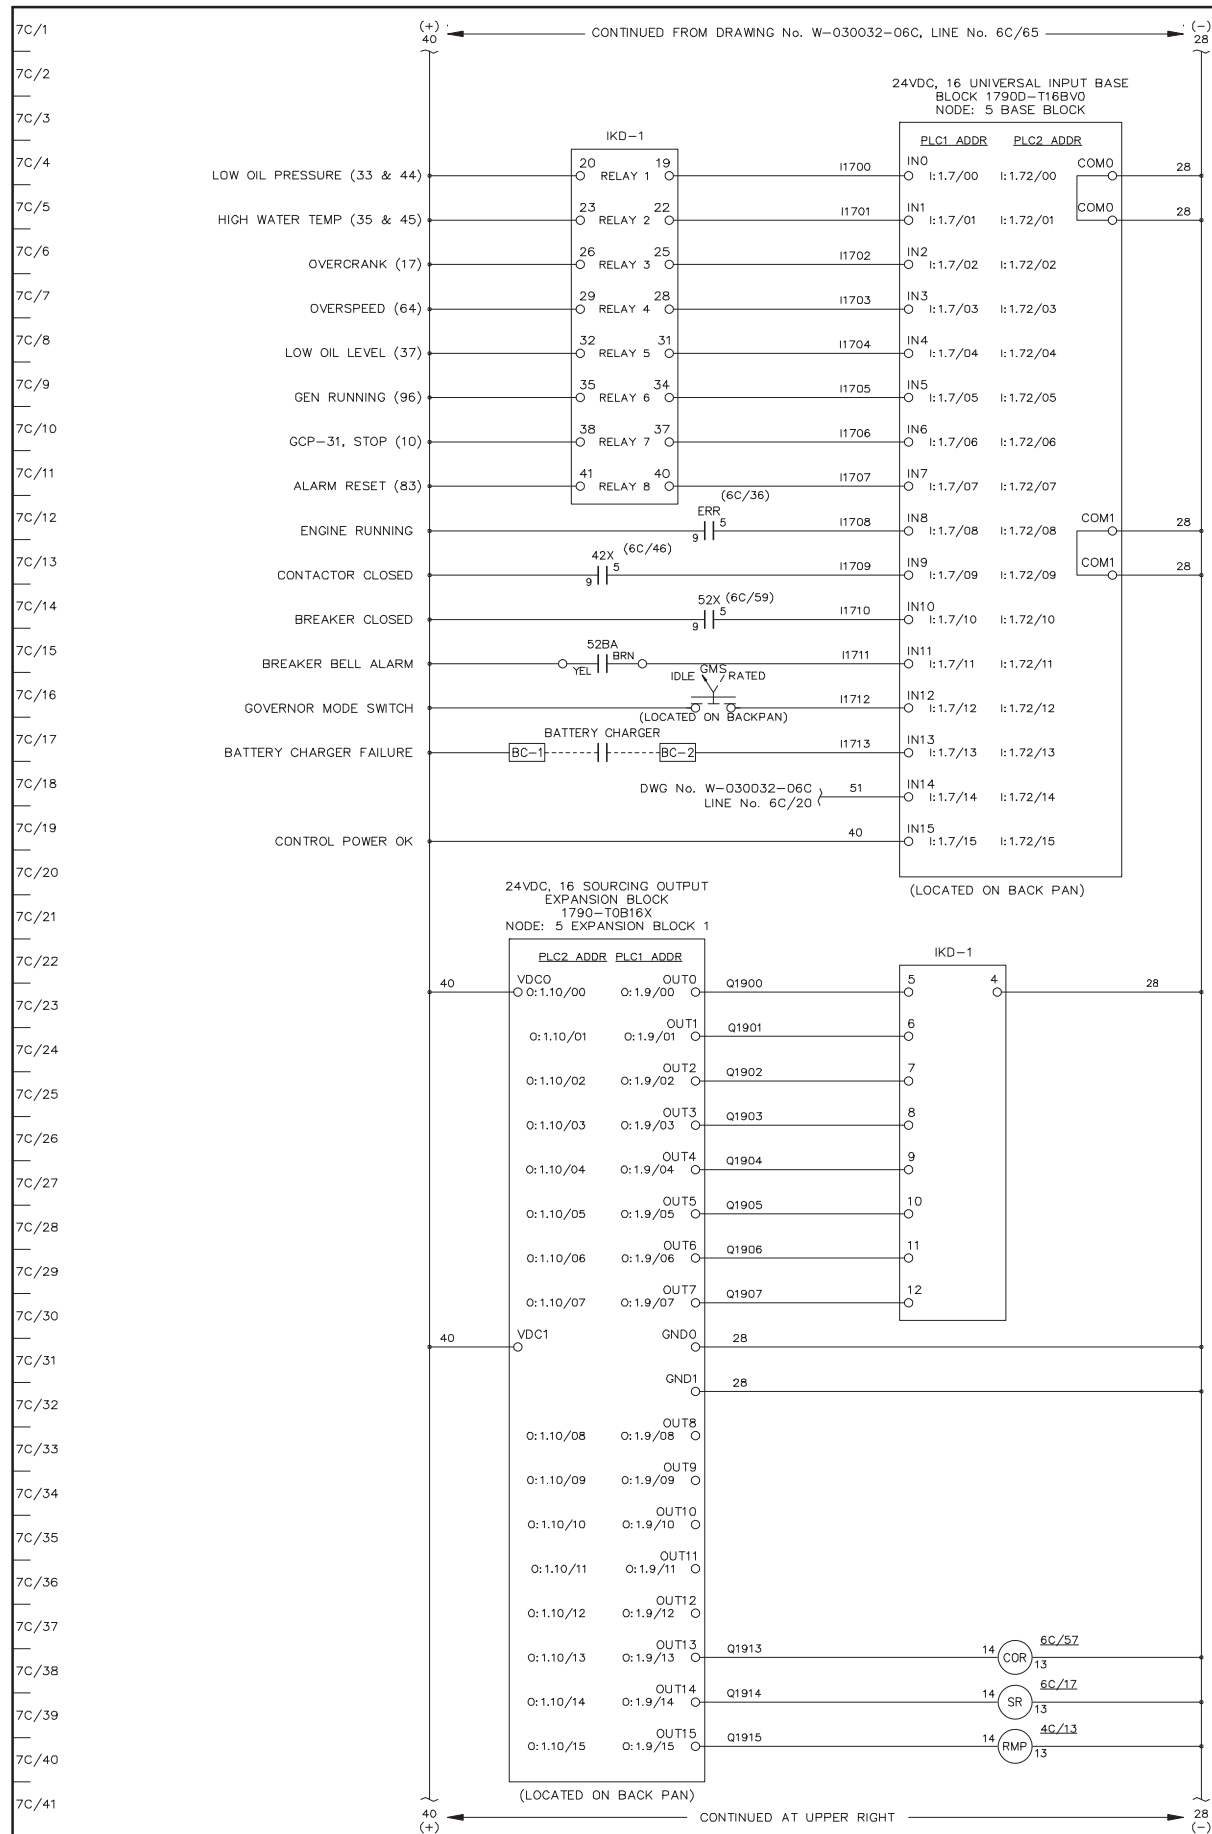


SECTION #3 AS BUILT

<p>REFER TO SHEET #</p> <p><input type="checkbox"/> APPROVED FOR CONSTRUCTION</p> <p><input type="checkbox"/> MASTER COPY <input type="checkbox"/> REFERENCE COPY OF</p> <p><input type="checkbox"/> MULTIPLE UNIT WORK ORDER</p> <p><input type="checkbox"/> RELEASED FOR INFORMATION</p> <p>AUTH. BY: _____ DATE: _____</p>	<table border="1" style="width: 100%; border-collapse: collapse;"> <tr> <td style="width: 50%;">DRAWING No.</td> <td style="width: 50%;">REFERENCE DRAWINGS</td> </tr> <tr> <td>2</td> <td>AS BUILT</td> </tr> <tr> <td>1</td> <td>APPROVAL MOD'S</td> </tr> </table>	DRAWING No.	REFERENCE DRAWINGS	2	AS BUILT	1	APPROVAL MOD'S	<table border="1" style="width: 100%; border-collapse: collapse;"> <tr> <td style="width: 50%;">BY</td> <td style="width: 50%;">AUTH</td> </tr> <tr> <td>BM</td> <td>RH</td> </tr> <tr> <td>BM</td> <td>RH</td> </tr> </table>	BY	AUTH	BM	RH	BM	RH	<table border="1" style="width: 100%; border-collapse: collapse;"> <tr> <td style="width: 50%;">DATE</td> <td style="width: 50%;">DATE</td> </tr> <tr> <td>05-05-06</td> <td>05-03-16</td> </tr> </table>	DATE	DATE	05-05-06	05-03-16	<p style="text-align: center;">THOMSON TECHNOLOGY POWER & CONTROL</p> <p style="text-align: center;">GENERATOR CONTROL PANEL MODEL GCS 2200 GENERATOR 3 DC CONTROL SCHEMATIC MIDDLE KUSKOKWIM REGIONAL ENERGY - TAKOTNA</p>	<p>CUSTOMER ALASKA ENERGY AUTHORITY</p> <table border="1" style="width: 100%; border-collapse: collapse;"> <tr> <td style="width: 50%;">CUSTOMER ORDER No. C-022623</td> <td style="width: 50%;">WORK ORDER No. W-030032</td> </tr> <tr> <td style="width: 50%;">DRAWN BY LR</td> <td style="width: 50%;">DATE 05-03-03</td> </tr> <tr> <td style="width: 50%;">AUTH BY RH</td> <td style="width: 50%;">REV 2</td> </tr> <tr> <td colspan="2">DRAWING/FILE No. W-030032-07C</td> </tr> </table> <p style="text-align: center;">SHEET 7C</p>	CUSTOMER ORDER No. C-022623	WORK ORDER No. W-030032	DRAWN BY LR	DATE 05-03-03	AUTH BY RH	REV 2	DRAWING/FILE No. W-030032-07C	
DRAWING No.	REFERENCE DRAWINGS																												
2	AS BUILT																												
1	APPROVAL MOD'S																												
BY	AUTH																												
BM	RH																												
BM	RH																												
DATE	DATE																												
05-05-06	05-03-16																												
CUSTOMER ORDER No. C-022623	WORK ORDER No. W-030032																												
DRAWN BY LR	DATE 05-03-03																												
AUTH BY RH	REV 2																												
DRAWING/FILE No. W-030032-07C																													

DRAWINGS AND/OR OTHER TECHNICAL INFORMATION SUPPLIED BY THOMSON TECHNOLOGY AS A PART OF A SALE OF EQUIPMENT ARE FOR THE PURCHASER'S USE SOLELY IN CONJUNCTION WITH THAT EQUIPMENT, UNLESS SPECIFICALLY AGREED TO OTHERWISE AS A PART OF THE TERMS OF SALE.

© THE INFORMATION ON THIS DRAWING IS THE PROPERTY OF THOMSON TECHNOLOGY. IT IS NOT TO BE USED DETRIMENTALLY TO OUR INTERESTS.

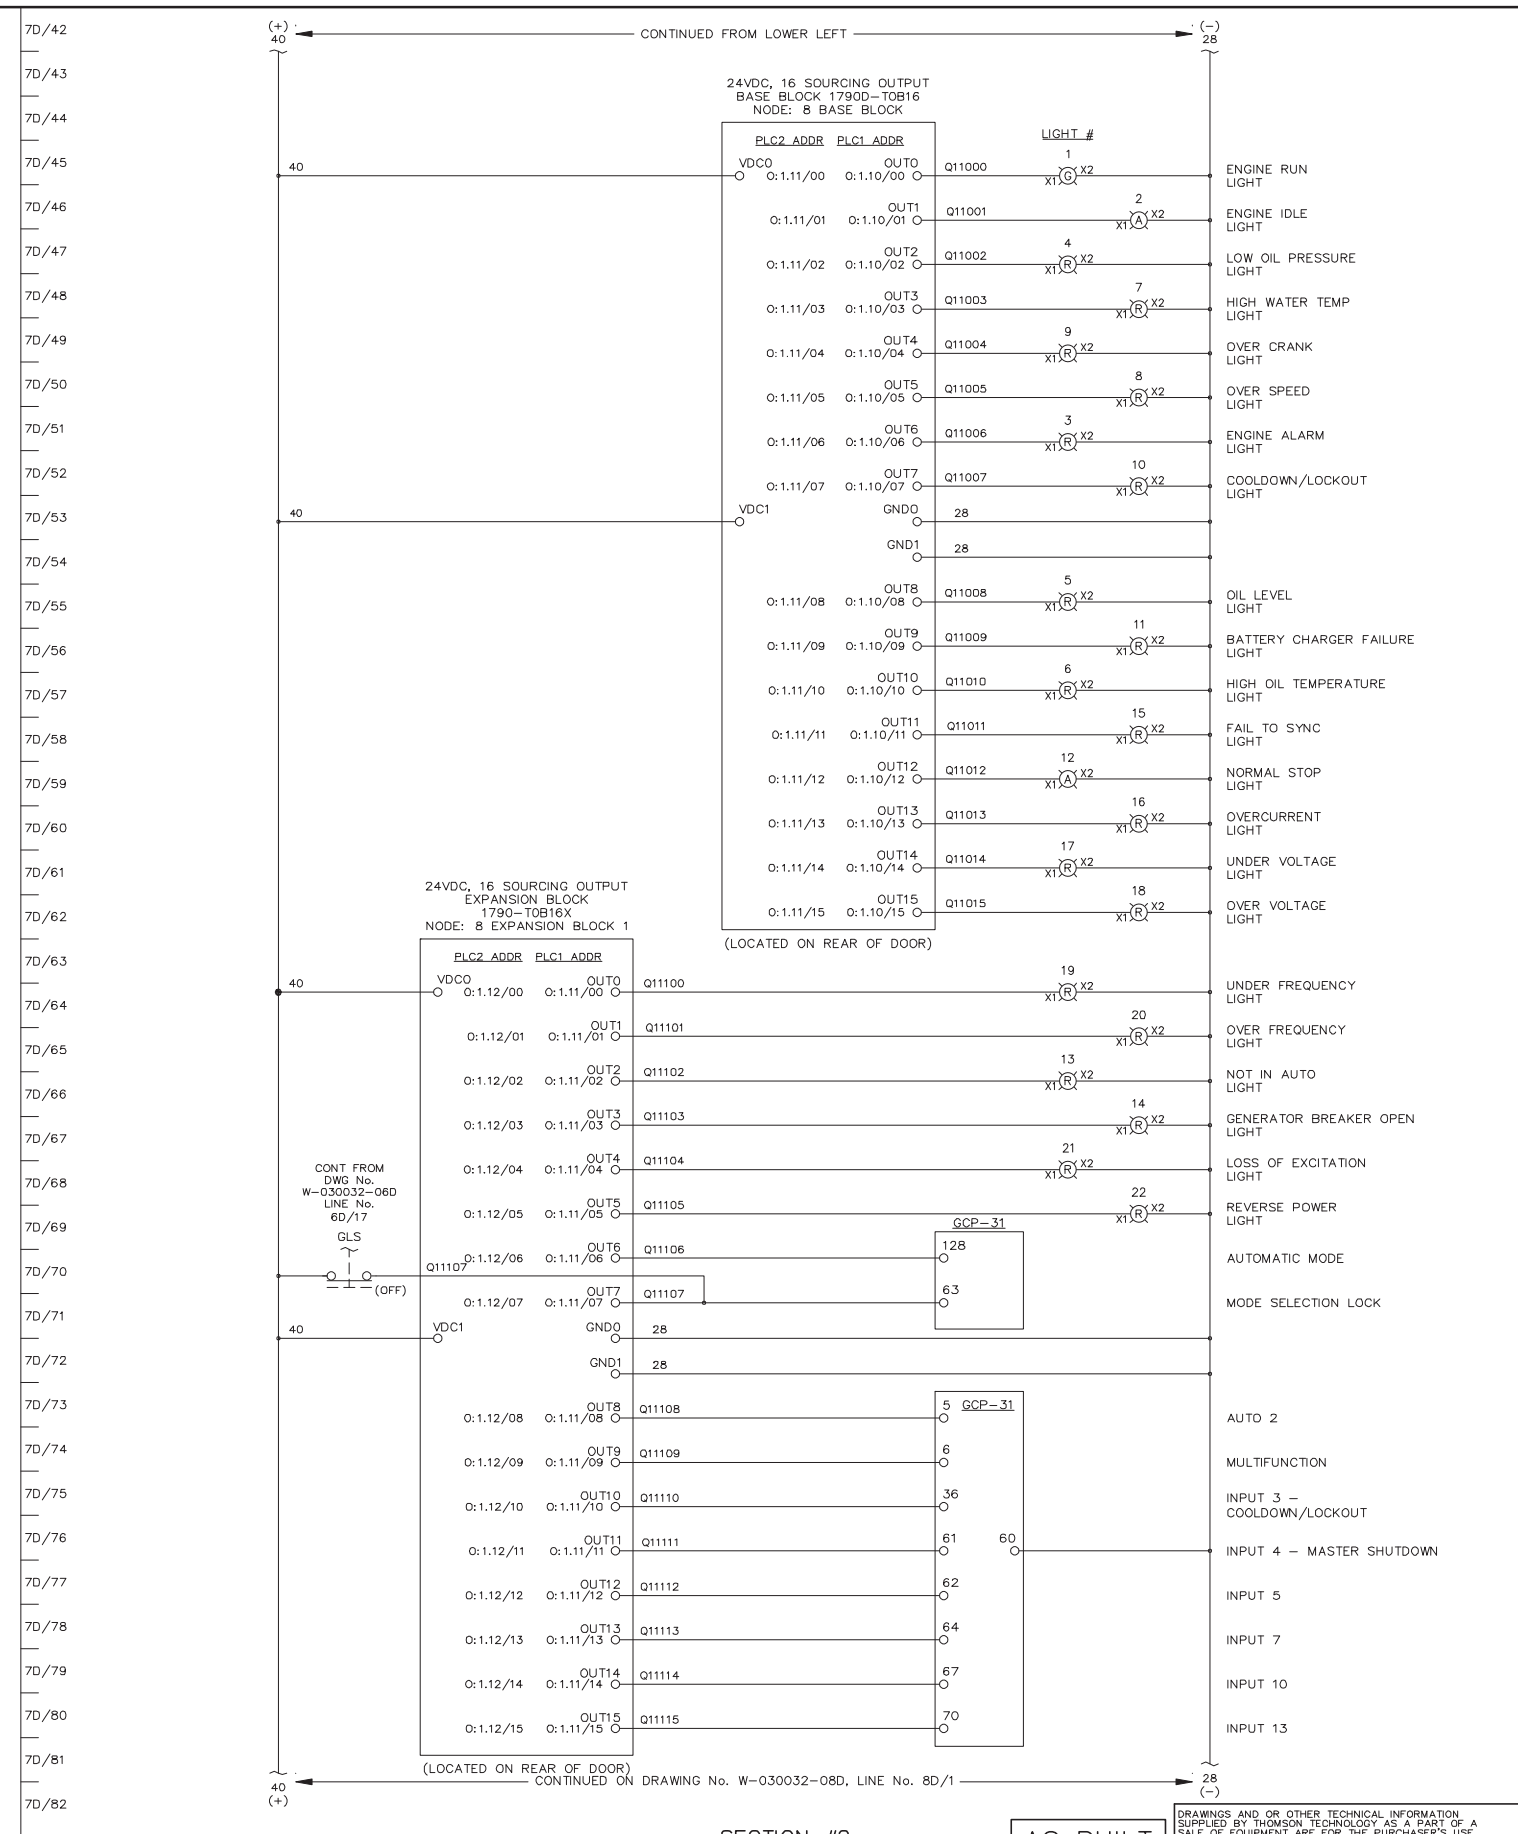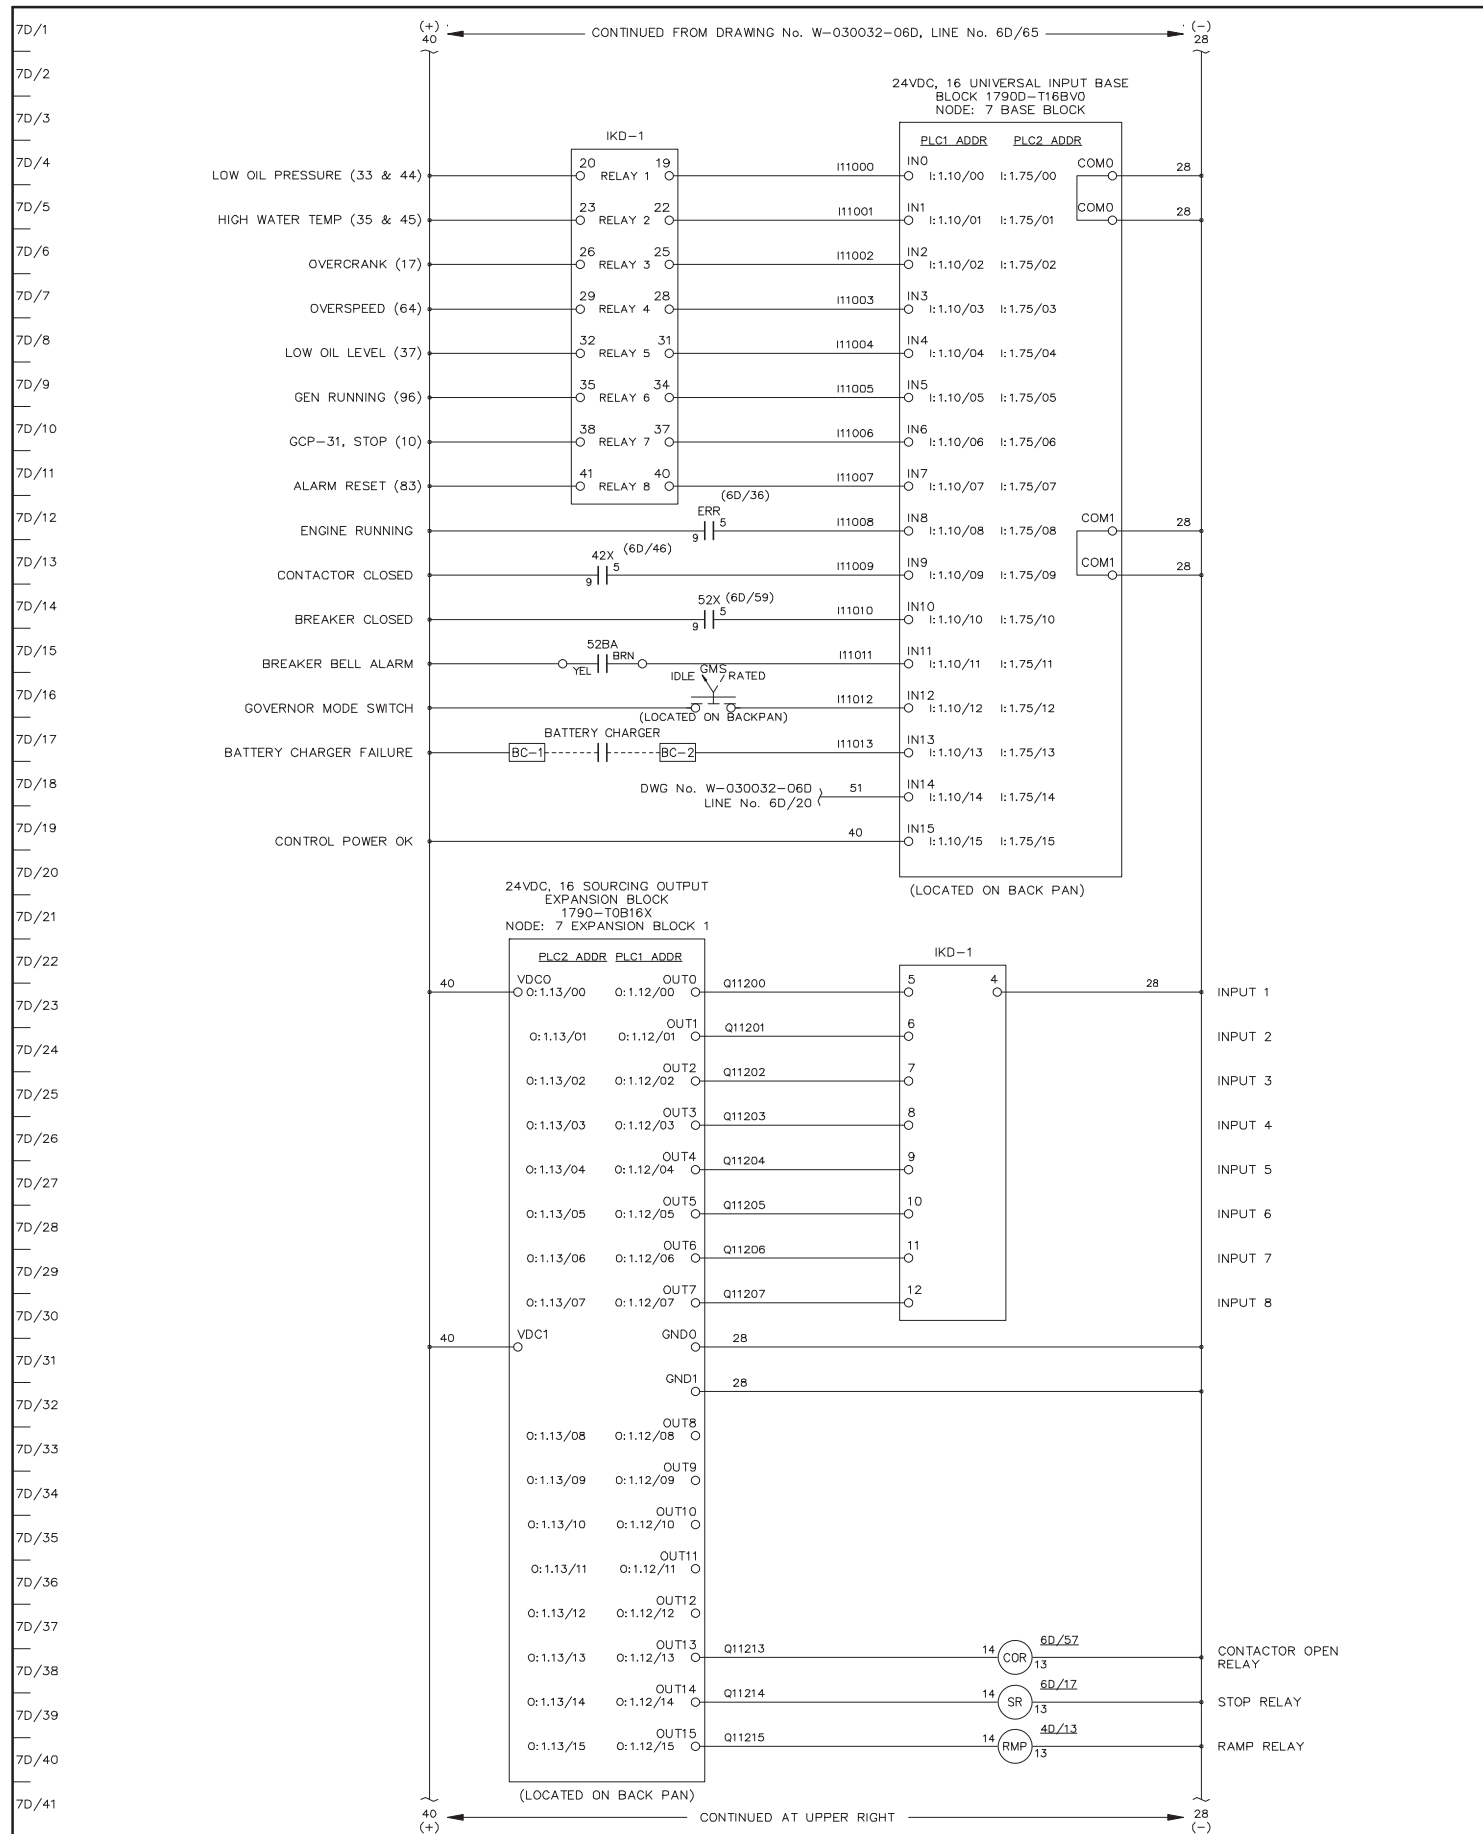

REFER TO SHEET #

APPROVED FOR CONSTRUCTION
 MASTER COPY REFERENCE COPY OF
 MULTIPLE UNIT WORK ORDER
 RELEASED FOR INFORMATION
 AUTH. BY: _____ DATE: _____

DRAWING No.	REFERENCE DRAWINGS	No.	REVISIONS	BY	AUTH	DATE
		2	AS BUILT	BM	RH	05-05-06
		1	APPROVAL MOD'S	BM	RH	05-03-16

THOMSON TECHNOLOGY
POWER & CONTROL


SECTION #2 **AS BUILT**

GENERATOR CONTROL PANEL
MODEL GCS 2200
GENERATOR 4 DC CONTROL SCHEMATIC
 MIDDLE KUSKOKWIM REGIONAL ENERGY - TAKOTNA

CUSTOMER ALASKA ENERGY AUTHORITY			
CUSTOMER ORDER No. C-022623	WORK ORDER No. W-030032		
DRAWN BY LR	AUTH BY RH	DATE 05-03-03	REV 2
DRAWING/FILE No. W-030032-07D			SHEET 7D

DRAWINGS AND/OR OTHER TECHNICAL INFORMATION SUPPLIED BY THOMSON TECHNOLOGY AS A PART OF A SALE OF EQUIPMENT ARE FOR THE PURCHASER'S USE SOLELY IN CONJUNCTION WITH THAT EQUIPMENT, UNLESS SPECIFICALLY AGREED TO OTHERWISE AS A PART OF THE TERMS OF SALE.

© THE INFORMATION ON THIS DRAWING IS THE PROPERTY OF THOMSON TECHNOLOGY. IT IS NOT TO BE USED DETRIMENTALLY TO OUR INTERESTS.

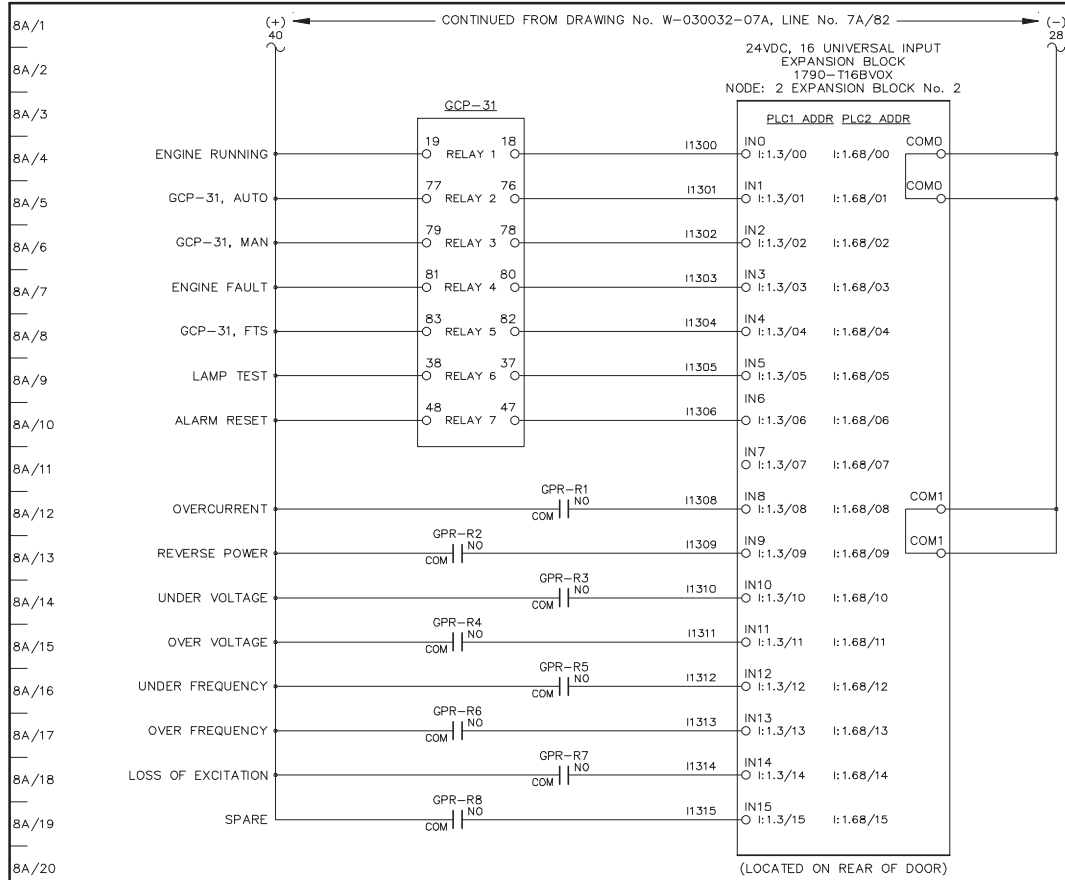

8A/1
8A/2
8A/3
8A/41

SECTION #5

REFER TO SHEET #

AS BUILT

DRAWINGS AND/OR OTHER TECHNICAL INFORMATION SUPPLIED BY THOMSON TECHNOLOGY AS A PART OF A SALE OF EQUIPMENT ARE FOR THE PURCHASER'S USE SOLELY IN CONJUNCTION WITH THAT EQUIPMENT, UNLESS SPECIFICALLY AGREED TO OTHERWISE AS A PART OF THE TERMS OF SALE.


APPROVED FOR CONSTRUCTION
 MASTER COPY REFERENCE COPY OF _____
 MULTIPLE UNIT WORK ORDER
 RELEASED FOR INFORMATION
 AUTH. BY: _____ DATE: _____

DRAWING No.	REFERENCE DRAWINGS	No.	AS BUILT	REVISIONS	BY	AUTH	DATE
		1	AS BUILT		BM	RH	05-05-06



GENERATOR CONTROL PANEL
 MODEL GCS 2200
 GENERATOR 1 DC CONTROL SCHEMATIC
 MIDDLE KUSKOKWIM REGIONAL ENERGY - TAKOTNA

CUSTOMER ALASKA ENERGY AUTHORITY			
CUSTOMER ORDER No. C-022623	WORK ORDER No. W-030032		
DRAWN BY LR	AUTH BY RH	DATE 05-03-03	REV 1
DRAWING/FILE No. W-030032-08A			SHEET 8A

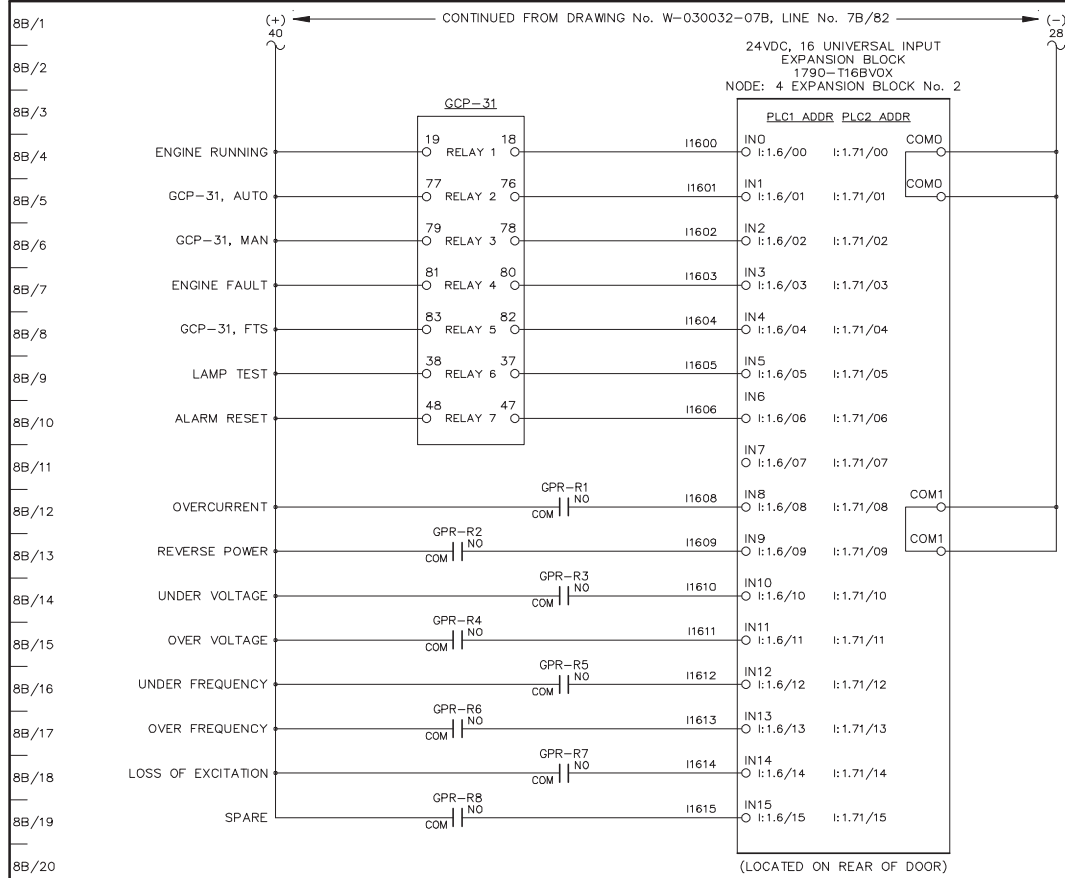

SECTION #4

REFER TO SHEET #

APPROVED FOR CONSTRUCTION
 MASTER COPY REFERENCE COPY OF _____
 MULTIPLE UNIT WORK ORDER
 RELEASED FOR INFORMATION
 AUTH. BY: _____ DATE: _____

DRAWING No.	REFERENCE DRAWINGS	No.	AS BUILT	REVISIONS	BY	AUTH	DATE
		1	AS BUILT		BM	RH	05-05-06




GENERATOR CONTROL PANEL
 MODEL GCS 2200
 GENERATOR 2 DC CONTROL SCHEMATIC
 MIDDLE KUSKOKWIM REGIONAL ENERGY - TAKOTNA

AS BUILT

DRAWINGS AND/OR OTHER TECHNICAL INFORMATION SUPPLIED BY THOMSON TECHNOLOGY AS A PART OF A SALE OF EQUIPMENT ARE FOR THE PURCHASER'S USE SOLELY IN CONJUNCTION WITH THAT EQUIPMENT, UNLESS SPECIFICALLY AGREED TO OTHERWISE AS A PART OF THE TERMS OF SALE.

CUSTOMER ALASKA ENERGY AUTHORITY			
CUSTOMER ORDER No. C-022623	WORK ORDER No. W-030032		
DRAWN BY LR	AUTH BY RH	DATE 05-03-03	REV 1
DRAWING/FILE No. W-030032-08B			SHEET 8B

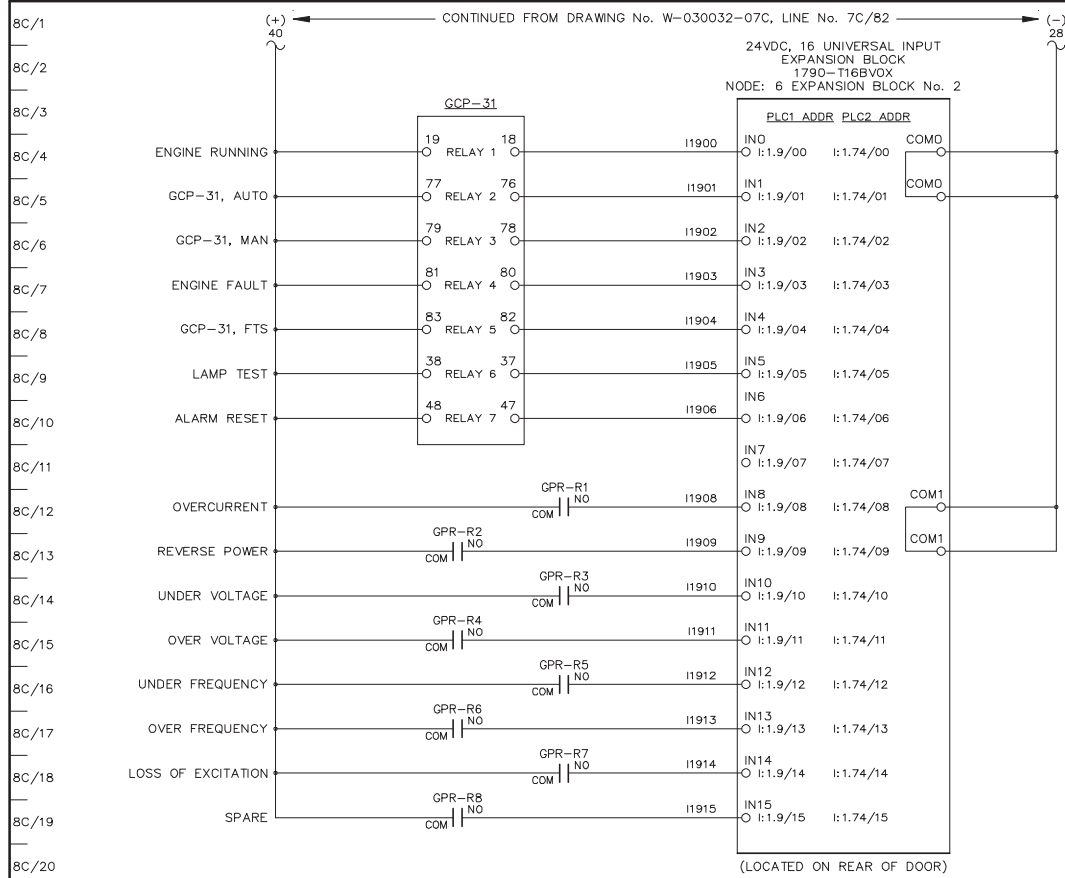

8C/1
8C/2
8C/3
8C/41

SECTION #3

AS BUILT

DRAWINGS AND/OR OTHER TECHNICAL INFORMATION SUPPLIED BY THOMSON TECHNOLOGY AS A PART OF A SALE OF EQUIPMENT ARE FOR THE PURCHASER'S USE SOLELY IN CONJUNCTION WITH THAT EQUIPMENT, UNLESS SPECIFICALLY AGREED TO OTHERWISE AS A PART OF THE TERMS OF SALE.


APPROVED FOR CONSTRUCTION
 MASTER COPY REFERENCE COPY OF _____
 MULTIPLE UNIT WORK ORDER
 RELEASED FOR INFORMATION
 AUTH. BY: _____ DATE: _____

DRAWING No.	REFERENCE DRAWINGS	No.	AS BUILT	REVISIONS	BY	AUTH	DATE
		1	AS BUILT		BM	RH	05-05-06



GENERATOR CONTROL PANEL
 MODEL GCS 2200
 GENERATOR 3 DC CONTROL SCHEMATIC
 MIDDLE KUSKOKWIM REGIONAL ENERGY - TAKOTNA

CUSTOMER ALASKA ENERGY AUTHORITY			
CUSTOMER ORDER No. C-022623	WORK ORDER No. W-030032		
DRAWN BY LR	AUTH BY RH	DATE 05-03-03	REV 1
DRAWING/FILE No. W-030032-08C			SHEET 8C

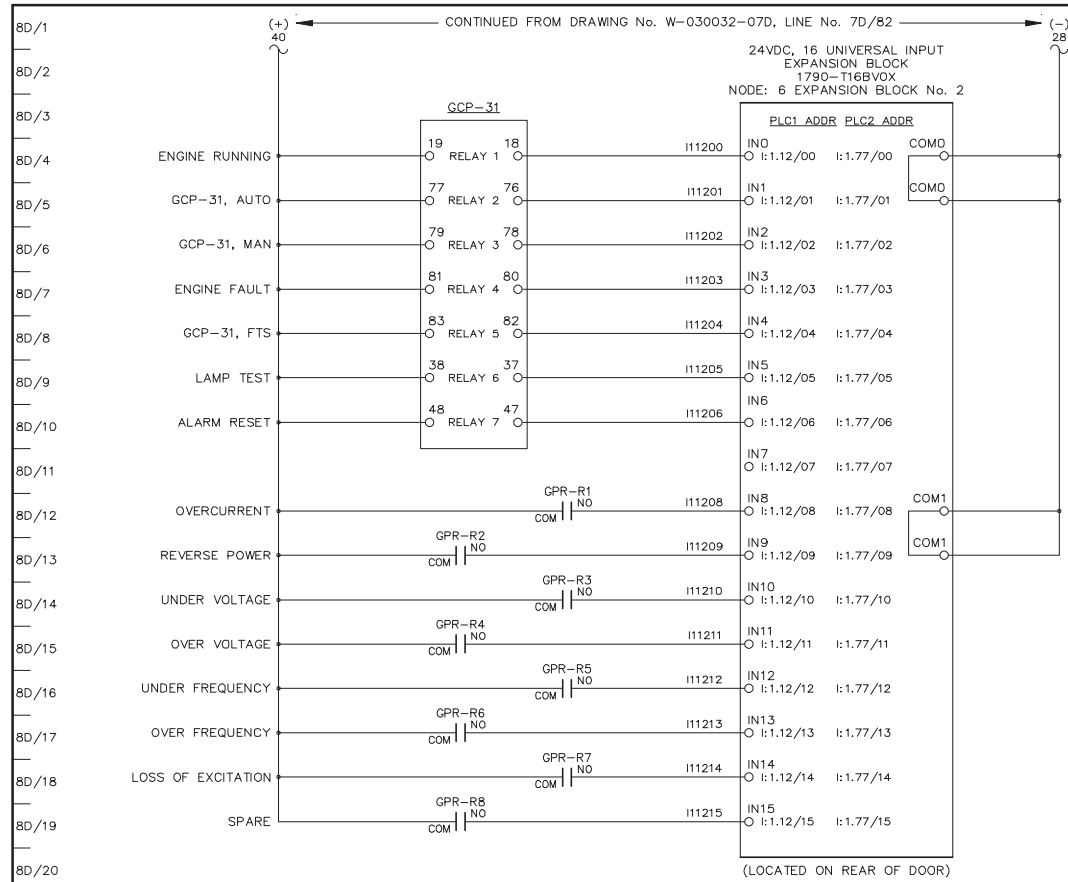

8D/1
8D/2
8D/3
8D/41

SECTION #2

AS BUILT

DRAWINGS AND/OR OTHER TECHNICAL INFORMATION SUPPLIED BY THOMSON TECHNOLOGY AS A PART OF A SALE OF EQUIPMENT ARE FOR THE PURCHASER'S USE SOLELY IN CONJUNCTION WITH THAT EQUIPMENT, UNLESS SPECIFICALLY AGREED TO OTHERWISE AS A PART OF THE TERMS OF SALE.

REFER TO SHEET #

APPROVED FOR CONSTRUCTION
 MASTER COPY REFERENCE COPY OF _____
 MULTIPLE UNIT WORK ORDER
 RELEASED FOR INFORMATION
 AUTH. BY: _____ DATE: _____


DRAWING No.	REFERENCE DRAWINGS	No.	AS BUILT	REVISIONS	BY	AUTH	DATE
		1	AS BUILT		BM	RH	05-05-06




GENERATOR CONTROL PANEL
 MODEL GCS 2200
 GENERATOR 4 DC CONTROL SCHEMATIC
 MIDDLE KUSKOKWIM REGIONAL ENERGY - TAKOTNA

CUSTOMER ALASKA ENERGY AUTHORITY			
CUSTOMER ORDER No. C-022623	WORK ORDER No. W-030032		
DRAWN BY LR	AUTH BY RH	DATE 05-03-03	REV 1
DRAWING/FILE No. W-030032-08D			SHEET 8D

9/1
9/2
9/3
9/41

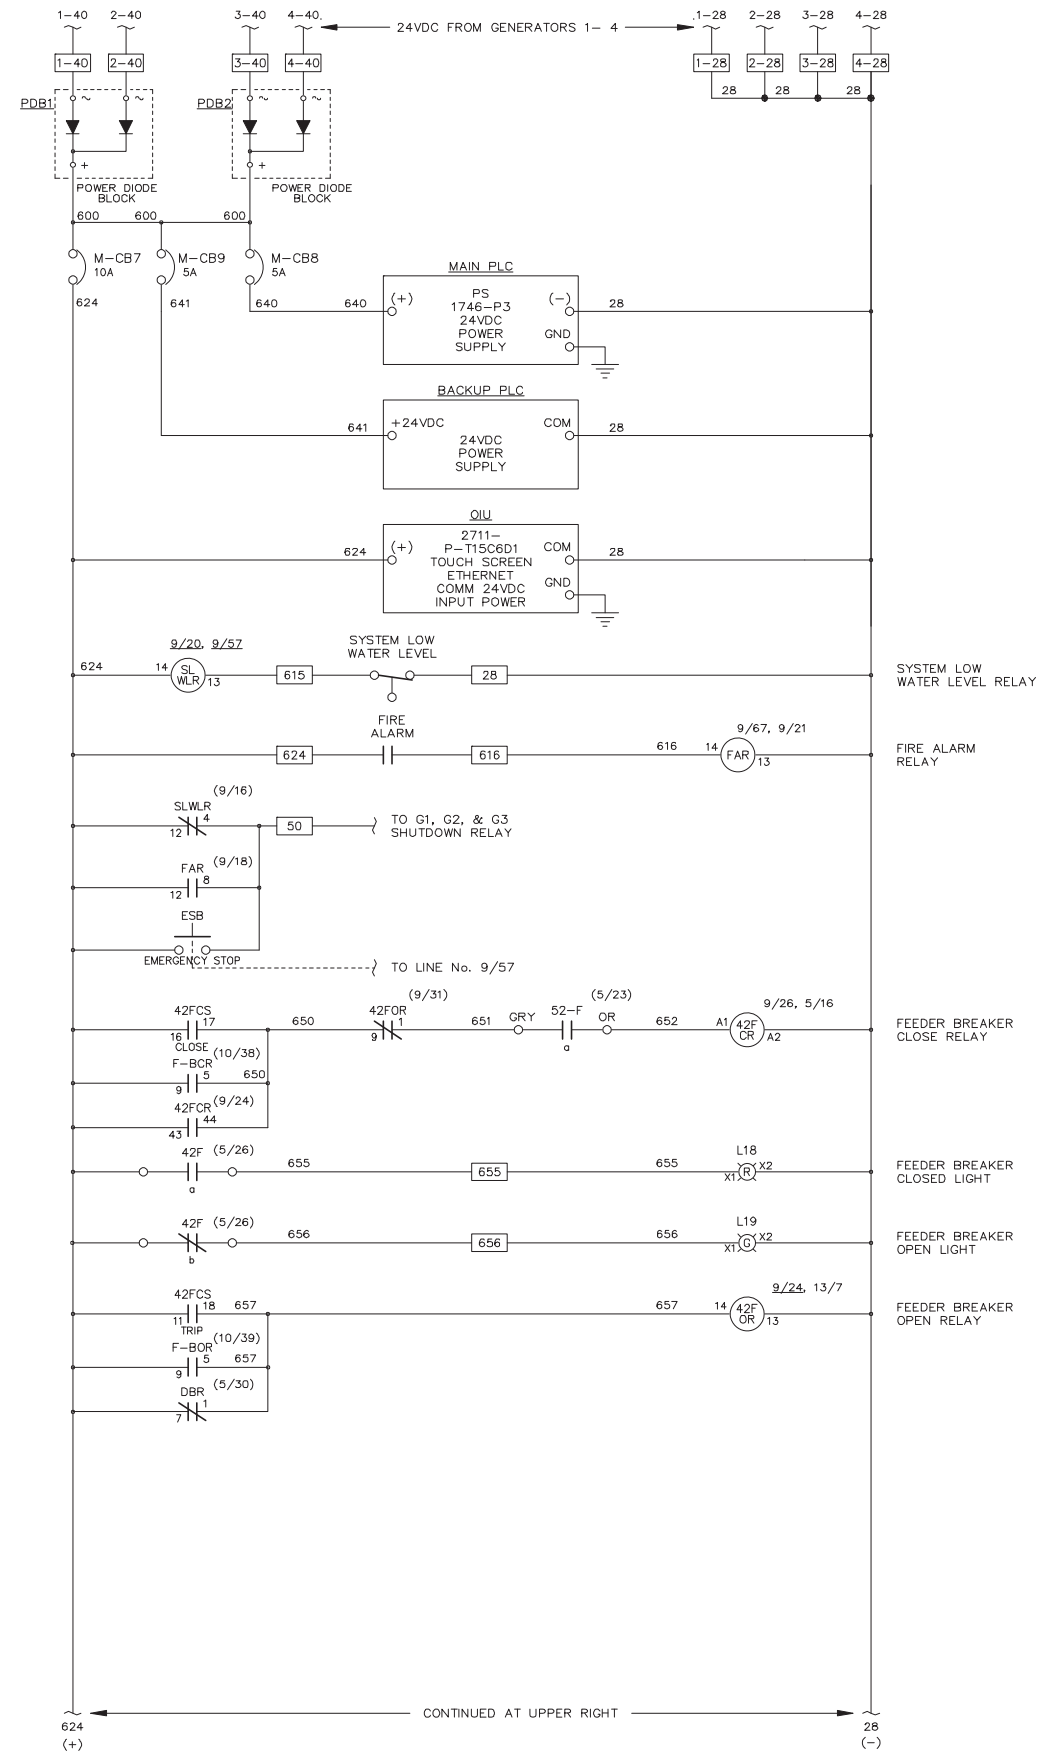

9/42
9/43
9/44
9/82

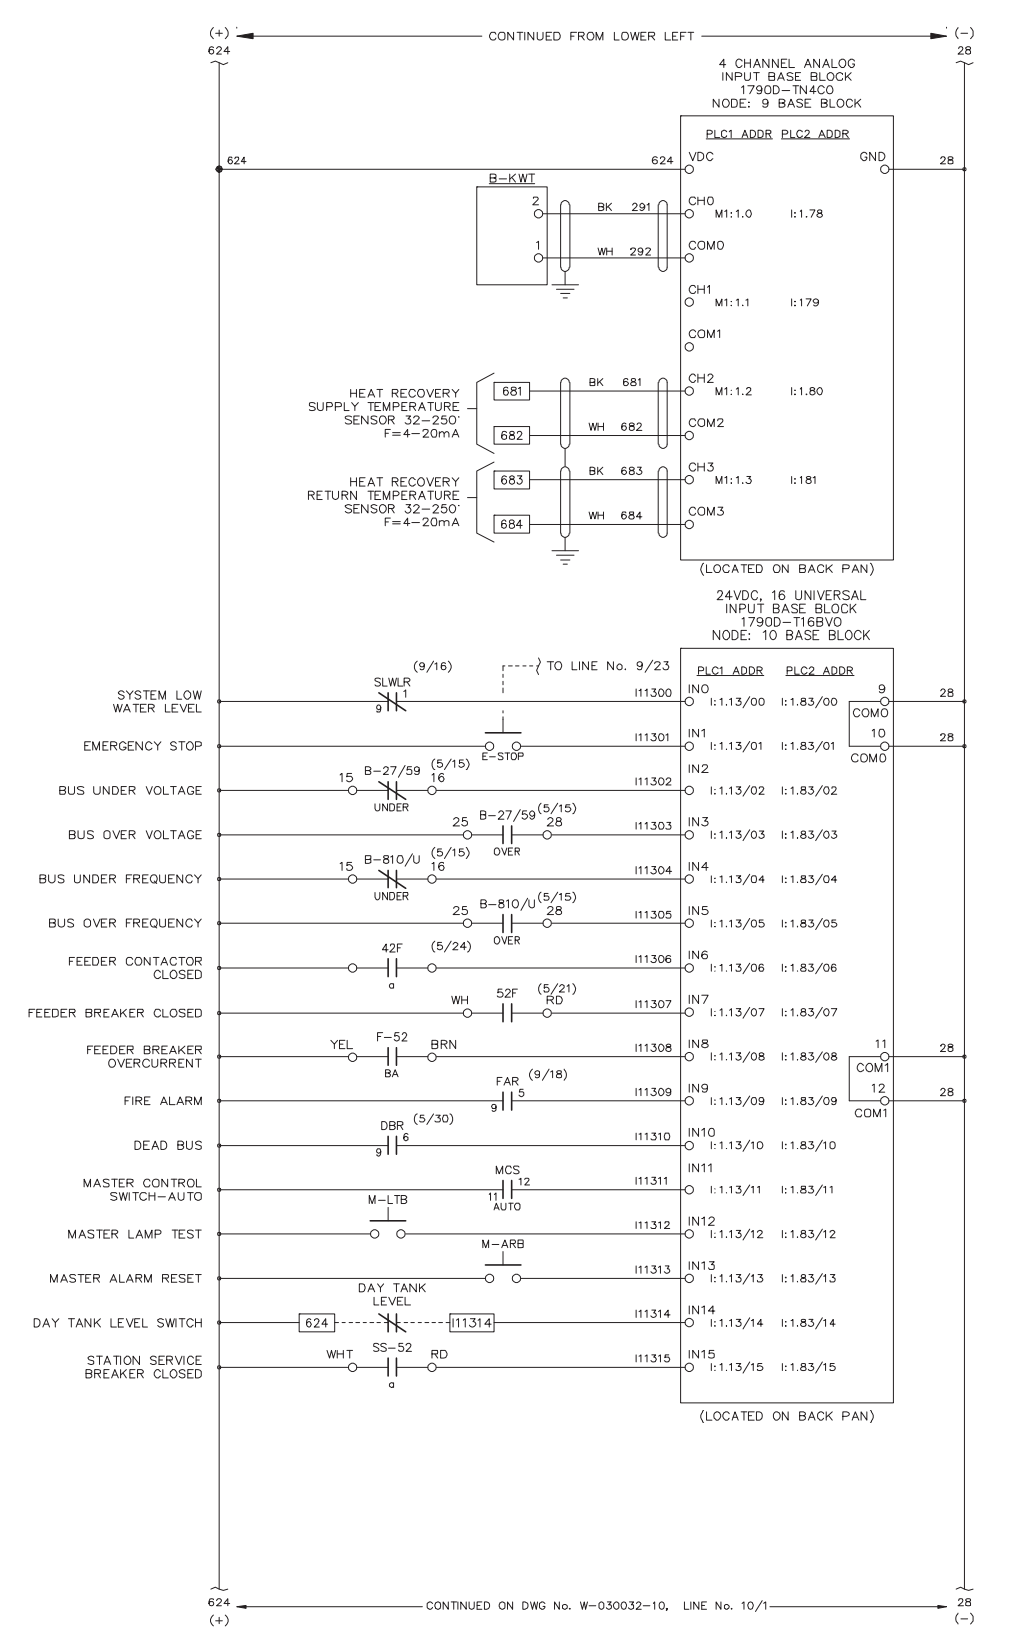

REFER TO SHEET #

APPROVED FOR CONSTRUCTION

MASTER COPY REFERENCE COPY OF

MULTIPLE UNIT WORK ORDER

RELEASED FOR INFORMATION

AUTH. BY: DATE:

DRAWING No.	REFERENCE DRAWINGS	No.	REVISIONS	BY	AUTH	DATE
		2	AS BUILT	BM	RH	05-05-06
		1	APPROVAL MOD'S	BM	RH	05-03-16





SECTION #1

AS BUILT

GENERATOR CONTROL PANEL
MODEL GCS 2200
MASTER DC CONTROL SCHEMATIC
MIDDLE KUSKOKWIM REGIONAL ENERGY - TAKOTNA

CUSTOMER ALASKA ENERGY AUTHORITY			
CUSTOMER ORDER No. C-022623	WORK ORDER No. W-030032		
DRAWN BY LR	AUTH BY RH	DATE 05-03-03	REV 2
DRAWING/FILE No. W-030032-09			SHEET 9

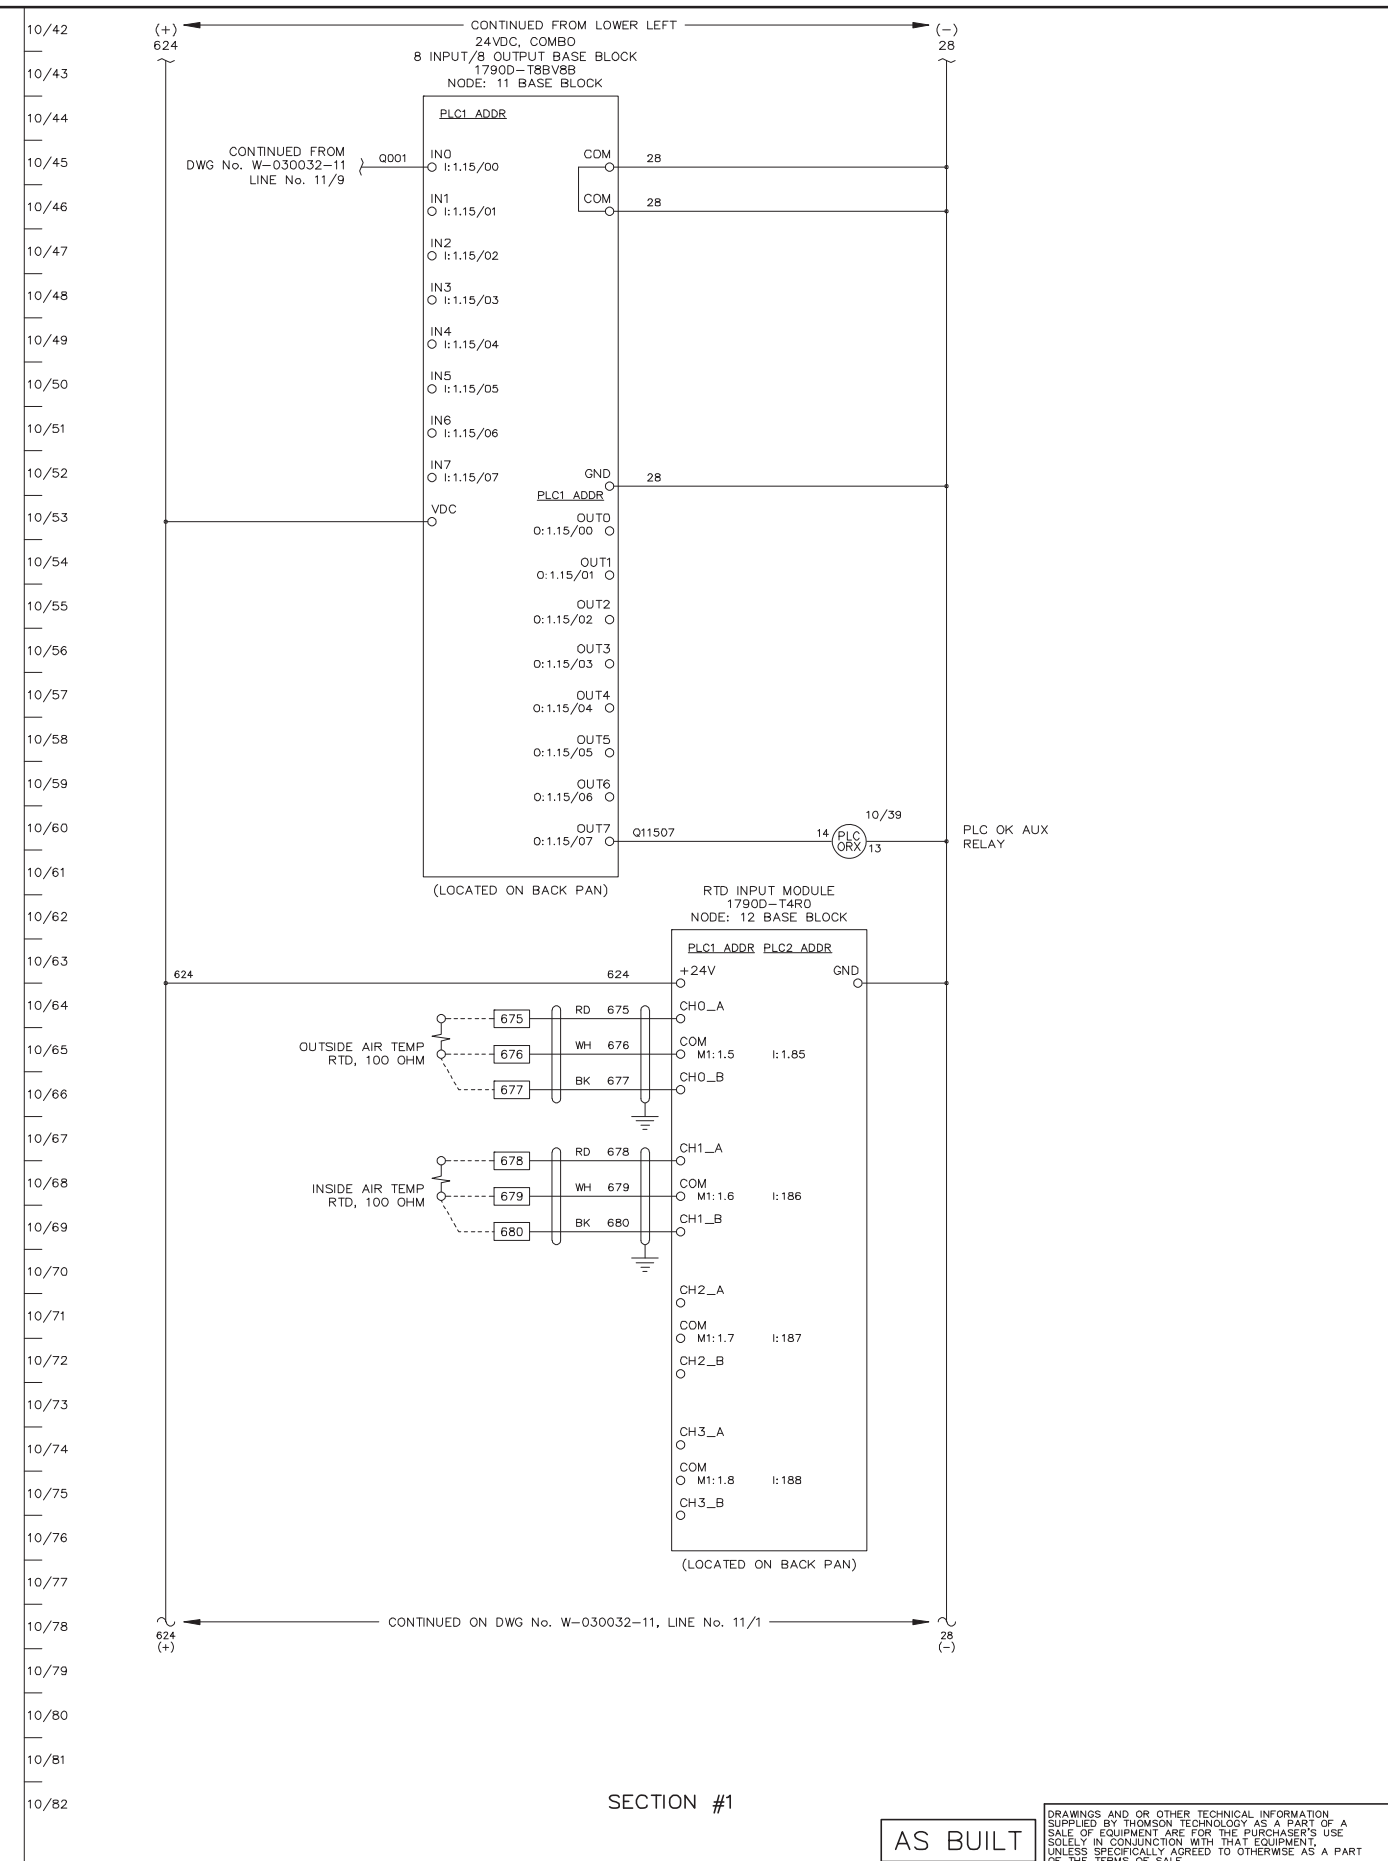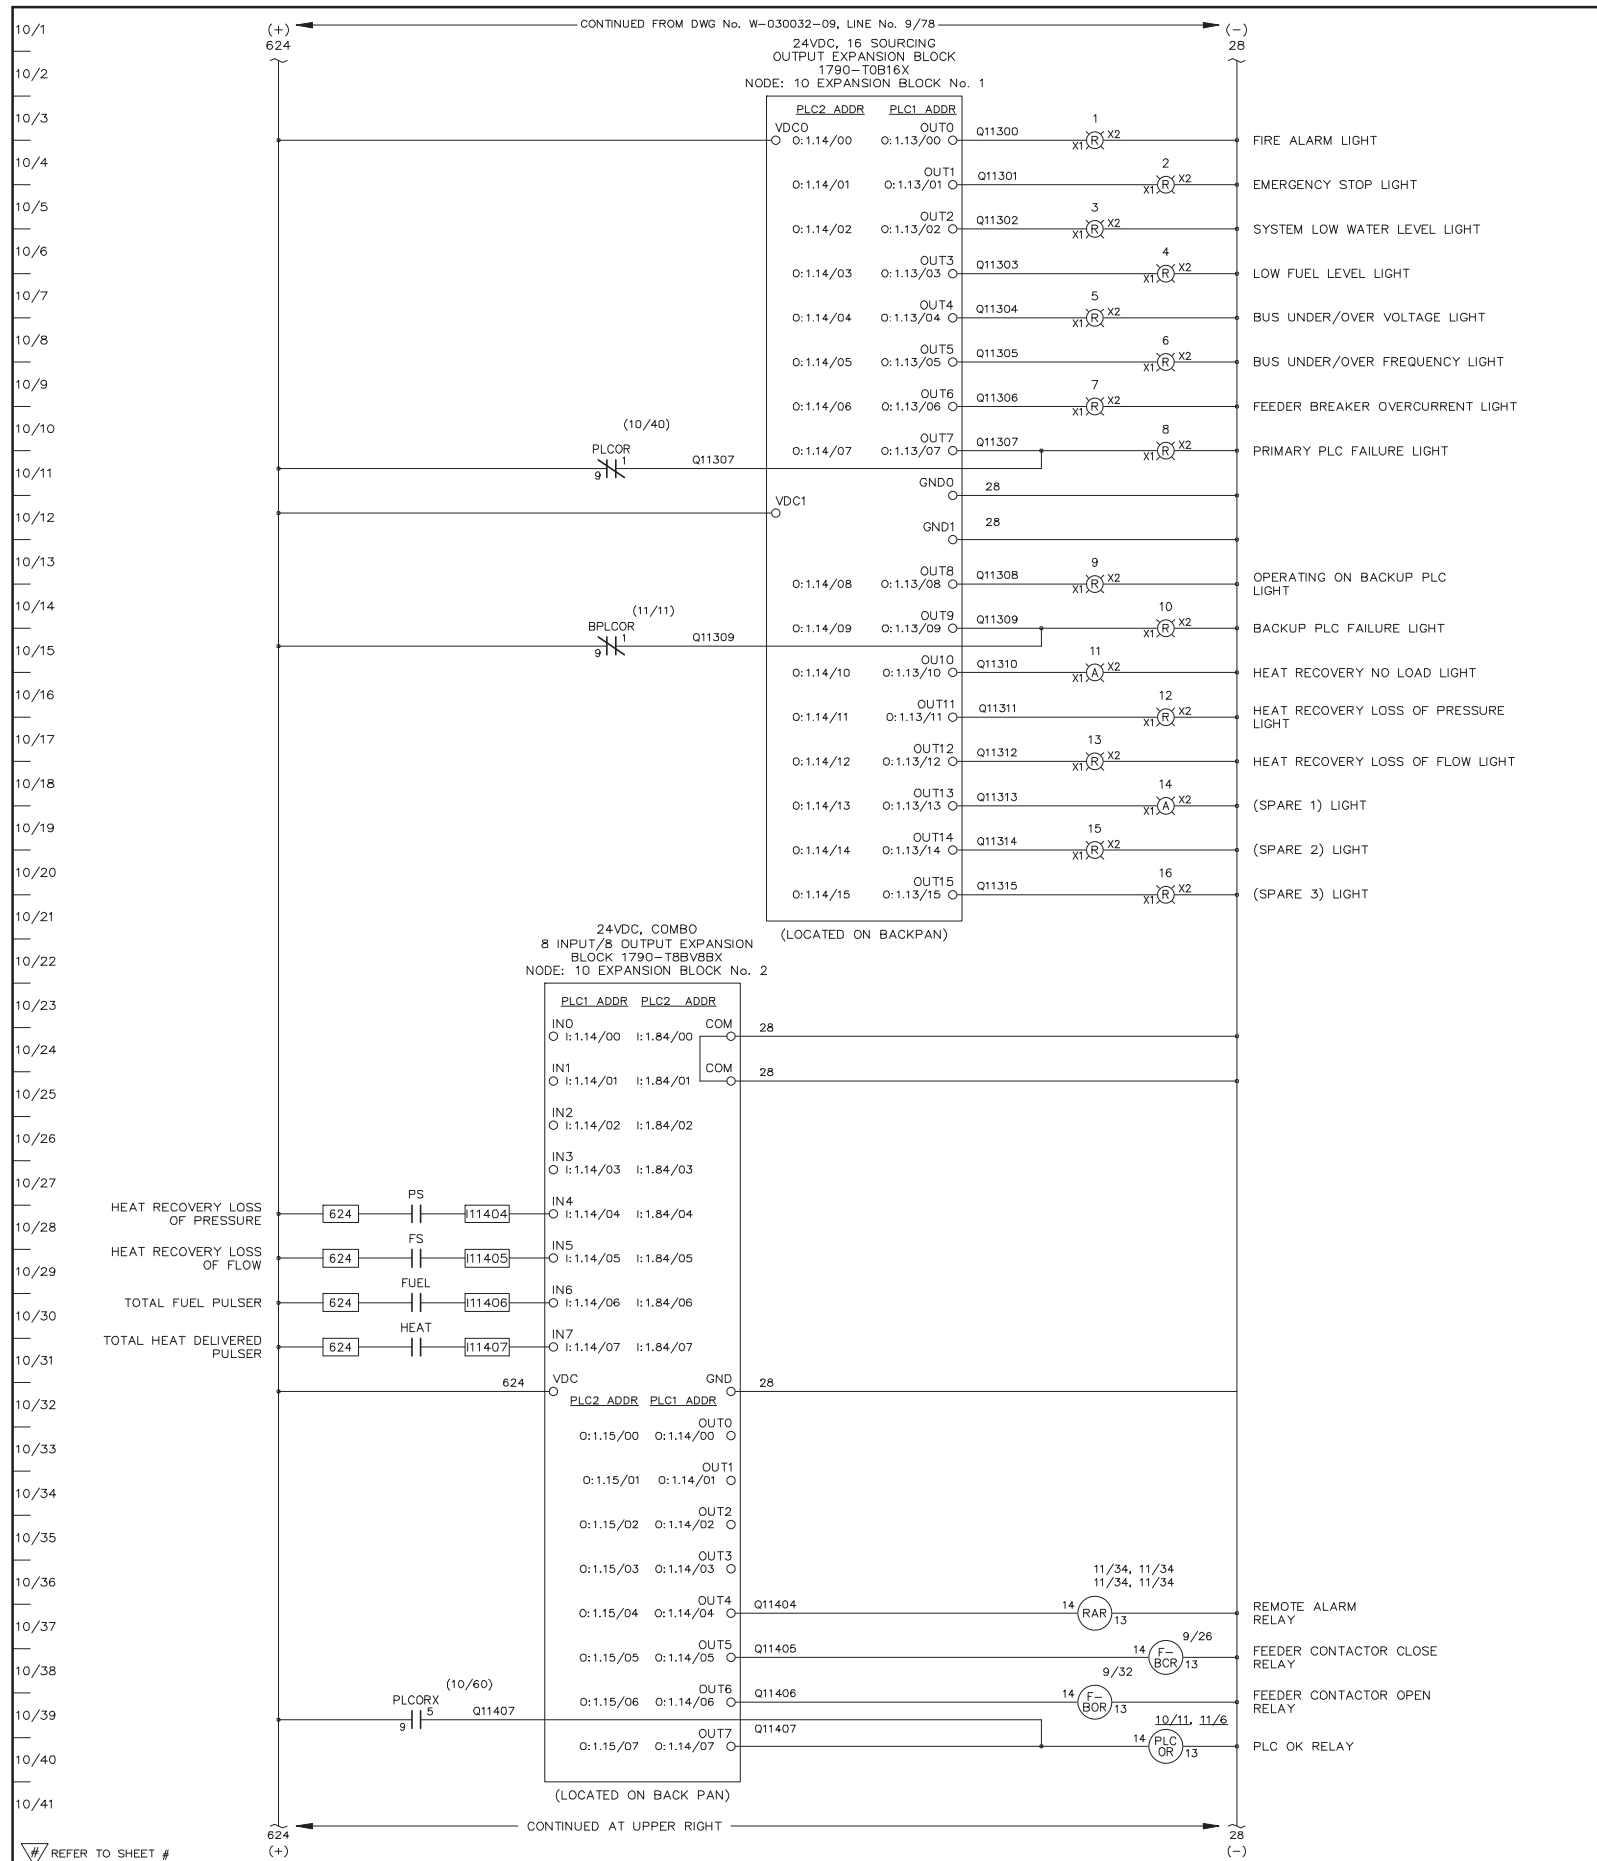

REFER TO SHEET #

APPROVED FOR CONSTRUCTION
 MASTER COPY REFERENCE COPY OF
 MULTIPLE UNIT WORK ORDER
 RELEASED FOR INFORMATION
 AUTH. BY: _____ DATE: _____

DRAWING No.	REFERENCE DRAWINGS	No.	REVISIONS	BY	AUTH	DATE
2	AS BUILT			BM	RH	05-05-06
1	APPROVAL MOD'S			BM	RH	05-03-16

THOMSON TECHNOLOGY
POWER & CONTROL


GENERATOR CONTROL PANEL
MODEL GCS 2200
MASTER DC CONTROL SCHEMATIC
MIDDLE KUSKOKWIM REGIONAL ENERGY - TAKOTNA

SECTION #1


AS BUILT

CUSTOMER ALASKA ENERGY AUTHORITY			
CUSTOMER ORDER No. C-022623	WORK ORDER No. W-030032	DRAWN BY LR	DATE 05-03-03
AUTH BY RH	REV 2	DRAWING/FILE No. W-030032-10	SHEET 10

© THE INFORMATION ON THIS DRAWING IS THE PROPERTY OF THOMSON TECHNOLOGY. IT IS NOT TO BE USED DETRIMENTALLY TO OUR INTERESTS.

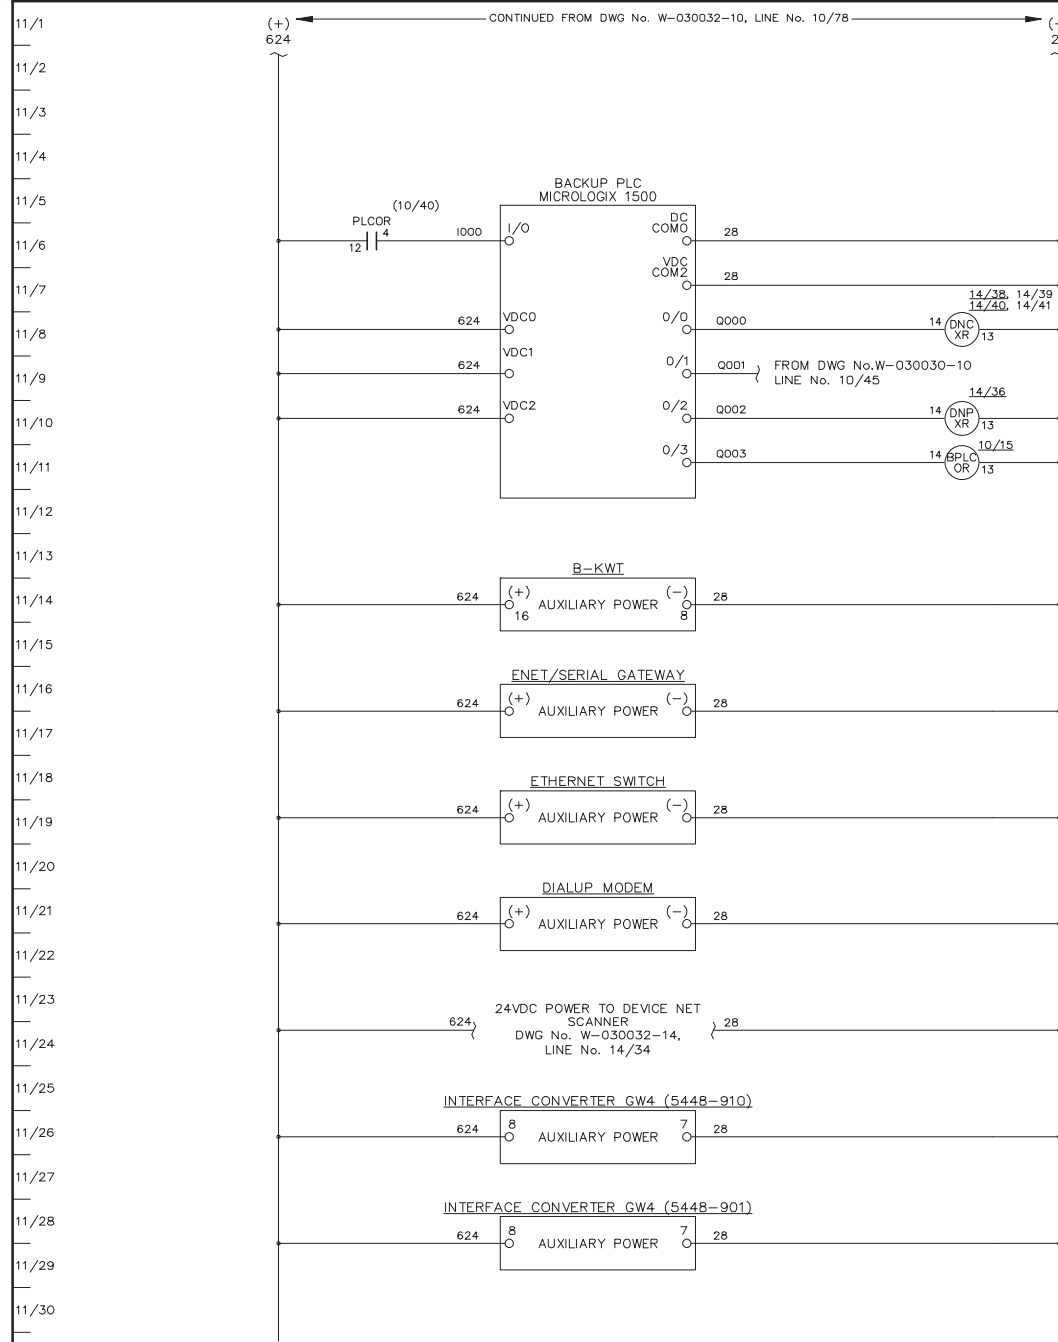

14/38, 14/39, 14/40, 14/41
14/DNC XR /13
14/36
14/DNP XR /13
10/15, 14/PLC OR /13

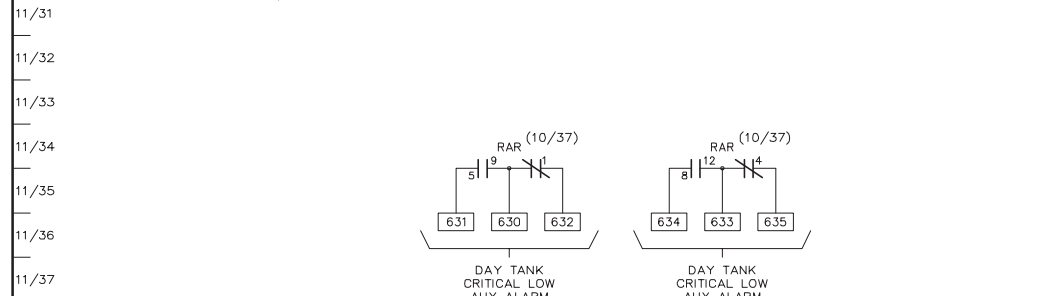

DAY TANK CRITICAL LOW AUX ALARM
DAY TANK CRITICAL LOW AUX ALARM

SECTION #1

AS BUILT

REFER TO SHEET #

APPROVED FOR CONSTRUCTION
 MASTER COPY REFERENCE COPY OF _____
 MULTIPLE UNIT WORK ORDER
 RELEASED FOR INFORMATION
 AUTH. BY: _____ DATE: _____

DRAWING No.	REFERENCE DRAWINGS	No.	AS BUILT	BY	AUTH	DATE
		1	AS BUILT	BM	RH	05-05-06



GENERATOR CONTROL PANEL
 MODEL GCS 2200
 MASTER DC CONTROL SCHEMATIC
 MIDDLE KUSKOKWIM REGIONAL ENERGY - TAKOTNA

DRAWINGS AND/OR OTHER TECHNICAL INFORMATION SUPPLIED BY THOMSON TECHNOLOGY AS A PART OF A SALE OF EQUIPMENT ARE FOR THE PURCHASER'S USE SOLELY IN CONJUNCTION WITH THAT EQUIPMENT, UNLESS SPECIFICALLY AGREED TO OTHERWISE AS A PART OF THE TERMS OF SALE.

CUSTOMER ALASKA ENERGY AUTHORITY			
CUSTOMER ORDER No. C-022623	WORK ORDER No. W-030032		
DRAWN BY LR	AUTH BY RH	DATE 05-003-03	REV 1
DRAWING/FILE No. W-030032-11			SHEET 11

12/1
12/2
12/3
12/82

REFER TO SHEET #

APPROVED FOR CONSTRUCTION
 MASTER COPY REFERENCE COPY OF _____
 MULTIPLE UNIT WORK ORDER
 RELEASED FOR INFORMATION
 AUTH. BY: _____ DATE: _____

DRAWING No.	REFERENCE DRAWINGS	No.	REVISIONS	BY	AUTH	DATE
		1	AS BUILT	BM	RH	05-05-06



GENERATOR CONTROL PANEL
 MODEL GCS 2200
 BLANK SHEET
 MIDDLE KUSKOKWIM REGIONAL ENERGY - TAKOTNA

AS BUILT

DRAWINGS AND/OR OTHER TECHNICAL INFORMATION SUPPLIED BY THOMSON TECHNOLOGY AS A PART OF A SALE OF EQUIPMENT ARE FOR THE PURCHASER'S USE SOLELY IN CONJUNCTION WITH THAT EQUIPMENT, UNLESS SPECIFICALLY AGREED TO OTHERWISE AS A PART OF THE TERMS OF SALE.

CUSTOMER ALASKA ENERGY AUTHORITY			
CUSTOMER ORDER No. C-022623	WORK ORDER No. W-030032		
DRAWN BY LR	AUTH BY RH	DATE 05-03-03	REV 1
DRAWING/FILE No. W-030032-12			SHEET 12

13/1
13/2
13/3
13/82

REFER TO SHEET #

APPROVED FOR CONSTRUCTION
 MASTER COPY REFERENCE COPY OF _____
 MULTIPLE UNIT WORK ORDER
 RELEASED FOR INFORMATION
 AUTH. BY: _____ DATE: _____

DRAWING No.	REFERENCE DRAWINGS	No.	REVISIONS	BY	AUTH	DATE
		1	AS BUILT	BM	RH	05-05-06




GENERATOR CONTROL PANEL
 MODEL GCS 2200
 BLANK SHEET
 MIDDLE KUSKOKWIM REGIONAL ENERGY - TAKOTNA

AS BUILT

DRAWINGS AND/OR OTHER TECHNICAL INFORMATION SUPPLIED BY THOMSON TECHNOLOGY AS A PART OF A SALE OF EQUIPMENT ARE FOR THE PURCHASER'S USE SOLELY IN CONJUNCTION WITH THAT EQUIPMENT, UNLESS SPECIFICALLY AGREED TO OTHERWISE AS A PART OF THE TERMS OF SALE.

CUSTOMER ALASKA ENERGY AUTHORITY			
CUSTOMER ORDER No. C-022623	WORK ORDER No. W-030032		
DRAWN BY LR	AUTH BY RH	DATE 05-03-03	REV 1
DRAWING/FILE No. W-030032-13			SHEET 13

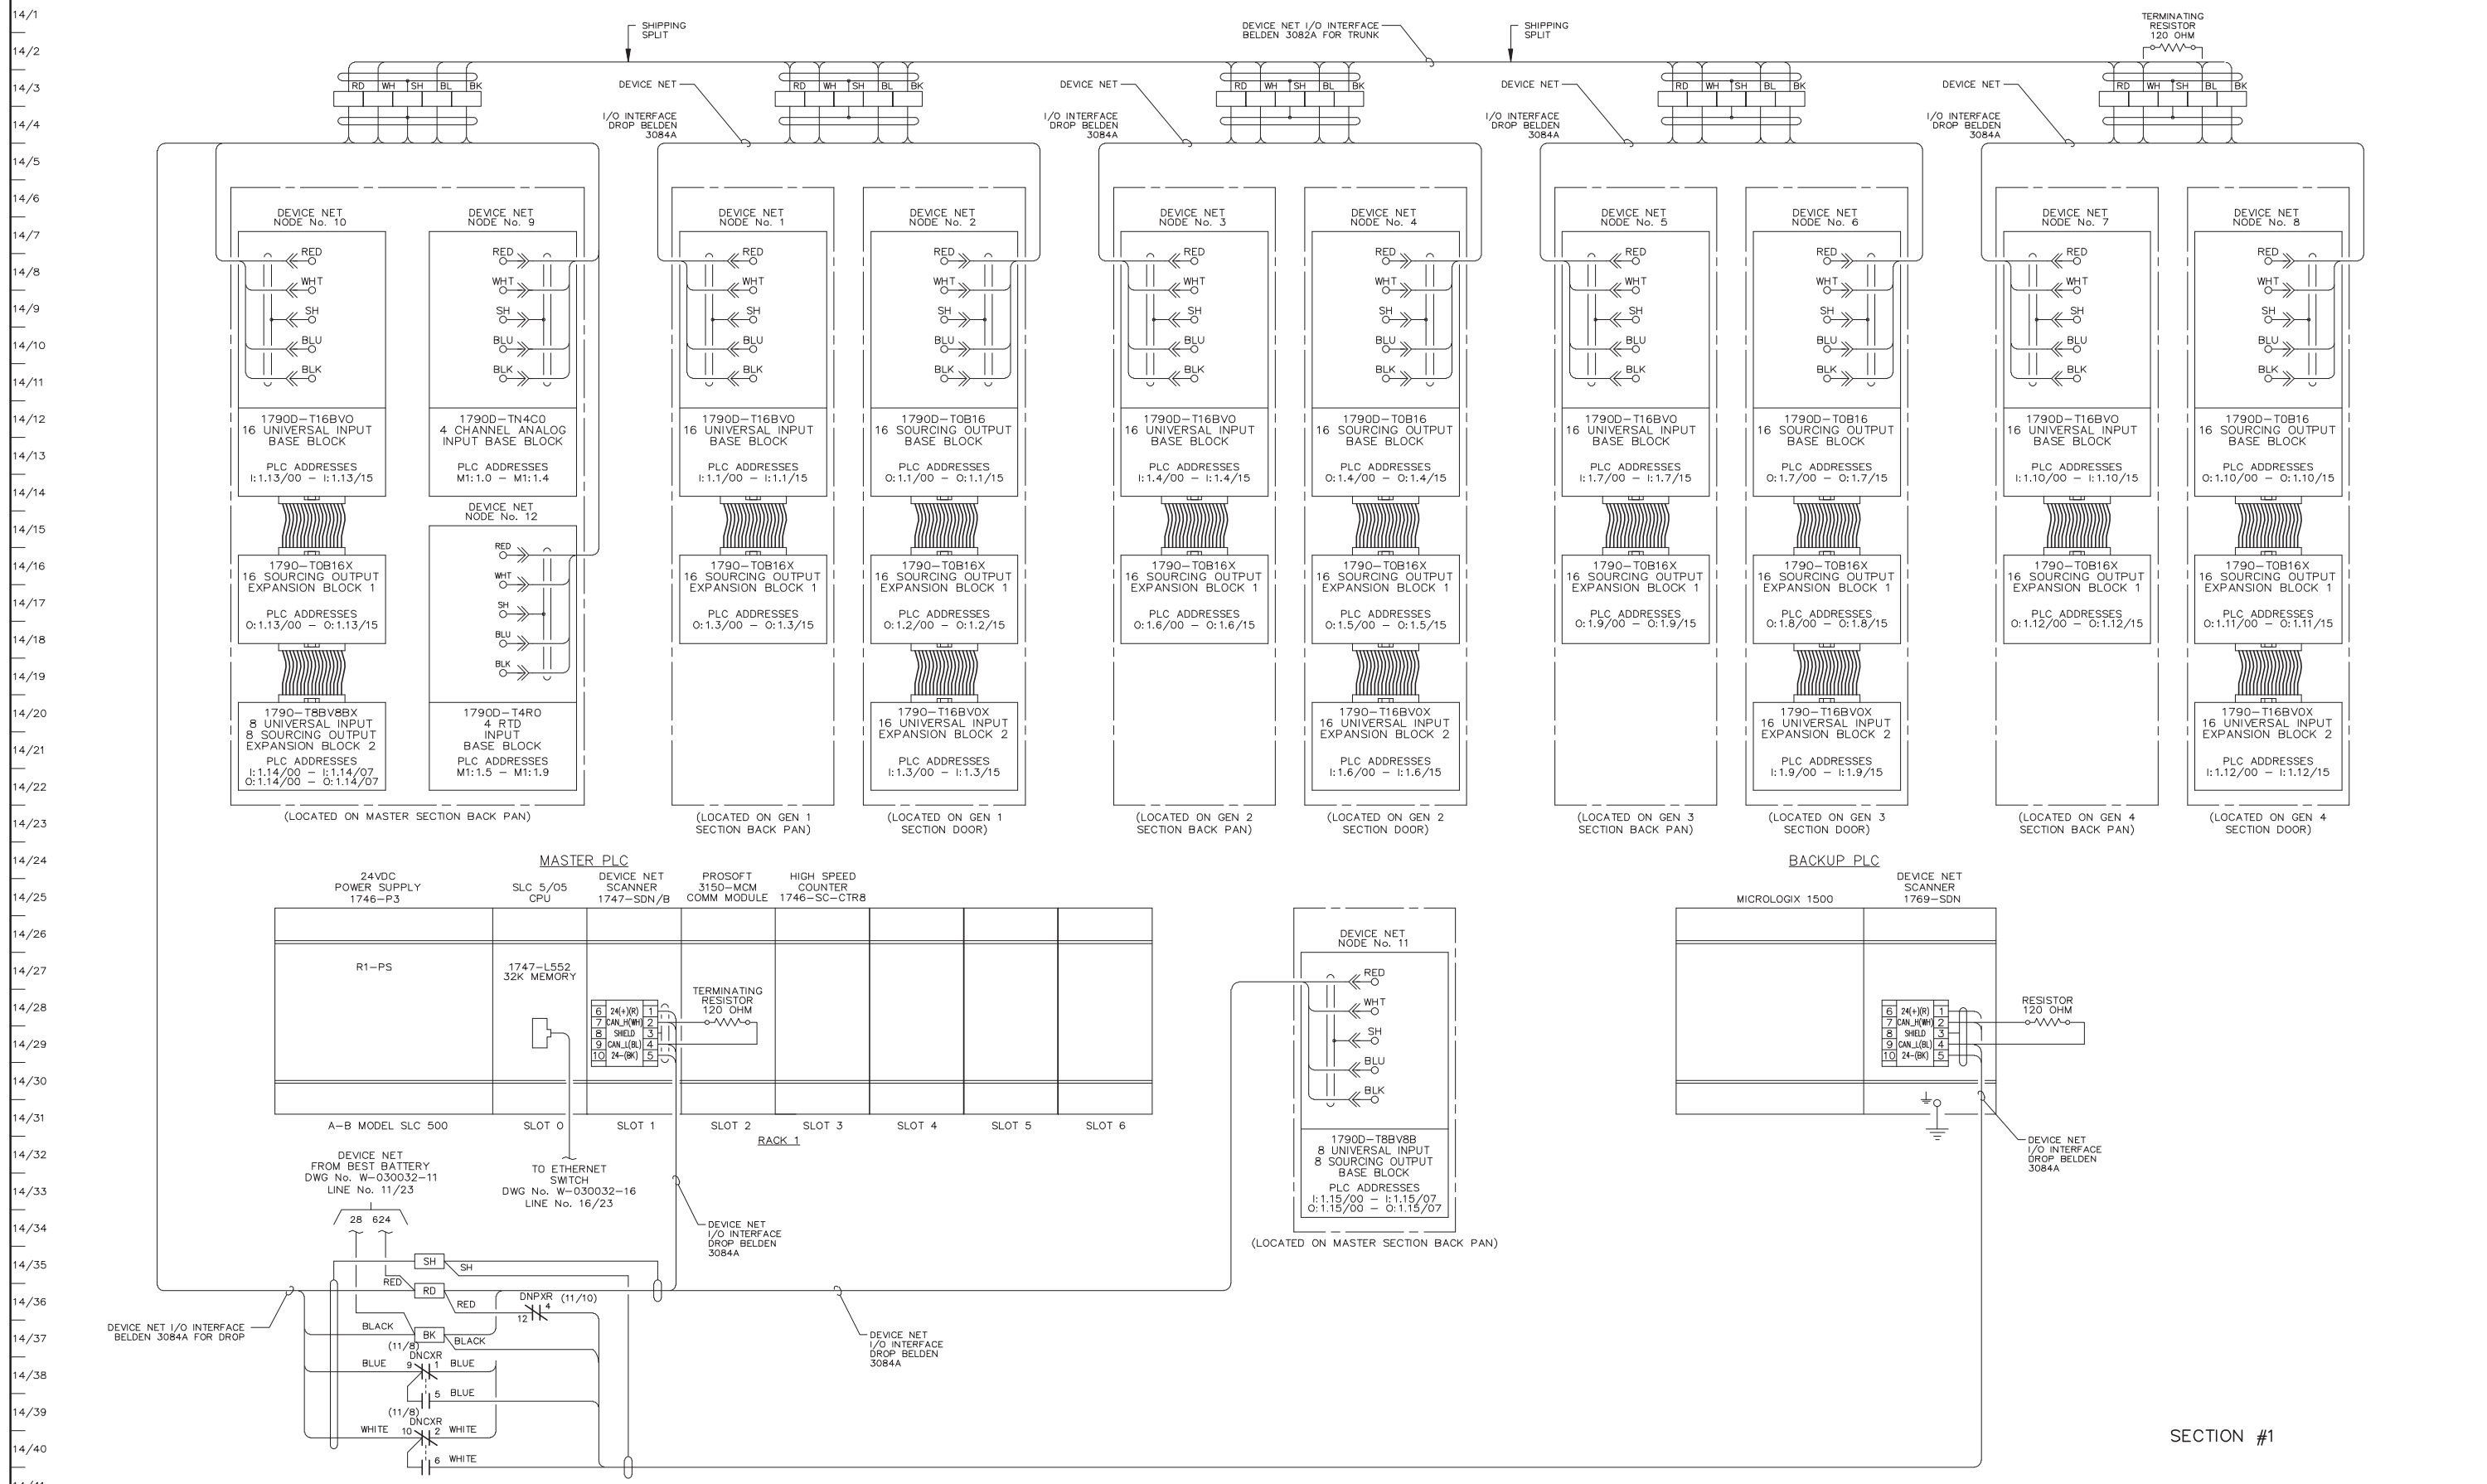

SECTION #1

AS BUILT

DRAWINGS AND/OR OTHER TECHNICAL INFORMATION SUPPLIED BY THOMSON TECHNOLOGY AS A PART OF A SALE OF EQUIPMENT ARE FOR THE PURCHASER'S USE SOLELY IN CONJUNCTION WITH THAT EQUIPMENT, UNLESS SPECIFICALLY AGREED TO OTHERWISE AS A PART OF THE TERMS OF SALE.

CUSTOMER ALASKA ENERGY AUTHORITY	
CUSTOMER ORDER No. C-022623	WORK ORDER No. W-030032
DRAWN BY LR	AUTH BY RH
DATE 05-03-03	REV 1
DRAWING/FILE No. W-030032-14	SHEET 14

REFER TO SHEET #

APPROVED FOR CONSTRUCTION
 MASTER COPY REFERENCE COPY OF
 MULTIPLE UNIT WORK ORDER
 RELEASED FOR INFORMATION


AUTH. BY: _____ DATE: _____

DRAWING No.	REFERENCE DRAWINGS	No.	REVISIONS	BY	AUTH	DATE
		1	AS BUILT	BM	RH	05-05-06



GENERATOR CONTROL PANEL
 MODEL GCS 2200
 PLC COMMUNICATION DIAGRAM
 MIDDLE KUSKOKWIM REGIONAL ENERGY - TAKOTNA

15/1
15/2
15/3
15/41

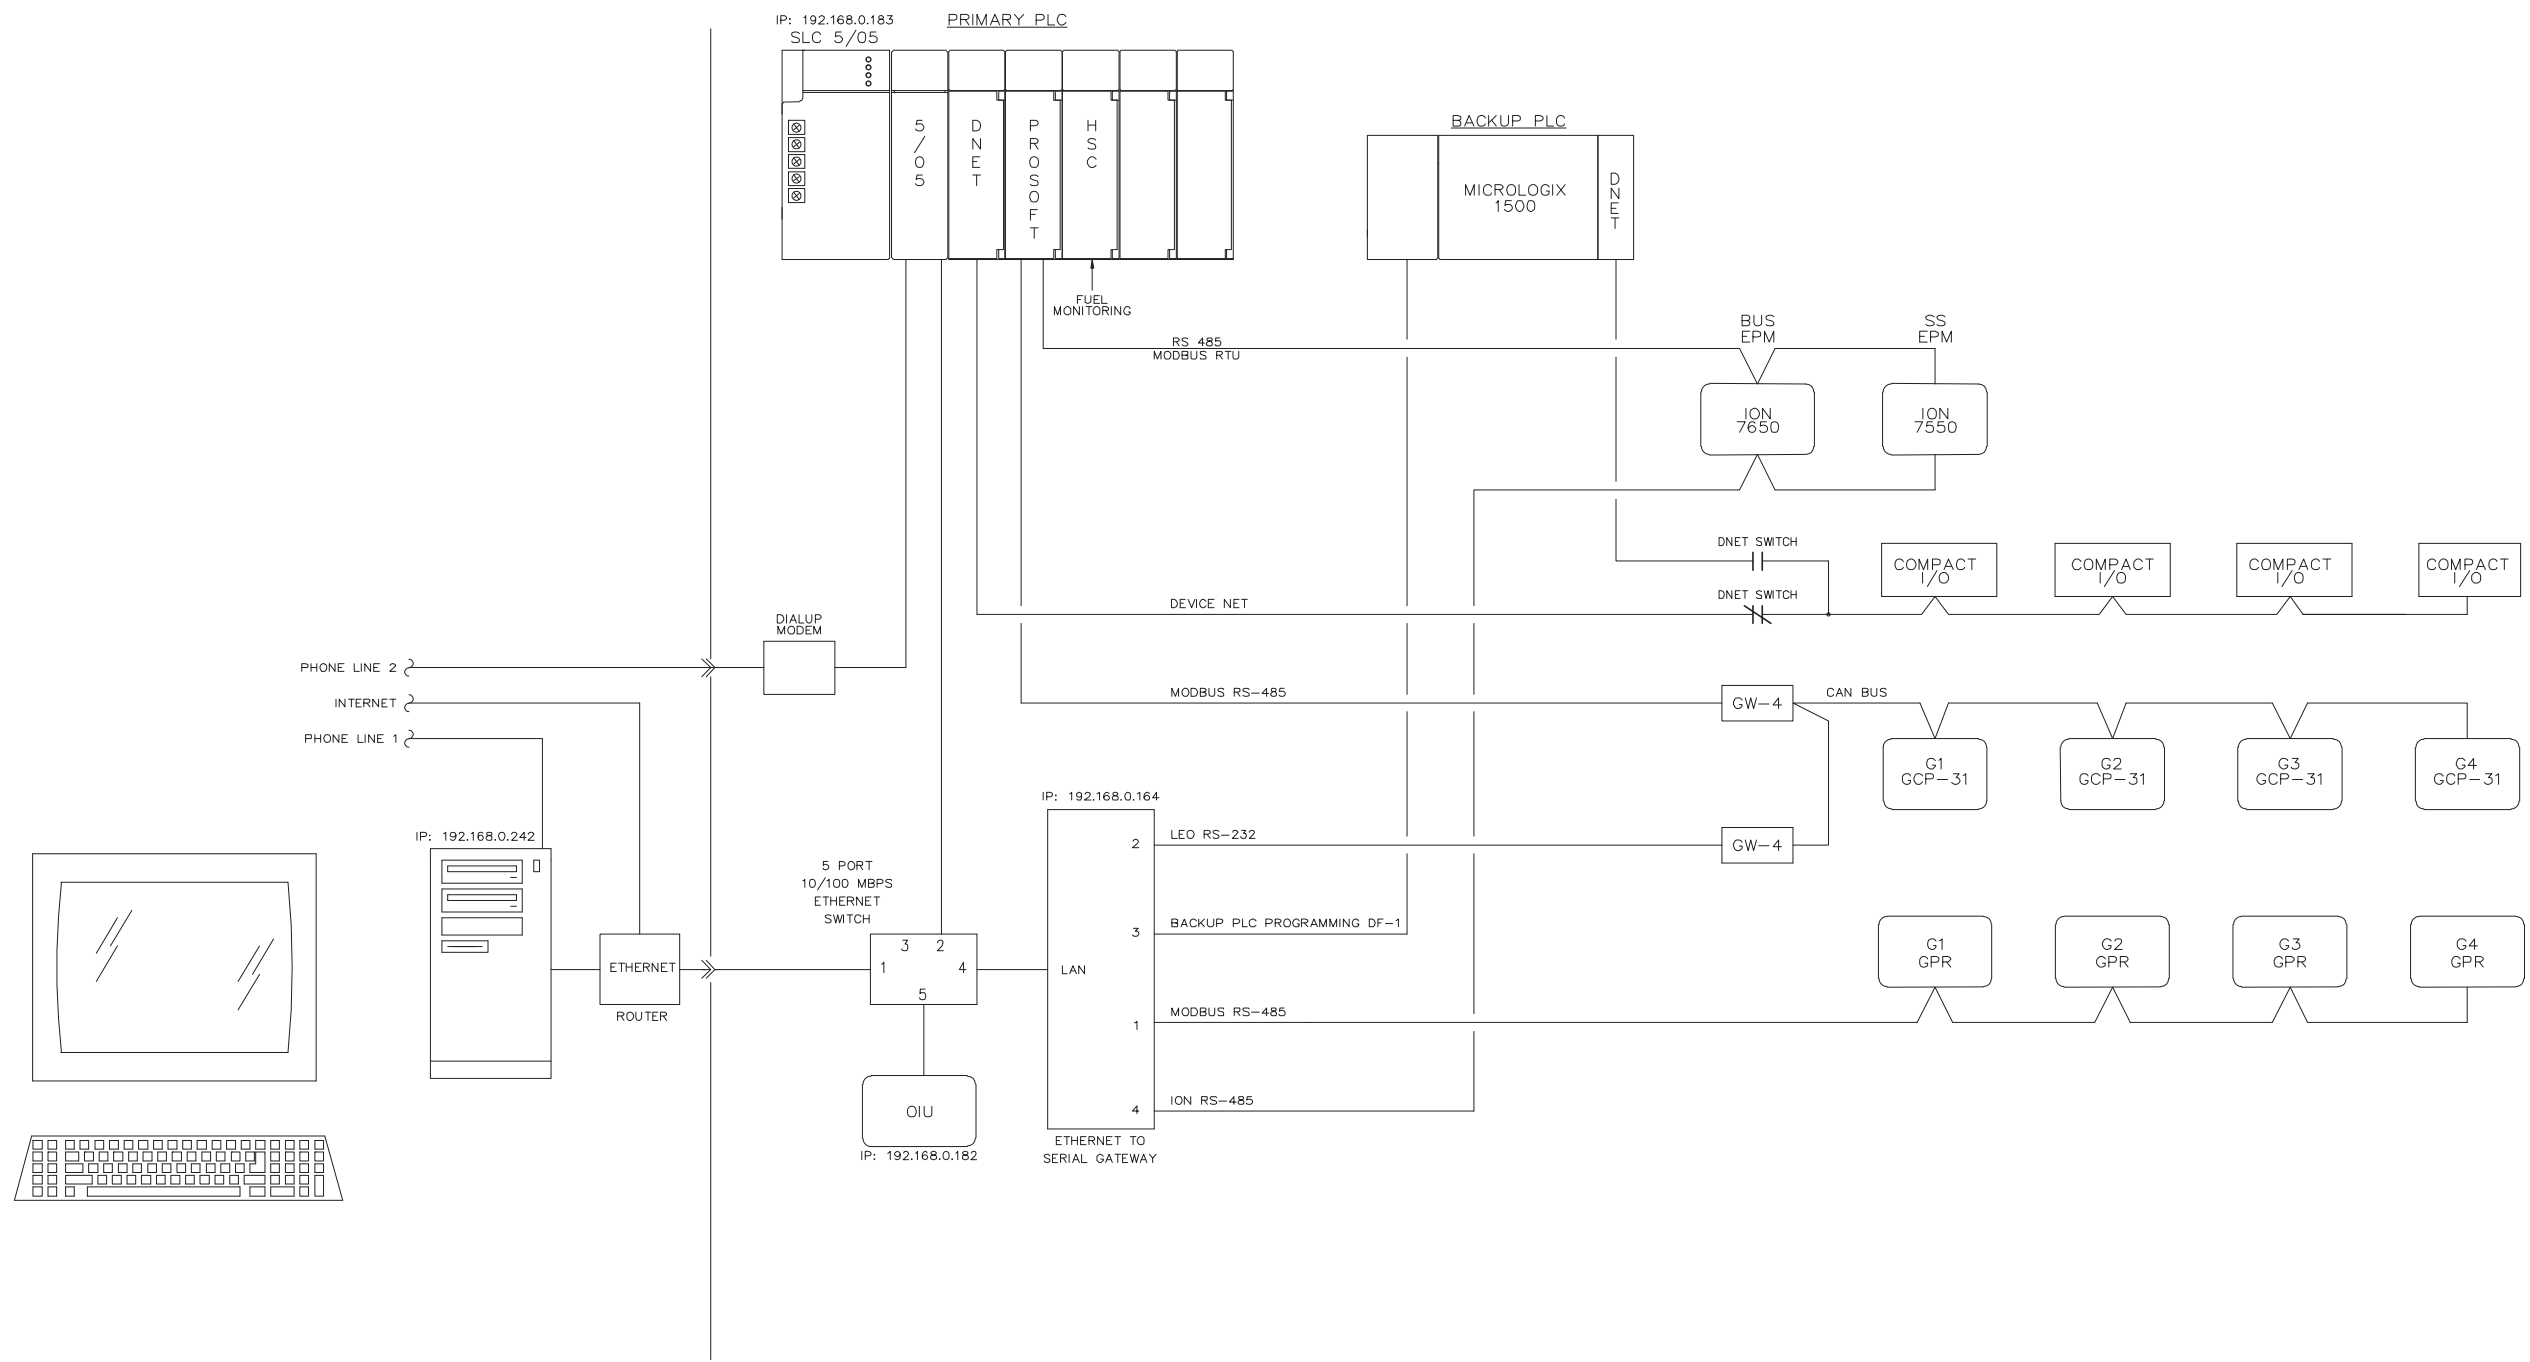

REFER TO SHEET #

APPROVED FOR CONSTRUCTION
 MASTER COPY REFERENCE COPY OF _____
 MULTIPLE UNIT WORK ORDER
 RELEASED FOR INFORMATION
 AUTH. BY: _____ DATE: _____

DRAWING No.	REFERENCE DRAWINGS	No.	REVISIONS	BY	AUTH	DATE
		1	AS BUILT	BM	RH	05-05-06




AS BUILT

GENERATOR CONTROL PANEL
 MODEL GCS 2200
 COMMUNICATION NETWORK DIAGRAM
 MIDDLE KUSKOKWIM REGIONAL ENERGY - TAKOTNA

DRAWINGS AND/OR OTHER TECHNICAL INFORMATION SUPPLIED BY THOMSON TECHNOLOGY AS A PART OF A SALE OF EQUIPMENT ARE FOR THE PURCHASER'S USE SOLELY IN CONJUNCTION WITH THAT EQUIPMENT, UNLESS SPECIFICALLY AGREED TO OTHERWISE AS A PART OF THE TERMS OF SALE.

CUSTOMER ALASKA ENERGY AUTHORITY			
CUSTOMER ORDER No. C-022623	WORK ORDER No. W-030032		
DRAWN BY LR	AUTH BY RH	DATE 05-03-03	REV 1
DRAWING/FILE No. W-030032-15			SHEET 15

16/1
16/2
16/3
16/41

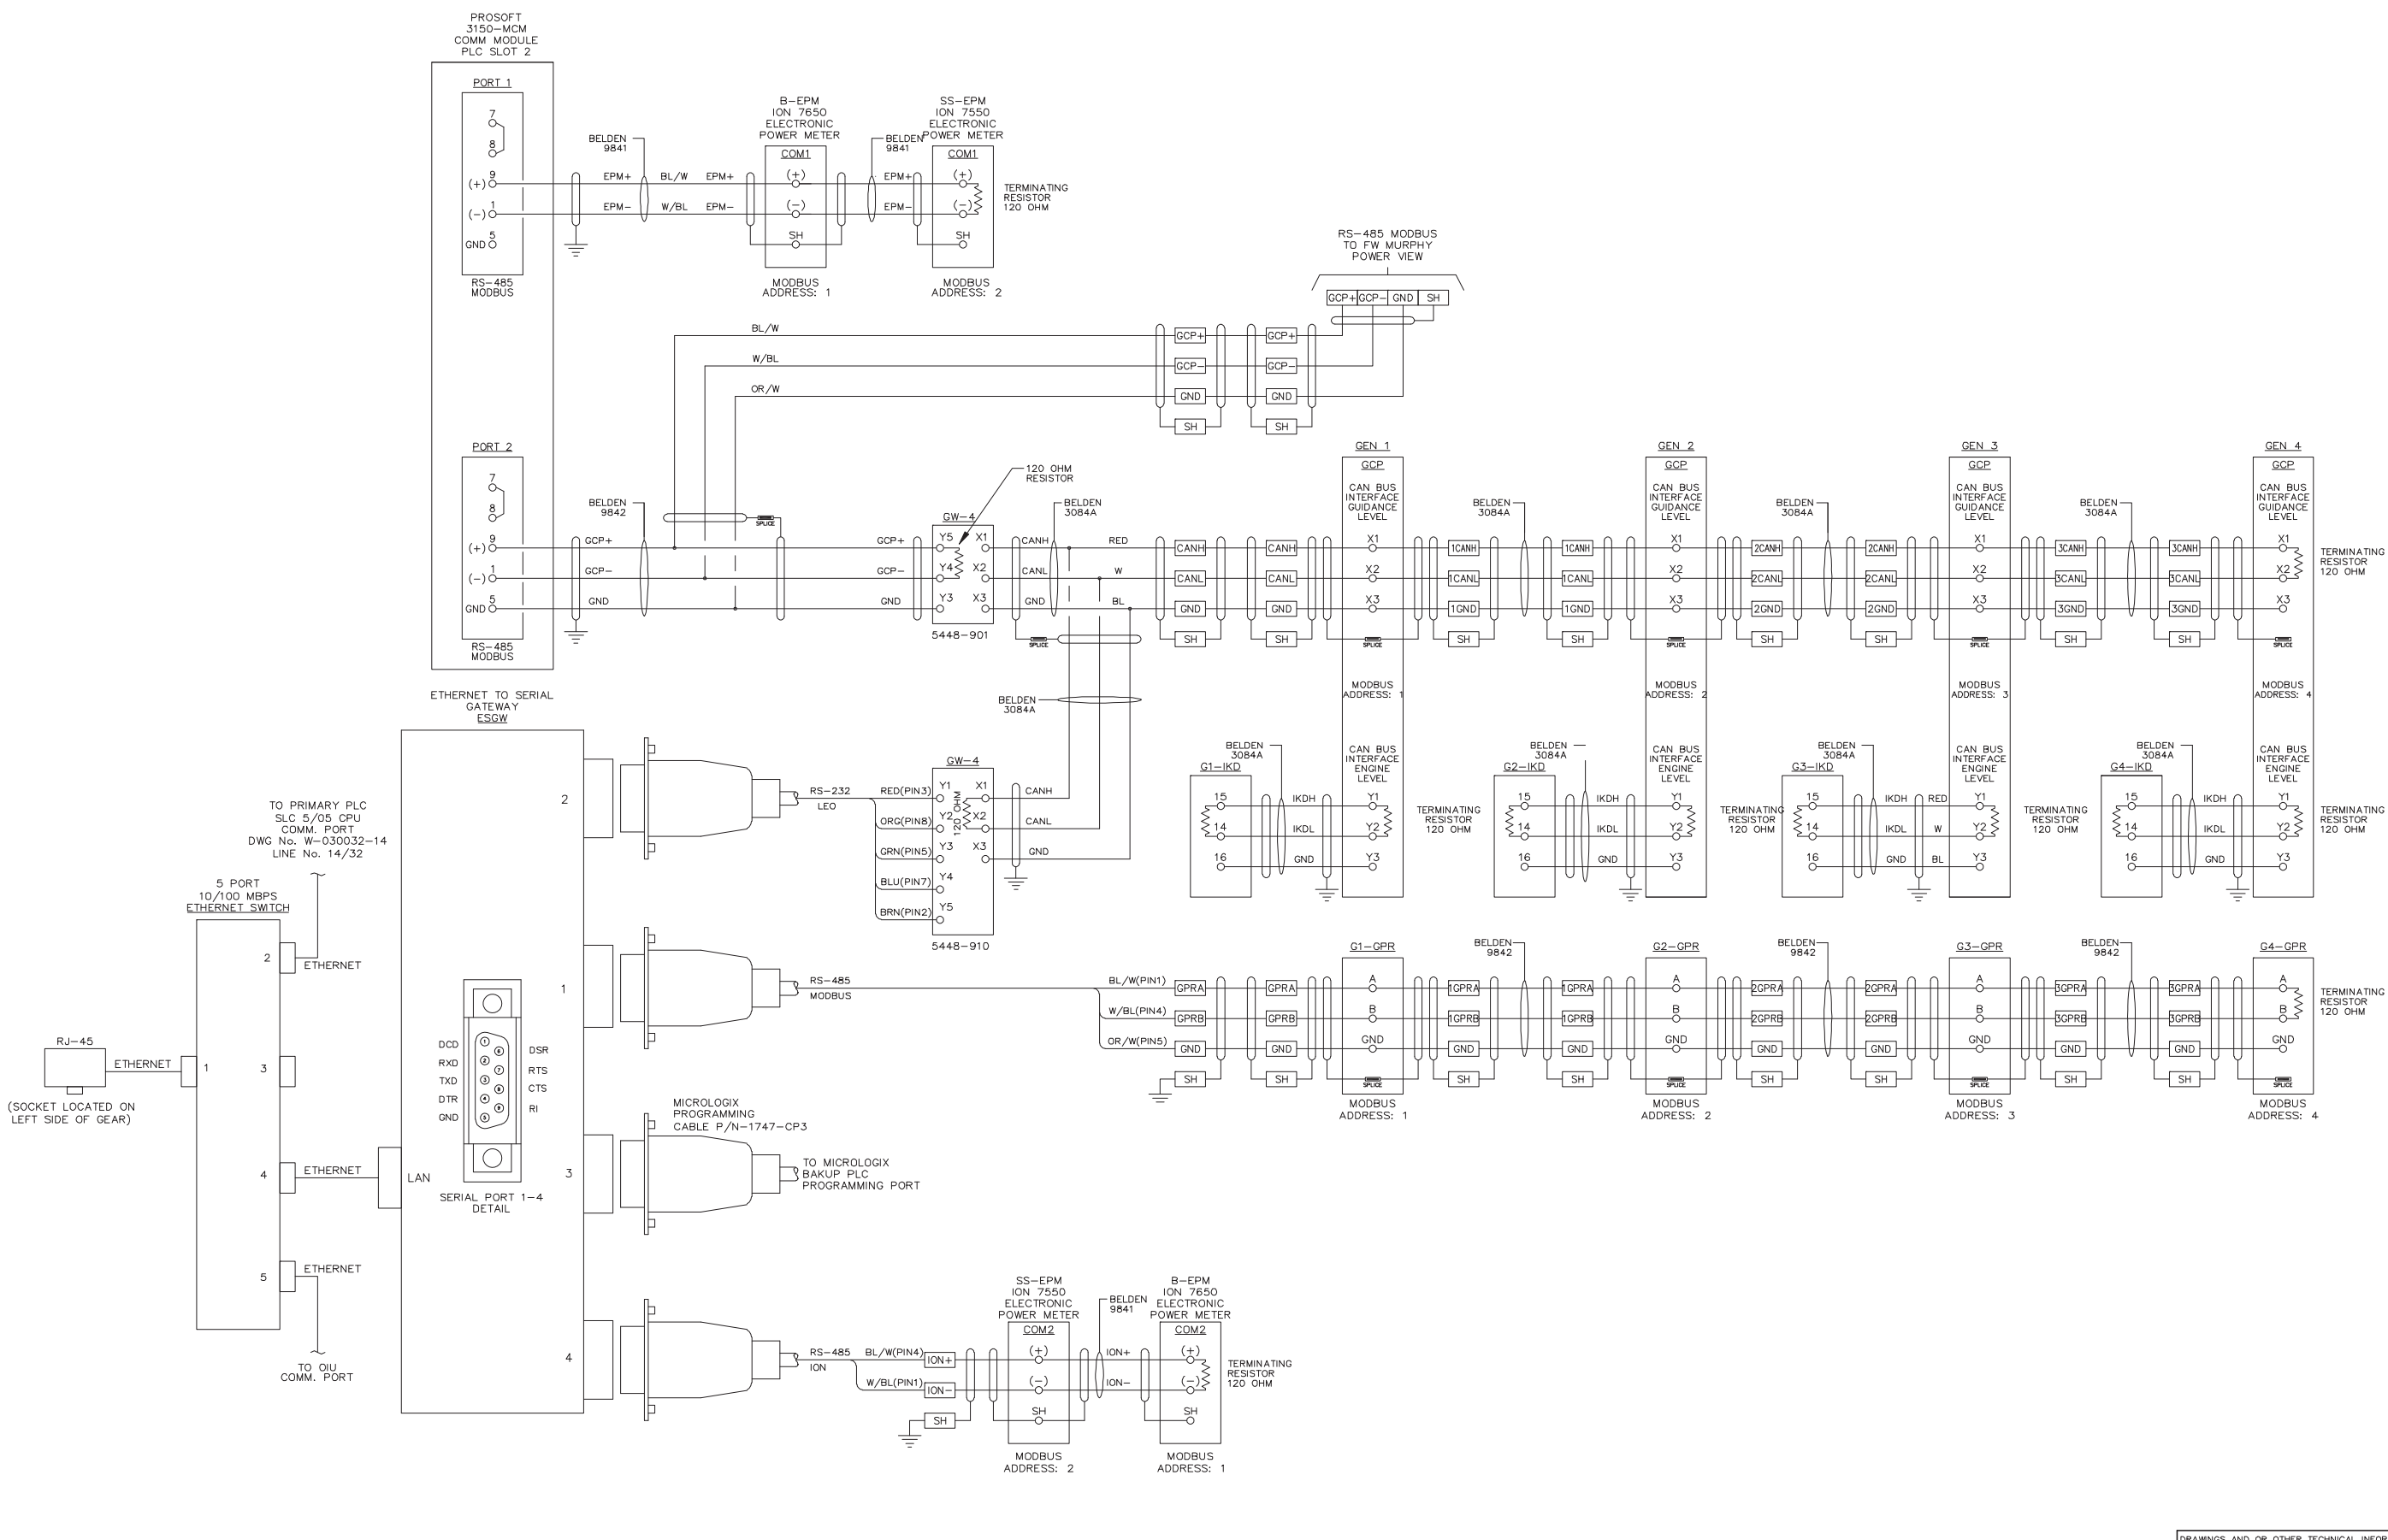

AS BUILT

DRAWINGS AND/OR OTHER TECHNICAL INFORMATION SUPPLIED BY THOMSON TECHNOLOGY AS A PART OF A SALE OF EQUIPMENT ARE FOR THE PURCHASER'S USE SOLELY IN CONJUNCTION WITH THAT EQUIPMENT, UNLESS SPECIFICALLY AGREED TO OTHERWISE AS A PART OF THE TERMS OF SALE.

APPROVED FOR CONSTRUCTION
 MASTER COPY REFERENCE COPY OF _____
 MULTIPLE UNIT WORK ORDER
 RELEASED FOR INFORMATION
 AUTH. BY: _____ DATE: _____


DRAWING No.	REFERENCE DRAWINGS	No.	AS BUILT	REVISIONS	BY	AUTH	DATE
		1	AS BUILT		BM	RH	05-05-06



GENERATOR CONTROL PANEL
 MODEL GCS 2200
 EPM MONITORING & SYSTEM COMMUNICATION DIAGRAM
 MIDDLE KUSKOKWIM REGIONAL ENERGY - TAKOTNA

CUSTOMER ALASKA ENERGY AUTHORITY			
CUSTOMER ORDER No. C-022623	WORK ORDER No. W-030032	DATE 05-03-03	REV 1
DRAWN BY LR	AUTH BY RH	DATE 05-03-03	REV 1
DRAWING/FILE No. W-030032-16			SHEET 16

17/1
17/2
17/3
17/41

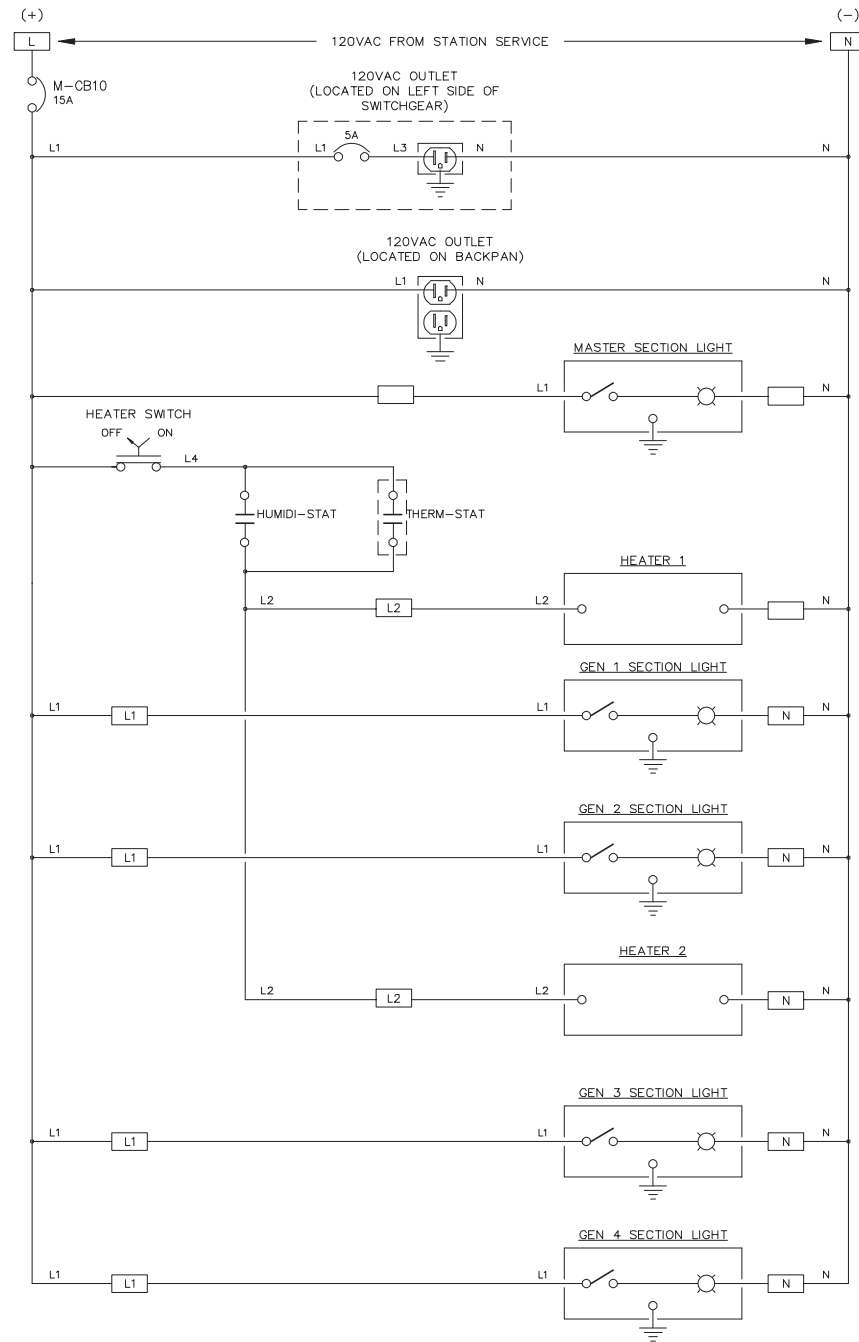

REFER TO SHEET #

APPROVED FOR CONSTRUCTION
 MASTER COPY REFERENCE COPY OF _____
 MULTIPLE UNIT WORK ORDER
 RELEASED FOR INFORMATION
 AUTH. BY: _____ DATE: _____

DRAWING No.	REFERENCE DRAWINGS	No.	AS BUILT	REVISIONS	BY	AUTH	DATE
		1	AS BUILT		BM	RH	05-05-06




GENERATOR CONTROL PANEL
 MODEL GCS 2200
 HEATER & LIGHTING CONTROL SCHEMATIC
 MIDDLE KUSKOKWIM REGIONAL ENERGY - TAKOTNA

AS BUILT


DRAWINGS AND/OR OTHER TECHNICAL INFORMATION SUPPLIED BY THOMSON TECHNOLOGY AS A PART OF A SALE OF EQUIPMENT ARE FOR THE PURCHASER'S USE SOLELY IN CONJUNCTION WITH THAT EQUIPMENT, UNLESS SPECIFICALLY AGREED TO OTHERWISE AS A PART OF THE TERMS OF SALE.

CUSTOMER ALASKA ENERGY AUTHORITY			
CUSTOMER ORDER No. C-022623	WORK ORDER No. W-030032		
DRAWN BY LR	AUTH BY RH	DATE 05-03-03	REV 1
DRAWING/FILE No. W-030032-17			SHEET 17


SYSTEM MODE SWITCH - SMS

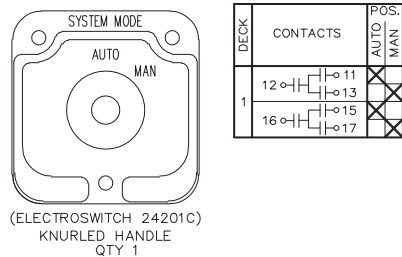


MAIN CONTACTOR CONTROL SWITCH - 42CS

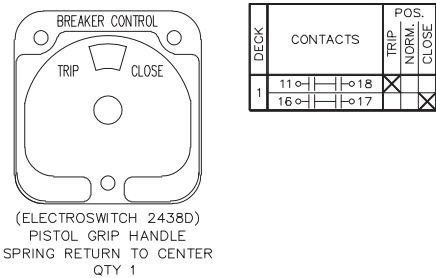


GOVERNOR MODE SWITCH - GMS

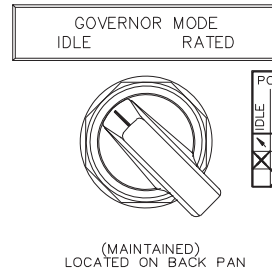

HEATER CONTROL SWITCH - HCS

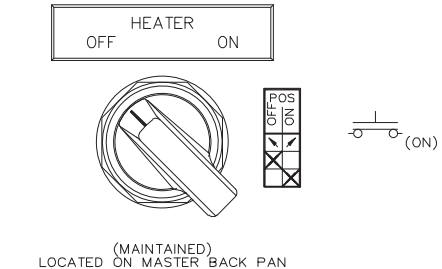

ENGINE CONTROL SWITCH - GLS

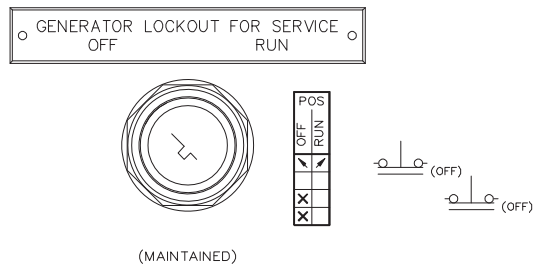

REFER TO SHEET #

APPROVED FOR CONSTRUCTION
 MASTER COPY REFERENCE COPY OF _____
 MULTIPLE UNIT WORK ORDER
 RELEASED FOR INFORMATION
 AUTH. BY: _____ DATE: _____

DRAWING No.	REFERENCE DRAWINGS	No.	REVISIONS	BY	AUTH	DATE
		2	AS BUILT	BM	RH	05-05-06
		1	APPROVAL MOD'S	BM	RH	05-03-16




GENERATOR CONTROL PANEL
 MODEL GCS 2200
 CONTROL SWITCH TARGET DIAGRAM
 MIDDLE KUSKOKWIM REGIONAL ENERGY - TAKOTNA

AS BUILT

DRAWINGS AND/OR OTHER TECHNICAL INFORMATION SUPPLIED BY THOMSON TECHNOLOGY AS A PART OF A SALE OF EQUIPMENT ARE FOR THE PURCHASER'S USE SOLELY IN CONJUNCTION WITH THAT EQUIPMENT, UNLESS SPECIFICALLY AGREED TO OTHERWISE AS A PART OF THE TERMS OF SALE.

CUSTOMER ALASKA ENERGY AUTHORITY			
CUSTOMER ORDER No. C-022623	WORK ORDER No. W-030032		
DRAWN BY LR	AUTH BY RH	DATE 05-03-03	REV 2
DRAWING/FILE No. W-030032-18			SHEET 18

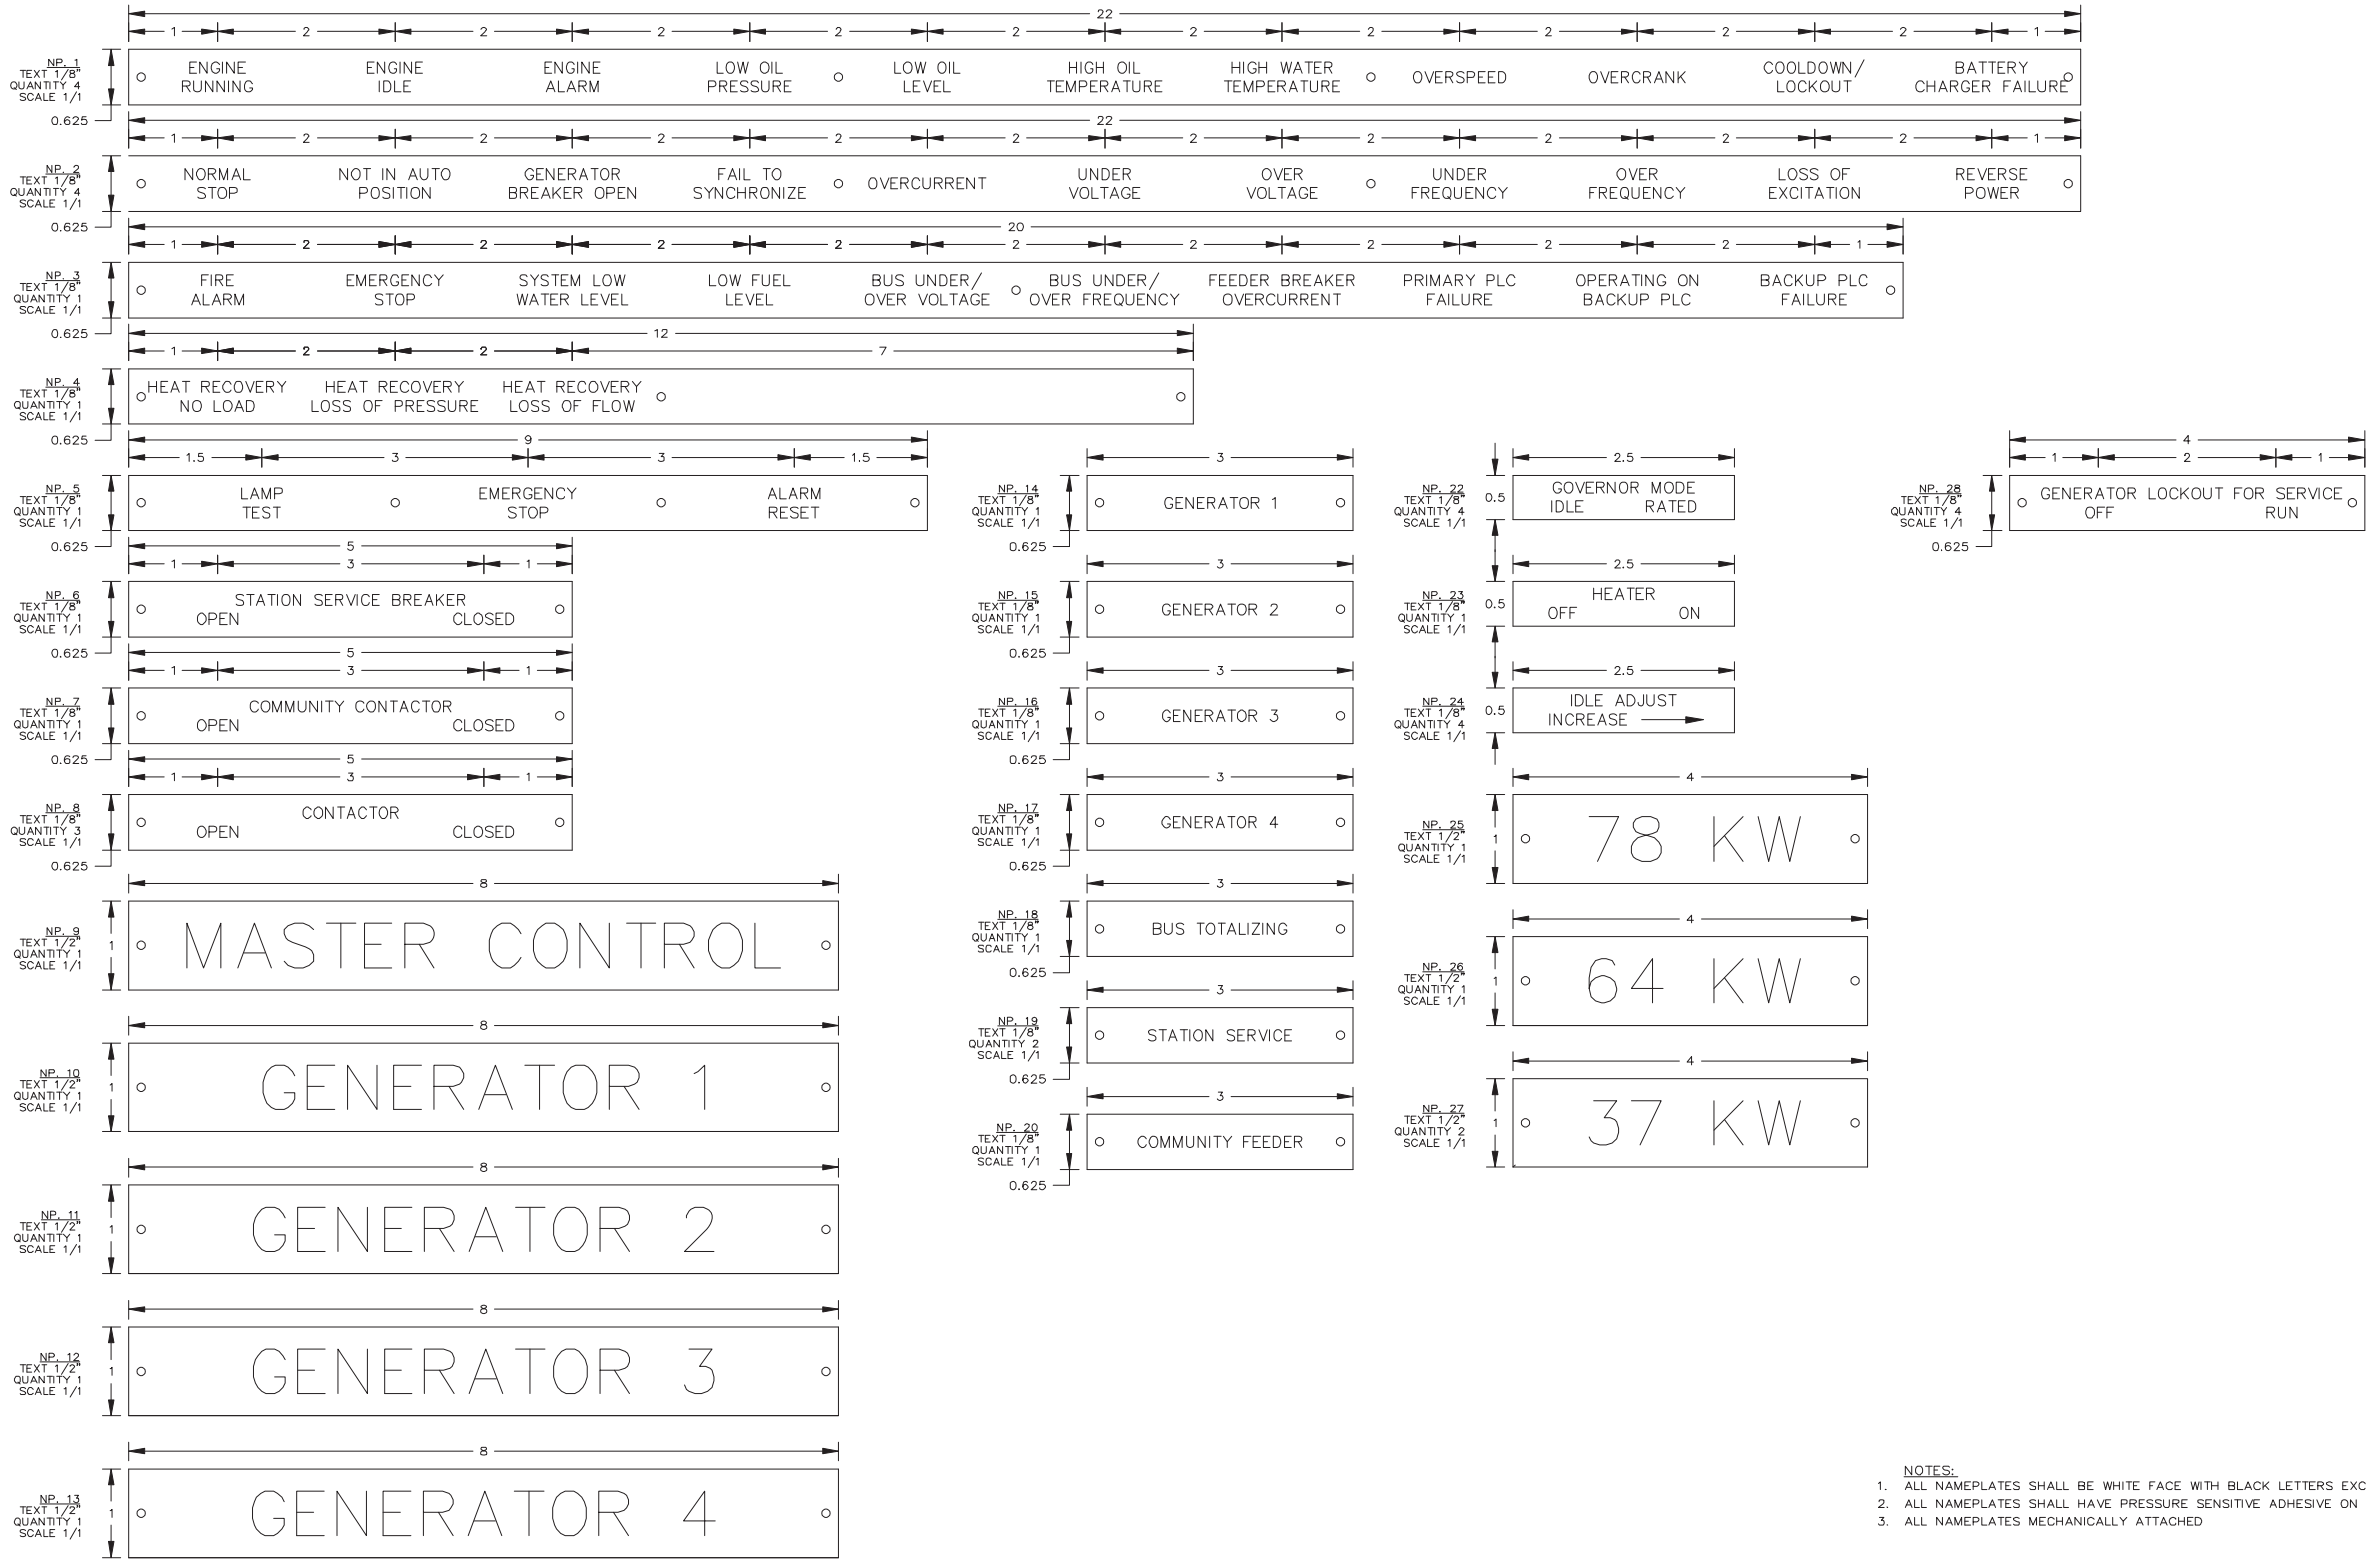

- NOTES:
1. ALL NAMEPLATES SHALL BE WHITE FACE WITH BLACK LETTERS EXCEPT AS NOTED.
 2. ALL NAMEPLATES SHALL HAVE PRESSURE SENSITIVE ADHESIVE ON BACK
 3. ALL NAMEPLATES MECHANICALLY ATTACHED

REFER TO SHEET #

AS BUILT

APPROVED FOR CONSTRUCTION
 MASTER COPY REFERENCE COPY OF _____
 MULTIPLE UNIT WORK ORDER
 RELEASED FOR INFORMATION
 AUTH. BY: _____ DATE: _____

DRAWING No.	REFERENCE DRAWINGS	No.	REVISIONS	BY	AUTH	DATE
		2	AS BUILT	BM	RH	05-05-06
		1	APPROVAL MOD'S	BM	RH	05-03-16



GENERATOR CONTROL PANEL
 MODEL GCS 2200
 NAMEPLATE ENGRAVING SCHEDULE, FABRICATION DETAIL
 MIDDLE KUSKOKWIM REGIONAL ENERGY - TAKOTNA

DRAWINGS AND/OR OTHER TECHNICAL INFORMATION SUPPLIED BY THOMSON TECHNOLOGY AS A PART OF A SALE OF EQUIPMENT ARE FOR THE PURCHASER'S USE SOLELY IN CONJUNCTION WITH THAT EQUIPMENT, UNLESS SPECIFICALLY AGREED TO OTHERWISE AS A PART OF THE TERMS OF SALE.			
CUSTOMER ALASKA ENERGY AUTHORITY		WORK ORDER No. W-030032	
CUSTOMER ORDER No. C-022623	DATE 05-03-03	REV 2	SHEET 19
DRAWN BY LR	AUTH BY RH	DATE 05-03-03	REV 2
DRAWING/FILE No. W-030032-19			SHEET 19



MASTER CONTROL

GENERATOR 1

GENERATOR 2

GENERATOR 3

GENERATOR 4

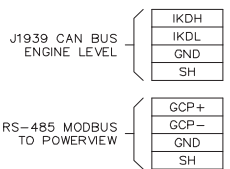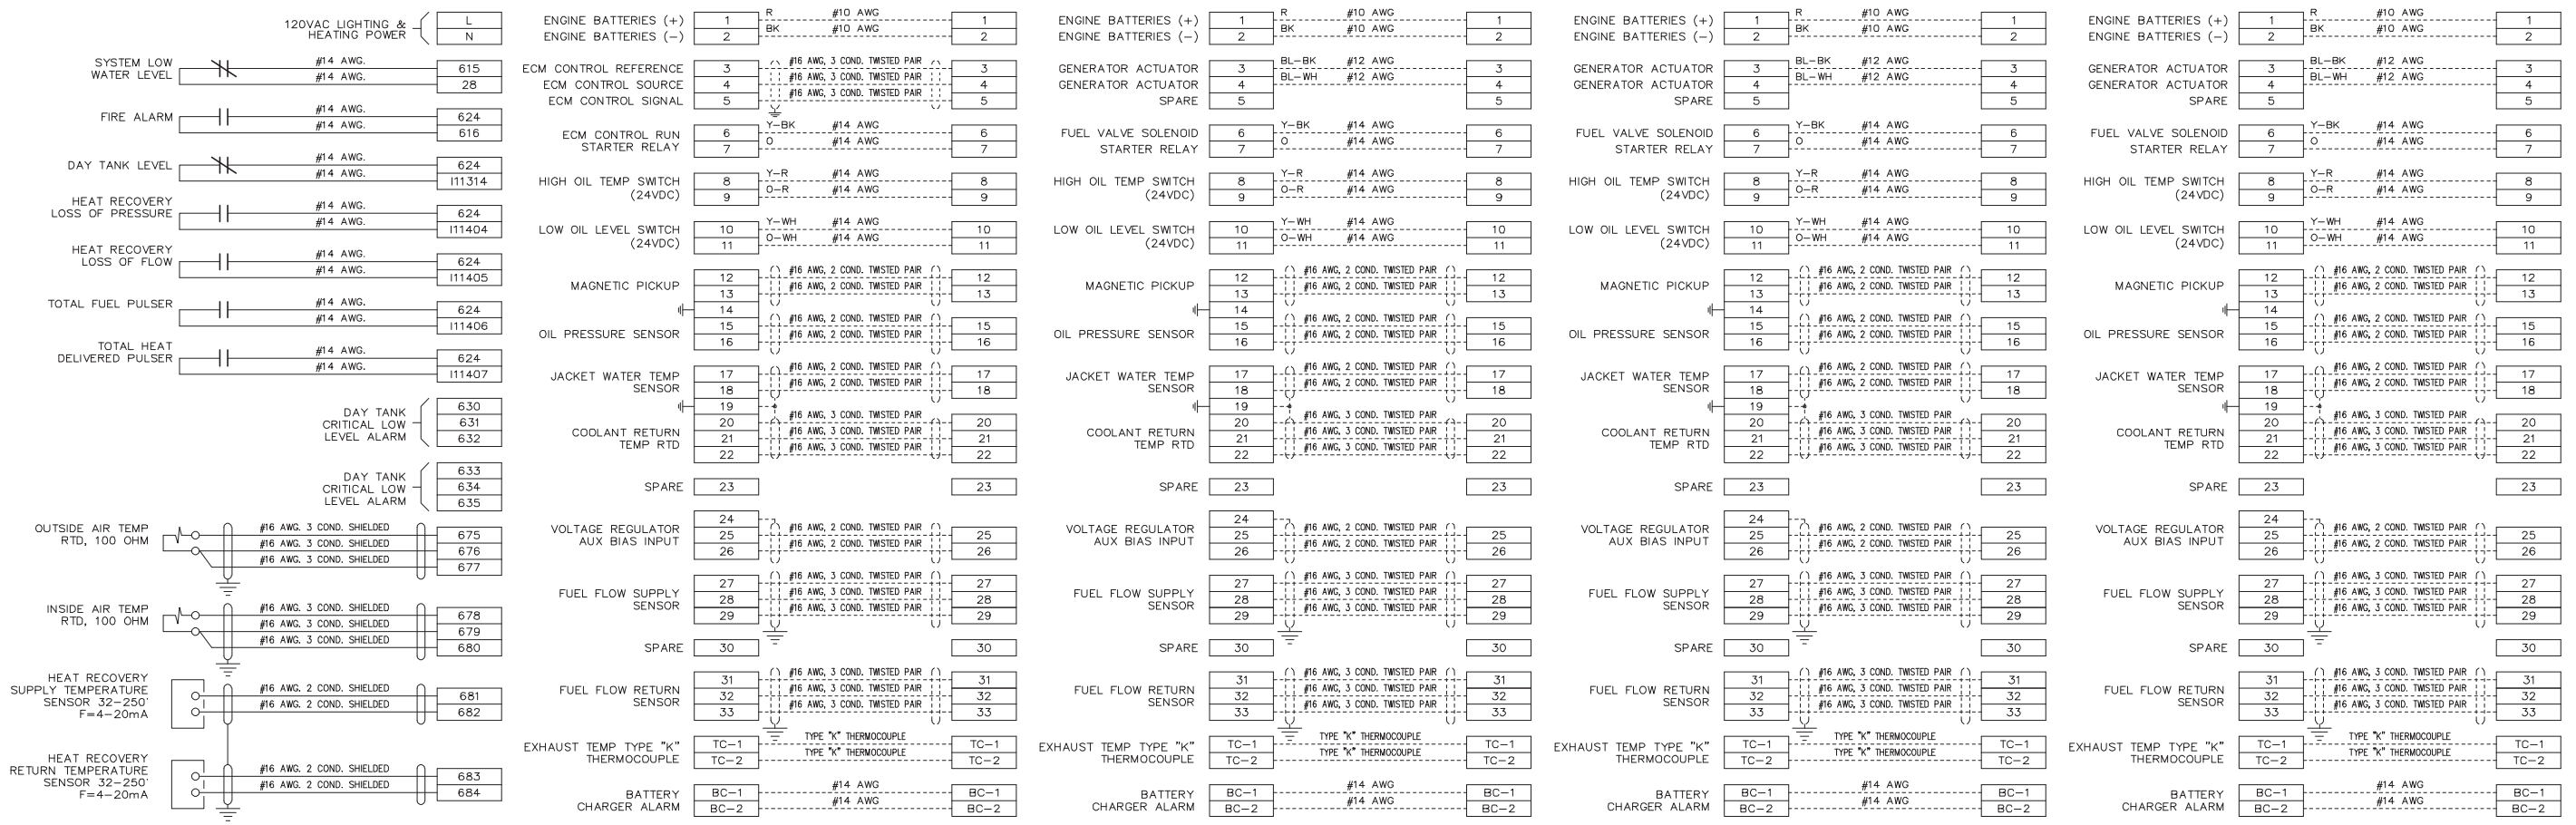

REFER TO SHEET #

APPROVED FOR CONSTRUCTION
 MASTER COPY REFERENCE COPY OF _____
 MULTIPLE UNIT WORK ORDER
 RELEASED FOR INFORMATION
 AUTH. BY: _____ DATE: _____

DRAWING No.	REFERENCE DRAWINGS	No.	1 AS BUILT	BY	BM RH	DATE	05-05-06
		REVISIONS					





GENERATOR CONTROL PANEL
 MODEL GCS 2200
 INTERCONNECTION DIAGRAM
 MIDDLE KUSKOKWIM REGIONAL ENERGY - TAKOTNA

AS BUILT

DRAWINGS AND/OR OTHER TECHNICAL INFORMATION SUPPLIED BY THOMSON TECHNOLOGY AS A PART OF A SALE OF EQUIPMENT ARE FOR THE PURCHASER'S USE SOLELY IN CONJUNCTION WITH THAT EQUIPMENT, UNLESS SPECIFICALLY AGREED TO OTHERWISE AS A PART OF THE TERMS OF SALE.

CUSTOMER ALASKA ENERGY AUTHORITY			
CUSTOMER ORDER No.	C-022623	WORK ORDER No.	W-030032
DRAWN BY	LR	AUTH BY	RH
DATE	05-03-03	REV	1
DRAWING/FILE No.	W-030032-20	SHEET	20

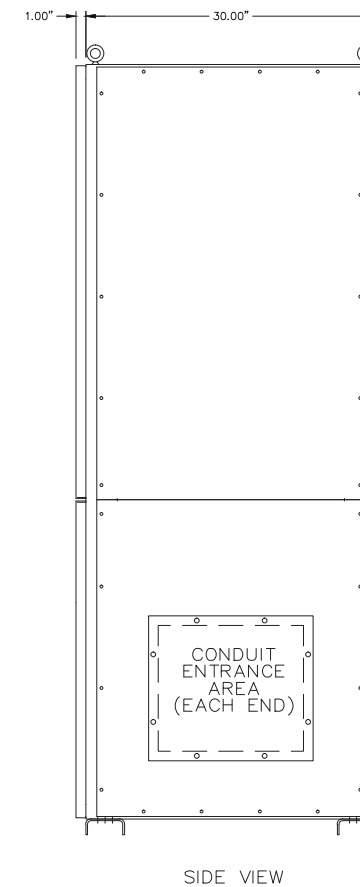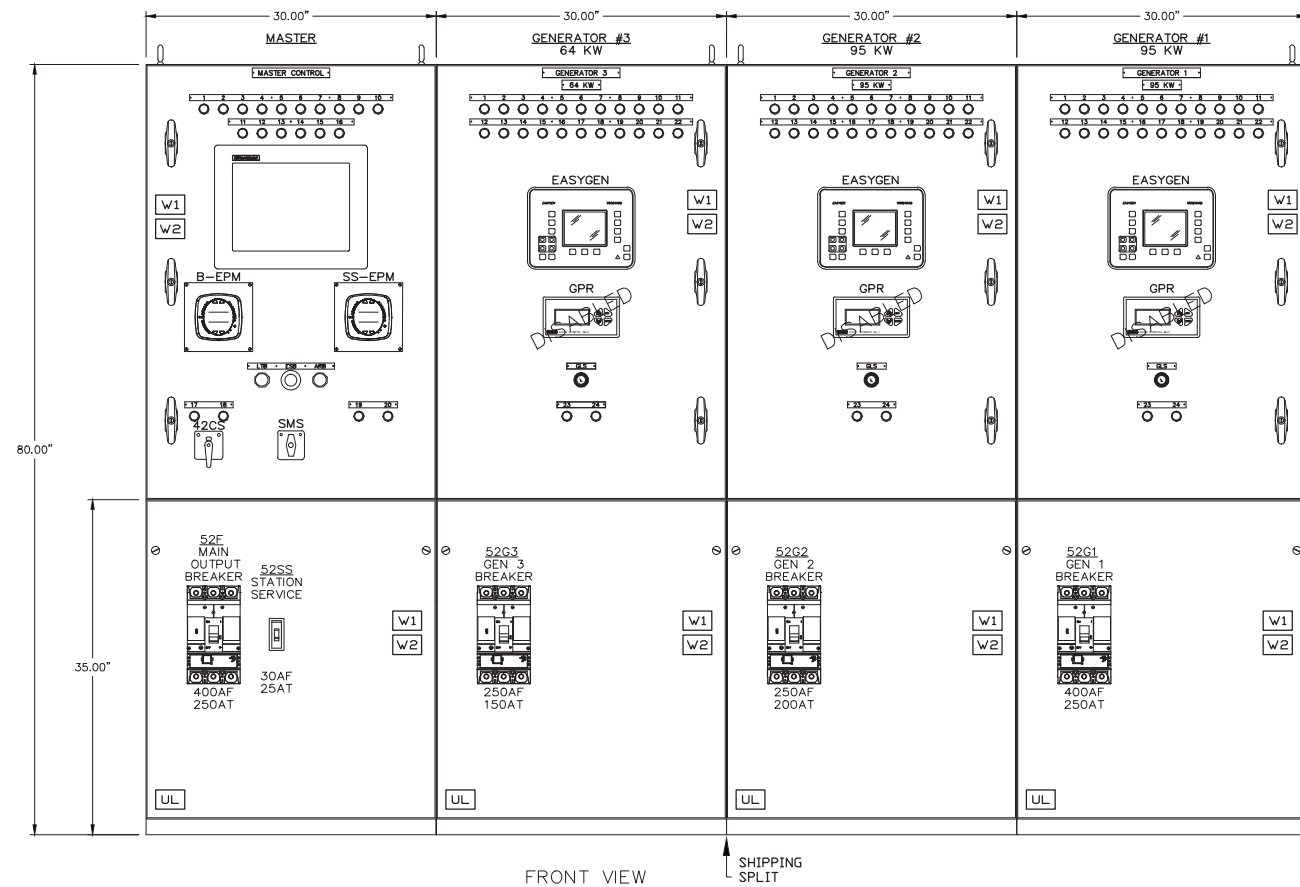

DEVICE LEGEND	
ARB	ALARM RESET BUTTON
B-EPM	BUS ELECTRONIC POWER METER - SHARK
ESB	EMERGENCY STOP BUTTON
EZGEN	GENERATOR CONTROL PACKAGE
GLS	GENERATOR LOCKOUT SWITCH
GPR	GENERATOR PROTECTIVE RELAY (DISABLED)
OIU	OPERATOR INTERFACE UNIT
LTB	LAMP TEST BUTTON
SMS	MASTER CONTROL SWITCH (AUTO-MANUAL)
SS-EPM	STATION SERVICE POWER METER - SHARK
42xx	CONTACTOR
42CS	CONTACTOR CONTROL SWITCH
52xx	CIRCUIT BREAKER

GENERATOR ANNUNCIATOR LEGEND:			
1	ENGINE RUN	13	NOT IN AUTO POSITION
2	ENGINE IDLE	14	GENERATOR BREAKER OPEN
3	ENGINE ALARM	15	FAIL TO SYNCHRONIZE
4	LOW OIL PRESSURE	16	OVERCURRENT
5	LOW OIL LEVEL	17	UNDER VOLTAGE
6	HIGH OIL TEMPERATURE	18	OVER VOLTAGE
7	HIGH WATER TEMPERATURE	19	UNDER FREQUENCY
8	OVERSPEED	20	OVER FREQUENCY
9	OVERCRANK	21	LOSS OF EXCITATION
10	COOLDOWN/LOCKOUT	22	REVERSE POWER
11	BATTERY CHARGER FAILURE	23	CONTACTOR OPEN
12	NORMAL STOP	24	CONTACTOR CLOSED

MASTER ANNUNCIATOR LEGEND:			
1	FIRE ALARM LIGHT	11	HEAT RECOVERY NO LOAD
2	EMERGENCY STOP LIGHT	12	HEAT RECOVERY LOSS OF PRESSURE
3	SYSTEM LOW WATER LEVEL LIGHT	13	HEAT RECOVERY LOSS OF FLOW
4	LOW FUEL LEVEL LIGHT	14	SPARE 1
5	BUS UNDER/OVER VOLTAGE LIGHT	15	SPARE 2
6	BUS UNDER/OVER FREQUENCY LIGHT	16	SPARE 3
7	FEEDER BREAKER OVERCURRENT LIGHT	17	FEEDER BREAKER OPEN
8	PRIMARY PLC FAILURE	18	FEEDER BREAKER CLOSED
9	OPERATING ON BACKUP PLC	19	STATION SERVICE BREAKER OPEN
10	BACKUP PLC FAILURE	20	STATION SERVICE BREAKER CLOSED

DRAWING LEGEND	
1	PHYSICAL LAYOUT
2	SINGLE LINE DIAGRAM
3	BLANK
4A	GENERATOR 1 AC SCHEMATIC
4B	GENERATOR 2 AC SCHEMATIC
4C	GENERATOR 3 AC SCHEMATIC
4D	GENERATOR 4 AC SCHEMATIC
5	MASTER AC & DISTRIBUTION SCHEMATIC
6A	GENERATOR 1 DC CONTROL SCHEMATIC
6B	GENERATOR 2 DC CONTROL SCHEMATIC
6C	GENERATOR 3 DC CONTROL SCHEMATIC
6D	GENERATOR 4 DC CONTROL SCHEMATIC
7A	GENERATOR 1 DC CONTROL SCHEMATIC
7B	GENERATOR 2 DC CONTROL SCHEMATIC
7C	GENERATOR 3 DC CONTROL SCHEMATIC
7D	GENERATOR 4 DC CONTROL SCHEMATIC
8A	GENERATOR 1 DC CONTROL SCHEMATIC
8B	GENERATOR 2 DC CONTROL SCHEMATIC
8C	GENERATOR 3 DC CONTROL SCHEMATIC
8D	GENERATOR 4 DC CONTROL SCHEMATIC

DRAWING LEGEND	
9	MASTER DC CONTROL SCHEMATIC
10	MASTER DC CONTROL SCHEMATIC
11	MASTER DC CONTROL SCHEMATIC
12	BLANK
13	BLANK
14	PLC COMMUNICATION DIAGRAM
15	COMMUNICATION NETWORK DIAGRAM
16	EPM MONITORING & SYSTEM COMMUNICATION DIAGRAM
17	HEATER & LIGHTING CONTROL SCHEMATIC
18	CONTROL SWITCH TARGET DIAGRAM
19	NAMEPLATE DETAILS
20	INTERCONNECTION DIAGRAM

NOTES	
1	WIRE MARKERS: HEATSHRINK TYPE C/W INDELIBLE INK MARKINGS
2	WIRE TYPE: ALL CONNECTIONS TO BUS AND BREAKERS TO BE #14AWG SIS. WIRING THAT IS TO BE PROVIDED AS PART OF OR IS AN INTEGRAL PART OF SUPERVISORY CONTROL EQUIPMENT SHALL BE #18-14AWG SIS. CT WIRING TO BE #10AWG SIS MIN.
3	WIRING COLOR CODED: NO WIRE NUMBERS TO MATCH TERMINAL NUMBERS UNLESS NOTED
4	LOAD BUS TO BE 1000A 3PH 4W SILVER PLATED COPPER BRACED AT 35KA.
5	ENCLOSURE TYPE NEMA 1 BUILT TO UL991.
6	PAINT ASA #61 GREY EXTERIOR, WHITE MOUNTING PAN
7	ENCLOSURE SUPPLIED IN THREE PIECES
8	FULL LENGTH COPPER GROUND BUS 0.25" X 2.5" C/W (6) #6-250MCM GROUND LUGS
9	POWER CABLES: UTILITY FROM BOTTOM; GEN & LOAD TOP. FRONT AND REAR ACCESS REQUIRED.
10	LAMICOLDS WHITE C/W BLACK LETTERS, MECHANICALLY ATTACHED
11	CABLE LUG SIZES: GEN 1, 2: (1) #8 - 600MCM Cu/AL PER PHASE GEN 3, 4: (1) #8 - 350MCM Cu/AL PER PHASE LOAD: (1) #8 - 600MCM Cu/AL PER PHASE SS: (1) #12 - 3/0 Cu/AL PER PHASE

EZGEN READOUT	
* INCLUDES, BUT IS NOT LIMITED TO THE FOLLOWING LIST OF METERING, STATUS, AND ALARMS.	
METERING LEGEND	
1. VOLTS: AØ, BØ, CØ L-N, L-L	
2. AMPS: AØ, BØ, CØ	
3. KW	
4. PF	
5. KWH	
ALARM LEGEND	
1. LOW OIL PRESSURE ALARM	
2. LOW OIL PRESSURE SHUTDOWN	
3. HIGH WATER TEMPERATURE ALARM	
4. HIGH WATER TEMPERATURE SHUTDOWN	
5. OVERCRANK	
6. OVERSPEED	
7. LOW OIL LEVEL	
ANALOG INPUT LEGEND	
1. OIL PRESSURE (PSI)	
2. WATER TEMP (°F)	
MISC LEGEND	
1. ENGINE HOURS	
2. ENGINE START COUNTER	
3. MAINTENANCE CALL	

CROOKED CREEK SWITCHGEAR UPGRADE, 25 SHEETS TOTAL. NOTE THAT THESE DRAWINGS SHOW A PRIOR UPGRADE TO EXISTING SWITCHGEAR THAT IS SIMILAR TO THE WORK FOR CHIGNIK LAKE AND TAKOTNA. THEY ARE PROVIDED FOR REFERENCE ONLY TO SHOW THE TYPE AND EXTENT OF MODIFICATIONS.

REV.	DATE	DESCRIPTION	BY
B	09-21-16	AS BUILT	RAC

PURCHASE ORDER No. ERNIE BAUMGARTNER CONTROLLED POWER JOB No. 8438CC

TITLE: GENERATOR CONTROL PANEL ELEVATION VIEW, OUTLINE DIAGRAM

SCALE: NONE DATE: 08-23-16 DWN. BY: GPN


DWG. No: 8438CC-4101-D SHEET: 1 OF 1 CKD. BY: JMD

JOB: CROOKED CREEK EASYGEN UPGRADE

NOTICE
THE DRAWINGS, INFORMATION AND SUBJECT MATTER HEREOF ARE THE CONFIDENTIAL, SOLE AND EXCLUSIVE PROPERTY OF CONTROLLED POWER, INC., AND ARE NOT TO BE COPIED, REPRODUCED OR USED IN ANY MANNER FOR ANY PURPOSE WHATSOEVER WITHOUT WRITTEN CONSENT OR DIRECTION.



ENGINEERED & MANUFACTURED BY
Controlled Power, Inc.
BOTHELL, WASHINGTON USA
(425)-485-1778 www.controlledpowerinc.com

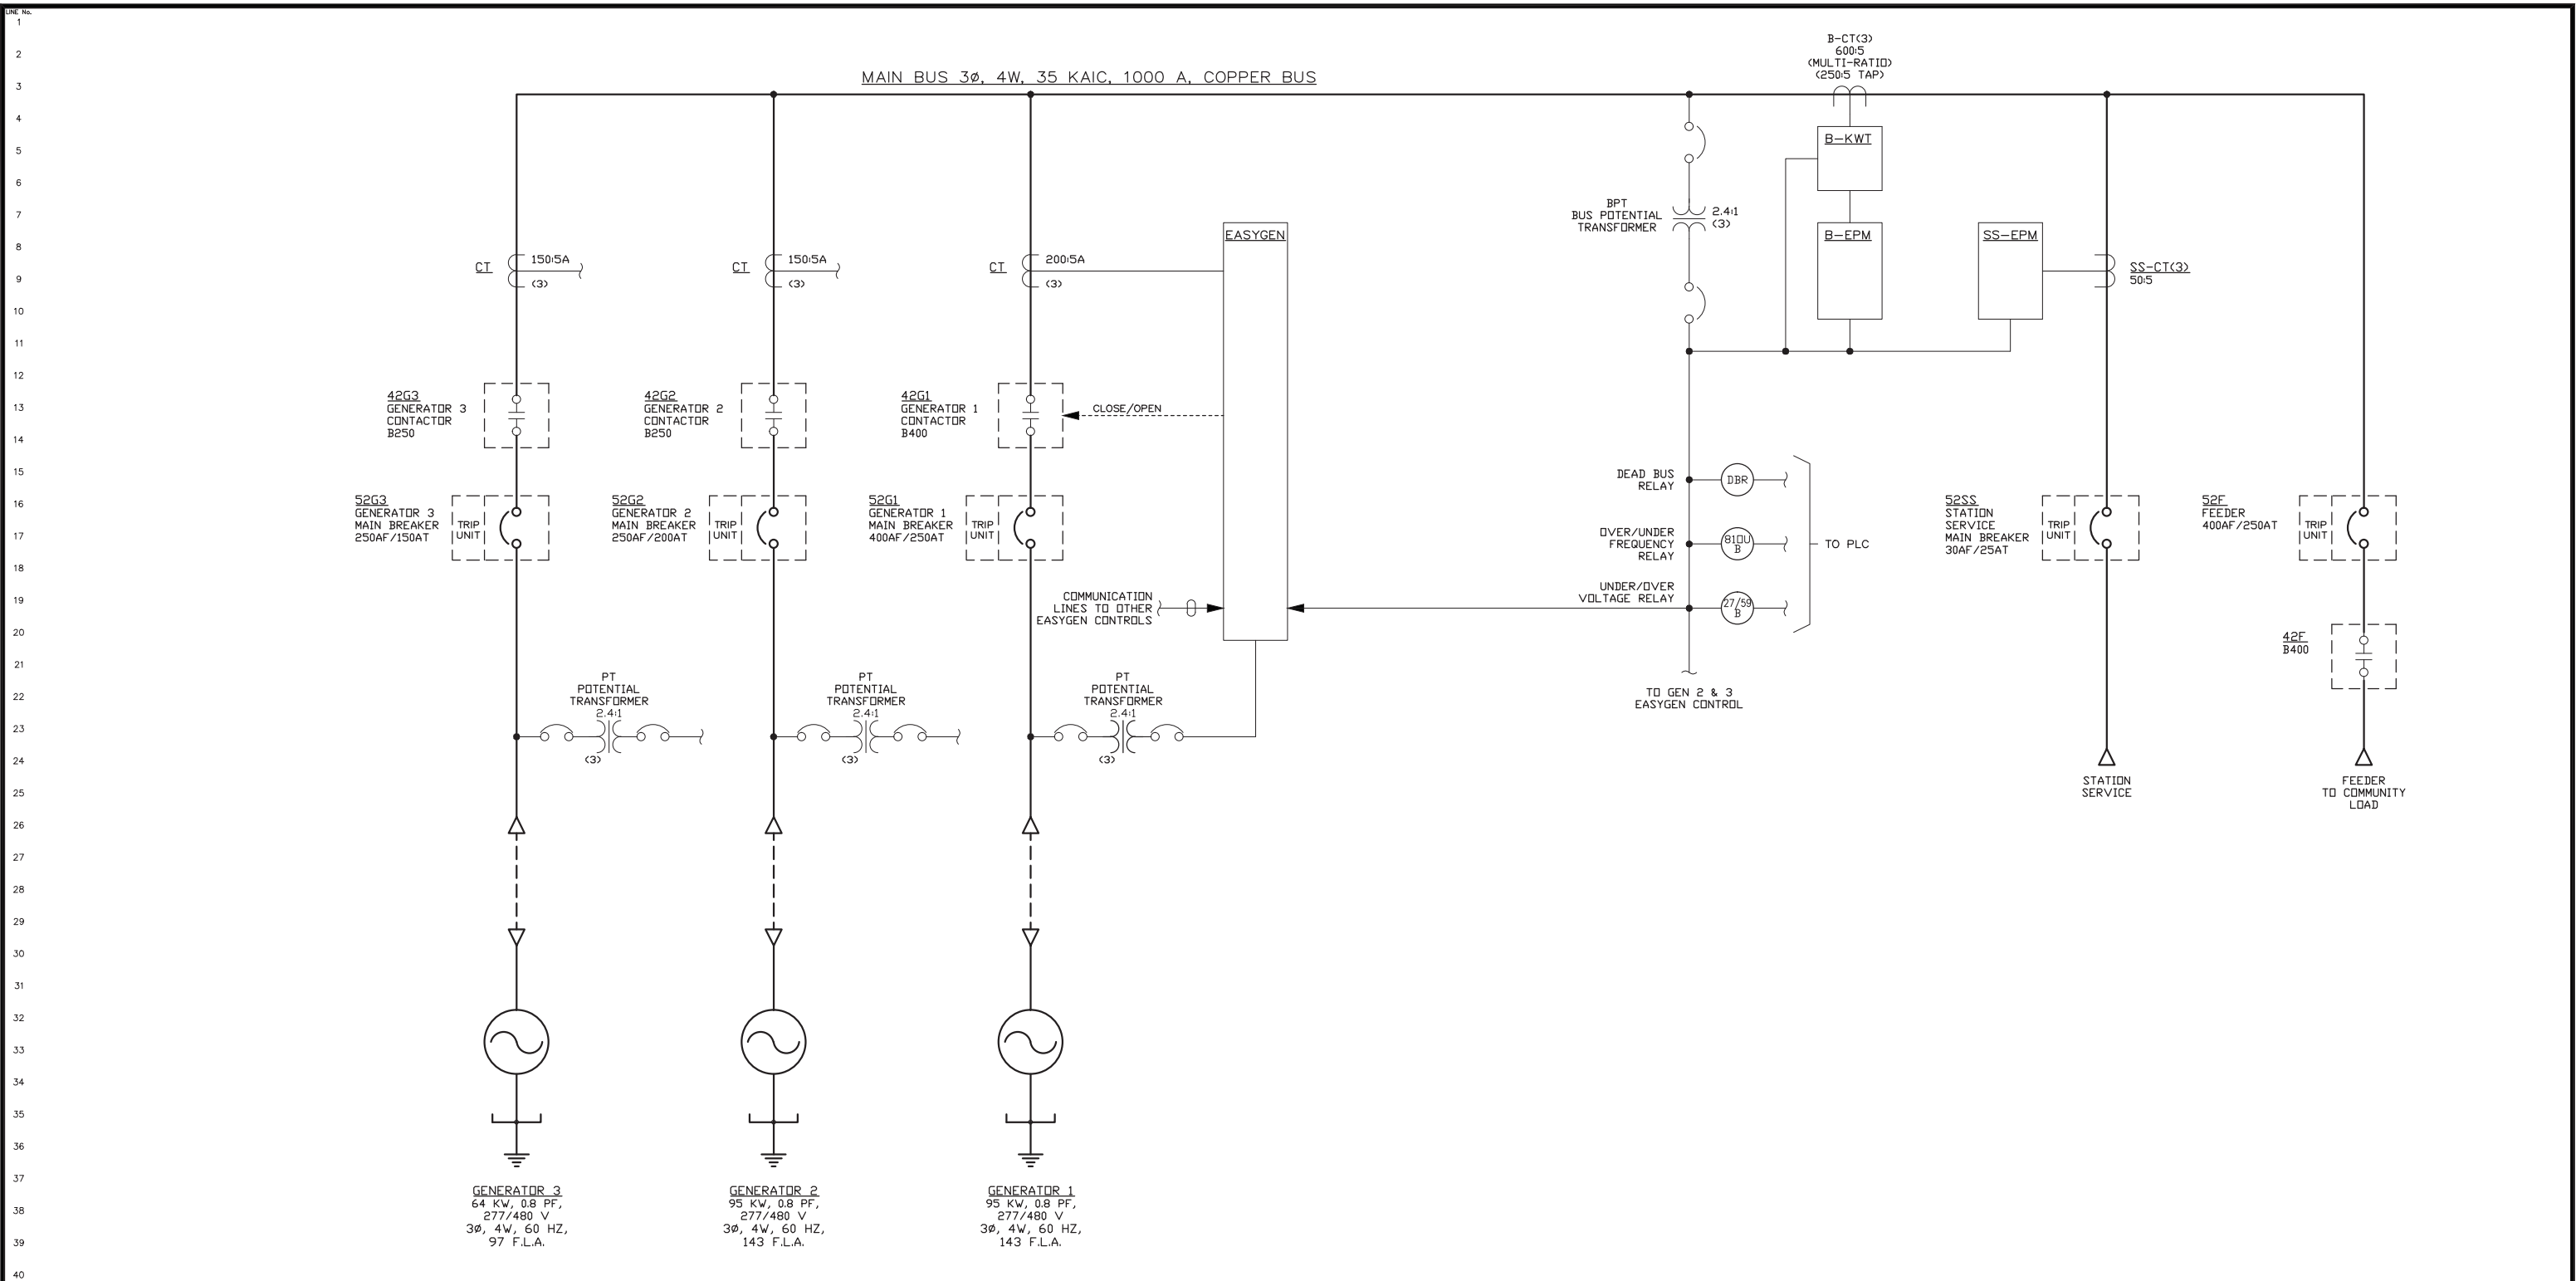

GENERATOR 3
 64 kW, 0.8 PF,
 277/480 V
 3Ø, 4W, 60 HZ,
 97 F.L.A.

GENERATOR 2
 95 kW, 0.8 PF,
 277/480 V
 3Ø, 4W, 60 HZ,
 143 F.L.A.

GENERATOR 1
 95 kW, 0.8 PF,
 277/480 V
 3Ø, 4W, 60 HZ,
 143 F.L.A.


NOTE:
 GENERATORS 2 & 3 SIMILAR TO GENERATOR 1.

REV.	DATE	DESCRIPTION	BY
B	09-21-16	AS BUILT	RAC
PURCHASE ORDER No. ERNIE BAUMGARTNER CONTROLLED POWER JOB No. 8438CC			
TITLE: GENERATOR SINGLE LINE, SCHEMATIC DIAGRAM			
SCALE: NONE	DATE: 08-23-16	DWN. BY: GPN	
DWG. No: 8438CC-5101-D	SHEET: 1 OF 1	CKD. BY: JMD	
JOB: CROOKED CREEK EASYGEN UPGRADE			

NOTICE
 THE DRAWINGS, INFORMATION AND SUBJECT MATTER HEREOF ARE THE CONFIDENTIAL, SOLE AND EXCLUSIVE PROPERTY OF CONTROLLED POWER, INC. AND ARE NOT TO BE COPIED, REPRODUCED OR USED IN ANY MANNER FOR ANY PURPOSE WHATSOEVER WITHOUT WRITTEN CONSENT OR DIRECTION.




ENGINEERED & MANUFACTURED BY
Controlled Power, Inc.
 BOTHELL, WASHINGTON USA
 (425)-485-1778 www.controlledpowerinc.com

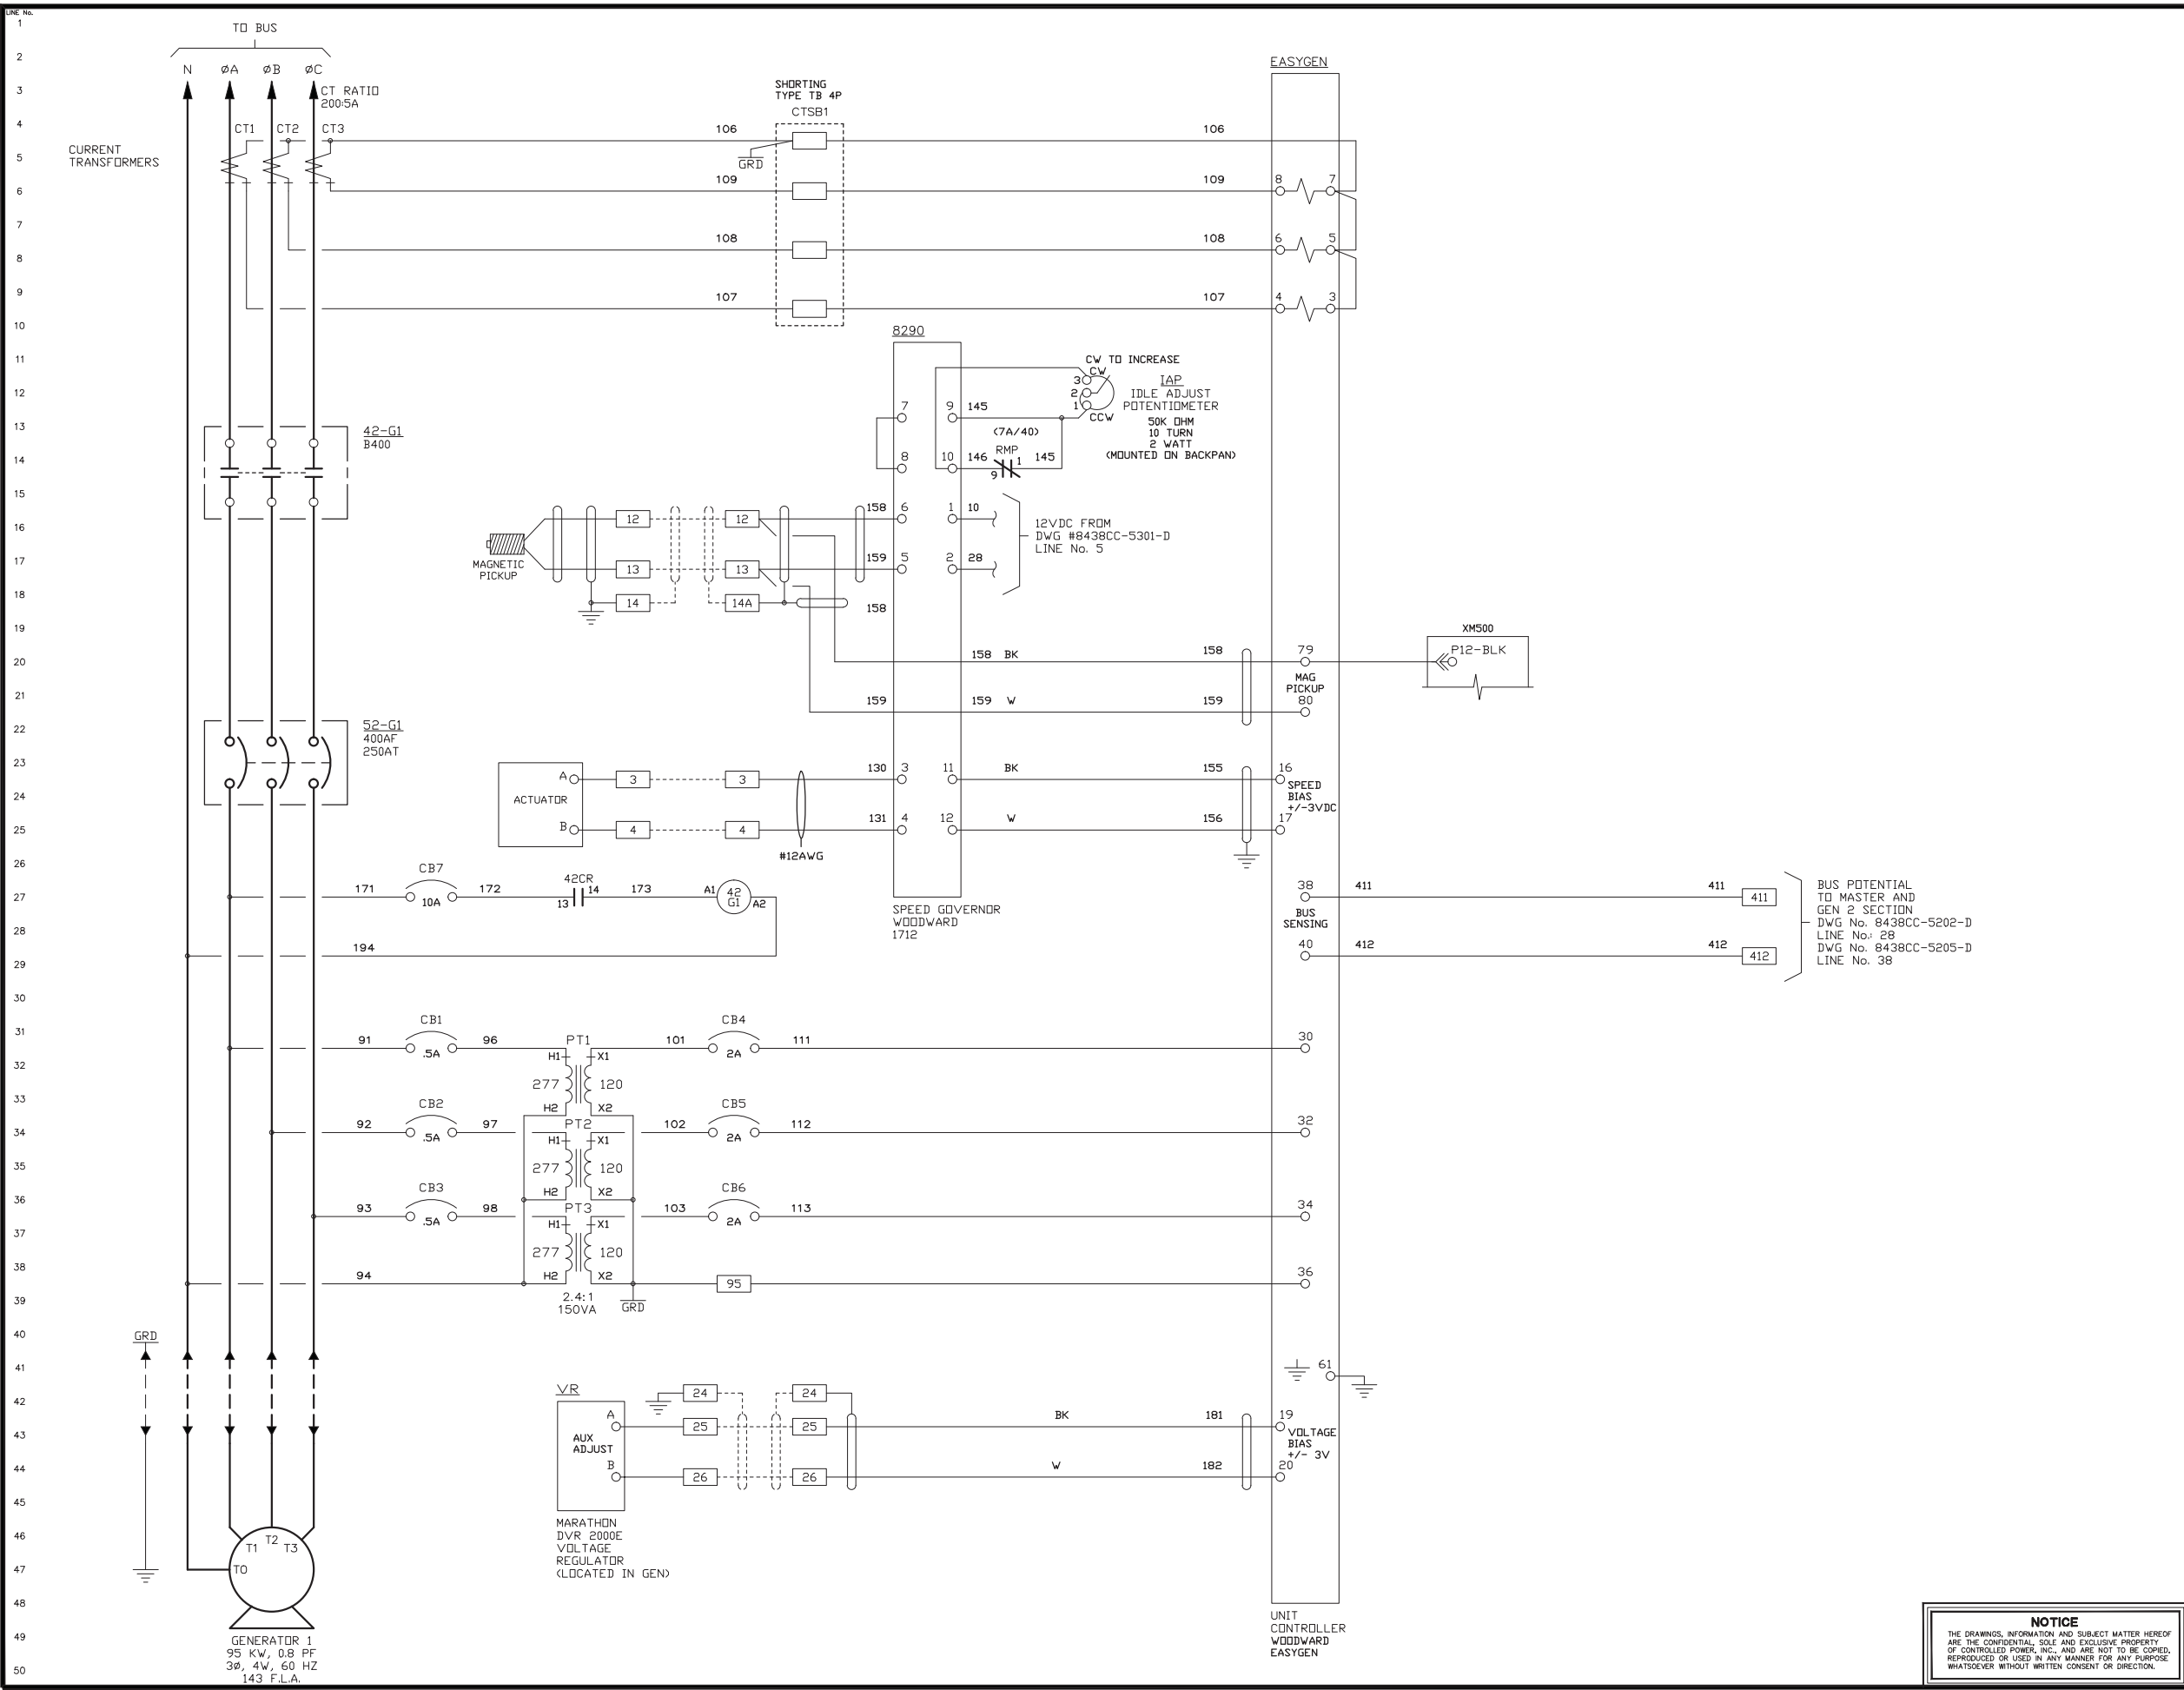

REV.	DATE	DESCRIPTION	BY
B	09-21-16	AS BUILT	RAC
PURCHASE ORDER No. ERNIE BAUMGARTNER CONTROLLED POWER JOB No. 8438CC			
TITLE: GENERATOR 1 AC THREE LINE, SCHEMATIC DIAGRAM			
SCALE: NONE	DATE: 08-23-16	DWN. BY: GPN	
DWG. No: 8438CC-5201-D	SHEET: 1 OF 1	CKD. BY: JMD	
JOB: CROOKED CREEK EASYGEN UPGRADE			

NOTICE
THE DRAWINGS, INFORMATION AND SUBJECT MATTER HEREOF ARE THE CONFIDENTIAL, SOLE AND EXCLUSIVE PROPERTY OF CONTROLLED POWER, INC., AND ARE NOT TO BE COPIED, REPRODUCED OR USED IN ANY MANNER FOR ANY PURPOSE WHATSOEVER WITHOUT WRITTEN CONSENT OR DIRECTION.

ENGINEERED & MANUFACTURED BY
Controlled Power, Inc.
BOTHELL, WASHINGTON USA
(425)-485-1778 www.controlledpowerinc.com

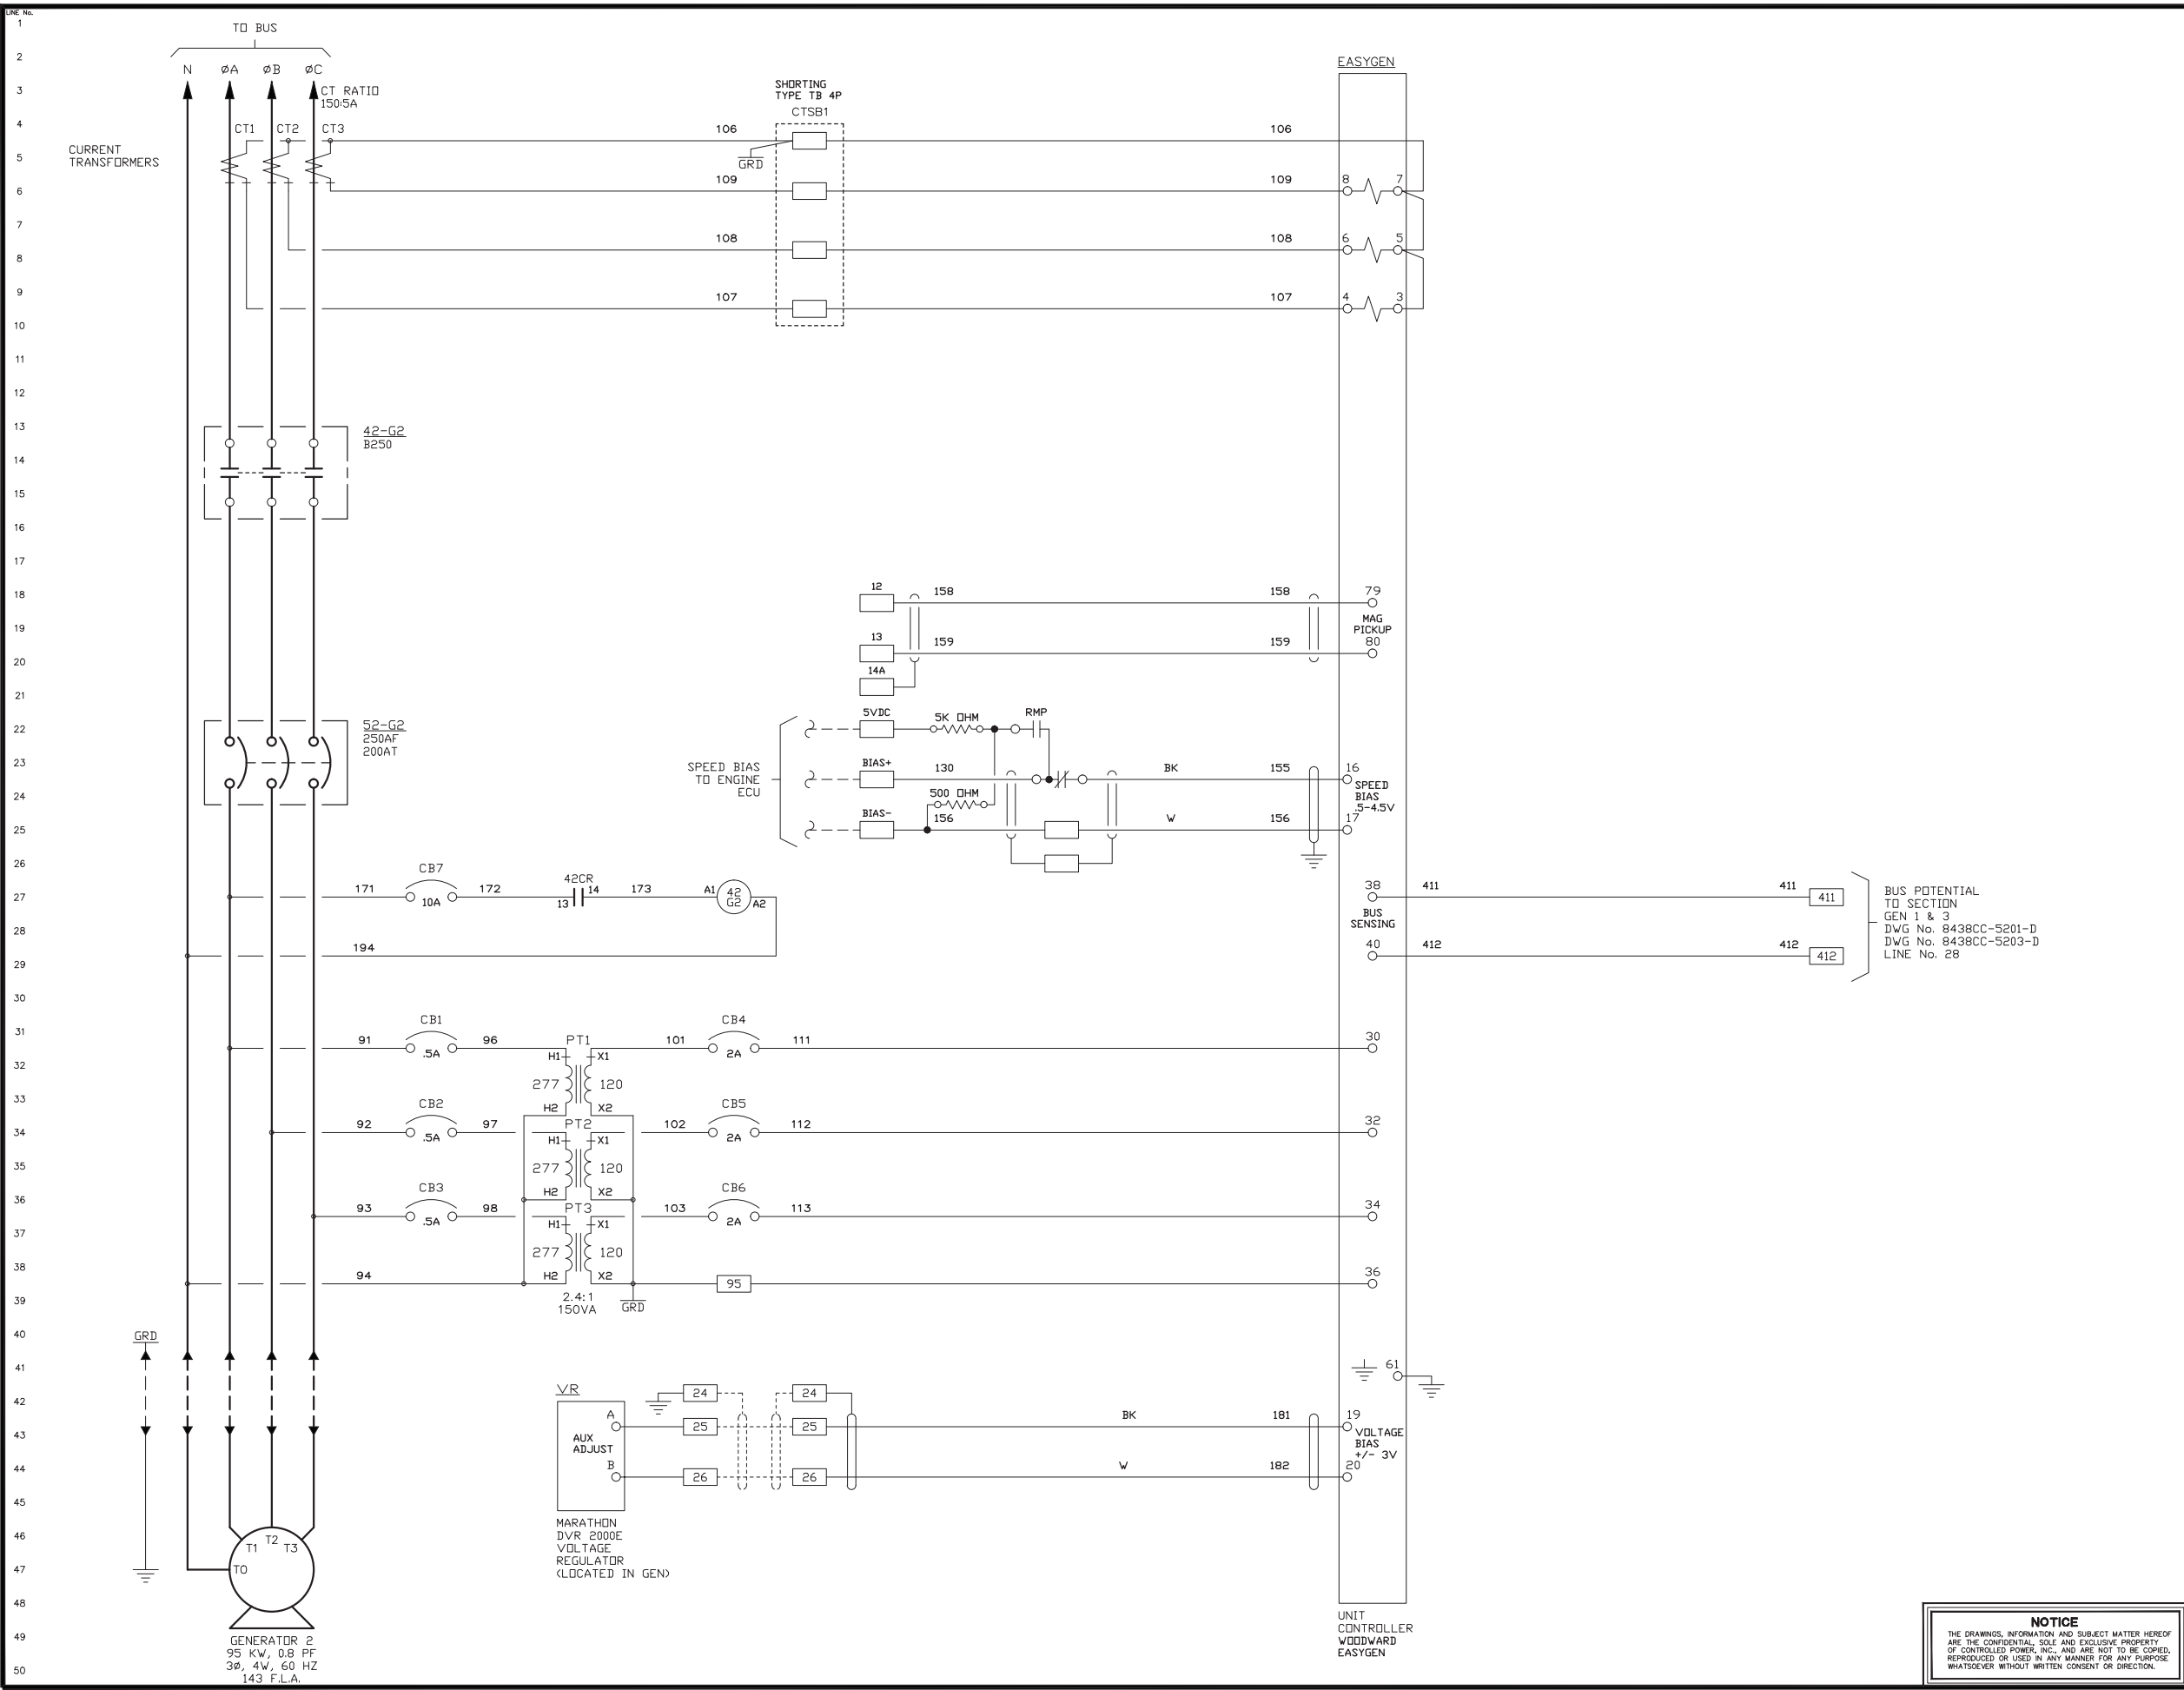


BUS POTENTIAL
TO SECTION
GEN 1 & 3
DWG No. 8438CC-5201-D
DWG No. 8438CC-5203-D
LINE No. 28

REV.	DATE	DESCRIPTION	BY
B	09-21-16	AS BUILT	RAC
PURCHASE ORDER No. ERNIE BAUMGARTNER CONTROLLED POWER JOB No. 8438CC			
TITLE: GENERATOR 2 AC THREE LINE, SCHEMATIC DIAGRAM			
SCALE: NONE	DATE: 08-23-16	DWN. BY: GPN	
DWG. No: 8438CC-5202-D	SHEET: 1 OF 1	CKD. BY: JMD	
JOB: CROOKED CREEK EASYGEN UPGRADE			

NOTICE
THE DRAWINGS, INFORMATION AND SUBJECT MATTER HEREOF ARE THE CONFIDENTIAL, SOLE AND EXCLUSIVE PROPERTY OF CONTROLLED POWER, INC., AND ARE NOT TO BE COPIED, REPRODUCED OR USED IN ANY MANNER FOR ANY PURPOSE WHATSOEVER WITHOUT WRITTEN CONSENT OR DIRECTION.


ENGINEERED & MANUFACTURED BY
Controlled Power, Inc.
BOTHELL, WASHINGTON USA
(425)-485-1778 www.controlleddpowerinc.com

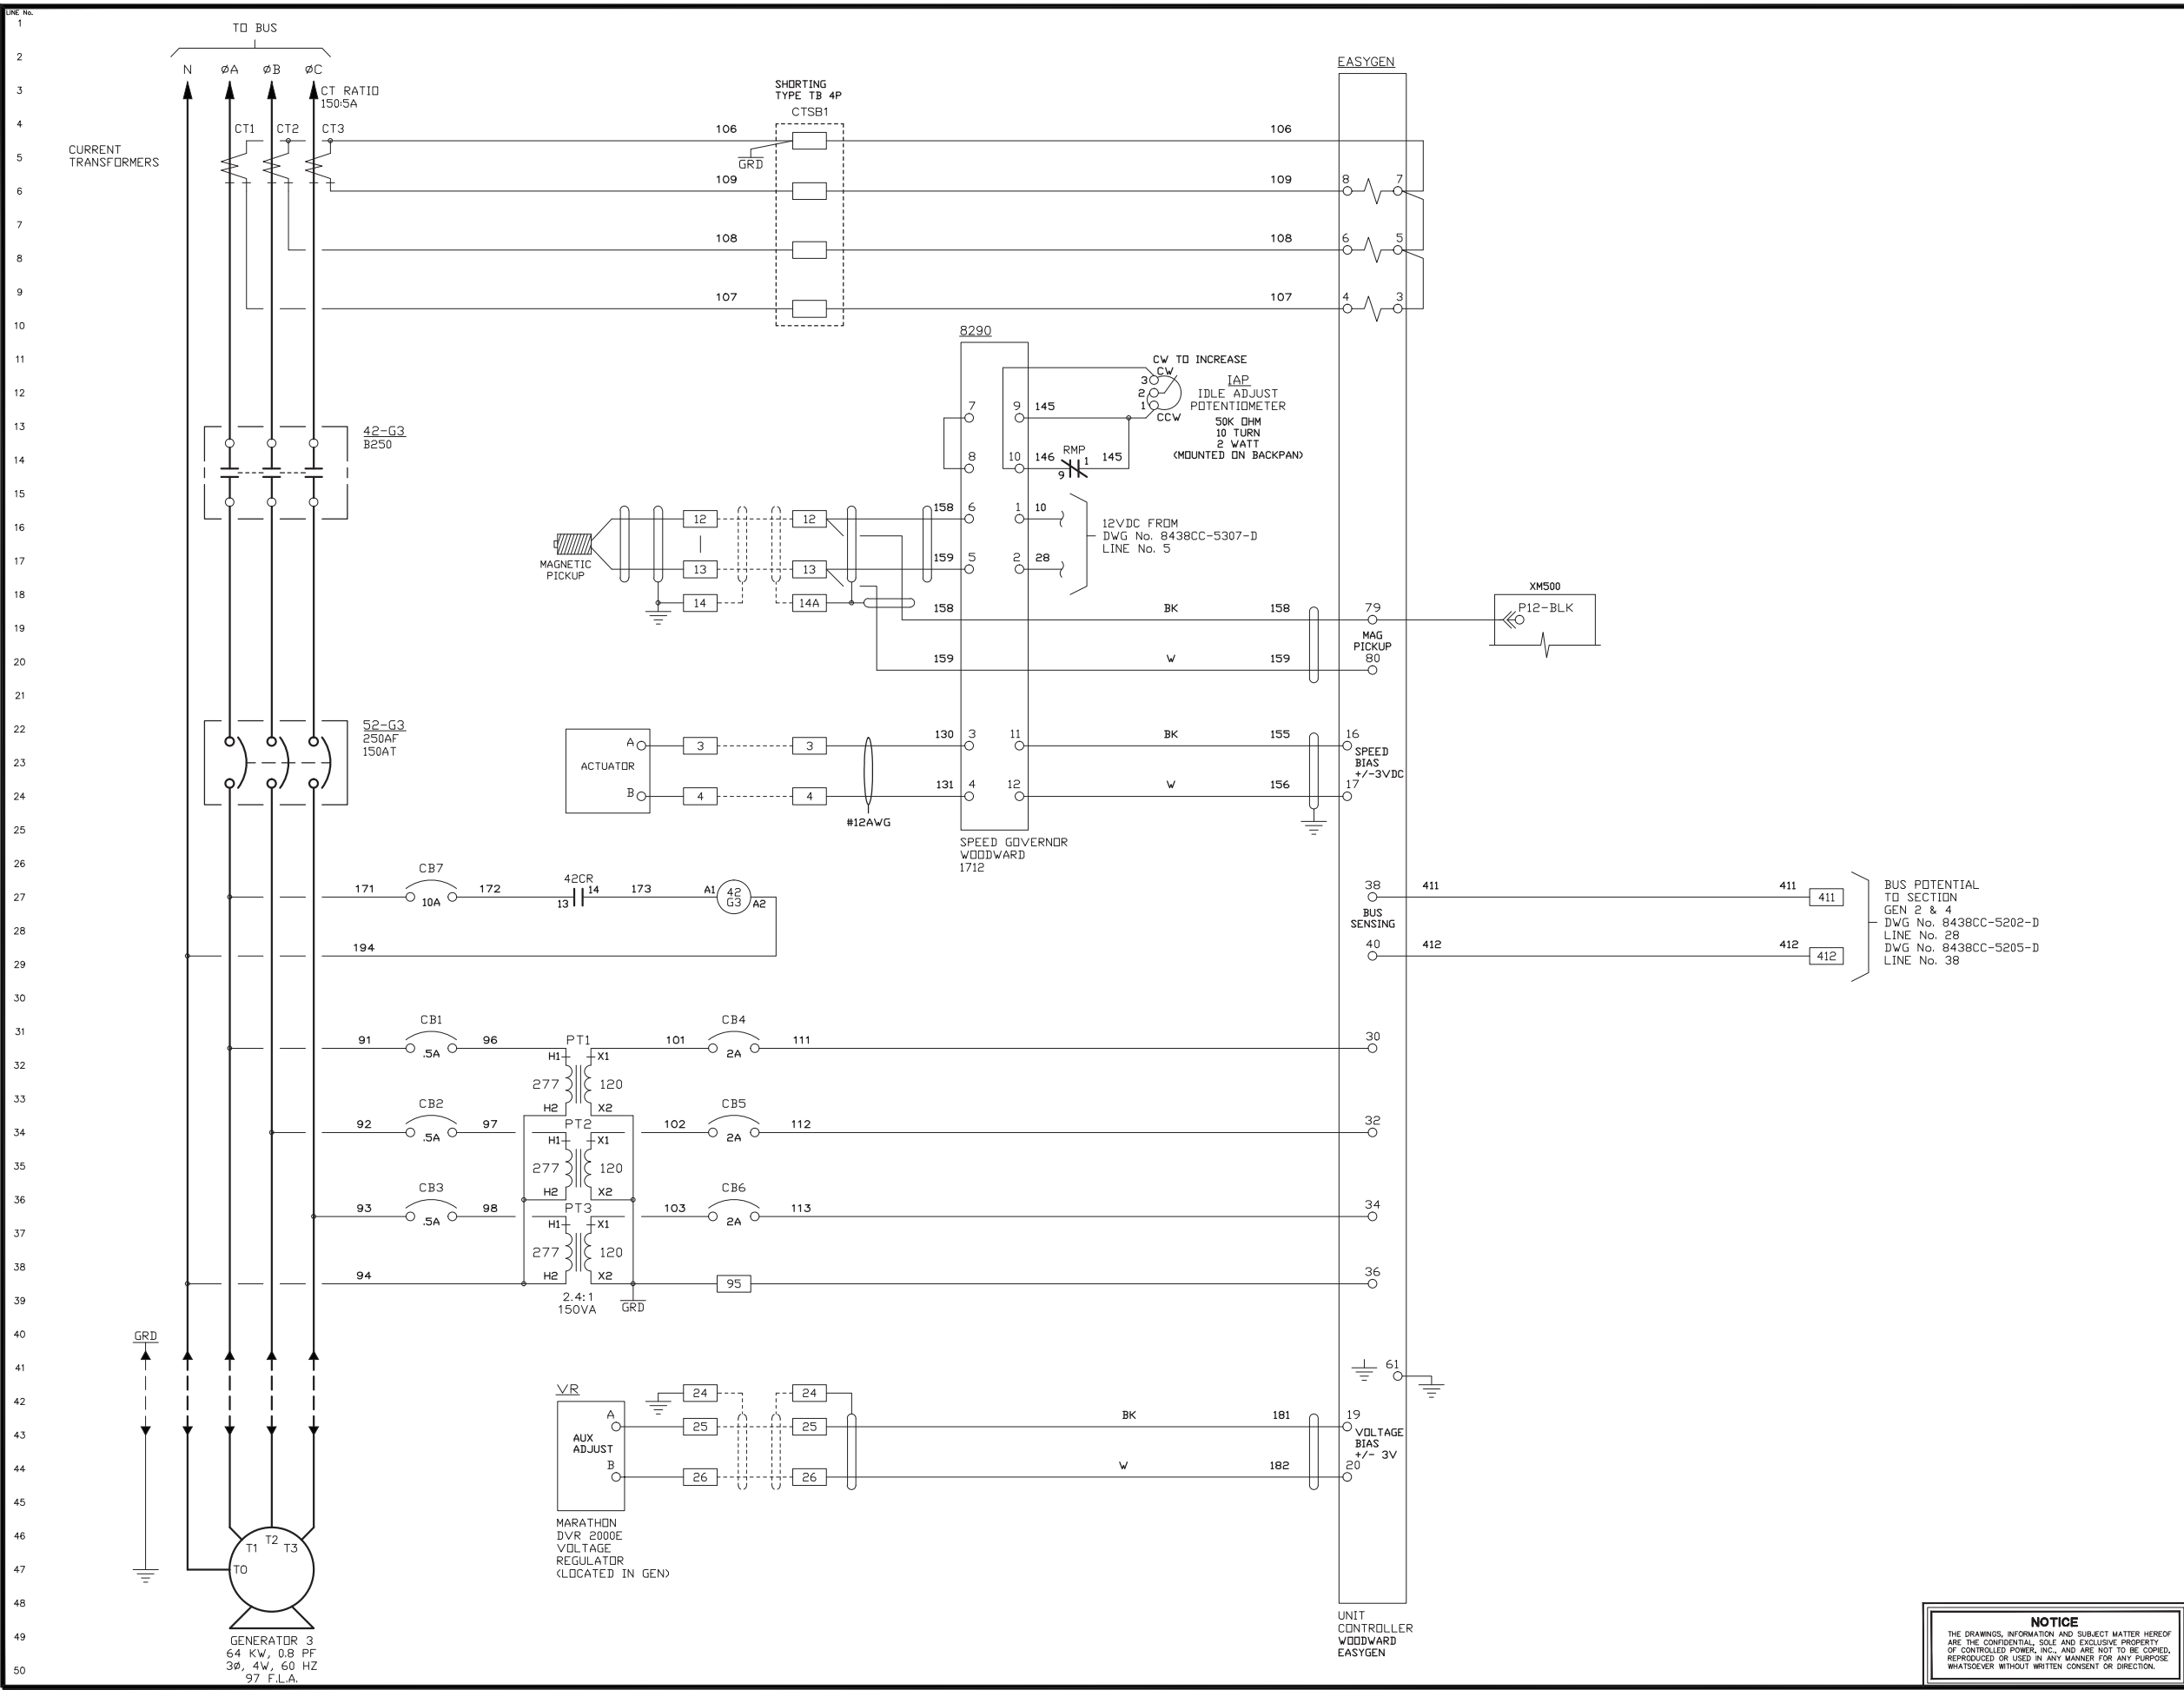

REV.	DATE	DESCRIPTION	BY
B	09-21-16	AS BUILT	RAC
PURCHASE ORDER No. ERNIE BAUMGARTNER CONTROLLED POWER JOB No. 8438CC			
TITLE: GENERATOR 3 AC THREE LINE, SCHEMATIC DIAGRAM			
SCALE: NONE	DATE: 08-23-16	DWN. BY: GPN	
DWG. No: 8438CC-5203-D	SHEET: 1 OF 1	CKD. BY: JMD	
JOB: CROOKED CREEK EASYGEN UPGRADE			

NOTICE
 THE DRAWINGS, INFORMATION AND SUBJECT MATTER HEREOF ARE THE CONFIDENTIAL, SOLE AND EXCLUSIVE PROPERTY OF CONTROLLED POWER, INC., AND ARE NOT TO BE COPIED, REPRODUCED OR USED IN ANY MANNER FOR ANY PURPOSE WHATSOEVER WITHOUT WRITTEN CONSENT OR DIRECTION.



ENGINEERED & MANUFACTURED BY
Controlled Power, Inc.
 BOTHELL, WASHINGTON USA
 (425)-485-1778 www.controlledpowerinc.com

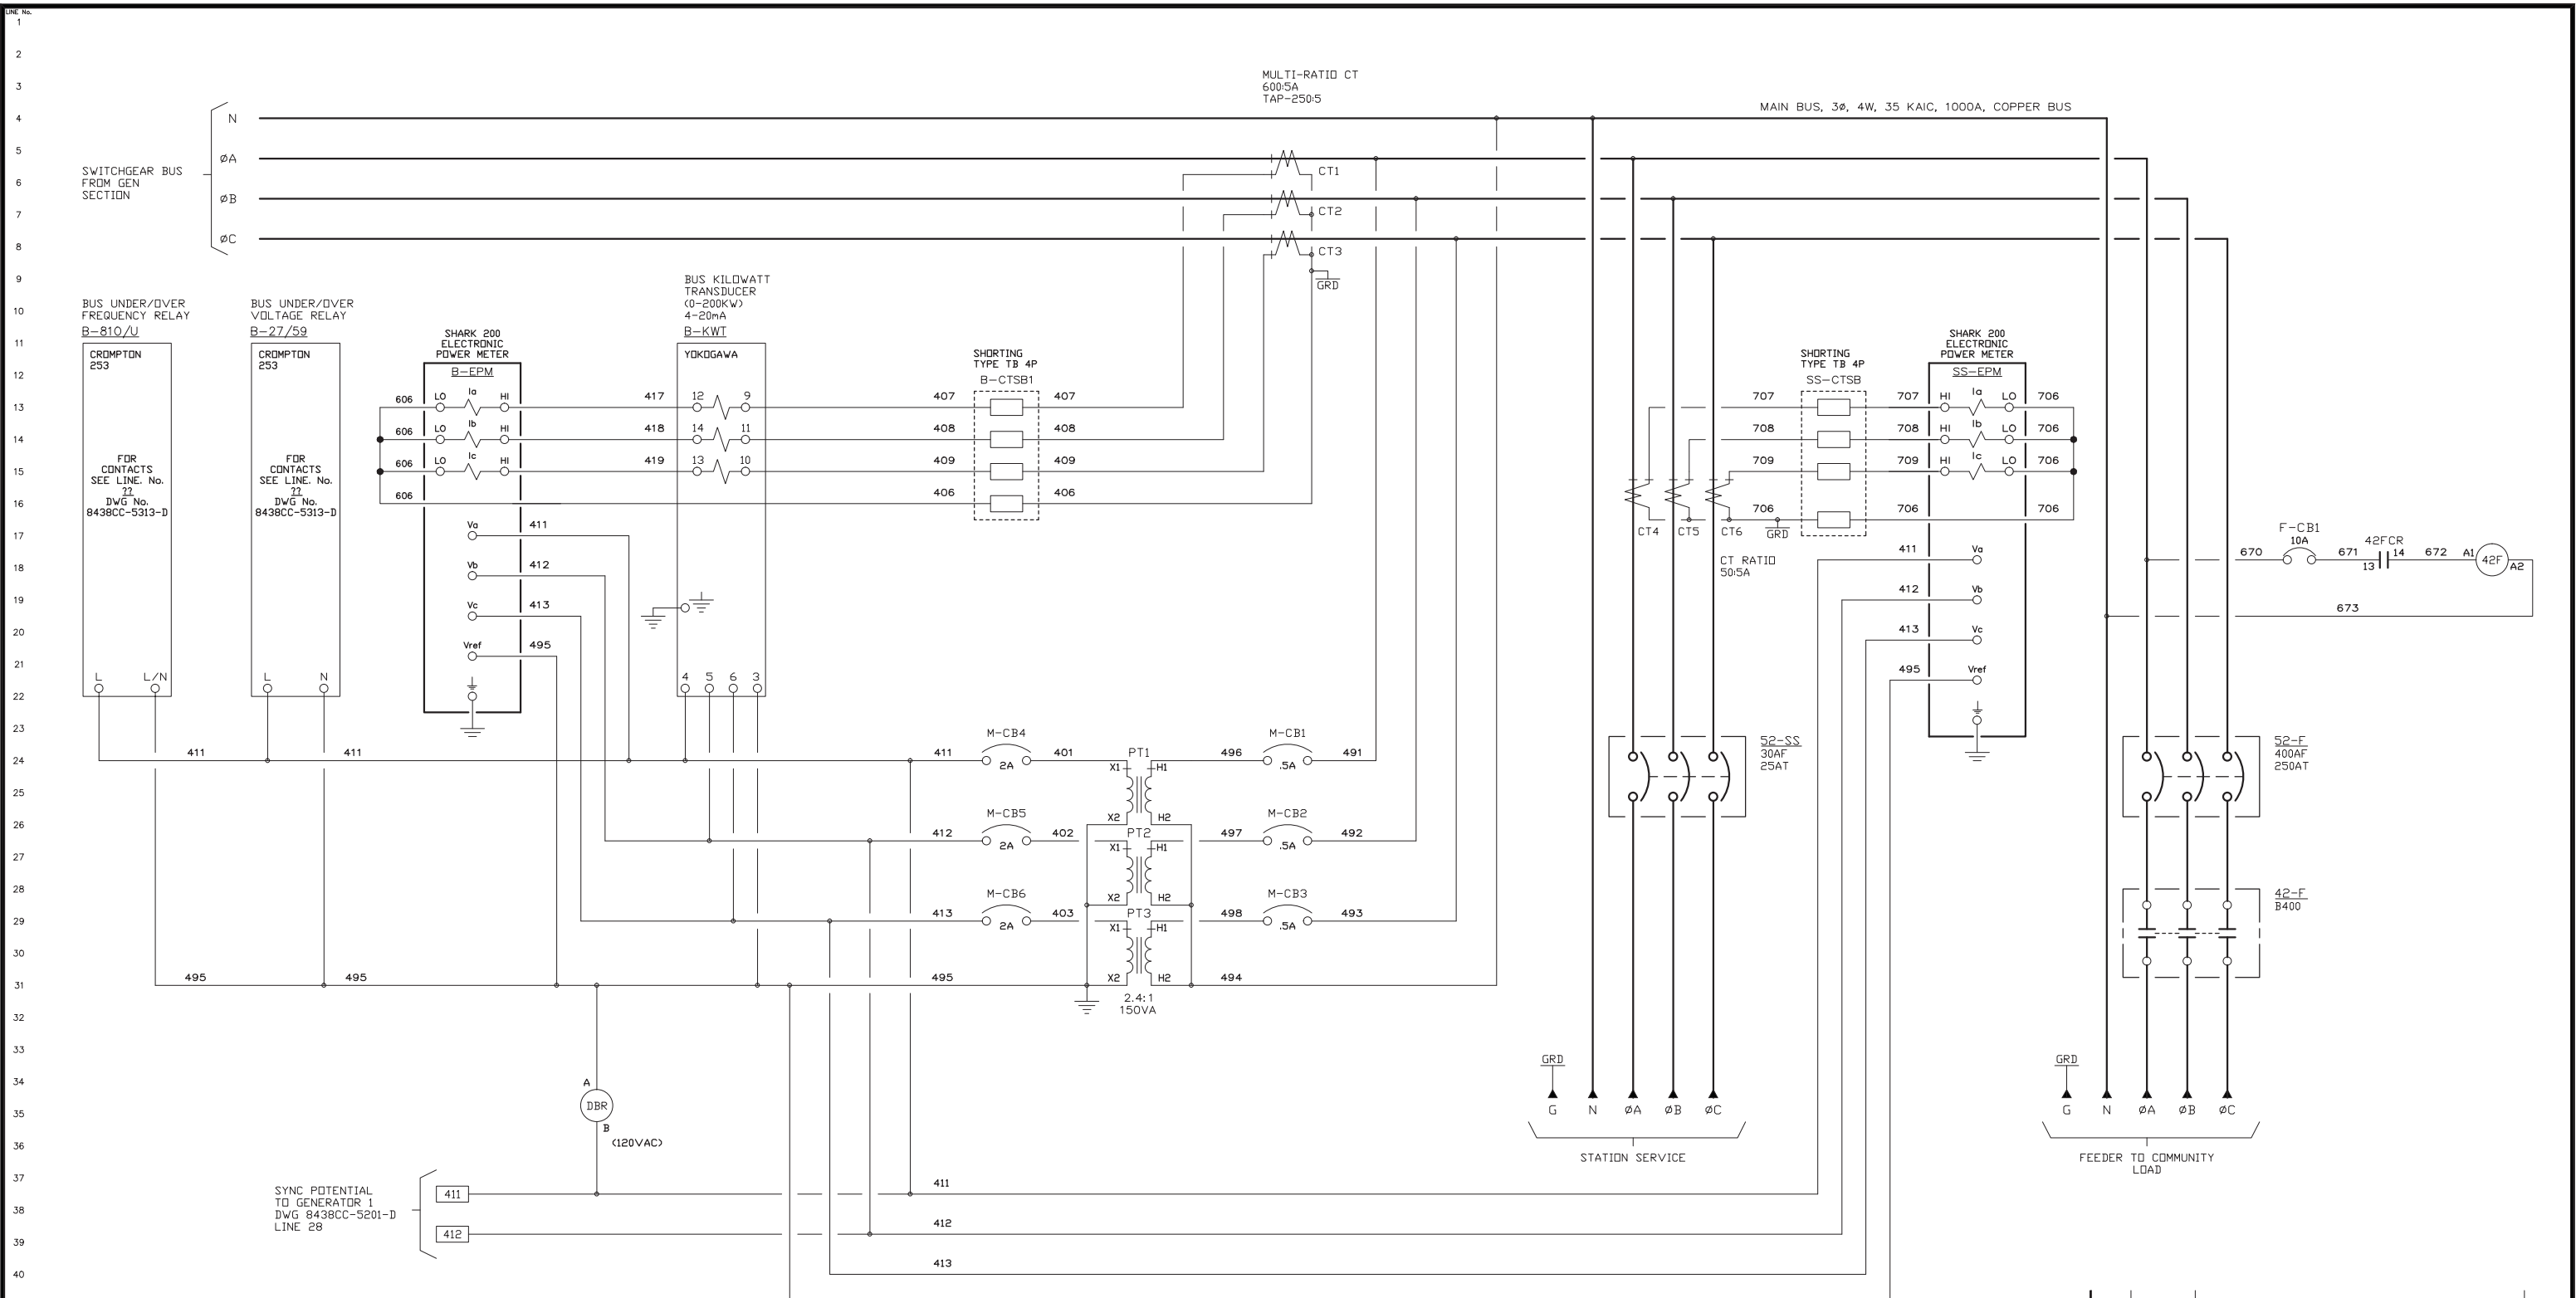

REV.	DATE	DESCRIPTION	BY
B	09-21-16	AS BUILT	RAC
PURCHASE ORDER No. ERNIE BAUMGARTNER CONTROLLED POWER JOB No. 8438CC			
TITLE: MASTER AC THREE LINE, SCHEMATIC DIAGRAM			
SCALE: NONE	DATE: 08-23-16	DWN. BY: GPN	
DWG. No: 8438CC-5205-D	SHEET: 1 OF 1	CKD. BY: JMD	
JOB: CROOKED CREEK EASYGEN UPGRADE			

NOTICE
 THE DRAWINGS, INFORMATION AND SUBJECT MATTER HEREOF ARE THE CONFIDENTIAL, SOLE AND EXCLUSIVE PROPERTY OF CONTROLLED POWER, INC., AND ARE NOT TO BE COPIED, REPRODUCED OR USED IN ANY MANNER FOR ANY PURPOSE WHATSOEVER WITHOUT WRITTEN CONSENT OR DIRECTION.



ENGINEERED & MANUFACTURED BY
Controlled Power, Inc.
 BOTHELL, WASHINGTON USA
 (425)-485-1778 www.controlledpowerinc.com

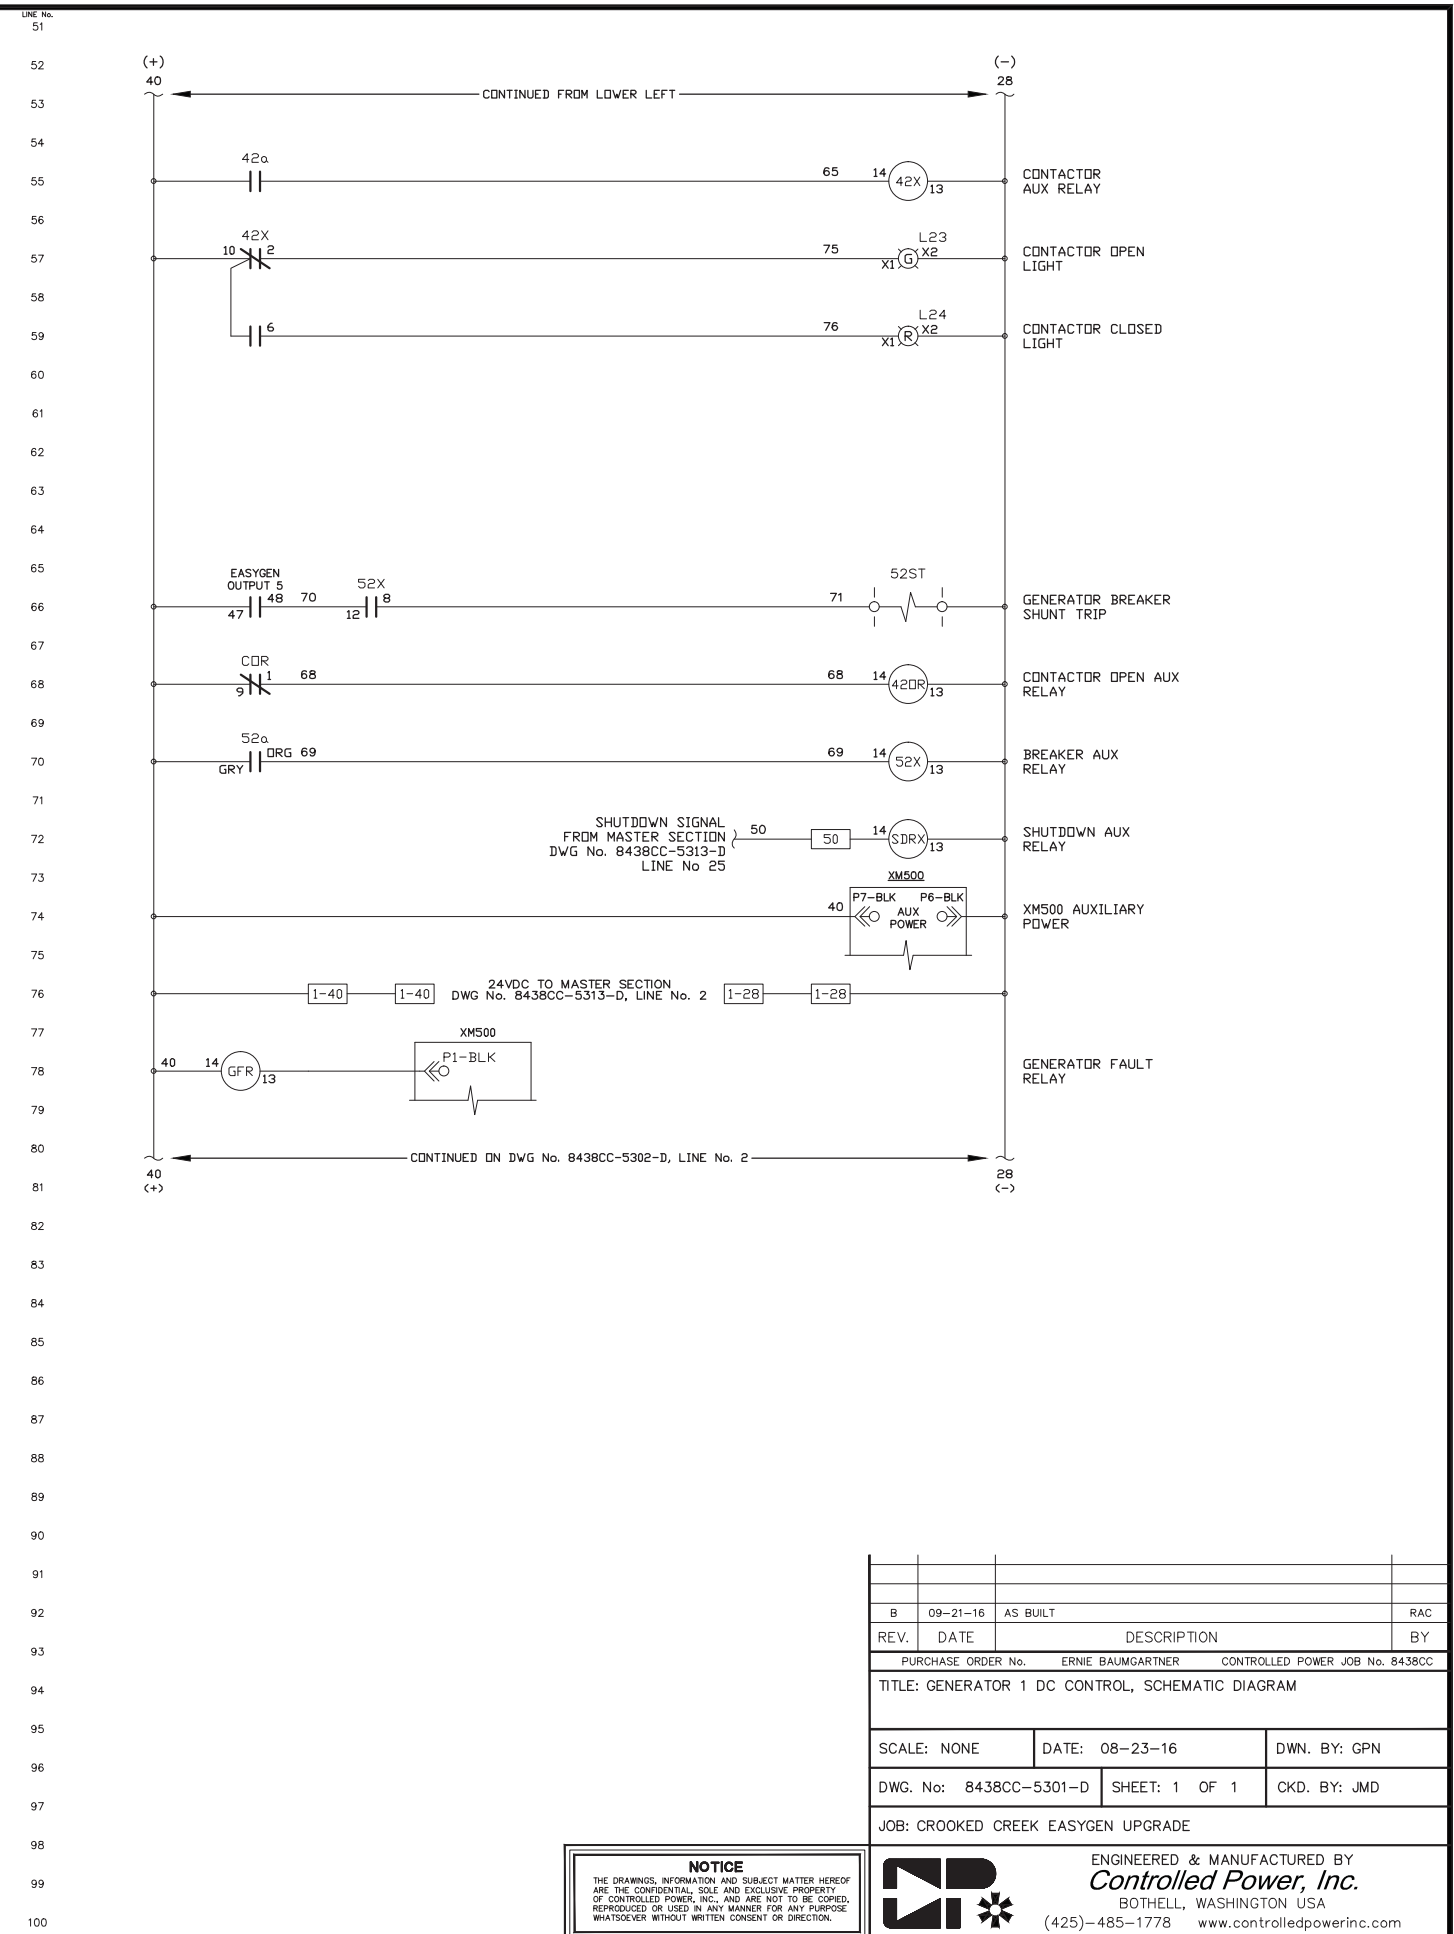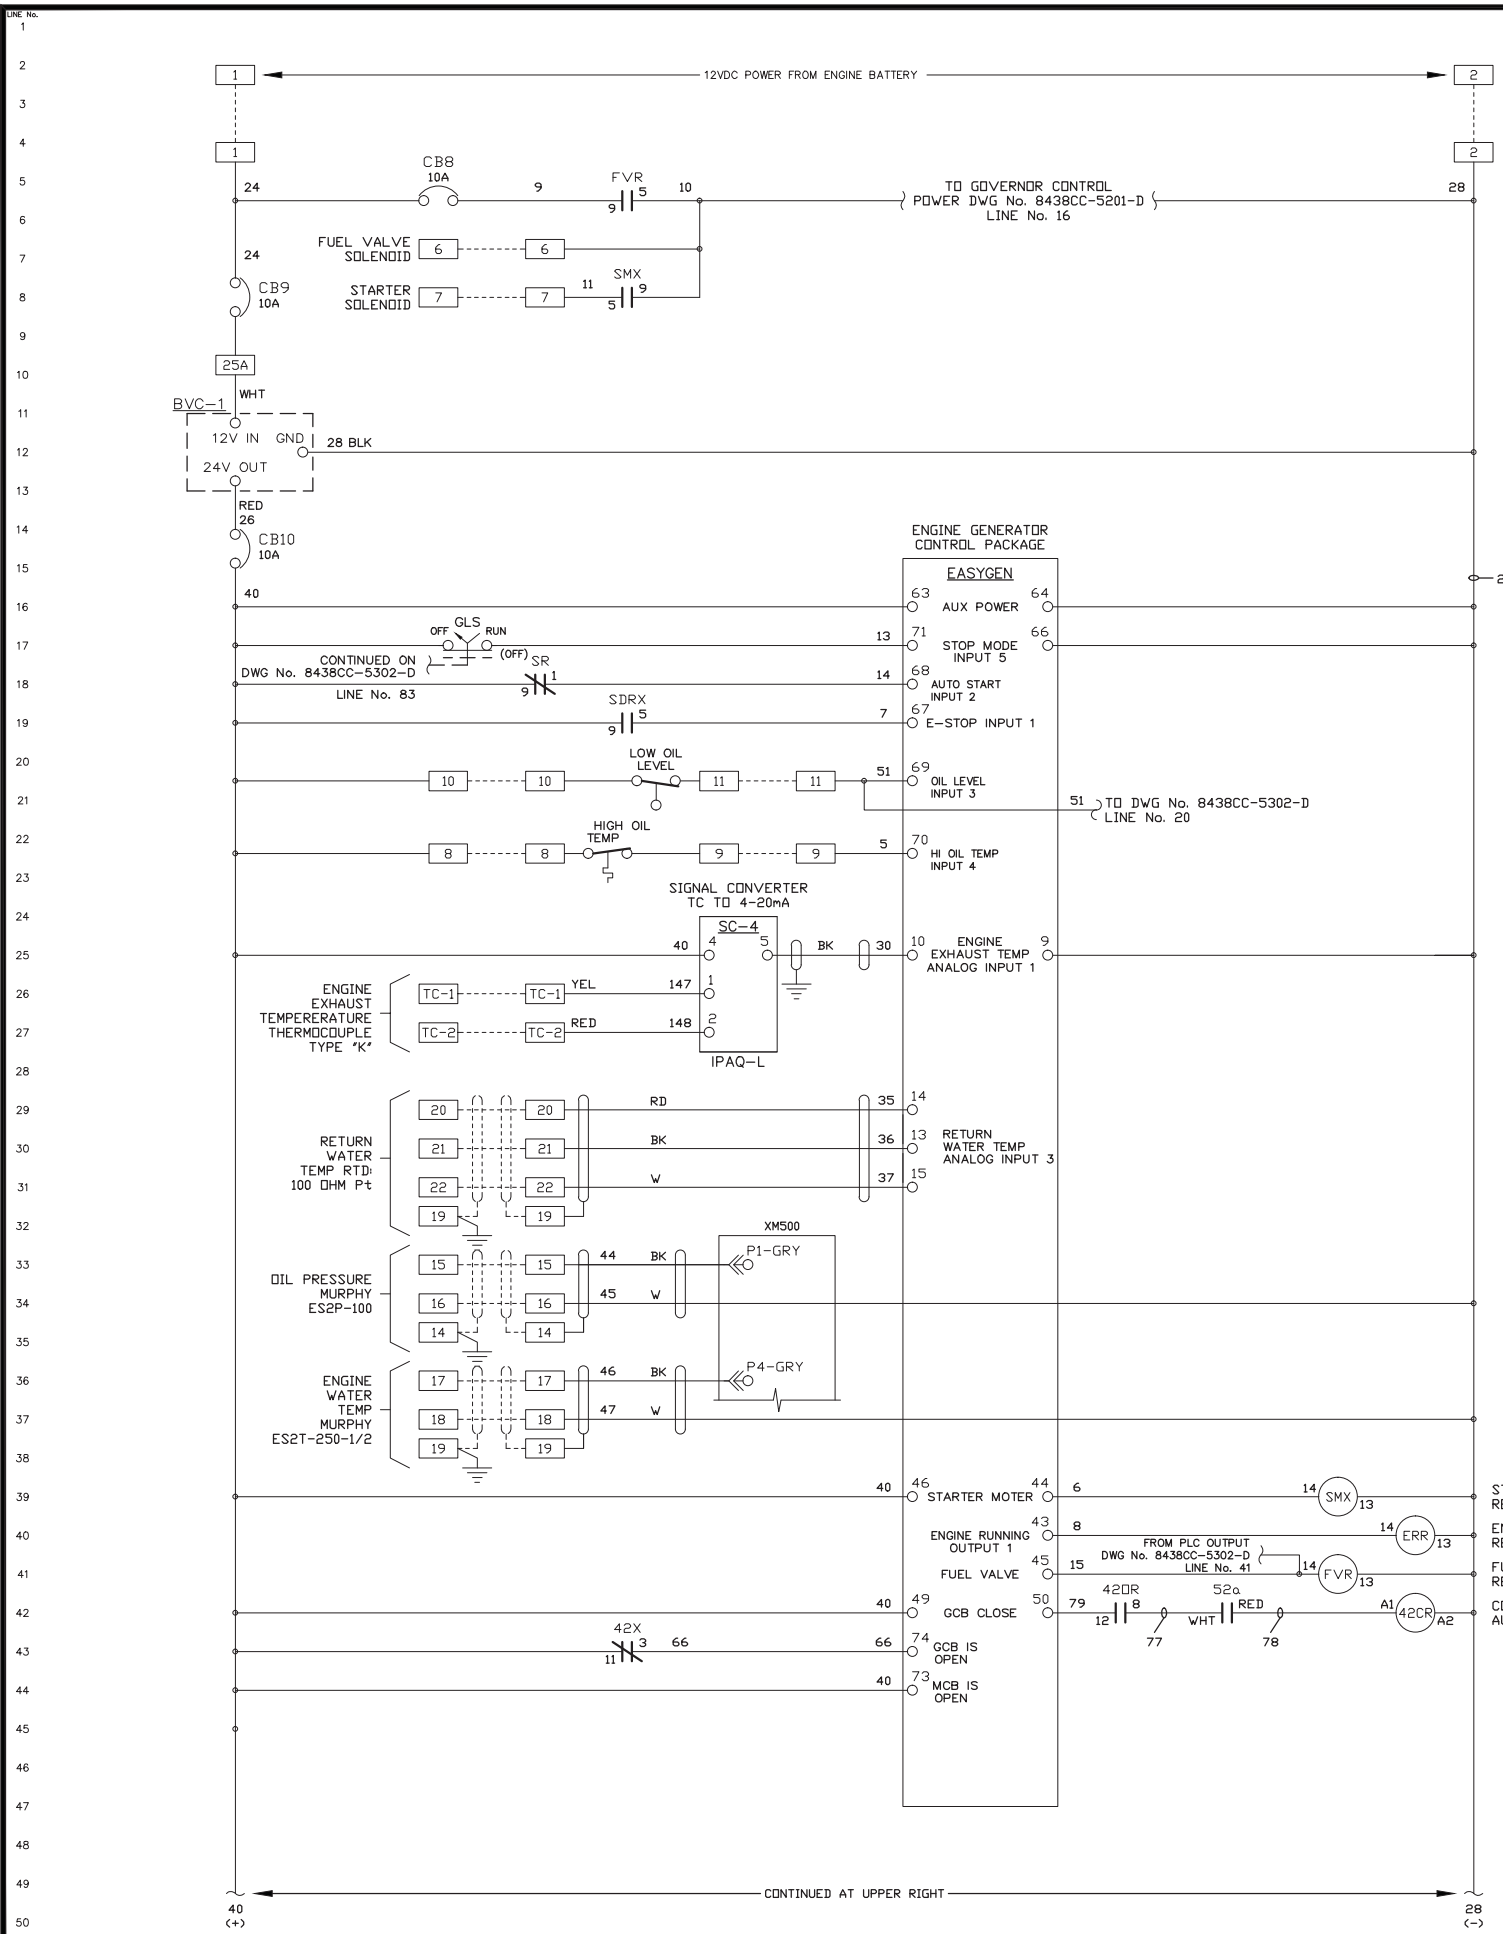

REV.	DATE	DESCRIPTION	BY
B	09-21-16	AS BUILT	RAC
PURCHASE ORDER No. ERNIE BAUMGARTNER CONTROLLED POWER JOB No. 8438CC			
TITLE: GENERATOR 1 DC CONTROL, SCHEMATIC DIAGRAM			
SCALE: NONE	DATE: 08-23-16	DWN. BY: GPN	
DWG. No: 8438CC-5301-D	SHEET: 1 OF 1	CKD. BY: JMD	
JOB: CROOKED CREEK EASYGEN UPGRADE			

NOTICE
THE DRAWINGS, INFORMATION AND SUBJECT MATTER HEREOF ARE THE CONFIDENTIAL, SOLE AND EXCLUSIVE PROPERTY OF CONTROLLED POWER, INC., AND ARE NOT TO BE COPIED, REPRODUCED OR USED IN ANY MANNER FOR ANY PURPOSE WHATSOEVER WITHOUT WRITTEN CONSENT OR DIRECTION.



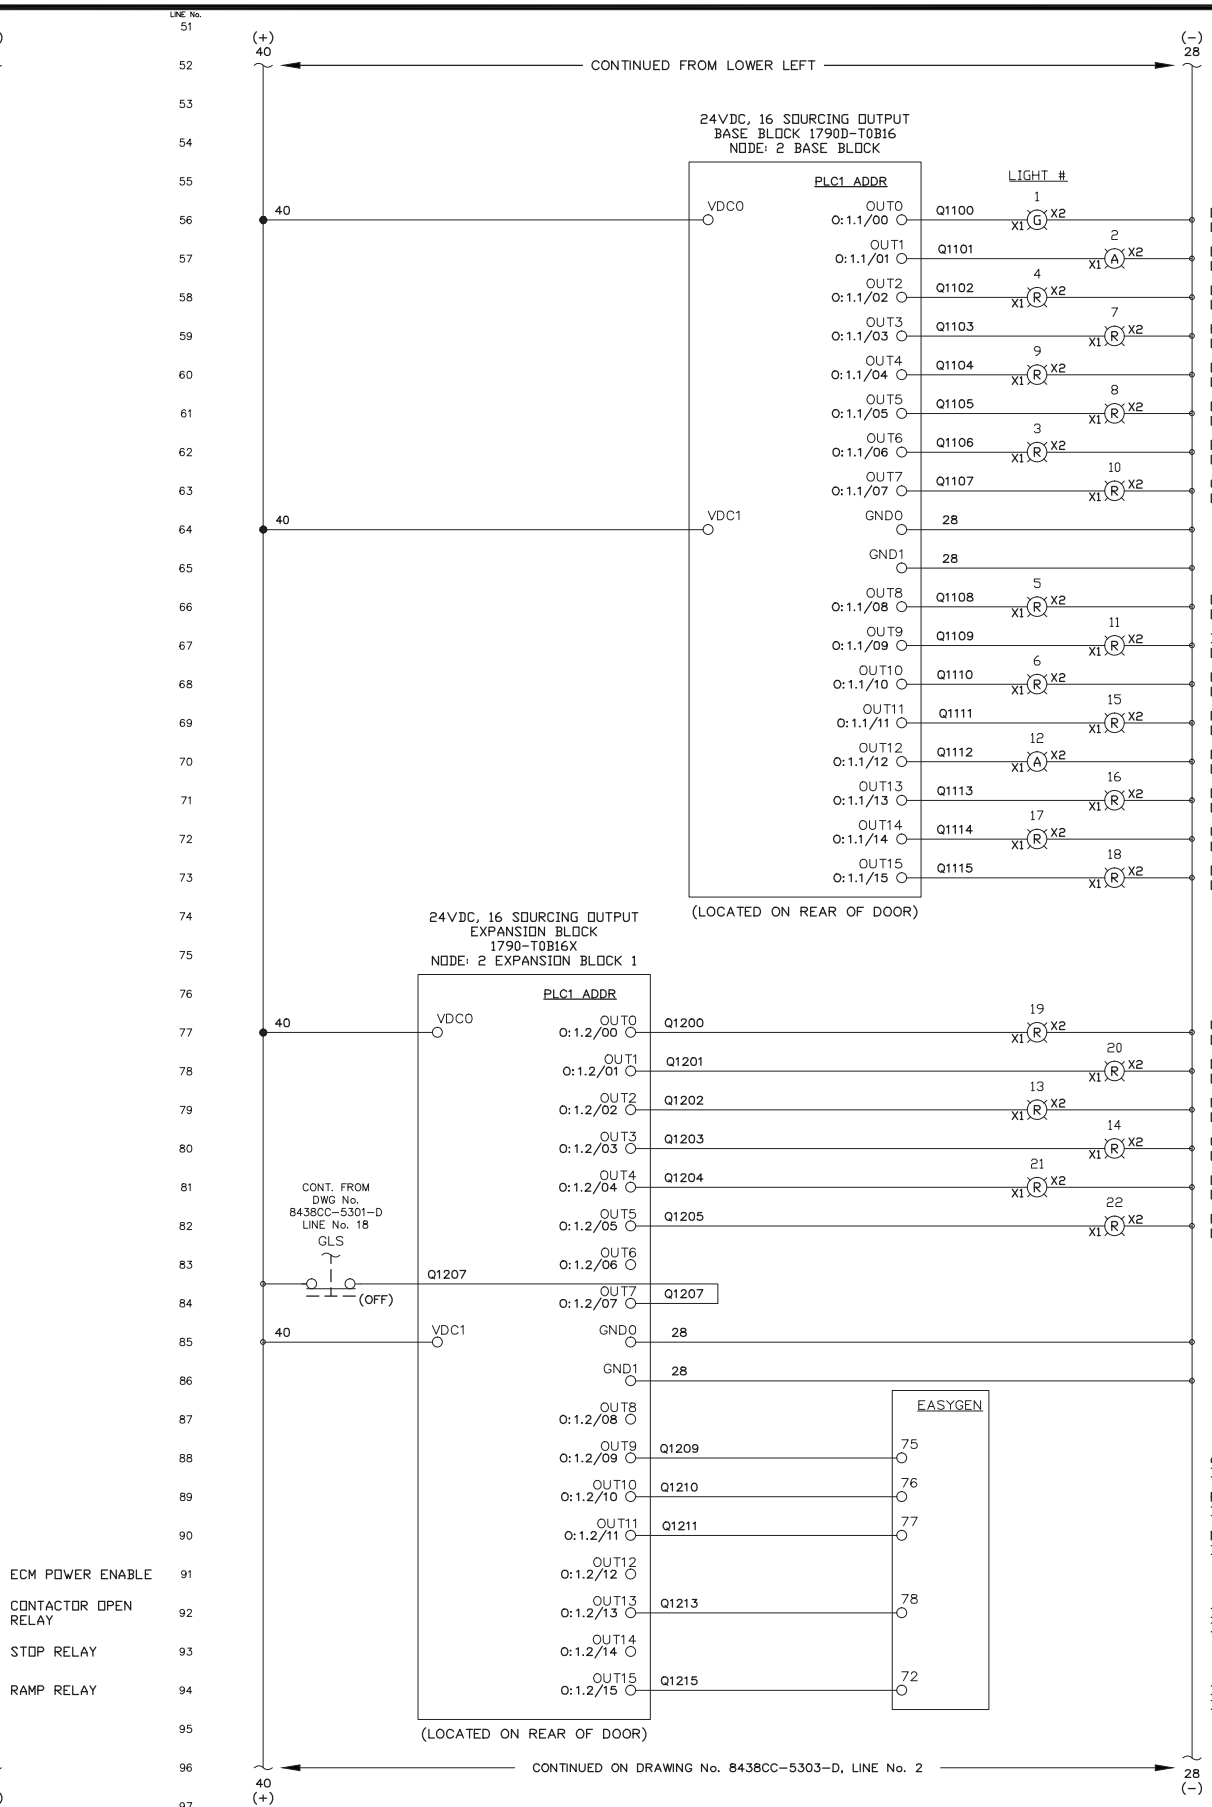
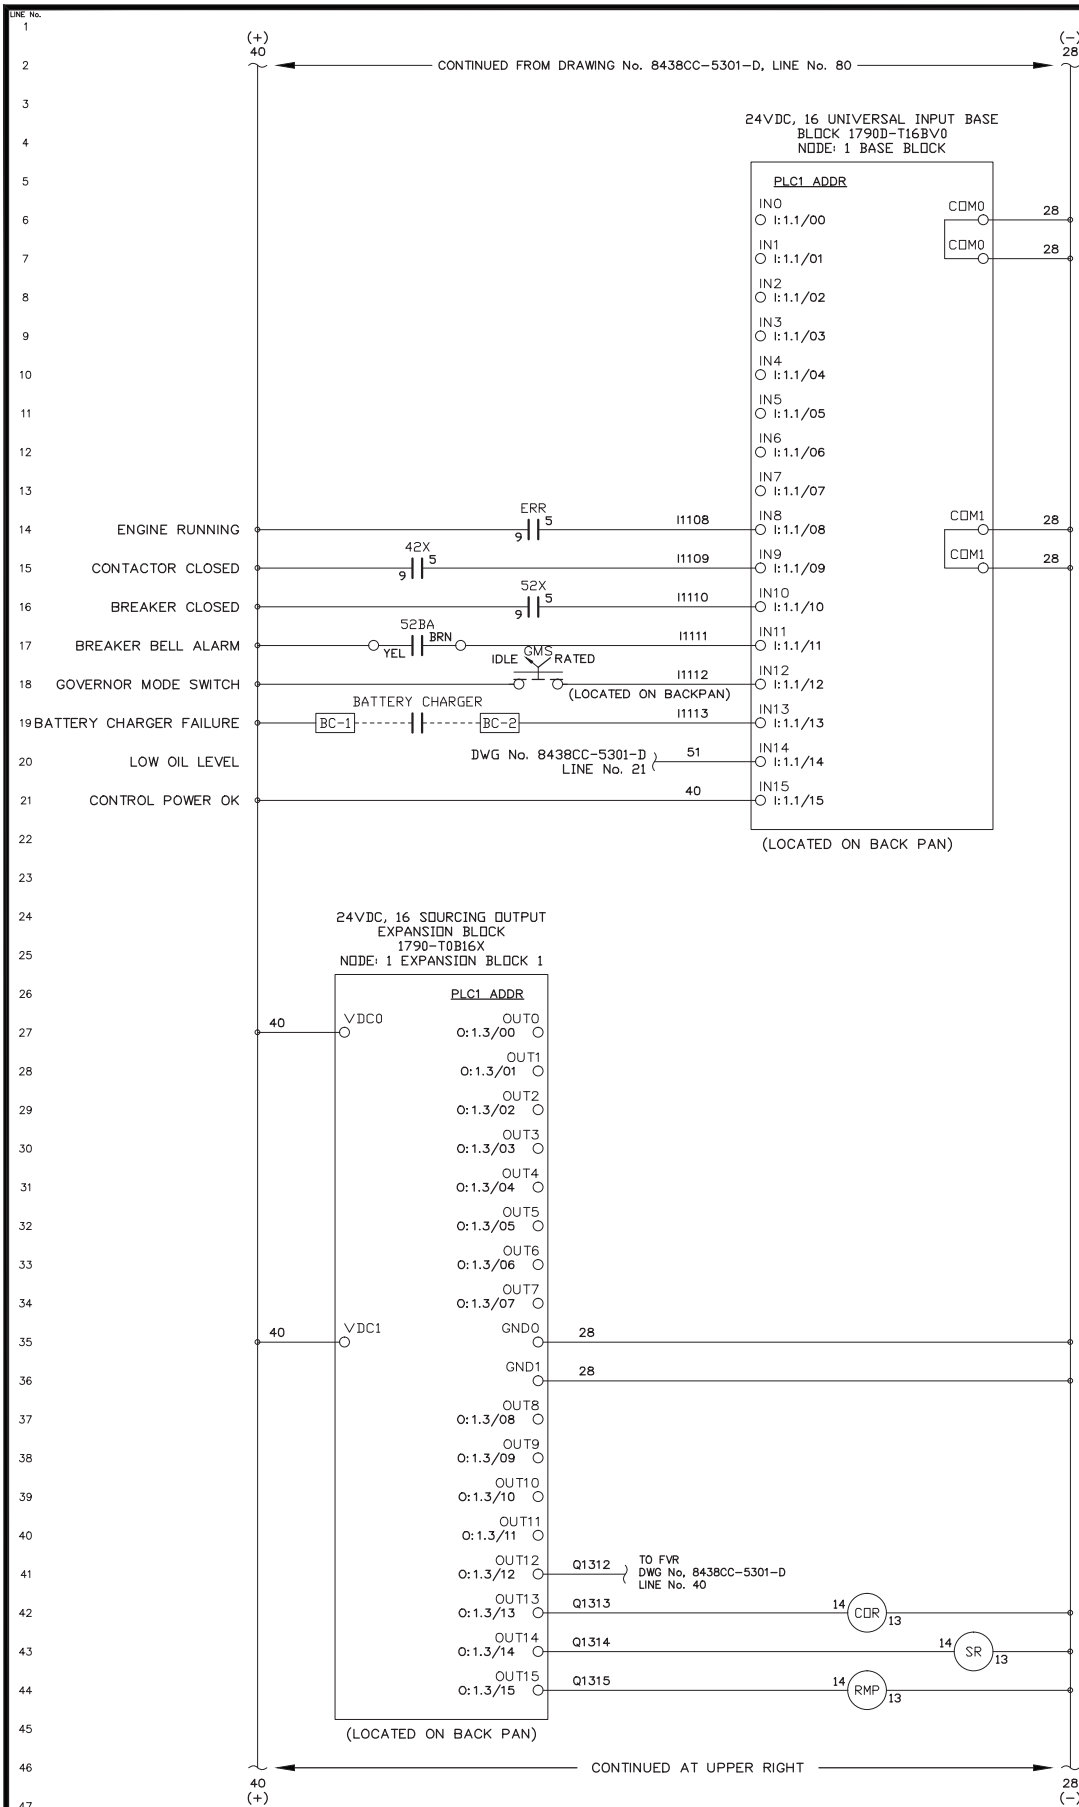


REV.	DATE	DESCRIPTION	BY
B	09-21-16	AS BUILT	RAC
PURCHASE ORDER No. ERNIE BAUMGARTNER CONTROLLED POWER JOB No. 8438CC			
TITLE: GENERATOR 1 DC CONTROL, SCHEMATIC DIAGRAM			
SCALE: NONE	DATE: 08-23-16	DWN. BY: GPN	
DWG. No: 8438CC-5302-D	SHEET: 1 OF 1	CKD. BY: JMD	
JOB: CROOKED CREEK EASYGEN UPGRADE			

NOTICE
THE DRAWINGS, INFORMATION AND SUBJECT MATTER HEREOF ARE THE CONFIDENTIAL, SOLE AND EXCLUSIVE PROPERTY OF CONTROLLED POWER, INC., AND ARE NOT TO BE COPIED, REPRODUCED OR USED IN ANY MANNER FOR ANY PURPOSE WHATSOEVER WITHOUT WRITTEN CONSENT OR DIRECTION.



ENGINEERED & MANUFACTURED BY
Controlled Power, Inc.
BOTHELL, WASHINGTON USA
(425)-485-1778 www.controlledpowerinc.com

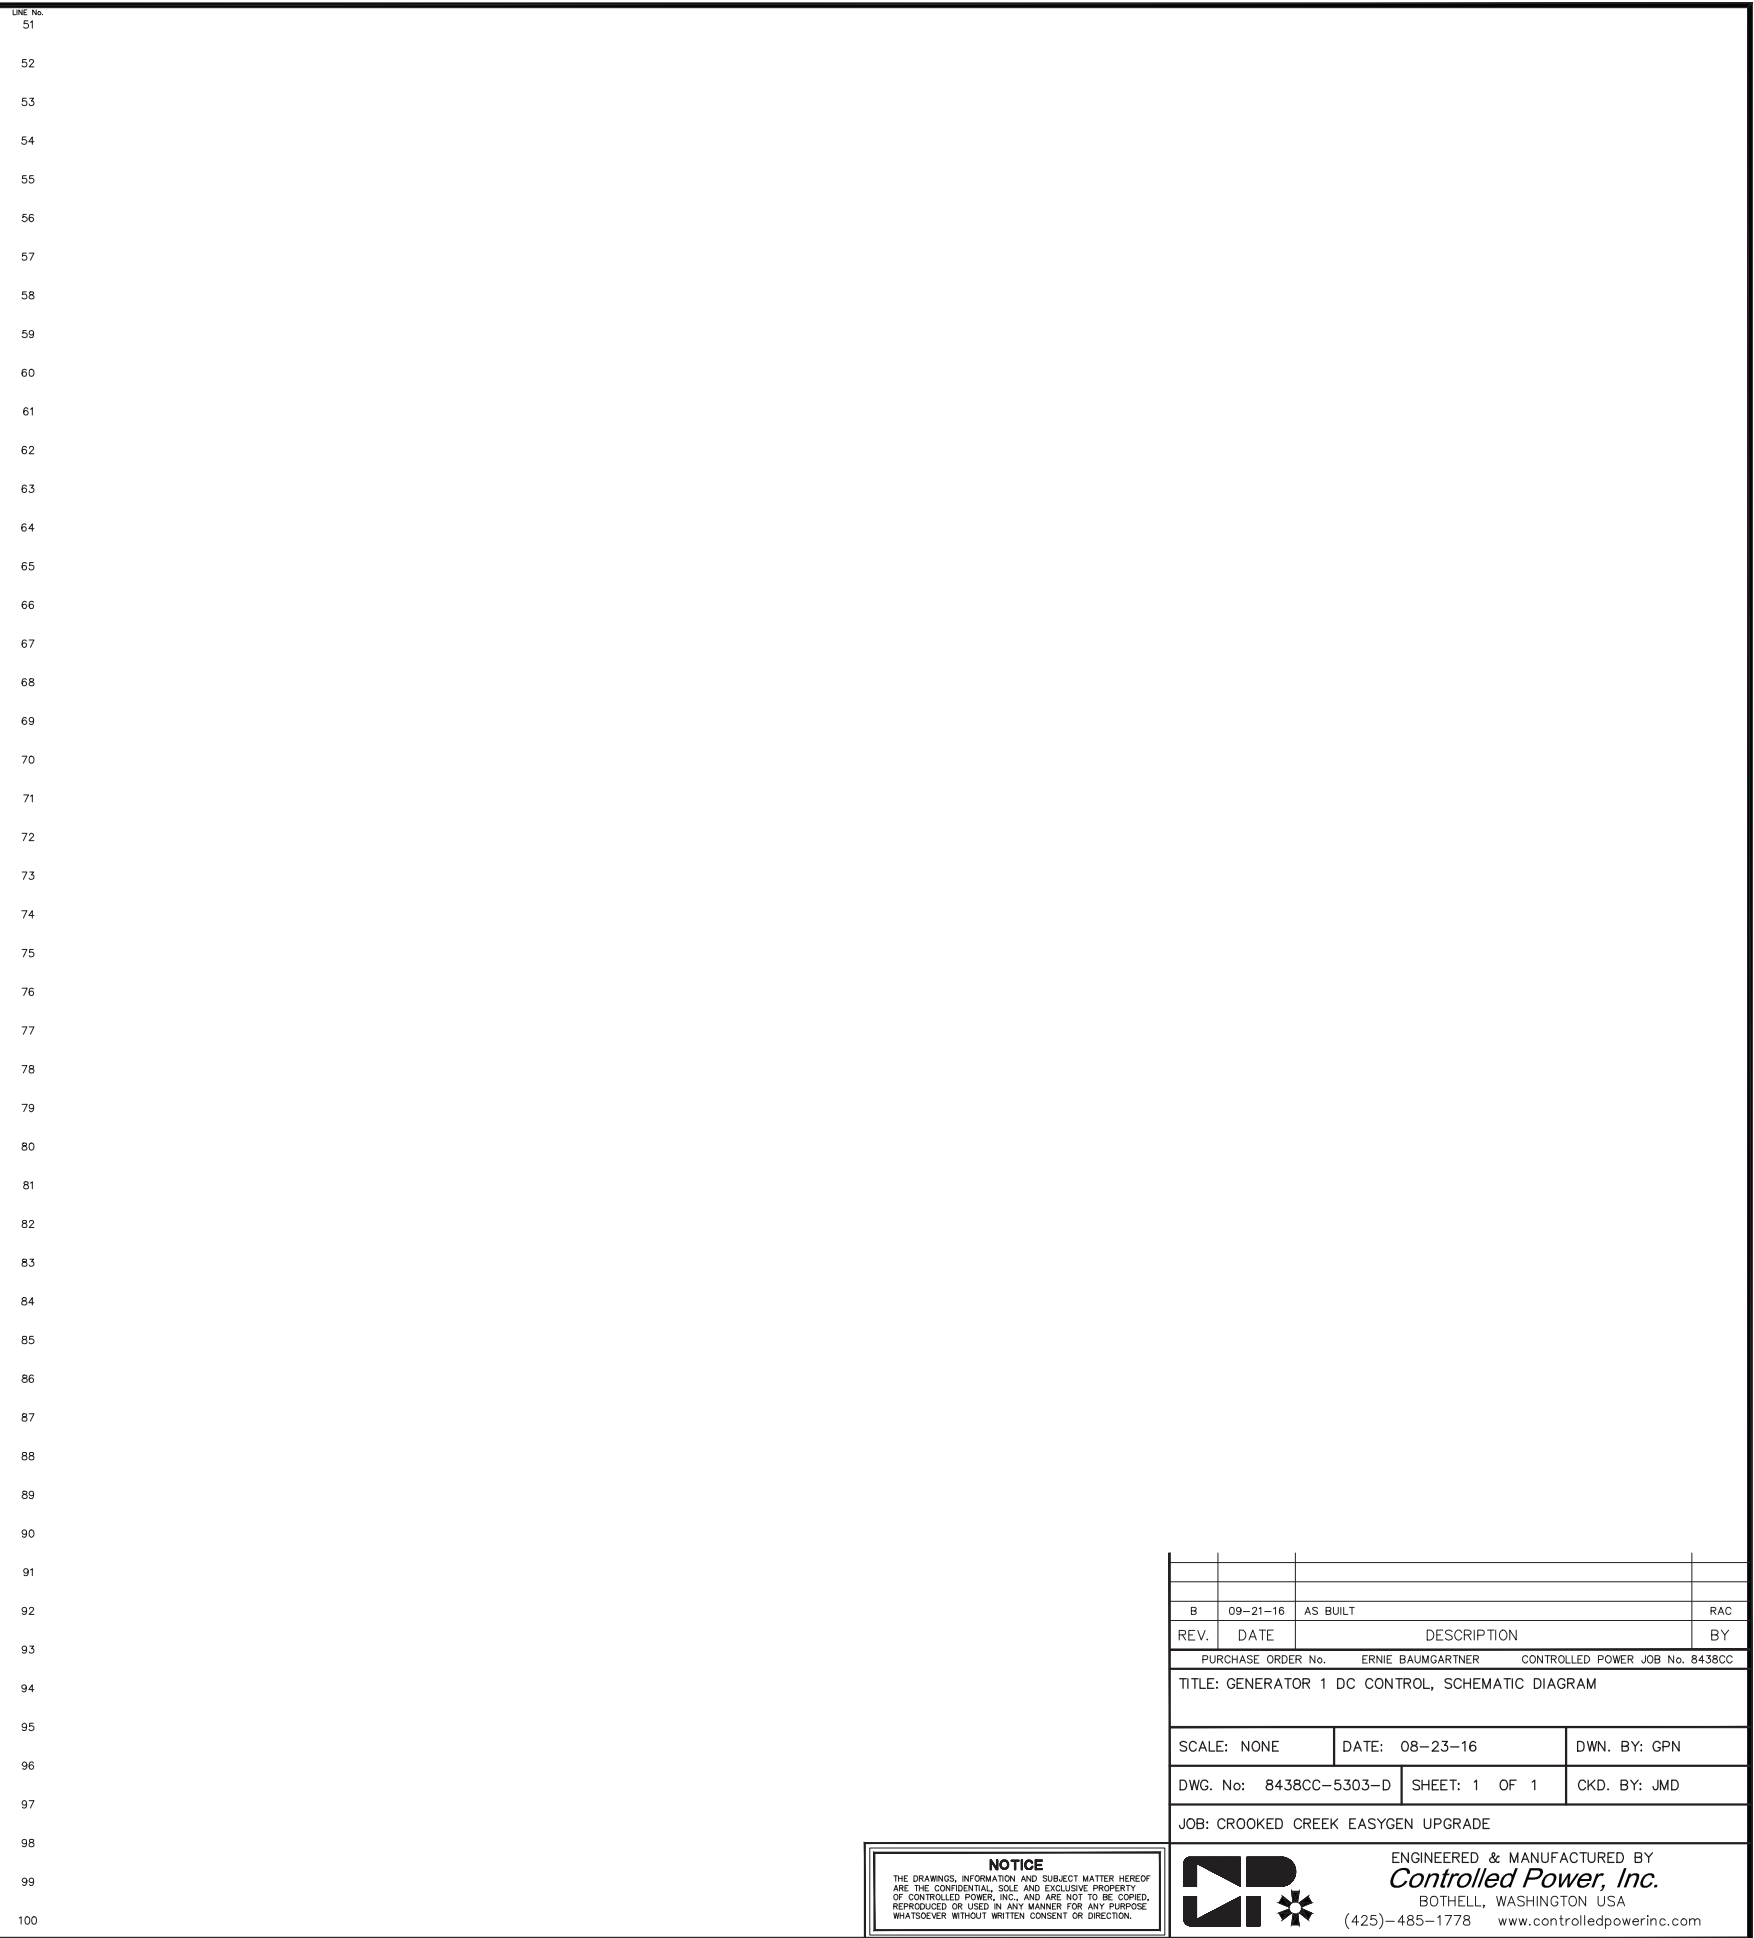
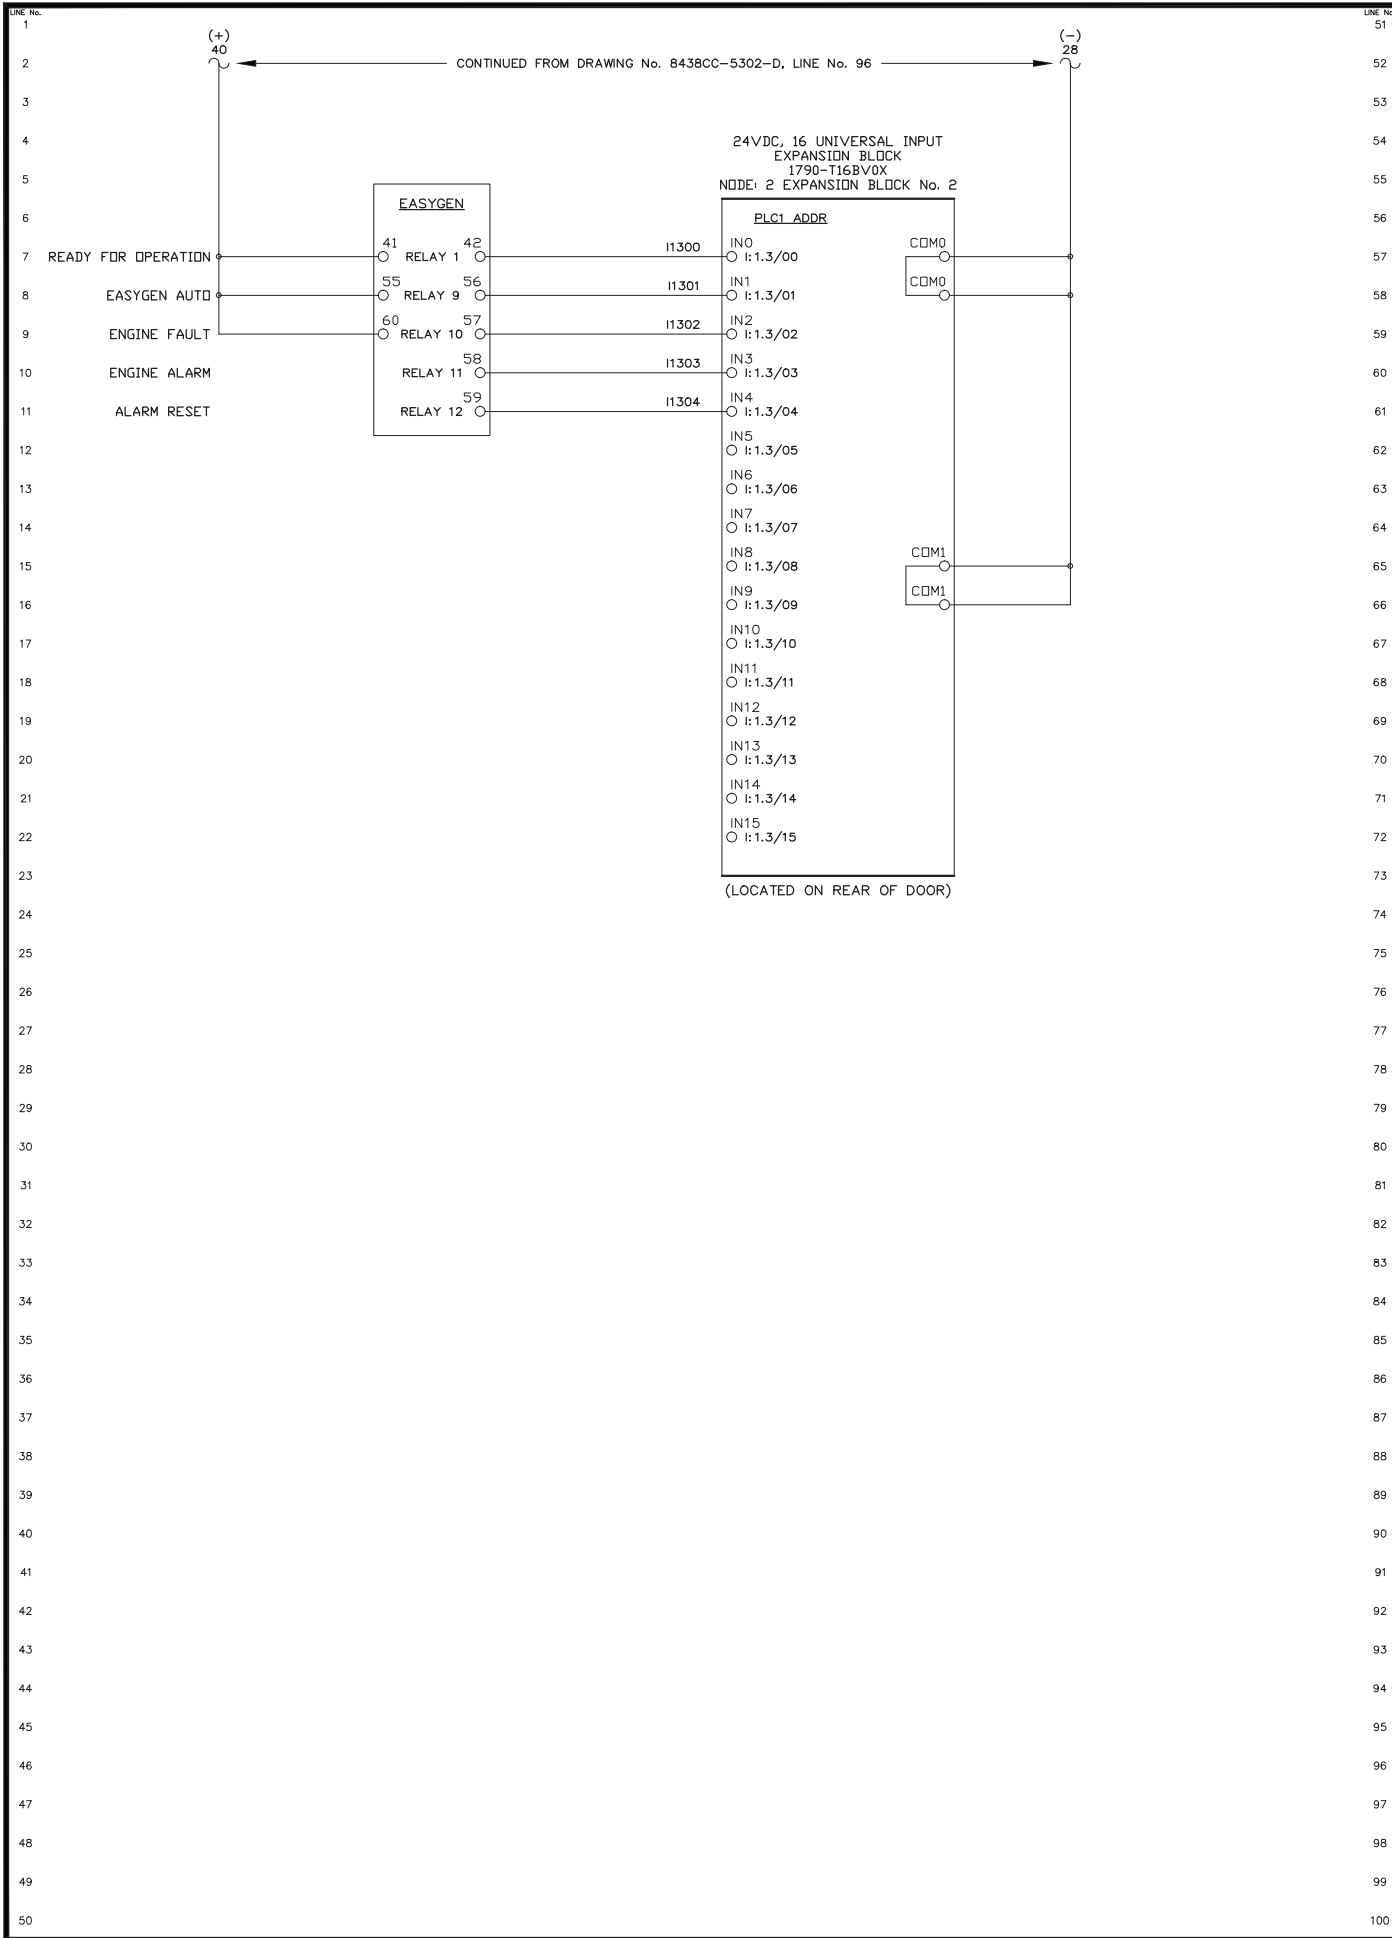


REV.	DATE	DESCRIPTION	BY
B	09-21-16	AS BUILT	RAC
PURCHASE ORDER No. ERNIE BAUMGARTNER CONTROLLED POWER JOB No. 8438CC			
TITLE: GENERATOR 1 DC CONTROL, SCHEMATIC DIAGRAM			
SCALE: NONE	DATE: 08-23-16	DWN. BY: GPN	
DWG. No: 8438CC-5303-D	SHEET: 1 OF 1	CKD. BY: JMD	
JOB: CROOKED CREEK EASYGEN UPGRADE			

NOTICE
THE DRAWINGS, INFORMATION AND SUBJECT MATTER HEREOF ARE THE CONFIDENTIAL, SOLE AND EXCLUSIVE PROPERTY OF CONTROLLED POWER, INC., AND ARE NOT TO BE COPIED, REPRODUCED OR USED IN ANY MANNER FOR ANY PURPOSE WHATSOEVER WITHOUT WRITTEN CONSENT OR DIRECTION.



ENGINEERED & MANUFACTURED BY
Controlled Power, Inc.
BOTHELL, WASHINGTON USA
(425)-485-1778 www.controlledpowerinc.com

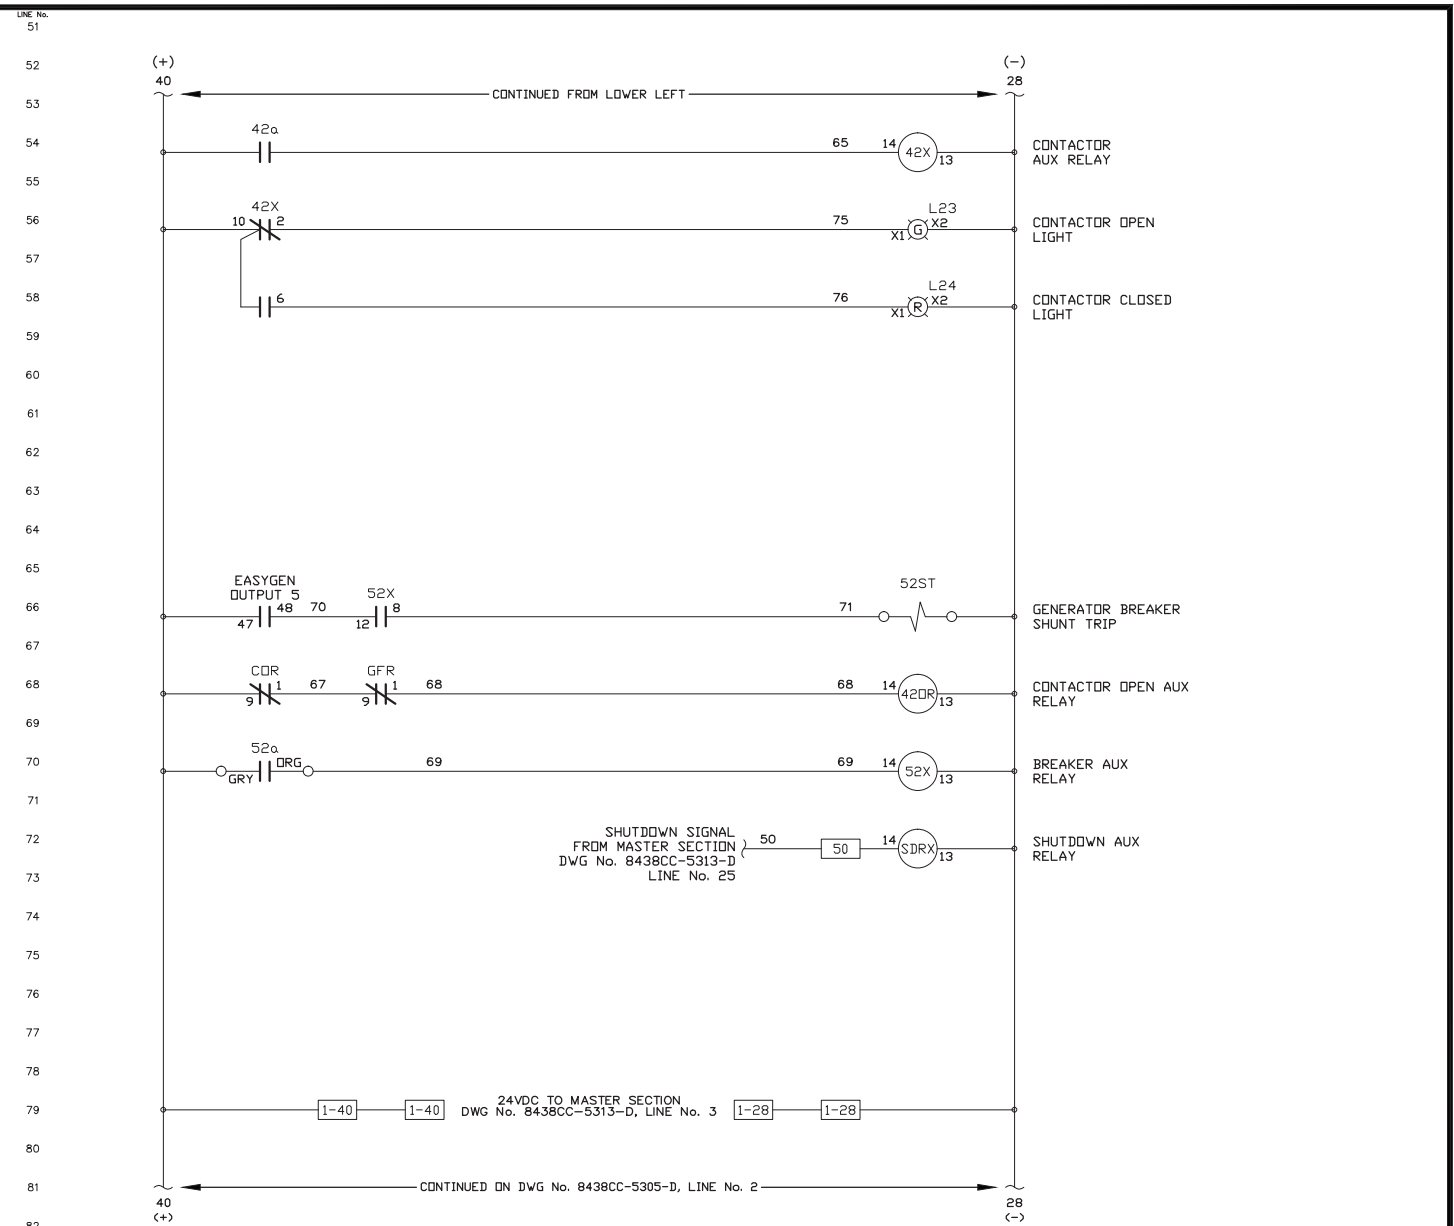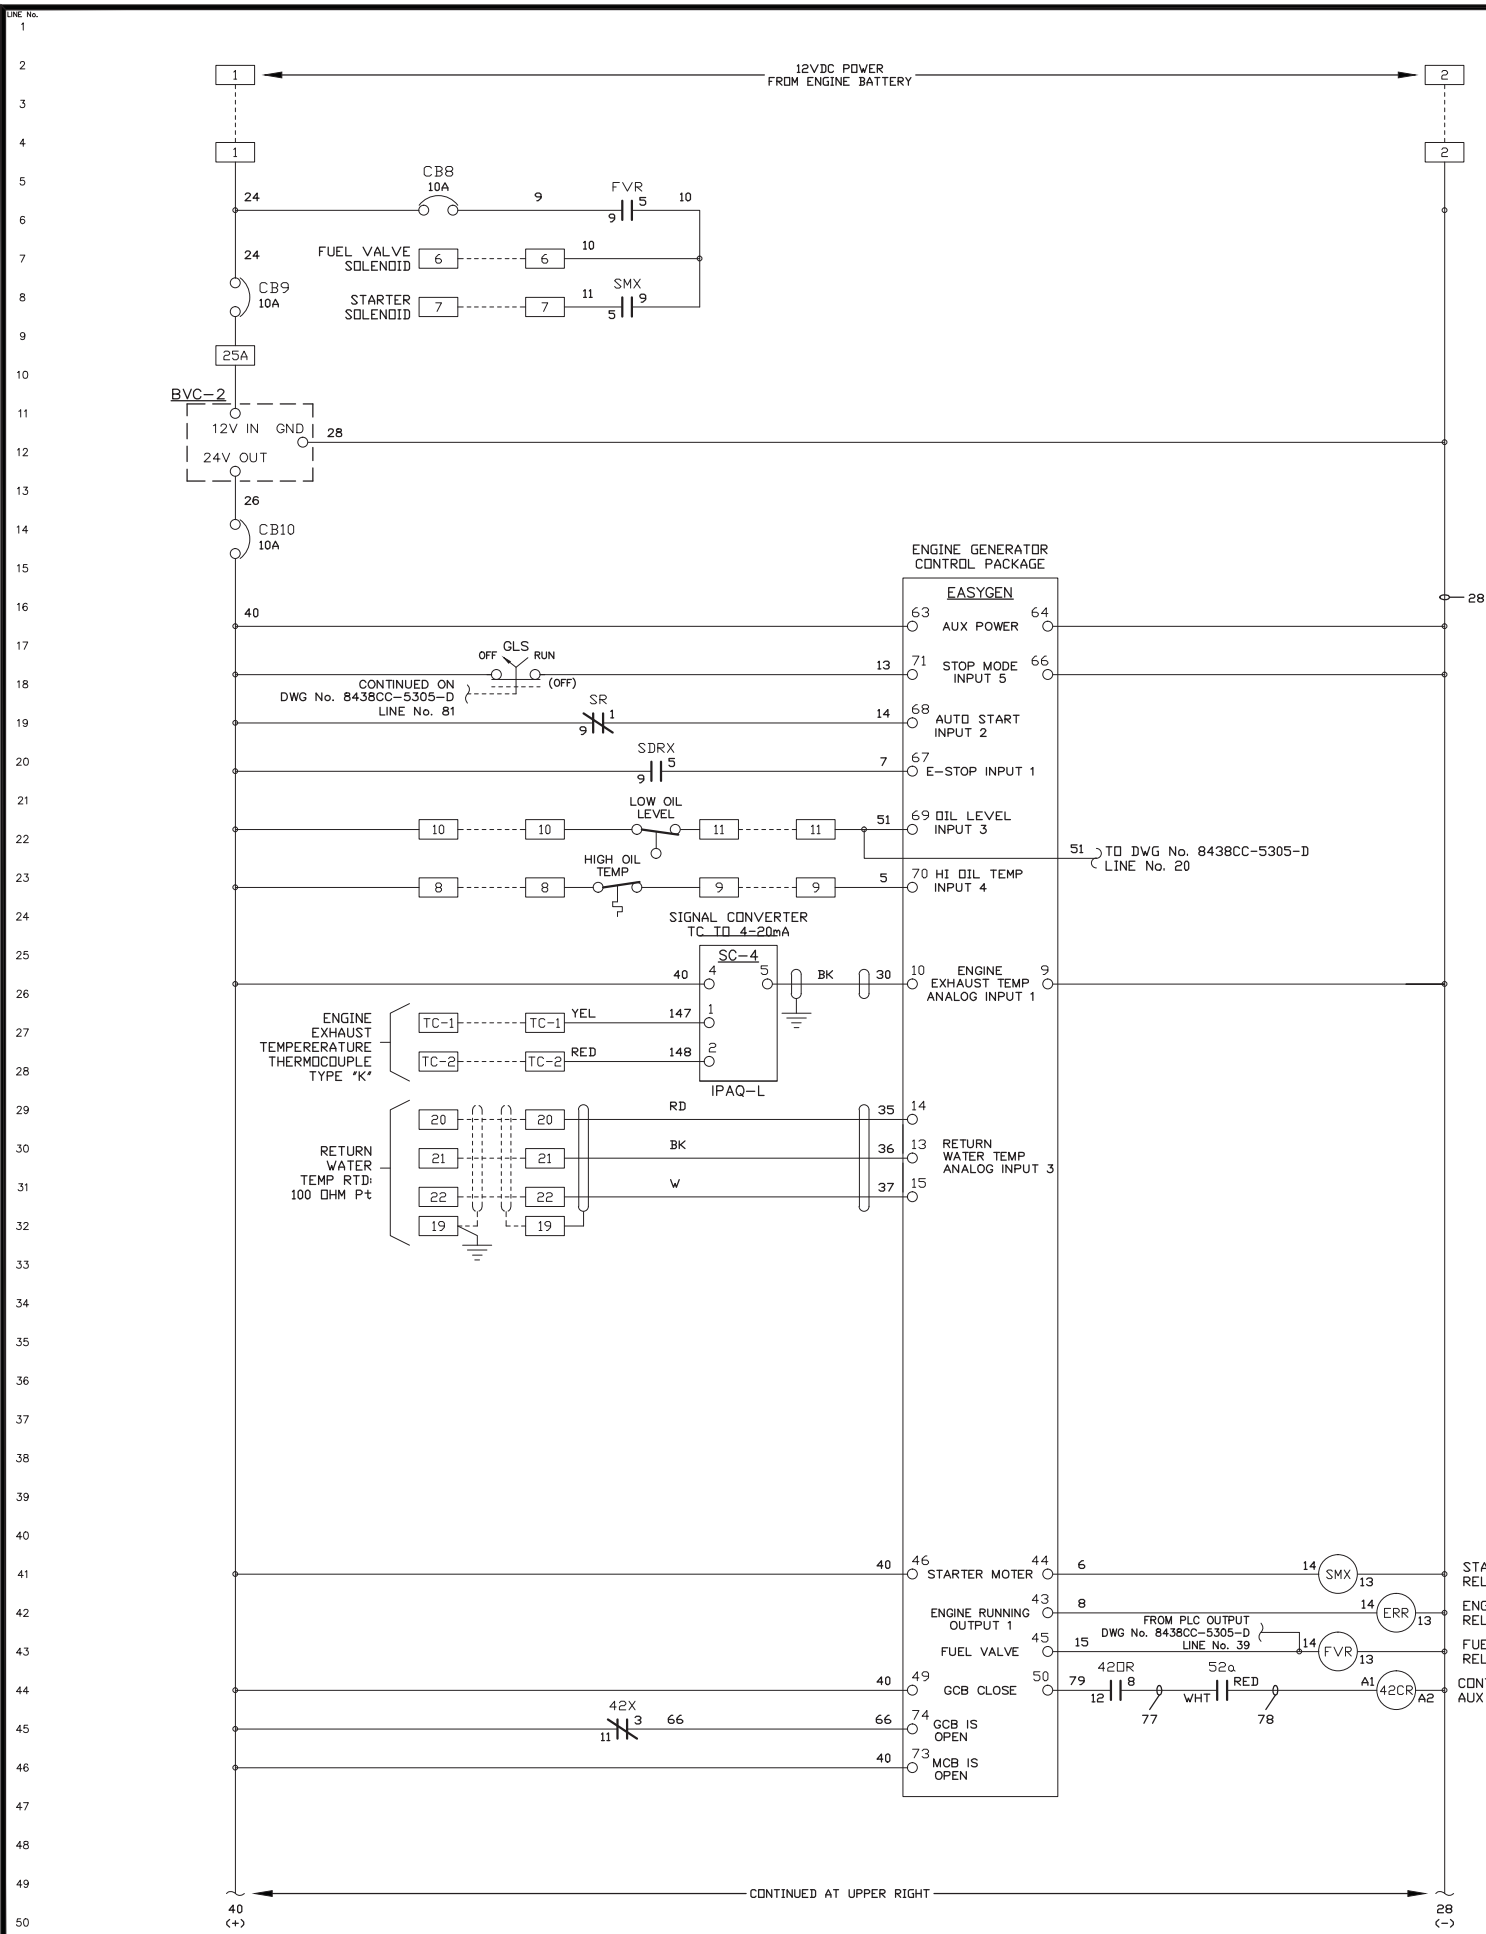

NOTICE
THE DRAWINGS, INFORMATION AND SUBJECT MATTER HEREOF ARE THE CONFIDENTIAL, SOLE AND EXCLUSIVE PROPERTY OF CONTROLLED POWER, INC., AND ARE NOT TO BE COPIED, REPRODUCED OR USED IN ANY MANNER FOR ANY PURPOSE WHATSOEVER WITHOUT WRITTEN CONSENT OR DIRECTION.





ENGINEERED & MANUFACTURED BY
Controlled Power, Inc.
BOTHELL, WASHINGTON USA
(425)-485-1778 www.controlledpowerinc.com

REV.	DATE	DESCRIPTION	BY
B	09-21-16	AS BUILT	RAC

PURCHASE ORDER No. ERNIE BAUMGARTNER CONTROLLED POWER JOB No. 8438CC
TITLE: GENERATOR 2 DC CONTROL, SCHEMATIC DIAGRAM

SCALE: NONE	DATE: 08-23-16	DWN. BY: GPN
DWG. No: 8438CC-5304-D	SHEET: 1 OF 1	CKD. BY: JMD


JOB: CROOKED CREEK EASYGEN UPGRADE

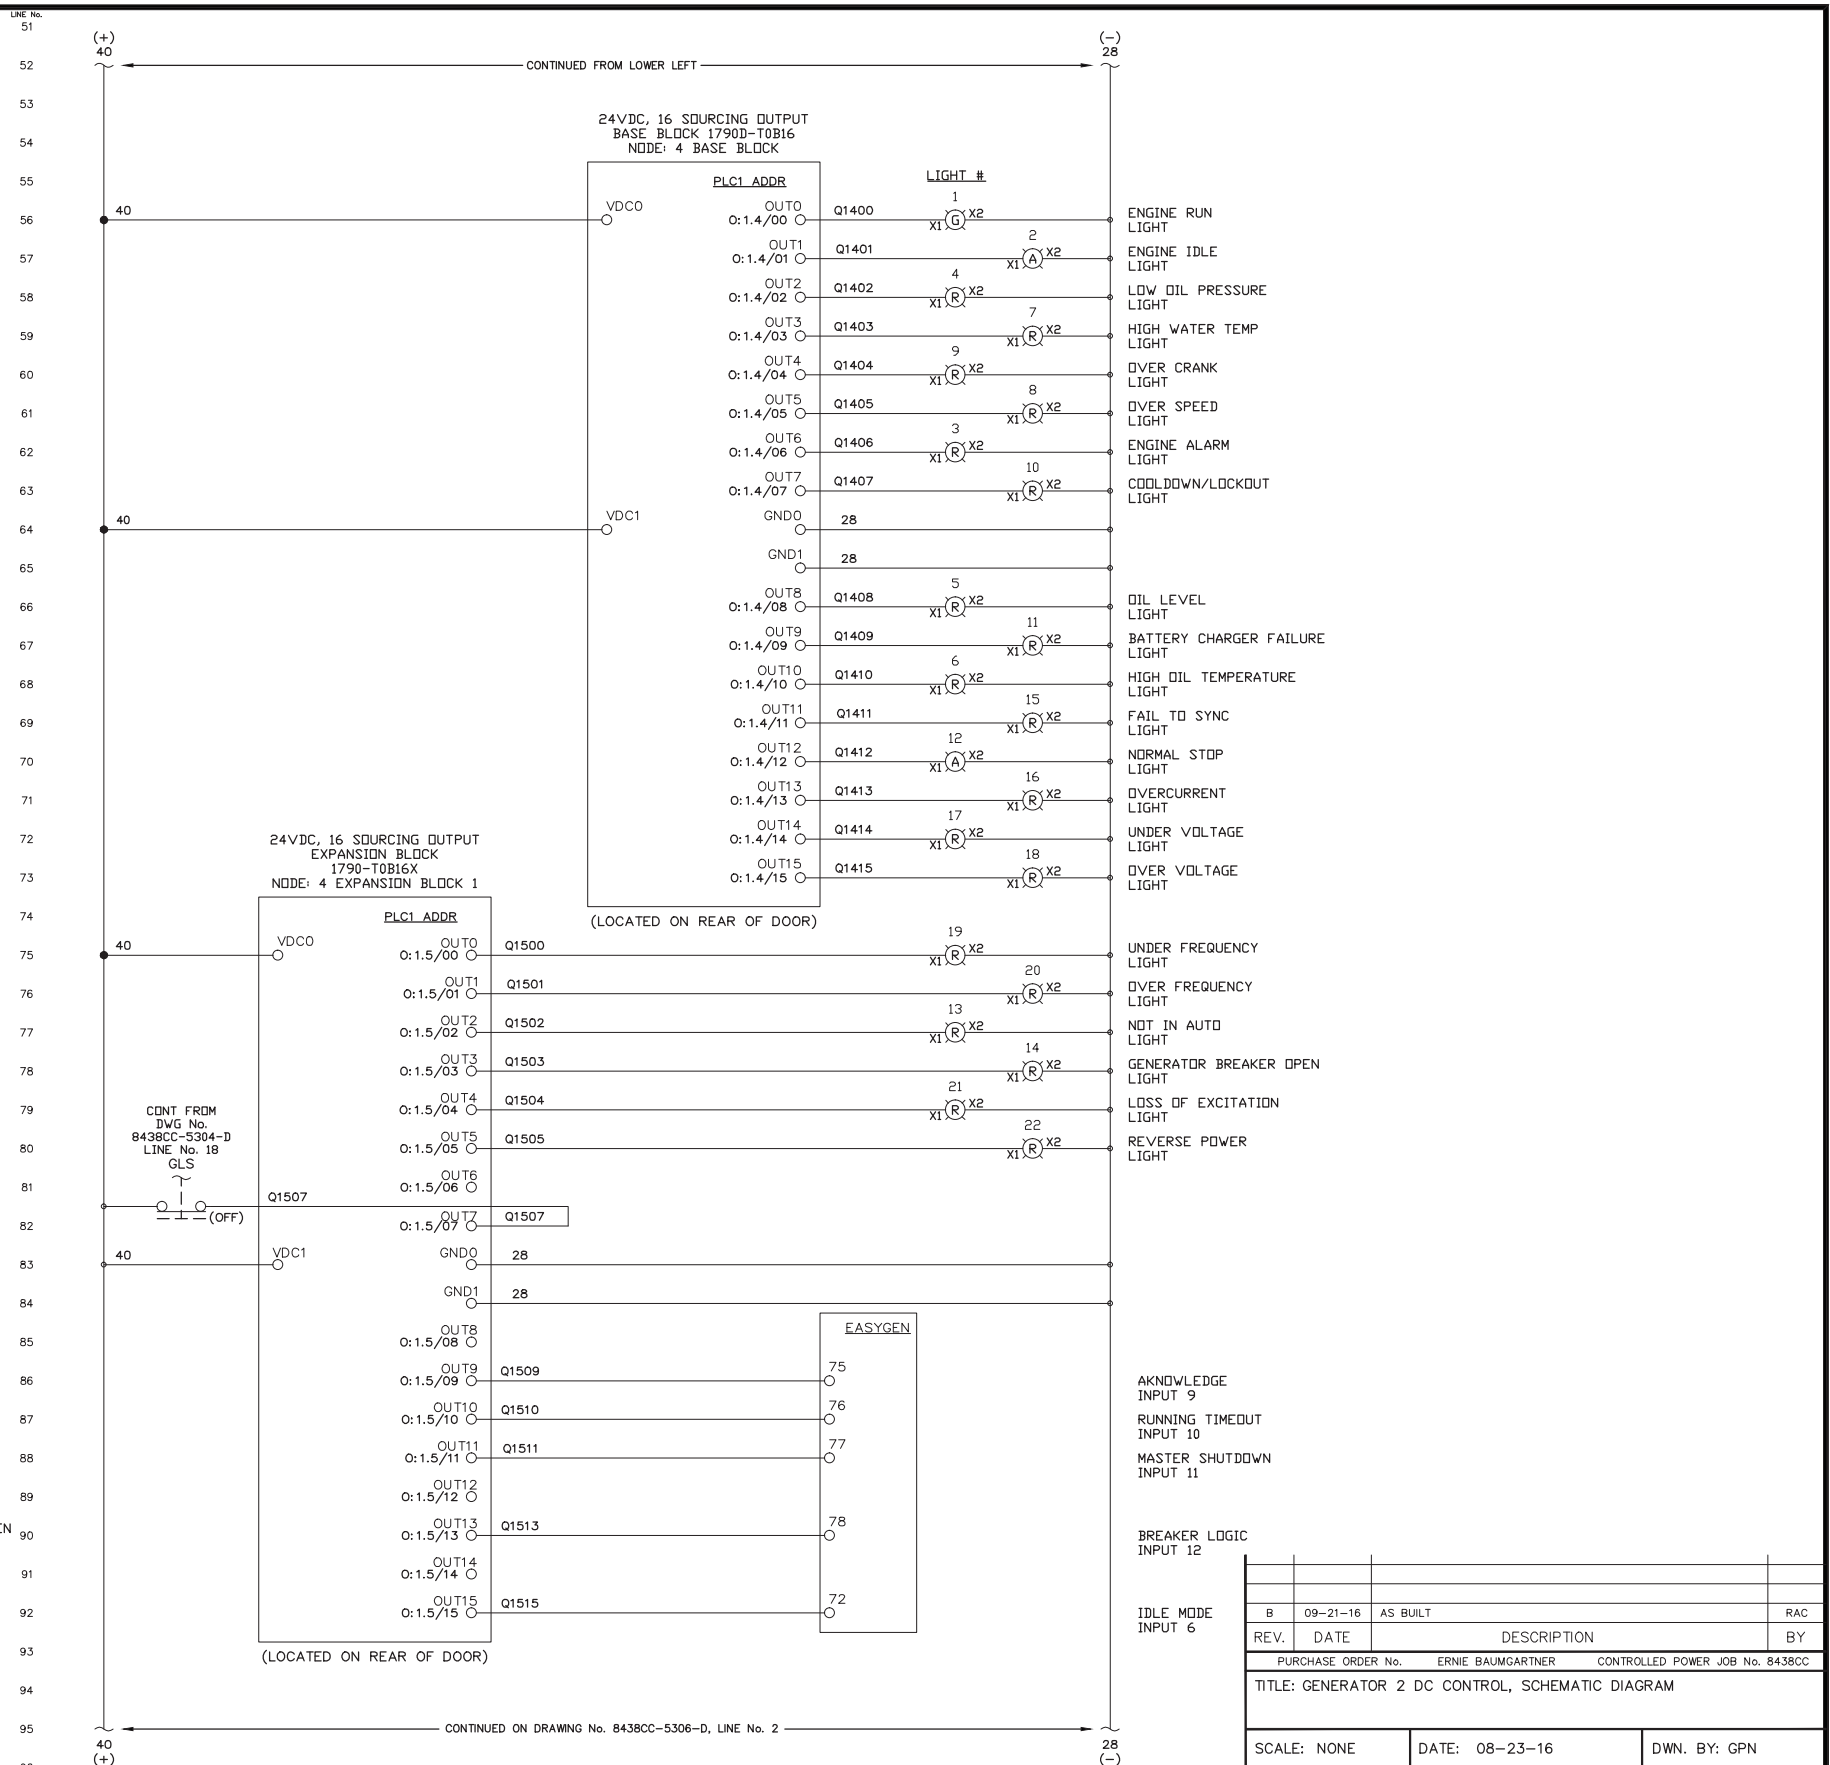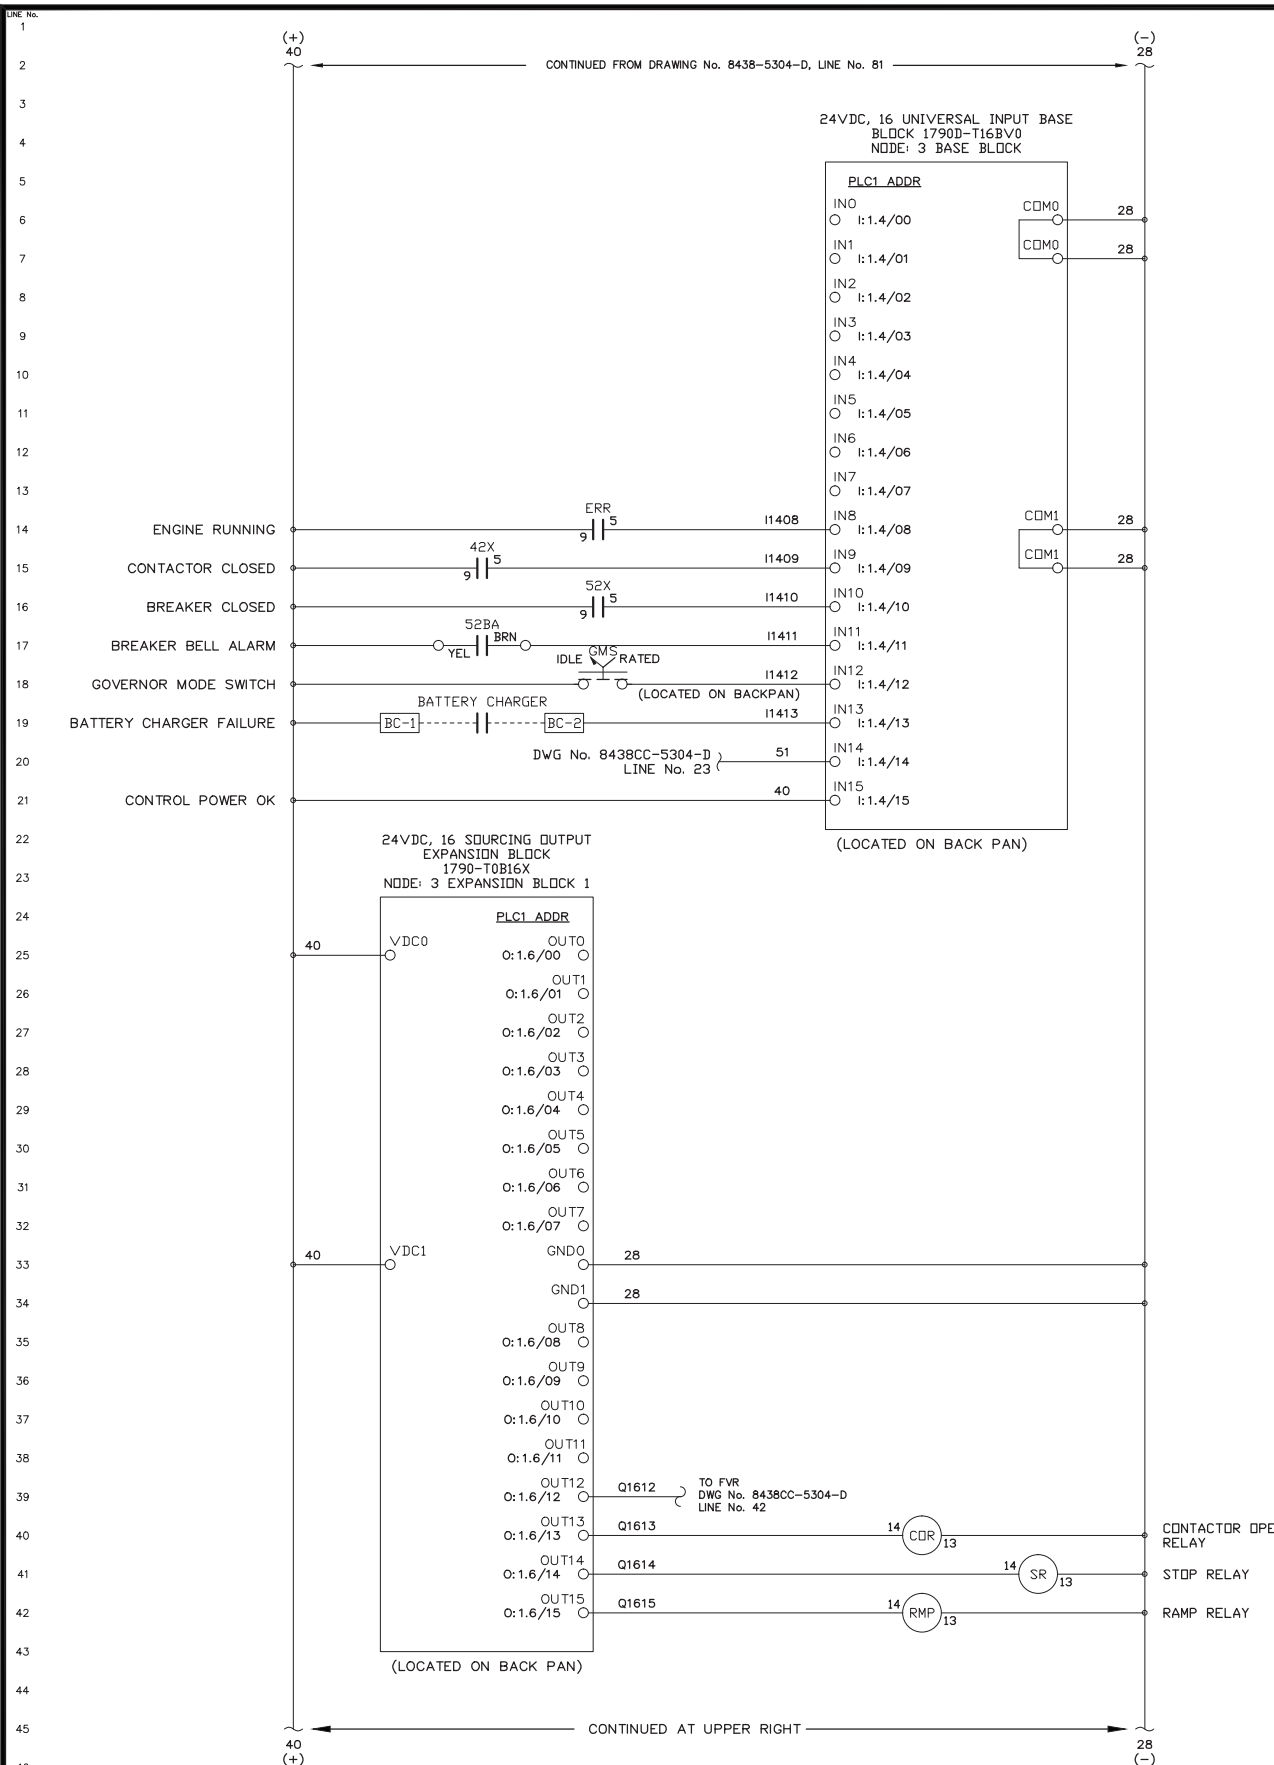

REV.	DATE	DESCRIPTION	BY
B	09-21-16	AS BUILT	RAC
PURCHASE ORDER No. ERNIE BAUMGARTNER CONTROLLED POWER JOB No. 8438CC			
TITLE: GENERATOR 2 DC CONTROL, SCHEMATIC DIAGRAM			
SCALE: NONE	DATE: 08-23-16	DWN. BY: GPN	
DWG. No: 8438CC-5305-D	SHEET: 1 OF 1	CKD. BY: JMD	
JOB: CROOKED CREEK EASYGEN UPGRADE			

NOTICE
 THE DRAWINGS, INFORMATION AND SUBJECT MATTER HEREOF ARE THE CONFIDENTIAL, SOLE AND EXCLUSIVE PROPERTY OF CONTROLLED POWER, INC., AND ARE NOT TO BE COPIED, REPRODUCED OR USED IN ANY MANNER FOR ANY PURPOSE WHATSOEVER WITHOUT WRITTEN CONSENT OR DIRECTION.

ENGINEERED & MANUFACTURED BY
Controlled Power, Inc.
 BOTHELL, WASHINGTON USA
 (425)-485-1778 www.controlledpowerinc.com

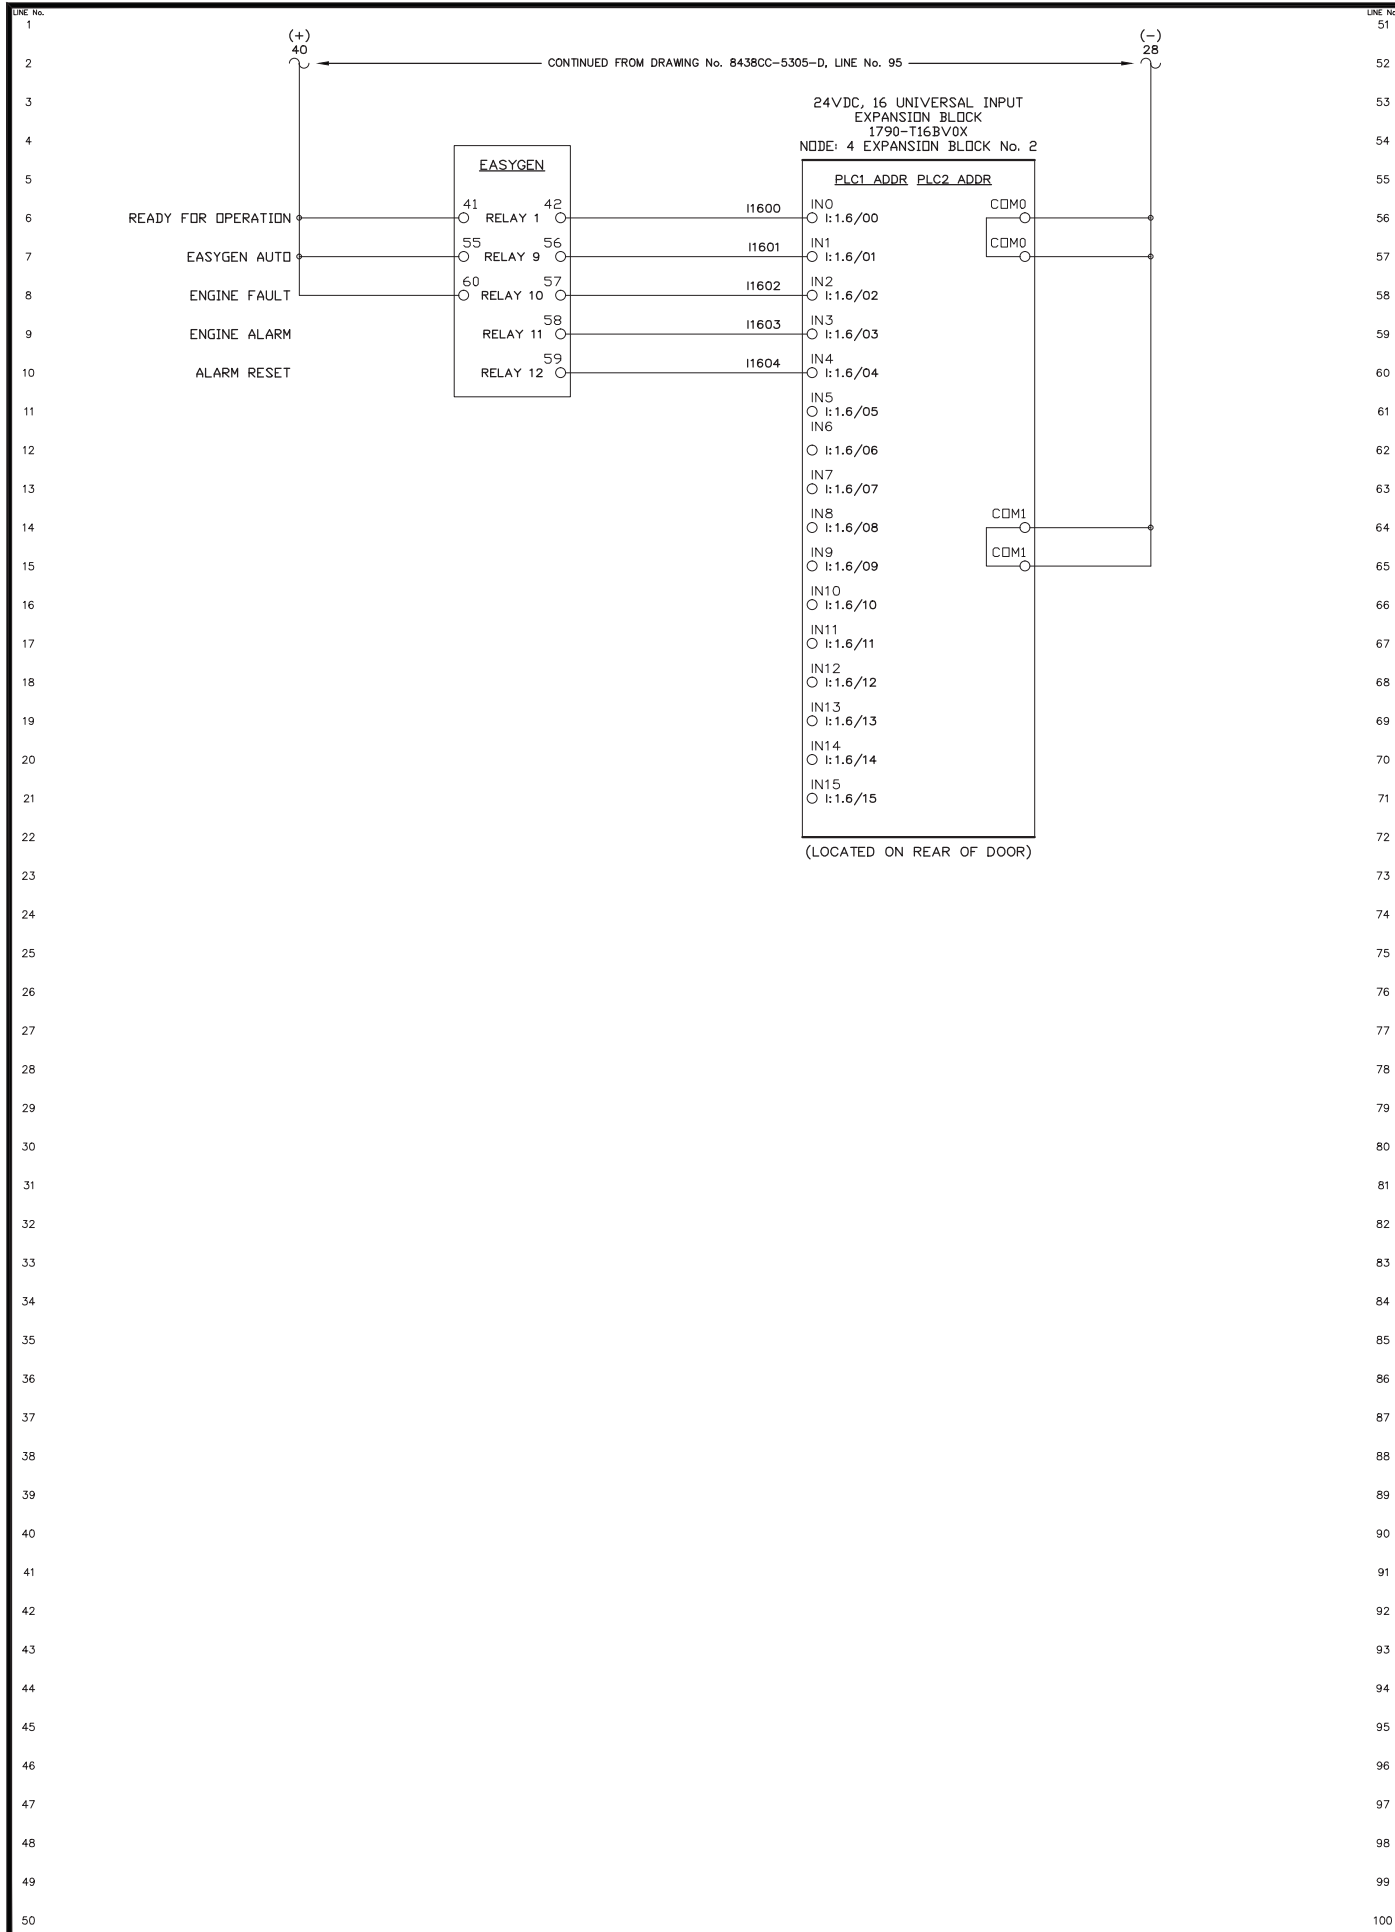



LINE No. 51
52
53
54
REV.	DATE	DESCRIPTION	BY
B	09-21-16	AS BUILT	RAC
PURCHASE ORDER No. ERNIE BAUMGARTNER CONTROLLED POWER JOB No. 8438CC			
TITLE: GENERATOR 2 DC CONTROL, SCHEMATIC DIAGRAM			
SCALE: NONE	DATE: 08-23-16	DWN. BY: GPN	
DWG. No: 8438CC-5306-D	SHEET: 1 OF 1	CKD. BY: JMD	
JOB: CROOKED CREEK EASYGEN UPGRADE			

NOTICE
THE DRAWINGS, INFORMATION AND SUBJECT MATTER HEREOF ARE THE CONFIDENTIAL, SOLE AND EXCLUSIVE PROPERTY OF CONTROLLED POWER, INC., AND ARE NOT TO BE COPIED, REPRODUCED OR USED IN ANY MANNER FOR ANY PURPOSE WHATSOEVER WITHOUT WRITTEN CONSENT OR DIRECTION.



ENGINEERED & MANUFACTURED BY
Controlled Power, Inc.
BOTHELL, WASHINGTON USA
(425)-485-1778 www.controlledpowerinc.com

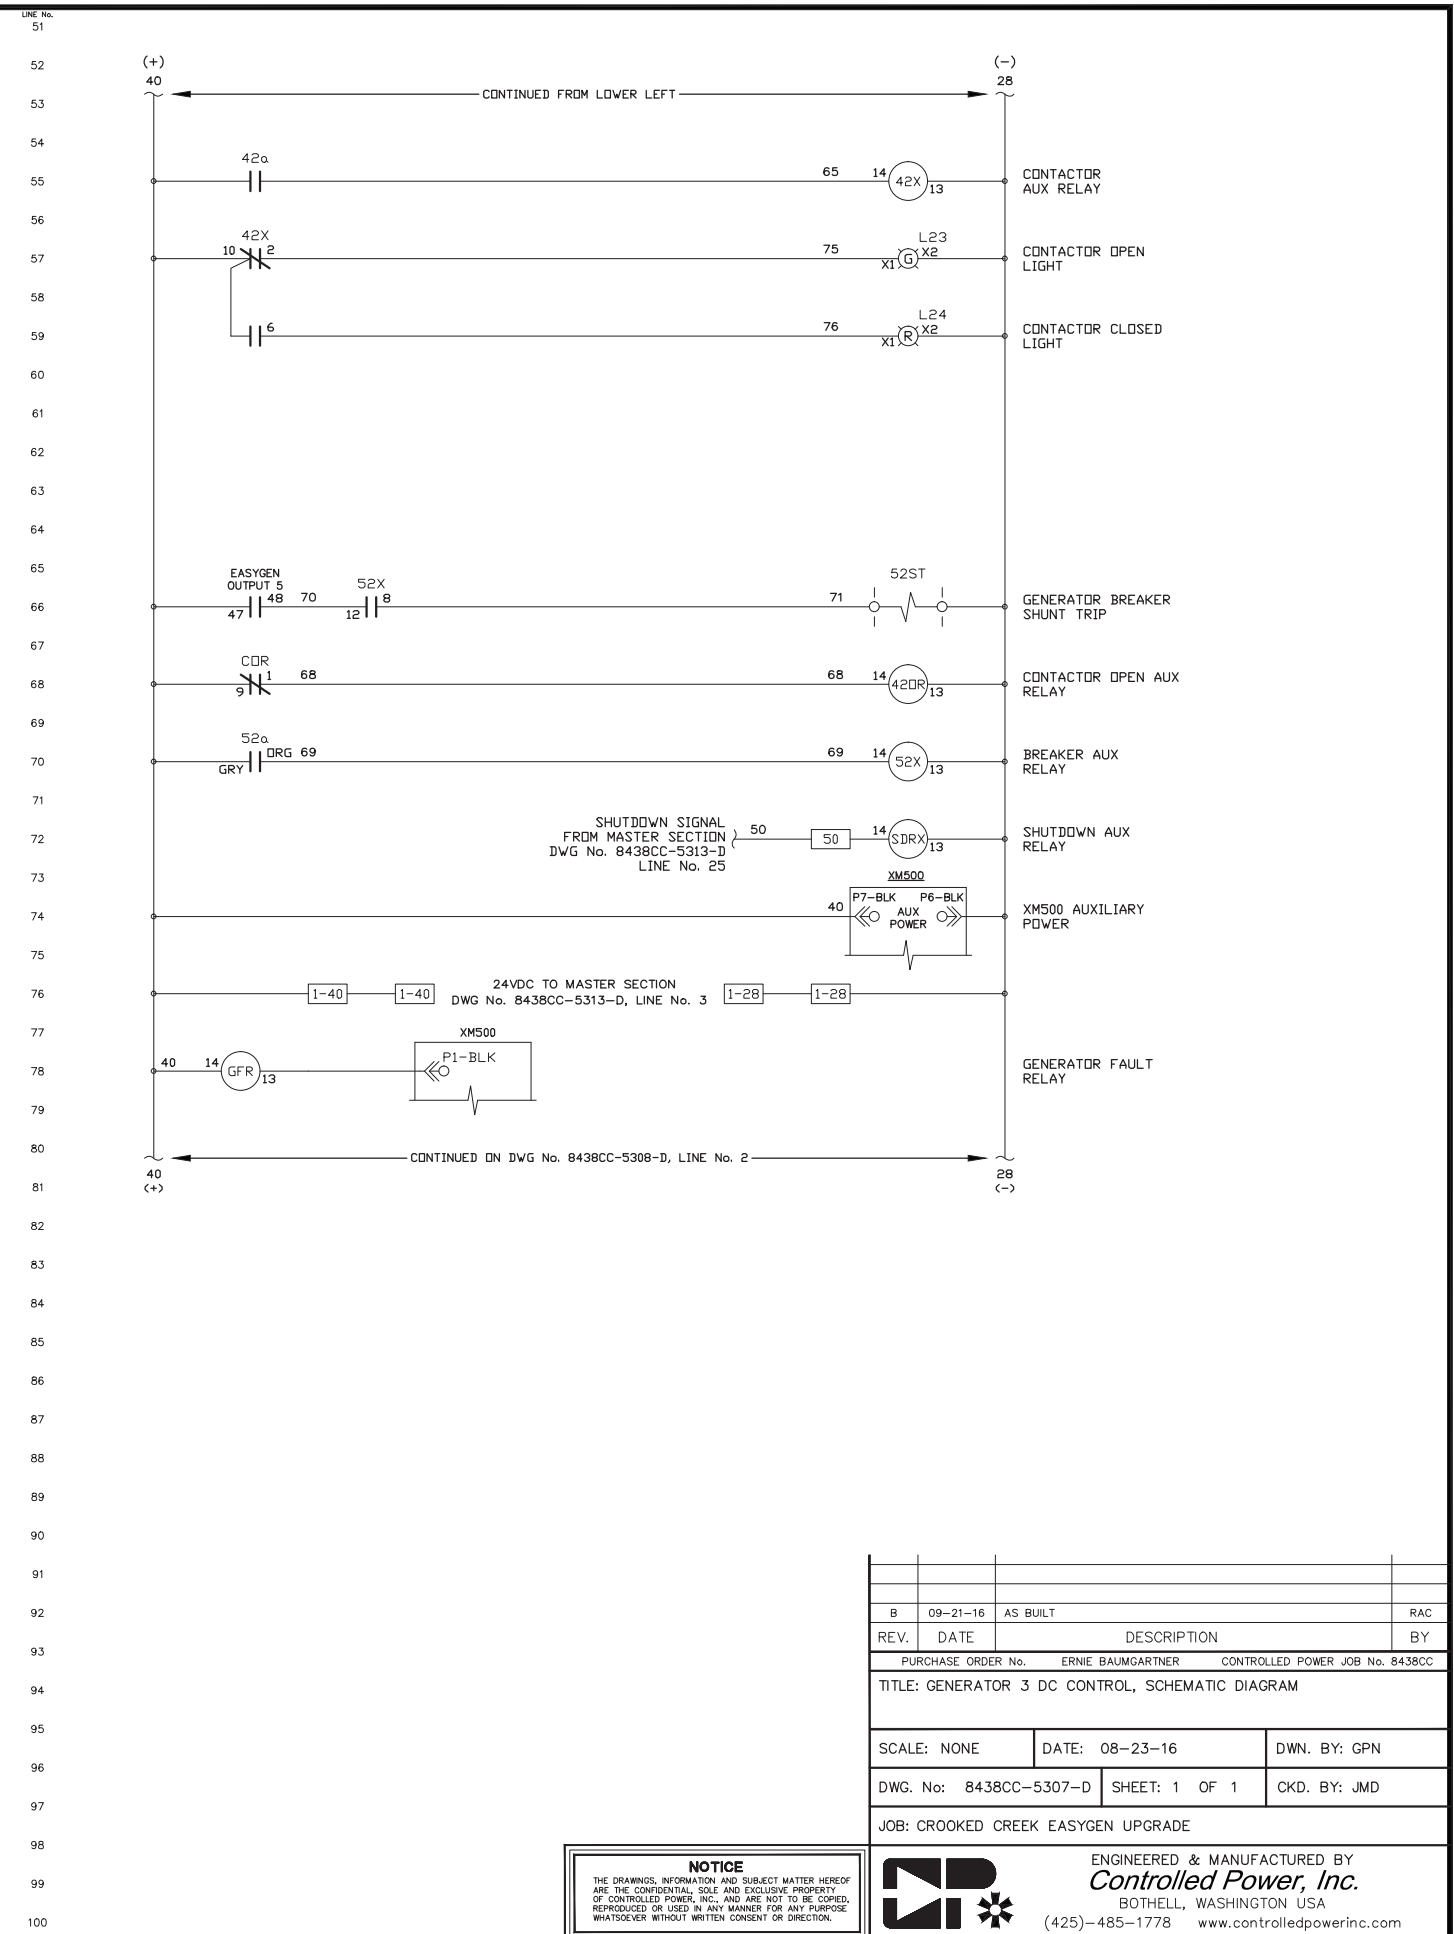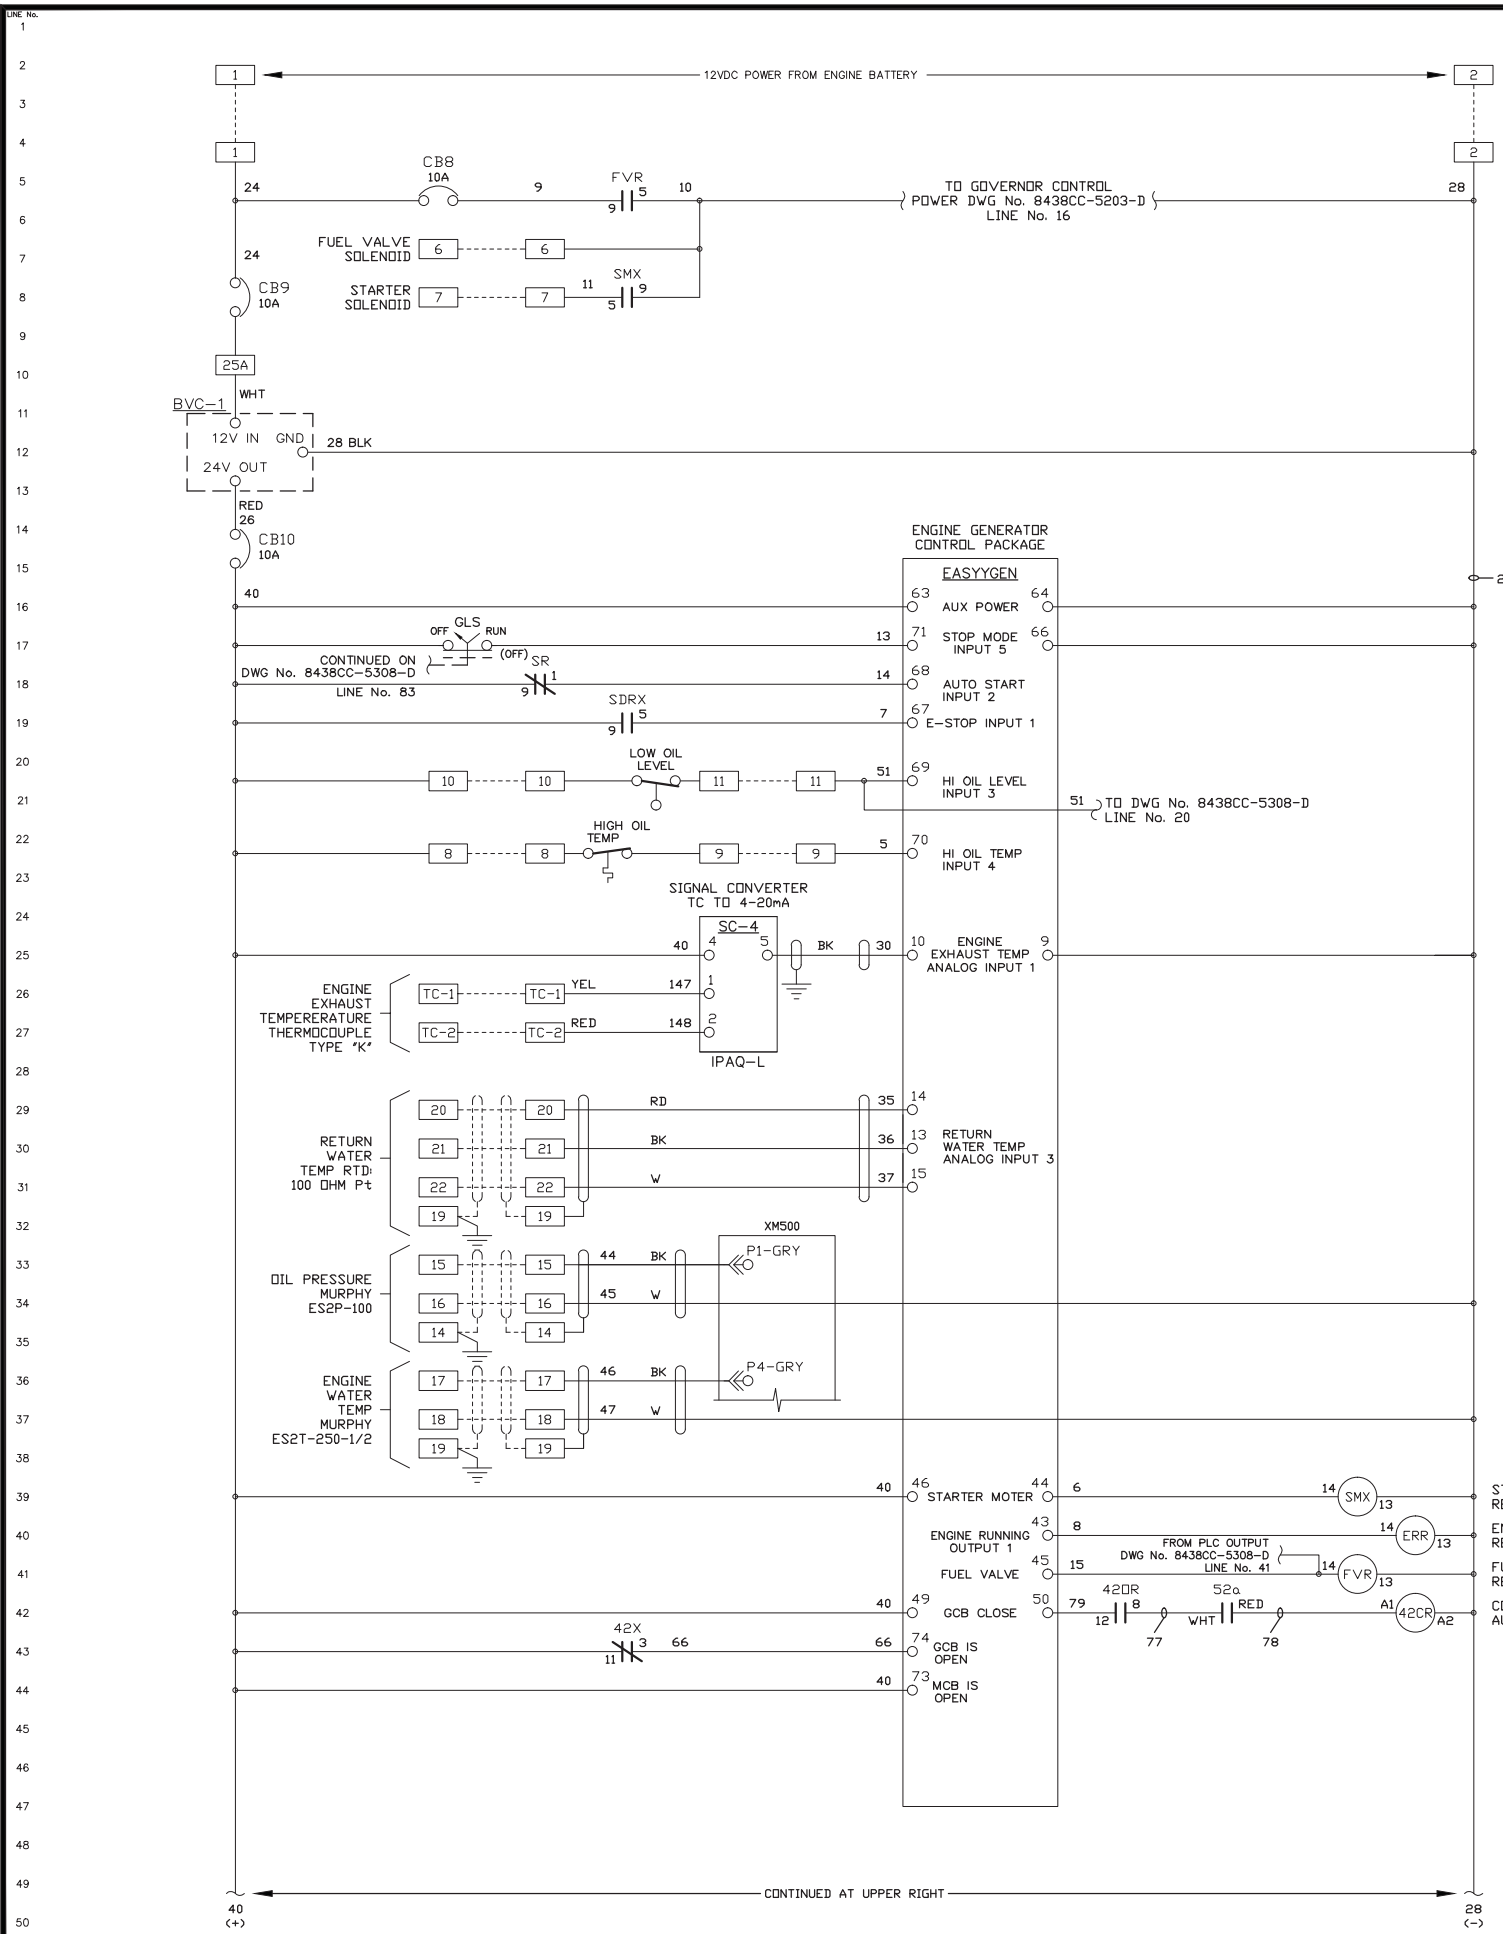

REV.	DATE	DESCRIPTION	BY
B	09-21-16	AS BUILT	RAC



PURCHASE ORDER No. ERNIE BAUMGARTNER CONTROLLED POWER JOB No. 8438CC

TITLE: GENERATOR 3 DC CONTROL, SCHEMATIC DIAGRAM

SCALE: NONE DATE: 08-23-16 DWN. BY: GPN

DWG. No: 8438CC-5307-D SHEET: 1 OF 1 CKD. BY: JMD

JOB: CROOKED CREEK EASYGEN UPGRADE

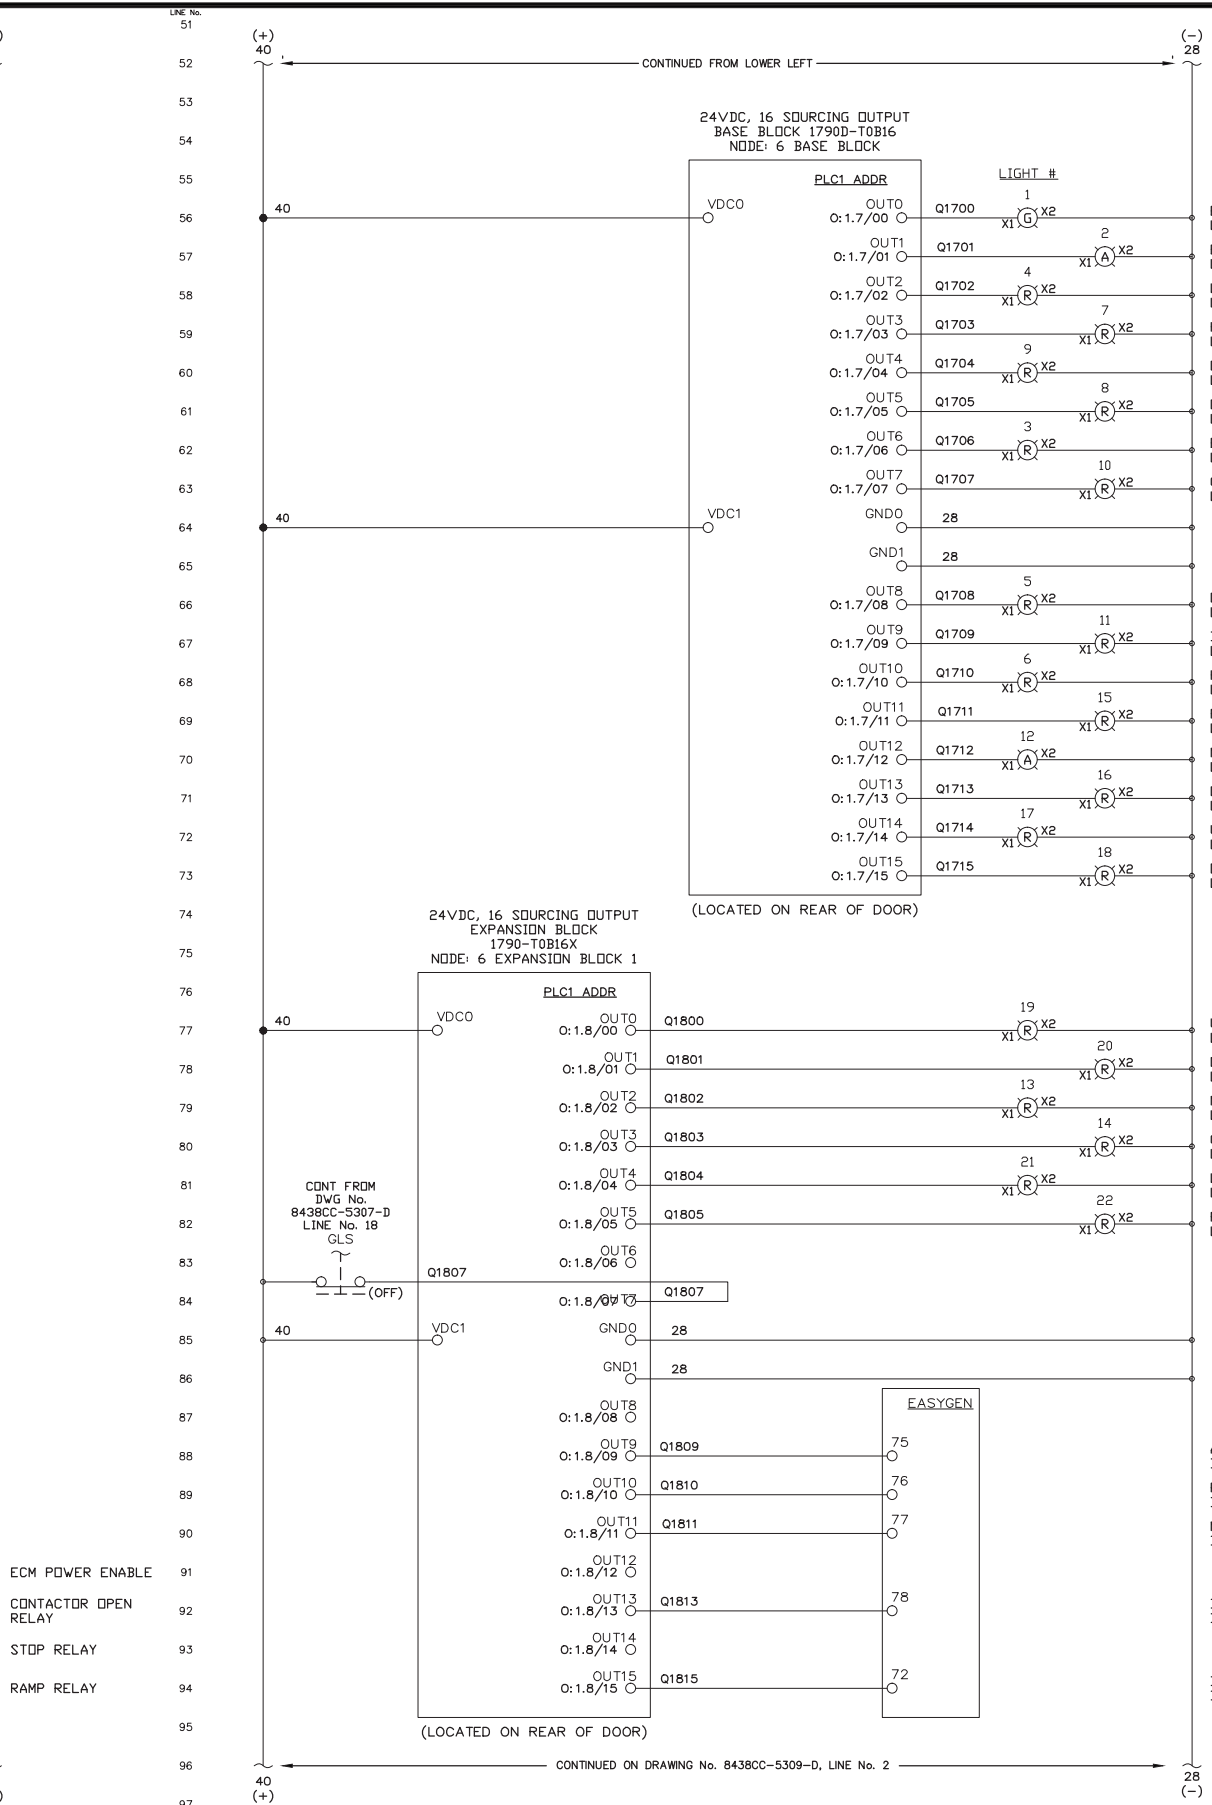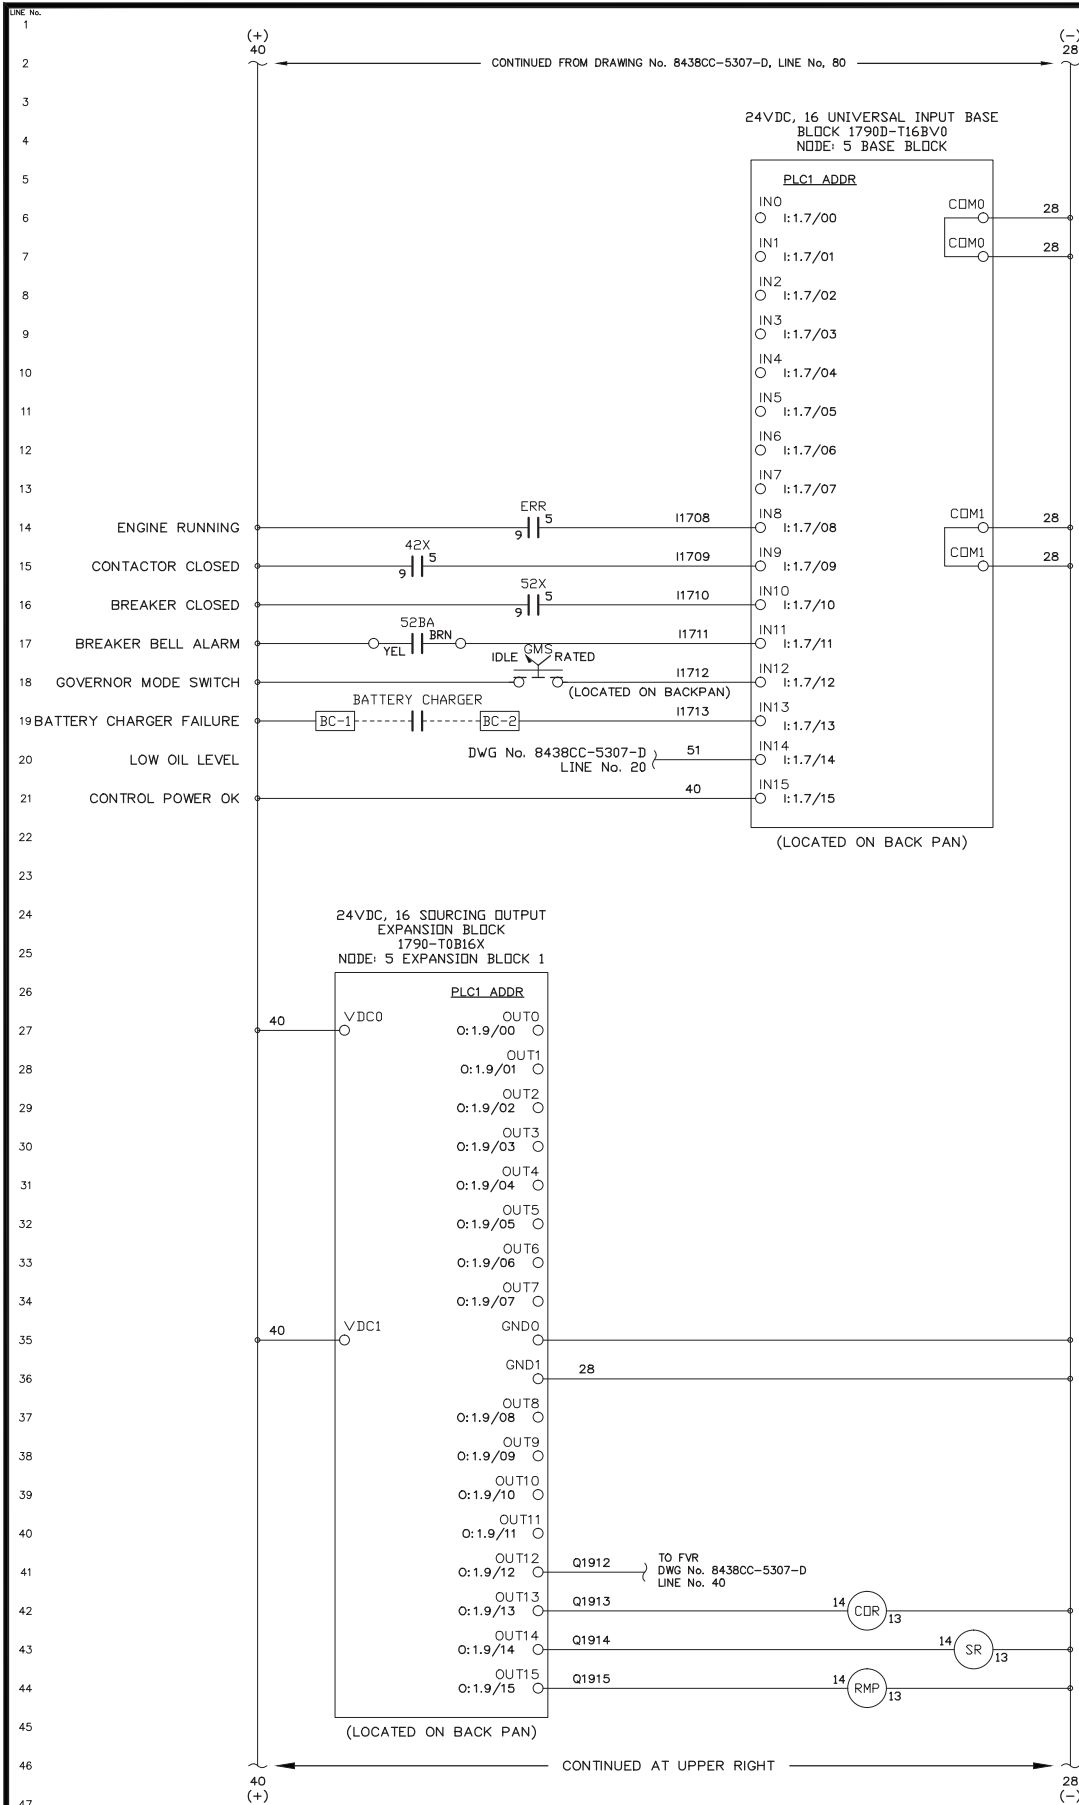



REV.	DATE	DESCRIPTION	BY
B	09-21-16	AS BUILT	RAC
PURCHASE ORDER No. ERNIE BAUMGARTNER CONTROLLED POWER JOB No. 8438CC			
TITLE: GENERATOR 3 DC CONTROL, SCHEMATIC DIAGRAM			

SCALE: NONE	DATE: 08-23-16	DWN. BY: GPN
DWG. No: 8438CC-5308-D	SHEET: 1 OF 1	CKD. BY: JMD

JOB: CROOKED CREEK EASYGEN UPGRADE

ENGINEERED & MANUFACTURED BY
Controlled Power, Inc.
BOTHELL, WASHINGTON USA
(425)-485-1778 www.controlledpowerinc.com

NOTICE
THE DRAWINGS, INFORMATION AND SUBJECT MATTER HEREOF ARE THE CONFIDENTIAL, SOLE AND EXCLUSIVE PROPERTY OF CONTROLLED POWER, INC., AND ARE NOT TO BE COPIED, REPRODUCED OR USED IN ANY MANNER FOR ANY PURPOSE WHATSOEVER WITHOUT WRITTEN CONSENT OR DIRECTION.

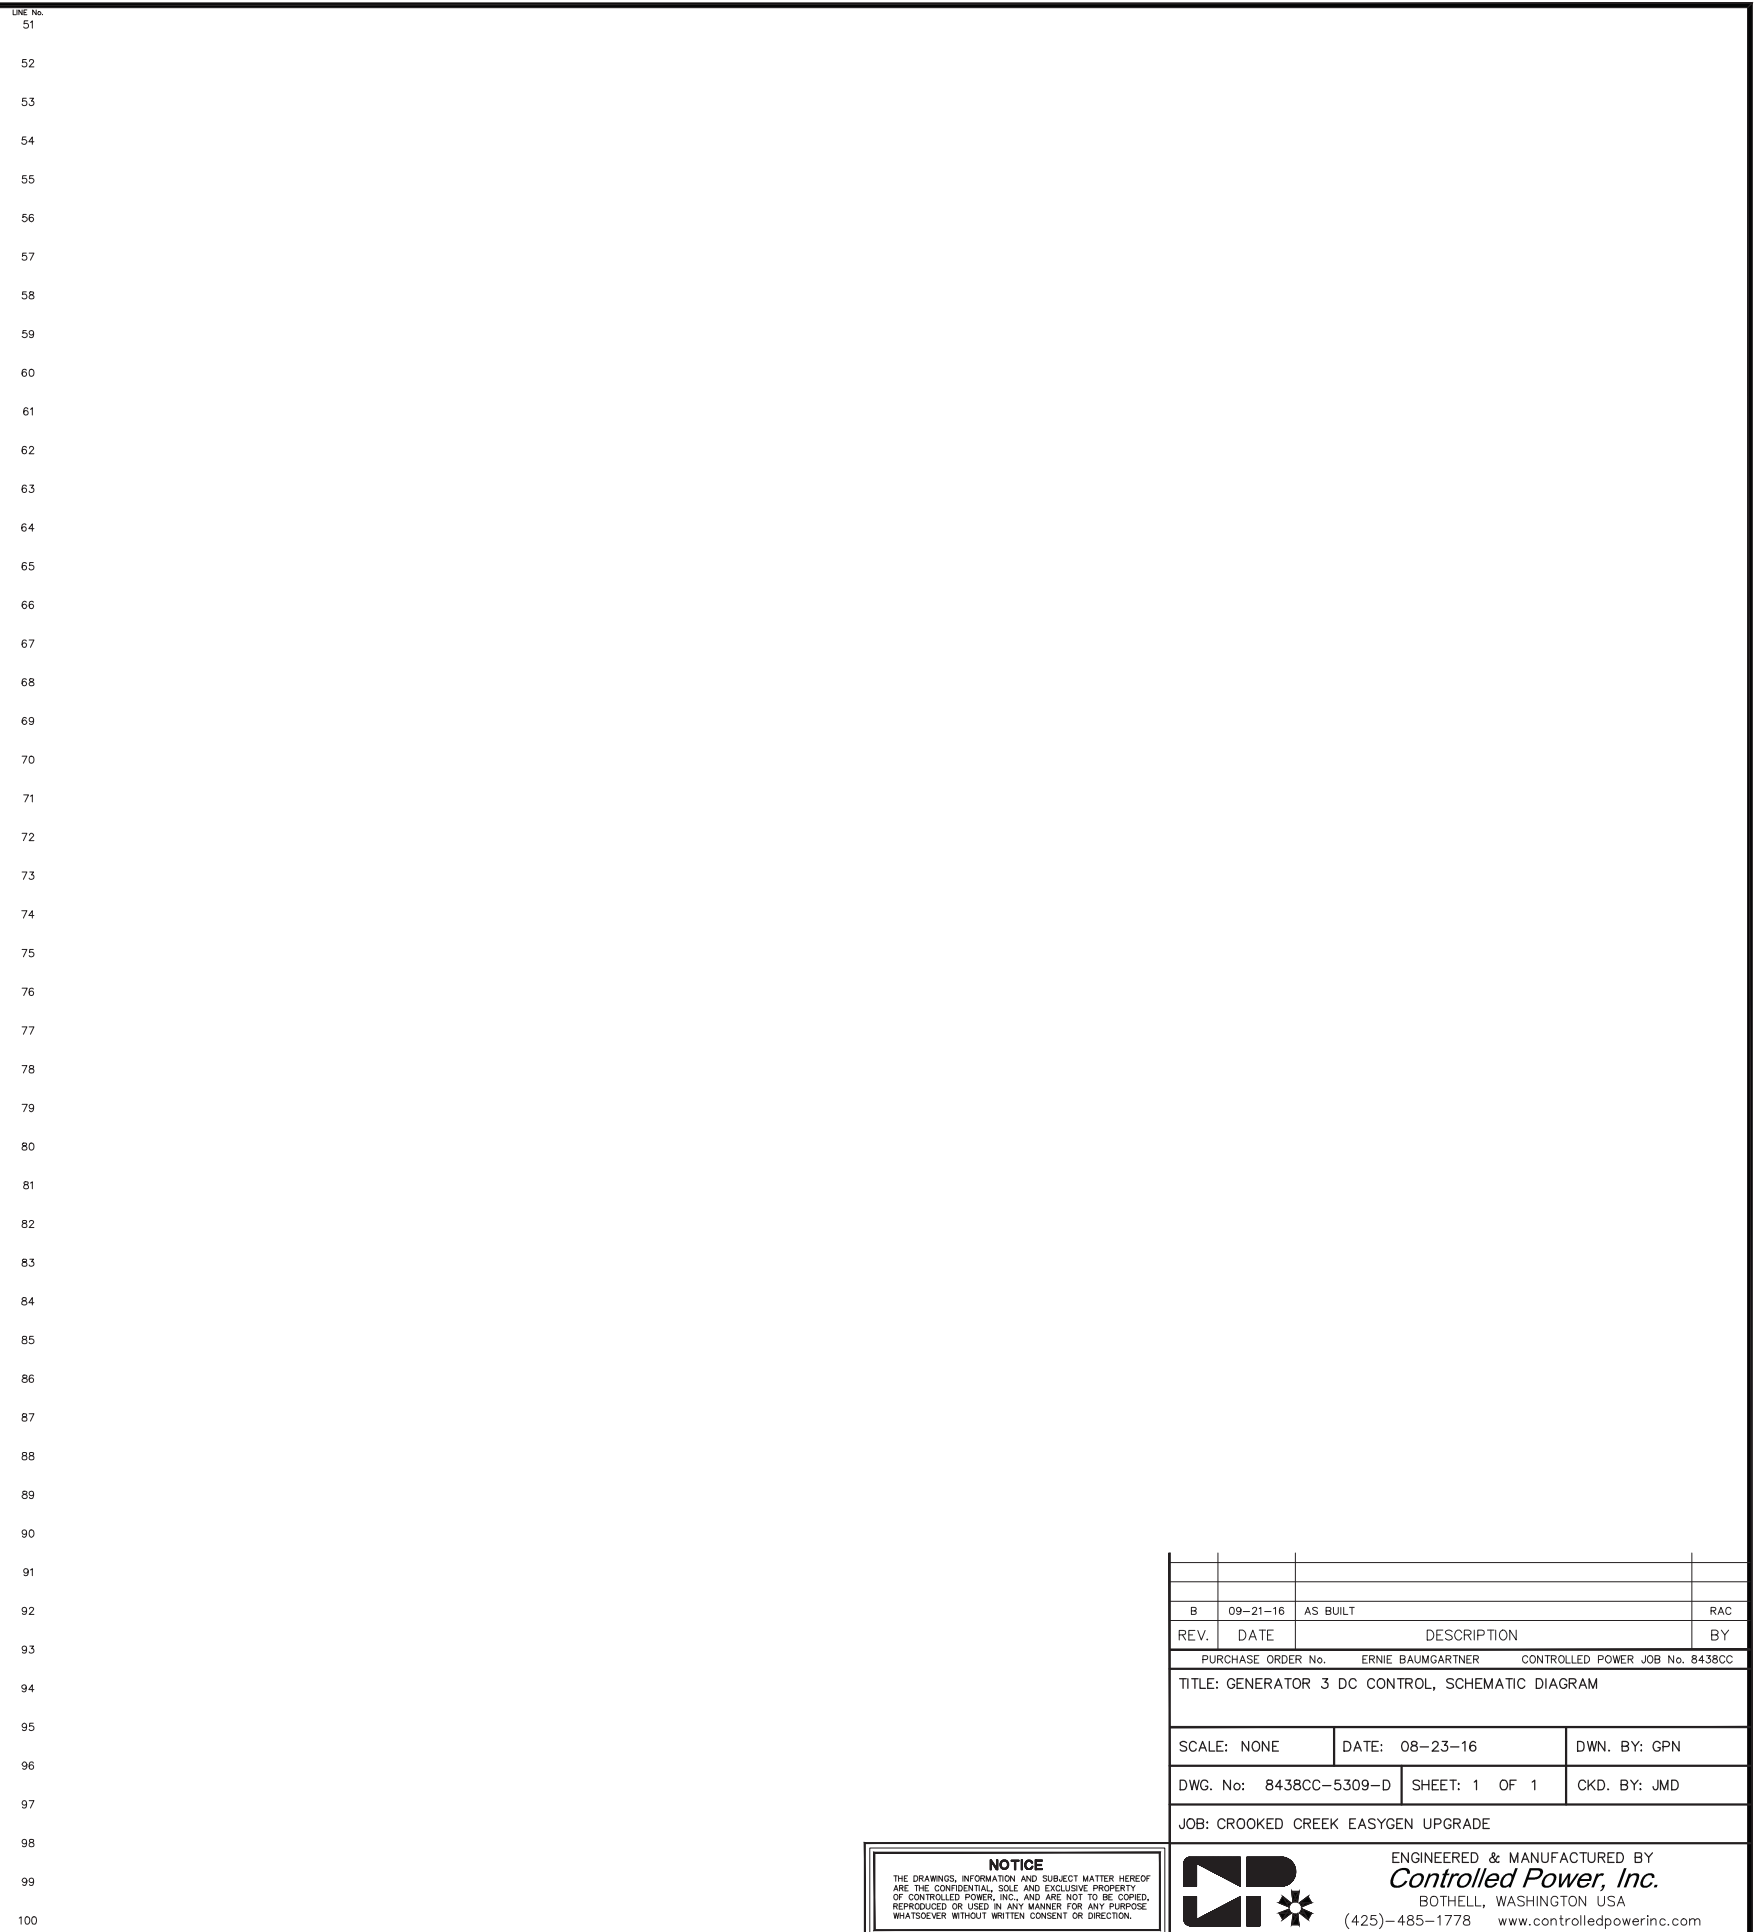
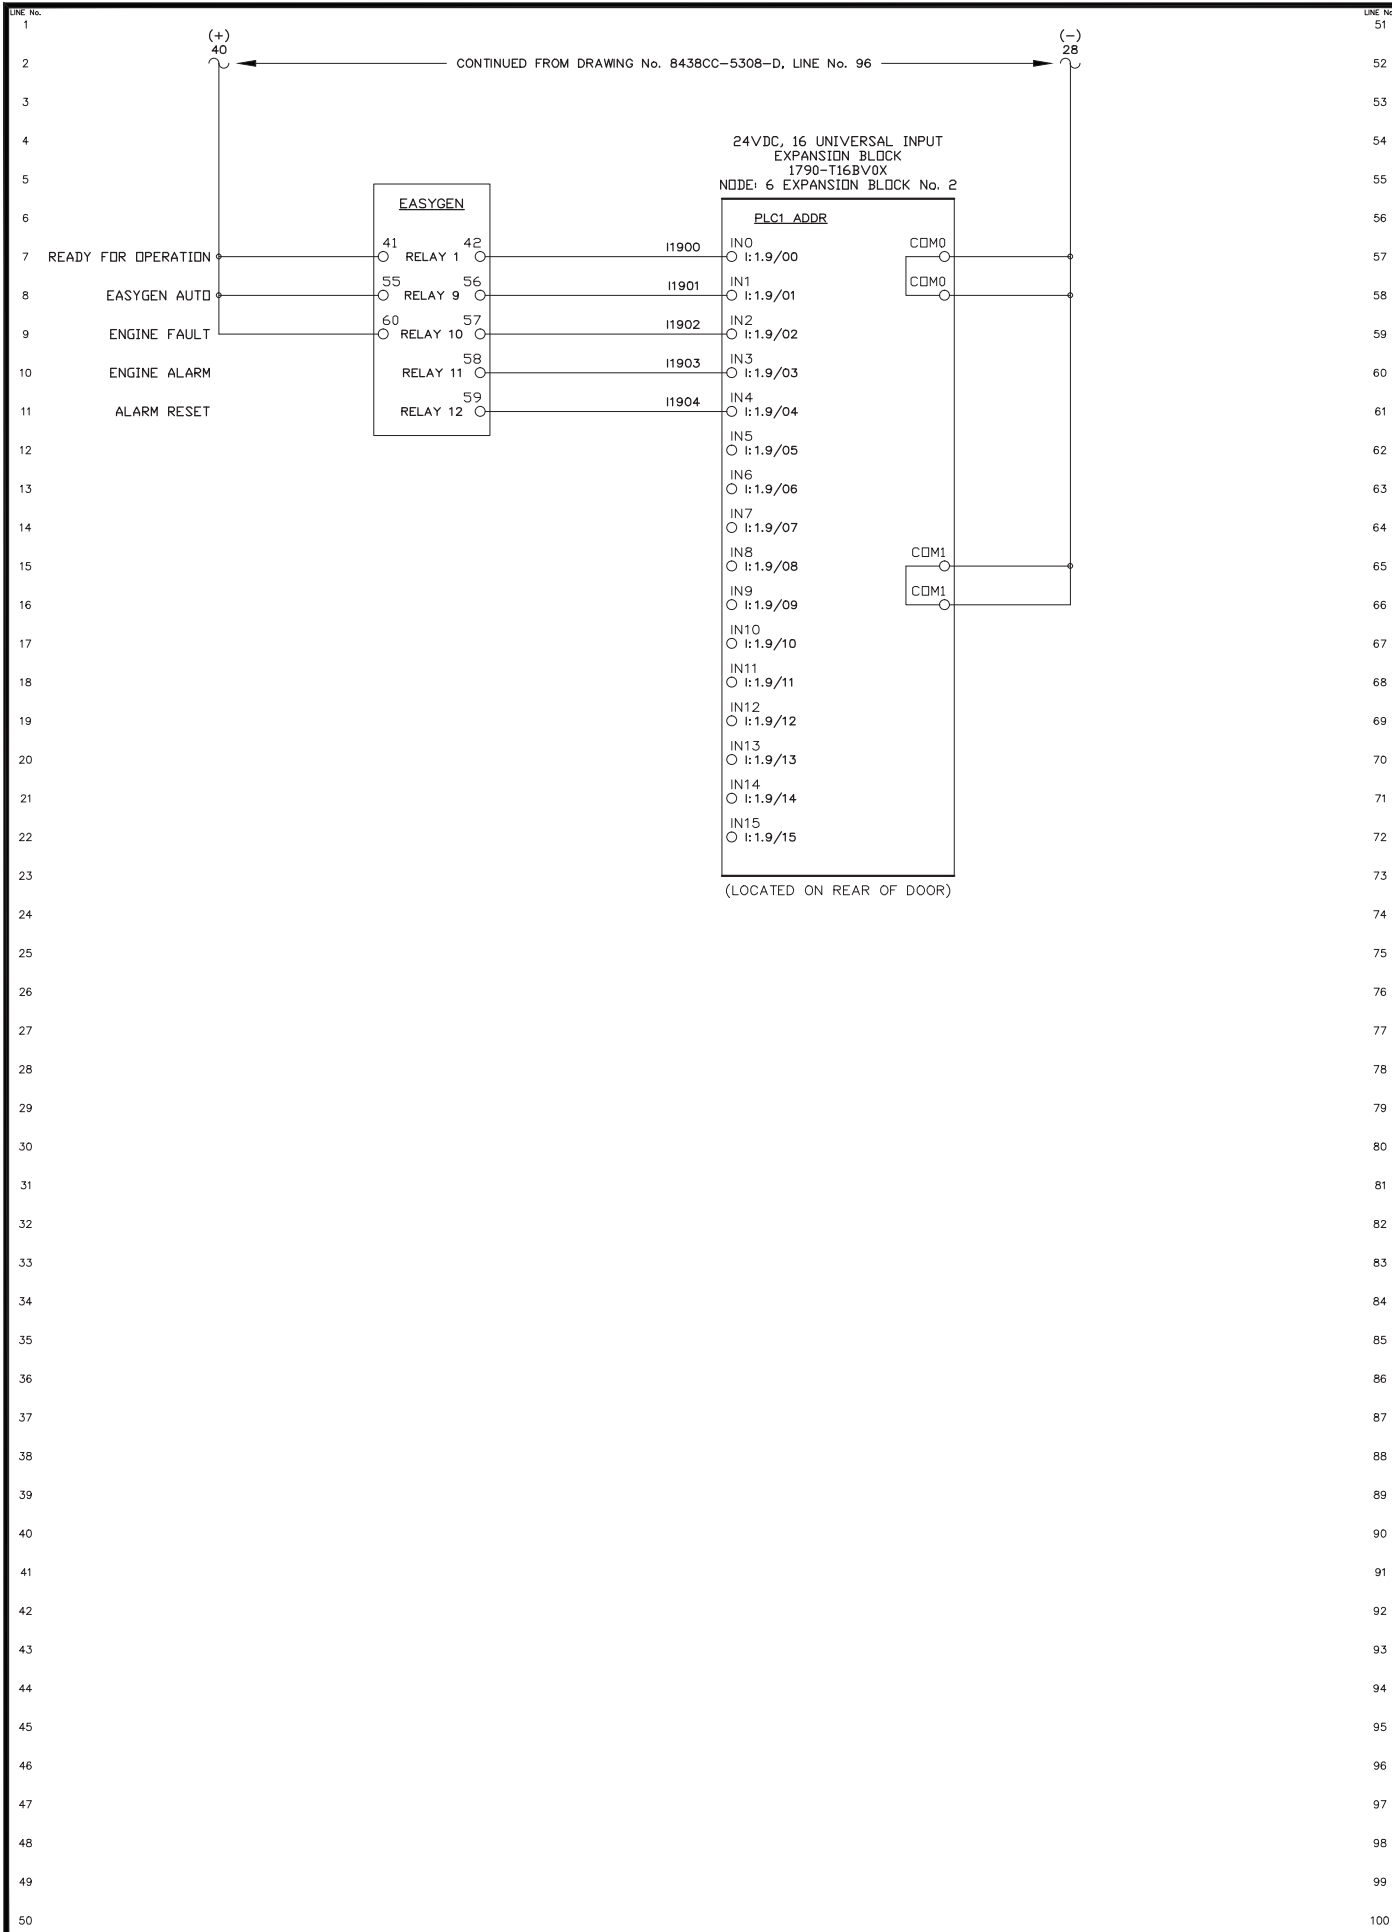


REV.	DATE	DESCRIPTION	BY
B	09-21-16	AS BUILT	RAC
PURCHASE ORDER No. ERNIE BAUMGARTNER CONTROLLED POWER JOB No. 8438CC			
TITLE: GENERATOR 3 DC CONTROL, SCHEMATIC DIAGRAM			
SCALE: NONE	DATE: 08-23-16	DWN. BY: GPN	
DWG. No: 8438CC-5309-D	SHEET: 1 OF 1	CKD. BY: JMD	
JOB: CROOKED CREEK EASYGEN UPGRADE			

NOTICE
THE DRAWINGS, INFORMATION AND SUBJECT MATTER HEREOF ARE THE CONFIDENTIAL, SOLE AND EXCLUSIVE PROPERTY OF CONTROLLED POWER, INC., AND ARE NOT TO BE COPIED, REPRODUCED OR USED IN ANY MANNER FOR ANY PURPOSE WHATSOEVER WITHOUT WRITTEN CONSENT OR DIRECTION.





ENGINEERED & MANUFACTURED BY
Controlled Power, Inc.
BOTHELL, WASHINGTON USA
(425)-485-1778 www.controlledpowerinc.com

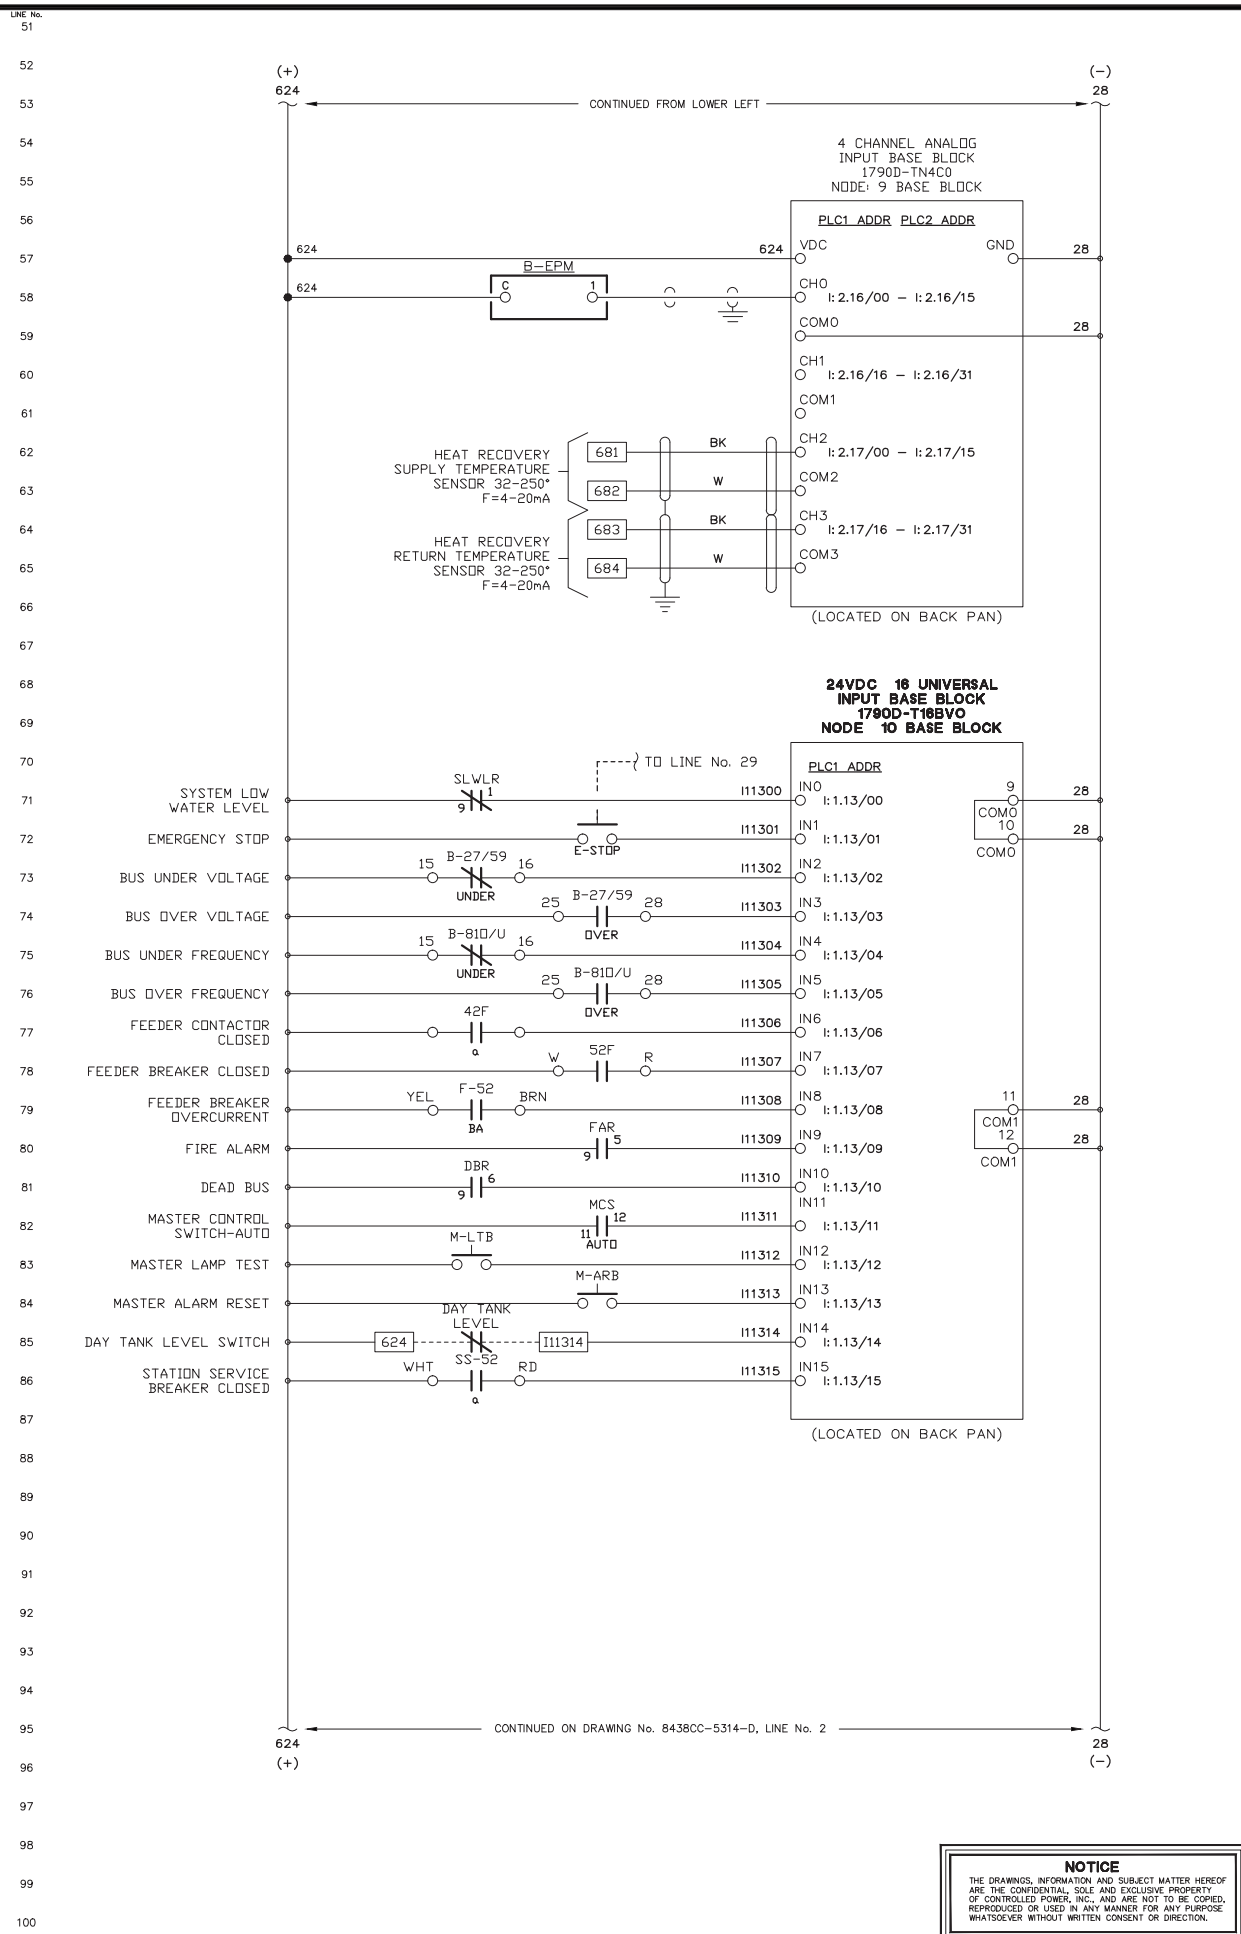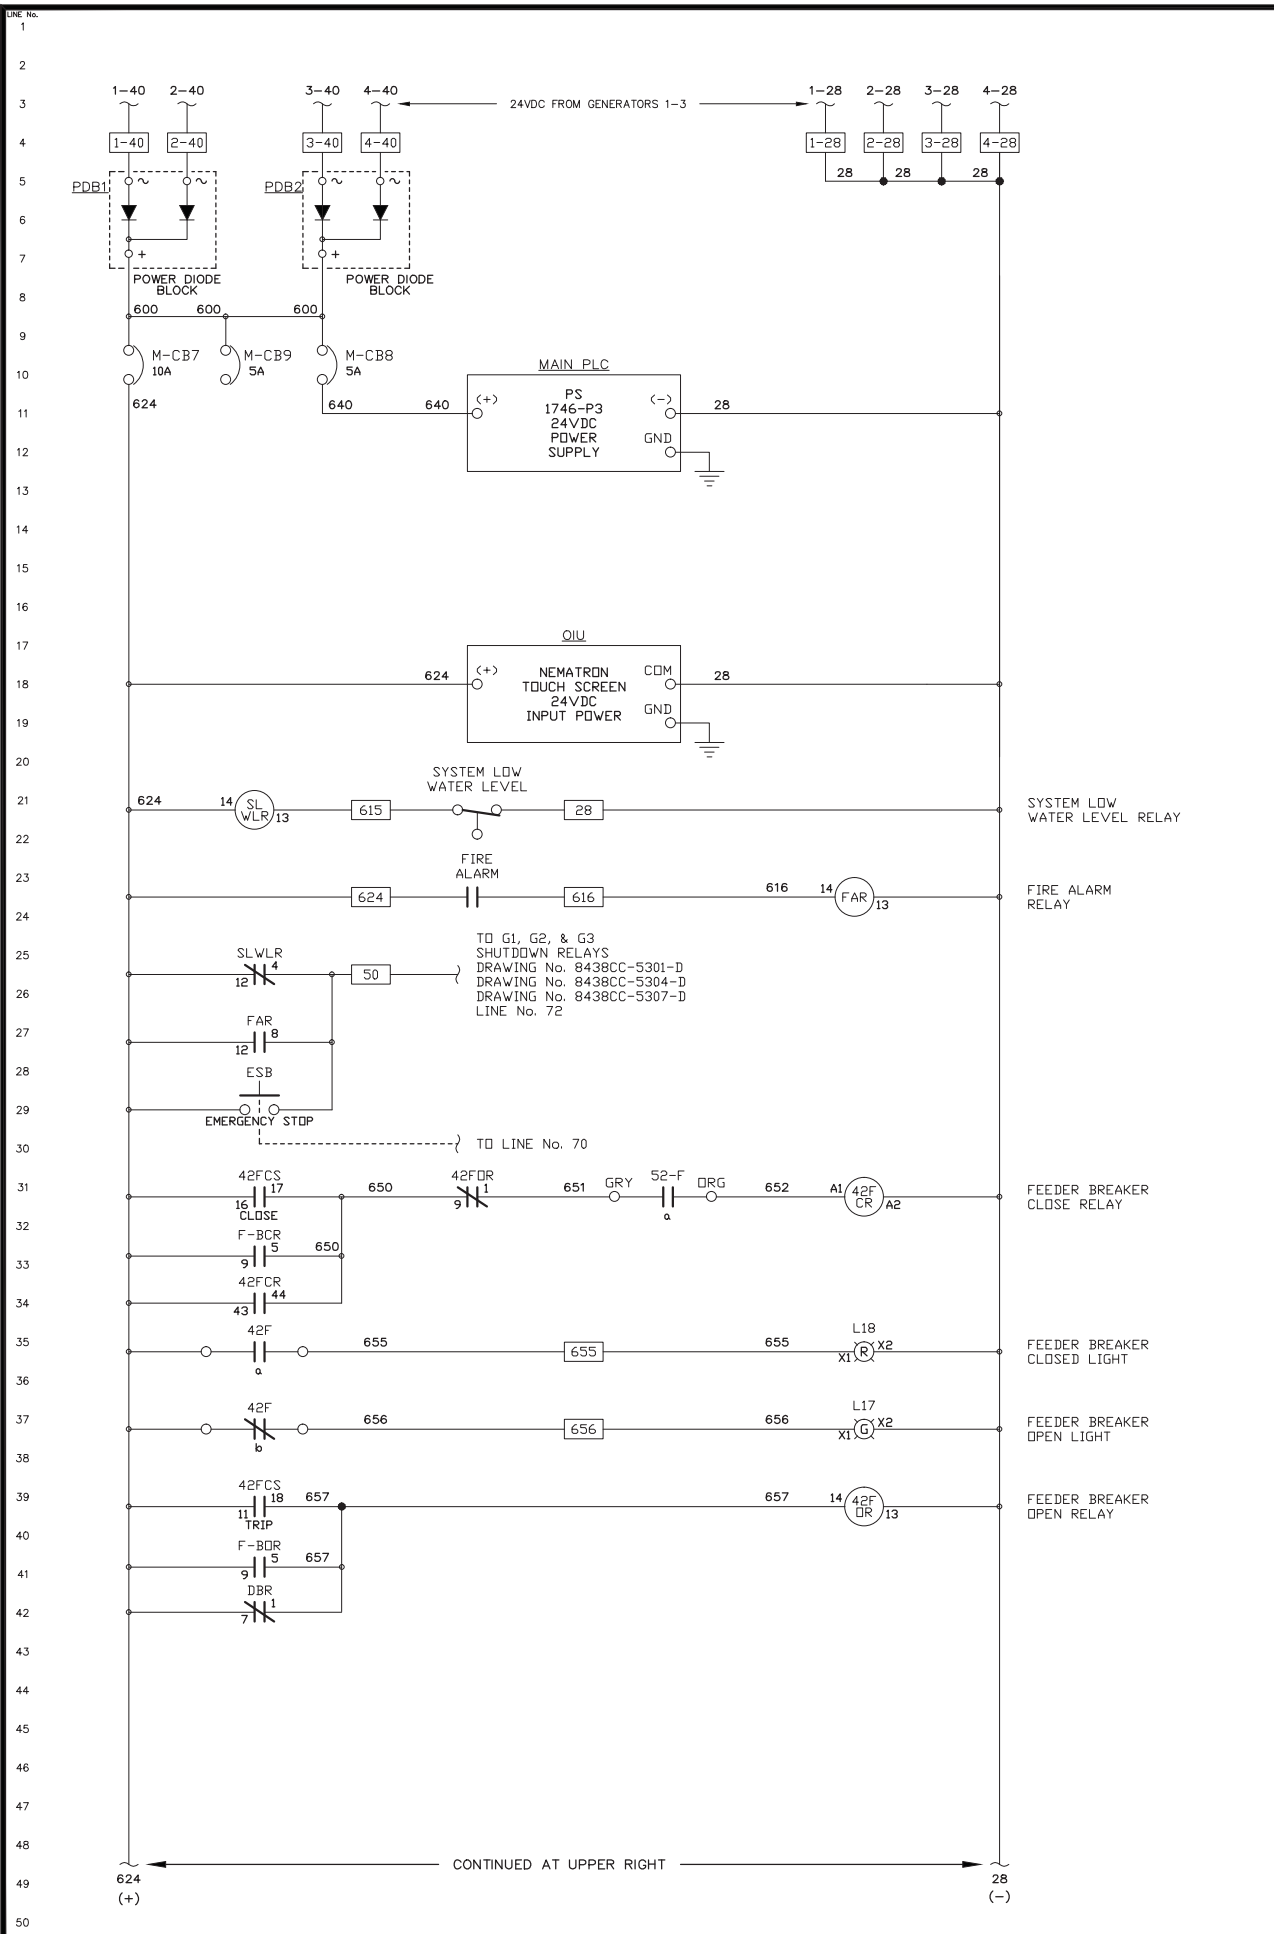

REV.	DATE	DESCRIPTION	BY
B	09-21-16	AS BUILT	RAC
PURCHASE ORDER No. ERNIE BAUMGARTNER CONTROLLED POWER JOB No. 8438CC			
TITLE: MASTER DC CONTROL, SCHEMATIC DIAGRAM			
SCALE: NONE	DATE: 08-23-16	DWN. BY: GPN	
DWG. No: 8438CC-5313-D	SHEET: 1 OF 1	CKD. BY: JMD	
JOB: CROOKED CREEK EASYGEN UPGRADE			

NOTICE
 THE DRAWINGS, INFORMATION AND SUBJECT MATTER HEREOF ARE THE CONFIDENTIAL, SOLE AND EXCLUSIVE PROPERTY OF CONTROLLED POWER, INC., AND ARE NOT TO BE COPIED, REPRODUCED OR USED IN ANY MANNER FOR ANY PURPOSE WHATSOEVER WITHOUT WRITTEN CONSENT OR DIRECTION.


ENGINEERED & MANUFACTURED BY
Controlled Power, Inc.
 BOTHELL, WASHINGTON USA
 (425)-485-1778 www.controlledpowerinc.com

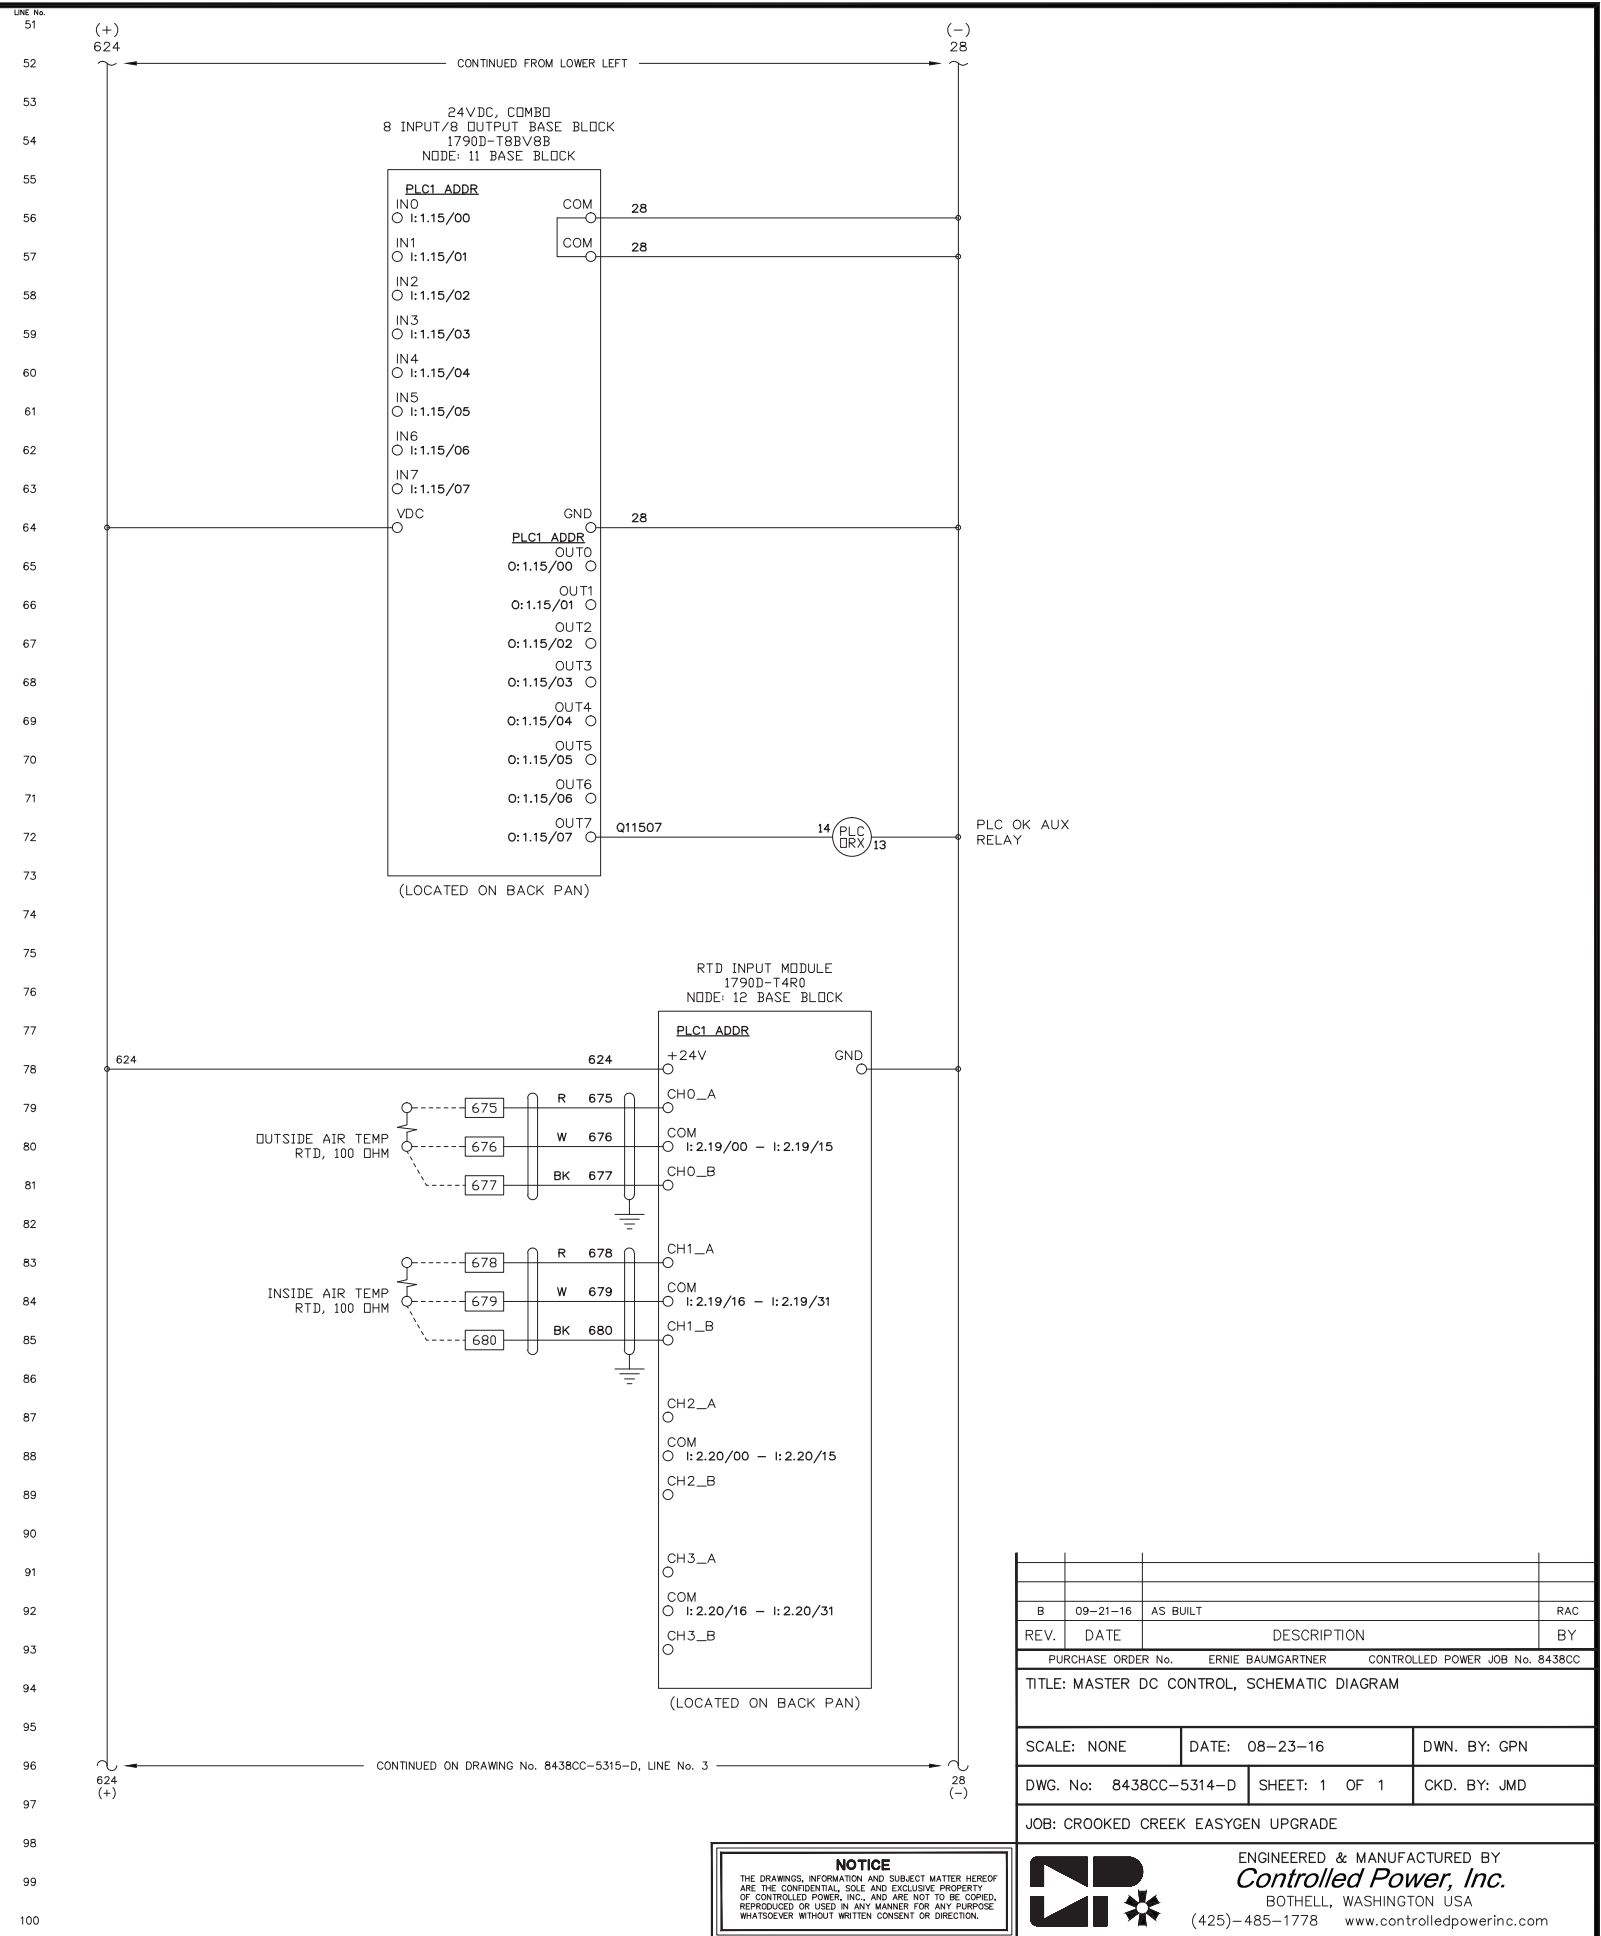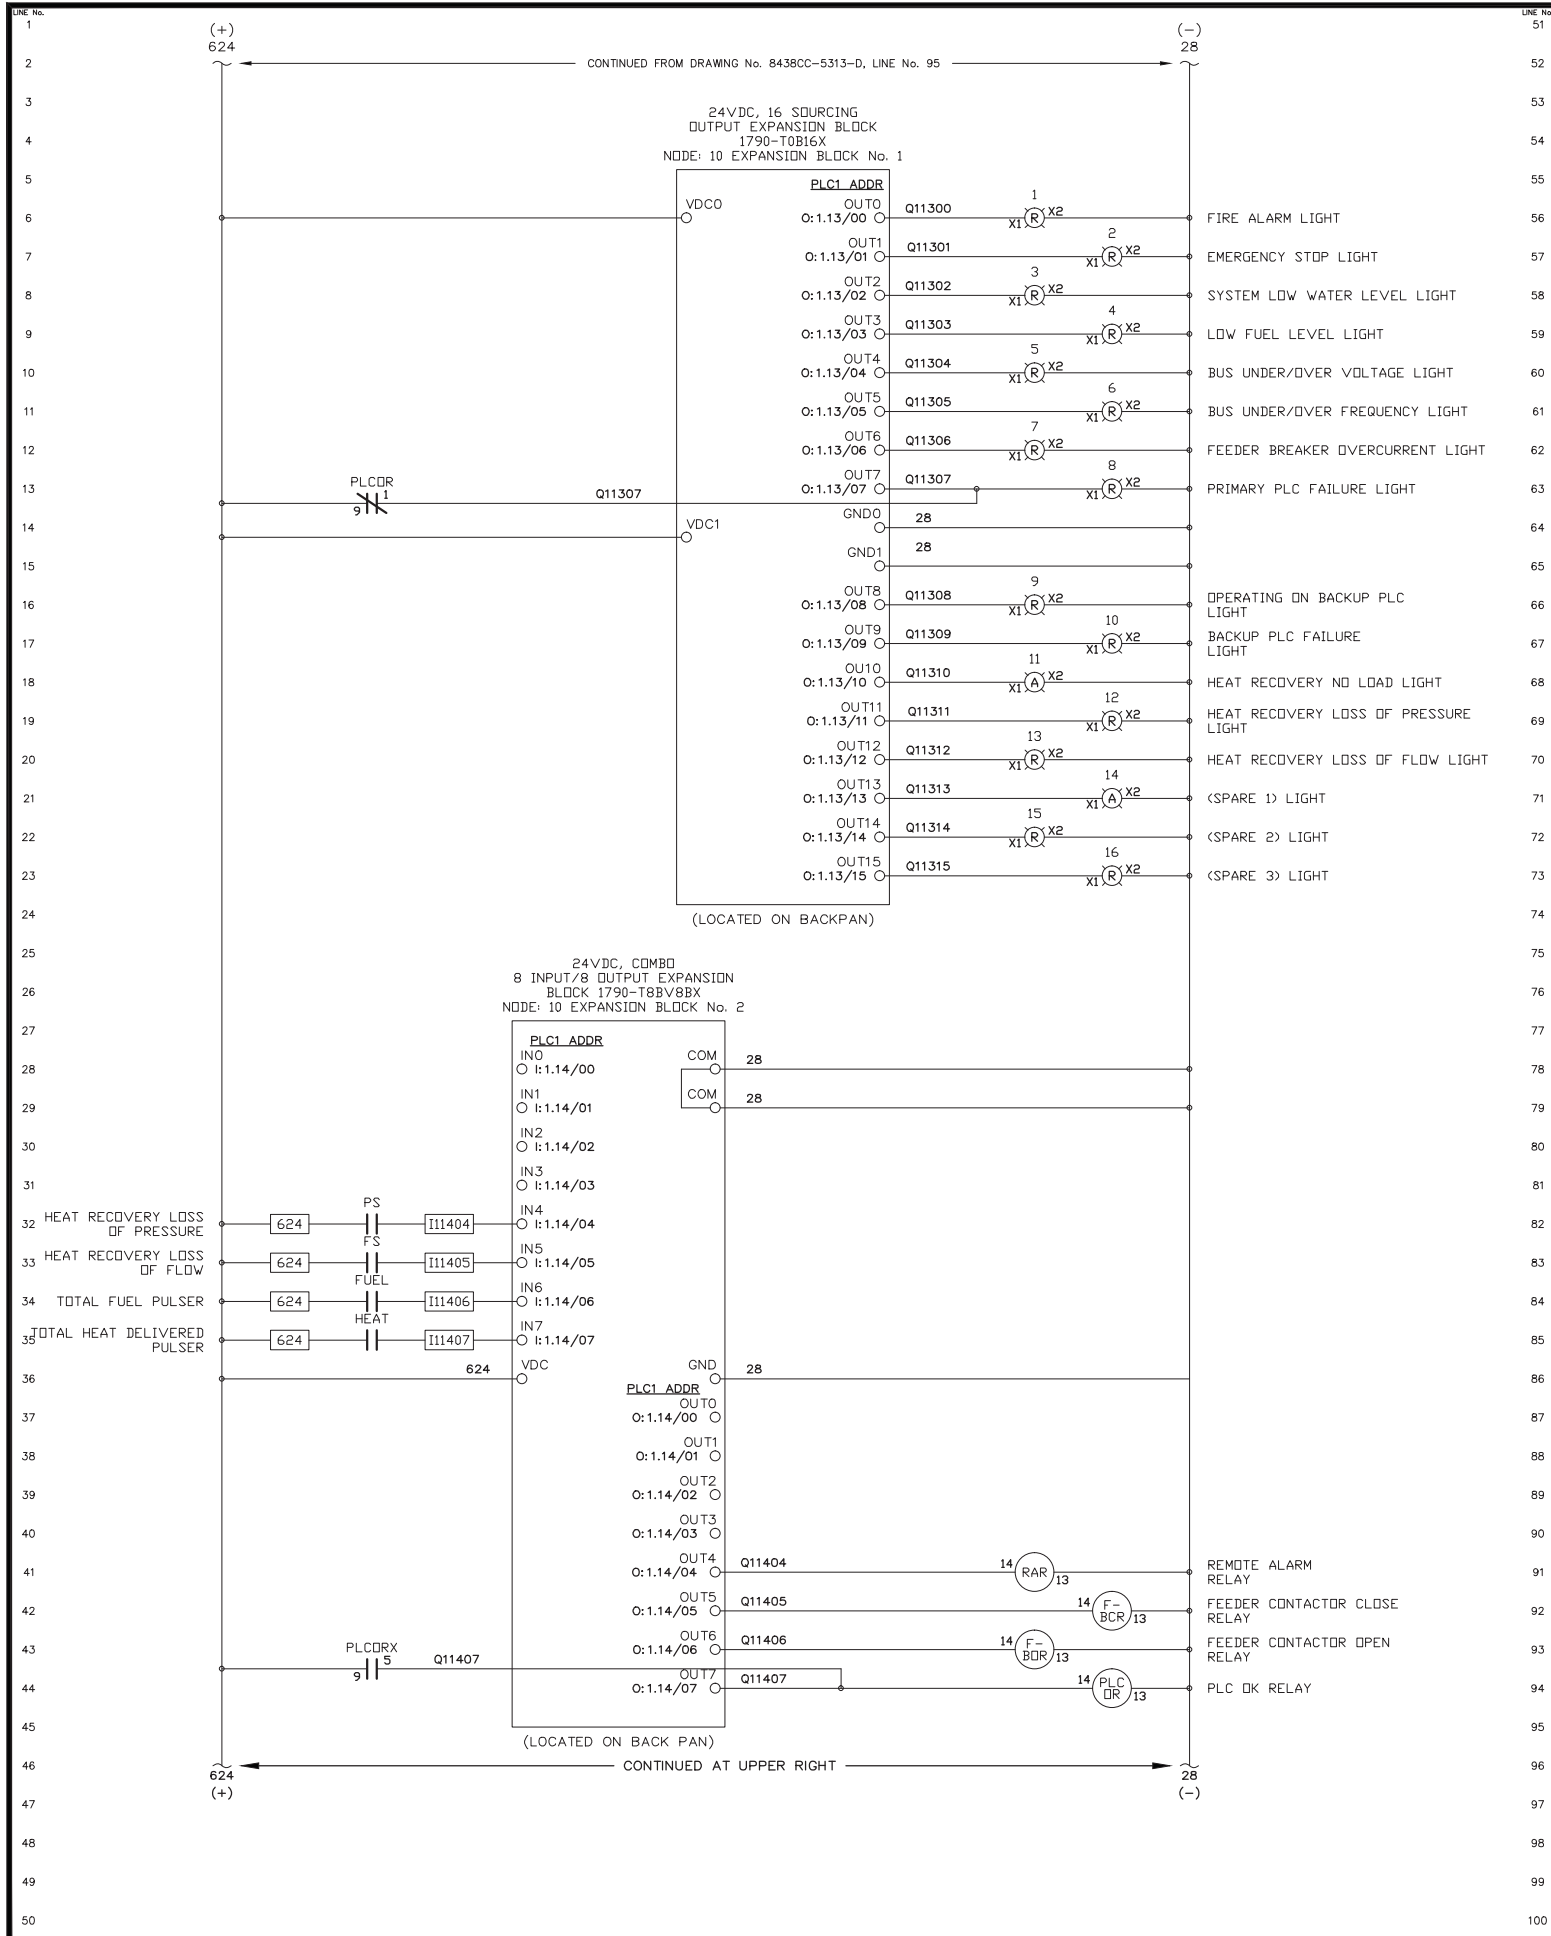

REV.	DATE	DESCRIPTION	BY
B	09-21-16	AS BUILT	RAC
PURCHASE ORDER No. ERNIE BAUMGARTNER CONTROLLED POWER JOB No. 8438CC			
TITLE: MASTER DC CONTROL, SCHEMATIC DIAGRAM			
SCALE: NONE	DATE: 08-23-16	DWN. BY: GPN	
DWG. No: 8438CC-5314-D	SHEET: 1 OF 1	CKD. BY: JMD	
JOB: CROOKED CREEK EASYGEN UPGRADE			

NOTICE
THE DRAWINGS, INFORMATION AND SUBJECT MATTER HEREOF ARE THE CONFIDENTIAL, SOLE AND EXCLUSIVE PROPERTY OF CONTROLLED POWER, INC., AND ARE NOT TO BE COPIED, REPRODUCED OR USED IN ANY MANNER FOR ANY PURPOSE WHATSOEVER WITHOUT WRITTEN CONSENT OR DIRECTION.



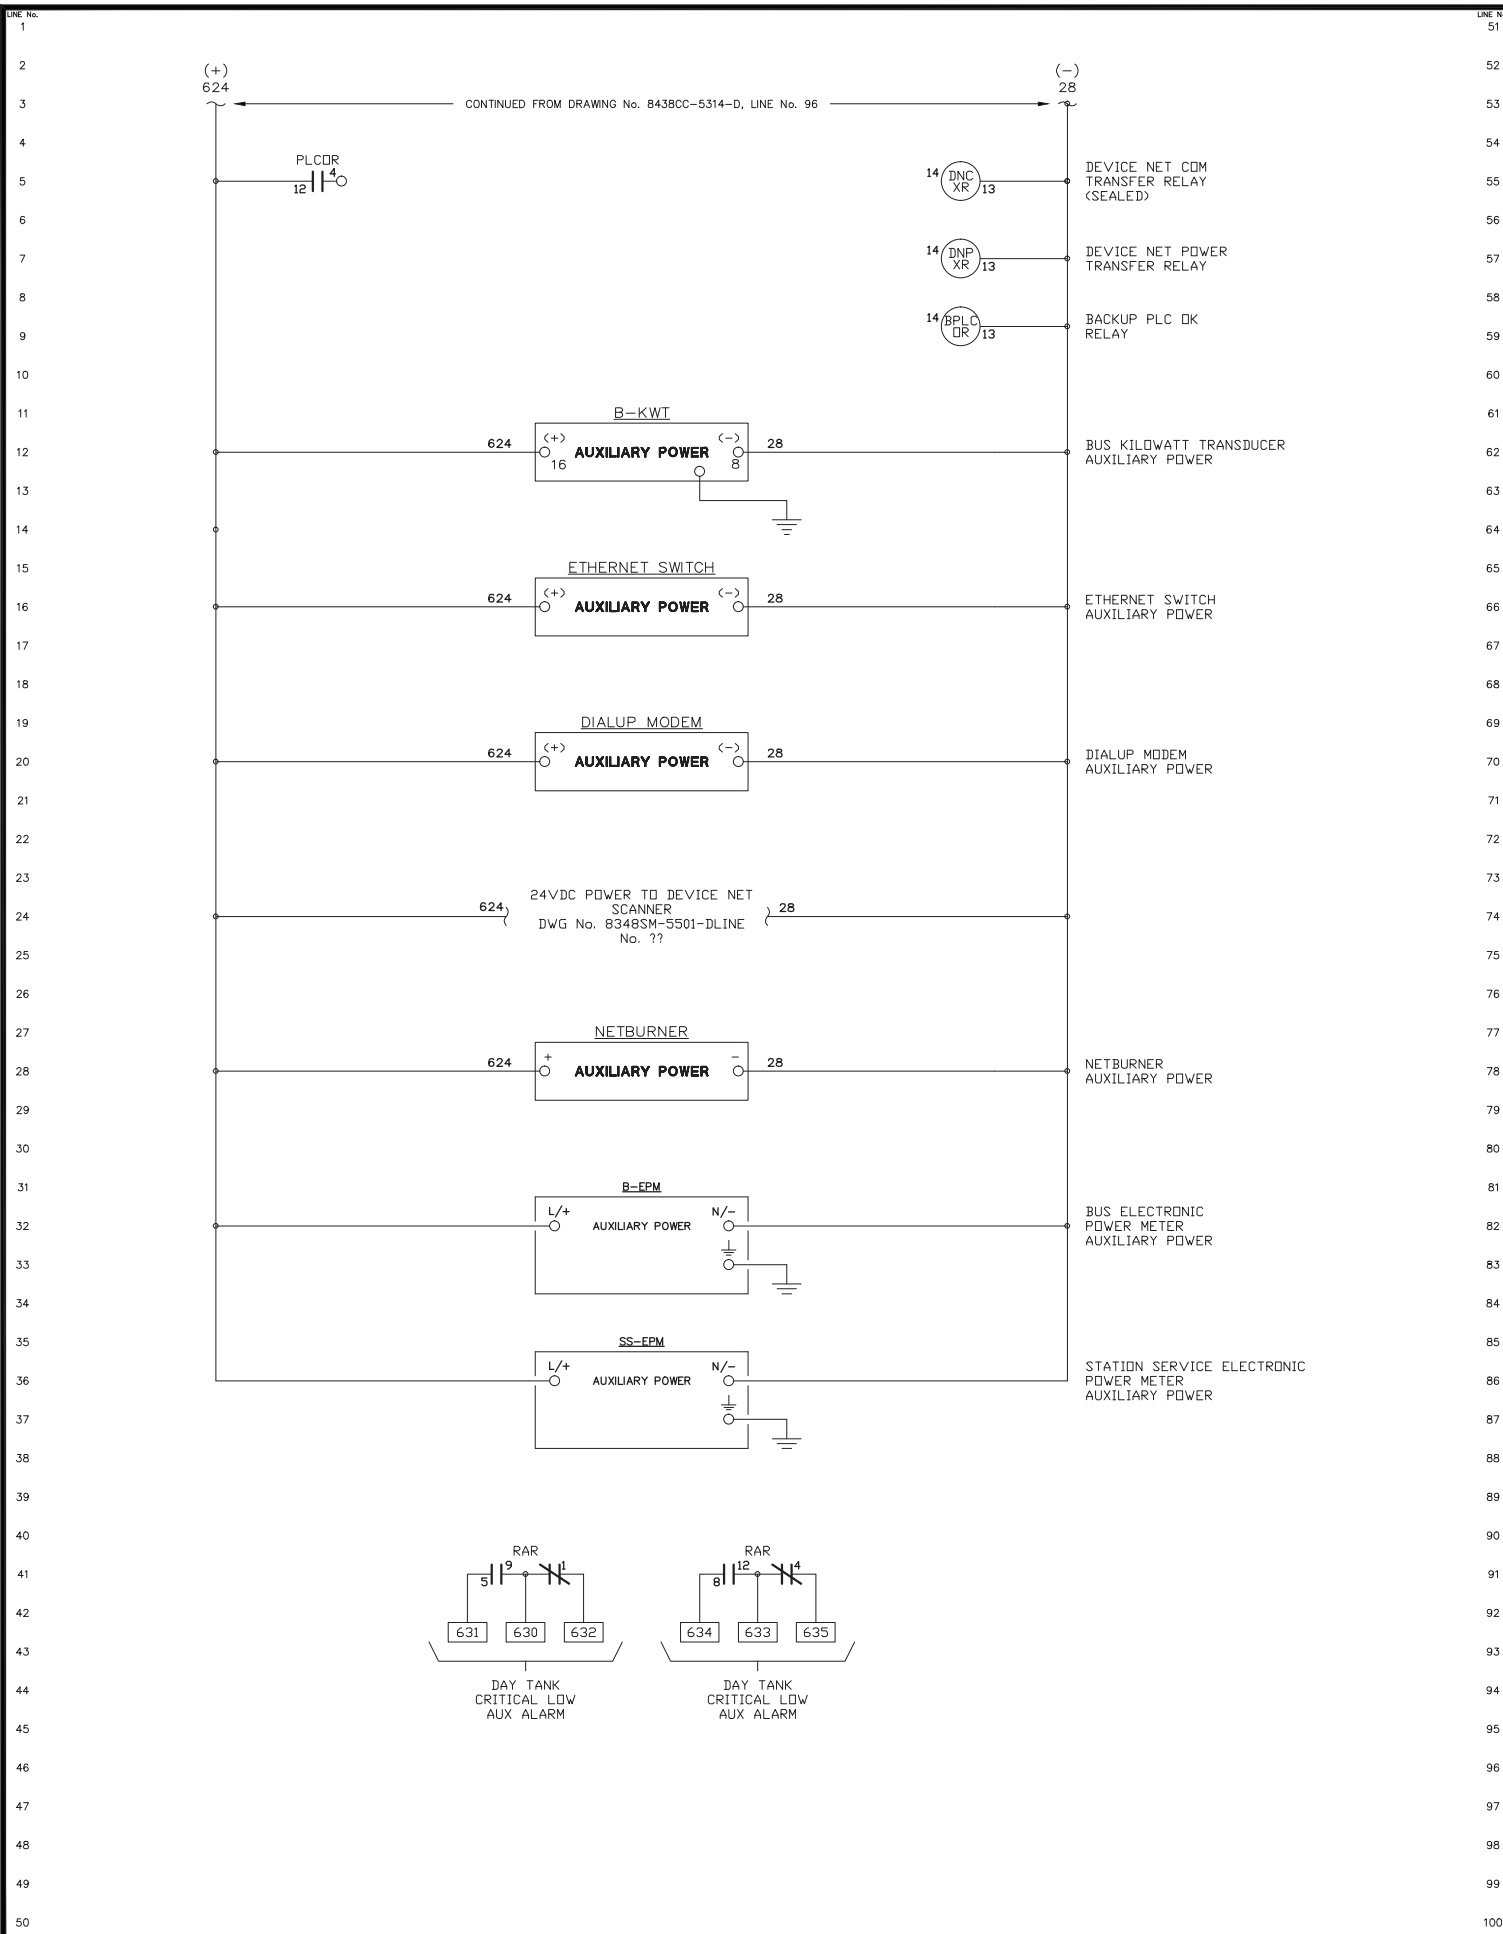

LINE No. 51 52 53 54 55 56 57 58 59 60 61 62 63 64 65 66 67 68 69 70 71 72 73 74 75 76 77 78 79 80 81 82 83 84 85 86 87 88 89 90 91 92 93 94 95 96 97 98 99 100

REV.	DATE	DESCRIPTION	BY
B	09-21-16	AS BUILT	RAC

PURCHASE ORDER No. ERNIE BAUMGARTNER CONTROLLED POWER JOB No. 8438CC

TITLE: MASTER DC CONTROL, SCHEMATIC DIAGRAM

SCALE: NONE DATE: 08-23-16 DWN. BY: GPN


DWG. No: 8438CC-5315-D SHEET: 1 OF 1 CKD. BY: JMD

JOB: CROOKED CREEK EASYGEN UPGRADE

NOTICE

THE DRAWINGS, INFORMATION AND SUBJECT MATTER HEREOF ARE THE CONFIDENTIAL, SOLE AND EXCLUSIVE PROPERTY OF CONTROLLED POWER, INC., AND ARE NOT TO BE COPIED, REPRODUCED OR USED IN ANY MANNER FOR ANY PURPOSE WHATSOEVER WITHOUT WRITTEN CONSENT OR DIRECTION.

ENGINEERED & MANUFACTURED BY
Controlled Power, Inc.
BOTHELL, WASHINGTON USA
(425)-485-1778 www.controlledpowerinc.com

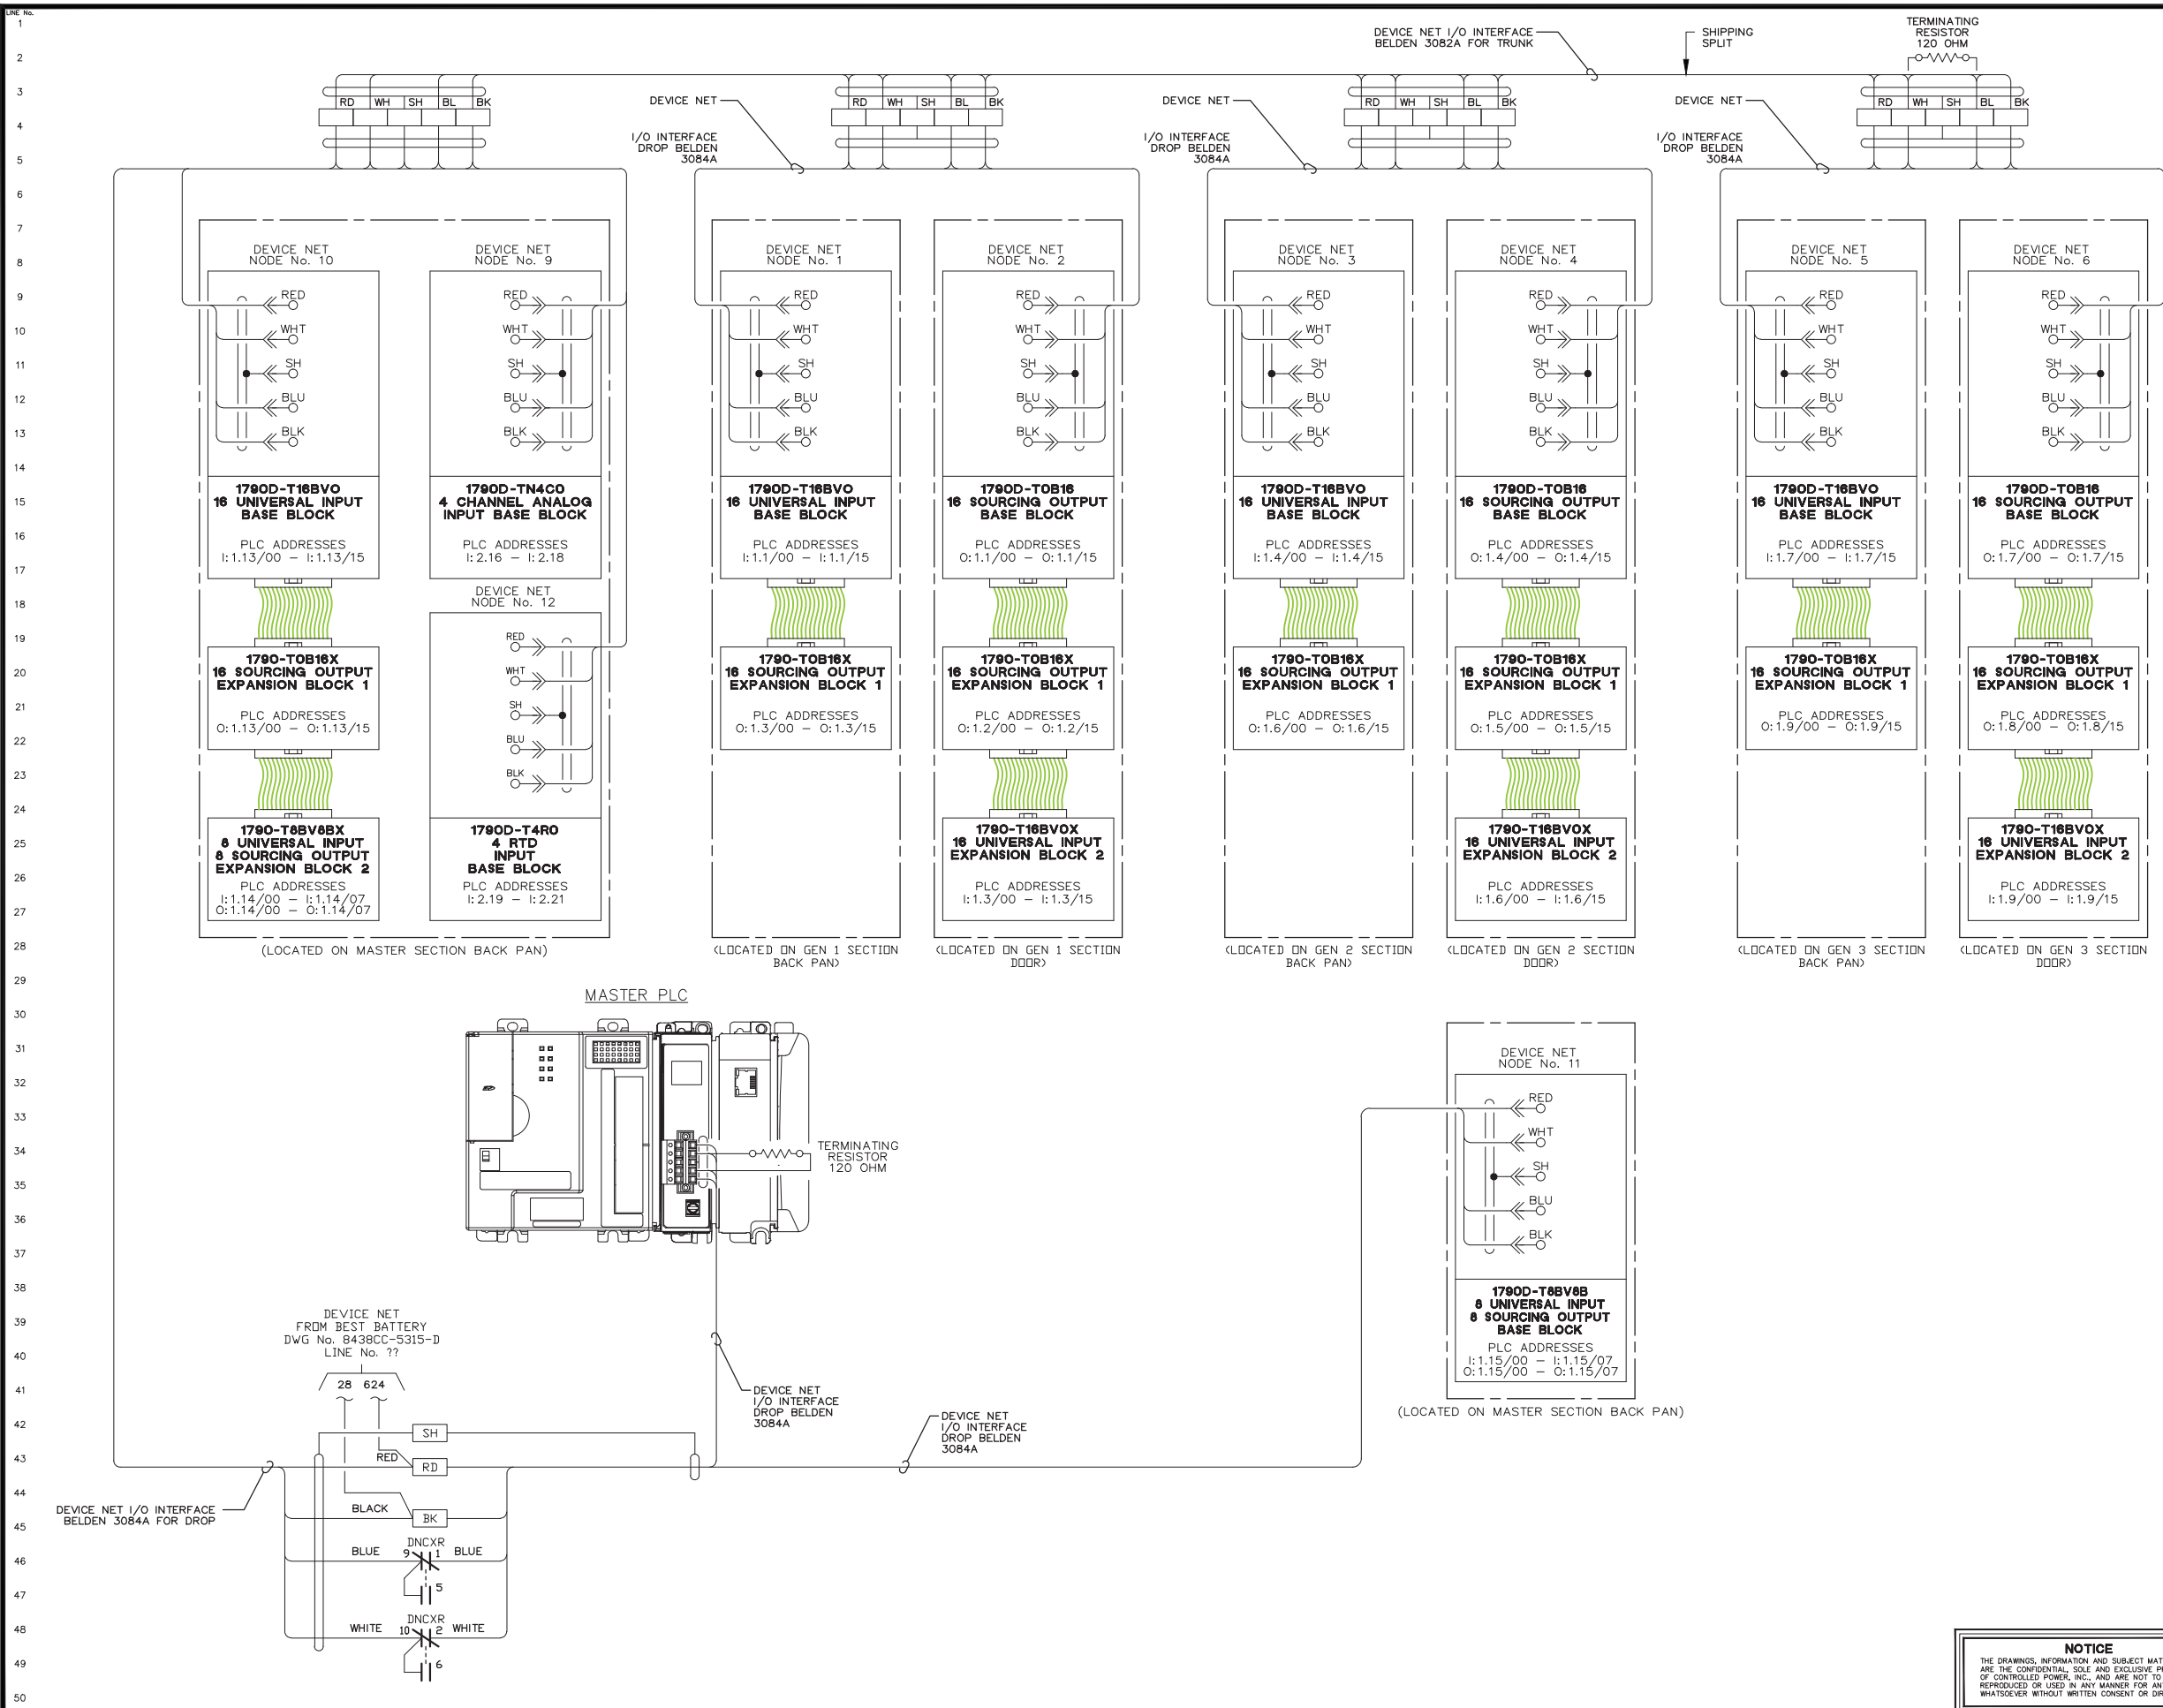


B	09-21-16	AS BUILT		RAC
REV.	DATE	DESCRIPTION		BY
PURCHASE ORDER No. ERNIE BAUMGARTNER CONTROLLED POWER JOB No. 8438CC				
TITLE: PLC COMMUNICATION DIAGRAM				
SCALE: NONE	DATE: 08-23-16	DWN. BY: GPN		
DWG. No: 8438CC-5501-D	SHEET: 1 OF 1	CKD. BY: JMD		
JOB: CROOKED CREEK EASYGEN UPGRADE				

NOTICE
THE DRAWINGS, INFORMATION AND SUBJECT MATTER HEREOF ARE THE CONFIDENTIAL, SOLE AND EXCLUSIVE PROPERTY OF CONTROLLED POWER, INC., AND ARE NOT TO BE COPIED, REPRODUCED OR USED IN ANY MANNER FOR ANY PURPOSE WHATSOEVER WITHOUT WRITTEN CONSENT OR DIRECTION.

ENGINEERED & MANUFACTURED BY
Controlled Power, Inc.
BOTHELL, WASHINGTON USA
(425)-485-1778 www.controlleddpowerinc.com

LINE No.
1
2
DEVICE	IP ADDRESS
SERVER	192.168.1.142
OIU	192.168.1.182
PLC CPU	192.168.1.183
PLC PROSOFT	192.168.1.187
BUS EPM	192.168.1.190
SS EPM	192.168.1.191
G1 EZGEN	192.168.1.161
G2 EZGEN	192.168.1.162
G3 EZGEN	192.168.1.163

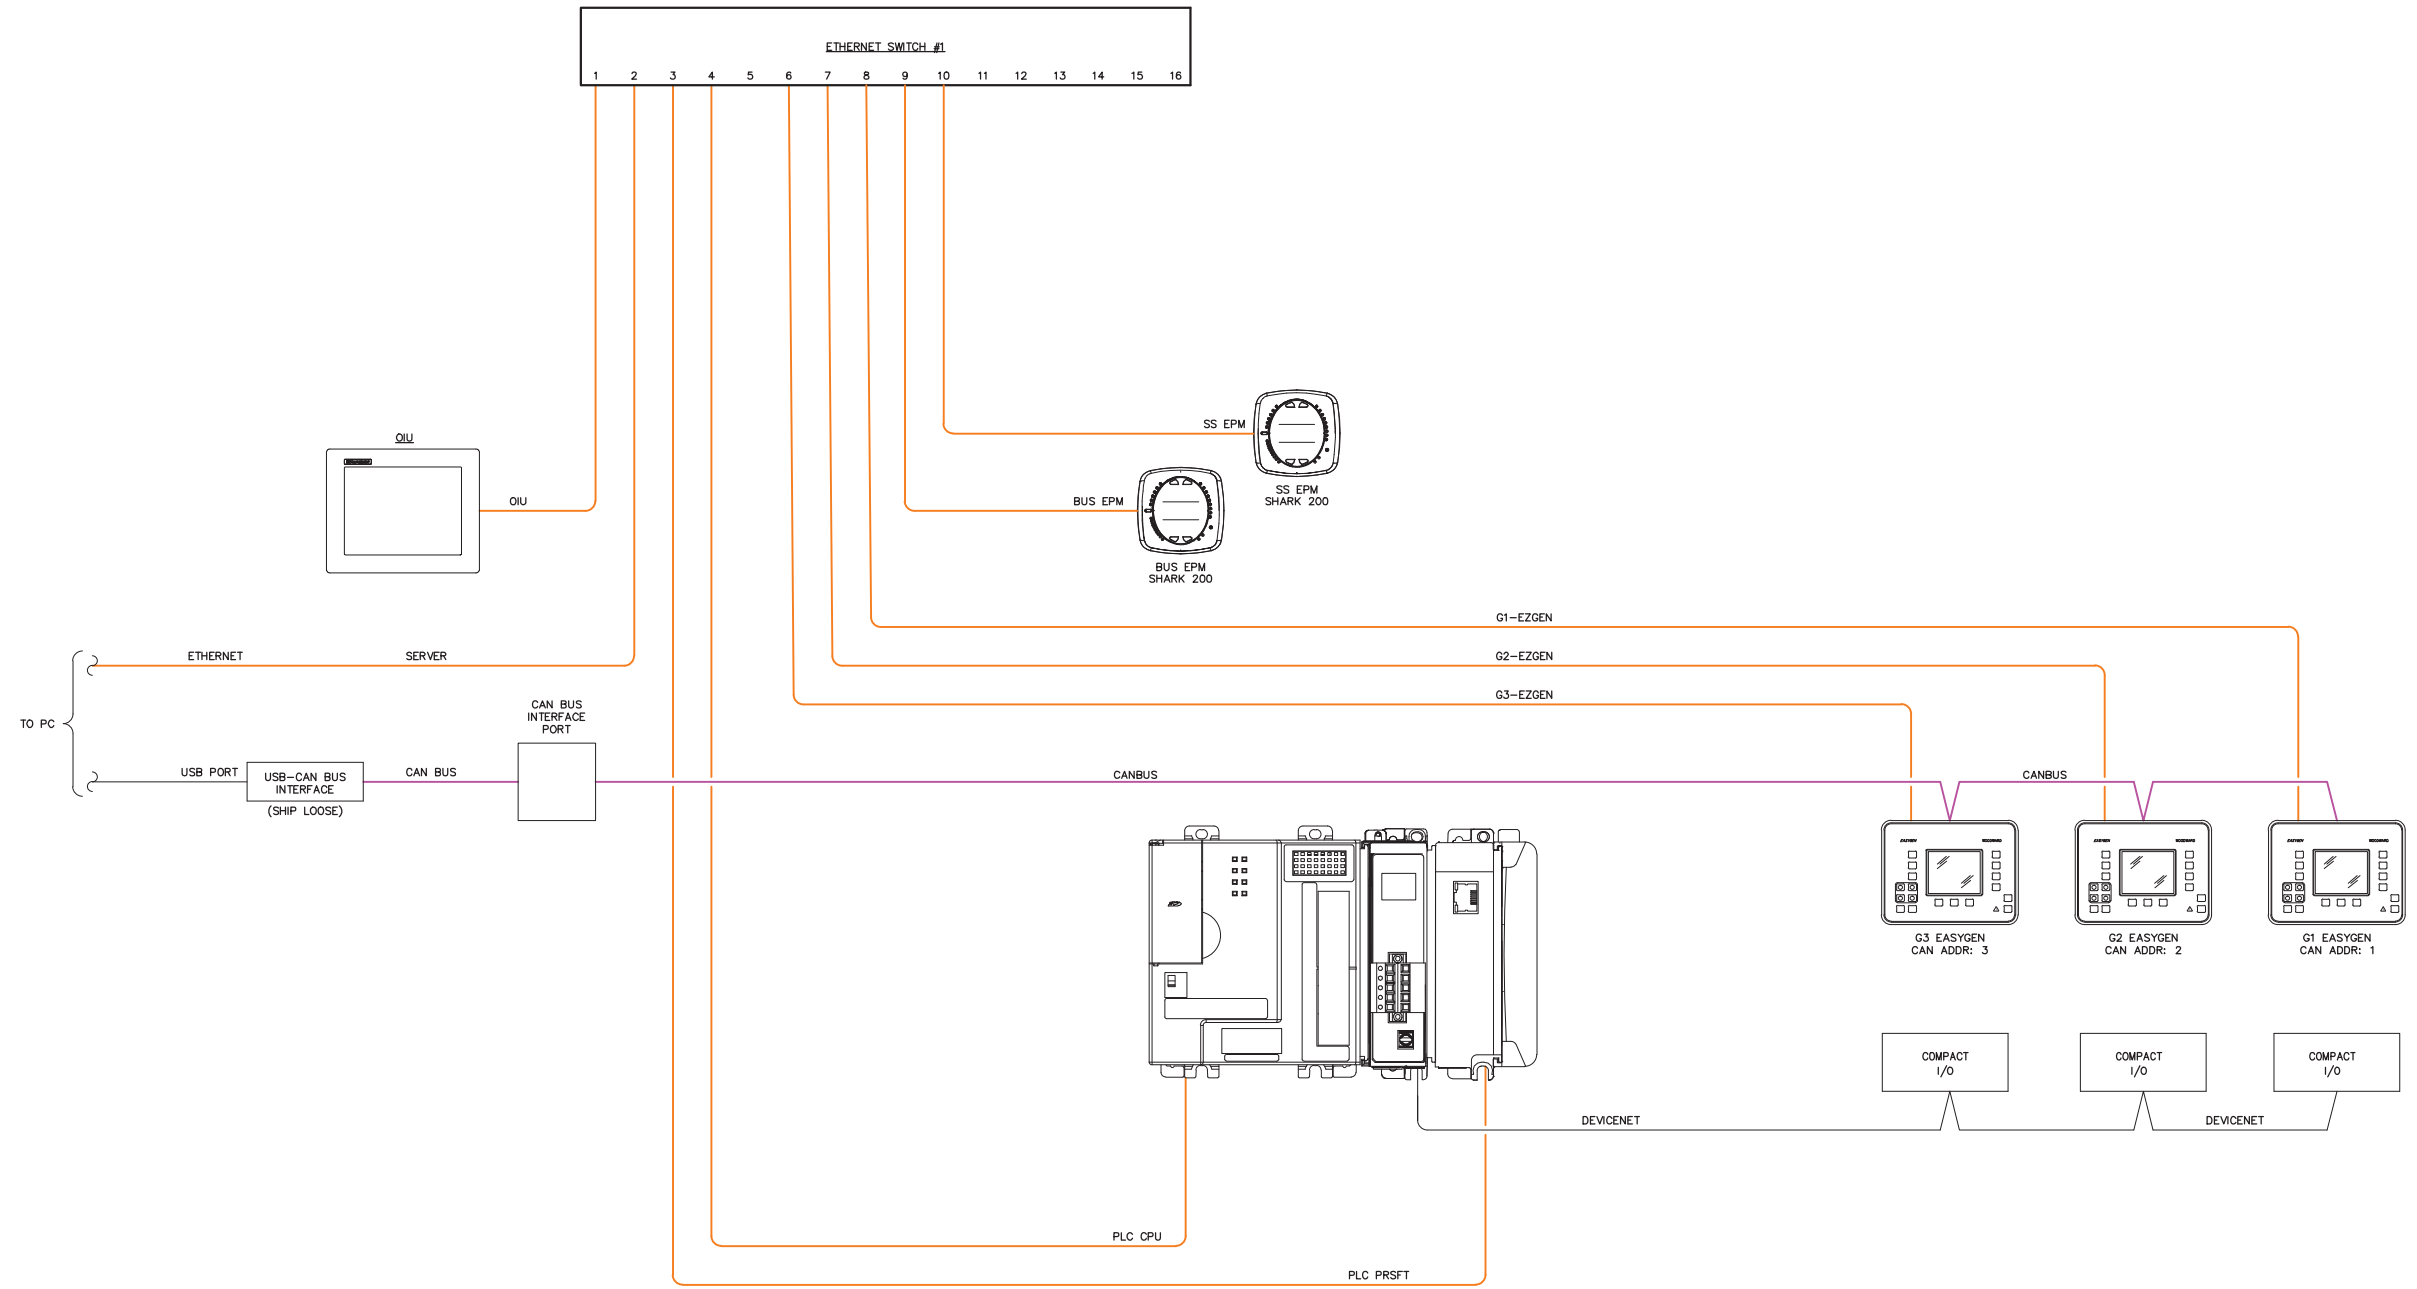

REV.	DATE	DESCRIPTION	BY
B	09-21-16	AS BUILT	RAC

PURCHASE ORDER No. ERNIE BAUMGARTNER CONTROLLED POWER JOB No. 8438CC

TITLE: COMMUNICATION NETWORK DIAGRAM

SCALE: NONE	DATE: 08-23-16	DWN. BY: GPN
DWG. No: 8438CC-5601-D	SHEET: 1 OF 1	CKD. BY: JMD


JOB: CROOKED CREEK EASYGEN UPGRADE

NOTICE
THE DRAWINGS, INFORMATION AND SUBJECT MATTER HEREOF ARE THE CONFIDENTIAL, SOLE AND EXCLUSIVE PROPERTY OF CONTROLLED POWER, INC., AND ARE NOT TO BE COPIED, REPRODUCED OR USED IN ANY MANNER FOR ANY PURPOSE WHATSOEVER WITHOUT WRITTEN CONSENT OR DIRECTION.



ENGINEERED & MANUFACTURED BY
Controlled Power, Inc.
BOTHELL, WASHINGTON USA
(425)-485-1778 www.controlledpowerinc.com

LINE No.
1
2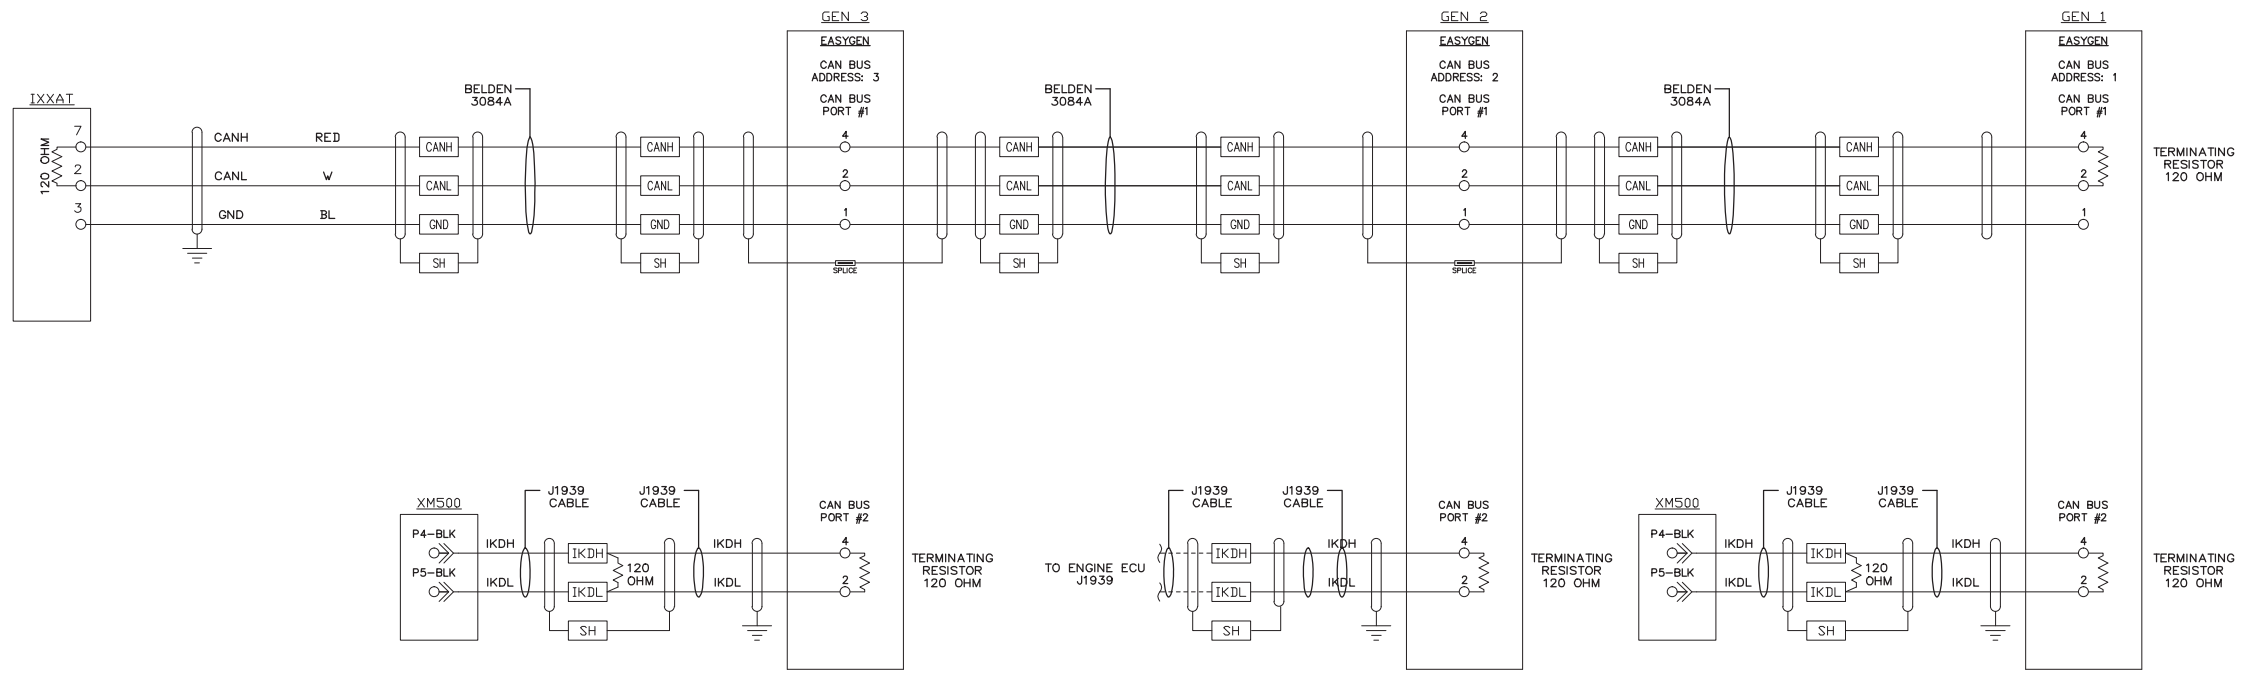
REV.	DATE	DESCRIPTION	BY
B	09-21-16	AS BUILT	RAC
PURCHASE ORDER No. ERNIE BAUMGARTNER CONTROLLED POWER JOB No. 8438CC			
TITLE: EPM MONITORING & SYSTEM COMMUNICATION DIAGRAM			
SCALE: NONE	DATE: 08-23-16	DWN. BY: GPN	
DWG. No: 8438CC-5602-D	SHEET: 1 OF 1	CKD. BY: JMD	
JOB: CROOKED CREEK EASYGEN UPGRADE			

NOTICE
THE DRAWINGS, INFORMATION AND SUBJECT MATTER HEREOF ARE THE CONFIDENTIAL, SOLE AND EXCLUSIVE PROPERTY OF CONTROLLED POWER, INC., AND ARE NOT TO BE COPIED, REPRODUCED OR USED IN ANY MANNER FOR ANY PURPOSE WHATSOEVER WITHOUT WRITTEN CONSENT OR DIRECTION.



ENGINEERED & MANUFACTURED BY
Controlled Power, Inc.
BOTHELL, WASHINGTON USA
(425)-485-1778 www.controlledpowerinc.com

LINE No.
1
2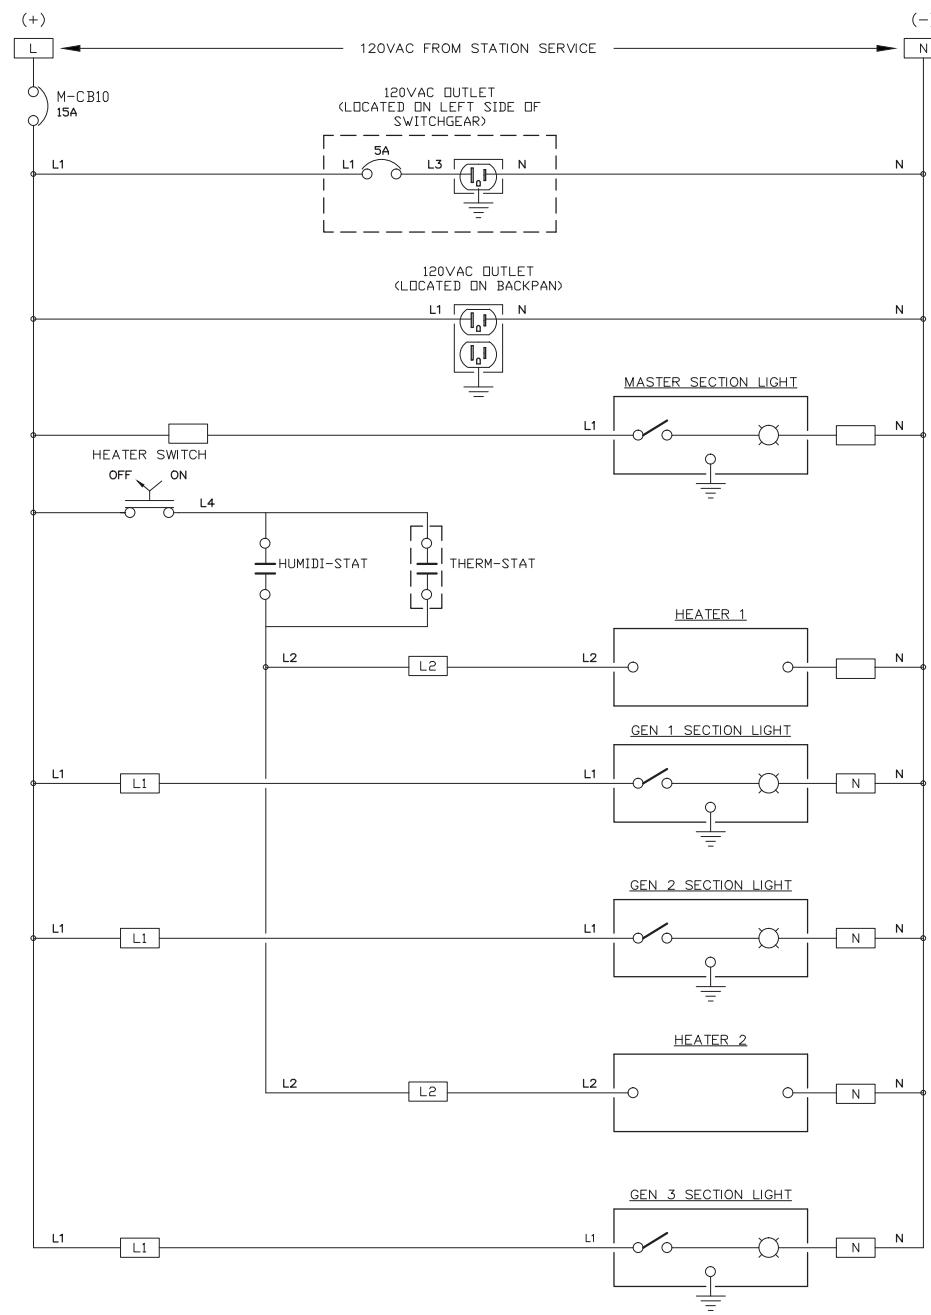
LINE No.
51
52
REV.	DATE	DESCRIPTION	BY
B	09-21-16	AS BUILT	RAC
PURCHASE ORDER No. ERNIE BAUMGARTNER CONTROLLED POWER JOB No. 8438CC			
TITLE: HEATER & LIGHTING CONTROL, SCHEMATIC DIAGRAM			
SCALE: NONE	DATE: 08-23-16	DWN. BY: GPN	
DWG. No: 8438CC-5701-D	SHEET: 1 OF 1	CKD. BY: JMD	
JOB: CROOKED CREEK EASYGEN UPGRADE			

NOTICE
THE DRAWINGS, INFORMATION AND SUBJECT MATTER HEREOF ARE THE CONFIDENTIAL, SOLE AND EXCLUSIVE PROPERTY OF CONTROLLED POWER, INC., AND ARE NOT TO BE COPIED, REPRODUCED OR USED IN ANY MANNER FOR ANY PURPOSE WHATSOEVER WITHOUT WRITTEN CONSENT OR DIRECTION.



ENGINEERED & MANUFACTURED BY
Controlled Power, Inc.
BOTHELL, WASHINGTON USA
(425)-485-1778 www.controlledpowerinc.com


SYSTEM MODE SWITCH - SMS

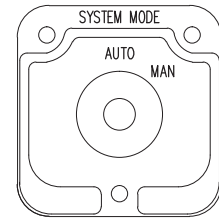

(ELECTROSWITCH 24201C)
KNURLED HANDLE
QTY 1

DECK	CONTACTS	POS.
1	12	011
		013
	16	015
		017
		AUTO
		MAN


MAIN CONTACTOR CONTROL SWITCH - 42CS

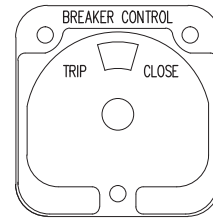

(ELECTROSWITCH 2438D)
PISTOL GRIP HANDLE
SPRING RETURN TO CENTER
QTY 1


DECK	CONTACTS	TRIP	POS.
1	11	018	NORM.
	16	017	CLOSE

GOVERNOR MODE SWITCH - GMS

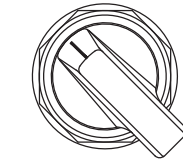


(MAINTAINED)
LOCATED ON BACK PAN

POS.
IDLE
RATED

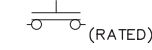


HEATER CONTROL SWITCH - HCS

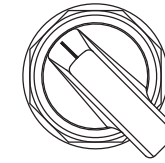


(MAINTAINED)
LOCATED ON MASTER BACK PAN

POS.
OFF
ON


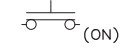


ENGINE CONTROL SWITCH - GLS

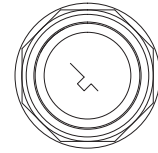

(MAINTAINED)

POS.
OFF
RUN

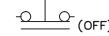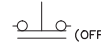


REV.	DATE	DESCRIPTION	BY
B	09-21-16	AS BUILT	RAC
PURCHASE ORDER No. ERNIE BAUMGARTNER CONTROLLED POWER JOB No. 8438CC			
TITLE: CONTROL SWITCH TARGET DIAGRAM			
SCALE: NONE	DATE: 08-23-16	DWN. BY: GPN	
DWG. No: 8438CC-6101-D	SHEET: 1 OF 1	CKD. BY: JMD	
JOB: CROOKED CREEK EASYGEN UPGRADE			

NOTICE
THE DRAWINGS, INFORMATION AND SUBJECT MATTER HEREOF ARE THE CONFIDENTIAL, SOLE AND EXCLUSIVE PROPERTY OF CONTROLLED POWER, INC., AND ARE NOT TO BE COPIED, REPRODUCED OR USED IN ANY MANNER FOR ANY PURPOSE WHATSOEVER WITHOUT WRITTEN CONSENT OR DIRECTION.



ENGINEERED & MANUFACTURED BY
Controlled Power, Inc.
BOTHELL, WASHINGTON USA
(425)-485-1778 www.controlledpowerinc.com

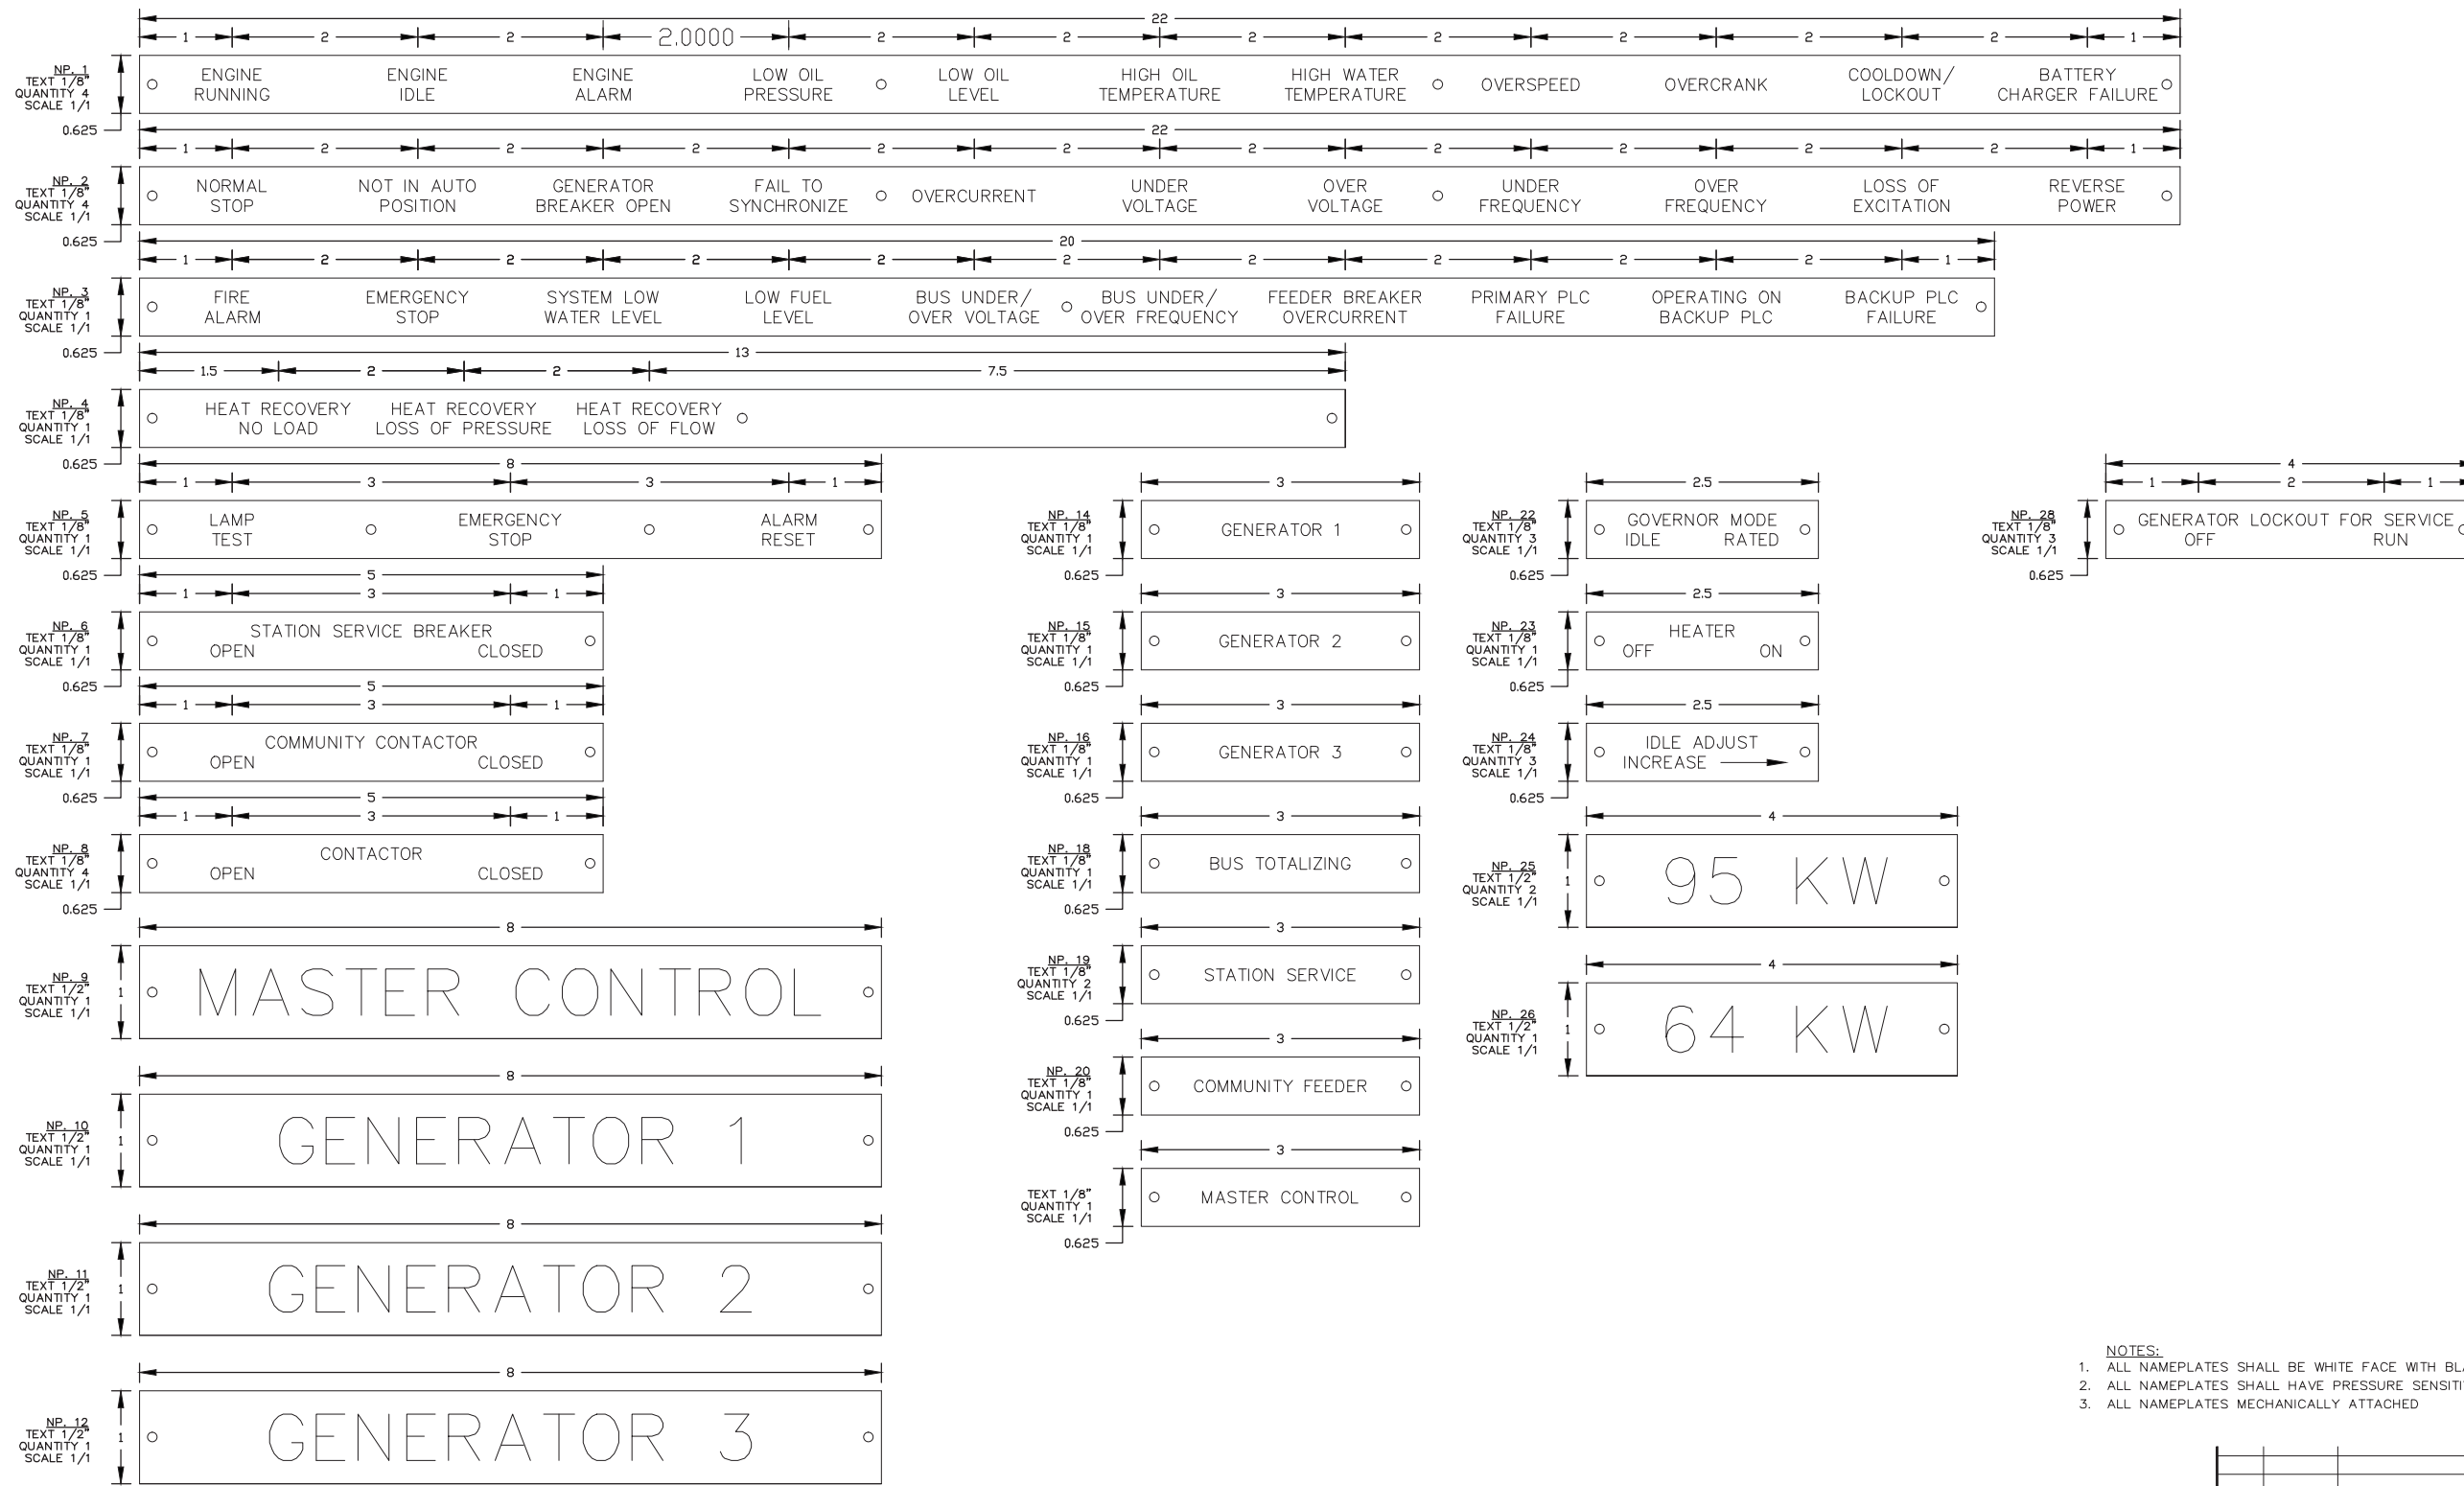

- NOTES:**
1. ALL NAMEPLATES SHALL BE WHITE FACE WITH BLACK LETTERS EXCEPT AS NOTED.
 2. ALL NAMEPLATES SHALL HAVE PRESSURE SENSITIVE ADHESIVE ON BACK
 3. ALL NAMEPLATES MECHANICALLY ATTACHED


REV.	DATE	DESCRIPTION	BY
B	09-21-16	AS BUILT	RAC
PURCHASE ORDER No. ERNIE BAUMGARTNER CONTROLLED POWER JOB No. 8438CC			
TITLE: NAMEPLATE ENGRAVING SCHEDULE, FABRICATION DIAGRAM			
SCALE: NONE	DATE: 08-23-16	DWN. BY: GPN	
DWG. No: 8438CC-6201-D	SHEET: 1 OF 1	CKD. BY: JMD	
JOB: CROOKED CREEK EASYGEN UPGRADE			

NOTICE
 THE DRAWINGS, INFORMATION AND SUBJECT MATTER HEREOF ARE THE CONFIDENTIAL, SOLE AND EXCLUSIVE PROPERTY OF CONTROLLED POWER, INC., AND ARE NOT TO BE COPIED, REPRODUCED OR USED IN ANY MANNER FOR ANY PURPOSE WHATSOEVER WITHOUT WRITTEN CONSENT OR DIRECTION.




ENGINEERED & MANUFACTURED BY
Controlled Power, Inc.
 BOTHELL, WASHINGTON USA
 (425)-485-1778 www.controlleddpowerinc.com


MASTER CONTROL

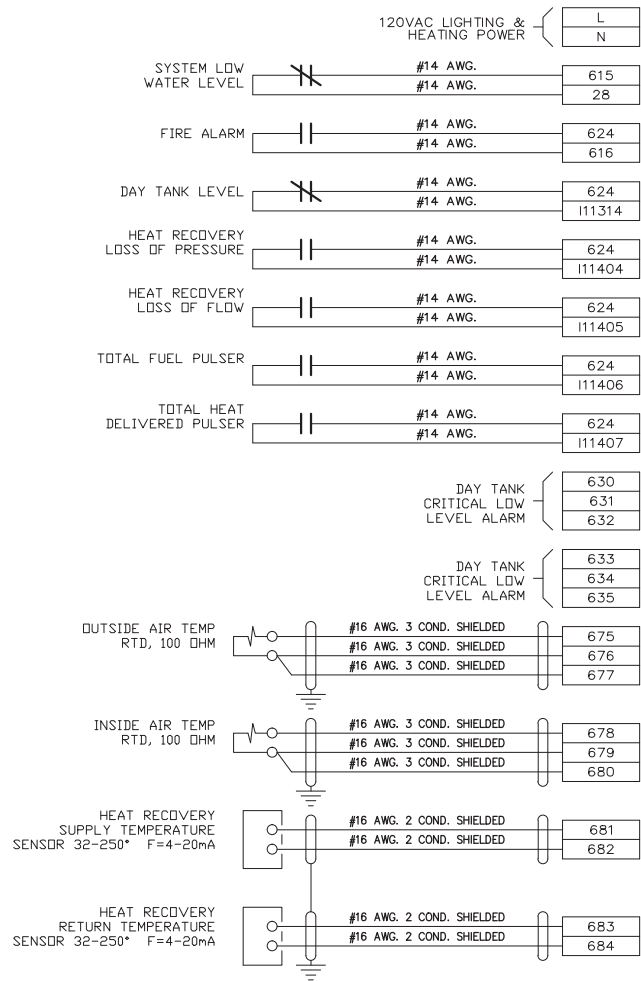


GENERATOR 1

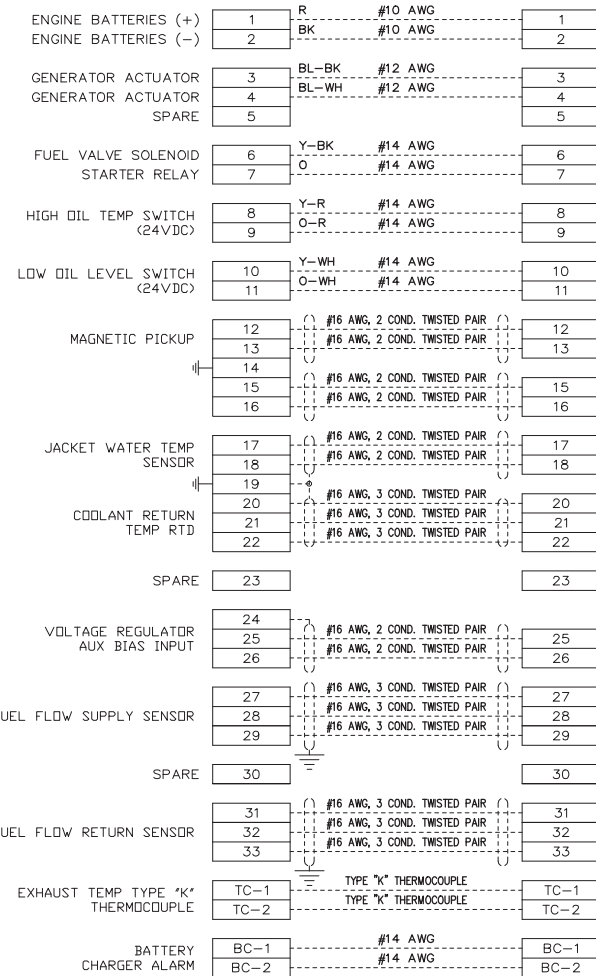

GENERATOR 2

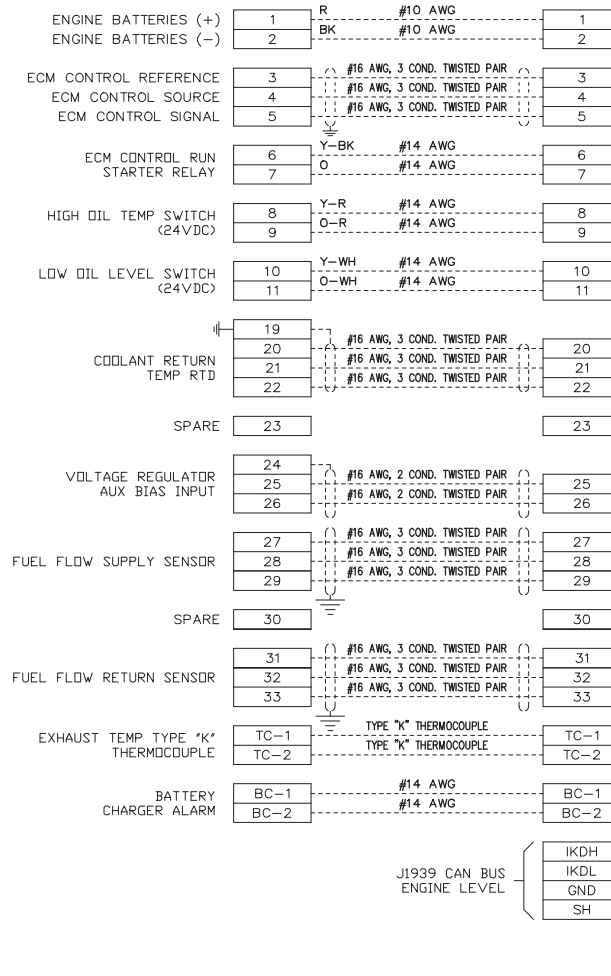

GENERATOR 3

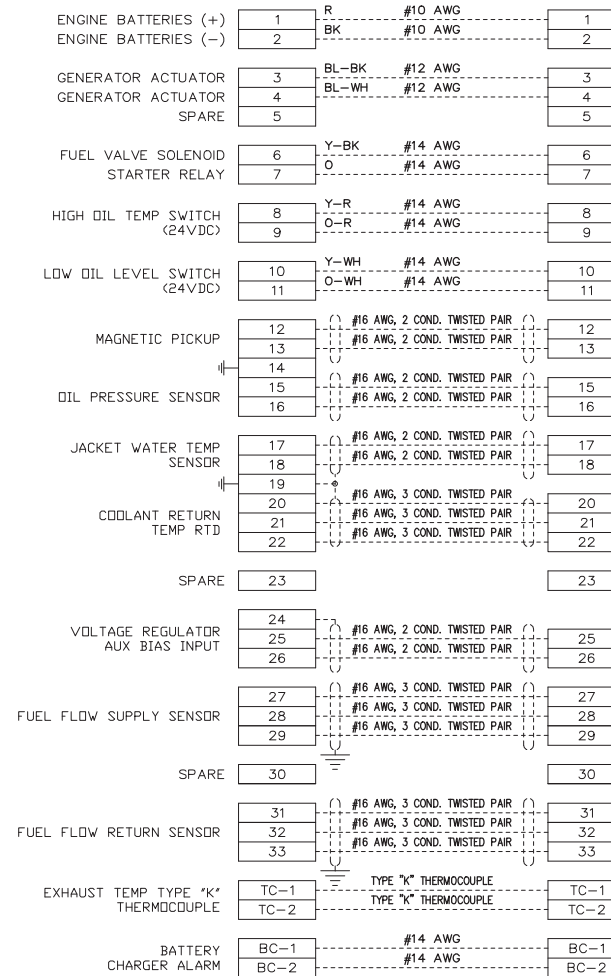

REV.	DATE	DESCRIPTION	BY
B	09-21-16	AS BUILT	RAC
PURCHASE ORDER No. ERNIE BAUMGARTNER CONTROLLED POWER JOB No. 8438CC			
TITLE: INTERCONNECTION DIAGRAM			
SCALE: NONE	DATE: 08-23-16	DWN. BY: GPN	
DWG. No: 8438CC-7101-D	SHEET: 1 OF 1	CKD. BY: JMD	
JOB: CROOKED CREEK EASYGEN UPGRADE			

NOTICE
THE DRAWINGS, INFORMATION AND SUBJECT MATTER HEREOF ARE THE CONFIDENTIAL, SOLE AND EXCLUSIVE PROPERTY OF CONTROLLED POWER, INC., AND ARE NOT TO BE COPIED, REPRODUCED OR USED IN ANY MANNER FOR ANY PURPOSE WHATSOEVER WITHOUT WRITTEN CONSENT OR DIRECTION.

ENGINEERED & MANUFACTURED BY
Controlled Power, Inc.
BOTHELL, WASHINGTON USA
(425)-485-1778 www.controlledpowerinc.com