
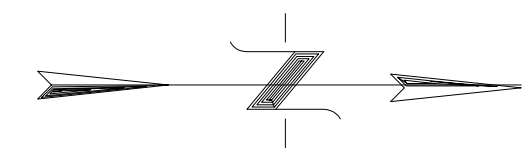


1 ASBUILT FLOOR PLAN  
 Scale: 1/4"=1'-0"

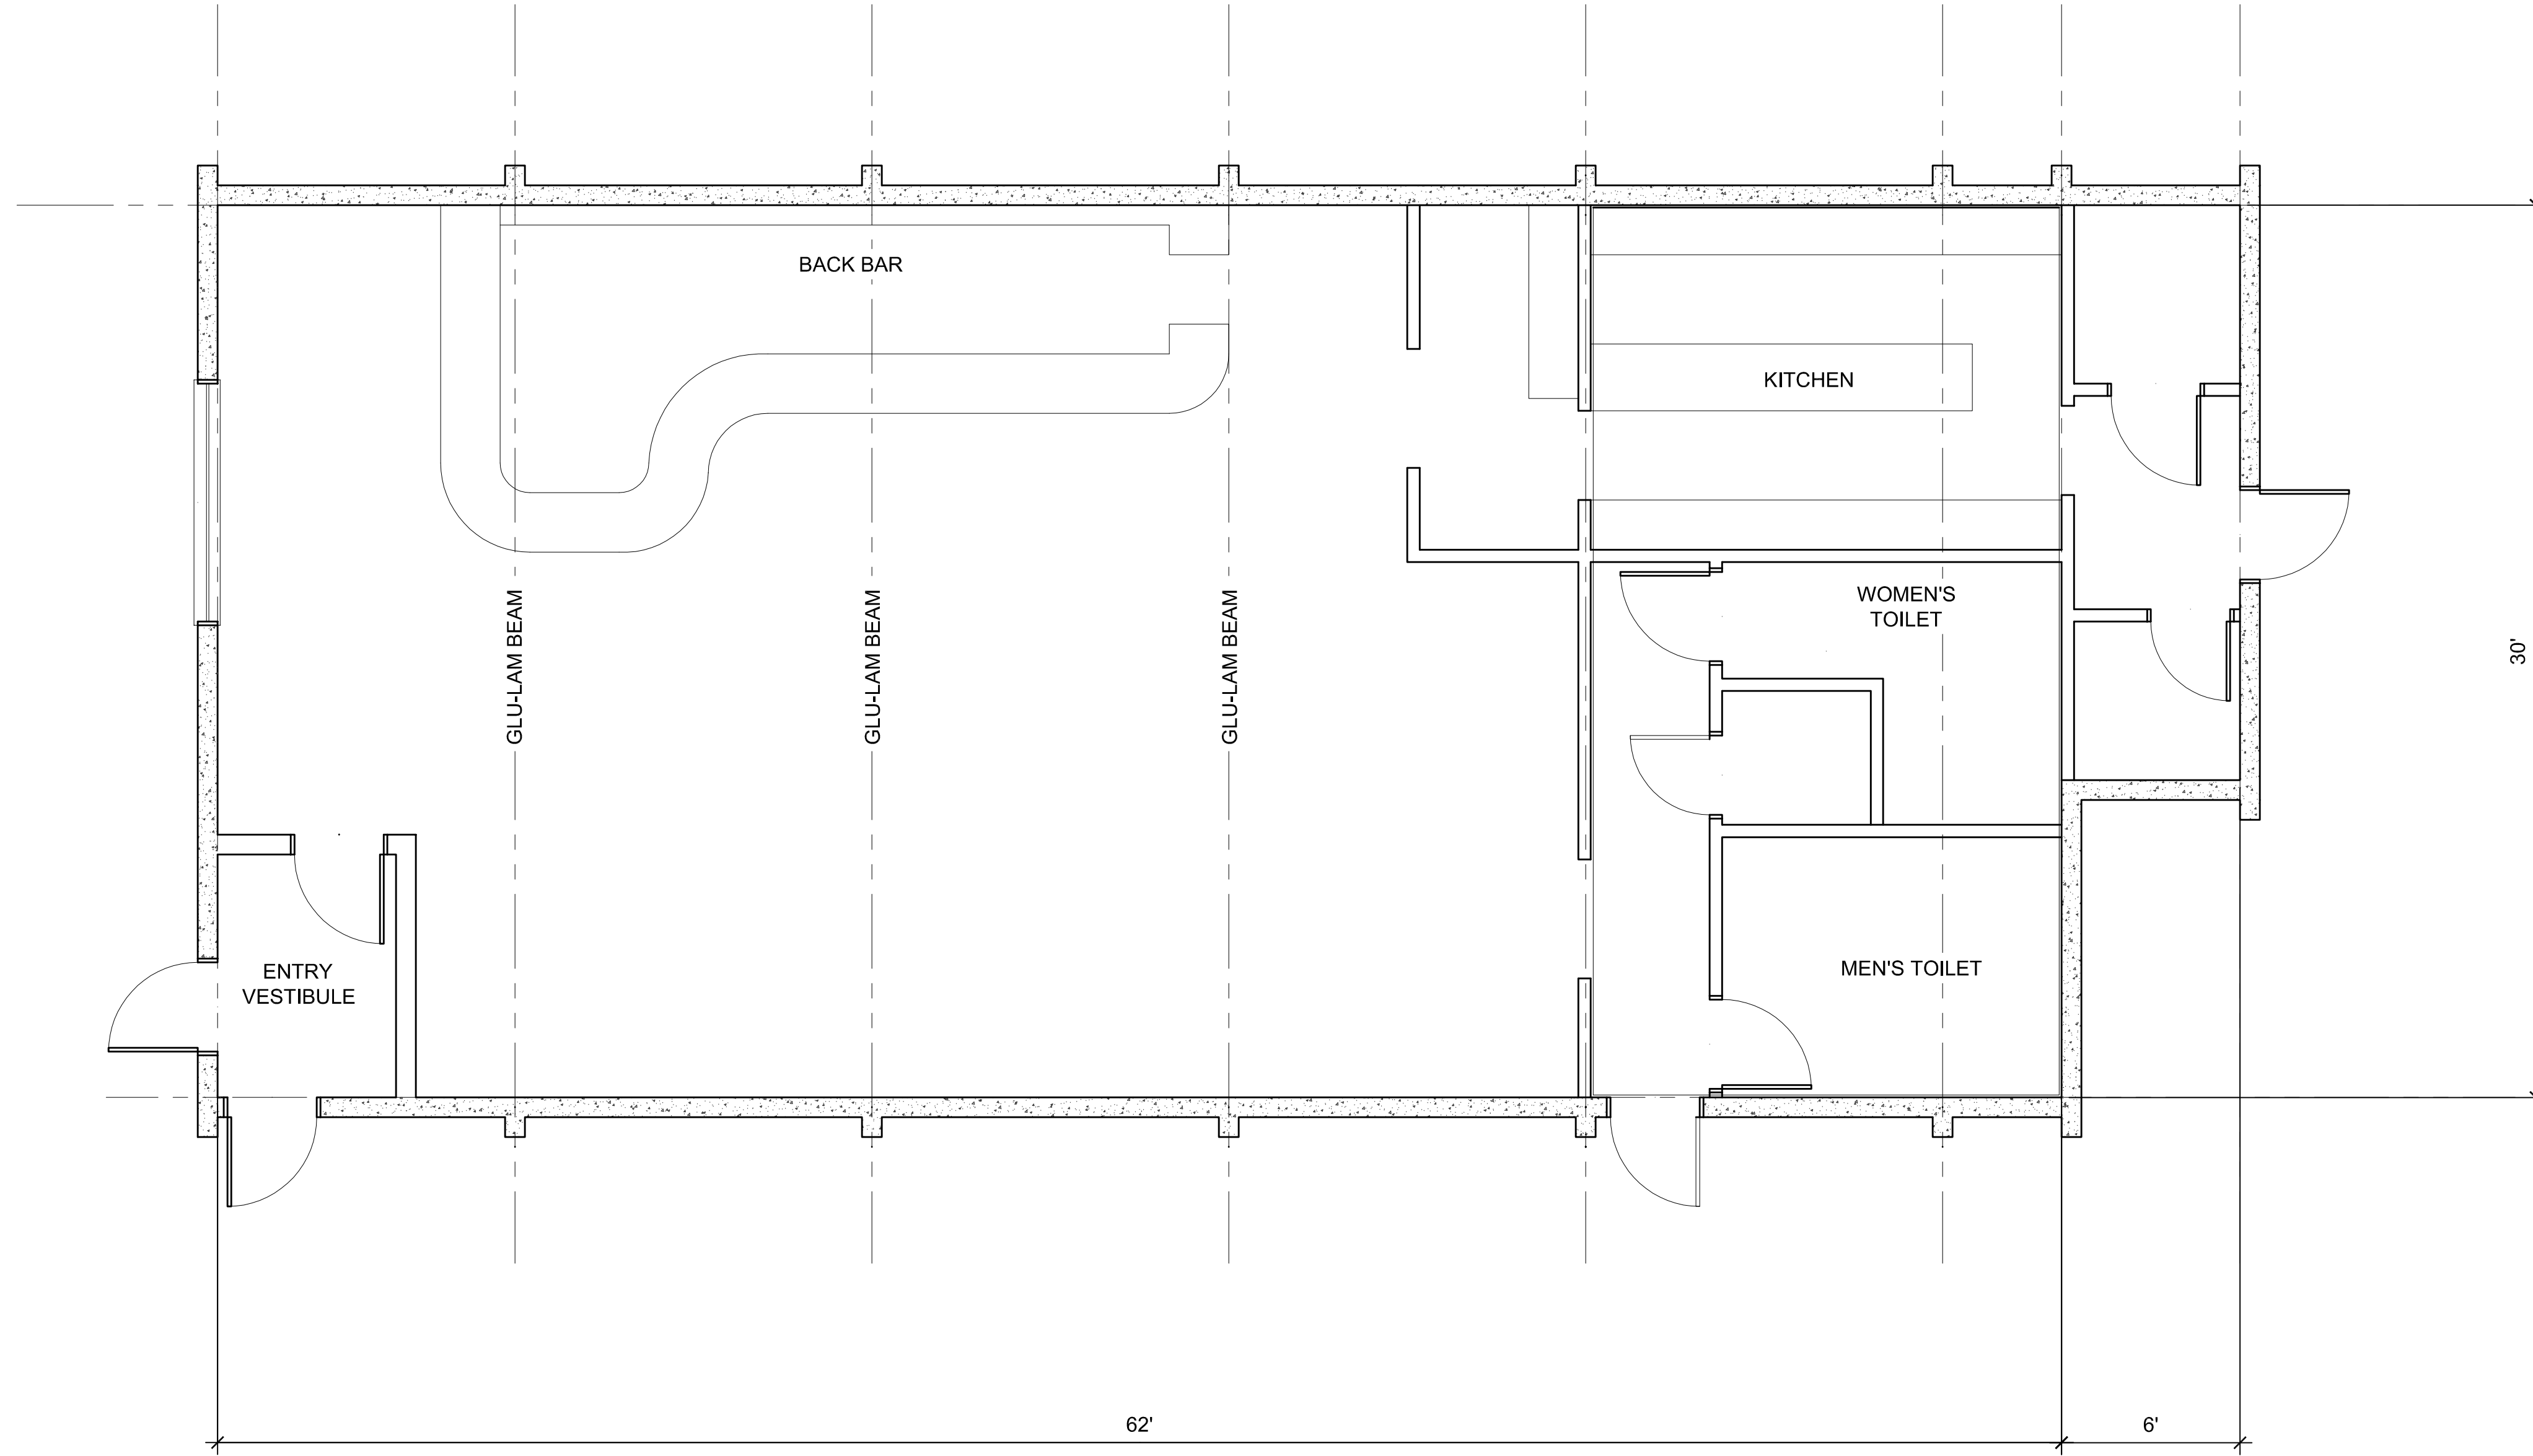

NOTE: USE HALF INDICATED SCALE FOR 11X17 DRAWINGS

PROJECT TITLE: Adult Care Facility  
 prepared for Frank Dahl  
 Asbuilt  
 825 W. Northern Lights Blvd Anchorage, Ak

SHEET NUMBER:

AS-1

JOB NUMBER: 1201

**Spreng Associates Inc., AIA**  
 Architecture & Planning ©2014  
 2522 Arctic Blvd, Suite #102 / Anchorage, Alaska 99503 / (907)563-5141 / FAX:279-2377  
 Job No: 1201 Drawn By: DHC Checked By: GLS Date: 10/2014 Revisions: